


LOCATION PLAN HOL-39-(16.69-17.29) 1951 SCALE: 1"=200'

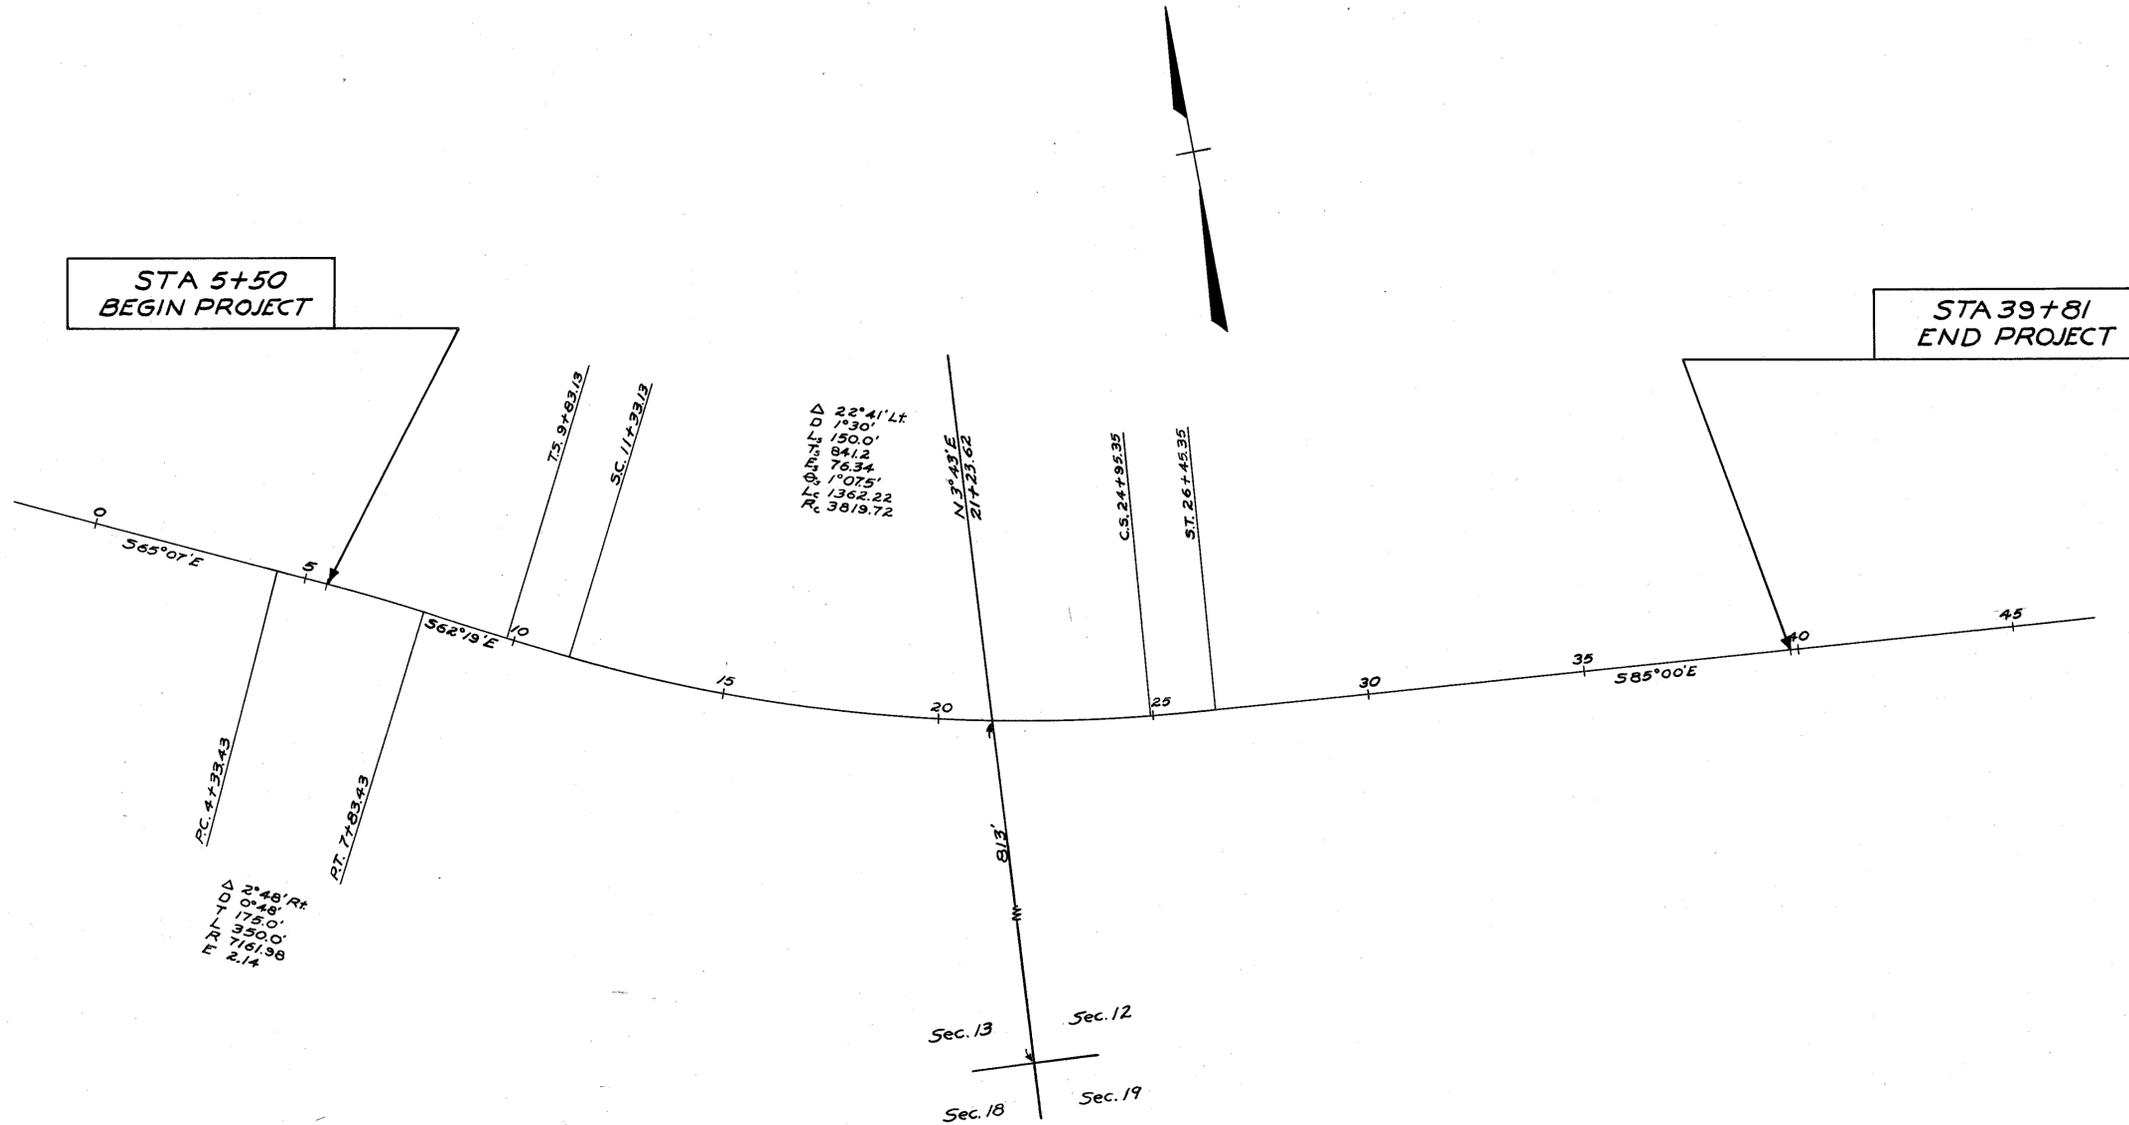


STA 5+50
BEGIN PROJECT

STA 39+81
END PROJECT

43384
 RECEIVED SEPT. 20 1951
 AT 1:15 O'CLOCK P.M.
 RECORDED NOV. 17 1951
 IN HOLMES COUNTY
 RECORD OF PLAT VOL. 2
 PAGE 32
 Evelyn Anderson RECORDER
 RECORDER'S FEE \$ 6.50

CENTER LINE REFERENCE MONUMENTS WILL BE SET BEFORE OR AFTER CONSTRUCTION

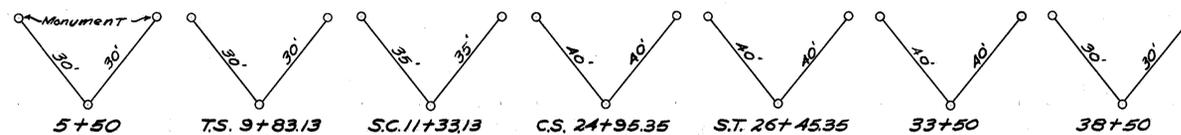


I hereby certify that this plat is correct to the best of my knowledge and belief.

Signed Dwight W. Smith Division Engineer.
 Date 9-19-51

HARDY TWP. SEC. 13 - T.9 - R.7

FED. RD. DIVISION	STATE	PROJECT	TYPE FUNDS	1
2	OHIO			3

HOL-39-(16.69-17.29)
 R/W PLANS
 Net Length of Project-0.649 Mile
 Revised: Nov. 21, 1951

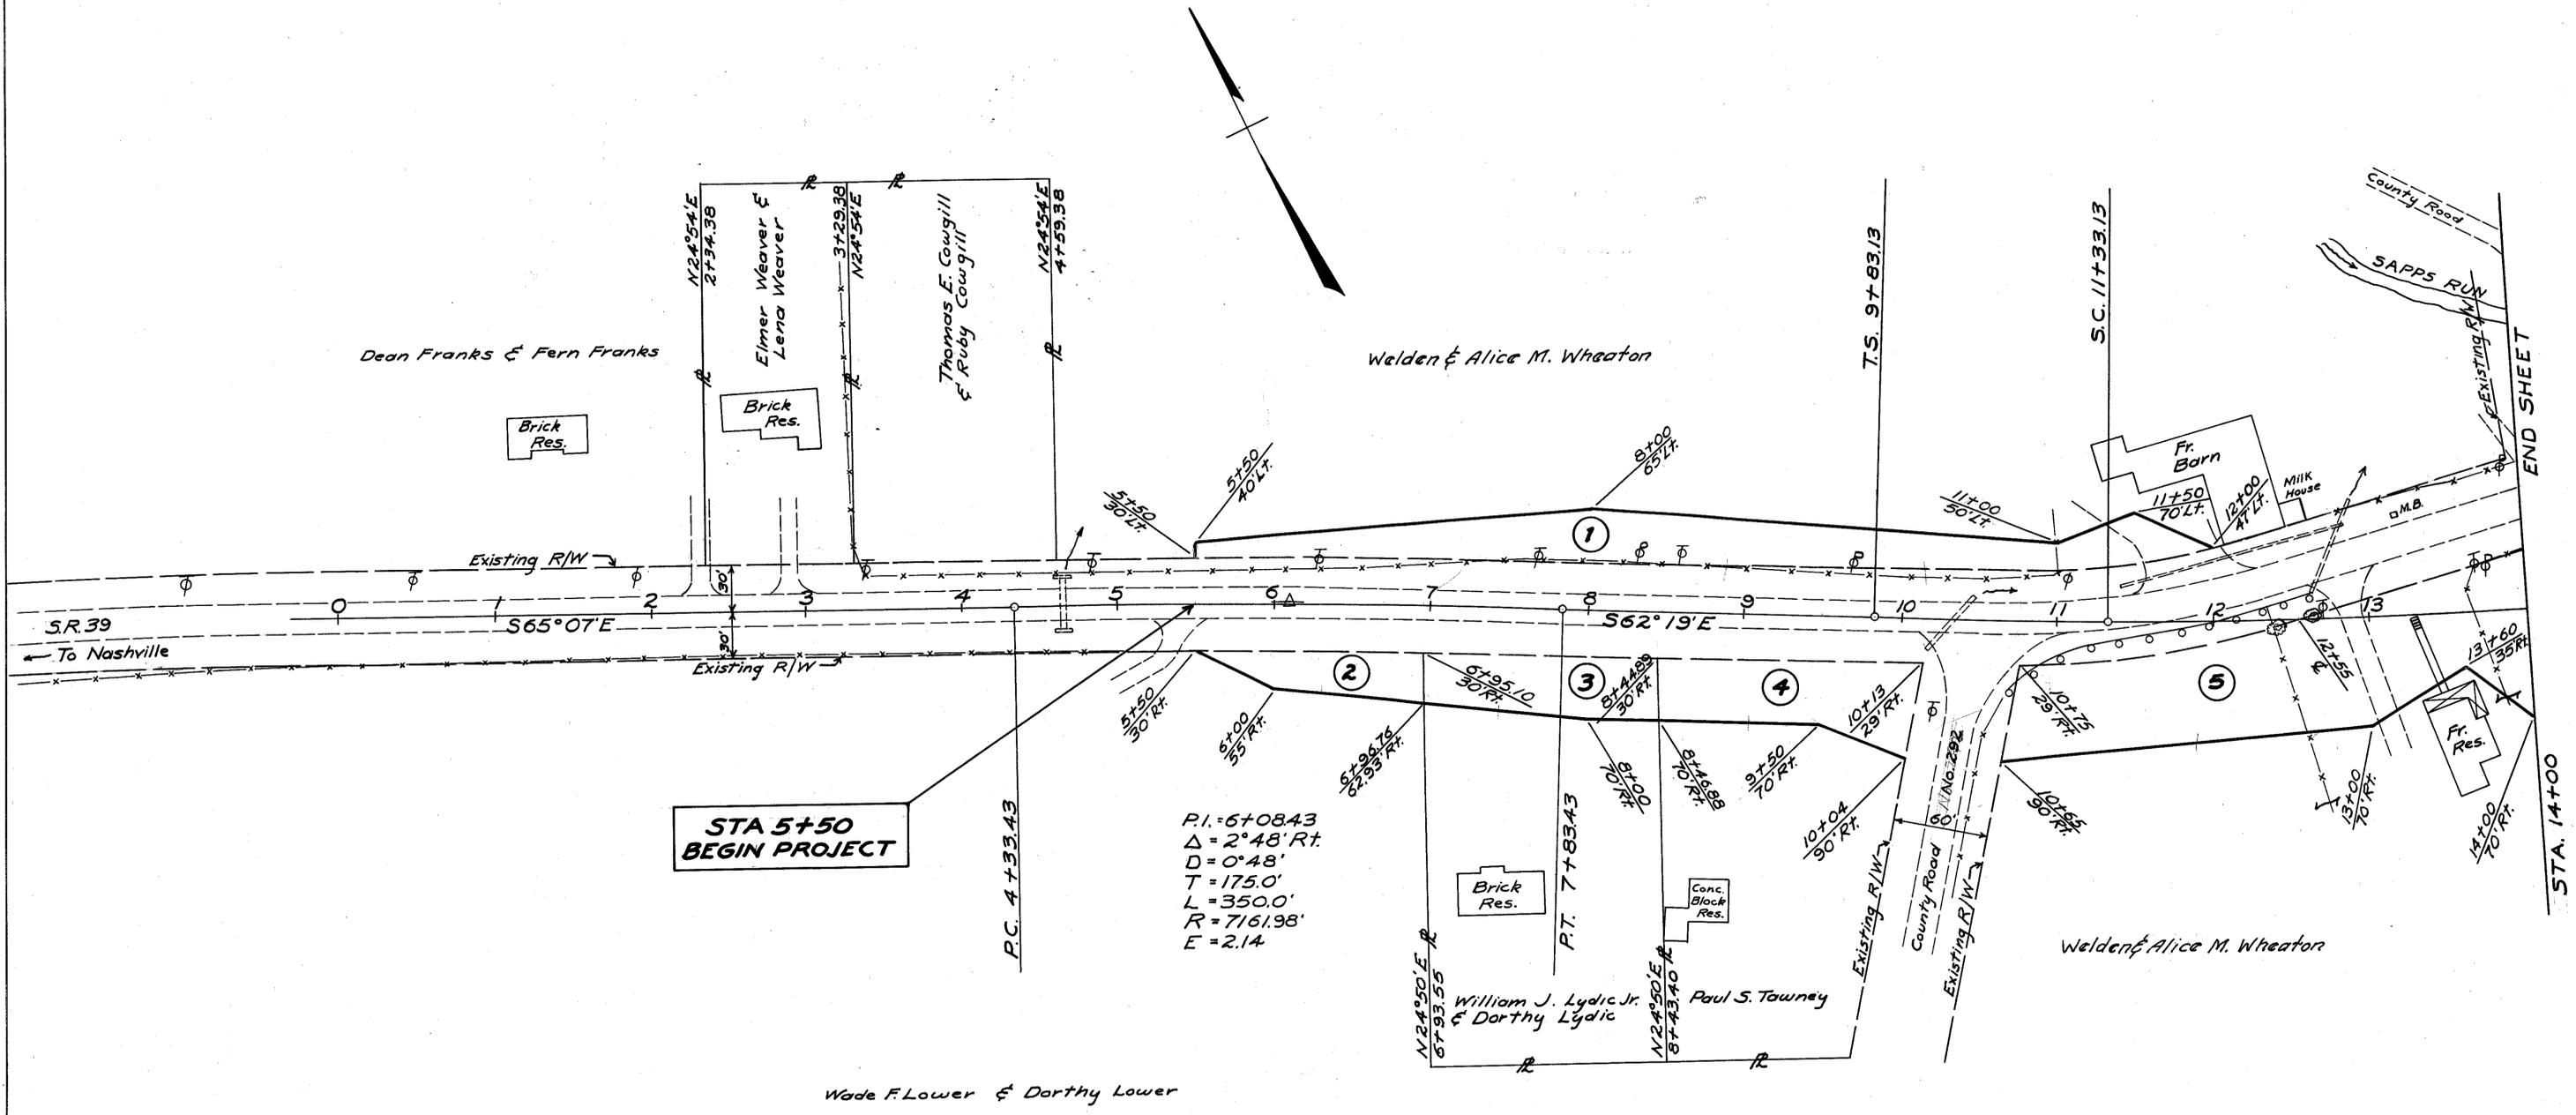

① ⑤
 Welden & Alice M. Wheaton
 ① T.B.A. = 0.36 Ac.
 ⑤ T.B.A. = 3.10 Ac.

②
 Wade F. Lower & Dorothy Lower
 T.B.A. = 0.08 Ac.

③
 William J. Lydic Jr. & Dorothy Lydic
 T.B.A. = 0.13 Ac.

④
 Paul S. Tawney
 T.B.A. = 0.17 Ac.

NOTE: No Portion of Existing S.R. 39 Right of Way to be Abandoned. Retain Existing Right of Way Between STA. 5+50 and STA. 39+38.

HARDY TWP. SECS. 13 & 12 ~ T.9 - R.7

FED. RD. DIVISION	STATE	PROJECT	TYPE FUNDS
2	OHIO		

2
3

HOL-39 - (16.69-17.29)
Revised: Nov. 21, 1951

P.I. 18+24.33
Δ = 22° 41' Lt.
D_c = 1° 30'
T_s = 841.20'
L_s = 150'
L_c = 1362.22'
E_s = 76.34'
R_c = 3819.72'

SEC. 13 ~ T.9 ~ R.7
N 3° 43' E
21723.62

SEC. 12 ~ T.9 ~ R.7

Ralph P. & Ruth A. Hipp

Harry C. Rottman & Vera E. Rottman

Welden & Alice M. Wheaton

Welden & Alice M. Wheaton

6

Edwin A. Uhl
T.B.A. = 0.16 Ac.

7

7X


7Y

Harry C. Rottman & Vera E. Rottman

7
7X
7Y

T.B.A.	4.61	Ac.
T.B.A.	0.28	Ac.
T.B.A.	0.19	Ac.

NOTE: No Portion of Existing SR. 39 Right of Way to be Abandoned. Retain Existing Right of Way Between STA. 5+50 and STA. 39+38.

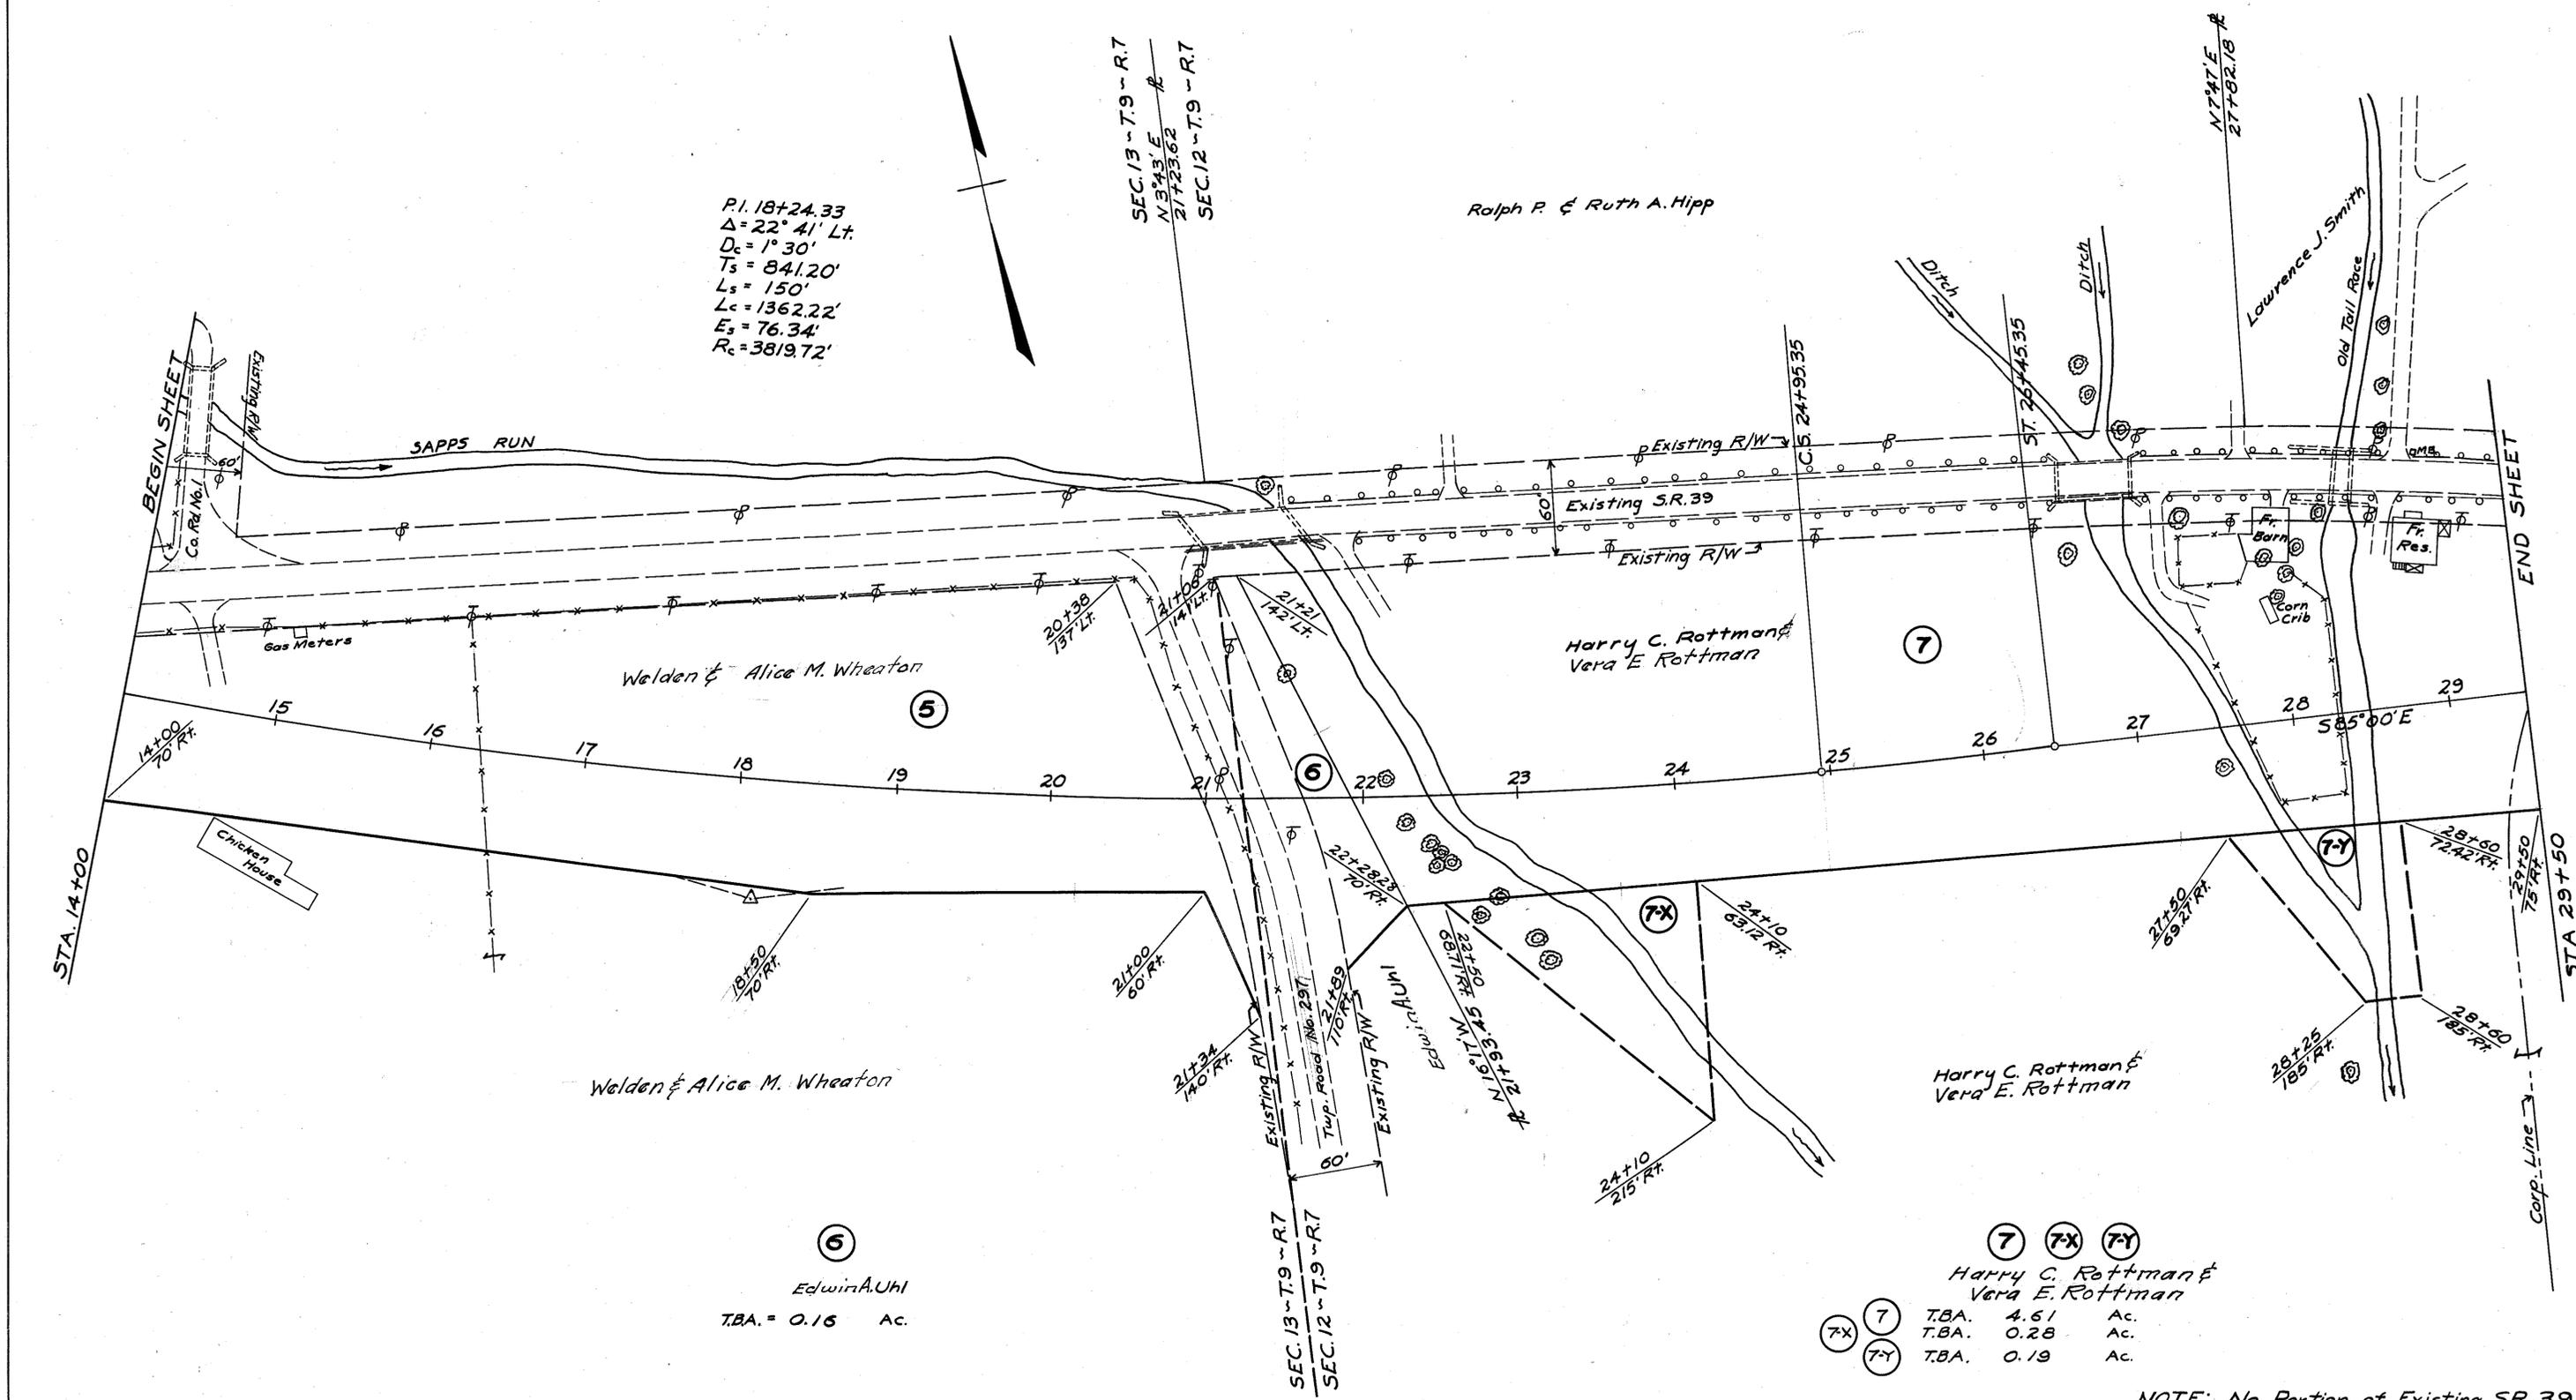


HARDY TWP. SEC.12-T.9-R.7 & VILLAGE OF MILLERSBURG

FED. RD. DIVISION	STATE	PROJECT	TYPE FUNDS
2	OHIO		

3
3

HOL-39 - (1669-1729)
 Revised: Nov. 21, 1951.
 Rev. - Added Parcel 10-V - June 30, 1975

PARCEL 10-V
 Vacated - June 18, 1975
 Containing - 0.251 Ac.
 Recorded:
 Director's Journal - Vol. 4 - Pg. 319
 Holmes Co. Records - Vol. 191 - Pg. 104
 June 25, 1975

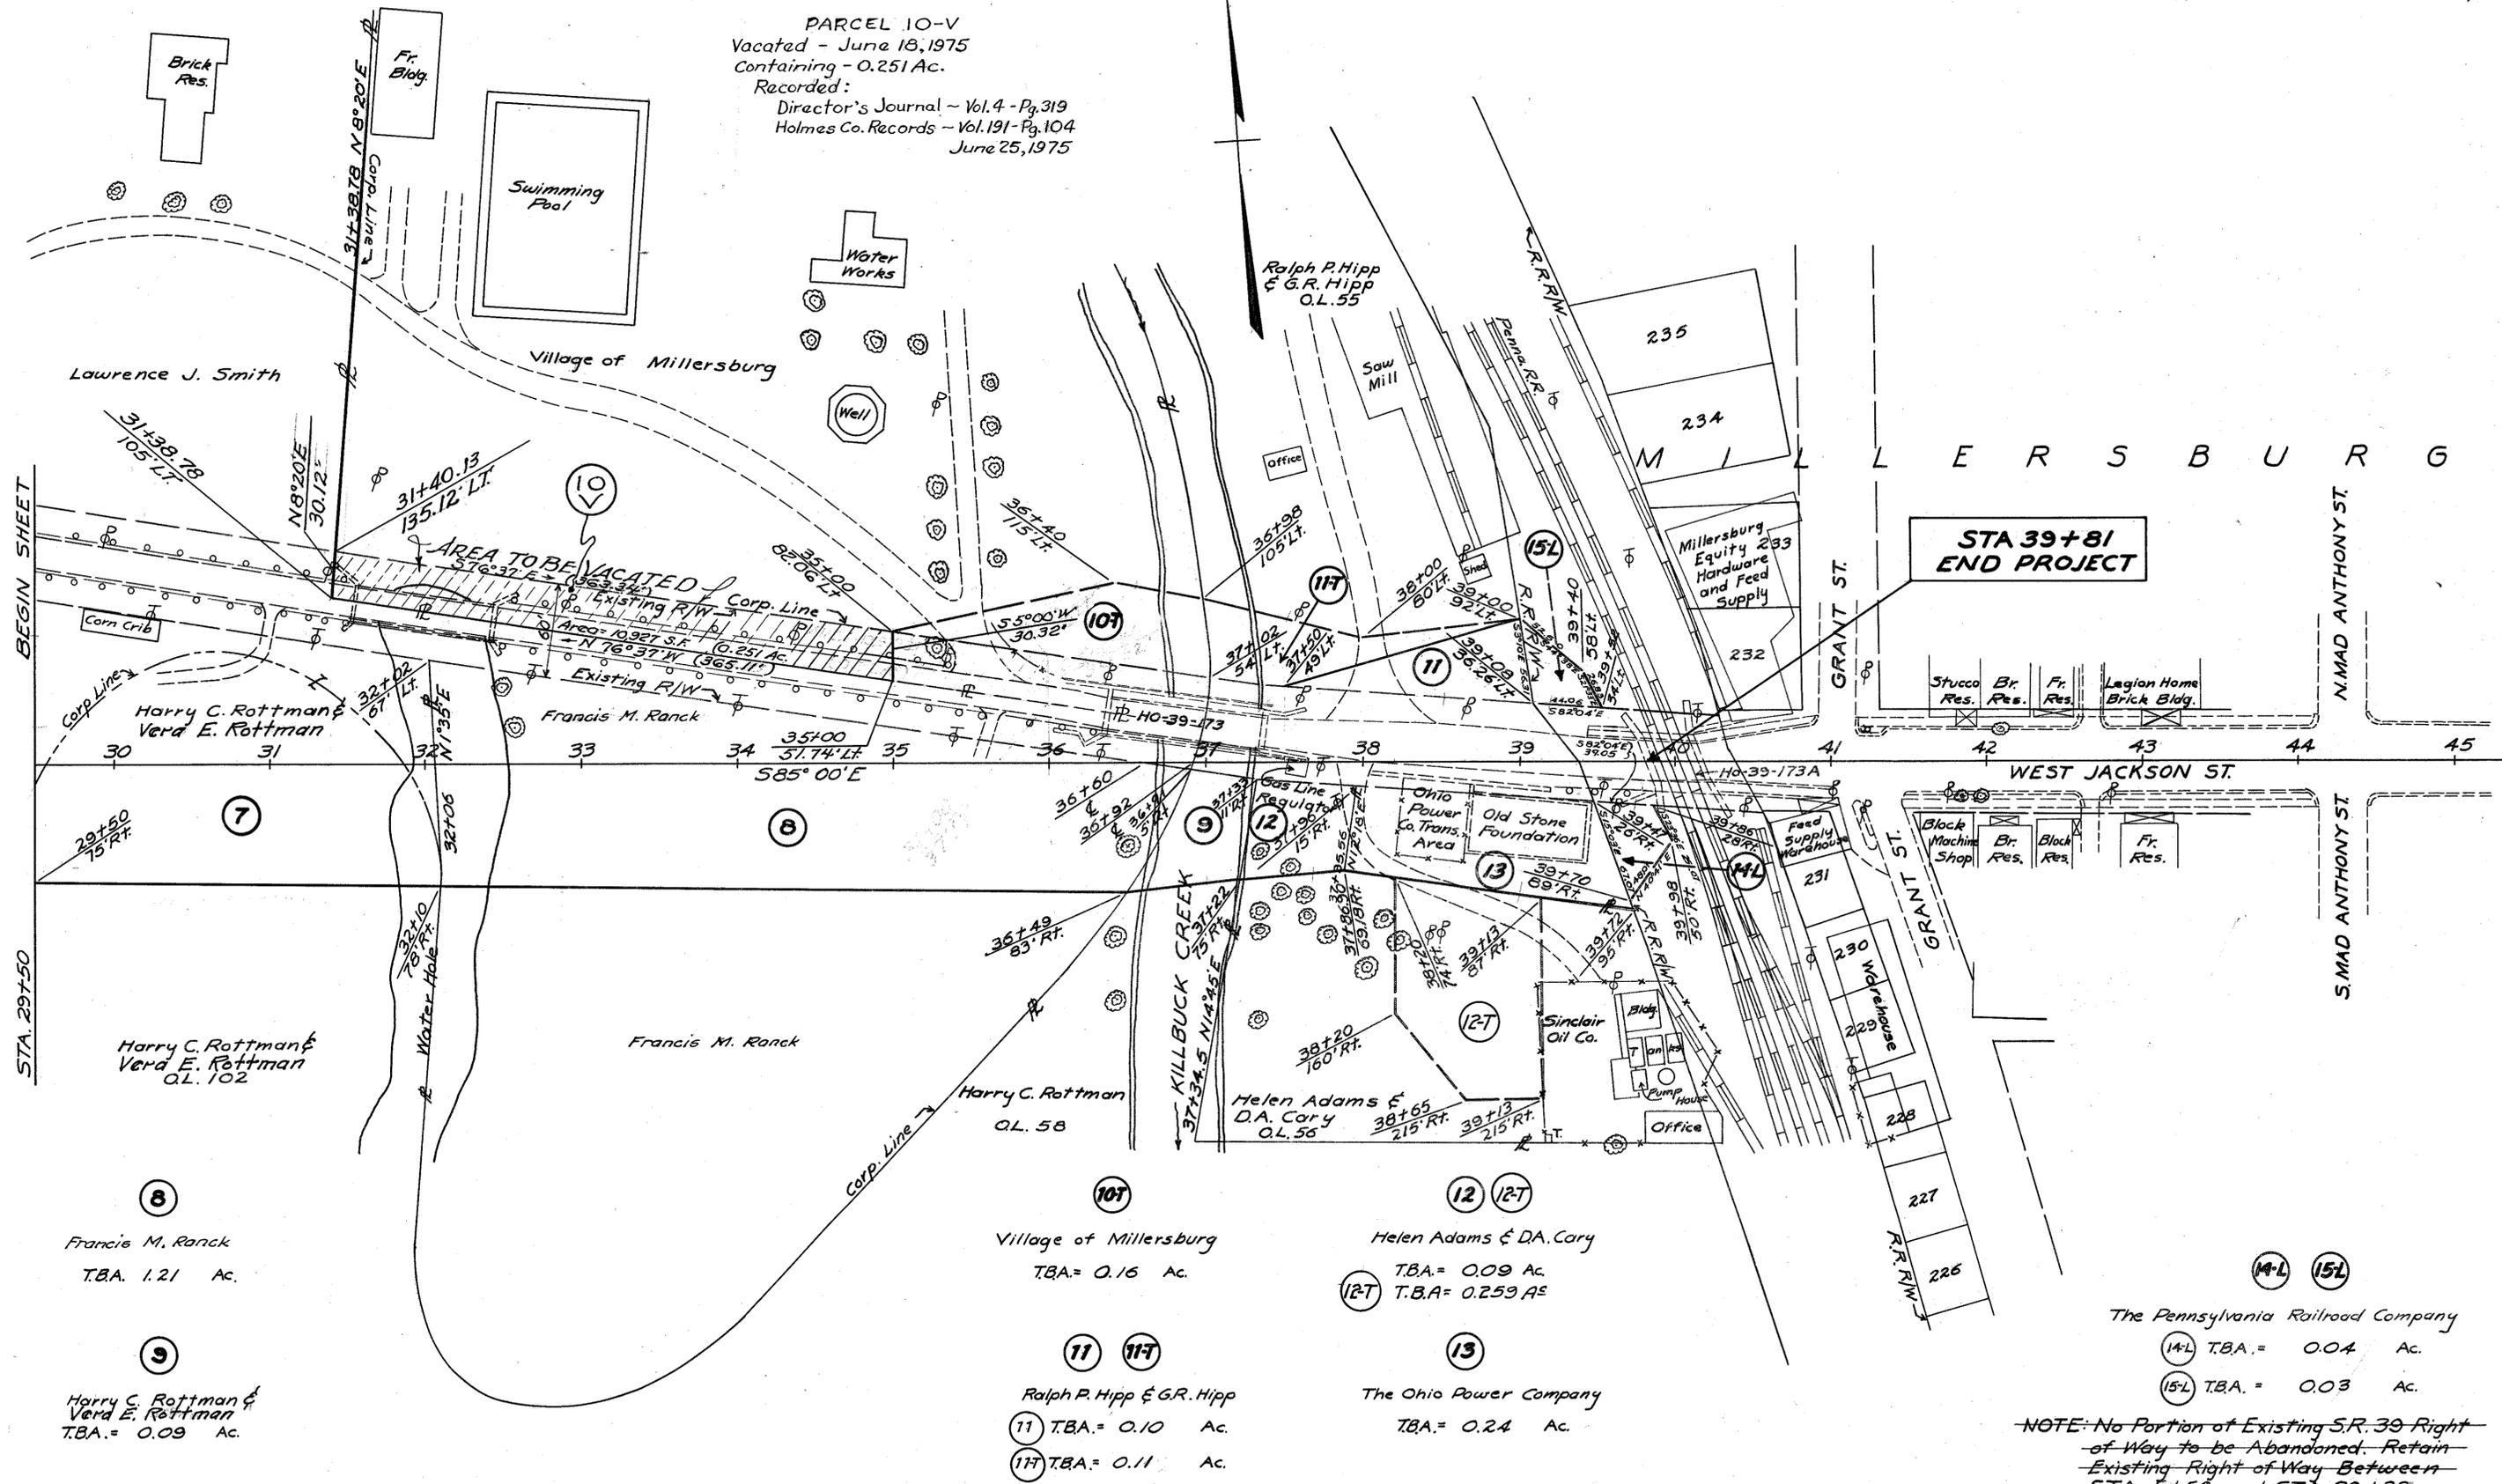

BEGIN SHEET

STA. 29+50

Lawrence J. Smith

Village of Millersburg

Ralph P. Hipp & G.R. Hipp
 O.L. 55

235
234

STA 39+81
 END PROJECT

WEST JACKSON ST.

N. MAD ANTHONY ST.

S. MAD ANTHONY ST.

Harry C. Rottman & Vera E. Rottman
 O.L. 102

Francis M. Ranck

Harry C. Rottman
 O.L. 58

Helen Adams & D.A. Cory
 O.L. 55

Francis M. Ranck
 T.B.A. = 1.21 Ac.

Village of Millersburg
 T.B.A. = 0.16 Ac.

Helen Adams & D.A. Cory
 T.B.A. = 0.09 Ac.
 T.B.A. = 0.259 Ac.

Harry C. Rottman & Vera E. Rottman
 T.B.A. = 0.09 Ac.

Ralph P. Hipp & G.R. Hipp
 11 T.B.A. = 0.10 Ac.
 117 T.B.A. = 0.11 Ac.

The Ohio Power Company
 T.B.A. = 0.24 Ac.

The Pennsylvania Railroad Company
 14-L T.B.A. = 0.04 Ac.
 15-L T.B.A. = 0.03 Ac.

NOTE: No Portion of Existing S.R. 39 Right-of-Way to be Abandoned. Retain Existing Right-of-Way Between STA. 5+50 and STA. 39+38.