

I:\ProjectData\81722\Design\Roadway\Sheets\81722_GG002.dgn Sheet 2/16/2020 4:52:16 PM shorrib

Table with columns: SHEET NUM., PART., ITEM, ITEM EXT, GRAND TOTAL, UNIT, DESCRIPTION, SEE SHEET NO.

PAVEMENT

TRAFFIC CONTROL


Handwritten red circles around values 960, 29,880, 4,300, 1,108, 6,069.

Handwritten red circles around values 960, 34,180, 81, 1,108, 6,069.

Handwritten red circles around values 960, 34,180, 81, 1,108, 6,069.


GENERAL SUMMARY

JEF / COL-7 -31.13 / 0.00

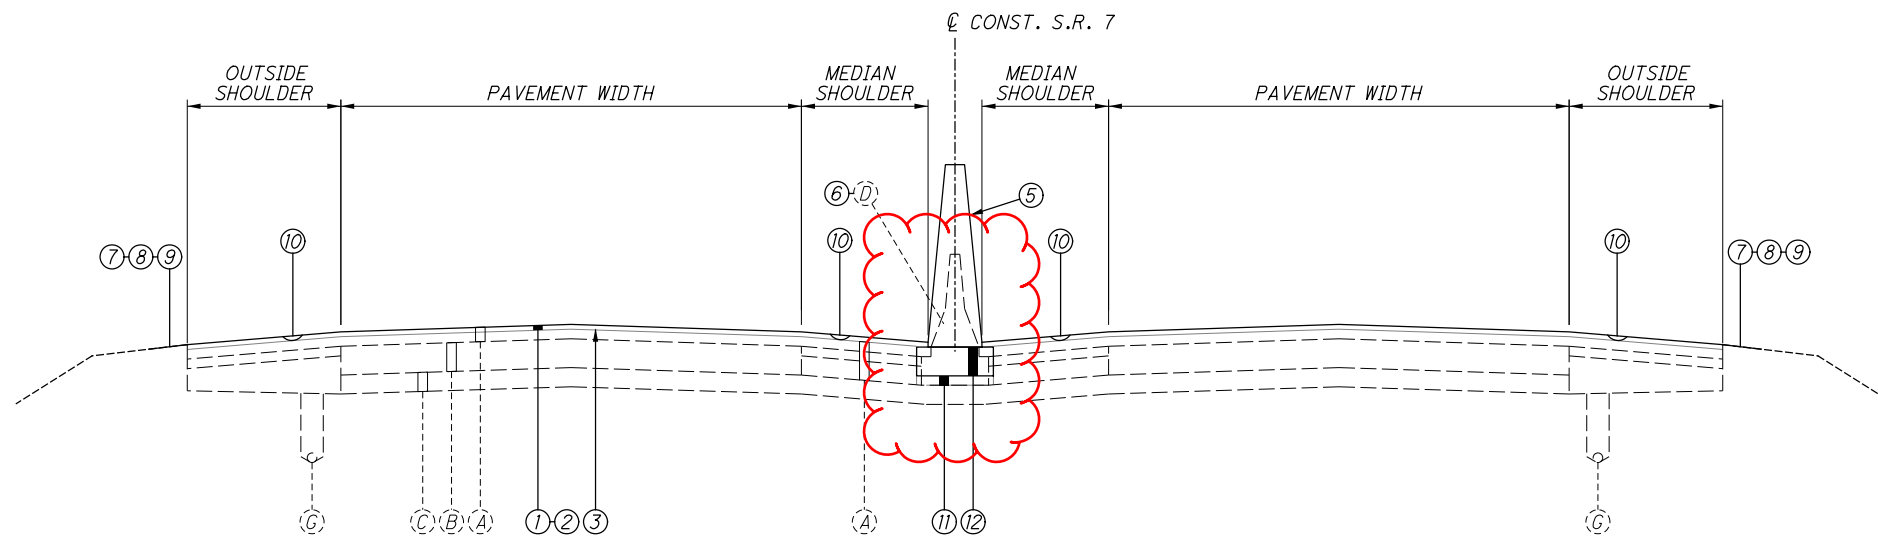


TYPICAL SECTION 3

FOR LEGEND SEE SHEET 15
 FOR MAINLINE PAVEMENT WIDTHS, SEE SHEET 19 - 20
 FOR MAINLINE OUTSIDE AND MEDIAN SHOULDER WIDTHS,
 SEE SHEET 23 - 24
 FOR RAMP PAVEMENT WIDTHS, SEE SHEET 21
 FOR RAMP SHOULDER WIDTHS, SEE SHEET 25

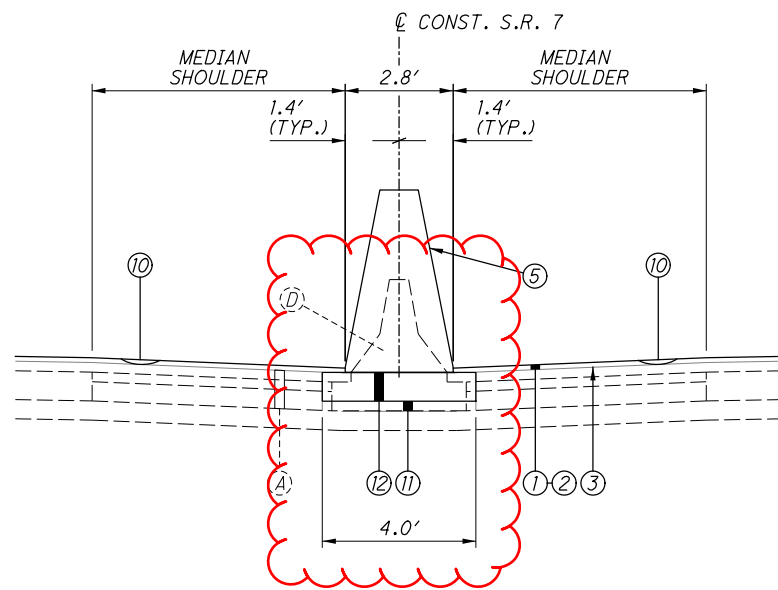

MEDIAN BARRIER DETAIL

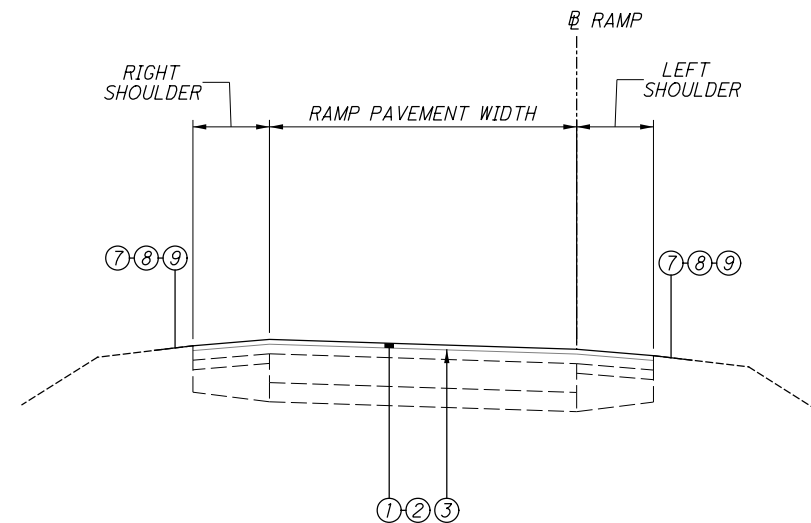



RAMP TYPICAL
 (IN DIRECTION OF TRAVEL)

I:\ProjectData\81722\Design\Roadway\Sheets\81722_GY002.dgn Sheet 2/6/2020 4:52:22 PM shorr\rsb

I:\ProjectData\81722\Design\Roadway\Sheets\81722_G001.dgn Sheet 2/6/2020 4:52:30 PM shorrrisb

S.R. 7 SLM		LENGTH FT	202				255	304	305	606	609	611						622								626	COMMENTS							
FROM	TO		FT	CONCRETE BARRIER REMOVED	PIPE REMOVE 24" AND UNDER	PAVEMENT REMOVED, ASPHALT	INLET REMOVED	FULL DEPTH PAVEMENT SAWING	6" AGGREGATE BASE	9" CONCRETE BASE, QC IP	IMPACT ATTENUATOR, TYPE 1, (BIDIRECTIONAL)	4" CONCRETE MEDIAN	INLET NO. 3 FOR SINGLE SLOPE BARRIER, TYPE BI	INLET NO. 3 FOR SINGLE SLOPE BARRIER, TYPE BI, AS PER PLAN	6" CONDUIT, TYPE F FOR UNDERDRAIN OUTLET	12" CONDUIT, TYPE B	15" CONDUIT, TYPE B	18" CONDUIT, TYPE B	21" CONDUIT, TYPE B	CONCRETE BARRIER, SINGLE SLOPE, TYPE BI	BARRIER TRANSITION	CONCRETE BARRIER, END ANCHORAGE, REINFORCED, TYPE BI, AS PER PLAN (A)	CONCRETE BARRIER, END ANCHORAGE, REINFORCED, TYPE BI, AS PER PLAN (B)	CONCRETE BARRIER, END ANCHORAGE, REINFORCED, TYPE BI, AS PER PLAN (C)	CONCRETE BARRIER, END ANCHORAGE, REINFORCED, TYPE BI, AS PER PLAN (D)	CONCRETE BARRIER, END ANCHORAGE, REINFORCED, TYPE BI, AS PER PLAN (E)		CONCRETE BARRIER, END ANCHORAGE, REINFORCED, TYPE BI, AS PER PLAN (F)	CONCRETE BARRIER, END ANCHORAGE, REINFORCED, TYPE BI, AS PER PLAN (G)	CONCRETE BARRIER END SECTION, TYPE BI	BARRIER REFLECTOR, TYPE 1, ONE-WAY (WHITE)			
COLUMBIANA CO.																																		
0.36	1.27	4724	4554		253			9108	340	1851																				190	FOR DETAILS SHEETS 31 - 37			
0.47		20		16								1		8				16																
0.49		20		24								1		16	8	8																		
0.5		20		8								1			8																			
0.62		20		8								1		8	8																			
0.71		20		8								1		8	8																			
0.89		20		8									1	8	8																			
1.25		20		8								1		8	8																			
STRUCTURE COL-7-0127																																		
1.28	1.92	3370	3270		182			6540	242	1320																								
1.5		20		8								1		8	8																			
1.65		20		8								1		8	8																			
1.67		20		32								1		16	16			16																
1.69		20		8								1		8	8																			
1.91		20		8								1		8	8																			
STRUCTURE COL-7-0193																																		
1.95	2.74	4231	4131		230			8262	306	1725																								
2.2		20		8								1		8	8																			
2.22		20		32								1		16	16			16																
2.24		20		8								1		8	8																			
2.38		20		16								1						16																
2.73		20		16								1		8	16																			
STRUCTURE COL-7-0275																																		
2.84	3.04	1027	947		53			1894	70	336																								
2.87		20		16								1		8	16																			
2.88		20		16								1		16	16																			
2.9		20		8								1		8	8																			
3.02		20		8								1		8	8																			
STRUCTURE COL-7-0305																																		
3.08	3.41	1709	1649		92			3298	122	664																								
3.19		20		16								1		8	8	8																		
3.22		20		16								1		16				16																
3.24		20		8								1		8	8																			
3.41	3.48	389						778	28	173	1	125																						
TOTALS CARRIED TO GENERAL SUMMARY																																		
			14551	312	810	24	29880	1108	6069	1	125	23	1	216	208	16	24	64	13266	8	67	1	1	1	1	1	1	1	612	PART 2 (01/NHS/PV)				

CALCULATED SAH CHECKED DAH	ROADWAY AND DRAINAGE QUANTITIES	JEF / COL-7 -31.13 / 0.00	26 53
-------------------------------------	--	----------------------------------	----------

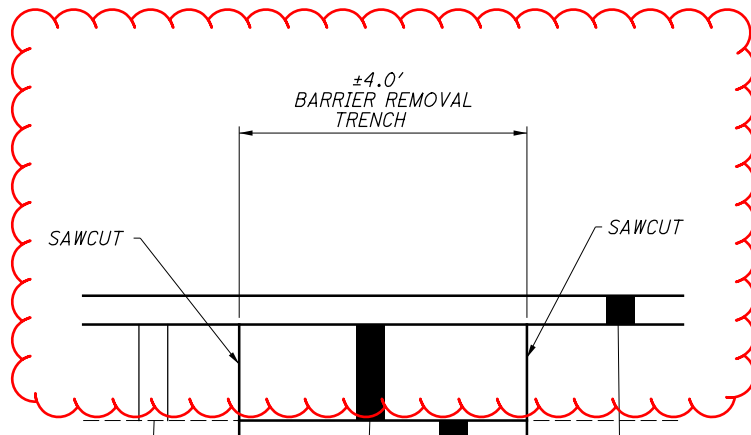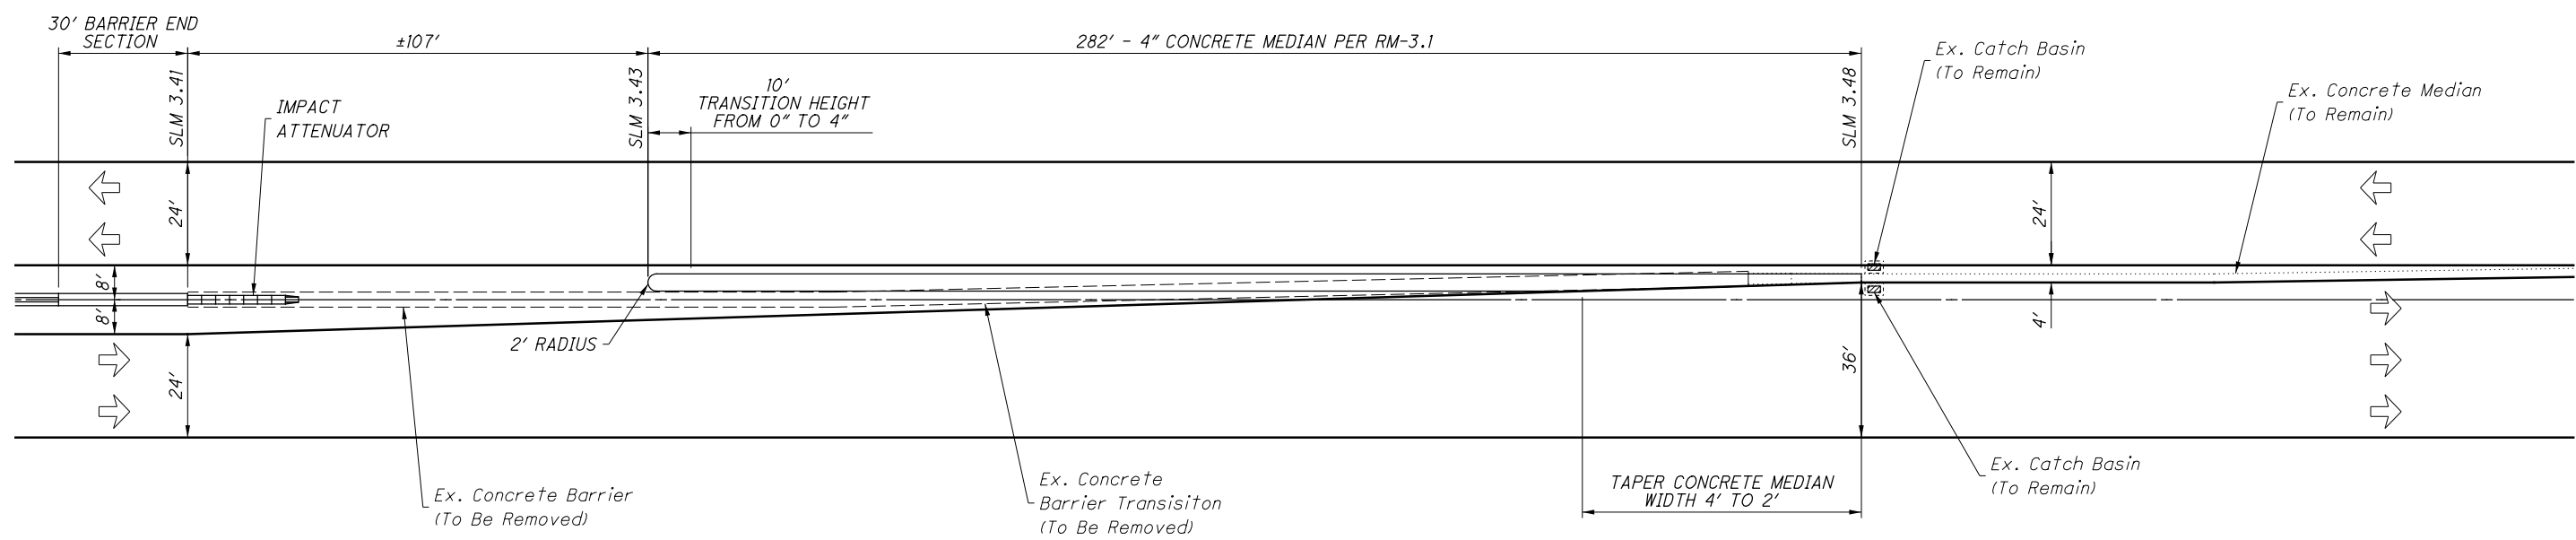

EXISTING ASPHALT CONCRETE MEDIAN BUILD-UP

9" CONCRETE BASE, QC 1P

6" AGGREGATE BASE

1-1/2" PAVEMENT PLANING, ASPHALT

1-1/2" ASPHALT CONCRETE SURFACE COURSE

ESTIMATED QUANTITIES

ITEM 252	FULL DEPTH PAVEMENT SAWING	778 FT
ITEM 304	6" AGGREGATE BASE	28 CU YD
ITEM 305	9" CONCRETE BASE, QC 1P	173 SQ YD
ITEM 606	IMPACT ATTENUATOR, BIDIRECTIONAL	1 EACH
ITEM 609	4" CONCRETE MEDIAN	125 SQ YD

TOTALS CARRIED TO SHEET 26

I:\ProjectData\81722\Design\Roadway\Sheets\81722_GM007.dgn Sheet 2/6/2020 4:52:40 PM shorr\isb