


H:\2018\180743\ODOT\ProjectData\08665\_LAK\_20\_WEST\Design\M01\Sheets\08665\_MY003.dgn M0T-01ALT I 7/13/2023 11:51:04 AM somogyi

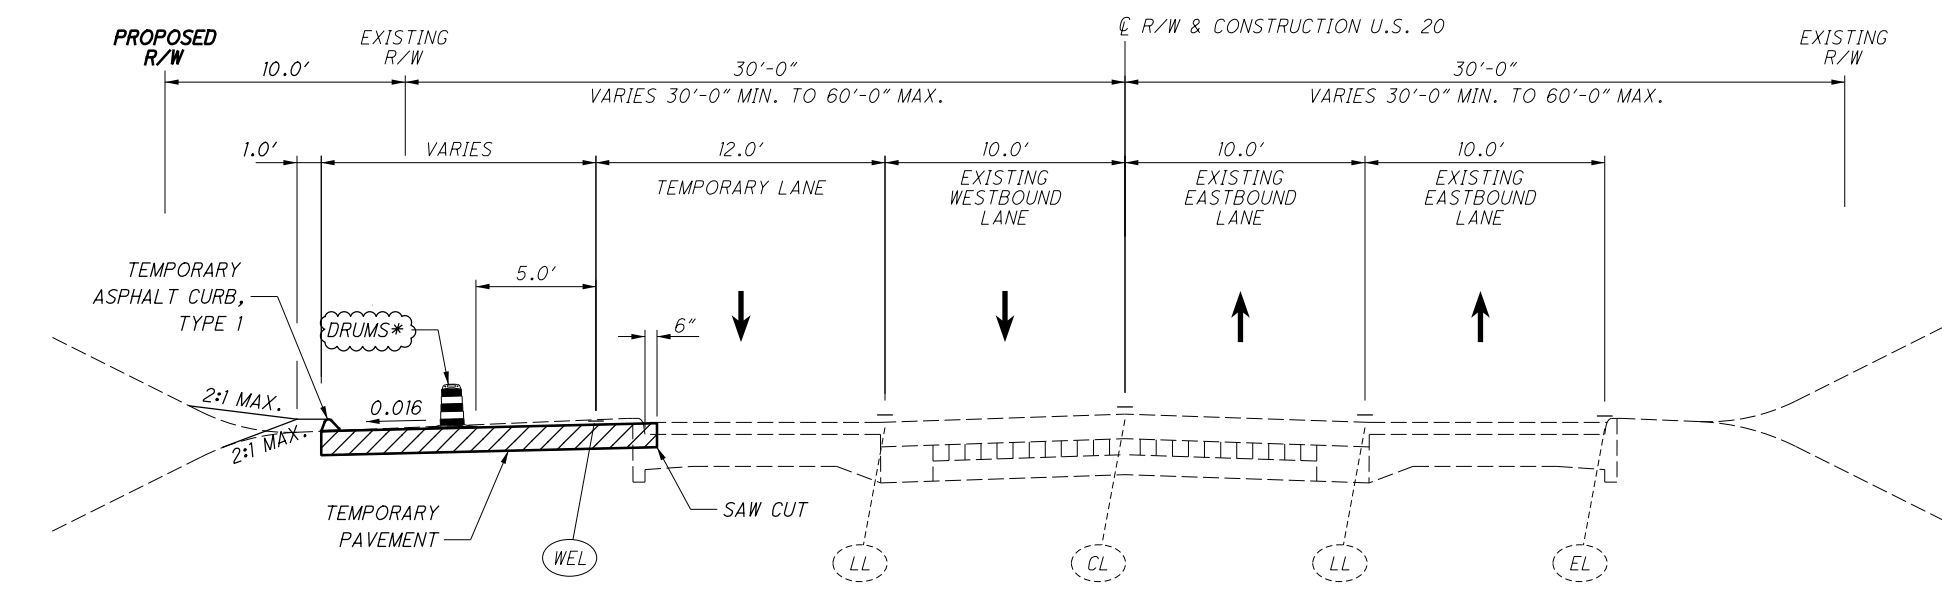

\* - 80' SPACING PER ODOT TRAFFIC STANDARD  
CONSTRUCTION DRAWING MT-95.31

**WINTER PHASE**

**PRE-PHASE 1C**  
STA. 283+46.3 TO STA. 402+72.3


**PRE-PHASE 3**  
STA. 179+42.6 TO STA. 275+22.6

**PRE-PHASE 5**  
STA. 114+45.6 TO STA. 170+88.8

**LEGEND**

- (CL) EXISTING CENTER LINE
- (EL) EXISTING EDGE LINE
- (LL) EXISTING CHANNELIZING LINE
- (WEL) WORKZONE EDGE LINE, CLASS 1
- [Hatched Box] PROPOSED TEMPORARY PAVEMENT  
CONSTRUCTED THIS PHASE
- ← TRAFFIC FLOW

H:\2018\180743\ODOT\ProjectData\09270\_LAK\_20\_EAST\Design\M0T\Sheets\09270\_My003.dgn M0T-01ALT 1/7/13/2023 11:56:46 AM somogyi

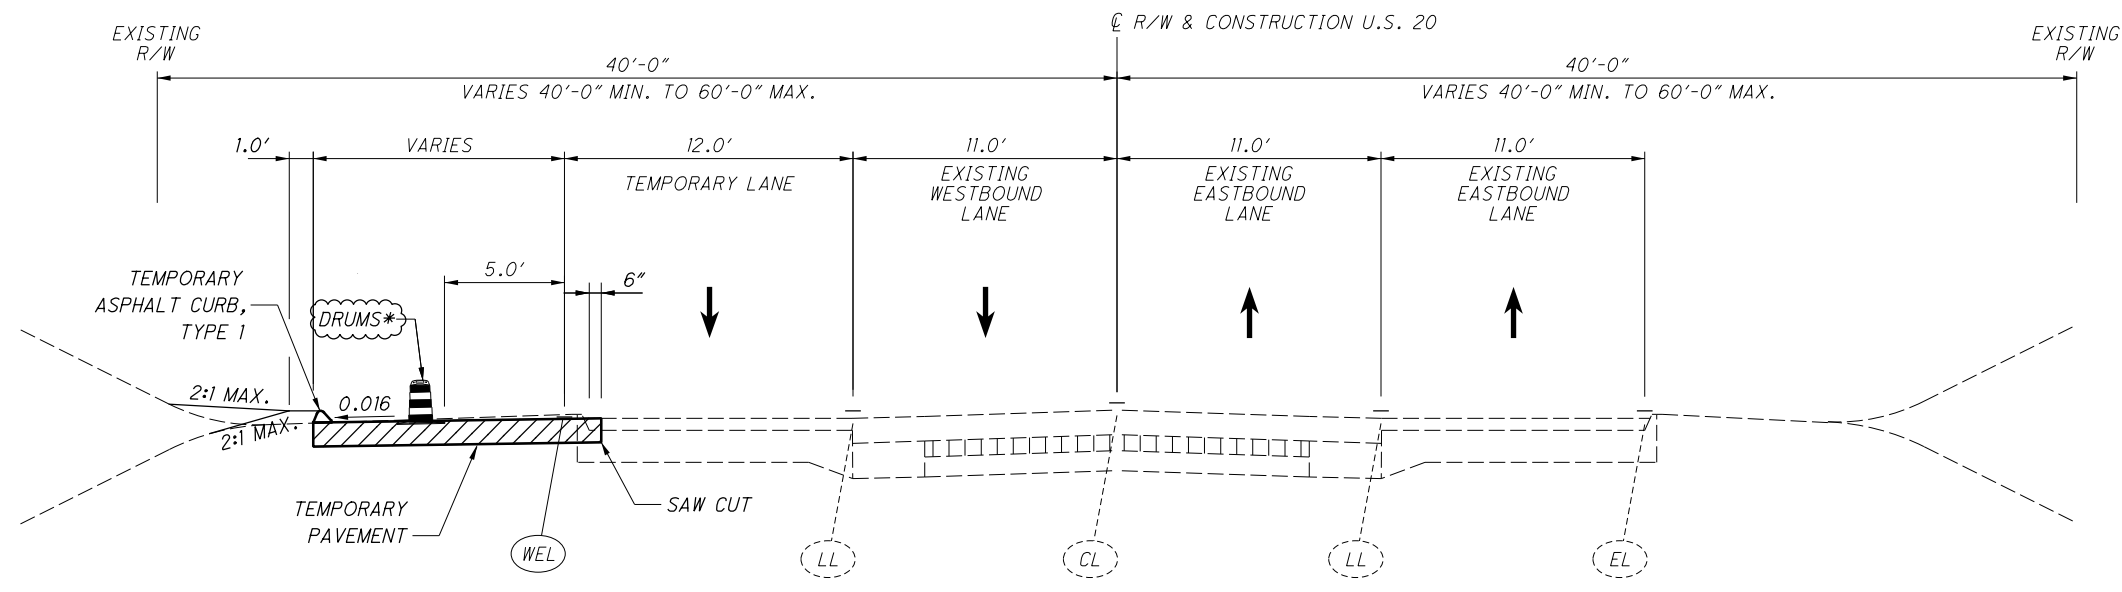

\* - 80' SPACING PER ODOT TRAFFIC STANDARD  
CONSTRUCTION DRAWING MT-95.31

**WINTER PHASE**

**PRE-PHASE 1**

STA. 499+78.0 TO STA. 512+00

**PRE-PHASE 3**

STA. 409+04.9 TO STA. 430+24.8  
STA. 436+55 TO STA. 488+88.6

**LEGEND**

- (CL) EXISTING CENTER LINE
- (EL) EXISTING EDGE LINE
- (LL) EXISTING CHANNELIZING LINE
- (WEL) WORKZONE EDGE LINE, CLASS 1
- [Hatched Box] PROPOSED TEMPORARY PAVEMENT CONSTRUCTED THIS PHASE
- ← TRAFFIC FLOW