

UTILITY NOTE

LAW-243-11.28

PID: 123191

Date: 07/13/2026

- Bidders are advised that the following utility facilities may not be cleared from the construction area at the time of award of the contract. Relocations are based on current information within anticipated construction limits of the project as set out below. All station locations listed below are approximate unless otherwise stated. Relocations are based on latest Right of Way and Construction Centerline.
- If there are any discrepancies between field markings and what the highway plan indicates, please contact ODOT's Utility Coordinator prior to any subsurface work being initiated. If requested, test hole data sheets will be provided to ODOT's Project Engineer and the State's Highway Contractor at the Pre-Construction Meeting.
- All changes to relocation work as described in the Utility Note must be approved by the ODOT Project Engineer and (District Utilities Coordinator or Design Consultant).
- ODOT shall not be held responsible for delay claims resulting from agreements made between the utility companies and the State's Highway Contractor without ODOT's prior consent to the agreement.
- The State's Highway Contractor shall notify ODOT's Project Engineer, in writing, within 24 hours of any project related contact with a utility company.
- Company work time frames DO NOT include Ohio Revised Code 4939 Ohio 811 Registered Utility Protection Service.
- Utility relocation work is based on the sequence of construction in the highway plan. Any changes made to the order of construction may impact the utility relocation work as described in this Utility Note.
- It should not be assumed a Company's work, in all locations, can be performed concurrently, unless otherwise noted. The number of working days in a Company's time frame may be determined by relocation work not being consecutive.
- Non-compliance to meeting established target dates could cause ODOT to incur project delays and/or additional costs. In this regard, 5512.02 ORC gives the Department the authority to ensure project clearance and recover costs.
- For further responsibilities of the State's Highway Contractor and Utility Companies, see the Department of Transportation Construction and Material Specifications, sections 105.07 & 107.16.
- The Companies shall comply with the following requirements, regarding restoration of areas within the project limits, where their facilities have been relocated due to proposed project work:
 - All excavations shall be backfilled with suitable material and compacted to ODOT specifications.
 - Mounding of dirt over trenches will not be permitted. Preliminary cleanup will be required while working and unsuitable material hauled away.
 - Trenches are not to remain open overnight, other than what is needed to start the next day's work. Those trenches shall be covered with a steel plate and designated with safety cones or barrels.
 - All disturbed right of way shall be restored to its original condition or better, and seeded and mulched as per Item 659, ODOT Specifications. Excavations must be restored within 7 days of original date of disturbance.
 - All trenched driveway approaches shall be backfilled with granular material and compacted to ODOT specifications. Driveway surfaces shall be replaced in kind. Consult with (District Utilities Coordinator or Design Consultant) on how to handle disturbed sidewalks.

AEP Ohio (*Ohio Power; Columbus Southern Power*)**Utility Type:** Power**Contact Information:** Clarke Saunders, 740-985-3054, cmsaunders@aep.com**Conflict Identified:** Yes**Conflict Resolution Type:** Relocate Prior to Construction**Conflict Resolution Target Date:** 11/01/2026**Conflict Resolved:** No**Location Details:**

Utility Location Identifier	Station Begin	Station End	Offset (ft.)	Side of Road	Depth (ft.)	Comments / Notes
Remove	595+03		31	Right (RT)		AEP to remove pole and facilities
Install	596+21		35	Left (LT)		AEP to install pole and facilities
Remove	598+43		22	Right (RT)		AEP to remove pole and facilities
Install	598+44		29	Left (LT)		AEP to install pole and facilities

Utility Note Comments:

AEP will relocate its aerial facilities to the north side of SR 243 to avoid conflicts with the ODOT project.

Frontier (*GTE; Verizon North*)**Utility Type:** Communication**Contact Information:** David Longworth, 937-283-5735, david.m.longworth@ftr.com**Conflict Identified:** Yes**Conflict Resolution Type:** Relocate Prior to Construction**Conflict Resolution Target Date:** 02/01/2027**Conflict Resolved:** No**Location Details:**

Utility Location Identifier	Station Begin	Station End	Offset (ft.)	Side of Road	Depth (ft.)	Comments / Notes
Remove	595+03		31	Right (RT)		Frontier to remove facilities from AEP pole.
Attach	596+21		35	Left (LT)		Frontier to attach to new AEP pole.
Remove	598+43		22	Right (RT)		Frontier to remove facilities from AEP pole.
Attach	598+44		29	Left (LT)		Frontier to attach to new AEP pole.

Utility Note Comments:

Frontier will follow AEP's relocation plan and move its facilities to the north side of SR 243 to avoid conflicts with the ODOT project.

Hecla Water Association *(HWA)***Utility Type:** Water**Contact Information:** Joe Unger, 740-533-0526, joe@heclawater.com**Conflict Identified:** No**Conflict Resolution Type:** Protect in Place**Location Details:****Utility Note Comments:**

The Company does not anticipate any conflicts with the proposed work. If a conflict does arise, the State's Highway Contractor will immediately contact the Company and ODOT Project Engineer, so the proper actions can be taken to prevent delay of construction.

Spectrum *(Charter Communications; Time Warner)***Utility Type:** Communication**Contact Information:** Jeffery Adams, 606-207-8203, jeffrey.ladams@charter.com**Conflict Identified:** Yes**Conflict Resolution Type:** Relocate Prior to Construction**Conflict Resolution Target Date:** 01/01/2027**Conflict Resolved:** No**Location Details:**

Utility Location Identifier	Station Begin	Station End	Offset (ft.)	Side of Road	Depth (ft.)	Comments / Notes
Remove	595+03		31	Right (RT)		Charter to remove facilities form AEP pole
Attach	596+21		35	Left (LT)		Charter to attach to new AEP pole
Remove	598+43		22	Right (RT)		Charter to remove facilities form AEP pole
Attach	598+44		29	Left (LT)		Charter to attach to new AEP pole

Utility Note Comments:

Charter will follow AEP's relocation plan and move its facilities to the north side of SR 243 to avoid conflicts with the ODOT project.

AEP Exhibit

CURVE DATA

69.70
RT

CURVE DATA

P.I. = STA. 597+03.59
Δ = 18°20'00" RT
Dc = 15°00'00"
R = 381.97'
T = 61.64'
L = 122.22'
E = 4.94'

CURVE DATA

P.I. = STA. 599+95.94
Δ = 18°00'00" LT
Dc = 08°30'00"
R = 674.07'
T = 106.76'
L = 211.76'
E = 8.40'

LEGEND

(DND) - DO NOT DISTURB

(R) - REMOVE

(TBRR) - TO BE REMOVED
AND REERECTED

- FULL DEPTH
PAVEMENT REPLACEMENT

EL-# - PROP. EDGE LINE, 6", TYPE 1

CL-# - PROP. CENTER LINE, TYPE 1


D-# - PROP. CULVERT

P-# - PROP. PAVEMENT

PRIMARY PROJECT CONTROL INFORMATION

POINT ID	STATION	OFFSET	COORD. IN US SURVEY FT		ELEV.	DESC.
			NORTHING	EASTING		
CP1	593+83.31	21.77' LT.	380791.673	182899.866	676.27	IPINS
CP2	595+73.62	23.76' LT.	380892.382	183065.190	660.77	IPINS
CP3	598+52.75	17.86' RT.	380889.277	183347.580	624.60	IPINS
TBM1	593+25.11	29.95' LT.	380763.132	182845.133	683.17	BM

HORIZONTAL
SCALE IN FEET

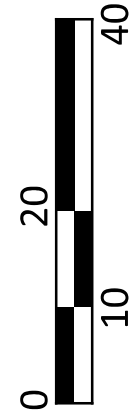

PLAN AND PROFILE - SR 243
STA. 595+00.00 TO STA. 599+50.00

DESIGN AGENCY



DESIGNER

MJB

REVIEWER

KDK 3/5/26

PROJECT ID


123191

SHEET

P.10

TOTAL

P.37

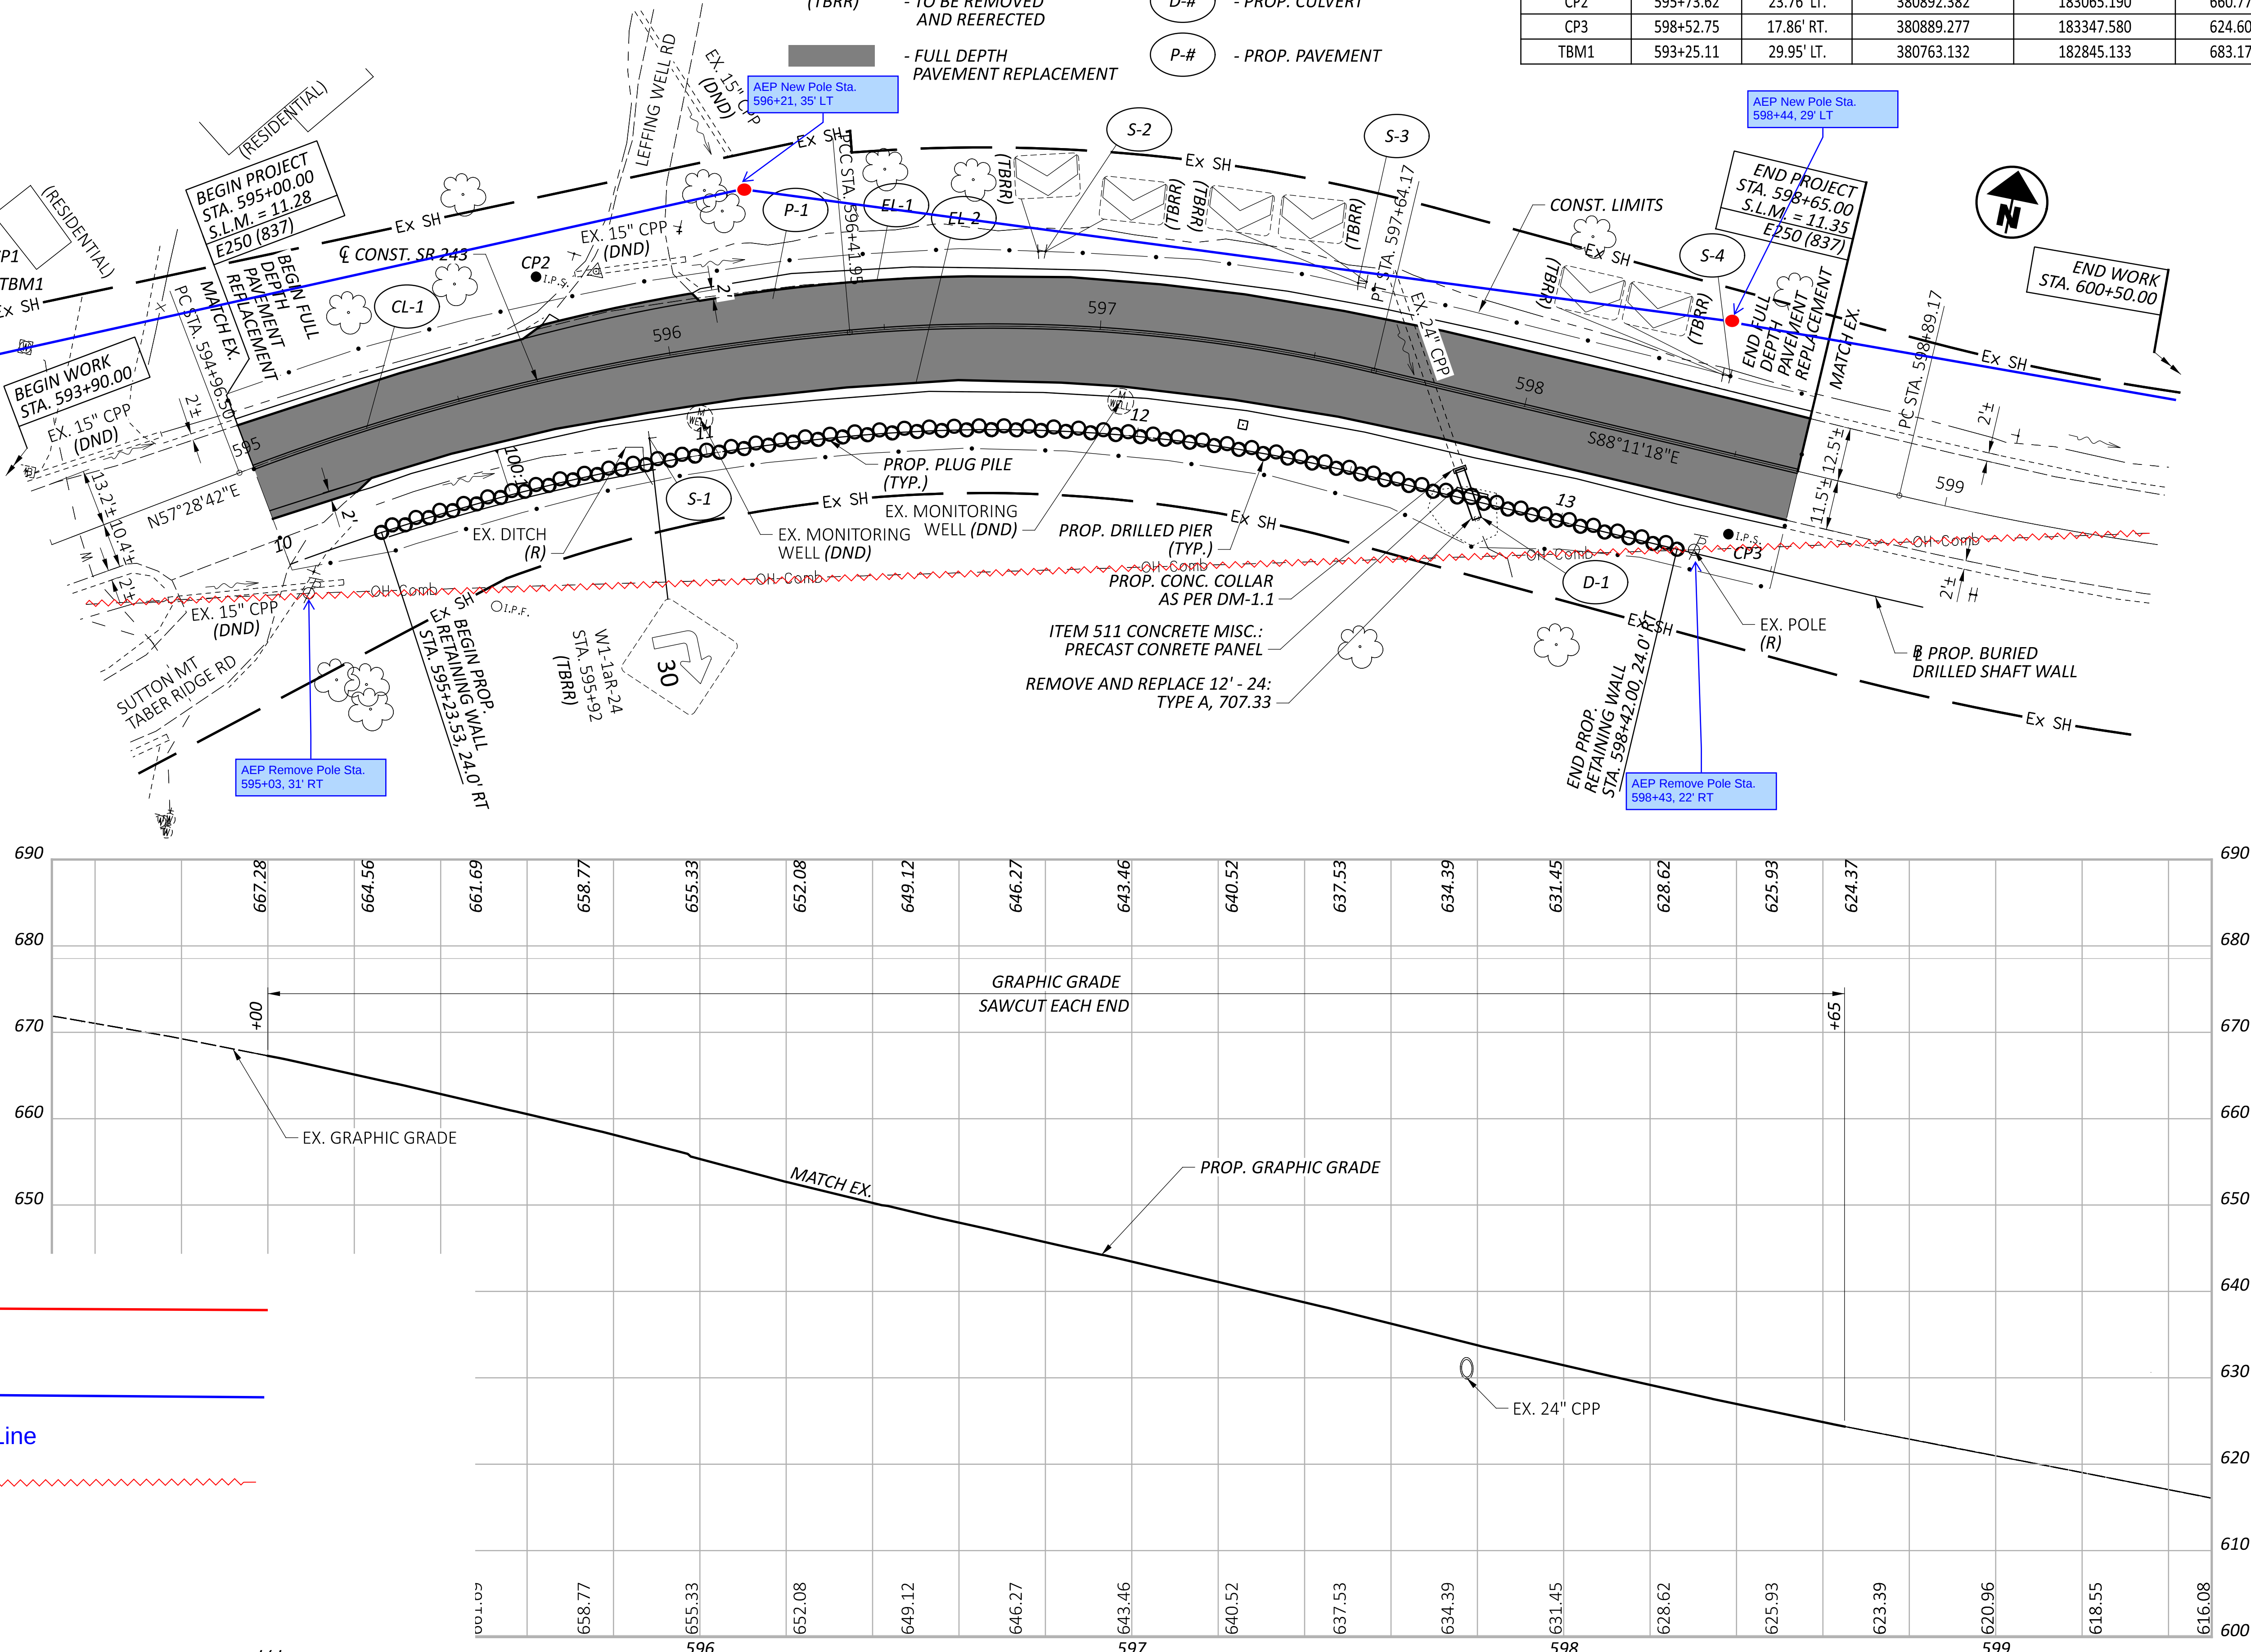

AEP Aerial Line

AEP New Aerial Line

Remove

CURVE DATA
= STA. 595+69.70
= 16°00'00" RT
= 11°00'00"
520.87'
73.2'
145.45'
5.12'

CURVE DATA
P.I. = STA. 597+03.59
Δ = 18°20'00" RT
Dc = 15°00'00"
R = 381.97'
T = 61.64'
L = 122.22'
E = 4.94'

CURVE DATA
P.I. = STA. 599+95.94
Δ = 18°00'00" LT
Dc = 08°30'00"
R = 674.07'
T = 106.76'
L = 211.76'
E = 8.40'

LEGEND

(DND) - DO NOT DISTURB

(R) - REMOVE

(TBRR) - TO BE REMOVED
AND REERECTED

- FULL DEPTH
PAVEMENT REPLACEMENT

EL-# - PROP. EDGE LINE, 6", TYPE 1

CL-# - PROP. CENTER LINE, TYPE 1


D-# - PROP. CULVERT

P-# - PROP. PAVEMENT

POINT ID	STATION	OFFSET	COORD. IN US SURVEY FT		ELEV.	DESC.
			NORTHING	EASTING		
CP1	593+83.31	21.77' LT.	380791.673	182899.866	676.27	IPINS
CP2	595+73.62	23.76' LT.	380892.382	183065.190	660.77	IPINS
CP3	598+52.75	17.86' RT.	380889.277	183347.580	624.60	IPINS
TBM1	593+25.11	29.95' LT.	380763.132	182845.133	683.17	BM



PLAN AND PROFILE - SR 243
STA. 595+00.00 TO STA. 599+50.00

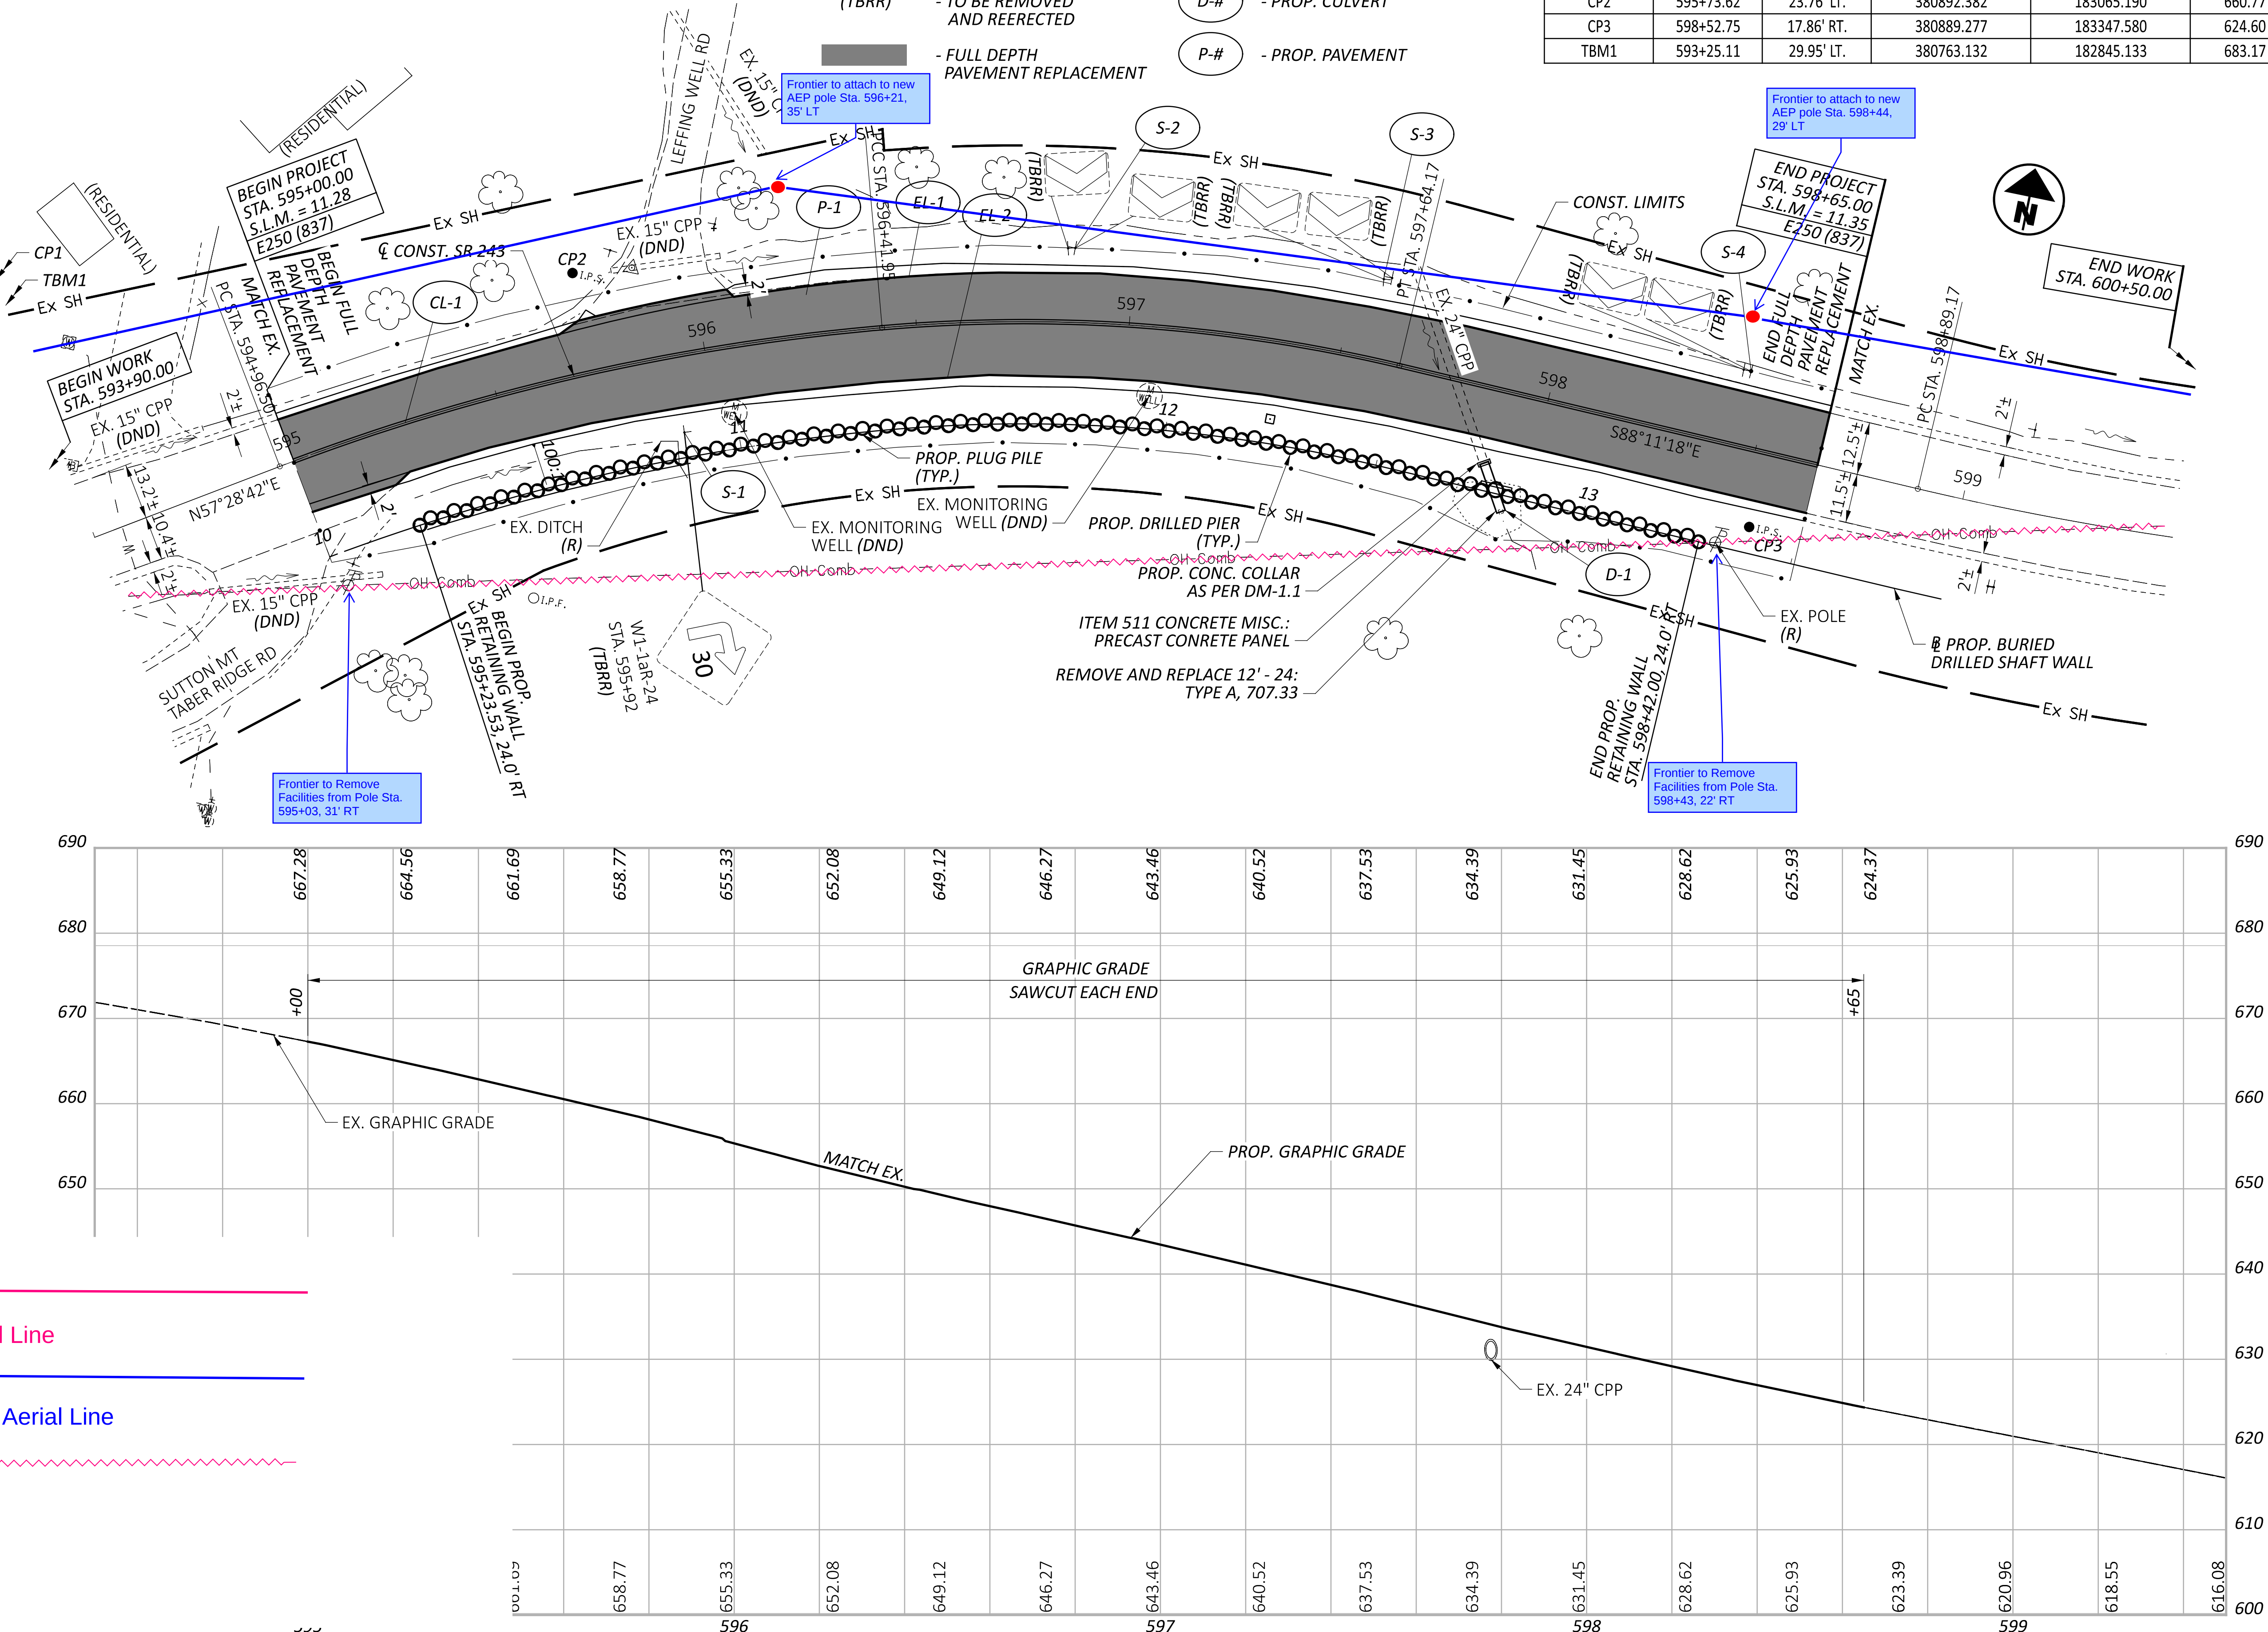

CURVE DATA P.I. = STA. 595+69.70 Δ = 18°00'00" RT Dc = 15°00'00" R = 381.97' T = 61.64' L = 122.22' E = 4.94'	CURVE DATA P.I. = STA. 597+03.59 Δ = 18°20'00" RT Dc = 15°00'00" R = 381.97' T = 61.64' L = 122.22' E = 4.94'	CURVE DATA P.I. = STA. 599+95.94 Δ = 18°00'00" LT Dc = 08°30'00" R = 674.07' T = 106.76' L = 211.76' E = 8.40'
--	--	---

- LEGEND**

(DND) - DO NOT DISTURB

(R) - REMOVE

(TBRR) - TO BE REMOVED AND REERECTED

- FULL DEPTH PAVEMENT REPLACEMENT
- EL-# - PROP. EDGE LINE, 6", TYPE 1

CL-# - PROP. CENTER LINE, TYPE 1

D-# - PROP. CULVERT


P-# - PROP. PAVEMENT

PRIMARY PROJECT CONTROL INFORMATION						
POINT ID	STATION	OFFSET	COORD. IN US SURVEY FT		ELEV.	DESC.
			NORTHING	EASTING		
CP1	593+83.31	21.77' LT.	380791.673	182899.866	676.27	IPINS
CP2	595+73.62	23.76' LT.	380892.382	183065.190	660.77	IPINS
CP3	598+52.75	17.86' RT.	380889.277	183347.580	624.60	IPINS
TBM1	593+25.11	29.95' LT.	380763.132	182845.133	683.17	BM



PLAN AND PROFILE - SR 243
STA. 595+00.00 TO STA. 599+50.00

DESIGN AGENCY	
ARCADIS	
222 SOUTH MAIN STREET SUITE 200 ARCADIS PARK PO BOX 434 ARCADIS, PA 16013 www.arcadis.com	
DESIGNER	MJB
REVIEWER	KDK
PROJECT ID	123191
SHEET	P.10
TOTAL	P.37

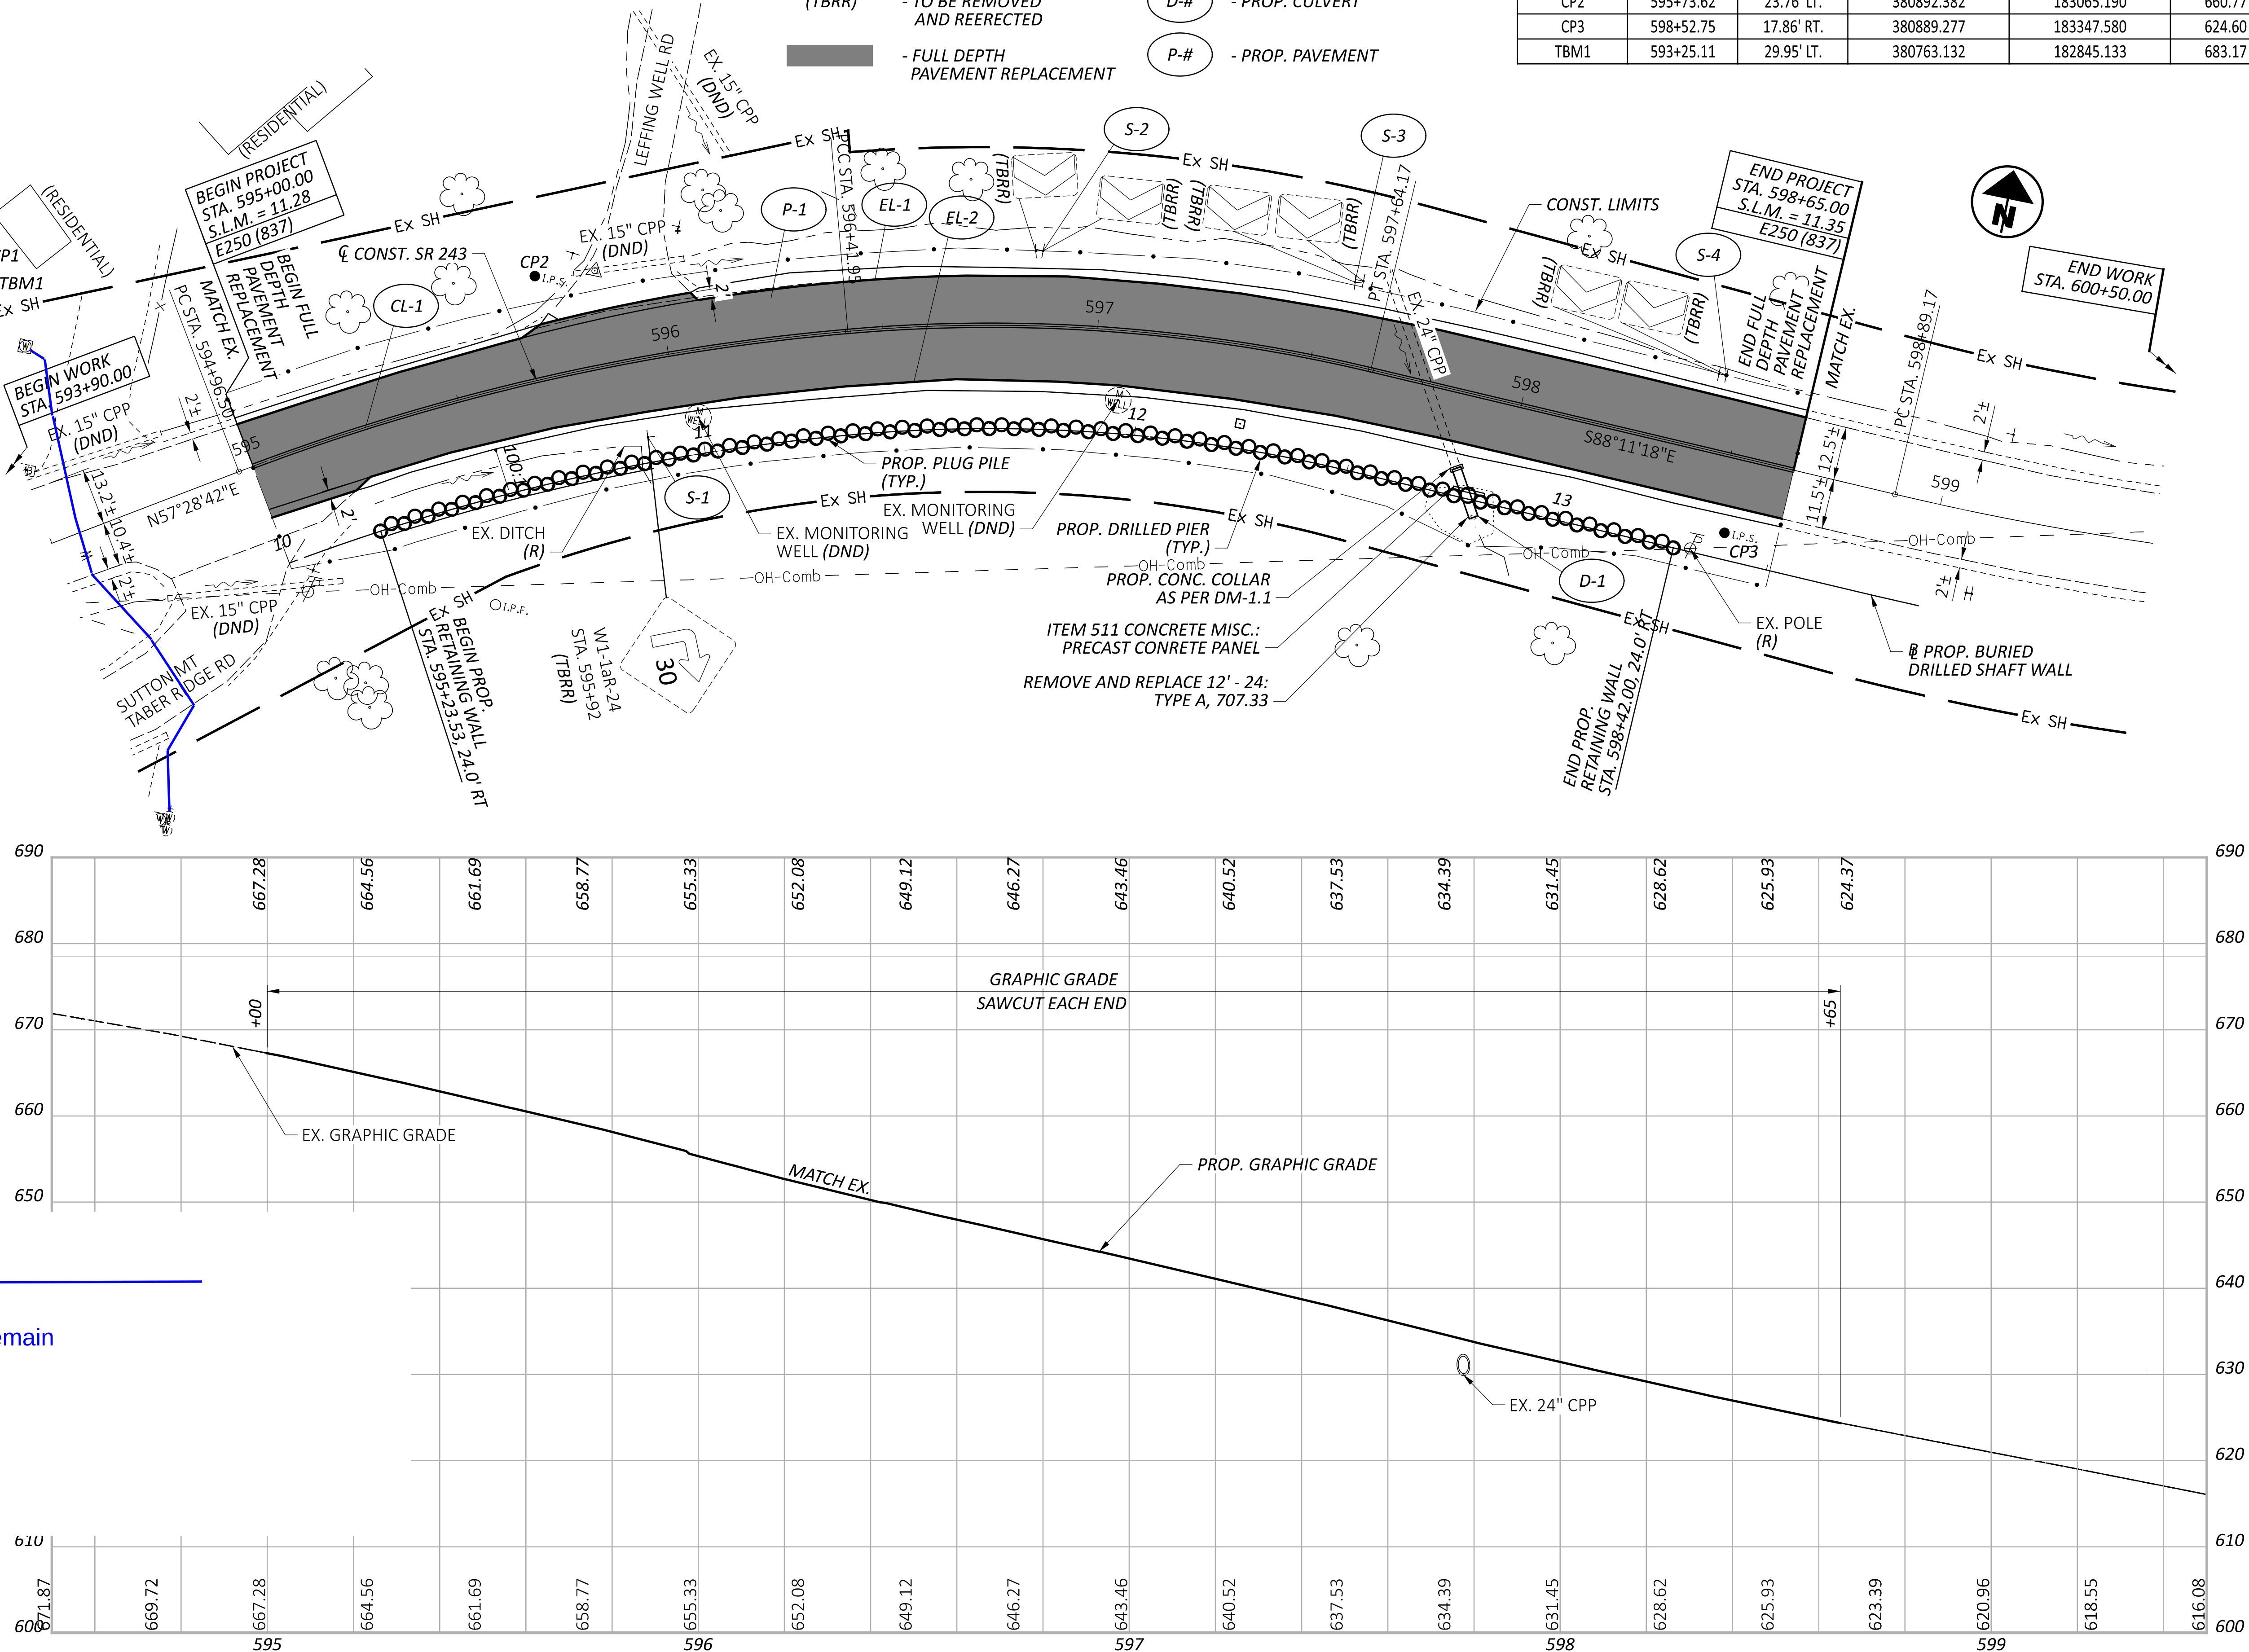

Water Line To Remain

VE DATA
= STA. 595+69.70
16°00'00" RT
= 11°00'00"
520.87'
73.2'
145.45'
5.12'

CURVE DATA
P.I. = STA. 597+03.59
Δ = 18°20'00" RT
Dc = 15°00'00"
R = 381.97'
T = 61.64'
L = 122.22'
E = 4.94'

CURVE DATA
P.I. = STA. 599+95.94
Δ = 18°00'00" LT
Dc = 08°30'00"
R = 674.07'
T = 106.76'
L = 211.76'
E = 8.40'

LEGEND
(DND) - DO NOT DISTURB
(R) - REMOVE
(TBRR) - TO BE REMOVED AND REERECTED
- FULL DEPTH PAVEMENT REPLACEMENT

EL-# - PROP. EDGE LINE, 6", TYPE 1
CL-# - PROP. CENTER LINE, TYPE 1
D-# - PROP. CULVERT
P-# - PROP. PAVEMENT

POINT ID	STATION	OFFSET	COORD. IN US SURVEY FT		ELEV.	DESC.
			NORTHING	EASTING		
CP1	593+83.31	21.77' LT.	380791.673	182899.866	676.27	IPINS
CP2	595+73.62	23.76' LT.	380892.382	183065.190	660.77	IPINS
CP3	598+52.75	17.86' RT.	380889.277	183347.580	624.60	IPINS
TBM1	593+25.11	29.95' LT.	380763.132	182845.133	683.17	BM



PLAN AND PROFILE - SR 243
STA. 595+00.00 TO STA. 599+50.00


DESIGN AGENCY
ARCADIS
222 SOUTH MAIN STREET SUITE 200
ARCADIS, INDIANA 46106
(317) 434-1985
www.arcadis.com

DESIGNER
MJB

REVIEWER
KDK 3/5/26

PROJECT ID
123191

SHEET TOTAL
P.10 P.37

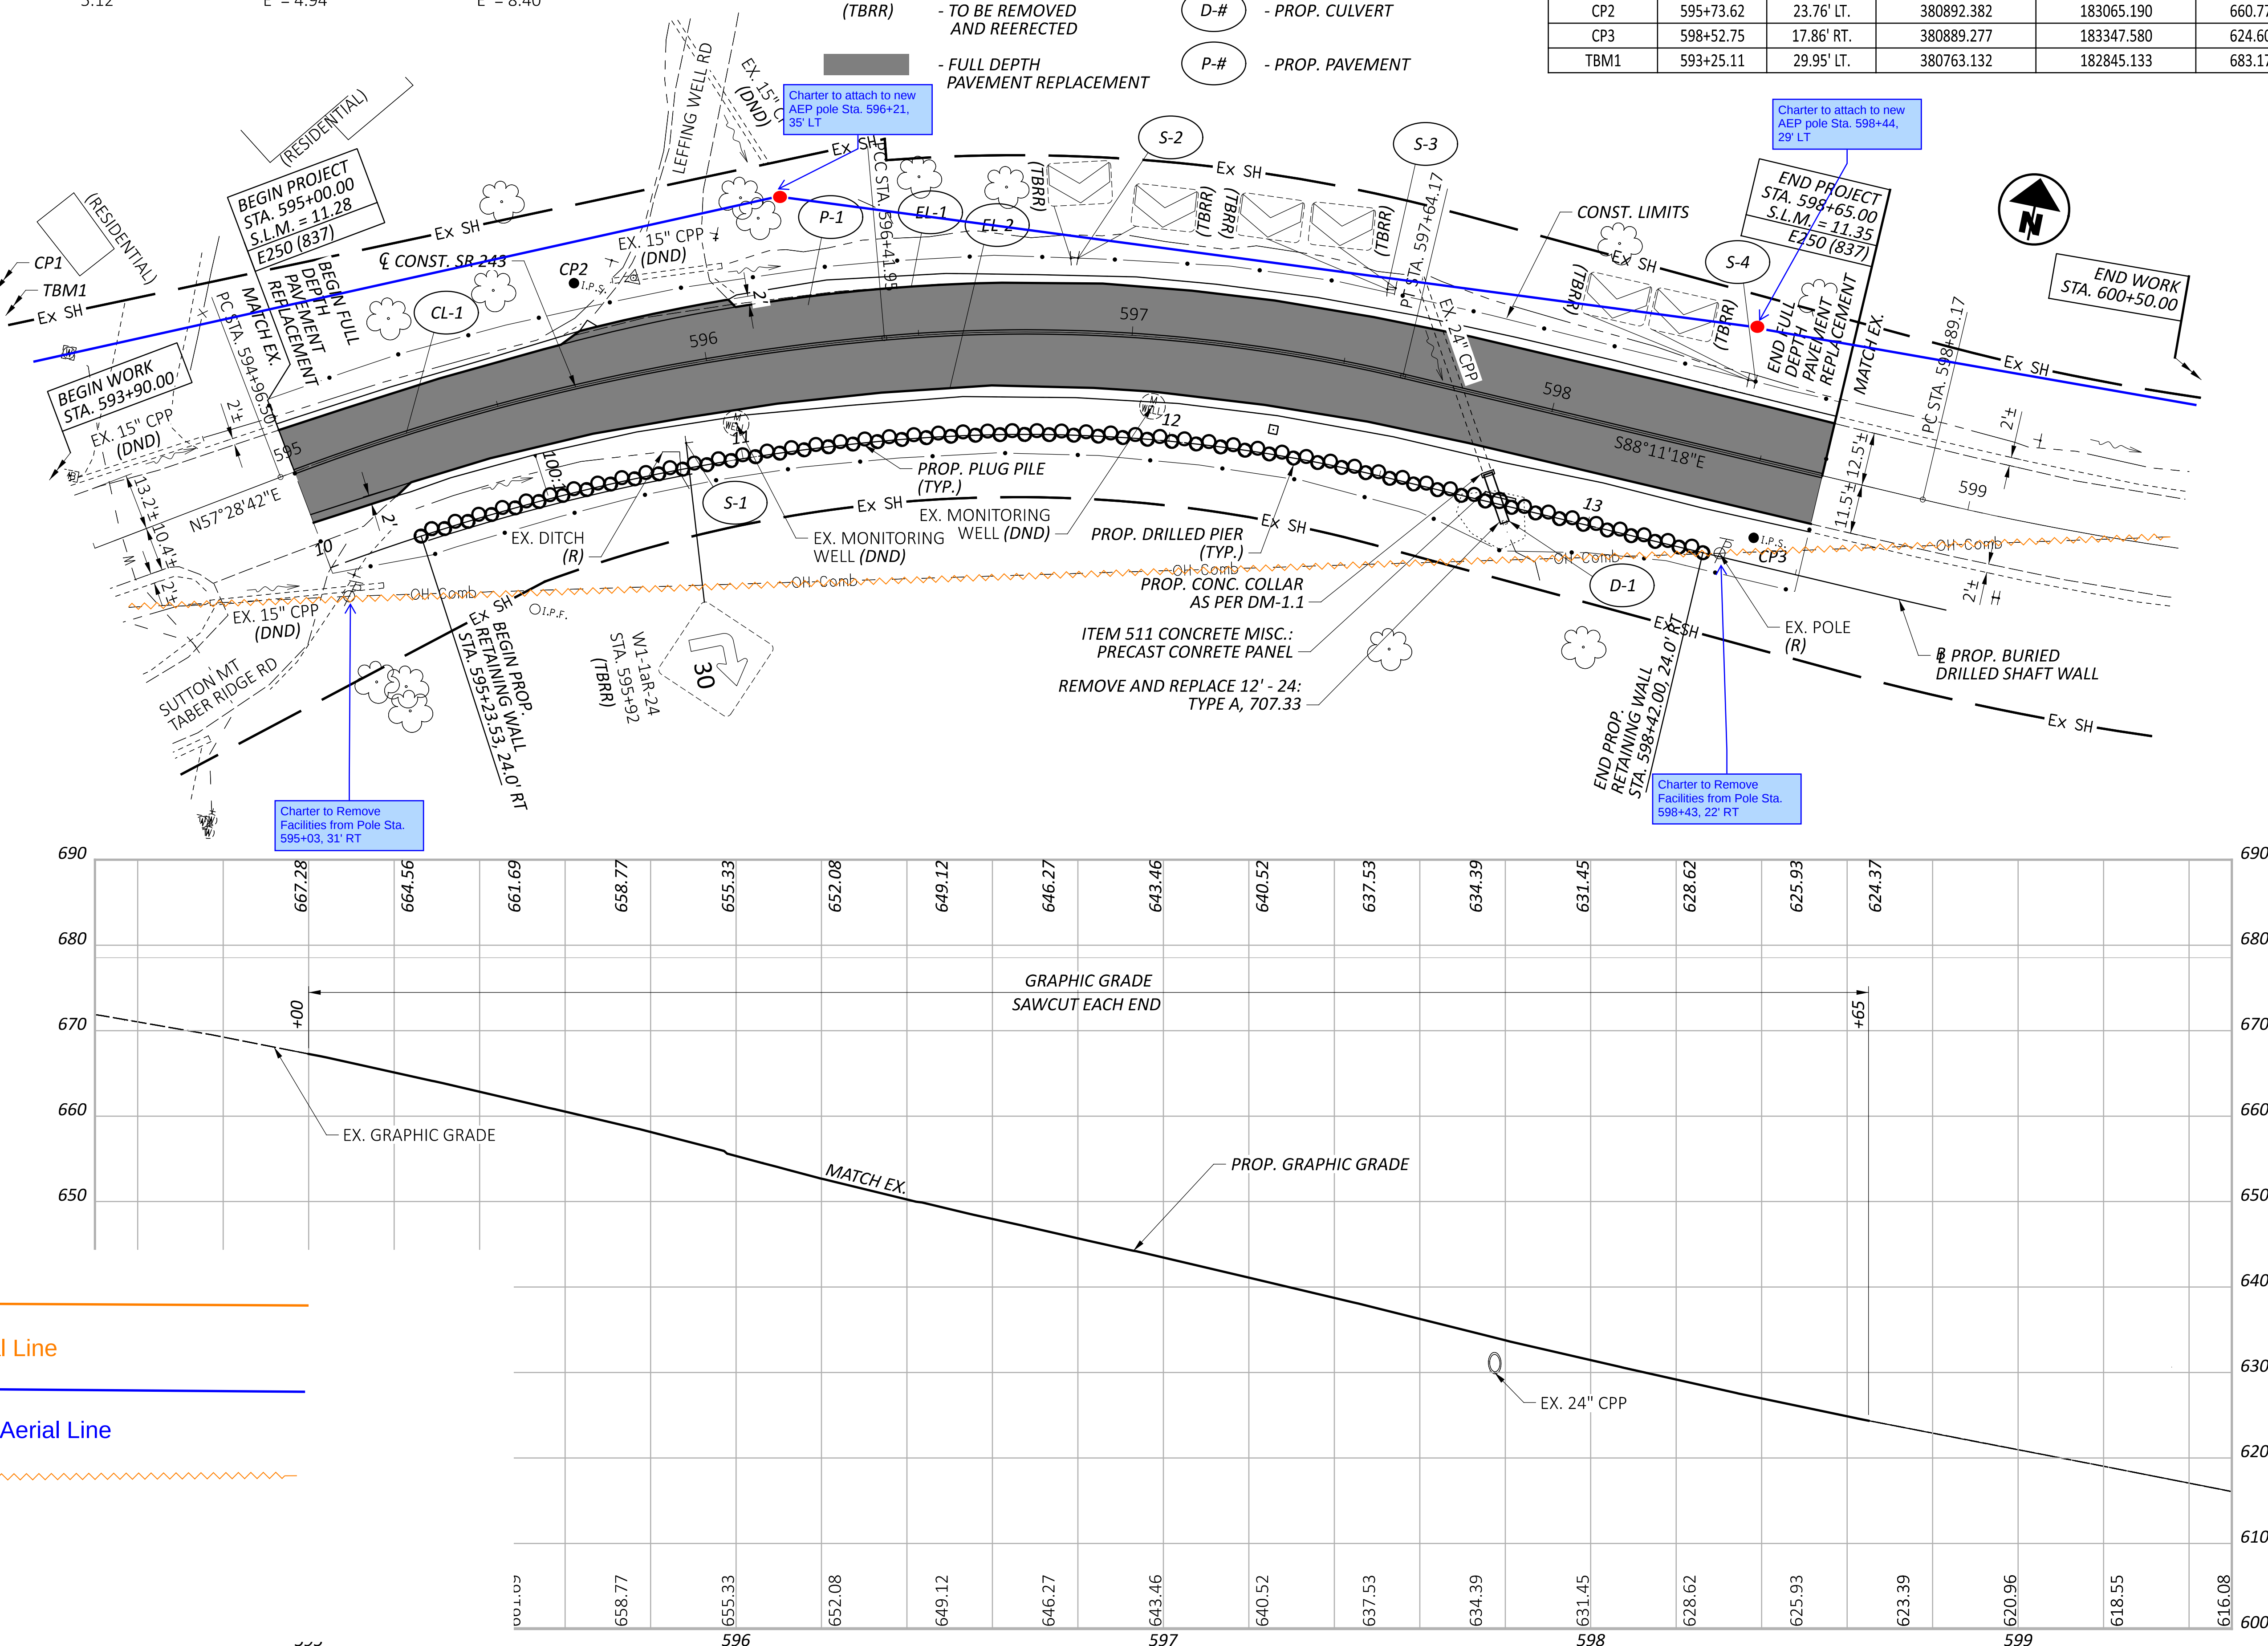

Charter Aerial Line

Charter New Aerial Line

Remove