




F:\Clients\Active\H\H034\109925\_HEATH\_PAVING\ProjAdmin\Addendum\109925\_GP002.dgn Sheet 8/24/2020 9:19:10 AM clarence

LOCATION	ROUTE	BEGIN LOG POINT SLM	END LOG POINT SLM	LENGTH		WIDTH (FT)		EXISTING PAVEMENT TYPE	PAVEMENT AREA	209		254		407		408		441		601		617	
				MILES	FT	BEGIN	END			SY	MILES	INCHES	SY	GAL	GAL	GAL	INCHES	CY	INCHES	CY	FT	CY	
2	COUNTY ROAD 301	0.49	1.53	1.04	5491.2	21.0	21.0	441	12813	1.04	3.00	12813	1089.1	704.7	488.1	1.25	444.9	1.75	622.8	800.0	270.9		
2	COUNTY ROAD 301	1.53	1.55	0.02	105.6	21.0	33.0	441	317	0.02	3.00	317	26.9	17.4	9.4	1.25	11.0	1.75	15.4		5.2		
2	COUNTY ROAD 301	1.55	1.59	0.04	211.2	33.0	33.0	441	774	0.04	3.00	774	65.8	42.6	18.8	1.25	26.9	1.75	37.6		10.4		
2	COUNTY ROAD 301	1.59	2.06	0.47	2481.6	21.0	21.0	441	5790	0.47	3.00	5790	492.2	318.5	220.6	1.25	201.1	1.75	281.5		122.4		
2	COUNTY ROAD 301	2.06	2.13	0.07	369.6	21.0	21.0	441	862	0.07	3.00	862	73.3	47.4	32.9	1.25	29.9	1.75	41.9		18.2		
<b>TOTALS CARRIED TO GENERAL SUMMARY</b>										1.64		20557	1747	1131	770		714		999	800	427		


CALCULATED  
CGL  
CHECKED  
SRH

**ASPHALT CONCRETE DATA - BLUE JAY ROAD**

LIC-CR343-0.00  
LIC-CR301-0.49

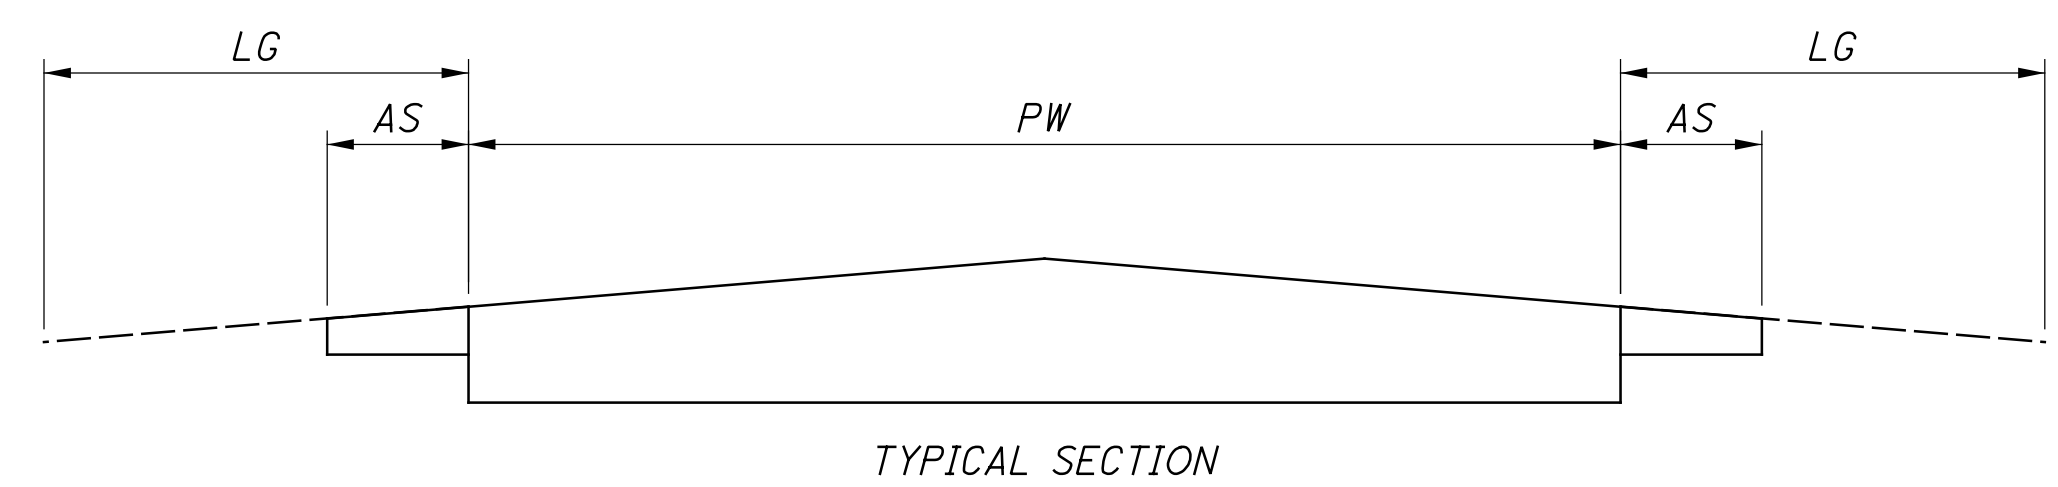

PW = PAVEMENT WIDTH  
AS = AGGREGATE SHOULDER  
LG = LINEAR GRADING

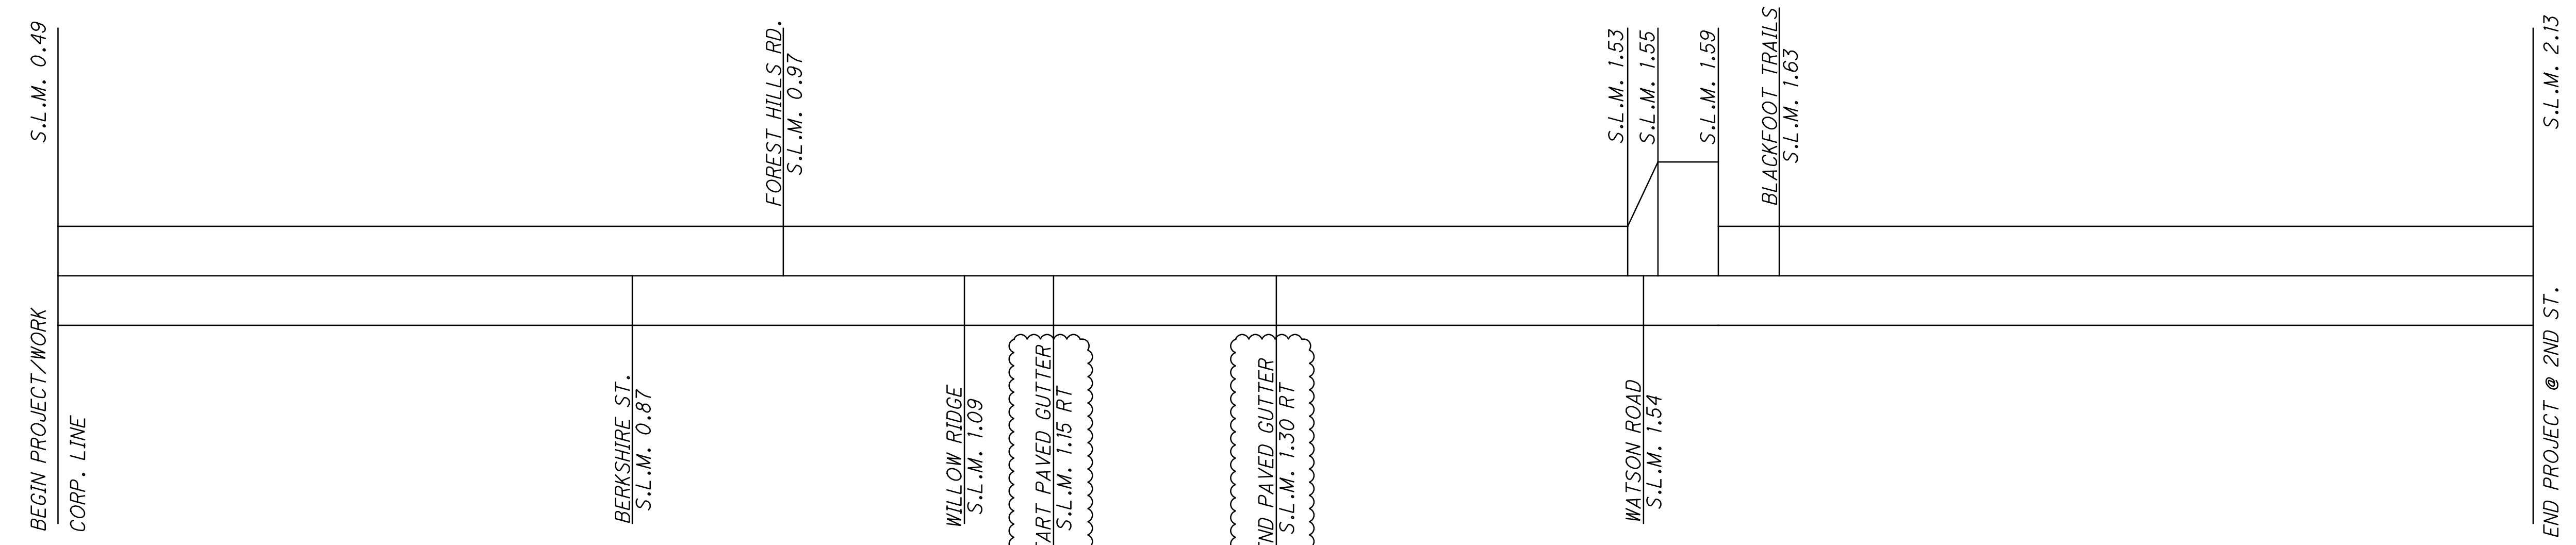


F:\Clients\Active\HTH\TH034\109925\_HEATH\_PAVING\ProjAdmin\Addendum\109925\_TS001.dgn Sheet 8/24/2020 9:19:11 AM clawrence

LOCATION	COUNTY	ROUTE	DESCRIPTION	SIDE	BEGIN LOG POINT SLM	END LOG POINT SLM	614		614	614	614	614	621		621	644	644	644	644	644	644	644	644	644	644
							WORK ZONE CENTERLINE, CLASS II	WORK ZONE CENTERLINE, CLASS III					WORK ZONE EDGE LINE, CLASS III, 4" 642 PAINT	WORK ZONE STOP LINE, CLASS III, 642 PAINT											
							MILE	MILE	MILE	FT	FT	Y/Y	W/R	EACH	MILE	MILE	FT	FT	FT	EACH	FT	EACH	MILE	MILE	
1	LIC	CR 343	PROJECT LENGTH	LT/RT	0.00	1.77	3.54	1.77	7.08	34	360				3.54	1.77	17	180	155	5	48	6			
1	LIC	CR 343	LIBERTY DRIVE	RT	0.06	0.07	0.02	0.01	0.04	32					0.02	0.01	16								
1	LIC	CR 343	BARB AVENUE	LT	0.10	0.11				24											90				
1	LIC	CR 343	SOUTH FORK ROAD	RT	0.66	0.67	0.02	0.01	0.04	30					0.02	0.01	15								
1	LIC	CR 343	RIVER OAKS DRIVE	LT	0.87	0.88				36					0.01		18								
1	LIC	CR 343	NADINE ROAD	LT	1.34	1.35				28							14								
1	LIC	CR 343	GREEN VALLEY DRIVE	LT	1.43	1.44				30							15								
1	LIC	CR 343	FRANKLIN AVENUE	LT	1.63	1.70	0.02	0.01	0.04	52	120	11	4	20	0.02	0.01	26	60		2					
TOTALS CARRIED TO GENERAL SUMMARY							7.0	3.5	14	424	480	11	4	20	7	3.5	212	240	155	7	138	6	0.04	0.02	

**PAVEMENT MARKING SUBSUMMARY**

**LIC-CR343-0.00  
LIC-CR301-0.49**

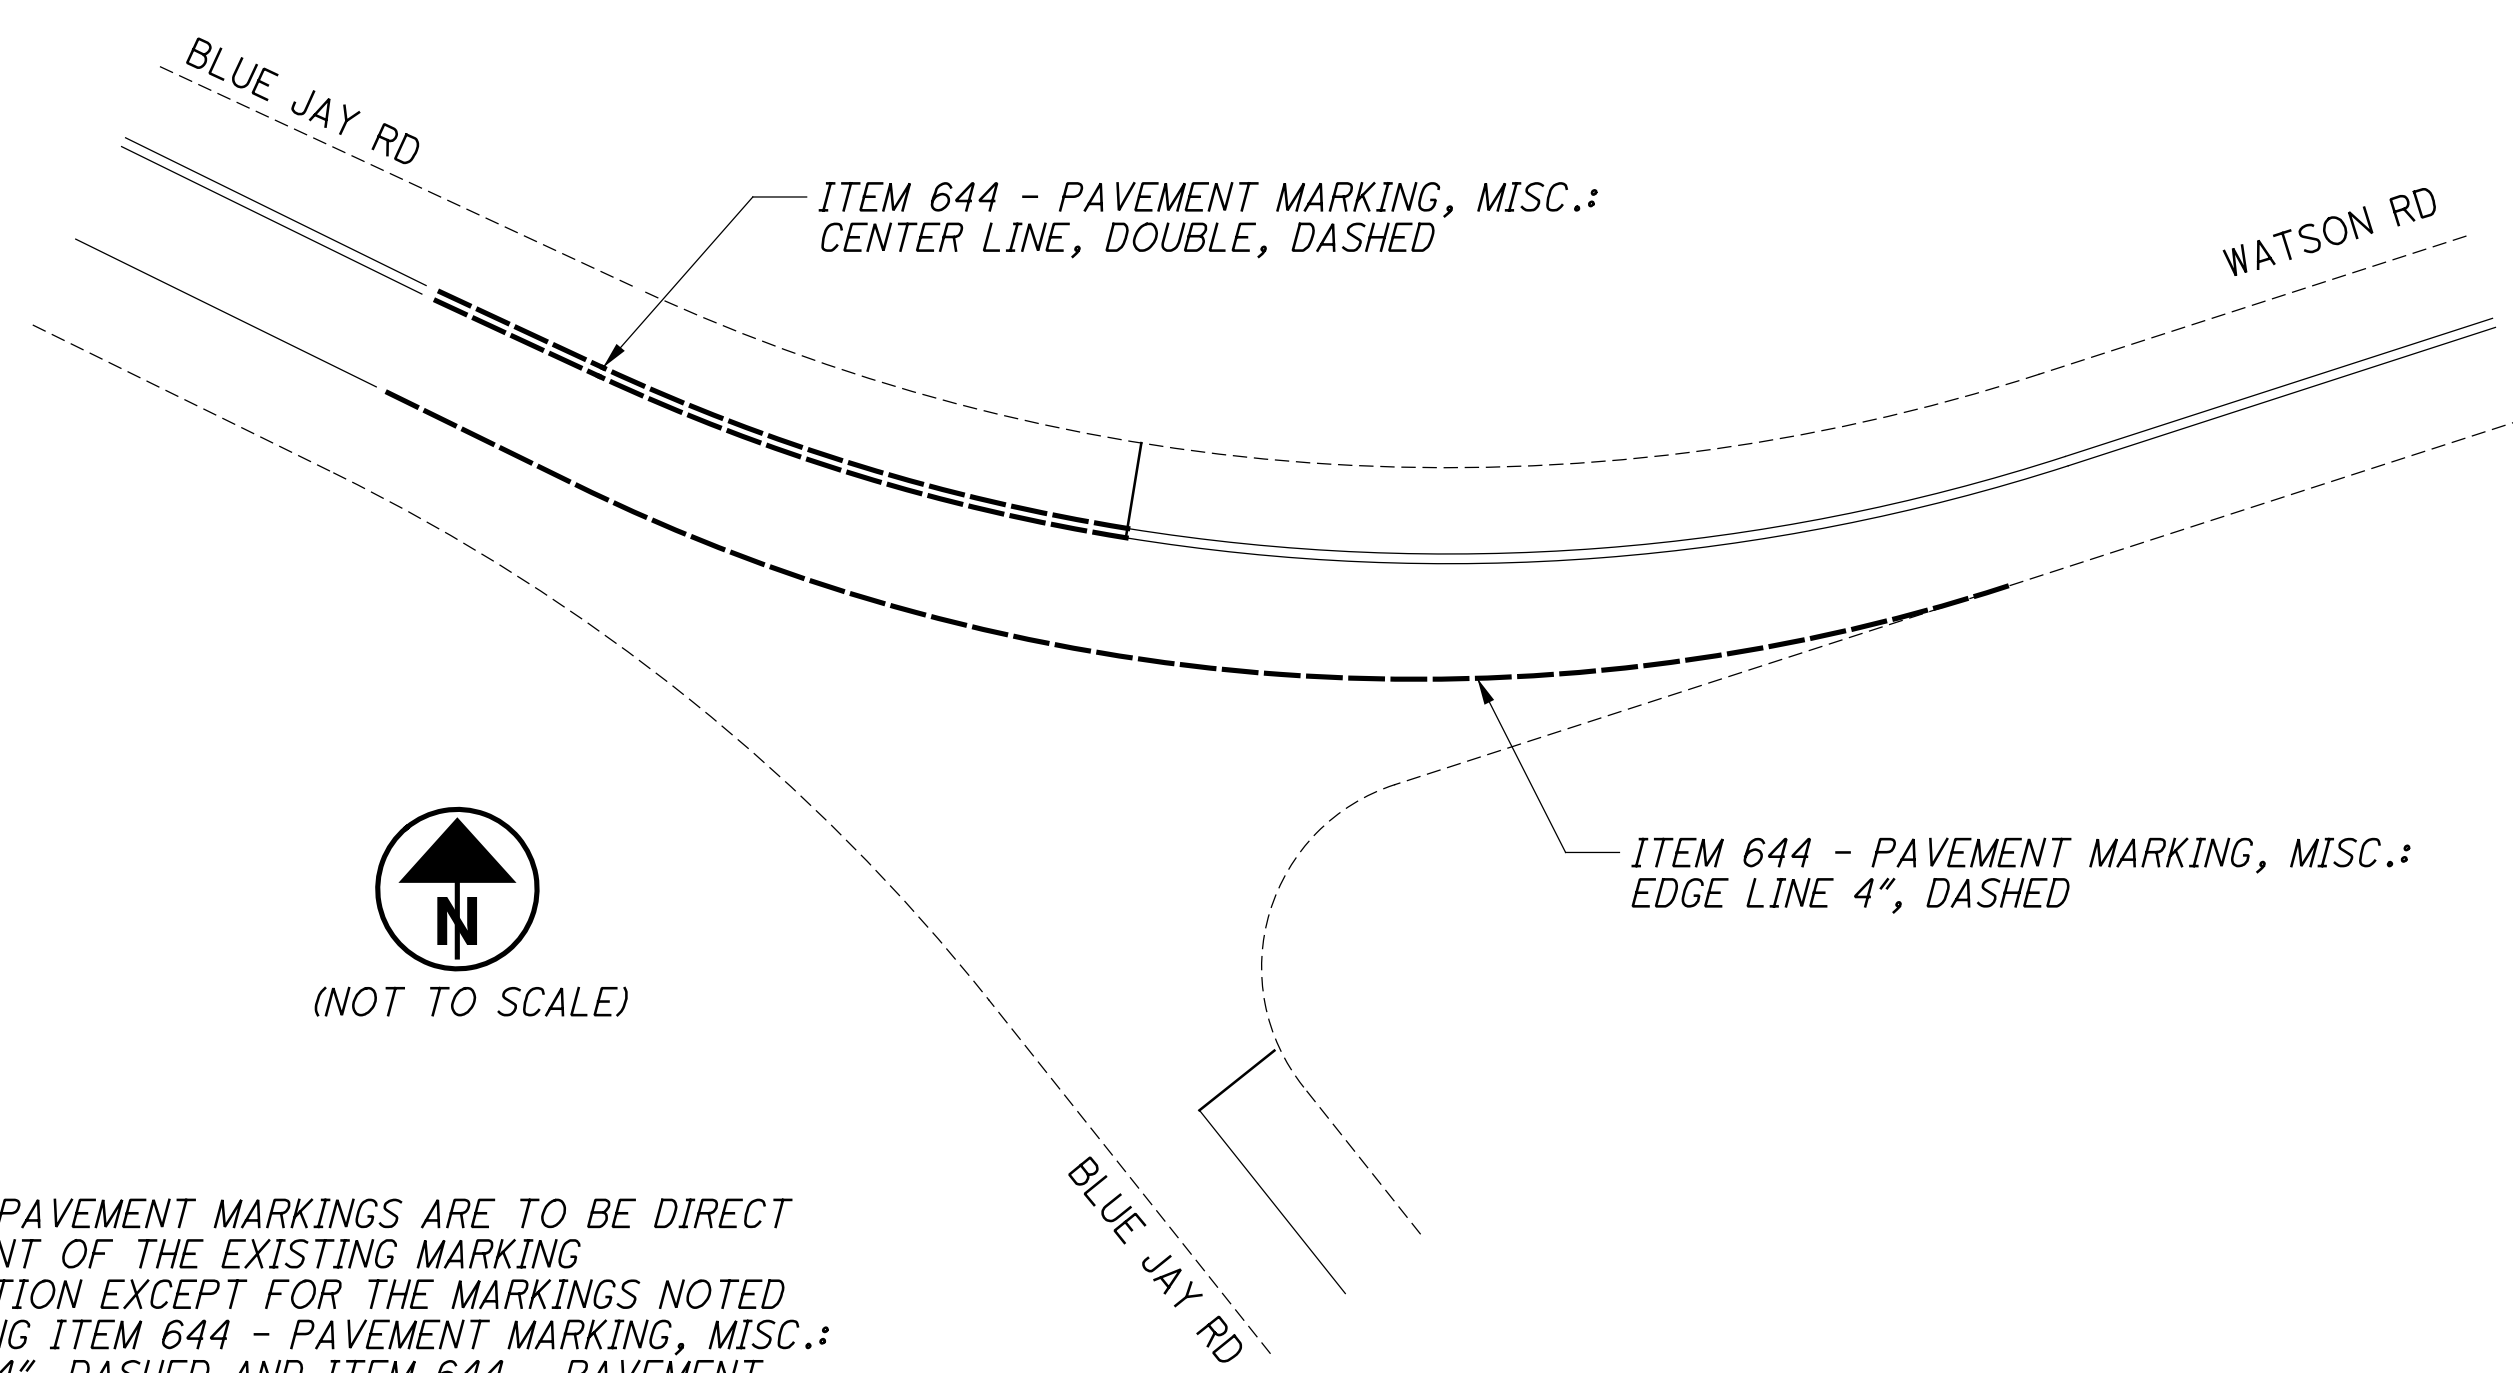

NOTE: ALL PAVEMENT MARKINGS ARE TO BE DIRECT REPLACEMENT OF THE EXISTING MARKING CONFIGURATION EXCEPT FOR THE MARKINGS NOTED ABOVE USING ITEM 644 - PAVEMENT MARKING, MISC.: EDGE LINE 4", DASHED AND ITEM 644 - PAVEMENT MARKING, MISC.: CENTER LINE, DOUBLE, DASHED AT THE INTERSECTION OF BLUE JAY ROAD AND WATSON ROAD.

