
- 0_60PAPERSIZE: 34X22 (in.) DATE: 8/19/2024 TIME: 10:56:40 AM USER: KC.KI LAGE OF GRANVILLE\761567_LIC-SR661-0.60\03-CIVIL\PLAN\ROAD\761567_G

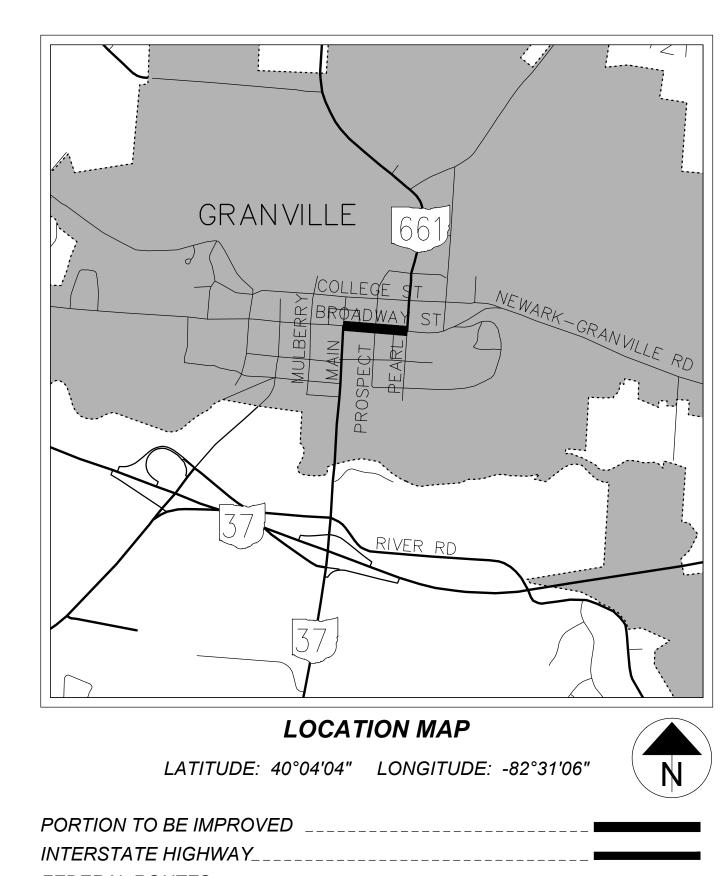

FEDERAL ROUTES_____ STATE ROUTES ______ — OTHER ROADS_____ — **DESIGN DESIGNATION** CURRENT ADT (2023)_______9,841 DESIGN YEAR ADT (2043).....11,890 DESIGN HOURLY VOLUME (year)______1,189 TRUCKS (24 HR B&C)_. DESIGN SPEED______ LEGAL SPEED______ DESIGN FUNCTIONAL CLASSIFICATION:

NHS PROJECT_____NO

ENGINEERS SEAL:

FOR ROADWAY

DESIGN EXCEPTIONS

NONE REQUIRED

MAJOR COLLECTOR

ADA DESIGN WAIVER

NONE REQUIRED





COLUMBUS, OH 43231 PHONE: 614.794.7080 FAX: 888.208.4826

STATE OF OHIO DEPARTMENT OF TRANSPORTATION

LIC-SR661-0.60

VILLAGE OF GRANVILLE LICKING COUNTY

INDEX OF SHEETS:

TITLE SHEET	1
SIGNATURES - VILLAGE OF GRANVILLE	1A
TYPICAL SECTIONS	2
GENERAL NOTES	3-4
MAINTENANCE OF TRAFFIC	5-6
GENERAL SUMMARY	7-9
ESTIMATED QUANTITIES	10-13
PAVEMENT CALCULATIONS	14
PLAN	15-18
INTERSECTION / CURB RAMP DETAILS	19-21
STORM SEWER PROFILES	22
WATER WORK	23
TRAFFIC CONTROL PLAN	24-30
SIGNALS	31-56
LIGHTING	57-59
LANDSCAPING	60-63
IRRIGATION PLAN	64-67
R/W ENCROACHMENT SUMMARY	68

FEDERAL PROJECT NUMBER

E190409

RAILROAD INVOLVEMENT

PROJECT DESCRIPTION

THIS PROJECT INCLUDES TRAFFIC SIGNAL AND PEDESTRIAN FACILITY UPGRADES AT THE INTERSECTIONS OF MAIN ST/SR 661 (BROADWAY), PROSPECT ST/SR 661 (BROADWAY), AND PEARL ST /SR 661 (BROADWAY) ALONG WITH THE INSTALLATION OF A MID-BLOCK RRFB.

EARTH DISTURBED AREAS

PROJECT EARTH DISTURBED AREA:	0.41 ACRES
ESTIMATED CONTRACTOR EARTH DISTURBED AREA:	0.35 ACRES
NOTICE OF INTENT EARTH DISTURBED AREA:	0.76 ACRES

2023 SPECIFICATIONS

THE STANDARD SPECIFICATIONS OF THE STATE OF OHIO. DEPARTMENT OF TRANSPORTATION, INCLUDING SUPPLEMENTAL SPECIFICATIONS LISTED IN THE PLANS AND CHANGES LISTED IN THE PROPOSAL SHALL GOVERN THIS IMPROVEMENT.

I HEREBY APPROVE THESE PLANS AND DECLARE THAT THE MAKING OF THIS IMPROVEMENT WILL NOT REQUIRE THE CLOSING TO TRAFFIC OF THE ROADWAY AND THAT PROVISIONS FOR THE MAINTENANCE AND SAFETY OF TRAFFIC WILL BE AS SET FORTH ON THE PLANS AND ESTIMATES.

APPROVED Jason 2 Sturgen

Jason L. Sturgeon, P.E.
DISTRICT 05 DEPUTY DIRECTOR

APPROVED July Marchbanks, PhD

Jack Marchbanks, PhD Director, Department of Transportation

