
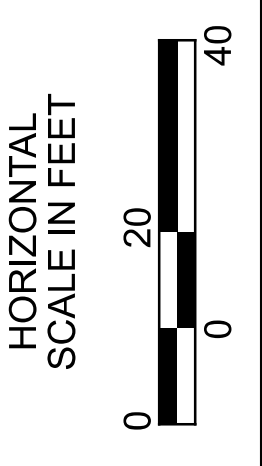
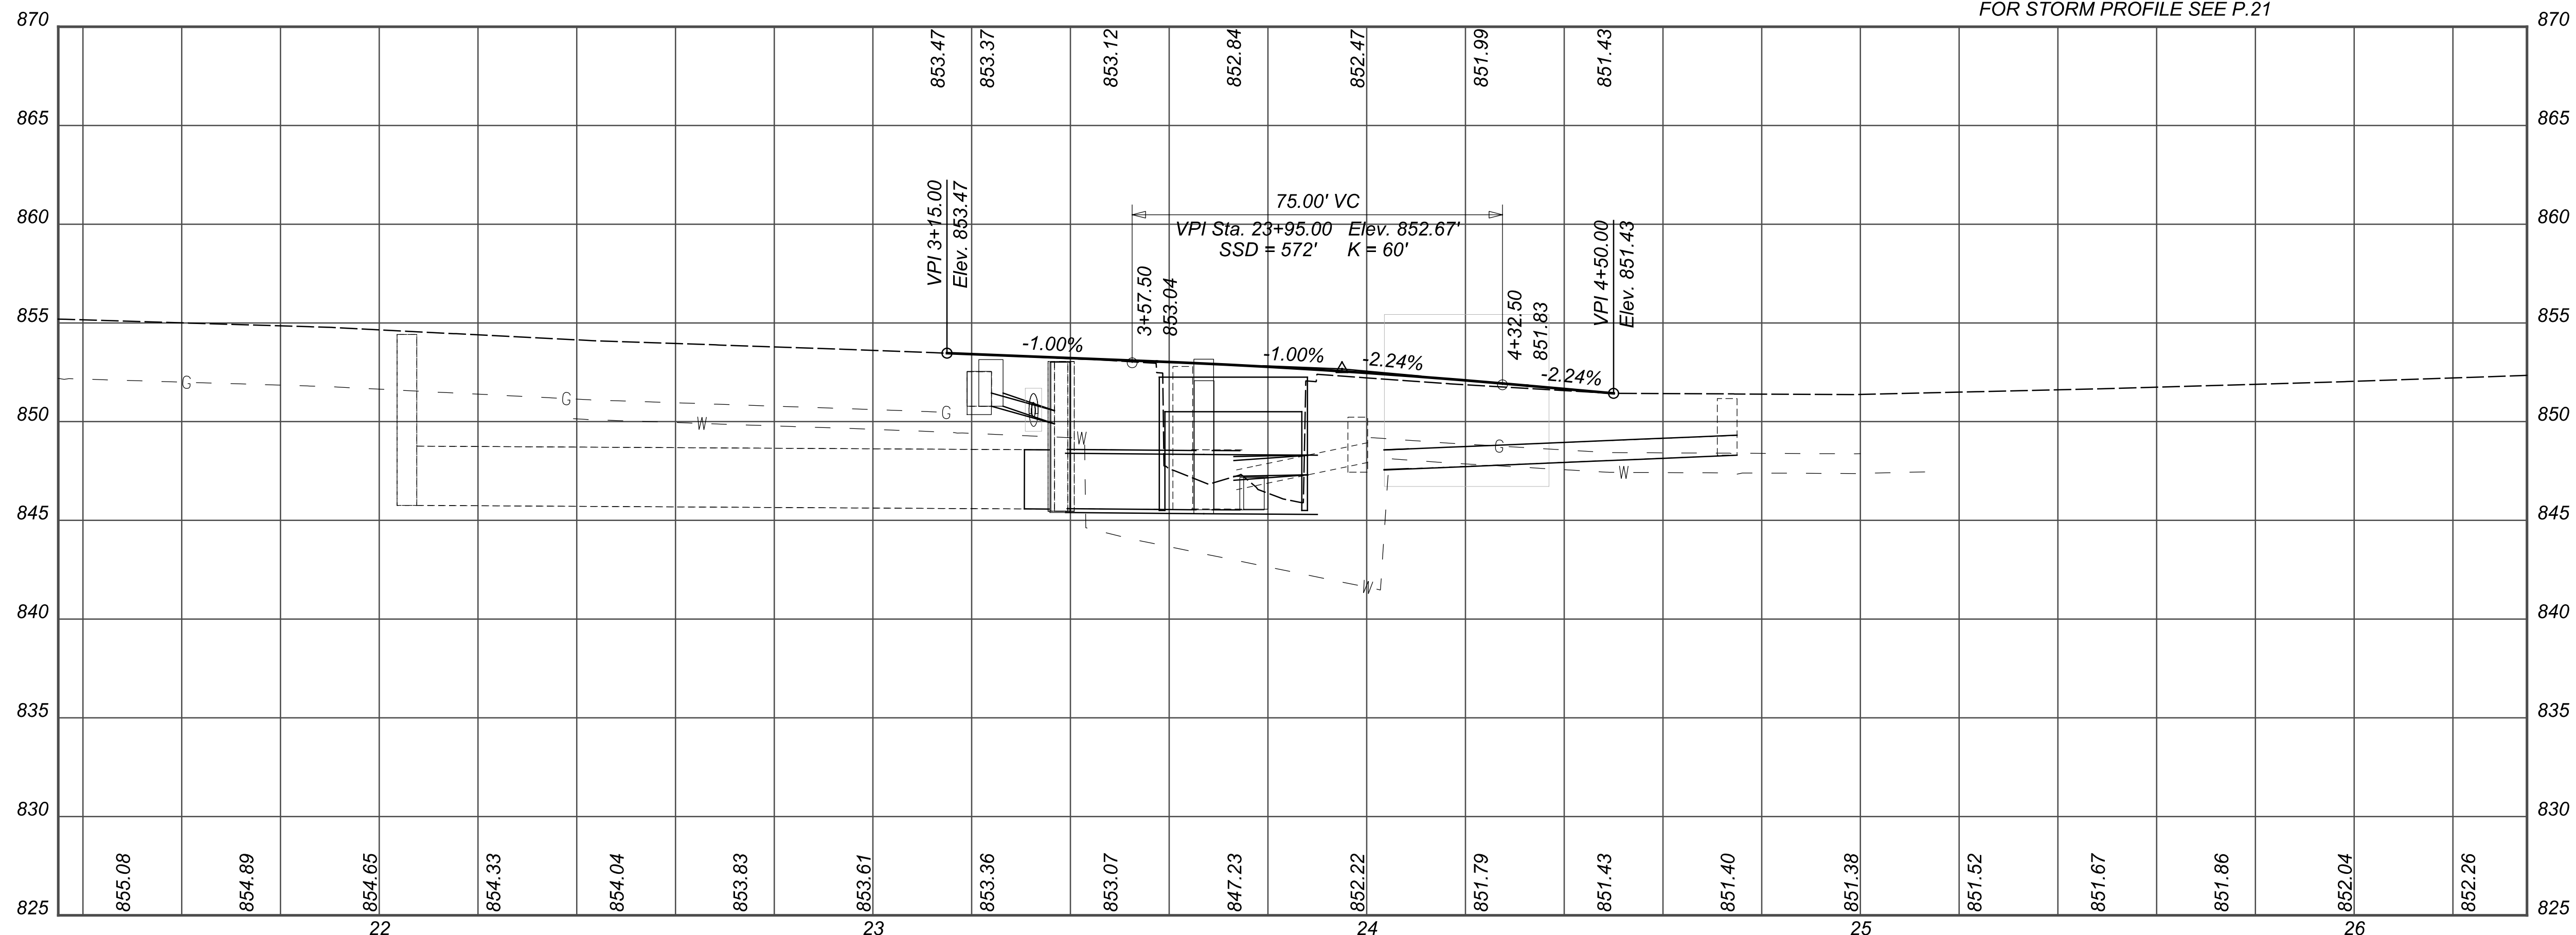


- A STA 23+30.82, 23.00' LT
- B STA 23+41.82, 17.50' LT
- C STA 23+45.62, 24.50' RT
- D STA 23+65.62, 19.50' RT
- E STA 24+02.38, 19.50' RT
- F STA 24+26.17, 25.50' RT

- SL -STOP LINE (ITEM 644)
- XW-1 -CROSS WALK LINE (ITEM 644)
- XW-2 -CROSS WALK LINE (ITEM 644)
- XW-3 -CROSS WALK LINE (ITEM 647)

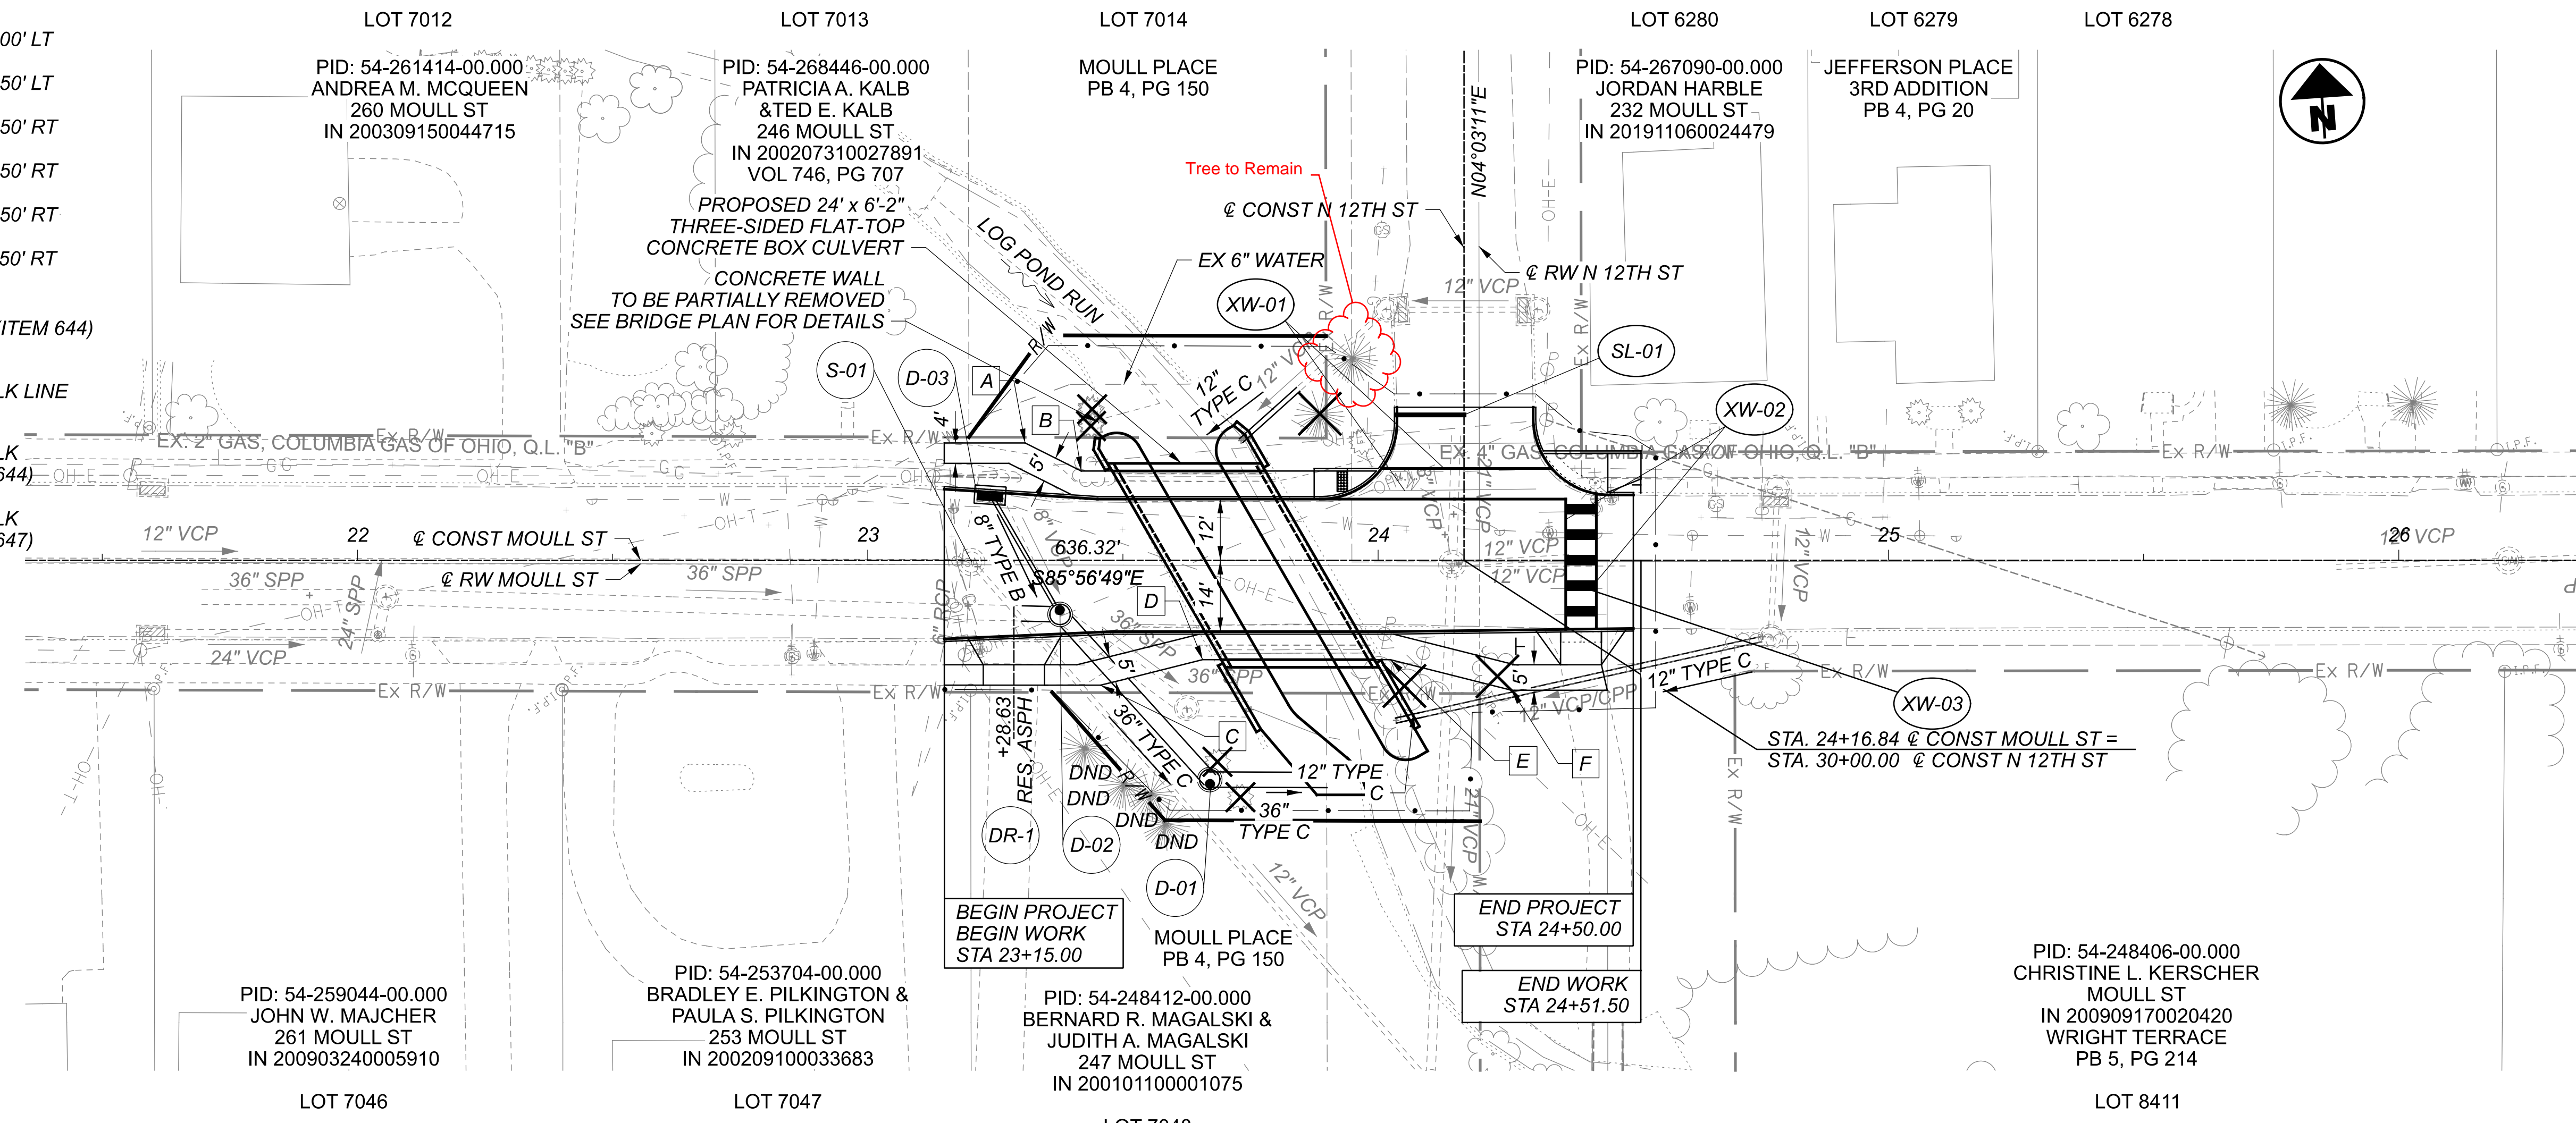

PLAN AND PROFILE
 MOULL STREET

DESIGN AGENCY	AMERICAN STRUCTUREPOINT INC.
DESIGNER	AJO
REVIEWER	AJL 02/15/21
PROJECT ID	111654
SHEET TOTAL	P.10 P.43