
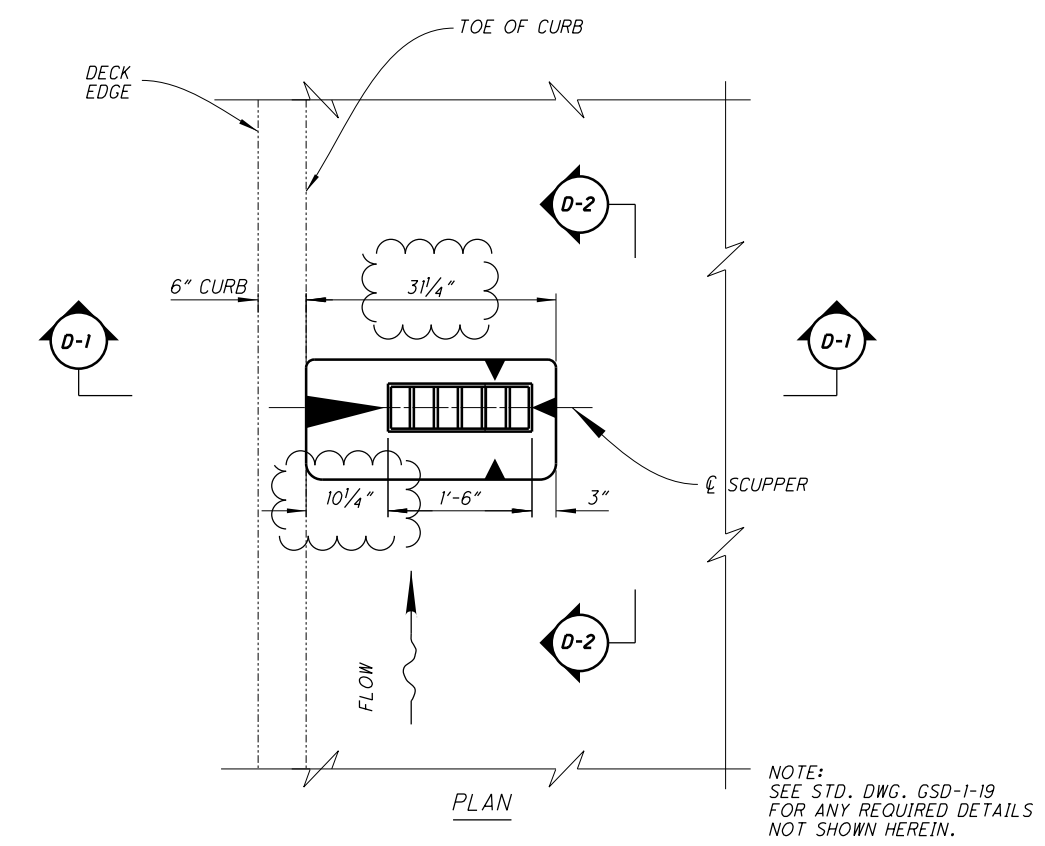
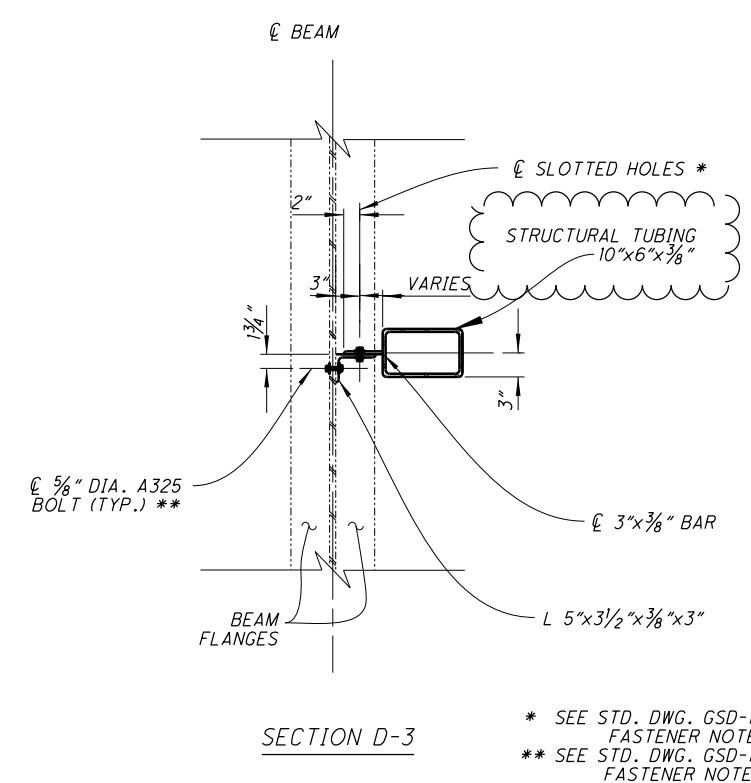


I:\ProjectData\LIC\97988\Design\Roadway\Sheets\97988\_G001.dgn Sheet 5/8/2020 10:52:53 AM jnelson





SHEET NUM.											PART.	ITEM	ITEM	GRAND	UNIT	DESCRIPTION	SEE SHEET NO.		
6	8	15	16	17	22	43					01/STR/B R		EXT	TOTAL					
											LS	201	11000	LS		ROADWAY			
																	CLEARING AND GRUBBING		
		262									262	202	23500	262	SY		WEARING COURSE REMOVED		
			669								669	202	38000	669	FT		GUARDRAIL REMOVED		
		198									198	203	10001	198	CY		EXCAVATION, AS PER PLAN	6	
											10	203	20000	10	CY		EMBANKMENT		
		646									646	204	10000	646	SY		SUBGRADE COMPACTION		
7											7	209	15000	7	STA		RESHAPING UNDER GUARDRAIL		
25											25	209	70000	25	CY		BORROW		
											4.9	209	72000	4.9	STA		PREPARING SUBGRADE FOR SHOULDER PAVING		
			512.5								512.5	606	15050	512.5	FT		GUARDRAIL, TYPE MGS		
			4								4	606	26550	4	EACH		ANCHOR ASSEMBLY, MGS TYPE T		
			4								4	606	35002	4	EACH		MGS BRIDGE TERMINAL ASSEMBLY, TYPE 1		
		8									8	609	24510	8	FT		CURB, TYPE 4-C		
																	EROSION CONTROL		
1,000											1,000	659	00510	1,000	SY		SEEDING AND MULCHING, CLASS 2		
0.14											0.14	659	20000	0.14	TON		COMMERCIAL FERTILIZER		
0.21											0.21	659	31000	0.21	ACRE		LIME		
5.4											5.4	659	35000	5.4	MGAL		WATER		
											1,000	832	30000	1,000	EACH		EROSION CONTROL		
																	PAVEMENT		
		505									505	252	01500	505	FT		FULL DEPTH PAVEMENT SAWING		
		937									937	254	01000	937	SY		PAVEMENT PLANING, ASPHALT CONCRETE		
		92									92	301	46000	92	CY		ASPHALT CONCRETE BASE, PG64-22		
		109									109	304	20000	109	CY		AGGREGATE BASE		
		180									180	407	20000	180	GAL		NON-TRACKING TACK COAT		
		50									50	441	50100	50	CY		ASPHALT CONCRETE SURFACE COURSE, TYPE 1, (448), PG70-22M		
		59									59	441	50300	59	CY		ASPHALT CONCRETE INTERMEDIATE COURSE, TYPE 2, (448)		
55											55	SPECIAL	69012050	55	SY		REINFORCED MESH FOR TRANSVERSE AND/OR LONGITUDINAL JOINTS AND CRACKS	6	
																	TRAFFIC CONTROL		
4											4	621	54000	4	EACH		RAISED PAVEMENT MARKER REMOVED		
			17								17	626	00110	17	EACH		BARRIER REFLECTOR, TYPE 2, ONE WAY		
48											48	630	03100	48	FT		GROUND MOUNTED SUPPORT, NO. 3 POST		
12											12	630	80100	12	SF		SIGN, FLAT SHEET		
			0.2								0.2	646	10010	0.2	MILE		EDGE LINE, 6"		
			0.1								0.1	646	10200	0.1	MILE		CENTER LINE		
				14							14	646	10400	14	FT		STOP LINE		

CALCULATED	JKS	CHECKED	TAG
<b>GENERAL SUMMARY</b>			
<b>LIC-79-19.90</b>			
13			
43			

I:\ProjectData\LIC\97988\Design\Structures\LIC079\_1991C\Sheets\079\_1991C\_SS004.dgn Sheet 5/14/2020 8:44:44 AM jneilson

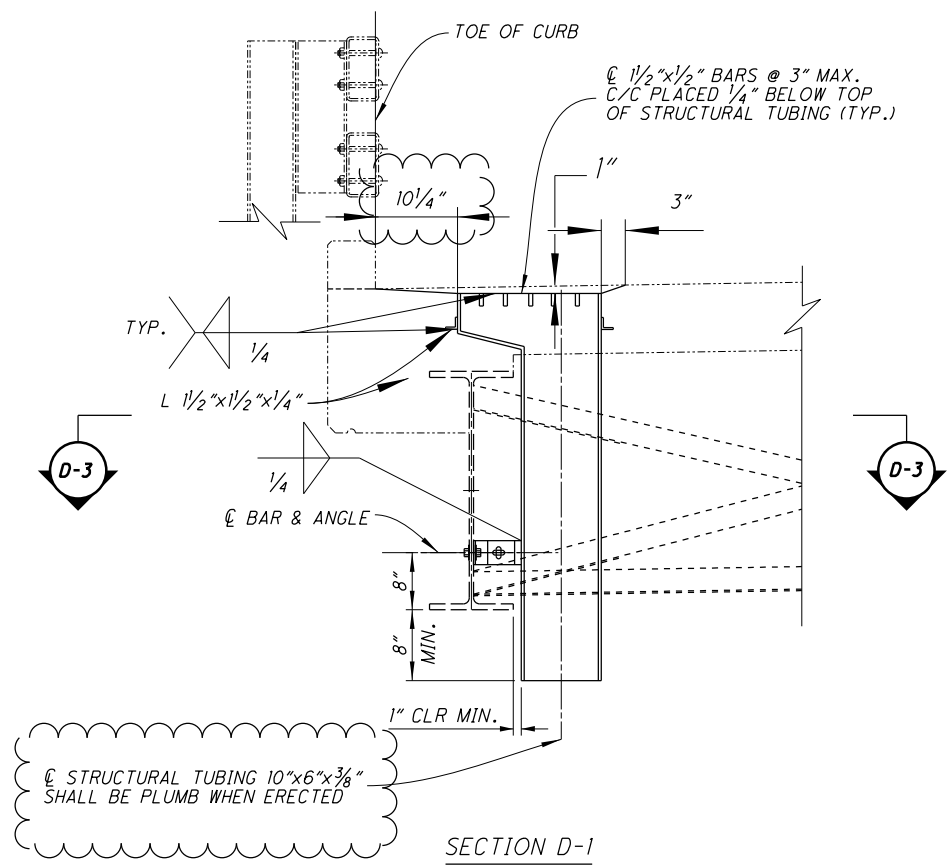

NOTE:  
SEE STD. DWG. GSD-1-19  
FOR ANY REQUIRED DETAILS  
NOT SHOWN HEREIN.

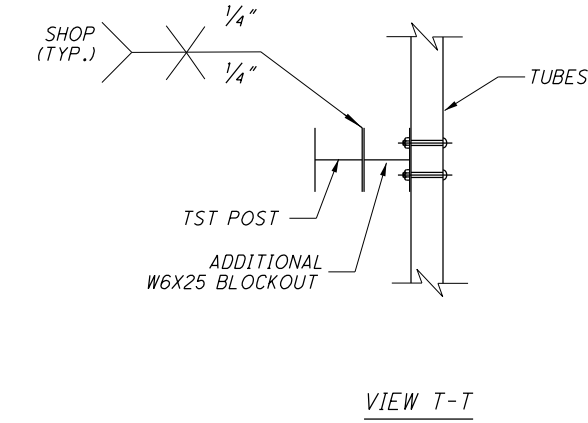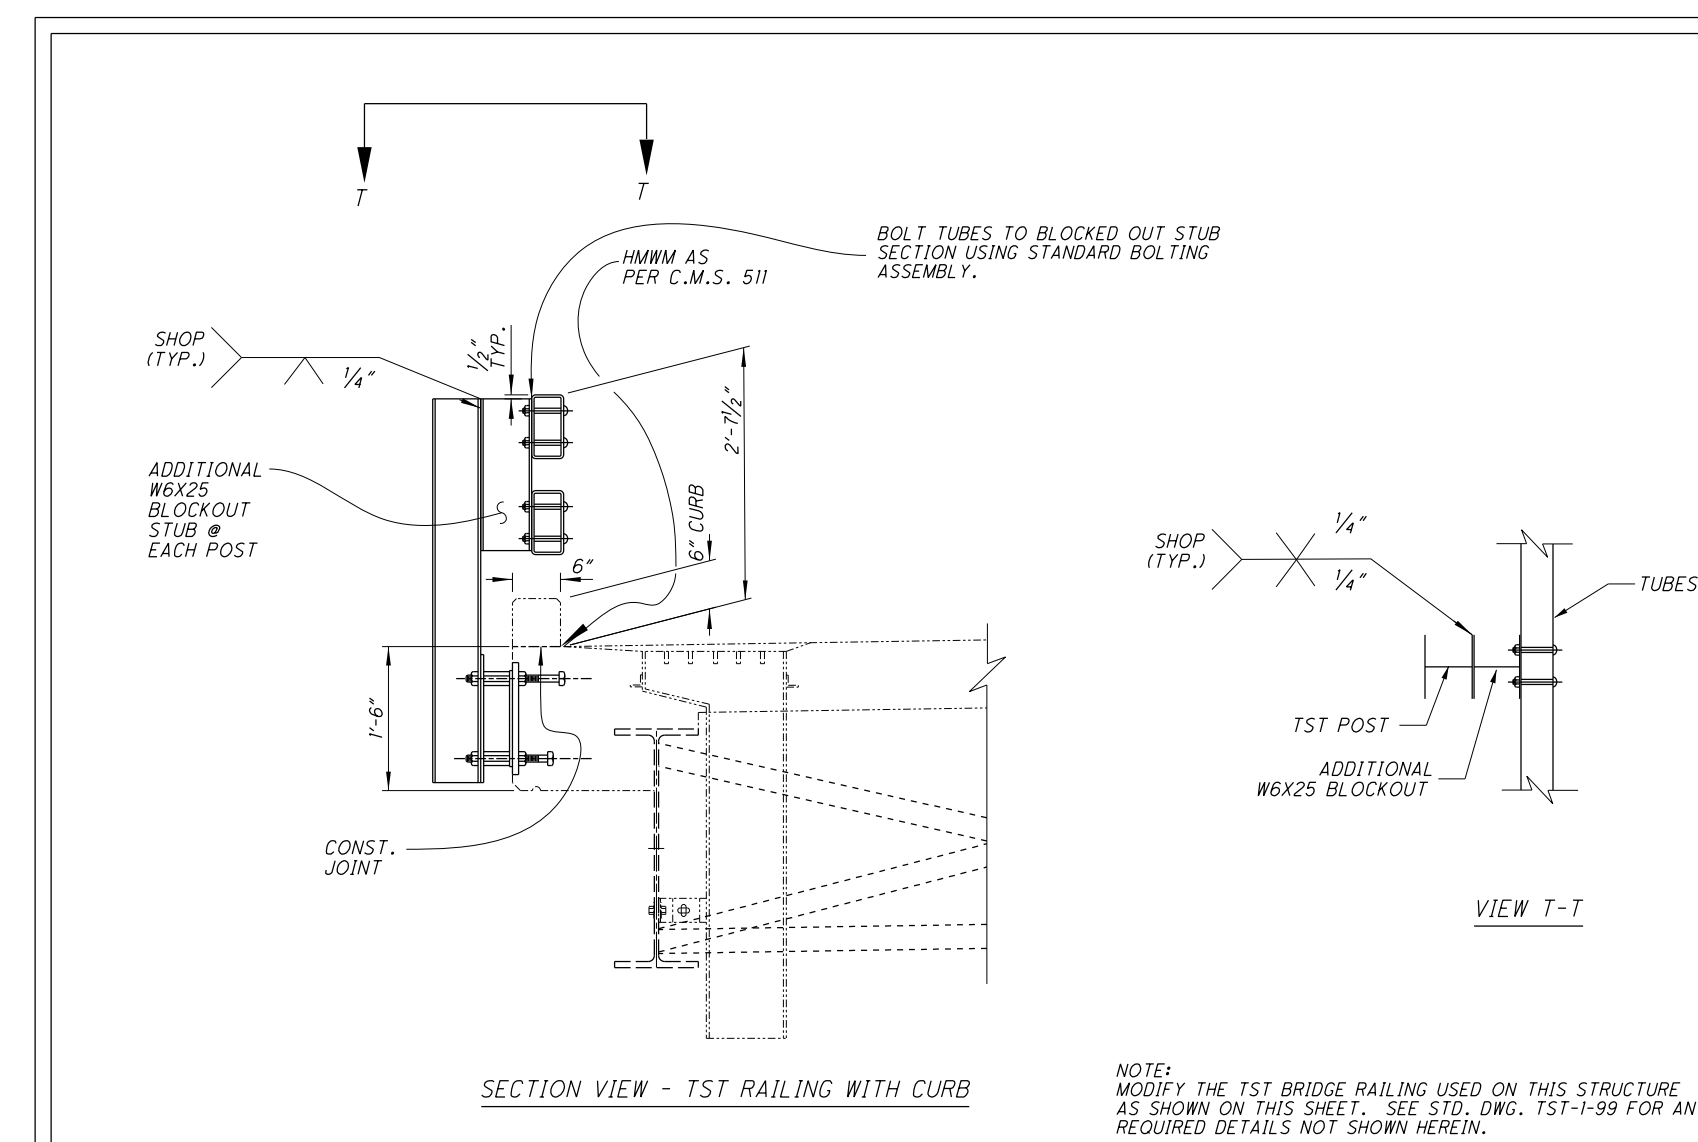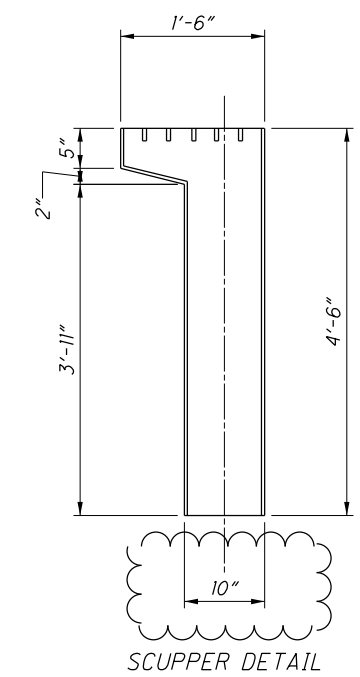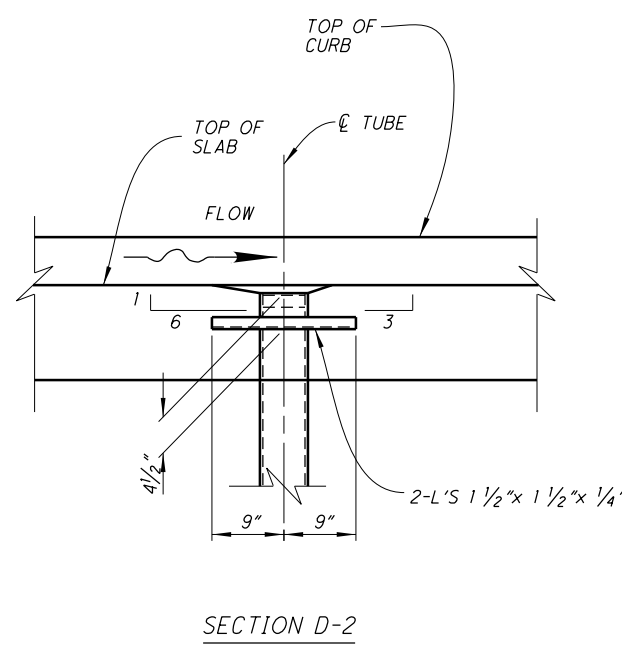

NOTE:  
MODIFY THE TST BRIDGE RAILING USED ON THIS STRUCTURE  
AS SHOWN ON THIS SHEET. SEE STD. DWG. TST-1-99 FOR ANY  
REQUIRED DETAILS NOT SHOWN HEREIN.

DESIGNED		JKS	CHECKED	TAG
DRAWN		JKS	REVIEWED	XXX
REVIEWED		TAG	DATE	2/7/20
STRUCTURE FILE NUMBER		4505018		
DESIGN AGENCY OHIO DEPARTMENT OF TRANSPORTATION, DISTRICT 5				
SCUPPER AND RAILING DETAILS				
BRIDGE NO. LIC-79-1991 OVER WILKINS RUN				
LIC-79-19.90		PID No. 97988		
17/25		35/43		