



APPLIES TO:

SP-1	0.00-0.09	0.09 MILES
SP-2	0.00-0.06	0.06 MILES
SP-2	0.10-0.11	0.01 MILES
SP-3	0.00-1.32	1.32 MILES
SP-9	0.00-1.36	1.36 MILES
SP-9A	0.00-0.03	0.03 MILES
SP-16	0.00-0.07	0.07 MILES
SP-17	0.00-0.13	0.13 MILES
TOTAL		3.07 MILES

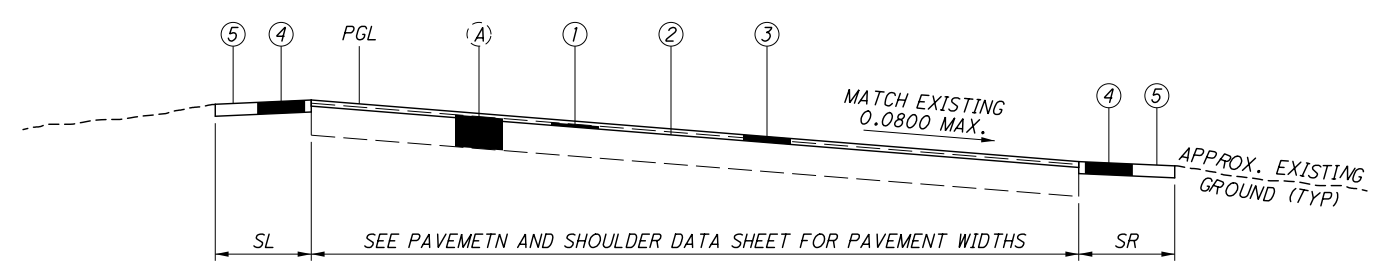

APPLIES TO:

SP-1A	0.00-0.07	0.07 MILES
SP-2A	0.00-0.09	0.09 MILES
TOTAL		0.16 MILES

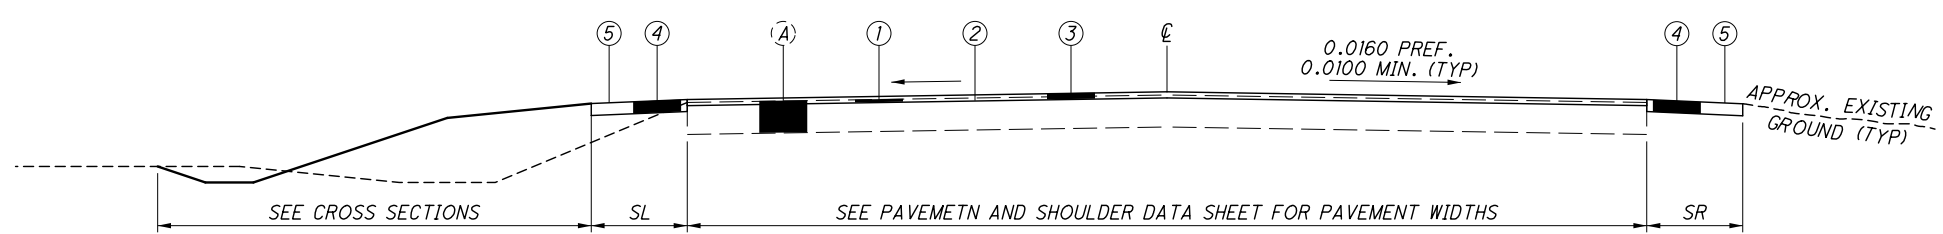

APPLIES TO:

SP-2	0.06-0.10	0.04 MILES
TOTAL		0.04 MILES

EXISTING LEGEND  
A - EXISTING PAVEMENT (SEE CORING DETAILS)

PROPOSED LEGEND

- 1 - ITEM 254 - PAVEMENT PLANING, ASPHALT CONCRETE (0.75")
- 2 - ITEM 407 - TACK COAT
- 3 - ITEM 442 - ASPHALT CONCRETE SURFACE COURSE, 9.5 MM, TYPE A (448), AS PER PLAN (PG64-22) (1.50")
- 4 - ITEM 617 - COMPACTED AGGREGATE (TYP) (3.00" AVG)
- 5 - ITEM 408 - PRIME COAT

I:\ProjectData\10815\Design\Roadway\Sheets\10815\_GY001.dgn

I:\ProjectData\10815\Design\Roadway\Sheets\10815\_GG001.dgn

SHEET NUM.								PART.	ALT	ITEM	ITEM	GRAND	UNIT	DESCRIPTION	SEE SHEET NO.
5	6	8	9	10	11	12		01/NFP/PV	(X)		EXT	TOTAL			
														ROADWAY	
					66			66		202	23000	66	SY	PAVEMENT REMOVED	
				2				2		202	35100	2	FT	PIPE REMOVED, 24" AND UNDER	
				4	119			123		203	10000	123	CY	EXCAVATION	
				48				48		203	20000	48	CY	EMBANKMENT	
	6.56							6.56		209	60500	6.56	MILE	LINEAR GRADING	
														DRAINAGE	
				5				5		611	01800	5	FT	8" CONDUIT, TYPE B	
														EROSION CONTROL	
				2				2		659	00100	2	EACH	SOIL ANALYSIS TEST	
				10				10		659	00300	10	CY	TOPSOIL	
				86				86		659	10000	86	SY	SEEDING AND MULCHING	
				5				5		659	14000	5	SY	REPAIR SEEDING AND MULCHING	
				5				5		659	15000	5	SY	INTER-SEEDING	
				0.02				0.02		659	20000	0.02	TON	COMMERCIAL FERTILIZER	
				0.02				0.02		659	31000	0.02	ACRE	LIME	
				1				1		659	35000	1	MGAL	WATER	
								5,000		832	30000	5,000	EACH	EROSION CONTROL	
														PAVEMENT	
517								517		251	01042	517	CY	PARTIAL DEPTH PAVEMENT REPAIR (ASPHALT CONCRETE BASE)	
					60			60		252	01500	60	FT	FULL DEPTH PAVEMENT SAWING	
30								30		253	02000	30	CY	PAVEMENT REPAIR	
	39,320							39,320		254	01000	39,320	SY	PAVEMENT PLANING, ASPHALT CONCRETE (0.75")	
	211							211		254	01600	211	SY	PATCHING PLANED SURFACE	
	3,556							3,556		407	10000	3,556	GAL	TACK COAT	
	2,963							2,963		408	10001	2,963	GAL	PRIME COAT, AS PER PLAN	5
	1,655							1,655		442	10501	1,655	CY	ASPHALT CONCRETE SURFACE COURSE, 9.5 MM, TYPE A (448), AS PER PLAN (PG64-22) (1.50")	5
	625				130			755		617	10100	755	CY	COMPACTED AGGREGATE	
														TRAFFIC CONTROL	
				5.92				5.92		642	00100	5.92	MILE	EDGE LINE, 4", TYPE 1 (WHITE)	
				0.46				0.46		642	00100	0.46	MILE	EDGE LINE, 4", TYPE 1 (YELLOW)	
				3.13				3.13		642	00300	3.13	MILE	CENTER LINE, TYPE 1	
														TRAFFIC CONTROL ALTERNATES	
				311				311	X	642	00500	311	FT	STOP LINE, TYPE 1 (ALTERNATE 1)	
				10				10	X	642	01322	10	EACH	WRONG WAY ARROW, TYPE 1 (ALTERNATE 1)	
				311				311	X	644	00500	311	FT	STOP LINE (ALTERNATE 2)	
				10				10	X	644	01360	10	EACH	WRONG WAY ARROW (ALTERNATE 2)	
														STRUCTURE REPAIR (SFN: 4726235)	
						34		34		846	00111	34	CF	POLYMER MODIFIED ASPHALT EXPANSION JOINT SYSTEM, AS PER PLAN	12
														MAINTENANCE OF TRAFFIC	
	10							10		614	13000	10	CY	ASPHALT CONCRETE FOR MAINTAINING TRAFFIC	
				3.16				3.16		614	21100	3.16	MILE	WORK ZONE CENTER LINE, CLASS I, 642 PAINT	
				311				311		614	26200	311	FT	WORK ZONE STOP LINE, CLASS I, 642 PAINT	
														INCIDENTALS	
								LS		614	11000	LS		MAINTAINING TRAFFIC	
								LS		623	10000	LS		CONSTRUCTION LAYOUT STAKES AND SURVEYING	
								LS		624	10000	LS		MOBILIZATION	

GENERAL SUMMARY

LOR-FINDLEY  
SP-MAIN ROAD

CALCULATED  
TPG  
CHECKED  
KCK