

**TEMPORARY DRAINAGE ITEMS**

TEMPORARY DRAINAGE ITEMS LABELED ON THE MAINTENANCE OF TRAFFIC PLAN ARE ITEMIZED ON THE MOT PLANS. PAYMENT FOR THE TEMPORARY DRAINAGE ITEMS ARE ITEMIZED AND CARRIED TO THE GENERAL SUMMARY.

**PROPOSED WATER WORK (AS PER PLAN)**

ALL PROPOSED WATER WORK SHALL BE PER ODOT CMS SPECIFICATIONS WITH THE AMENDMENTS OF THE CITY OF TOLEDO PART A STANDARDS 2020 SPECIFICATION AND 2020 CITY OF TOLEDO CONSTRUCTION STANDARDS

WATERWORK SHALL BE PERFORMED BY THE CITY OF TOLEDO AT THE CONTRACTOR'S EXPENSE (\$7,700).

ITEM 638, 6" WATER MAIN DUCTILE IRON PIPE ANSI CLASS 52, PUSH-ON JOINTS AND FITTINGS, AS PER PLAN (BY CITY)

ITEM 638, FIRE HYDRANT REMOVED (BY CITY)

ITEM 638, WATER WORK, MISC.: STANDARD FIRE HYDRANT ASSEMBLY, AS PER PLAN (BY CITY)

**PARTIAL AND FULL DEPTH PAVEMENT REPAIR**

PARTIAL OR FULL DEPTH PAVEMENT REPAIR SHALL BE PERFORMED ON THE EXSISTING PAVEMENT AS DETAILED ON THIS SHEET. LOCATIONS FOR PAVEMENT REPAIR SHALL BE AS DIRECTED BY THE ENGINEER. THE FOLLOWING QUANTITIES HAVE BEEN CARRIED TO THE GENERAL SUMMARY FOR THIS PURPOSE.

ITEM 251, PARTIAL DEPTH PAVEMENT REPAIR	351 SY
ITEM 252, FULL DEPTH PAVEMENT SAWING	150 FT
ITEM 255, FULL DEPTH PAVEMENT REMOVAL AND RIGID REPLACEMENT, CLASS QC MS	141 SY

**ITEM 442, ASPHALT CONCRETE INTERMEDIATE COURSE, 19MM, TYPE A, AS PER PLAN**

ITEM 442 ASPHALT INTERMEDIATE COURSE, 19MM, TYPE A (448), AS PER PLAN SHALL FOLLOW THE SPECIFICATIONS FOR THE 442 ITEM EXCEPT FOR SECTION 442.04 ASPHALT BINDER. THE BINDER SHALL BE PG70-22M FOR THE INTERMEDIATE COURSE AND A MAXIMUM OF 20% OF RAP BY DRY WEIGHT OF MIX CAN BE USED.

**ITEM 609, CURB, MISC.: CONCRETE CURB - TYPE A (CITY OF TOLEDO)**

ALL PROPOSED CURB SHALL BE PER CITY OF TOLEDO PART A STANDARDS 2020 SPECIFICATIONS AND 2020 CITY OF TOLEDO CONSTRUCTION STANDARD DRAWING 21: CONCRETE CURBS TYPES A, B, C & D.

**ITEM 611, 12" CONDUIT, AS PER PLAN**


ALL STORM PIPE MATERIALS SHALL COMPLY WITH THE CITY OF TOLEDO STANDARDS AND CRITERIA AND SHALL BE ONE OF THE FOLLOWING:

1. REINFORCED CONCRETE CIRCULAR PIPE AS PER ODOT CMS 706.02
2. VITRIFIED CLAY PIPE AS PER ODOT CMS 706.06
3. POLYVINYL CHLORIDE SOLID WALL AS PER ODOT 707.45 CELL CLASS 12454-B
4. POLYVINYL CHLORIDE SOLID WALL (> 15 INCHES) AS PER ODOT CMS 707.48, PSW115, CELL CLASS 12454-B

**ITEM 611, MANHOLE, MISC.: SANITARY SEWER MANHOLE LID REMOVED AND REPLACED**

THREE EXISTING SANITARY MANHOLES WITHIN THE PROJECT CONSTRUCTION LIMITS SHALL HAVE THE LIDS REMOVED AND REPLACED WITH A SOLID CITY OF TOLEDO STANDARD CASTING AS DIRECTED BY THE ENGINEER. EXISTING CASTINGS SHALL BE CAREFULLY REMOVED AND STORED WITHING THE RIGHT OF WAY FOR SALVAGE BY ODOT FORCES.

PAYMENT FOR THE ABOVE SHALL BE INCLUDED PER EACH IN THE CONTRACT PRICE FOR ITEM 611, MANHOLE, MISC.: SANITARY SEWER MANHOLE LID REMOVED AND REPLACED.

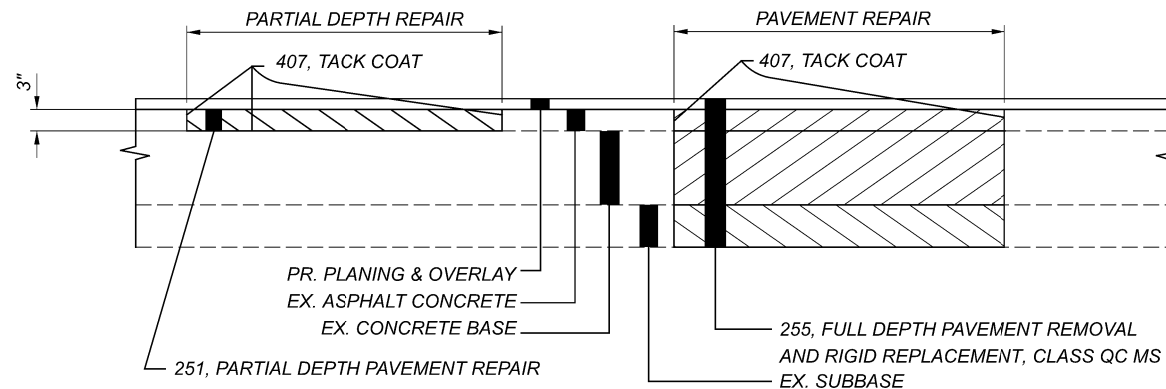

**PARTIAL AND FULL DEPTH PAVEMENT REPAIR**