

ODOT Dist 4 - Stark County - FINAL No Passing Zone Log (STA)

Page: 1 of 15


Route: 0153R (SSTASR00153**C)

Length: 11.736

Direction: East

From: 3.290 RICHMOND

To: 15.026 S0183R

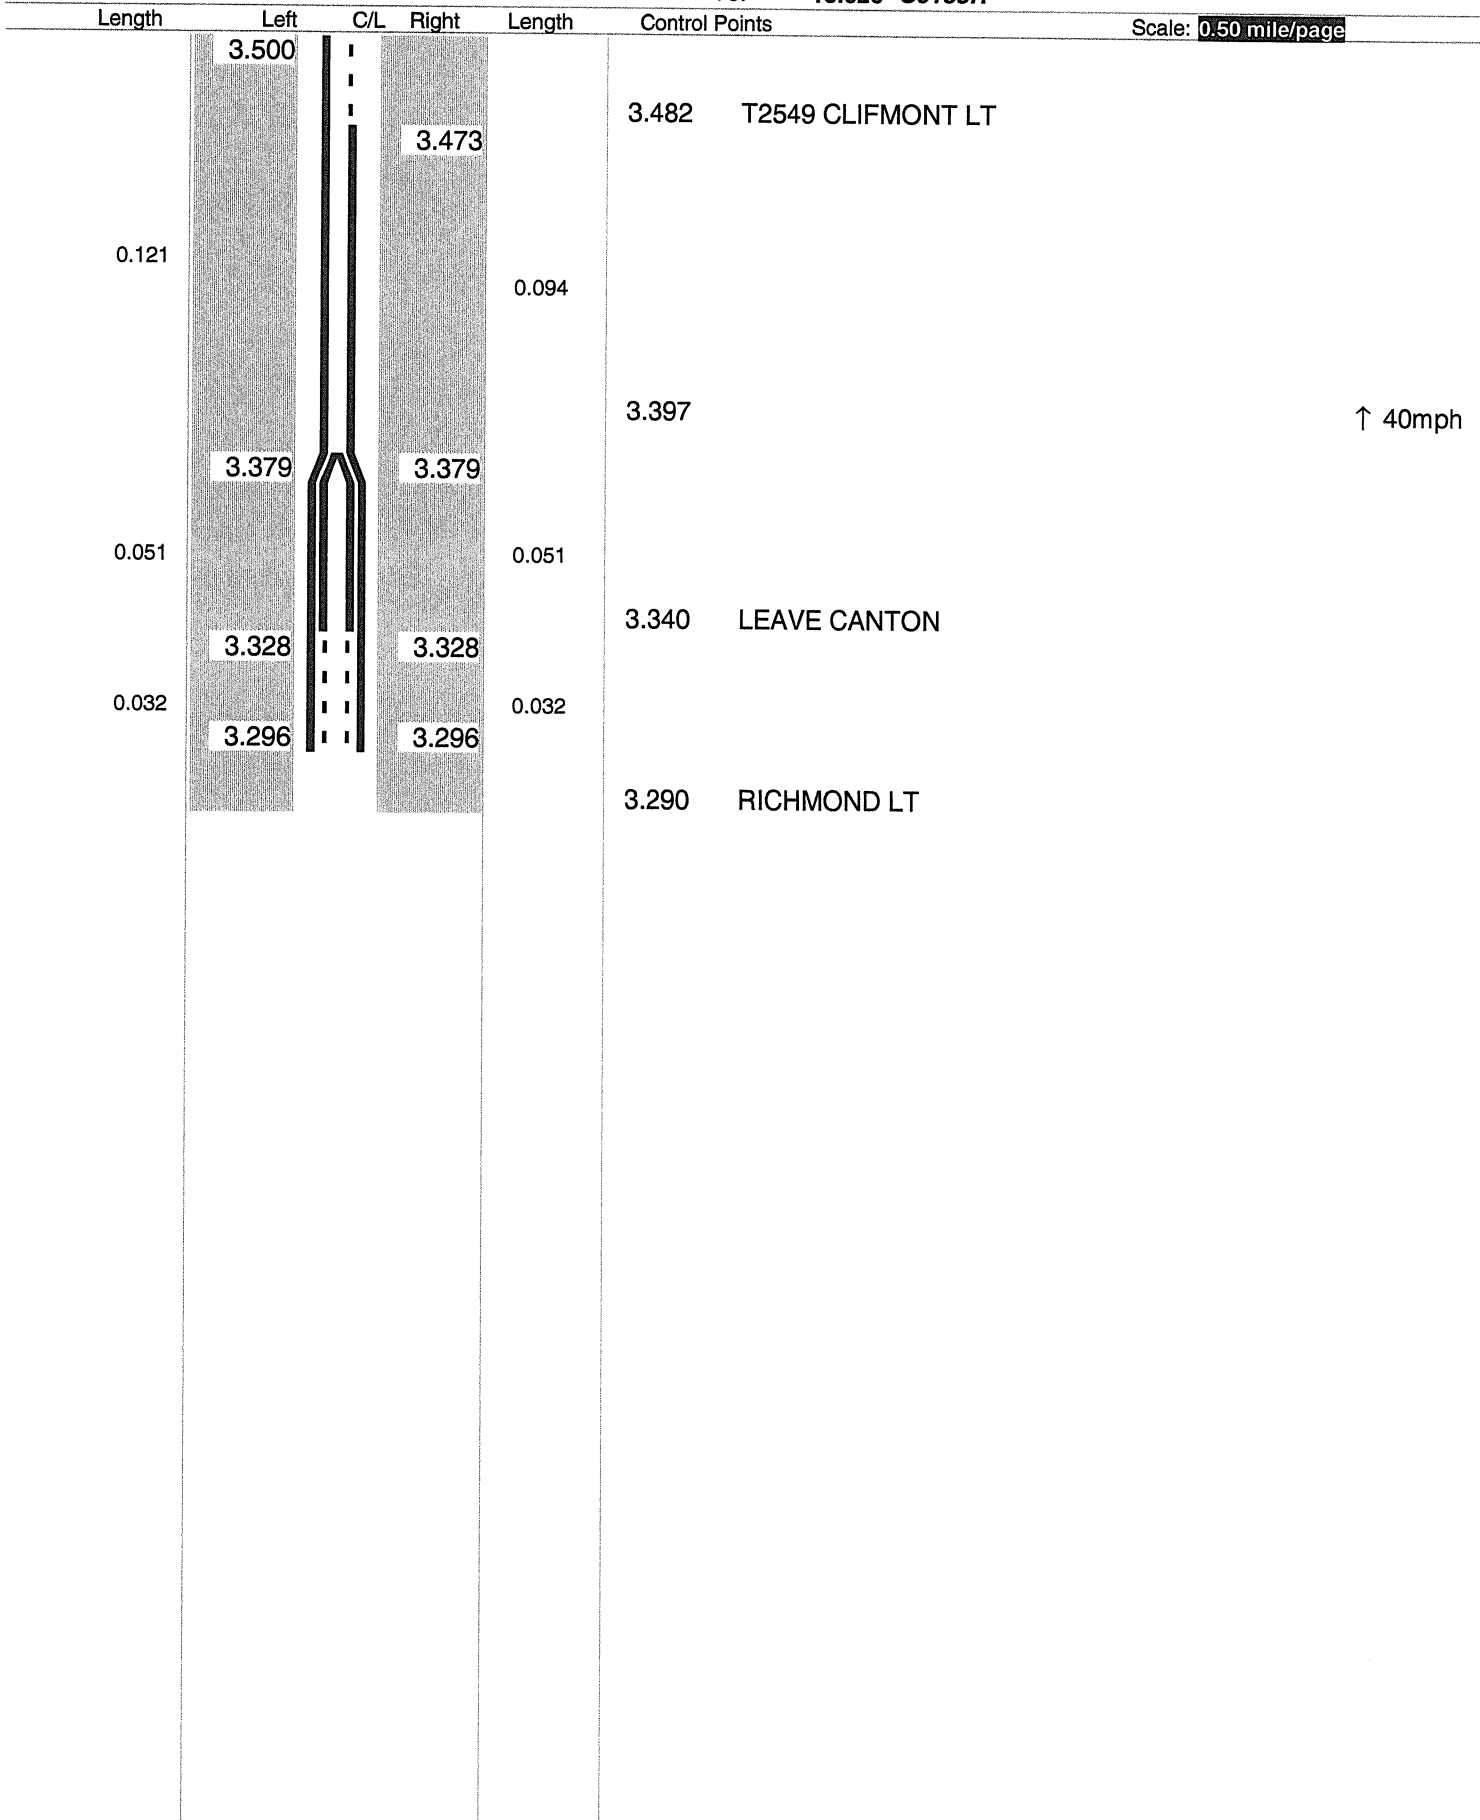

Sheet total equivalent length of solid line: 0.506


Accum. total: 0.506

ODOT Dist 4 - Stark County - FINAL No Passing Zone Log (STA)

Page: 2 of 15

Route: 0153R (SSTASR00153**C)
Length: 11.736 Direction: East

From: 3.290 RICHMOND
To: 15.026 S0183R

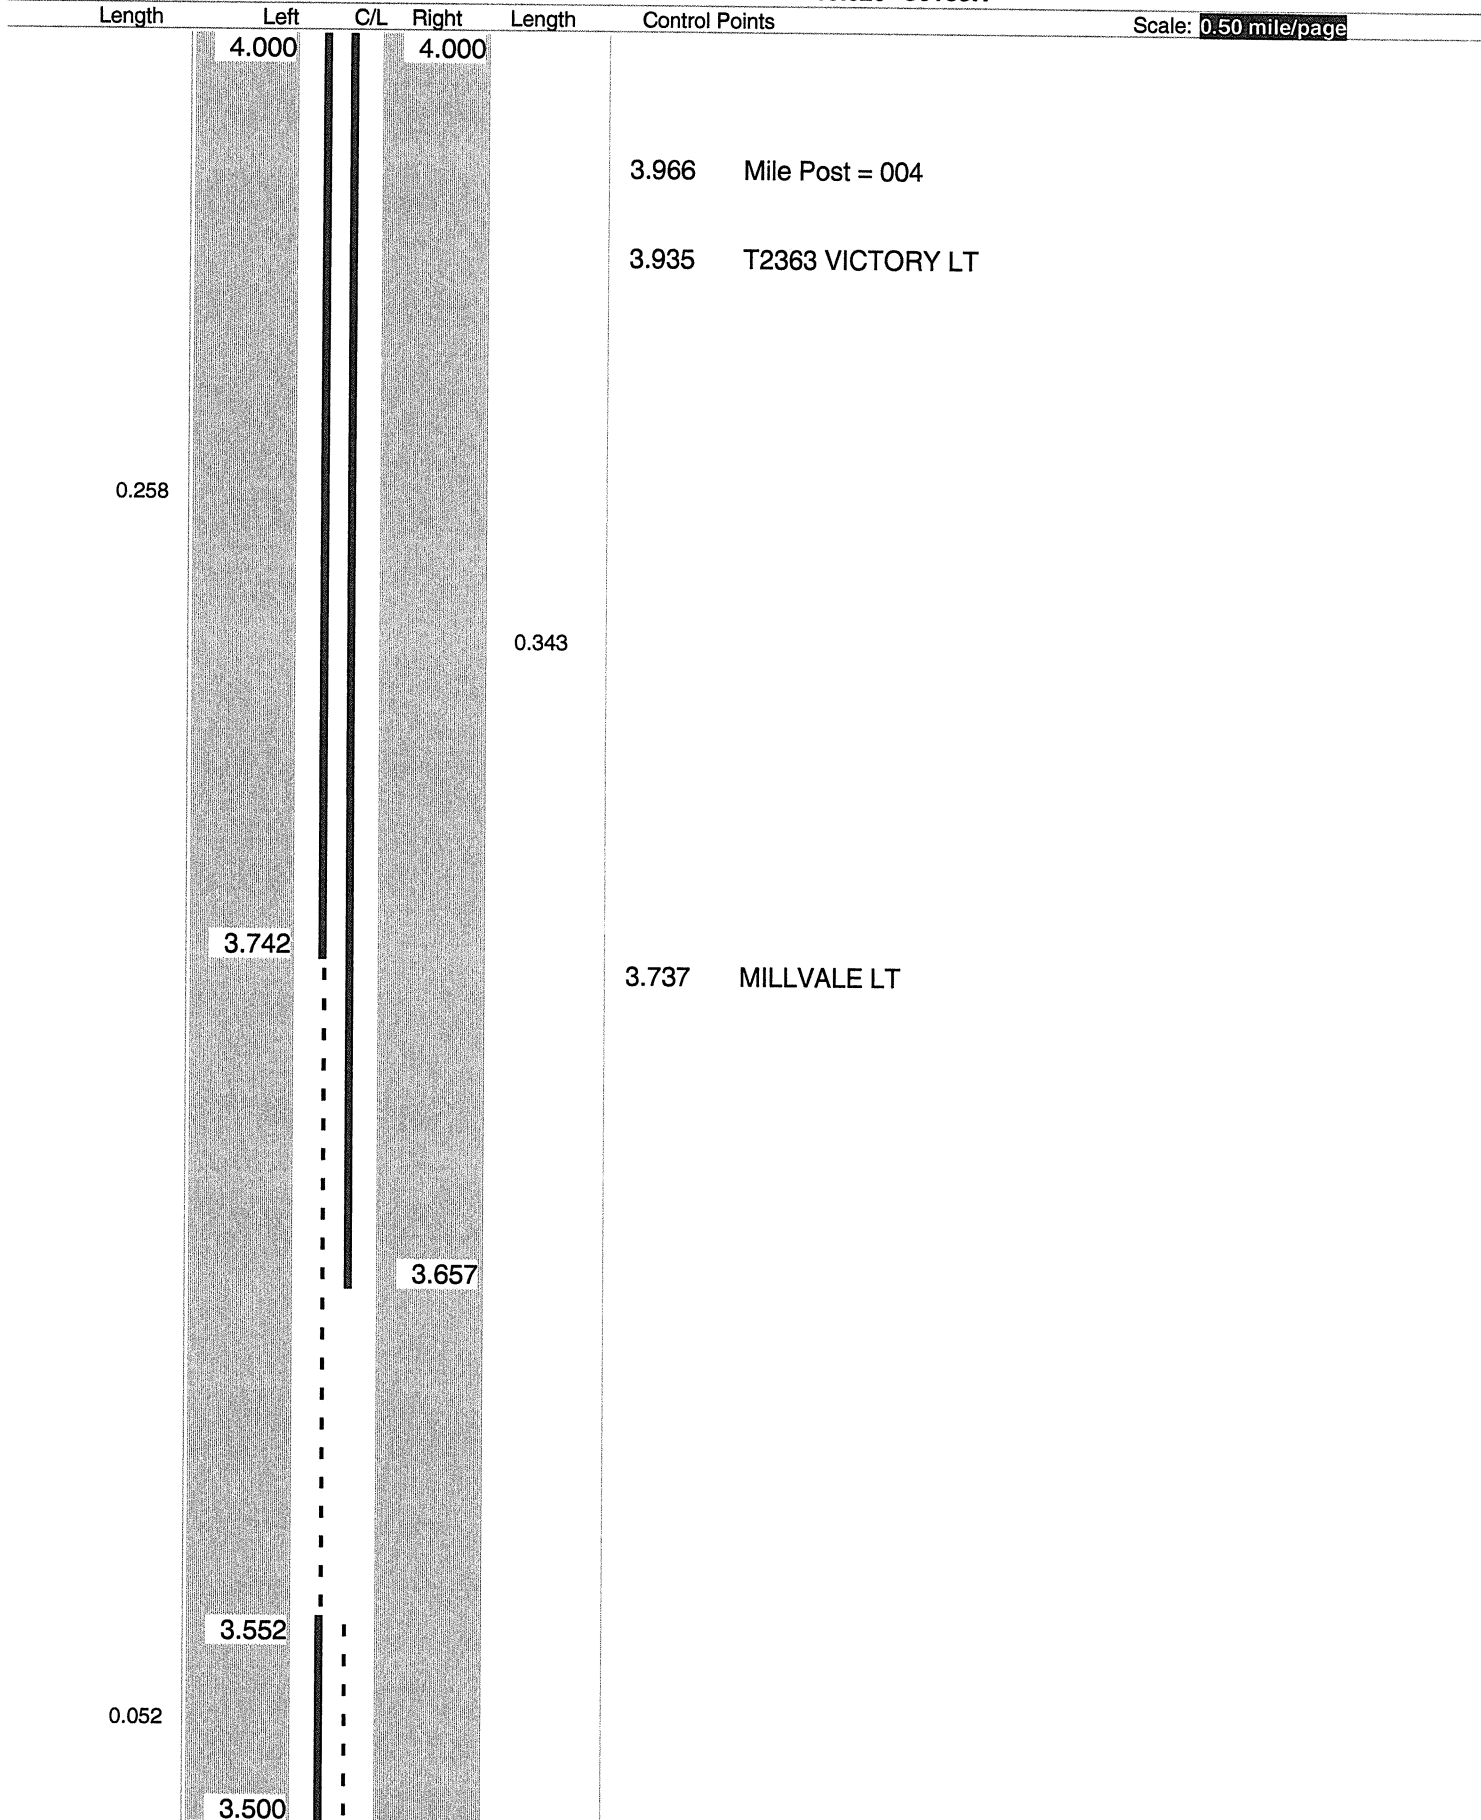

Sheet total equivalent length of solid line: 0.740

Accum. total: 1.246

© 2004 - MasterMind Systems, Inc. - Traffic Safety Suite

ODOT Dist 4 - Stark County - FINAL No Passing Zone Log (STA)

Page: 3 of 15


Route: 0153R (SSTASR00153**C)

Length: 11.736

Direction: East

From: 3.290 RICHMOND

To: 15.026 S0183R

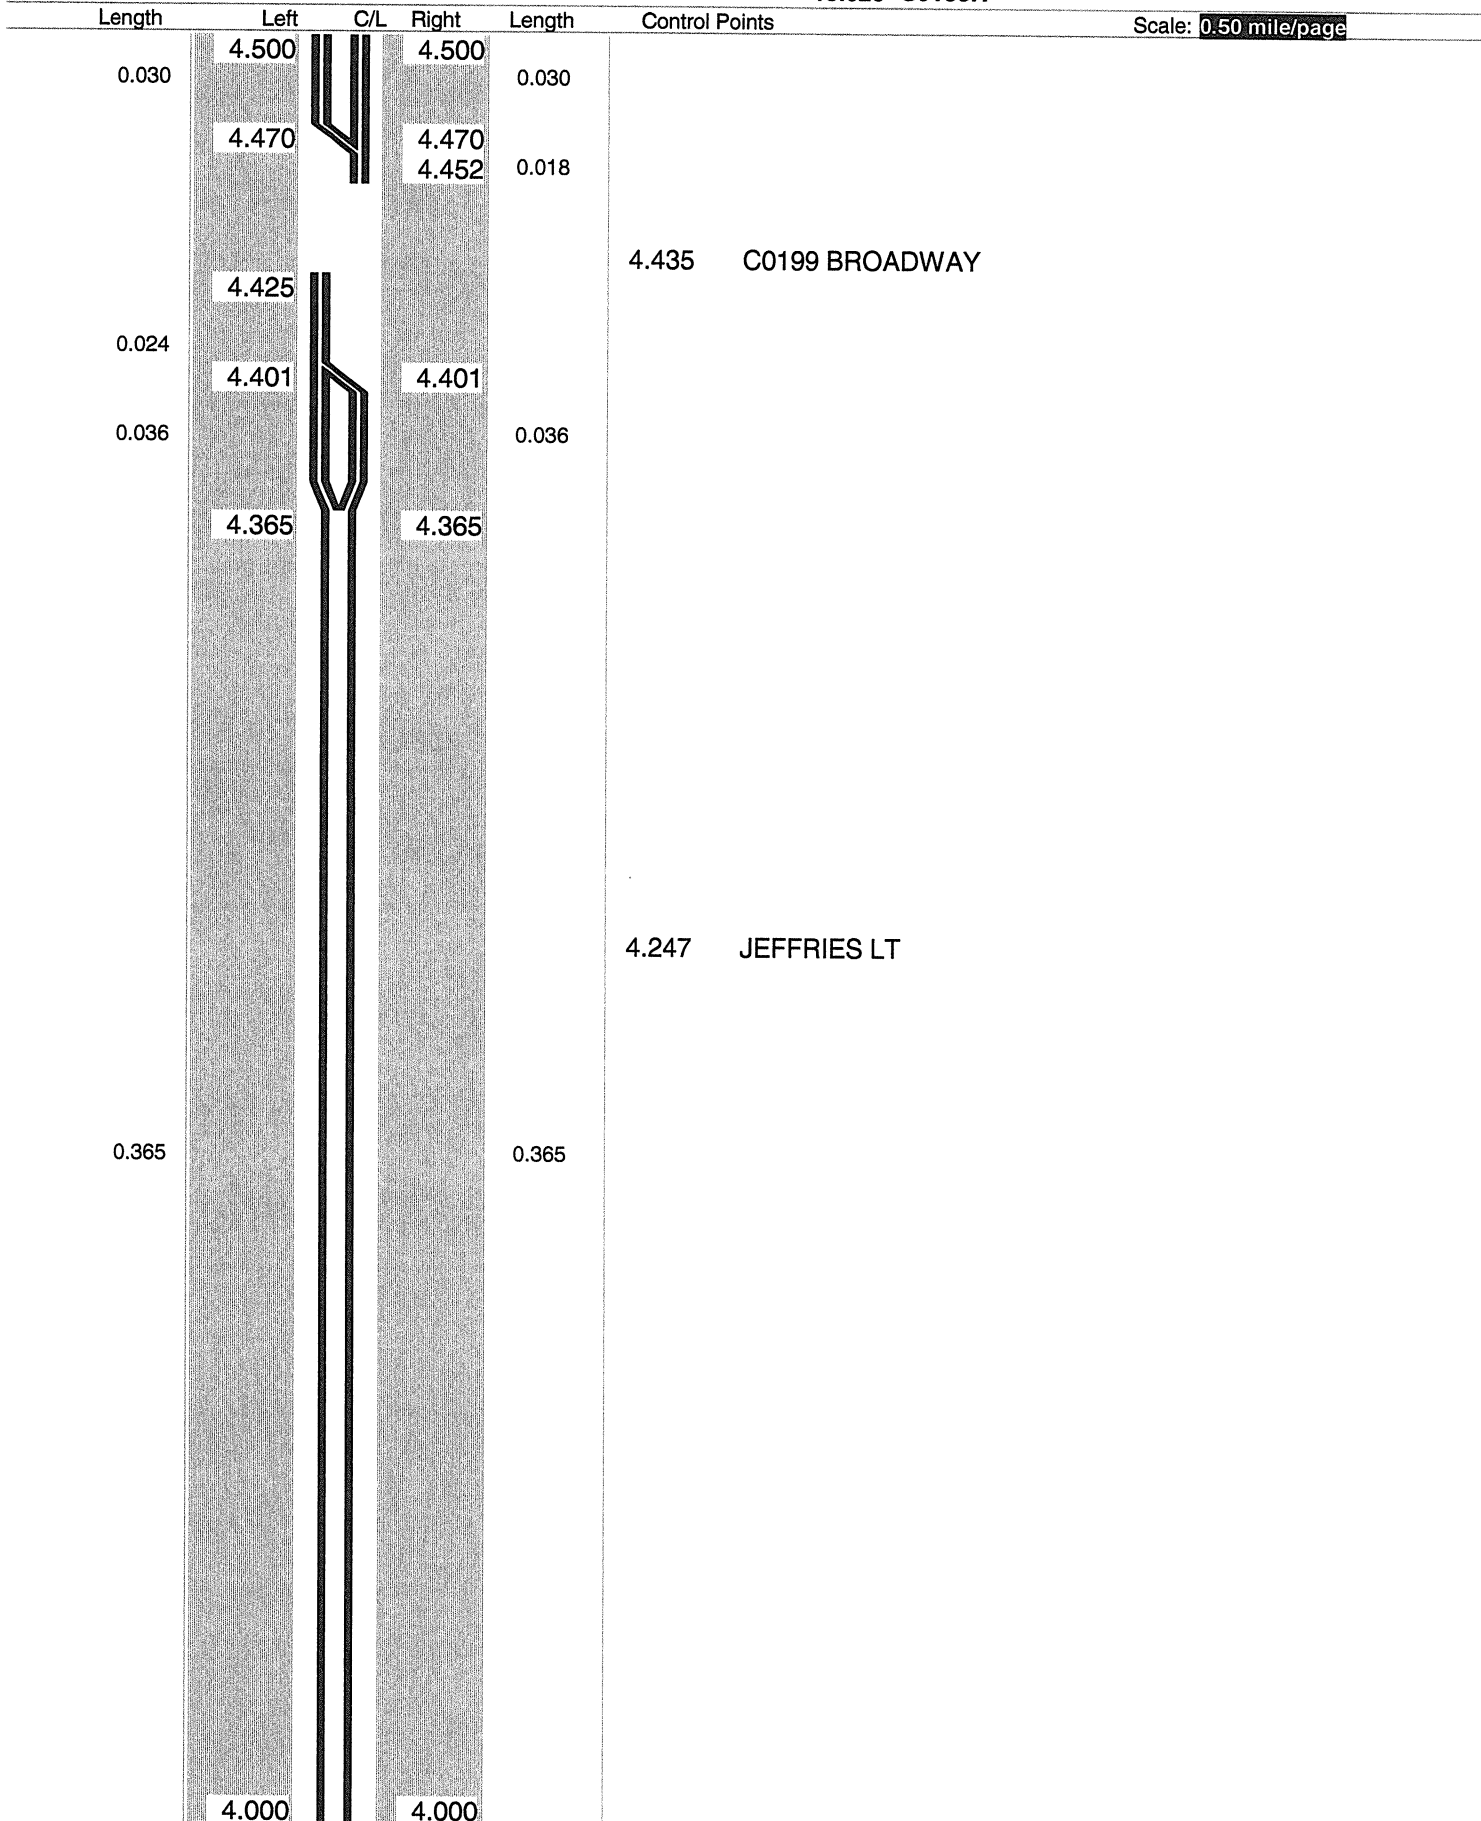

Sheet total equivalent length of solid line: 1.078

Accum. total: 2.324


© 2004 - MasterMind Systems, Inc. - Traffic Safety Suite

ODOT Dist 4 - Stark County - FINAL No Passing Zone Log (STA)

Page: 4 of 15

Route: 0153R (SSTASR00153**C)
Length: 11.736 Direction: East

From: 3.290 RICHMOND
To: 15.026 S0183R

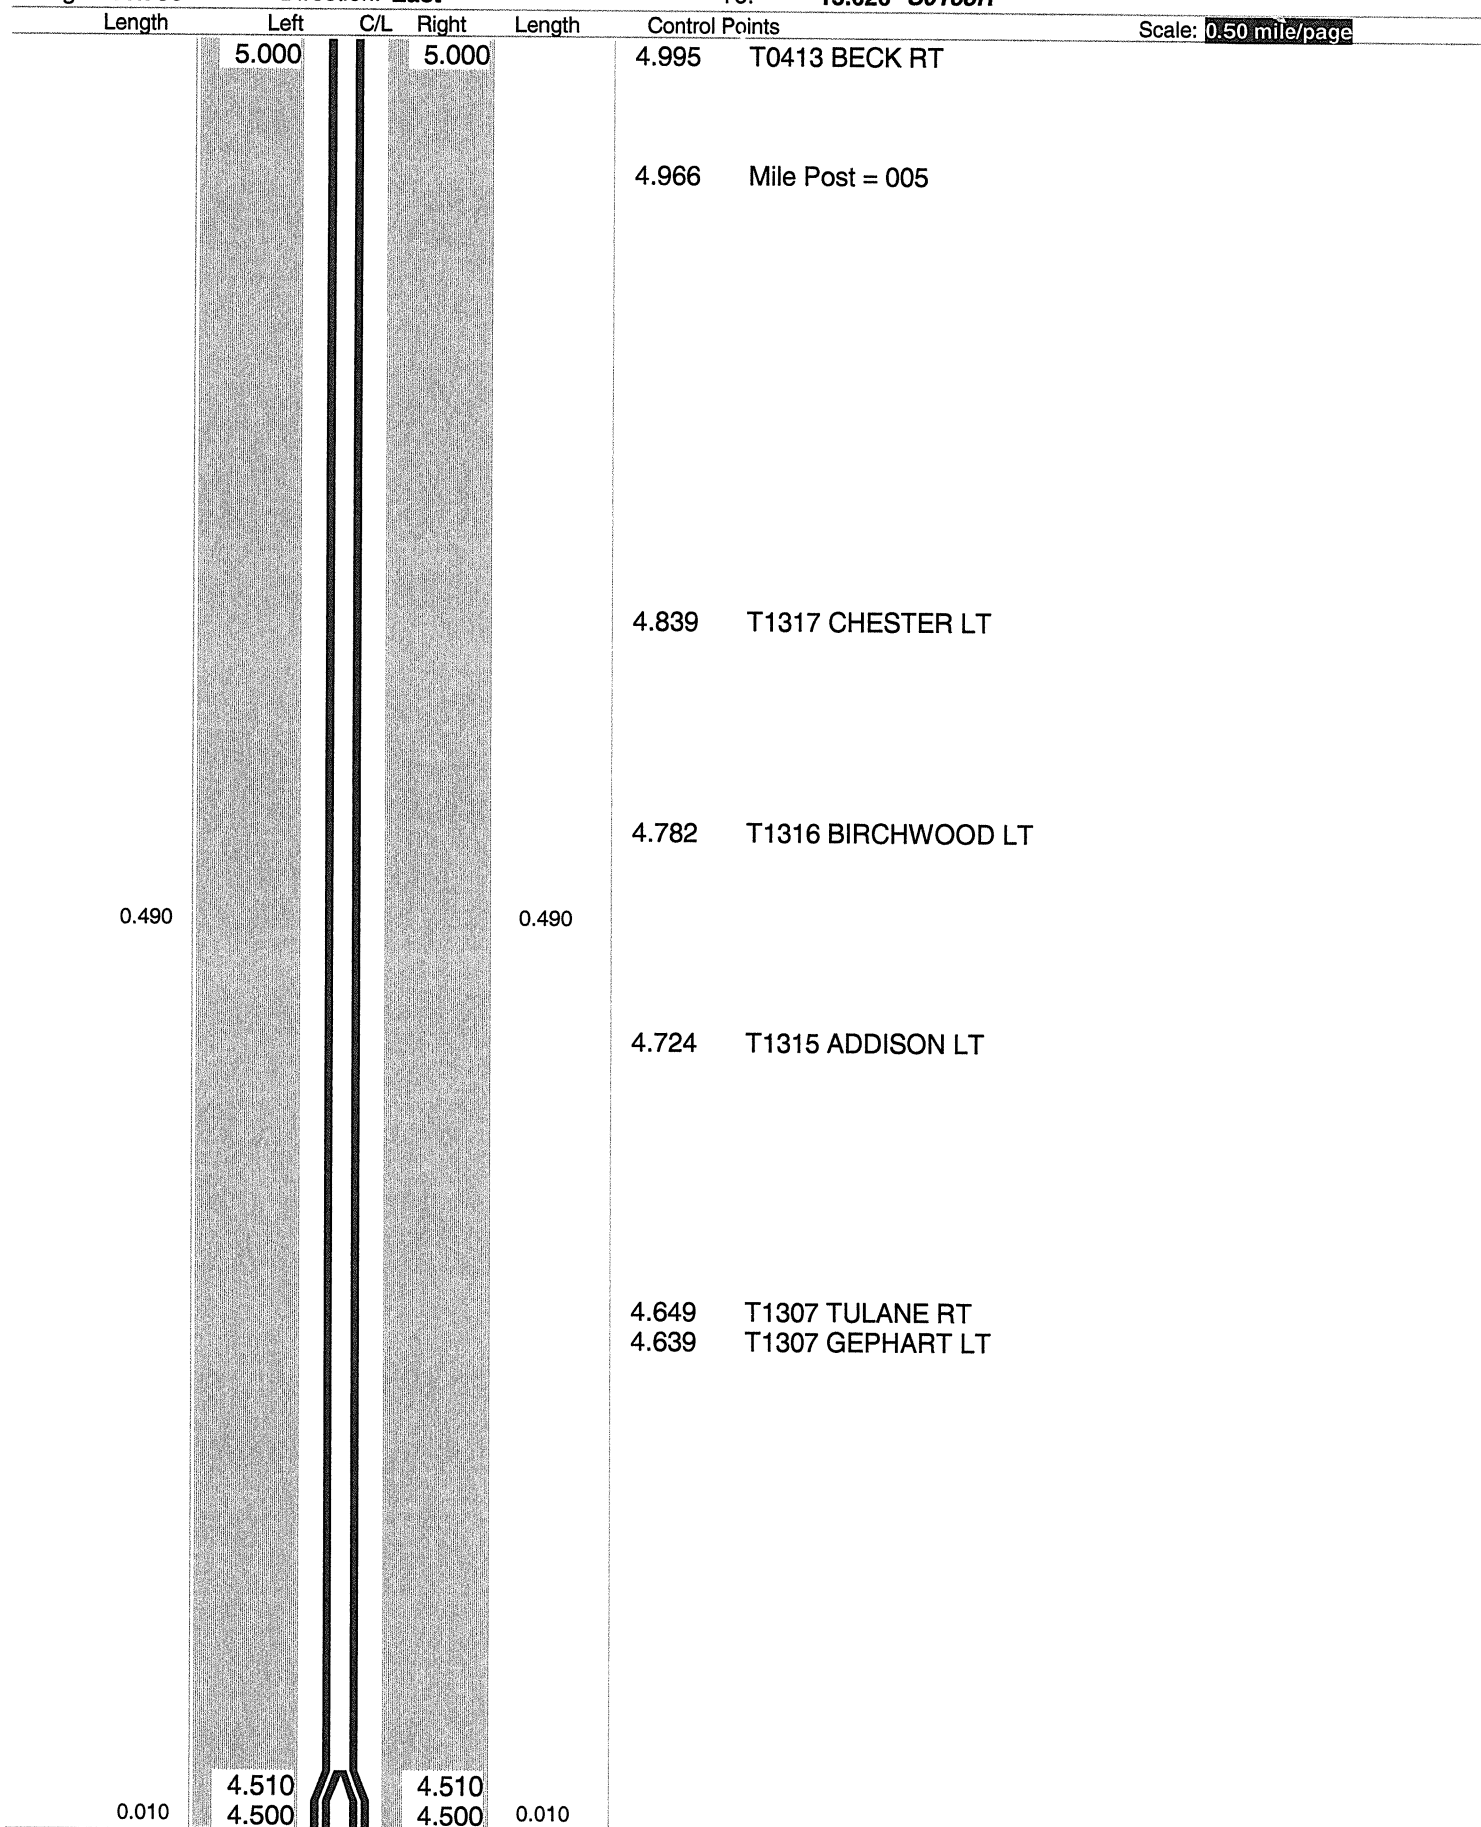

Sheet total equivalent length of solid line: 1.020

Accum. total: 3.344

© 2004 - MasterMind Systems, Inc. - Traffic Safety Suite

ODOT Dist 4 - Stark County - FINAL No Passing Zone Log (STA)

Page: 5 of 15


Route: 0153R (SSTASR00153**C)

Length: 11.736

Direction: East

From: 3.290 RICHMOND

To: 15.026 S0183R

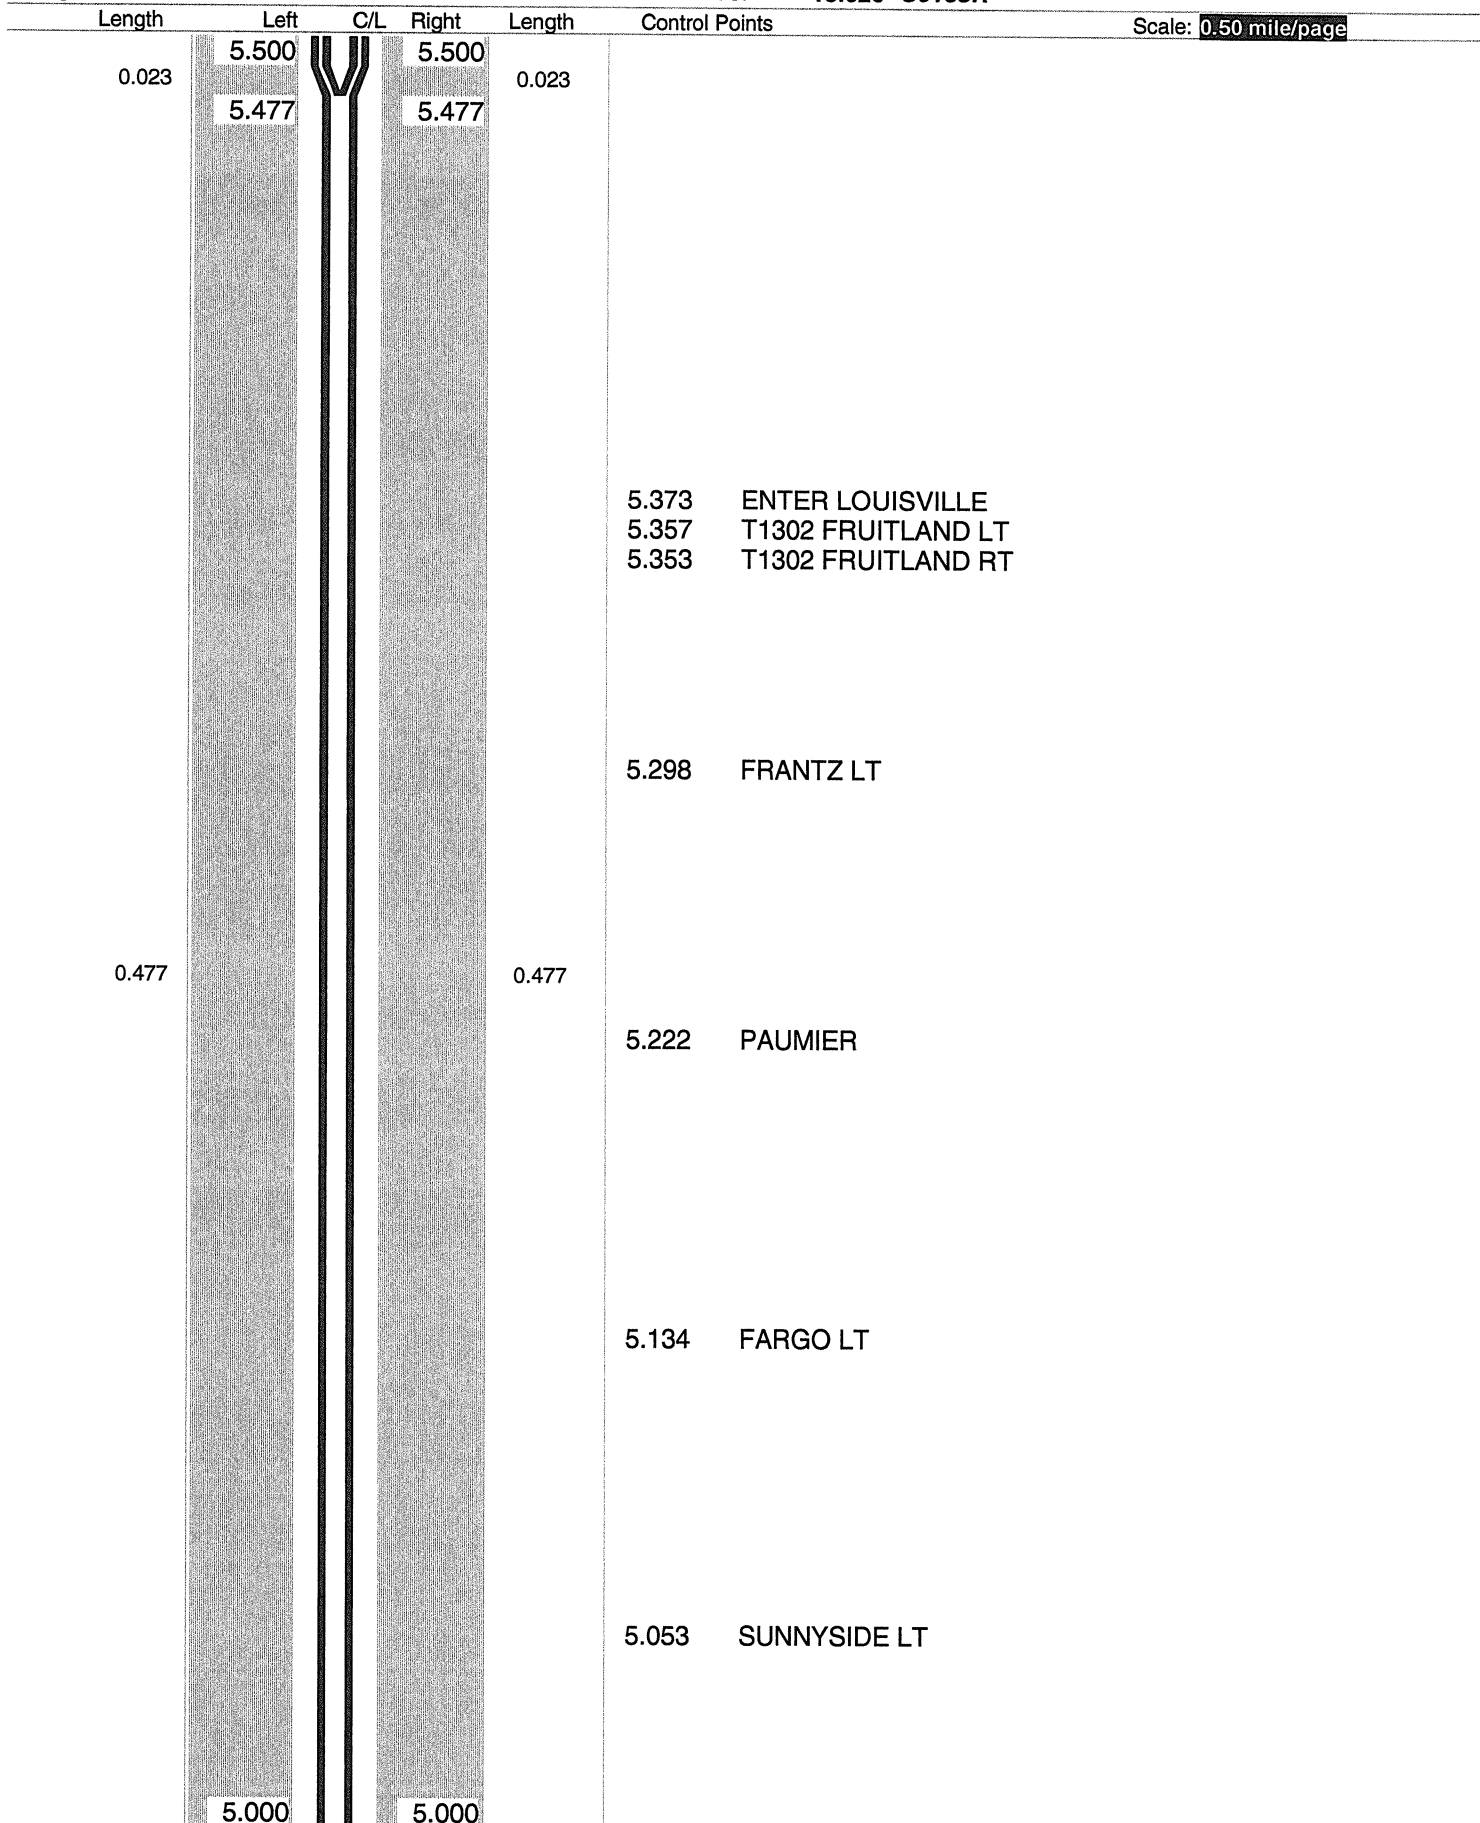

Sheet total equivalent length of solid line: 1.046

Accum. total: 4.390

© 2004 - MasterMind Systems, Inc. - Traffic Safety Suite

No Passing Zone Log (STA)

To: **15.026 S0183R**

Scale: 0.50 mile/page



© 2004 - MasterMind Systems, Inc. - Traffic Safety Suite

ODOT District 4
No Passing Zone Log (STA)

Page: 1 of 8
 7 15

Route: **0153R (SSTASR00153**C)**
 Length: **7.000** Direction: **East**

From: **7.000 LEAVE CANTON**
 To: **14.000 S0183R**

Scale: **1.00 mile/page**

Length	Left	C/L	Right	Length	Control Points	
	8.000		8.000			
					7.915	
					7.890	MIDPINE RT
						↑ 55mph
0.530				0.530		
					7.680	HYLAND RT
					7.560	C0179 MEESE LT
	7.470		7.470		7.470	
					7.470	LEAVE LOUISVILLE
						↑ 45mph

Sheet total equivalent length of solid line: 1.060

Accum. total: 1.060

© 2008 - MasterMind Systems, Inc. - Traffic Safety Suite

ODOT District 4
No Passing Zone Log (STA)

Page: **2** of **8**

8 15

Route: **0153R (SSTASR00153**C)**

From: **7.000 LEAVE CANTON**

Length: **7.000** Direction: **East**

To: **14.000 S0183R**

Scale: **1.00 mile/page**

Length	Left	C/L	Right	Length	Control Points
			9.000		
	8.876				8.875 T0180 MAPLEGROVE
0.129					
	8.747			0.469	8.783 T2831 PINE GROVE RT
	8.585				8.647 FOSTER LT
					8.552 LAKEKNOLL LT
			8.531		
0.228					
			8.408		
	8.357			0.118	8.352 T0178 SWALLEN RT
			8.290		
	8.149				
0.149			8.074		8.079 T0178A ESHELMAN LT
				0.074	
	8.000		8.000		

Sheet total equivalent length of solid line: 1.340

Accum. total: 2.400

ODOT District 4 No Passing Zone Log (STA)

Page: 1 of 1
9 15

Route: 0153R (SSTASR00153**C)

Length: 6.026

Direction: East

From: 9.000 RICHMOND

To: 15.026 S0183R

Scale: 1.00 mile/page

Length Left C/L Right Length

Control Points

0.044

10.000

9.956

9.911

0.125

9.786

9.628

0.176

9.452

9.458

0.458

9.216

9.215 T0180 MAPLEGROVE

0.129

9.123 T2831 PINE GROVE RT

9.087

9.000

Sheet total equivalent length of solid line: 1.148

Accum. total: 1.148

ODOT District 4
No Passing Zone Log (STA)

Page: ~~4~~ of ~~8~~
10 15

Route: **0153R (SSTASR00153**C)**
Length: **7.000** Direction: **East**

From: **7.000 LEAVE CANTON**
To: **14.000 S0183R**

Scale: **1.00 mile/page**

Length	Left	C/L	Right	Length	Control Points
			11.000		
				0.097	
			10.903		
	10.879				
0.116					
	10.763				
			10.709		
				0.116	
			10.593		
	10.532				
0.082					
	10.450				
	10.437		10.437		10.444 C0122 LYNNHAVEN LT
0.063				0.063	
	10.374		10.374		
			10.356		10.367 C0044 PARIS
				0.126	
			10.230		
	10.053				
0.053					
	10.000				

Sheet total equivalent length of solid line: 0.943

Accum. total: 4.091

© 2008 - MasterMind Systems, Inc. - Traffic Safety Suite

Page: ~~5~~ of ~~8~~
11 15

From: 7.000 LEAVE CANTON

Direction: **East**

To: **14.000 S0183R**

Sheet total equivalent length of solid line: 0.679 Accum. total: 4.770 © 2008 - MasterMind Systems, Inc. - Traffic Safety Suite

ODOT District 4 No Passing Zone Log (STA)

Page: 6 of 8

12 15

Route: 0153R (SSTASR00153**C)


Length: 7.000

Direction: East

From: 7.000 LEAVE CANTON

To: 14.000 S0183R

Scale: 1.00 mile/page

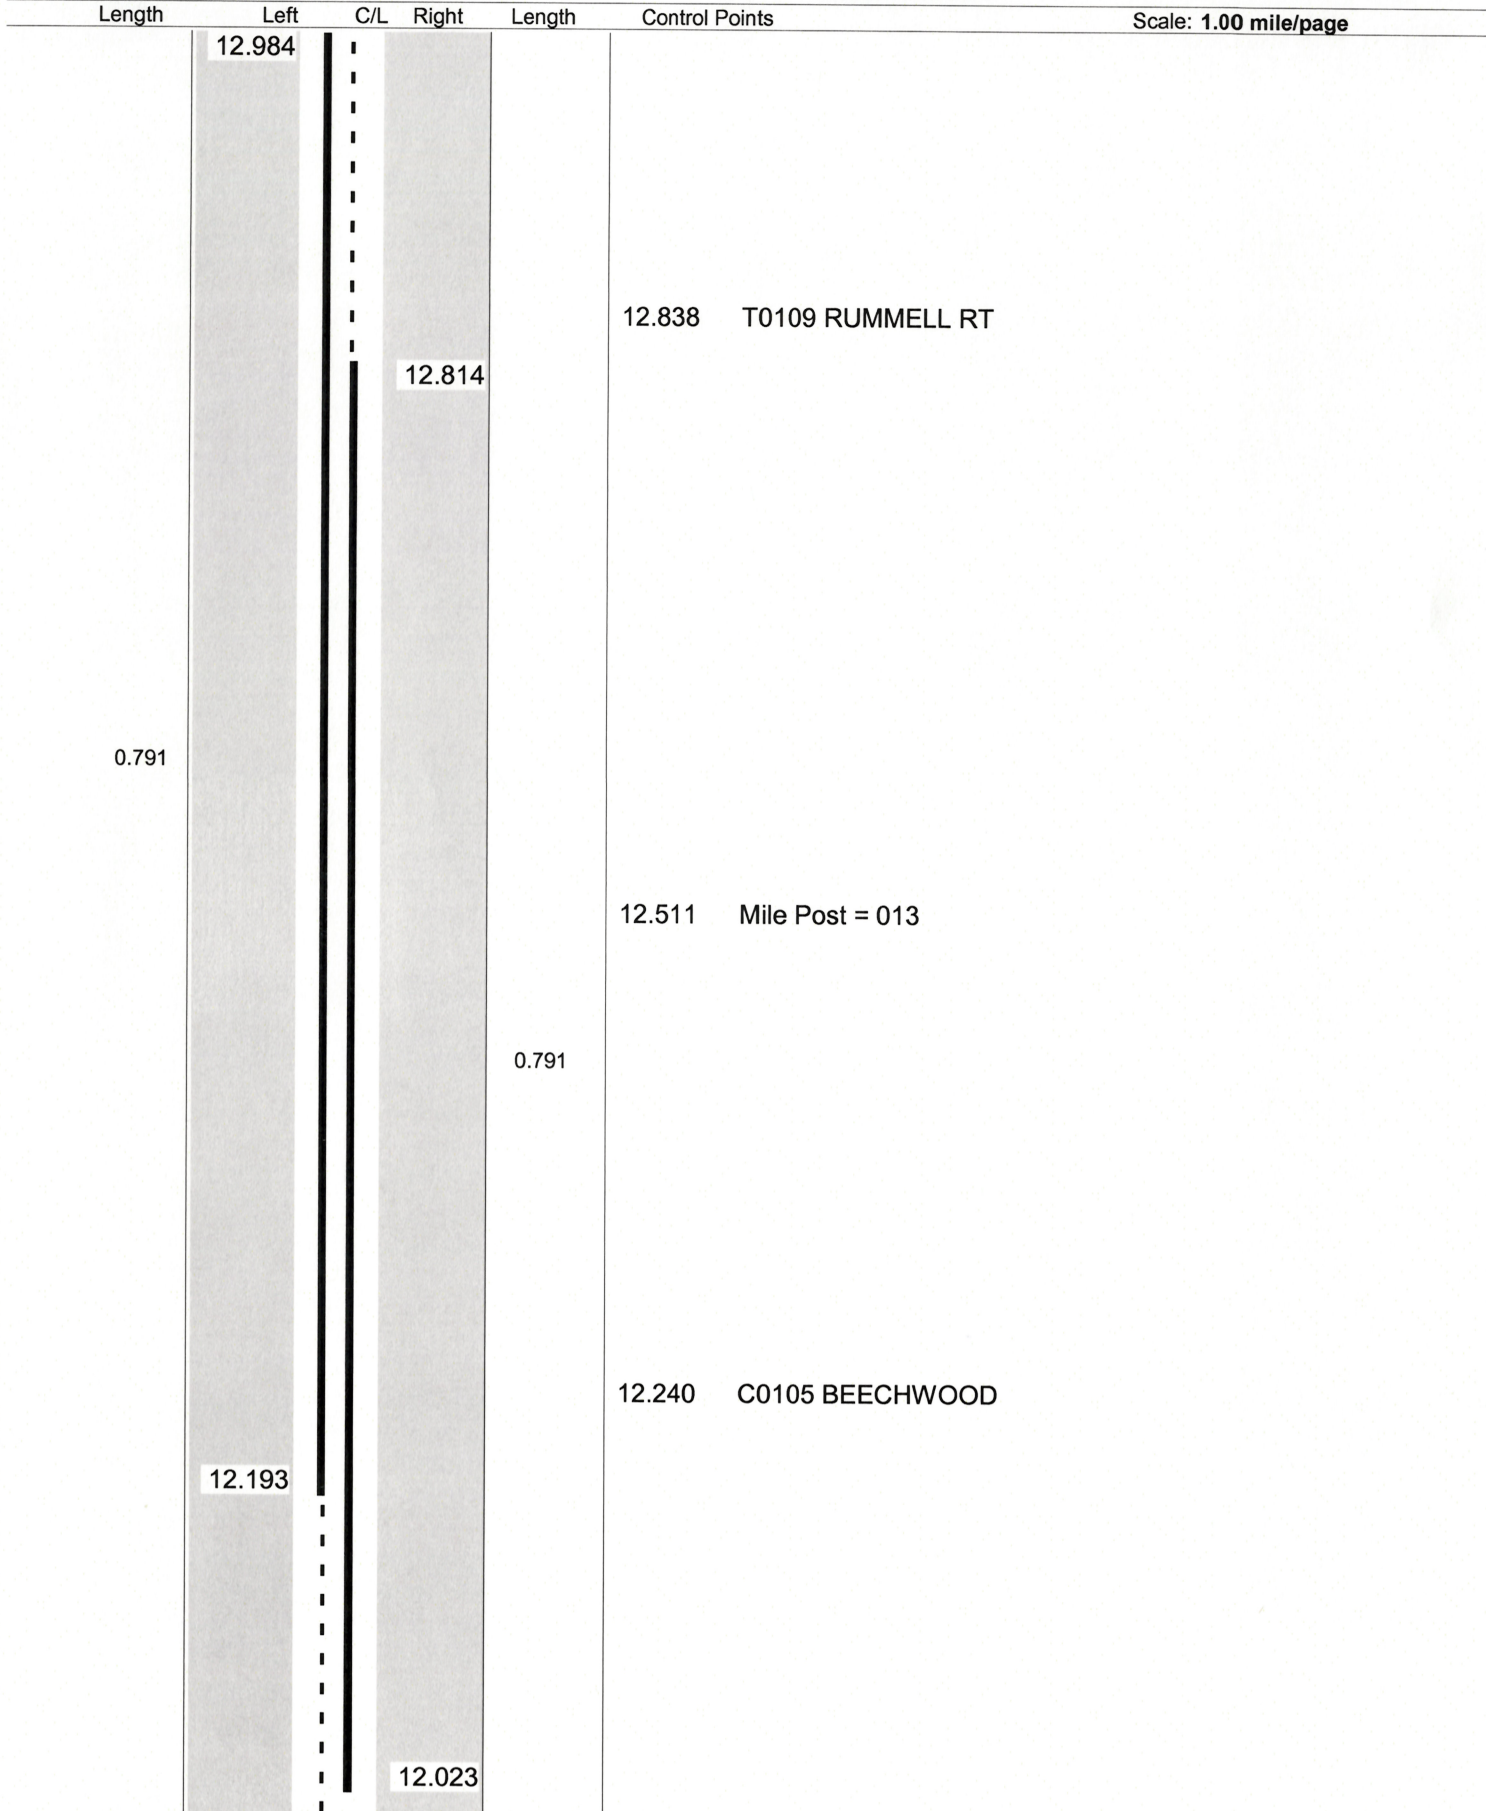

Sheet total equivalent length of solid line: 1.677

Accum. total: 6.447


© 2008 - MasterMind Systems, Inc. - Traffic Safety Suite

ODOT District 4
No Passing Zone Log (STA)

Page: 7 of 8
13 15

Route: **0153R (SSTASR00153**C)**
 Length: **7.000** Direction: **East**

From: **7.000 LEAVE CANTON**
 To: **14.000 S0183R**

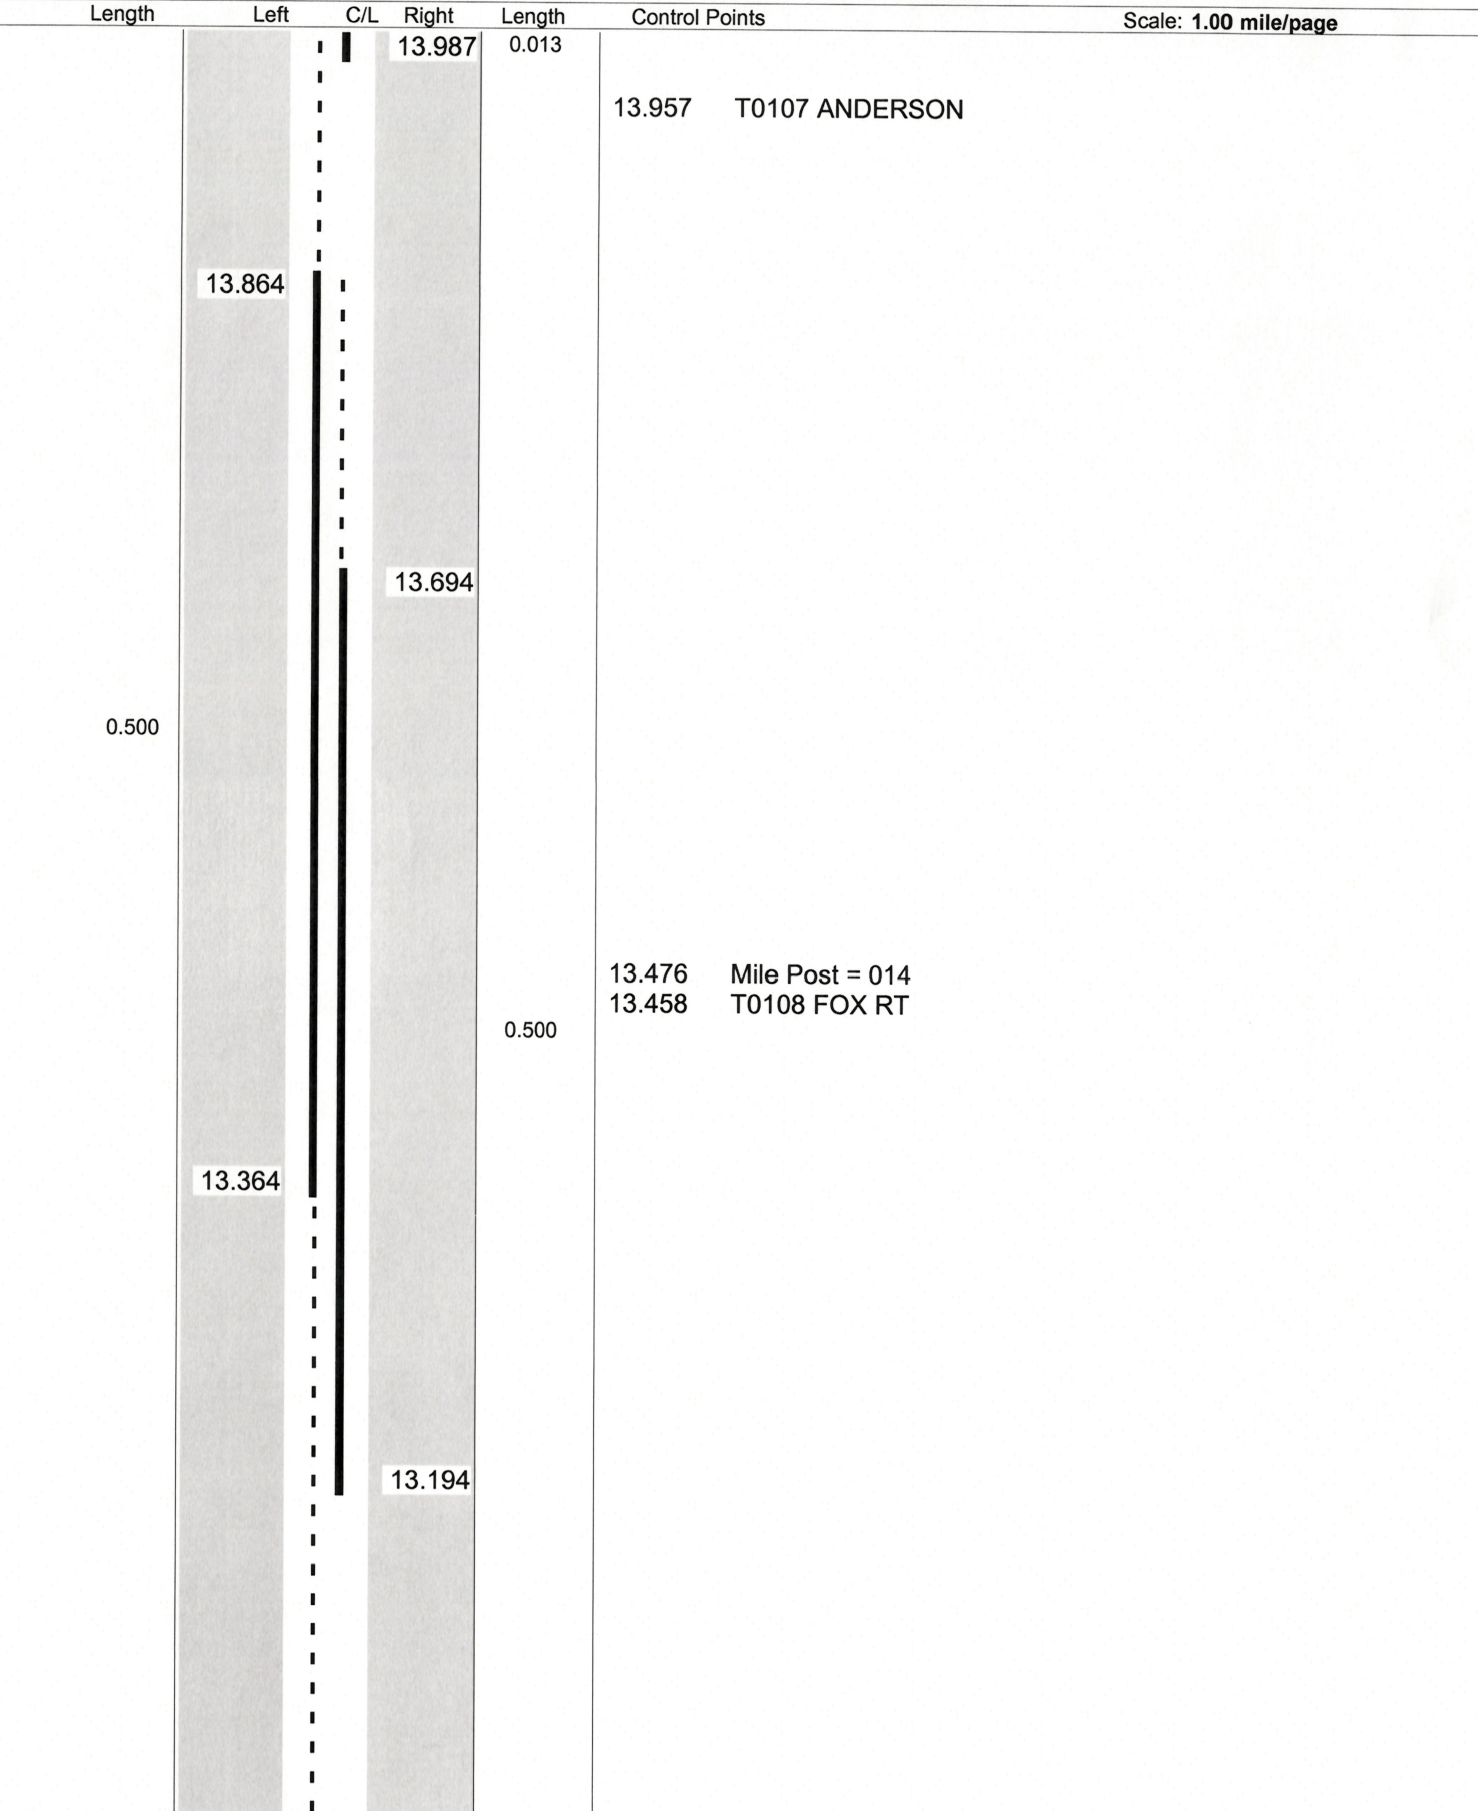

Sheet total equivalent length of solid line: 1.181

Accum. total: 7.628

© 2008 - MasterMind Systems, Inc. - Traffic Safety Suite

ODOT District 4 No Passing Zone Log (STA)

Page: ~~8~~ of ~~8~~

Route: 0153R (SSTASR00153**C)

Length: 7.000

Direction: **East**

From: 7.000 **LEAVE CANTON**

To: **14.000 S0183R**

Length

Left

C/L

Right

Length

Control Points

Scale: 1.00 mile/page

Sheet total equivalent length of solid line: 0.000

Accum. total: 7.628

© 2008 - MasterMind Systems, Inc. - Traffic Safety Suite