


1. PAVEMENT MARKINGS DENOTED WITH ** ARE USED FROM PHASE 2
2. FOR MAINTENANCE OF TRAFFIC LEGEND, SEE SHEET P.64

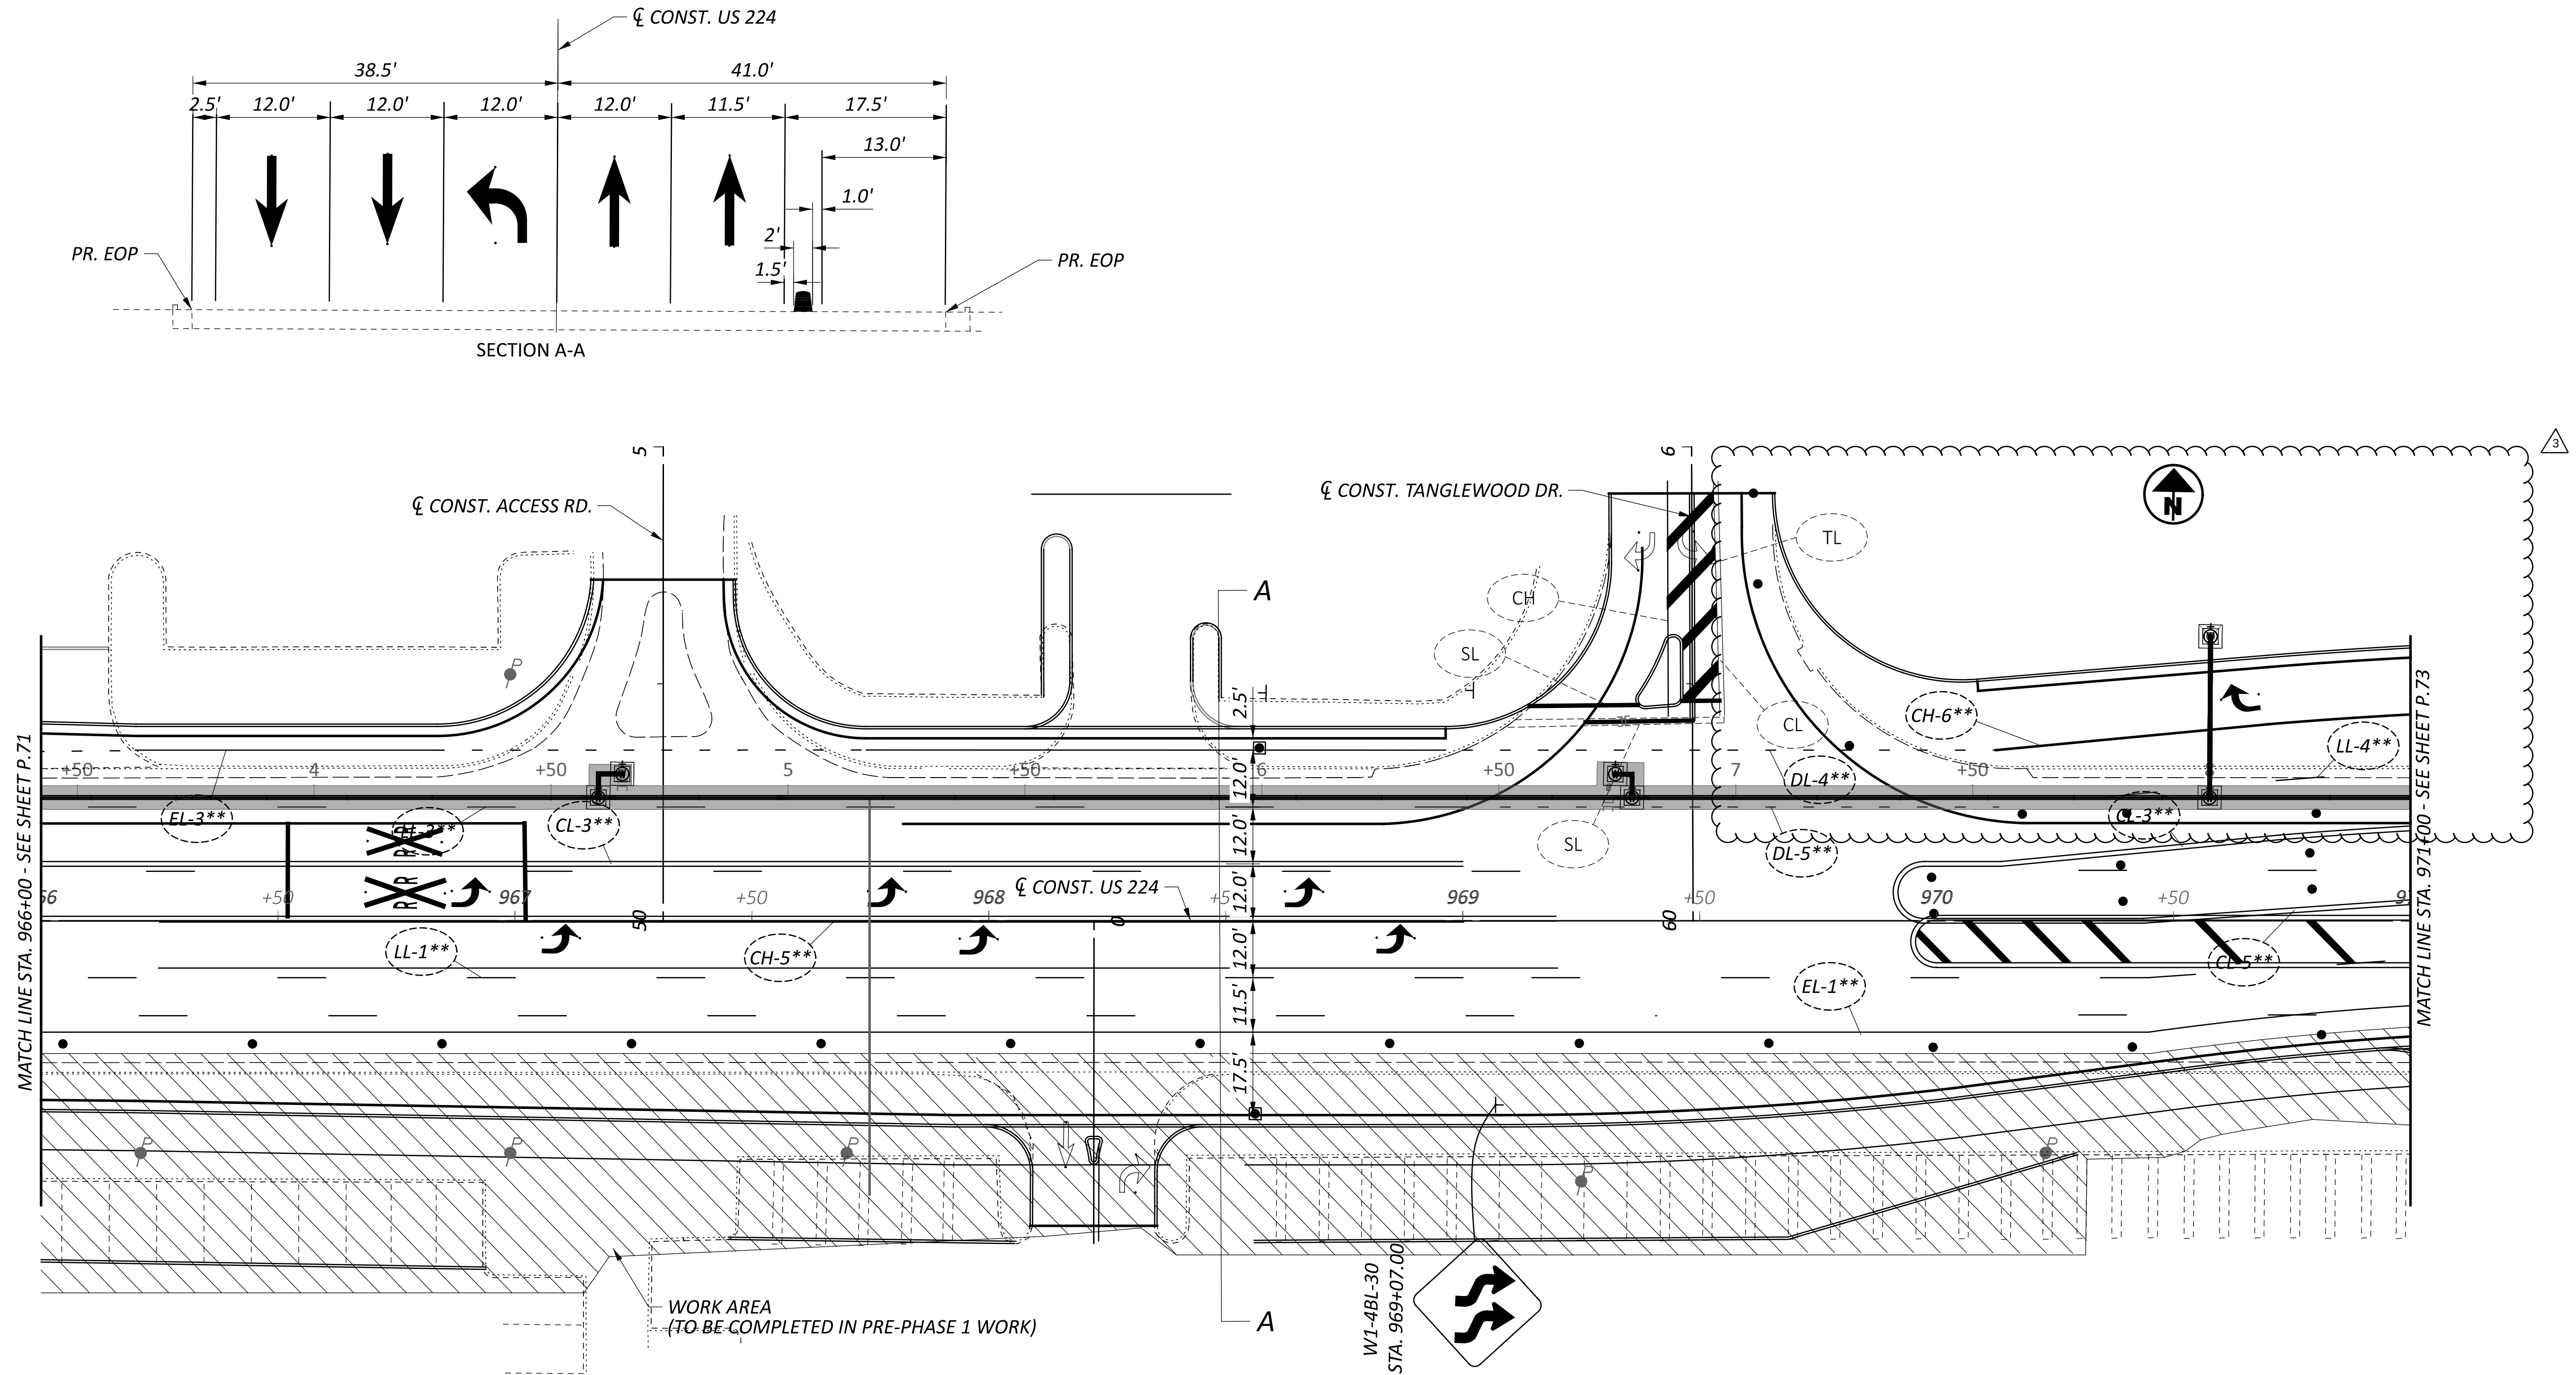

MAINTENANCE OF TRAFFIC - PHASE 2A
STA. 966+00.00 TO STA 971+00.00

DESIGN AGENCY



DESIGNER

MGW

REVIEWER

SA 03/27/26

PROJECT ID


115790

SHEET TOTAL

P.72 | 43

NOTES:

1. PAVEMENT MARKINGS DENOTED WITH ** ARE USED FROM PHASE 2
2. FOR MAINTENANCE OF TRAFFIC LEGEND, SEE SHEET P.64

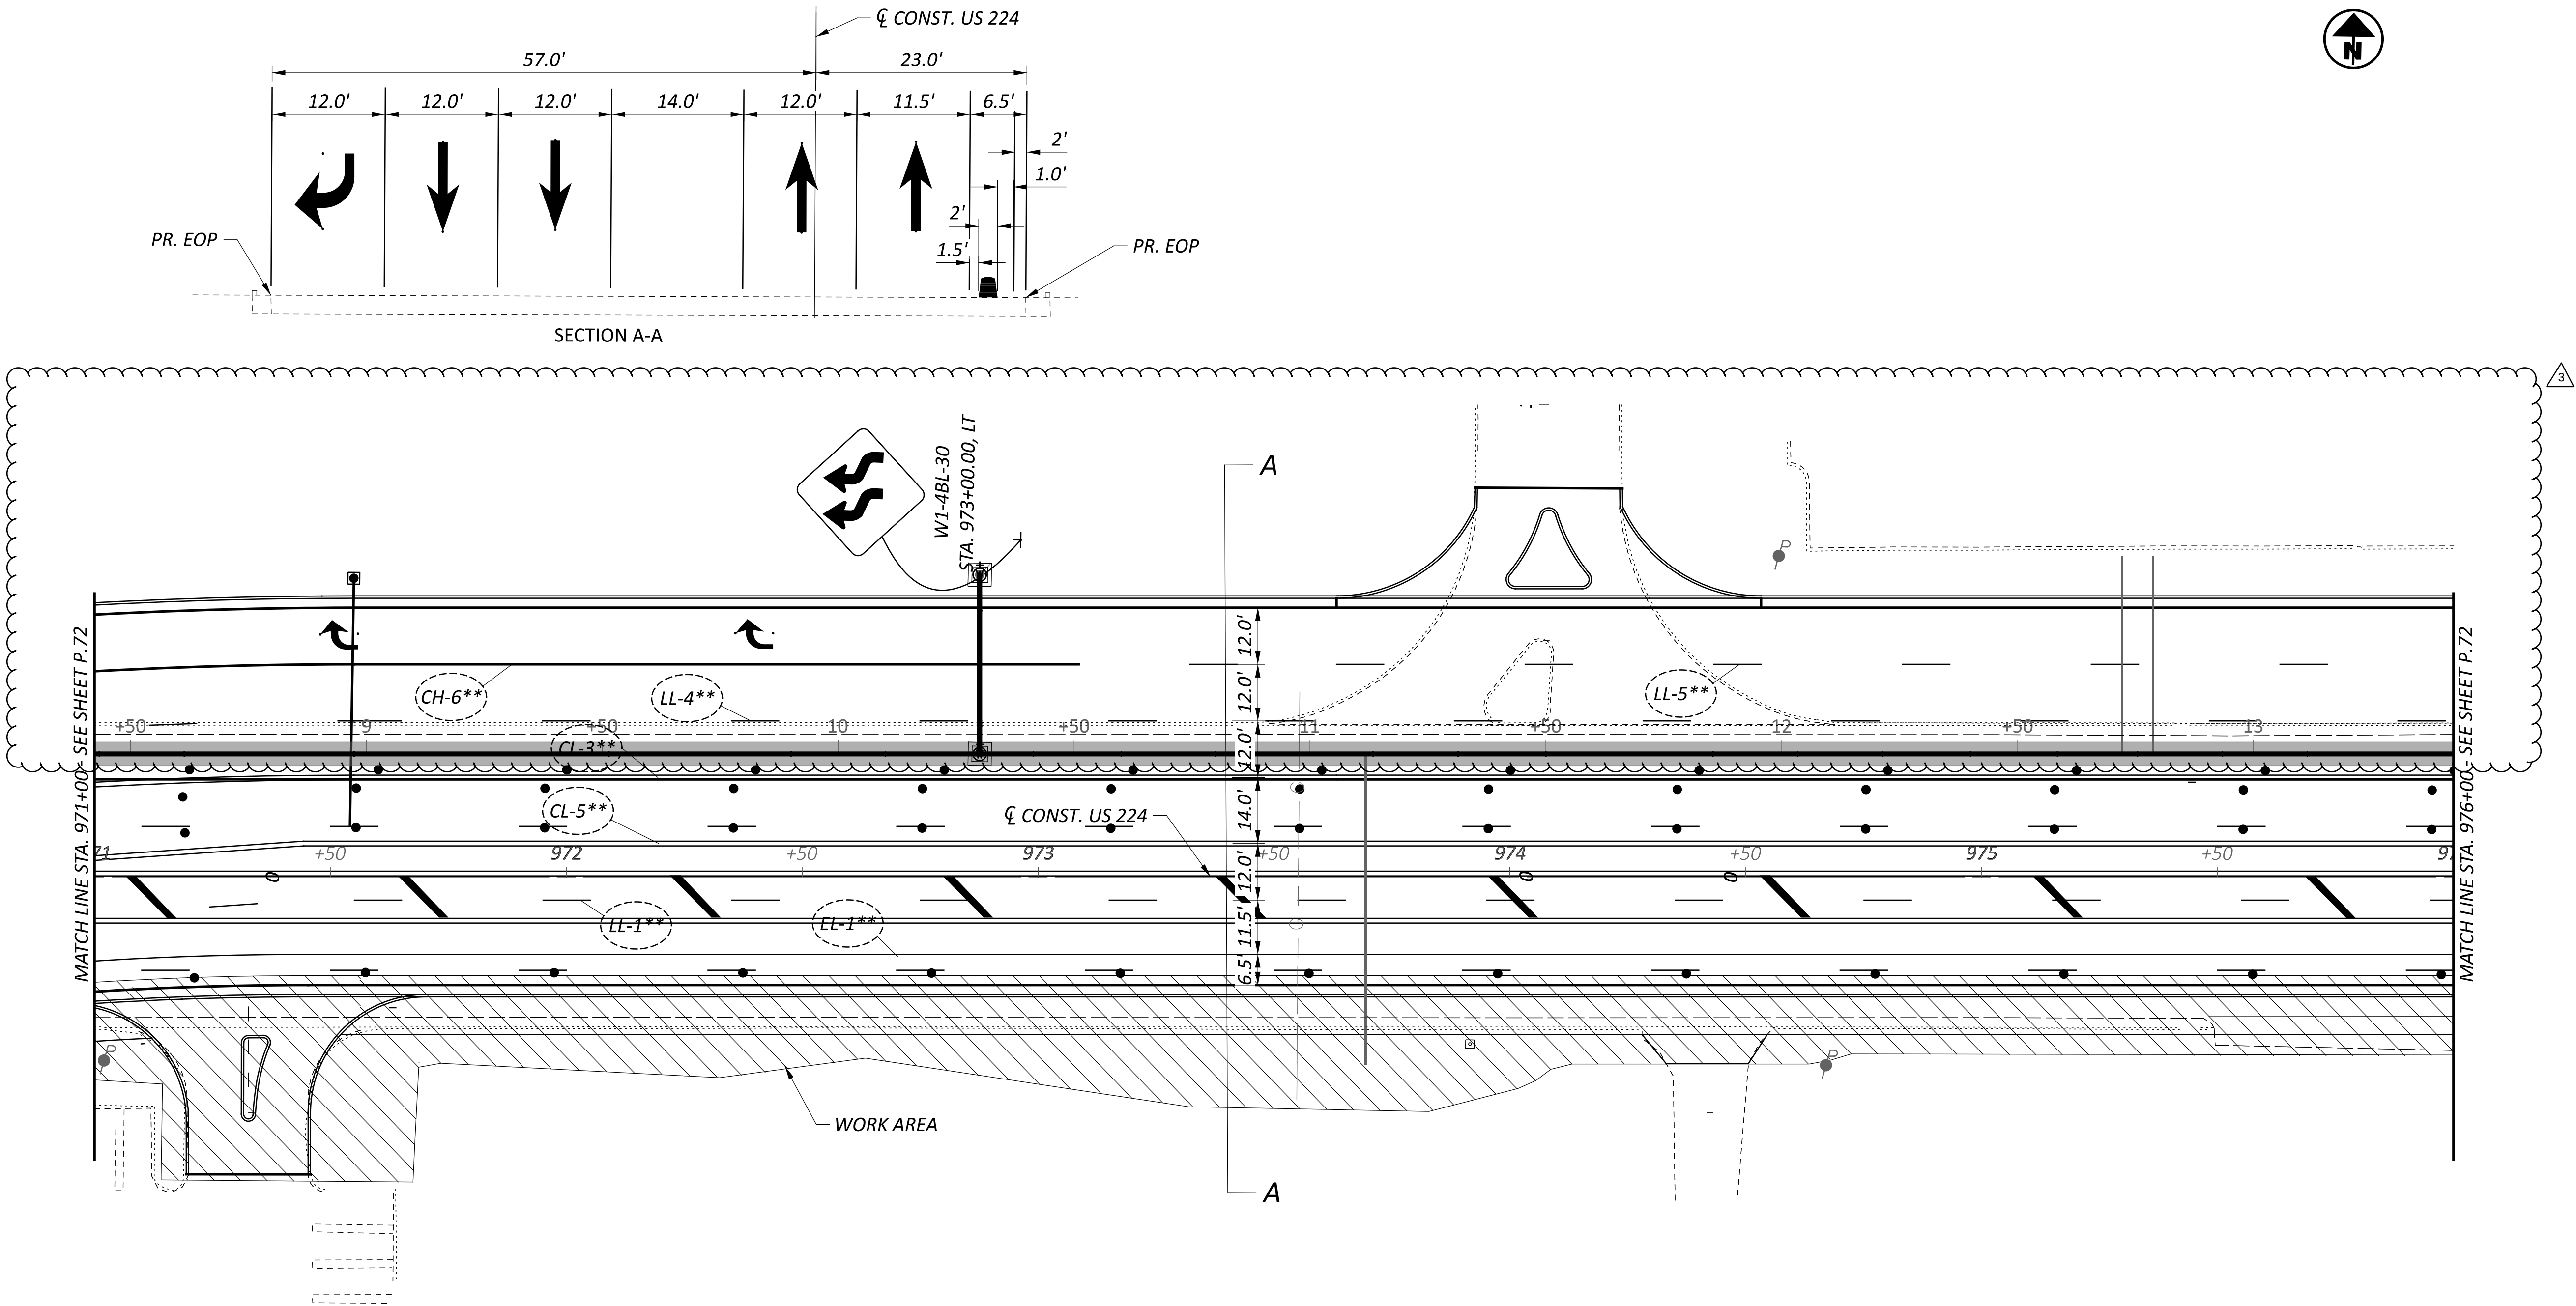

DESIGN AGENCY

PRIME
8415 Pulsar Place Suite 300
Columbus Ohio 43240

DESIGNER

MGW

REVIEWER

SA 03/27/26

PROJECT ID

115790


SHEET

P.73

TOTAL


439

MAINTENANCE OF TRAFFIC - PHASE 2A
STA. 971+00.00 TO STA 976+00.00

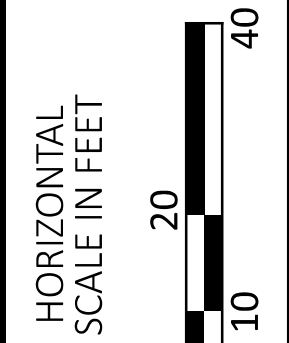


NOTES:

- 1. PAVEMENT MARKINGS DENOTED WITH ** ARE USED FROM PHASE 2
- 2. FOR MAINTENANCE OF TRAFFIC LEGEND, SEE SHEET P.64

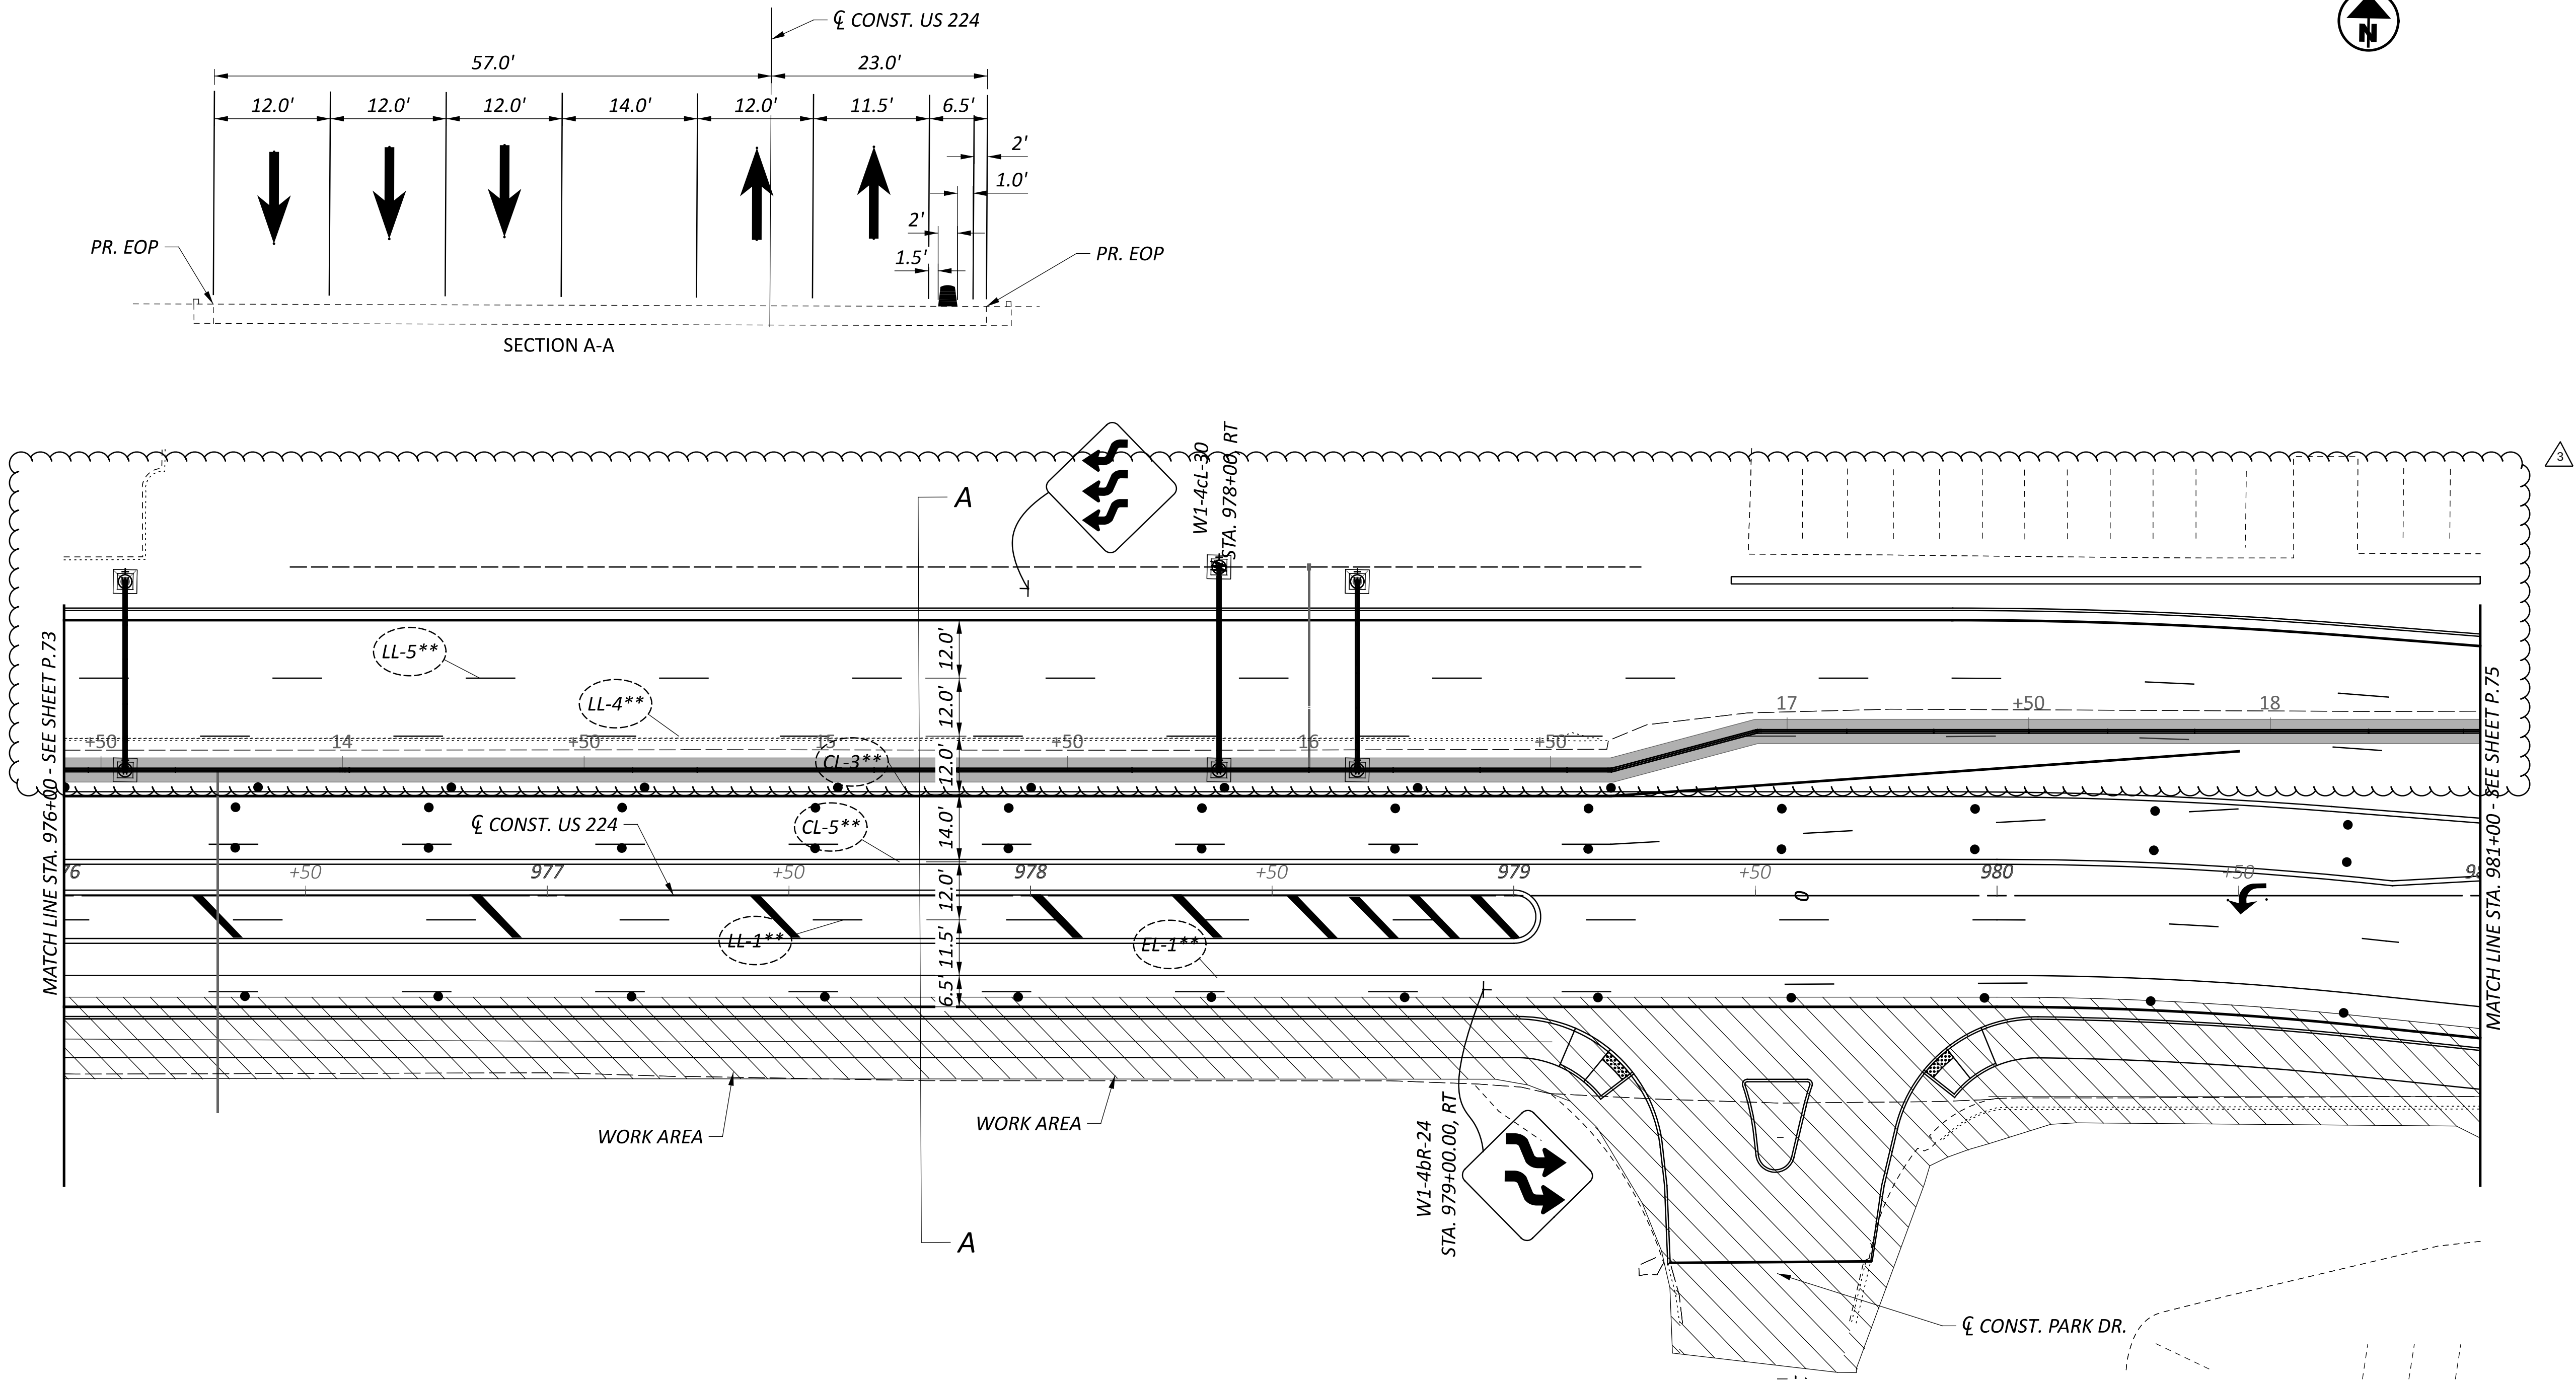

NOTES:

- 1. PAVEMENT MARKINGS DENOTED WITH ** ARE USED FROM PHASE 2
- 2. FOR MAINTENANCE OF TRAFFIC LEGEND, SEE SHEET P.64

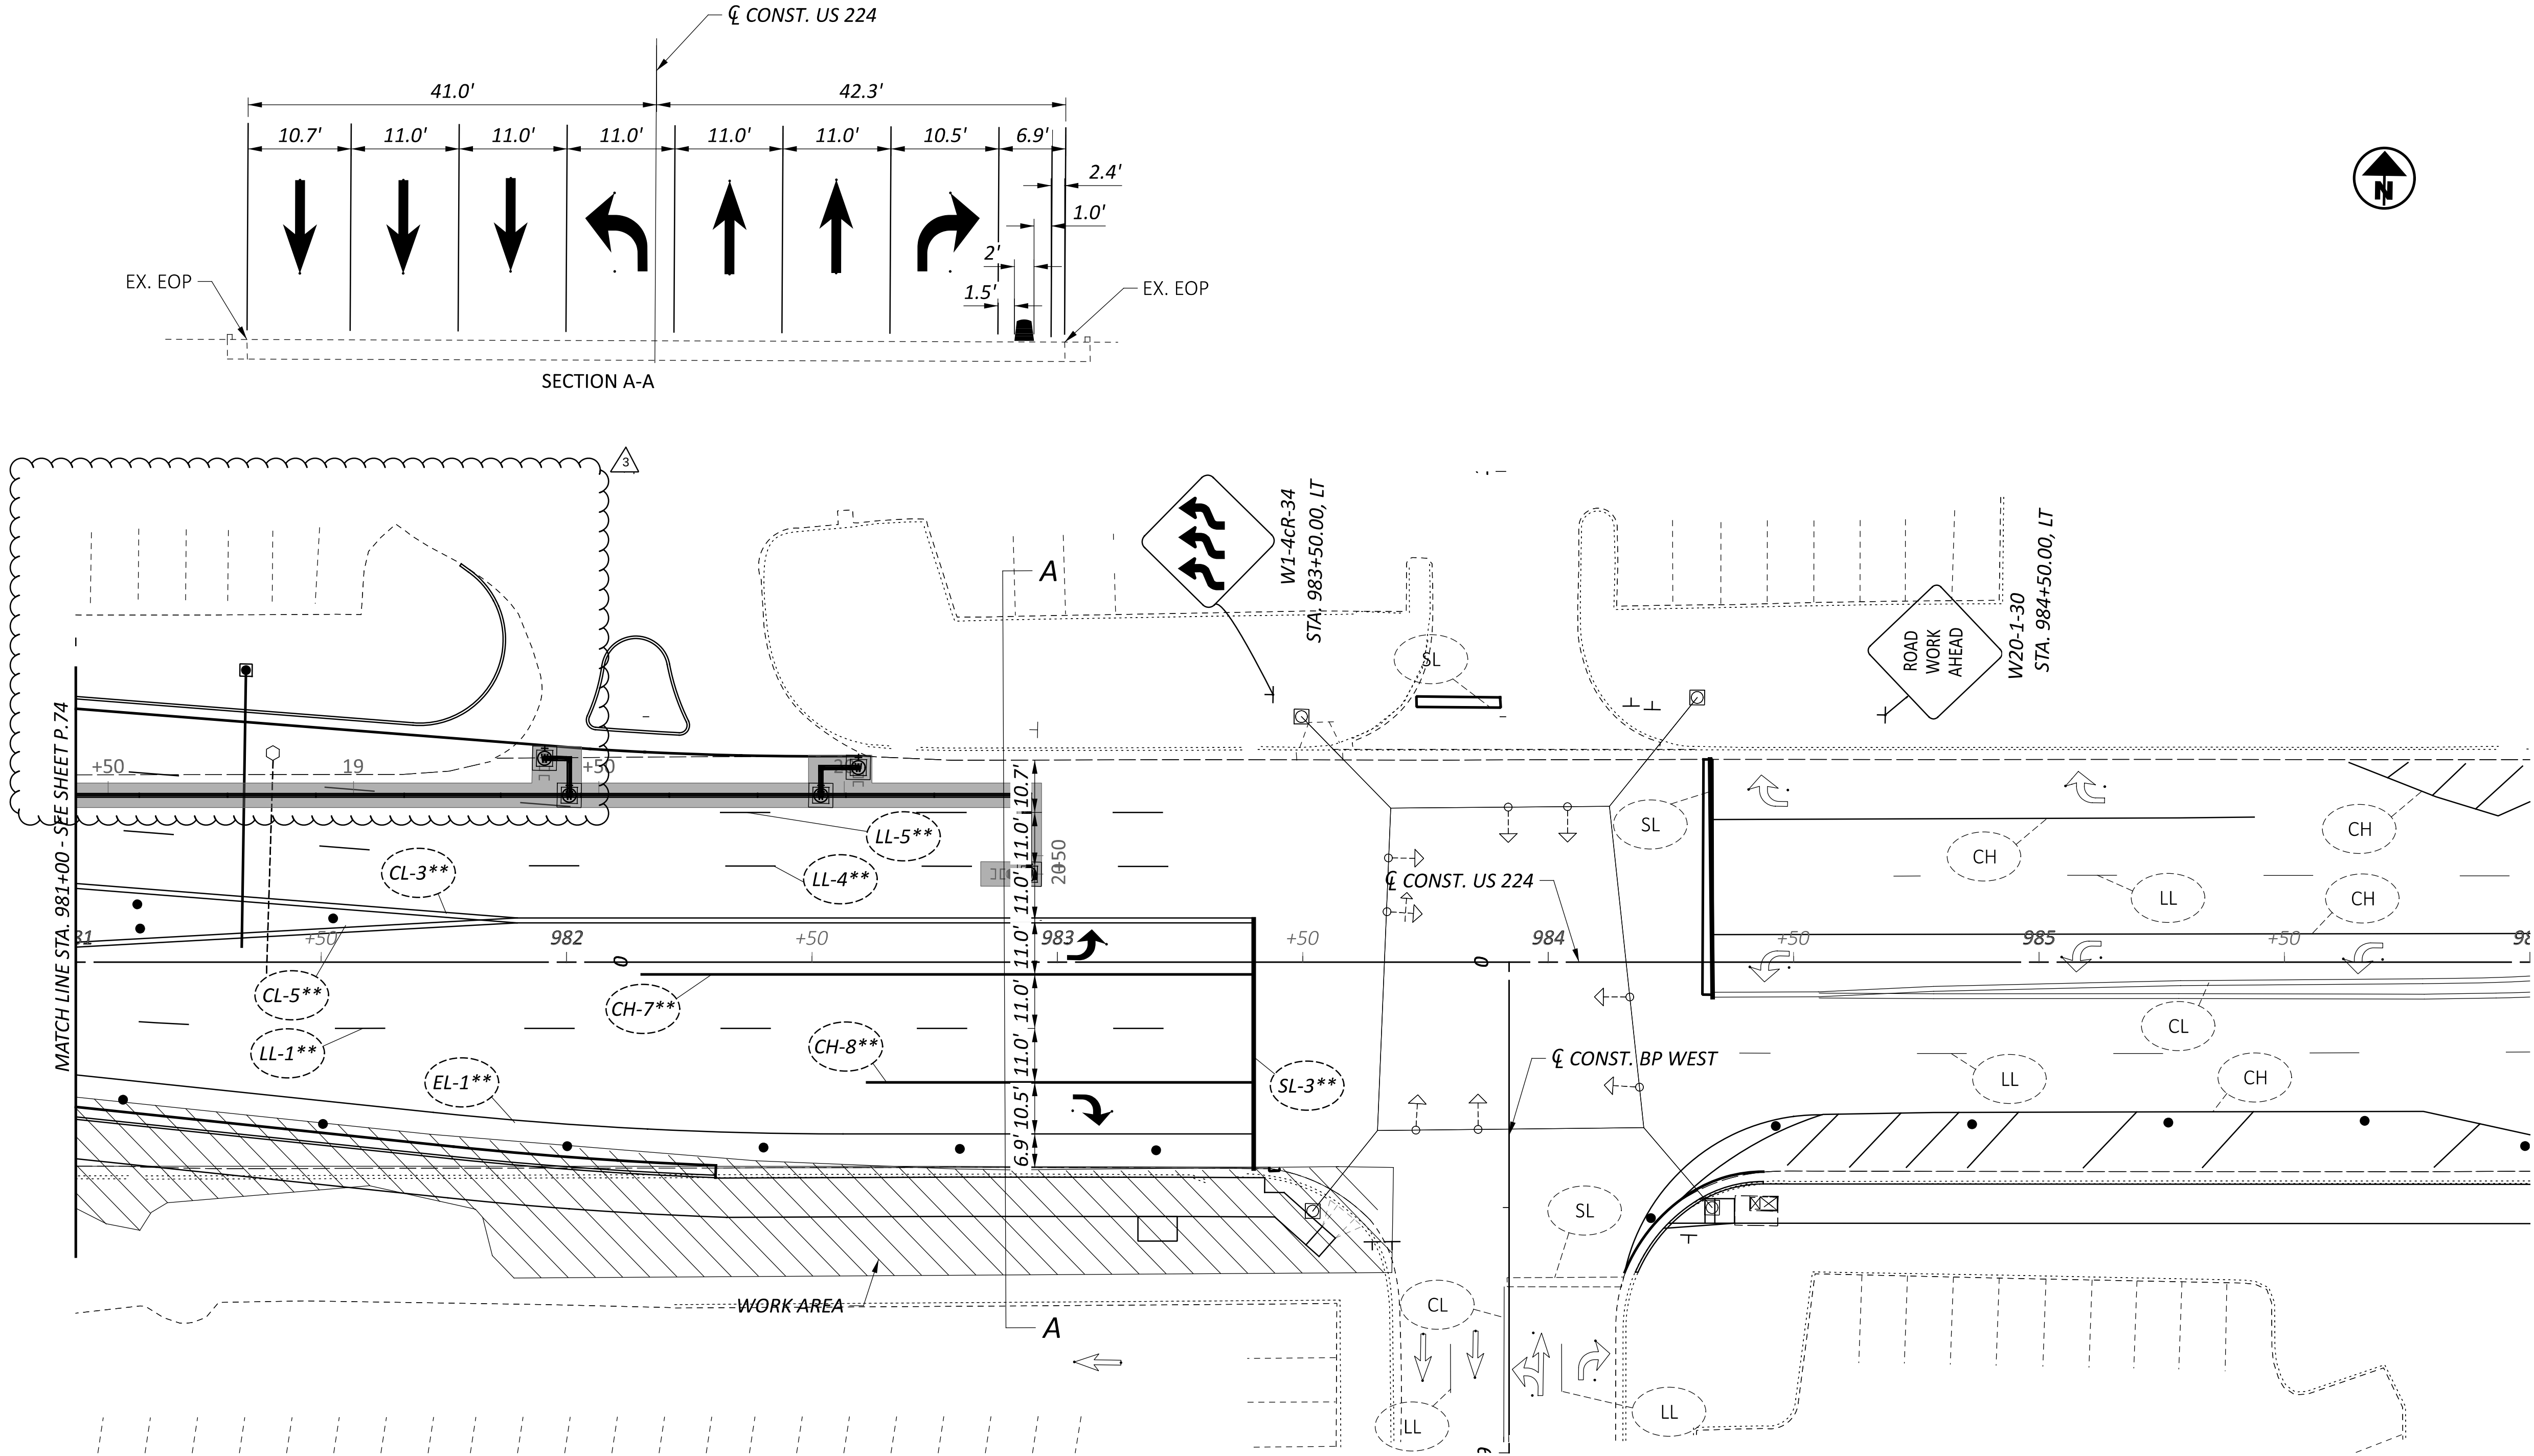

DESIGN AGENCY
PRIME
8415 Pulsar Place Suite 300
Columbus Ohio 43240

DESIGNER
MGW


REVIEWER
SA 03/27/26

PROJECT ID
115790

SHEET
P.75

TOTAL
439

MAINTENANCE OF TRAFFIC - PHASE 2A
STA. 981+00.00 TO STA 986+00.00

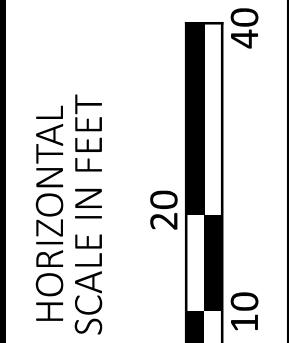

MAH-224-17.72

MODEL: Sheet PAPERSIZE: 34x22 (in.) DATE: 7/13/2026 TIME: 9:50:42 PM PLTDRV: OHDOT_PDF.pltG PENTBL: OHDOT_Pen.tbl USER: macen.whitret@primeeng.com WORKSPACE: OHDOTCEV02 WORKSET: 115790 PRODUCT: OpenRoadsDesigner 24.00.02.25
 www\ohiodot-pw.bentley.com\ohiodot-pw-02\Documents\01 Active Projects\District 04\Mahoning\115790\402-Engineering_PrimeEngineering\Roadway\Sheets\115790_GG001.dgn

SHEET NUMBER														PART.	ITEM	ITEM EXT	GRAND TOTAL	UNIT	DESCRIPTION	SEE SHEET NO.	
P.15	P.16	P.17	P.18	P.19	P.132	P.133	P.134	P.135	P.136	P.137	P.138	P.301	OFFICE CALCS	01/SAF							
																				ROADWAY	
															LS	201	11000	LS		CLEARING AND GRUBBING	
									552	4,766	6,193				11,511	202	23000	11,511	SY	PAVEMENT REMOVED	
									3,747	14,316	430				18,493	202	30000	18,493	SF	WALK REMOVED	
									96						96	202	30600	96	SY	CONCRETE MEDIAN REMOVED	
										81	230				311	202	30800	311	SY	TRAFFIC ISLAND REMOVED	
500									105	1,560	2,667				4,832	202	32000	4,832	FT	CURB REMOVED	
											644				644	202	32001	644	FT	CURB REMOVED, AS PER PLAN	P.19
500									794	4,140	3,468				8,902	202	32500	8,902	FT	CURB AND GUTTER REMOVED	
									73	134	350				557	202	35100	557	FT	PIPE REMOVED, 24" DIAMETER AND UNDER	
											41				41	202	38000	41	FT	GUARDRAIL REMOVED	
									3	11	8				22	202	58100	22	EACH	CATCH BASIN REMOVED	
			100																		
	4,324																				
	1,207																				
	1,207																				
	4																				
	3,623																				
			2,713																		
			2,713																		
								50													
								1													
				450																	
					2,787	30,391	21,749	3,141													
					1,129	997	1,224	122													
		LS																			
LS																					
				</																	


GENERAL SUMMARY

DESIGN AGENCY  PRIMEVA 84115 Pulsar Place Suite 300 Columbus Ohio 43240	
DESIGNER	
MGW	
REVIEWER	
SA	03/27/26
PROJECT ID	
115790	
SHEET	TOTAL
P.127	439

MAH-224-17.72

MODEL: Sheet PAPER:SIZE: 34x22 (in.) DATE: 7/8/2026 AM 10:30:06 PLTRDV: OHDOT_PDF.pltctg PENTBL: OHDOT_Pen.tbl USER: macen.whitrett@primeeng.com WORKSPACE: OHDOTCEv02 WORKSET: 115790 PRODUCT: OpenRoadsDesigner 24.00.02.25
pwc:\ohdot\p-w-bentley.com\ohdot\p-w-02\Documents\01 Active Projects\District 04\Mahoning\115790\402-Engineering_PrimeEngineering_Roadway\Sheets\115790_GG002.dgn

SHEET NUMBER															PART.	ITEM	ITEM EXT	GRAND TOTAL	UNIT	DESCRIPTION		
P.15	P.16	P.17	P.18	P.132	P.133	P.134	P.135	P.139	P.140	P.141	P.142	P.286	P.301	OFFICE CALCS	01/SAF							
																					DRAINAGE	
			1												1	202	98100	1	EACH	REMOVAL MISC.: INSPECTION WELL		
			100												100	202	98200	100	FT	REMOVAL MISC.: CONDUIT		
		6													6	601	21050	6	SY	TIED CONCRETE BLOCK MAT WITH TYPE 1 UNDERLAYMENT		
		15													15	605	05200	15	FT	4" UNCLASSIFIED PIPE UNDERDRAINS		
								937	5,893	5,917	2,285				15,032	605	14020	15,032	FT	6" BASE PIPE UNDERDRAINS WITH GEOTEXTILE FABRIC		
		30													30	611	00406	30	FT	4" CONDUIT, TYPE F		
								79	240	220	180				719	611	00510	719	FT	6" CONDUIT, TYPE F FOR UNDERDRAIN OUTLETS		
											10				10	611	80908	10	FT	8" CONDUIT, TYPE B		
											10				10	611	01800	10	FT	8" CONDUIT, TYPE B		
								21	901	276	475				1,273	611	84408	1,273	FT	12" CONDUIT, TYPE B		
										39					39	611	04600	39	FT	12" CONDUIT, TYPE C		
										350	39				389	611	05900	389	FT	15" CONDUIT, TYPE B		
										10		5			15	611	07400	15	FT	18" CONDUIT, TYPE B		
										5					5	611	10400	5	FT	24" CONDUIT, TYPE B		
			100												100	611	97400	100	FT	CONDUIT, MISC.: TYPE C FOR DRAINAGE DISCHARGE CONTINUANCE		
			100												100	611	97400	100	FT	CONDUIT, MISC.: TYPE B FOR DRAINAGE DISCHARGE CONTINUANCE		
			100												100	611	97400	100	FT	CONDUIT, MISC.: TYPE F FOR DRAINAGE DISCHARGE CONTINUANCE		
								2	8	3	2				15	611	98150	15	EACH	CATCH BASIN, NO. 3		
								1							1	611	98151	1	EACH	CATCH BASIN, NO. 3, AS PER PLAN		
									6	10	6				22	611	98180	22	EACH	CATCH BASIN, NO. 3A		
										2					2	611	98470	2	EACH	CATCH BASIN, NO. 2-2B		
										1	2				3	611	98630	3	EACH	CATCH BASIN ADJUSTED TO GRADE		
											1				1	611	98710	1	EACH	INLET, NO. 2-6		
										12	7	6			25	611	99574	25	EACH	MANHOLE, NO. 3		
										2	6	6			14	611	99654	14	EACH	MANHOLE ADJUSTED TO GRADE		
		3													3	611	99710	3	EACH	PRECAST REINFORCED CONCRETE OUTLET		
			1												1	611	99720	1	EACH	INSPECTION WELL		
	400														400	SPECIAL	61199820	400	LB	MISCELLANEOUS METAL		
																					PAVEMENT	
2,000															2,000	251	01000	2,000	SY	PARTIAL DEPTH PAVEMENT REPAIR (441)		
														70,904	70,904	254	01000	70,904	SY	PAVEMENT PLANING, ASPHALT CONCRETE, T=1.25"		
														21,516	21,516	254	01000	21,516	SY	PAVEMENT PLANING, ASPHALT CONCRETE, T=1.5"		
												248			248	301	56100	248	CY	ASPHALT CONCRETE BASE, PG64-22, (449), (DRIVEWAYS), T=5"		
													6	2,950	2,956	301	56000	2,956	CY	ASPHALT CONCRETE BASE, PG64-22, (449)		
															3	3,070	3,073	3,073	CY	AGGREGATE BASE		
															109	407	10000	109	GAL	TACK COAT		
															20	10,612	10,632	10,632	GAL	NON-TRACKING TACK COAT		
																3,290	3,290	3,290	CY	FINE GRADED POLYMER ASPHALT CONCRETE, TYPE B, (448)		
															51	441	70500	51	CY	ASPHALT CONCRETE SURFACE COURSE, TYPE 1, (449), (DRIVEWAYS)		
															437	437	442	22100	437	CY	ASPHALT CONCRETE SURFACE COURSE, 12.5 MM, TYPE A (449)	
															2	243	245	442	22300	245	CY	ASPHALT CONCRETE INTERMEDIATE COURSE, 12.5 MM, TYPE A (449), T=2.5"
																570	570	442	20170	570	CY	ASPHALT CONCRETE INTERMEDIATE COURSE, 12.5 MM, TYPE A (448), T=2.25"
																2,331	2,331	452	09010	2,331	SY	4" NON-REINFORCED CONCRETE PAVEMENT, CLASS QC 1P
																494	494	452	12010	494	SY	8" NON-REINFORCED CONCRETE PAVEMENT, CLASS QC 1P
															464	153	617	452	12050	617	SY	8" NON-REINFORCED CONCRETE PAVEMENT, CLASS QC MS
500					508	5,280										7,643	609	12000	7,643	FT	COMBINATION CURB AND GUTTER, TYPE 2	
500						302	2,465	1,051								4,318	609	24510	4,318	FT	CURB, TYPE 4-C	
					176	2,193	1,215	676								6,339	609	26000	6,339	FT	CURB, TYPE 6	
						215										215	609	28000	215	FT	CURB, TYPE 7	
		2,580														2,580	SPECIAL	69012060	2,580	SY	PAVEMENT OVERLAY FABRIC COMPOSITE	
																						WATER WORK
														188	188	638	00990	188	FT	6" WATER MAIN POLYVINYL CHLORIDE PIPE AND FITTINGS, ASTM SDR 21		
															7	638	07800	7	EACH	6" GATE VALVE AND VALVE BOX		
															7	638	09390	7	EACH	8" X 6" TAPPING SLEEVE, VALVE AND VALVE BOX		
															7	638	10200	7	EACH	6" FIRE HYDRANT		
															7	638	07480	7	EACH	6" GATE VALVE		

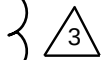

GENERAL SUMMARY

DESIGN AGENCY



PRIME
8415 Pulsar Place Suite 300
Columbus Ohio 43240

DESIGNER

MGW

REVIEWER

SA 03/27/26

PROJECT ID

115790

SHEET

P.128

TOTAL

439

PLAN SHEET No.	REFERENCE No.	LOCATION	STATION TO STATION		SIDE	605	611																	FOR INFORMATION ONLY						
						6" BASE PIPE UNDERDRAIN WITH GEOTEXTILE FABRIC	6" CONDUIT, TYPE F FOR UNDERDRAIN OUTLET	6" CONDUIT, TYPE B	8" CONDUIT, TYPE B	12" CONDUIT, TYPE B	12" CONDUIT, TYPE C	15" CONDUIT, TYPE A	15" CONDUIT, TYPE B	18" CONDUIT, TYPE B	24" CONDUIT, TYPE B	CATCH BASIN, NO. 3	CATCH BASIN NO.3A	CATCH BASIN NO. 2-2B	CATCH BASIN ADJUSTED TO GRADE	MANHOLE, NO. 3	MANHOLE ADJUSTED TO GRADE	INLET, NO. 2-6	BENDS AND BRANCHES							
																							* DENOTES TO CONNECT TO EXISTING UD							
																							6" PLUG	6" x 11.25 BEND	6" x 22.50 BEND	6" x 45 BEND	6" x 90 BEND	6" TEE		
P.145	UD-1	℄ CONST. US 224	941+95.00	973+08.00	RT.	226																					1			
P.148	UD-2	℄ CONST. US 224 / ℄ CONST. CALIFORNIA AVE.	957+00.00	8+55.18	RT.	194	20															2								
P.149	UD-3	℄ CONST. US 224 / ℄ CONST. CALIFORNIA AVE.	958+65.02	8+55.18	RT.	602																2								
P.149	D-2	℄ CONST. US 224	960+58.71		RT.												1													
P.149	D-3	℄ CONST. US 224	960+72.38	961+35.68	RT.		10					61				1			1											
P.149	D-4	℄ CONST. US 224	961+17.93		LT.		10								1															
P.149	D-5	℄ CONST. US 224	961+35.68		RT.					10									1											
P.149	UD-7	℄ CONST. US 224	960+65.19	65+07.71	LT.	607																								
P.149	D-6	℄ CONST. US 224	961+35.68	961+37.83	RT.		10			4						1														
P.149	UD-9	℄ CONST. US 224	961+85.60	964+62.12	LT.	301																1	1	1						
P.149	D-10	℄ CONST. US 224	962+47.06	962+57.58	LT.		20			15							1													
P.149	D-12	℄ CONST. US 224	962+56.19		RT.					5			5						1											
P.149	D-13	℄ CONST. US 224	962+56.19	962+56.98	RT.								24						1											
P.149	D-11	℄ CONST. US 224	962+57.58		LT.					10			5	5	5				1											
P.149	D-14	℄ CONST. US 224	962+56.19	962+76.53	RT.		10			21						1														
P.149	UD-10	℄ CONST. US 224	962+56.19	970+44.81	RT.	791																1		1						
P.149	UD-11	℄ CONST. US 224	962+57.58	964+59.94	LT.	203																1	1							
P.149	UD-12	℄ CONST. US 224	962+74.19	971+43.69	RT.	876																1								
P.149	D-15A	℄ CONST. US 224	962+86.58		RT.					10			5						1											
P.149	D-15	℄ CONST. US 224	962+92.26		LT.				10										1											
P.150	D-16	℄ CONST. US 224	963+15.25		RT.																									
P.150	UD-13	℄ CONST. US 224	964+59.52	966+99.12	LT.	242																1		1						
P.150	D-17	℄ CONST. US 224	964+60.16	964+60.51	RT.		10			5						1														
P.150	D-18	℄ CONST. US 224	964+60.51		RT.		10			10									1											
P.150	D-19	℄ CONST. US 224	964+60.67	967+02.28	LT.		10			5			240	5					1											
P.150	D-20	℄ CONST. US 224	964+60.67	964+65.65	LT.		10			12						1														
P.150	UD-14	℄ CONST. US 224	964+65.65	967+07.35	LT.	245																1								
P.150	D-21	℄ CONST. US 224	964+76.64		RT.																									
P.150	D-22	℄ CONST. US 224	967+02.28		LT.					5									1											
P.150	D-23	℄ CONST. US 224	967+02.28	967+10.77	LT.		10			17						1														
P.150	UD-15	℄ CONST. US 224	967+07.78	967+15.53	LT.	18																1								
P.150	UD-16	℄ CONST. US 224	967+47.19	967+84.06	LT.	50																1								
P.150	UD-17	℄ CONST. US 224	967+87.72	969+30.35	LT.	177																								
P.150	UD-18	℄ CONST. US 224	967+88.28	969+22.27	LT.	140																			1					
P.150	D-24	℄ CONST. US 224	967+50.14	967+88.28	LT.		20			41						1														
P.150	D-25	℄ CONST. US 224	967+87.70	967+88.28	LT.		10			7							1													
P.150	D-26	℄ CONST. US 224	967+88.28		LT.		10			10									1											
P.150	D-27	℄ CONST. US 224	967+88.28	967+92.22	RT./LT.		10			77							1													
P.151	D-28	℄ CONST. US 224	969+21.75		LT.					5			5						1											
P.151	UD-19	℄ CONST. US 224	969+66.35	971+49.93	LT.	206																2								
P.151	UD-19A	℄ CONST. US 224	969+75.00	969+92.00	LT.	25																1								
P.151	D-29	℄ CONST. US 224	969+73.26		LT.							5						1												
P.151	D-30	℄ CONST. US 224	969+73.26	969+97.30	LT.		30			23							1													
P.151	UD-19B	℄ CONST. US 224	969+92.00	969+98.00	LT.	17																					1			
P.151	UD-19C	℄ CONST. US 224	969+92.00	971+50.00	LT.	160																1								
P.151	UD-20	℄ CONST. US 224	971+50.60	975+43.69	RT.	394																1								
P.151	UD-21	℄ CONST. US 224	971+51.45	973+60.51	LT.	210																1	1							
P.151	UD-22	℄ CONST. US 224	971+51.93	973+60.92	LT.	209																2								
P.151	D-32	℄ CONST. US 224	973+60.51	975+42.47	LT.		10			178									1											
P.151	D-31	℄ CONST. US 224	973+60.51	973+60.91	LT.		20			26								1												
TOTALS CARRIED TO GENERAL SUMMARY						5893	240	0	10	501	0	0	350	10	5	7	6	0	1	13	2	0	21	3	4	0	1	1		

UNDERDRAIN AND DRAINAGE SUBSUMMARY

DESIGN AGENCY



PRIME
8415 Pulsar Plaza Suite 300
Columbus Ohio 43240

DESIGNER

MGW

REVIEWER

SA 03/27/26

PROJECT ID

115790

SHEET

P.140

TOTAL

439

PLAN SHEET No.	REFERENCE No.	LOCATION	STATION TO STATION		SIDE	605																	FOR INFORMATION ONLY						
						6" BASE PIPE UNDERDRAIN WITH GEOTEXTILE FABRIC	6" CONDUIT, TYPE F FOR UNDERDRAIN OUTLET	6" CONDUIT, TYPE B	8" CONDUIT, TYPE B	12" CONDUIT, TYPE B	12" CONDUIT, TYPE C	15" CONDUIT, TYPE A	15" CONDUIT, TYPE B	18" CONDUIT, TYPE B	24" CONDUIT, TYPE B	CATCH BASIN, NO. 3	CATCH BASIN NO.3A	CATCH BASIN NO. 2-2B	CATCH BASIN ADJUSTED TO GRADE	MANHOLE, NO. 3	MANHOLE ADJUSTED TO GRADE	INLET, NO. 2-6	BENDS AND BRANCHES						
																							* DENOTES TO CONNECT TO EXISTING UD						
																							6" PLUG	6" x 11.25 BEND	6" x 22.50 BEND	6" x 45 BEND	6" x 90 BEND	6" TEE	
P.152	UD-23	☒ CONST. US 224	973+60.69	979+11.00	LT.	552															1	1							
P.152	UD-24	☒ CONST. US 224	973+62.16	973+92.25	LT.	47															1								
P.152	UD-25	☒ CONST. US 224	973+72.82	979+12.00	LT.	540															1	1							
P.152	D-33	☒ CONST. US 224	975+41.96	975+42.47	LT.		10			27						1													
P.152	D-34	☒ CONST. US 224	975+42.47		LT.		10			5								1											
P.152	D-36	☒ CONST. US 224	975+43.69		RT.		10			6																			
P.152	D-35	☒ CONST. US 224	975+42.47	975+50.89	LT.					19						1													
P.152	UD-26	☒ CONST. US 224	975+47.46	981+11.19	RT.	565															1								
P.153	D-39	☒ CONST. US 224	979+11.87	979+11.87	LT.					25																			
P.153	D-37	☒ CONST. US 224	979+12.00	979+12.25	LT.		10			27						1													
P.153	D-38	☒ CONST. US 224	979+12.25		LT.		20			5									1										
P.153	UD-27A	☒ CONST. US 224	979+12.00	981+94.00	LT.	290															1	1	1						
P.153	UD-27	☒ CONST. US 224	979+15.38	981+86.55	LT.	297															1								
P.153	D-42	☒ CONST. US 224	981+12.22		RT.						10								1										
P.153	D-41	☒ CONST. US 224	981+12.22	981+12.73	RT.		20				11							1											
P.153	D-40	☒ CONST. US 224	981+12.73	981+14.33	RT./LT.								39								1								
P.153	UD-28	☒ CONST. US 224	981+14.22	982+30.31	RT.	117																1							
P.153	D-43	☒ CONST. US 224	981+77.92		LT.		20			5								1											
P.155	D-44	☒ CONST. US 224	988+78.82		RT.					6											1								
P.155	D-44A	☒ CONST. US 224	989+79.00		RT.					5								1											
P.155	D-45	☒ CONST. US 224	988+78.82	988+98.82	RT.						18							1											
P.156	D-46	☒ CONST. US 224	995+64.92		RT.																	1							
P.156	D-47	☒ CONST. US 224	995+71.42		RT.																1								
P.156	D-48	☒ CONST. US 224	995+83.21		RT.													1											
P.157	D-49	NOT USED																											
P.157	D-50	☒ CONST. US 224	998+88.63		RT.																	1							
P.157	D-51	☒ CONST. US 224	998+95.29		RT.																	1							
P.157	D-52	☒ CONST. US 224	999+03.85	999+04.67	RT.					7											1								
P.157	D-53	☒ CONST. US 224	999+03.85	999+11.18	RT.					9								1											
P.158	D-54	☒ CONST. US 224	1003+84.62		LT.														1										
P.159	D-55	☒ CONST. US 224	1010+01.70		RT.																	1							
P.159	D-56	☒ CONST. US 224	1010+06.42		RT.																	1							
P.159	UD-29	☒ CONST. US 224	1012+94.68	1018+13.00	LT.	519																	1						
P.160	UD-30	☒ CONST. US 224	1013+05.88	1018+79.69	RT.	630																	2						
P.160	UD-31	☒ CONST. US 224	1013+08.81	1018+61.38	RT.	567																	2	2			1		
P.160	D-57	☒ CONST. US 224	1013+38.64		RT.		20			5										1									
P.160	D-58	☒ CONST. US 224	1013+38.64	1013+43.55	RT.		20			13								0	1										
P.160	UD-32	☒ CONST. US 224	1013+61.25	1018+70.55	LT.	533																	2				1		
P.161	D-59	☒ CONST. US 224	1018+13.00	1018+66.04	LT.		20			51								1											
P.161	D-62	☒ CONST. US 224	1018+13.00	1018+14.44	RT.		20			9																			
P.161	D-63	☒ CONST. US 224	1018+14.44		RT.		10			5											1								
P.161	UD-33	☒ CONST. US 224	1018+16.79	1018+75.15	LT.	125																	1						
P.161	D-60	☒ CONST. US 224	1018+66.04	1018+77.49	LT.		20			33								1											
P.161	UD-37	☒ CONST. US 224	1019+38.25	1023+78.97	LT.	490																	2			2	1		
P.161	UD-37A	☒ CONST. US 224	1019+46.00	1021+99.00	RT.	228																	1			1	1		
P.161	D-64	☒ CONST. US 224	1019+61.18		LT.		10			14																			
P.161	UD-38	☒ CONST. US 224	1019+64.20	1023+79.11	LT.	418																		1					
TOTALS CARRIED TO GENERAL SUMMARY						5917	220	0	0	276	39	0	39	0	0	3	10	2	2	7	6	1	18	6	1	0	3	4	

UNDERDRAIN AND DRAINAGE SUBSUMMARY

DESIGN AGENCY



8415 Pulsar Place Suite 300
Columbus Ohio 43240

DESIGNER

MGW

REVIEWER

SA 03/27/26

PROJECT ID

115790

SHEET

P.141

TOTAL

439

MAH-224-17.72


MODEL: Sheet PAPERSIZE: 34x22 (in.) DATE: 7/8/2026 TIME: 10:19:54 AM PLTDRV: OHDOT_PDF.pltctg PENTBL: OHDOT_Pen.tbl USER: macen.whirett@primeeng.com WORKSPACE: OHDOTCEv02 WORKSET: 115790 PRODUCT: OpenRoadsDesigner 24.00.02.25
p\\vhohdot-pw.bentley.com:ohdot-pw-02\Documents\01 Active Projects\District 04\Wahoning\115790\402-Engineering_PrimeEngineering\Drainage\Sheets\115790_DS002.dgn

[illegible]

3

UNDERDRAIN AND DRAINAGE SUBSUMMARY

DESIGN AGENCY  PRIMEA 8415 Pulsar Place Suite 300 Columbus Ohio 43240	
DESIGNER MGW	
REVIEWER SA 03/27/26	
PROJECT ID 115790	
SHEET P.142	TOTAL 439

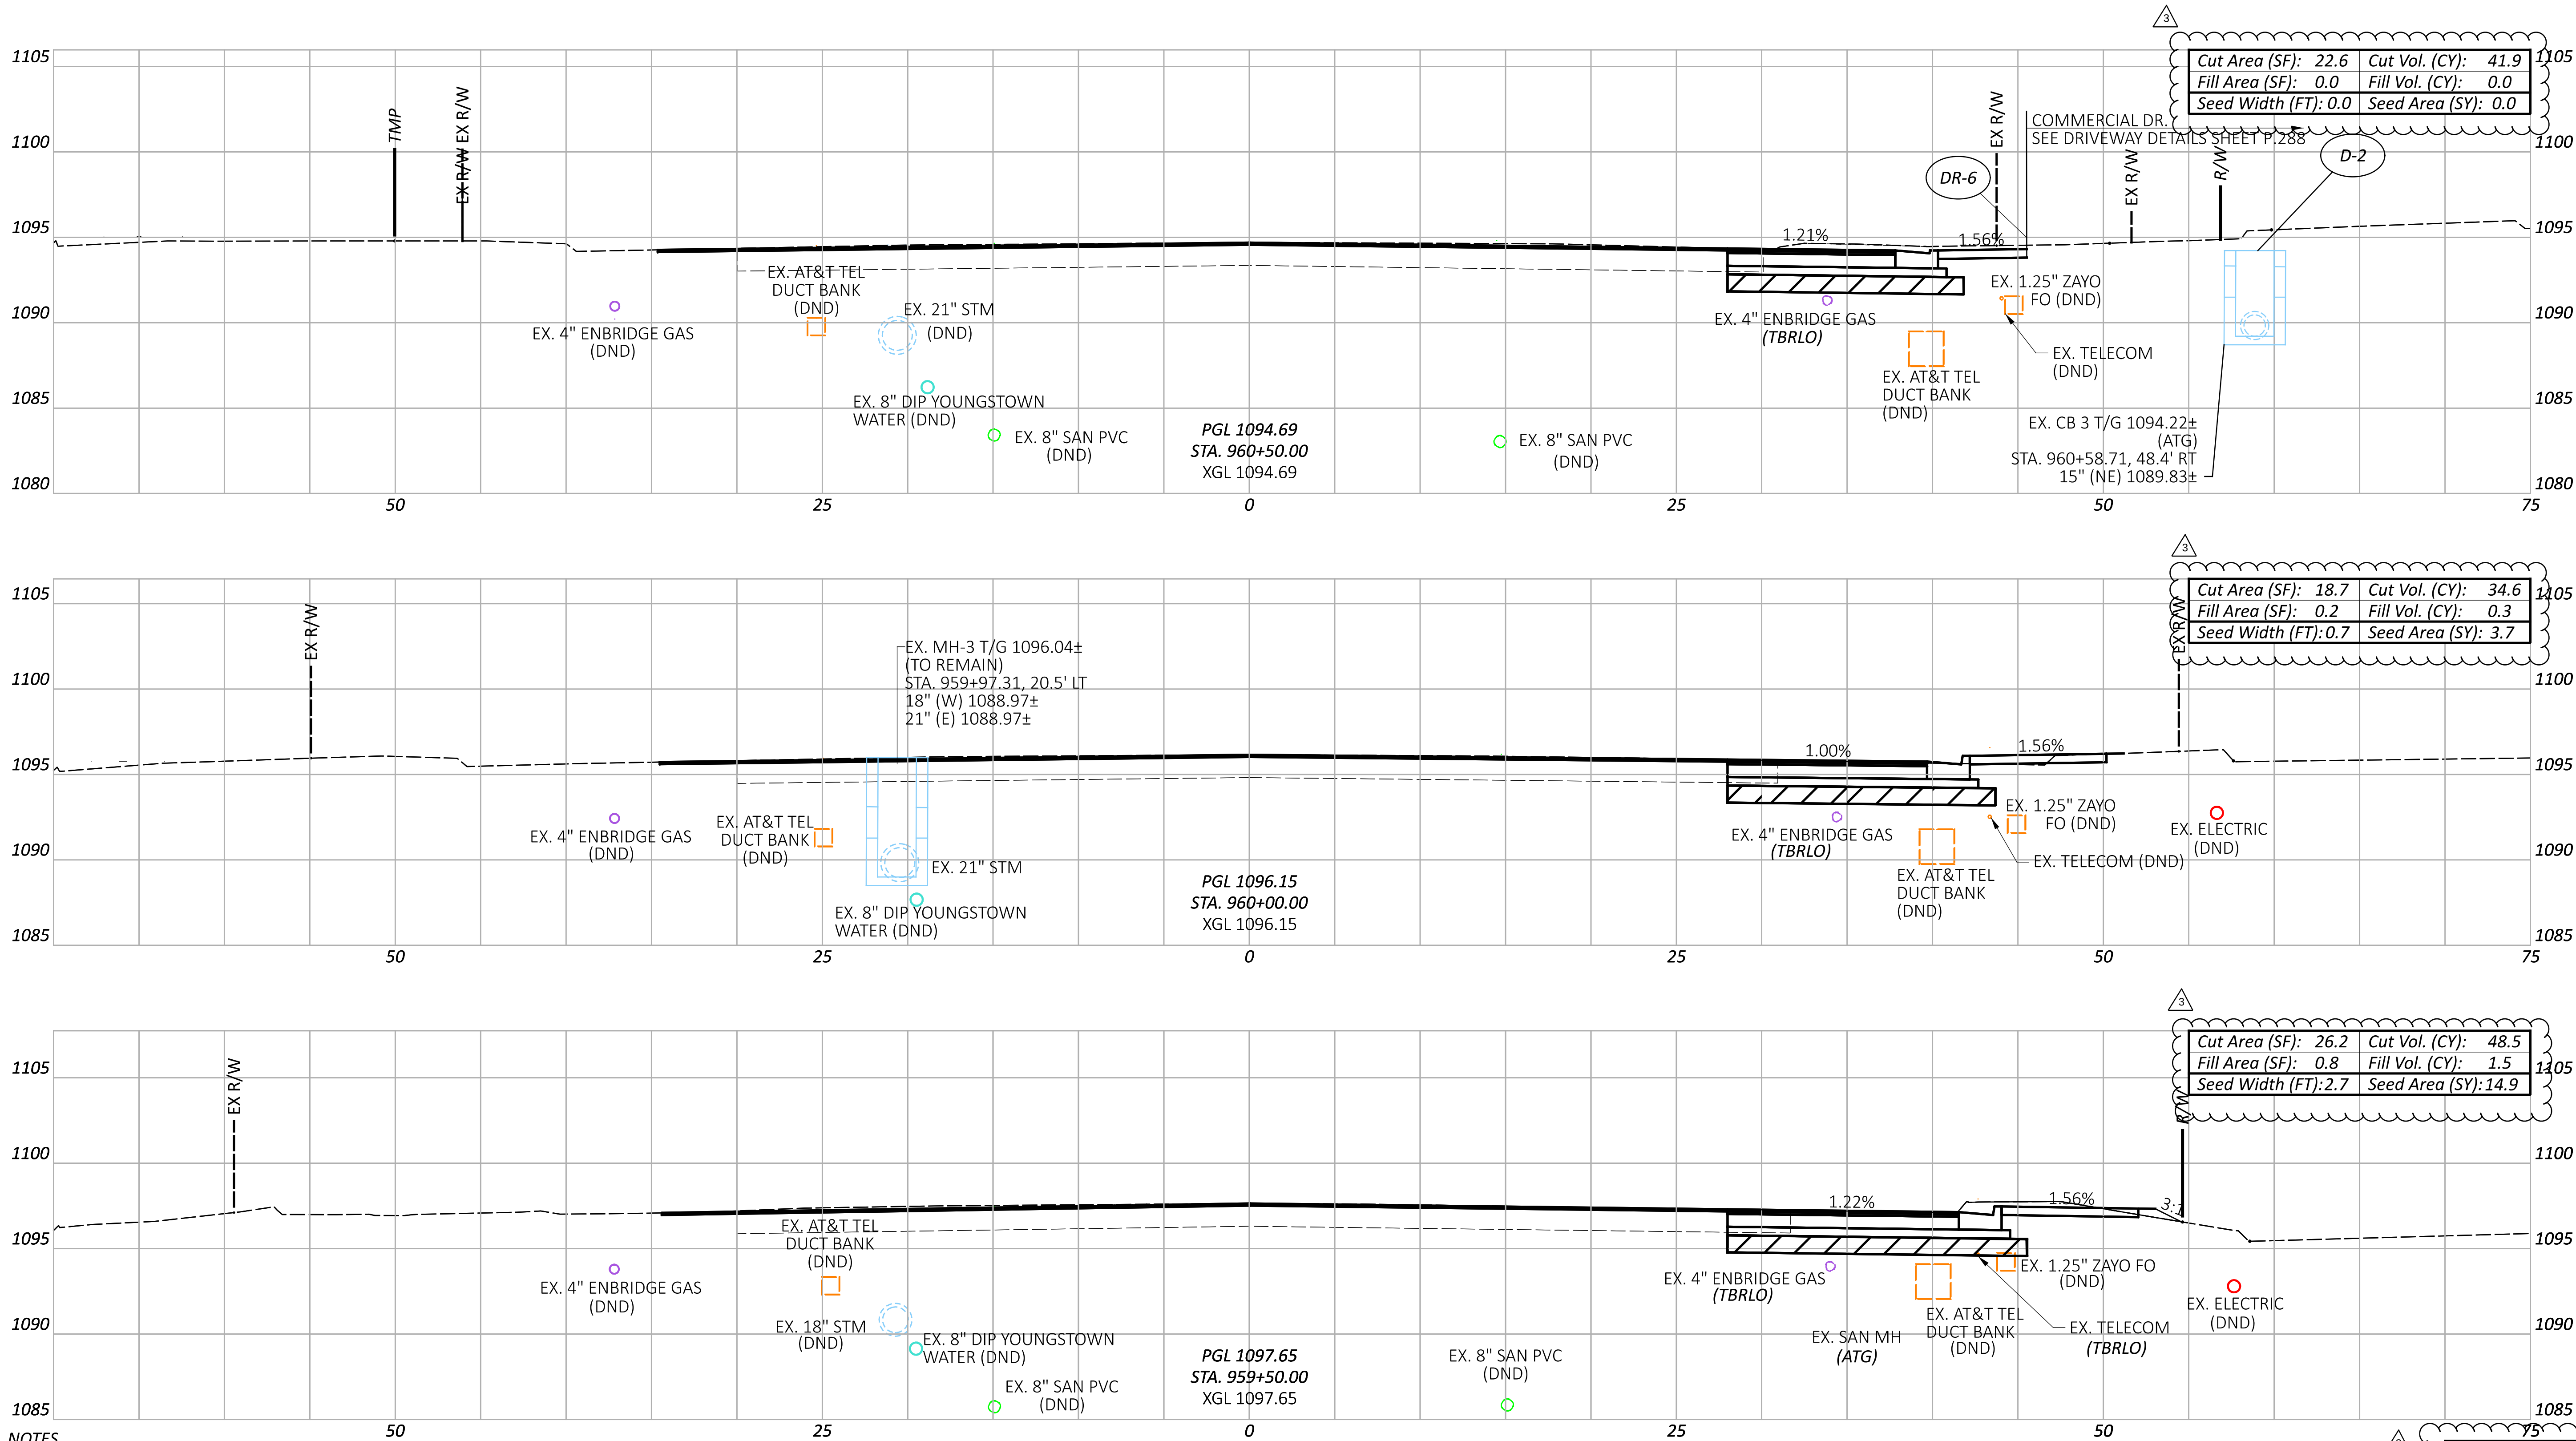

NOTES

- FOR AREAS WHERE FULL DEPTH PAVEMENT WIDENING IS PROPOSED, SUBGRADE COMPACTION SHALL BE PERFORMED. FOR THE PROPOSED LIMITS FOR FULL DEPTH WIDENING, SEE THE TYPICAL SECTIONS ON SHEETS P.4 THRU P.14.

Item 204 - Granular Material, Type B with Geotextile Fabric

Sheet Totals			SHEET TOTAL	
Seeding	Cut	Fill	187	439
18.6	125.0	1.8		

CROSS SECTIONS - U.S. 224
STA. 959+50.00 TO STA. 960+50.00



DESIGN AGENCY
MGW
REVIEWER
SA 03/27/26

PROJECT ID
115790




1. FOR AREAS WHERE FULL DEPTH PAVEMENT WIDENING IS PROPOSED, SUBGRADE COMPACTION SHALL BE PERFORMED. FOR THE PROPOSED LIMITS FOR FULL DEPTH WIDENING, SEE THE TYPICAL SECTIONS ON SHEETS P.4 THRU P.14.

 Item 204 - Granular Material, Type B with Geotextile Fabric

Sheet Totals			PROJECT ID 115790	
Seeding	Cut	Fill	SHEET	TOTAL
98.5	246.4	24.0	P.188	439

3 ADDENDUM # 3 - 07/14/2026

CROSS SECTIONS - U.S. 224
STA. 961+00.00 TO STA. 962+00.00

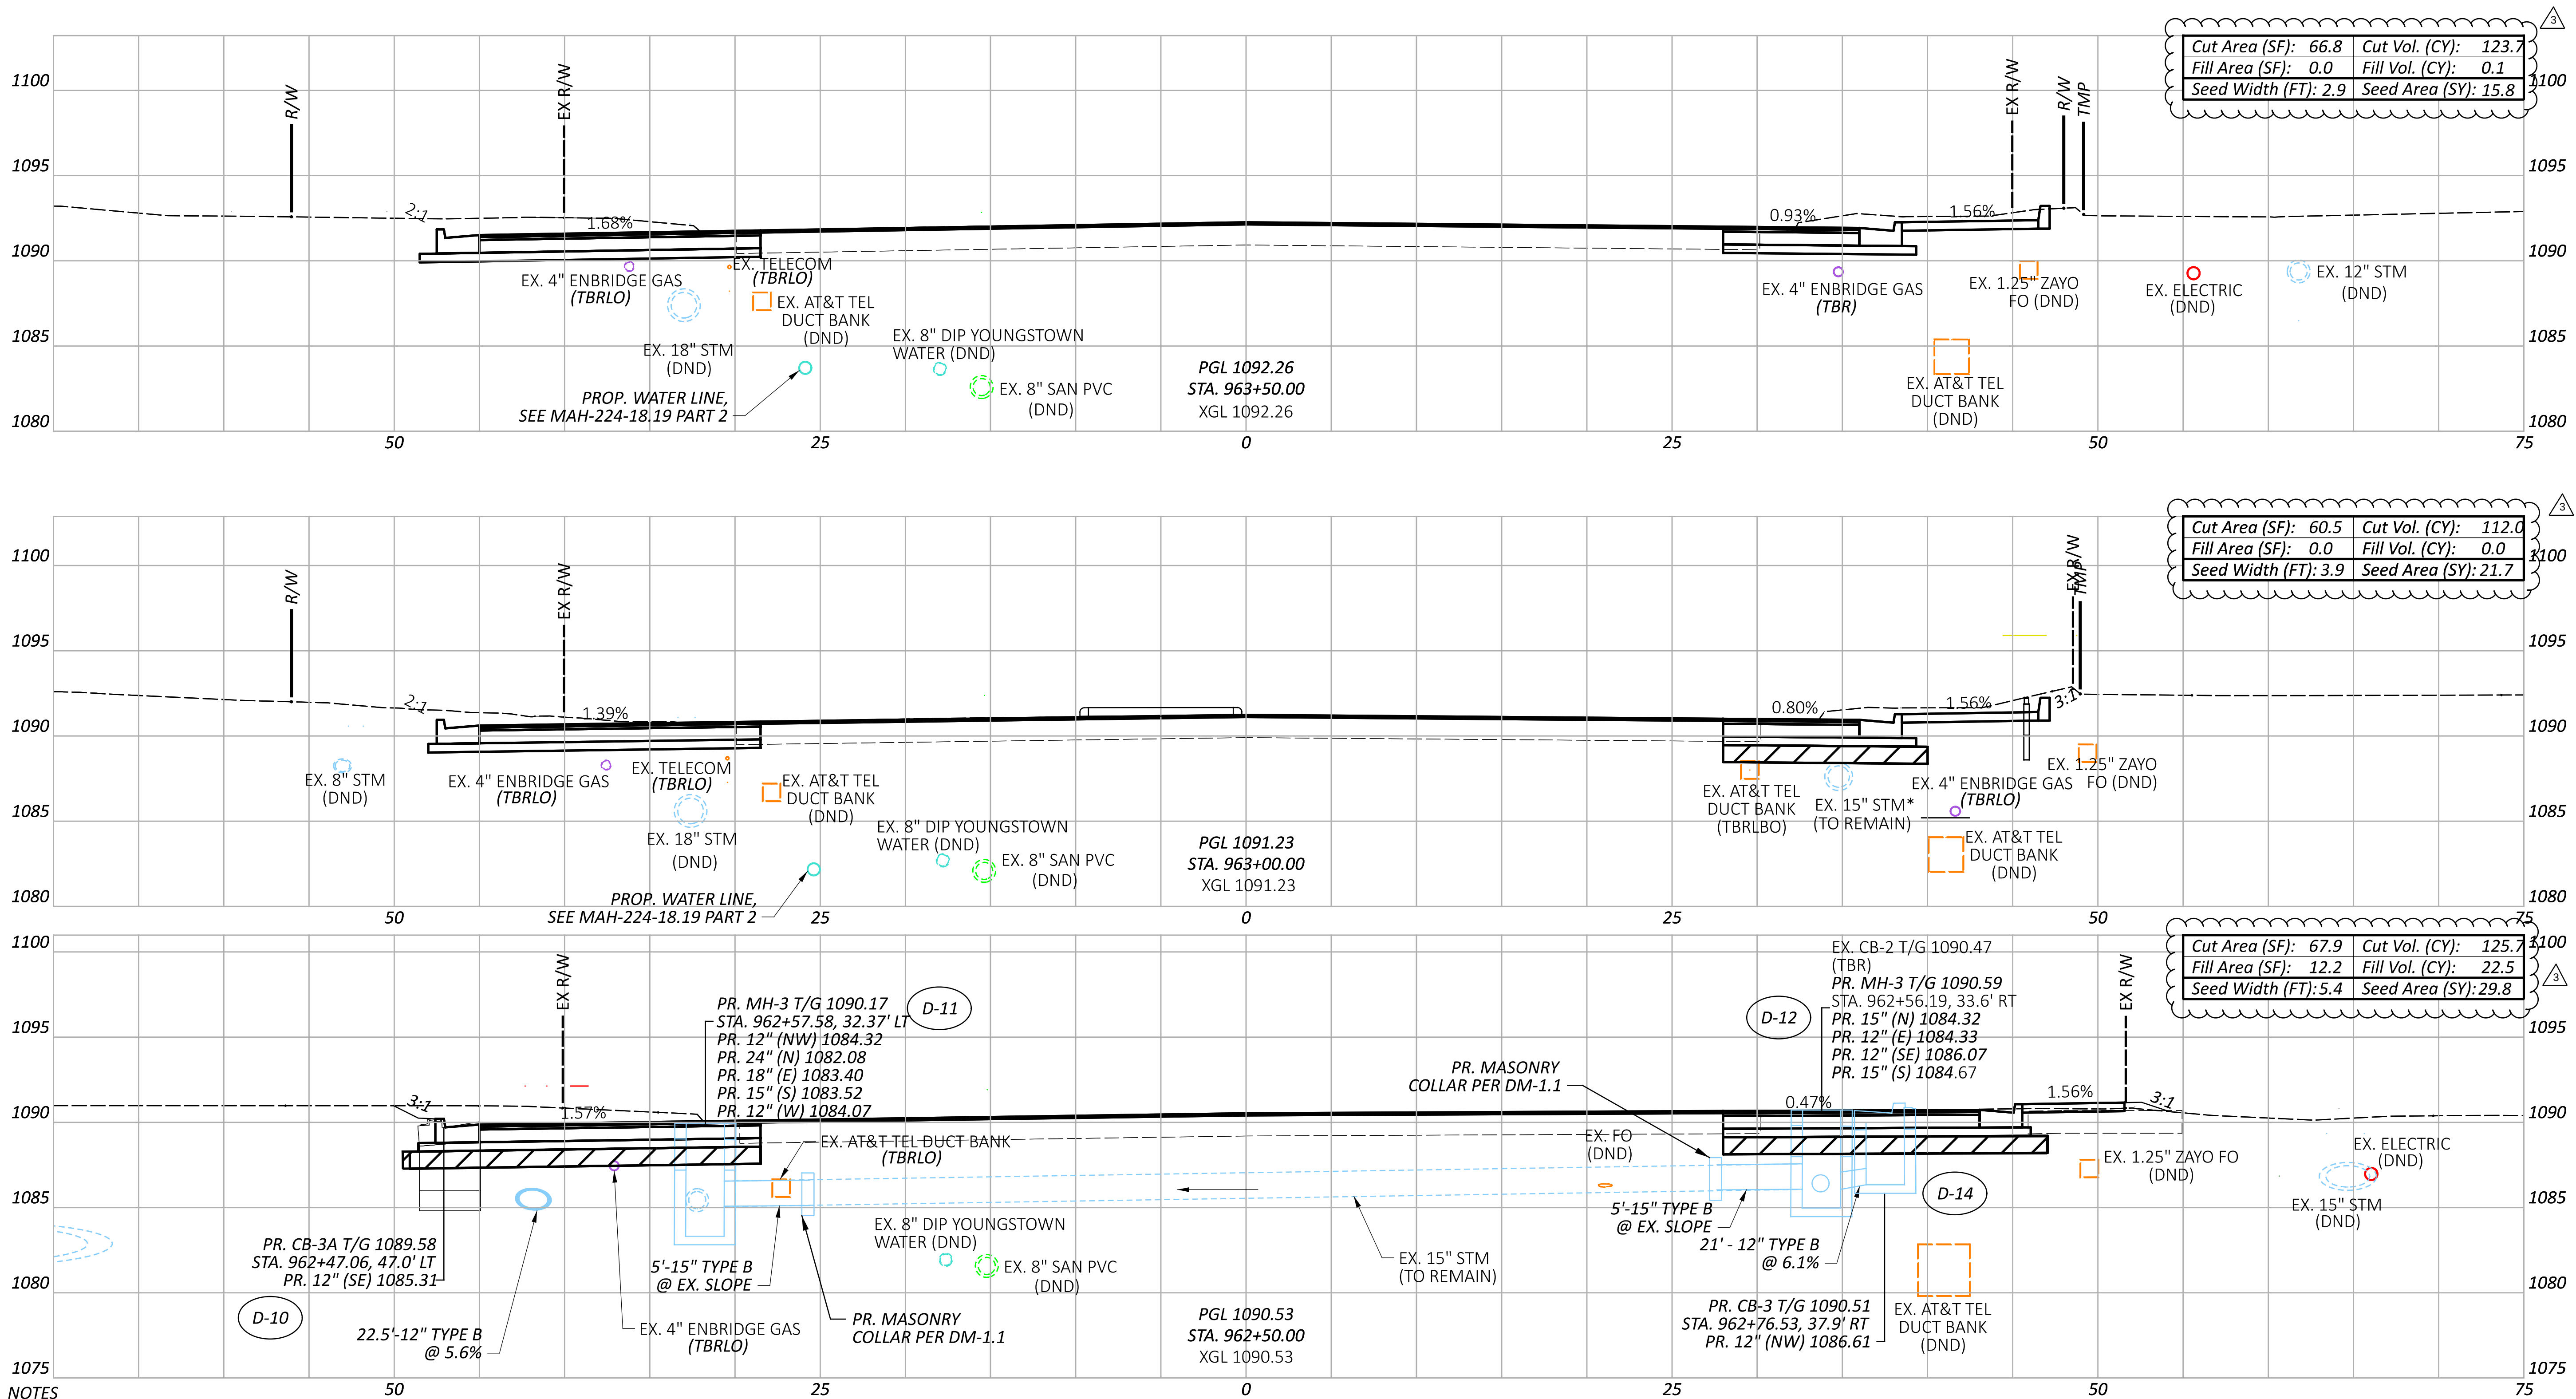

NOTES

1. FOR AREAS WHERE FULL DEPTH PAVEMENT WIDENING IS PROPOSED, SUBGRADE COMPACTION SHALL BE PERFORMED. FOR THE PROPOSED LIMITS FOR FULL DEPTH WIDENING, SEE THE TYPICAL SECTIONS ON SHEETS P.4 THRU P.14.

* - CONTRACTOR SHALL IDENTIFY EX. CONDUIT DURING THE REVIEW OF DRAINAGE FACILITIES, AS NOTED ON SHEET 16. CONTRACTOR SHALL PROCEED WITH EXTREME CAUTION DIGGING IN IDENTIFIED AREAS, NOT TO DISTURB THE EX. STORM SEWER.

Item 204 - Granular Material, Type B with Geotextile Fabric

Sheet Totals		TOTAL	
Seeding	Cut	Fill	SHEET
67.3	361.4	22.6	1.189

CROSS SECTIONS - U.S. 224
STA. 962+50.00 TO STA. 963+50.00

DESIGN AGENCY

PRIME
8415 Pulsar Place Suite 300
Columbus Ohio 43240

DESIGNER

MGW

REVIEWER

SA 03/27/26


PROJECT ID

115790

SHEET

TOTAL

ADDENDUM # 3 - 07/14/2026

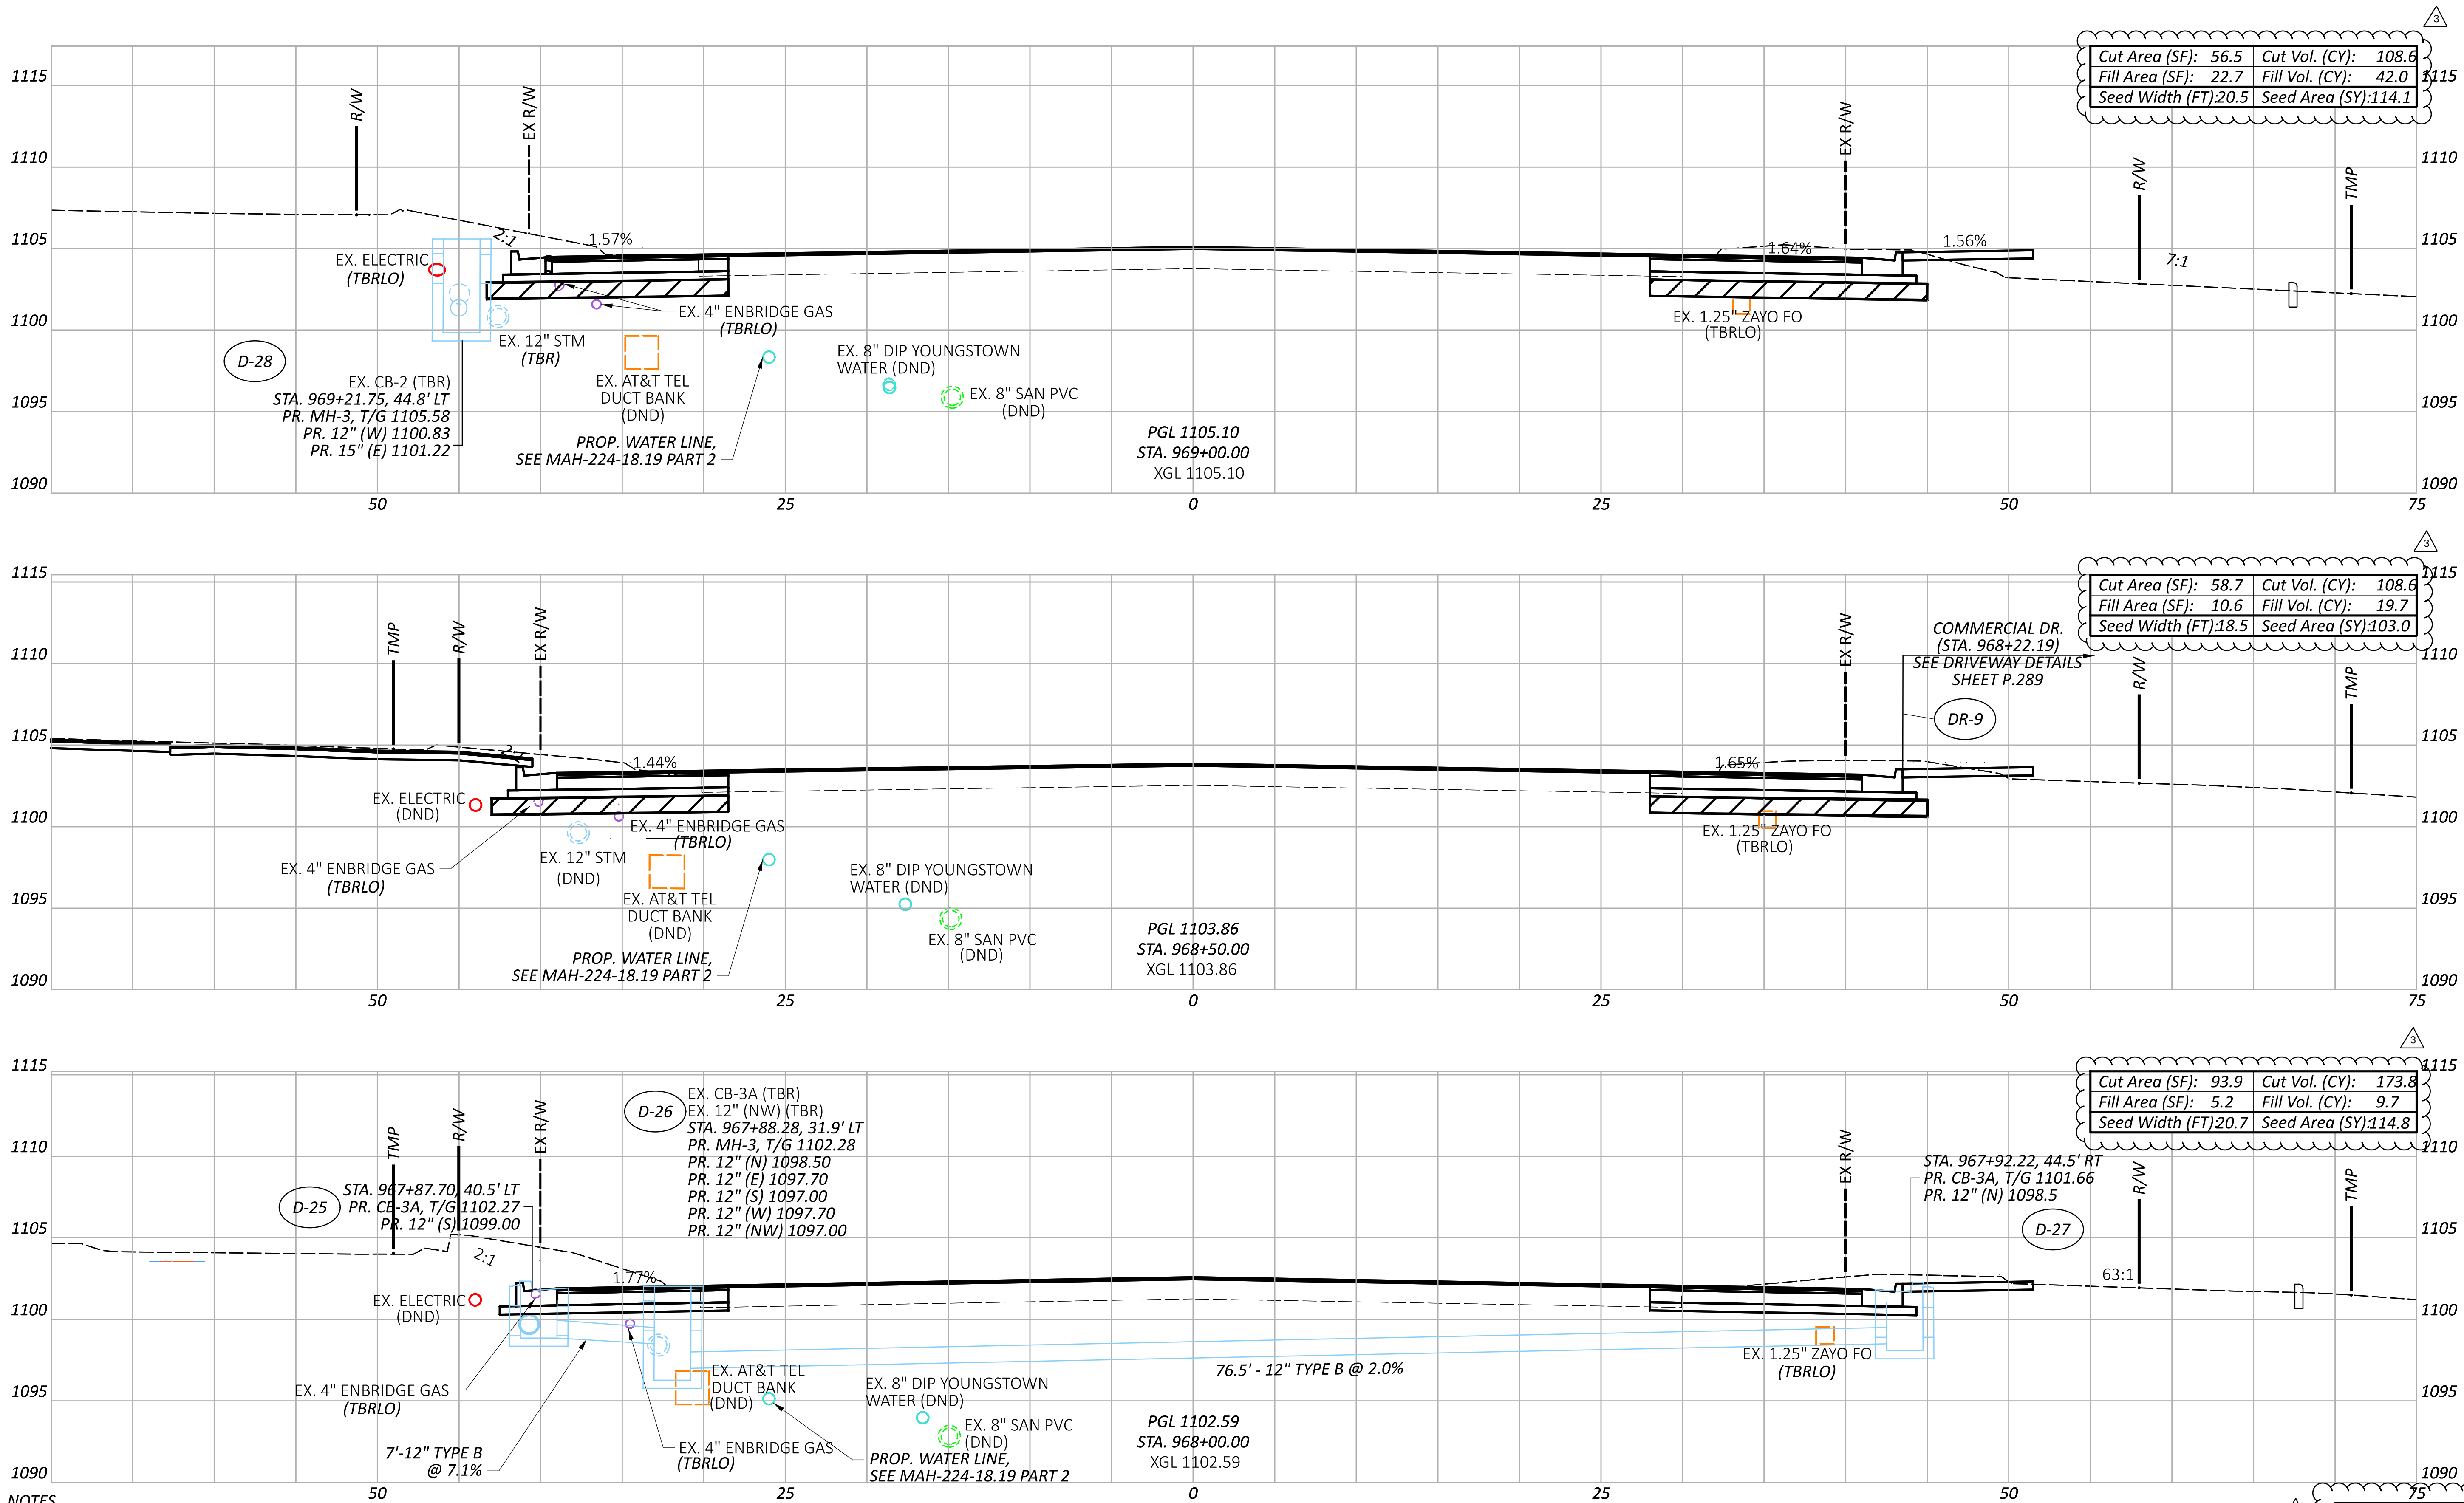

NOTES

1. FOR AREAS WHERE FULL DEPTH PAVEMENT WIDENING IS PROPOSED, SUBGRADE COMPACTION SHALL BE PERFORMED.
FOR THE PROPOSED LIMITS FOR FULL DEPTH WIDENING, SEE THE TYPICAL SECTIONS ON SHEETS P.4 THRU P.14.


Item 204 - Granular Material, Type B with Geotextile Fabric

Sheet Totals		
Seeding	Cut	Fill
331.9	387.0	71.4



DESIGN AGENCY
MGW
REVIEWER
SA 03/27/26

PROJECT ID	
115790	
SHEET TOTAL	
2.193	439

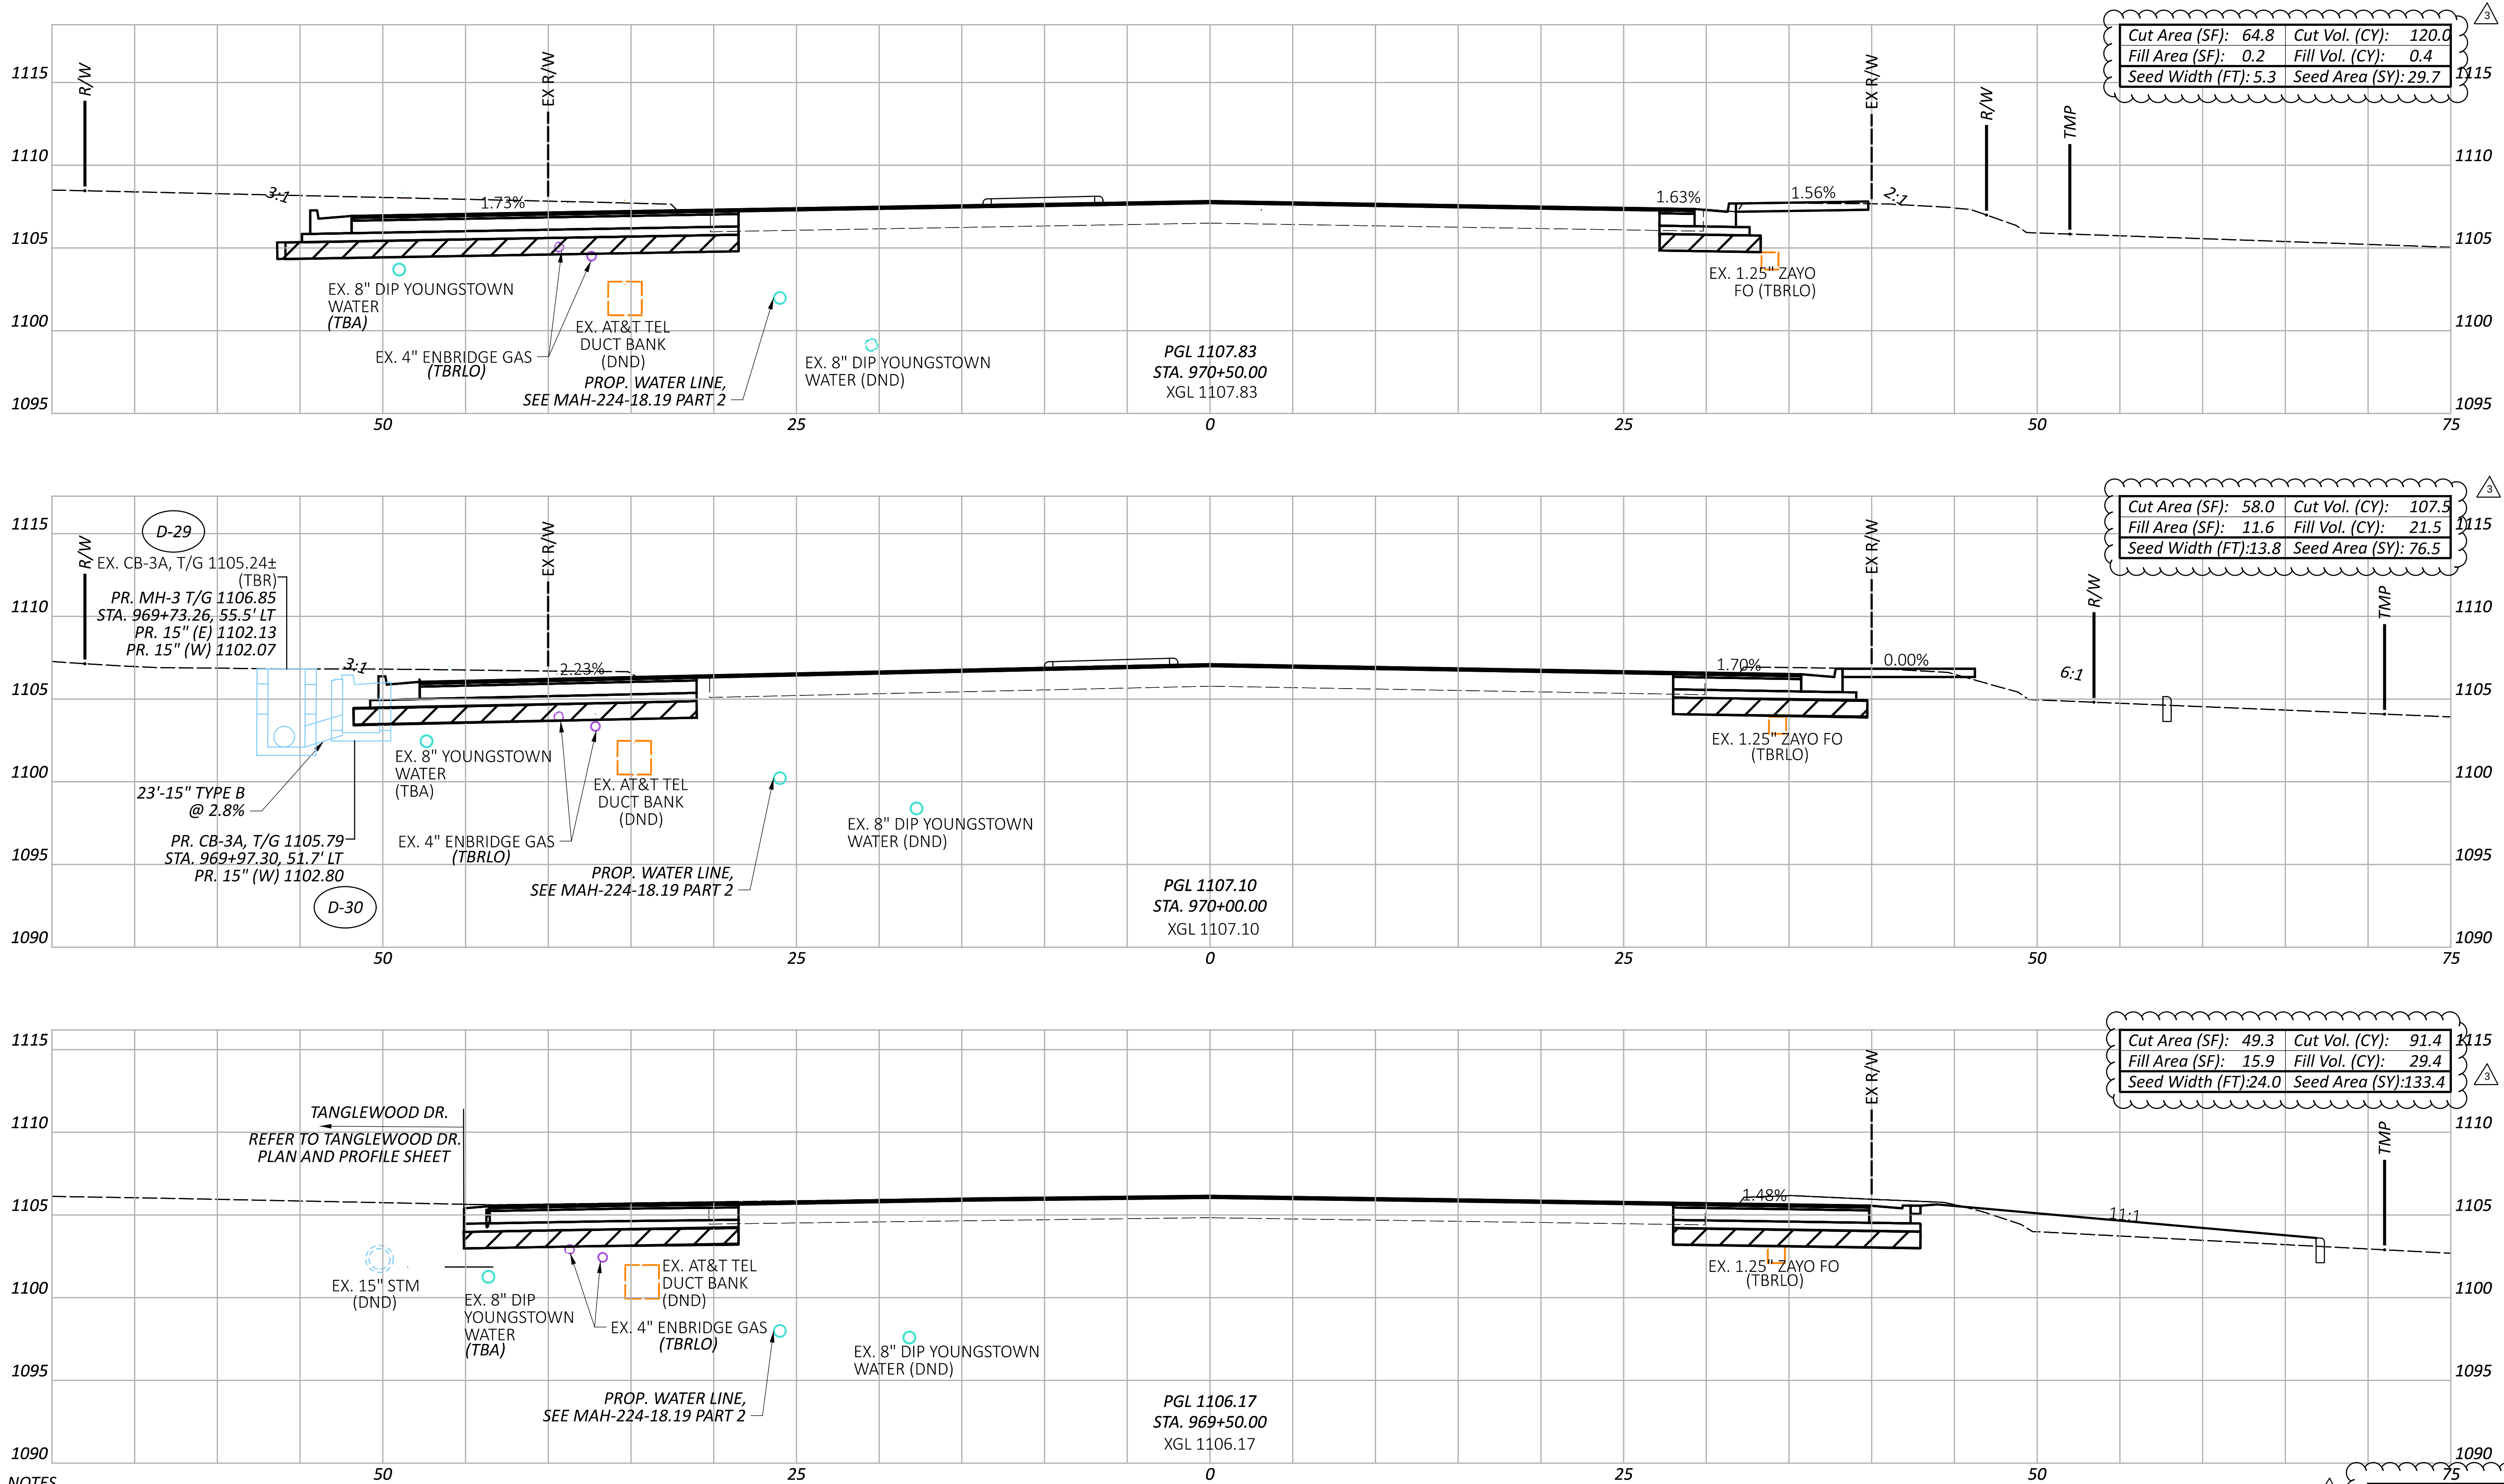

NOTES
1. FOR AREAS WHERE FULL DEPTH PAVEMENT WIDENING IS PROPOSED, SUBGRADE COMPACTION SHALL BE PERFORMED.
FOR THE PROPOSED LIMITS FOR FULL DEPTH WIDENING, SEE THE TYPICAL SECTIONS ON SHEETS P.4 THRU P.14.

Item 204 - Granular Material, Type B with Geotextile Fabric

Sheet Totals			PROJECT ID	
Seeding	Cut	Fill	115790	TOTAL
239.6	318.9	51.3	1.194	439

CROSS SECTIONS - U.S. 224
STA. 969+50.00 TO STA. 970+50.00


DESIGN AGENCY
PRIME
8415 Pulsar Place Suite 300
Columbus Ohio 43240

DESIGNER
MGW

REVIEWER
SA 03/27/26

PROJECT ID
115790

ADDENDUM # 3 - 07/14/2026

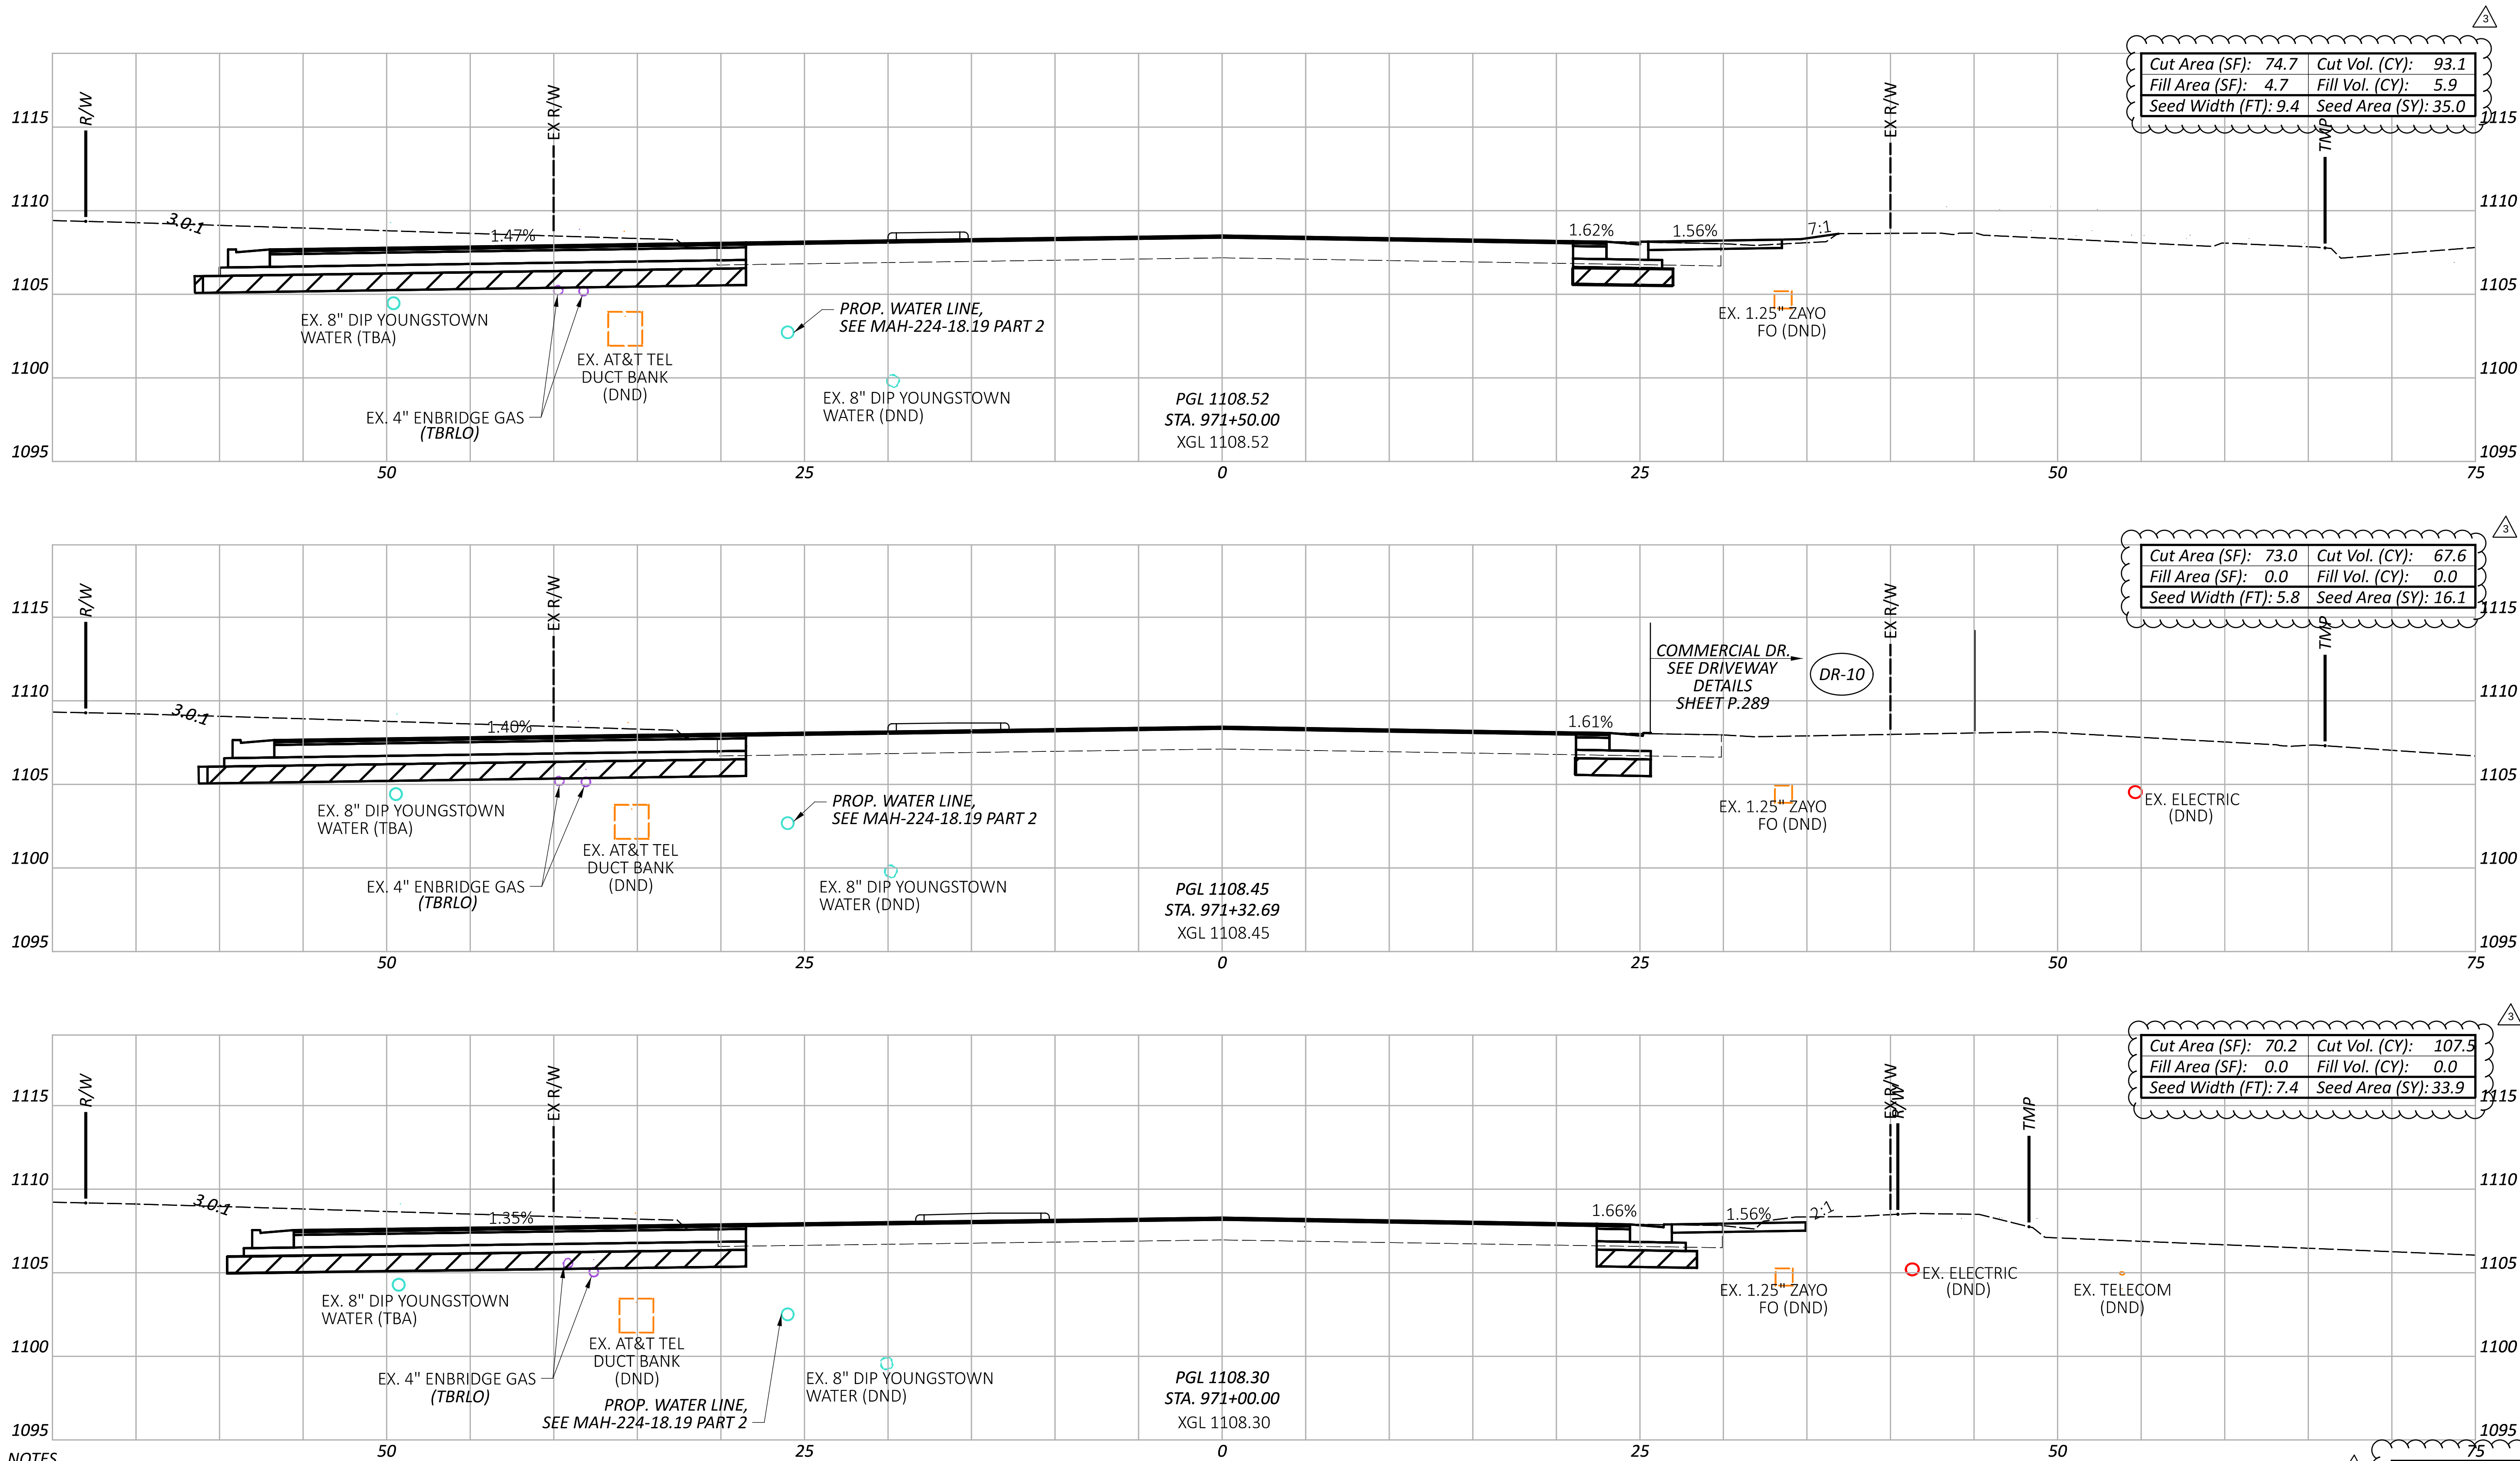


NOTES

1. FOR AREAS WHERE FULL DEPTH PAVEMENT WIDENING IS PROPOSED, SUBGRADE COMPACTION SHALL BE PERFORMED.
FOR THE PROPOSED LIMITS FOR FULL DEPTH WIDENING, SEE THE TYPICAL SECTIONS ON SHEETS P.4 THRU P.14.

Item 204 - Granular Material, Type B with Geotextile Fabric


Sheet Totals			SHEET TOTAL
Seeding	Cut	Fill	
85.0	268.2	5.9	R195 439

CROSS SECTIONS - U.S. 224
STA. 971+00.00 TO STA. 971+50.00

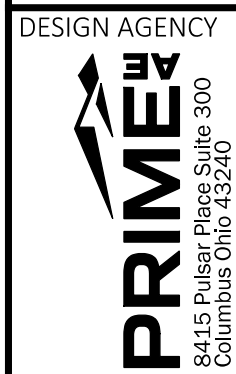

DESIGN AGENCY
MGW
REVIEWER
SA 03/27/26

PROJECT ID
115790

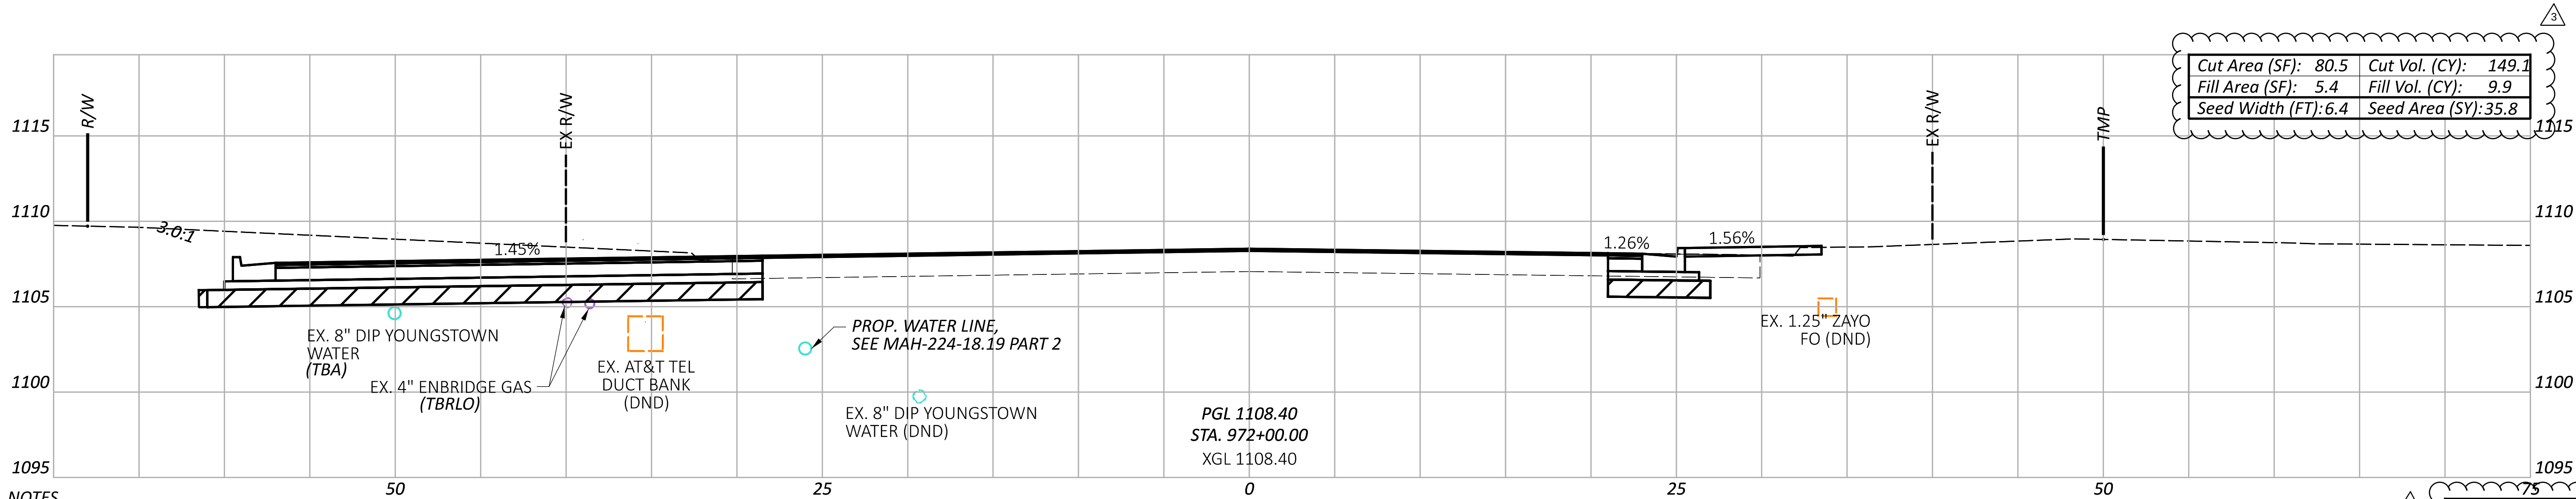

NOTES
1. FOR AREAS WHERE FULL DEPTH PAVEMENT WIDENING IS PROPOSED, SUBGRADE COMPACTION SHALL BE PERFORMED.
FOR THE PROPOSED LIMITS FOR FULL DEPTH WIDENING, SEE THE TYPICAL SECTIONS ON SHEETS P.4 THRU P.14.

Item 204 - Granular Material, Type B with Geotextile Fabric

Cut Area (SF):	80.5	Cut Vol. (CY):	149.1
Fill Area (SF):	5.4	Fill Vol. (CY):	9.9
Seed Width (FT):	6.4	Seed Area (SY):	35.8

Sheet Totals		
Seeding	Cut	Fill
35.8	149.1	9.9

SHEET	TOTAL
1196	439

DESIGN AGENCY

PRIME
8415 Pulsar Place Suite 300
Columbus Ohio 43240

DESIGNER

MGW




REVIEWER

SA 03/27/26

PROJECT ID

115790

CROSS SECTIONS - U.S. 224
STA. 972+00.00

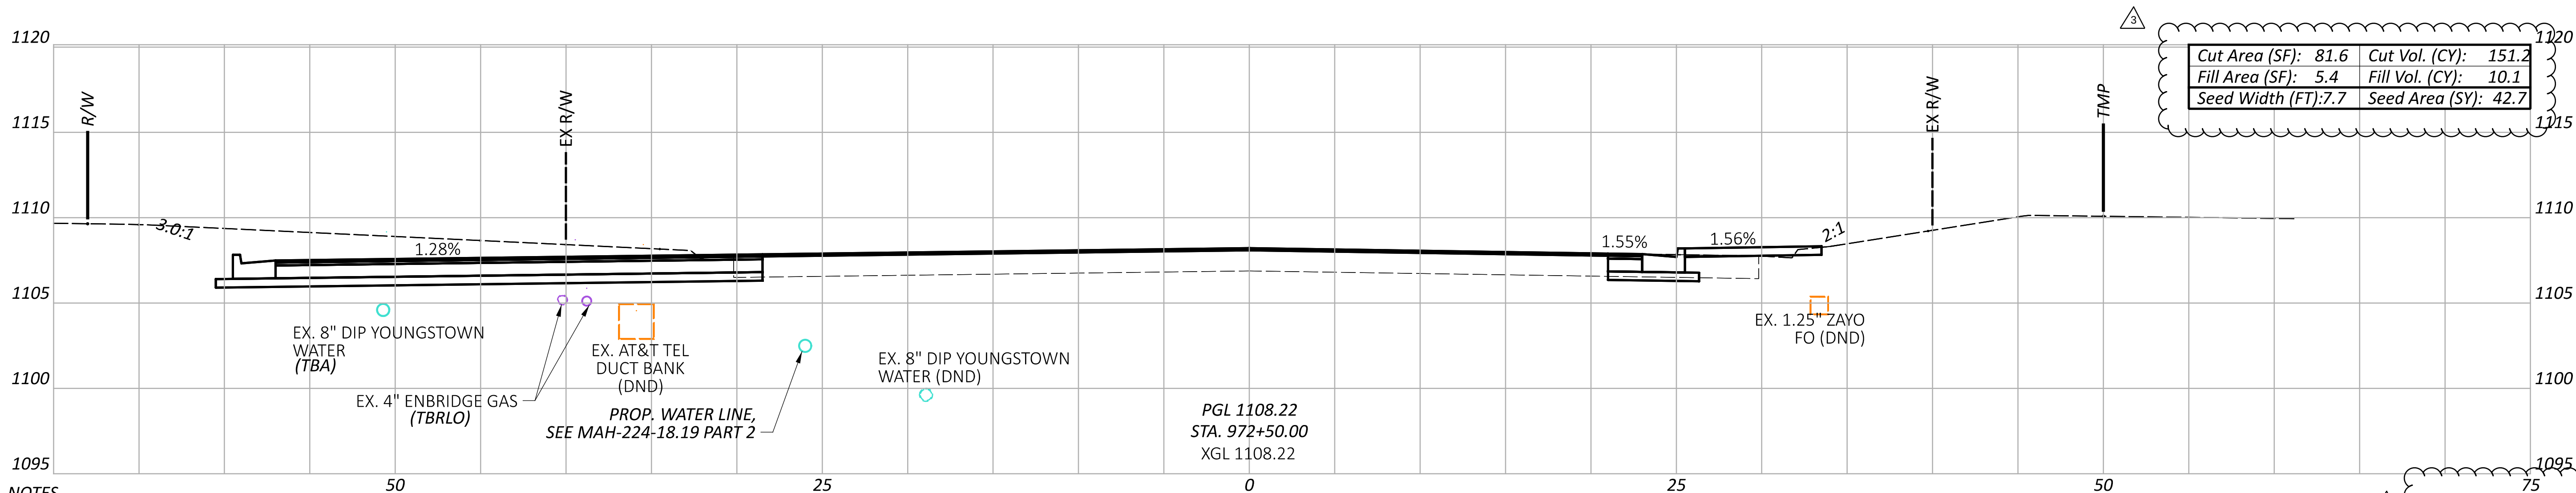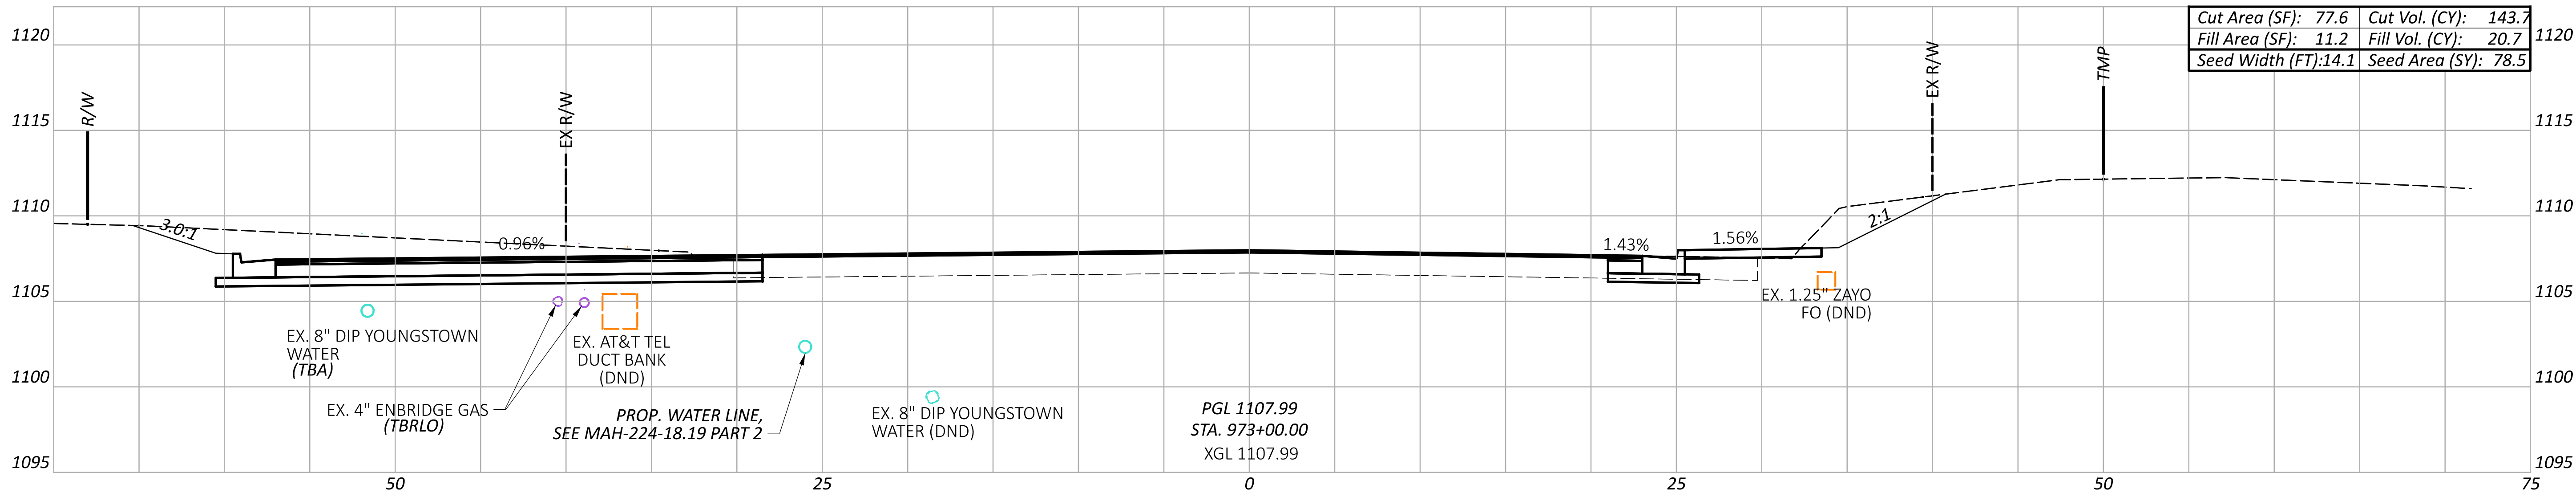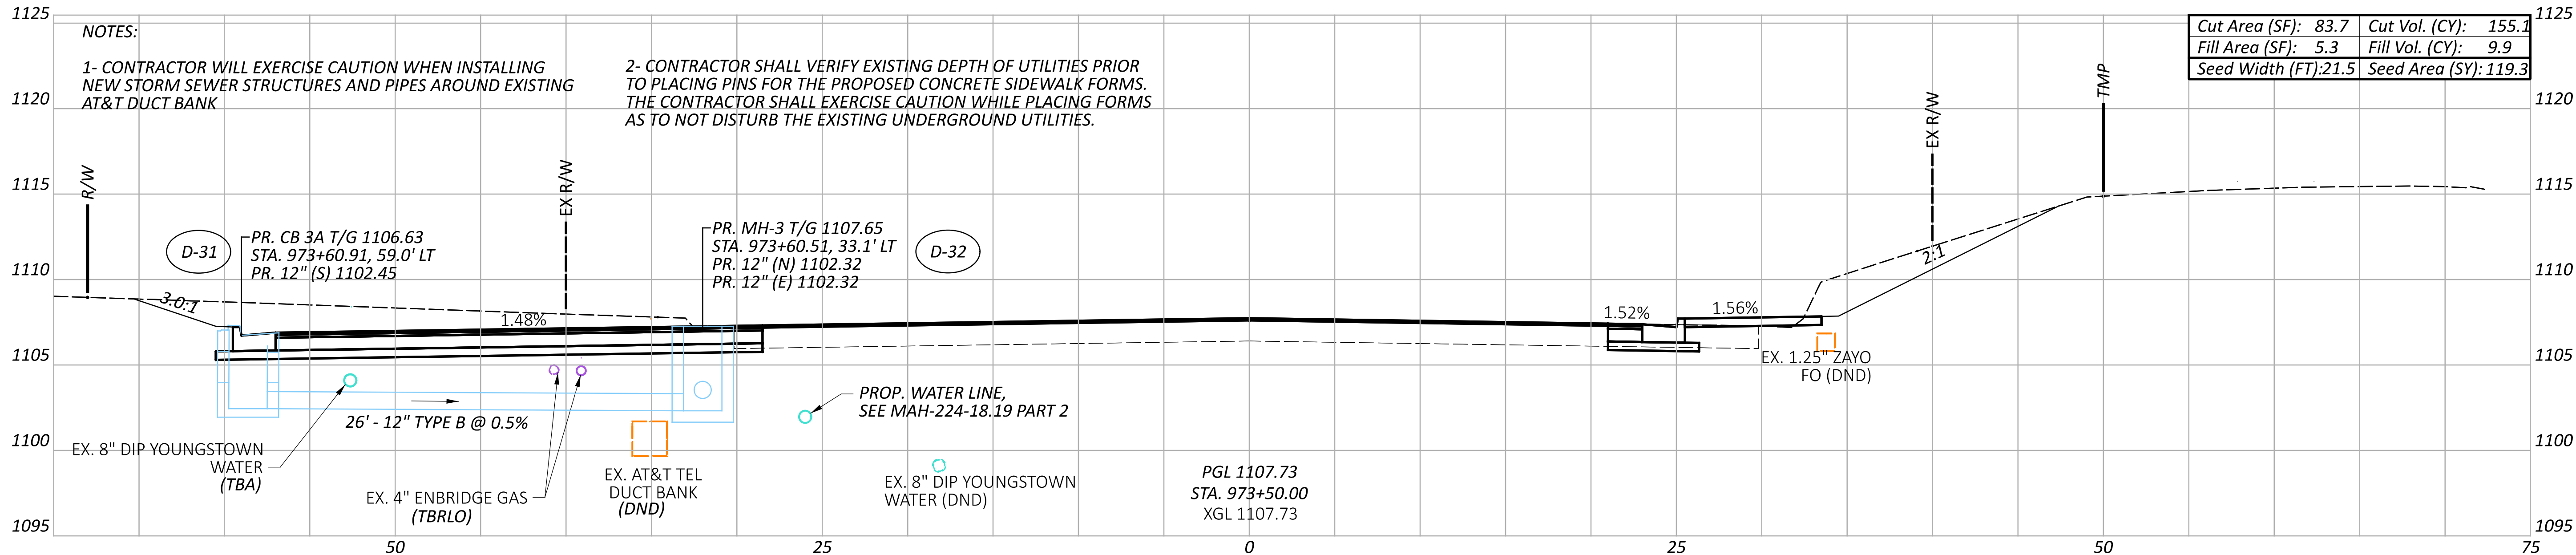


NOTES

1. FOR AREAS WHERE FULL DEPTH PAVEMENT WIDENING IS PROPOSED, SUBGRADE COMPACTION SHALL BE PERFORMED. FOR THE PROPOSED LIMITS FOR FULL DEPTH WIDENING, SEE THE TYPICAL SECTIONS ON SHEETS 4 THRU 14.


CROSS SECTIONS - U.S. 224
STA. 972+50.00 TO STA. 973+50.00



DESIGN AGENCY	MGW
DESIGNER	MGW
REVIEWER	SA 03/27/26
PROJECT ID	115790
SHEET	P.197
TOTAL	439

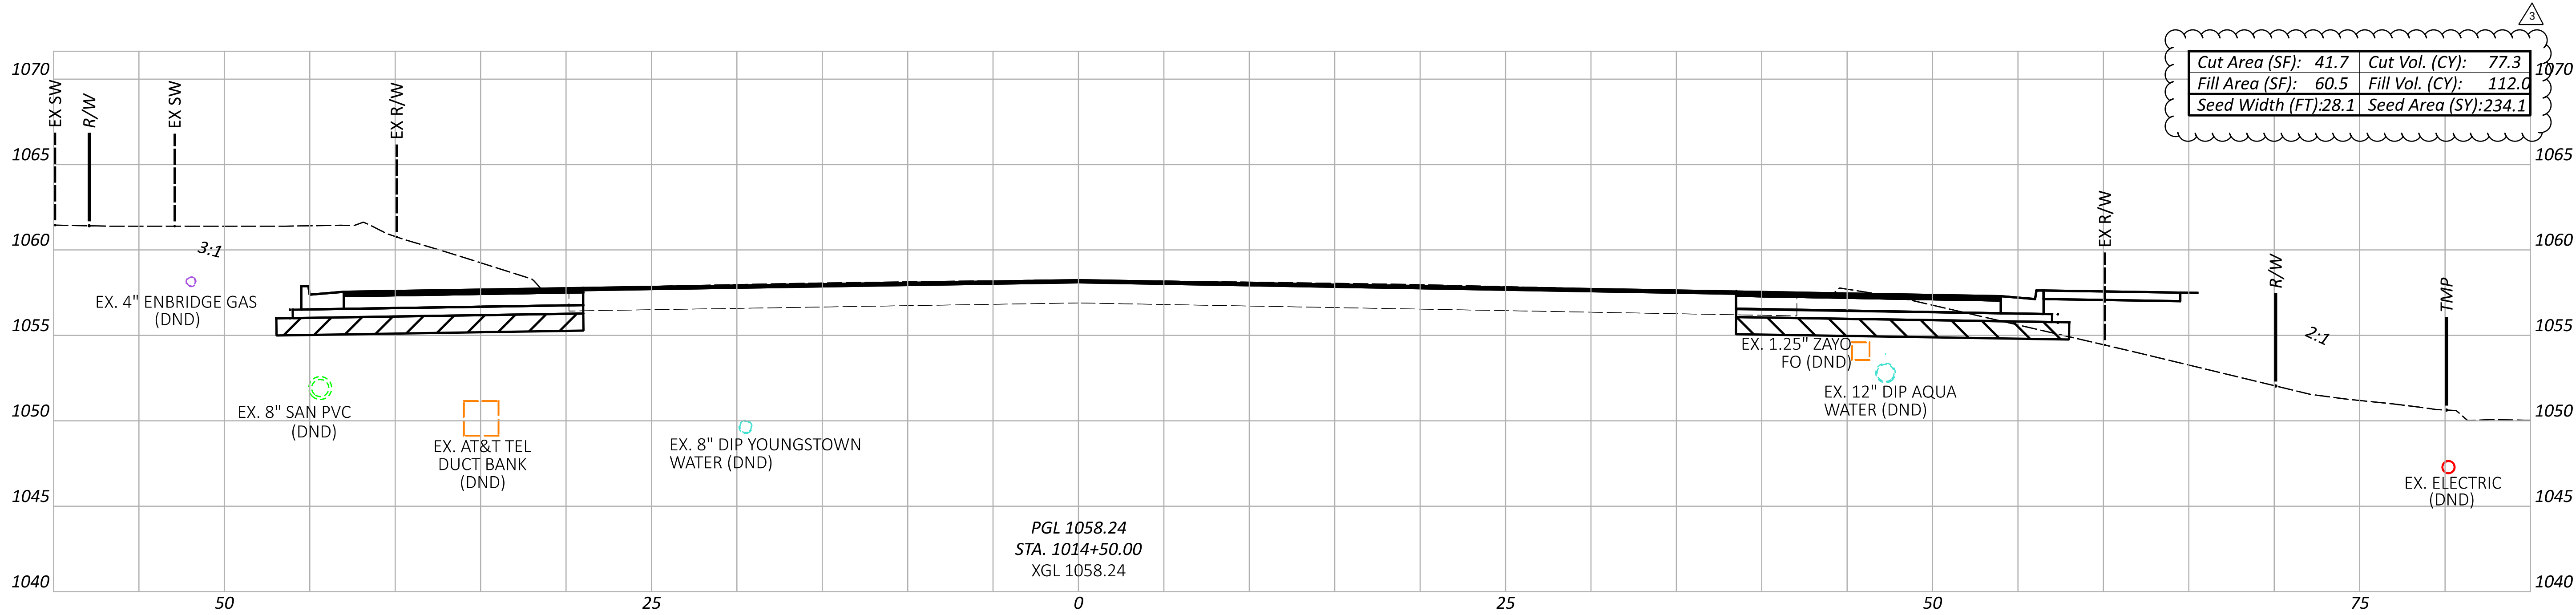

Cut Area (SF):	41.7	Cut Vol. (CY):	77.3
Fill Area (SF):	60.5	Fill Vol. (CY):	112.0
Seed Width (FT):	28.1	Seed Area (SY):	234.1

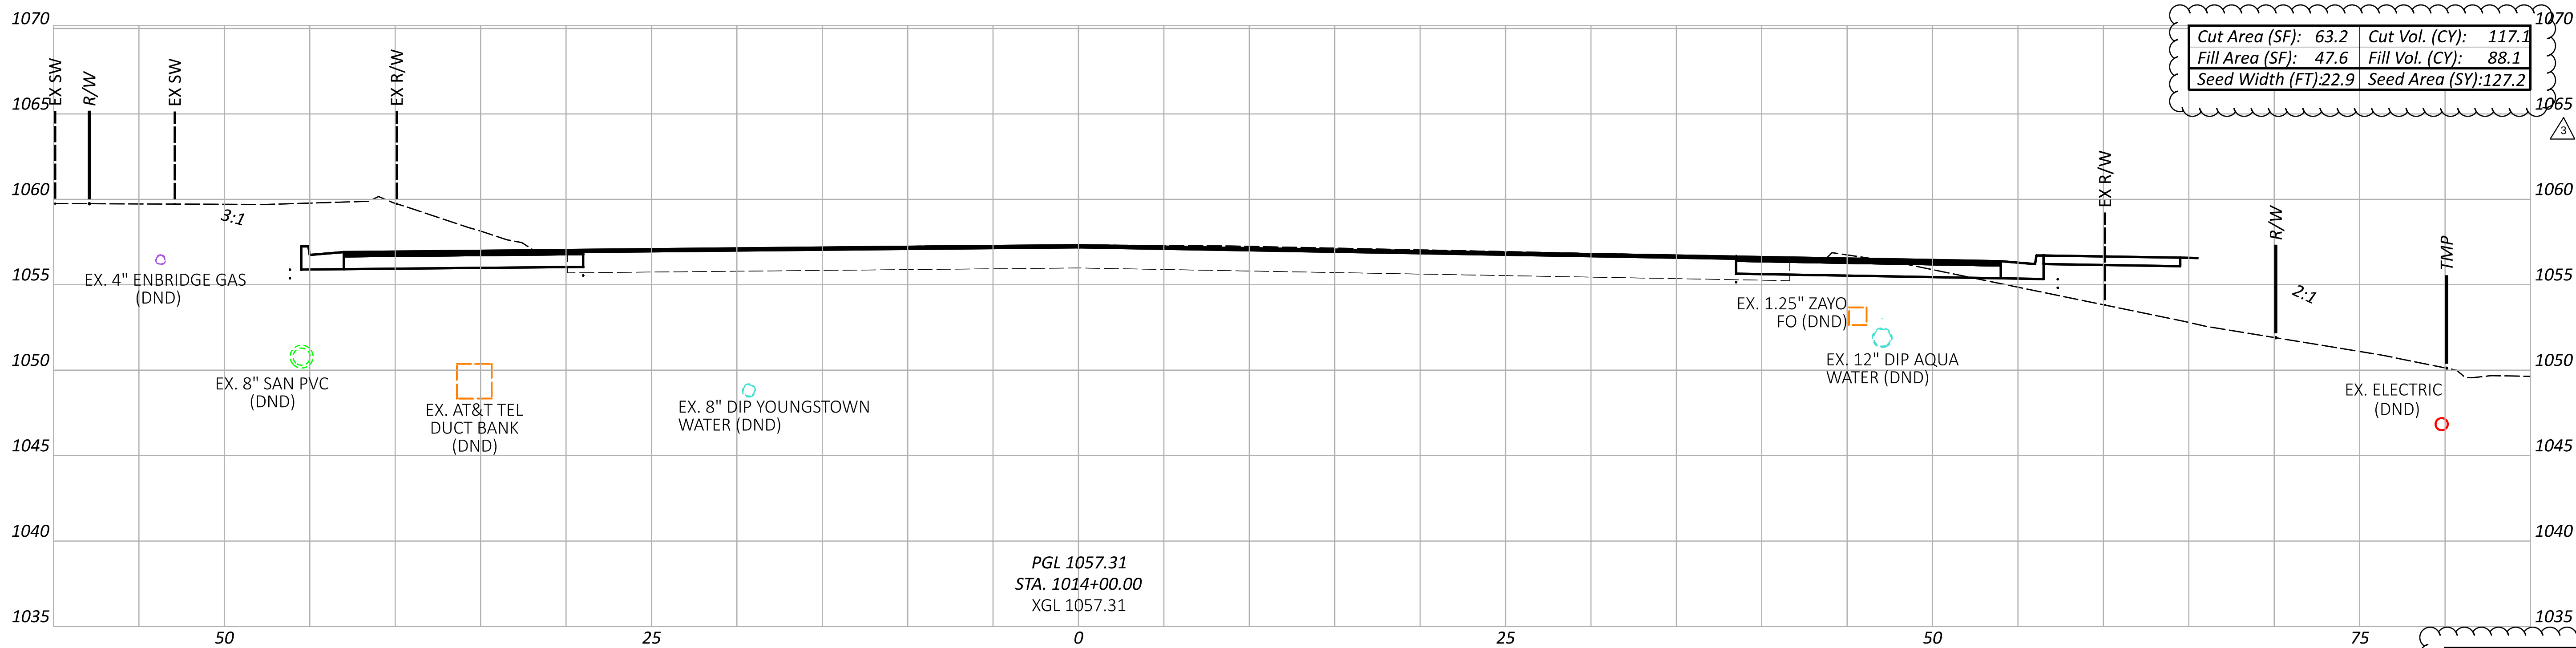

Cut Area (SF):	63.2	Cut Vol. (CY):	117.1
Fill Area (SF):	47.6	Fill Vol. (CY):	88.1
Seed Width (FT):	22.9	Seed Area (SY):	127.2

 Item 204 - Granular Material, Type B, with Geotextile Fabric

Sheet Totals			PROJECT ID	
Seeding	Cut	Fill	115790	
282.4	194.4	200.1	226	439

CROSS SECTIONS - U.S. 224
STA. 1014+00.00 TO STA. 1014+50.00

DESIGN AGENCY



8415 Pulsar Place Suite 300
Columbus Ohio 43240

DESIGNER
MGW

REVIEWER
SA 03/27/26

PROJECT ID
115790

ADDENDUM # 3 - 07/14/2026

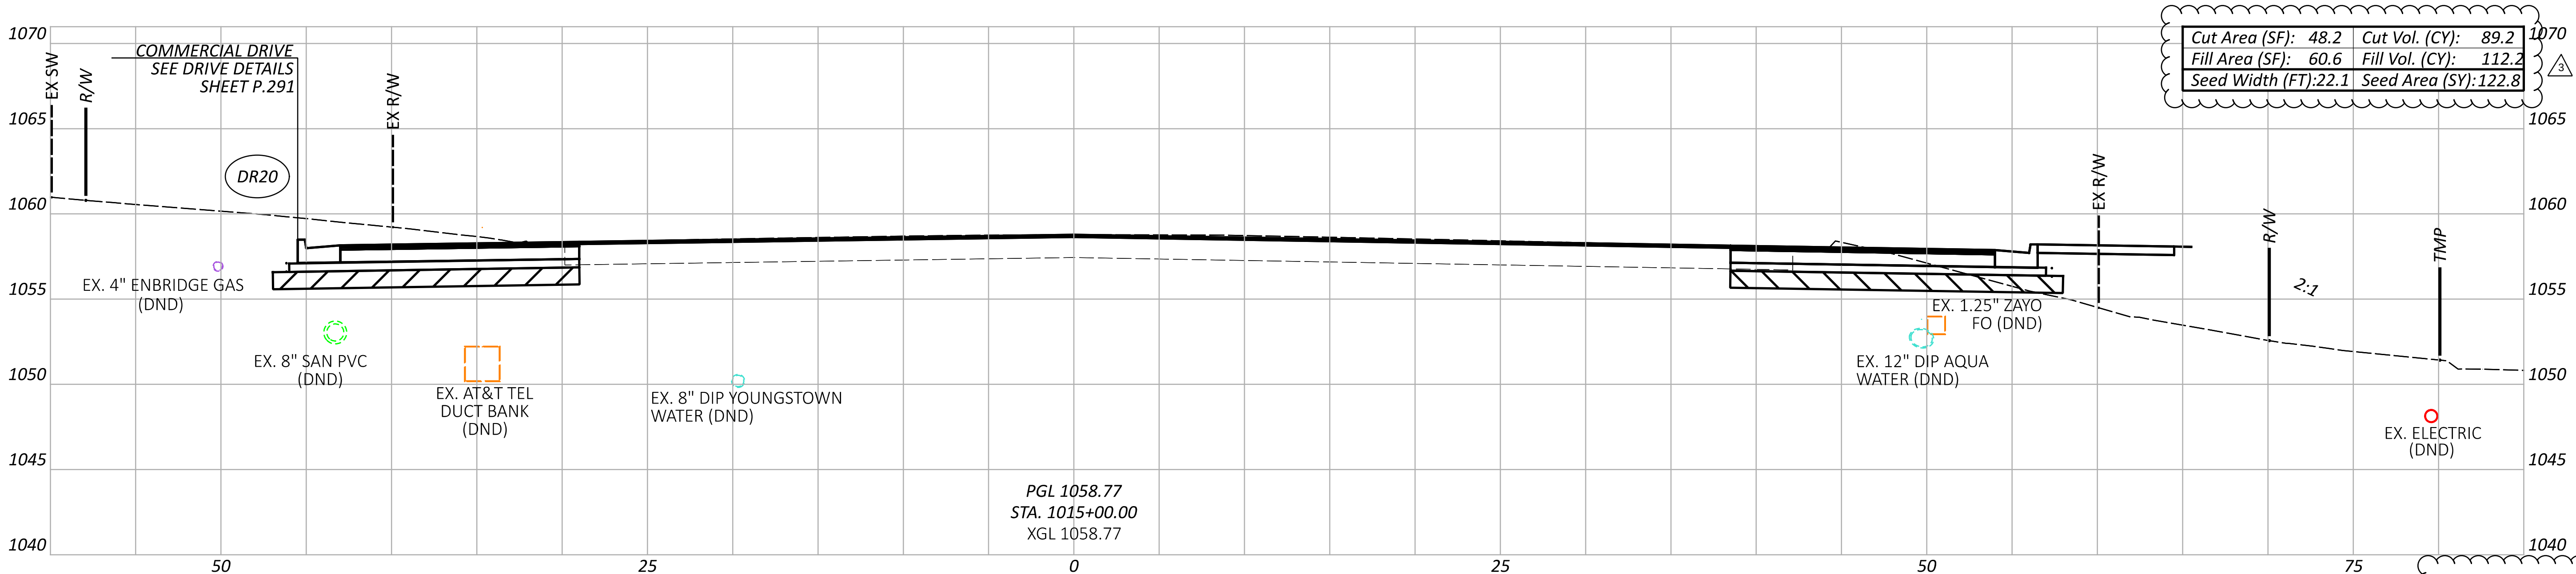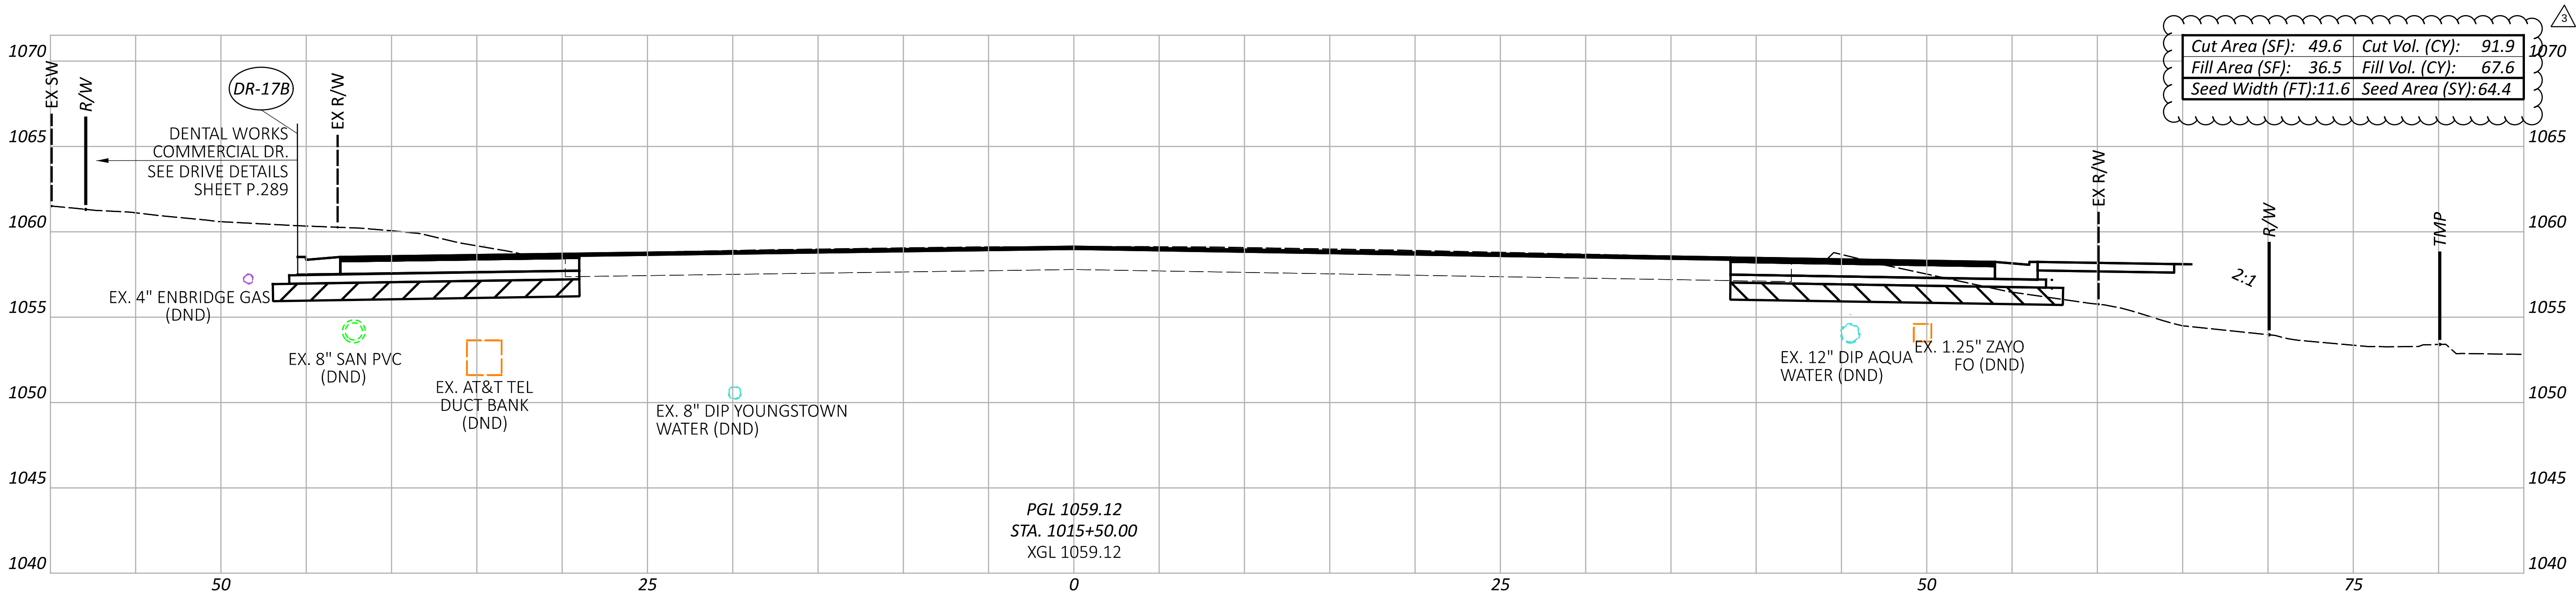

Item 204 - Granular Material, Type B, with Geotextile Fabric

Sheet Totals			SHEET TOTAL
Seeding	Cut	Fill	
187.2	181.1	179.8	439


CROSS SECTIONS - U.S. 224
STA. 1015+00.00 TO STA. 1015+50.00

DESIGN AGENCY
PRIME
8415 Pulsar Place Suite 300
Columbus Ohio 43240

DESIGNER
MGW

REVIEWER
SA 03/27/26

PROJECT ID
115790

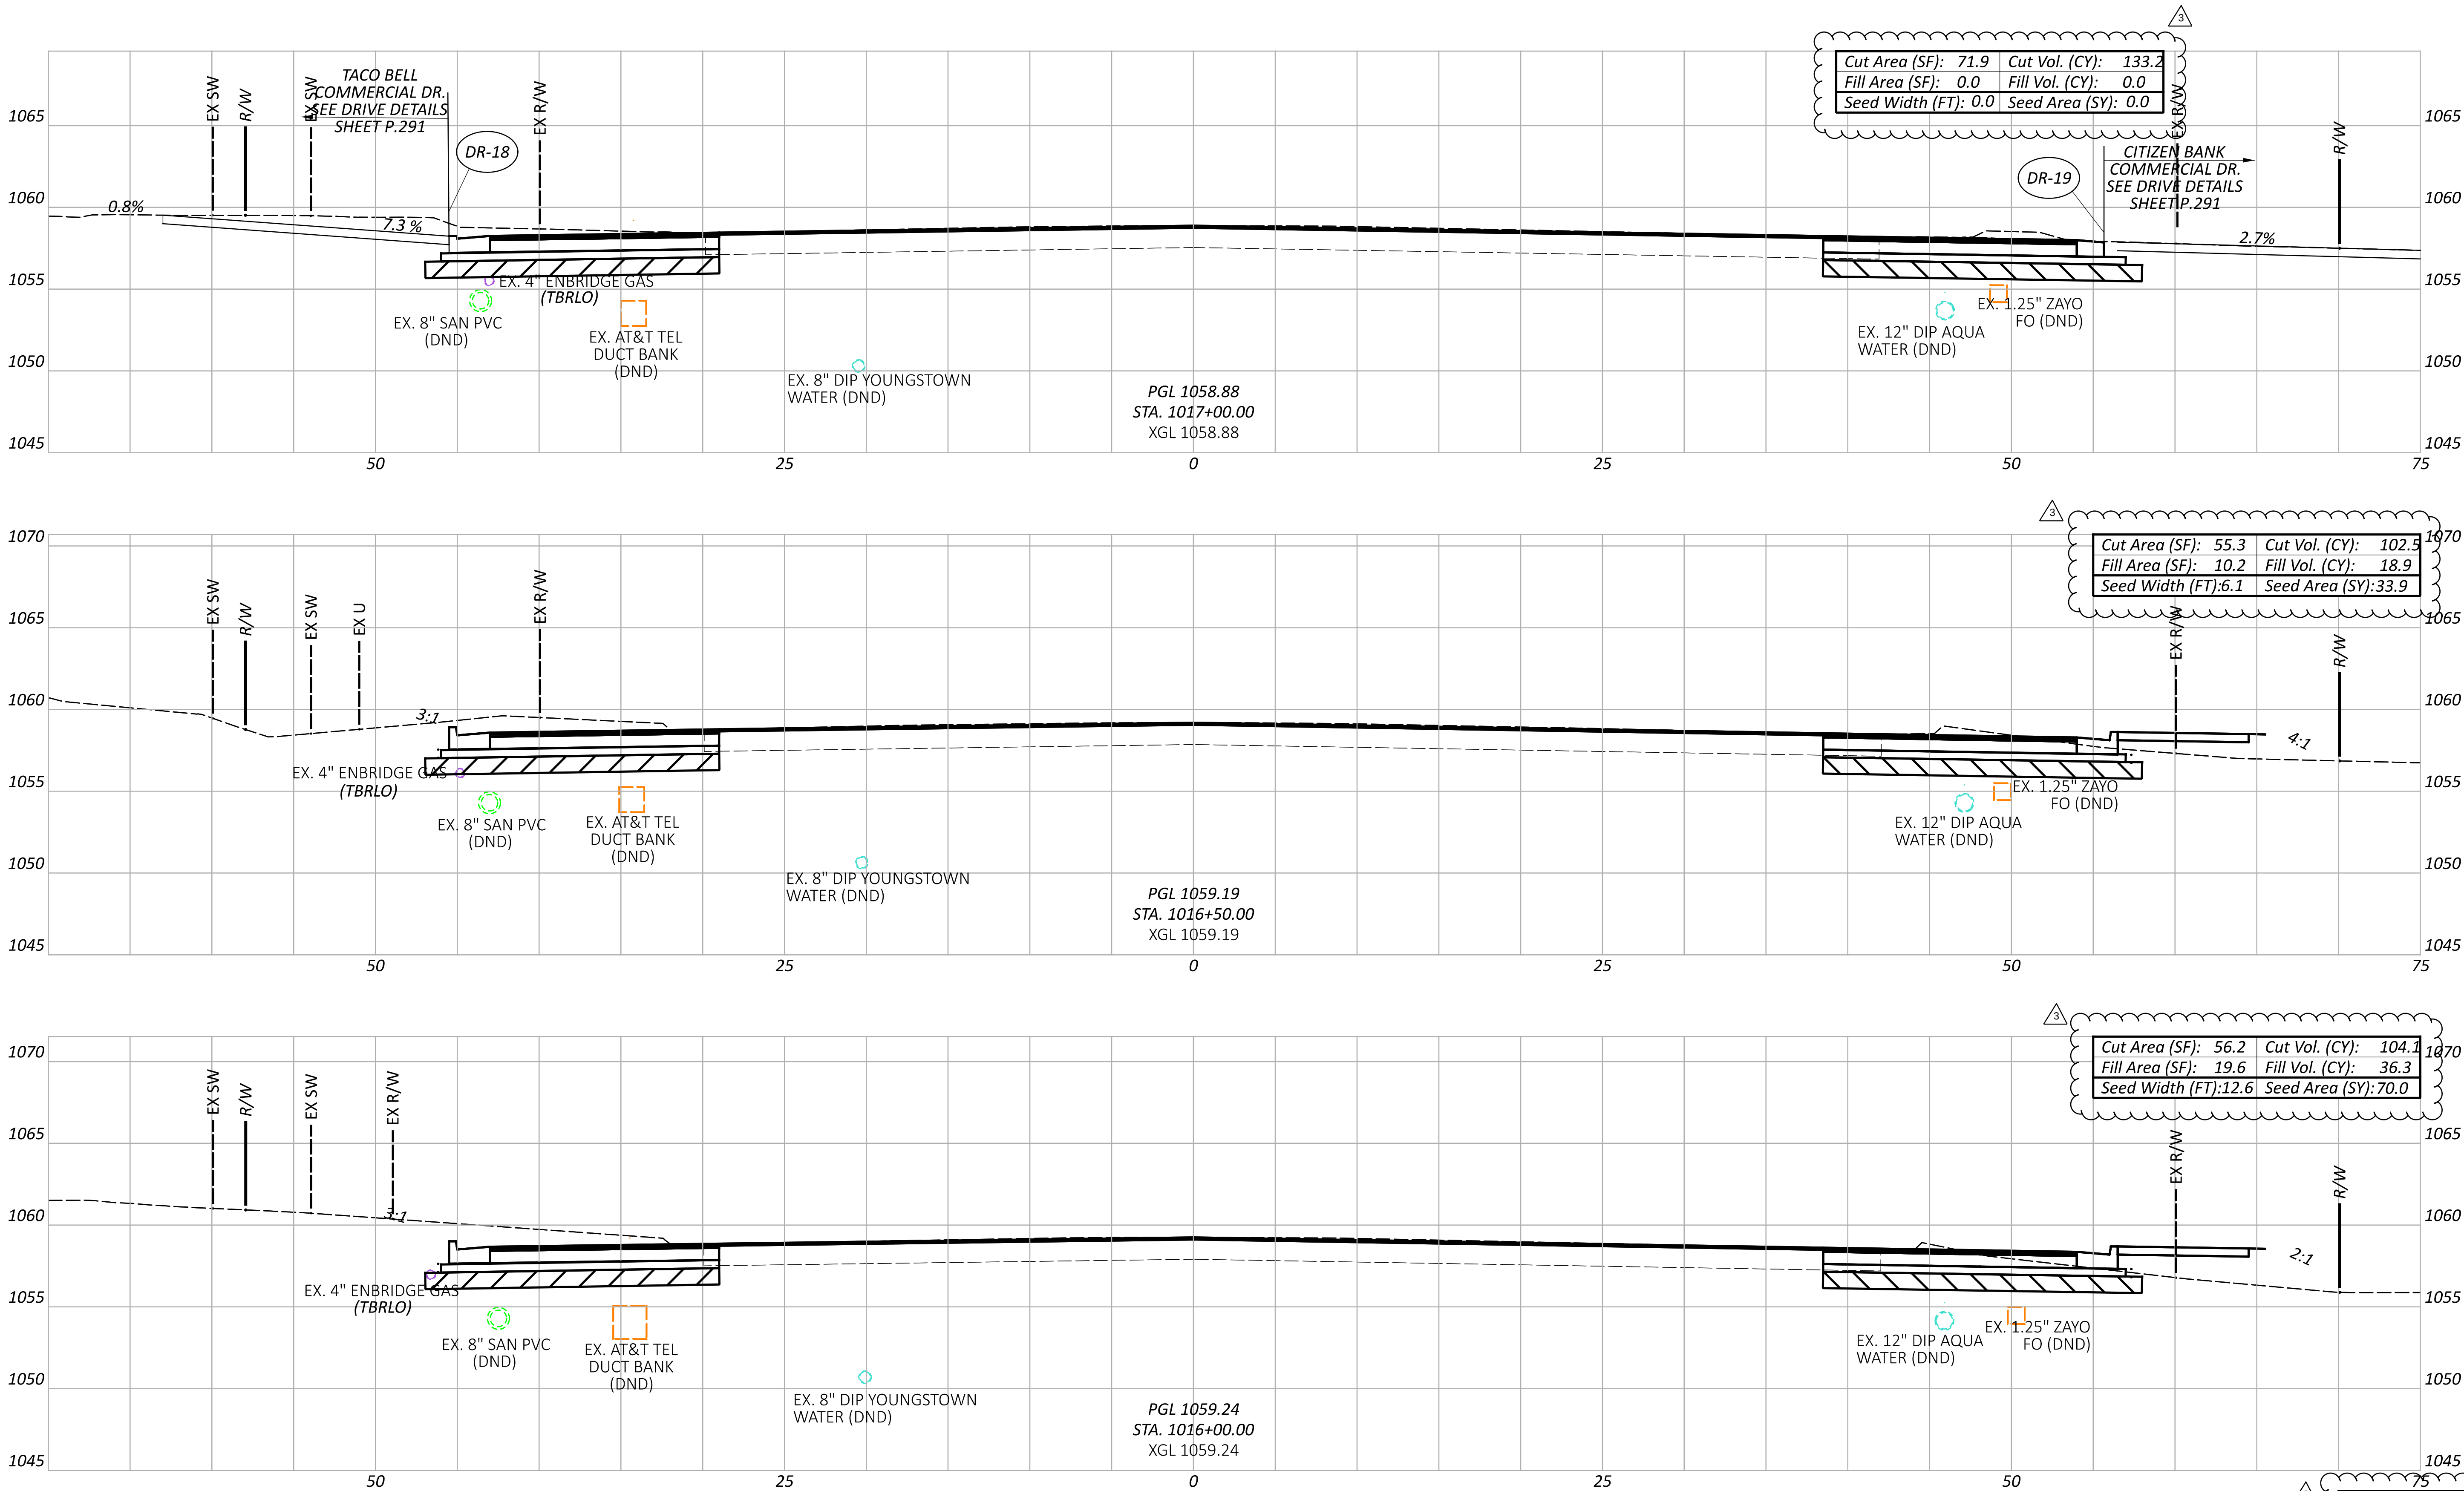

Item 204 - Granular Material, Type B, with Geotextile Fabric

Sheet Totals			SHEET TOTAL
Seeding	Cut	Fill	
103.9	339.8	55.2	499

CROSS SECTIONS - U.S. 224
STA. 1016+00.00 TO STA. 1017+00.00

DESIGN AGENCY

PRIME
8415 Pulsar Place Suite 300
Columbus Ohio 43240

DESIGNER

MGW

REVIEWER

SA 03/27/26

PROJECT ID

115790


SHEET

1

TOTAL

439

MODEL: CLP_U224 - 1017+50.00 [Sheet] PAPER SIZE: 34x22 [in] DATE: 7/13/2026 TIME: 9:44:34 PM PLTDRY: OHDOT_OHDOT_PDF-plotcpg PENTBL: OHDOT_Uten.tbl USER: macen.whitrett@primeeng.com WORKSPACE: OHDOTcvs02 WORKSET: 115790 PRODUCT: OpenRoadsDesigner 24.00.02.25
\\ohidot-pw.bentley.com:ohidot-pw-02\Documents\01 Active Projects\District 04\Mahoning\115790\402-Engineering_PrimeEngineering\Roadway\Sheets\115790_XS003.dgn

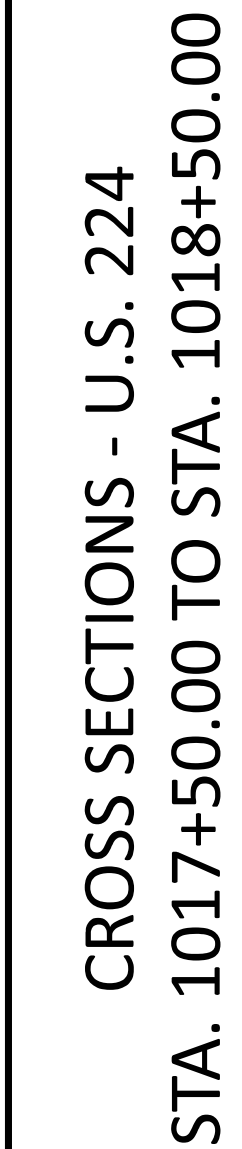


1. FOR AREAS WHERE FULL DEPTH PAVEMENT WIDENING IS PROPOSED, SUBGRADE COMPACTION SHALL BE PERFORMED. FOR THE PROPOSED LIMITS FOR FULL DEPTH WIDENING, SEE THE TYPICAL SECTIONS ON SHEETS THRU .

 Item 204 - Granular Material, Type B, with Geotextile Fabric

Sheet Totals			PROJECT ID	115790
Seeding	Cut	Fill	SHEET	TOTAL
130.0	332.6	11.7	9.229	439

DESIGN AGENCY	
 PRIMER 8415 Bayview Plaza Suite 300 Columbus Ohio 43240	
DESIGNER	
MGW	
REVIEWER	
SA 03/27/26	
PROJECT ID	
115790	
SHEET	TOTAL
7	439

ADDENDUM # 3 - 07/14/2026

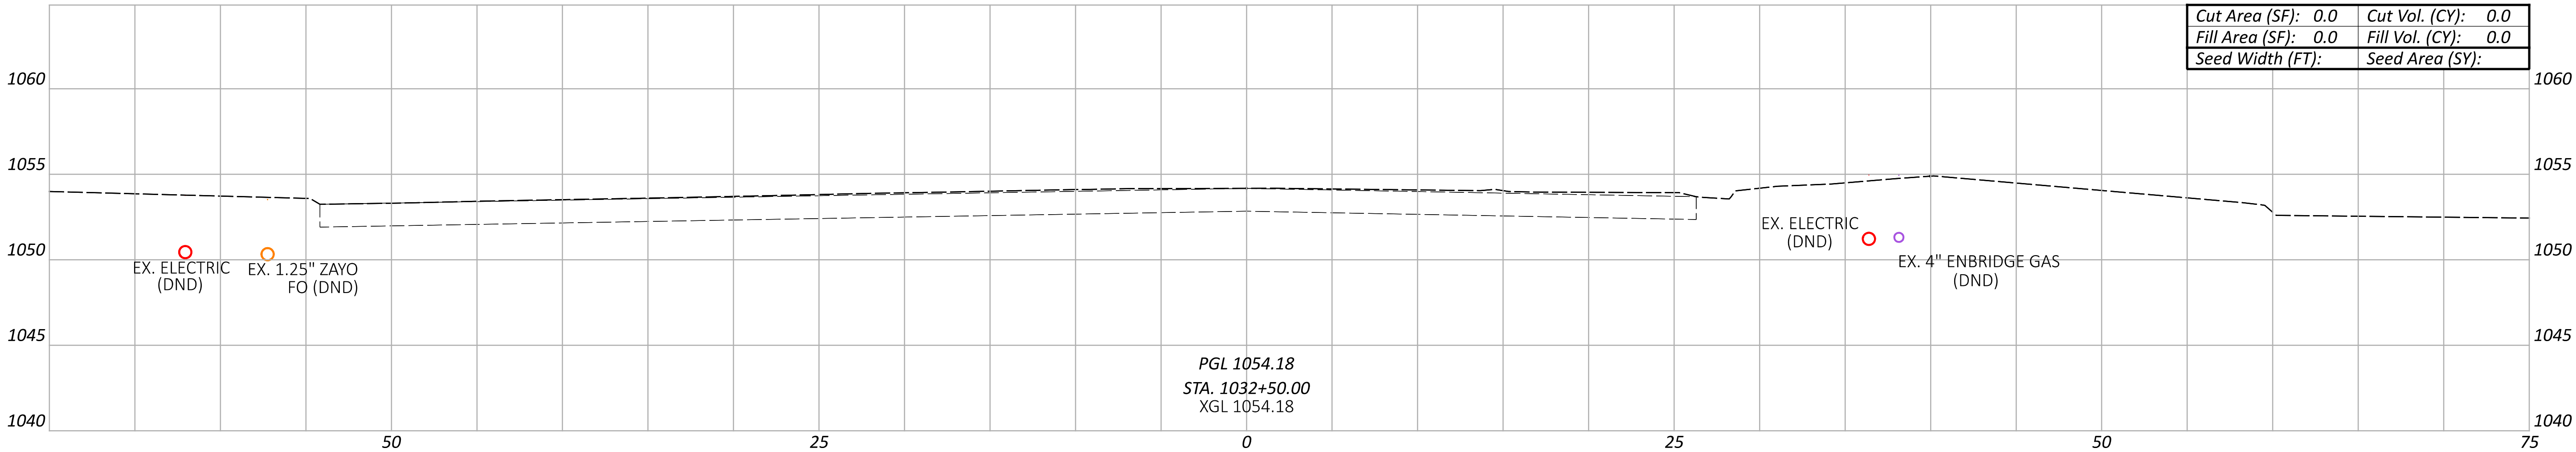

NOTES


1. FOR AREAS WHERE FULL DEPTH PAVEMENT WIDENING IS PROPOSED, SUBGRADE COMPACTION SHALL BE PERFORMED.
FOR THE PROPOSED LIMITS FOR FULL DEPTH WIDENING, SEE THE TYPICAL SECTIONS ON SHEETS P.4 THRU P.14.

Sheet Totals		
Seeding	Cut	Fill
0.0	0.0	0.0

US 224 TOTAL		
SEEDING (SY)	CUT (CY)	FILL (CY)
7,492.4	8047.0	2069.6

PROJECT ID	115790
SHEET	239
TOTAL	439

ROADWAY	SHEET NO.	SEEDING (SY)	CUT (CY)	FILL (CY)
US 224	P.239	7,492.4	8047.0	2069.6
MARKET STREET	P.250	729.8	534.0	30.0
CALIFORNIA AVENUE	P.251	25.8	6.1	1.3
SOUTHERN BOULEVARD	P.261	663.5	870.1	163.7
SOUTH AVENUE	P.265	147.8	202.9	147.8
TOTALS CARRIED TO GENERAL SUMMARY		9060	9,661	2,412.4

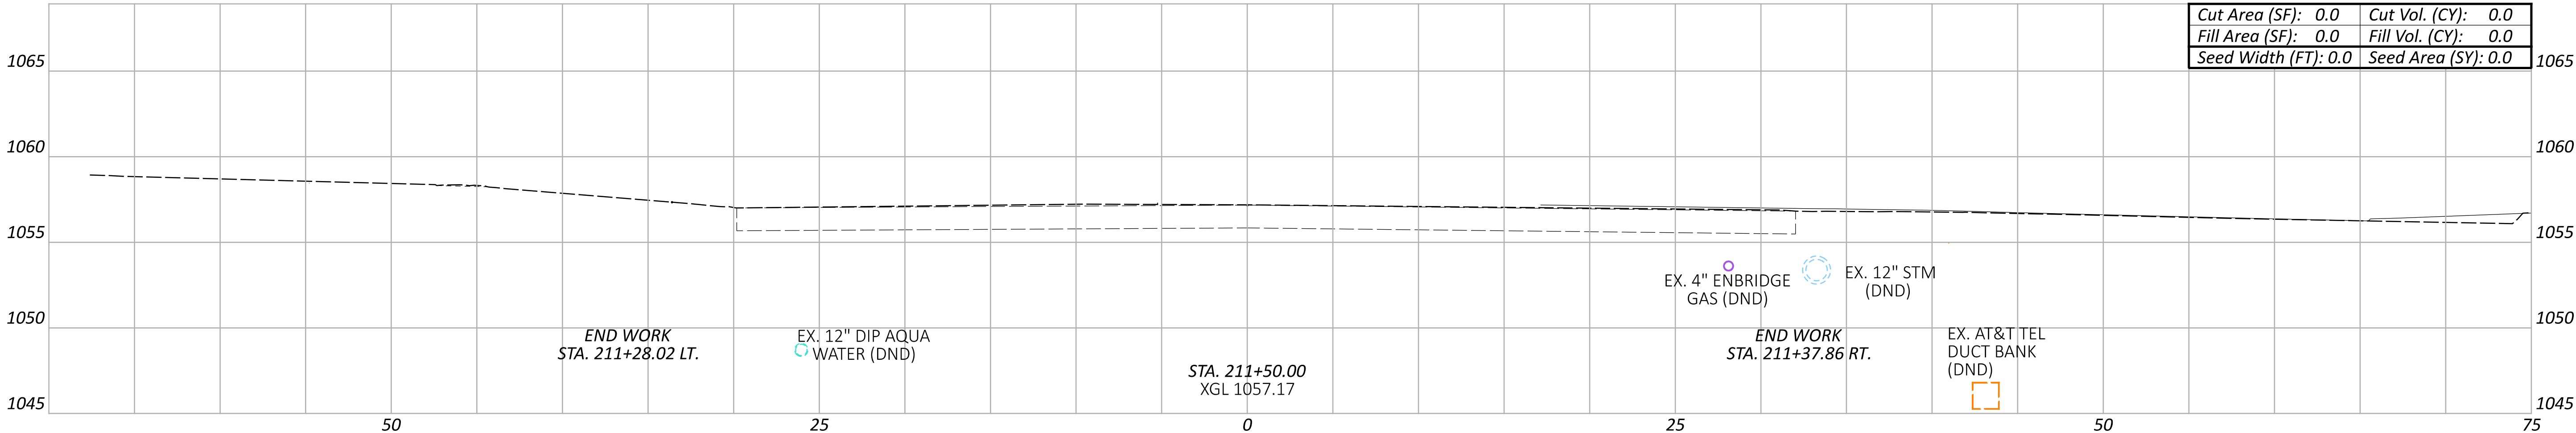

NOTES

1. FOR AREAS WHERE FULL DEPTH PAVEMENT WIDENING IS PROPOSED, SUBGRADE COMPACTION SHALL BE PERFORMED.
FOR THE PROPOSED LIMITS FOR FULL DEPTH WIDENING, SEE THE TYPICAL SECTIONS ON SHEETS P.4 THRU P.14.

Sheet Totals		
Seeding	Cut	Fill
0.0	0.0	0.0



SOUTH AVE TOTALS		
SEEDING (SY)	CUT (CY)	FILL (CY)
147.8	202.9	29.7

DESIGN AGENCY	
 PRIME 8415 Pulsar Place Suite 300 Columbus Ohio 43240	
DESIGNER	
MGW	
REVIEWER	
SA	03/27/26
PROJECT ID	
115790	
SHEET	TOTAL
P.265	439

CROSS SECTIONS - SOUTH AVE.
STA. 211+50.00

- SEE SHEET P.266 FOR LEGEND

* - CONTRACTOR SHALL VERIFY DEPTH PRIOR TO BEGINNING WORK.
DEPTHS OF EXISTING UTILITIES ARE ASSUMED UNTIL VERIFIED IN THE FIELD.

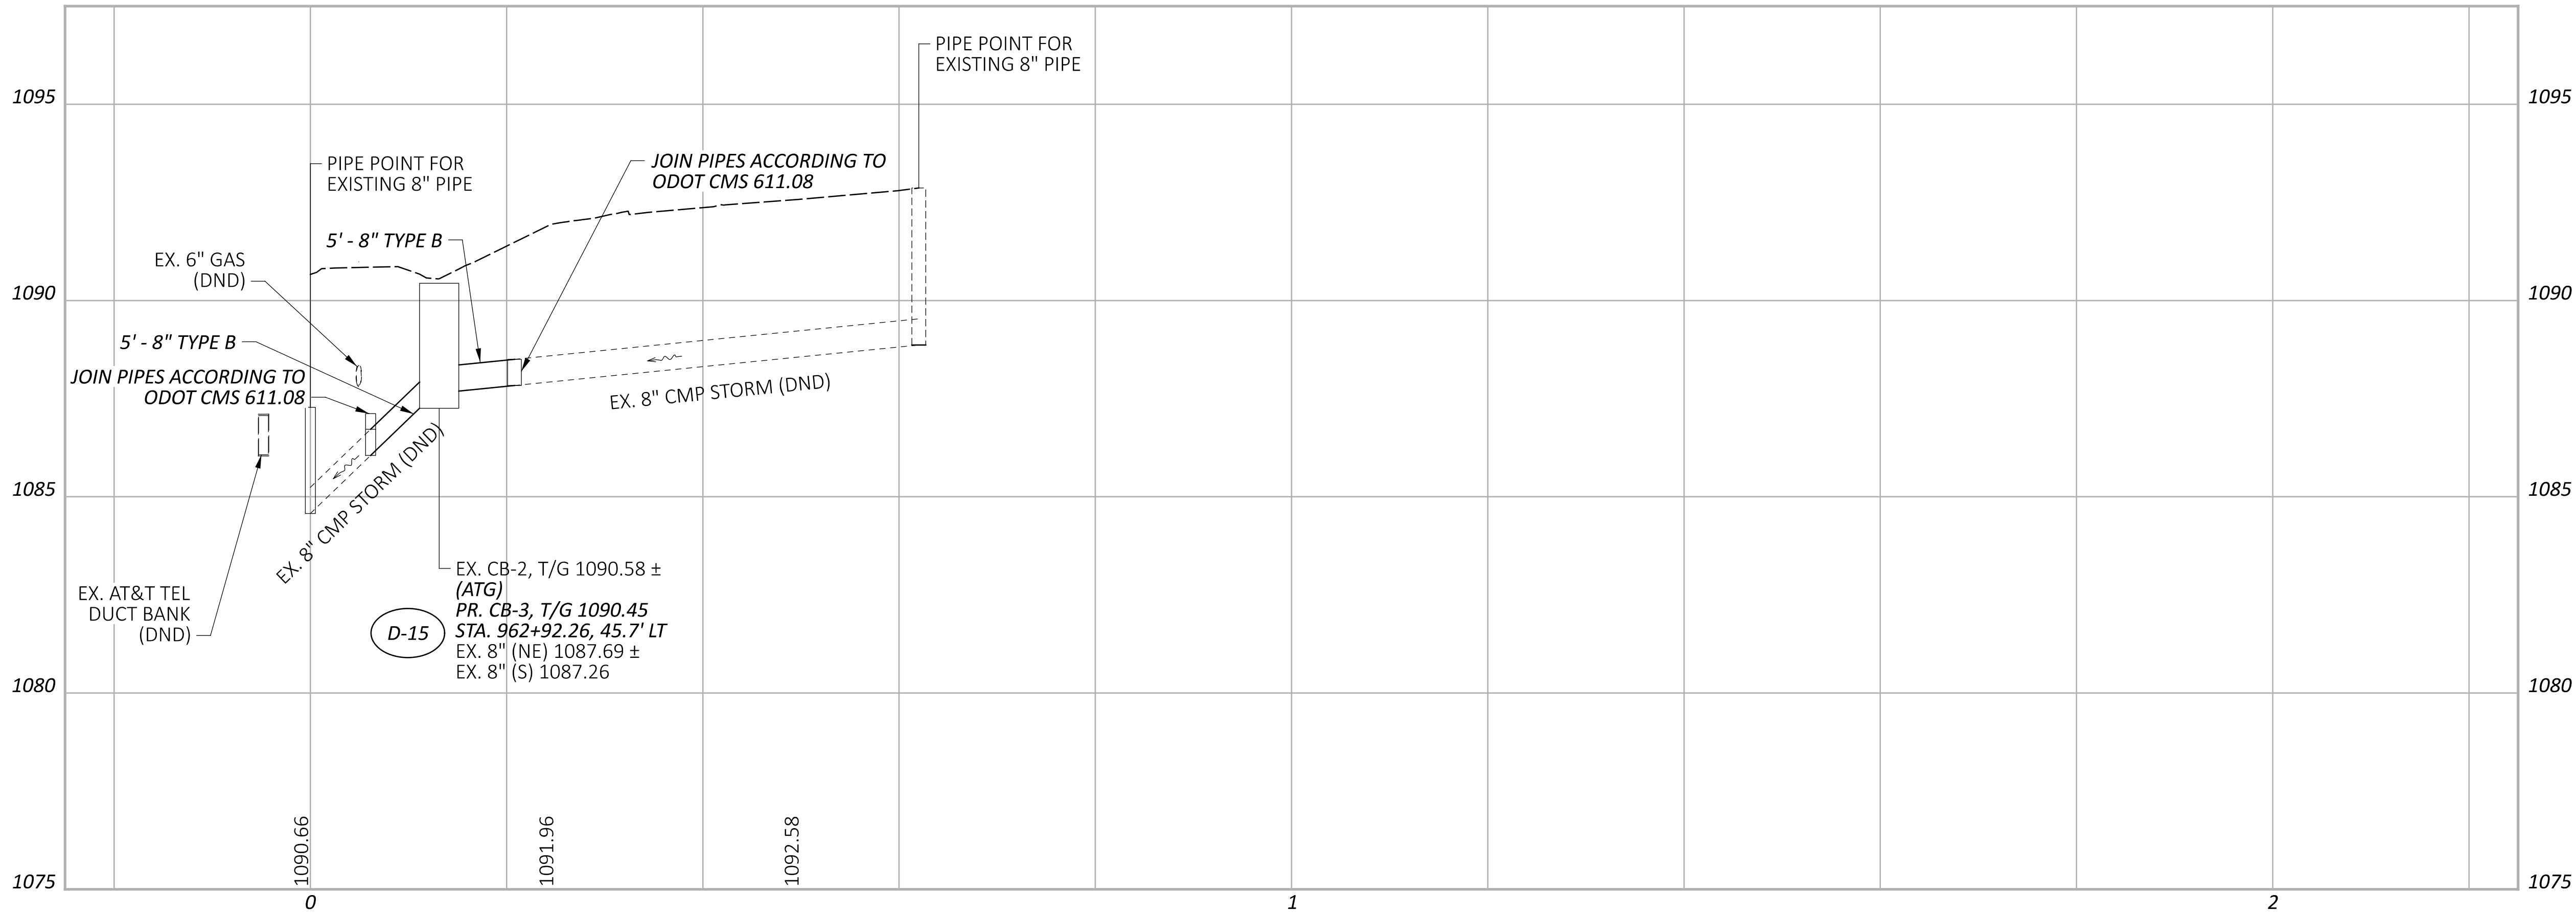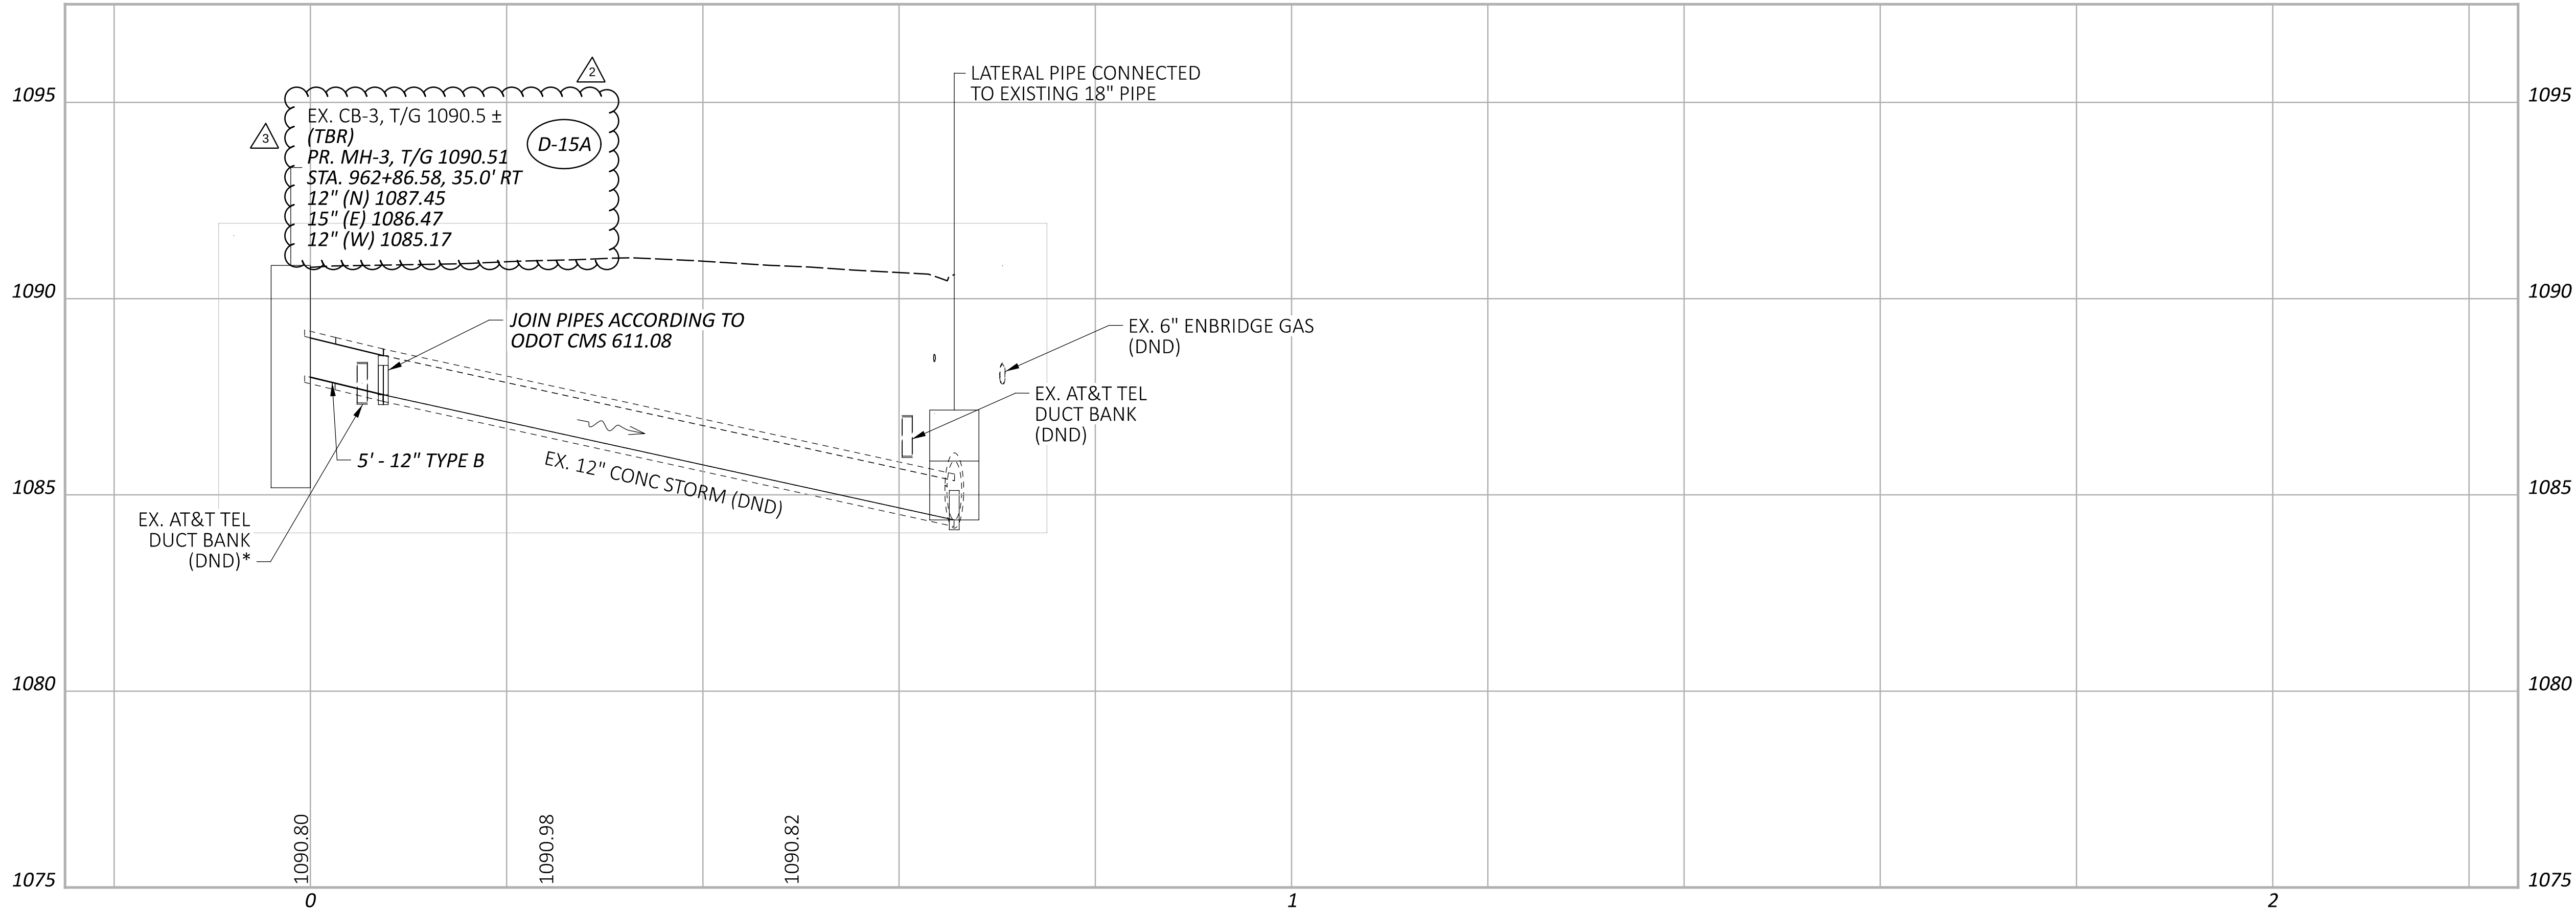

STORM SEWER PROFILES
D-15A, D-15

DESIGN AGENCY



DESIGNER

MGW

REVIEWER

SA 03/27/26

PROJECT ID

115790

SHEET

P.268

TOTAL

439