



F:\Clients\Active\001\001266\10448\MAR-423-7.40\Design\Roadway\Sheets\10448_GY002.dgn Sheet 12/28/2022 8:30:58 AM morr

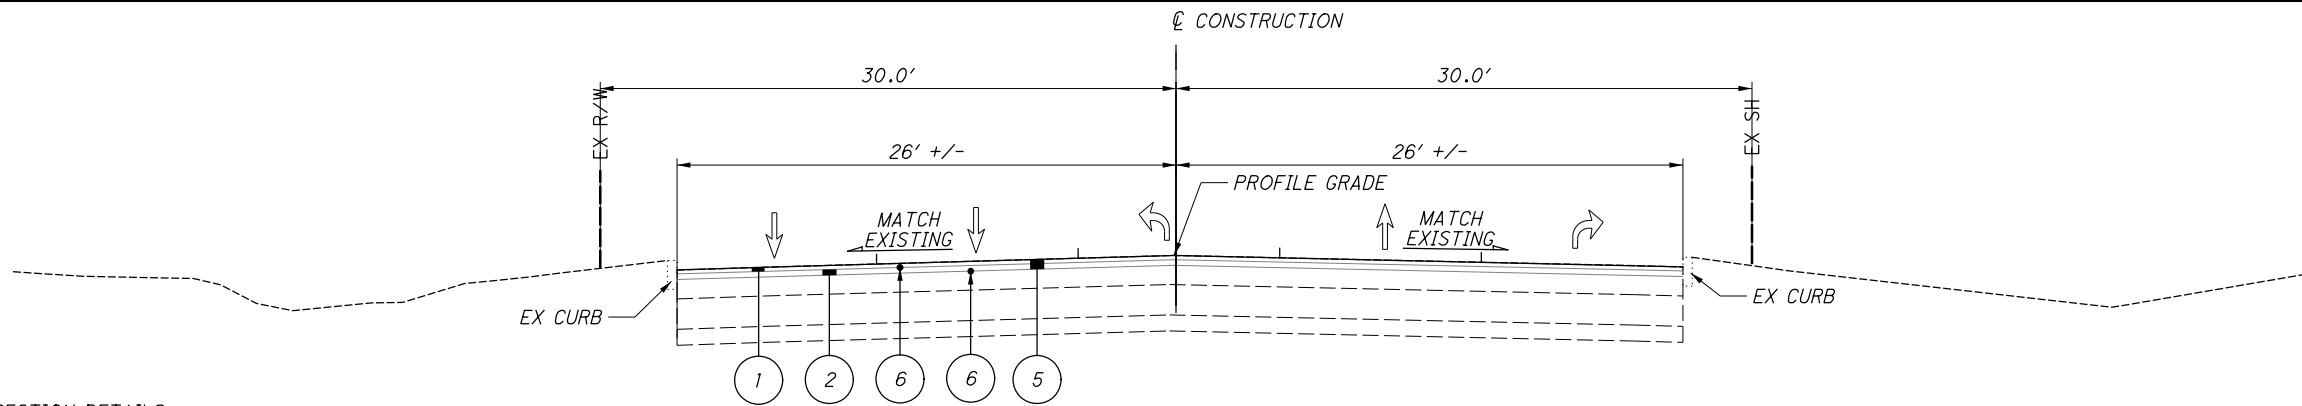

NORMAL SECTION - BARKS ROAD
STA. 19+54.27 TO STA. 20+34.50

A SEE INTERSECTION DETAILS

B 12.5' FROM STA. 20+62.74 TO STA. 23+00.00 TAPERS FROM 12.5' TO 0' STA. 23+00.00 TO STA. 23+50.00

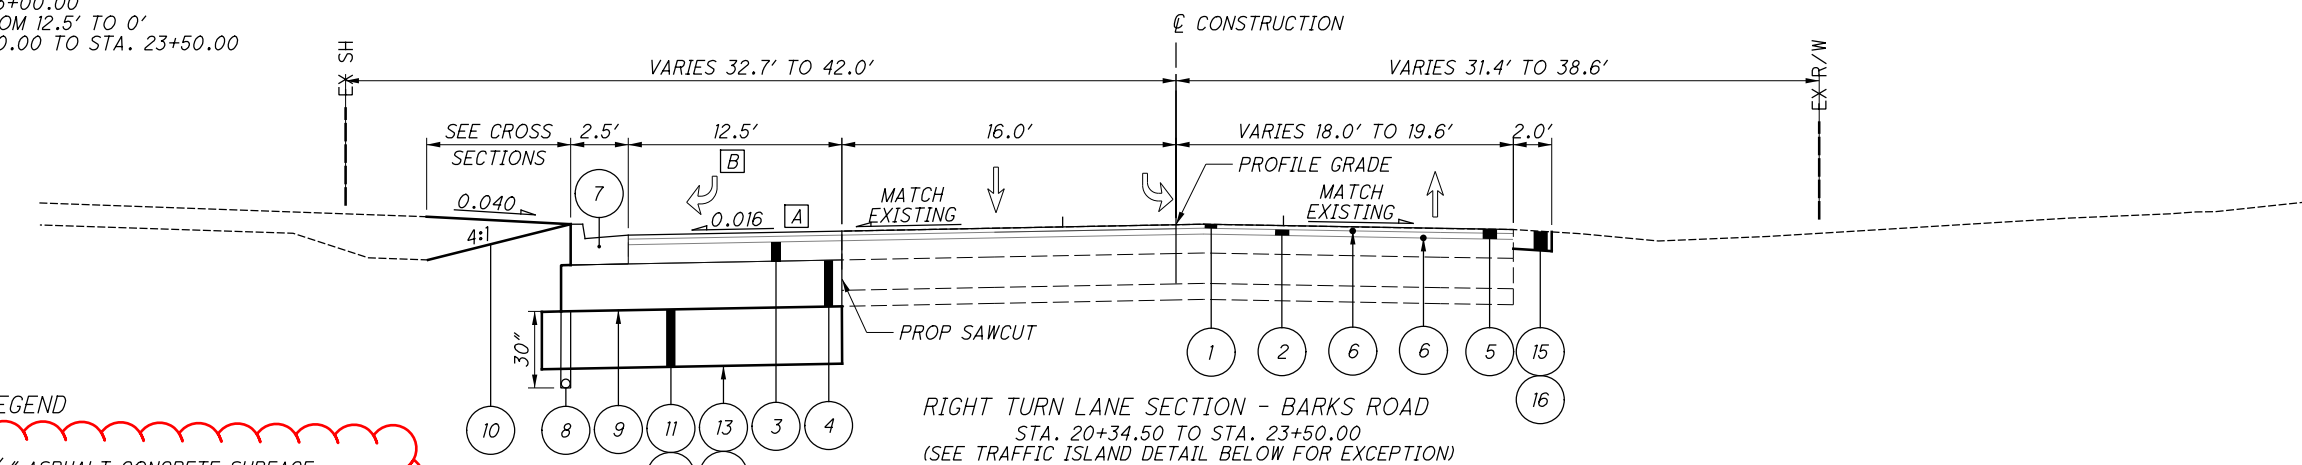


RIGHT TURN LANE SECTION - BARKS ROAD
STA. 20+34.50 TO STA. 23+50.00
(SEE TRAFFIC ISLAND DETAIL BELOW FOR EXCEPTION)


LEGEND

- 1 ITEM 442 - 1 1/2" ASPHALT CONCRETE SURFACE COURSE, 12.5MM, TYPE B (449)
- 2 ITEM 442 - 1 3/4" ASPHALT CONCRETE INTERMEDIATE COURSE, 12.5MM, TYPE B (449)

- 3 ITEM 301 - 6" ASPHALT CONCRETE BASE, PG64-22, (449)
- 4 ITEM 304 - 9" - 14" (12" AVG) AGGREGATE BASE, AS PER PLAN (MATCH EXISTING SUBGRADE)
- 5 ITEM 254 - 3 1/4" PAVEMENT PLANING, ASPHALT CONCRETE
- 6 ITEM 407 - NON-TRACKING TACK COAT (RATE PER CMS TABLE 407.06-1)
- 7 ITEM 609 - COMBINATION CURB AND GUTTER, TYPE 2
- 8 ITEM 605 - 6" SHALLOW PIPE UNDERDRAIN
- 9 ITEM 204 - SUBGRADE COMPACTION
- 10 ITEM 659 - SEEDING AND MULCHING
- 11 ITEM 204 - EXCAVATION OF SUBGRADE, 18"
- 12 ITEM 204 - GRANULAR MATERIAL, TYPE B, 18"
- 13 ITEM 204 - GEOTEXTILE FABRIC
- 14 ITEM 204 - GEOGRID
- 15 ITEM 304 - 6" AGGREGATE BASE
- 16 ITEM 408 - PRIME COAT
- 17 ITEM 609 - CONCRETE TRAFFIC ISLAND (STD DWG RM-3.1)

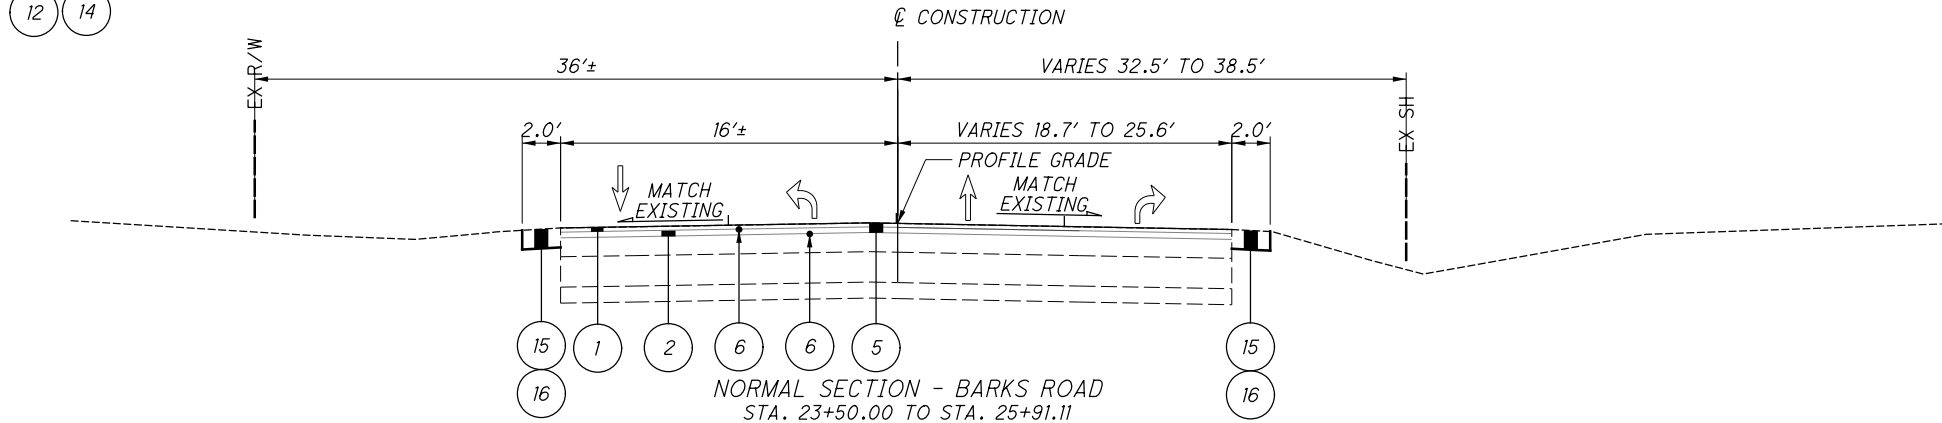

NORMAL SECTION - BARKS ROAD
STA. 23+50.00 TO STA. 25+91.11
(SEE TRAFFIC ISLAND DETAIL BELOW FOR EXCEPTION)

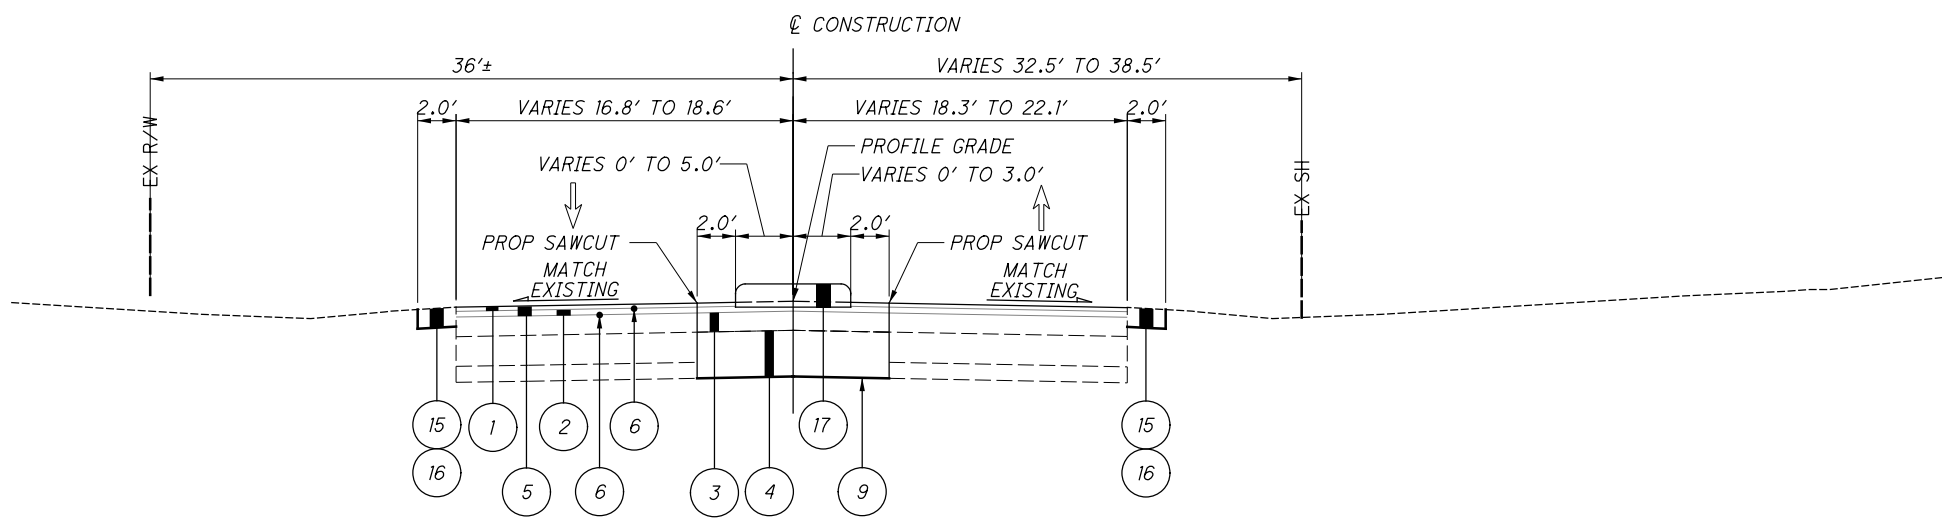

TRAFFIC ISLAND - BARKS ROAD
STA. 23+19.28 TO STA. 24+45.80

F:\Clients\Active\001\001266\10448_MAR-423-7.40\Design\Roadway\Sheets\10448_GS001.dgn Sheet 12/28/2022 8:33:16 AM morr

STATION	SIDE	CAD AREA			202		204					252	254	301	304		407	408	442		452	609
		SURFACE	SURFACE	SURFACE	PAVEMENT REMOVED	CONCRETE MEDIAN REMOVED	SUBGRADE COMPACTION	EXCAVATION OF SUBGRADE, 18"	GRANULAR MATERIAL, TYPE B, 18"	GEOTEXTILE FABRIC	GEOGRID	FULL DEPTH PAVEMENT SAWING	PAVEMENT PLANING, ASPHALT CONCRETE, 3 1/4"	ASPHALT CONCRETE BASE, PG64-22, (449) 6"	AGGREGATE BASE, AS PER PLAN, 9"-14"	AGGREGATE BASE, 6"	NON-TRACKING TACK COAT	PRIME COAT	ASPHALT CONCRETE SURFACE COURSE, 12.5MM, TYPE B (449), 1 1/2"		ASPHALT CONCRETE INTERMEDIATE COURSE, 12.5MM TYPE B (449), 1 3/4"	8" NON-REINFORCED CONCRETE PAVEMENT, CLASS QC MS
		SF	SF	SF	SY	SY	SY	CY	CY	SY	SY	FT	SY	CY	CY	CY	GAL	GAL	CY	CY	SY	SY
BARKS RD - FULL DEPTH																						
20+35	23+50	3937	5453	349	39		606	303	303	606	606	369		73	236		52		18	21	39	
BARKS RD - RESURFACING																						
19+54	25+91	19671											2186		30	262	5		91	106		
SR 423 - FULL DEPTH																						
124+85	125+92	118			13		13					92		2	5		2		1	1		
SR 423 - RESURFACING																						
113+43	127+42	86743											9638		52	1157	19		402	469		
TRAFFIC ISLANDS																						
23+19	24+46	820	1346		150		150					269		15	23		5			7		91
114+43	115+92	963	1734		193		193					316		18	27		6			9		107
122+04	123+43	893	1608		179		179					294		17	25		6			9		99
125+81	127+42		821			91	91					330		15	23		5		4	4		
TOTALS CARRIED TO GENERAL SUMMARY					573	91	1231	303	303	606	606	1670	11824	140	338	82	1496	24	515	626	39	297

PRIME COAT
 ASPHALT CONCRETE SURFACE COURSE, 12.5MM, TYPE B (449), 1 1/2"
 ASPHALT CONCRETE INTERMEDIATE COURSE, 12.5MM TYPE B (449), 1 3/4"
 8" NON-REINFORCED CONCRETE PAVEMENT, CLASS QC MS

MAR-423-7.40	CALCULATED MRO CHECKED NRV
PAVEMENT CALCULATIONS	