


STATE OF OHIO DEPARTMENT OF TRANSPORTATION

MEG POMEROY PATH PHASE 4

VILLAGE OF POMEROY

MEIGS COUNTY

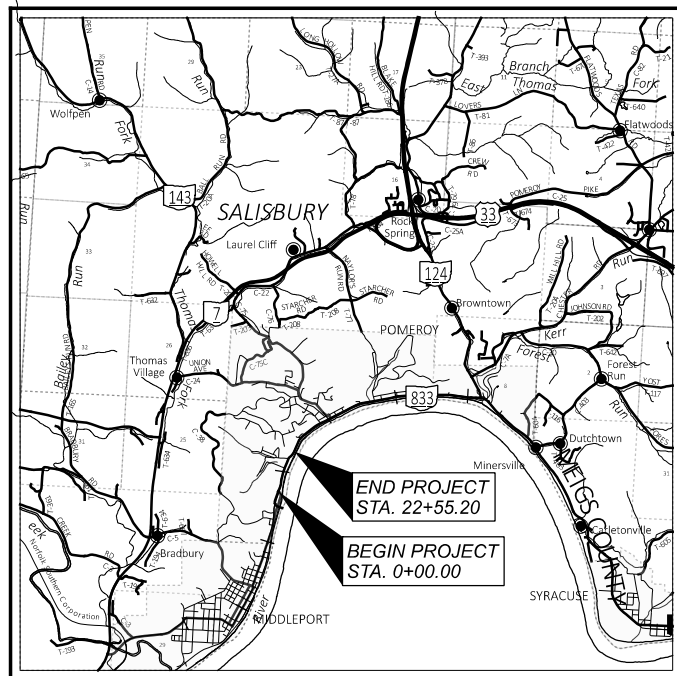

LOCATION MAP

LATITUDE: N39°01'07" LONGITUDE: W82°02'34"



PORTION TO BE IMPROVED	-----	=====
INTERSTATE HIGHWAY	-----	=====
FEDERAL ROUTES	-----	=====
STATE ROUTES	-----	=====
COUNTY & TOWNSHIP ROADS	-----	=====
OTHER ROADS	-----	=====

DESIGN DESIGNATION

CURRENT ADT (20_)	-----	N/A
DESIGN YEAR ADT (20_)	-----	N/A
DESIGN HOURLY VOLUME (20_)	-----	N/A
DIRECTIONAL DISTRIBUTION	-----	N/A
TRUCKS (24 HOUR B&C)	-----	N/A
DESIGN SPEED	-----	N/A
LEGAL SPEED	-----	N/A
DESIGN FUNCTIONAL CLASSIFICATION:		
PEDESTRIAN SHARED USE PATH	-----	
NHS PROJECT	-----	NO

DESIGN EXCEPTIONS

NONE

ADA DESIGN WAIVERS

NONE

UNDERGROUND UTILITIES
Contact Two Working Days
Before You Dig

OHIO811.org
Before You Dig

OHIO 811, 8-1-1, or 1-800-362-2764
(Non members must be called directly)

PLAN PREPARED BY:
FISHBECK, THOMPSON, CARR & HUBER, INC.
1 E. CAMPUS VIEW BLVD., SUITE 310
COLUMBUS, OH 43235

ENGINEER'S SEAL



INDEX OF SHEETS:

TITLE SHEET	1
SCHEMATIC PLAN	2
TYPICAL SECTIONS	3
GENERAL NOTES	4
MAINTENANCE OF TRAFFIC	5
GENERAL SUMMARY	6-7
SUBSUMMARIES	8-9
PLAN AND PROFILE	10-14
CROSS SECTIONS	15-26
DRIVE DETAILS	27-28
LIGHTING GENERAL NOTES	29
LIGHTING PLAN	30-31

STANDARD CONSTRUCTION DRAWINGS				SUPPLEMENTAL SPECIFICATIONS	SPECIAL PROVISIONS
BP-3.1	1/21/22	HL-10.11	7/15/22	800 SEE PROPOSAL	
BP-4.1	7/19/13	HL-10.13	1/20/23	813 10/17/18	
BP-5.1	7/15/22	HL-20.11	10/21/22	832 7/15/22	
BP-7.1	7/21/22	HL-30.11	1/15/21	913 4/16/21	
		HL-30.21	4/17/20		
		HL-30.22	1/15/21		
		HL-40.20	7/15/22		
MT-97.10	4/19/19	HL-60.11	7/21/17		
MT-101.90	7/17/20	HL-60.31	1/17/20		
DM-1.1	7/17/20	HW-2.1	7/20/18		
DM-4.4	1/15/16	MH-3	7/16/21		

FEDERAL PROJECT NUMBER

E200(016)

RAILROAD INVOLVEMENT

NONE

PROJECT DESCRIPTION

CONSTRUCT A SHARED USE PATH BEGINNING AT THE INTERSECTION OF SR 833 AND MAIN ST (CURRENT TERMINI OF POMEROY PATH PHASE 3) AND EXTEND APPROXIMATELY 0.43 MILES TO THE INTERSECTION OF DIAMOND ST. AND MAIN ST. WORK WILL INCLUDE PAVING, LIGHTING, AND MINIMAL DRAINAGE AND EARTHWORK.

EARTH DISTURBED AREAS

PROJECT EARTH DISTURBED AREA: 0.8 ACRES
ESTIMATED CONTRACTOR EARTH DISTURBED AREA: 0.1 ACRES
NOTICE OF INTENT EARTH DISTURBED AREA: 0.9 ACRES

2019 SPECIFICATIONS

THE STANDARD SPECIFICATIONS OF THE STATE OF OHIO, DEPARTMENT OF TRANSPORTATION, INCLUDING SUPPLEMENTAL SPECIFICATIONS LISTED IN THE PLANS AND CHANGES LISTED IN THE PROPOSAL SHALL GOVERN THIS IMPROVEMENT.

I HEREBY APPROVE THESE PLANS AND DECLARE THAT THE MAKING OF THIS IMPROVEMENT WILL NOT REQUIRE THE CLOSING TO TRAFFIC OF THE HIGHWAY AND THAT PROVISIONS FOR THE MAINTENANCE AND SAFETY OF TRAFFIC WILL BE AS SET FORTH ON THE PLANS AND ESTIMATES.

DISTRICT DEPUTY DIRECTOR

Rich Oster
District 10 Deputy Director

DIRECTOR, DEPARTMENT OF TRANSPORTATION

TITLE SHEET

DESIGN AGENCY



DESIGNER

JBT

REVIEWER

JAH 01/31/23

PROJECT ID

111209

SHEET TOTAL


1 | 31

MEG-POMEROY PATH PH4

MODEL: Sheet PAPER: 17x11 (in.) DATE: 5/6/2023 TIME: 12:25:22 PM USER: jthomas Z:\2022\2211209\400-Engineering\Roadway\Sheets\111209_GT001.dgn

SHEET NUM.											PART.		ITEM	ITEM EXT	GRAND TOTAL	UNIT	DESCRIPTION	SEE SHEET NO.
9											01/ENH/28	02/ENH/01						
LIGHTING CONTINUED																		
1											1		625	75500	1	EACH	LIGHT POLE FOUNDATION REMOVED	
1											1		625	75506	1	EACH	LUMINAIRE REMOVED	
1											1		625	75520	1	EACH	LUMINAIRE SUPPORT REMOVED	
TRAFFIC CONTROL																		
2											2		630	84900	2	EACH	REMOVAL OF GROUND MOUNTED SIGN AND DISPOSAL	
5											5		630	85100	5	EACH	REMOVAL OF GROUND MOUNTED SIGN AND REERECTION	
290											290		644	01200	290	FT	PARKING LOT STALL MARKING	
1											1		647	20200	1	EACH	HANDICAP SYMBOL MARKING, TYPE A90	
INCIDENTALS																		
											LS		103	05000	LS		PREMIUM FOR CONTRACT PERFORMANCE BOND AND FOR PAYMENT BOND	
											LS		614	11000	LS		MAINTAINING TRAFFIC	
											4		619	16010	4	MNTH	FIELD OFFICE, TYPE B	
											LS		623	10001	LS		CONSTRUCTION LAYOUT STAKES AND SURVEYING, AS PER PLAN	
											LS		624	10000	LS		MOBILIZATION	


GENERAL SUMMARY

DESIGN AGENCY

 DESIGNER
 JBT
 REVIEWER
 JAH 01/31/23
 PROJECT ID
 111209
 SHEET TOTAL
 7 31

STATION RANGE	TYPICAL SECTION	DISTANCE (D)	AVERAGE WIDTH (W)	SURFACE AREA (A) A=DxW/9	CADD GENERATED AREA	202	202	202	204	254	304	407	407	441	441	452	608	609	
						PAVEMENT REMOVED	WALK REMOVED	CURB REMOVED	SUBGRADE COMPACTION	PAVEMENT PLANING, ASPHALT CONCRETE, 1.25" DEPTH	AGGREGATE BASE, 6"	TACK COAT, 0.055 GAL/SY	TACK COAT, 0.085 GAL/SY	ASPHALT CONCRETE SURFACE COURSE, TYPE 1, (449), PG64-22	ASPHALT CONCRETE INTERMEDIATE COURSE, TYPE 1, (449)	8" NON-REINFORCED CONCRETE PAVEMENT, CLASS QC1	4" CONCRETE WALK	CURB, TYPE 4-C	
		FT	FT	SY	SY	SY	SF	FT	SY	SY	CY	GAL	GAL	CY	CY	SY	SF	FT	
0+00.00 TO 3+42.16	1	342.16	6.00						25.00							25.00	2153.31		
3+71.96 TO 4+21.09	1	49.13	6.00														294.78		
4+56.61 TO 4+93.33	1	36.72	6.00														220.32		
5+37.88 TO 5+89.47	1	51.59	6.00				138.70										309.54		
6+55.99 TO 15+26.62	2	870.63																1447.63	
6+55.99 TO 7+46.66	2	90.67	10.00	100.74			408.02	89.40	100.74		16.79				5.60				
8+03.22 TO 9+21.95	2	118.73	10.00	131.92			534.29	119.10	131.92		21.99				7.33				
9+64.89 TO 9+86.43	2	21.54	10.00	23.93			96.93	21.60	23.93		3.99				1.33				
10+35.94 TO 10+83.63	2	47.69	10.00	52.99			214.61	31.60	52.99		8.83				2.94				
11+20.99 TO 11+38.15	2	17.16	10.00	19.07			77.22	17.16	19.07		3.18				1.06				
11+87.21 TO 11+90.00	2	2.79	10.00	3.10			12.55	2.79	3.10		0.52				0.17				
11+90.00 TO 12+00.00	2	10.00	9.00	10.00			45.00	10.00	10.00		1.67				0.56				
12+00.00 TO 15+54.01	2	354.01	8.00	314.68			1593.05	282.80	314.68		52.45				17.48				
15+57.73 TO 16+81.25	3				276.59					276.59		23.51		9.60					
17+18.70 TO 22+51.92	3				790.26					790.26		67.17		27.44					
DRIVEWAYS																			
3+56.97					48.22		48.22		48.22							48.22			
7+71.90					87.17	87.17			87.17							87.17			
9+43.43					71.39	71.39	48.40		71.39							71.39			
10+11.44					84.31	84.31	69.50		84.31							84.31			
11+02.63					63.27	63.27	40.10		63.27							63.27			
11+62.71					82.63	82.63			82.63							82.63			
PARKING LOT																			
PATH SPUR																			
SUBTOTALS						388.77	3168.58	732.45		2042.83	1066.85	263.47	50.84	90.68	105.61	38.52	461.99	3912.69	1447.63
TOTALS CARRIED TO GENERAL SUMMARY						389	3169	733		2043	1067	264	51	91	106	39	462	3913	1448

REF NO.	SHEET NO.	STATION TO STATION	601	602	611	611	611	611
			ROCK CHANNEL PROTECTION, TYPE A WITH FILTER	CONCRETE MASONRY	24" CONDUIT, TYPE C	30" CONDUIT, TYPE C	36" CONDUIT, TYPE C	MANHOLE, NO. 3
			CY	CY	FT	FT	FT	EACH
V-1	11	5+45.33						
V-2	11	8+61.64						
MH-1	10	3+24.44	2.2	0.8	8	8	8	1
MH-2	13	15+39.53						
TOTALS CARRIED TO GENERAL SUMMARY			2.2	0.8	8	8	8	1

ROADWAY AND PAVEMENT SUBSUMMARY

DESIGN AGENCY

 DESIGNER
 JBT
 REVIEWER
 JAH 01/31/23
 PROJECT ID
 111209
 SHEET TOTAL
 8 | 31

