

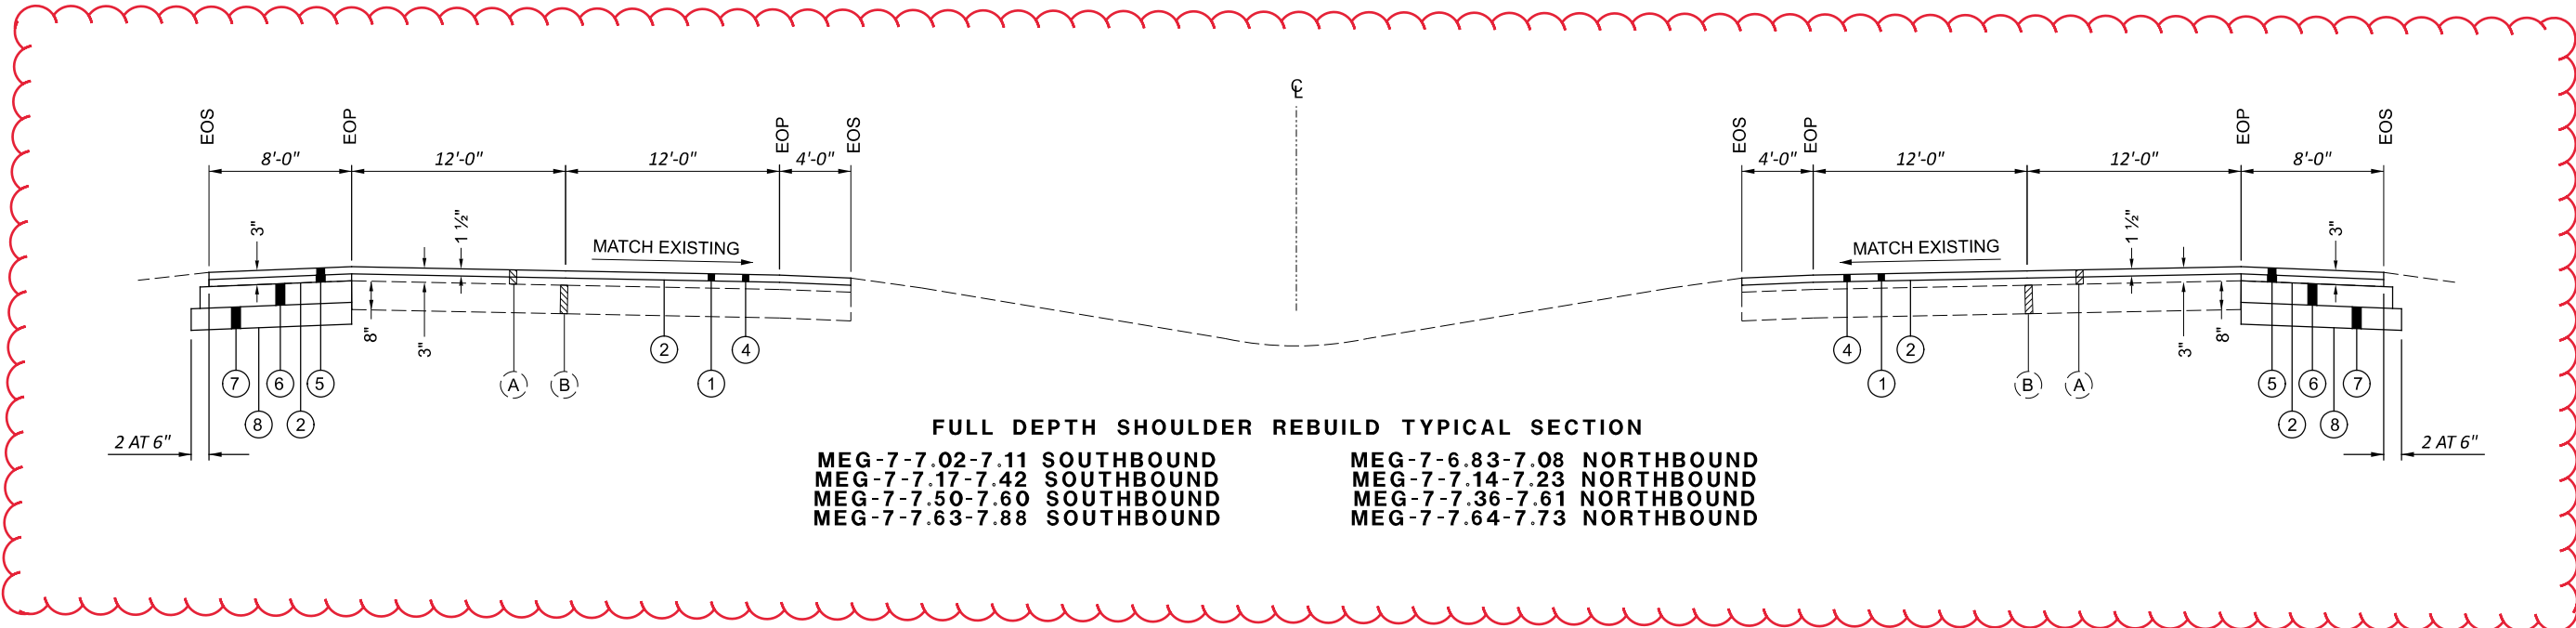


REPAIR TO TOP OF CONCRETE


TYPICAL SECTION
MEG-7-6.25-8.22

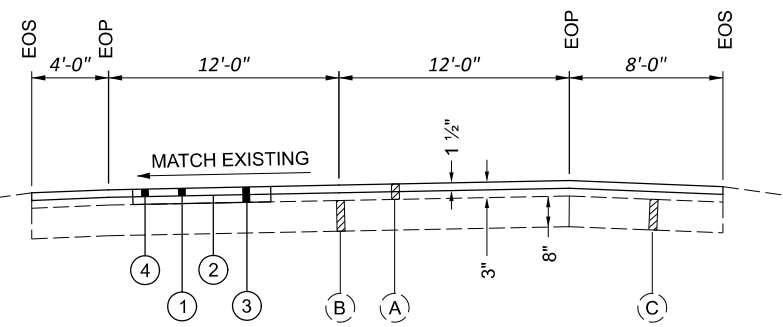

FULL DEPTH SHOULDER REBUILD TYPICAL SECTION
MEG-7-7.02-7.11 SOUTHBOUND **MEG-7-6.83-7.08 NORTHBOUND**
MEG-7-7.17-7.42 SOUTHBOUND **MEG-7-7.14-7.23 NORTHBOUND**
MEG-7-7.50-7.60 SOUTHBOUND **MEG-7-7.36-7.61 NORTHBOUND**
MEG-7-7.63-7.88 SOUTHBOUND **MEG-7-7.64-7.73 NORTHBOUND**

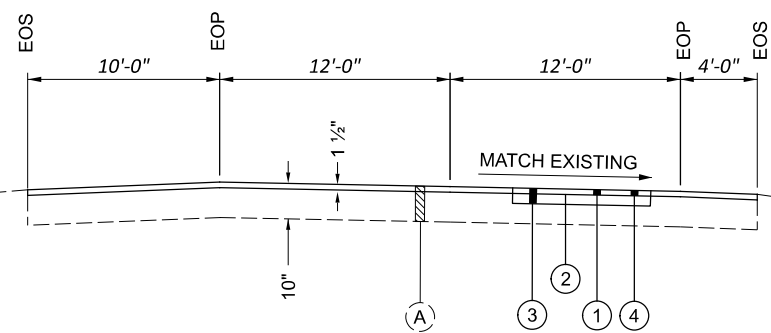

TYPICAL SECTION
MEG-33-10.72-13.32

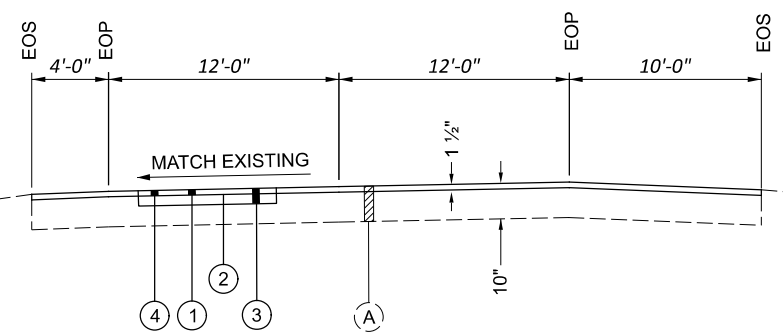

PROPOSED LEGEND

- ① ITEM 442 - ASPHALT CONCRETE SURFACE COURSE, TYPE A, (447)
- ② ITEM 407 - NON-TRACKING TACK COAT (0.08 GAL/SY)
- ③ ITEM 253 - PAVEMENT REPAIR
- ④ ITEM 254 - PAVEMENT PLANING
- ⑤ ITEM 442 - 3" ASPHALT CONCRETE INTERMEDIATE COURSE, 12.5MM, TYPE A (449)
- ⑥ ITEM 301 - 6" ASPHALT CONCRETE BASE, PG64-22, (449)
- ⑦ ITEM 304 - 6" AGGREGATE BASE
- ⑧ ITEM 204 - SUBGRADE COMPACTION

EXISTING LEGEND

- (A) EXISTING ASPHALT
- (B) EXISTING CONCRETE
- (C) AGGREGATE BASE

DESIGN AGENCY



DESIGNER

BAC

REVIEWER

MRF 1-24-22

PROJECT ID

87264

SHEET TOTAL

2 | 14

WORK ZONE SPEED ZONES (WZSZS)

THE FOLLOWING WORK ZONE SPEED ZONE (WZSZ) SPEED LIMIT REVISION(S) HAVE BEEN APPROVED FOR USE ON THIS PROJECT WHEN WORK ZONE CONDITIONS AND FACTORS ARE MET AS DESCRIBED BELOW:

WZSZ REVISION NUMBER(S)	COUNTY-ROUTE-SECTION(S)	DIRECTION(S)
WZ-55289	MEG-33-10.72-13.57	EB AND WB
WZ-55290	MEG-7-6.24-8.22	NB AND SB

POTENTIAL WZSZ LOCATIONS SHALL HAVE AN ORIGINAL (PRE-CONSTRUCTION) POSTED SPEED LIMIT OF 55 MPH OR GREATER, A QUALIFYING WORK ZONE CONDITION OF AT LEAST 0.5 MILE IN LENGTH, AN EXPECTED WORK DURATION OF AT LEAST THREE HOURS, AND A WORK ZONE CONDITION IN PLACE THAT REDUCES THE EXISTING FUNCTIONALITY OF THE TRAVEL LANES OR SHOULDERS (I.E., LANE CLOSURE, LANE SHIFT, CROSSOVER, CONTRAFLOW AND/OR SHOULDER CLOSURE). THE LENGTH OF THE WORK ZONE CONDITION IS MEASURED FROM THE BEGINNING OF THE TAPER FOR THE SUBJECT WORK ZONE CONDITION IMPACTING THE TRAVEL LANES AND/OR SHOULDER TO THE END OF THE DOWNSTREAM TAPER, WHERE DRIVERS ARE RETURNED TO TYPICAL ALIGNMENT. AN EXPECTED WORK DURATION OF AT LEAST THREE HOURS IS REQUIRED TO BALANCE THE ADDITIONAL EXPOSURE CREATED BY INSTALLING AND REMOVING WZSZ SIGNING WITH THE TIME NEEDED TO COMPLETE THE WORK.

IF THE WORK ZONE MEETS THESE MINIMUM CRITERIA, IT SHALL BE ANALYZED FURTHER USING TABLE 1 BELOW TO DETERMINE IF AND WHEN IT QUALIFIES FOR A SPEED LIMIT REDUCTION. DEPENDING ON THE ORIGINAL POSTED SPEED LIMIT, THE TYPE OF TEMPORARY TRAFFIC CONTROL USED, AND WHETHER OR NOT WORKERS ARE PRESENT, A WARRANTED WZSZ WILL VARY IN THE APPROVED SPEED LIMIT TO BE POSTED OVER TIME.

C&MS ITEM 614, PARAGRAPH 614.02(B), INDICATES THAT TWO DIRECTIONS OF A DIVIDED HIGHWAY ARE CONSIDERED SEPARATE HIGHWAY SECTIONS. THEREFORE, IF THE WORK ON A MULTI-LANE DIVIDED HIGHWAY IS LIMITED TO ONLY ONE DIRECTION, A SPEED LIMIT REDUCTION IN THE DIRECTION OF THE WORK DOES NOT AUTOMATICALLY CONSTITUTE A SPEED LIMIT REDUCTION IN THE OPPOSITE DIRECTION. EACH DIRECTION SHALL BE ANALYZED INDEPENDENTLY FROM EACH OTHER.

ALL WZSZS FLUCTUATE BETWEEN TWO APPROVED REDUCED SPEED LIMITS OR BETWEEN AN APPROVED REDUCED SPEED LIMIT AND THE ORIGINAL POSTED SPEED LIMIT. ONLY ONE OF TWO SIGNING STRATEGIES SHALL BE USED TO IMPLEMENT A WZSZ.

ONLY ONE WARRANTED SPEED LIMIT APPLIES AT ANY ONE TIME; SPEED LIMIT REDUCTIONS ARE NOT CUMULATIVE. WZSZS SHALL NOT BE USED FOR MOVING/MOBILE ACTIVITIES, AS DEFINED IN OMTCD PART 6.

WZSZS USING DSL SIGN ASSEMBLIES SHALL BE IN ACCORDANCE WITH THIS NOTE, APPROVED LIST, SUPPLEMENTAL SPECIFICATIONS (SS) 808 AND 908, AND TRAFFIC SCD MT-104.10.

WHEN LOOKING UP THE WARRANTED WORK ZONE SPEED LIMITS, ALWAYS USE THE ORIGINAL, PRECONSTRUCTION, POSTED SPEED LIMIT. DO NOT USE A PRIOR OR CURRENT WORK ZONE SPEED LIMIT AS A LOOK UP VALUE IN THE TABLE. POSITIVE PROTECTION IS GENERALLY REGARDED AS PORTABLE BARRIER OR OTHER RIGID BARRIER IN USE ALONG THE WORK AREA WITHIN THE SUBJECT WARRANTED WORK ZONE CONDITION. WITHOUT POSITIVE PROTECTION IS GENERALLY REGARDED AS USING DRUMS, CONES, SHADOW VEHICLE, ETC., ALONG THE WORK AREA WITHIN THE SUBJECT WARRANTED WORK ZONE CONDITION. WORKERS ARE CONSIDERED AS BEING PRESENT WHEN ON-SITE, WORKING WITHIN THE SUBJECT WARRANTED WORK ZONE CONDITION. WHEN THE WORK ZONE CONDITION REDUCING THE EXISTING FUNCTIONALITY OF THE TRAVEL LANES OR SHOULDERS IS REMOVED, THE SPEED LIMIT DISPLAYED SHALL RETURN TO THE ORIGINAL POSTED SPEED LIMIT.

TABLE 1: WARRANTED WORK ZONE SPEED LIMITS (MPH) FOR WORK ZONES ON HIGH-SPEED (55 MPH OR GREATER) MULTI-LANE HIGHWAYS

TABLE 1	WITH POSITIVE PROTECTION		WITHOUT POSITIVE PROTECTION	
	WORKERS PRESENT	WORKERS NOT PRESENT	WORKERS PRESENT	WORKERS NOT PRESENT
70	60	65	55	65
65	55	60	50	60
60	55	60	50	60
55	50	55	45	55

THE FOLLOWING ESTIMATED QUANTITY HAS BEEN CARRIED TO THE GENERAL SUMMARY.

ITEM 808, DIGITAL SPEED LIMIT (DSL) SIGN ASSEMBLY
 1 SIGN / MILE FOR 4.83 MILES = 5 SIGNS
 5 SIGNS X 2 (DUAL MOUNTED) = 10 SIGNS
 10 SIGNS X 2 (EACH DIRECTION) = 20 SIGNS
 20 SIGNS + 2 SIGNS (1 PER RAMP) = 22 SIGNS
 22 DSL SIGN ASSEMBLIES FOR 2 MONTH = 44 SIGN MONTHS
 44 SIGN MONTHS CARRIED TO GENERAL SUMMARY

ITEM 614, SPEED ZONE AHEAD SIGN
 8 W3-HB SIGNS CARRIED TO THE GENERAL SUMMARY

ITEM 614, RESUME LEGAL SPEED LIMIT SIGN
 4 R2-1 SIGNS CARRIED TO THE GENERAL SUMMARY

FULL DEPTH SHOULDER RECONSTRUCTION

THE OUTSIDE SHOULDERS OF STATE ROUTE 7 SHALL BE REBUILT AS SHOWN ON THE TYPICAL SECTIONS AT BRIDGES MEG-7-0708 LT & RT AND MEG-7-0761 LT & RT. THE SHOULDERS SHALL BE REBUILT 1325 FEET ON THE APPROACH END OF EACH BRIDGE AND 515 FEET ON THE TRAILING END OF EACH BRIDGE. A TOTAL OF 7360 FEET OF SHOULDER WILL BE REBUILT. THE FOLLOWING QUANTITIES HAVE BEEN CARRIED TO THE GENERAL SUMMARY TO PERFORM THIS WORK:

ITEM 442 - 3" ASPHALT CONCRETE SURFACE COURSE, 12.5MM, TYPE A (449)
 7360' X 8' X 3" / 12 / 27 = 546 CU YD

ITEM 301 - ASPHALT CONCRETE BASE, PG64-22, (449)
 7360' X 8.5' X 6" / 12 / 27 = 1159 CU YD

ITEM 304 - AGGREGATE BASE
 7360' X 9' X 6" / 12 / 27 = 1227 CU YD

ITEM 204 - SUBGRADE COMPACTION
 7360' X 9.5' / 9 = 7769 SQ YD

ITEM 407 - NON-TRACKING TACK COAT
 7360' X 8' / 9 X 0.08 GAL/SY = 524 GAL

ITEM 203 - EXCAVATION
 7360' X 8' X 1.25' / 27 = 2726 CU YD

CONSTRUCTION SEQUENCE

NOV. 1, 2022 SHALL SERVE AS AN INTERIM COMPLETION DATE FOR THE FOLLOWING WORK:

MEG-33-10.72-13.32 PAVEMENT PLANING, PAVEMENT REPAIR, SURFACE COURSE ASPHALT, AND TEMPORARY PAVEMENT MARKINGS.

MEG-7-7.08 AND MEG-7-7.61 SHOULDER RECONSTRUCTION

DESIGN AGENCY



DESIGNER
 BAC


REVIEWER
 MRF 1-24-22

PROJECT ID
 87264

SHEET TOTAL
 4 14

SHEET NUM.										PART.		ITEM	ITEM EXT	GRAND TOTAL	UNIT	DESCRIPTION	SEE SHEET NO.
3	4	6	7	8	9	10	01/NHS/PV	02/SAF/OT									
	2,726									203	10000	2,726	CY	ROADWAY			
	7,769									204	10000	7,769	SY	EXCAVATION			
														SUBGRADE COMPACTION			
														PAVEMENT			
188										188	253	188	CY	PAVEMENT REPAIR, AS PER PLAN	3		
		214,311				2,269				254	01000	216,580	SY	PAVEMENT PLANING, ASPHALT CONCRETE, 1.5"			
	1,159									301	56000	1,159	CY	ASPHALT CONCRETE BASE, PG64-22, (449)			
										304	20000	1,227	CY	AGGREGATE BASE			
	1,227									407	20000	17,851	GAL	NON-TRACKING TACK COAT			
	524	17,145				182				442	10300	9,025	CY	ASPHALT CONCRETE SURFACE COURSE, 12.5 MM, TYPE A (449)			
	546	8,930				95				442	22100	546	CY	ASPHALT CONCRETE SURFACE COURSE, 12.5 MM, TYPE A (449)			
		28								617	10100	28	CY	COMPACTED AGGREGATE			
		17.94								618	40600	17.94	MILE	RUMBLE STRIPS, SHOULDER (ASPHALT CONCRETE)			
					8.12					618	41000	8.12	MILE	RUMBLE STRIPES, EDGE LINE (ASPHALT CONCRETE)			
					4.06					618	43000	4.06	MILE	RUMBLE STRIPES, CENTER LINE (ASPHALT CONCRETE)			
		26.82								850	10010	26.82	MILE	GROOVING FOR 6" RECESSED PAVEMENT MARKING, (ASPHALT)			
		6,801								850	10130	6,801	FT	GROOVING FOR 12" RECESSED PAVEMENT MARKING, (ASPHALT)			
		3,162								850	20110	3,162	FT	GROOVING FOR 6" RECESSED PAVEMENT MARKING, (CONCRETE)			
														TRAFFIC CONTROL			
			763							621	00100	763	EACH	RPM			
			763							621	54000	763	EACH	RAISED PAVEMENT MARKER REMOVED			
					8.12					642	00104	8.12	MILE	EDGE LINE, 6", TYPE 1			
					4.06					642	00300	4.06	MILE	CENTER LINE, TYPE 1			
			192			48				644	00500	240	FT	STOP LINE			
			175							644	00700	175	FT	TRANSVERSE/DIAGONAL LINE			
			650							644	00720	650	FT	CHEVRON MARKING			
						856				644	01200	856	FT	PARKING LOT STALL MARKING			
			49							644	01300	49	EACH	LANE ARROW			
			1							644	01350	1	EACH	LANE REDUCTION ARROW			
			1,385							807	13410	1,385	FT	WET REFLECTIVE SPRAY THERMOPLASTIC PAVEMENT MARKING, DOTTED LINE, 6"			
			18.28							807	14010	18.28	MILE	WET REFLECTIVE THERMOPLASTIC PAVEMENT MARKING, EDGE LINE, 6"			
			9.14							807	14110	9.14	MILE	WET REFLECTIVE THERMOPLASTIC PAVEMENT MARKING, LANE LINE, 6"			
			6,801							807	14310	6,801	FT	WET REFLECTIVE THERMOPLASTIC PAVEMENT MARKING, CHANNELIZING LINE, 12"			
			4							814	00012	4	EACH	US ROUTE SHIELD SYMBOL MARKING, TYPE B125			
														MAINTENANCE OF TRAFFIC			
	8									614	12410	8	EACH	SPEED ZONE AHEAD SYMBOL SIGN			
	4									614	12490	4	EACH	RESUME LEGAL SPEED SIGN			
				18.28						614	20110	18.28	MILE	WORK ZONE LANE LINE, CLASS I, 6", 642 PAINT			
				36.56						614	22110	36.56	MILE	WORK ZONE EDGE LINE, CLASS I, 6", 642 PAINT			
				11,916						614	23210	11,916	FT	WORK ZONE CHANNELIZING LINE, CLASS I, 12", 642 PAINT			
				480						614	26200	480	FT	WORK ZONE STOP LINE, CLASS I, 642 PAINT			
	44									808	18700	44	SNMT	DIGITAL SPEED LIMIT (DSL) SIGN ASSEMBLY	4		
														INCIDENTALS			
LS										LS	614	11000	LS	MAINTAINING TRAFFIC			
LS										LS	623	10001	LS	CONSTRUCTION LAYOUT STAKES AND SURVEYING, AS PER PLAN	3		
										LS	624	10000	LS	MOBILIZATION			

GENERAL SUMMARY

DESIGN AGENCY

 DESIGNER
 BAC
 REVIEWER
 MRF 1-24-22
 PROJECT ID
 87264
 SHEET TOTAL
 5 14