

SHEET NUMBER													PART.	ITEM	ITEM	GRAND	UNIT	DESCRIPTION	SEE
7	16	17	20	21	32								01/S>2		EXT	TOTAL			SHEET NO.
																		TRAFFIC CONTROL	
			58										58	620	60000	58	EACH	DELINEATOR, POST SURFACE MOUNTED	
				89.5									89.5	630	03100	89.5	FT	GROUND MOUNTED SUPPORT, NO. 3 POST	
				34.5									34.5	630	08520	34.5	FT	STREET NAME SIGN SUPPORT, NO. 3 POST	
				32.5									32.5	630	80100	32.5	SF	SIGN, FLAT SHEET	
				6									6	630	80500	6	EACH	SIGN, DOUBLE FACED, STREET NAME	
				18									18	630	84900	18	EACH	REMOVAL OF GROUND MOUNTED SIGN AND DISPOSAL	
				14									14	630	86002	14	EACH	REMOVAL OF GROUND MOUNTED POST SUPPORT AND DISPOSAL	
			2,910										2,910	645	30000	2,910	FT	REMOVAL OF PAVEMENT MARKINGS	
			0.92										0.94	646	10000	0.92	MILE	EDGE LINE, 4"	
			0.03										0.04	646	10100	0.03	MILE	LANE LINE, 4"	
			0.6										0.6	646	10200	0.6	MILE	CENTER LINE	
			150										150	646	10300	150	FT	CHANNEUZING LINE, 8"	
			348										348	646	10510	348	FT	CROSSWALK LINE, 12"	
				55									55	646	10520	55	FT	CROSSWALK LINE, 24"	
			1,200										1,200	646	10600	1,200	FT	TRANSVERSE/DIAGONAL LINE	
			2										2	646	20300	2	EACH	LANE ARROW	
																		MISCELLANEOUS STRUCTURE	
					LS								LS	202	11203	LS		PORTIONS OF STRUCTURE REMOVED, OVER 20 FOOT SPAN, AS PER PLAN	32
					2,025								2,025	509	10000	2,025	LB	EPOXY COATED STEEL REINFORCEMENT	
					186								186	510	10001	186	EACH	DOWEL HOLES WITH NONSHRINK, NONMETALLIC GROUT, AS PER PLAN	32
					85								85	511	34448	85	CY	CLASS QC2 CONCRETE, BRIDGE DECK (PARAPET)	
542					743								1,285	512	10001	1,285	SY	SEALING OF CONCRETE SURFACES, AS PER PLAN, (PERMANENT GRAFFITI PROTECTION).	32
					428								428	517	76300	428	FT	RAILING, MISC.: MODIFIED BR-2-15 RAILING	32
					8								8	518	12801	8	EACH	SCUPPER, MODIFICATION, AS PER PLAN	37
		2											2	606	60023	2	EACH	IMPACT ATTENUATOR, TYPE 2 (UNIDIRECTIONAL), AS PER PLAN, 55 MPH , 20"	6
		718											718	607	98000	718	FT	FENCE, MISC.: 42" WOOD FENCE	6
		139											139	607	98000	139	FT	FENCE, MISC.: PERIMETER GEOTEXTILE FENCE	6
544													544	622	10160	544	FT	CONCRETE BARRIER, SINGLE SLOPE, TYPE D	
		2											2	622	25000	2	EACH	CONCRETE BARRIER END SECTION, TYPE D	
		2											2	622	25050	2	EACH	CONCRETE BARRIER, END ANCHORAGE, REINFORCED, TYPE D	
																		MAINTENANCE OF TRAFFIC	
0.06													0.06	614	20560	0.06	MILE	WORK ZONE LANE LINE, CLASS III, 6", 642 PAINT	7
0.25													0.25	614	21550	0.25	MILE	WORK ZONE CENTER LINE, CLASS III, 642 PAINT	7
0.33													0.33	614	22360	0.33	MILE	WORK ZONE EDGE LINE, CLASS III, 6", 642 PAINT	7
																		INCIDENTALS	
													LS	614	11000	LS		MAINTAINING TRAFFIC	7
													12	619	16010	12	MNTH	FIELD OFFICE, TYPE B	
													LS	623	10000	LS		CONSTRUCTION LAYOUT STAKES AND SURVEYING	
													LS	624	10000	LS		MOBILIZATION	

GENERAL SUMMARY

DESIGN AGENCY



CHOICE ONE ENGINEERING

DESIGNER

DWL

REVIEWER

AJH 07-25-25

PROJECT ID

119378

SHEET

P.15

TOTAL

83

Z:\project\Miami\WestMilton\MIA-WMI-2305_SR571BridgePedImprovements\119378-GS001.dwg 26-Nov-25 9:19 AM

SUBSUMMIARY - ROADWAY, EROSION CONTROL, DRAINAGE, PAVEMENT	
 CHOICE ONE ENGINEERING	
DESIGNER DWL	
REVIEWER AJH 07-25-25	
PROJECT ID 119378	
SHEET P.16	TOTAL 83



CONSTRUCTION LIMITS

- 1-1/4" GRIND AND OVERLAY**
ITEM 254 - 1-1/4"± PAVEMENT PLANING, ASPHALT CONCRETE
ITEM 441 - 1-1/4" ASPHALT CONCRETE SURFACE COURSE, TYPE 1, (449), PG64-22
ITEM 407 - NON-TRACKING TACK COAT, (APPLIED AT 0.09 GAL/S.Y.)
- FULL DEPTH PAVEMENT REPAIR**
ITEM 441 - 1-1/2" ASPHALT CONCRETE SURFACE COURSE, TYPE 1, (449), PG64-22
ITEM 407 - NON-TRACKING TACK COAT, (APPLIED AT 0.06 GAL/S.Y.)
ITEM 441 - 1-3/4" ASPHALT CONCRETE SURFACE COURSE, TYPE 1, (449), PG64-22
ITEM 613 - 6" LOW STRENGTH MORTAR BACKFILL
ITEM 204 - SUBGRADE COMPACTION

- VEGETATED FILTER STRIP**
ITEM 659 - TOPSOIL (4" MINIMUM)
ITEM 659 - SEEDING AND MULCHING, CLASS 1
ITEM 670 - SLOPE EROSION PROTECTION
- SEEDING AND MULCHING, CLASS 1**
ITEM 659 - SEEDING AND MULCHING, CLASS 1
ITEM 659 - 4" TOPSOIL
- PROPOSED CURB RAMP**
ITEM 608 - CURB RAMP
ITEM 304 - 6" AGGREGATE BASE

- GRAVEL DRIVE**
ITEM 304 - 12" AGGREGATE BASE
- CONCRETE SIDEWALK**
ITEM 608 - 4" CONCRETE WALK
ITEM 304 - 4" AGGREGATE BASE
- BIKE PATH**
ITEM 441 - 1-1/2" ASPHALT CONCRETE SURFACE COURSE, TYPE 1, (449), PG64-22
ITEM 407 - NON-TRACKING TACK COAT, (APPLIED AT 0.06 GAL/S.Y.)
ITEM 441 - 2-1/2" ASPHALT CONCRETE INTERMEDIATE COURSE, TYPE 2, (449)
ITEM 304 - 6" AGGREGATE BASE
ITEM 204 - SUBGRADE COMPACTION

- VALVE ADJUSTED TO GRADE
MANHOLE ADJUSTED TO GRADE
MANHOLE RECONSTRUCT TO GRADE
(DND) DO NOT DISTURB
(TBR) TO BE REMOVED
(ATG) ADJUSTED TO GRADE
(R&R) REMOVE AND RESET
(TBRBO) TO BE RELOCATED BY OTHERS
- MIAMI CONSERVANCY DISTRICT
EXCAVATED MATERIAL TO BE
HAULED OFFSITE (SEE PLAN NOTE)

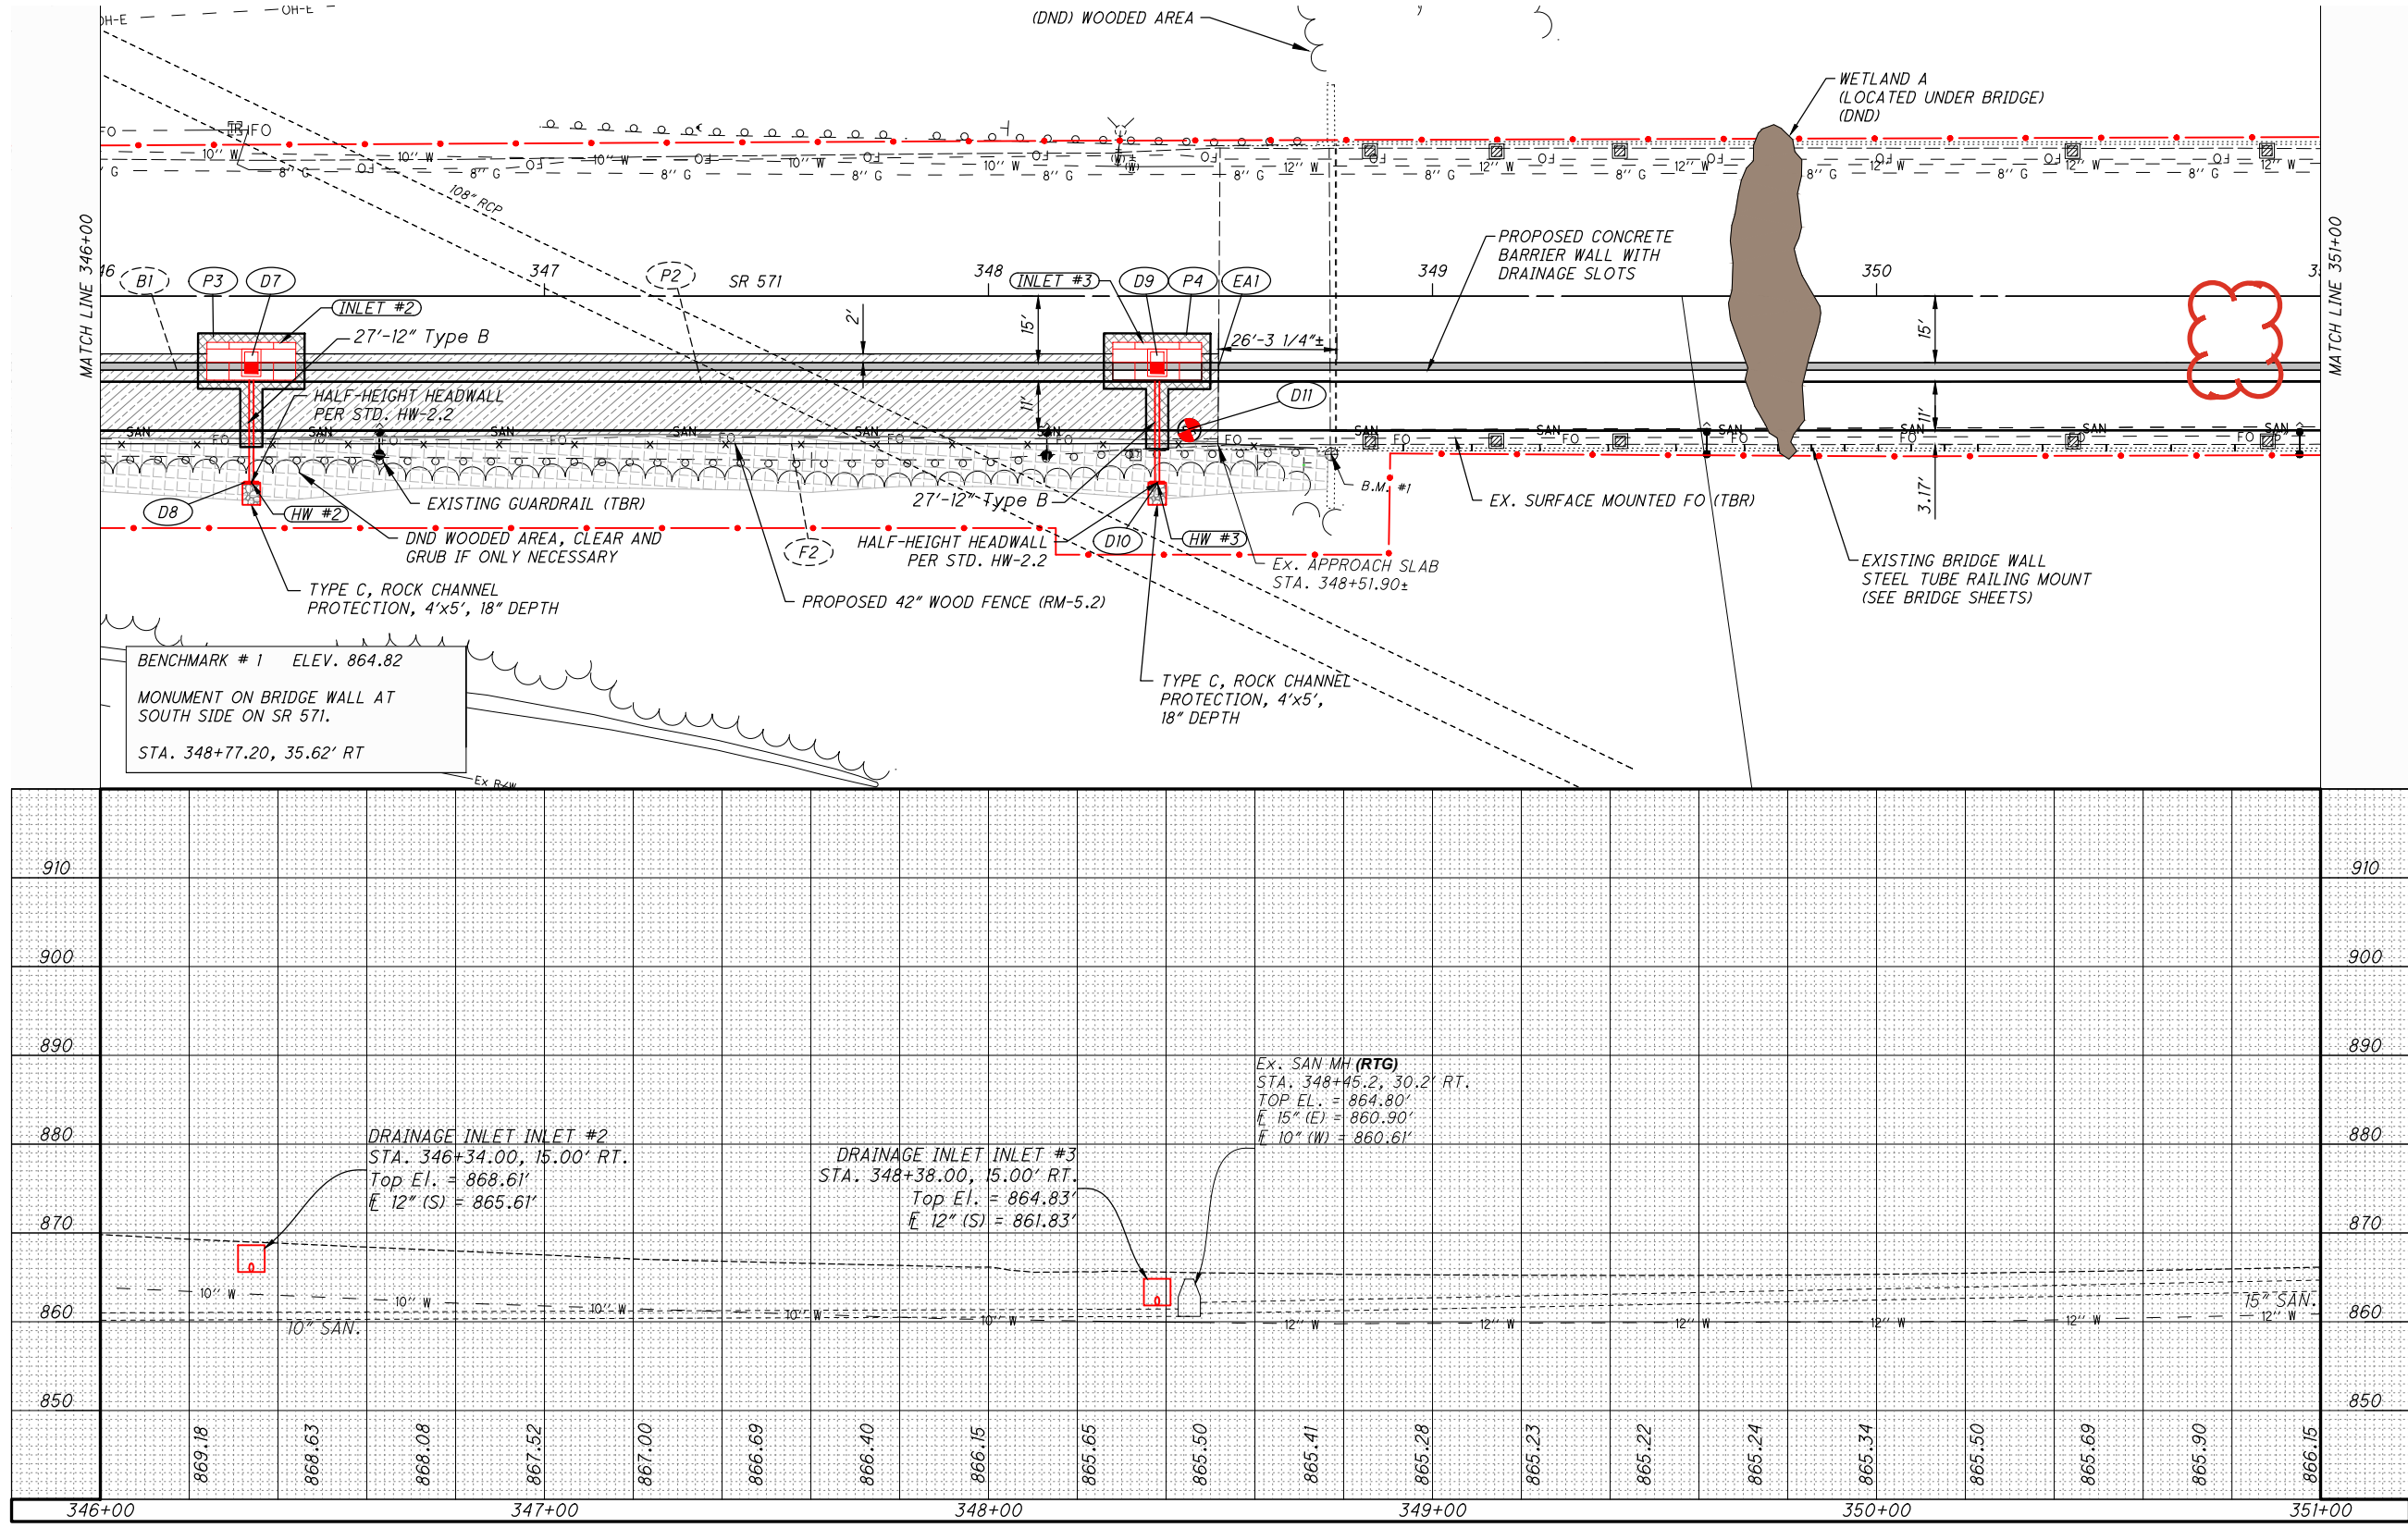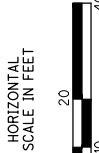

PLAN AND PROFILE - STATE ROUTE 571
STA. 346+00 TO STA. 351+00


CONSTRUCTION LIMITS

- 1-1/4" GRIND AND OVERLAY**
ITEM 254 - 1-1/4"± PAVEMENT PLANING, ASPHALT CONCRETE
ITEM 441 - 1-1/4" ASPHALT CONCRETE SURFACE COURSE, TYPE 1, (449), PG64-22
ITEM 407 - NON-TRACKING TACK COAT, (APPLIED AT 0.09 GAL/S.Y.)
- FULL DEPTH PAVEMENT REPAIR**
ITEM 441 - 1-1/2" ASPHALT CONCRETE SURFACE COURSE, TYPE 1, (449), PG64-22
ITEM 407 - NON-TRACKING TACK COAT, (APPLIED AT 0.06 GAL/S.Y.)
ITEM 441 - 1-3/4" ASPHALT CONCRETE SURFACE COURSE, TYPE 1, (449), PG64-22
ITEM 613 - 6" LOW STRENGTH MORTAR BACKFILL
ITEM 204 - SUBGRADE COMPACTION

- VEGETATED FILTER STRIP**
ITEM 659 - TOPSOIL (4" MINIMUM)
ITEM 659 - SEEDING AND MULCHING, CLASS 1
ITEM 670 - SLOPE EROSION PROTECTION
- SEEDING AND MULCHING, CLASS 1**
ITEM 659 - SEEDING AND MULCHING, CLASS 1
ITEM 659 - 4" TOPSOIL
- PROPOSED CURB RAMP**
ITEM 608 - CURB RAMP
ITEM 304 - 6" AGGREGATE BASE

- GRAVEL DRIVE**
ITEM 304 - 12" AGGREGATE BASE
- CONCRETE SIDEWALK**
ITEM 608 - 4" CONCRETE WALK
ITEM 304 - 4" AGGREGATE BASE
- BIKE PATH**
ITEM 441 - 1-1/2" ASPHALT CONCRETE SURFACE COURSE, TYPE 1, (449), PG64-22
ITEM 407 - NON-TRACKING TACK COAT, (APPLIED AT 0.06 GAL/S.Y.)
ITEM 441 - 2-1/2" ASPHALT CONCRETE INTERMEDIATE COURSE, TYPE 2, (449)
ITEM 304 - 6" AGGREGATE BASE
ITEM 204 - SUBGRADE COMPACTION

- VALVE ADJUSTED TO GRADE
MANHOLE ADJUSTED TO GRADE
MANHOLE RECONSTRUCT TO GRADE
(DND) DO NOT DISTURB
(TBR) TO BE REMOVED
(ATG) ADJUSTED TO GRADE
(R&R) REMOVE AND RESET
(TBRBO) TO BE RELOCATED BY OTHERS
- MIAMI CONSERVANCY DISTRICT
EXCAVATED MATERIAL TO BE
HAULED OFFSITE (SEE PLAN NOTE)

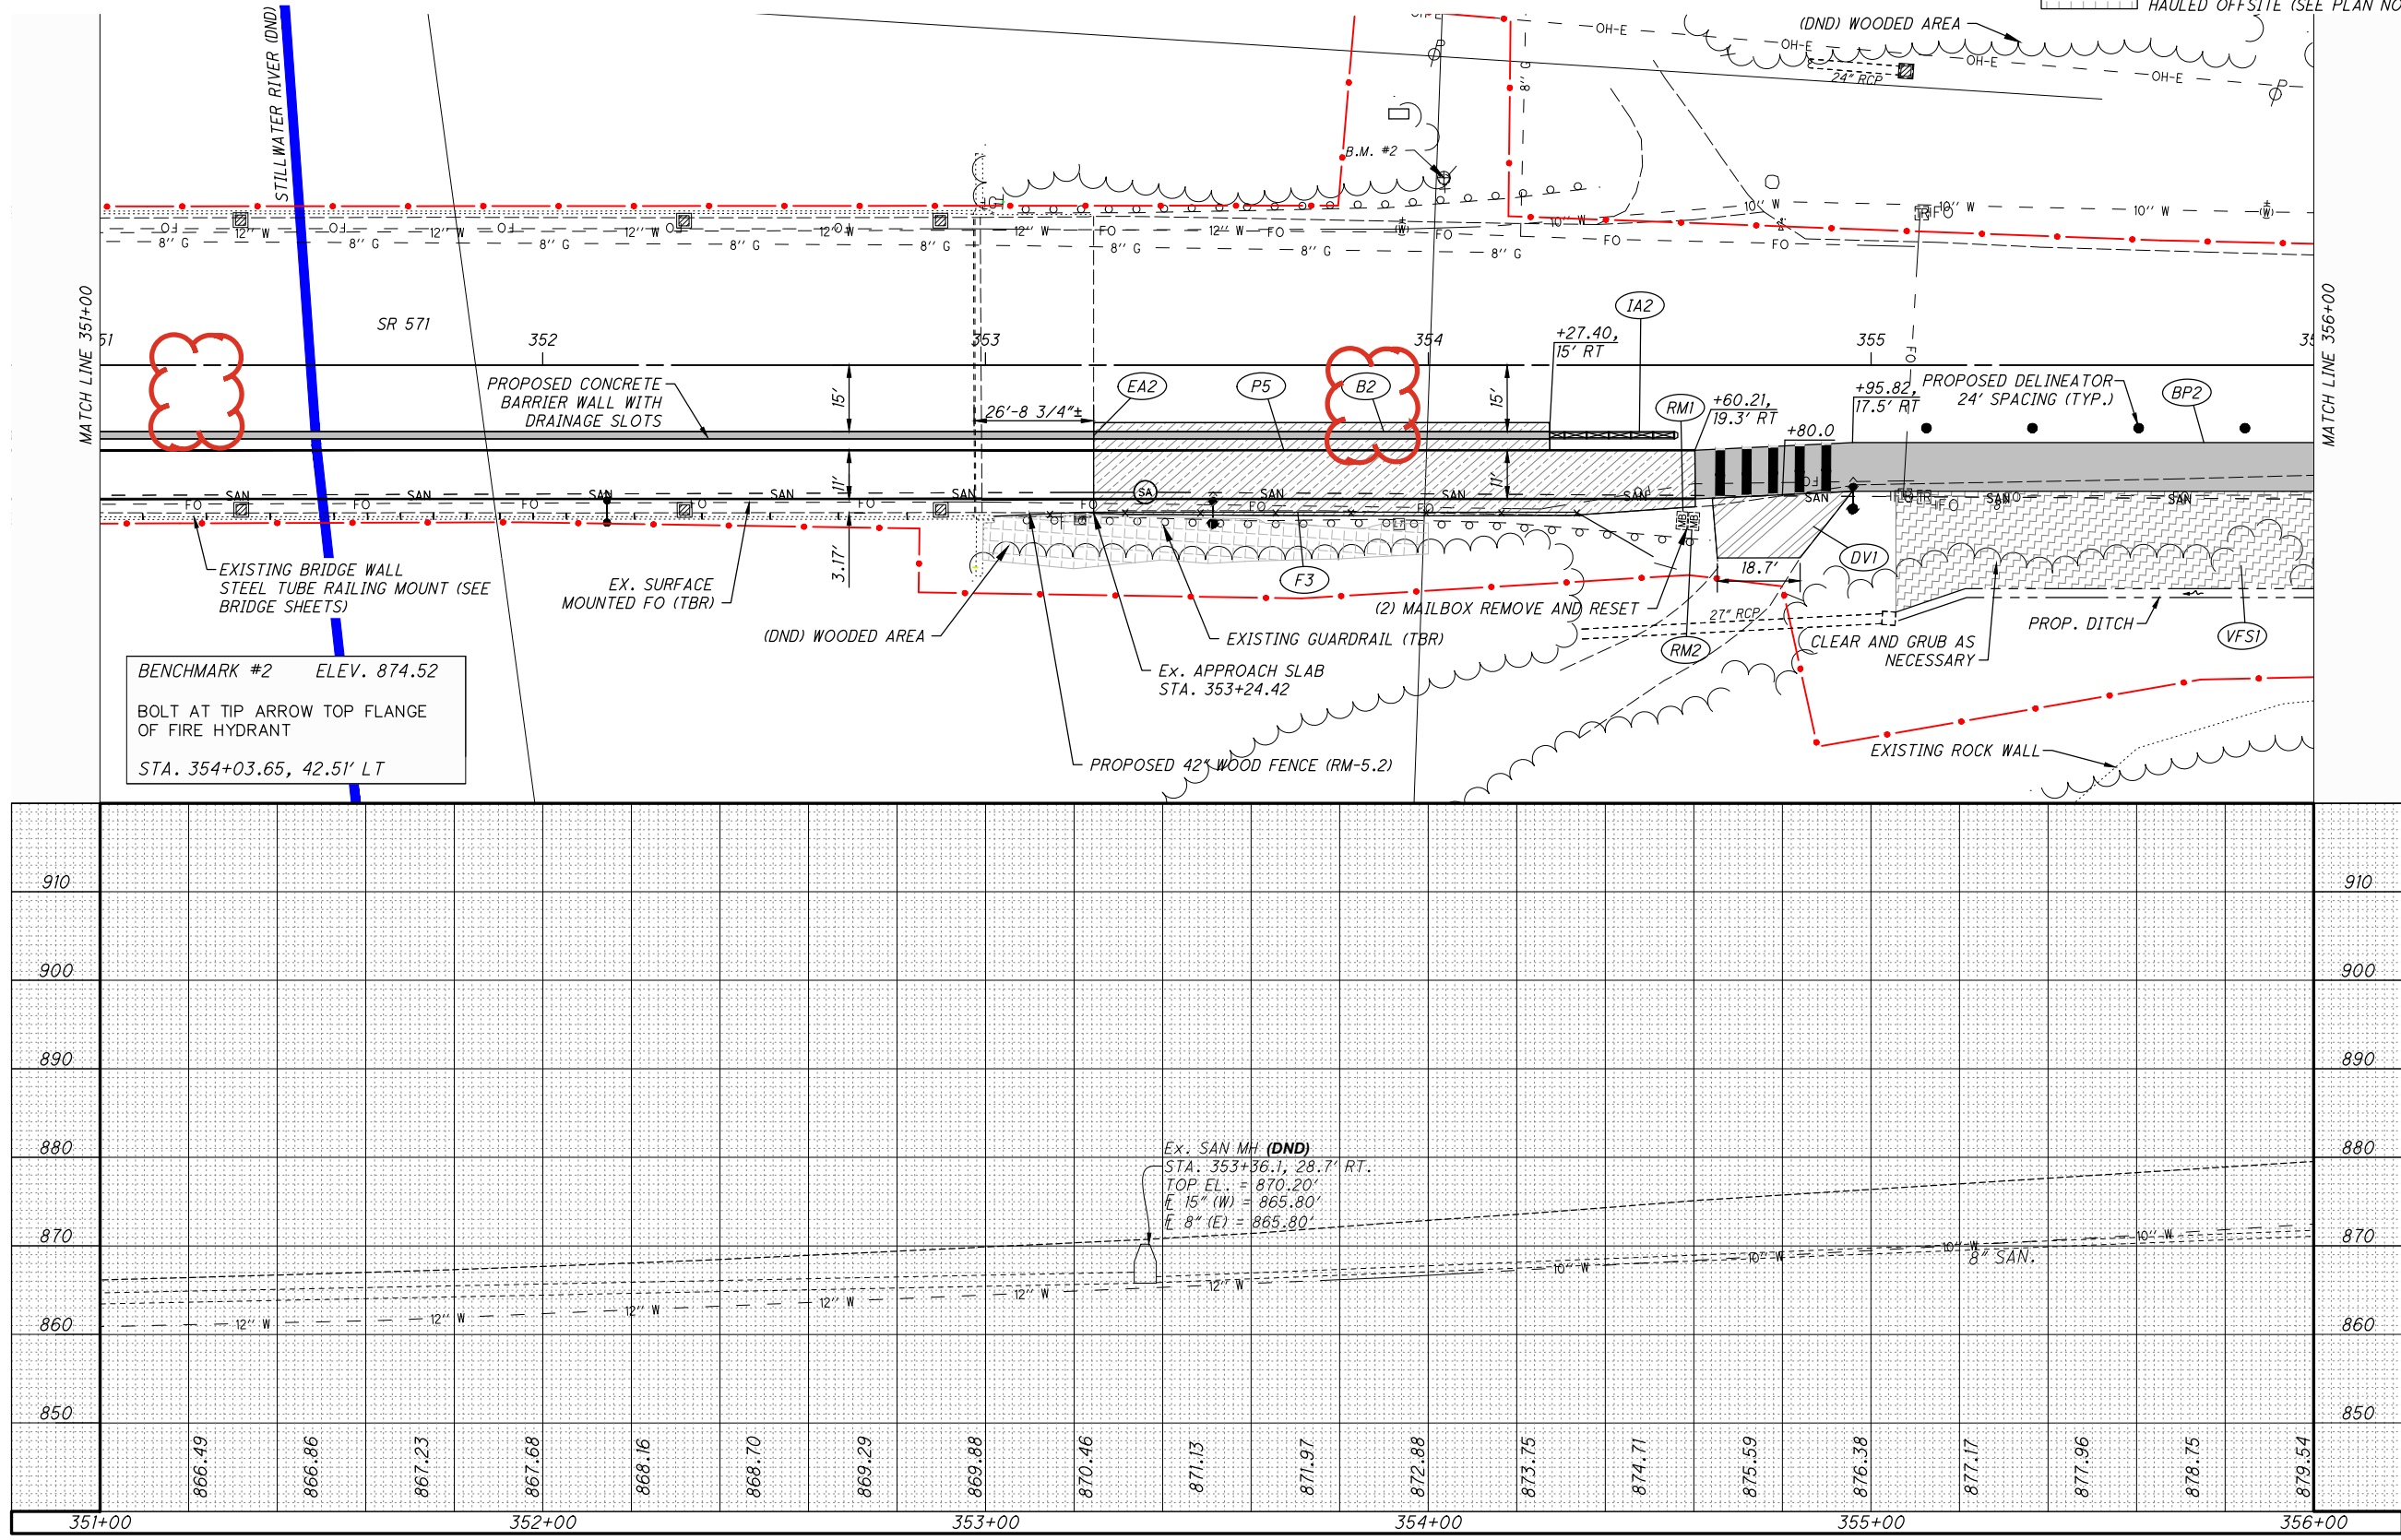

PLAN AND PROFILE - STATE ROUTE 571
STA. 351+00 TO STA. 356+00