



I:\ProjectData\MOT\10096\IR70-0671\Design\Roadway\Sheets\10096\CY001.dgn Sheet 2/5/2021 6:42:34 AM cweiss

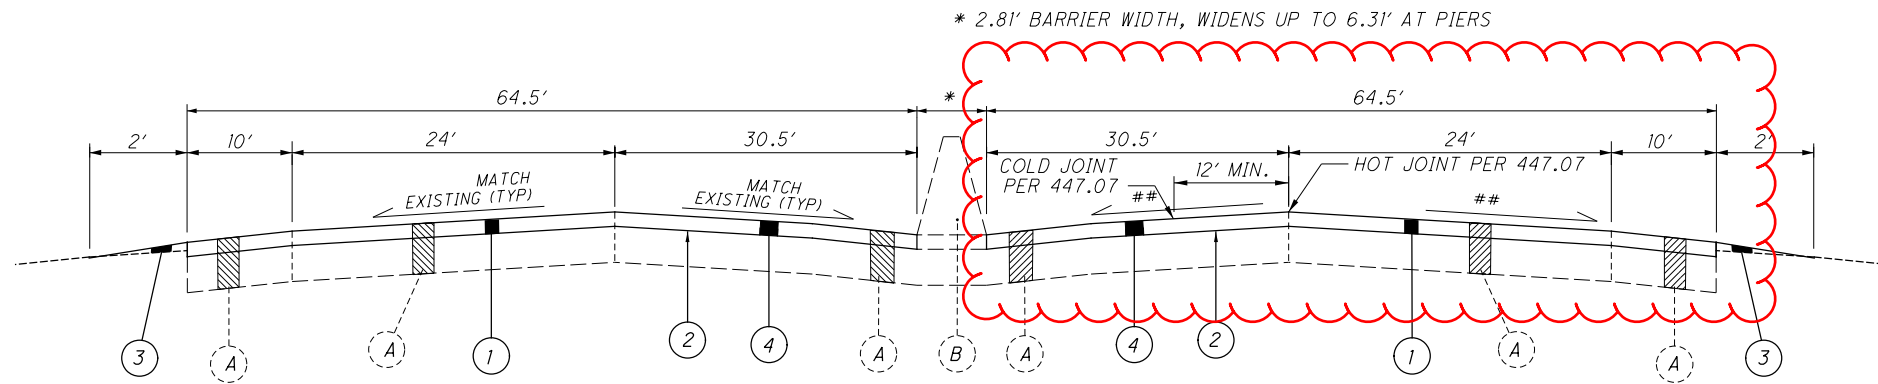

TYPICAL 1
FOUR LANE UNDIVIDED SECTION
2" PLANING/ 2" RESURFACING

MOT-IR 70 SLM 6.71 TO 6.73 - SKIP STRUCTURE MOT-70-0672
MOT-IR 70 SLM 6.73 TO 7.19
MOT-IR 70 SLM 7.19 TO 7.22 - SKIP STRUCTURE MOT-70-0719
MOT-IR 70 SLM 7.22 TO 7.42

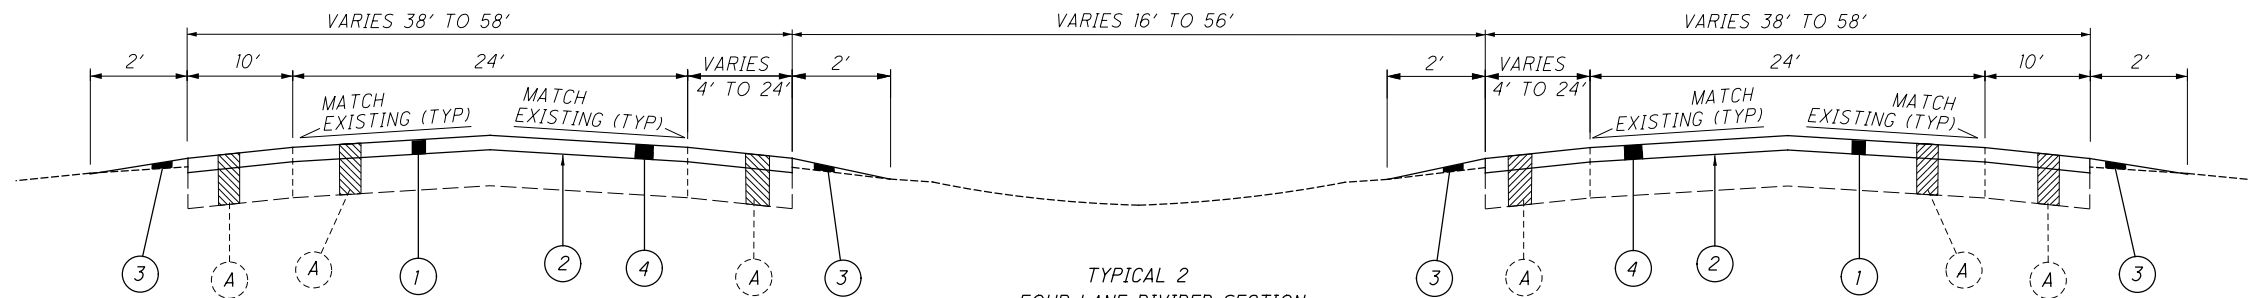

TYPICAL 2
FOUR LANE DIVIDED SECTION
2" PLANING/ 2" RESURFACING
MOT-IR 70 SLM 7.42 TO 10.52

LEGEND

- A - EXISTING ASPHALT CONCRETE PAVEMENT
- B - EXISTING CONCRETE MEDIAN BARRIER
- 1 - ITEM 442 - 2" ASPHALT CONCRETE SURFACE COURSE, 12.5mm, TYPE A (447), AS PER PLAN, PG76-22M
- 2 - ITEM 407 - NON-TRACKING TACK COAT (0.085 GAL/SY.)
- 3 - ITEM 617 - COMPACTED AGGREGATE (2" AVE. THICKNESS)
- 4 - ITEM 254 - PAVEMENT PLANING, ASPHALT CONCRETE, (2" DEPTH)
- ## - MATCH EXISTING (TYP)