



MOT - /MIA-SR 48-25.18/00.00
 210416 PID - 106424
 Dist 7 7/15/2021

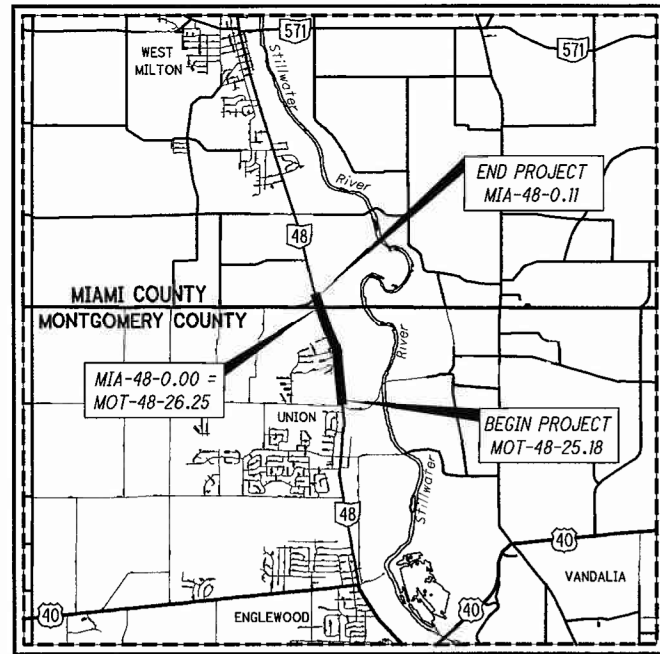

LOCATION MAP

LATITUDE: 39°54'54" LONGITUDE: 84°18'28"

SCALE IN MILES

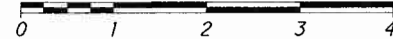

PORTION TO BE IMPROVED

ROUTE	LOCATION	ADT	TRUCKS
MOT-48	SLM 25.18 TO 26.25	6420	140
MIA-48	SLM 0.00 TO 0.11	6505	135

STATE OF OHIO
 DEPARTMENT OF TRANSPORTATION

MOT / MIA - 48 - 25.18 / 0.00

CITY OF UNION
 MONTGOMERY & MIAMI COUNTIES

INDEX OF SHEETS:

TITLE SHEET	1
TYPICAL SECTION	2
GENERAL NOTES	3-4
GENERAL SUMMARY	5
PAVEMENT SUBSUMMARY	6
DRIVE DETAILS	7
TRAFFIC CONTROL SUBSUMMARY	8
STRUCTURES	9-10

PROJECT DESCRIPTION

THIS PROJECT CONSISTS OF PLANING AND RESURFACING OF SR 48 WITH ASPHALT CONCRETE IN MONTGOMERY AND MIAMI COUNTY.

PROJECT LOCATIONS

PARTICIPATION 1 = 01/NHS/PV
 MOT-48-SLM 25.18 TO 26.25
 MIA-48-SLM 0.00 TO 0.11

EARTH DISTURBED AREAS

PROJECT EARTH DISTURBED AREA: NA*
 ESTIMATED CONTRACTOR EARTH DISTURBED AREA: NA*
 NOTICE OF INTENT EARTH DISTURBED AREA: NA*
 * MAINTENANCE PROJECT

2019 SPECIFICATIONS

THE STANDARD SPECIFICATIONS OF THE STATE OF OHIO, DEPARTMENT OF TRANSPORTATION, INCLUDING SUPPLEMENTAL SPECIFICATIONS LISTED IN THE PLANS AND CHANGES LISTED IN THE PROPOSAL SHALL GOVERN THIS IMPROVEMENT.

I HEREBY APPROVE THESE PLANS AND DECLARE THAT THE MAKING OF THIS IMPROVEMENT WILL NOT REQUIRE THE CLOSING TO TRAFFIC OF THE HIGHWAY AND THAT PROVISIONS FOR THE MAINTENANCE AND SAFETY OF TRAFFIC WILL BE AS SET FORTH ON THE PLANS AND ESTIMATES.

UNDERGROUND UTILITIES
 Contact Two Working Days
 Before You Dig

OHIO811, 8-1-1, or 1-800-362-2764
 (Non-members must be called directly)

PLAN PREPARED BY:
 ODOT DISTRICT 7 - ENGINEERING
 1001 ST. MARYS AVE.
 SIDNEY, OHIO

ENGINEERS SEAL:



SIGNED: *Chris Weiss*
 DATE: 4/15/21

STANDARD CONSTRUCTION DRAWINGS				SUPPLEMENTAL SPECIFICATIONS		SPECIAL PROVISIONS	
BP-3.1	1/17/20	TC-41.20	10/18/13	800	4/16/21		
BP-3.2	1/18/19	TC-42.20	10/18/13				
DM-4.3	1/15/16	TC-52.10	10/18/13	832	10/19/18		
DM-4.4	1/15/16	TC-52.20	1/15/21				
MT-97.10	4/19/19	TC-71.10	1/19/18				
MT-97.12	1/20/17						
MT-99.20	4/19/19						
MT-101.90	7/17/20						
MT-105.10	1/17/20						

APPROVED *Randall J. Chubb* PE, PS
 DATE 4/15/2021 DISTRICT DEPUTY DIRECTOR

APPROVED *John Harwood* PS
 DATE 4/21/2021 DIRECTOR, DEPARTMENT OF TRANSPORTATION

FEDERAL PROJECT NO.
E191 (365)

PID NO.
106424

CONSTRUCTION PROJECT NO.

RAILROAD INVOLVEMENT
NONE

MOT / MIA - 48 - 25.18 / 0.00

I:\ProjectData\MOT\106424_Sr48-2512_Design\Roadway\Sheets\106424_GTOOL.dgn Sheet 4/15/2021 7:30:03 AM tknapke

Contract Proposal available @
 www.contracts.dot.state.oh.us