


P:\DDT\07\0683\MOT-75-9.53\109436\Design\Roadway\Sheets\109436\_CG001.dgn Sheet 11/24/2020 9:18:10 AM CMT008

SHEET NUM.										PART.		ITEM	ITEM EXT	GRAND TOTAL	UNIT	DESCRIPTION	SEE SHEET NO.
				4	13	19	23	24	OFFICE CALCS	01/SAF/OT							
<b>ROADWAY</b>																	
				LS						LS		201	11000	LS		CLEARING AND GRUBBING	
									647	647		202	23000	647	SY	PAVEMENT REMOVED	
									114	114		202	30800	114	SY	TRAFFIC ISLAND REMOVED	
				83						83		202	32000	83	FT	CURB REMOVED	
				15						15		202	35100	15	FT	PIPE REMOVED, 24" AND UNDER	
				1						1		202	58100	1	EACH	CATCH BASIN REMOVED	
				1						1		202	88100	1	EACH	REMOVAL MISC.: SIGNAL FOUNDATION	5
					159					159		203	10000	159	CY	EXCAVATION	
					68					68		203	20000	68	CY	EMBANKMENT	
									1,136	1,136		204	10000	1,136	SY	SUBGRADE COMPACTION	
				20						20		204	13000	20	CY	EXCAVATION OF SUBGRADE	
				20						20		204	30020	20	CY	GRANULAR MATERIAL, TYPE C	
				1						1		204	45000	1	hour	PROOF ROLLING	
<b>EROSION CONTROL</b>																	
				58						58		659	00300	58	CY	TOPSOIL	
						520				520		659	10000	520	SY	SEEDING AND MULCHING	
				26						26		659	14000	26	SY	REPAIR SEEDING AND MULCHING	
				0.07						0.07		659	20000	0.07	TON	COMMERCIAL FERTILIZER	
				0.11						0.11		659	31000	0.11	ACRE	LIME	
				3						3		659	35000	3	MGAL	WATER	
									5,000	5,000		832	30000	5,000	EACH	EROSION CONTROL	
<b>DRAINAGE</b>																	
				159						159		605	05200	159	FT	4" UNCLASSIFIED PIPE UNDERDRAINS	
				10						10		611	00410	10	FT	4" CONDUIT, TYPE F FOR UNDERDRAIN OUTLET	
				83						83		611	05900	83	FT	15" CONDUIT, TYPE B	
				1						1		611	98151	1	EACH	CATCH BASIN, NO. 3, AS PER PLAN	4
				1						1		611	98370	1	EACH	CATCH BASIN, NO. 6	
<b>PAVEMENT</b>																	
									6,589	6,589		254	01000	6,589	SY	PAVEMENT PLANING, ASPHALT CONCRETE (DEPTH = 1.25")	
									251	251		304	20000	251	CY	AGGREGATE BASE	
									560	560		407	20000	560	GAL	NON-TRACKING TACK COAT	
									229	229		442	10500	229	CY	ASPHALT CONCRETE SURFACE COURSE, 9.5 MM, TYPE A (448)	
									824	824		452	14010	824	SY	10" NON-REINFORCED CONCRETE PAVEMENT, CLASS QC 1P	
				10						10		609	26000	10	FT	CURB, TYPE 6	
									267	267		609	58000	267	SY	9" CONCRETE TRAFFIC ISLAND	
									4	4		617	10100	4	CY	COMPACTED AGGREGATE	
<b>WATER WORK</b>																	
				1						1		638	10800	1	EACH	VALVE BOX ADJUSTED TO GRADE	
<b>TRAFFIC CONTROL</b>																	
						72				72		621	00100	72	EACH	RPM	
						32				32		621	54000	32	EACH	RAISED PAVEMENT MARKER REMOVED	
								274		274		630	03100	274	FT	GROUND MOUNTED SUPPORT, NO. 3 POST	
								14		14		630	08600	14	EACH	SIGN POST REFLECTOR	
								2		2		630	79100	2	EACH	SIGN HANGER ASSEMBLY, MAST ARM	
								207		207		630	80100	207	SF	SIGN, FLAT SHEET	
								19		19		630	84900	19	EACH	REMOVAL OF GROUND MOUNTED SIGN AND DISPOSAL	
								12		12		630	86002	12	EACH	REMOVAL OF GROUND MOUNTED POST SUPPORT AND DISPOSAL	
						0.46				0.46		644	00104	0.46	MILE	EDGE LINE, 6"	
						0.05				0.05		644	00200	0.05	MILE	LANE LINE, 4"	
						0.14				0.14		644	00204	0.14	MILE	LANE LINE, 6"	
						0.12				0.12		644	00300	0.12	MILE	CENTER LINE	
						136				136		644	00400	136	FT	CHANNELIZING LINE, 8"	
						40				40		644	00500	40	FT	STOP LINE	
						6				6		644	01300	6	EACH	LANE ARROW	

GENERAL SUMMARY

MOT-75-9.53

REVIEWS	NUMBER	DATE	DESCRIPTION
	1	11/24/20	REVISED QUANTITY

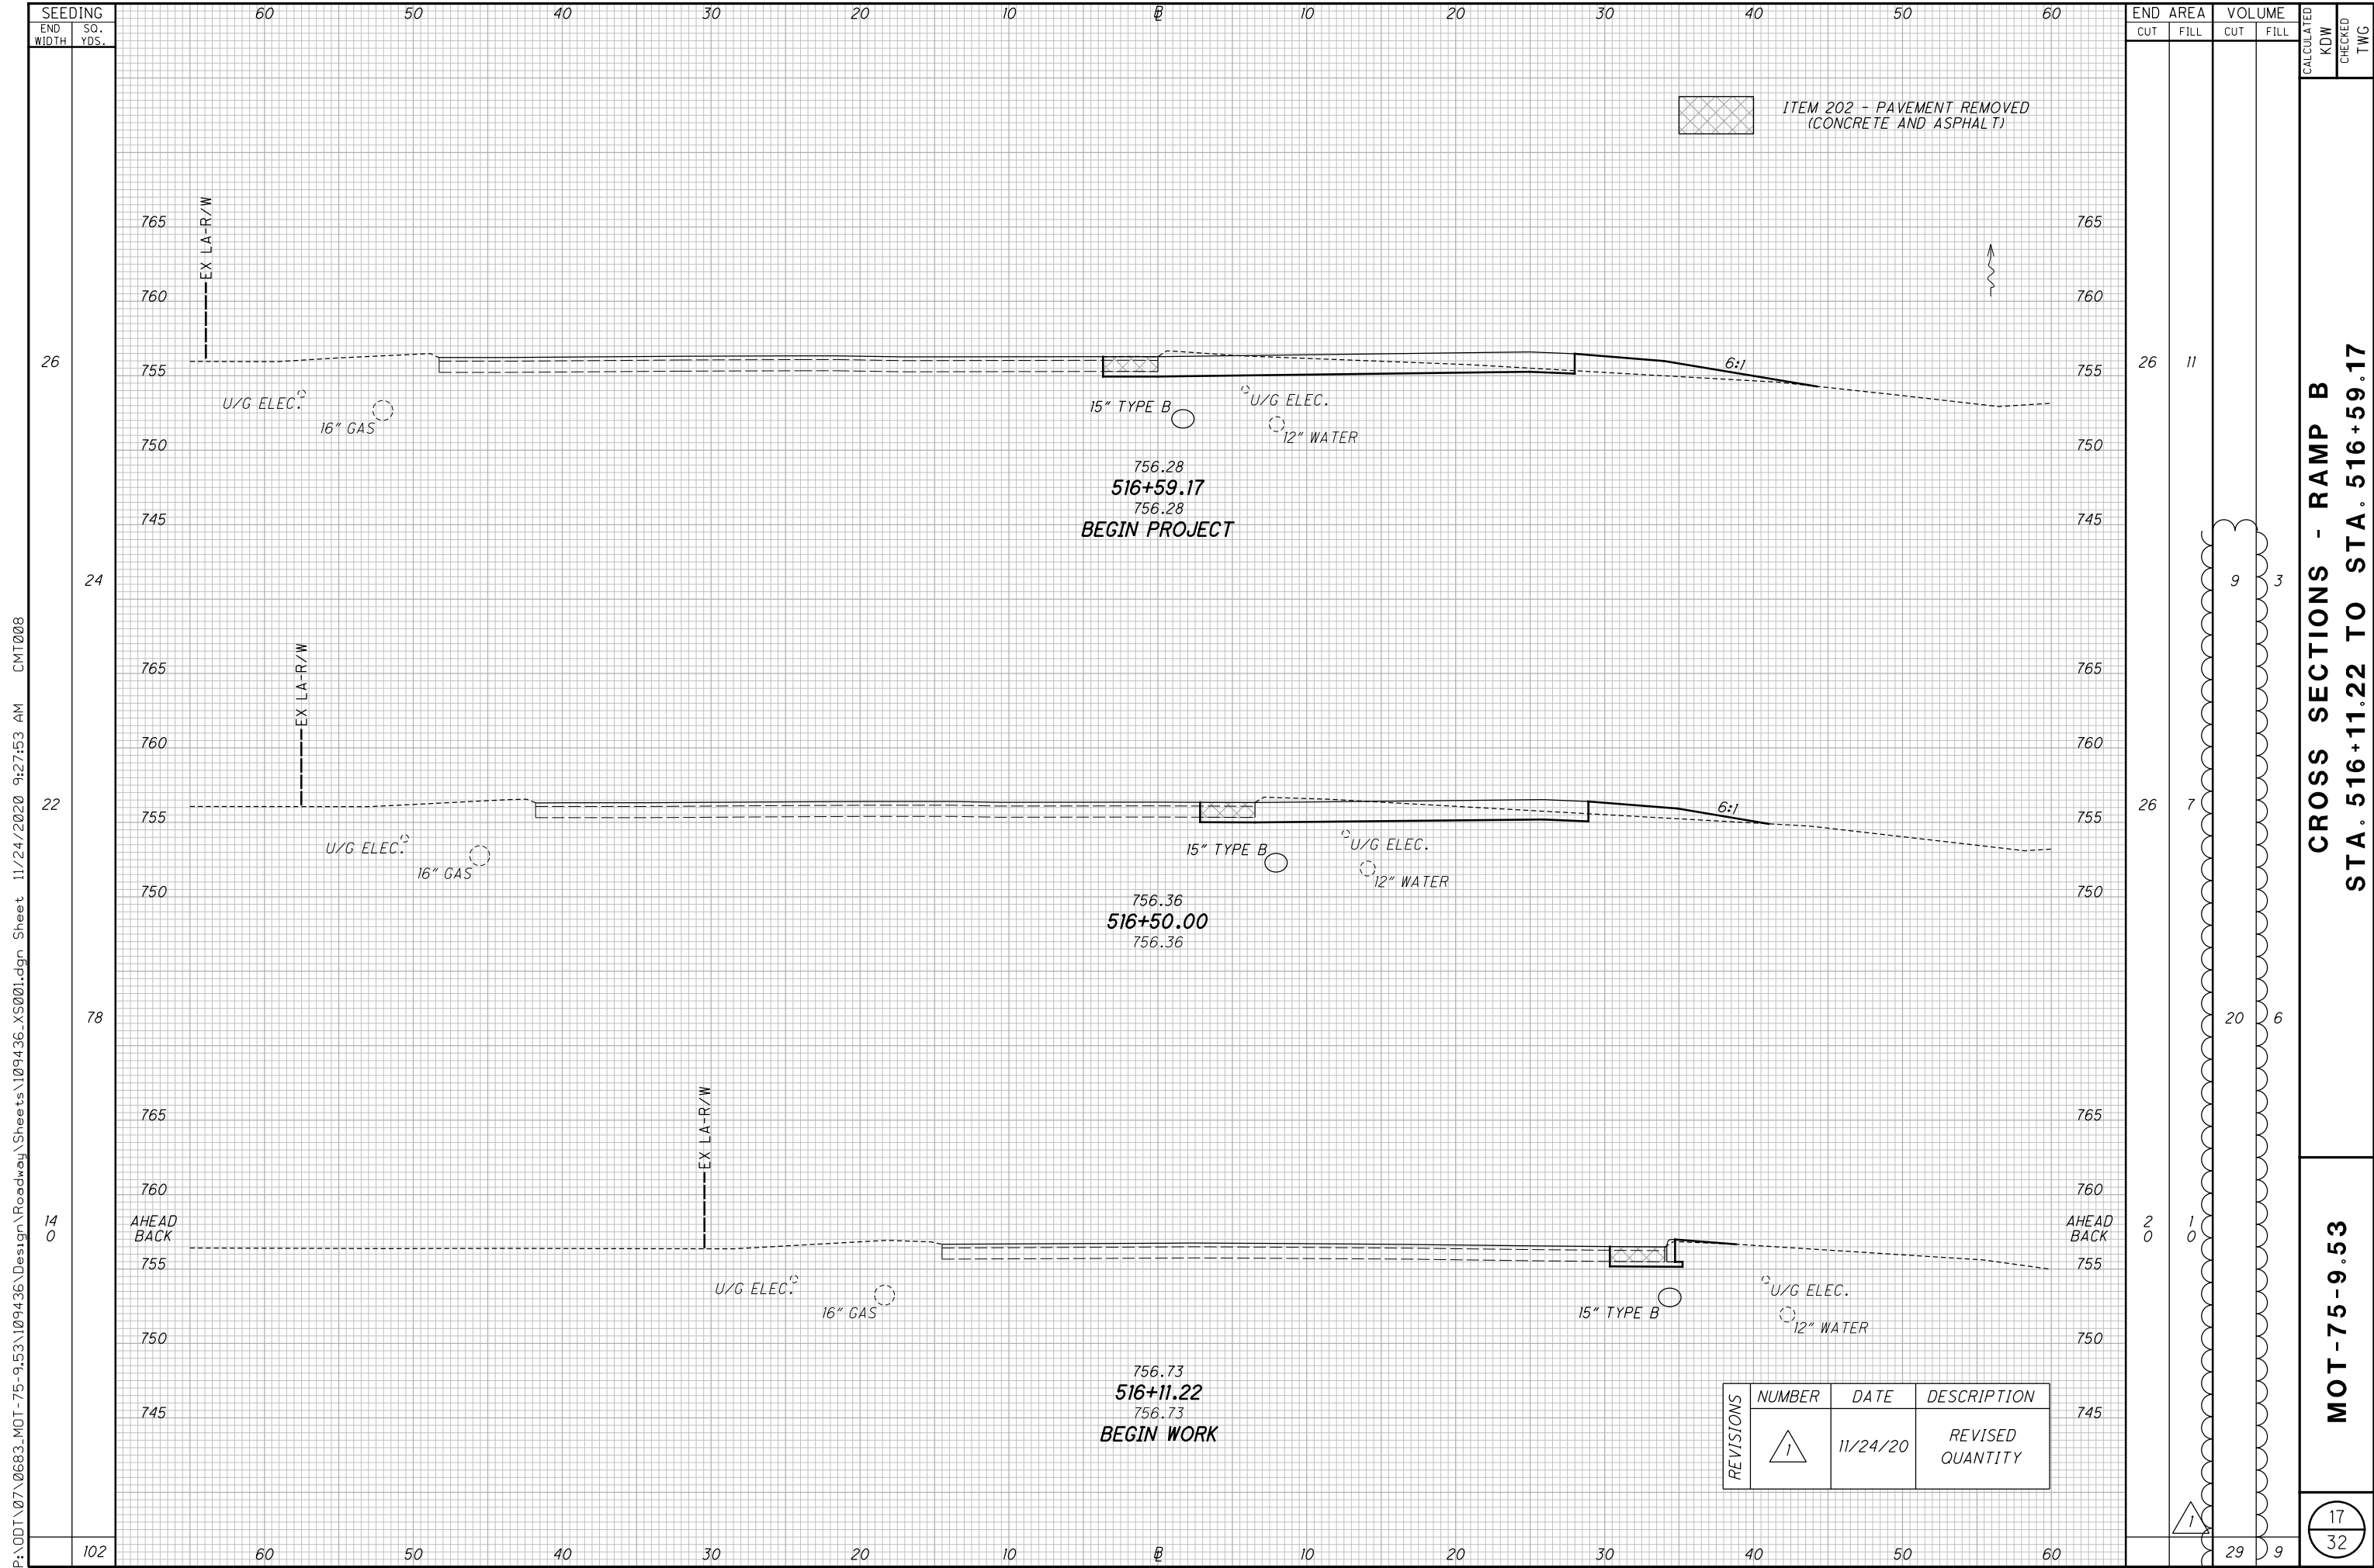

ITEM 202 - PAVEMENT REMOVED  
(CONCRETE AND ASPHALT)

756.28  
516+59.17  
756.28  
BEGIN PROJECT

756.36  
516+50.00  
756.36

756.73  
516+11.22  
756.73  
BEGIN WORK

REVISIONS	NUMBER	DATE	DESCRIPTION
	1	11/24/20	REVISED QUANTITY


END AREA	VOLUME		CALCULATED KDW	CHECKED TWC
	CUT	FILL		
26	11			
26	7			
20	6			
20	10			
29	9			

CROSS SECTIONS - RAMP B  
STA. 516+11.22 TO STA. 516+59.17

MOT-75-9.53

17  
32

P:\DDT\07\0683\MOT-75-9.53\109436\Design\Roadway\Sheets\109436\_XS001.dgn Sheet 11/24/2020 9:27:53 AM CMT008

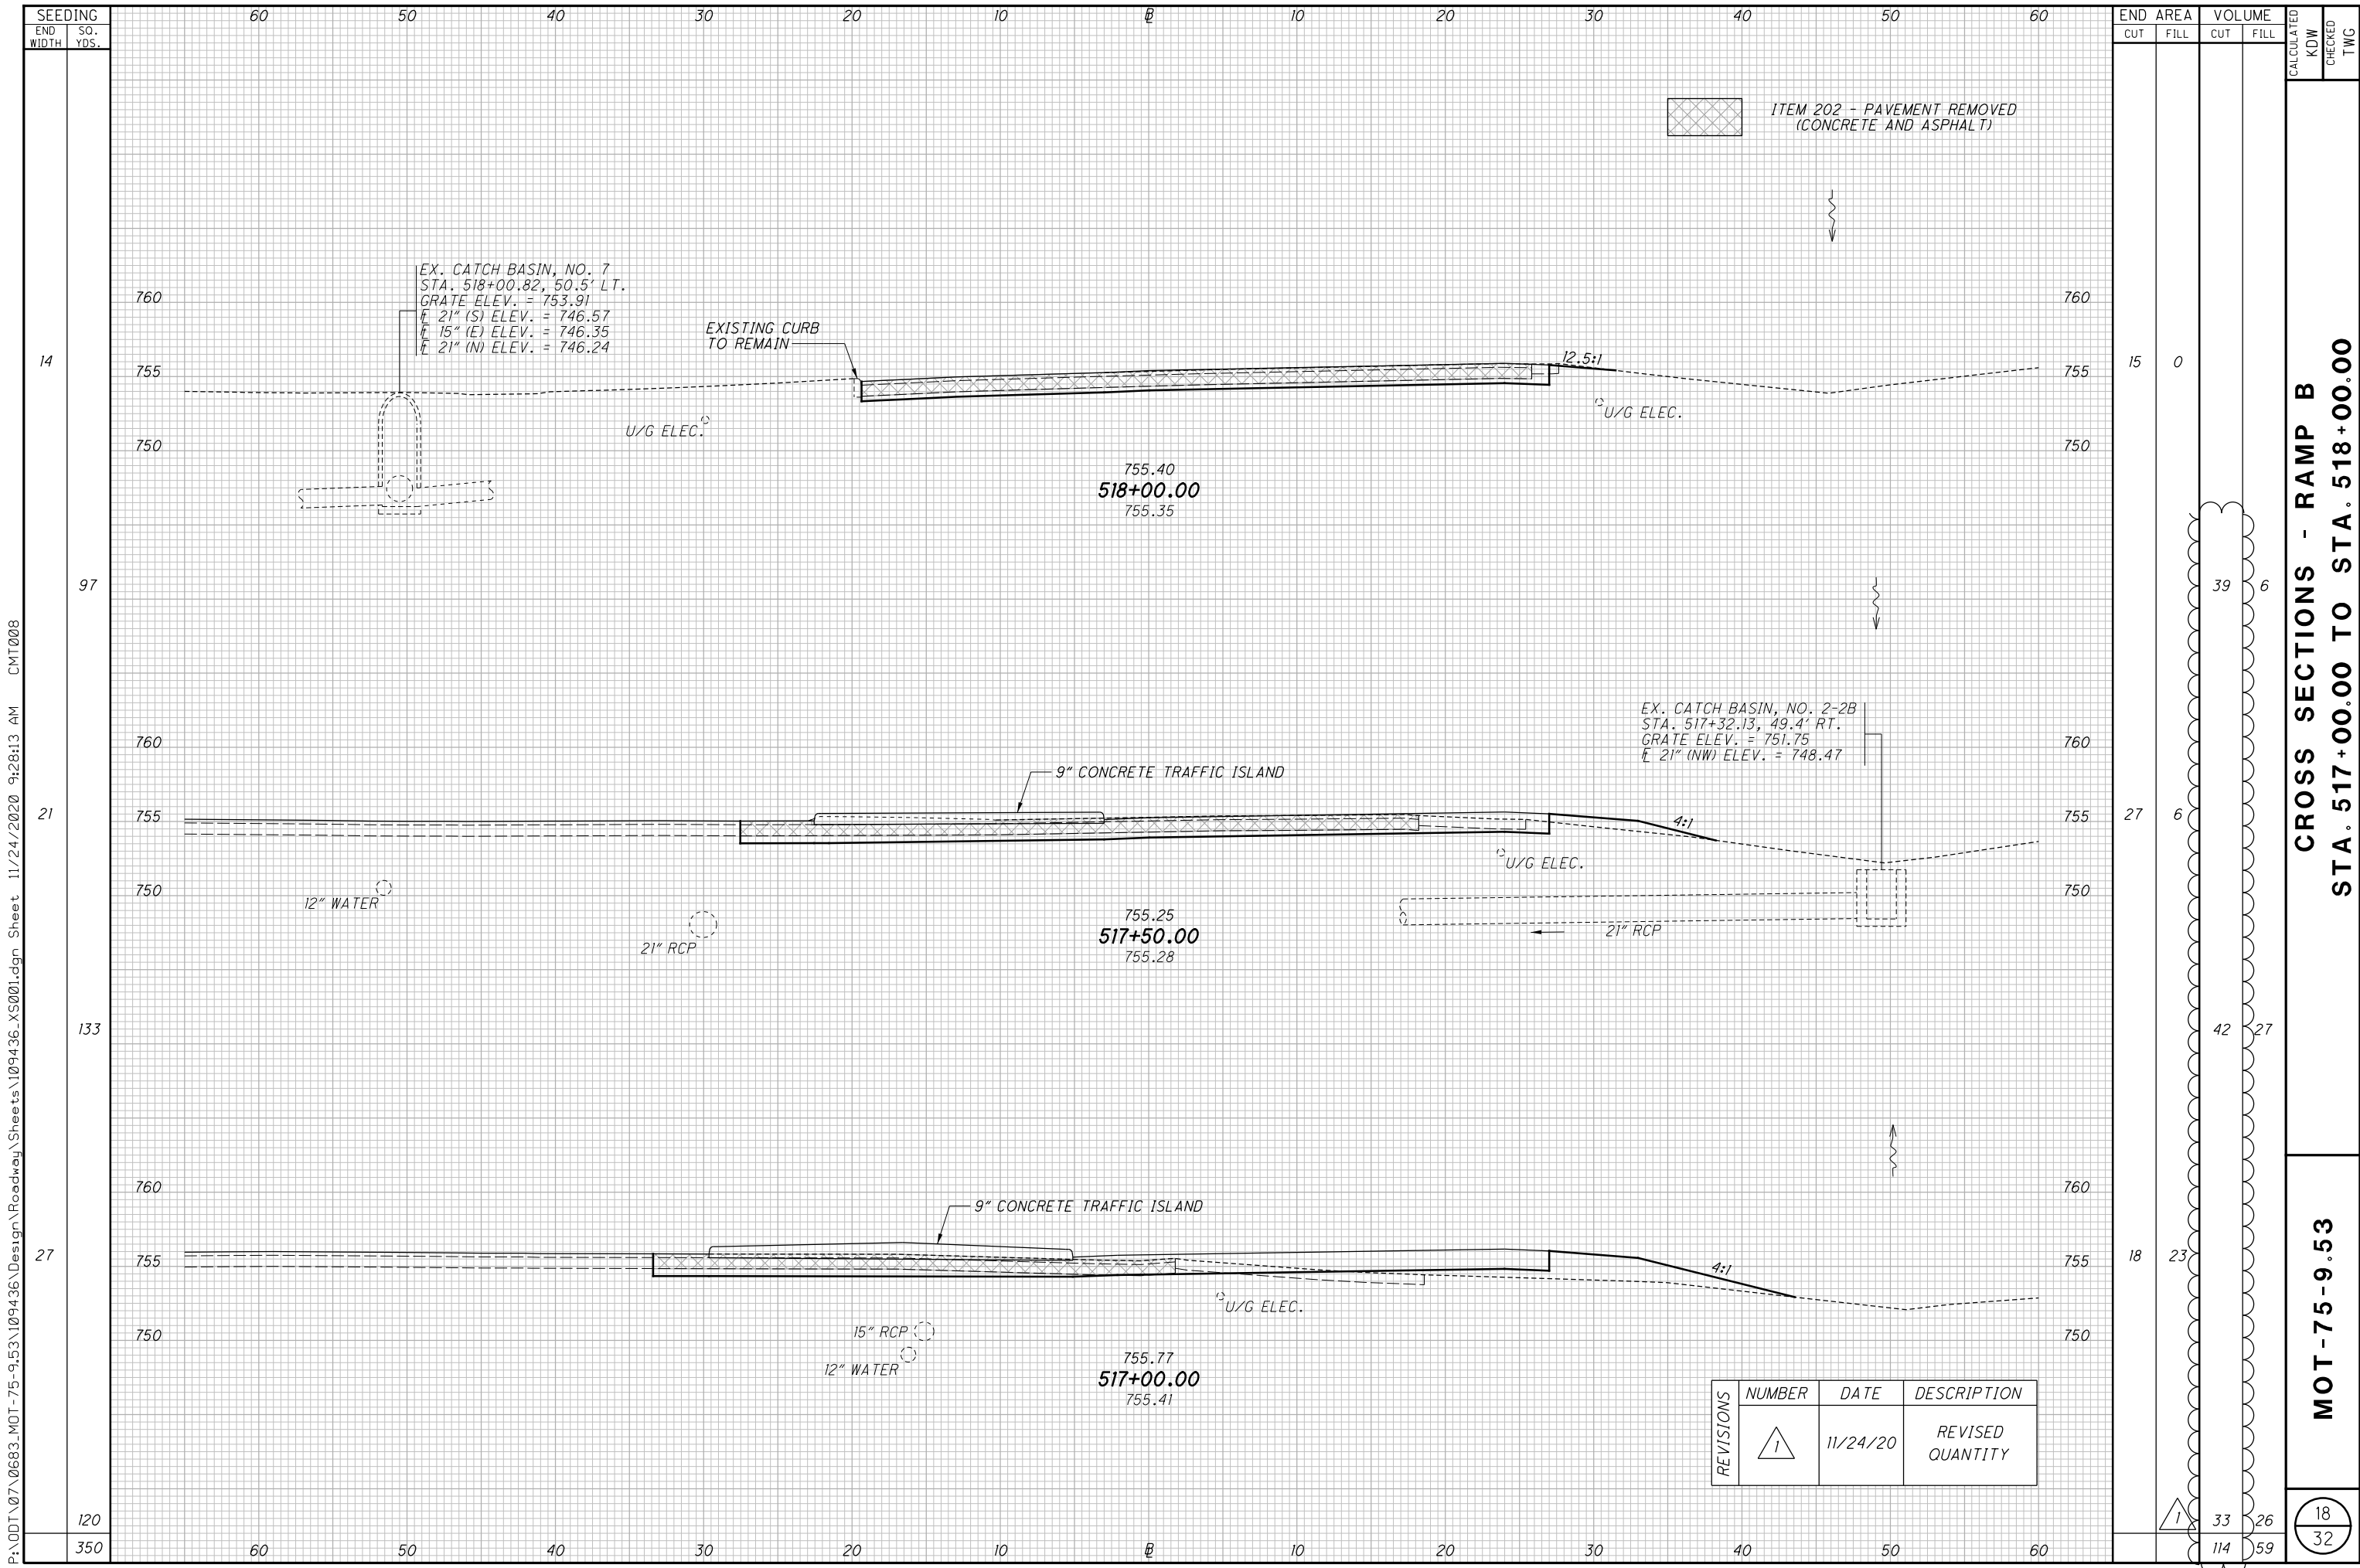

SEEDING	
END WIDTH	SO. YDS.
14	60
97	50
21	40
133	30
27	20
120	10
350	0

END CUT	AREA FILL	VOLUME		CALCULATED KDW	CHECKED TWG
		CUT	FILL		
15	0	39	6		
27	6	42	27		
18	23	33	26		
		114	59		


**CROSS SECTIONS - RAMP B**  
**STA. 517+00.00 TO STA. 518+00.00**

**MOT-75-9.53**

18  
32

REVISIONS	NUMBER	DATE	DESCRIPTION
1	1	11/24/20	REVISED QUANTITY

P:\DDT\07\0683\MOT-75-9.53\109436\Design\Roadway\Sheets\109436\_XS001.dgn Sheet 11/24/2020 9:28:13 AM CMT008

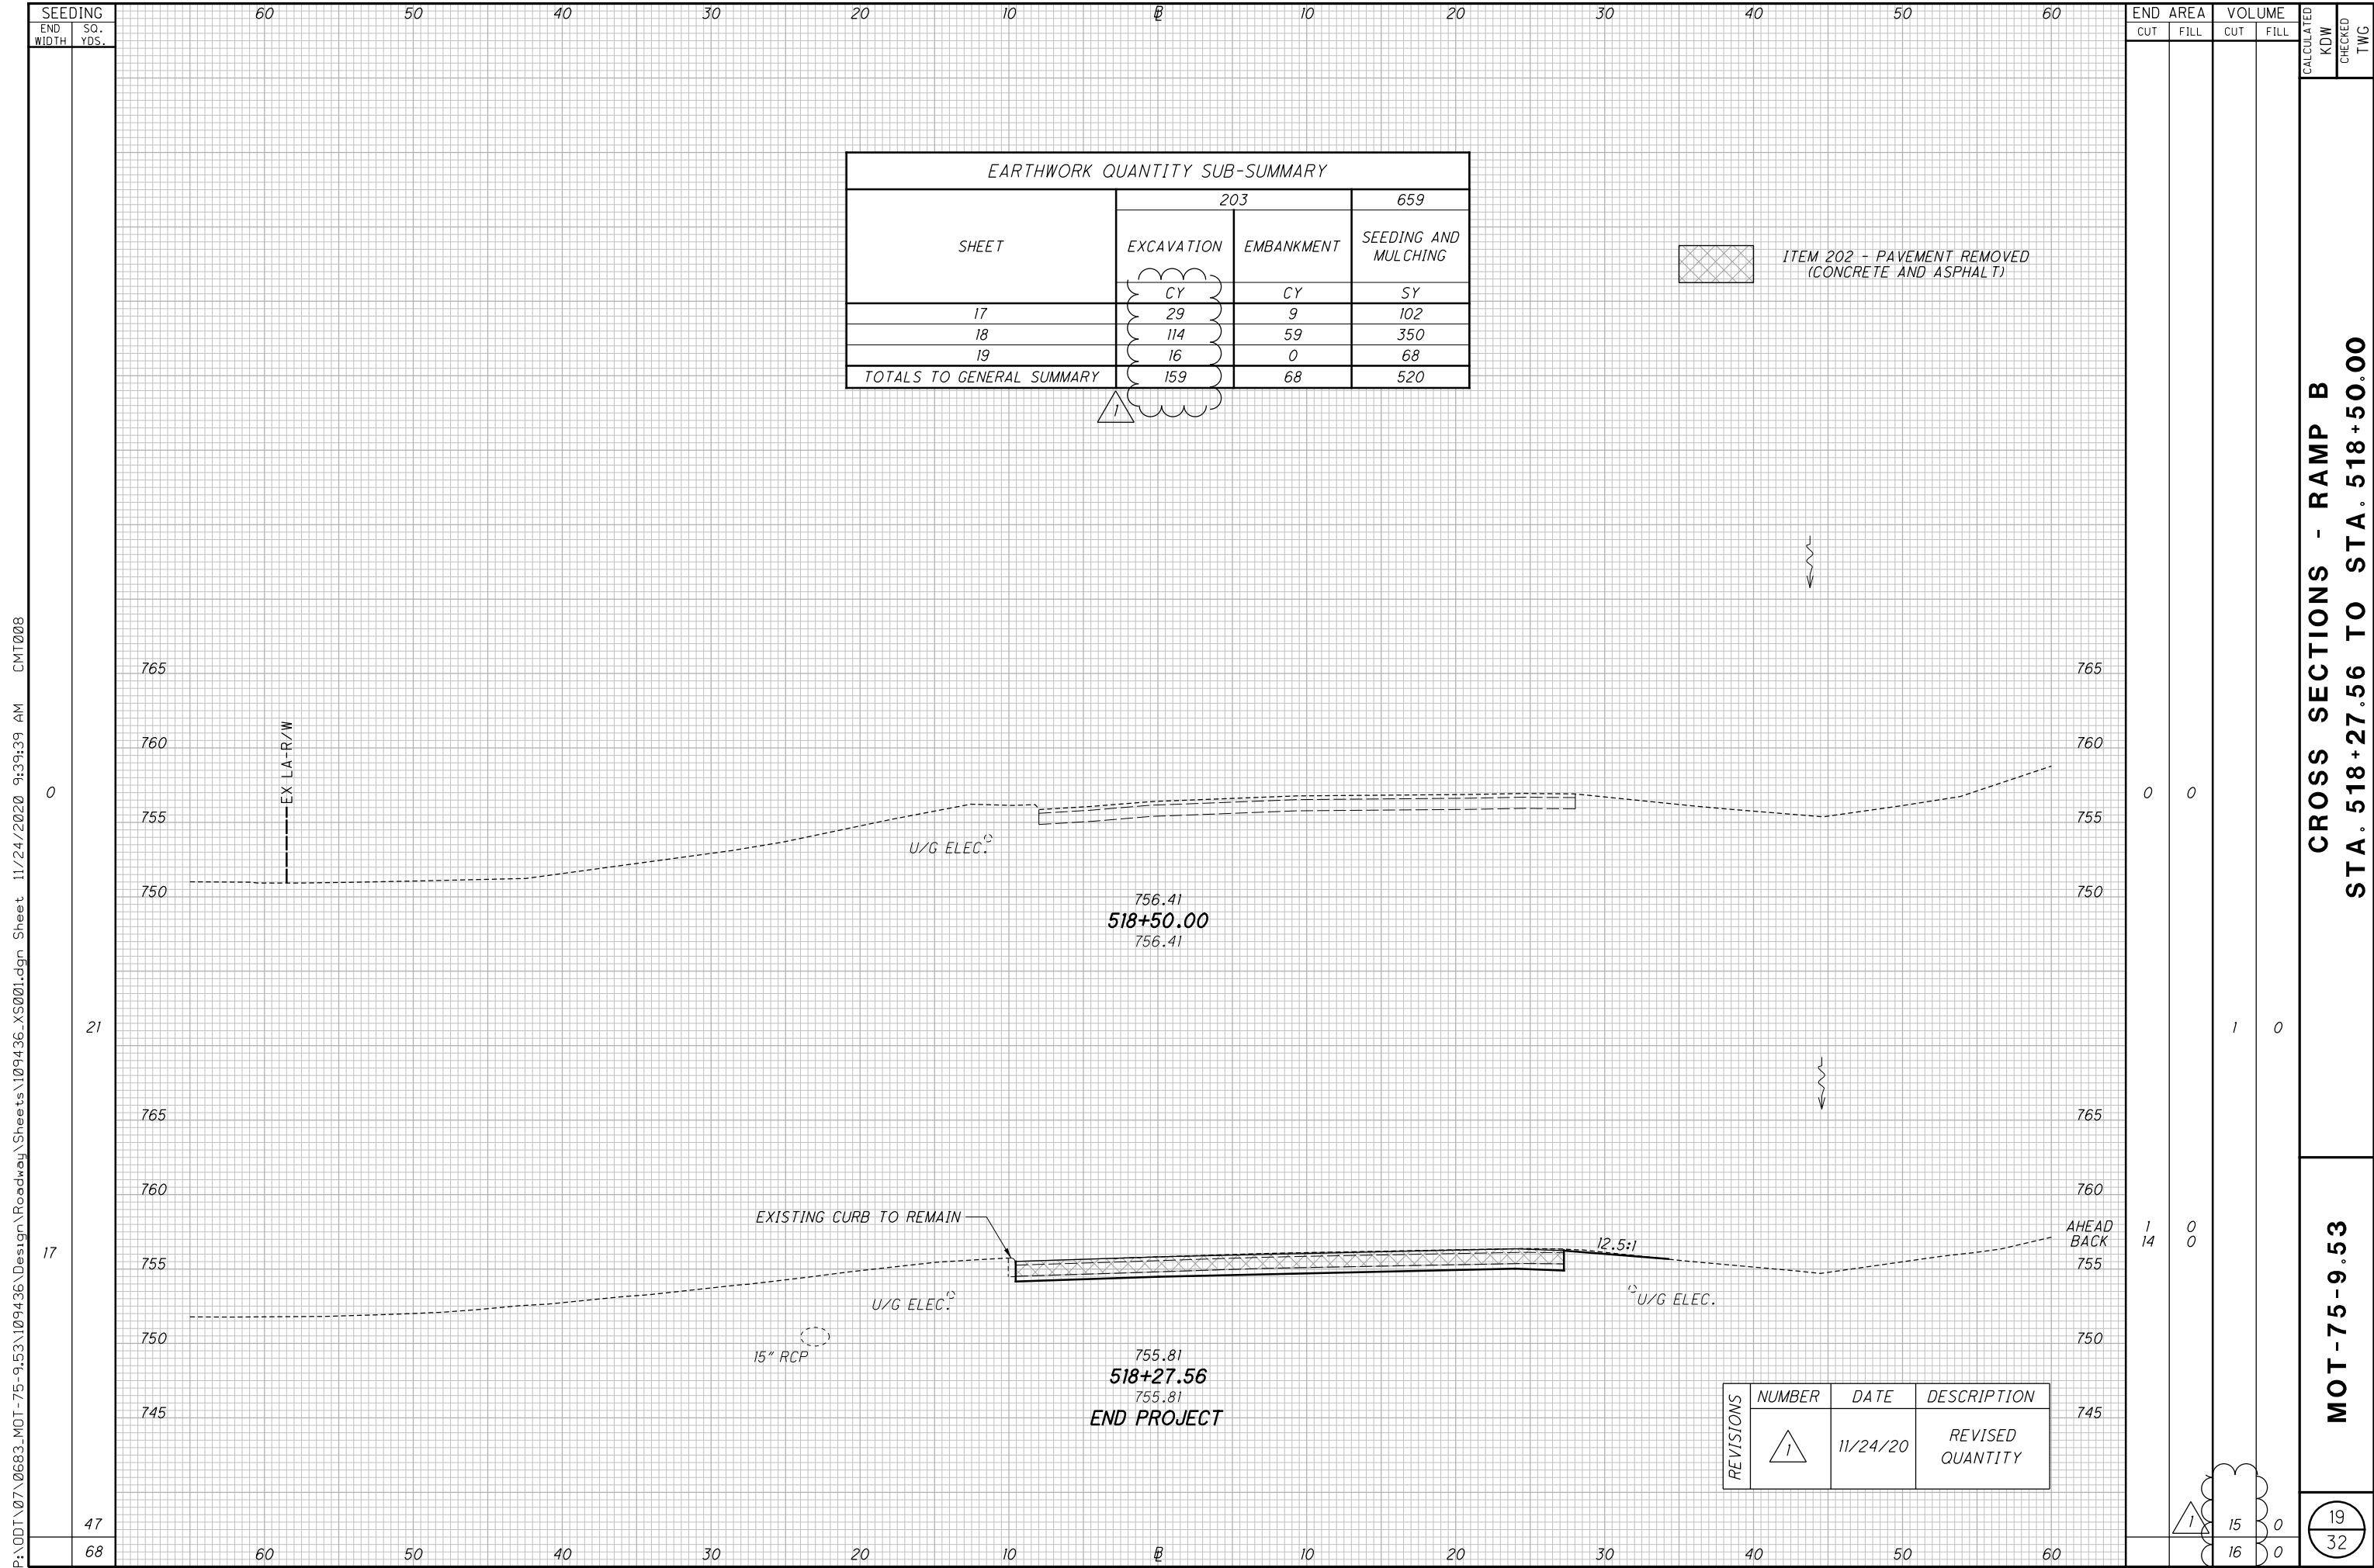

EARTHWORK QUANTITY SUB-SUMMARY			
SHEET	203		659
	EXCAVATION CY	EMBANKMENT CY	SEEDING AND MULCHING SY
17	29	9	102
18	114	59	350
19	16	0	68
TOTALS TO GENERAL SUMMARY	159	68	520

ITEM 202 - PAVEMENT REMOVED  
(CONCRETE AND ASPHALT)

P:\DDT\07\0683\MOT-75-9.53\109436\Design\Roadway\Sheets\109436\_XS001.dgn Sheet 11/24/2020 9:39:39 AM CMT008

END AREA	VOLUME	CALCULATED	CHECKED	TWC	
					CUT
0	0				
1	0				
14	0				
15	0				
16	0				

**CROSS SECTIONS - RAMP B**  
**STA. 518+27.56 TO STA. 518+50.00**

**MOT-75-9.53**

REVISIONS	NUMBER	DATE	DESCRIPTION
△	1	11/24/20	REVISED QUANTITY

1	15	0	19
	16	0	32