



SR 202 (OLD TROY PK) TYPICAL SECTION

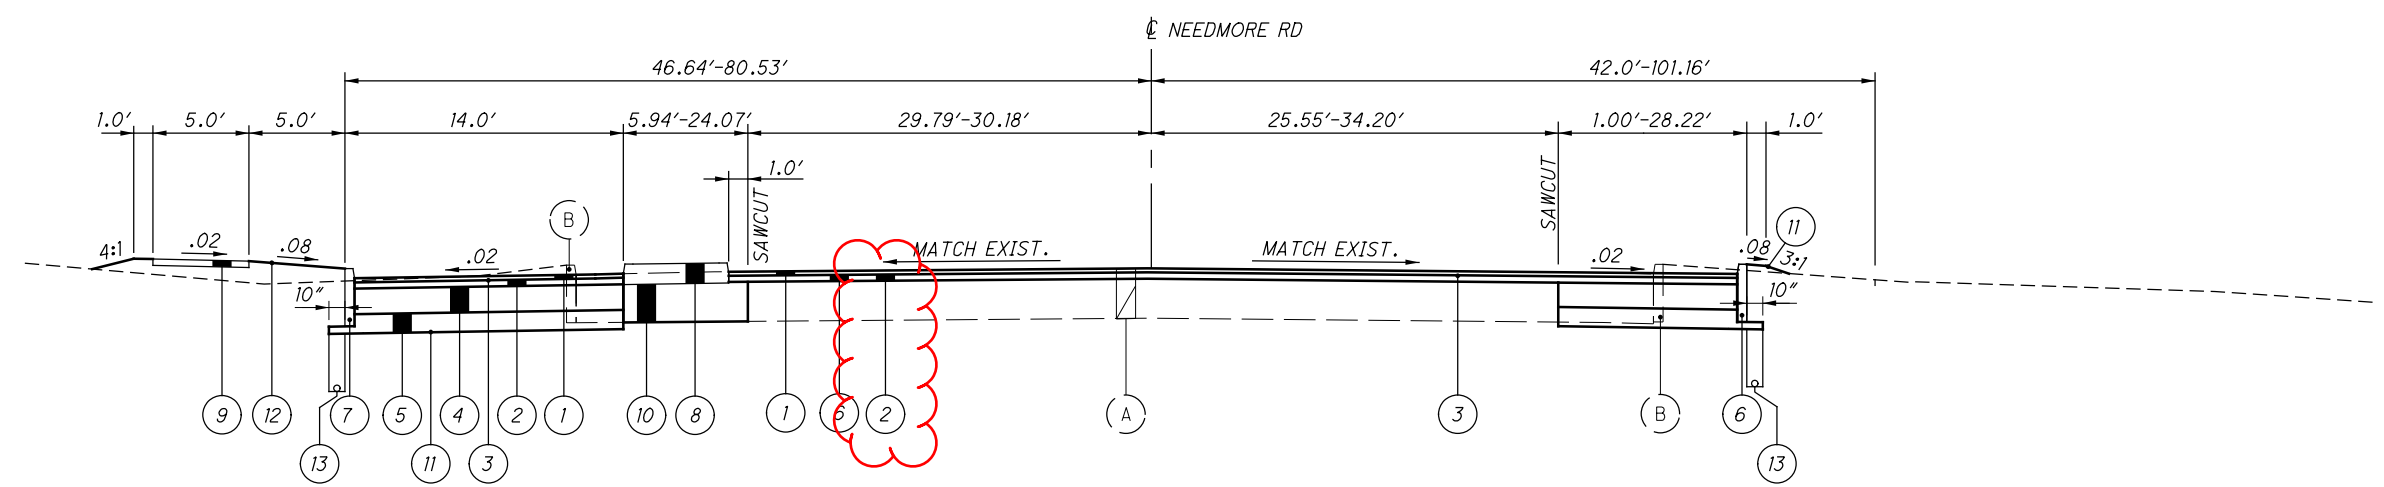

NEEDMORE RD TYPICAL SECTION

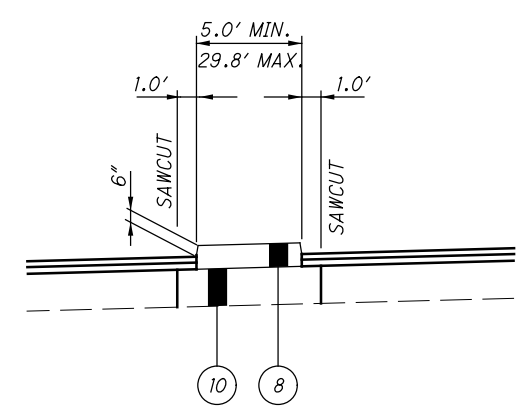

TRAFFIC ISLAND DETAIL

LEGEND

- (1) ITEM 443 - 1 1/2", STONE MATRIX ASPHALT CONCRETE 12.5MM, PG70-22M (448)
- (2) ITEM 442 - 1 3/4", ASPHALT CONCRETE INTERMEDIATE COURSE, 19MM, TYPE B (448)
- (3) ITEM 407 - NON-TRACKING TACK COAT APPLIED AT 0.06 GAL/SY [NEW ASPHALT] OR 0.09 GAL/SY [MILLED ASPHALT]
- (4) ITEM 301 - 8" ASPHALT CONCRETE BASE
- (5) ITEM 304 - 6" AGGREGATE BASE
- (6) ITEM 254 - PAVEMENT PLANING ASPHALT CONCRETE, 3 1/4" DEPTH
- (7) ITEM 609 - CURB, TYPE 6
- (8) ITEM 609 - TRAFFIC ISLAND, 9" THICK
- (9) ITEM 608 - 4" CONCRETE WALK
- (10) ITEM 613 - LOW STRENGTH MORTAR BACKFILL, TYPE 2 (12")
- (11) ITEM 204 - SUBGRADE COMPACTION
- (12) ITEM 659 - COMMERCIAL FERTILIZER, SEEDING AND MULCHING
- (13) ITEM 605 - 4" BASE PIPE UNDERDRAIN

- (A) Existing Pavement
- (B) Existing Curb

L:\ODOT\19068304-00_D7&8SafetyDesign\01_MOT-202\110483_Sheets\110483_GY001.dgn 11/23/2021 1:03:12 PM nbrickner