



J:\139963_Van_Web_Pave\7.0_Production\7.03_Design\04_Civil\Sheets\139963_TYPICAL_SECTIONS.dwg Plotted By: Mike Murray Date: 03/26/2024 Time: 2:46:41 PM Plotter: AutoCAD PDF (General Documentation).pc3 Pentable: IBI_Ohio.ctb Scale: 1:1 ~ IBI Group, Inc.

LEGEND

- | | |
|---|--|
| ① ITEM 441- 1.5" ASPHALT CONCRETE SURFACE COURSE, TYPE 1, (448), PG64-22 | ⑤ ITEM 204-SUBGRADE COMPACTION |
| ② ITEM 407-NON-TRACKING TACK COAT @ 0.075 GAL./S.Y. | ⑥ ITEM 304-AGGREGATE BASE, 6" |
| ③ ITEM 254-PAVEMENT PLANING, ASPHALT CONCRETE (1.5"), AS PER PLAN | ⑦ ITEM 301-ASPHALT CONCRETE BASE PG64-22, 5" |
| ④ ITEM 441- 1.5" ASPHALT CONCRETE INTERMEDIATE COURSE, TYPE 2, (448), PG64-22 | Ⓐ EX. PAVEMENT (COMPOSITION UNKNOWN) |

NOTES:

- NON-TRACKING TACK COAT @ 0.075 GAL./S.Y. APPLIED TO THE FINAL MILLED SURFACE.
- SUSPEND MILL & RESURFACING AT RAILROAD LIMITS STA 18+06 AND RESUME AT STA 18+29

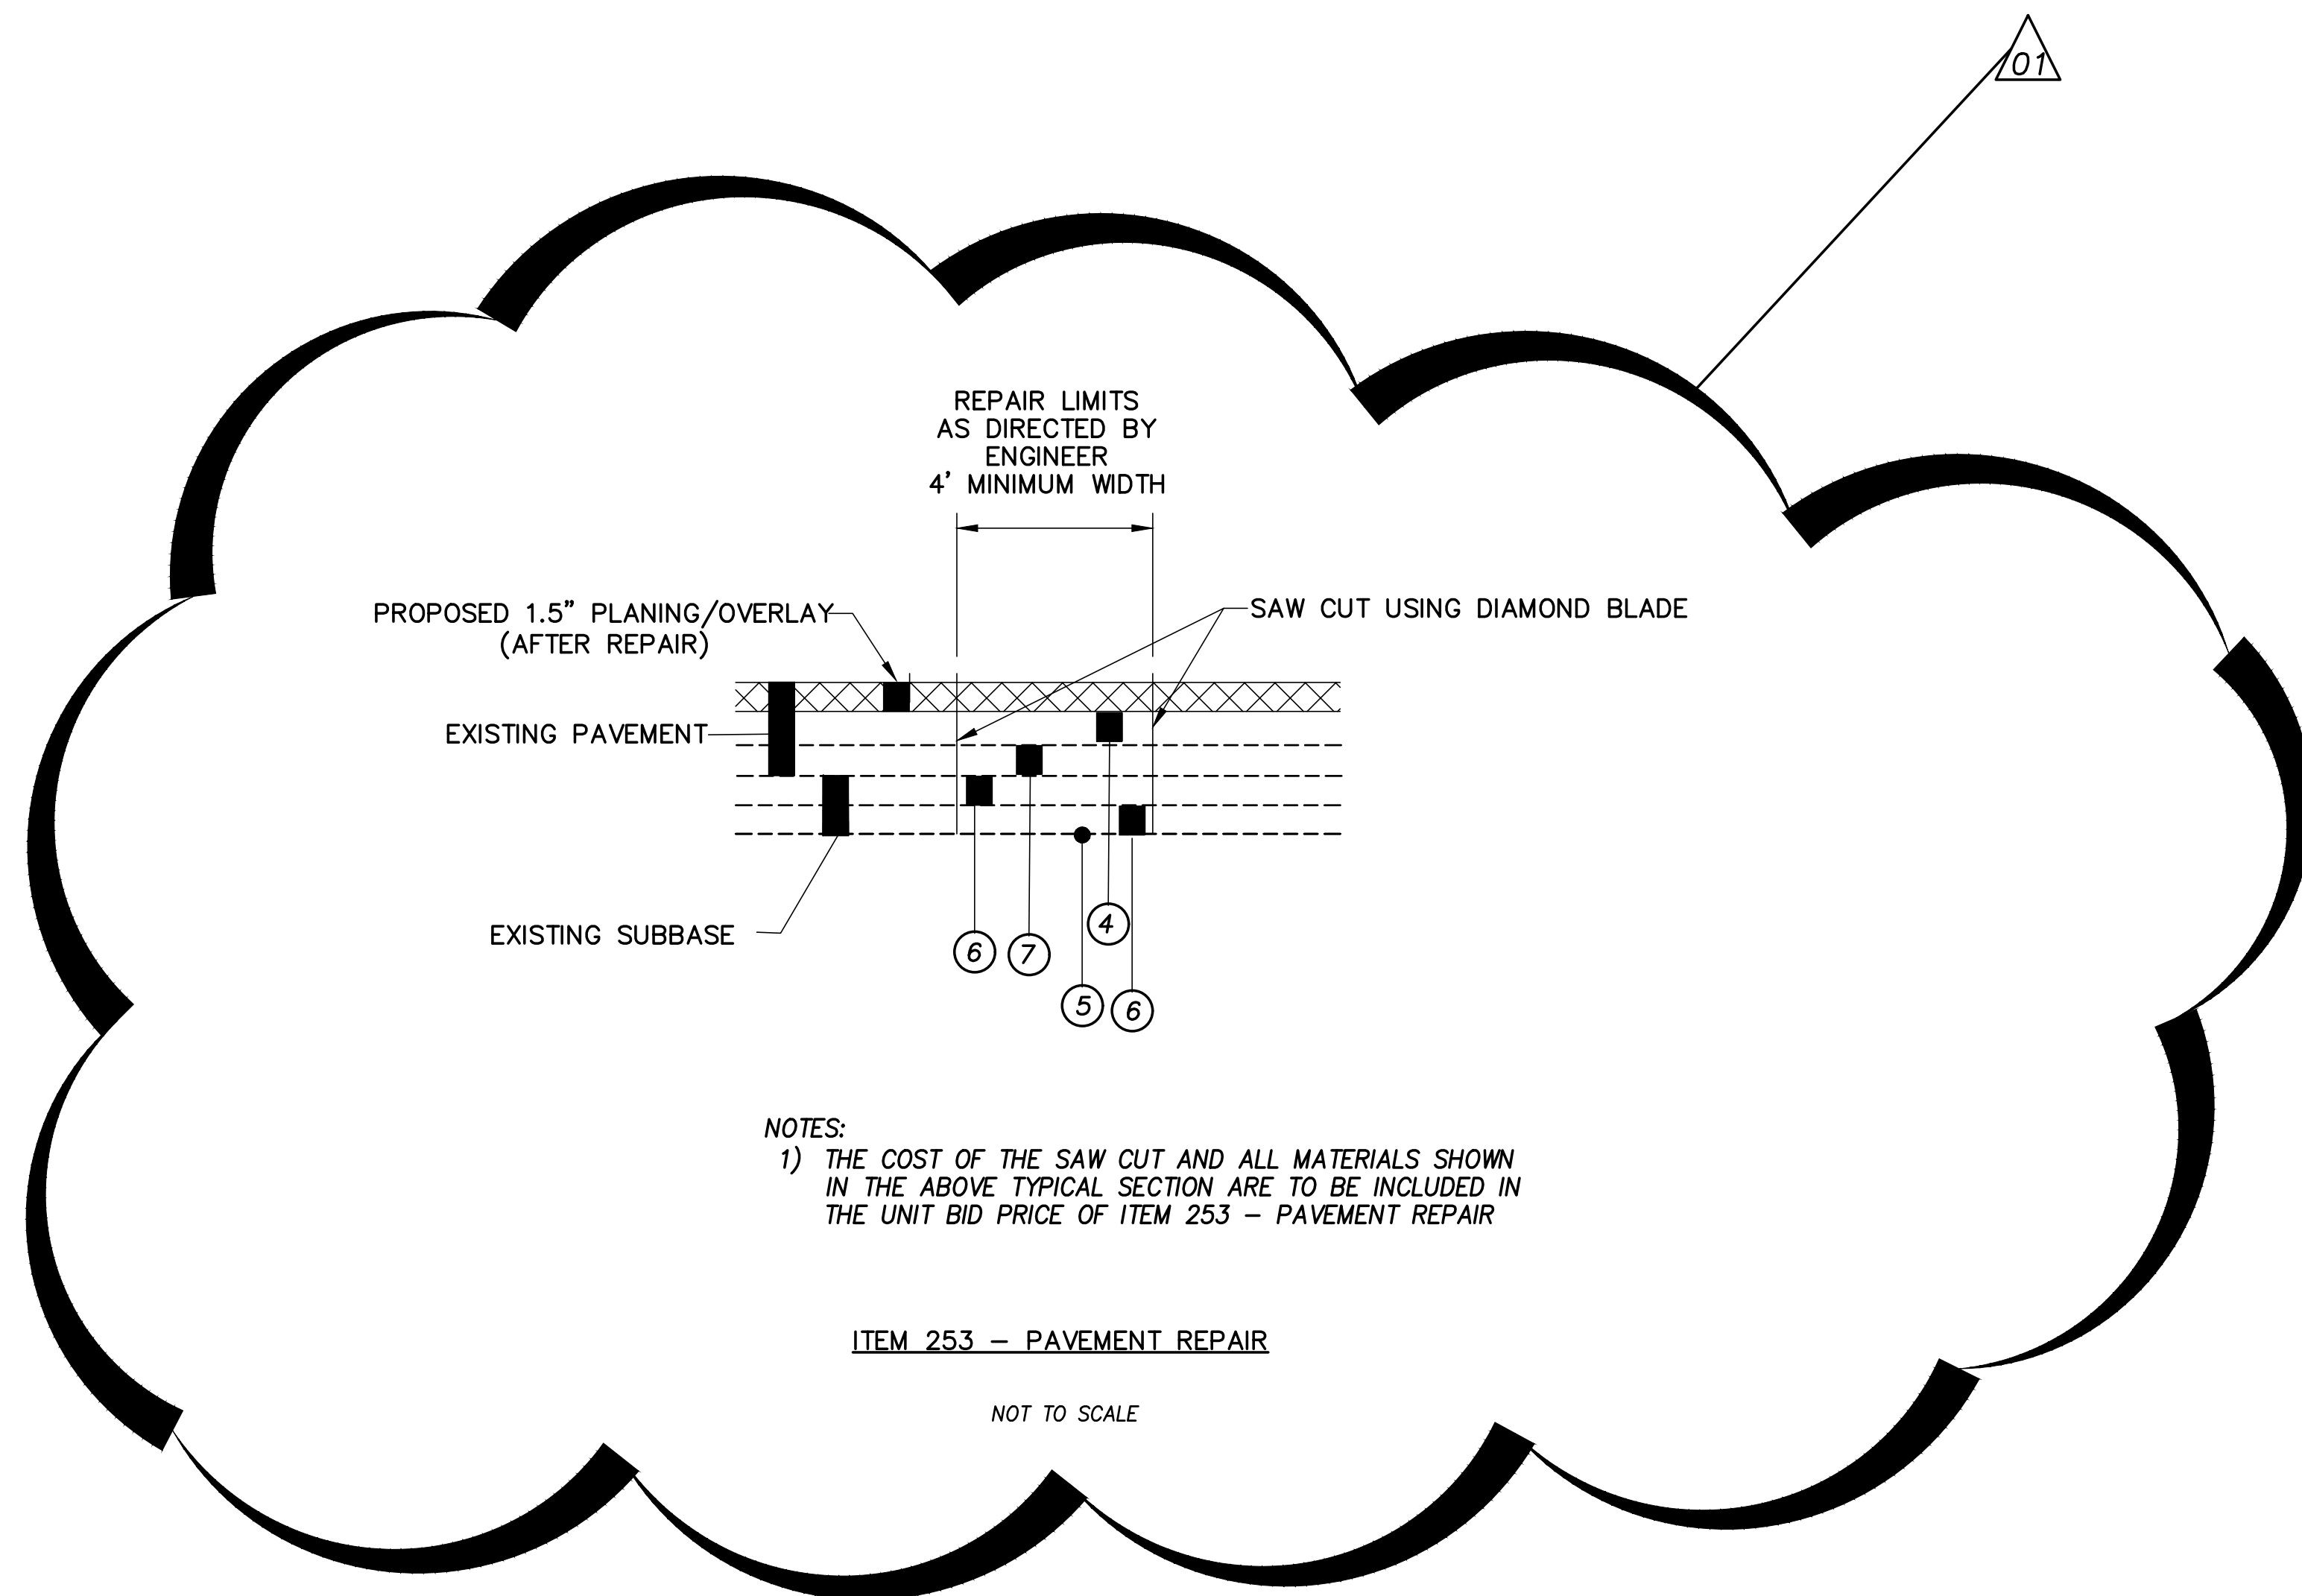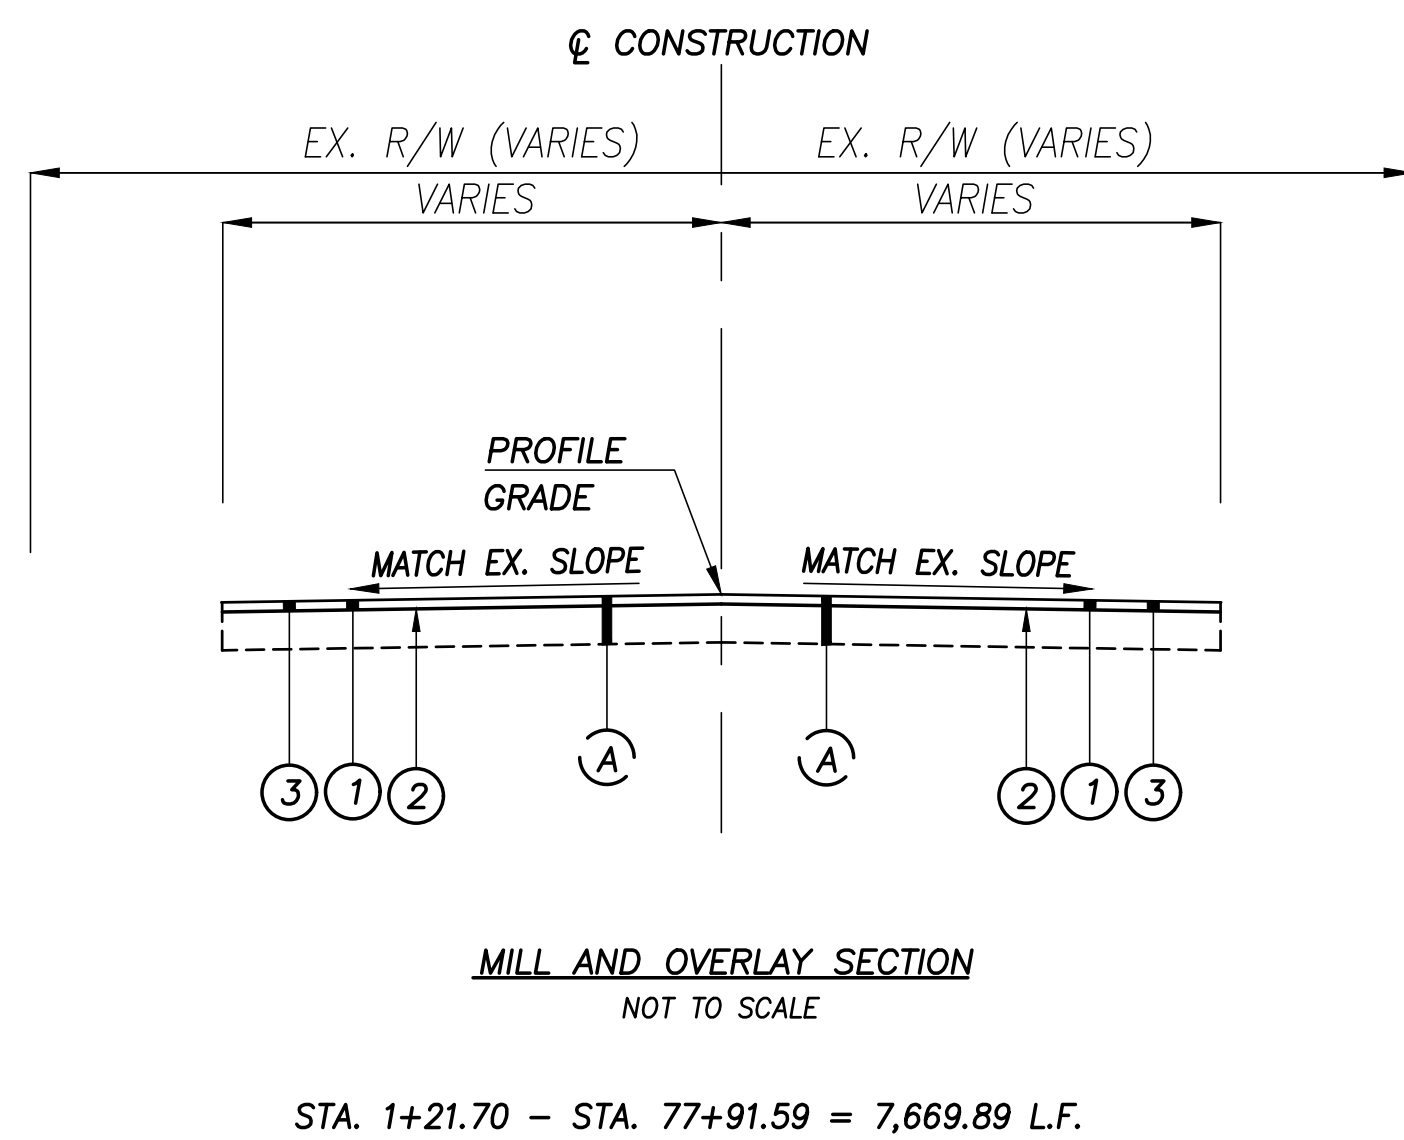

- NOTES:**
- THE COST OF THE SAW CUT AND ALL MATERIALS SHOWN IN THE ABOVE TYPICAL SECTION ARE TO BE INCLUDED IN THE UNIT BID PRICE OF ITEM 253 - PAVEMENT REPAIR

CALCULATED
BSS
CHECKED
MSM

TYPICAL SECTIONS

MOT-WEBSTER STREET RESURFACING