

STATE OF OHIO
DEPARTMENT OF TRANSPORTATION

MOT-75-(10.44)(10.78)

CITY OF DAYTON
MONTGOMERY COUNTY

PROJECT DESCRIPTION

REMOVAL AND REPLACEMENT OF THE CONCRETE DECK OF THE MOT-75-1044 STRUCTURE OVER CARILLON BLVD AND THE GREAT MIAMI RIVER. SUPERSTRUCTURE REPLACEMENT OF THE MOT-75-1078 STRUCTURE OVER EDWIN C. MOSES BLVD. APPROACH SLAB REPLACEMENT FOR EACH STRUCTURE, GUIDE SIGN REPLACEMENT ALONG EDWIN C. MOSES BLVD, REMOVAL OF THE TURNAROUND LOCATED AT THE EDWIN C. MOSES BLVD. INTERCHANGE, AND REPLACEMENT OF MEDIAN BARRIER WALL. RESURFACING OF I.R. 75 AND THE EDWIN C. MOSES BLVD INTERCHANGE RAMP.

PROJECT EARTH DISTURBED AREA: 1.89 ACRES
ESTIMATED CONTRACTOR EARTH DISTURBED AREA: 1.00 ACRES
NOTICE OF INTENT EARTH DISTURBED AREA: 4.9 ACRES

LIMITED ACCESS

THIS IMPROVEMENT IS ESPECIALLY DESIGNED FOR THROUGH TRAFFIC AND HAS BEEN DECLARED A LIMITED ACCESS HIGHWAY OR FREEWAY BY ACTION OF THE DIRECTOR IN ACCORDANCE WITH THE PROVISIONS OF SECTION 5511.02 OF THE OHIO REVISED CODE.

2019 SPECIFICATIONS


THE STANDARD SPECIFICATIONS OF THE STATE OF OHIO, DEPARTMENT OF TRANSPORTATION, INCLUDING CHANGES AND SUPPLEMENTAL SPECIFICATIONS LISTED IN THE PROPOSAL SHALL GOVERN THIS IMPROVEMENT.

I HEREBY APPROVED THESE PLANS AND DECLARE THAT THE MAKING OF THIS IMPROVEMENT WILL NOT REQUIRE THE CLOSING TO TRAFFIC OF THE HIGHWAY AND THAT PROVISIONS FOR THE MAINTENANCE AND SAFETY OF TRAFFIC WILL BE AS SET FORTH ON THE PLANS AND ESTIMATES.

INDEX OF SHEETS:

TITLE SHEET	1	PLAN AND PROFILE - RAMP E	136
SCHEMATIC PLAN	2	CROSS SECTIONS - RAMP E	137-141
REFERENCES & BENCHMARKS	3	PLAN AND PROFILE - EDWIN C. MOSES BLVD	142
TYPICAL SECTIONS	4-10	CROSS SECTIONS - EDWIN C. MOSES BLVD	143-147
GENERAL NOTES	11-13	SUPERELEVATION TABLE	148
MAINTENANCE OF TRAFFIC	14-115	PAVEMENT DETAILS	149-152
GENERAL SUMMARY	116-121	DRAINAGE DETAILS	153
SUBSUMMARIES	122-125	NOT USED	154-156
PROJECT SITE PLAN	126	BARRIER DETAILS	157
PLAN AND PROFILE - IR 75	127-128	CAUSEWAY DETAILS	158-159
PLAN AND PROFILE - RAMP A	129	TRAFFIC CONTROL	160-177
PLAN AND PROFILE - RAMP B	130	LIGHTING	178-192
PLAN AND PROFILE - RAMP D	131	STRUCTURES OVER 20': MOT-75-1044	193-283
CROSS SECTIONS - RAMP D	132-135	STRUCTURES OVER 20': MOT-75-1078	284-340
		RIGHT OF WAY	341-348

205A

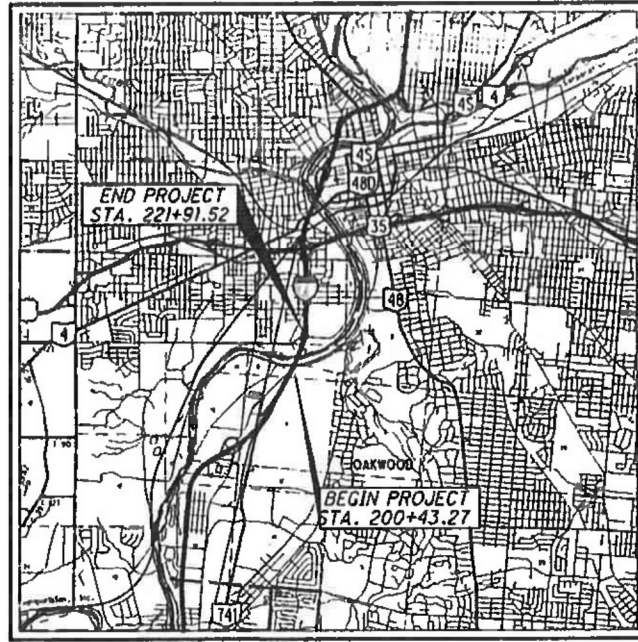

LOCATION MAP

LATITUDE: 39°43'52" LONGITUDE: 84°12'21"

SCALE IN MILES

PORTION TO BE IMPROVED	-----
INTERSTATE HIGHWAY	-----
FEDERAL ROUTES	-----
STATE ROUTES	-----
COUNTY & TOWNSHIP ROADS	-----
OTHER ROADS	-----

DESIGN DESIGNATION

CURRENT ADT (2019)	119,000
DESIGN YEAR ADT (2039)	131,000
DESIGN HOURLY VOLUME (2039)	12,000
DIRECTIONAL DISTRIBUTION	53%
TRUCKS (24 HOUR B&C)	20%
DESIGN SPEED	60 MPH
LEGAL SPEED	55 MPH
DESIGN FUNCTIONAL CLASSIFICATION:	
URBAN INTERSTATE	
NHS PROJECT	YES

DESIGN EXCEPTIONS

SUPERELEVATION - APPROVED 11/7/16
SHOWN ON SHEETS 2-6-7-8

UNDERGROUND UTILITIES
CONTACT BOTH SERVICES TWO WORKING DAYS BEFORE YOU DIG.

OHIO Utilities Protection SERVICE
Call Before You Dig
1-800-362-2764
(Non-members must be called directly)

OIL & GAS PRODUCERS UNDERGROUND PROTECTION SERVICE
1-800-925-0988

PLAN PREPARED BY:



ENGINEERS SEAL:
FOR SHEETS 178-192

STATE OF OHIO
REGISTERED PROFESSIONAL ENGINEER
MARK E. MOELLMAN
E-48120

SIGNED: [Signature]
DATE: 2/13/20

ENGINEERS SEAL:
FOR SHEETS 193-340

STATE OF OHIO
REGISTERED PROFESSIONAL ENGINEER
DAVID F. TRAINI
E-48751

SIGNED: [Signature]
DATE: 2/13/20

ENGINEERS SEAL:
FOR SHEETS 1-177

STATE OF OHIO
REGISTERED PROFESSIONAL ENGINEER
BRENT B. DOWNING
#E-EX2856

SIGNED: [Signature]
DATE: 2/13/20

STATE OF OHIO
REGISTERED PROFESSIONAL ENGINEER
BRENT B. DOWNING
#E-EX2856

STANDARD CONSTRUCTION DRAWINGS										SUPPLEMENTAL SPECIFICATIONS	SPECIAL PROVISIONS			
BP-3.1	01/17/20	MGS-4.3	1/18/13	VFP-1-90	7/20/18	MT-95.31	7/19/19	MT-103.10	1/18/18	TC-65.11	7/21/17	800-2019	4/17/20	GEPA DEMO
		MGS-5.2	7/15/16			MT-95.40	1/17/20	MT-104.10	10/16/15	TC-72.20	7/20/18	808	1/18/19	1/28/09
I-2.1	1/15/16	MGS-5.3	7/15/16	HL-10.11	7/19/19	MT-95.41	1/17/20	MT-105.10	1/17/20			813	10/19/18	
I-2.2	7/19/19	MGS-6.1	1/18/18	HL-10.12	1/20/17	MT-95.45	1/17/20	MT-110.10	7/19/13			814	7/15/16	WPC
				HL-10.13	1/17/20	MT-95.72	1/17/20					821	4/20/12	6/15/18
DM-1.1	7/21/17	RM-4.1	1/17/20	HL-20.11	4/21/17	MT-98.10	1/17/20	TC-7.65	7/20/18			832	10/19/18	
DM-1.2	1/18/13	RM-4.2	1/17/20	HL-20.13	1/19/18	MT-98.11	1/17/20	TC-9.10	1/19/18			845	4/20/18	
DM-2.1	1/18/13	RM-4.3	7/18/14	HL-30.11	7/19/19	MT-98.20	4/19/19	TC-12.30	1/19/18					
DM-4.1	7/20/18	RM-4.4	7/19/19	HL-30.31	1/17/20	MT-98.21	1/17/20	TC-21.10	7/19/19			908	10/20/17	
DM-4.3	1/15/16	RM-4.6	7/19/13	HL-30.32	1/17/20	MT-98.22	1/17/20	TC-21.20	7/20/18			913	4/21/17	
DM-4.4	1/15/16			HL-30.33	1/17/20	MT-98.29	1/17/20	TC-21.50	7/15/16			914	7/15/16	
		A-1-69	7/19/02	HL-30.41	1/19/18	MT-98.30	7/19/19	TC-41.10	7/19/13			921	4/20/12	
BP-5.1	1/18/19	AS-1-15	7/17/15	HL-40.10	1/20/17	MT-99.20	4/19/19	TC-41.20	10/18/13					
BP-9.1	1/18/19	AS-2-15	1/18/19	HL-40.20	1/17/20	MT-99.30	1/17/20	TC-41.30	10/18/13					
		GSD-1-96	7/19/02	HL-50.11	1/16/15	MT-101.60	1/17/20	TC-42.10	10/18/13					
F-1.1	7/19/13	HW-2.1	7/20/18	HL-50.21	1/18/19	MT-101.70	1/17/20	TC-42.20	10/18/13					
		HW-2.2	7/20/18	HL-60.11	7/21/17	MT-101.75	1/17/20	TC-51.11	1/15/16					
MGS-1.1	1/19/18	PCB-91	1/18/13	HL-60.12	7/15/16	MT-101.80	1/17/20	TC-51.12	1/15/16					
MGS-2.1	1/19/18	SBR-1-13	7/20/18	HL-60.21	7/20/18	MT-101.90	7/21/17	TC-52.10	10/18/13					
MGS-3.1	1/19/18	SBR-2-13	7/20/18	HL-60.31	1/17/20	MT-102.10	1/17/20	TC-52.20	7/20/18					
MGS-3.2	1/18/13	SICD-1-96	7/18/14			MT-102.20	4/19/19	TC-61.30	7/19/19					
MGS-4.2	7/19/13	SICD-2-14	7/18/14			MT-102.30	7/19/19	TC-65.10	1/17/14					

APPROVED: [Signature] DISTRICT DEPUTY DIRECTOR
DATE: 2/25/2020

APPROVED: [Signature] DIRECTOR, DEPARTMENT OF TRANSPORTATION
DATE: 3/5/20

MOT - IR - 75 - (10.44)(10.78)
200341
PID - 91606
Dist 7
07/02/2020

Contract Proposal Available @
www.contracts.dot.state.oh.us/home

FEDERAL PROJECT NO.
E120(723)

PID NO.
91606

CONSTRUCTION PROJECT NO.

RAILROAD INVOLVEMENT
NONE

MOT-75-(10.44)(10.78)

1
348

WINTER WORK

THE CONTRACTOR IS REQUIRED TO PURSUE ALL AVAILABLE WORK THROUGH THE WINTERS WHILE IN PHASE 2 AND PHASE 4 OF THE PLAN MOT. A SCHEDULE WILL NOT BE ACCEPTED THAT DOES NOT REPRESENT WORK (CRITICAL AND NON-CRITICAL) BEING PERFORMED THROUGHOUT THESE WINTER PERIODS. THE PLAN MOT IS PHASED AS SUCH WITH POTENTIAL DISINCENTIVES TO ENSURE THE PROJECT IS IN A CONDITION TO ALLOW WORK TO CONTINUE THROUGHOUT PHASE 2 AND PHASE 4. WEATHER DAYS THROUGHOUT THESE WINTER PERIODS WILL BE ANALYZED IN ACCORDANCE WITH 108.06 IN CONJUNCTION WITH THE TABLE IN 108.06-1, HOWEVER THE CONTRACT IS REQUIRED TO RECOGNIZE DURING THE BIDDING PROCESS THAT WINTER WORK MAY POTENTIALLY REQUIRE ITEMS SUCH AS COLD WEATHER PROTECTION, LESS EFFICIENT PRODUCTIVITY, ETC.

SEQUENCE OF CONSTRUCTION

PHASE 1

INSTALL ALL TEMPORARY TRAFFIC CONTROL DEVICES NECESSARY TO MAINTAIN TRAFFIC IN THE PHASE 1 CONFIGURATION. SHIFT NORTHBOUND TRAFFIC ONTO THE OUTSIDE LANES AND SHOULDER AS SHOWN IN THE PLANS.

REMOVE MEDIAN BARRIER WALL WITHIN CROSSOVER LIMITS. EXISTING LIGHT POLES WITHIN REMOVAL LIMITS SHALL BE STORED. PLACE ASPHALT WEDGE ON EXISTING INSIDE SHOULDERS NEAR CROSSOVERS AS DETAILED IN THE PLANS. INSTALL TEMPORARY DRAINAGE NEEDED FOR FUTURE PHASES.

UTILIZE APPLICABLE STANDARD CONSTRUCTION DRAWINGS TO SHIFT OR CLOSE LANES IN ACCORDANCE WITH THE NOTES HEREIN IN ORDER TO PERFORM A 1.5" MILL AND FILL OF THE EXISTING PAVEMENT FROM THE NORTHERN LIMIT OF THE BRIDGE OVER SR-741 TO THE SOUTHERN LIMIT OF THE BRIDGE OVER STEWART ST., INCLUDING THE EDWIN C. MOSES INTERCHANGE RAMP AND BETWEEN THE MOT-1044 AND MOT-1078 STRUCTURES. THE VARIABLE DEPTH OVERLAY BETWEEN THE STRUCTURES SHALL BE COMPLETED IN FUTURE PHASES.

THE SOUTHBOUND EXIT RAMP TO NORTHBOUND ENTRANCE RAMP TURNAROUND SHALL BE CLOSED AT THE START OF WORK. REMOVAL OF THE PORTION OF THE TURNAROUND ALONG THE EXISTING RAMP SHALL BE COMPLETED PRIOR TO RAMP RESURFACING. EDWIN C. MOSES BLVD AND RAMP TRAFFIC SHALL BE MAINTAINED ACCORDING TO THE APPLICABLE STANDARD CONSTRUCTION DRAWINGS AND NOTES HEREIN. THE REMOVAL OF THE REMAINDER OF THE TURNAROUND MAY BE PERFORMED AT ANY TIME DURING THE PROJECT.

PHASE 2

PHASE 2 CONSTRUCTION SHALL BEGIN NO LATER THAN OCTOBER 15, 2020.

REMOVE EXISTING SIGNING IN CONFLICT WITH PROPOSED MOT SETUP. INSTALL MOT SIGNING AS PER STANDARD CONSTRUCTION DRAWINGS LISTED AND AS SHOWN IN THE PLANS.

INSTALL ALL TEMPORARY TRAFFIC CONTROL DEVICES NECESSARY TO MAINTAIN TRAFFIC IN THE PHASE 2 CONFIGURATION. SHIFT NORTHBOUND TRAFFIC ONTO THE OUTSIDE LANES AND SHOULDER AS SHOWN IN THE PLANS. CROSSOVER THE SOUTHBOUND INSIDE LANE OF TRAFFIC TO THE NORTHBOUND INSIDE SHOULDER. SHIFT THE REMAINING TWO OUTSIDE SOUTHBOUND LANES ONTO THE EXISTING INSIDE LANES AND SHOULDER. RAMP TRAFFIC SHALL BE MAINTAINED AS SHOWN IN THESE PLANS.

THE SOUTHBOUND ENTRANCE RAMP FROM EDWIN C. MOSES BLVD SHALL BE CLOSED AND DETOURED AS SHOWN IN THE PLANS FOR THE DURATION OF THIS PHASE.

RECONSTRUCT THE PORTION OF SOUTHBOUND PAVEMENT NOT USED TO MAINTAIN TRAFFIC AS SHOWN IN THE PLANS. PLACE TEMPORARY PAVEMENT ADJACENT TO THE EXISTING OUTSIDE SHOULDER AS SHOWN IN THE PLANS. RECONSTRUCT EASTBOUND EDWIN C. MOSES SLIP RAMP TO I.R. 75 SOUTHBOUND DURING RAMP CLOSURE.

PHASE 3A

NORTHBOUND TRAFFIC SHALL REMAIN IN THE PHASE 2 CONFIGURATION. CONTINUE TO CROSSOVER THE SOUTHBOUND INSIDE LANE OF TRAFFIC TO THE NORTHBOUND INSIDE SHOULDER AS SETUP IN PHASE 2. SHIFT THE REMAINING TWO OUTSIDE SOUTHBOUND LANES ONTO THE EXISTING OUTSIDE LANES AND SHOULDER AND TEMPORARY PAVEMENT INSTALLED IN PHASE 2. RAMP TRAFFIC SHALL BE MAINTAINED AS SHOWN IN THESE PLANS. DURING CONCRETE DECK PLACEMENT, THE CONTRACTOR SHALL CLOSE THE LANE ADJACENT TO THE WORK ZONE DURING PERMITTED LANE CLOSURES TIMES WITH THE APPLICABLE STANDARD CONSTRUCTION DRAWINGS.

RECONSTRUCT THE PORTION OF SOUTHBOUND PAVEMENT NOT USED TO MAINTAIN TRAFFIC AS SHOWN IN THE PLANS.

IN ORDER TO PROVIDE ADEQUATE PROTECTION FOR THE DROPOFF BETWEEN EXISTING AND PROPOSED PAVEMENT, THE CONTRACTOR SHALL COMPLETE RESURFACING UP TO THE INTERMEDIATE COURSE BETWEEN THE MOT-75-1044 AND MOT-75-1078 STRUCTURES PRIOR TO INSTALLATION OF THE CONSTRUCTION ACCESS POINT DETAILED ON SHEET 69.

PHASE 3B

NORTHBOUND TRAFFIC SHALL REMAIN IN THE PHASE 2 CONFIGURATION. RETURN ALL LANES OF SOUTHBOUND TRAFFIC TO THE SOUTHBOUND SIDE OF THE MEDIAN AND SHIFT SOUTHBOUND TRAFFIC ONTO THE OUTSIDE LANES AND SHOULDER AS SHOWN IN THE PLANS. RAMP TRAFFIC SHALL BE MAINTAINED AS SHOWN IN THE PLANS.

REPLACE THE PORTIONS OF THE EXISTING CONCRETE MEDIAN BARRIER SHOWN IN THE PLANS. PERFORM ADDITIONAL MEDIAN WORK SUCH AS CATCH BASIN REPLACEMENT AND SIGN FOUNDATION REPLACEMENT.

PHASE 4A

PHASE 4 CONSTRUCTION SHALL BEGIN NO LATER THAN OCTOBER 15, 2021.

PRIOR TO THE START OF PROPOSED PHASE 4 CONSTRUCTION, PLACE ALL TEMPORARY TRAFFIC CONTROL DEVICES AND TEMPORARY PAVEMENT MARKINGS REQUIRED FOR PHASE 4 OPERATIONS.

SOUTHBOUND TRAFFIC SHALL BE SHIFTED ONTO THE OUTSIDE SHOULDER. CROSSOVER THE NORTHBOUND INSIDE LANE OF TRAFFIC TO THE SOUTHBOUND INSIDE SHOULDER. SHIFT THE REMAINING TWO OUTSIDE NORTHBOUND LANES ONTO THE EXISTING INSIDE SHOULDER. RAMP TRAFFIC SHALL BE MAINTAINED AS SHOWN IN THESE PLANS.

RECONSTRUCT THE PORTION OF NORTHBOUND PAVEMENT NOT USED TO MAINTAIN TRAFFIC AS SHOWN IN THE PLANS.

PHASE 4B

NORTHBOUND AND SOUTHBOUND TRAFFIC SHALL REMAIN IN THE PHASE 4A CONFIGURATION. CLOSE THE NORTHBOUND EXIT RAMP TO EDWIN C. MOSES TO COMPLETE OUTSIDE I.R. 75 AND RAMP RESURFACING. THE RAMP SHALL BE CLOSED FOR A SINGLE WEEKEND PERIOD FROM 8PM FRIDAY TO 6AM MONDAY. RAMP TRAFFIC SHALL BE DETOURED AS SHOWN IN THE PLANS.

PHASE 5

SOUTHBOUND TRAFFIC SHALL REMAIN IN THE PHASE 4 CONFIGURATION. CONTINUE TO CROSSOVER THE NORTHBOUND INSIDE LANE OF TRAFFIC TO THE SOUTHBOUND INSIDE SHOULDER AS SETUP IN PHASE 4. SHIFT THE REMAINING TWO OUTSIDE NORTHBOUND LANES ONTO THE EXISTING OUTSIDE SHOULDER AND TEMPORARY PAVEMENT INSTALLED IN PHASE 4. RAMP TRAFFIC SHALL BE MAINTAINED AS SHOWN IN THESE PLANS. DURING CONCRETE DECK PLACEMENT, THE CONTRACTOR SHALL CLOSE THE LANE ADJACENT TO THE WORK ZONE DURING PERMITTED LANE CLOSURES TIMES WITH THE APPLICABLE STANDARD CONSTRUCTION DRAWINGS.

RECONSTRUCT THE PORTION OF NORTHBOUND PAVEMENT NOT USED TO MAINTAIN TRAFFIC AS SHOWN IN THE PLANS.

IN ORDER TO PROVIDE ADEQUATE PROTECTION FOR THE DROPOFF BETWEEN EXISTING AND PROPOSED PAVEMENT, THE CONTRACTOR SHALL COMPLETE RESURFACING UP TO THE INTERMEDIATE COURSE BETWEEN THE MOT-75-1044 AND MOT-75-1078 STRUCTURES PRIOR TO INSTALLATION OF THE CONSTRUCTION ACCESS POINT DETAILED ON SHEET 106.

AT LEAST TWO WEEKS PRIOR TO OPENING THE BRIDGE TO TRAFFIC THE CONTRACTOR SHALL NOTIFY THE ODOT DISTRICT 7 BRIDGE INSPECTION ENGINEER (937-497-6884) TO PERFORM THE POST-CONSTRUCTION INITIAL INSPECTION OF THE BRIDGE PER THE NOTE ON SHEET 11.

PHASE 6

COMPLETE ALL REMAINING WORK ITEMS.

PLACE FINAL SURFACE COURSE AND PAVEMENT MARKINGS UTILIZING STANDARD CONSTRUCTION DRAWINGS FOR LANE SHIFTS AND CLOSURES AS PER THE PLANS AND NOTES HEREIN.

THE NORTH AND SOUTH CROSSOVERS SHALL BE CLOSED WITH PB USING SCD MT-101.80 AT LOCATIONS SHOWN BELOW. PORTABLE BARRIER USED TO CLOSE THE CROSSOVERS SHALL BE CONCRETE AND INCLUDE ALL COST TO CONNECT TO THE EXISTING CONCRETE BARRIER. AT THE END OF THE PROJECT THE BARRIER SHALL BE LEFT IN PLACE AND WILL BECOME PROPERTY OF ODOT UPON CONTRACT COMPLETION.

PB LOCATIONS:
STA. 176+75 TO 180+40 = 365'
STA. 238+50 TO 242+20 = 370'

THE FOLLOWING QUANTITIES HAVE BEEN CARRIED TO THE GENERAL SUMMARY FOR THE ABOVE WORK.

ITEM 622 PORTABLE BARRIER, ANCHORED, AS PER PLAN-735'

THE FOLLOWING ESTIMATED QUANTITIES HAVE BEEN CARRIED TO THE GENERAL SUMMARY FOR PRIOR TO PLACING FINAL PAVEMENT MARKINGS:

- ITEM 614 WORK ZONE LANE LINE, CLASS III, 6", 642 PAINT-6.17 MI
- ITEM 614 WORK ZONE EDGE LINE, CLASS III, 6", 642 PAINT-6.23 MI
- ITEM 614 WORK ZONE CHANNELIZING LINE, CLASS III, 12", 642 PAINT-3500'
- ITEM 614 WORK ZONE DOTTED LINE, 6", CLASS III, 642 PAINT-3274'
- ITEM 614 WORK ZONE DOTTED LINE, 12", CLASS III, 642 PAINT-1288'

PN 121 - INCENTIVE/DISINCENTIVE CONTRACT

THE CONTRACTOR SHALL COMPLETE ALL CRITICAL WORK AND SAFETY ITEMS ACCORDING TO THE INCENTIVE/DISINCENTIVE CONTRACT TABLE. IN THE EVENT THE CONTRACTOR IMPEDES THE FLOW OF TRAFFIC SUBSEQUENT TO THE OPENING TO UNRESTRICTED TRAFFIC, THE CONTRACTOR SHALL BE ASSESSED A DISINCENTIVE ACCORDING TO THE INCENTIVE/DISINCENTIVE CONTRACT TABLE.

CRITICAL WORK IS SHOWN IN THE INCENTIVE/DISINCENTIVE CONTRACT TABLE.

CRITICAL WORK IS DEFINED AS HAVING THE DESIGNATED SECTION OF WORK OPEN TO UNRESTRICTED TRAFFIC AS SHOWN IN THE TABLE, OR THE ENTIRE PROJECT IF NOT OTHERWISE LISTED.

UNRESTRICTED TRAFFIC IS DEFINED AS ALL TRAFFIC LANES BEING AVAILABLE FOR USE IN THE MOT PHASE OR THEIR FINAL DESIGN WIDTH WITH ALL MARKINGS, RPM'S, AND SAFETY FEATURES INSTALLED, ALONG WITH NO RESTRICTIONS WITHIN 2 FEET OF THE EDGE LINE ON THE SHOULDERS.

DESCRIPTION OR LOCATION OF CRITICAL WORK	COMPLETION DATE	TIME UNIT	DISINCENTIVE \$ PER TIME UNIT
TRAFFIC IN PHASE 2 CONFIGURATION	10/15/2020	DAY	\$2,000
TRAFFIC IN PHASE 4 CONFIGURATION	10/15/2021	DAY	\$2,000
TRAFFIC IN FINAL CONFIGURATION	10/15/2022	DAY	\$10,000

STANDARD DRAWINGS AND SUPPLEMENTAL SPECIFICATIONS:

REFER TO THE FOLLOWING STANDARD BRIDGE DRAWING(S):

A-1-69	DATED (REVISED)	7-19-02
AS-1-15	DATED (REVISED)	7-17-15
AS-2-15	DATED (REVISED)	1-18-19
GSD-1-96	DATED (REVISED)	7-19-02
PCB-91	DATED (REVISED)	1-18-13
SBR-1-13	DATED (REVISED)	7-20-18
SBR-2-13	DATED (REVISED)	7-20-18
VPF-1-90	DATED (REVISED)	7-20-18

AND TO THE FOLLOWING SUPPLEMENTAL SPECIFICATION(S):

845	DATED	4-20-18
-----	-------	---------

DESIGN SPECIFICATIONS:

THIS SUPERSTRUCTURE CONFORMS TO THE "LRFD BRIDGE DESIGN SPECIFICATIONS" ADOPTED BY THE AMERICAN ASSOCIATION OF STATE HIGHWAY AND TRANSPORTATION OFFICIALS, 2014, INCLUDING THE 2015 & 2016 INTERIM SPECIFICATIONS AND THE ODOT BRIDGE DESIGN MANUAL, 2007.

DESIGN LOADING:

DESIGN LOADING (SUPERSTRUCTURE): HL93
FUTURE WEARING SURFACE (FWS) OF 60 LBS/SF

DESIGN DATA:

CONCRETE CLASS QC2 - COMPRESSIVE STRENGTH 4.5 KSI (SUPERSTRUCTURE)
CONCRETE CLASS QC3 - COMPRESSIVE STRENGTH 4.5 KSI (SUPERSTRUCTURE)
CONCRETE CLASS QC1 - COMPRESSIVE STRENGTH 4.0 KSI (SUBSTRUCTURE)
REINFORCING STEEL - ASTM A615 OR A996 GRADE 60 MINIMUM YIELD STRENGTH 60 KSI
STRUCTURAL STEEL - ASTM A709 GRADE 50

DECK PROTECTION METHOD:

EPOXY COATED REINFORCING STEEL WITH 2 1/2" CONCRETE COVER

MONOLITHIC WEARING SURFACE:

MONOLITHIC WEARING SURFACE IS ASSUMED, FOR DESIGN PURPOSES, TO BE 1 INCH THICK.

EXISTING BRIDGE PLANS:

MAY BE INSPECTED IN THE OFFICE OF STRUCTURAL ENGINEERING IN COLUMBUS, OHIO OR AT THE DISTRICT 7 OFFICE IN SIDNEY, OHIO. 1001 SAINT MARYS AVENUE, SIDNEY, OH 45365.

EXISTING STRUCTURE VERIFICATION:

DETAILS AND DIMENSIONS SHOWN ON THESE PLANS PERTAINING TO THE EXISTING STRUCTURE HAVE BEEN OBTAINED FROM PLANS OF THE EXISTING STRUCTURE AND FROM FIELD OBSERVATIONS AND MEASUREMENTS. CONSEQUENTLY, THEY ARE INDICATIVE OF THE EXISTING STRUCTURE AND THE PROPOSED WORK BUT THEY SHALL BE CONSIDERED TENTATIVE AND APPROXIMATE. THE CONTRACTOR IS REFERRED TO CMS SECTIONS 102.05, 105.02 AND 513.04.

BASE CONTRACT BID PRICES UPON A RECOGNITION OF THE UNCERTAINTIES DESCRIBED ABOVE AND UPON A PREBID EXAMINATION OF THE EXISTING STRUCTURE. HOWEVER, THE DEPARTMENT WILL PAY FOR ALL PROJECT WORK BASED UPON ACTUAL DETAILS AND DIMENSIONS THAT HAVE BEEN VERIFIED IN THE FIELD.

PROTECTION OF TRAFFIC:

REFER TO CMS 501.05 FOR THE REQUIREMENTS FOR THE PROTECTION OF TRAFFIC DURING CONSTRUCTION.

MAINTENANCE OF TRAFFIC:

I.R. 75 TRAFFIC SHALL BE MAINTAINED AT ALL TIMES. SEE ROADWAY PLANS FOR ADDITIONAL MAINTENANCE OF TRAFFIC NOTES AND DETAILS.

UTILITY LINES:

THE UTILITY(IES) SHALL BARE ALL EXPENSE INVOLVED IN RELOCATING (INSTALLING) THE AFFECTED UTILITY LINES. THE CONTRACTOR AND UTILITY(IES) ARE TO COOPERATE BY ARRANGING THEIR WORK IN SUCH A MANNER THAT INCONVENIENCE TO EITHER WILL BE HELD TO A MINIMUM.

STRUCTURE GROUNDING:

THE STRUCTURE SHALL BE GROUNDED PER ODOT STANDARD DRAWING HL-50.21.

DECK PLACEMENT DESIGN ASSUMPTIONS:

THE FOLLOWING ASSUMPTIONS OF CONSTRUCTION MEANS AND METHODS WERE MADE FOR THE ANALYSIS AND DESIGN OF THE SUPERSTRUCTURE. THE CONTRACTOR IS RESPONSIBLE FOR THE DESIGN OF THE FALSEWORK SUPPORT SYSTEM WITHIN THESE PARAMETERS AND WILL ASSUME RESPONSIBILITY FOR SUPERSTRUCTURE ANALYSIS FOR DEVIATION FROM THESE DESIGN ASSUMPTIONS.

AN EIGHT WHEEL FINISHING MACHINE WITH A MAXIMUM WHEEL LOAD OF 2.4 KIPS FOR A TOTAL MACHINE LOAD OF 19.2 KIPS.

A MINIMUM OUT-TO-OUT WHEEL SPACING AT EACH END OF THE MACHINE OF 103".

A MAXIMUM SPACING OF OVERHANG FALSEWORK BRACKETS OF 48".

A MAXIMUM DISTANCE FROM THE CENTERLINE OF THE BEAM TO THE FACE OF THE SAFETY HANDRAIL OF 65".

ITEM 202 - PORTIONS OF STRUCTURE REMOVED, OVER 20 FOOT SPAN, AS PER PLAN:

DESCRIPTION: THIS WORK CONSISTS OF THE REMOVAL OF CONCRETE DECKS INCLUDING PARAPETS, RAILINGS, DECK JOINTS AND OTHER APPURTENANCES FROM STEEL SUPPORTING SYSTEMS (BEAMS, GIRDERS, CROSS FRAMES, ETC.). ALSO INCLUDED ARE ALL MATERIALS, LABOR, AND INCIDENTALS REQUIRED TO REMOVE AND REINSTALL CROSS FRAMES AS INDICATED IN THE PLANS. DRILLING OF DRAINAGE HOLES IN THE DECK IS INCLUDED. THE PROVISIONS OF ITEM 202 APPLY EXCEPT AS SPECIFIED BY THE FOLLOWING NOTES. PERFORM WORK CAREFULLY DURING DECK REMOVALS TO PROTECT PORTIONS OF SUCH SYSTEMS THAT ARE TO BE SALVAGED AND INCORPORATED INTO THE PROPOSED STRUCTURE. THE USE OF EXPLOSIVES, HEADACHE BALLS AND/OR HOE RAM TYPE OF EQUIPMENT IS PROHIBITED. SUBMIT CONSTRUCTION PLANS ACCORDING TO CMS 501.05.

PROTECTION OF STEEL SUPPORT SYSTEMS: BEFORE DECK SLAB CUTTING IS PERMITTED, DRAW THE OUTLINE OF PRIMARY STEEL MEMBERS IN CONTACT WITH THE BOTTOM OF THE DECK ON THE SURFACE OF DECK. DRILL SMALL DIAMETER PILOT HOLES 2 INCHES OUTSIDE THESE LINES TO CONFIRM THE LOCATION OF FLANGE EDGES. DECK CUTS OVER OR WITHIN 2 INCHES OF FLANGE EDGES SHALL NOT EXTEND LOWER THAN THE BOTTOM LAYER OF DECK SLAB REINFORCING STEEL. CUTS MADE OUTSIDE 2 INCHES OF FLANGE EDGES MAY EXTEND THE FULL DEPTH OF THE DECK. PERFORM WORK CAREFULLY DURING CUTTING OF THE DECK SLAB TO AVOID DAMAGING STEEL MEMBERS THAT ARE TO BE INCORPORATED INTO THE PROPOSED STRUCTURE. REPLACE OR REPAIR STEEL MEMBERS DAMAGED BY THE DECK SLAB CUTTING OPERATIONS AT NO COST TO THE PROJECT. AT LEAST 7 DAYS BEFORE PERFORMING REPAIR WORK, SUBMIT A PROPOSED REPAIR PLAN, DEVELOPED BY AN OHIO REGISTERED PROFESSIONAL ENGINEER TO THE DIRECTOR. OBTAIN THE DIRECTOR'S APPROVAL BEFORE PERFORMING REPAIR.

REMOVAL METHODS: THE CONTRACTOR MAY REMOVE CONCRETE BY CUTTING AND BY MEANS OF HAND OPERATED PNEUMATIC HAMMERS EMPLOYING POINTED OR BLUNTED CHISEL TYPE TOOLS. FOR REMOVALS OVER STRUCTURAL MEMBERS (PRESTRESSED BOX BEAM, I-BEAM, STEEL BEAM STEEL GIRDER, ETC), THE CONTRACTOR MAY USE A HAMMER HEAVIER THAN 35 POUNDS BUT NOT TO EXCEED 90 POUNDS UNLESS APPROVED BY THE ENGINEER. REMOVAL METHODS OVER STRUCTURAL MEMBERS SHALL ENSURE ADEQUATE DEPTH CONTROL AND PREVENT NICKING OR GOUGING THE PRIMARY STRUCTURAL MEMBERS.

DUE TO THE POSSIBLE PRESENCE OF ATTACHMENTS (E.G., FINISHING MACHINE, SCUPPER AND FORM SUPPORTS, ETC.) TO EXISTING STRUCTURAL MEMBERS, PERFORM WORK CAREFULLY DURING DECK REMOVAL TO AVOID DAMAGING STRUCTURAL MEMBERS THAT ARE TO REMAIN. REPLACE OR REPAIR STRUCTURAL MEMBERS DAMAGED BY THE REMOVAL OPERATIONS AT NO COST TO THE PROJECT. AT LEAST 7 DAYS BEFORE PERFORMING REPAIR WORK, SUBMIT A PROPOSED REPAIR PLAN, DEVELOPED BY AN OHIO REGISTERED PROFESSIONAL ENGINEER TO THE DIRECTOR. OBTAIN THE DIRECTOR'S APPROVAL BEFORE PERFORMING REPAIR.

EXISTING WELDED ATTACHMENTS: REMOVE EXISTING WELDED ATTACHMENTS (E.G., FINISHING MACHINE AND FORM SUPPORTS; AND SUPPORTS FOR SCUPPERS AND BULB ANGLES WHICH ARE TO BE REMOVED) LOCATED IN THE DESIGNATED TENSION PORTIONS OF THE TOP FLANGES OF EXISTING STEEL MEMBERS AND GRIND THE FLANGE SURFACES SMOOTH. CAREFULLY GRIND PARALLEL TO THE FLANGES.

MEASUREMENT & PAYMENT: THE DEPARTMENT WILL MEASURE THE QUANTITY OF REMOVALS ON A LUMP SUM BASIS. THE DEPARTMENT WILL PAY FOR THE ACCEPTED QUANTITIES OF REMOVALS AT THE CONTRACT PRICE FOR ITEM 202, PORTIONS OF STRUCTURE REMOVED, OVER 20 FT SPAN, AS PER PLAN.

THE DESIGN SHOWN IN THE PLANS FOR TEMPORARY SUPPORT OF BRIDGE DECK OVERHANGS DURING PHASE CONSTRUCTION IS ONE REPRESENTATIVE DESIGN THAT MAY BE USED TO CONSTRUCT THE PROJECT. THE CONTRACTOR MAY CONSTRUCT THE DESIGN SHOWN ON THE PLANS OR PREPARE AN ALTERNATE DESIGN TO SUPPORT THE OVERHANG. IF CONSTRUCTING AN ALTERNATE DESIGN FOR TEMPORARY SUPPORT OF THE OVERHANG, PREPARE AND PROVIDE PLANS IN ACCORDANCE WITH C&MS 501.05. THE DEPARTMENT WILL PAY FOR THE TEMPORARY SUPPORT OF OVERHANGS AT THE CONTRACT LUMP SUM PRICE FOR ITEM 202. THE DEPARTMENT WILL NOT MAKE ADDITIONAL PAYMENT FOR PROVIDING AN ALTERNATE DESIGN.

ITEM 503 - UNCLASSIFIED EXCAVATION:

PLACE AND COMPACT BACKFILL MATERIAL IN 6 INCH LIFTS FOR THE CONSTRUCTION OF THE BACKFILL BEHIND THE ABUTMENTS AND UNDER THE APPROACH SLABS.

ITEM 509 - REINFORCING STEEL, REPLACEMENT OF EXISTING REINFORCING STEEL:

REPLACE ALL EXISTING REINFORCING BARS DEEMED BY THE ENGINEER TO BE UNUSABLE BECAUSE OF CORROSION. THE DEPARTMENT WILL MEASURE THE REPLACEMENT REINFORCING STEEL BY THE NUMBER OF POUNDS ACCEPTED IN PLACE.

REPLACE ALL EXISTING REINFORCING STEEL BARS WHICH ARE TO BE INCORPORATED INTO THE NEW WORK AND ARE DEEMED BY THE ENGINEER TO BE MADE UNUSABLE BY CONCRETE REMOVAL OPERATIONS WITH NEW EPOXY COATED REINFORCING STEEL OF THE SAME SIZE AT NO COST TO THE DEPARTMENT.

ITEM 510 - DOWEL HOLES WITH NONSHRINK, NONMETALLIC GROUT:

DRILL DOWEL HOLES WHERE SHOWN IN THE PLANS. INSTALL REINFORCING STEEL ACCORDING TO ITEM 510 USING EPOXY GROUT, 705.20. PRIOR TO DRILLING DOWEL HOLES, LOCATE ALL EXISTING REINFORCING STEEL BARS IN THE AREA OF THE HOLE WITH THE AID OF A REINFORCING STEEL BAR LOCATOR (PACHOMETER). IF AN EXISTING BAR IS ENCOUNTERED AT THE SAME LOCATION AS A PROPOSED DOWEL HOLE, MOVE THE DOWEL HOLE TO EITHER SIDE OF THE EXISTING BAR.

ITEM 513 - STRUCTURAL STEEL MEMBERS, LEVEL UF, AS PER PLAN:

ALL REQUIREMENTS OF 513 APPLY TO SHOP FABRICATED MEMBERS. PERFORM WORK FOR FIELD FABRICATED MEMBERS ACCORDING TO ITEM 513, EXCEPT AS MODIFIED HEREIN. THE DEPARTMENT WILL NOT REQUIRE THE CONTRACTOR PERFORMING FIELD FABRICATION TO BE PRE-QUALIFIED AS SPECIFIED IN SUPPLEMENT 1078. SUBMIT A WRITTEN LETTER OF MATERIAL ACCEPTANCE IN ACCORDANCE WITH 501.06, TO THE ENGINEER. PROVIDE THE ENGINEER "AS-BUILT" DRAWINGS ACCORDING TO 513.06, EXCEPT 501.04 DOES NOT APPLY. UPON RECEIPT OF THE ENGINEER'S ACCEPTANCE, SUPPLY A COPY OF THE DRAWINGS, ACCORDING TO SUPPLEMENT 1002, TO THE OFFICE OF MATERIAL MANAGEMENT FOR RECORD PURPOSES.

THE FOLLOWING MEMBERS ARE INCLUDED IN THIS ITEM: END CROSS FRAMES AND ASSEMBLIES.

ITEM 513 - STRUCTURAL STEEL MEMBERS, MODULAR EXPANSION JOINT, LEVEL UF, AS PER PLAN:

ABUTMENT JOINTS SHALL BE WATSON BOWMAN ACME (WABO) MODULAR STM-900 OR APPROVED ALTERNATE. THE MANUFACTURER SHALL SUBMIT DESIGN CALCULATIONS SHOWING THAT THE DEVICE CAN MEET THE IMPACT AND FATIGUE DESIGN REQUIREMENTS SET FORTH BY AASHTO LRFD BRIDGE DESIGN SPECIFICATIONS, 7TH EDITION, SECTION 14.5.

A. DESCRIPTION:

FURNISH ALL MATERIALS, SERVICES, LABOR, TOOLS, EQUIPMENT AND INCIDENTALS NECESSARY TO DESIGN, FABRICATE, INSPECT, TEST AND INSTALL MODULAR EXPANSION JOINTS IN ACCORDANCE WITH THE PLANS AND THESE NOTES. ALL REQUIREMENTS OF 513, UF LEVEL FABRICATION APPLY, UNLESS MODIFIED BY THESE NOTES.

B. DESIGN:

1. PREPARE AND CHECK THE DESIGN UNDER THE AUTHORITY OF AN OHIO REGISTERED PROFESSIONAL ENGINEER. THE REGISTERED ENGINEER SHALL SEAL, SIGN AND DATE THE DESIGN CALCULATIONS AND SHOP DRAWINGS.

2. INCLUDE DESIGN CALCULATIONS WITH THE CONTRACTOR'S SUBMISSION OF SHOP DRAWINGS PER 513.06.

3. PROVIDE A DETAILED INSTALLATION PROCEDURE AND INCLUDE ANY SPECIFIC MANUFACTURER'S NOTES NECESSARY FOR COMPLETION OF THE WORK.

4. DESIGN AND TEST THE MODULAR JOINT COMPONENTS, JOINT ARMOR AND ANCHORAGES ACCORDING TO THE AASHTO LRFD BRIDGE DESIGN SPECIFICATIONS AND THE NATIONAL COOPERATIVE HIGHWAY RESEARCH PROGRAM (NCHRP) REPORT 402 "FATIGUE DESIGN OF MODULAR BRIDGE EXPANSION JOINTS" APPENDICES A AND B.

P:\91606\structures\MOT075_1044C\sheets\075_1044CGN001.dgn 6/22/2020 9:54:02 AM gwnittaker




1801 Walmark Drive, Suite 310 - Columbus, Ohio 43215
www.elrobinsonengineering.com

DATE	7/2017
REVIEWED	DFT
DRAWN	TAS
DESIGNED	TAS
CHECKED	CJW
STRUCTURE FILE NUMBER	5707056


GENERAL NOTES (1 OF 3)
BRIDGE NO. MOT-75-1044
OVER THE GREAT MIAMI RIVER AND CARILLON BOULEVARD

MOT-75-(10.44)(10.78)
PID No. 91606

P:\91606\structures\MOT075_1044C\sheets\075_1044CPC001.dgn 6/22/2020 9:54:03 AM gwnittaker

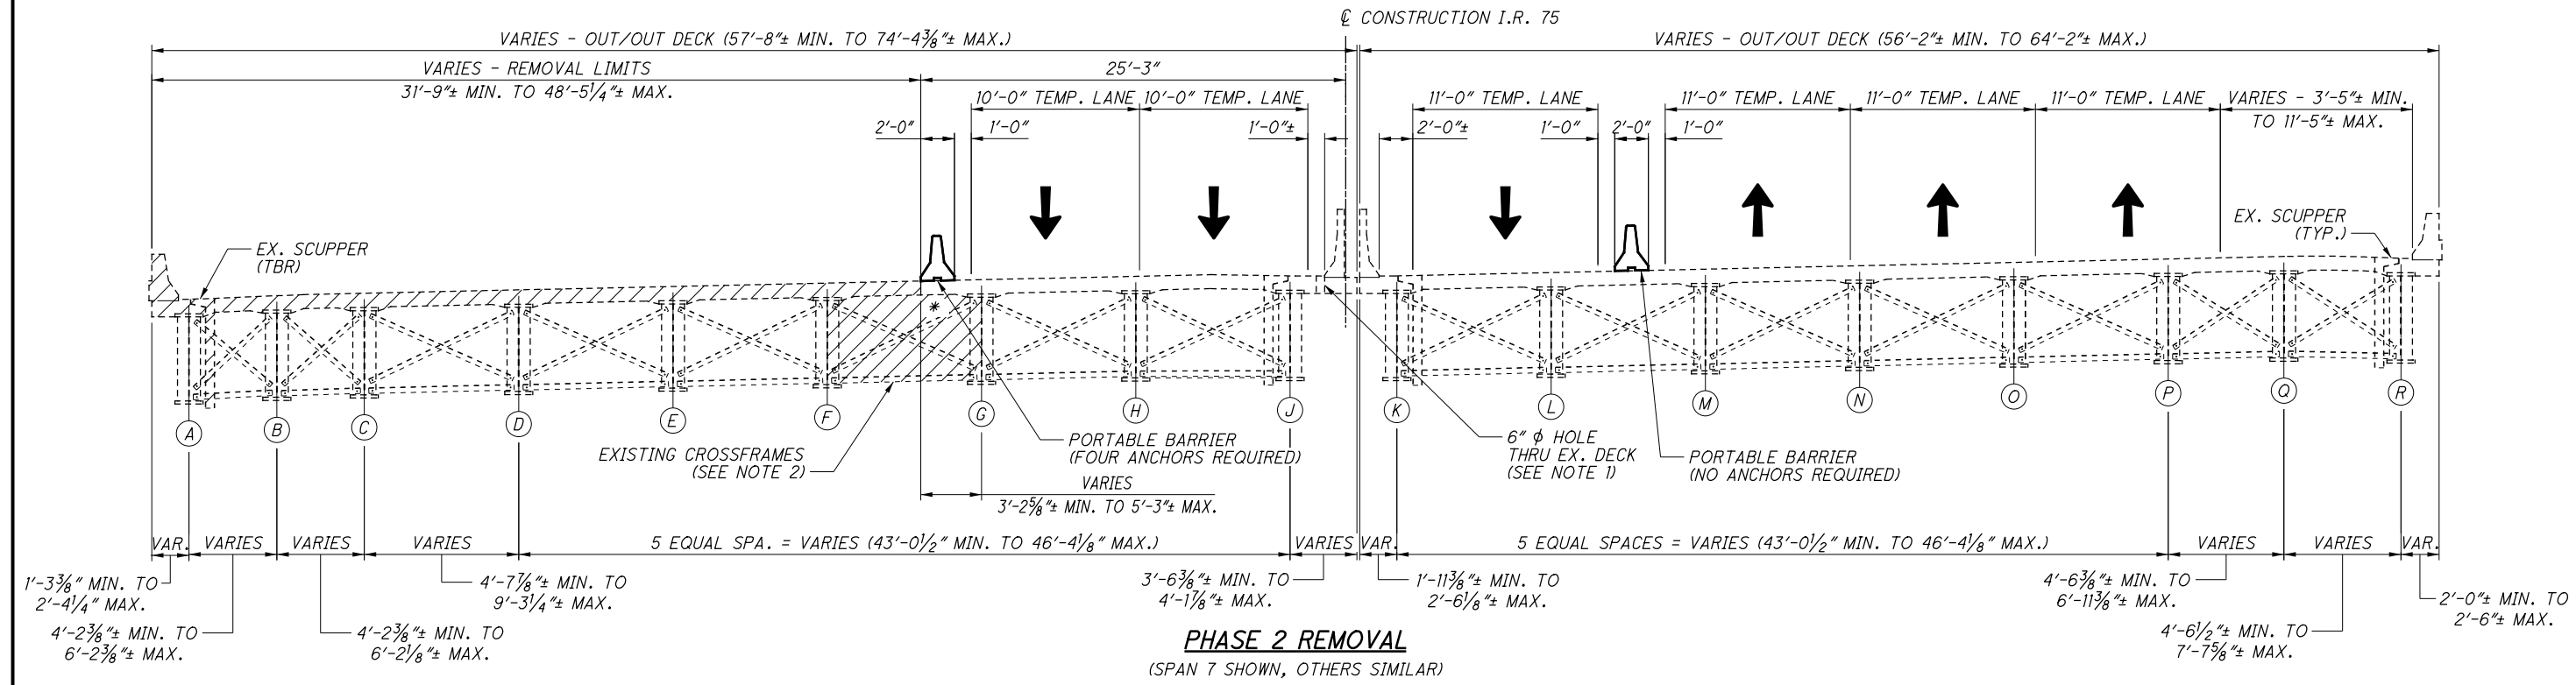

PHASE 2 REMOVAL
(SPAN 7 SHOWN, OTHERS SIMILAR)

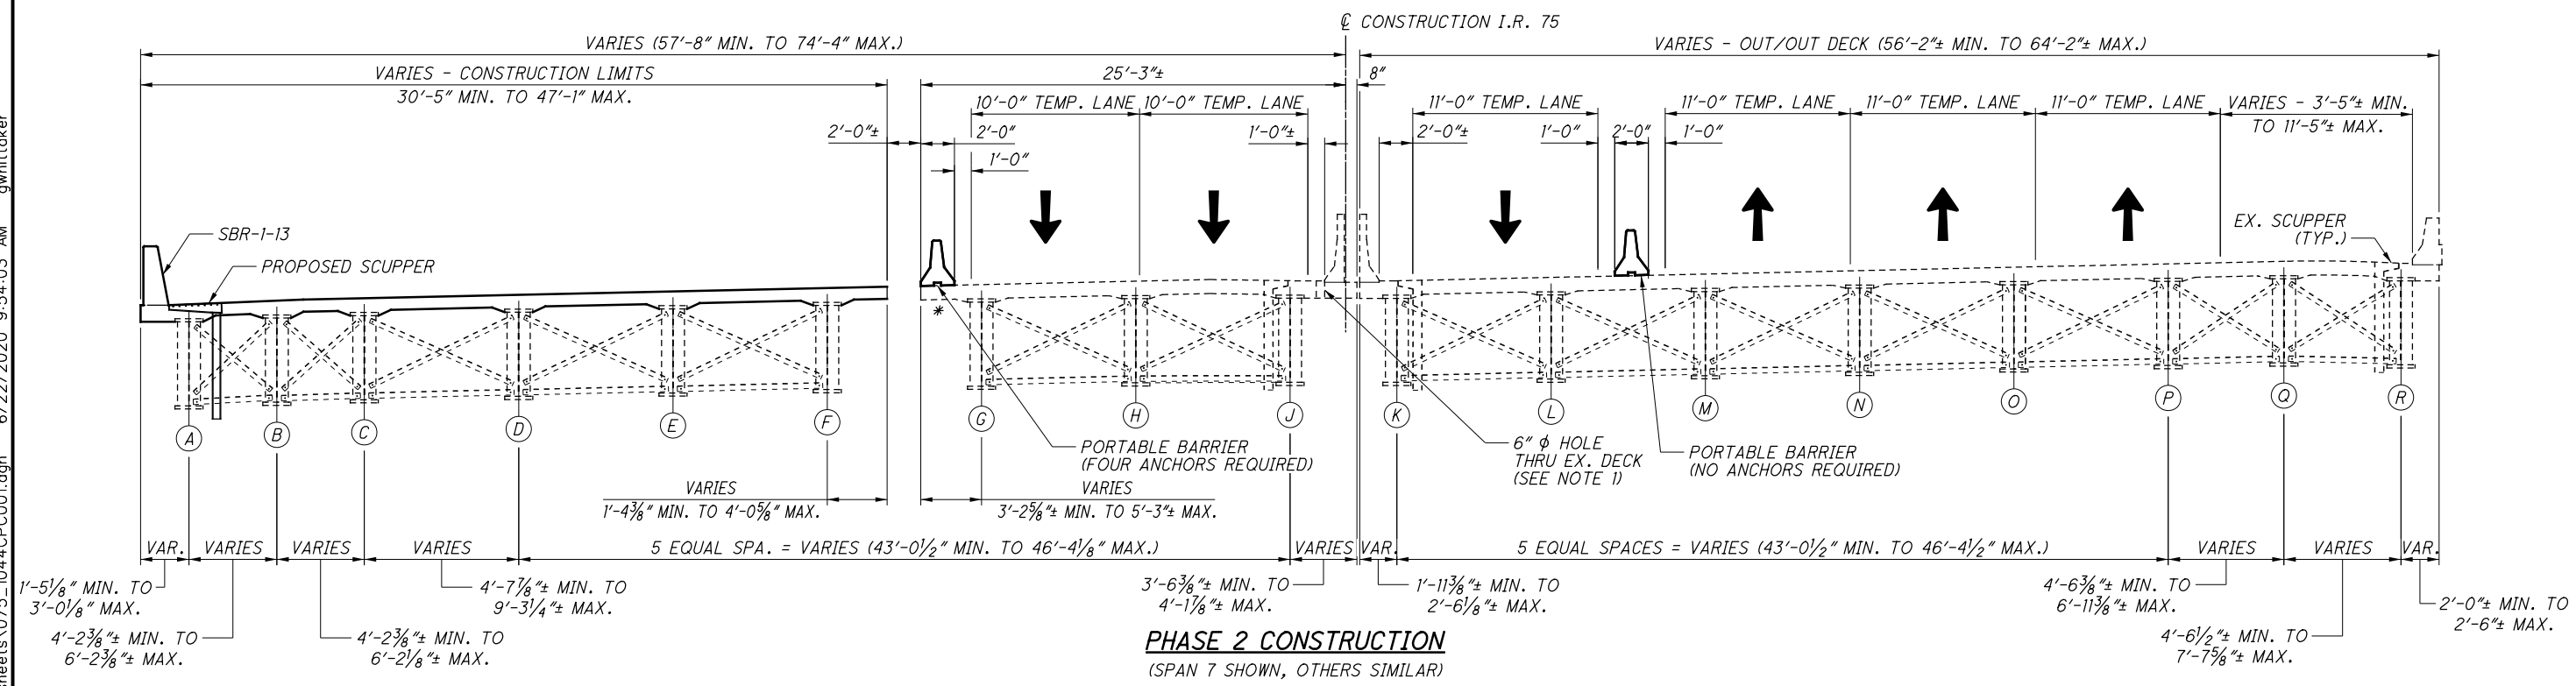

PHASE 2 CONSTRUCTION
(SPAN 7 SHOWN, OTHERS SIMILAR)

PHASE 2 REMOVAL

1. INSTALL PORTABLE BARRIERS AS SHOWN.
2. REMOVE EXISTING WEARING COURSE, CONCRETE DECK, SCUPPERS, APPROACH SLABS, AND PORTIONS OF EXISTING GIRDERS TO THE LIMITS SHOWN IN THE PLANS.
3. INSTALL TEMPORARY EXCAVATION BRACING.
4. REMOVE PORTIONS OF ABUTMENT TO THE LIMITS SHOWN IN THE PLANS.

PHASE 2 CONSTRUCTION

1. CONSTRUCT MODIFIED ABUTMENTS TO THE LIMITS SHOWN IN THE PLANS AND REMOVE TEMPORARY EXCAVATION BRACING.
2. INSTALL NEW BEARINGS, STEEL BEAMS, AND PERFORM STEEL REHABILITATION.
3. CONSTRUCT NEW CONCRETE DECK, PARAPETS, VANDAL PROTECTION FENCE, AND APPROACH SLAB TO THE LIMITS SHOWN IN THE PLANS.
4. SEAL CONCRETE SURFACES.

LEGEND:

- INDICATES AREAS TO BE REMOVED AS PER ITEM 202 - STRUCTURE REMOVED, OVER 20 FOOT SPAN, AS PER PLAN.
- GIRDER DESIGNATION
- DUE TO EXCESSIVE OVERHANG, THE CONTRACTOR SHALL SUPPORT THE EXISTING DECK DURING PHASE 2 WHERE THE OVERHANG EXCEEDS 3'-9". SUPPORTS SHALL BE INSTALLED PRIOR TO ADJACENT DECK REMOVAL. SEE [134/91] FOR DETAILS.

NOTES:

1. SEE [23/91] FOR HOLE LOCATIONS. ALL HOLES THROUGH THE EXISTING DECK SHALL BE DRILLED DURING PHASE 1. THE CONTRACTOR SHALL ADHERE TO ODOT STANDARD DRAWING MT-95.30 REQUIREMENTS FOR LANE CLOSURE.
2. EXISTING CROSSFRAMES TO BE REMOVED AND STORED DURING PHASE REMOVAL. EXISTING CROSSFRAMES ARE TO BE USED AND REINSTALLED DURING PHASE CONSTRUCTION. PAINT DAMAGED DURING REMOVAL AND REINSTALLATION SHALL BE REPAIRED. CROSSFRAMES REMOVED AND PAINT REPAIR SHALL BE PAID UNDER ITEM 202 - PORTIONS OF STRUCTURE REMOVED, OVER 20 FOOT SPAN, AS PER PLAN.
3. FOR EXISTING SCUPPERS TO BE REMOVED, WELDS SHALL BE GROUND FLUSH AT THE WEB AND PAINT SHALL BE REPAIRED. PAYMENT INCLUDED WITH ITEM 202 - PORTIONS OF STRUCTURE REMOVED, OVER 20 FOOT SPAN, AS PER PLAN.

E.L. ROBINSON ENGINEERING
1801 Walmark Drive, Suite 310 - Columbus, Ohio 43215
www.elrobinsonengineering.com

DATE	7/2017
REVIEWED	DFT
DRAWN	FIB
CHECKED	CJW
DESIGNED	TJE
STRUCTURE FILE NUMBER	5707056


PHASE CONSTRUCTION SEQUENCE (1 OF 4)
BRIDGE NO. MOT-75-1044
OVER THE GREAT MIAMI RIVER AND CARILLON BOULEVARD

MOT-75-(10.44)(10.78)
PID No. 91606


10/91

202
348

P:\91606\structures\MOT075_1044\structures\075_1044\PC003.dgn 6/22/2020 9:54:04 AM gwhittaker

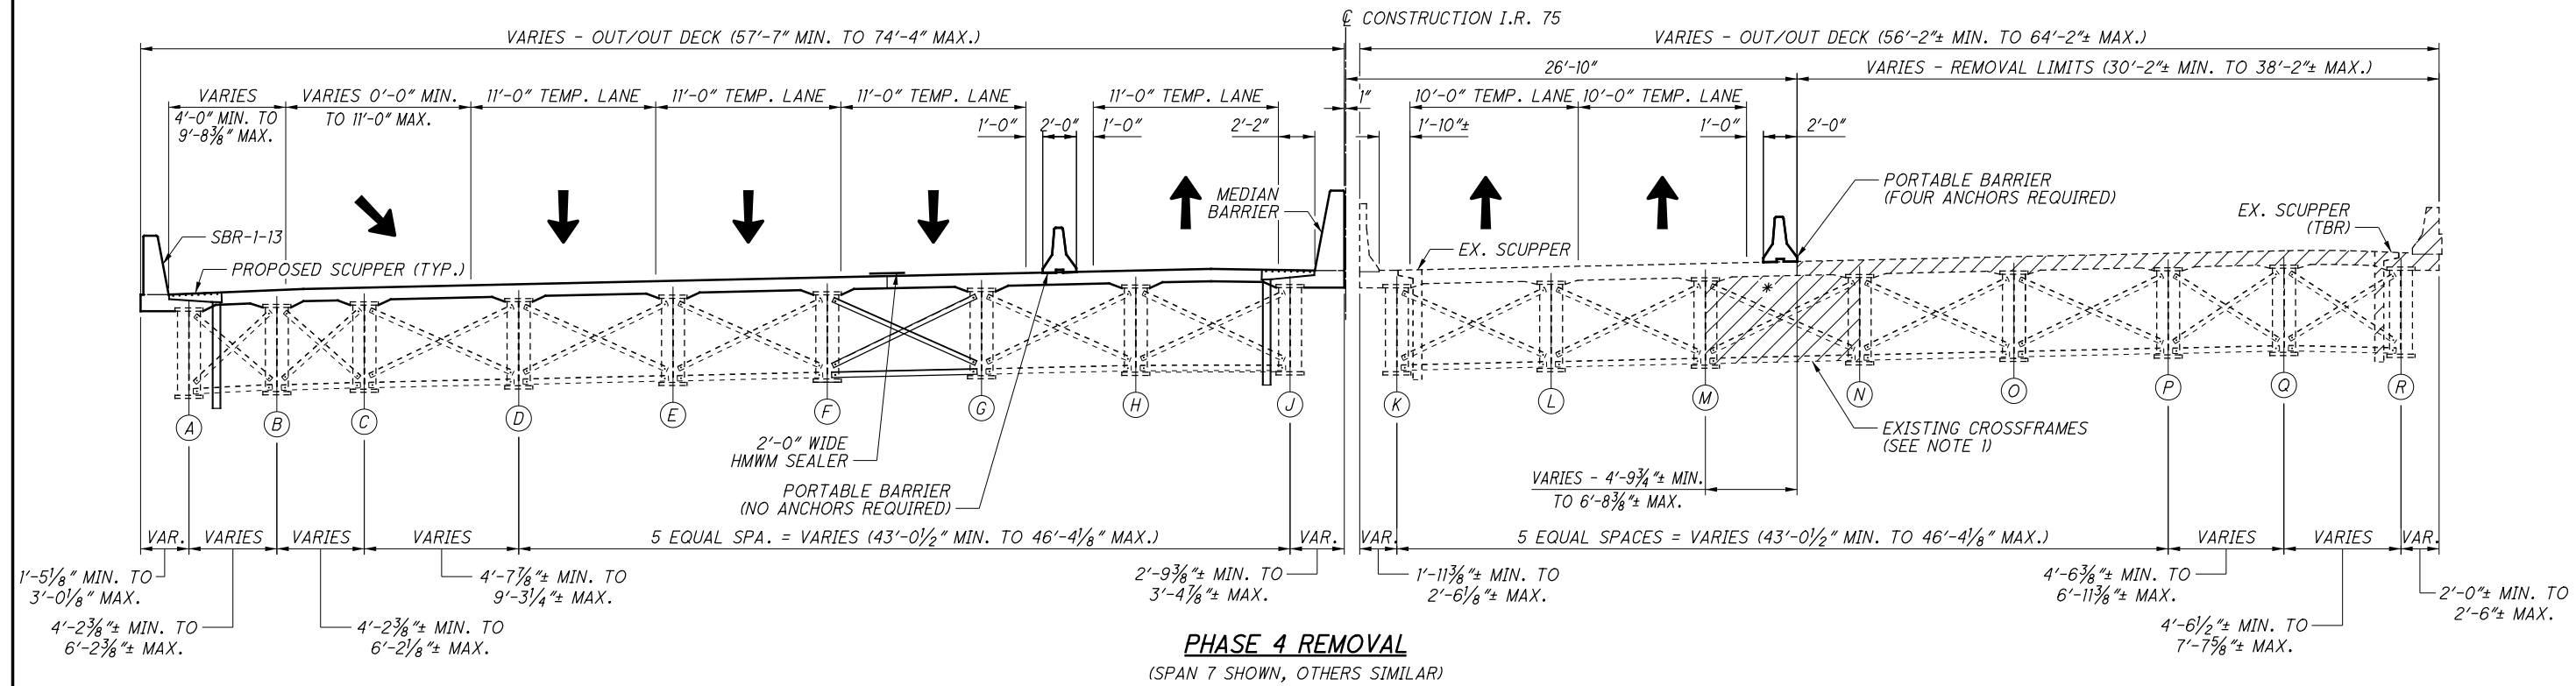

PHASE 4 REMOVAL
(SPAN 7 SHOWN, OTHERS SIMILAR)

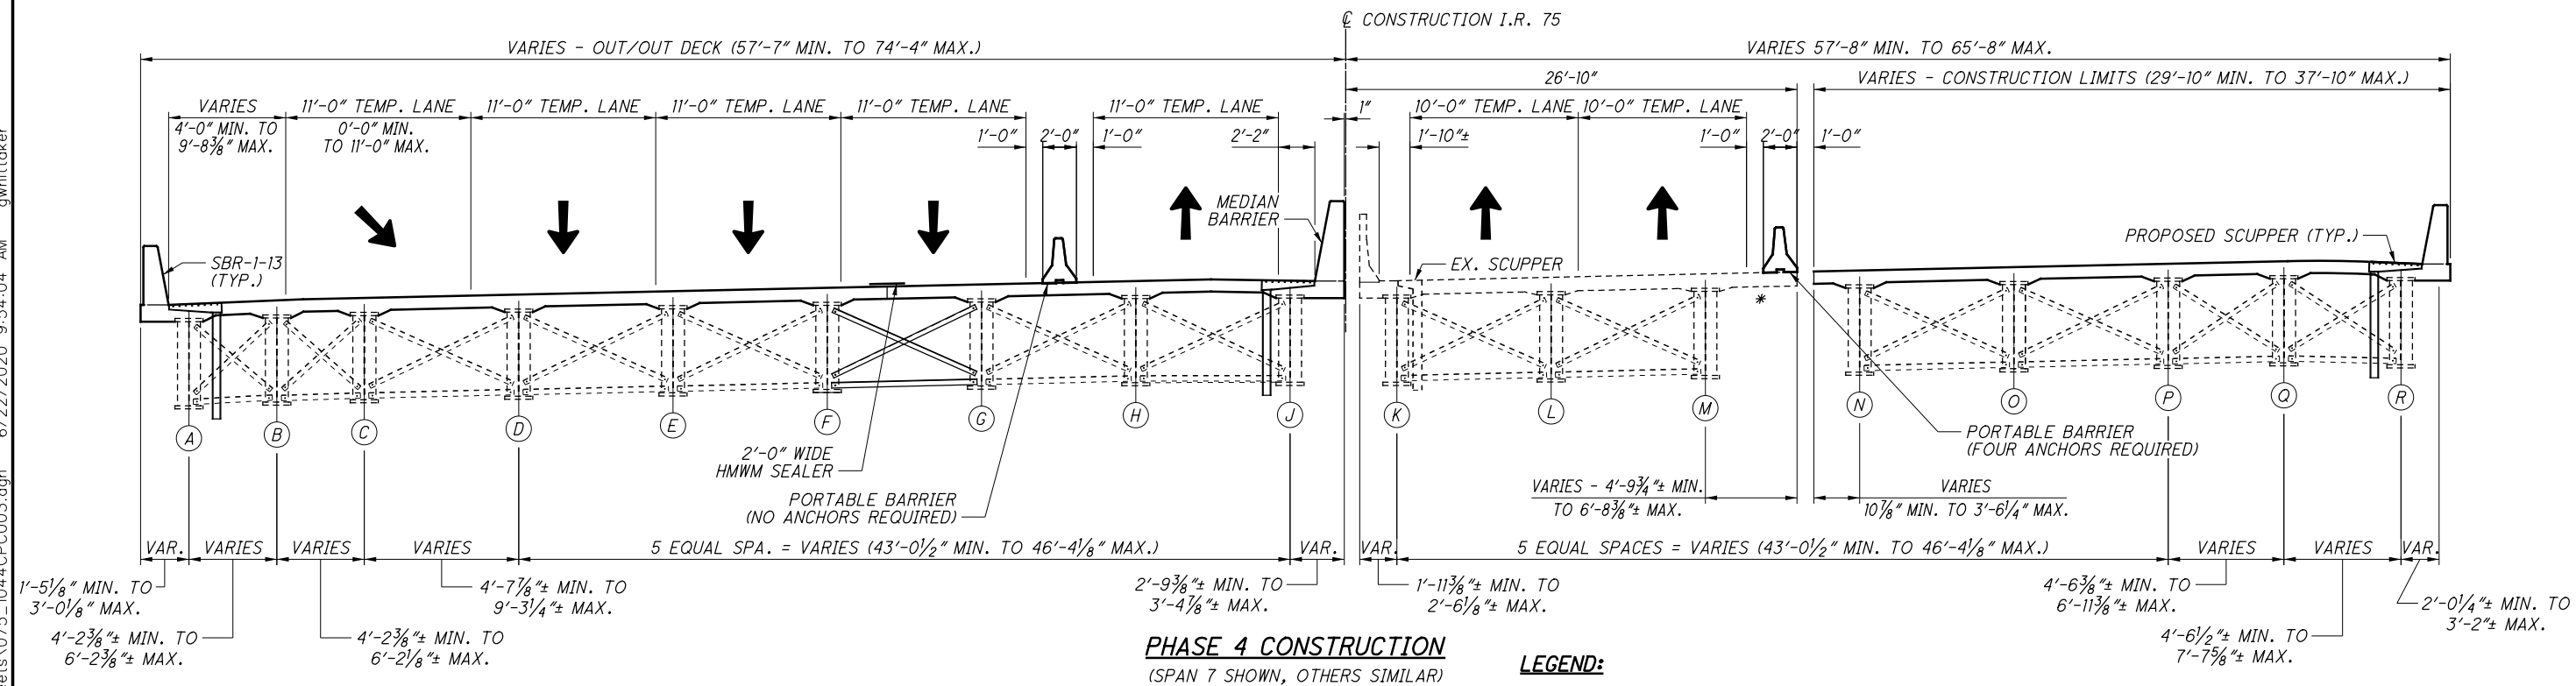

PHASE 4 CONSTRUCTION
(SPAN 7 SHOWN, OTHERS SIMILAR)



LEGEND:
 - INDICATES AREAS TO BE REMOVED AS PER ITEM 202 - STRUCTURE REMOVED, OVER 20 FOOT SPAN, AS PER PLAN.
 # - GIRDER DESIGNATION
 * - DUE TO EXCESSIVE OVERHANG, THE CONTRACTOR SHALL SUPPORT THE EXISTING DECK DURING PHASE 4. SUPPORTS SHALL BE INSTALLED PRIOR TO ADJACENT DECK REMOVAL. SEE 134/91 FOR DETAILS.

- PHASE 4 REMOVAL**
1. INSTALL PORTABLE BARRIERS AS SHOWN.
 2. REMOVE EXISTING WEARING COURSE, CONCRETE DECK, SCUPPERS, APPROACH SLABS, AND PORTIONS OF EXISTING GIRDERS TO THE LIMITS SHOWN IN THE PLANS.
 3. INSTALL TEMPORARY EXCAVATION BRACING.
 4. REMOVE PORTIONS OF ABUTMENT TO THE LIMITS SHOWN IN THE PLANS.

- PHASE 4 CONSTRUCTION**
1. CONSTRUCT MODIFIED ABUTMENTS TO THE LIMITS SHOWN IN THE PLANS AND REMOVE TEMPORARY EXCAVATION BRACING.
 2. INSTALL NEW BEARINGS, STEEL BEAM, AND CROSSFRAMES, AND PERFORM STEEL REHABILITATION.
 3. CONSTRUCT NEW CONCRETE DECK, PARAPETS, VANDAL PROTECTION FENCE, AND APPROACH SLAB TO THE LIMITS SHOWN IN THE PLANS.
 4. SEAL CONCRETE SURFACES.

- NOTES:**
1. EXISTING CROSSFRAMES TO BE REMOVED AND STORED DURING PHASE REMOVAL. EXISTING CROSSFRAMES ARE TO BE USED AND REINSTALLED DURING PHASE CONSTRUCTION. PAINT DAMAGED DURING REMOVAL AND REINSTALLATION SHALL BE REPAIRED. CROSSFRAMES REMOVAL AND PAINT REPAIR SHALL BE PAID UNDER ITEM 202 - PORTIONS OF STRUCTURE REMOVED, OVER 20 FOOT SPAN, AS PER PLAN.
 2. FOR EXISTING SCUPPERS TO BE REMOVED, WELDS SHALL BE GROUND FLUSH AT THE WEB AND PAINT SHALL BE REPAIRED. PAYMENT INCLUDED WITH ITEM 202 - PORTIONS OF STRUCTURE REMOVED, OVER 20 FOOT SPAN, AS PER PLAN.

P:\91606\structures\MOT075_1044C\sheets\075_1044CSD0032.dgn 6/22/2020 9:54:08 AM gwhittaker

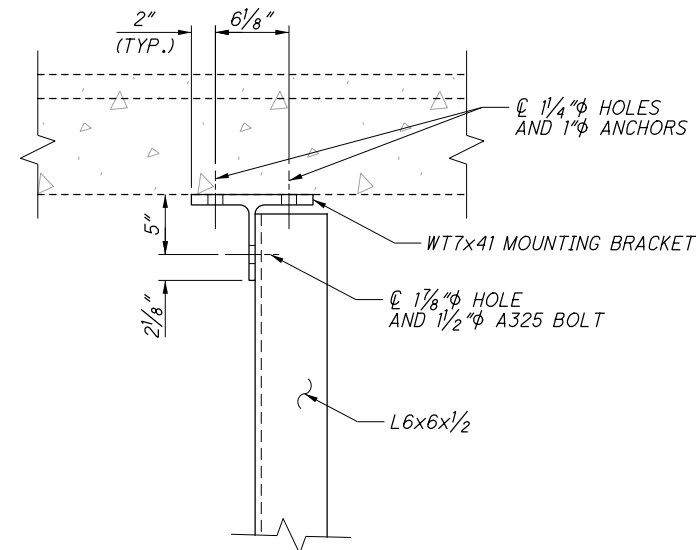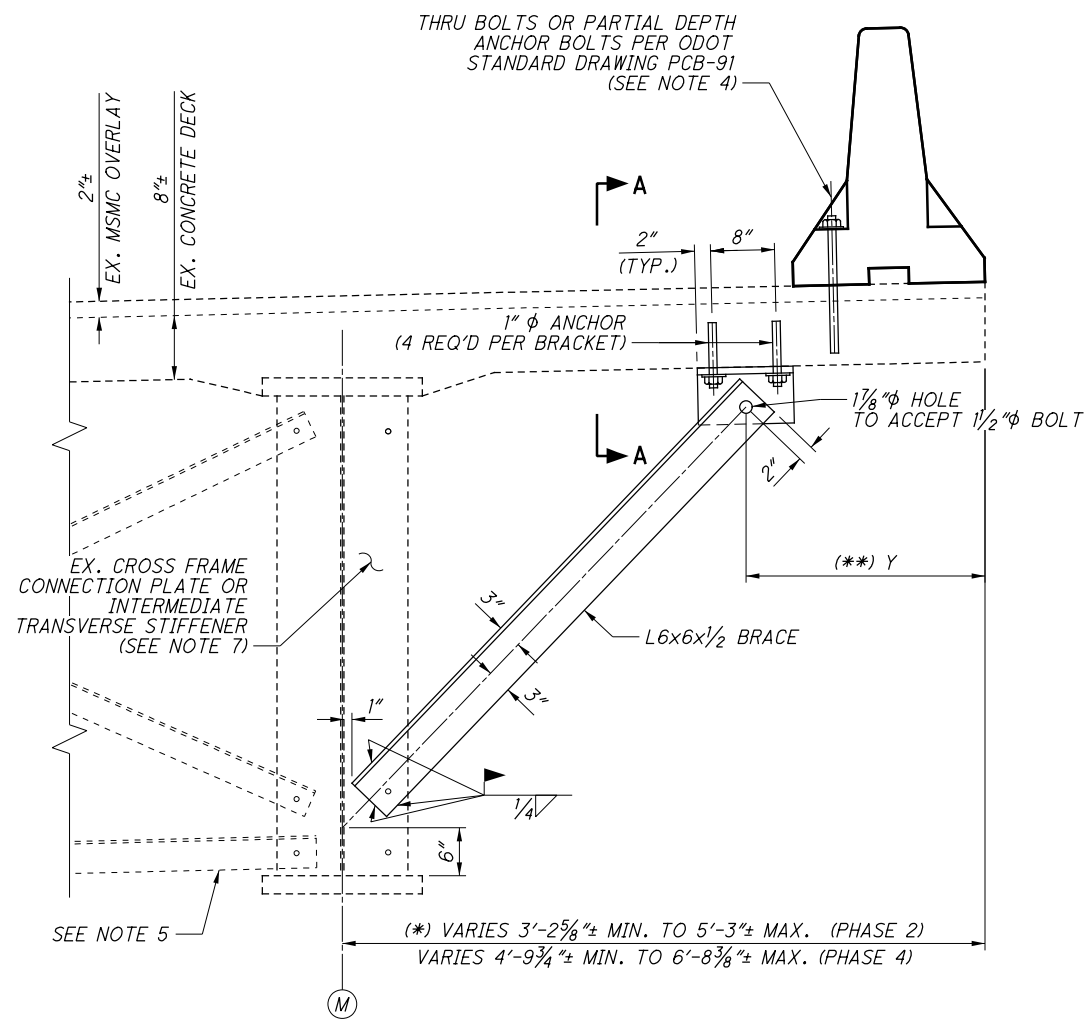

SECTION A-A

TEMPORARY OVERHANG SUPPORT
(PHASE 4 SHOWN, PHASE 2 OPPOSITE HAND)

- (*) TEMPORARY SUPPORT REQUIRED AT 15'-0" MAX. SPACING WHERE OVERHANG EXCEEDS 3'-9". TEMPORARY SUPPORT REQUIRED AT 7'-6" MAX. SPACING WHERE OVERHANG EXCEEDS 5'-6".
- (**) FOR OVERHANGS BETWEEN 3'-9" AND 4'-7", Y = OVERHANG - 25"
FOR OVERHANGS > 4'-7", Y = 30"

APPROXIMATE STATION LIMITS FOR TEMPORARY OVERHANG SUPPORT			
PHASE	STATION RANGE	OVERHANG	MAX. SUPPORT SPACING
2	201+15 THRU 208+33	VARIES 5'-3"± TO 3'-9"±	15'-0"
4	201+45 THRU 208+12	VARIES 6'-8 3/4"± TO 5'-6"±	7'-6"
4	208+12 THRU 210+75	VARIES 5'-6"± TO 4'-9 3/4"±	15'-0"

NOTES:

1. MOUNTING BRACKETS AND BRACES SHALL BE ASTM A709 GRADE 50 OR 50W.
2. BOLTS SHALL BE ASTM F3125, GRADE A325, WITH THREADS EXCLUDED FROM THE SHEAR PLANE.
3. THE ANCHOR BOLTS SHALL BE 1" φ HILTI KWIK BOLT 3 CARBON STEEL WITH 4" EFFECTIVE EMBEDMENT, OR APPROVED EQUAL THAT MEET THE FOLLOWING DESIGN CRITERIA:
EFFECTIVE EMBEDMENT = 4"
DESIGN SHEAR CAPACITY = 11.6 KIPS/ANCHOR
DESIGN TENSILE CAPACITY = 2.2 KIPS/ANCHOR
4. PRIOR TO INSTALLING PCB ANCHORS, THE CONTRACTOR SHALL MARK THE LOCATION OF THE OVERHANG BRACKET ANCHORS ON THE TOP SURFACE OF THE BRIDGE DECK. PCB ANCHORS SHALL BE SPACED AS NECESSARY TO PROVIDE A MINIMUM CLEARANCE OF 5 INCHES FROM THE OVERHANG BRACKET ANCHORS.
5. AT TEMPORARY OVERHANG SUPPORTS WHERE CROSS FRAMES ARE NOT LOCATED IN EITHER OF THE ADJACENT TWO BAYS, LATERAL BRACING SUFFICIENT TO RESIST A FACTORED COMPRESSIVE LOAD OF 24 KIPS SHALL BE INSTALLED TO PROVIDE A LINE OF CONTINUOUS SUPPORT AT THE BOTTOM FLANGES OF THE THREE GIRDERS.
6. THE CONTRACTOR MAY, AT HIS DISCRETION, CHOOSE AN ALTERNATE OVERHANG SUPPORT SYSTEM. TEMPORARY SUPPORT DETAILS SHALL BE INCLUDED WITH THE ENGINEERING DRAWING SUBMITTAL REQUIRED PER CM&S 501.05.
7. WHERE THE DECK OVERHANG EXCEEDS 3'-9", TEMPORARY DECK OVERHANG BRACING SHALL BE INSTALLED AT THE EXISTING INTERMEDIATE AND BEND POINT CROSS FRAMES. WHERE THE CROSS FRAME SPACING EXCEEDS THE MAXIMUM TEMPORARY OVERHANG BRACING SPACING, TEMPORARY OVERHANG BRACING SHALL BE INSTALLED AT INTERMEDIATE TRANSVERSE STIFFENERS BETWEEN CROSS FRAMES AS NECESSARY TO MEET THE MAXIMUM ALLOWABLE SPACING. AT EXPANSION ROLLERS, CONTRACTOR SHALL MODIFY THESE DETAILS AS NECESSARY. THE COST OF THIS TEMPORARY BRACING SHALL INCLUDE INSTALLATION OF TEMPORARY BRACING AND REMOVAL, INCLUDING GRINDING FLUSH ALL REQUIRED WELDS AND REPAIRING DAMAGED PAINT. COST TO BE INCLUDED IN ITEM 202, PORTIONS OF STRUCTURES REMOVED, OVER 20 FOOT SPAN, AS PER PLAN.

E.L. ROBINSON ENGINEERING
1801 Walmark Drive, Suite 310 - Columbus, Ohio 43215
www.elrobinsonengineering.com

DESIGNED	DFT	CHECKED	GMW
DRAWN	GMW	REVISED	
REVIEWED	TAS	DATE	6/2020
STRUCTURE FILE NUMBER	5707056		

TEMPORARY OVERHANG BRACKET
BRIDGE NO. MOT-75-1044
OVER THE GREAT MIAMI RIVER AND CARILLON BOULEVARD

MOT-75-(10.44)(10.78)
PID No. 91606

13A/91

205A
348