

## **LOCATION MAP**

LATITUDE: 39°32'52" LONGITUDE: 81°47'20"

PORTION TO BE IMPROVED	.j
INTERSTATE HIGHWAY	
FEDERAL ROUTES	
STATE ROUTES	
COUNTY & TOWNSHIP ROADS	
OTHER ROADS	

## **DESIGN DESIGNATION**

	MRG-266	WAS-339
CURRENT ADT (2025)	1200	6600
DESIGN YEAR ADT (2045)	1400	6700
DESIGN HOURLY VOLUME (2045)		800
DIRECTIONAL DISTRIBUTION	53.1%	56.3%
TRUCKS (24 HOUR B&C)	5%	7%
DESIGN SPEED	·	
LEGAL SPEED	35 MPH	35 MPH
DESIGN FUNCTIONAL CLASSIFICATION:	COLLECTOR	RURAL MINOR ARTERIAL
NHS PROJECT	<b>NO</b>	NO

## **DESIGN EXCEPTIONS**

NONE REQUIRED

#### ADA DESIGN WAIVERS

NONE REQUIRED



PLAN PREPARED BY: OHIO DEPARTMENT OF TRANSPORTATION DISTRICT 10 - CAPITAL PROGRAMS MARIETTA, OHIO

# STATE OF OHIO **DEPARTMENT OF TRANSPORTATION**

MRG/WAS-266/339-4.13/20.12

**WINDSOR TOWNSHIP MORGAN COUNTY** WATERFORD TOWNSHIP WASHINGTON COUNTY


## **INDEX OF SHEETS:**

TITLE SHEET	
GENERAL NOTES	.,2 & 3
GENERAL SUMMARY	4
LIGHTING SUBSUMMARY	
MRG-266-4.13, LIGHTING PLAN SHEET	6
WAS-339-20.12, LIGHTING PLAN SHEET	
LIGHTING DETAILS	8

## EARTH DISTURBED AREAS

PROJECT EARTH DISTURBED AREA:	N/A	ACRES
ESTIMATED CONTRACTOR EARTH DISTURBED AREA;	N/A	ACRES
NOTICE OF INTENT EARTH DISTURBED AREA:	N/A	ACRES
(MAINTENÀ	NCE PR	OJECT)

	STANDARD CONSTRUCTION DRAWINGS				SUPPLEMENTAL SPECIFICATIONS			
	HL-10.11	7/15/22				800-2023	01/19/2024	
	HL-10.12	1/20/23	MT-95.50	7/21/17		813	10/19/18	
	HL-10.13	1/20/23	MT-97.10	4/19/19		832	7/15/22	
ENGINEER'S SEAL	HL-20.11	10/21/22	MT-105.10	1/17/20				
11(0)(1011(0)01(1	HL-30.11	1/15/21						
	HL-30.21	4/17/20						
SERVE OF OR	HL-30.22	1/15/21						
JOHN JOHN	HL-40.10 HL-60.11	7/17/20 7/21/17				1	SPECIAL PROVISIONS	
*( COÉN )*	HL-60.12	7/16/21						
E-56542	HL-60.31	1/17/20						
SOMAL ENGINE								

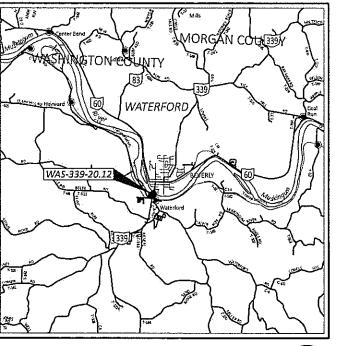

## **LOCATION MAP**

LATITUDE: 39°32'39" LONGITUDE: 81°38'28"



## FEDERAL PROJECT NUMBER

E240(445)

## RAILROAD INVOLVEMENT

## PROJECT DESCRIPTION

UPGRADE BRIDGE LIGHTING AT MRG-266-4.13 AND WAS-339-20.12.

## **2023 SPECIFICATIONS**

THE STANDARD SPECIFICATIONS OF THE STATE OF OHIO, DEPARTMENT OF TRANSPORTATION, INCLUDING SUPPLEMENTAL SPECIFICATIONS LISTED IN THE PLANS AND CHANGES LISTED IN THE PROPOSAL SHALL GOVERN THIS IMPROVEMENT.

I HEREBY APPROVE THESE PLANS AND DECLARE THAT THE MAKING OF THIS IMPROVEMENT WILL NOT REQUIRE THE CLOSING TO TRAFFIC OF THE HIGH-WAY AND THAT PROVISIONS FOR THE MAINTENANCE AND SAFETY OF TRAFFIC WILL BE AS SET FORTH ON THE PLANS AND ESTIMATES.

> lack Marchbanks, PhD Director, Department of Transportation



116857