
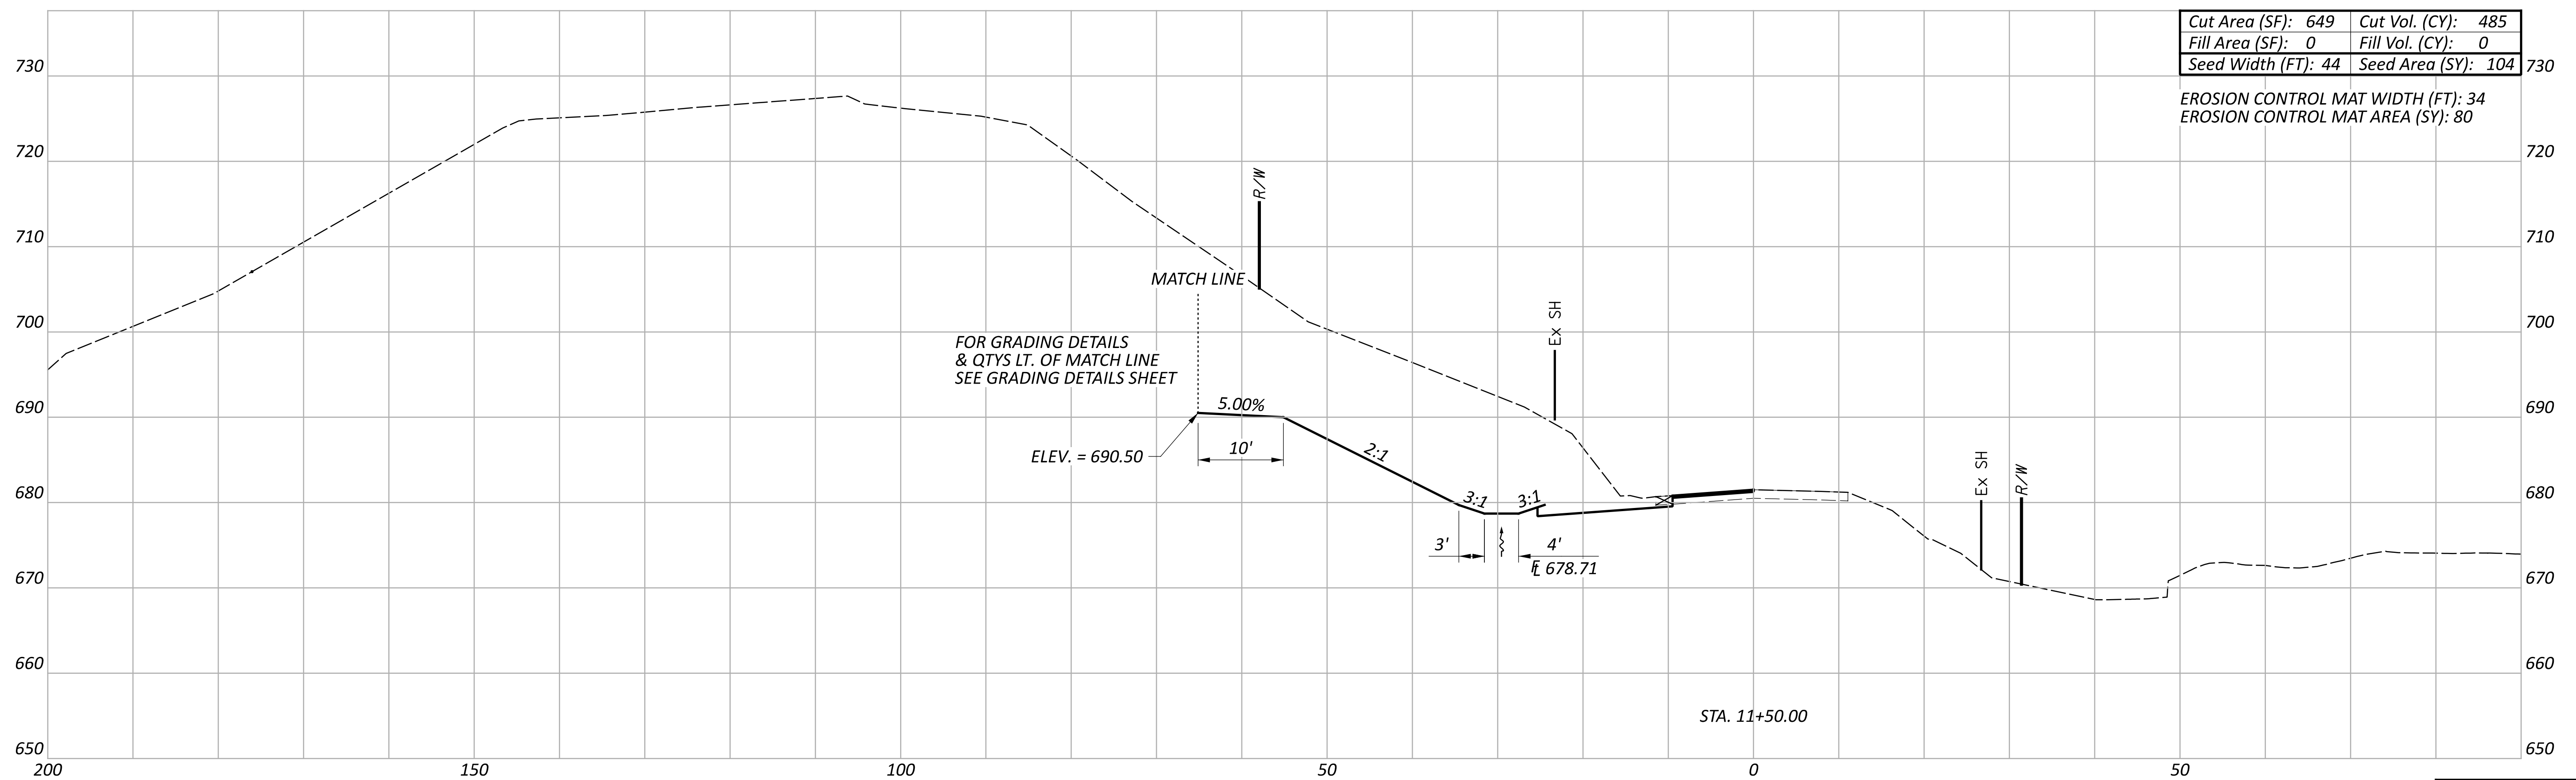
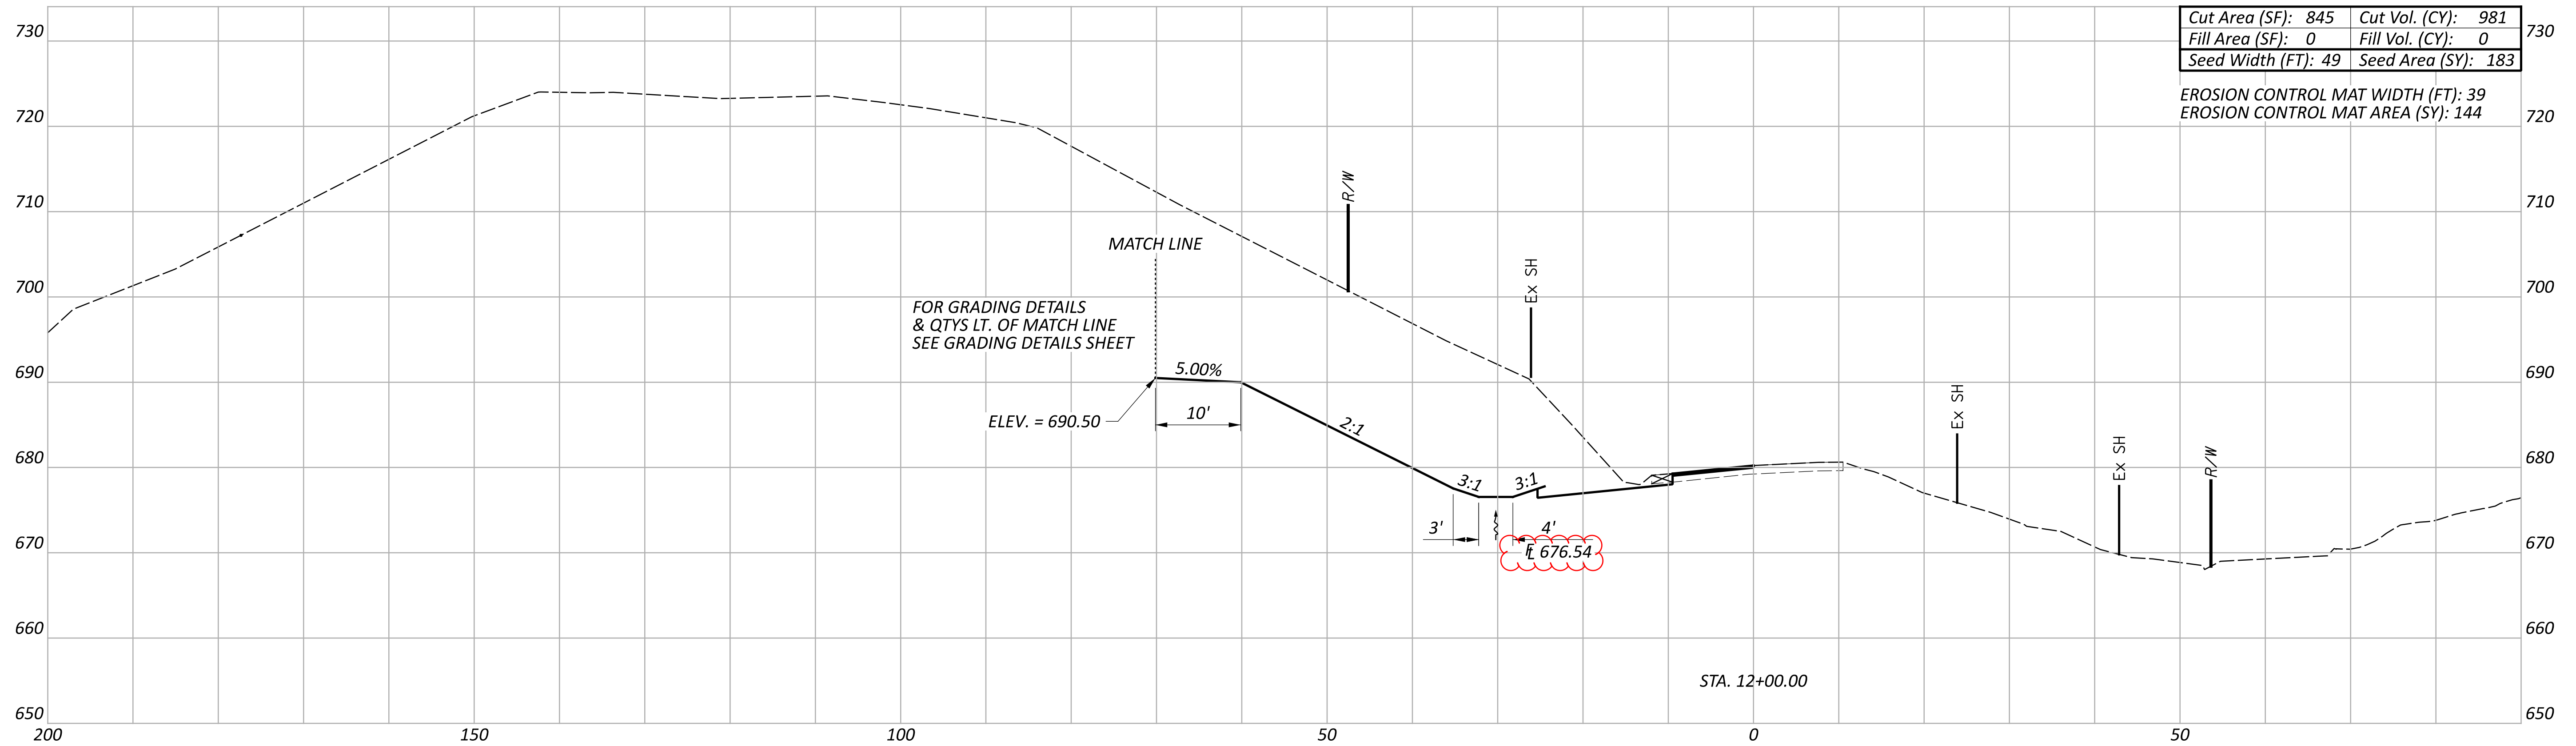


SHEET NUM.					PART.	ITEM	ITEM	GRAND	UNIT	DESCRIPTION	SEE SHEET NO.
5	6	12	15	26	01/NFA/06		EXT	TOTAL			
ROADWAY											
LS					LS	201	11000	LS		CLEARING AND GRUBBING	
			118		118	202	23000	118	SY	PAVEMENT REMOVED	
			25		25	202	38000	25	FT	GUARDRAIL REMOVED	
			1		1	SPECIAL	20266000	1	EACH	DRILLED WATER WELL ABANDONED	5
				38	38	SPECIAL	20270000	38	FT	FILL AND PLUG EXISTING CONDUIT - 12"	5
15,017					15,017	203	10000	15,017	CY	EXCAVATION	
31					31	203	20000	31	CY	EMBANKMENT	
			698		698	204	10000	698	SY	SUBGRADE COMPACTION	
			25		25	606	13030	25	FT	GUARDRAIL, TYPE 5, USING 9 FOOT POSTS	
6					6	623	40520	6	EACH	RIGHT-OF-WAY MONUMENT, TYPE B	
LS					LS	623	50000	LS		PRECONSTRUCTION SURVEY MONUMENT VERIFICATION AND REPORT	
LS					LS	623	51000	LS		POST CONSTRUCTION SURVEY MONUMENT VERIFICATION AND REPORT	
	LS				LS	SPECIAL	69098400	LS		ROADWAY PRESERVATION	6
EROSION CONTROL											
				1	1	601	32200	1	CY	ROCK CHANNEL PROTECTION, TYPE C WITH FILTER	
4,002					4,002	659	00540	4,002	SY	SEEDING AND MULCHING, CLASS 3C	
0.54					0.54	659	20000	0.54	TON	COMMERCIAL FERTILIZER	
0.83					0.83	659	31000	0.83	ACRE	LIME	
22					22	659	35000	22	MGAL	WATER	
3,347					3,347	671	15060	3,347	SY	EROSION CONTROL MAT, TYPE G	
					15,000	832	30000	15,000	EACH	EROSION CONTROL	
DRAINAGE											
				0.5	0.5	602	20000	0.5	CY	CONCRETE MASONRY	
				70	70	611	05700	70	FT	15" CONDUIT, TYPE A-706.02	
PAVEMENT											
			428		428	254	01000	428	SY	PAVEMENT PLANING, ASPHALT CONCRETE (3" THICKNESS)	
			101		101	301	56000	101	CY	ASPHALT CONCRETE BASE, PG64-22, (449)	
		20	105		125	304	20000	125	CY	AGGREGATE BASE	
		24	137		161	407	20000	161	GAL	NON-TRACKING TACK COAT	
			2		2	408	10001	2	GAL	PRIME COAT, AS PER PLAN	5
					36	441	70100	36	CY	ASPHALT CONCRETE SURFACE COURSE, TYPE 1, (449), PG70-22M	
					50	441	70300	50	CY	ASPHALT CONCRETE INTERMEDIATE COURSE, TYPE 2, (449)	
					1	617	10101	1	CY	COMPACTED AGGREGATE, AS PER PLAN	5
					237	SPECIAL	69012050	237	SY	REINFORCED MESH FOR TRANSVERSE AND/OR LONGITUDINAL JOINTS AND CRACKS	6
TRAFFIC CONTROL											
					30	621	00100	30	EACH	RPM	
					18	621	54000	18	EACH	RAISED PAVEMENT MARKER REMOVED	
					16.5	630	03101	16.5	FT	GROUND MOUNTED SUPPORT, NO. 3 POST, AS PER PLAN	6
					20.5	630	80100	20.5	SF	SIGN, FLAT SHEET	
					5	630	84900	5	EACH	REMOVAL OF GROUND MOUNTED SIGN AND DISPOSAL	
					1	630	85100	1	EACH	REMOVAL OF GROUND MOUNTED SIGN AND REERECTION	
					2	630	86002	2	EACH	REMOVAL OF GROUND MOUNTED POST SUPPORT AND DISPOSAL	
					0.16	642	00104	0.16	MILE	EDGE LINE, 6", TYPE 1	
					0.08	642	00300	0.08	MILE	CENTER LINE, TYPE 1	
					610	644	00700	610	FT	TRANSVERSE/DIAGONAL LINE	
BUILDING DEMOLITION											
LS					LS	202	56000	LS		BUILDING DEMOLISHED, PARCEL 10, 1-STORY FRAMED HOUSE WITH BASEMENT	
LS					LS	202	56000	LS		BUILDING DEMOLISHED, PARCEL 10, SHED	
	LS				LS	SPECIAL	69071000	LS		ASBESTOS ABATEMENT (WORK INVOLVING ASBESTOS CONTAINING MATERIAL)	6
MAINTENANCE OF TRAFFIC											
					LS	614	12420	LS		DETOUR SIGNING	
20					20	614	13000	20	CY	ASPHALT CONCRETE FOR MAINTAINING TRAFFIC	
		4			4	614	18601	4	SNMT	PORTABLE CHANGEABLE MESSAGE SIGN, AS PER PLAN	12
			0.08		0.08	614	21550	0.08	MILE	WORK ZONE CENTER LINE, CLASS III, 642 PAINT	
			0.16		0.16	614	22360	0.16	MILE	WORK ZONE EDGE LINE, CLASS III, 6", 642 PAINT	
		20			20	616	10000	20	MGAL	WATER	
INCIDENTALS											
		LS			LS	614	11000	LS		MAINTAINING TRAFFIC	
	LS				LS	623	10001	LS		CONSTRUCTION LAYOUT STAKES AND SURVEYING, AS PER PLAN	6
					LS	624	10000	LS		MOBILIZATION	

GENERAL SUMMARY

DESIGN AGENCY

 DESIGNER GPM
 REVIEWER CMY
 PROJECT ID 115989
 SHEET TOTAL
 P.14 37



CROSS SECTIONS - S.R. 376
 STA. 11+50 - STA. 12+00

DESIGN AGENCY



DESIGNER



GPM

REVIEWER

PROJECT ID

115989

Sheet Totals			115989
Seeding	Cut	Fill	SHEET TOTAL
287	1466	0	P.19 37

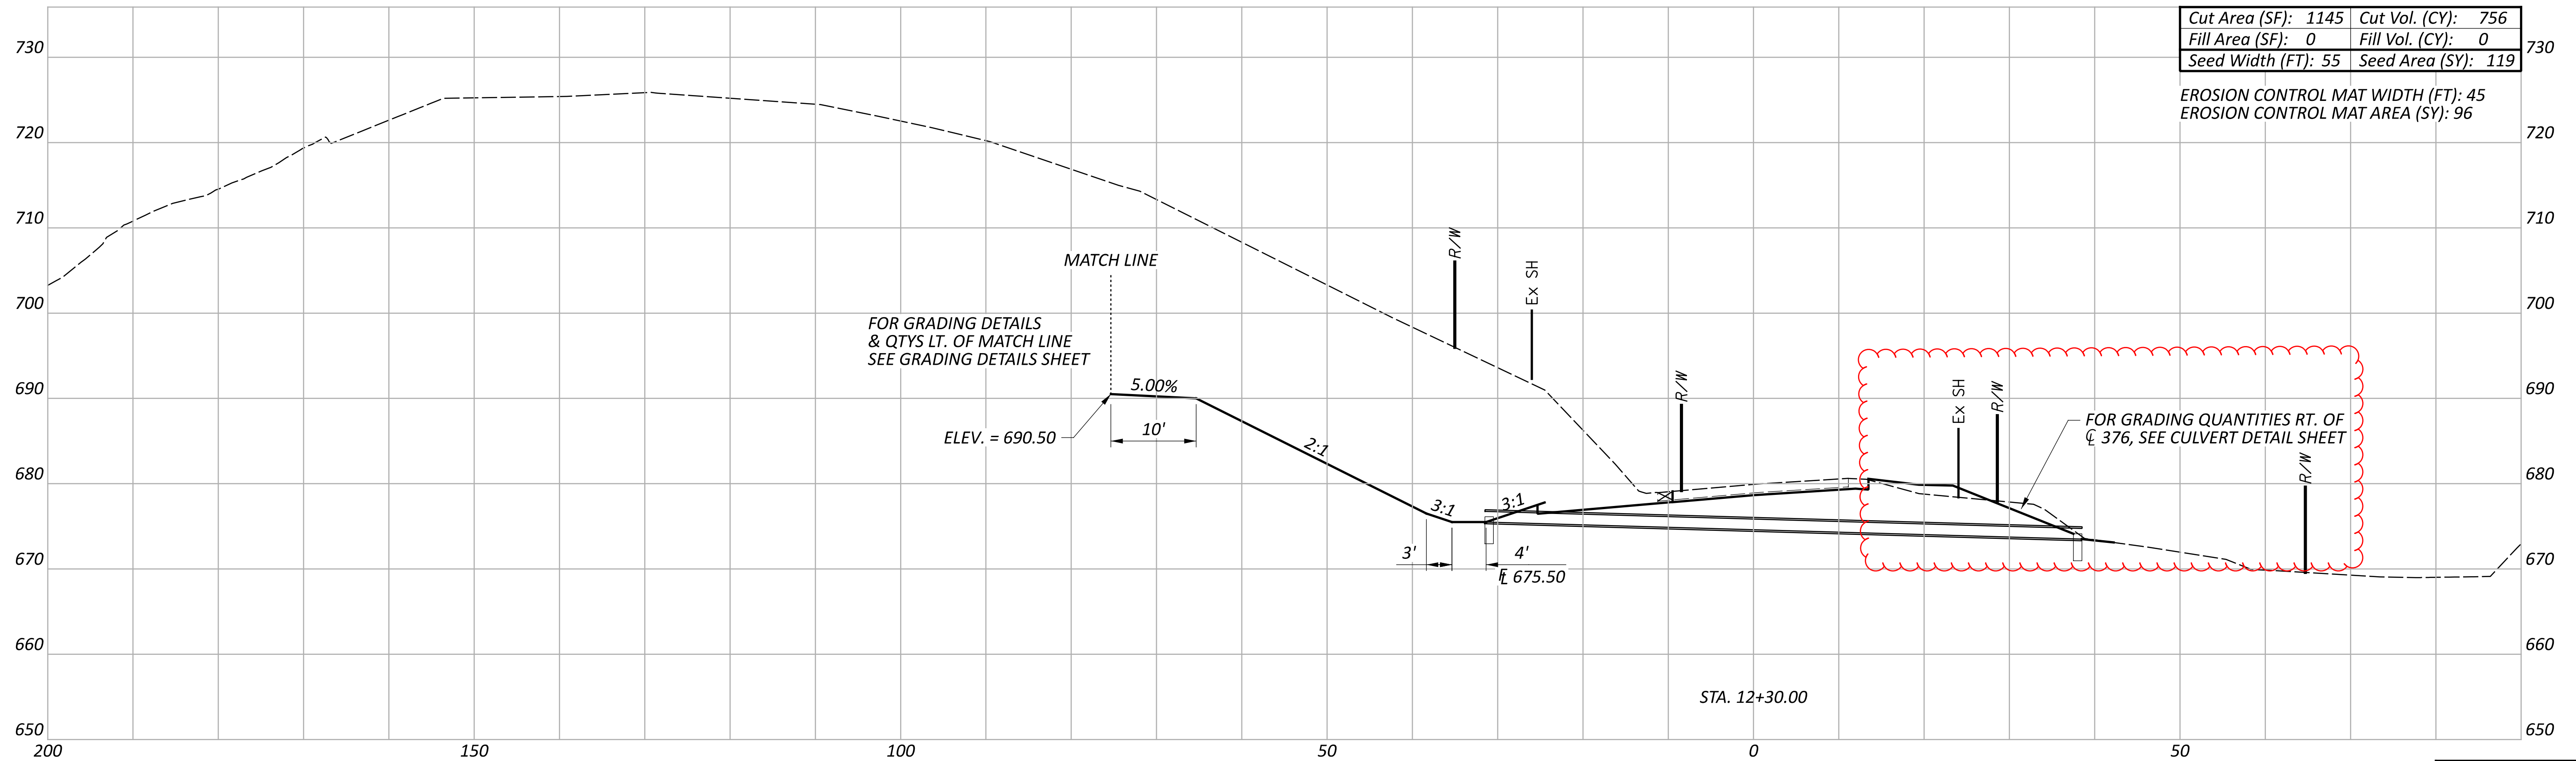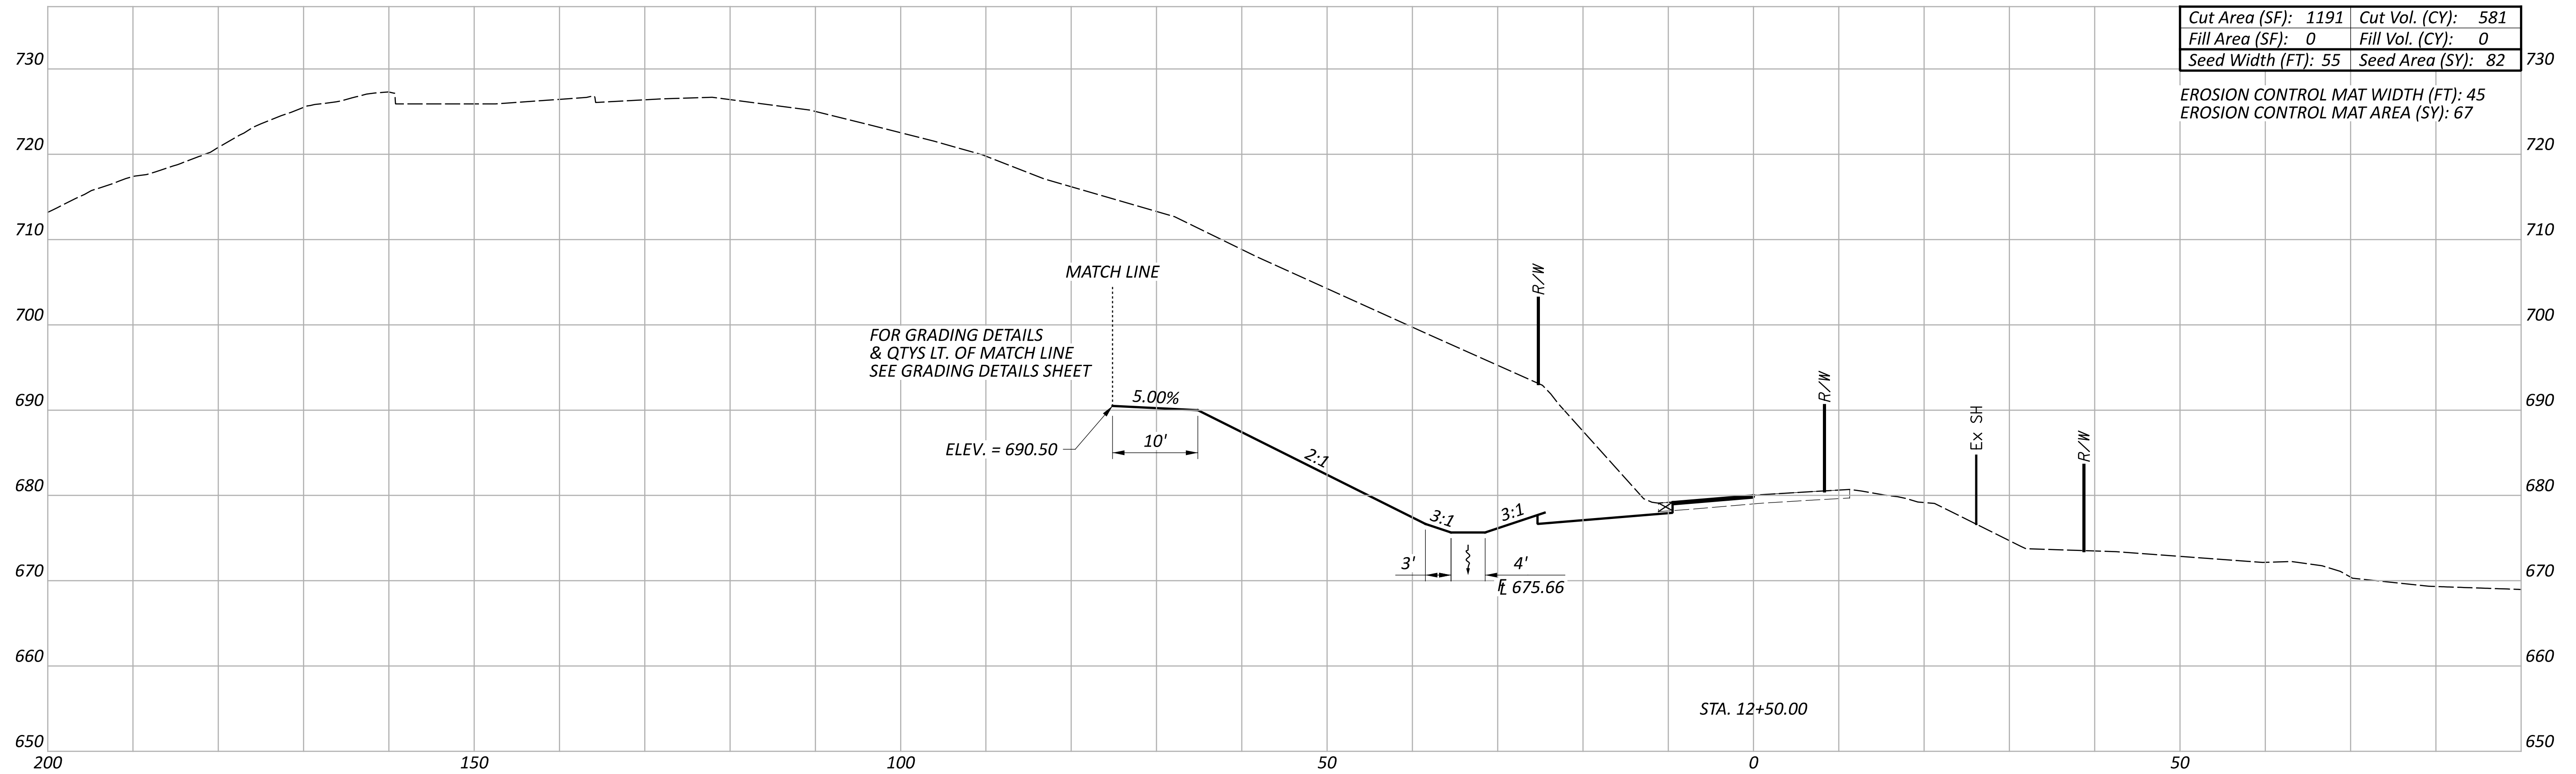

CROSS SECTIONS - S.R. 376
 STA. 12+30 - STA. 12+50

DESIGN AGENCY



DESIGNER
 GPM

REVIEWER
 CMY

PROJECT ID
 115989

Sheet Totals			SHEET TOTAL	
Seeding	Cut	Fill	P.20	37
201	1337	0		