

MOT SEQUENCE OF OPERATIONS

PRE-PHASE 1 (SHEETS 103-139)

REMOVE AND REERECT EXISTING LIGHT POLES THAT CONFLICT WITH THE PROPOSED TEMPORARY PAVEMENT.

CONSTRUCT TEMPORARY PAVEMENT ON THE OUTSIDE SHOULDERS OF I.R. 70 AS SHOWN IN THE PLANS UTILIZING SHOULDER CLOSURES AS PER SCD MT-95.45. PORTABLE BARRIER QUANTITIES ITEMIZED IN THE PLANS.

REMOVE ALL OVERHEAD SIGNS AND SUPPORTS ALONG I.R. 70 AS SHOWN IN THE PLANS. INSTALL WORK ZONE GROUND MOUNTED MAJOR SIGNS ON TEMPORARY SUPPORTS IN ACCORDANCE WITH SCD MT-105.10. SEE SHEETS 93-95 FOR DETAILS OF THESE SIGNS.

MILL AND FILL EXISTING RUMBLE STRIPS ALONG THE INSIDE AND OUTSIDE SHOULDERS OF I.R. 70 AS DETAILED ON SHEET 63.

INSTALL ALL PROPOSED RADAR DETECTORS AT THE VARIOUS INTERSECTIONS IN THE CITY OF ZANESVILLE AS SHOWN ON SHEETS 1221-1228.

ALL CONFLICTING PAVEMENT MARKINGS, SIGNS, AND OTHER TRAFFIC CONTROL DEVICES SHALL BE REMOVED OR COVERED.

PHASE 1 (SHEETS 140-189)

MAINTAIN TWO LANES OF TRAFFIC IN EACH DIRECTION ON I.R. 70 AT ALL TIMES UNLESS OTHERWISE APPROVED BY THE ENGINEER.

MOVE TRAFFIC TO THE OUTSIDE OF THE EASTBOUND AND WESTBOUND LANES AND CONSTRUCT THE MEDIAN SECTION OF I.R. 70.

CONSTRUCT THE I.R. 70 MAINLINE PAVEMENT AS PER THE PROPOSED TYPICAL SECTIONS EXCEPT THAT THE 1.50" SURFACE COURSE SHALL BE REPLACED WITH A TEMPORARY 1.50" SURFACE COMPRISED OF ITEM 442, ASPHALT CONCRETE INTERMEDIATE COURSE, 19 MM, TYPE A (448), AS PER PLAN (PG64-22/PG64-28).

CONSTRUCT RAMP E, RAMP F, RAMP H AND RAMP O DURING PHASE 1. (RAMP N MAY BE CONSTRUCTED THIS PHASE ALSO.)

BEFORE RAMP O CAN BE CLOSED, TEMPORARY SIGNALS MUST BE IN PLACE AT THE RAMP INTERSECTIONS OF THE I.R. 70/S.R. 93 INTERCHANGE AS SHOWN ON SHEETS 87-89. THESE SIGNALS ARE TO REMAIN IN PLACE UNTIL THE PROJECT IS COMPLETED.

BEFORE RAMP E CAN BE CLOSED, THE NECESSARY RE-STRIPING OF MAPLE AVE. AT ADAIR AVE. AND SUBSEQUENT SIGNAL WORK MUST BE IN PLACE. SEE SHEETS 90-92 FOR DETAILS.

CLOSURE RESTRICTIONS:

- RAMP E AND RAMP O SHALL NOT BE CLOSED AT THE SAME TIME.
- 5TH STREET, 6TH STREET, AND 7TH STREET SHALL BE CLOSED DURING BRIDGE DEMOLITION AND WHILE THE FALSEWORK IS IN PLACE. 5TH STREET AND 7TH STREET SHALL NOT BE CLOSED AT THE SAME TIME.

PRE-PHASE 2 (SHEETS 190-196)

CONSTRUCT CROSSOVER 1, CROSSOVER 2, AND OTHER NECESSARY TEMPORARY PAVEMENT NEEDED TO MAINTAIN PHASE 2 TRAFFIC AS DETAILED IN THE PLANS.

ALL CONFLICTING PAVEMENT MARKINGS, SIGNS, AND OTHER TRAFFIC CONTROL DEVICES SHALL BE REMOVED OR COVERED.

PHASE 2 (SHEETS 197-239)

MAINTAIN TWO LANES OF TRAFFIC IN EACH DIRECTION ON I.R. 70 AT ALL TIMES UNLESS OTHERWISE APPROVED BY THE ENGINEER.

THE PASSING LANE OF I.R. 70 EASTBOUND WILL CROSSOVER TO THE WESTBOUND SIDE OF THE ROADWAY, AND THE DRIVING LANE WILL TAPER OVER TO THE PASSING LANE TO ALLOW FOR THE CONSTRUCTION AREA OF THE EASTBOUND LANES.

CONSTRUCT THE I.R. 70 MAINLINE PAVEMENT AS PER THE PROPOSED TYPICAL SECTIONS EXCEPT THAT THE 1.50" SURFACE COURSE SHALL BE REPLACED WITH A TEMPORARY 1.50" SURFACE COMPRISED OF ITEM 442, ASPHALT CONCRETE INTERMEDIATE COURSE, 19 MM, TYPE A (448), AS PER PLAN (PG64-22/PG64-28).

CONSTRUCT RAMP T, RAMP U, RAMP J, AND RAMP L DURING PHASE 2.

CLOSURE RESTRICTIONS:

- RAMP T, RAMP J, AND RAMP L SHALL NOT BE CLOSED AT THE SAME TIME. A MINIMUM OF TWO EASTBOUND OFF-RAMPS SHALL BE OPEN AT ALL TIMES.
- RAMP U AND RAMP O SHALL NOT BE CLOSED AT THE SAME TIME.
- RAMP E, RAMP H, AND RAMP J SHALL BE CLOSED WHILE WORK IS IN PROGRESS ON THE MUS-70-1159 STRUCTURE. RAMP E AND RAMP H MAY BE REOPENED TO FIRE/EMS VEHICLES WHILE WORK ON THE MUS-70-1159 STRUCTURE IS ONGOING ONCE THE REAR APPROACH SLAB IS COMPLETE.
- 5TH STREET, 6TH STREET, AND 7TH STREET SHALL BE CLOSED DURING BRIDGE DEMOLITION AND WHILE THE FALSEWORK IS IN PLACE. 5TH STREET AND 7TH STREET SHALL NOT BE CLOSED AT THE SAME TIME.

PRE-PHASE 3 (SHEETS 240-248)

CONSTRUCT CROSSOVER 3, CROSSOVER 4, AND OTHER NECESSARY TEMPORARY PAVEMENT NEEDED TO MAINTAIN PHASE 3 TRAFFIC AS DETAILED IN THE PLANS.

ALL CONFLICTING PAVEMENT MARKINGS, SIGNS, AND OTHER TRAFFIC CONTROL DEVICES SHALL BE REMOVED OR COVERED.

PHASE 3 (SHEETS 249-292)

MAINTAIN TWO LANES OF TRAFFIC IN EACH DIRECTION ON I.R. 70 AT ALL TIMES UNLESS OTHERWISE APPROVED BY THE ENGINEER.

THE PASSING LANE OF I.R. 70 WESTBOUND WILL CROSSOVER TO THE EASTBOUND SIDE OF THE ROADWAY, AND THE DRIVING LANE WILL TAPER OVER TO THE PASSING LANE TO ALLOW FOR THE CONSTRUCTION AREA OF THE WESTBOUND LANES.

CONSTRUCT THE I.R. 70 MAINLINE PAVEMENT AS PER THE PROPOSED TYPICAL SECTIONS EXCEPT THAT THE 1.50" SURFACE COURSE SHALL BE REPLACED WITH A TEMPORARY 1.50" SURFACE COMPRISED OF ITEM 442, ASPHALT CONCRETE INTERMEDIATE COURSE, 19 MM, TYPE A (448), AS PER PLAN (PG64-22/PG64-28).

CONSTRUCT RAMP V, RAMP W, RAMP A, RAMP K, AND STATE STREET DURING PHASE 3. CONSTRUCT RAMP N IN PHASE 3 (IF NOT CONSTRUCTED IN PHASE 1).

CLOSURE RESTRICTIONS:

- RAMP W, RAMP A, AND RAMP N SHALL NOT BE CLOSED AT THE SAME TIME. A MINIMUM OF TWO WESTBOUND OFF-RAMPS SHALL BE OPEN AT ALL TIMES.
- RAMP V AND RAMP K SHALL NOT BE CLOSED AT THE SAME TIME.
- RAMP A AND RAMP K SHALL BE CLOSED WHILE WORK IS IN PROGRESS ON THE MUS-70-1159 STRUCTURE. RAMP A AND RAMP K MAY BE REOPENED TO FIRE/EMS VEHICLES WHILE WORK ON THE MUS-70-1159 STRUCTURE IS ONGOING ONCE THE APPROACH SLABS ARE COMPLETE.
- 5TH STREET, 6TH STREET, AND 7TH STREET SHALL BE CLOSED DURING BRIDGE DEMOLITION AND WHILE THE FALSEWORK IS IN PLACE. 5TH STREET AND 7TH STREET SHALL NOT BE CLOSED AT THE SAME TIME.
- STATE STREET SHALL BE CLOSED AS PER THE A+B DETAILS ON THIS SHEET.

BEFORE FINAL RESURFACING, CONSTRUCT THE REMAINING SECTIONS OF MEDIAN BARRIER UTILIZING SHOULDER CLOSURES PER SCD MT-95.45.

PHASE 4

THE ASPHALT CONCRETE PAVEMENT ALONG I.R. 70 WITHIN THE FULL DEPTH PROJECT LIMITS SHALL BE PLANED OFF AT A DEPTH OF 1.50".

PLACE ASPHALT CONCRETE SURFACE COURSE AS SHOWN ON THE PROPOSED TYPICAL SECTIONS.

WORK DURING THIS PHASE SHALL BE PERFORMED AT NIGHT WITH ONE LANE CLOSED DURING THE PERMITTED CLOSURE TIMES.

PAINTING OF ALL STRUCTURES AS SHOWN IN THE PLANS SHALL ALSO BE PERFORMED DURING PHASE 4. INTERMITTENT CLOSURES OF MCINTIRE AVENUE, LINDEN AVENUE, AND UNDERWOOD STREET WILL BE PERMITTED.

A+B BIDDING CONTRACT TABLE

USE THE FOLLOWING INFORMATION WITH THE PROPOSAL NOTE 124 A+B BIDDING. THE CONTRACTOR WILL BID THE NUMBER OF CALENDAR DAYS TO COMPLETE THE PROJECT AS LISTED IN THE PROPOSAL.

A+B BIDDING CONTRACT TABLE

CONTRACT SEGMENT/ LOCATION OF CRITICAL WORK	MIN. DAYS	MAX. DAYS	INCENTIVE/ DISINCENTIVE \$ PER DAY	MAXIMUM INCENTIVE \$
STATE STREET BRIDGE & RELATED ROADWAY WORK	115*	125	\$8,000	\$80,000

*CLOSURE WILL ONLY BE PERMITTED DURING THE SUMMER MONTHS. ANY CLOSURE TIME THAT WILL OCCUR WHILE SCHOOL IS IN SESSION MUST BE COORDINATED WITH ZANESVILLE CITY SCHOOLS A MINIMUM OF 1 (ONE) YEAR PRIOR TO THE CLOSURE BEING PUT INTO PLACE.

LANE VALUE- I.R. 70

LANE CLOSURES WILL ONLY BE IMPLEMENTED AT THE TIMES LISTED ON THE OHIO DEPARTMENT OF TRANSPORTATION'S WEBSITE, "PERMITTED LANE CLOSURE TIMES" SECTION, LOCATED AT THE ADDRESS BELOW:

<http://plcm.dot.state.oh.us/>

THE PERMITTED LANE CLOSURE TIMES LISTED ON THE WEBSITE, 14 CALENDAR DAYS PRIOR TO THE BID LETTING DATE, WILL BE IN EFFECT FOR THIS PROJECT. NO WORK WITHIN ACTIVE TRAVEL LANES OR WHICH WILL SLOW TRAFFIC IS PERMITTED AT ANY OTHER TIMES. WHEN NECESSARY, LANE CLOSURES WILL BE ACCOMPLISHED IN ACCORDANCE WITH THE STANDARD CONSTRUCTION DRAWINGS.

SHOULD THE CONTRACTOR CLOSE A LANE BEFORE THE ALLOWABLE TIME AND/OR FAIL TO RE-OPEN ALL LANES TO TRAFFIC, BY THE ALLOWABLE TIME, A DISINCENTIVE AS DESIGNATED IN THE LANE VALUE CONTRACT TABLE AND PROPOSAL NOTE 127 WILL BE ASSESSED.

LANE VALUE CONTRACT TABLE - I.R. 70

DESCRIPTION OF CRITICAL LANE TO BE MAINTAINED	RESTRICTED TIME PERIOD	TIME UNIT	DISINCENTIVE \$ PER TIME UNIT
1 LANE OF I.R. 70 MM 10.00 TO MM 14.00	ODOT WEBSITE: PERMITTED LANE CLOSURE TIMES	15 MIN.	\$2,500

ALTERNATE METHODS

IF THE CONTRACTOR SO ELECTS, HE MAY SUBMIT ALTERNATE METHODS FOR THE MAINTENANCE OF TRAFFIC, PROVIDED THE INTENT OF THE ABOVE PROVISIONS IS FOLLOWED AND NO ADDITIONAL INCONVENIENCE TO THE TRAVELING PUBLIC RESULTS THEREFROM. NO ALTERNATE PLAN SHALL BE PLACED EFFECT UNTIL APPROVAL HAS BEEN GRANTED, IN WRITING, BY THE DIRECTOR.

I:\ProjectData\MUS\93006\400-Engineering\MOT\Sheets\93006_MN001.dgn_Sheet 4/12/2021 2:46 PM bharlow

CALCULATED
BRH
CHECKED
HAG

MAINTENANCE OF TRAFFIC GENERAL NOTES

MUS-70-10.49

MUS-70-1066L BRIDGE SUMMARY - 02/IMS/BR

CALC: MMZ CHECK: CTM

ITEM	ITEM EXT.	TOTAL QUANTITY	TOTAL PER PHASE			UNIT	DESCRIPTION	PHASE 1			PHASE 3			GENERAL	APP/REF SHEET NO.
			PH 1	PH 3	GEN			ABUT.	PIERS	SUPER	ABUT.	PIERS	SUPER		
202	11003	LS			LS		STRUCTURE REMOVED, OVER 20 FOOT SPAN, AS PER PLAN						LS	4	
202	22900	228	78	150		SY	APPROACH SLAB REMOVED	78			150				
503	11101	LS			LS		COFFERDAMS AND EXCAVATION BRACING, AS PER PLAN						LS	5	
503	21301	LS	LS	LS			UNCLASSIFIED EXCAVATION, AS PER PLAN	LS			LS			5	
505	11100	LS			LS		PILE DRIVING EQUIPMENT MOBILIZATION						LS		
507	00600	1,050	550	500		FT	14" CAST-IN-PLACE REINFORCED CONCRETE PILES, DRIVEN	550			500				
507	00650	1,190	620	570		FT	14" CAST-IN-PLACE REINFORCED CONCRETE PILES, FURNISHED	620			570				
509	10001	180,372	72,730	107,642		LB	EPOXY COATED REINFORCING STEEL, AS PER PLAN	7,635		65,095	10,538		300	5	
509	20001	300			300	LB	REINFORCING STEEL, REPLACEMENT OF EXISTING REINFORCING STEEL, AS PER PLAN							5	
510	10001	118	38	80		EACH	DOWEL HOLES WITH NONSHRINK, NONMETALLIC GROUT, AS PER PLAN	38			80			5	
511	33500	2	2			EACH	SEMI-INTEGRAL DIAPHRAGM GUIDE	2							
511	34447	566	213	353		CY	CLASS QC2 CONCRETE WITH QC/QA, BRIDGE DECK, AS PER PLAN			213				5	
511	34451	120	60	60		CY	CLASS QC2 CONCRETE WITH QC/QA, BRIDGE DECK (PARAPET), AS PER PLAN			60			60	5	
511	44112	185	73	113		CY	CLASS QC1 CONCRETE WITH QC/QA, ABUTMENT NOT INCLUDING FOOTING	73			113				
511	46512	62	31	31		CY	CLASS QC1 CONCRETE WITH QC/QA, FOOTING	31			31				
512	10050	911	445	466		SY	SEALING OF CONCRETE SURFACES (NON-EPOXY)	52		393	74			392	
512	10300	75		75		SY	SEALING CONCRETE BRIDGE DECKS WITH HMWM RESIN							75	
512	10601	50			50	FT	CONCRETE REPAIR BY EPOXY INJECTION, AS PER PLAN						50	5	
512	33000	66	26	40		SY	TYPE 2 WATERPROOFING	26			40				
513	10260	517,113	210,852	306,261		LB	STRUCTURAL STEEL MEMBERS, LEVEL 3			210,852				306,261	
513	20000	7,077	3,033	4,044		EACH	WELDED STUD SHEAR CONNECTORS			3,033				4,044	
514	00061	26,218	10,786	15,432		SF	FIELD PAINTING STRUCTURAL STEEL, INTERMEDIATE COAT, AS PER PLAN			10,786				15,432	
514	00067	26,218	10,786	15,432		SF	FIELD PAINTING STRUCTURAL STEEL, FINISH COAT, AS PER PLAN			10,786				15,432	
514	10000	22	9	13		EACH	FINAL INSPECTION REPAIR			9				13	
516	13901	79	39	39		SF	2" PREFORMED EXPANSION JOINT FILLER, AS PER PLAN			39				39	
516	14020	182	72	111		FT	SEMI-INTEGRAL ABUTMENT EXPANSION JOINT SEAL			72				111	
516	14600	142	51	91		FT	STRUCTURAL JOINT OR JOINT SEALER, MISC.: EMSEAL WITH SLEEPER SLAB	51			91			50	
516	44101	28	12	16		EACH	ELASTOMERIC BEARING WITH INTERNAL LAMINATES AND LOAD PLATE (NEOPRENE), AS PER PLAN , DIMENSIONS VARY	6	6		8	8		30	
516	46900	7	3	4		EACH	BEARING DEVICE, MISC.: SEISMIC ISOLATION BEARING		3			4		31	
518	12200	7	5	2		EACH	SCUPPERS, INCLUDING SUPPORTS	5			2				
518	21200	134	53	81		CY	POROUS BACKFILL WITH GEOTEXTILE FABRIC	53			81				
518	40000	217	88	129		FT	6" PERFORATED CORRUGATED PLASTIC PIPE	88			129				
518	40010	60	30	30		FT	6" NON-PERFORATED CORRUGATED PLASTIC PIPE, INCLUDING SPECIALS	30			30				
519	11101	70			70	SF	PATCHING CONCRETE STRUCTURE, AS PER PLAN						70	5	
523	20001	8	4	4		EACH	DYNAMIC LOAD TESTING, AS PER PLAN	4			4			5	
523	20501	8	4	4		EACH	RESTRIKE, AS PER PLAN	4			4			5	
526	30010	316	114	201		SY	REINFORCED CONCRETE APPROACH SLABS WITH QC/QA (T=17")	114			201				
SPECIAL	53000200	LS			LS		STRUCTURES - MEASUREMENTS FOR PROPOSED BEARINGS						LS	6	
601	20000	1,044			1,044	SY	CRUSHED AGGREGATE SLOPE PROTECTION						1,044		
607	39900	350	175	175		FT	VANDAL PROTECTION FENCE, 6' STRAIGHT, COATED FABRIC			175			175		
613	41201	287	99	188		CY	LOW STRENGTH MORTAR BACKFILL, AS PER PLAN	99			188			5	

DESIGN AGENCY
Gannett Fleming
ENGINEERS & ARCHITECTS, P.C.
2800 CORPORATE EXCHANGE DRIVE SUITE 230
COLUMBIUS, OHIO 43231


DATE 12/2020
REVIEWED CTM
STRUCTURE FILE NUMBER 6002641
DRAWN LAM
CHECKED REVISOR
DESIGNED MZ
CHECKED DF

BRIDGE SUMMARY
BRIDGE NO. MUS-70-1066L
OVER LICKING ROAD & CUOH RAILROAD


MUS-70-10.49
PID No. 93006
7 / 54
1294
2231

SUBMITTAL: Stage 3
PID: 93006
PLOT DRIVER: 000Tcodd_PDF.pltctg
PENTABLE: 93006-000TV81_Pen.tbl
pw:\gfnnet-pw.bentley.com\gfnnet-pw-0\Documents\Projects\6477\93006\40-Engineering-GannettFleming\Structures\MUS070_1066L\Sheets\006_sq001_4/9/2021:9:47:58 AM modonnell


SUBMITTAL: Stage 3
 PLOT DRIVER: 000Tcodd_PDF.pltcf9
 PENTABLE: 93006_0001V81_Pen.tbl
 pw:\gtnet-pw.bentley.com\gtnet-pw-0\Documents\Projects\6477\93006\401-Engineering-GannettFleming\MUS070_1066\Structures\MUS070_1066\Sheets\04_sr002_4/8/2021 2:08:48 PM cmarburger

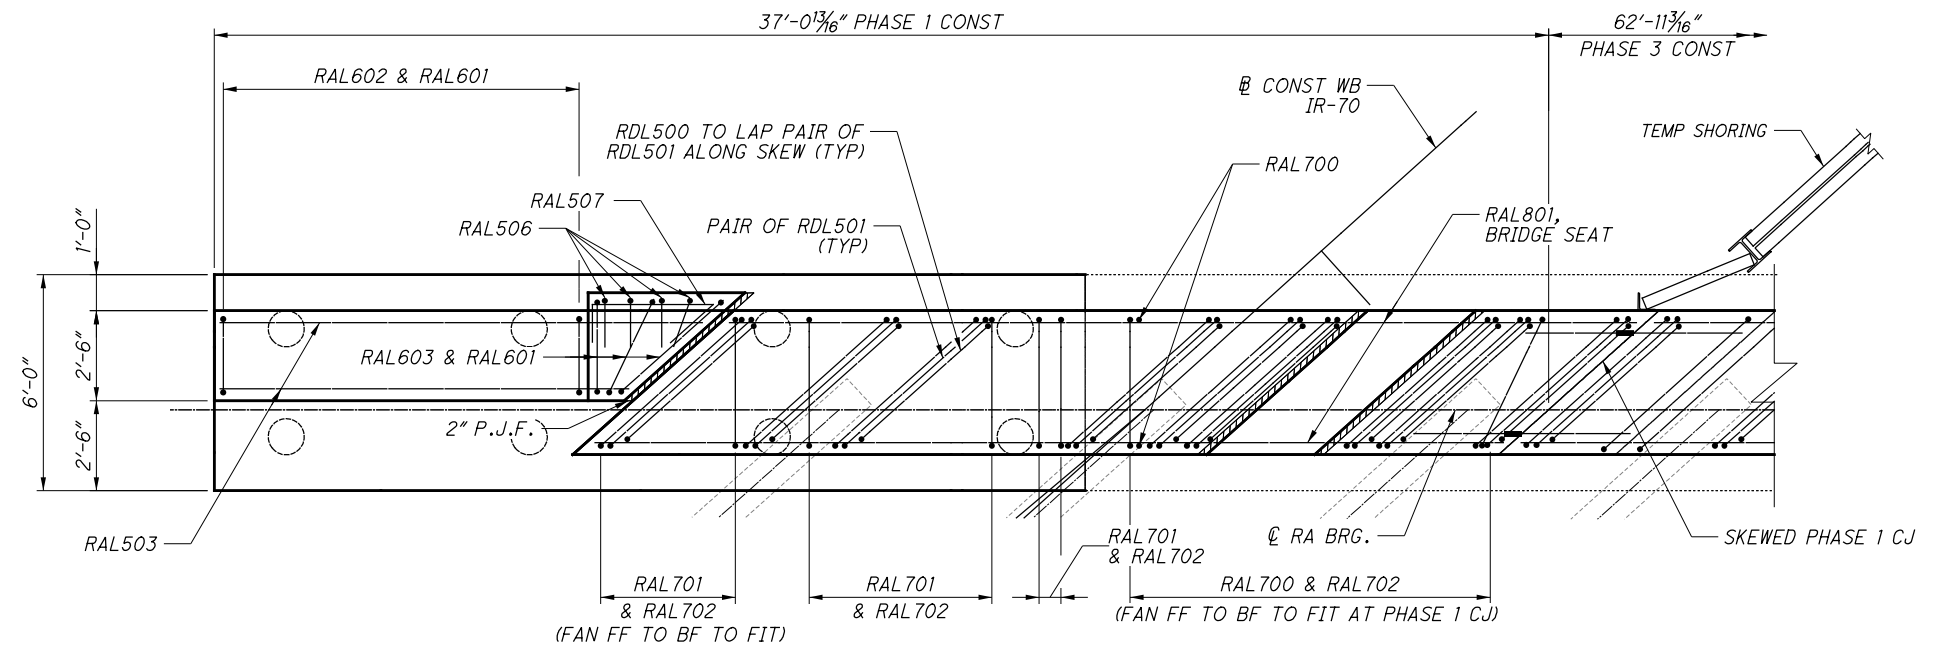

REAR ABUTMENT PHASE 1 PLAN

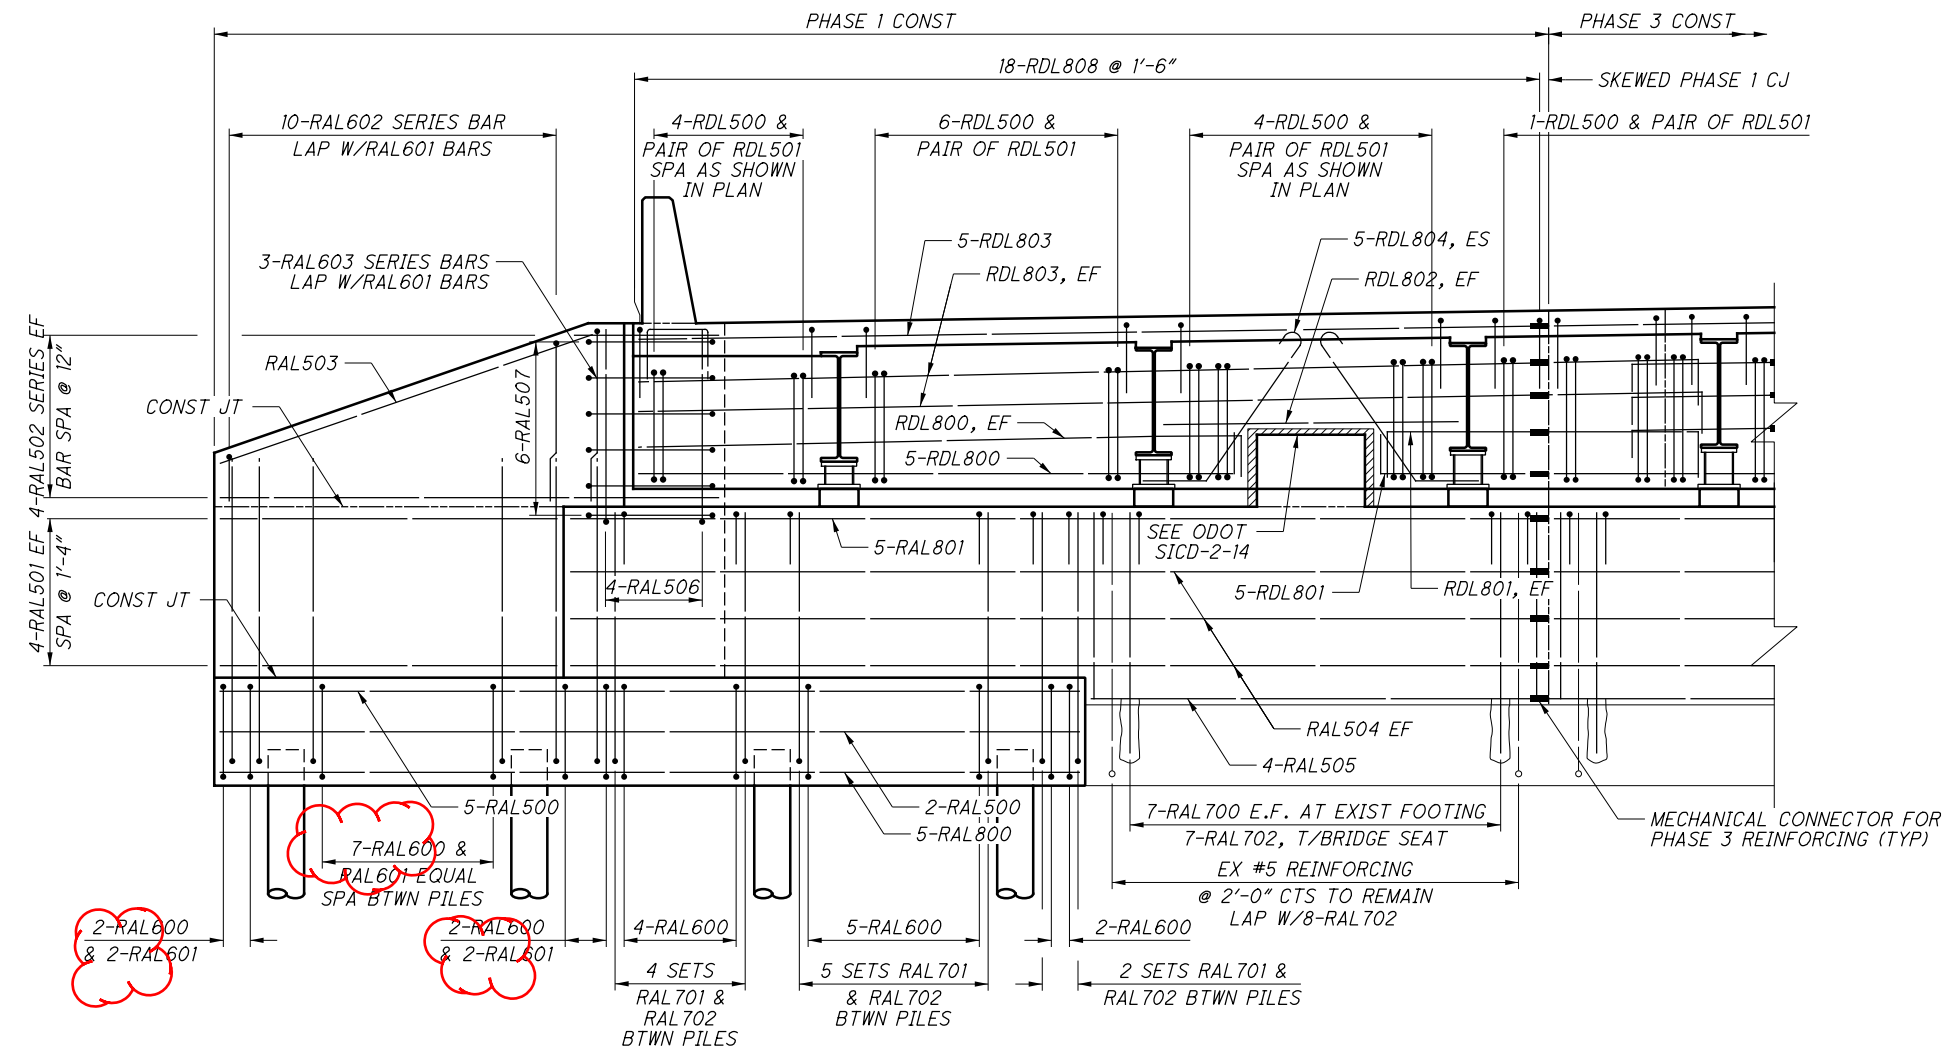


REAR ABUTMENT PHASE 1 ELEVATION
DECK REINFORCEMENT NOT SHOWN FOR CLARITY

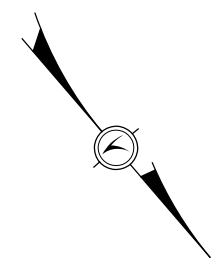

- NOTES**
1. SEE SHEET 18/54 FOR ABUTMENT DETAILS AND SECTIONS.
 2. SEE SHEET 12/54 FOR FOUNDATION PLAN.
 3. SEE SHEET 38/54 FOR TRANSVERSE SECTION.
 4. 2" CLEAR COVER UNLESS NOTED OTHERWISE.
 5. 12" MAX SPACING UNLESS NOTED OTHERWISE.

REAR ABUTMENT PHASE 1 BRIDGE NO. MUS-70-1066L OVER LICKING ROAD & CUOH RAILROAD	MUS-70-10.49 PID No. 93006	DESIGN AGENCY Gannett Fleming ENGINEERS & ARCHITECTS, P.C. 2500 CORPORATE EXCHANGE DRIVE, SUITE 230 COLUMBUS, OHIO 43231	DATE 12/2020 REVIEWED CTM STRUCTURE FILE NUMBER 6002641	DRAWN LAM REVISIONS DESIGNED JGC CHECKED DF
--	--------------------------------------	---	--	---


SUBMITTAL: Stage 3
 PLOT DRIVER: 000Tcodd_PDF.pltcf9
 PENTABLE: 93006_0001V81_Pen.tbl
 pw:\gfnnet-pw.bentley.com\gfnnet-pw-0\Documents\Projects\6477\93006_401-Engineering-GannettFleming\Structures\MUS070_10661\Sheets\015 sr-003 4/8/2021 2:09:06 PM cmarburger

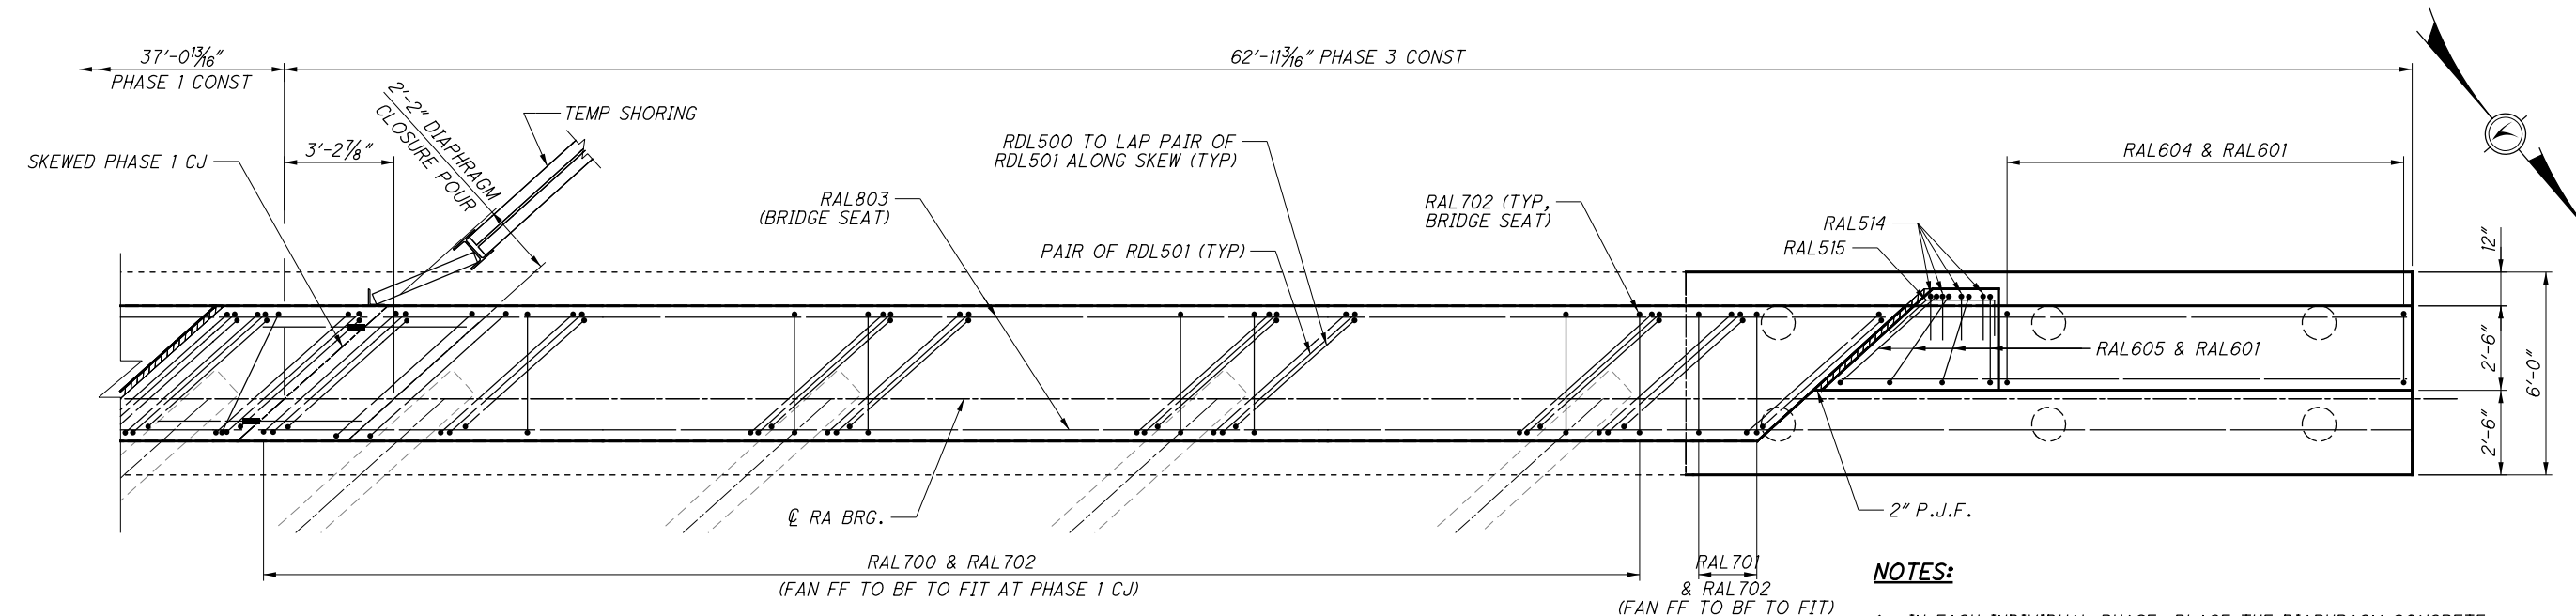

REAR ABUTMENT PHASE 3 PLAN

NOTES:


1. IN EACH INDIVIDUAL PHASE, PLACE THE DIAPHRAGM CONCRETE ENCASEING THE STRUCTURAL MEMBER ENDS AFTER THE DECK PLACEMENT IN THE ADJACENT SPAN IS COMPLETE. PROCEDURES THAT PLACE THE ABUTMENT DIAPHRAGM WITH THE DECK CONCRETE MAY BE APPROVED BY THE ENGINEER IF THE PLACEMENT SUBMITTAL CAN ASSURE THAT THE DECK CONCRETE IN THE ADJACENT SPAN WILL BE PLACED BEFORE CONCRETE IN THE DIAPHRAGM HAS REACHED ITS INITIAL SET. PLACE CLOSURE POUR IN THE DIAPHRAGM AND DECK CONCURRENTLY.
2. SEE SHEET 16154 FOR ADDITIONAL NOTES.

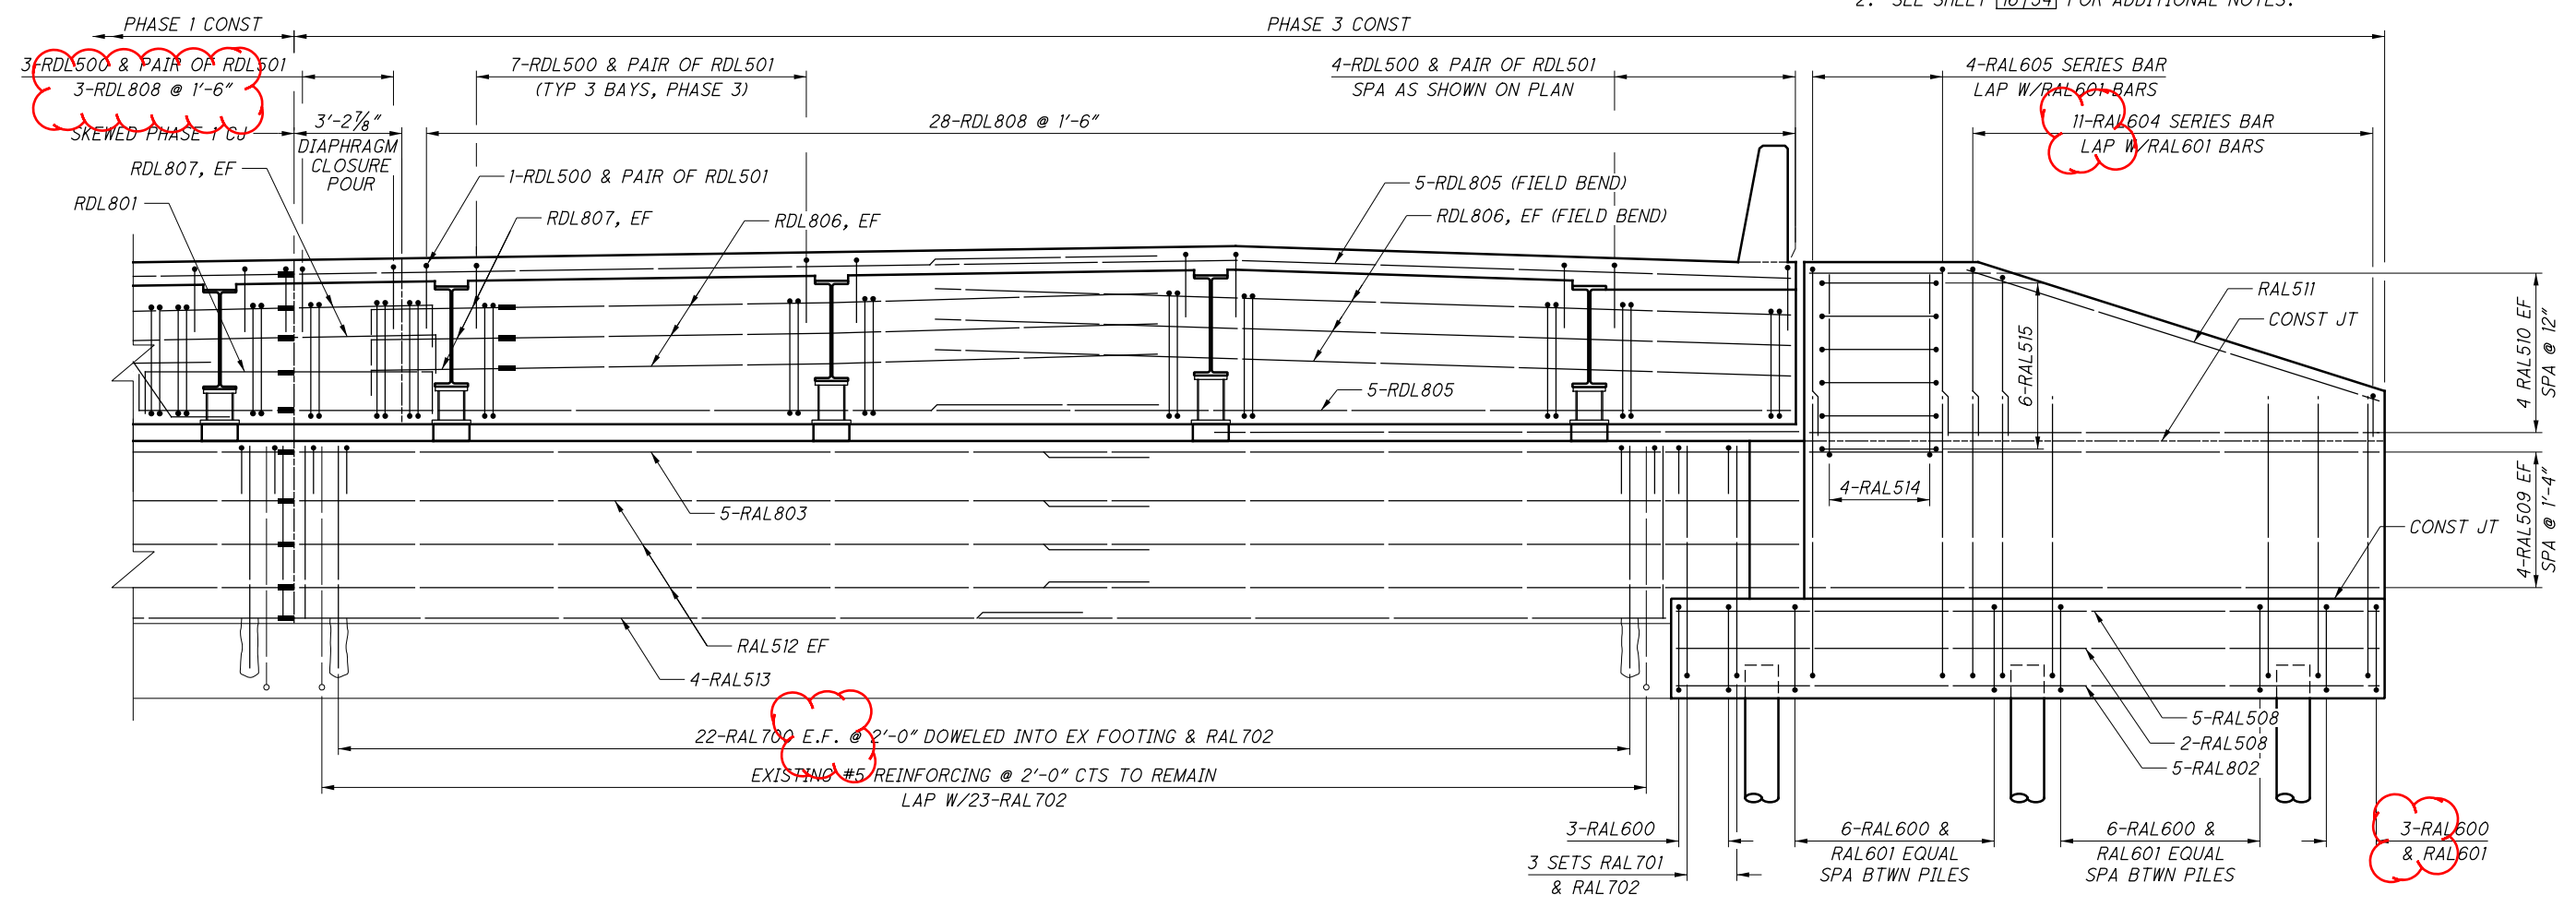


REAR ABUTMENT PHASE 3 ELEVATION
DECK REINFORCEMENT NOT SHOWN FOR CLARITY

 Gannett Fleming ENGINEERS & ARCHITECTS, P.C. 2500 CORPORATE EXCHANGE DRIVE, SUITE 230 COLUMBUS, OHIO 43231	DESIGN AGENCY MUS-70-10.49 BRIDGE NO. MUS-70-10661 OVER LICKING ROAD & CUOH RAILROAD	REAR ABUTMENT PHASE 3	DESIGNER: JGC CHECKED: DF DRAWN: LAM REVISED: DATE: 12/2020 CTM STRUCTURE FILE NUMBER: 6002641
17 / 54		1304 2231	

SUBMITTAL: Stage 3
 PLOT DRIVER: 000Tcodd_PDF.pltcf9
 PENTABLE: 93006_0001V81_Pen.tbl
 pw:\gfnnet-pw.bentley.com\gfnnet-pw-0\Documents\Projects\6477\93006\401-Engineering-GannettFleming\Structures\MUS070.1066L\Sheets\020_sf002_4/8/2021 2:10:42 PM cmarburger

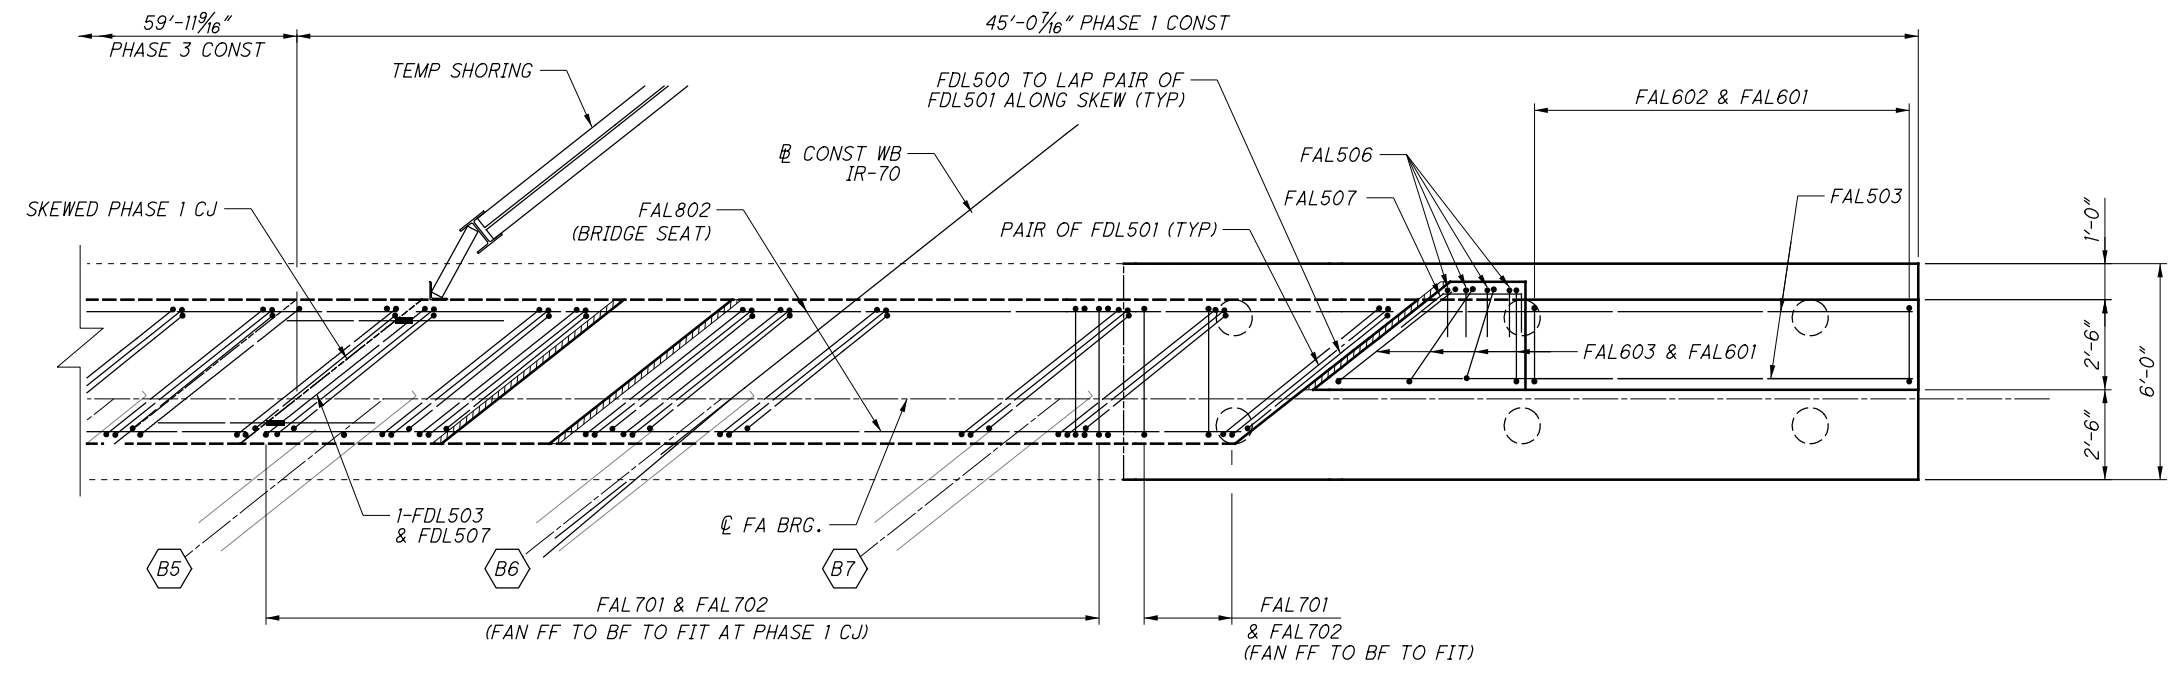


FORWARD ABUTMENT PHASE 1 PLAN

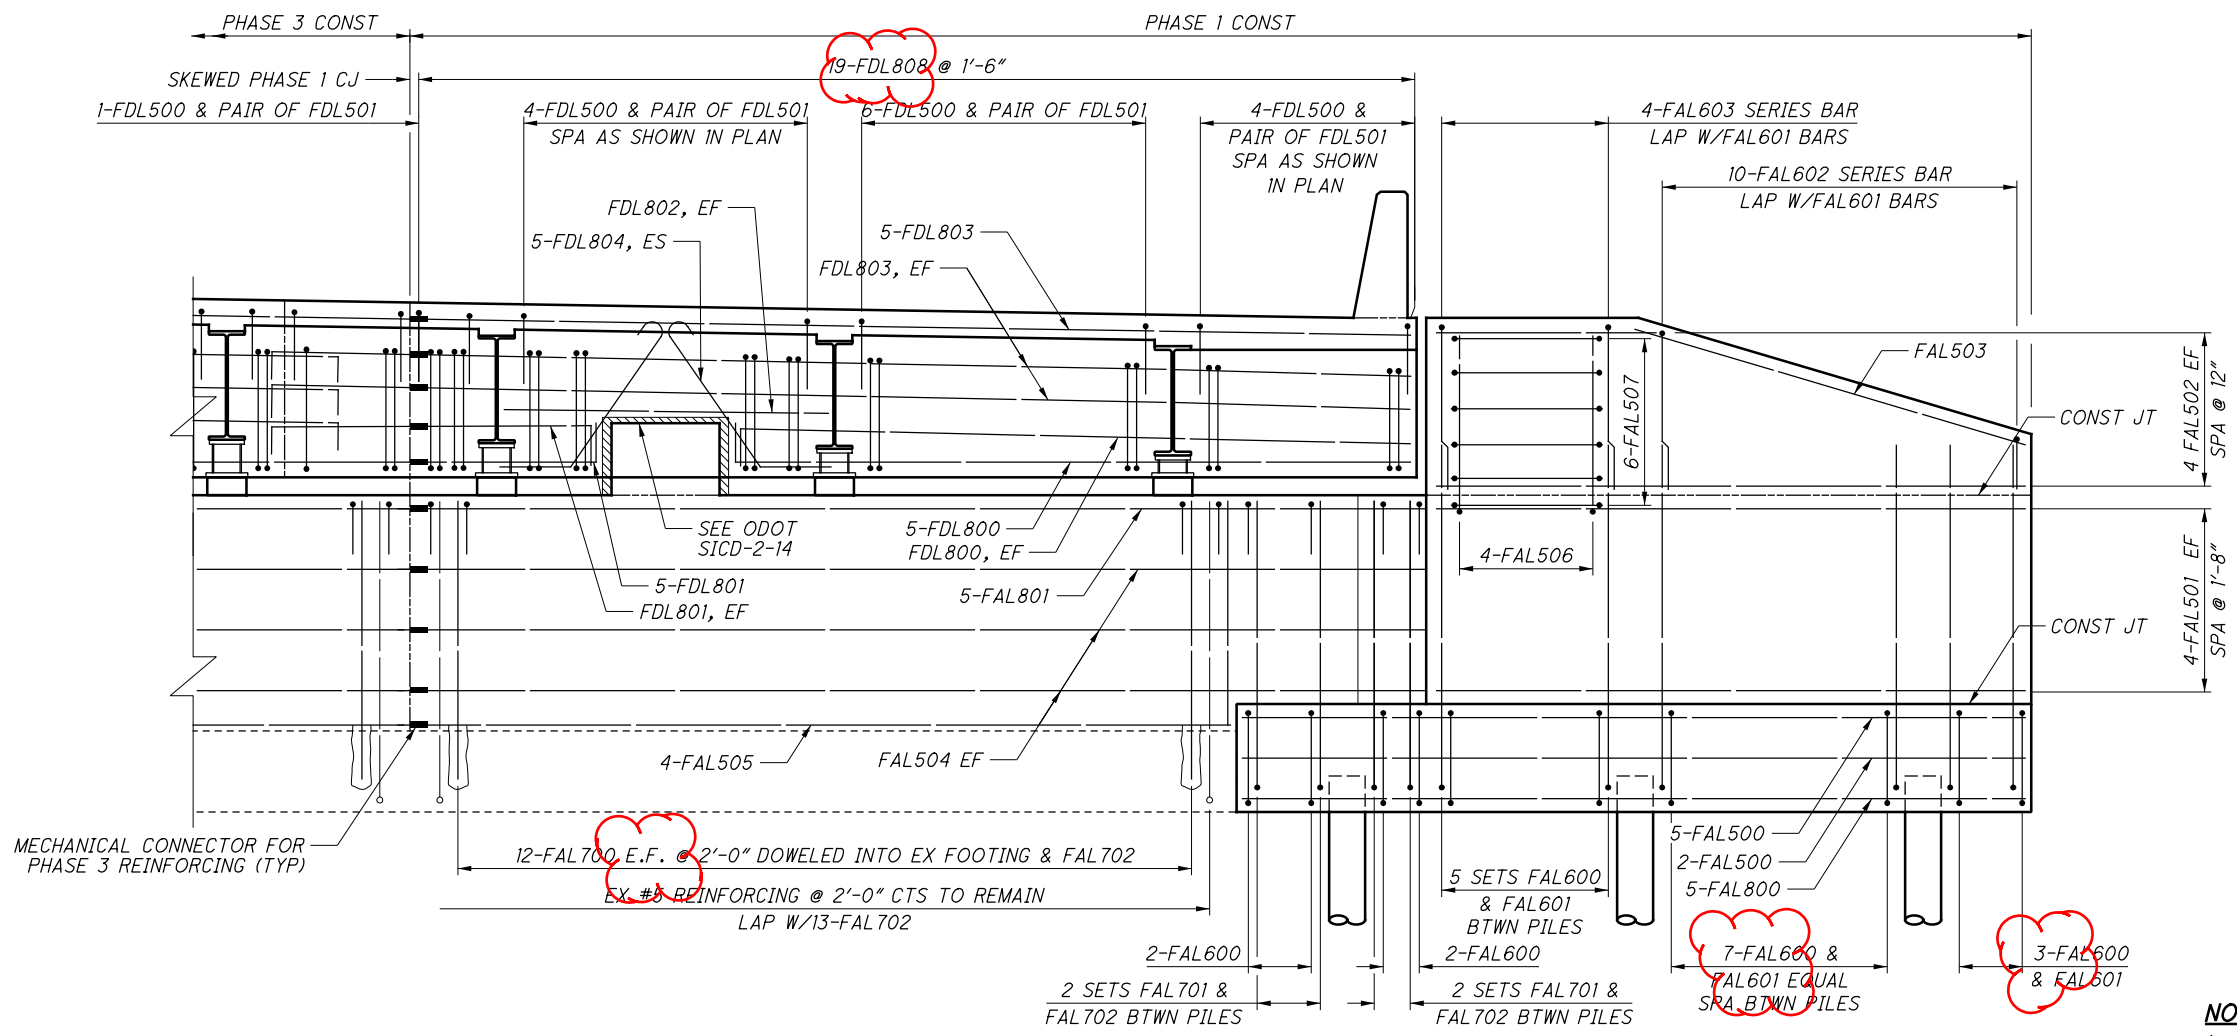

FORWARD ABUTMENT PHASE 1 ELEVATION
DECK REINFORCEMENT NOT SHOWN FOR CLARITY


NOTES

1. SEE SHEET 24/54 FOR ABUTMENT DETAILS AND SECTIONS.
2. SEE SHEET 13/54 FOR FOUNDATION PLAN.
3. SEE SHEET 38/54 FOR TRANSVERSE SECTION.
4. 2" CLEAR COVER UNLESS NOTED OTHERWISE.

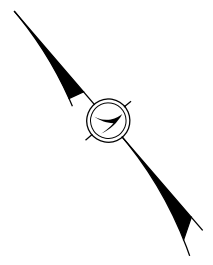

Gannett Fleming <small>ENGINEERS & ARCHITECTS, P.C. 2500 CORPORATE EXCHANGE DRIVE SUITE 230 COLUMBUS, OHIO 43231</small>	DESIGN AGENCY Gannett Fleming <small>ENGINEERS & ARCHITECTS, P.C. 2500 CORPORATE EXCHANGE DRIVE SUITE 230 COLUMBUS, OHIO 43231</small>	DATE 12/2020	REVIEWED CTM	STRUCTURE FILE NUMBER 6002641
DESIGNED JGC	CHECKED DF	DRAWN LAM	REVISED	
FORWARD ABUTMENT PHASE 1 BRIDGE NO. MUS-70-1066L OVER LICKING ROAD & CUOH RAILROAD				
MUS-70-10.49 PID No. 93006				
22 / 54				
1309 2231				


SUBMITTAL: Stage 3
 PLOT DRIVER: 000Tcodd_PDF.pltcf9
 PENTABLE: 93006_0001V81_Pen.tbl
 pw:\gfnnet-pw.bentley.com\gfnnet-pw-0\Documents\Projects\6477\93006_401-Engineering-GannettFleming-Structures\MUS070_10666\Sheets\02\sf003 4/8/2021 2:10:23 PM cmorburger

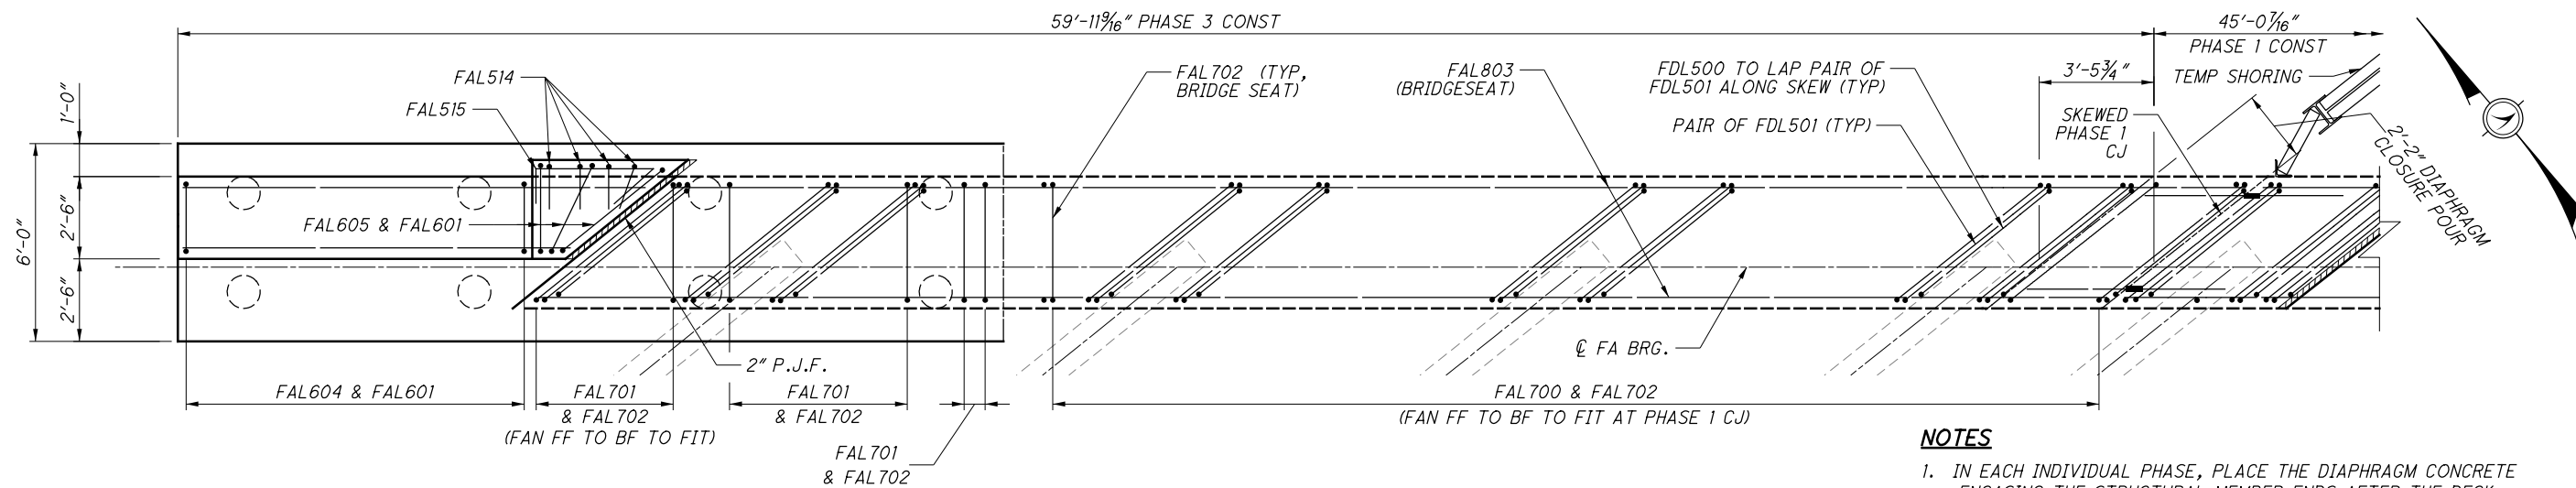

FORWARD ABUTMENT PHASE 3 PLAN

NOTES


1. IN EACH INDIVIDUAL PHASE, PLACE THE DIAPHRAGM CONCRETE ENCASING THE STRUCTURAL MEMBER ENDS AFTER THE DECK PLACEMENT IN THE ADJACENT SPAN IS COMPLETE. PROCEDURES THAT PLACE THE ABUTMENT DIAPHRAGM WITH THE DECK CONCRETE MAY BE APPROVED BY THE ENGINEER IF THE PLACEMENT SUBMITTAL CAN ASSURE THAT THE DECK CONCRETE IN THE ADJACENT SPAN WILL BE PLACED BEFORE CONCRETE IN THE DIAPHRAGM HAS REACHED ITS INITIAL SET. PLACE CLOSURE POUR IN THE DIAPHRAGM AND DECK CONCURRENTLY.
2. SEE SHEET 22154 FOR ADDITIONAL NOTES.

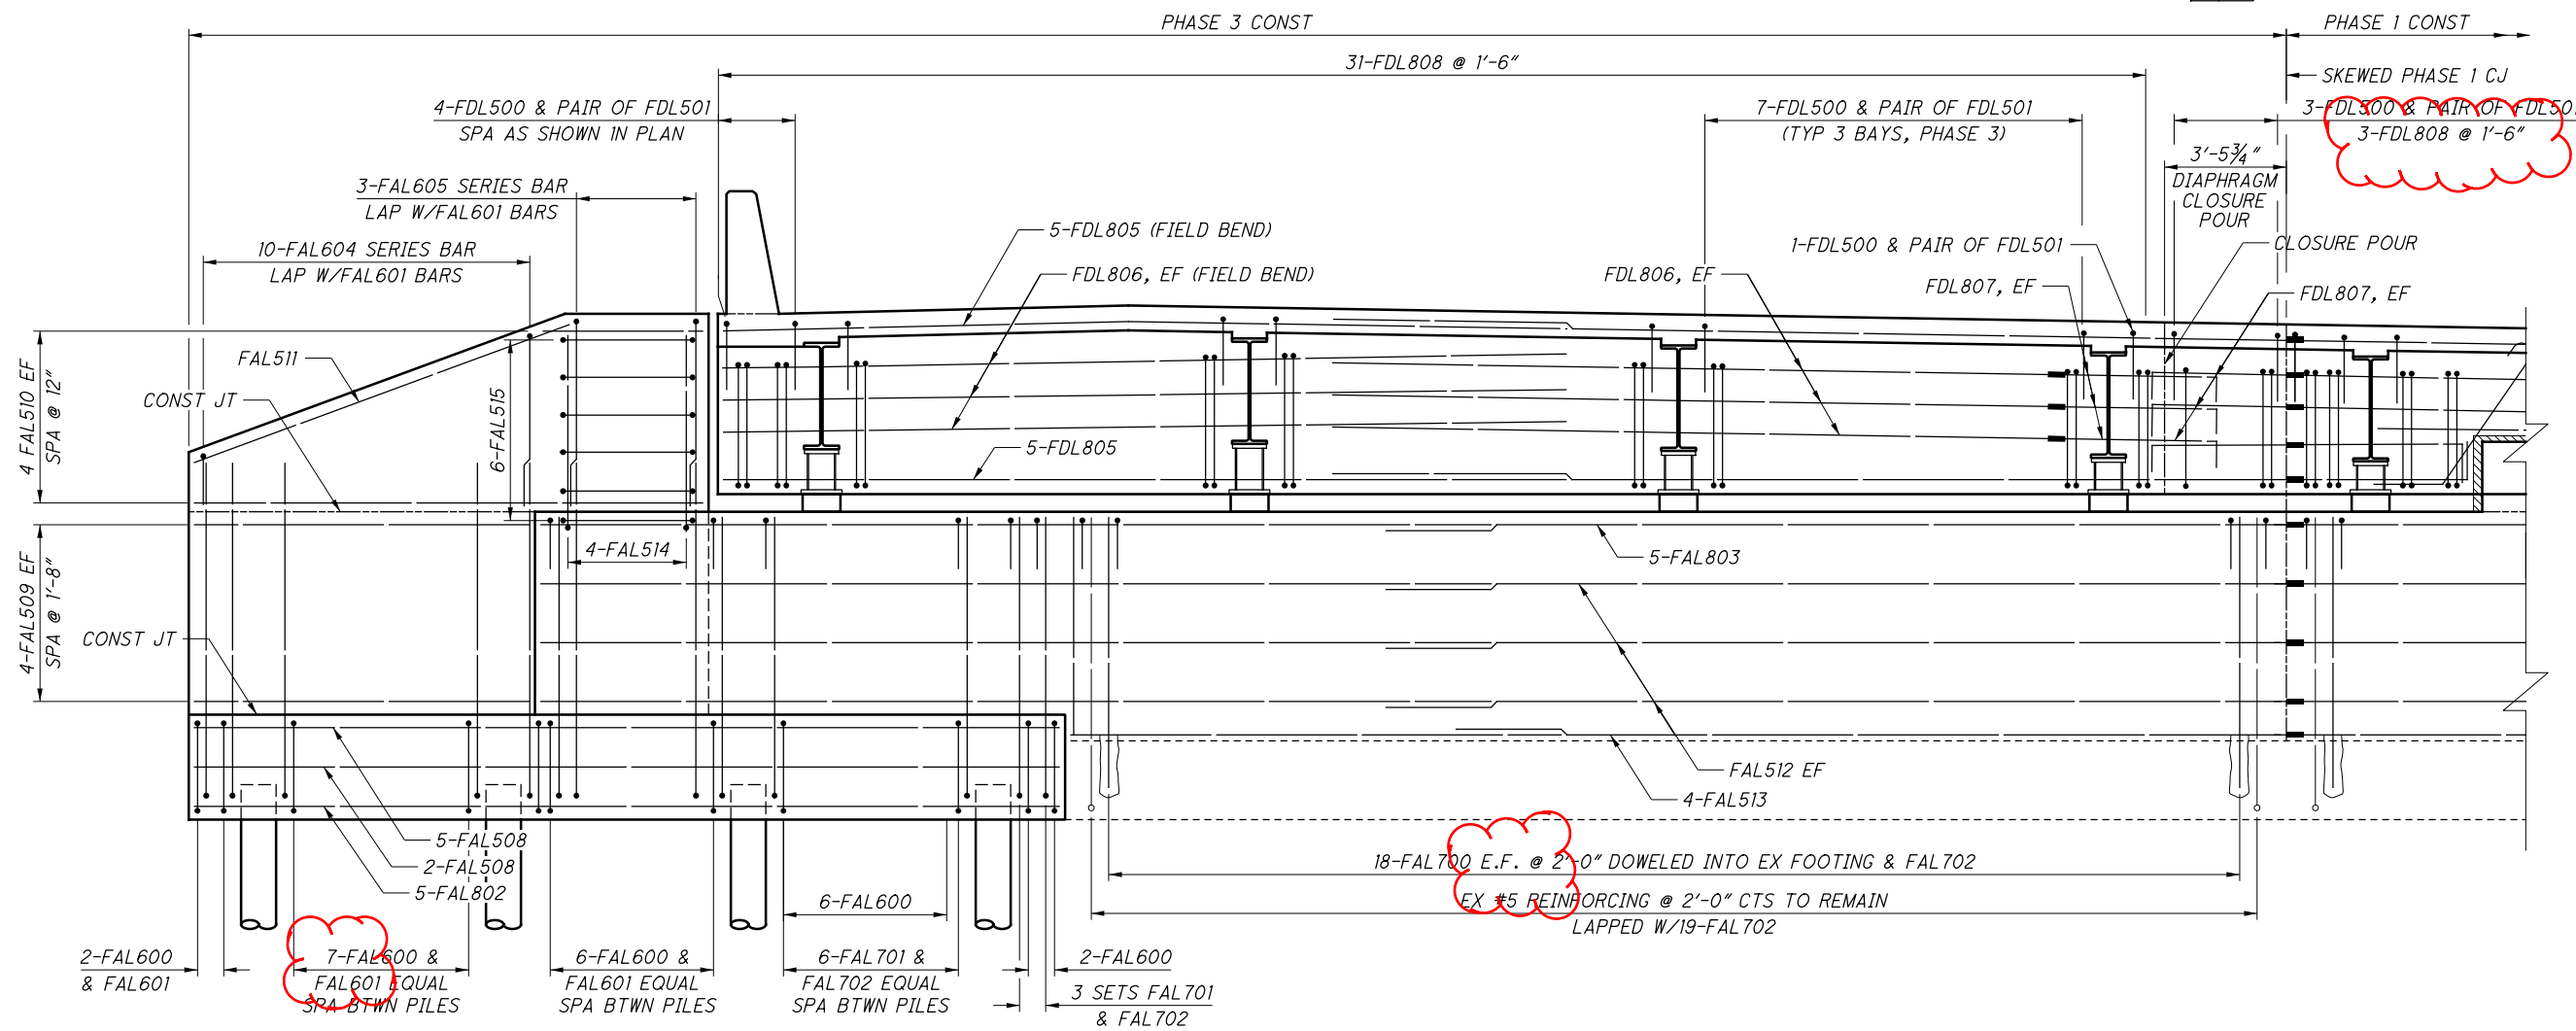

FORWARD ABUTMENT PHASE 3 ELEVATION

DECK REINFORCEMENT NOT SHOWN FOR CLARITY


SUBMITTAL: Stage 3
 PLOT DRIVER: 000Tcodd_PDF.pltcf9
 PENTABLE: 93006_0001V81_Pen.tbl
 pw:\gfnnet-pw.bentley.com\gfnnet-pw-0\Documents\Projects\6477\93006\401-Engineering-Gannett+Fleming\MUS070-10661\Sheets\039_sd001_4/8/2021\13:16 PM_cmarburger

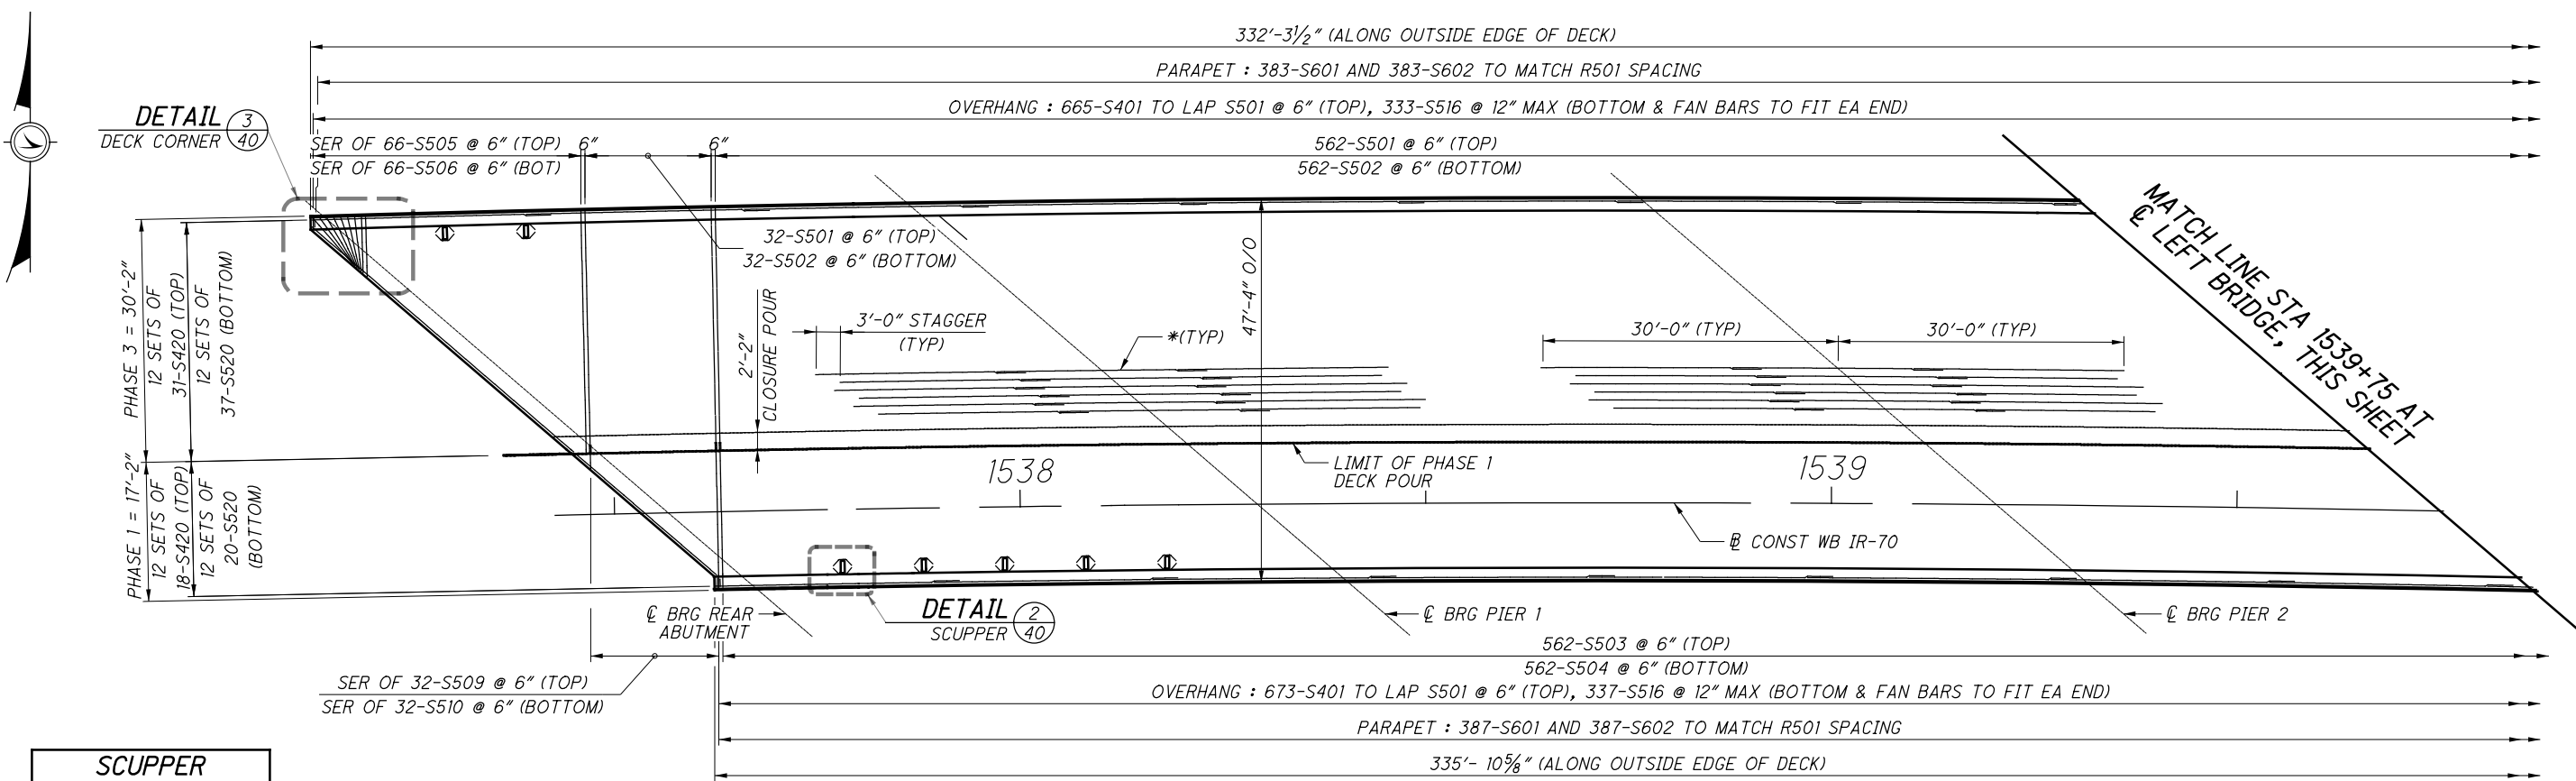

SCUPPER LOCATION TABLE

STATION	OFFSET
1537+30	36.00' LT
1537+40	36.00' LT
1537+78	8.00' RT
1537+88	8.00' RT
1537+98	8.00' RT
1538+08	8.00' RT
1538+18	8.00' RT

OFFSET MEASURED FROM \varnothing TO GUTTER LINE

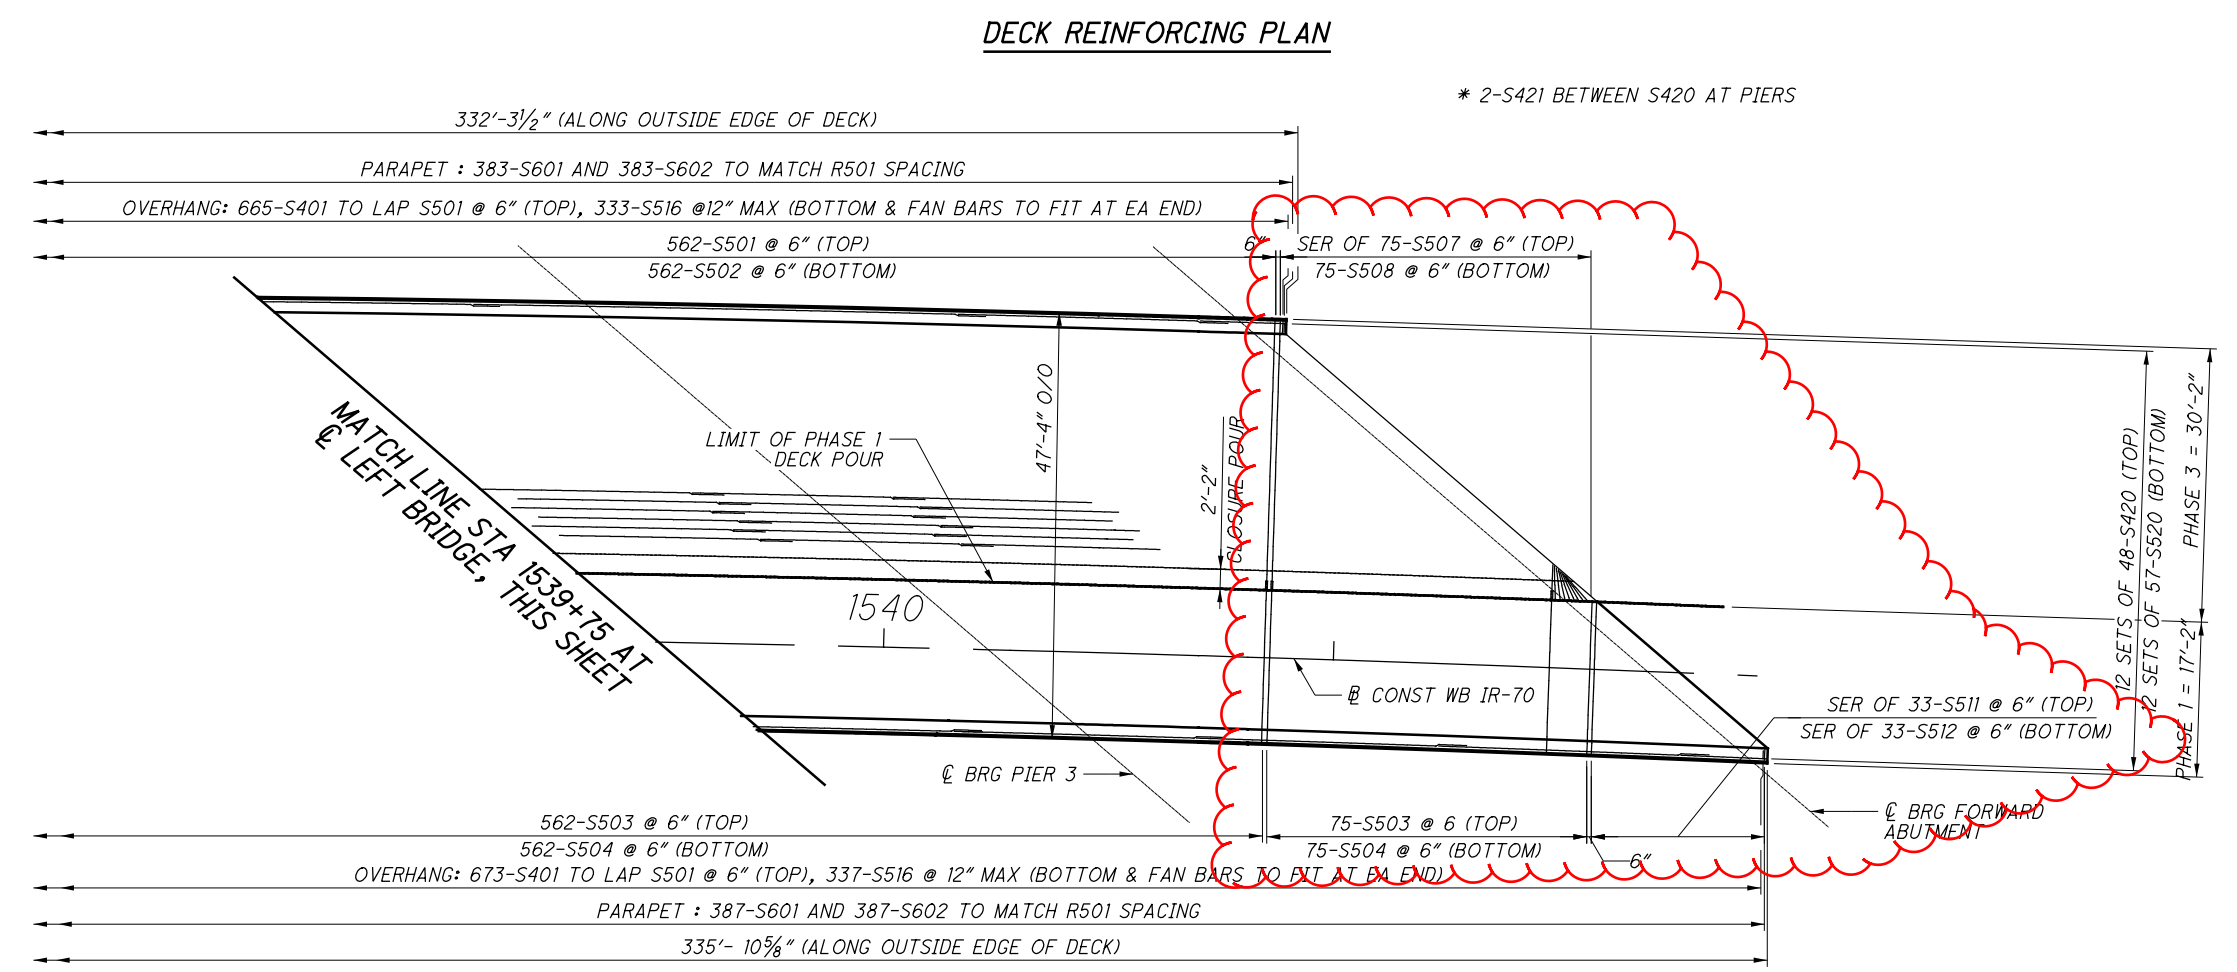

DECK REINFORCING PLAN (CONTINUATION)

DECK REINFORCING PLAN
 BRIDGE NO. MUS-70-1066L
 OVER LICKING ROAD & CUOH RAILROAD

MUS-70-10.49
 PID No. 93006

DESIGN AGENCY
Gannett Fleming
 ENGINEERS & ARCHITECTS, P.C.
 2500 CORPORATE EXCHANGE DRIVE SUITE 230
 COLUMBUS, OHIO 43231

DATE
 12/2020

REVIEWED
 CTM

DRAWN
 EBP

CHECKED
 DF

STRUCTURE FILE NUMBER
 6002641

39 / 54

1326
 2231

Mark	NUMBER			LENGTH	WEIGHT			TYPE	DIMENSIONS				
	Phase 1	Phase 3	TOTAL		Phase 1	Phase 3	TOTAL		A	B	C	D	INC
REAR ABUTMENT													
RAL500	7		7	23'-10"	175		175	STR.					
RAL501	8		8	13'-10"	116		116	STR.					
	2		2	4'-3"									
RAL502	SER OF		SER OF	to	76		76	STR.				3'-2 1/4"	
	4		4	13'-10"									
RAL503	2		2	11'-0"	23		23	STR.					
RAL504	6		6	25'-6"	160		160	STR.					
	1		1	12'-0"									
RAL505	SER OF		SER OF	to	60		60	STR.				1'-6"	
	4		4	16'-6"									
RAL506	4		4	10'-0"	42		42	19	5'-10"	2'-11"	2'-11"		
RAL507	6		6	7'-7"	48		48	9	1'-0"	1'-0"	3'-9"	2'-8"	
RAL508		7	7	21'-2"		155	155	STR.					
RAL509		8	8	17'-1"		143	143	STR.					
		2	2	5'-6"									
RAL510	SER OF		SER OF	to	95		95	STR.				3'-10 1/4"	
	4		4	17'-1"									
RAL511	2		2	13'-0"		28	28	STR.					
RAL512	12		12	24'-0"		301	301	STR.					
RAL513	8		8	23'-0"		192	192	STR.					
RAL514	4		4	10'-2"		43	43	19	6'-0"	2'-11"	2'-11"		
RAL515	6		6	5'-6"		35	35	9	1'-0"	1'-0"	1'-8"	2'-8"	
RAL600	22	18	40	17'-0"	562	460	1,022	3	5'-8"	2'-7"			
RAL601	11	15	26	20'-0"	331	451	782	2	9'-1"	2'-2"	9'-1"		
	1		1	4'-4"					1'-3"		1'-3"		
RAL602	SER OF		SER OF	to	116		116	2	to	2'-2"	to	8 3/4"	
	10		10	11'-0"					4'-7"		4'-7"		
	1		1	11'-0"						2'-2"			
RAL603	SER OF		SER OF	to	53		53	2	4'-7"	to	4'-7"	8"	
	3		3	12'-4"						3'-6"			
	1		1	4'-4"					1'-3"		1'-3"		
RAL604	SER OF		SER OF	to	127		127	2	to	2'-2"	to	8"	
	11		11	11'-0"					4'-7"		4'-7"		
	1		1	11'-0"						2'-2"			
RAL605	SER OF		SER OF	to	71		71	2	4'-7"	to	4'-7"	5 1/4"	
	4		4	12'-4"						3'-6"			
RAL700	14	44	58	7'-0"	200	630	830	STR.					
RAL701	11	3	14	19'-0"	427	117	544	2	7'-10"	3'-8"	7'-10"		
RAL702	26	48	74	12'-8"	673	1,243	1,916	2	4'-8"	3'-8"	4'-8"		
RAL800	5		5	23'-10"	319		319	STR.					
RAL801	5		5	25'-6"	341		341	STR.					
RAL802		5	5	21'-2"		283	283	STR.					
RAL803		10	10	25'-3"		675	675	STR.					
				SUB-TOTAL	3,722	5,049	8,771						
REAR DIAPHRAGM													
RDL500	15	28	43	9'-9"	153	285	438	2	2'-6"	4'-11"	2'-6"		
RDL501	30	56	86	11'-2"	350	652	1,002	2	2'-11 1/2"	5'-6"	2'-11 1/2"		
RDL800	7		7	18'-4"	343		343	1	1'-6"	17'-0"			
RDL801	7		7	6'-1"	114		114	1	1'-6"	4'-9"			
RDL802	2		2	8'-6"	46		46	STR.					
RDL803	9		9	25'-5"	611		611	STR.					
RDL804	10		10	8'-6"	227		227	18	5'-0"	1'-11"	1'-9"		
RDL805		20	20	25'-10"		1,380	1,380	STR.					
RDL806		12	12	22'-11"		735	735	STR.					
RDL807		12	12	5'-0"		161	161	1	1'-0"	4'-2"			
RDL808	18	31	49	5'-2"	248	428	676	18	2'-3"	1'-4 3/4"	1'-4 3/4"		
				SUB-TOTAL	2,092	3,641	5,733						

= BAR WITH MECHANICAL CONNECTOR

REINFORCING LIST 02
 BRIDGE NO. MUS-70-1066L
 OVER LICKING ROAD & CUOH RAILROAD

MUS-70-10.49
 PID No. 93006

53 / 54

1340
2231

DESIGN AGENCY
Gannett Fleming
 ENGINEERS & ARCHITECTS, P.C.
 2800 CORPORATE EXCHANGE DRIVE, SUITE 230
 COLUMBUS, OHIO 43231

DATE
12/2020

REVIEWED
CTM

DRAWN
MZ

DESIGNED
MZ


STRUCTURE FILE NUMBER
6002641

CHECKED
JC

REVISED

SUBMITTAL: Stage 3
 PID: 93006
 PLOT DRIVER: 000Tcodd_PDF.pltcf9
 PENTABLE: 93006_000TY81_Pen.tbl
 dw: \\snet-pw-001\pwworkspace\pwworkspace\Projects\6471193006\40-Engineering-Gannett Fleming\Structures\MUS070-1066\Sheets\063_s1003_4/9/2021 9:13:48 AM cmarburger

Mark	NUMBER			LENGTH	WEIGHT			TYPE	DIMENSIONS				
	Phase 1	Phase 3	TOTAL		Phase 1	Phase 3	TOTAL		A	B	C	D	INC
FORWARD ABUTMENT													
FAL500	7		7	21'-9"	159		159	STR.					
FAL501	8		8	16'-6"	138		138	STR.					
FAL502	SER OF		SER OF	to	94		94	STR.					3'-6 1/2"
FAL503	2		2	5'-10"									
FAL504	6		6	27'-6"	173		173	STR.					
FAL505	SER OF		SER OF	to	91		91	STR.					1'-8"
FAL506	4		4	9'-9"	41		41	19	5'-7"	2'-11"	2'-11"		
FAL507	6		6	5'-10"	37		37	9	1'-0"	1'-0"	2'-0"	2'-8"	
FAL508		7	7	24'-10"		182	182	STR.					
FAL509		8	8	14'-10"		124	124	STR.					
FAL510	SER OF		SER OF	to		58	58	STR.					1'-10"
FAL511	4		4	9'-7"									
FAL512	2		2	14'-10"		31	31	STR.					
FAL513	12		12	26'-6"		332	332	STR.					
FAL514	8		8	19'-0"		159	159	STR.					
FAL515	4		4	10'-6"		44	44	19	6'-4"	2'-11"	2'-11"		
FAL515	6		6	7'-8"		48	48	9	1'-0"	1'-0"	3'-10"	2'-8"	
FAL600	18	23	41	17'-0"	460	587	1,047	3	5'-8"	2'-7"			
FAL601	14	15	29	22'-6"	474	507	981	2	10'-4"	2'-2"	10'-4"		
FAL602	SER OF		SER OF	to	116		116	2	to	2'-2"	to		8 3/4"
FAL603	SER OF		SER OF	to	71		71	2	4'-7"	to	4'-7"		5 1/4"
FAL604	SER OF		SER OF	to		112	112	2	to	2'-2"	to		11 3/4"
FAL605	SER OF		SER OF	to		57	57	2	5'-0"	to	5'-0"		8"
FAL700	24	36	60	7'-7"	372	559	931	STR.					
FAL701	4	9	13	19'-4"	158	356	514	2	8'-0"	3'-8"	8'-0"		
FAL702	29	46	75	14'-2"	840	1,332	2,172	2	5'-5"	3'-8"	5'-5"		
FAL800	5		5	21'-9"	291		291	STR.					
FAL801	5		5	28'-0"	374		374	STR.					
FAL802		5	5	24'-9"		331	331	STR.					
FAL803		10	10	25'-1"		670	670	STR.					
SUB-TOTAL					3,913	5,489	9,402						
FORWARD DIAPHRAGM													
FDL500	15	29	44	9'-9"	153	295	448	2	2'-6"	4'-11"	2'-6"		
FDL501	30	58	88	11'-2"	349	676	1,025	2	2'-11 1/2"	5'-6"	2'-11 1/2"		
FDL800	7		7	20'-0"	374		374	1	1'-6"	18'-8"			
FDL801	7		7	6'-7"	124		124	1	1'-6"	5'-3"			
FDL802	2		2	9'-0"	49		49	STR.					
FDL803	9		9	27'-4"	657		657	STR.					
FDL804	10		10	8'-6"	227		227	18	5'-0"	1'-11"	1'-9"		
FDL805		20	20	26'-9"		1,429	1,429	STR.					
FDL806		12	12	22'-6"		721	721	STR.					
FDL807		12	12	5'-0"		161	161	1	1'-0"	4'-2"			
FDL808	19	34	53	5'-2"	262	470	732	18	2'-3"	1'-4 3/4"	1'-4 3/4"		
SUB-TOTAL					2,195	3,752	5,947						
TOTAL ALL REINFORCING					72,730	107,642	180,372						

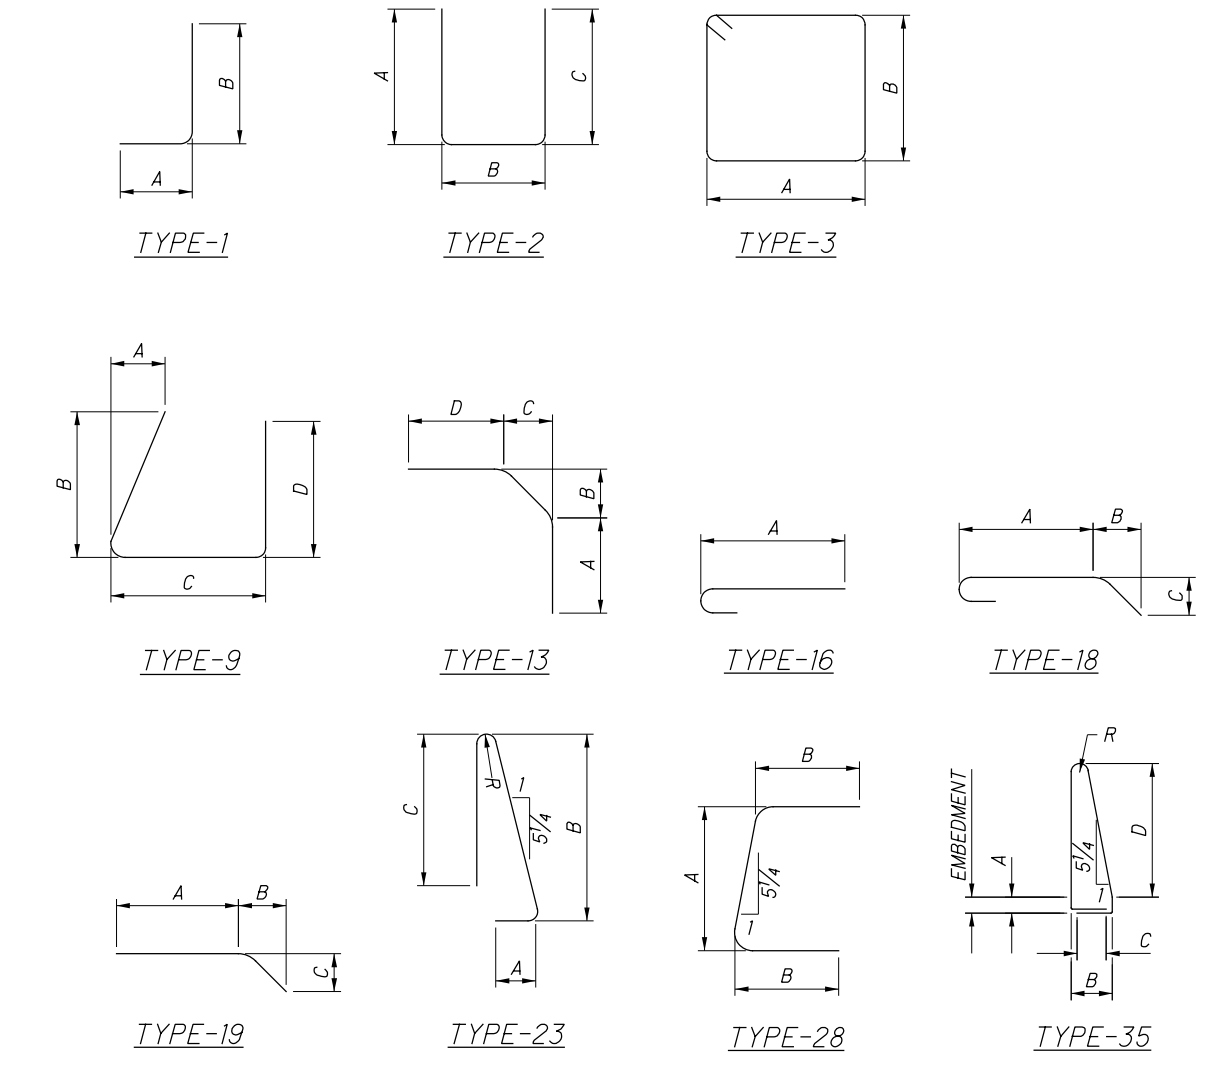

= BAR WITH MECHANICAL CONNECTOR

REINFORCING LIST 03
 BRIDGE NO. MUS-70-1066L
 OVER LICKING ROAD & CUOH RAILROAD
MUS-70-10.49
 PID No. 93006
 54 / 54
 1341
 2231

DESIGN AGENCY
Gannett Fleming
 ENGINEERS & ARCHITECTS, P.C.
 2800 CORPORATE EXCHANGE DRIVE, SUITE 230
 COLUMBUS, OHIO 43231

DATE
 12/2020
 REVIEWED
 CTM
 STRUCTURE FILE NUMBER
 6002641

DRAWN
 MZ
 REVISIONS

DESIGNED
 MZ
 CHECKED
 JC

MUS-70-1066R BRIDGE SUMMARY - 02/IMS/BR

CALC: MMZ

CHECK: CTM

ITEM	ITEM EXT.	TOTAL QUANTITY	TOTAL PER PHASE			UNIT	DESCRIPTION	PHASE 1			PHASE 2			GENERAL	APP/REF SHEET NO.
			PH 1	PH 2	GEN			ABUT.	PIERS	SUPER	ABUT.	PIERS	SUPER		
202	11003	LS			LS		STRUCTURE REMOVED, OVER 20 FOOT SPAN, AS PER PLAN						LS	4	
202	22900	228	78	150		SY	APPROACH SLAB REMOVED	78			150				
503	11101	LS			LS		COFFERDAMS AND EXCAVATION BRACING, AS PER PLAN						LS	5	
503	21301	LS	LS	LS			UNCLASSIFIED EXCAVATION, AS PER PLAN	LS			LS			5	
505	11100	LS			LS		PILE DRIVING EQUIPMENT MOBILIZATION						LS		
507	00600	1,050	500	550		FT	14" CAST-IN-PLACE REINFORCED CONCRETE PILES, DRIVEN	500			550				
507	00650	1,190	570	620		FT	14" CAST-IN-PLACE REINFORCED CONCRETE PILES, FURNISHED	570			620				
509	10001	178,208	71,416	106,792		LB	EPOXY COATED REINFORCING STEEL, AS PER PLAN	7,612		63,804	10,181		96,611	5	
509	20001	300			300	LB	REINFORCING STEEL, REPLACEMENT OF EXISTING REINFORCING STEEL, AS PER PLAN						300	5	
510	10001	108	34	74		EACH	DOWEL HOLES WITH NONSHRINK, NONMETALLIC GROUT, AS PER PLAN	34			74			5	
511	33500	2	2			EACH	SEMI-INTEGRAL DIAPHRAGM GUIDE	2							
511	34447	553	206	346		CY	CLASS QC2 CONCRETE WITH QC/QA, BRIDGE DECK, AS PER PLAN			206			346	5	
511	34451	117	58	58		CY	CLASS QC2 CONCRETE WITH QC/QA, BRIDGE DECK (PARAPET), AS PER PLAN			58			58	5	
511	44112	168	70	99		CY	CLASS QC1 CONCRETE WITH QC/QA, ABUTMENT NOT INCLUDING FOOTING	70			99				
511	46512	61	31	29		CY	CLASS QC1 CONCRETE WITH QC/QA, FOOTING	31			29				
512	10050	909	444	465		SY	SEALING OF CONCRETE SURFACES (NON-EPOXY)	62		382	82		383		
512	10300	73		73		SY	SEALING CONCRETE BRIDGE DECKS WITH HMWM RESIN						73		
512	10601	50			50	FT	CONCRETE REPAIR BY EPOXY INJECTION, AS PER PLAN						50	5	
512	33000	64	26	38		SY	TYPE 2 WATERPROOFING	26			38				
513	10260	512,447	212,046	300,401		LB	STRUCTURAL STEEL MEMBERS, LEVEL 3			212,046			300,401		
513	20000	6,951	2,979	3,972		EACH	WELDED STUD SHEAR CONNECTORS			2,979			3,972		
514	00061	26,269	11,173	15,096		SF	FIELD PAINTING STRUCTURAL STEEL, INTERMEDIATE COAT, AS PER PLAN			11,173			15,096	5	
514	00067	26,269	11,173	15,096		SF	FIELD PAINTING STRUCTURAL STEEL, FINISH COAT, AS PER PLAN			11,173			15,096	5	
514	10000	22	9	13		EACH	FINAL INSPECTION REPAIR			9			13		
516	13901	79	40	39		SF	2" PREFORMED EXPANSION JOINT FILLER, AS PER PLAN			40			39	5	
516	14020	180	71	109		FT	SEMI-INTEGRAL ABUTMENT EXPANSION JOINT SEAL			71			109		
516	14600	142	51	91		FT	STRUCTURAL JOINT OR JOINT SEALER, MISC.: EMSEAL WITH SLEEPER SLAB	51			91			50	
516	44101	28	12	16		EACH	ELASTOMERIC BEARING WITH INTERNAL LAMINATES AND LOAD PLATE (NEOPRENE), AS PER PLAN , DIMENSIONS VARY	6	6		8	8		30	
516	46900	7	3	4		EACH	BEARING DEVICE, MISC.: SEISMIC ISOLATION BEARING		3			4		31	
518	12200	7	2	5		EACH	SCUPPERS, INCLUDING SUPPORTS	2			5				
518	21200	128	52	76		CY	POROUS BACKFILL WITH GEOTEXTILE FABRIC	52			76				
518	40000	194	88	105		FT	6" PERFORATED CORRUGATED PLASTIC PIPE	88			105				
518	40010	60	30	30		FT	6" NON-PERFORATED CORRUGATED PLASTIC PIPE, INCLUDING SPECIALS	30			30				
519	11101	70			70	SF	PATCHING CONCRETE STRUCTURE, AS PER PLAN						70	5	
523	20001	8	4	4		EACH	DYNAMIC LOAD TESTING, AS PER PLAN	4			4			5	
523	20501	8	4	4		EACH	RESTRIKE, AS PER PLAN	4			4			5	
526	30010	316	114	201		SY	REINFORCED CONCRETE APPROACH SLABS WITH QC/QA (T=17")	114			201				
SPECIAL	53000200	LS			LS		STRUCTURES - MEASUREMENTS FOR PROPOSED BEARINGS						LS	6	
601	20000	1,022			1,022	SY	CRUSHED AGGREGATE SLOPE PROTECTION						1,022		
607	39900	340	170	170		FT	VANDAL PROTECTION FENCE, 6' STRAIGHT, COATED FABRIC			170			170		
613	41201	333	128	205		CY	LOW STRENGTH MORTAR BACKFILL, AS PER PLAN	128			205			5	

DESIGN AGENCY
Gannett Fleming
ENGINEERS & ARCHITECTS, P.C.
2800 CORPORATE EXCHANGE DRIVE SUITE 230
COLUMBUS, OHIO 43231

DATE
12/2020
REVIEWED
CTM
STRUCTURE FILE NUMBER
6002676


DRAWN
LAM
REVISOR
MMZ
CHECKED
DF

BRIDGE SUMMARY
BRIDGE NO. MUS-70-1066R
OVER LICKING ROAD & CUOH RAILROAD


MUS-70-10.49
PID No. 93006

SUBMITTAL: Stage 3
PID: 93006
PLOT DRIVER: 000Tcodd_PDF.pltcfgr
PENTABLE: 93006-000TV81_Pen.tbl
pw:\gfnnet-pw.bentley.com\gfnnet-pw-0\Documents\Projects\6477\93006\40-Engineering-GannettFleming\Structures\MUS070_1066R\Sheets\006_sq001_4/9/2021 9:52:29 AM modonnell

SUBMITTAL: Stage 3
 PLOT DRIVER: 000Tcodd_PDF.pltcf9
 PENTABLE: 93006_0001V81_Pen.tbl
 pw:\gtnet-pw.bentley.com\gtnet-pw-01\Documents\Projects\6477\93006\401-Engineering-GannettFleming\Structures\MUS070_1066R\Sheets\021sr002 4/8/2021 3:19:25 PM cmarburger

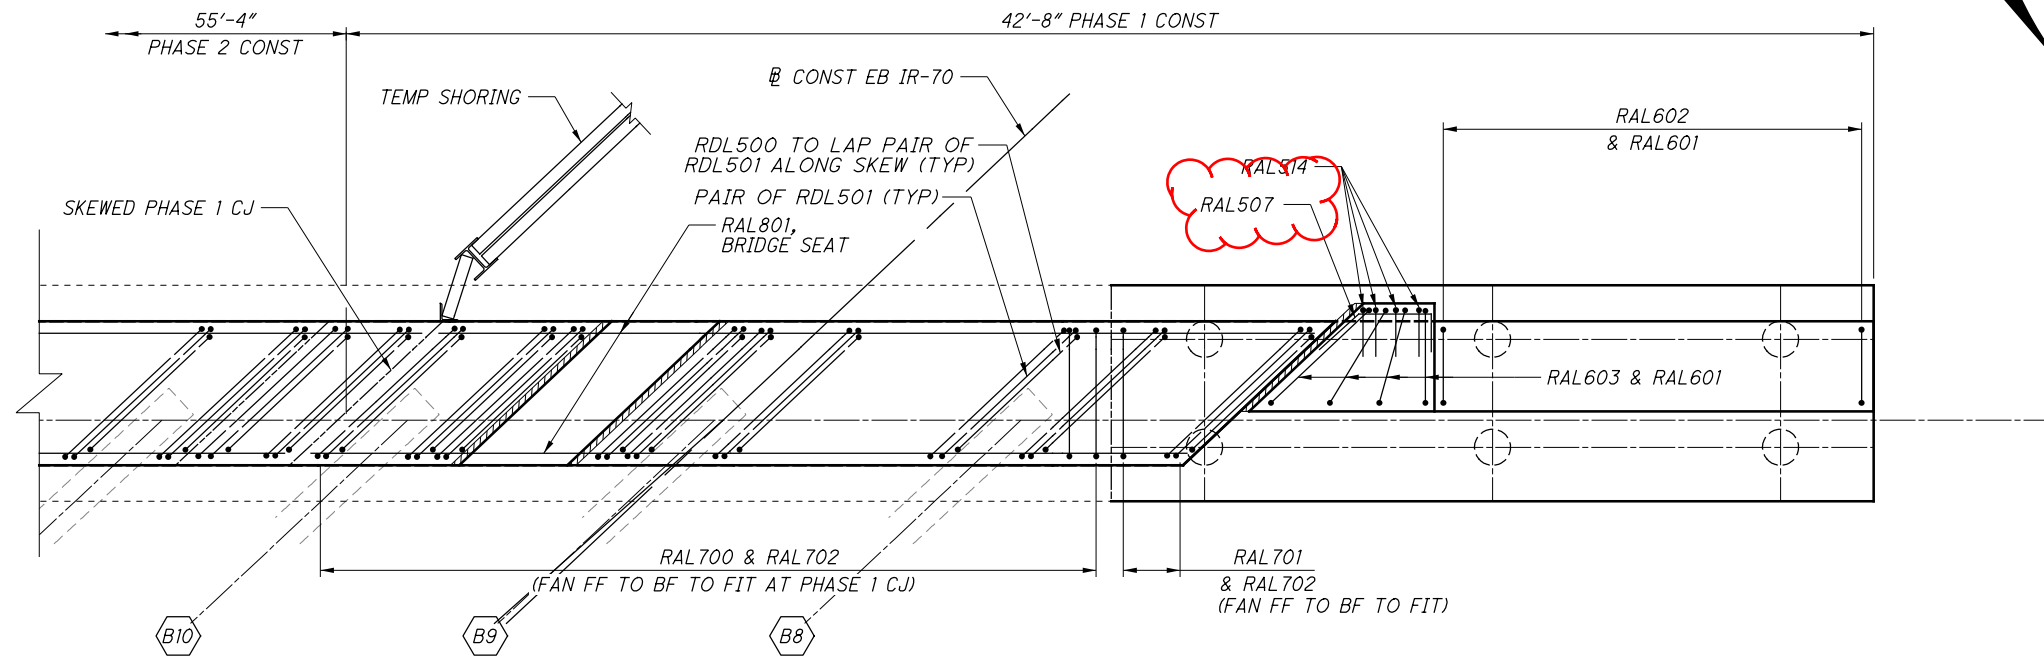


REAR ABUTMENT PHASE 1 PLAN

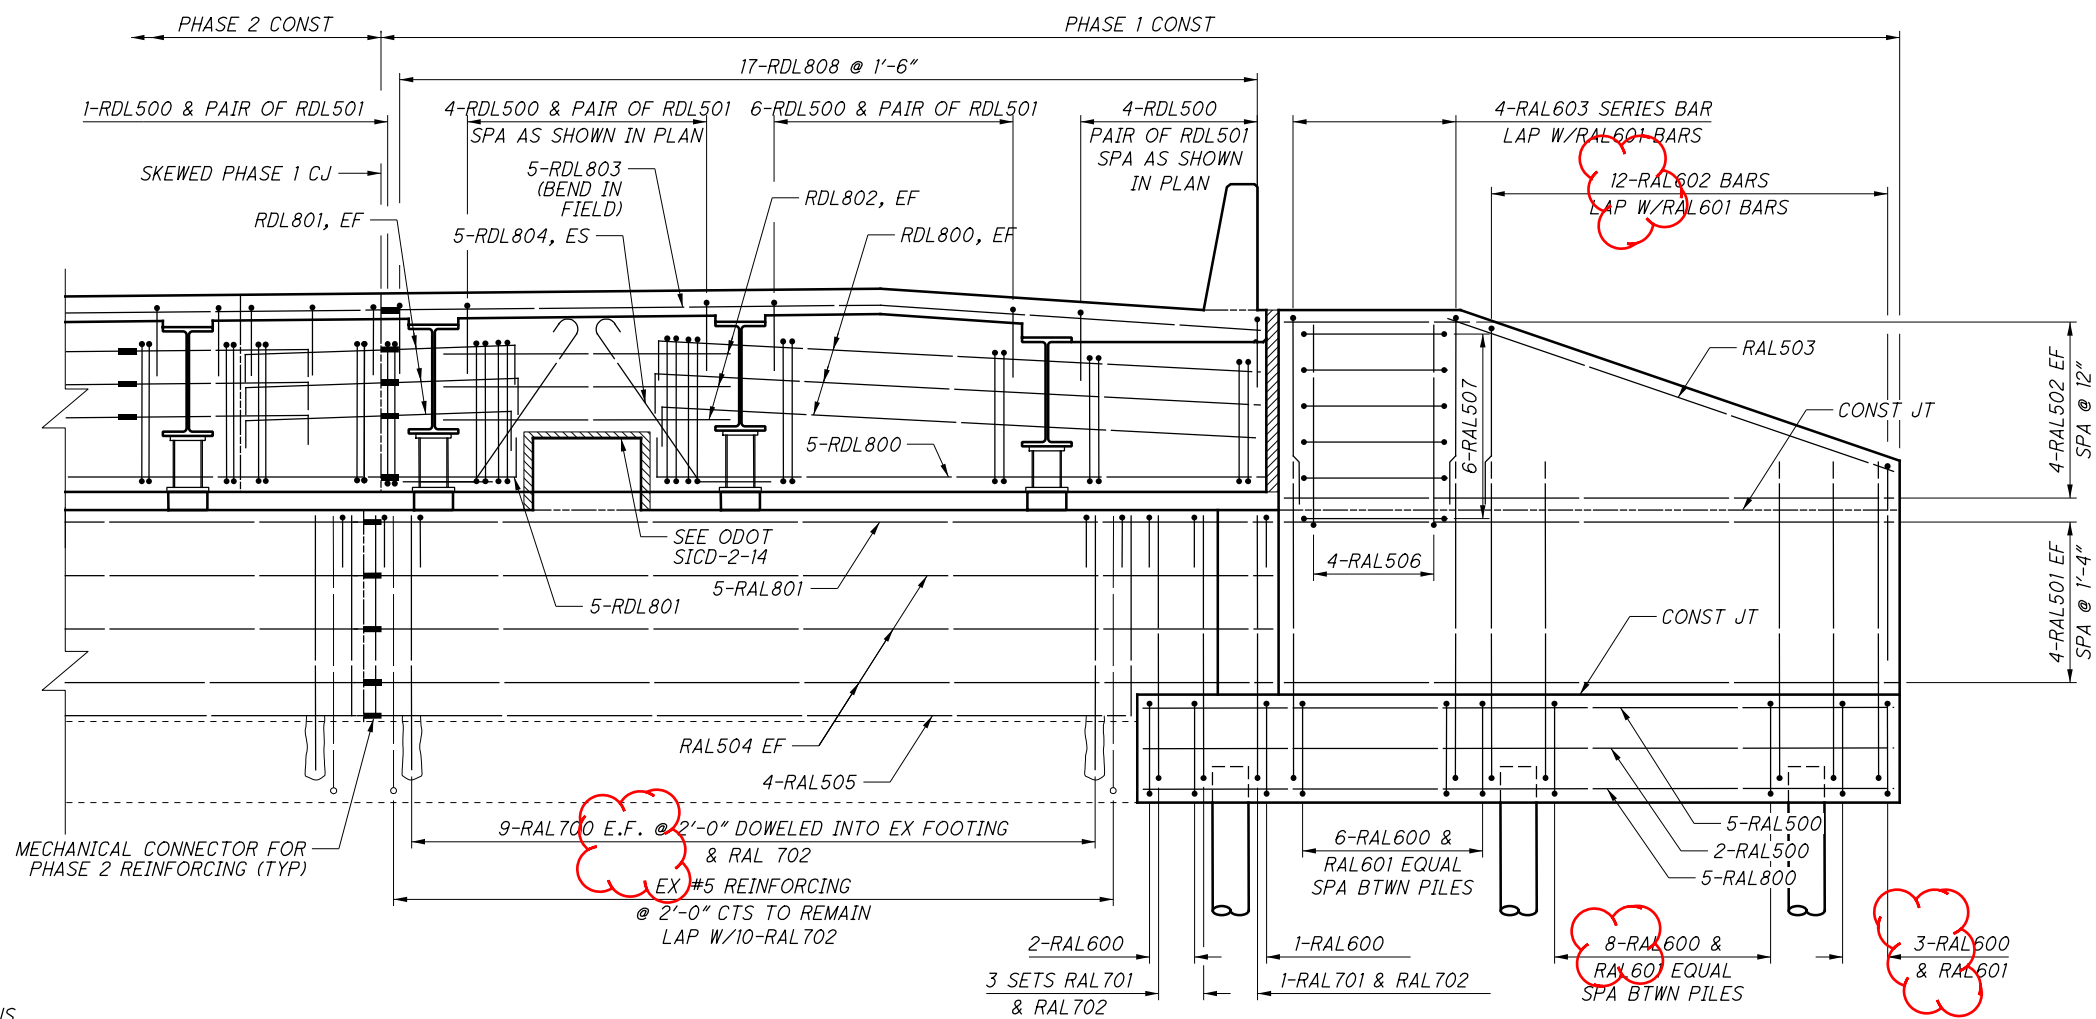



REAR ABUTMENT PHASE 1 ELEVATION
 DECK REINFORCEMENT NOT SHOWN FOR CLARITY

NOTES

1. SEE SHEET 18 | 53 FOR ABUTMENT DETAILS AND SECTIONS.
2. SEE SHEET 12 | 53 FOR FOUNDATION PLAN.
3. SEE SHEET 38 | 53 FOR TRANSVERSE SECTION.
4. ASSUME 2" CLEAR COVER UNLESS NOTED OTHERWISE.

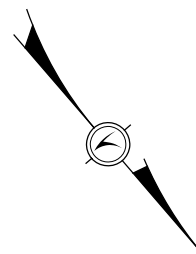

MUS-70-10.49 PID No. 93006	REAR ABUTMENT PHASE 1 BRIDGE NO. MUS-70-1066R OVER LICKING ROAD & CUOH RAILROAD	DESIGN AGENCY Gannett Fleming ENGINEERS & ARCHITECTS, P.C. 2500 CORPORATE EXCHANGE DRIVE, SUITE 230 COLUMBUS, OHIO 43231
DESIGNED JGC	DRAWN LAM	REVIEWED CTM
CHECKED DF	REVISIONS	DATE 12/2020
STRUCTURE FILE NUMBER 6002676		FILE NUMBER 6002676
16 / 53		1357 2231

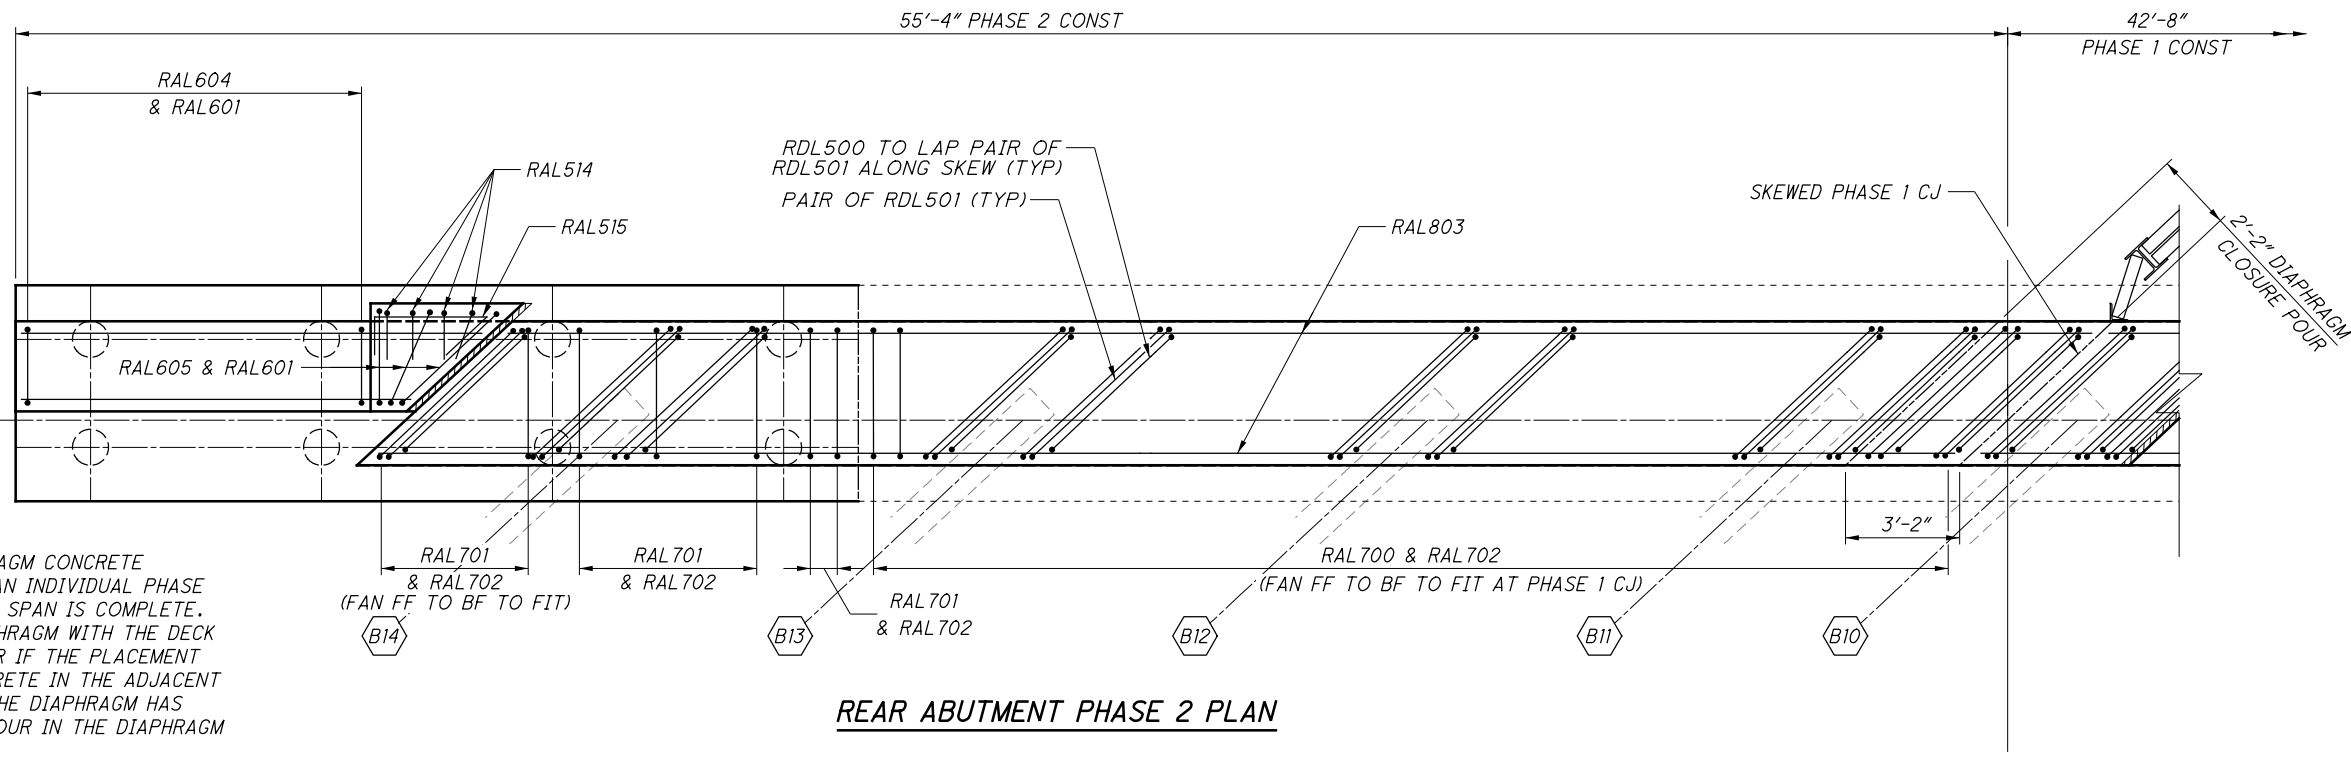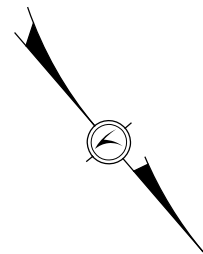


NOTES:

1. IN EACH INDIVIDUAL PHASE, PLACE THE DIAPHRAGM CONCRETE ENCASING THE STRUCTURAL MEMBER ENDS OF AN INDIVIDUAL PHASE AFTER THE DECK PLACEMENT IN THE ADJACENT SPAN IS COMPLETE. PROCEDURES THAT PLACE THE ABUTMENT DIAPHRAGM WITH THE DECK CONCRETE MAY BE APPROVED BY THE ENGINEER IF THE PLACEMENT SUBMITTAL CAN ASSURE THAT THE DECK CONCRETE IN THE ADJACENT SPAN WILL BE PLACED BEFORE CONCRETE IN THE DIAPHRAGM HAS REACHED ITS INITIAL SET. PLACE CLOSURE POUR IN THE DIAPHRAGM AND DECK CONCURRENTLY.

2. SEE SHEET 22153 FOR ADDITIONAL NOTES.

REAR ABUTMENT PHASE 2 PLAN

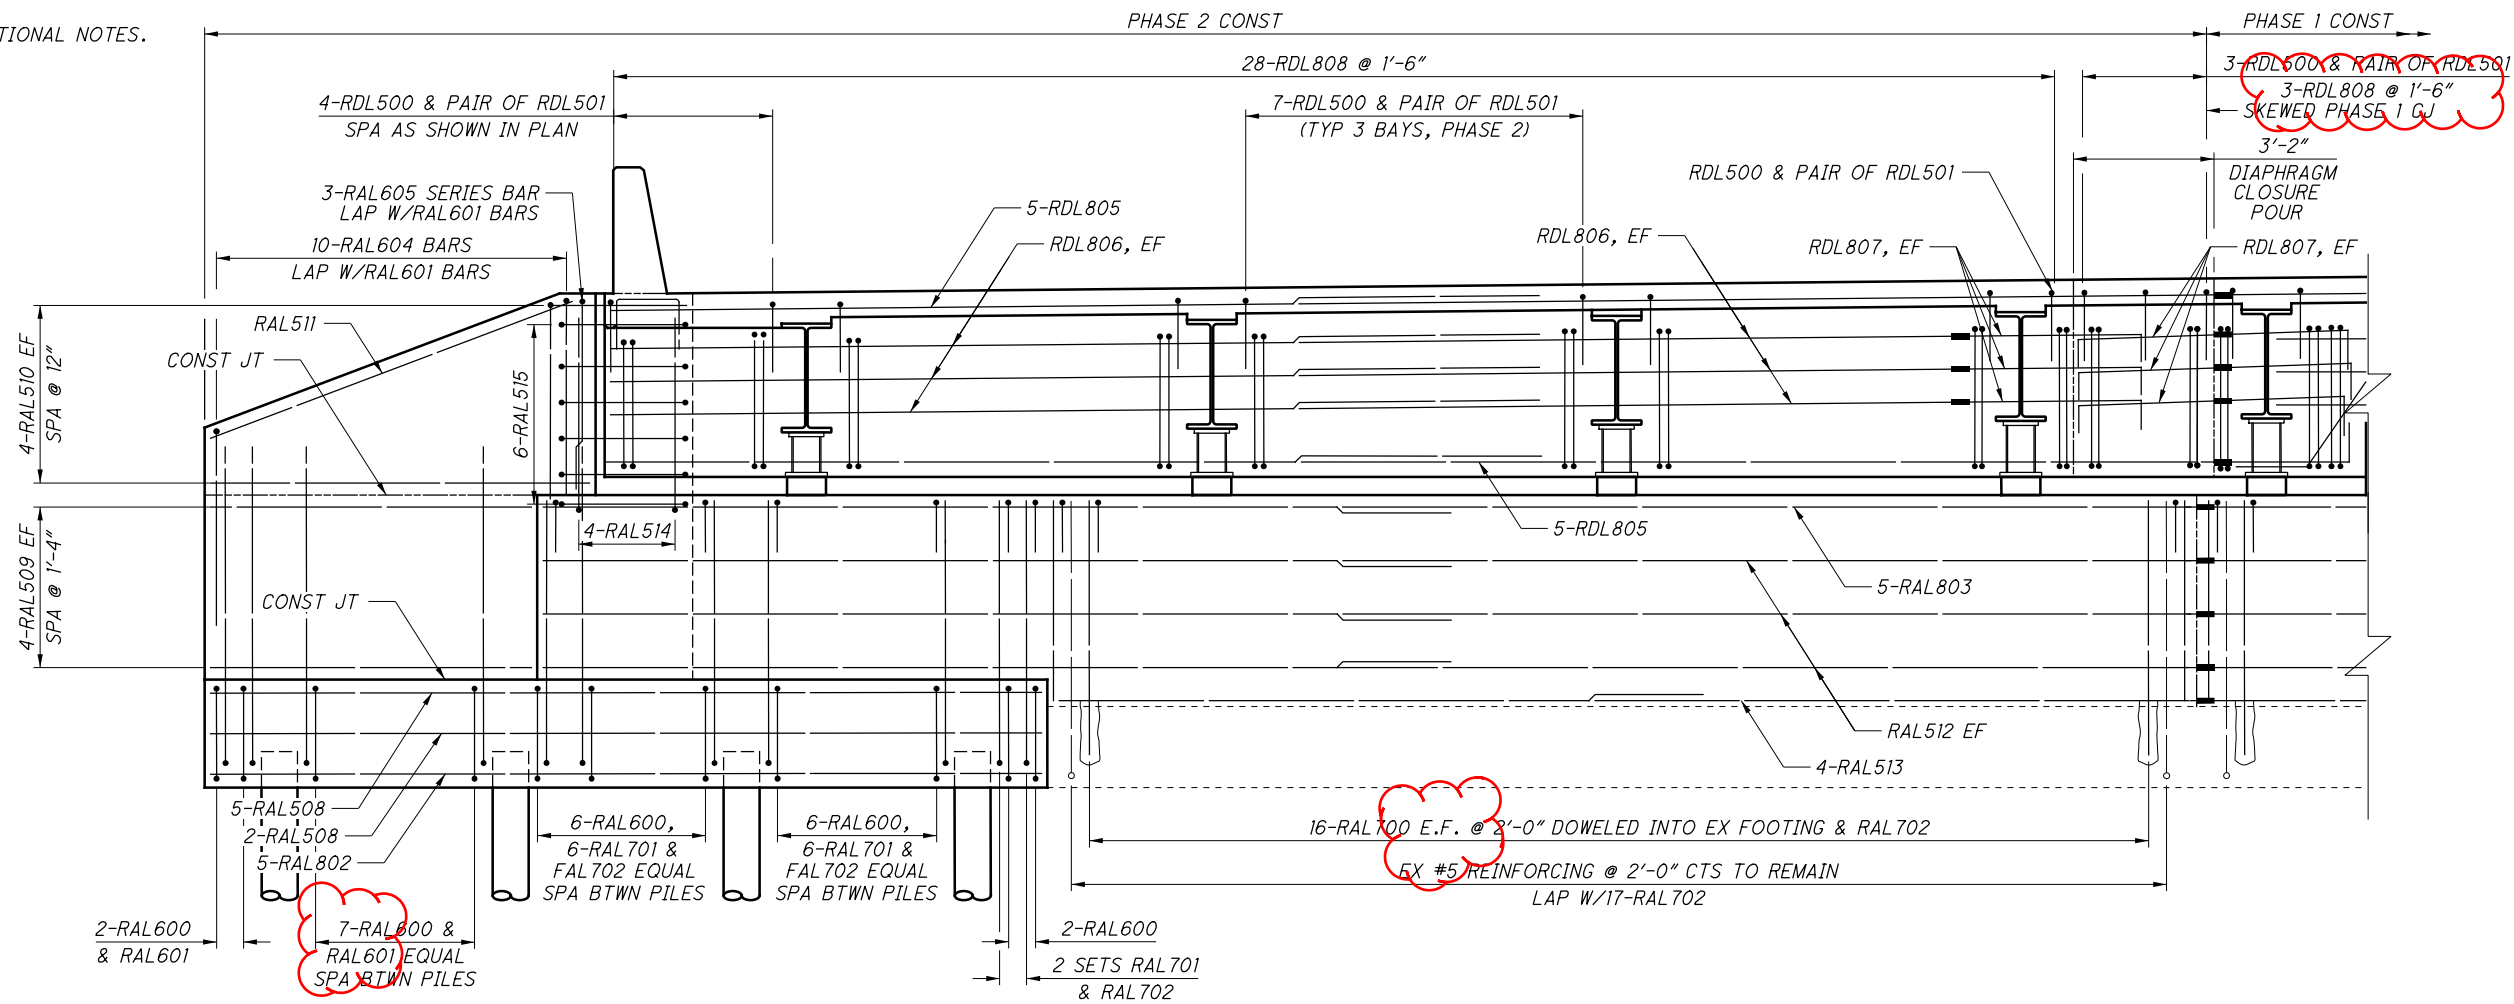


REAR ABUTMENT PHASE 2 ELEVATION
DECK REINFORCEMENT NOT SHOWN FOR CLARITY


SUBMITTAL: Stage 3
 PLOT DRIVER: 000Tcodd_PDF.pltcf9
 PENTABLE: 93006_0001V81_Pen.tbl
 pw:\gfnnet-pw.bentley.com\gfnnet-pw-01\Documents\Projects\6477\93006_401-Engineering-GannettFleming\Structures\MUS070-1066R\Sheets\022_sr003_4/8/2021 3:19:42 PM cmarburger

Gannett Fleming ENGINEERS & ARCHITECTS, P.C. 2800 CORPORATE EXCHANGE DRIVE SUITE 230 COLUMBUS, OHIO 43231	
DESIGN AGENCY DATE: 12/2020 REVIEWED: CTM STRUCTURE FILE NUMBER: 6002676	DRAWN: LAM LAM REVISIONS: DF
REAR ABUTMENT PHASE 2 BRIDGE NO. MUS-70-1066R OVER LICKING ROAD & CUOH RAILROAD	
MUS-70-10.49 PID No. 93006	
17 / 53	
1358 2231	

SUBMITTAL: Stage 3
 PLOT DRIVER: 000Tcodd_PDF.pltcf9
 PENTABLE: 93006_000T181_Pen.tbl
 pw:\gtnet-pw.bentley.com\gtnet-pw-0\Documents\Projects\6477\93006\401-Engineering-GannettFleming\Structures\MUS070_1066R\Sheets\027_sf002_4/8/2021 3:21:01PM cmorburger

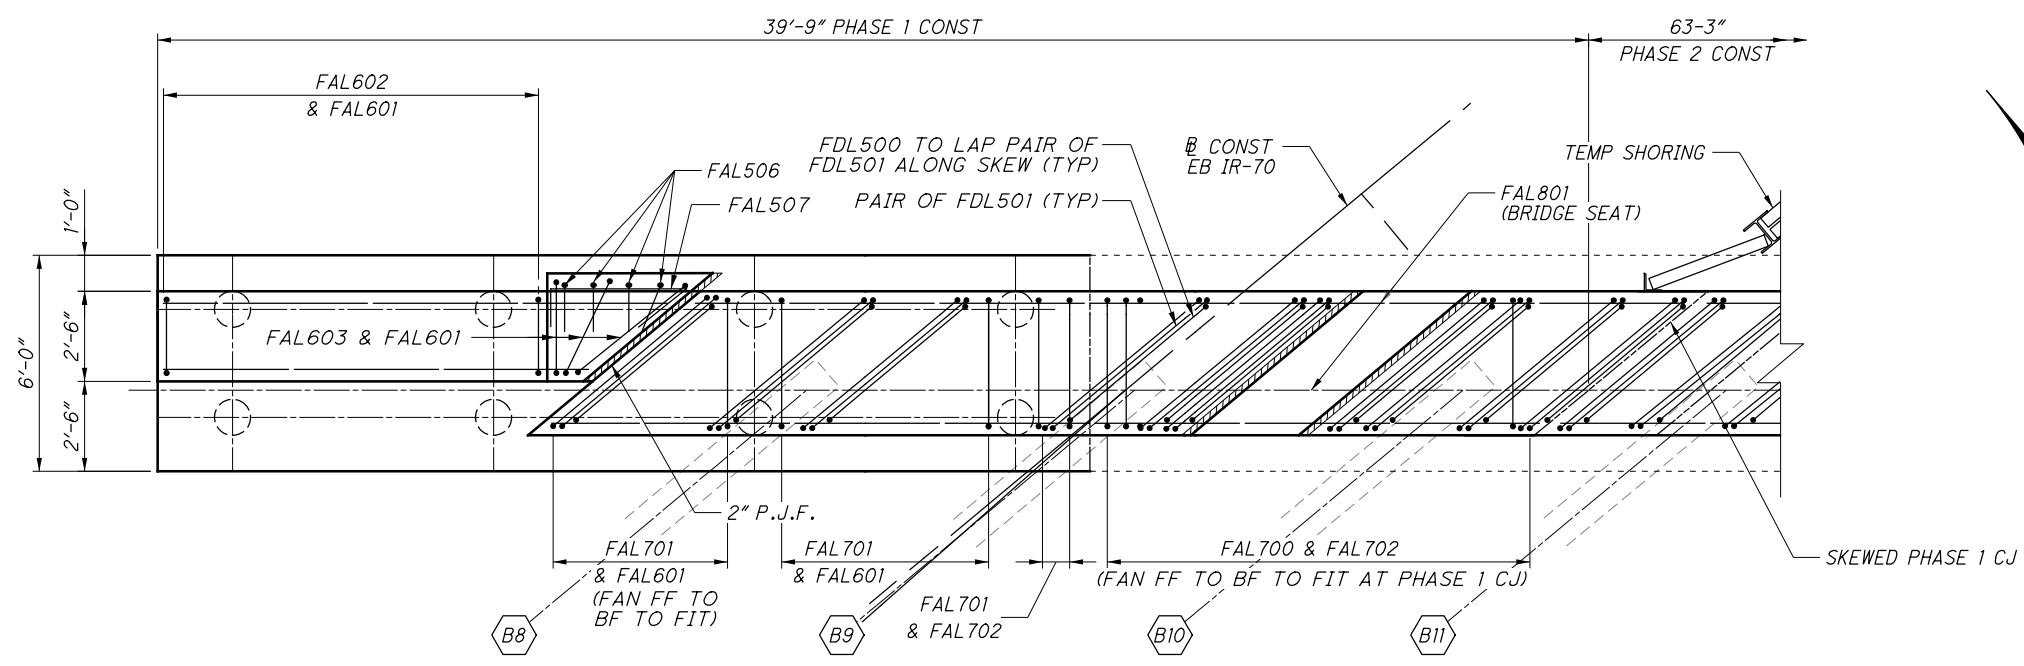

FORWARD ABUTMENT PHASE 1 PLAN

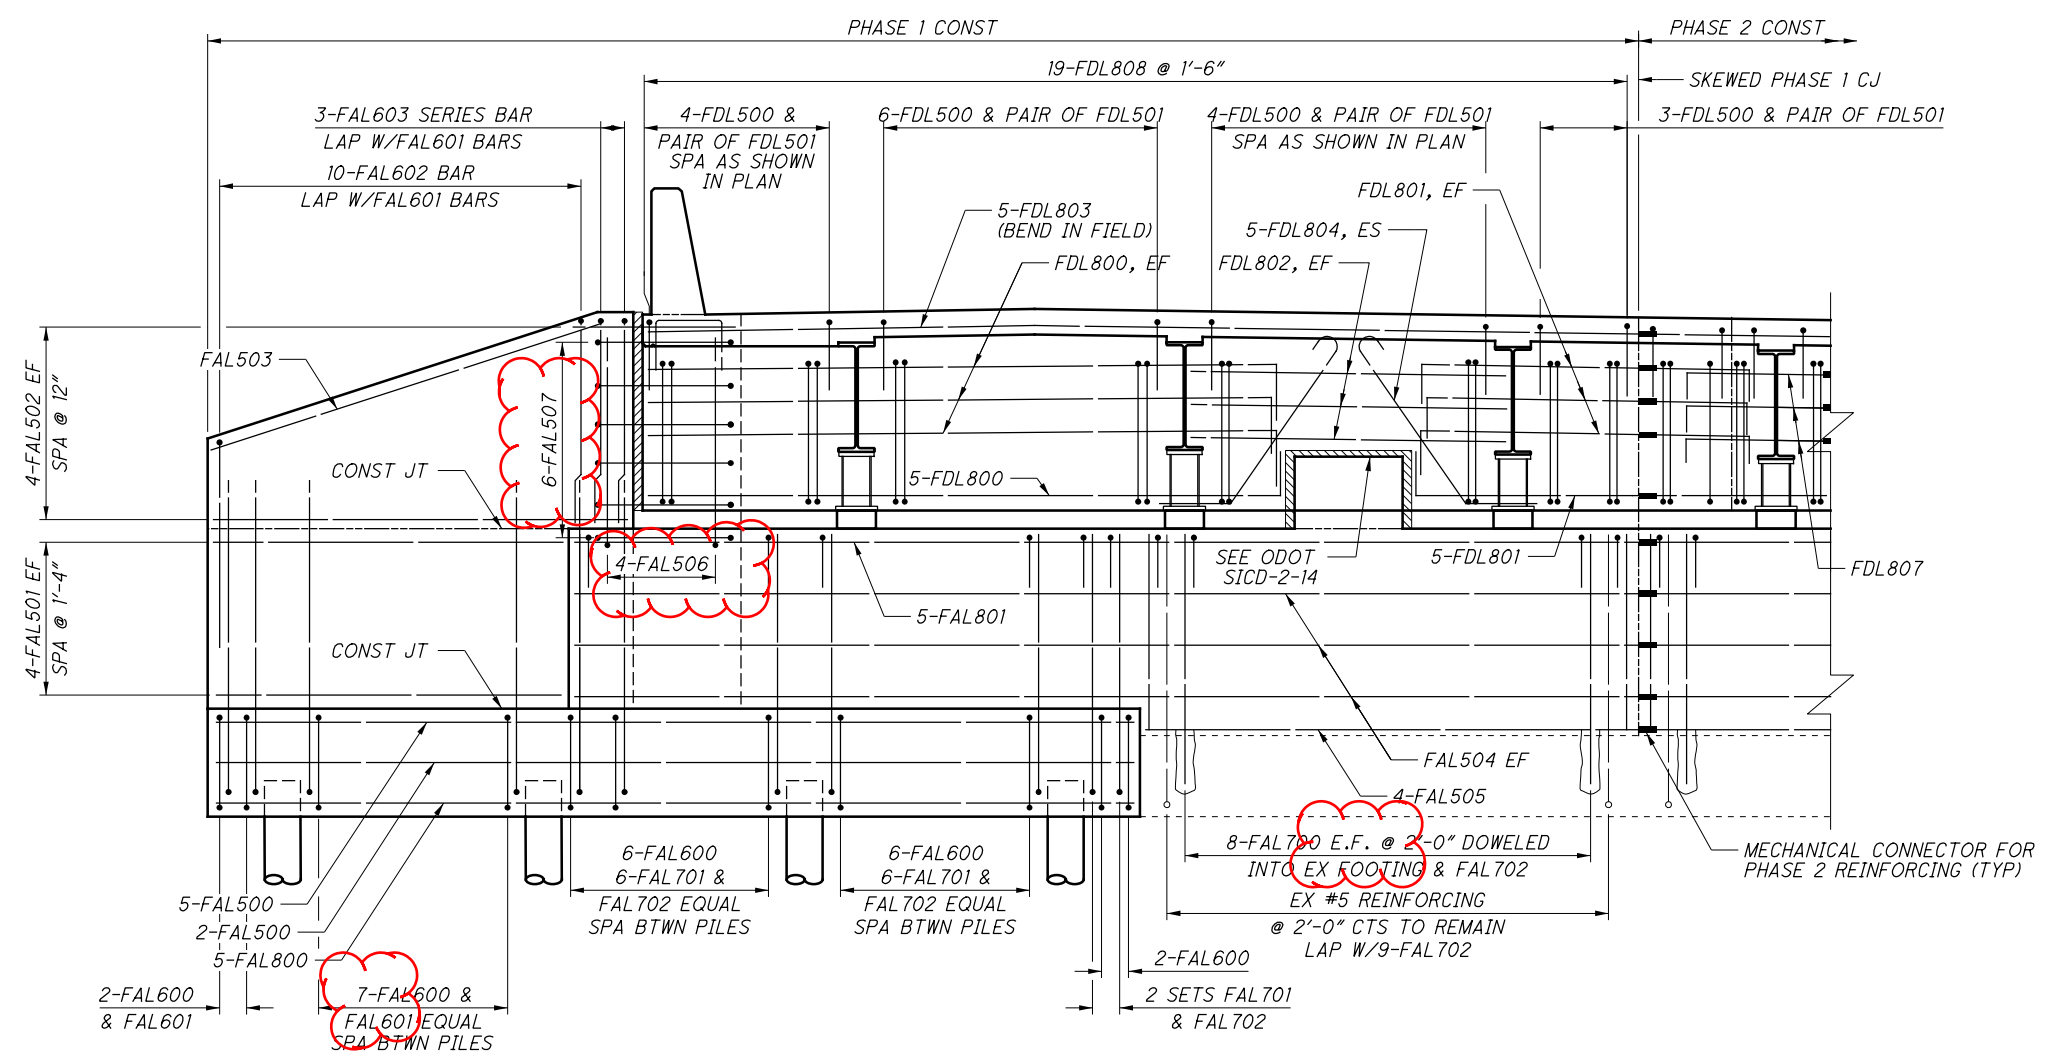


FORWARD ABUTMENT PHASE 1 ELEVATION
 DECK REINFORCEMENT NOT SHOWN FOR CLARITY

- NOTES**
1. SEE SHEET 24/53 FOR ABUTMENT DETAILS AND SECTIONS.
 2. SEE SHEET 13/53 FOR FOUNDATION PLAN.
 3. SEE SHEET 38/53 FOR TRANSVERSE SECTION.
 4. ASSUME 2" CLEAR COVER UNLESS NOTED OTHERWISE.

Gannett Fleming <small>ENGINEERS & ARCHITECTS, P.C. 2500 CORPORATE EXCHANGE DRIVE, SUITE 230 COLUMBUS, OHIO 43231</small>	<small>DESIGN AGENCY</small>
MUS-70-10.49 <small>BRIDGE NO. MUS-70-1066R OVER LICKING ROAD & CUOH RAILROAD</small>	<small>DATE</small> 12/2020
<small>DESIGNED</small> JGC	<small>REVIEWED</small> CTM
<small>CHECKED</small> DF	<small>STRUCTURE FILE NUMBER</small> 6002676
<small>DRAWN</small> LAM	<small>REVISED</small>


SUBMITTAL: Stage 3
 PLOT DRIVER: 000Tcodd_PDF.pltcf9
 PENTABLE: 93006_0001V81_Pen.tbl
 pw:\gfnnet-pw.bentley.com\gfnnet-pw-0\Documents\Projects\6477\93006_401-Engineering-GannettFleming\Structures\MUS070_1066R\Sheets\028 sf003 4/8/2021 3:24:17 PM cmarburger

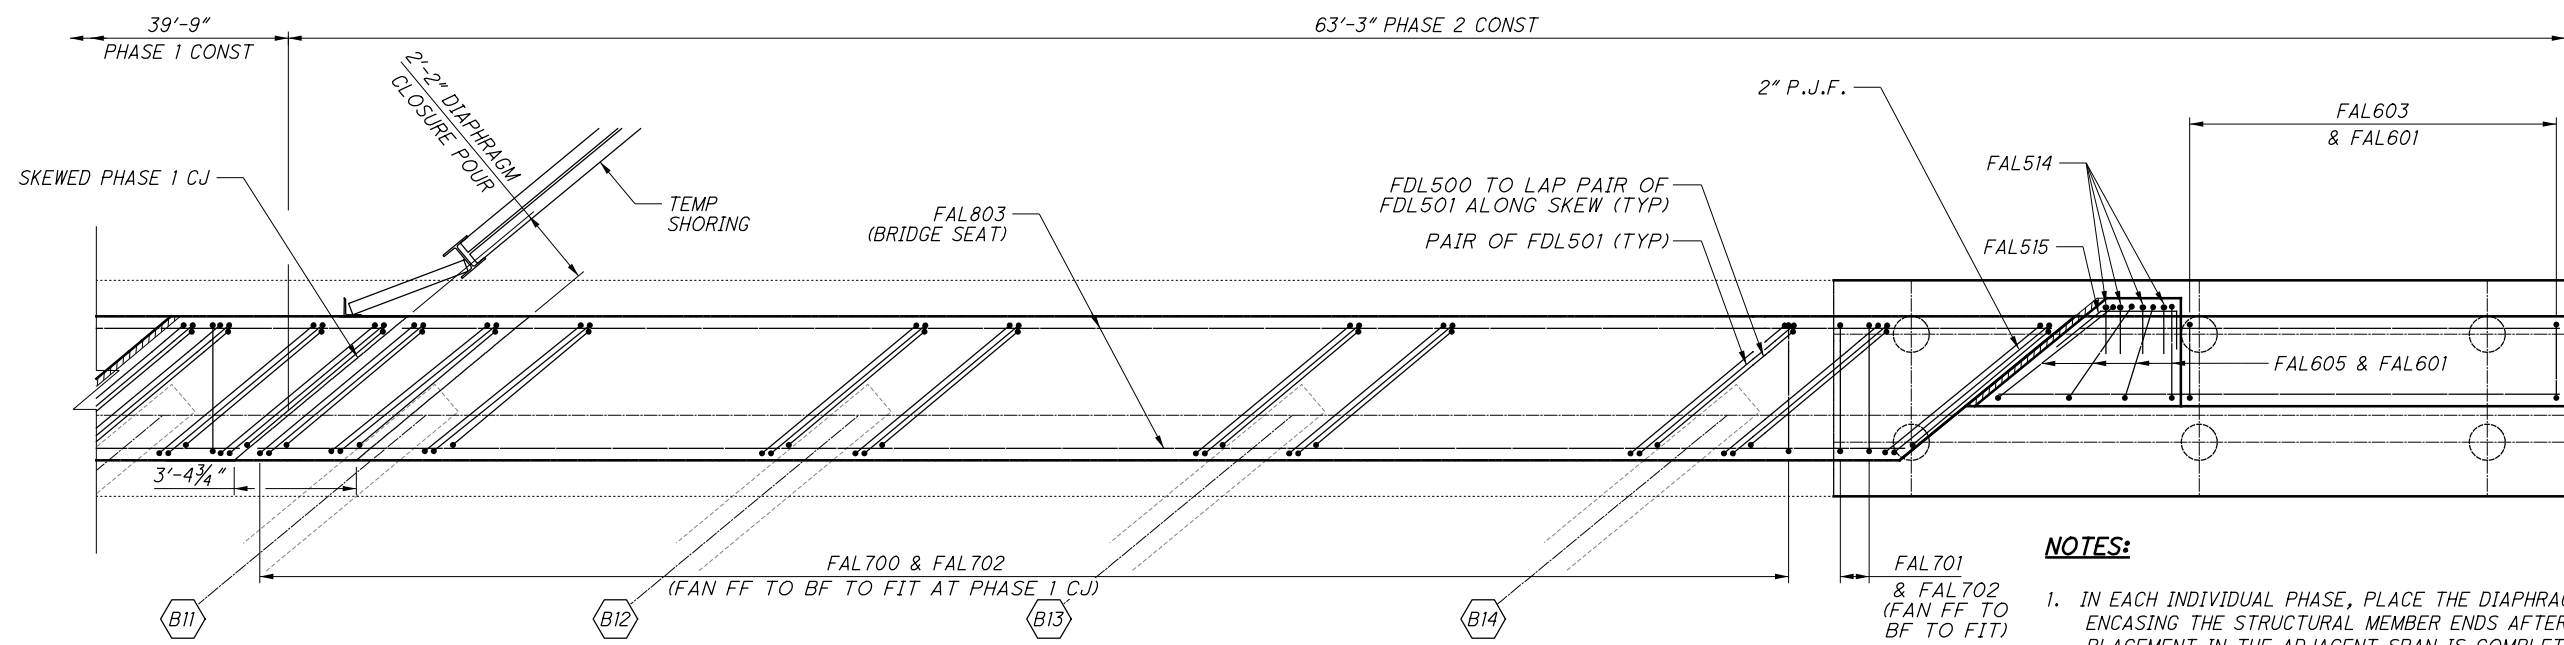

FORWARD ABUTMENT PHASE 2 PLAN

NOTES:


1. IN EACH INDIVIDUAL PHASE, PLACE THE DIAPHRAGM CONCRETE ENCASEING THE STRUCTURAL MEMBER ENDS AFTER THE DECK PLACEMENT IN THE ADJACENT SPAN IS COMPLETE. PROCEDURES THAT PLACE THE ABUTMENT DIAPHRAGM WITH THE DECK CONCRETE MAY BE APPROVED BY THE ENGINEER IF THE PLACEMENT SUBMITTAL CAN ASSURE THAT THE DECK CONCRETE IN THE ADJACENT SPAN WILL BE PLACED BEFORE CONCRETE IN THE DIAPHRAGM HAS REACHED ITS INITIAL SET. PLACE CLOSURE POUR IN THE DIAPHRAGM AND DECK CONCURRENTLY.
2. SEE SHEET [22/53] FOR ADDITIONAL NOTES.

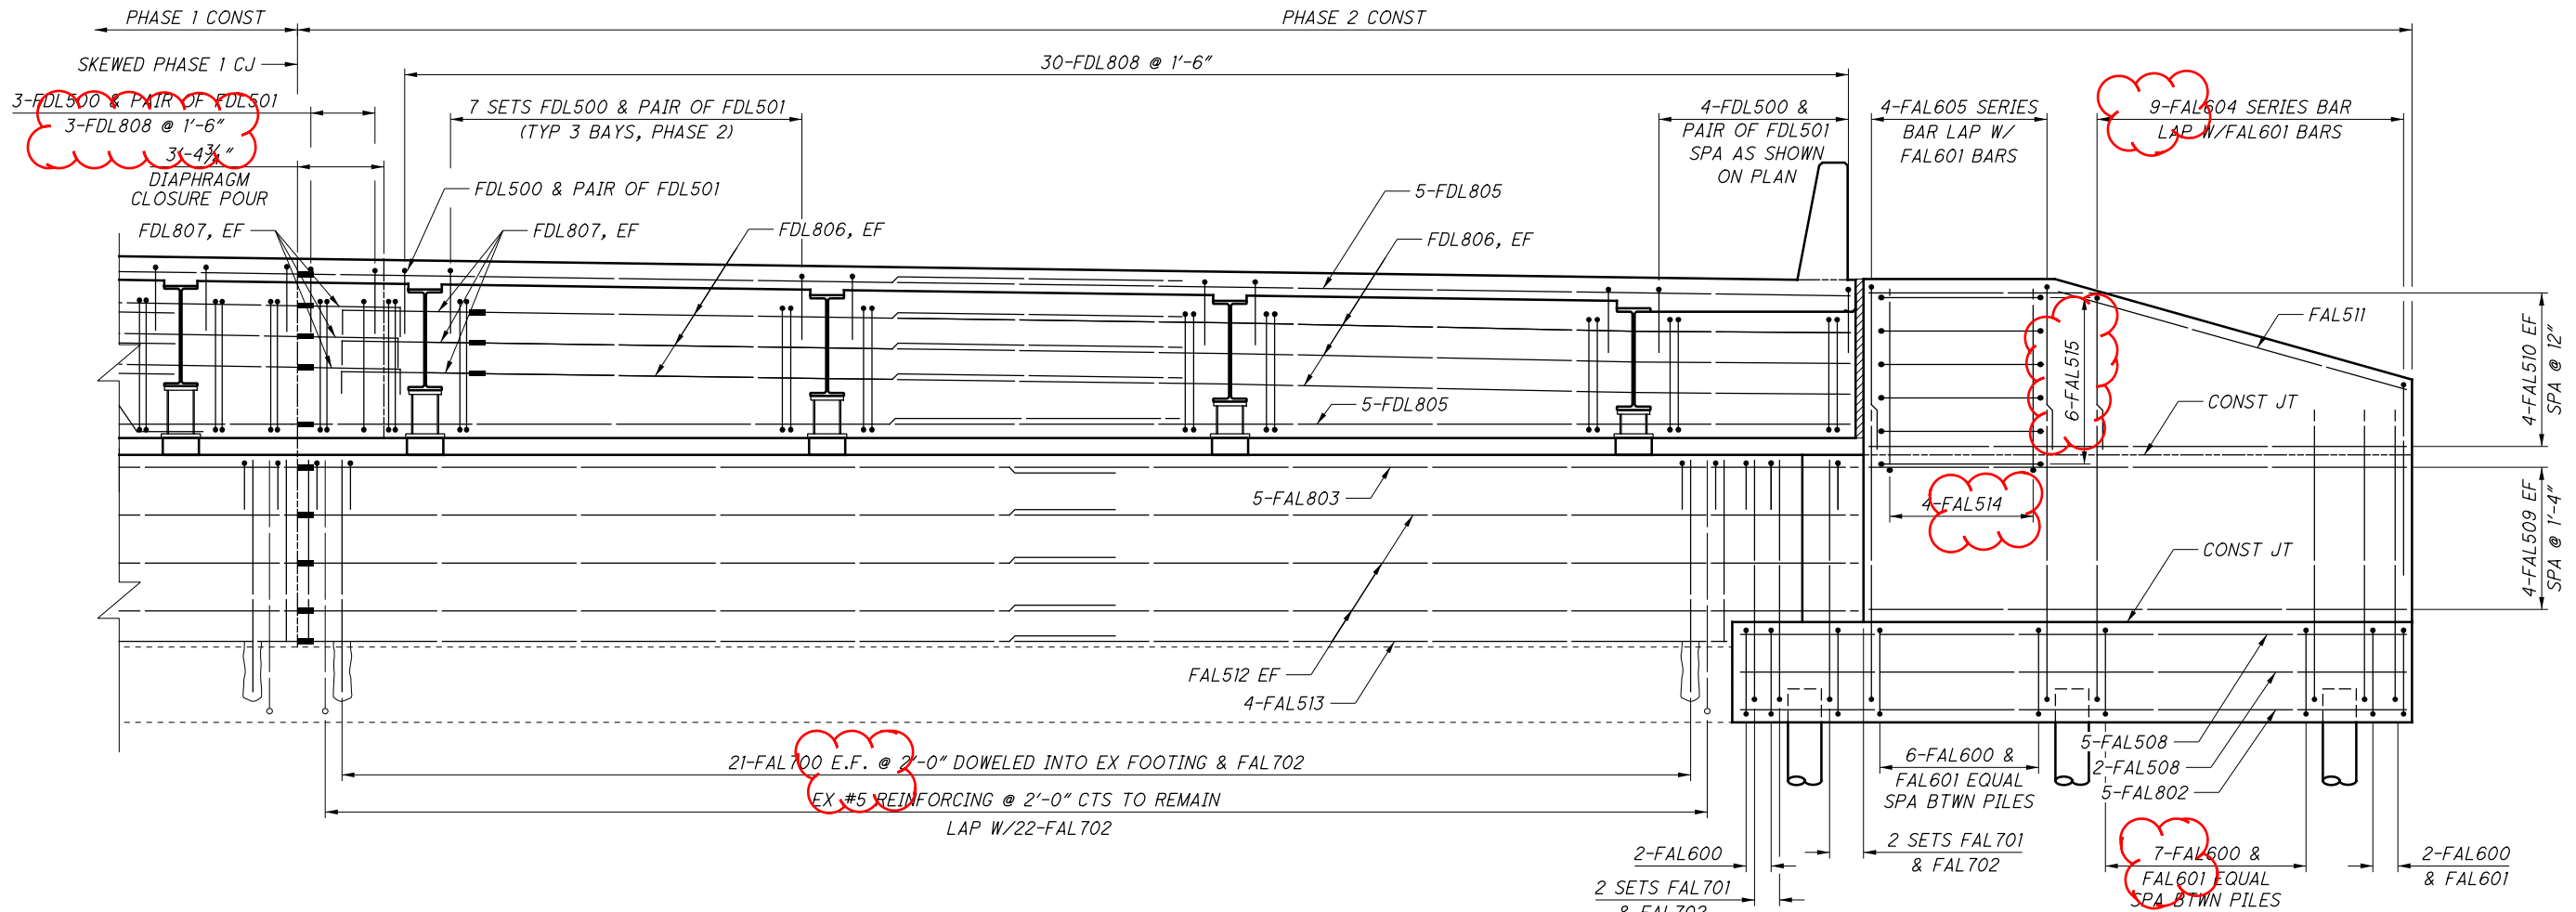

FORWARD ABUTMENT PHASE 2 ELEVATION
DECK REINFORCEMENT NOT SHOWN FOR CLARITY

DESIGN AGENCY Gannett Fleming ENGINEERS & ARCHITECTS, P.C. 2500 CORPORATE EXCHANGE DRIVE SUITE 230 COLUMBUS, OHIO 43231	
DESIGNED JGC	DATE 12/2020
DRAWN LAM	REVIEWED CTM
CHECKED DF	STRUCTURE FILE NUMBER 6002676
FORWARD ABUTMENT PHASE 2 BRIDGE NO. MUS-70-1066R OVER LICKING ROAD & CUOH RAILROAD	
MUS-70-10.49 PID No. 93006	
23 / 53	
1364 2231	


SUBMITTAL: Stage 3
 PLOT DRIVER: 000Tcodd_PDF.pltcf9
 PENTABLE: 93006_0001V81_Pen.tbl
 pw:\gfnnet-pw.bentley.com:gfnnet-pw-01\Documents\Projects\6477\93006\401-Engineering-Gannett+Fleming\MUS070_1066R\Sheets\051.sd001_4/8/2021 3:26:18 PM cmarburger

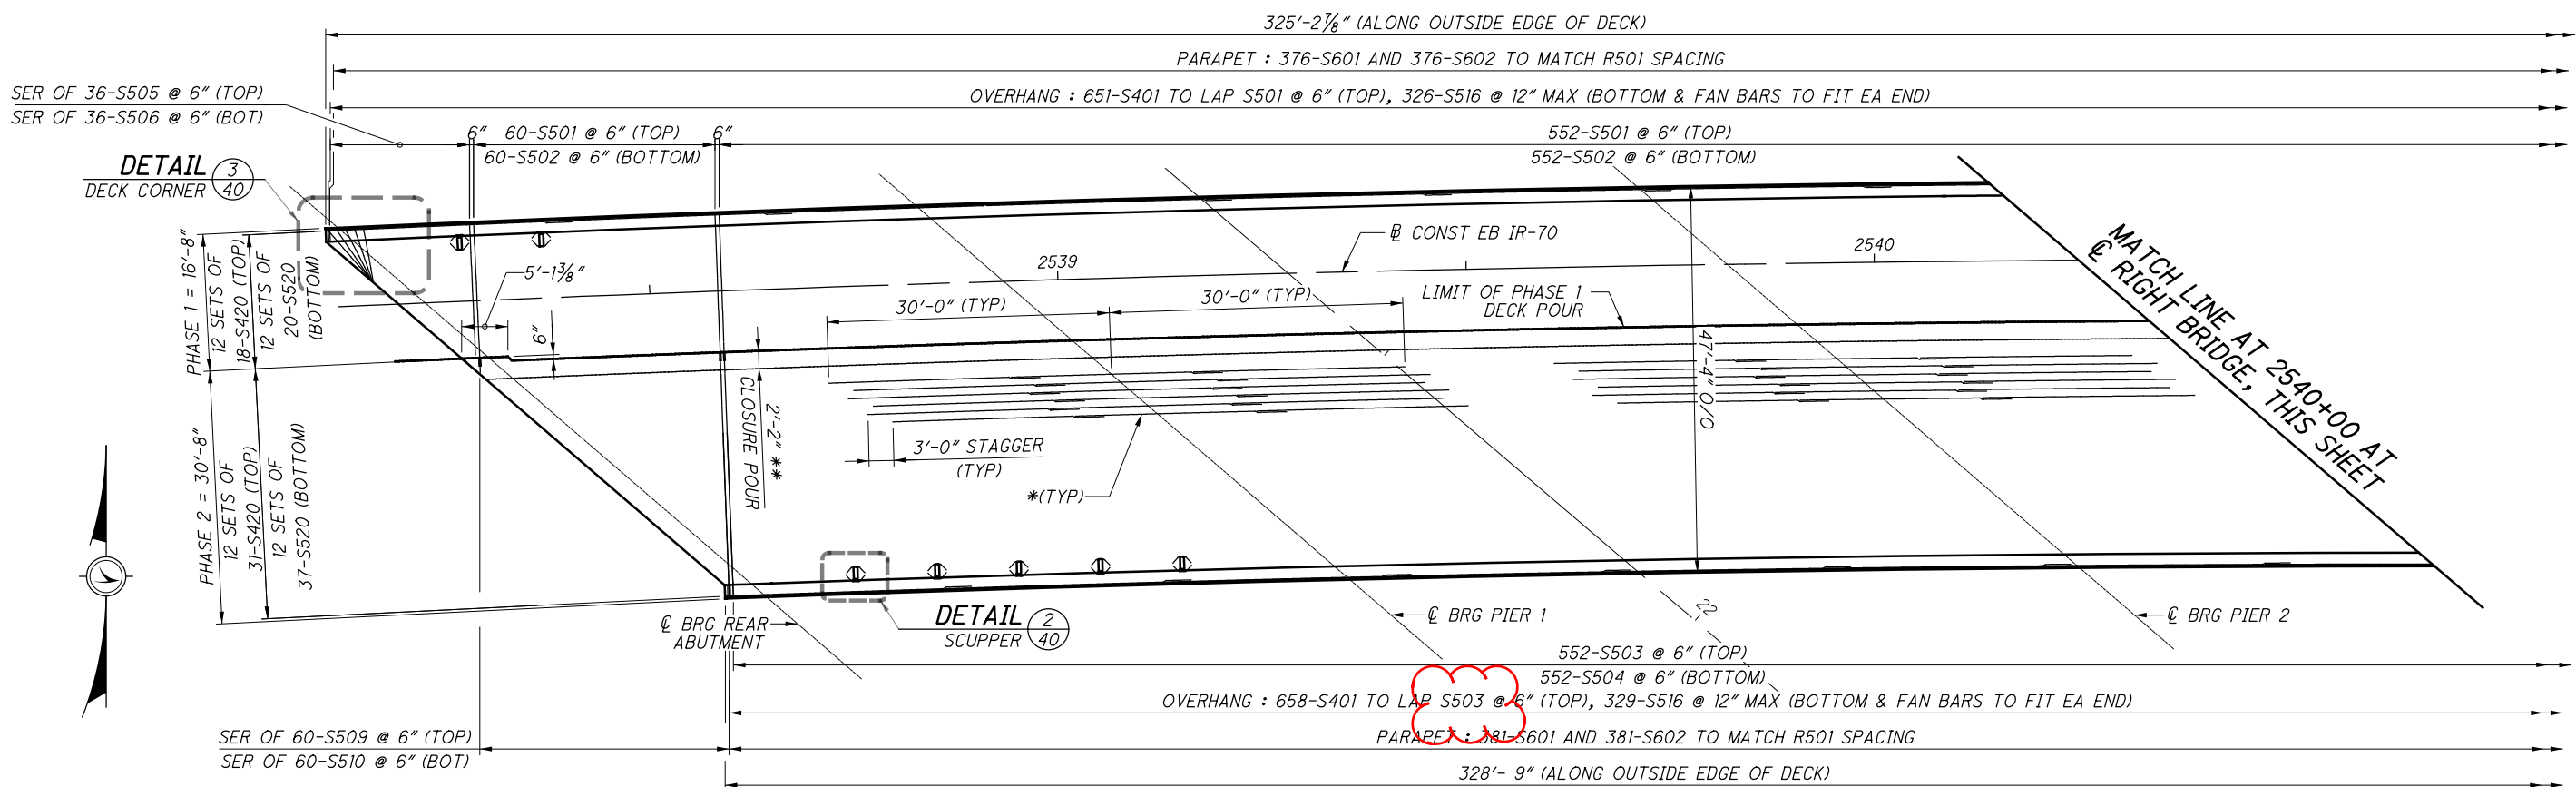

SCUPPER LOCATION TABLE

STATION	OFFSET
2538+27	8.00' LT
2538+37	8.00' LT
2538+74	36.00' RT
2538+84	36.00' RT
2538+94	36.00' RT
2539+04	36.00' RT
2539+14	36.00' RT

OFFSET MEASURED FROM \bar{C} TO GUTTER LINE

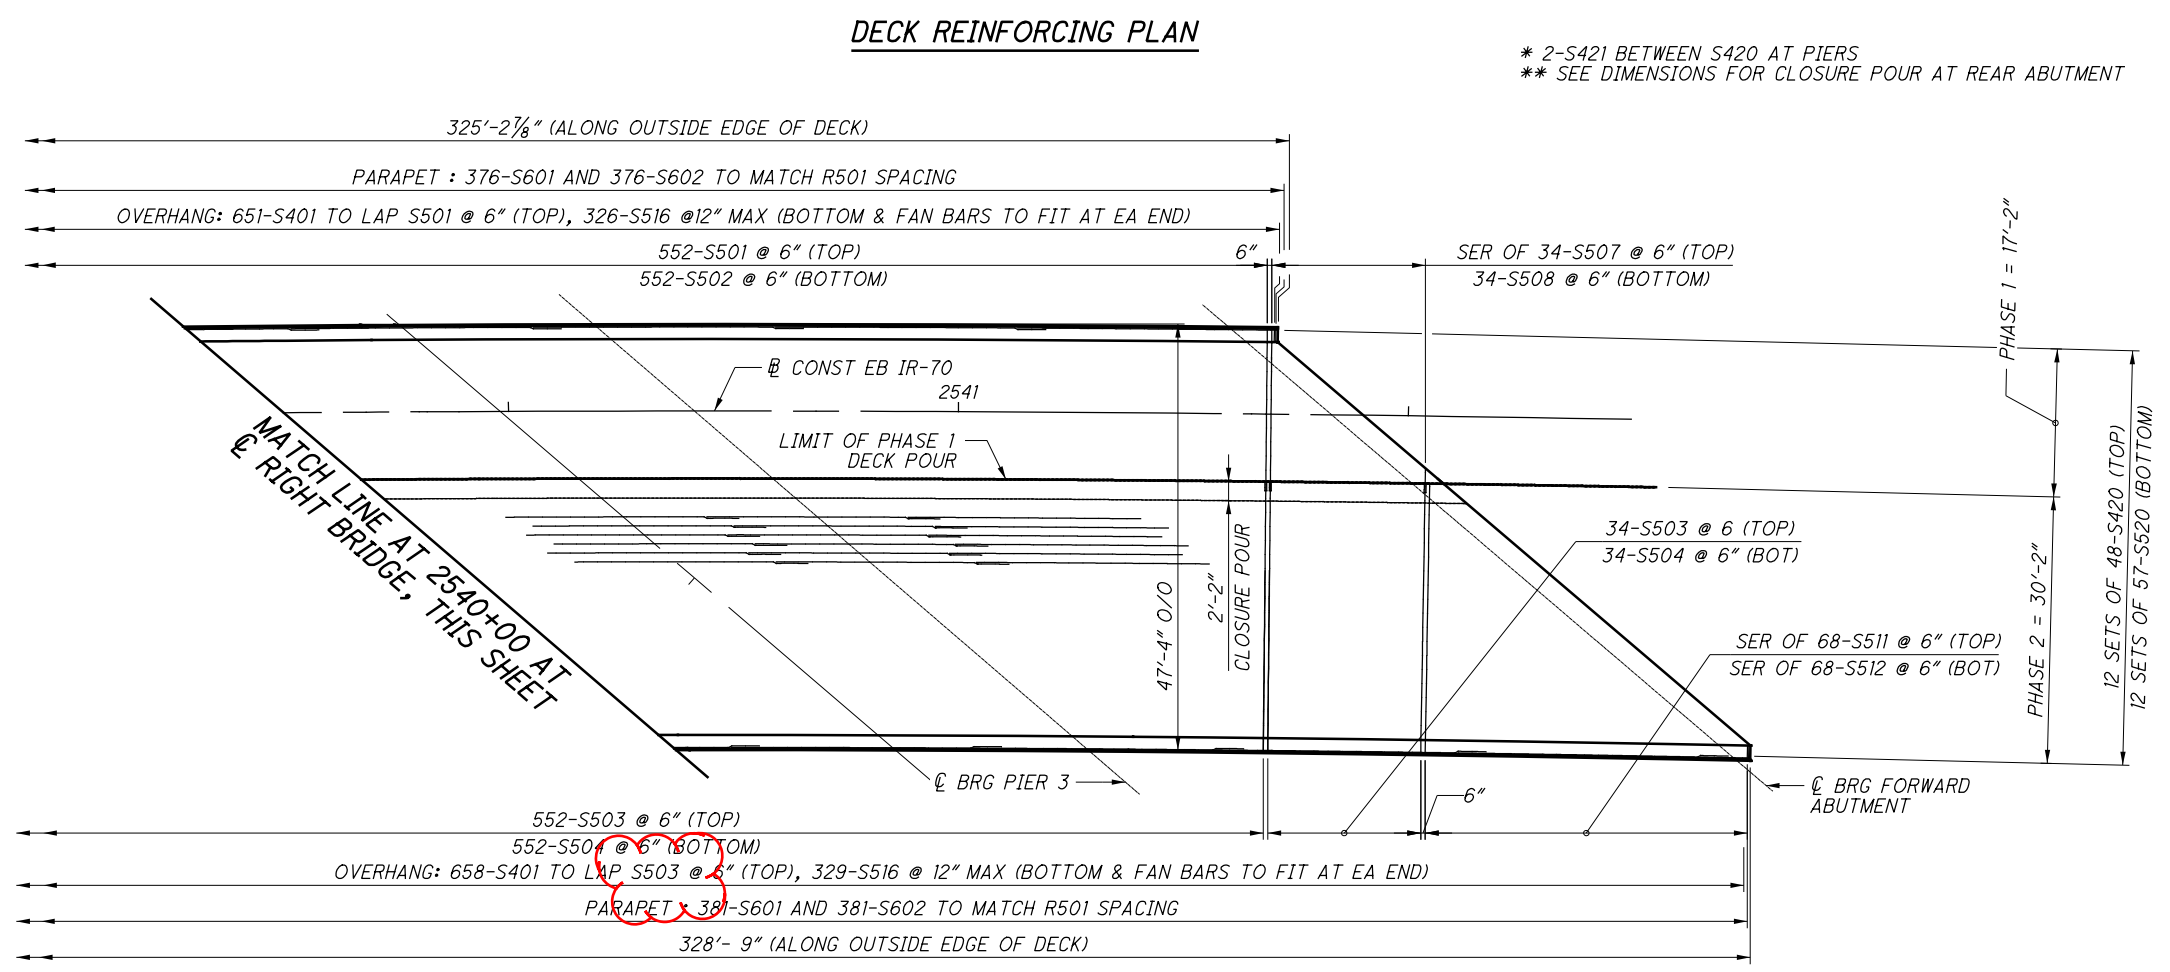

* 2-S421 BETWEEN S420 AT PIERS
 ** SEE DIMENSIONS FOR CLOSURE POUR AT REAR ABUTMENT

DECK REINFORCING PLAN

DECK REINFORCING PLAN

Gannett Fleming
 ENGINEERS & ARCHITECTS, P.C.
 2800 CORPORATE EXCHANGE DRIVE SUITE 230
 COLUMBUS, OHIO 43231
 DESIGN AGENCY
 DATE 12/2020
 REVIEWED CTM 12/2020
 DRAWN EBP
 CHECKED DF
 DESIGNED MMZ
 STRUCTURE FILE NUMBER 6002676
DECK REINFORCING PLAN
 BRIDGE NO. MUS-70-1066R
 OVER LICKING ROAD & CUOH RAILROAD
MUS-70-10.49
 PID No. 93006
 39 / 53
 1380
 2231

Mark	NUMBER			LENGTH	WEIGHT			TYPE	DIMENSIONS					
	Phase 1	Phase 2	TOTAL		Phase 1	Phase 2	TOTAL		A	B	C	D	R	INC
DECK														
S401	651	658	1,309	7'-5"	3,226	3,260	6,486	16	6'-11"					
S420	216	372	588	30'-3"	4,365	7,517	11,882	STR.						
S421	324	540	864	21'-4"	4,617	7,696	12,313	STR.						
# S501	612		612	17'-9"	11,331		11,331	16	17'-2"					
# S502	612		612	17'-2"	10,958		10,958	STR.						
S503		586	586	30'-6"		18,642	18,642	16	29'-11"					
S504		586	586	29'-11"		18,286	18,286	STR.						
S505	1 SER OF 36		1 SER OF 36	1'-7" to 17'-9"		363	363	16	1'-0" to 17'-2"					5 1/2"
S506	1 SER OF 36		1 SER OF 36	1'-0" to 17'-2"		342	342	STR.						5 1/2"
S507	1 SER OF 34		1 SER OF 34	1'-7" to 17'-9"		343	343	16	1'-0" to 17'-2"					5 3/4"
S508	1 SER OF 34		1 SER OF 34	1'-0" to 17'-2"		323	323	STR.						5 3/4"
S509		1 SER OF 60	1 SER OF 60	1'-7" to 30'-6"		1,004	1,004	16	1'-0" to 29'-11"					5 3/4"
S510		1 SER OF 60	1 SER OF 60	1'-0" to 29'-11"		968	968	STR.						5 3/4"
S511		1 SER OF 68	1 SER OF 68	1'-7" to 30'-6"		1,138	1,138	16	1'-0" to 29'-11"					5"
S512		1 SER OF 68	1 SER OF 68	1'-0" to 29'-11"		1,097	1,097	STR.						5"
S516	326	329	655	7'-9"	2,635	2,660	5,295	2	3'-9"	6"	3'-9"			
S520	240	444	684	30'-3"	7,572	14,009	21,581	STR.						
S521	4	10	14	5'-10"	25	61	86	13	2'-0"	1'-4"	1'-4"	2'-0"		
S601	410	415	825	5'-4"	3,284	3,325	6,609	1	2'-5"	3'-1"				
S602	410	415	825	5'-3"	3,233	3,273	6,506	28	3'-1"	1'-2"				
S603	4 SER OF 12	4 SER OF 12	8 SER OF 12	4'-0" to 4'-10"		318	318	1	1'-0" to 4'-0"	3'-2" to 4'-0"				3/4"
S604	12	12	24	3'-10"	70	70	140	1	1'-0"	3'-0"				
SUB-TOTAL					53,005	83,324	136,329							
PARAPET														
R501	410	415	825	7'-5"	3,172	3,210	6,382	23	11"	3'-3"	3'-0"			2 3/4"
R510	30	28	58	9'-8"	303	282	585	STR.						
R511	66	74	140	4'-8"	322	360	682	STR.						
R512	2	2	4	3'-5"	8	8	16	STR.						
R513	2		2	6'-9"	15		15	STR.						
R514	48		48	29'-4"	1,469		1,469	STR.						
R515		48	48	29'-7"		1,482	1,482	STR.						
R520	4	4	8	15'-11"	66	66	132	STR.						
R521	16	16	32	16'-2"	270	270	540	STR.						
R522	8	8	16	10'-0"	84	84	168	STR.						
R523	8	8	16	5'-11"	50	50	100	STR.						
R524	8	8	16	5'-11"	50	50	100	STR.						
R610	15	14	29	9'-8"	218	204	422	STR.						
R611	33	37	70	4'-8"	231	260	491	STR.						
R612	1	1	2	3'-4"	6	6	12	STR.						
R613	1		1	6'-9"	11		11	STR.						
R620	2	2	4	15'-11"	48	48	96	STR.						
SUB-TOTAL					6,323	6,380	12,703							

= BAR WITH MECHANICAL CONNECTOR

MINIMUM LAP LENGTH

- #4 BARS = 1'-11"
- #5 BARS (DECK) = 2'-5"
- #5 BARS (OTHERS) = 3'-1"
- #6 BARS = 3'-7"
- #7 BARS = 4'-8"
- #8 BARS = 5'-4"

NOTES:

1. ALL REINFORCEMENT BARS SHALL BE EPOXY COATED. PAYMENT FOR REINFORCING, INCLUDING MECHANICAL CONNECTORS, SHALL BE MADE WITH ITEM 509 - EPOXY COATED REINFORCING STEEL
2. "STR." IN THE TYPE COLUMN INDICATES STRAIGHT BARS.
3. "SER OF" DENOTES SERIES OF BARS, E.G. "X" SER OF "Y" = "X" SERIES OF "Y" BARS/SERIES.
4. REFER TO C.M.S SECTION 509.05 FOR STANDARD BEND DIMENSIONS.
5. MECHANICAL CONNECTORS: AN APPROVED TYPE OF MECHANICAL CONNECTOR FOR REINFORCING BARS SHALL BE PROVIDED IN ACCORDANCE WITH C.M.S. SECTION 509.07. INSTALLATION OF CONNECTORS SHALL CONFORM WITH MANUFACTURER RECOMMENDED PROCEDURES.

CONNECTORS AND DOWEL BARS USED WITH EPOXY COATED BARS SHALL BE EPOXY COATED. COATING FOR BOTH CONNECTORS AND BARS SHALL CONFORM TO THE SAME SPECIFICATIONS. COATINGS THAT HAVE BEEN DAMAGED OR THAT OTHERWISE DO NOT MEET SPECIFICATIONS WITH RESPECT TO COLOR, CONTINUITY AND UNIFORMITY, MAY BE REPAIRED AS DIRECTED BY THE ENGINEER, OR THEY SHALL BE REPLACED WITH MATERIAL WITH MEETS THE SPECIFICATIONS. FOR BARS UTILIZING A MECHANICAL CONNECTOR, THE BAR LENGTH FOR PAYMENT IS MEASURED TO THE CENTER OF THE PLANNED MECHANICAL CONNECTION. EXTRA BAR LENGTH AND/OR BAR END PREPARATION MAY BE NECESSARY DEPENDING UPON THE TYPE OF MECHANICAL CONNECTOR FURNISHED AND THOSE COSTS SHALL BE INCLUDED IN THE BID PRICE FOR ITEM 509. CONNECTORS AND DOWEL BAR EXTENSIONS SHALL CONFORM TO AND BE INCLUDED IN THE BID PRICE FOR ITEM 509.

Mark	NUMBER			LENGTH	WEIGHT			TYPE	DIMENSIONS				
	Phase 1	Phase 2	TOTAL		Phase 1	Phase 2	TOTAL		A	B	C	D	INC
REAR ABUTMENT													
RAL500	7		7	20'-10"	153		153	STR.					
RAL501	8		8	16'-11"	142		142	STR.					
	2		2	4'-8"									
RAL502	SER OF		SER OF	to	91		91	STR.					4'-1"
	4		4	16'-11"									
RAL503	2		2	12'-10"	27		27	STR.					
RAL504	6		6	24'-5"	153		153	STR.					
	1		1	18'-2"									
RAL505	SER OF		SER OF	to	85		85	STR.					1'-5 1/4"
	4		4	22'-6"									
RAL506	4		4	9'-7"	40		40	19	6'-2"	2'-5"	2'-5"		
RAL507	6		6	5'-6"	35		35	9	1'-0"	1'-0"	1'-8"	2'-8"	
RAL508		7	7	23'-1"		169	169	STR.					
RAL509		8	8	13'-2"		110	110	STR.					
		2	2	3'-6"									
RAL510	SER OF		SER OF	to		70	70	STR.					3'-2 1/2"
	4		4	13'-2"									
RAL511	2		2	10'-6"		22	22	STR.					
RAL512	12		12	24'-2"		303	303	STR.					
RAL513	8		8	17'-1"		143	143	STR.					
RAL514	4		4	9'-8"		41	41	19	6'-3"	2'-5"	2'-5"		
RAL515	6		6	7'-6"		47	47	9	1'-0"	1'-0"	3'-8"	2'-8"	
RAL600	20	23	43	17'-0"	511	587	1,098	3	5'-8"	2'-7"			
RAL601	17	12	29	20'-6"	523	370	893	2	9'-4"	2'-2"	9'-4"		
	1		1	4'-4"					1'-3"		1'-3"		
RAL602	SER OF		SER OF	to	146		146	2	to	2'-2"	to		8"
	12		12	11'-10"					5'-0"		5'-0"		
	1		1	11'-10"						2'-2"			
RAL603	SER OF		SER OF	to	76		76	2	5'-0"	to	5'-0"		5 1/4"
	4		4	13'-2"						3'-6"			
		1	1	4'-4"					1'-3"		1'-3"		
RAL604	SER OF		SER OF	to		116	116	2	to	2'-2"	to		8 3/4"
	10		10	11'-0"					4'-7"		4'-7"		
	1		1	11'-0"						2'-2"			
RAL605	SER OF		SER OF	to		53	53	2	4'-7"	to	4'-7"		8"
	3		3	12'-4"						3'-6"			
RAL700	18	32	50	7'-0"	258	458	716	STR.					
RAL701	4	14	18	18'-10"	154	539	693	2	7'-9"	3'-8"	7'-9"		
RAL702	23	47	70	12'-8"	596	1,217	1,813	2	4'-8"	3'-8"	4'-8"		
RAL800	5		5	20'-10"	279		279	STR.					
RAL801	5		5	24'-7"	329		329	STR.					
RAL802		5	5	23'-1"		309	309	STR.					
RAL803		10	10	24'-2"		646	646	STR.					
				SUB-TOTAL	3,598	5,200	8,798						
REAR DIAPHRAGM													
RDL500	15	29	44	9'-6"	149	287	436	2	2'-6"	4'-9"	2'-6"		
RDL501	30	58	88	11'-0"	344	666	1,010	2	2'-11 1/2"	5'-3"	2'-11 1/2"		
RDL800	11		11	18'-1"	532		532	1	1'-6"	16'-9"			
RDL801	11		11	5'-10"	172		172	1	1'-6"	4'-6"			
RDL802	6		6	8'-2"	131		131	STR.					
RDL803	5		5	24'-7"	329		329	STR.					
RDL804	10		10	8'-6"	227		227	18	5'-0"	1'-11"	1'-9"		
RDL805		20	20	25'-7"		1,367	1,367	STR.					
RDL806		12	12	22'-4"		716	716	STR.					
RDL807		12	12	5'-0"		161	161	1	1'-0"	4'-2"			
RDL808	17	31	48	5'-2"	235	428	663	18	2'-3"	1'-4 3/4"	1'-4 3/4"		
				SUB-TOTAL	2,119	3,625	5,744						

= BAR WITH MECHANICAL CONNECTOR

REINFORCING LIST 02
 BRIDGE NO. MUS-70-1066R
 OVER LICKING ROAD & CUOH RAILROAD

MUS-70-10.49
 PID No. 93006

52 / 53

1393
2231

DESIGN AGENCY
Gannett Fleming
 ENGINEERS & ARCHITECTS, P.C.
 2500 CORPORATE EXCHANGE DRIVE SUITE 230
 COLUMBUS, OHIO 43231


DATE
12/20/20
REVIEWED
CTM
DRAWN
MZ
DESIGNED
MZ
CHECKED
JC

STRUCTURE FILE NUMBER
6002676

REVISIONS

SUBMITTAL Stage 3
 PID: 93006
 PLOT DRIVER: 000Tcodd_PDF.pltcf9
 PENTABLE: g3006-000.tbl, Rep.tbl
 pw:\gtnet-pw\ben.ley.com\gtnet-pw-0\Documents\Projects\6177193006-10-Engineering\Gannett Fleming Structures\MUS070\066R\Reinforcing\Reinforcing Lists\Reinforcing Lists.tbl

Mark	NUMBER			LENGTH	WEIGHT			TYPE	DIMENSIONS										
	Phase 1	Phase 2	TOTAL		Phase 1	Phase 2	TOTAL		A	B	C	D	INC						
	FORWARD ABUTMENT																		
FAL500	7		7	25'-6"	187		187	STR.											
FAL501	8		8	13'-10"	116		116	STR.											
FAL502	2		2	3'-6"															
FAL502	SER OF		SER OF	to	73		73	STR.									3'-5 1/4"		
FAL503	4		4	13'-10"															
FAL503	2		2	11'-0"	23		23	STR.											
FAL504	6		6	27'-9"	174		174	STR.											
FAL505	1		1	12'-0"															
FAL505	SER OF		SER OF	to	61		61	STR.									1'-7 1/4"		
FAL506	4		4	16'-10"															
FAL506	4		4	9'-1"	38		38	19	5'-8"	2'-5"	2'-5"								
FAL507	6		6	7'-8"	48		48	9	1'-0"	1'-0"	3'-10"	2'-8"							
FAL508		7	7	20'-0"			147	147	STR.										
FAL509		8	8	16'-4"			137	137	STR.										
FAL510		2	2	4'-11"															
FAL510	SER OF		SER OF	to			89	89	STR.								3'-9 1/2"		
FAL510	4		4	16'-4"															
FAL511	2		2	11'-0"			23	23	STR.										
FAL512	12		12	24'-6"			307	307	STR.										
FAL513	8		8	23'-6"			197	197	STR.										
FAL514	4		4	9'-4"			39	39	19	5'-11"	2'-5"	2'-5"							
FAL515	6		6	5'-8"			36	36	9	1'-0"	1'-0"	1'-10"	2'-8"						
FAL600	23	18	41	17'-0"	587	460	1,047	3	5'-8"	2'-7"									
FAL601	8	14	22	22'-4"	268	470	738	2	10'-3"	2'-2"	10'-3"								
FAL602	1		1	4'-4"						1'-3"		1'-3"							
FAL602	SER OF		SER OF	to	127		127	2	to	2'-2"	to						10 3/4"		
FAL602	10		10	12'-6"						5'-4"		5'-4"							
FAL603	1		1	12'-6"							2'-2"								
FAL603	SER OF		SER OF	to	60		60	2	5'-4"	to	5'-4"						8"		
FAL603	3		3	13'-10"							3'-6"								
FAL604	1		1	3'-0"						7"		7"							
FAL604	SER OF		SER OF	to			95	95	2	to	2'-2"	to					1'-0"		
FAL604	9		9	11'-0"							4'-7"								
FAL605	1		1	11'-0"							2'-2"								
FAL605	SER OF		SER OF	to			71	71	2	4'-7"	to	4'-7"					5 1/4"		
FAL605	4		4	12'-4"							3'-6"								
FAL700	16	42	58	7'-0"	229	601	830	STR.											
FAL701	14	4	18	18'-4"	525	150	675	2	7'-6"	3'-8"	7'-6"								
FAL702	31	47	78	12'-8"	803	1,217	2,020	2	4'-8"	3'-8"	4'-8"								
FAL800	5		5	25'-6"	341		341	STR.											
FAL801	5		5	26'-6"	354		354	STR.											
FAL802		5	5	20'-0"		267	267	STR.											
FAL803		10	10	25'-3"		675	675	STR.											
SUB-TOTAL					4,014	4,981	8,995												
FORWARD DIAPHRAGM																			
FDL500	17	29	46	9'-9"	173	295	468	2	2'-6"	5'-0"	2'-6"								
FDL501	34	58	92	11'-3"	399	681	1,080	2	2'-11 1/2"	5'-7"	2'-11 1/2"								
FDL800	11		11	19'-4"	568		568	1	1'-6"	18'-0"									
FDL801	11		11	7'-4"	216		216	1	1'-6"	6'-0"									
FDL802	6		6	8'-9"	141		141	STR.											
FDL803	5		5	27'-9"	371		371	STR.											
FDL804	10		10	8'-6"	227		227	18	5'-0"	1'-11"	1'-9"								
FDL805		20	20	26'-6"		1,416	1,416	STR.											
FDL806		12	12	8'-6"		273	273	18	5'-0"	1'-11"	1'-9"								
FDL807		12	12	5'-0"		161	161	1	1'-0"	4'-2"									
FDL808	19	33	52	5'-2"	262	456	718	18	2'-3"	1'-4 3/4"	1'-4 3/4"								
SUB-TOTAL					2,357	3,282	5,639												
TOTAL ALL REINFORCING					71,416	106,792	178,208												

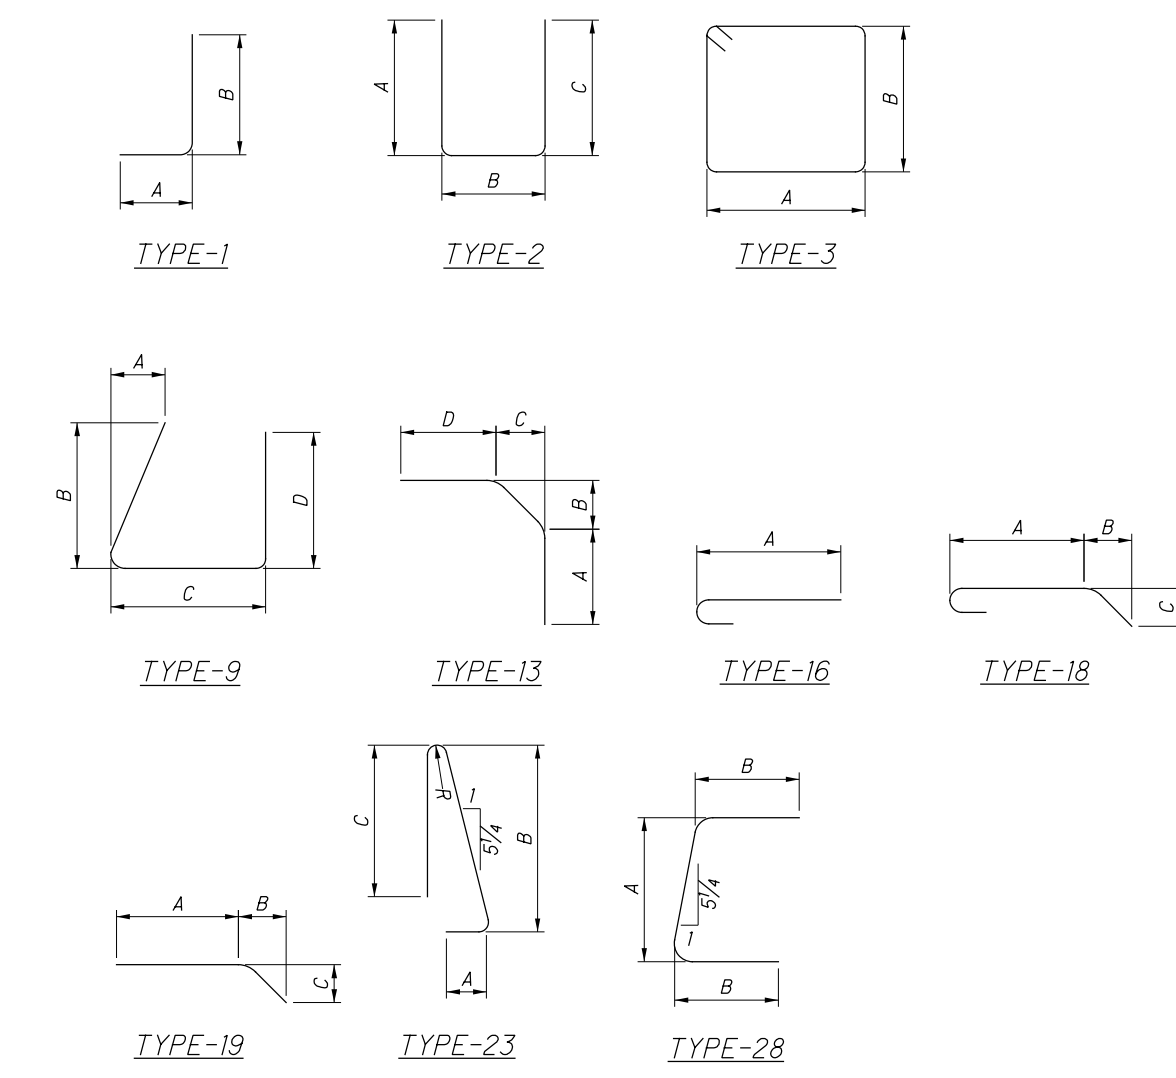

= BAR WITH MECHANICAL CONNECTOR

REINFORCING LIST 03

BRIDGE NO. MUS-70-1066R
OVER LICKING ROAD & CUOH RAILROAD

DESIGNED: JC
CHECKED: JC

DRAWN: MZ
REVISED: JC

REVIEWED: CTM
STRUCTURE FILE NUMBER: 6002676

DATE: 12/2020

Gannett Fleming
ENGINEERS & ARCHITECTS, P.C.
2800 CORPORATE EXCHANGE DRIVE, SUITE 230
COLUMBUS, OHIO 43231

MUS-70-10.49
PID No. 93006

53 / 53

1394
2231

STANDARD DRAWINGS AND SUPPLEMENTAL SPECIFICATIONS

REFER TO THE FOLLOWING STANDARD BRIDGE DRAWINGS:

Table with 3 columns: Drawing Name, DATED/REVISED, and Date. Includes items like A-1-20, AS-1-15, AS-2-15, etc.

AND TO THE FOLLOWING SUPPLEMENTAL SPECIFICATION(S):

DESIGN SPECIFICATIONS

THIS STRUCTURE CONFORMS TO 8TH EDITION OF THE "LRFD BRIDGE DESIGN SPECIFICATIONS" ADOPTED BY THE AMERICAN ASSOCIATION OF STATE HIGHWAY AND TRANSPORTATION OFFICIALS, 2017, AND THE ODOT BRIDGE DESIGN MANUAL, 2020.

SPECIAL DESIGN SPECIFICATIONS

THIS BRIDGE REQUIRED THE USE OF A TWO-DIMENSIONAL MODEL USING GRILLAGE DESIGN METHOD TO ANALYZE THE STRUCTURE. THE COMPUTER PROGRAM USED FOR STRUCTURAL ANALYSIS WAS BENTLEY LEAP STEEL V19.

DEAD LOAD DISTRIBUTION: DC1 LOADING WAS DISTRIBUTED TO BEAMS BASED ON TRIBUTARY AREA. BARRIER LOADS DC2 WERE APPLIED TO THE TWO EXTERIOR BEAMS (FOR DESIGN) AND EQUALLY TO ALL BEAMS FOR CAMBER/DEFLECTION DESIGN.

LIVE LOAD DISTRIBUTION: HL-93 TRUCK AND LANE LOADS WERE APPLIED BY 1, 2, & 3 LANE FLOAT METHOD ACROSS THE BRIDGE DECK DIRECTLY TO THE GRILLAGE MODEL.

LRFD OPERATIONAL IMPORTANCE

A LOAD MODIFIER OF 1.00 HAS BEEN ASSUMED FOR THE DESIGN OF THIS STRUCTURE IN ACCORDANCE WITH THE AASHTO LRFD BRIDGE DESIGN SPECIFICATIONS, ARTICLE 1.3.5, AND THE ODOT BRIDGE DESIGN MANUAL, 2020

DESIGN LOADING

HL-93
FUTURE WEARING SURFACE (FWS) OF 0.60 KSF

DESIGN DATA

CONCRETE CLASS, QC2 - COMPRESSIVE STRENGTH 4.5 KSI (SUPERSTRUCTURE)

CONCRETE CLASS, QC1 - COMPRESSIVE STRENGTH 4.0 KSI (SUBSTRUCTURE)

REINFORCING STEEL - MINIMUM YIELD STRENGTH 60 KSI
STRUCTURAL STEEL - ASTM A709 GRADE 50W - YIELD STRENGTH 50 KSI

MONOLITHIC WEARING SURFACE

MONOLITHIC WEARING SURFACE IS ASSUMED, FOR DESIGN PURPOSES, TO BE 1 INCH THICK.

MONOLITHIC WEARING SURFACE

MONOLITHIC WEARING SURFACE IS ASSUMED, FOR DESIGN PURPOSES, TO BE 1 INCH THICK.

INSPECTION FOR BATS

PRIOR TO THE START OF DEMOLITION ACTIVITIES THE CONTRACTOR SHALL INSPECT THE UNDERSIDE OF THE BRIDGE FOR THE PRESENCE OF BATS OR NESTING BIRDS. IF ANY BATS OR BIRD NESTS ARE OBSERVED THE CONTRACTOR SHALL NOTIFY NICOLE HAFER-LIPSTREU IN THE DISTRICT 5 PLANNING DEPARTMENT @ (740) 323-5103 (NICOLE.HAFERLIPSTREU@DOT.OHIO.GOV), OR, BRIAN TATMAN @ (740) 323-5191 (BRIAN.TATMAN@DOT.OHIO.GOV) PRIOR TO STARTING ANY DEMOLITION WORK.

ITEM 202, PORTIONS OF STRUCTURE REMOVED, AS PER PLAN

THIS ITEM INCLUDES THE ELEMENTS INDICATED IN THE PLANS AND GENERAL NOTES AND THAT ARE NOT SEPARATELY LISTED FOR PAYMENT, EXCEPT FOR WEARING COURSE REMOVAL. ITEMS TO BE REMOVED INCLUDE ALL EXISTING MATERIALS BEING REPLACED BY NEW CONSTRUCTION AND MISCELLANEOUS ITEMS THAT ARE NOT SHOWN TO BE INCORPORATED INTO THE FINAL CONSTRUCTION AND ARE DIRECTED TO BE REMOVED BY THE ENGINEER. THE USE OF EXPLOSIVES, HEADACHE BALLS AND/OR HOE-RAMS WILL NOT BE PERMITTED. THE METHOD OF REMOVAL AND THE WEIGHT OF HAMMER SHALL BE APPROVED BY THE ENGINEER. PERFORM ALL WORK IN A MANNER THAT WILL NOT CUT, ELONGATE OR DAMAGE THE EXISTING REINFORCING STEEL TO BE PRESERVED. CHIPPING HAMMERS MUST NOT BE HEAVIER THAN THE NOMINAL 90-POUND CLASS. PNEUMATIC HAMMERS MUST NOT BE PLACED IN DIRECT CONTACT WITH REINFORCING STEEL THAT IS TO BE RETAINED IN THE REBUILT STRUCTURE. SUBMIT CONSTRUCTION PLANS ACCORDING TO C&MS 501.05.

EXISTING STRUCTURE VERIFICATION

DETAILS AND DIMENSIONS SHOWN ON THESE PLANS PERTAINING TO THE EXISTING STRUCTURE HAVE BEEN OBTAINED FROM PLANS OF THE EXISTING STRUCTURE AND FROM FIELD OBSERVATIONS AND MEASUREMENTS. CONSEQUENTLY, THEY ARE INDICATIVE OF THE EXISTING STRUCTURE AND THE PROPOSED WORK BUT THEY SHALL BE CONSIDERED TENTATIVE AND APPROXIMATE. THE CONTRACTOR IS REFERRED TO C&MS SECTIONS 102.05, 105.02 AND 513.04. BASE CONTRACT BID PRICES UPON A RECOGNITION OF THE UNCERTAINTIES DESCRIBED ABOVE AND UPON A PREBID EXAMINATION OF THE EXISTING STRUCTURE. HOWEVER, THE DEPARTMENT WILL PAY FOR ALL PROJECT WORK BASED UPON ACTUAL DETAILS AND DIMENSIONS THAT HAVE BEEN VERIFIED IN THE FIELD.

ITEM 516, JACKING AND TEMPORARY SUPPORT OF SUPERSTRUCTURE, AS PER PLAN

IN ORDER TO MAINTAIN STABILITY OF PIER 4 DURING TRAFFIC SHIFT, INSTALL TEMPORARY SUPPORTS FOR BEAMS 1 & 14 AT PIER 4 PRIOR TO REMOVING THE DECK IN PHASE 1. AFTER THE COMPLETION OF PHASE 1 AND PRIOR TO THE DECK REMOVAL IN PHASE 2, MOVE THE TEMPORARY SUPPORTS TO BEAMS 7 AND 8 AT PIER 4. THE SUPPORTS ARE TO REMAIN UNTIL THE COMPLETION OF PHASE 3. DESIGN JACKS AND TEMPORARY SUPPORTS TO PROVIDE A MINIMUM OF 250 KIPS RESISTANCE PER BEAM.

SUBMIT CONSTRUCTION PLANS IN ACCORDANCE WITH C&MS 501.05. IF, DURING JACKING OPERATIONS, CRACKING OF THE CONCRETE DECK FROM THE STEEL STRINGERS, OR OTHER DAMAGE TO THE STRUCTURE IS VISUALLY OBSERVED IMMEDIATELY CEASE THE JACKING OPERATION AND INSTALL SUPPORTS TO THE SATISFACTION OF THE ENGINEER. ANALYZE THE DAMAGE AND SUBMIT A METHOD OF CORRECTION TO THE ENGINEER FOR APPROVAL.

DECK PLACEMENT DESIGN ASSUMPTIONS

THE FOLLOWING ASSUMPTIONS OF CONSTRUCTION MEANS AND METHODS WERE MADE FOR THE ANALYSIS AND DESIGN OF THE SUPERSTRUCTURE. THE CONTRACTOR IS RESPONSIBLE FOR THE DESIGN OF THE FALSEWORK SUPPORT SYSTEM WITHIN THESE PARAMETERS AND WILL ASSUME RESPONSIBILITY FOR THE SUPERSTRUCTURE ANALYSIS FOR DEVIATION FROM THESE DESIGN ASSUMPTIONS.

AN EIGHT WHEEL FINISHING MACHINE WITH A MAXIMUM WHEEL LOAD OF 2.2 KIPS

A MINIMUM OUT-TO-OUT WHEEL SPACING AT EACH END OF THE MACHINE OF 103".

A MAXIMUM SPACING OF OVERHANG FALSEWORK BRACKETS OF 48 IN.

A MAXIMUM DISTANCE FROM THE CENTERLINE OF THE FASCIA GIRDER TO THE FACE OF THE SAFETY HANDRAIL OF 65".

DECK SLAB CONCRETE QUANTITY

THE ESTIMATED QUANTITY OF DECK SLAB CONCRETE IS BASED ON THE CONSTANT DECK SLAB THICKNESS, AS SHOWN, PLUS THE QUANTITY OF CONCRETE THAT FORMS EACH BEAM HAUNCH. THE ESTIMATE ASSUMES A CONSTANT HAUNCH THICKNESS OF 2 INCHES AND A HAUNCH WIDTH EQUAL TO THE TOP FLANGE WIDTH. DEVIATE FROM THIS HUNCH THICKNESS AS NECESSARY TO PLACE THE DECK SURFACE AT THE FINISHED GRADE.

ITEM 513 STRUCTURAL STEEL, MISC: EXTERNAL POST TENSIONING

THIS ITEM CONSIST OF FURNISHING ALL MATERIAL, LABOR AND EQUIPMENT NECESSARY TO FURNISH AND INSTALL EXTERNAL POST TENSIONING ASSEMBLIES TO TEMPORARILY ATTACH PIER THREE STRUCTURES.

THE 1 INCH DIAMETER (NOMINAL) ALL-THREAD BARS WITH A CROSS SECTIONAL AREA OF 0.85 SQUARE INCHES AND A MODULUS OF ELASTICITY OF 29,700 KSI SHALL BE ASTM A722 (TYPE II) GRADE 150 MANUFACTURED IN THE UNITED STATES. THE ANCHOR (SPHERICAL HEX) NUTS MUST BE ASTM A536. ANCHOR (DISHED) PLATES SHALL BE A572 GRADE 50.

GALVANIZED DISHED ANCHOR PLATES AND GALVANIZED SPHERICAL HEX NUTS SHALL BE COMPATIBLE WITH THE GALVANIZED ALL-THREAD BARS AND SHALL MEET THE REQUIREMENTS OF THE ALL-THREAD BAR MANUFACTURER'S POST TENSIONING SYSTEM. DISHED ANCHOR PLATES, SPHERICAL HEX NUTS AND ALL-THREAD BARS SHALL BE HOT DIP GALVANIZED IN ACCORDANCE WITH C&MS 711.02. ALL -THREAD BARS SHALL BE MECHANICALLY CLEANED (NOT ACID WASHED) TO AVOID PROBLEMS ASSOCIATED WITH HYDROGEN EMBRITTELMET.

END PLATE ASSEMBLIES SHALL BE HOT DIP GALVANIZED ACCORDING TO C&MS 711.02.

FABRIC PADS SHALL BEET THE REQUIREMENTS OF C&MS 711.21, PREFORMED BEARING PADS.

BAR CLAMPS SHALL BE 1/8 INCH INSIDE DIAMETER VIBRATION-DAMPING ROUTING CLAMPS.

ALL-THREAD BARS SHALL BE TENSIONED BY HYDRAULIC JACKS SO AS TO PRODUCE THE INDICATED FORCES.

EACH JACK USED TO TENSION THE BARS SHALL BE EQUIPPED WITH A PRESSURE GAUGE HAVING AN ACCURATE READING DIAL AT LEAST SIX INCHES IN DIAMETER FOR DETERMINING JACK PRESSURE. WITHIN 30 DAYS PRIOR TO USE FOR TENSIONING ON THE PROJECT, EACH JACK AND ITS GAUGE SHALL BE CALIBRATED AS A UNIT BY A TESTING LABORATORY APPROVED BY THE ENGINEER. CALIBRATION SHALL BE DONE WITH CYLINDER EXTENSION APPROXIMATELY IN THE POSITION THAT IT WILL BE WHEN APPLYING THE FINAL JACKING FORCE AND WITH THE JACK ASSEMBLY IN AN IDENTICAL CONFIGURATION TO THAT WHICH WILL BE USED AT THE JOB SITE (I.E. SAME LENGTH HYDRAULIC LINES). PERFORM THE CALIBRATION WITH THE JACK APPLYING LOAD TO THE TESTING MACHINE. FURNISH CERTIFIED CALIBRATION CALCULATIONS AND CALIBRATION CHART, BOTH IN ENGLISH UNITS OF MEASURE, TO THE ENGINEER FOR EACH JACK. THESE CERTIFICATIONS SHALL STATE THAT THE CALIBRATION TESTING WAS PERFORMED IN ACCORDANCE WITH THE SPECIFICATIONS FOR THE PROJECT. PRESSURE GAUGE READINGS ARE TO BE WITHIN THREE PERCENT OF THE ACTUAL APPLIED FORCE DURING CALIBRATION. IF PRESSURE GAUGE READINGS ARE NOT WITHIN THREE PERCENT OF THE APPLIED FORCE, THE SOURCE OF ERROR IS TO BE DETERMINED AND CORRECTED AND THE GAUGE RE CALIBRATED.

RE CALIBRATION OF EACH JACK SHALL BE DONE AS REQUESTED BY THE ENGINEER (SIX MONTH MINIMUM INTERVAL). AT THE OPTION OF THE CONTRACTOR, CALIBRATIONS SUBSEQUENT TO THE INITIAL LABORATORY CALIBRATION MAY BE ACCOMPLISHED BY USE OF A MASTER GAUGE. THE MASTER GAUGE SHALL BE SUPPLIED BY THE CONTRACTOR IN A PROTECTIVE WATERPROOF CONTAINER CAPABLE OF PROTECTING THE CALIBRATION OF THE MASTER GAUGE DURING SHIPMENT TO A LABORATORY. THE CONTRACTOR SHALL PROVIDE A QUICK-ATTACH COUPLER NEXT TO THE PERMANENT GAUGE IN THE HYDRAULIC LINES, WHICH ENABLES THE QUICK AND EASY INSTALLATION OF THE MASTER GAUGE TO VERIFY THE PERMANENT GAUGE READINGS. THE MASTER GAUGE SHALL REMAIN IN THE POSSESSION OF AND BE CALIBRATED BY THE ENGINEER FOR THE DURATION OF THE PROJECT. IF ANY REPAIR TO OR MODIFICATION OF A JACK IS ACCOMPLISHED, SUCH AS REPLACING THE SEALS OR CHANGING THE LENGTH OF HYDRAULIC LINES, THE JACK SHALL BE RE CALIBRATED BY THE APPROVED TESTING LABORATORY. JACKS AND GAUGES SHALL NOT BE INTERCHANGED WITHOUT RE CALIBRATION OR PROOF LOADING USING LOAD CELLS, MAST GAUGES OR OTHER METHODS APPROVED BY THE ENGINEER. NO EXTRA COMPENSATION WILL BE ALLOWED FOR THE INITIAL OR SUBSEQUENT JACK CALIBRATIONS OR FOR USE AND REQUIRED CALIBRATION OF A MASTER GAUGE.

THE FOLLOWING VALUES WERE CALCULATED

FINAL JACKING TENSION = 35 KIPS
ELONGATION = 1.56 INCHES

A RECORD OF GAUGE PRESSURES AND BAR ELONGATIONS FOR EACH BAR SHALL BE PROVIDED BY THE CONTRACTOR

FOR REVIEW AND APPROVAL BY THE ENGINEER. ELONGATIONS SHALL BE MEASURED TO AN ACCURACY OF +/- 1/16 INCH.

BASIS OF PAYMENT: THE WORK SHALL BE PAID FOR BY LUMP SUM FOR STRUCTURAL STEEL, MISC.: EXTERNAL POST TENSIONING. THE LUMP SUM UNIT SHALL INCLUDE ALL WORK NECESSARY TO TEMPORARILY SUPPORT THE PIERS BY EXTERNAL POST TENSIONING, INCLUDING BUT NOT LIMITED TO: ALL-THREAD BARS, DISHED ANCHOR PLATES, SPHERICAL HEX NUTS, END PLATE ASSEMBLIES, GALVANIZING, CLAMPS, EXPANSION ANCHORS, JACKING EQUIPMENT, CALIBRATING AND CERTIFYING JACKS, TEMPORARY OCI CONCRETE BETWEEN PIERS.

ITEM 601 CONCRETE SLOPE PROTECTION, AS PER PLAN

THIS ITEM INCLUDES REMOVAL AND REPLACEMENT OF EXISTING DETERIORATED CONCRETE SLOPE PROTECTION LOCATED AT THE FORWARD ABUTMENT.

REMOVE ALL CONCRETE PANELS WHERE FILL HAS WASHED OUT OR LOOSENED BELOW THE PANEL. BACKFILL AND COMPACT CAVITIES WITH 703.16 TYPE B MATERIAL AND PROVIDE 712.09 GEOTEXTILE FABRIC BELOW BETWEEN THE TYPE B AND EXISTING SOIL. SEE GENERAL PLAN FOR APPROXIMATE LOCATION.

CONSTRUCT NEW PANELS IN ACCORDANCE WITH ITEM 601.

THIS WORK WILL BE PAID FOR BY SQUARE FOOT BASIS FOR ITEM 601 CONCRETE SLOPE PROTECTION, AS PER PLAN AND INCLUDES ALL WORK NECESSARY TO COMPLETE THE ABOVE WORK.

ITEM 503 UNCLASSIFIED EXCAVATION, AS PER PLAN

THIS ITEM INCLUDES REMOVING MATERIALS FROM BEHIND THE EXISTING BACK BALL IN ORDER TO PERFORM ITEM 202, PORTIONS OF STRUCTURE REMOVED, AS PER PLAN. LIMITS OF EXCAVATION SHALL BE LIMITED BETWEEN THE PROPOSED WINGWALLS AND EXTEND TO THE END OF THE PROPOSED APPROACH SLABS AS DETAILED.

BACKFILL MATERIAL FOR ALL EXCAVATION BEHIND APPROACH SLABS AND BELOW APPROACH SLABS SHALL BE LOW STRENGTH MORTAR BACKFILL (LSM). LSM TYPE 1 SHALL CONFORM TO C&MS SECTION 613 AND BE PLACED WITHIN THE LIMITS OF THE APPROACH SLABS AND IT MAY ALSO BE USED TO CONSTRUCT THE SLOPES IN THE AREA AS LONG AS IT IS COVERED WITH ONE FOOT OF SOIL TO MATCH EXISTING GRADE. THE AREA FOR POROUS BACKFILL WITH GEOTEXTILE FABRIC SHALL BE FORMED PRIOR TO THE PLACEMENT OF LSM, TYPE 1 BACKFILL AND PLACEMENT OF THE GEOTEXTILE FABRIC SHALL BE PLACED AFTER LSM HAS CURED AND THE FORMS HAVE BEEN REMOVED.

PAYMENT TO PERFORM ALL WORK OUTLINED ABOVE SHALL BE INCLUDED IN THE LUMP SUM BID FOR ITEM 503 - UNCLASSIFIED EXCAVATION, AS PER PLAN AND SHALL INCLUDE ALL LABOR, EQUIPMENT, MATERIALS, AND INCIDENTALS NECESSARY TO COMPLETE THE WORK UNLESS SEPARATELY ITEMIZED IN THE PLANS.

ITEM 516 - 2" DEEP JOINT SEALER, AS PER PLAN

A 2" DEEP X 1" WIDE STRIP SHALL BE SAWCUT OUT OF THE APPROACH SLAB CONCRETE ABUTTING THE BRIDGE AFTER THE FINAL SURFACE HAS BEEN CONSTRUCTED. JOINT SEALER AS PER 705.04 SHALL BE USED TO SEAL THE JOINT CREATED.

\\d05fsi05\ProjectData\MUS\93006\400-Engineering\Sheet\070_1089C_SNO01.dgn 93006SNO01 4/1/2021 11:05 AM jhuffma3

DESIGN AGENCY
OHIO DEPARTMENT OF
TRANSPORTATION DISTRICT 5

DATE
12/2/2020
REVIEWED
JPH
STRUCTURE FILE NUMBER
6002706
DRAWN
JPH
CHECKED
MJB

BRIDGE NOTES
BRIDGE NO. MUS-70-1089
OVER LICKING RIVER & NEWARK RD.

MUS-70-10.49
PID No. 93006
3 / 52
1397
2231

MUS-70-1159 BRIDGE PLAN SUMMARY


Table with 2 columns: Description and Range. Includes items like SITE AND GENERAL PLANS, GENERAL NOTES AND QUANTITIES, STAGED CONSTRUCTION DETAILS, etc.

STANDARD PLAN DETAILING NOMENCLATURE


THROUGHOUT THE PLANS, SECTIONS AND DETAILS ARE REFERENCED TO THEIR CORRESPONDING VIEWS THROUGH THE USE OF STANDARD CALLOUTS. THE VIEWS OF SECTIONS, ELEVATIONS, AND DETAILS WILL HAVE UNIQUE NUMBERS ON THE PAGES ON WHICH THEY ARE SHOWN.

LETTERS WILL BE UTILIZED FOR SECTION AND ELEVATION CALLOUTS. NUMBERS WILL BE UTILIZED FOR DETAIL CALLOUTS.


IF A SECTION, ELEVATION, OR DETAIL VIEW IS ON THE SAME SHEET FROM WHICH IT IS CUT, THE CALLOUT WILL APPEAR AS FOLLOWS:

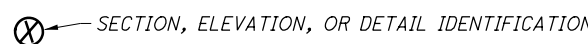

IF A SECTION, ELEVATION, OR DETAIL VIEW IS ON A DIFFERENT SHEET FROM WHICH IT IS CUT, THE CALLOUT WILL APPEAR AS FOLLOWS:

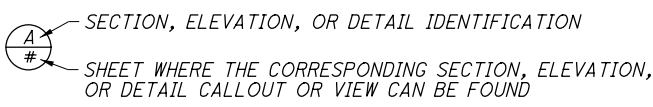

MEMBERS WILL BE IDENTIFIED AS FOLLOWS:

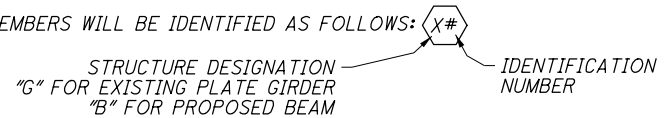

SURFACE SMOOTHNESS FOR BRIDGES AND APPROACHES

AT THE COMPLETION OF WORK FOR ALL PHASES OF CONSTRUCTION THE CONTRACTOR SHALL PERFORM THE FOLLOWING AS PER PROPOSAL NOTE 555:

- 1. CLEAN, SWEEP, AND PREPARE THE FINAL DECK AND FINAL ROADWAY SURFACE.
2. MEASURE, GRIND, AND RE-MEASURE THE BRIDGE AND/OR ROADWAY AS NECESSARY.
3. PERFORM GROOVING OF THE BRIDGE DECK.

RAILROAD CONSTRUCTION CLEARANCES

MAINTAIN A CONSTRUCTION CLEARANCE OF 13.00' HORIZONTALLY FROM THE CENTER OF TRACKS, AND 22.00' VERTICALLY FROM A POINT LEVEL WITH THE TOP OF THE HIGHER RAIL AND 6.00' FROM THE CENTER OF TRACKS, AT ALL TIMES.

STANDARD PLAN ABBREVIATIONS AND SYMBOLS

Table of abbreviations and symbols. Left column includes terms like ABUT, APP, AVE, BEAM NUMBER, BF, BM, BOT, BRG, BTWN, C.B., C/C, CB, CCTV, CIP, CJ, CJ-O, CLR, CMP, CMS, CONST, CP, CSP/N, CSP/P, DIA, DND, DPRM, E/P, E/S, EB, EF, ELEC, ELEV or EL, EX, EXP, F/F, FA, FF, FO, FTG, GIRDER NUMBER, GR, H.C., HORZ, I/I, IR, JT, LT, MAX, MH, MHC, MIN, MISC, MSE, MVC. Right column includes terms like NB, NE, NF, NO, NW, O/O, OD, OH, OVHD, ODOT, P.V.I., PC, PCB, PEJF, PGL, PI, PMVC, POT, PROP, PT, PVMT, RA, RCP, RD, REF, REINF., REQ'D, RT, R/W, S/O, SR, SB, SCD, SE, SER, SF, SHLDR, SPA, ST, STA, STD, STG, STM, SW, T/, T/B, T/T, TBR, TEMP, TYP, U.N.O., VC, VERT, WB, WW.

ITEM 530 - STRUCTURES: MEASUREMENTS FOR PROPOSED BEARINGS

THIS WORK CONSISTS OF VERIFYING THE EXISTING SUBSTRUCTURE DIMENSIONS, SEAT ELEVATIONS, AND EXISTING BEARING LOCATIONS AND HEIGHTS BEFORE FABRICATING THE PROPOSED BEARINGS. AT EACH LOCATION WHERE NEW BEARINGS WILL SIT ATOP EXISTING BEARING SEATS, THE CONTRACTOR SHALL VERIFY THAT THE PLAN DIMENSIONS AND ELEVATIONS MATCH THE EXISTING CONDITIONS USED IN THESE PLANS. A REPORT DETAILING EXISTING HORIZONTAL CLEARANCES AND SEAT ELEVATIONS COMPARED TO THOSE IN THE PLANS SHALL BE SUBMITTED TO THE ENGINEER FOR REVIEW PRIOR TO BEARING FABRICATION. ANY PROPOSED HEIGHT ADJUSTMENTS SHALL BE SUBMITTED ALONG WITH THE REPORT. ADDITIONALLY, AT LOCATIONS WHERE THE PROPOSED BEARINGS REQUIRE ANCHORAGE, CONTRACTOR SHALL VERIFY LOCATIONS OF THE EXISTING BEAM SEAT REINFORCING, ADJUST THE ANCHOR HOLE LOCATIONS TO CLEAR THE REINFORCING AS NECESSARY, AND INCORPORATE THE ADJUSTED ANCHOR HOLE LOCATIONS INTO THE BEARING SHOP DRAWINGS AND FABRICATION.

ITEM 530 - STRUCTURES: MEASUREMENTS FOR PROPOSED BEARINGS (CONT'D)

THE DEPARTMENT WILL MEASURE THE WORK ON A LUMP SUM BASIS AND PAY FOR ACCEPTED QUANTITIES AT THE LUMP SUM CONTRACT PRICE. PAYMENT IS FULL COMPENSATION FOR THE ACCESS, MEASUREMENT, DOCUMENTATION, AND REPORTING OF REQUIRED DATA, INCLUDING MARKUPS OF REQUIRED ADJUSTMENTS TO BEARING HEIGHTS AND ANCHOR HOLE LOCATIONS. FABRICATED BEARING HEIGHTS SHALL BE ADJUSTED TO MATCH CONTRACTOR BEARING MEASUREMENTS. BEARING HEIGHT ADJUSTMENTS OF 3" OR LESS SHALL BE CONSIDERED INCIDENTAL TO THE COST OF THE BEARINGS.

MUS-70-1159 BRIDGE SUMMARY - 02/IMS/BR

CALC: ST/RSN CHECK: CTM

SUBMITTAL: Stage 3
 PLOT DRIVER: 000Tcodd_PDF.plt
 PENTABLE: 93006-0001V81_Pen.tbl
 pw:\gfnnet-pw.bentley.com:gfnnet-pw-0\Documents\Projects\6477\93006\401-Engineering-GannettFleming\Structures\MUS-70-1159\Sheets\02_s001_4/8/2021 3:13:08 PM modonnell

ITEM	ITEM EXT.	TOTAL QUANTITY	TOTAL PER PHASE				UNIT	DESCRIPTION	PHASE 1			PHASE 2			PHASE 3			GENERAL	APP/REF SHEET NO.
			PH 1	PH 2	PH 3	GEN			ABUT.	PIERS	SUPER	ABUT.	PIERS	SUPER	ABUT.	PIERS	SUPER		
202	11203	LS				LS	PORTIONS OF STRUCTURE REMOVED, OVER 20 FOOT SPAN, AS PER PLAN										LS	13	
202	22900	768	228	286	254		APPROACH SLAB REMOVED	228			286			254					
503	11100	LS				LS	COFFERDAMS AND EXCAVATION BRACING										LS		
503	21301	LS	LS	LS	LS		UNCLASSIFIED EXCAVATION, AS PER PLAN	LS			LS			LS				14	
509	10001	1,134,875	382,879	396,441	355,555		EPOXY COATED REINFORCING STEEL, AS PER PLAN	3,504	3,406	375,969	3,467	3,733	389,241	2,995	4,140	348,420		13	
509	20001	300				300	REINFORCING STEEL, REPLACEMENT OF EXISTING REINFORCING STEEL, AS PER PLAN										300	13	
510	10001	788	209	321	258		DOWEL HOLES WITH NONSHRINK, NONMETALLIC GROUT, AS PER PLAN	59	150		129	192		114	144			13	
511	33500	4	4				SEMI-INTEGRAL DIAPHRAGM GUIDE	4											
511	34447	3,279	1,065	1,205	1,009		CLASS QC2 CONCRETE WITH QC/QA, BRIDGE DECK, AS PER PLAN			1,065			1,205			1,009		14	
511	34451	433	433				CLASS QC2 CONCRETE WITH QC/QA, BRIDGE DECK (PARAPET), AS PER PLAN			433								14	
511	34463	298		147	151		CLASS QC SCC CONCRETE WITH QC/QA, BRIDGE DECK (PARAPET), AS PER PLAN						147			151		14	
511	42512	131	46	43	42		CLASS QCI CONCRETE WITH QC/QA, PIER CAP		46			43			42			14	
511	45712	80	20	32	28		CLASS QCI CONCRETE WITH QC/QA, ABUTMENT	20			32			28				14	
512	10050	8,985	3,419	2,867	2,699		SEALING OF CONCRETE SURFACES (NON-EPOXY)	208	667	2,544	550	715	1,602	543	806	1,350			
512	10300	1,016		603	413		SEALING CONCRETE BRIDGE DECKS WITH HMWM RESIN						603			413			
512	10601	100				100	CONCRETE REPAIR BY EPOXY INJECTION, AS PER PLAN										100	14	
512	33000	131	31	49	51		TYPE 2 WATERPROOFING	31			49			51					
513	10260	1,211,292	372,132	436,885	402,275		STRUCTURAL STEEL MEMBERS, LEVEL 3			372,132			436,885			402,275			
513	20000	14,355	14,355	14,355	14,355		WELDED STUD SHEAR CONNECTORS			14,355			14,355			14,355			
514	00050	193,100	76,700	57,400	59,000		SURFACE PREPARATION OF EXISTING STRUCTURAL STEEL			76,700			57,400			59,000			
514	00056	193,100	76,700	57,400	59,000		FIELD PAINTING OF EXISTING STRUCTURAL STEEL, PRIME COAT			76,700			57,400			59,000			
514	00061	262,000	97,000	84,300	80,700		FIELD PAINTING STRUCTURAL STEEL, INTERMEDIATE COAT, AS PER PLAN			97,000			84,300			80,700		14	
514	00067	262,000	97,000	84,300	80,700		FIELD PAINTING STRUCTURAL STEEL, FINISH COAT, AS PER PLAN			97,000			84,300			80,700		14	
514	00504	108	43	33	32		GRINDING FINS, TEARS, SLIVERS ON EXISTING STRUCTURAL STEEL			43			33			32			
514	10000	104	37	41	26		FINAL INSPECTION REPAIR			37			41			26			
516	11211	248	75	98	75		STRUCTURAL EXPANSION JOINT INCLUDING ELASTOMERIC STRIP SEAL, AS PER PLAN		75			98			75			146	
516	13601	60	40	10	10		1" PREFORMED EXPANSION JOINT FILLER, AS PER PLAN	40			10			10				14	
516	13901	287	175	54	58		2" PREFORMED EXPANSION JOINT FILLER, AS PER PLAN	175			54			58				14	
516	14020	298	77	124	97		SEMI-INTEGRAL ABUTMENT EXPANSION JOINT SEAL	77			124			97					
516	14600	330	95	128	107		STRUCTURAL JOINT OR JOINT SEALER, MISC.: EMSEAL WITH SLEEPER SLAB	95			128			107				151	
516	44101	90	32	28	30		ELASTOMERIC BEARING WITH INTERNAL LAMINATES AND LOAD PLATE (NEOPRENE), AS PER PLAN, DIMENSIONS VARY	12	20		11	17		12	18			69	
516	46900	20	8	6	6		BEARING DEVICE, MISC.: ELASTOMERIC BEARING WITH INTERNAL LAMINATES, LOAD PLATE, AND PTFE SURFACE		8			6			6			71	
516	46900	55	20	17	18		BEARING DEVICE, MISC.: SEISMIC ISOLATION BEARING		20			17			18			73	
516	47001	LS				LS	JACKING AND TEMPORARY SUPPORT OF SUPERSTRUCTURE, AS PER PLAN										LS	14	
518	12201	52	17	13	22		SCUPPERS, INCLUDING SUPPORTS, AS PER PLAN			17			13			22		14	
518	21200	35	11	14	10		POROUS BACKFILL WITH GEOTEXTILE FABRIC	11			14			10				14	
518	63300	LS				LS	STRUCTURE DRAINAGE, MISC.: BRIDGE DRAINAGE SYSTEM, AS PER PLAN										LS	14	
519	11101	1,000				1,000	PATCHING CONCRETE STRUCTURE, AS PER PLAN										1,000	14	
526	25010	798	194	334	270		REINFORCED CONCRETE APPROACH SLABS WITH QC/QA (T=15")			194			334			270			
SPECIAL	53000200	LS	LS	LS	LS		STRUCTURES - MEASUREMENTS FOR PROPOSED BEARINGS			LS			LS			LS		12	
SPECIAL	53000600	5,766		2,811	2,955		STRUCTURES - AESTHETIC TREATMENT (CONCRETE FORMLINER/STAIN)						2,811			2,955		14	
607	39900	1,883		916	967		VANDAL PROTECTION FENCE, 6' STRAIGHT, COATED FABRIC						916			967			
607	39930	886		886			VANDAL PROTECTION FENCE, 12' CURVED, COATED FABRIC						886						
613	41201	646	166	250	230		LOW STRENGTH MORTAR BACKFILL, AS PER PLAN	166			250			230				14	

DESIGN AGENCY: **Gannett Fleming**
 ENGINEERS & ARCHITECTS, P.C.
 2800 CORPORATE EXCHANGE DRIVE, SUITE 230
 COLUMBUS, OHIO 43231

DATE: 12/2020
 REVIEWED: MTO
 DRAWN: RSN
 DESIGNED: RSN
 CHECKED: CTM


STRUCTURE FILE NUMBER: 6002854
 BRIDGE NO.: MUS-70-1159
 OVER LINDEN AVE, OHCR & CUOH RAILROADS, AND MUSKINGUM RIVER

BRIDGE SUMMARY
 MUS-70-10.49
 PID No. 93006



15 / 160

1461
2231



SUBMITTAL Stage 3
 PID: 93006
 PLOT DRIVER: 000Tcodd_PDF.pltcf9
 PENTABLE: 93006_0001V81_Pen.tbl
 pw:\gfn\pw.bentley.com\gfn\Projects\401-Engineering-GannettFleming\MUS070\159L\Sheets\074 sb004 4/8/2021 1:48:13 PM modonnell

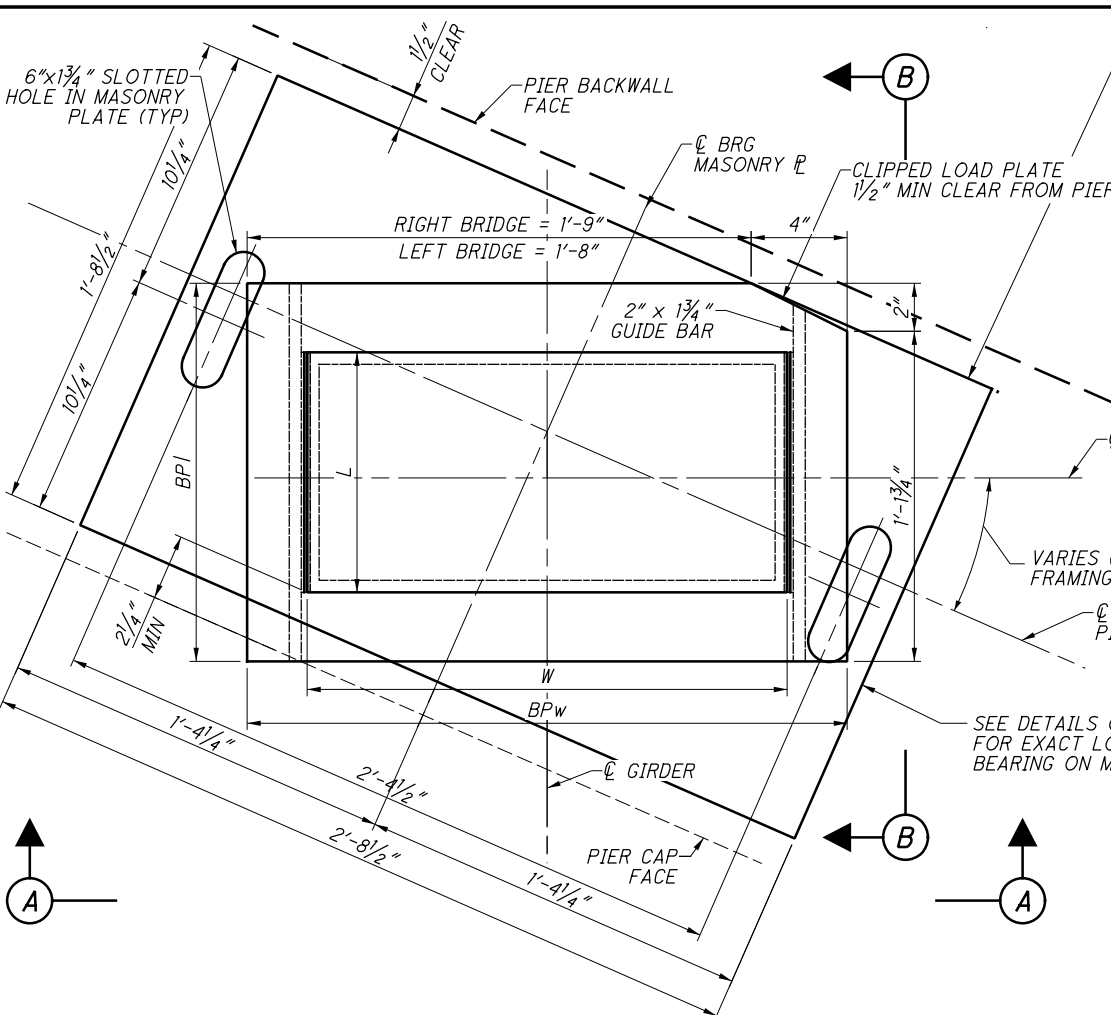


EXPANSION BEARING WITH MASONRY PLATE
 PIER 2 (FWD) SHOWN, PIER 7 (REAR) SIMILAR. TYP AT GIRDERS 3 & 8

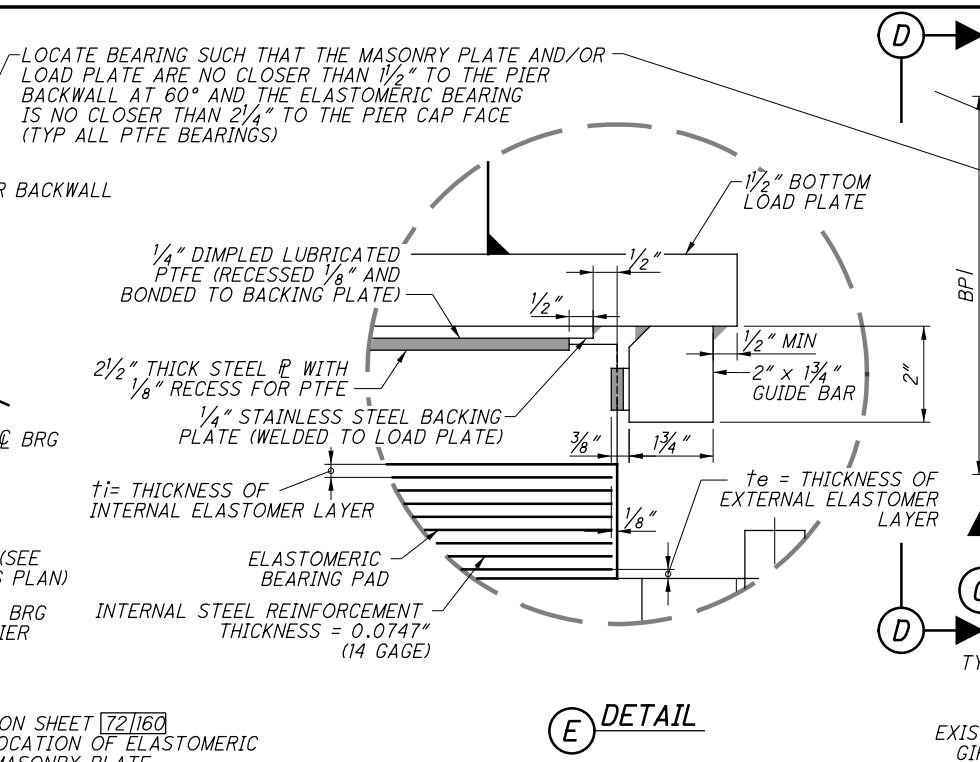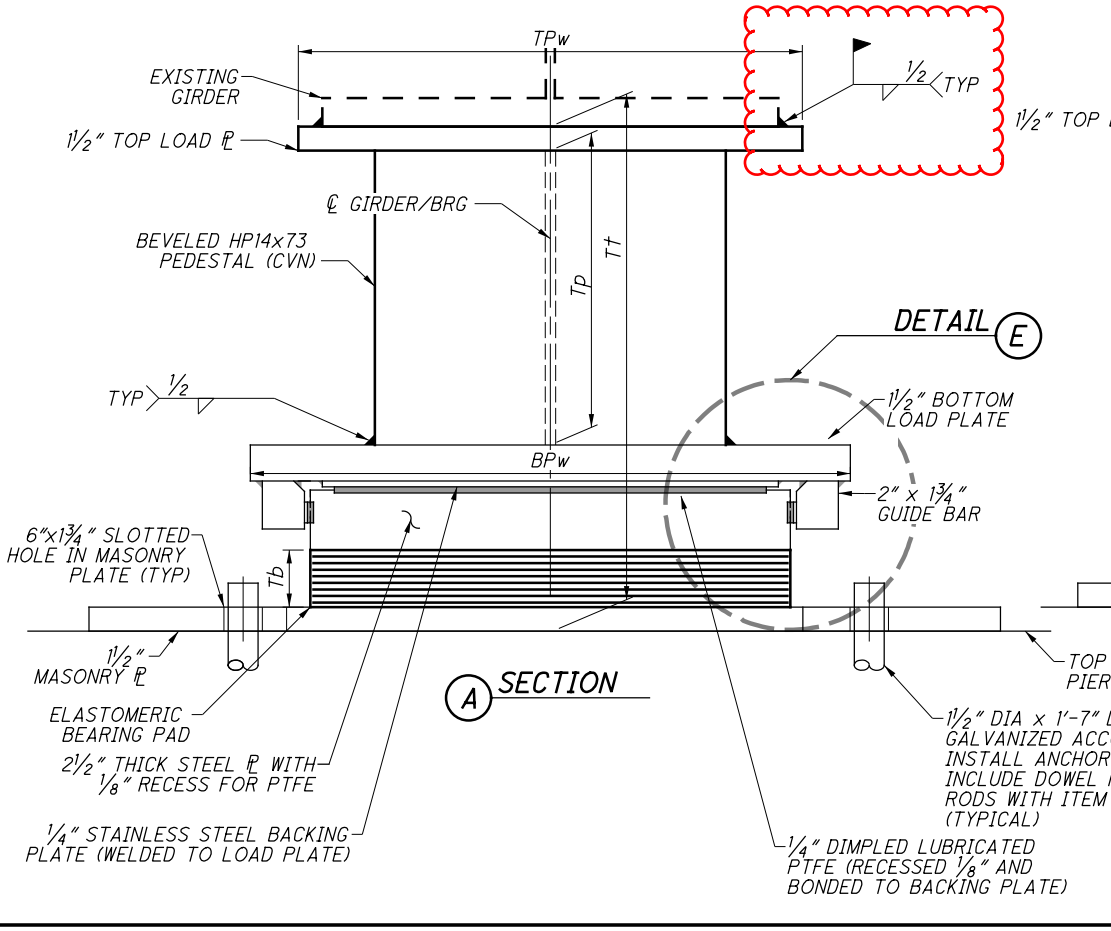

MAX REACTION TABLE FOR PTFE BEARINGS				
SUPPORT	BEARING TYPE	DEAD LOAD (KIPS)	LIVE LOAD (KIPS)	TOTAL LOAD (KIPS)
PIER 2 (FWD)-LEFT BRIDGE	EXP	91.23	128.88	220.11
PIER 2 (FWD)-RIGHT BRIDGE	EXP	128.99	115.41	244.4
PIER 7 (REAR)-LEFT BRIDGE	EXP	91.3	123.5	214.8
PIER 7 (REAR)-RIGHT BRIDGE	EXP	110.71	98.5	209.21

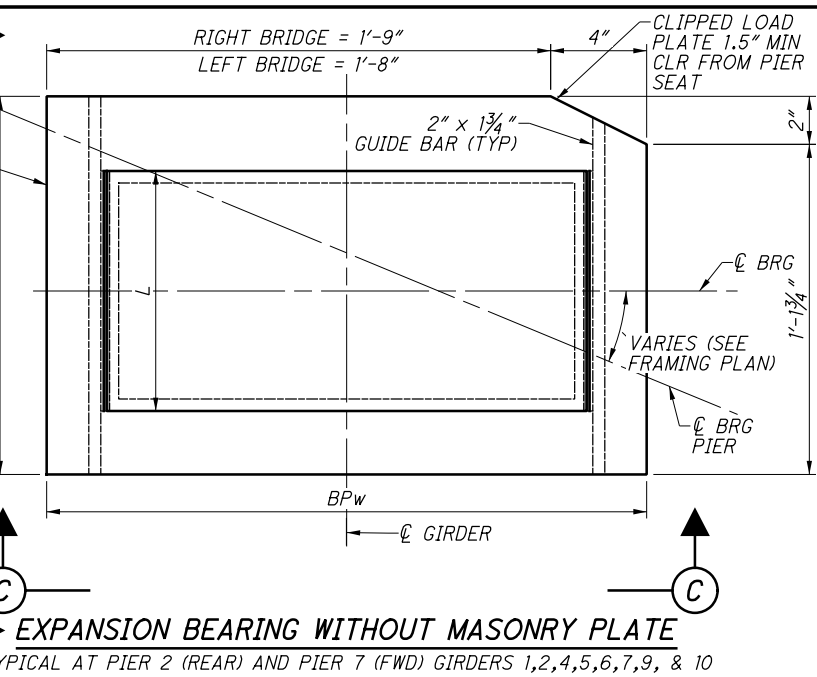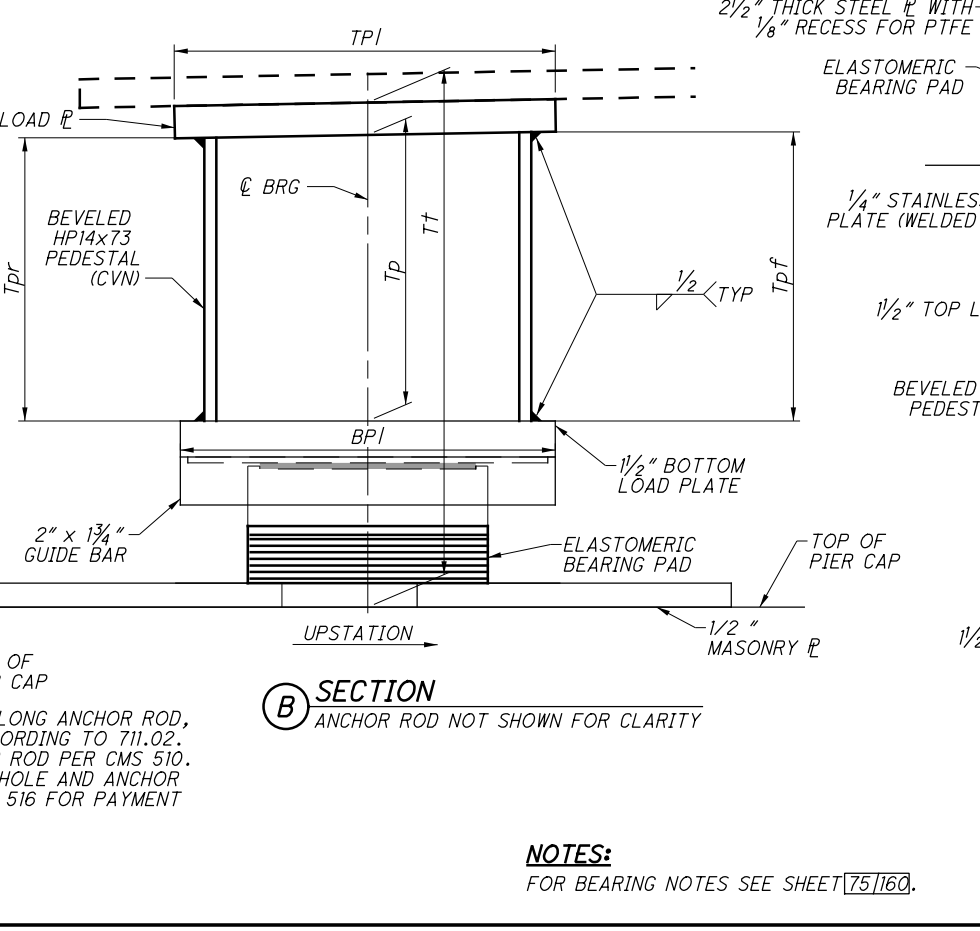


EXPANSION BEARING WITHOUT MASONRY PLATE
 TYPICAL AT PIER 2 (REAR) AND PIER 7 (FWD) GIRDERS 1,2,4,5,6,7,9, & 10

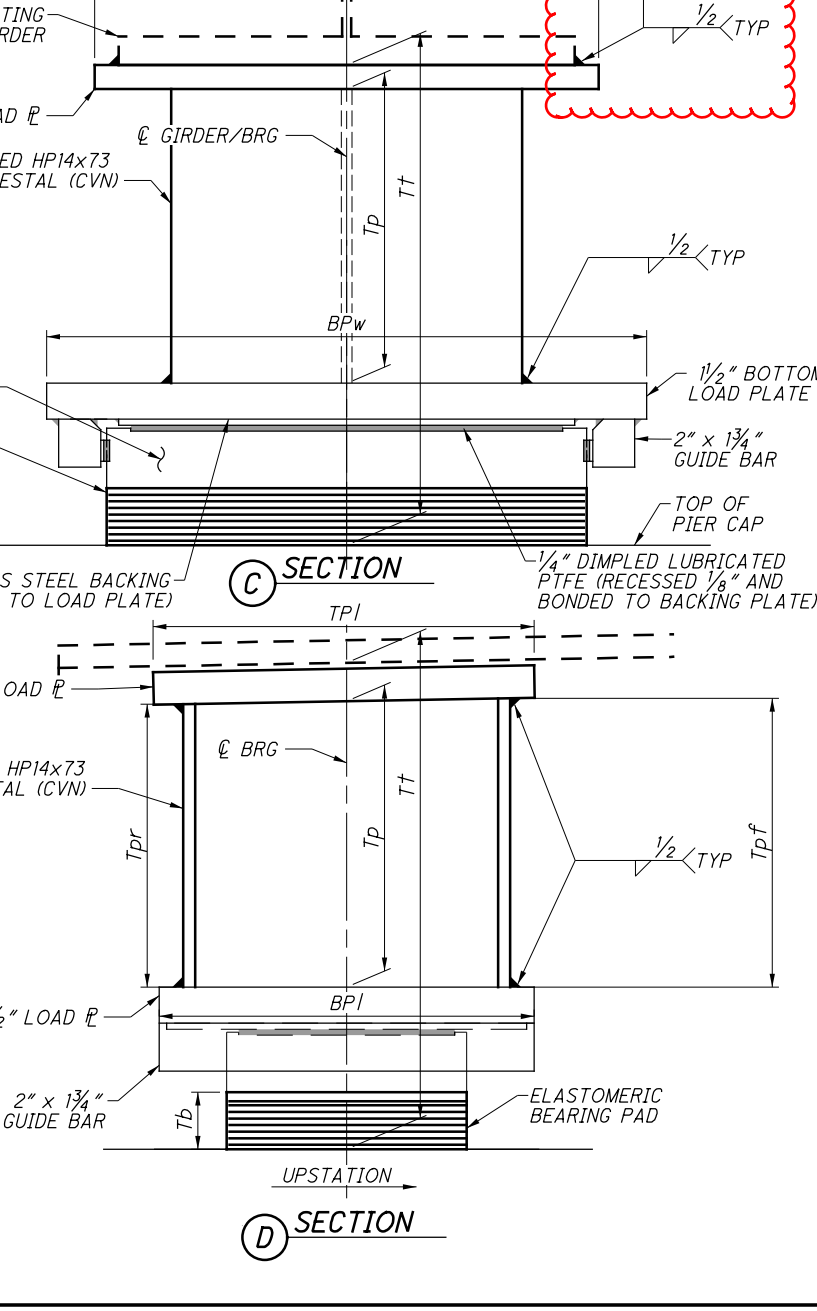

NOTES:
 FOR BEARING NOTES SEE SHEET 75/160.


SUBMITTAL: Stage 3
 PLOT DRIVER: 000Tcodd_PDF.plt
 PENTABLE: 93006_0001V81_Pen.tbl
 pw:\gtnet-pw.bentley.com\gtnet-pw-0\Documents\Projects\6477193006_401-Engineering-GannettFleming\Structures\MUS070_1159\Sheets\097_st001_4/7/2021\2:58:05 PM modonnell

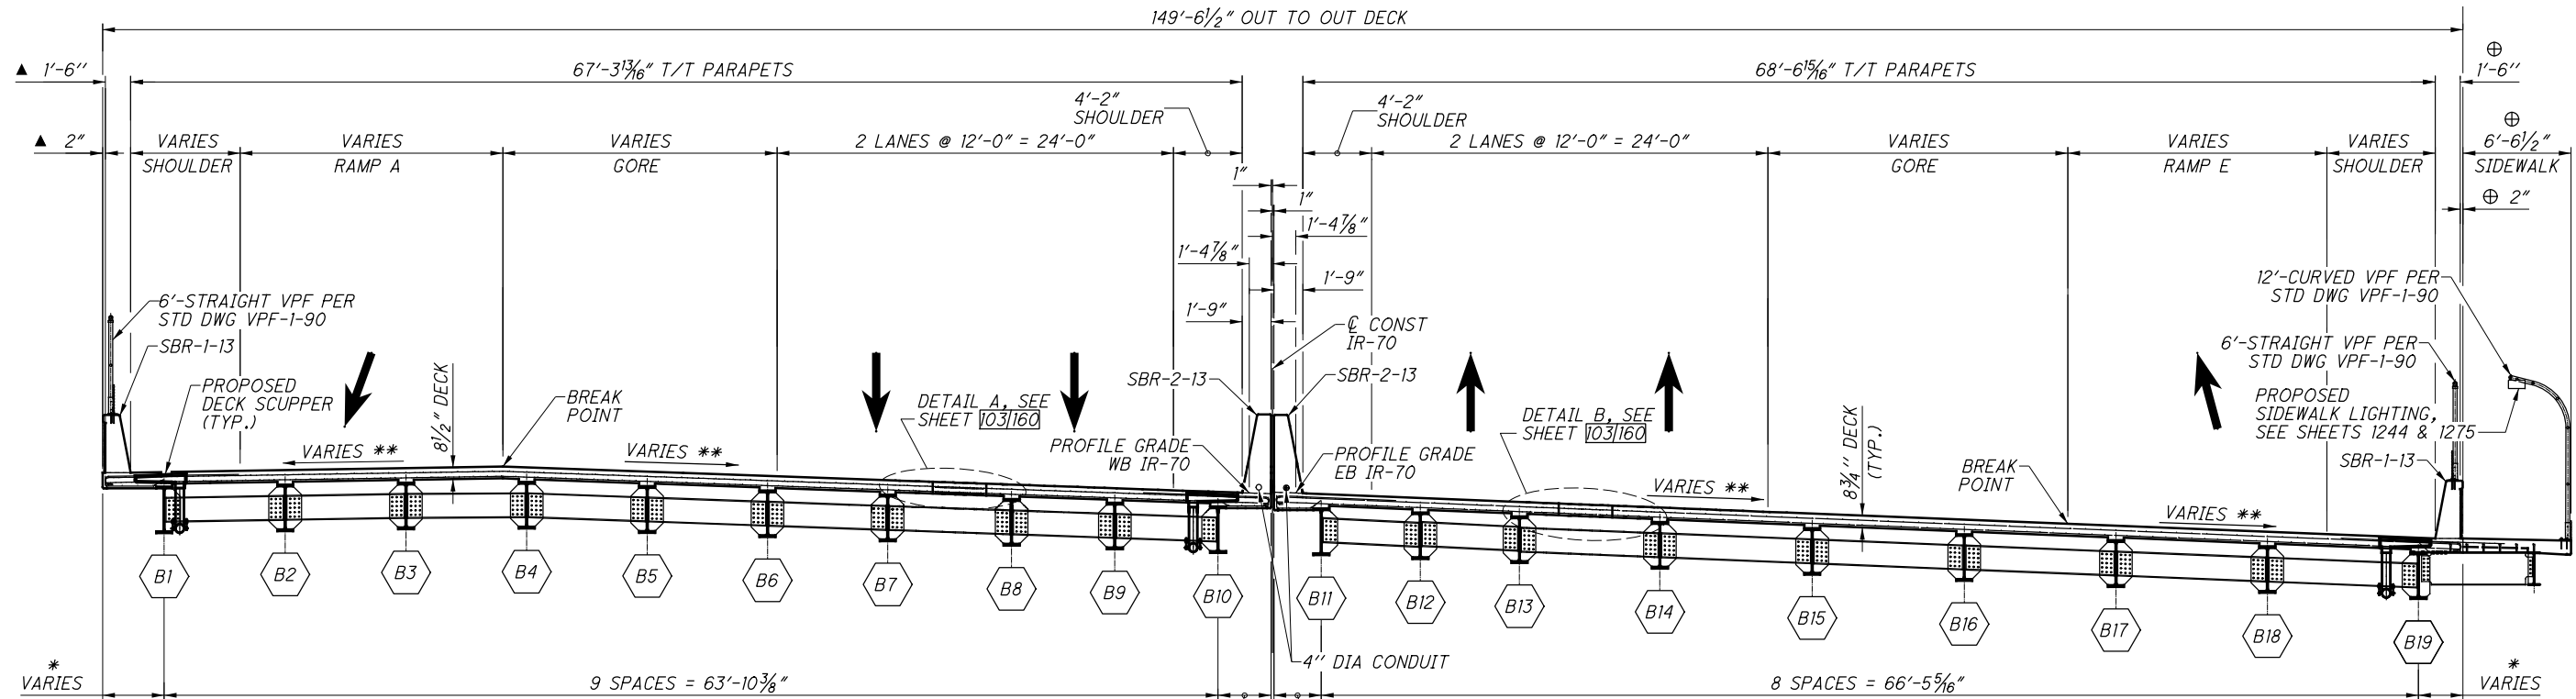


* SEE SHEET 114/160 FOR HORIZONTAL OVERHANG OFFSETS.

** SEE SHEET 9/160 TO 11/160 FOR SUPERELEVATION DIAGRAMS.

TRANSVERSE SECTION AT REAR ABUTMENT
LOOKING UPSTATION

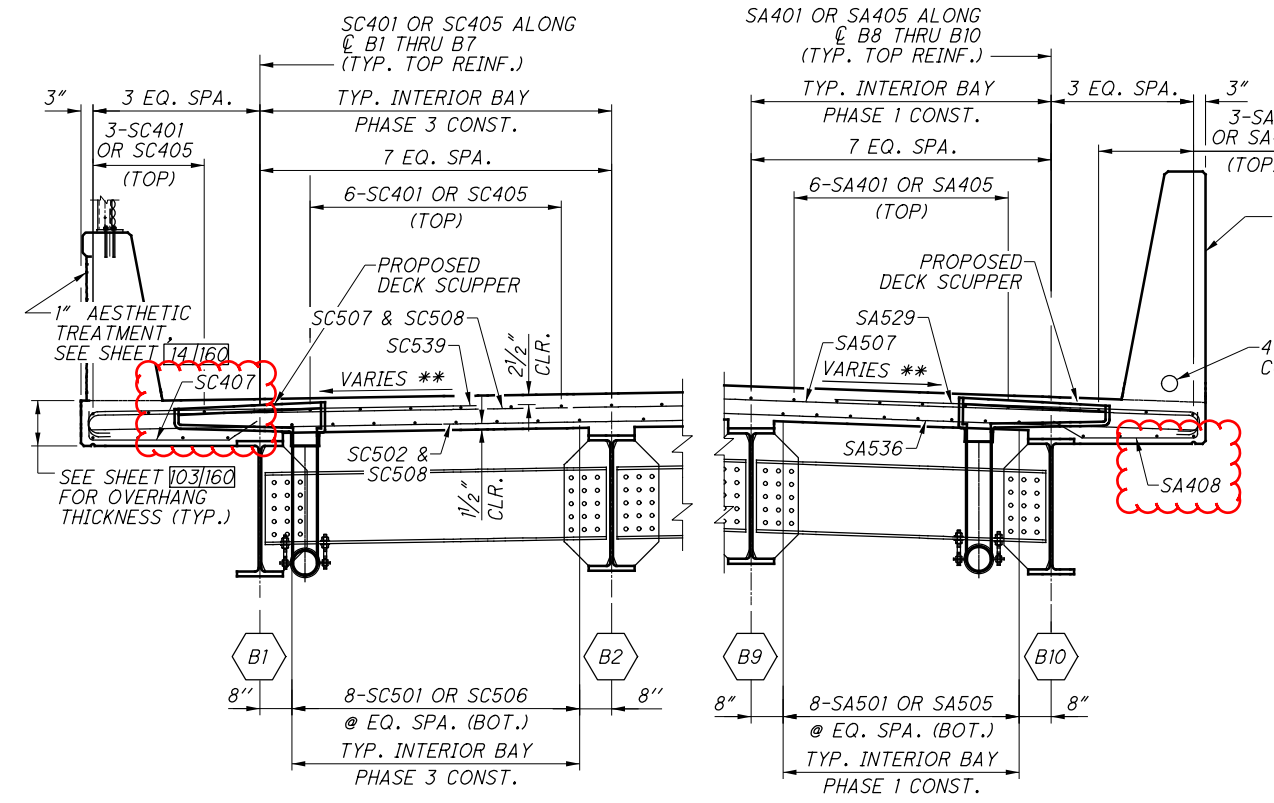

REINFORCING DETAILS-WEST BOUND STRUCTURE

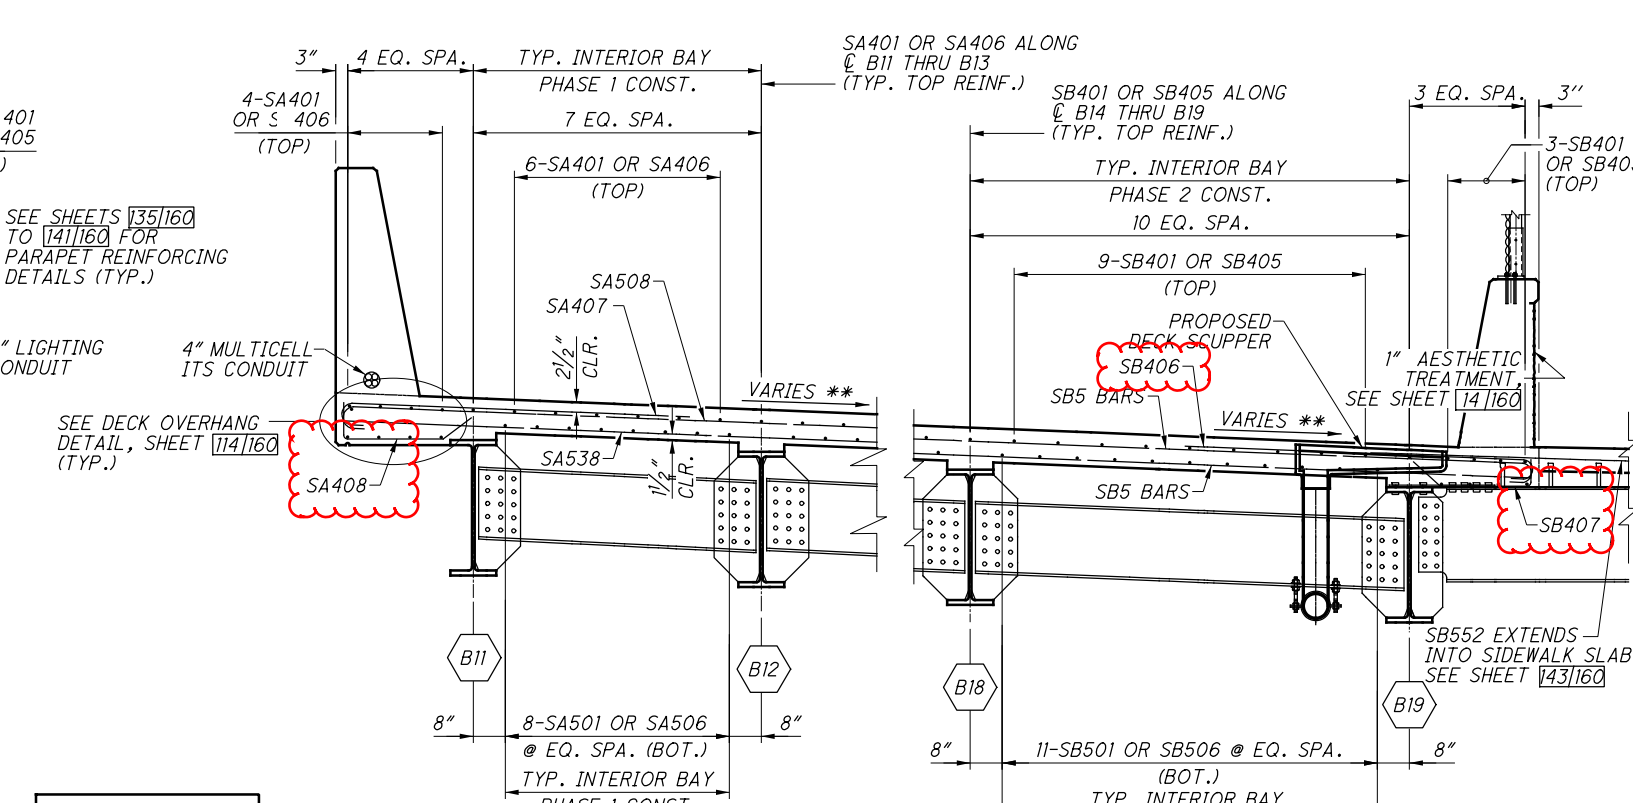

REINFORCING DETAILS-EAST BOUND STRUCTURE

MINIMUM REINFORCEMENT LAP LENGTHS (TYP. U.N.O.)	
#4	2'-0"
#5	2'-5"
#6	3'-0"

- NOTES:**
- DIMENSIONS ARE MEASURED PERPENDICULAR TO C CONST IR-70 UNLESS NOTED OTHERWISE.
 - SEE SHEET 103/160 FOR CLOSURE POUR DETAILS AND ADDITIONAL NOTES.
 - REFER TO SHEET 1897 OF 2231 FOR ADDITIONAL PARAPET AESTHETIC DETAILS.

- ▲ DIMENSION MEASURED PERPENDICULAR TO C CONST RAMP A.
- ⊕ DIMENSION MEASURED PERPENDICULAR TO C CONST RAMP E.

DESIGN AGENCY
GannettFleming
ENGINEERS & ARCHITECTS, P.C.
2800 CORPORATE EXCHANGE DRIVE, SUITE 230
COLUMBIAS, OHIO 43231

DATE
12/2020

REVIEWED
MTO

DRAWN
JM

DESIGNED
TMF

CHECKED
JAY

STRUCTURE FILE NUMBER
6002854

BRIDGE NO. MUS-70-1159

OVER LINDEN AVE, OHCR & CUOH RAILROADS, AND MUSKINGUM RIVER


MUS-70-10-49

PID No. 93006

98/160

1544
2231


SUBMITTAL: Stage 3
 PLOT DRIVER: 000Tcodd_PDF.plt
 PLOT: 93006_000T181_Pen.tbl
 PENTABLE: 93006_000T181_Pen.tbl
 pw:\gtnet-pw.bentley.com\gtnet-pw-0\Documents\Projects\6477193006\401-Engineering-GannettFleming-GannettFleming\Structures\MUS070-1159\Sheets\098_st002_47712012:58:21PM_modonnell

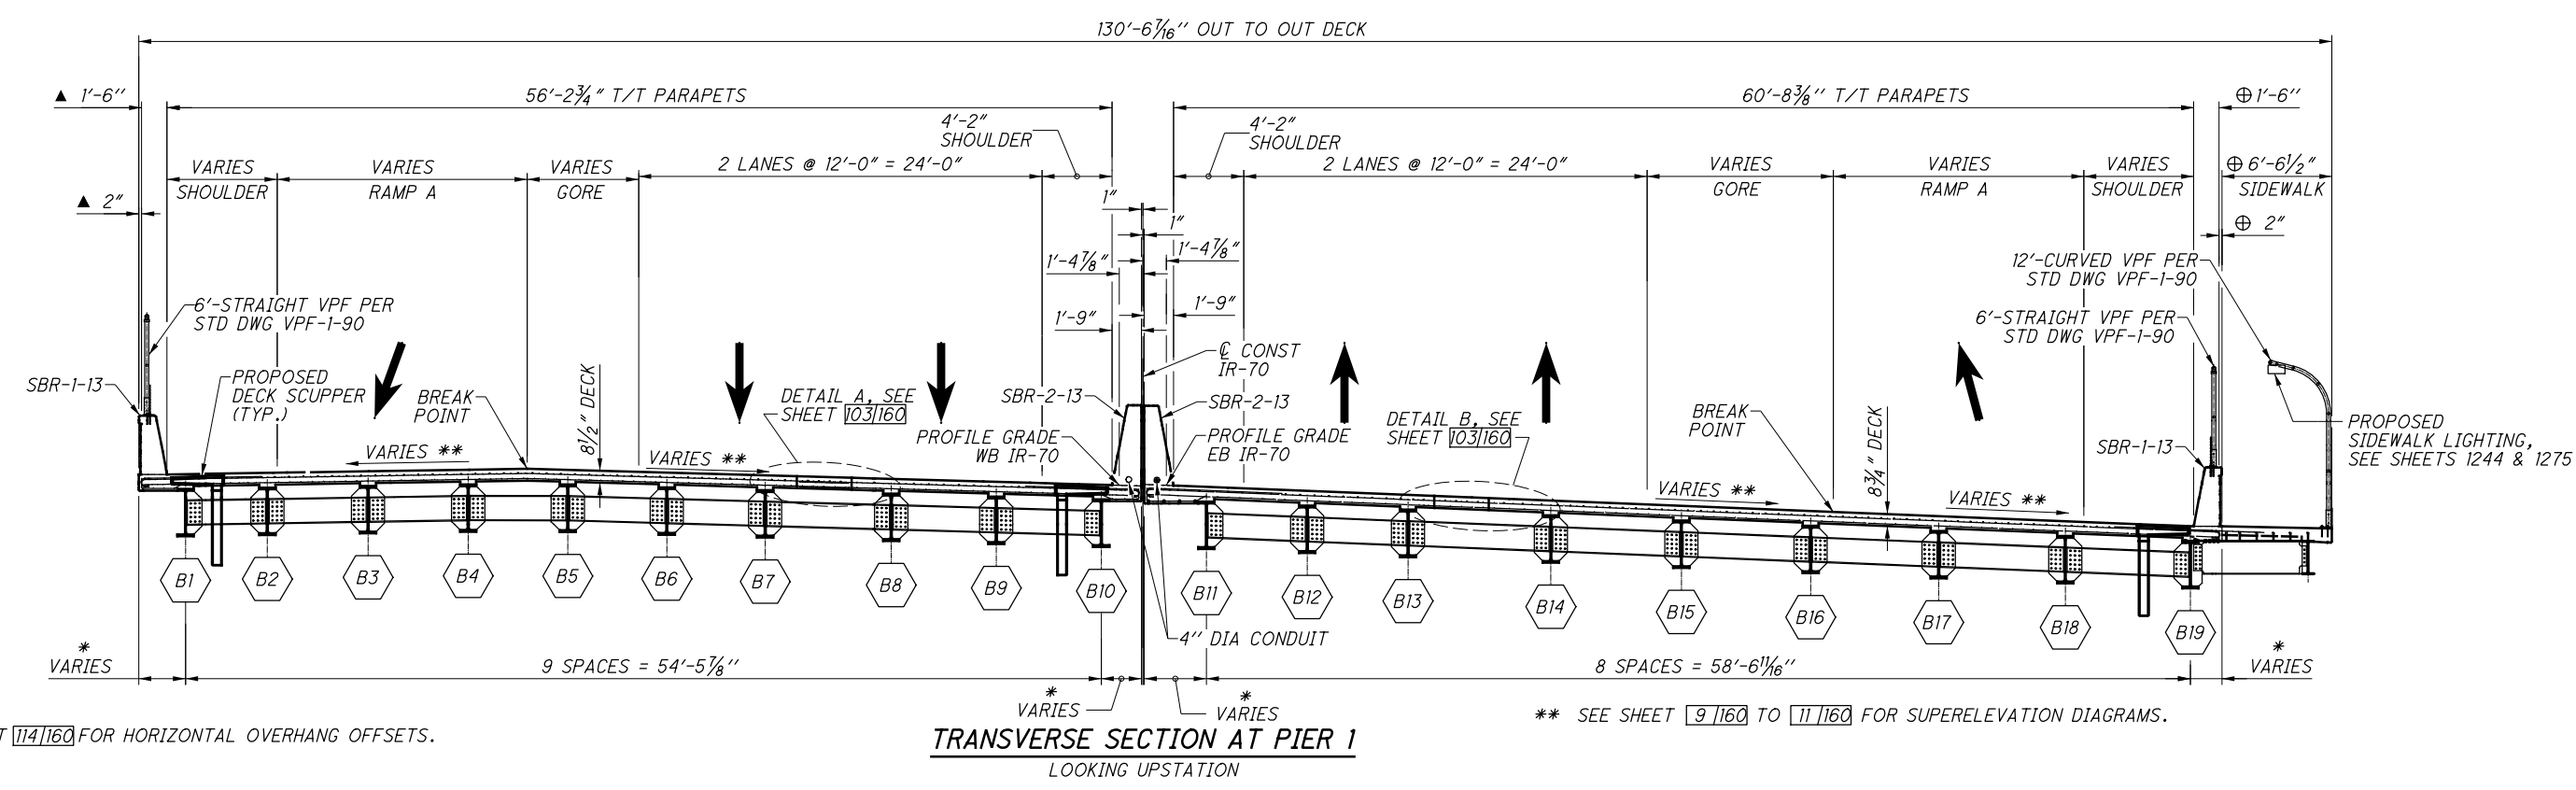

* SEE SHEET 1141160 FOR HORIZONTAL OVERHANG OFFSETS.

** SEE SHEET 91160 TO 111160 FOR SUPERELEVATION DIAGRAMS.

TRANSVERSE SECTION AT PIER 1
LOOKING UPSTATION

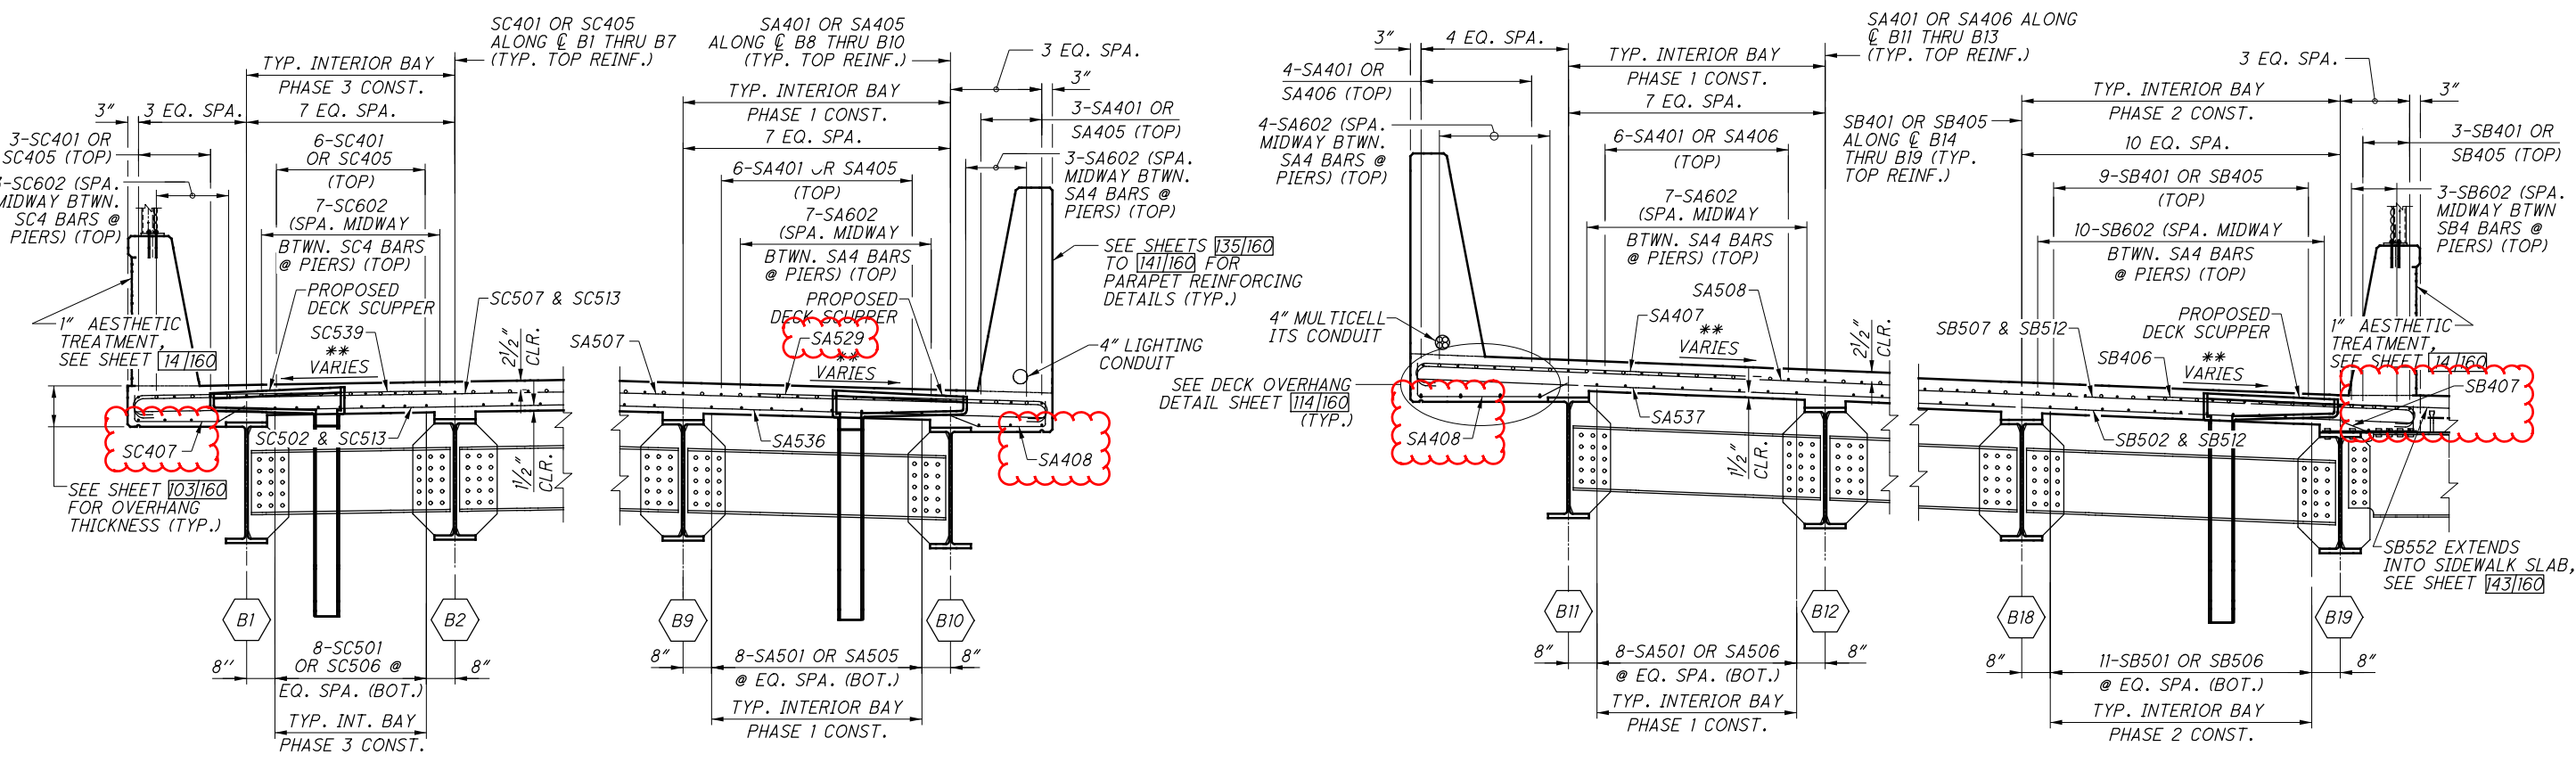

REINFORCING DETAILS-WEST BOUND STRUCTURE

REINFORCING DETAILS-EAST BOUND STRUCTURE

MINIMUM REINFORCEMENT LAP LENGTHS (TYP. U.N.O.)	
#4	2'-0"
#5	2'-5"
#6	3'-0"

- ▲ DIMENSION MEASURED PERPENDICULAR TO @ CONST RAMP A.
- ⊕ DIMENSION MEASURED PERPENDICULAR TO @ CONST RAMP E.

- NOTES:**
- DIMENSIONS ARE MEASURED PERPENDICULAR TO @ CONST IR-70 UNLESS NOTED OTHERWISE.
 - SEE SHEET 1031160 FOR CLOSURE POUR DETAILS AND ADDITIONAL NOTES.
 - REFER TO SHEET 1897 OF 2231 FOR ADDITIONAL PARAPET AESTHETIC DETAILS.

DESIGN AGENCY
Gannett Fleming
ENGINEERS & ARCHITECTS, P.C.
2800 CORPORATE EXCHANGE DRIVE SUITE 230
COLUMBIUS, OHIO 43231

DATE
12/2020

REVIEWED
MTO

DESIGNED
TMF

DRAWN
JM

BRIDGE NO. MUS-70-1159

STRUCTURE FILE NUMBER
6002854

TRANSVERSE SECTION AT PIER 1

OVER LINDEN AVE, OHCR & CUOH RAILROADS, AND MUSKINGUM RIVER


MUS-70-10.49

PID No. 93006

99/160



1545
2231

SUBMITTAL: Stage 3
 PLOT DRIVER: 000Tcodd_PDF.plt
 PLOT: 93006
 PENTABLE: 93006_000T181_Pen.tbl
 pw:\gfnnet-pw.bentley.com\gfnnet-pw-0\Documents\Projects\6477\93006\401-Engineering-GannettFleming\Structures\MUS070_1159\Sheets\099 st003 477\2021\2:58:56 PM modonnell

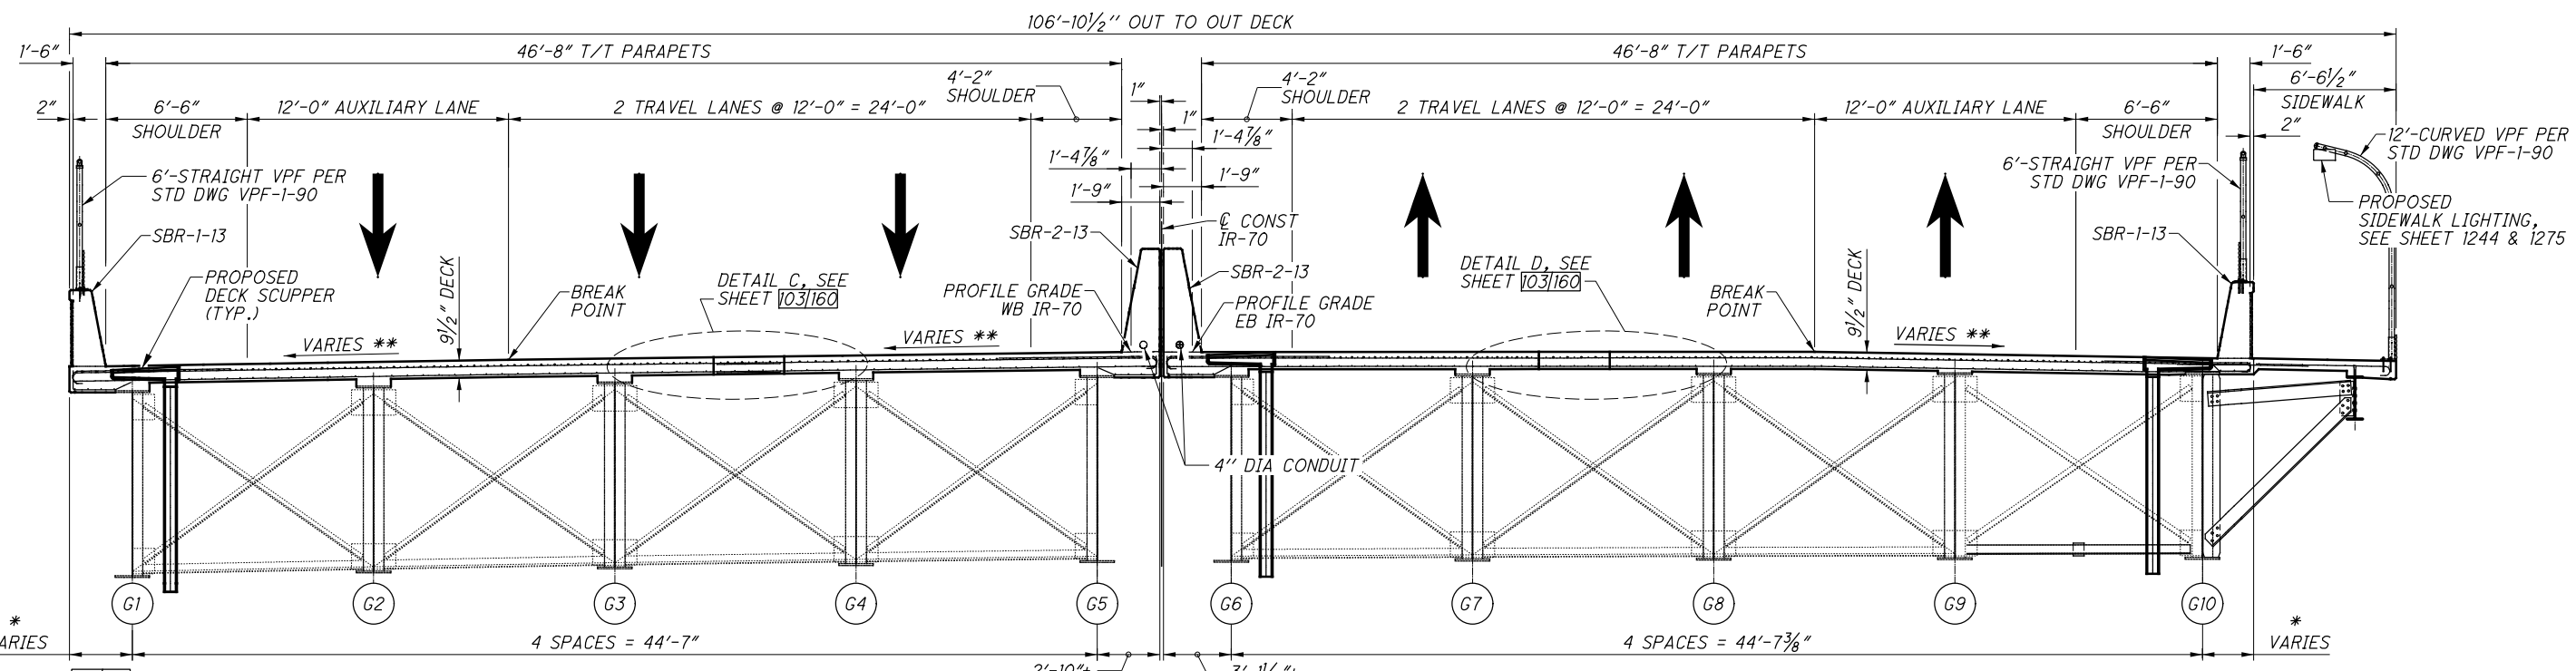


* SEE SHEET 1141160 FOR HORIZONTAL OVERHANG OFFSETS.

** SEE SHEET 91160 TO 111160 FOR SUPERELEVATION DIAGRAMS.

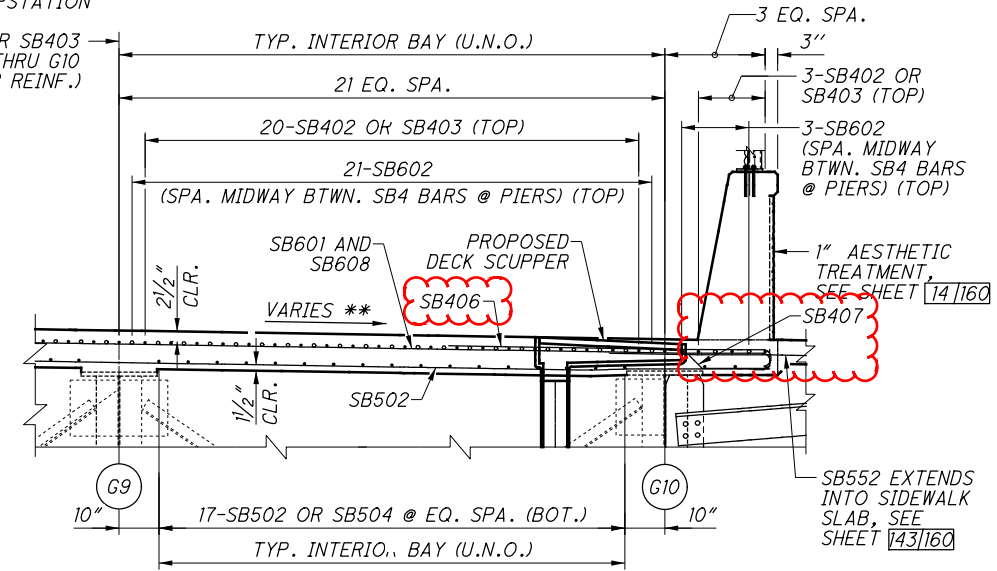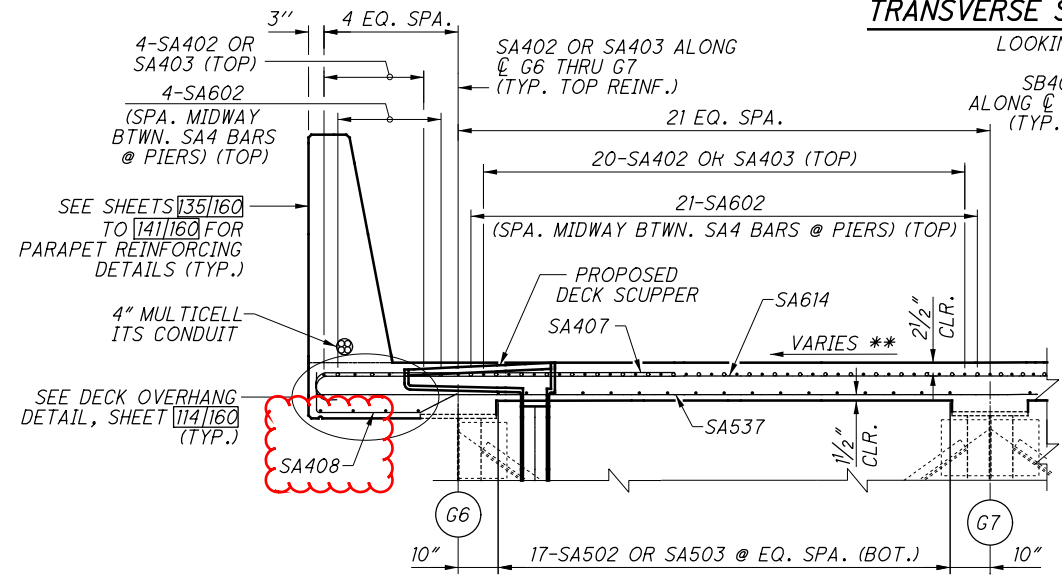

REINFORCING DETAILS-EAST BOUND STRUCTURE

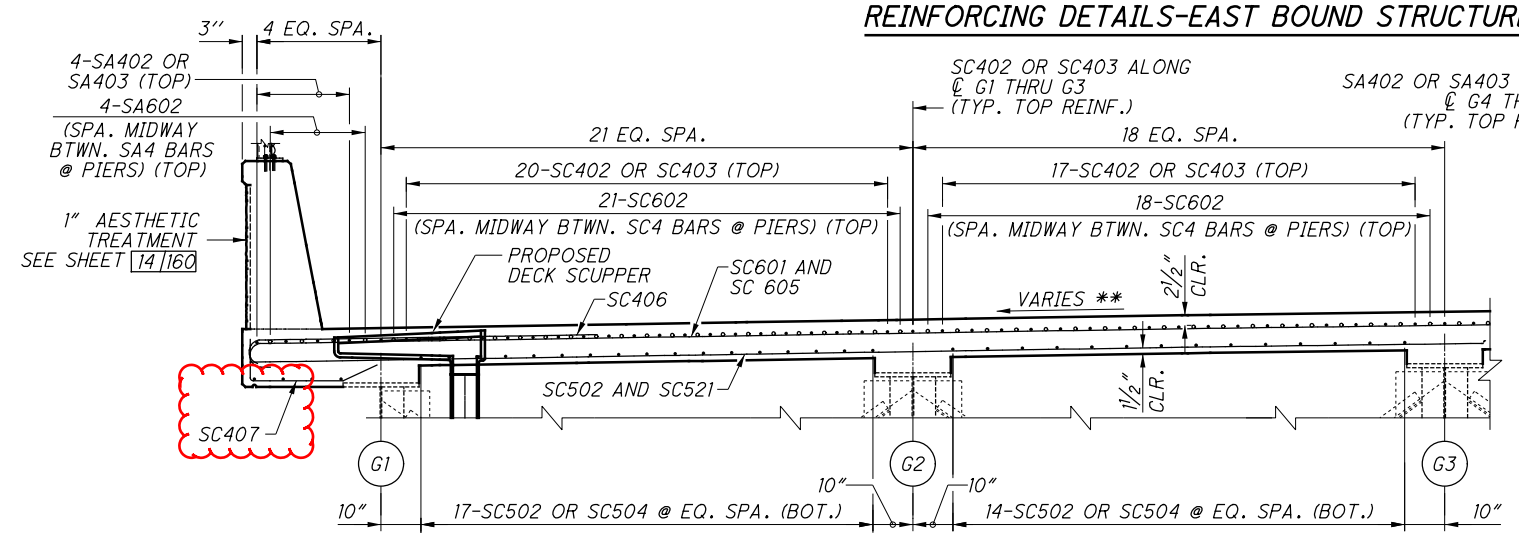


REINFORCING DETAILS-WEST BOUND STRUCTURE


MINIMUM REINFORCEMENT LAP LENGTHS (TYP. U.N.O.)	
#4	2'-0"
#5	2'-5"
#6	3'-0"

- NOTES:**
- DIMENSIONS ARE MEASURED PERPENDICULAR TO ϕ CONST IR-70 UNLESS NOTED OTHERWISE.
 - SEE SHEET 1031160 FOR CLOSURE POUR DETAILS AND ADDITIONAL NOTES.
 - REFER TO SHEET 1897 OF 2231 FOR ADDITIONAL PARAPET AESTHETIC DETAILS.

SUBMITTAL: Stage 3
 PLOT DRIVER: 000Tcodd_PDF.plt
 PENTABLE: 93006_000T181_Pen.tbl
 pw:\gtnet-pw.bentley.com\gtnet-pw-0\Documents\Projects\6477\93006\401-Engineering-GannettFleming\Structures\MUS070\159\Sheets\100_st004_477\2021\12\19\10 PM modonnell

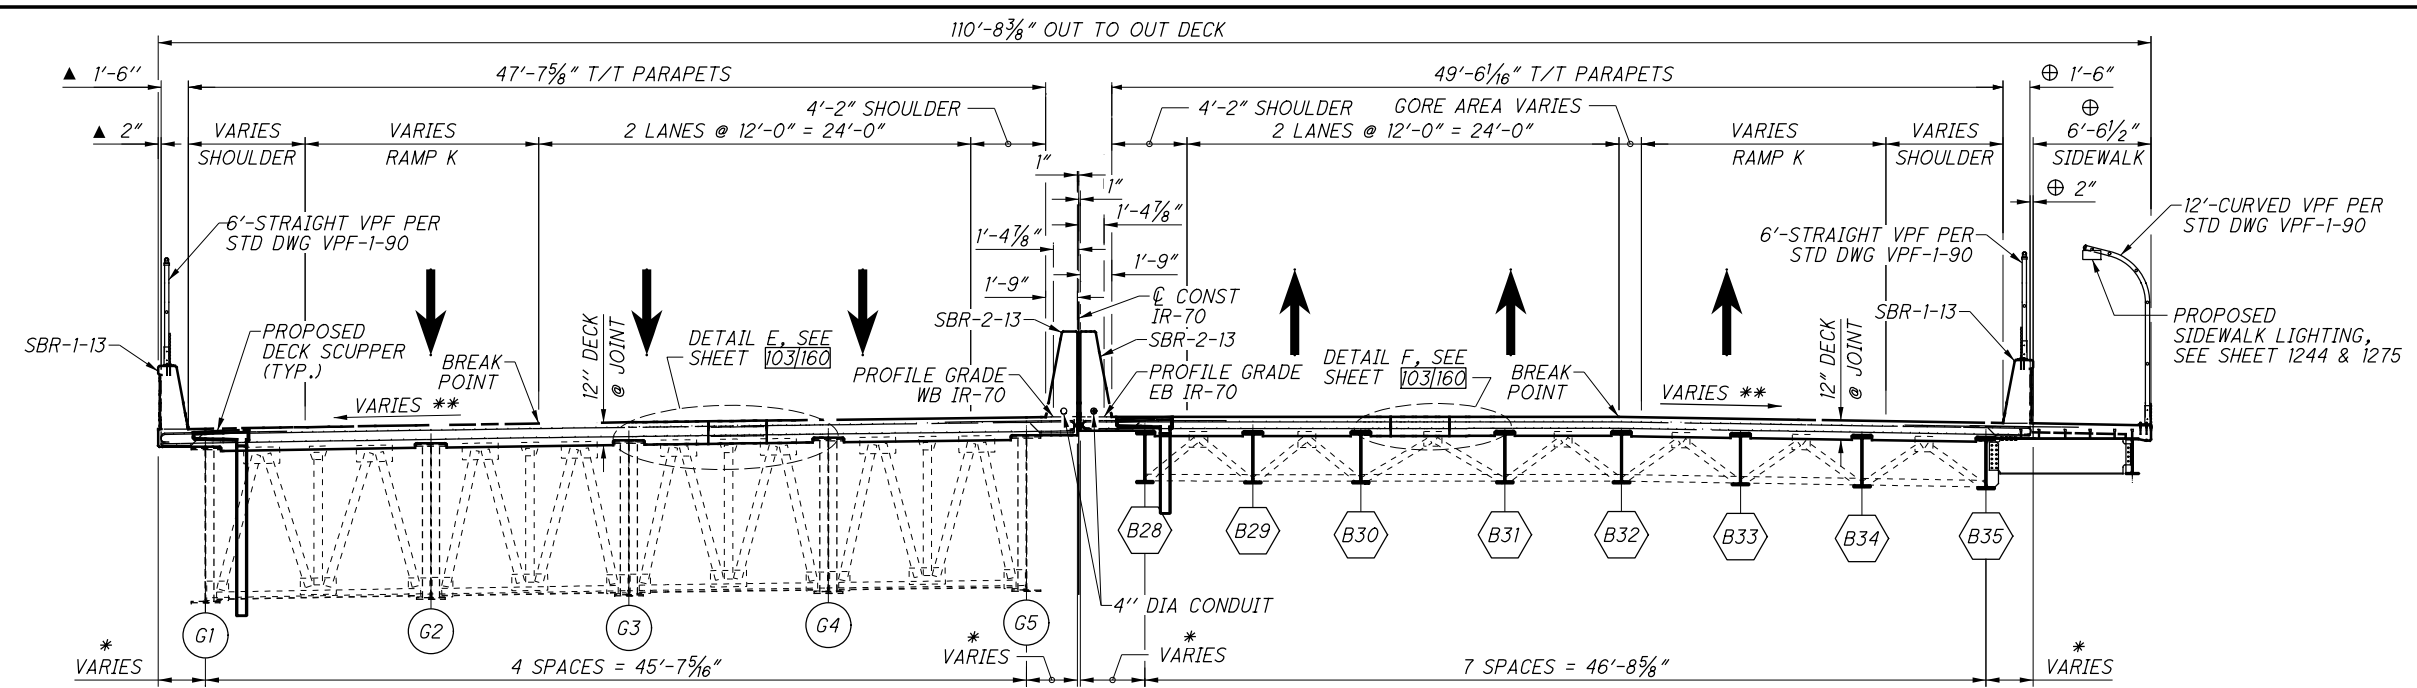


* SEE SHEET [114/160] FOR HORIZONTAL OVERHANG OFFSETS.
 ** SEE SHEET [9/160] TO [11/160] FOR SUPERELEVATION DIAGRAMS.

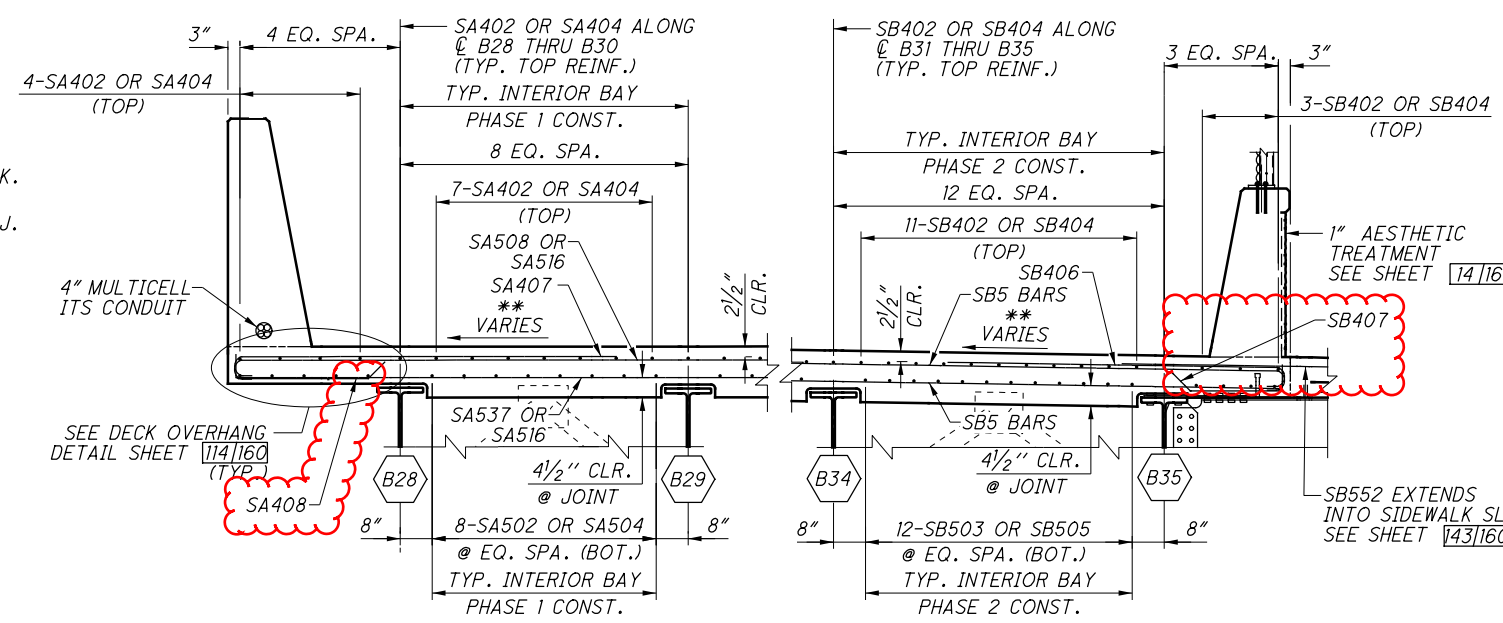


MINIMUM REINFORCEMENT LAP LENGTHS (TYP. U.N.O.)	
#4	2'-0"
#5	2'-5"
#6	3'-0"

- NOTES:**
- DIMENSIONS ARE MEASURED PERPENDICULAR TO @ CONST IR-70 UNLESS NOTED OTHERWISE.
 - SEE SHEET [103/160] FOR CLOSURE POUR DETAILS AND ADDITIONAL NOTES.
 - REFER TO SHEET 1897 OF 2231 FOR ADDITIONAL PARAPET AESTHETIC DETAILS.

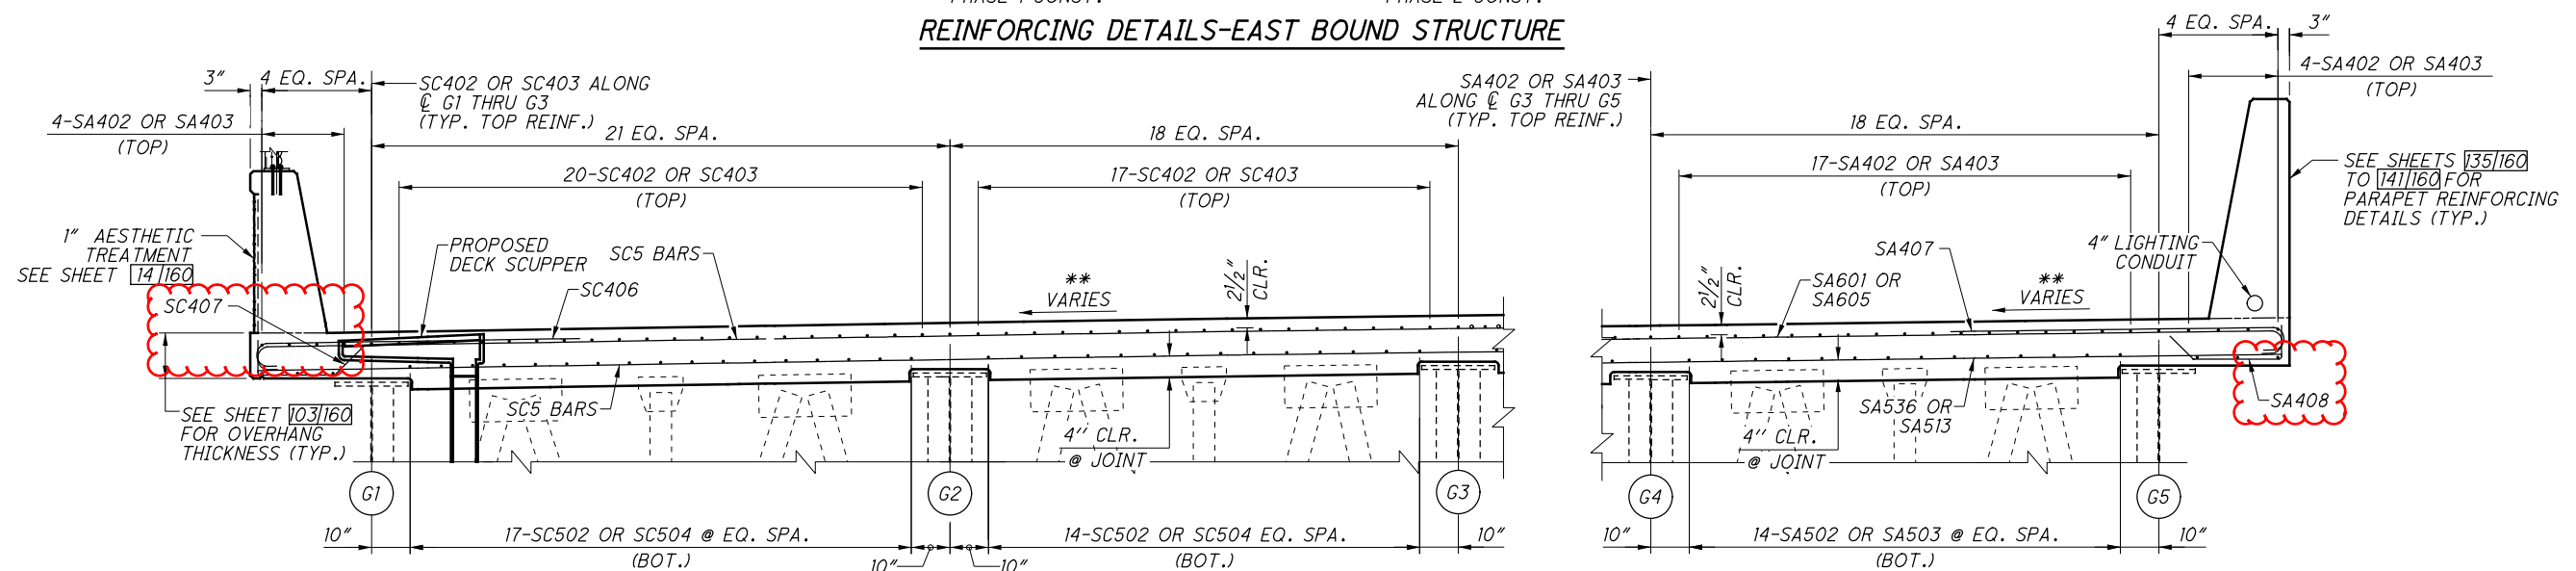


SUBMITTAL: Stage 3
 PLOT DRIVER: 00Tocadd_PDF.pltcf9
 PLOT: 93006_0001V81_Pen.tbl
 PENTABLE: 93006_0001V81_Pen.tbl
 pw:\gtnet-pw.bentley.com\gtnet-pw-0\Documents\Projects\6477\93006_401-Engineering-GannettFleming\Structures\MUS070_1159L\Sheets\101st005 4/7/2021 12:59:21 PM modonnell

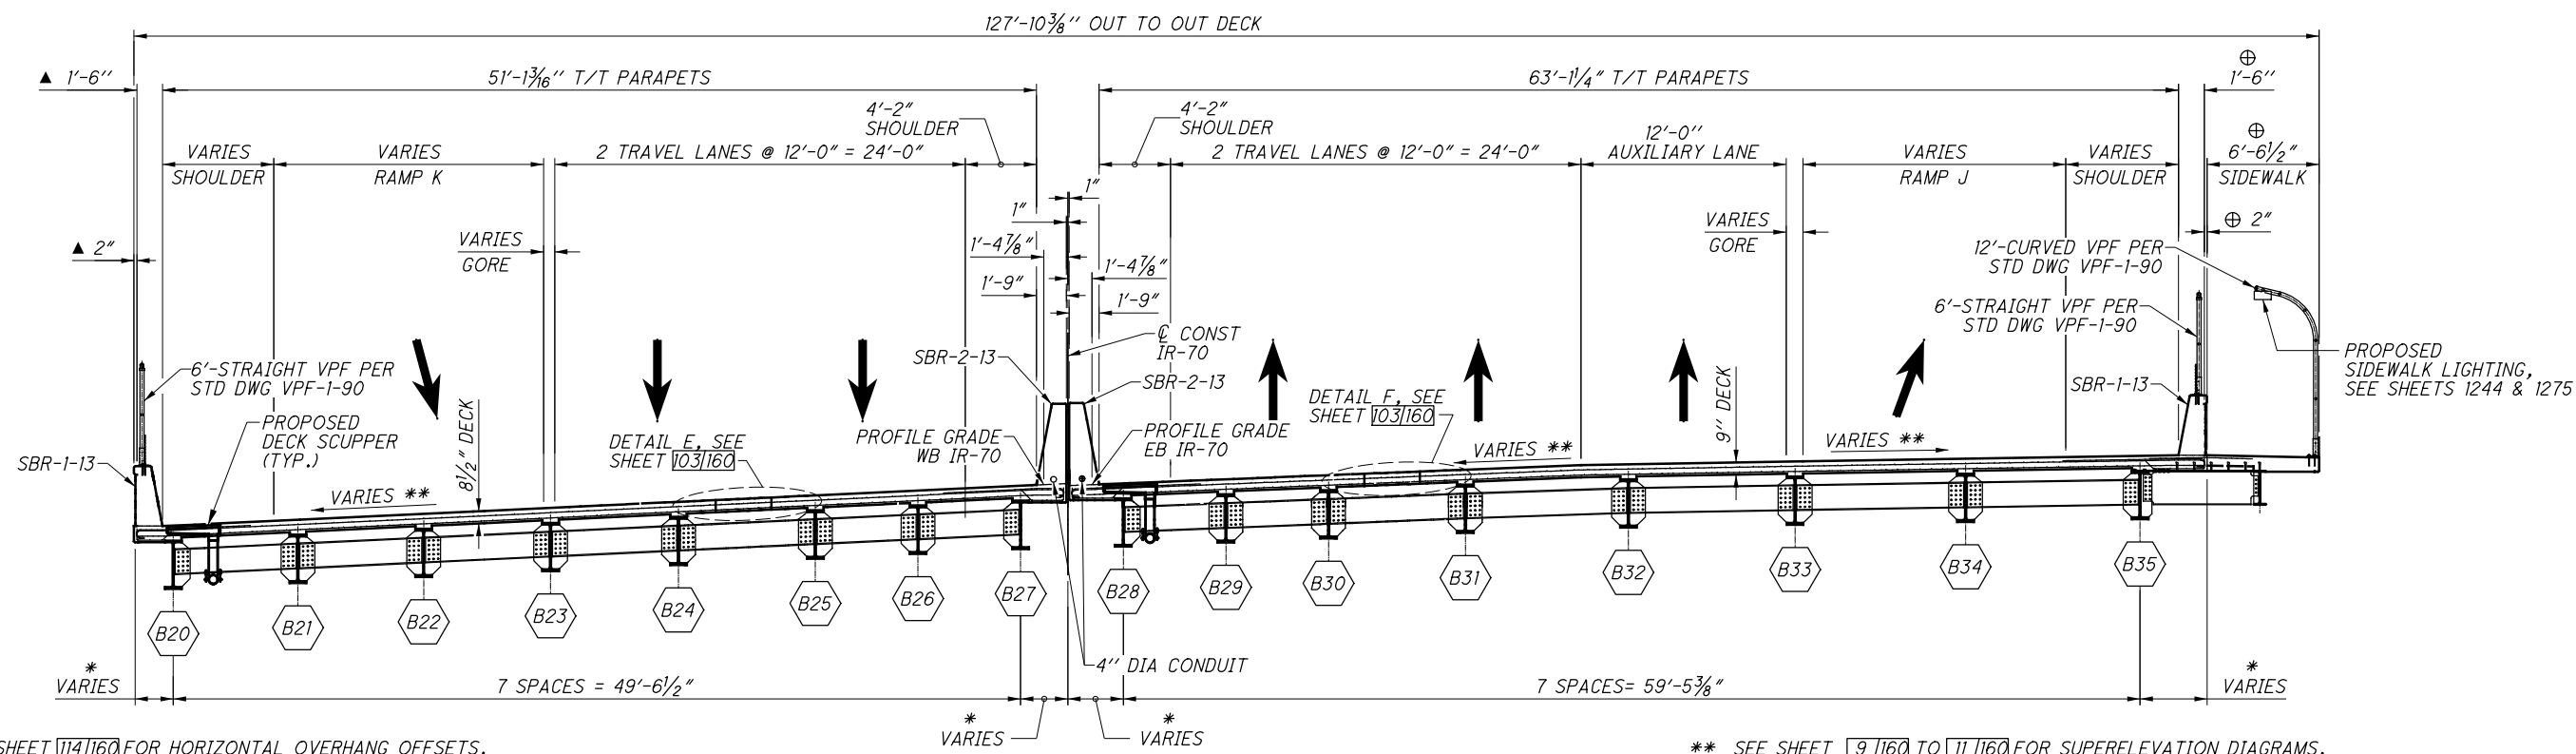

* SEE SHEET 1141160 FOR HORIZONTAL OVERHANG OFFSETS.

** SEE SHEET 91160 TO 111160 FOR SUPERELEVATION DIAGRAMS.

TRANSVERSE SECTION AT FORWARD ABUTMENT
LOOKING UPSTATION

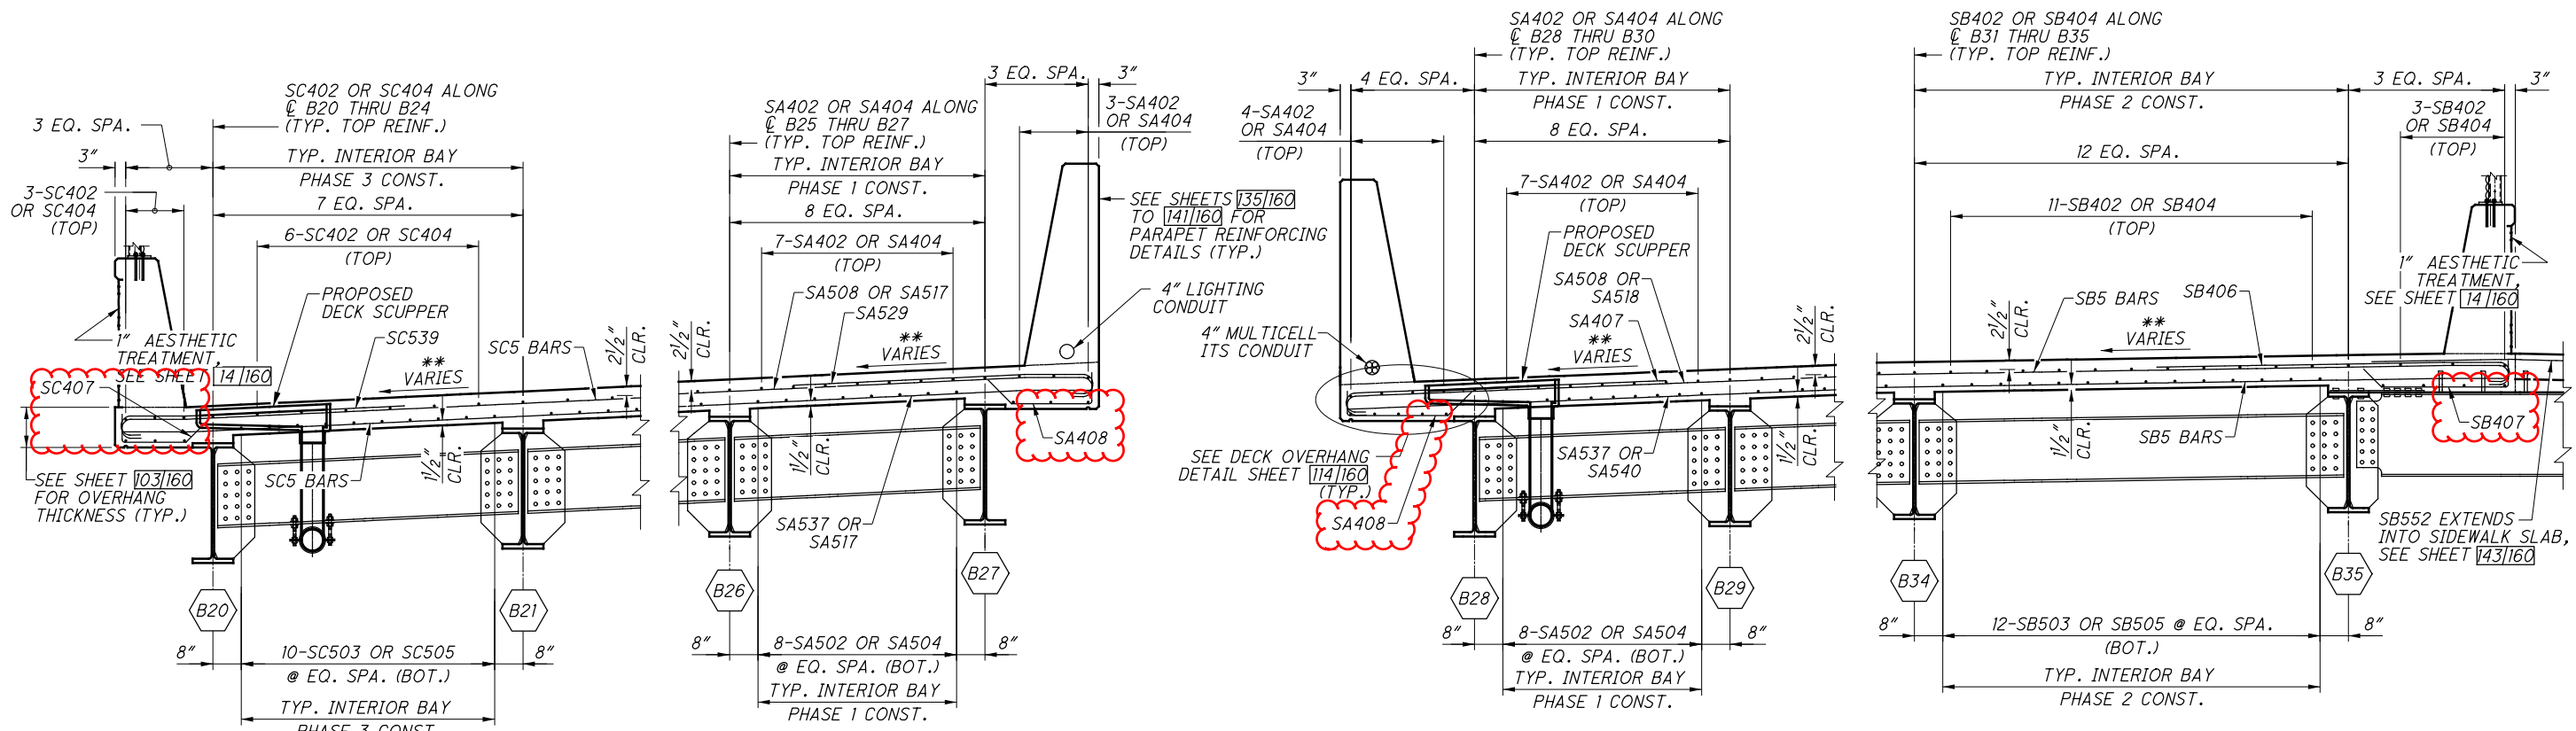

REINFORCING DETAILS-WEST BOUND STRUCTURE

REINFORCING DETAILS-EAST BOUND STRUCTURE

MINIMUM REINFORCEMENT LAP LENGTHS (TYP. U.N.O.)	
#4	2'-0"
#5	2'-5"
#6	3'-0"

- ▲ DIMENSION MEASURED PERPENDICULAR TO @ CONST RAMP K.
- ⊕ DIMENSION MEASURED PERPENDICULAR TO @ CONST RAMP J.

NOTES:

1. DIMENSIONS ARE MEASURED PERPENDICULAR TO @ CONST IR-70 UNLESS NOTED OTHERWISE.
2. SEE SHEET 1031160 FOR CLOSURE POUR DETAILS AND ADDITIONAL NOTES.
3. REFER TO SHEET 1897 OF 2231 FOR ADDITIONAL PARAPET AESTHETIC DETAILS.

DESIGN AGENCY
Gannett Fleming
ENGINEERS & ARCHITECTS, P.C.
2800 CORPORATE EXCHANGE DRIVE, SUITE 230
COLUMBIUS, OHIO 43231

DATE
12/2020

STRUCTURE FILE NUMBER
6002854

DESIGNED
TMF

DRAWN
JM

REVIEWED
MTO

BRIDGE NO. MUS-70-1159


OVER LINDEN AVE, OHCR & CUOH RAILROADS, AND MUSKINGUM RIVER

PID No. 93006

MUS-70-10.49

102/160

1548
2231

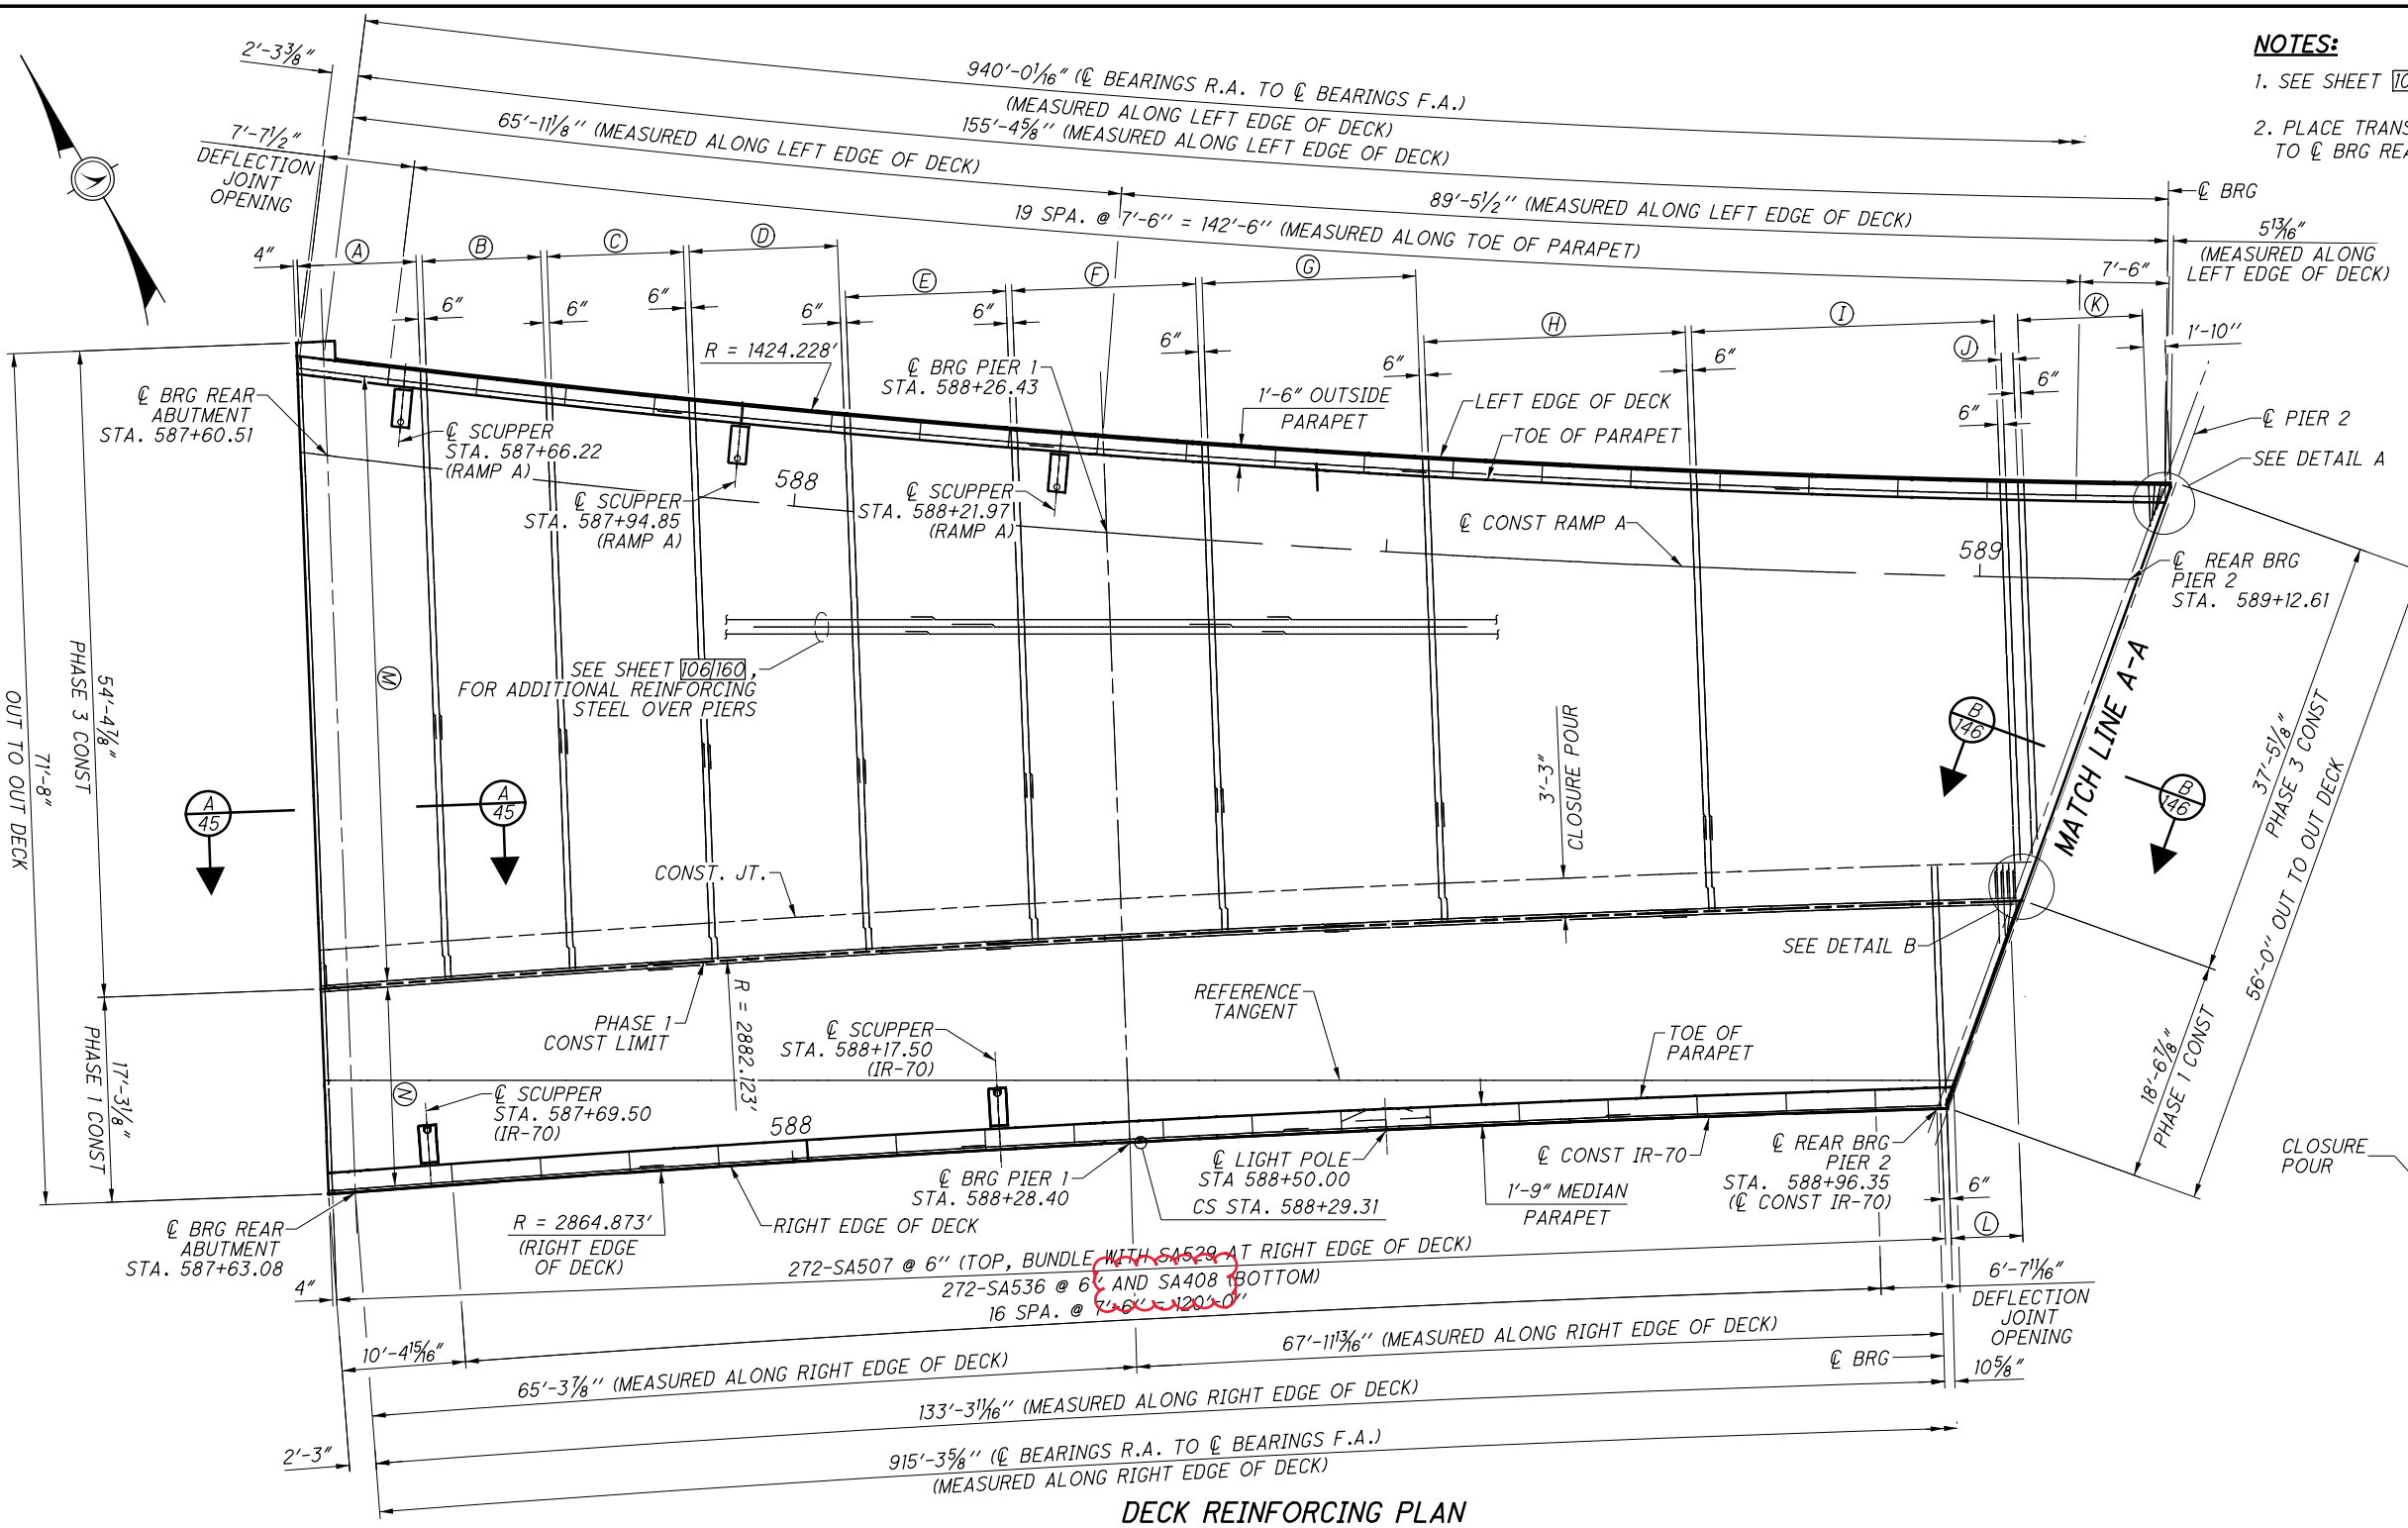



DECK REINFORCING PLAN
LEFT SPAN 1 AND SPAN 2

- (A) = 21-SC507 AND SC508 @ 6" (TOP BUNDLE SC507 WITH SC539 AT LEFT EDGE OF DECK) AND SC407 (BOTTOM)
- (B) = 21-SC507 AND SC509 @ 6" (TOP BUNDLE SC507 WITH SC539 AT LEFT EDGE OF DECK) AND SC407 (BOTTOM)
- (C) = 24-SC507 AND SC510 @ 6" (TOP BUNDLE SC507 WITH SC539 AT LEFT EDGE OF DECK) AND SC407 (BOTTOM)
- (D) = 26-SC507 AND SC511 @ 6" (TOP BUNDLE SC507 WITH SC539 AT LEFT EDGE OF DECK) AND SC407 (BOTTOM)
- (E) = 28-SC507 AND SC512 @ 6" (TOP BUNDLE SC507 WITH SC539 AT LEFT EDGE OF DECK) AND SC407 (BOTTOM)
- (F) = 32-SC507 AND SC513 @ 6" (TOP BUNDLE SC507 WITH SC539 AT LEFT EDGE OF DECK) AND SC407 (BOTTOM)
- (G) = 37-SC507 AND SC514 @ 6" (TOP BUNDLE SC507 WITH SC539 AT LEFT EDGE OF DECK) AND SC407 (BOTTOM)
- (H) = 45-SC507 AND SC515 @ 6" (TOP BUNDLE SC507 WITH SC539 AT LEFT EDGE OF DECK) AND SC407 (BOTTOM)
- (I) = 52-SC507 AND SC516 @ 6" (TOP BUNDLE SC507 WITH SC539 AT LEFT EDGE OF DECK) AND SC407 (BOTTOM)
- (J) = 4-SC507 AND SC517 @ 6" (TOP BUNDLE SC507 WITH SC539 AT LEFT EDGE OF DECK) AND SC407 (BOTTOM)
- (K) = 1 S.O. 21-SC518 @ 6" (TOP BUNDLE WITH SC539 AT LEFT EDGE OF DECK) AND SC407 (BOTTOM)
- (L) = 1 S.O. 11-SA509 @ 6" (TOP) AND SC407 (BOTTOM)
- (M) = 53-SC401 (5 LENGTHS) LAPPED WITH 1 S.O. 53-SC405 (TOP, SPACED AS SHOWN ON TRANSVERSE SECTION) (FAN BARS AS NECESSARY) AND 60-SC501 (5 LENGTHS) LAPPED WITH 1 S.O. 60-SC506 (BOTTOM, SPACED AS SHOWN ON TRANSVERSE SECTION) (FAN BARS AS NECESSARY)
- (N) = 19-SA401 (5 LENGTHS) LAPPED WITH 1 S.O. 19-SA405 (TOP, SPACED AS SHOWN ON TRANSVERSE SECTION) (FAN BARS AS NECESSARY) AND 22-SA501 (5 LENGTHS) LAPPED WITH 1 S.O. 22-SA505 (BOTTOM, SPACED AS SHOWN ON TRANSVERSE SECTION) (FAN BARS AS NECESSARY)


NOTES:
 1. SEE SHEET 103160 FOR ADDITIONAL NOTES AND LEGEND.
 2. PLACE TRANSVERSE REINFORCEMENT PARALLEL TO BRG REAR ABUTMENT.

MINIMUM REINFORCEMENT LAP LENGTHS (TYP. U.N.O.)

#4	2'-0"
#5	2'-5"
#6	3'-0"

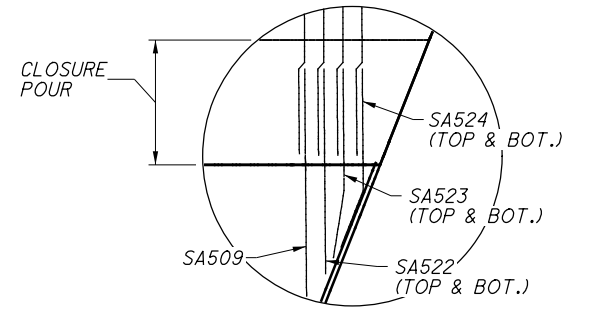
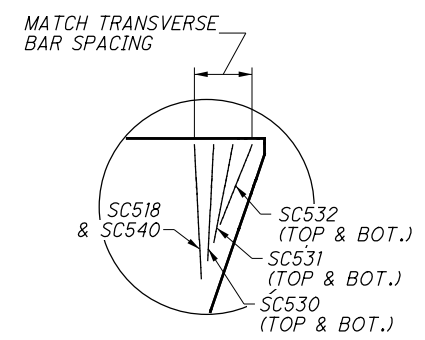


SUBMITTAL: Stage 3
 PLOT DRIVER: 000Tcodd_PDF.plt/cfg
 PENTABLE: 93006_0001V81_Pen.tbl
 PROJECT: 93006_0001V81_Pen.tbl
 PROJECTS: 6477\93006\401-Engineering-GannettFleming\Structures\MUS070\159L\Sheets\04_sd002_4/6/2021\12:54:35 PM modonnell

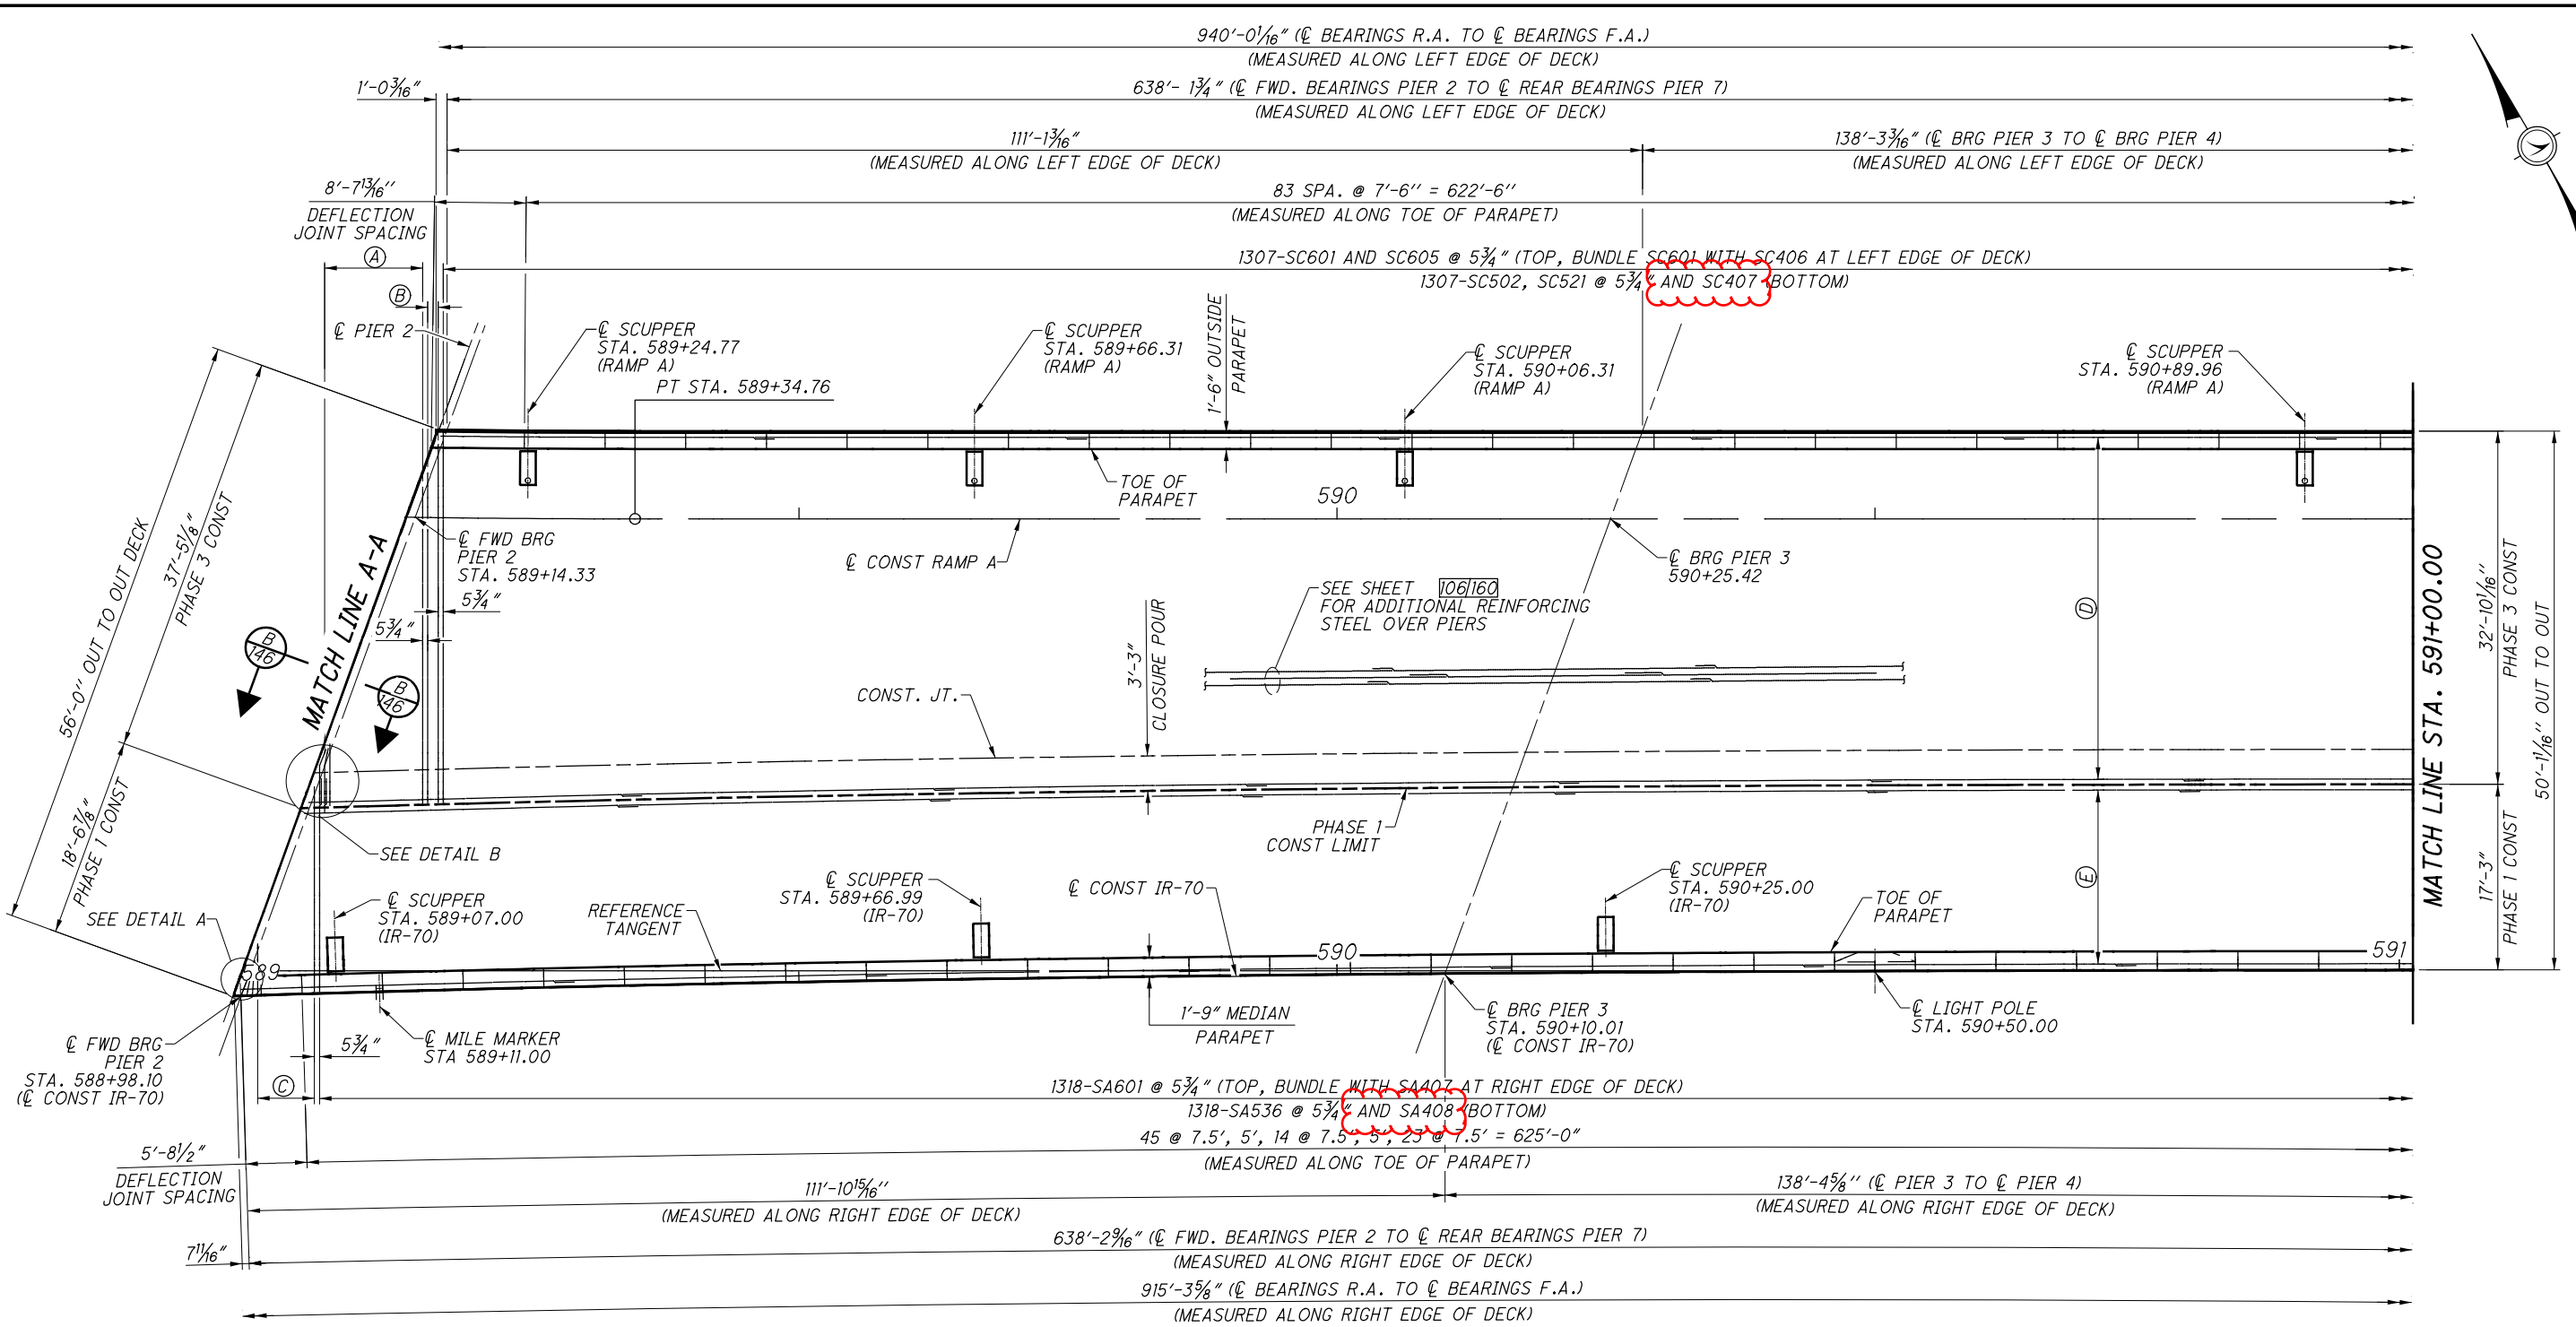

DECK REINFORCING PLAN
LEFT SPAN 3 AND 4

- (A) = 1 S.O. 19-SC603 @ 5³/₄" (TOP)
1 S.O. 19-SC519 @ 5³/₄" (BOTTOM)
- (B) = 3-SC613 AND 3-SC604 @ 5³/₄" (TOP)
3-SC502 AND 3-SC520 @ 5³/₄" (BOTTOM)
- (C) = 1 S.O. 12-SA603 @ 5³/₄" (TOP, BUNDLE WITH SA407 AT RIGHT EDGE OF DECK)
1 S.O. 12-SA511 @ 5³/₄" AND SA408 (BOTTOM)
- (D) = 56-SC402 (23 LENGTHS) LAPPED WITH 56-SC403 (TOP, SPACED AS SHOWN ON TRANSVERSE SECTION) (FAN BARS AS NECESSARY)
46-SC502 (23 LENGTHS) LAPPED WITH 46-SC504 (BOTTOM, SPACED AS SHOWN ON TRANSVERSE SECTION) (FAN BARS AS NECESSARY)
- (E) = 27-SA402 (23 LENGTHS) LAPPED WITH 27-SA403 (TOP, SPACED AS SHOWN ON TRANSVERSE SECTION) (FAN BARS AS NECESSARY)
22-SA502 (23 LENGTHS) LAPPED WITH 22-SA503 (BOTTOM, SPACED AS SHOWN ON TRANSVERSE SECTION) (FAN BARS AS NECESSARY)

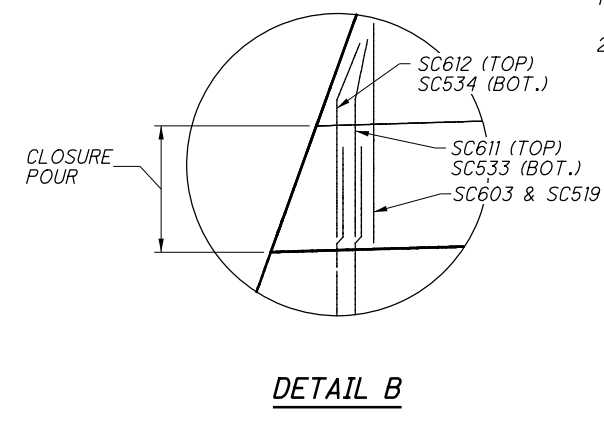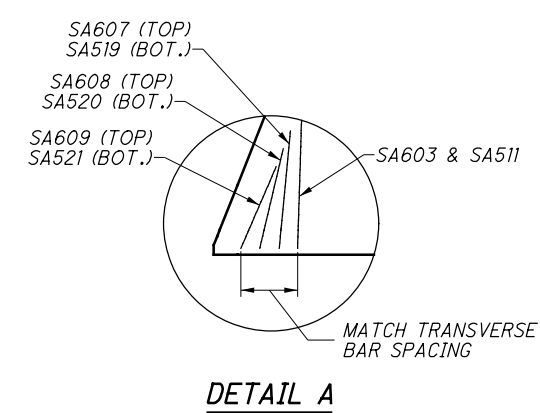

- NOTES:**
- SEE SHEET 1031160 FOR ADDITIONAL NOTES AND LEGEND.
 - PLACE TRANSVERSE REINFORCEMENT PERPENDICULAR TO THE REFERENCE TANGENT.

MINIMUM REINFORCEMENT LAP LENGTHS (TYP. U.N.O.)	
#4	2'-0"
#5	2'-5"
#6	3'-0"

GannettFleming
 ENGINEERS & ARCHITECTS, P.C.
 2500 CORPORATE EXCHANGE DRIVE, SUITE 230
 COLUMBUS, OHIO 43231


DESIGN AGENCY
 DATE 12/2020
 REVIEWED MTO
 DRAWN JM
 DESIGNED JAY
 CHECKED RDF

BRIDGE NO. MUS-70-1159
 OVER LINDEN AVE, OHCR & CUOH RAILROADS, AND MUSKINGUM RIVER

MUS-70-10.49
 PID No. 93006


105/160
 1551
 2231

SUBMITTAL: Stage 3
 PLOT DRIVER: 000Tcodd_PDF.pltcfgr
 PENTABLE: 93006_0001V81_Pen.tbl
 pw:\gfnnet-pw.bentley.com\gfnnet-pw-0\Documents\Projects\6477\93006\401-Engineering-GannettFleming\Structures\MUS070_1159L\Sheets\05_sd003_4/6/2021\12:54:55 PM modonnell

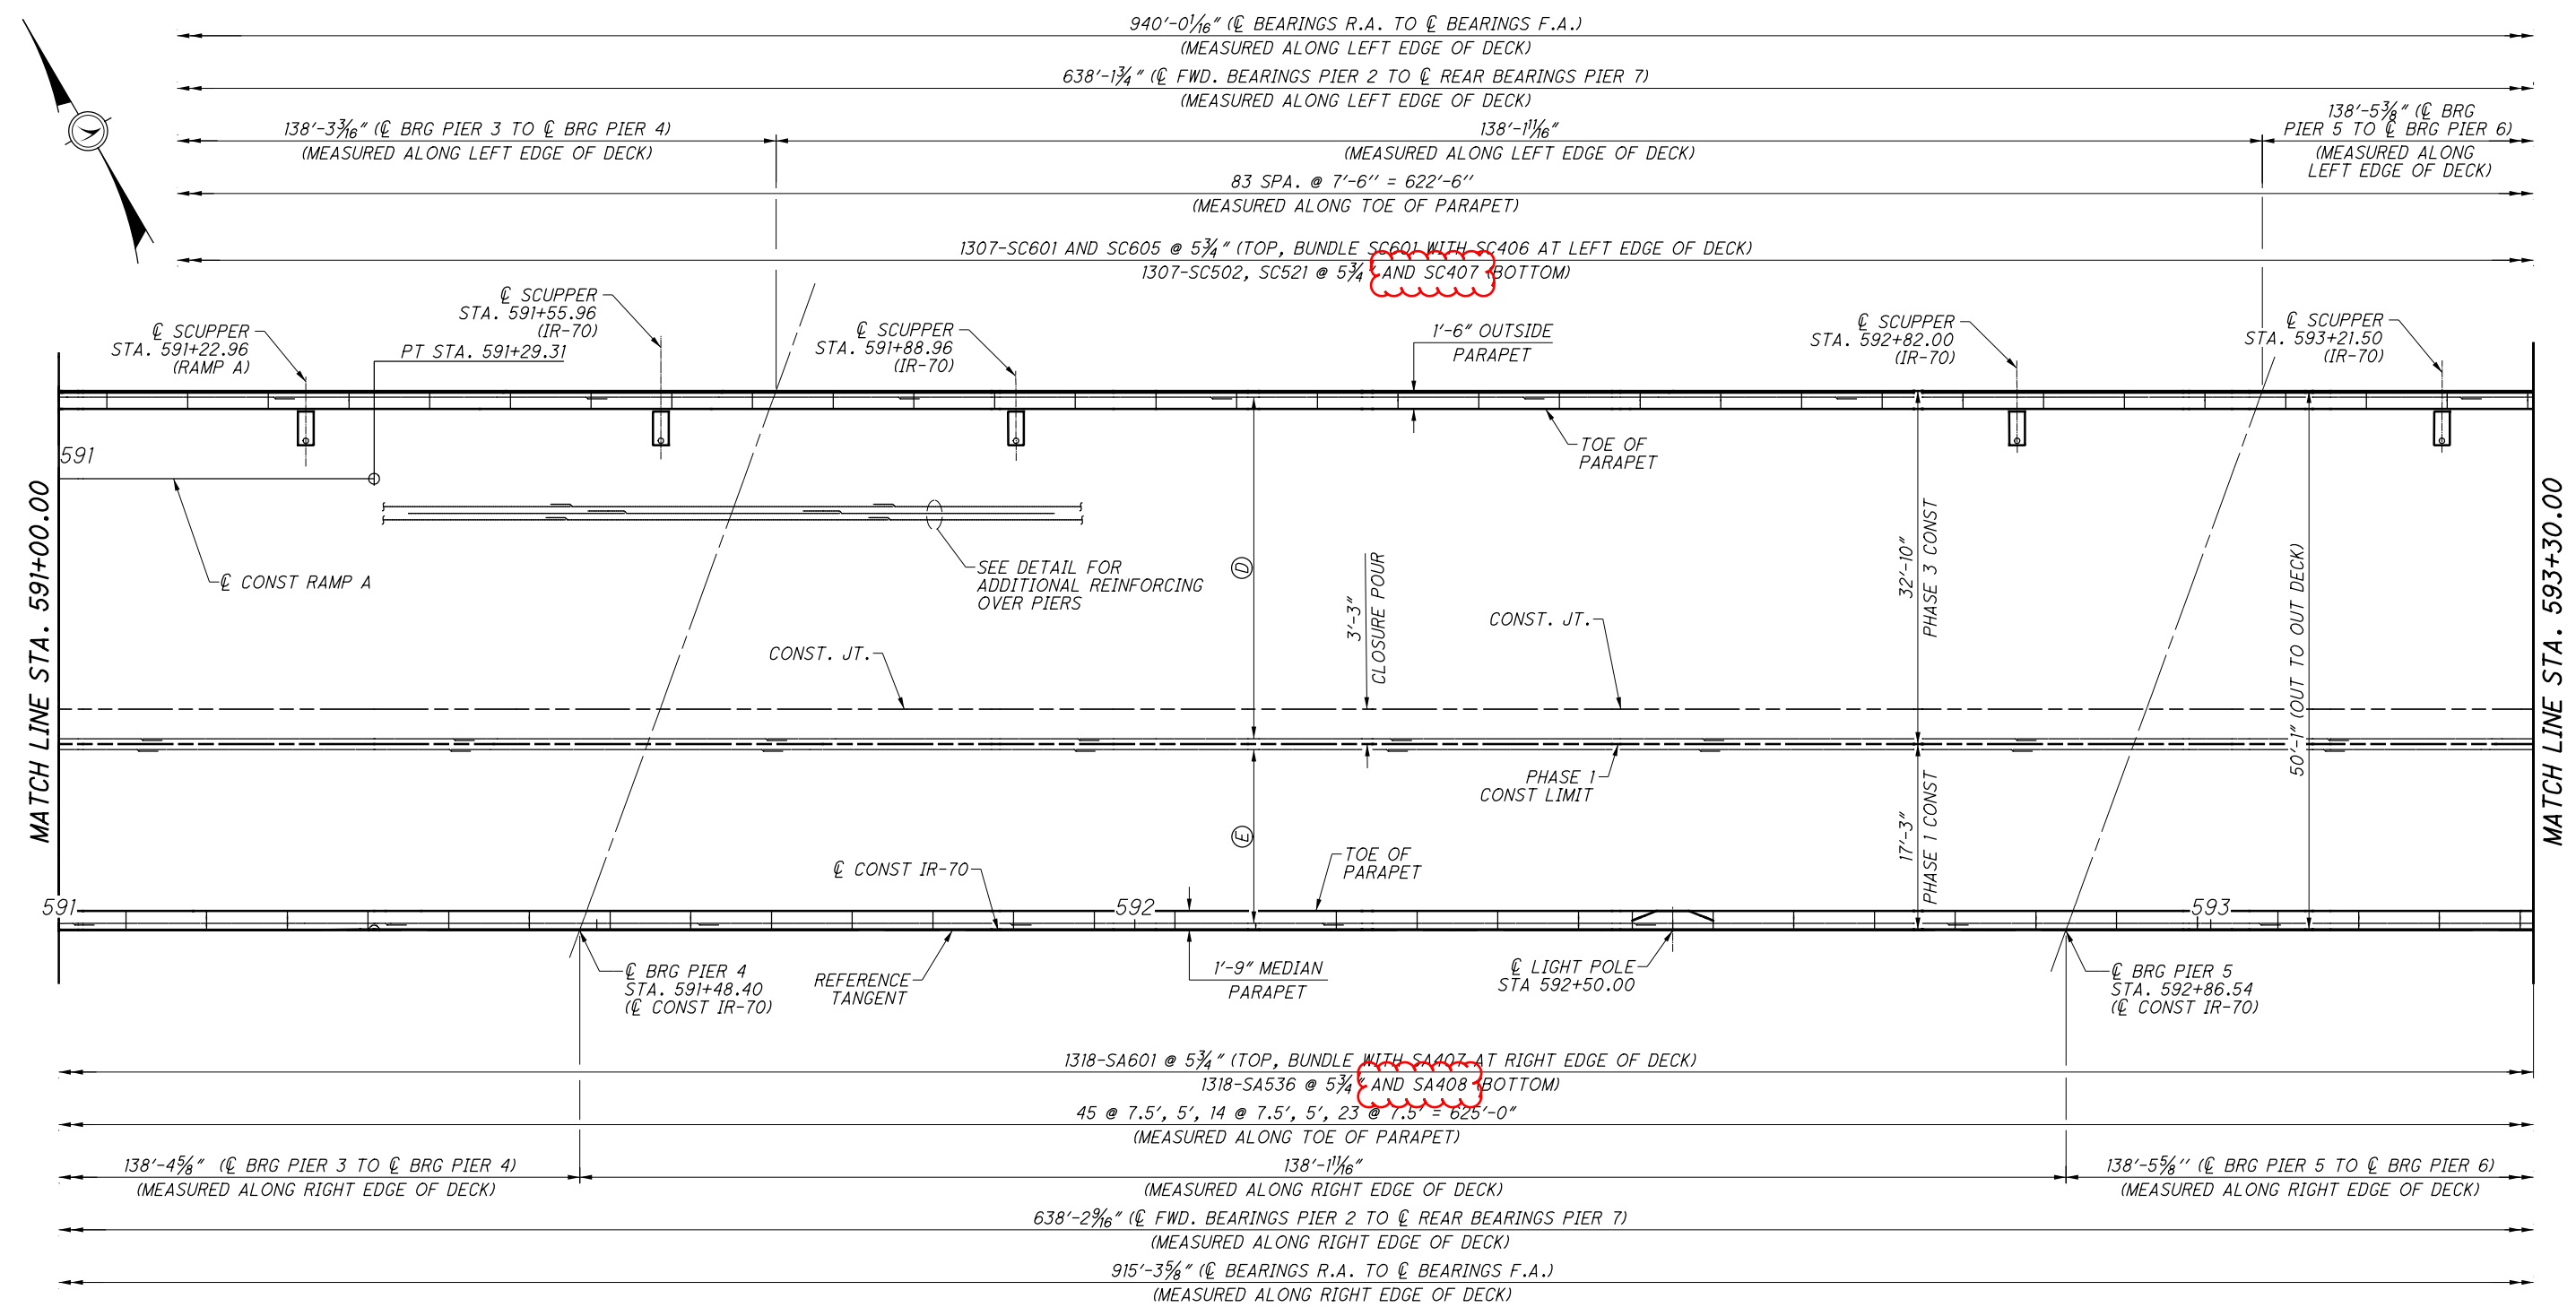

DECK REINFORCING PLAN
LEFT SPAN 4, 5 AND 6

- Ⓧ = 56-SC402 (23 LENGTHS) LAPPED WITH 56-SC403 (TOP, SPACED AS SHOWN ON TRANSVERSE SECTION) (FAN BARS AS NECESSARY)
46-SC502 (23 LENGTHS) LAPPED WITH 46-SC504 (BOTTOM, SPACED AS SHOWN ON TRANSVERSE SECTION) (FAN BARS AS NECESSARY)
- Ⓧ = 27-SA402 (23 LENGTHS) LAPPED WITH 27-SA403 (TOP, SPACED AS SHOWN ON TRANSVERSE SECTION) (FAN BARS AS NECESSARY)
22-SA502 (23 LENGTHS) LAPPED WITH 22-SA503 (BOTTOM, SPACED AS SHOWN ON TRANSVERSE SECTION) (FAN BARS AS NECESSARY)

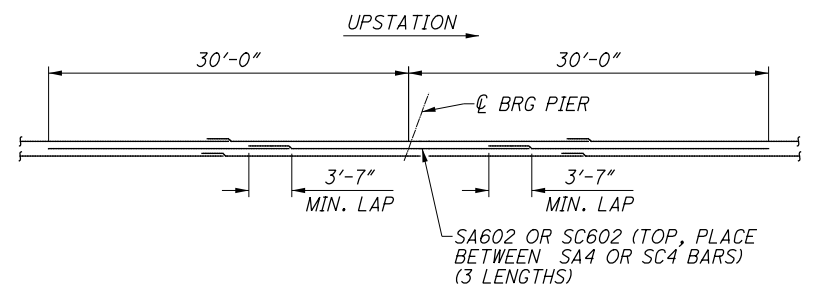

ADDITIONAL REINFORCEMENT OVER PIERS

- NOTES:**
- SEE SHEET 103160 FOR ADDITIONAL NOTES AND LEGEND.
 - PLACE TRANSVERSE REINFORCEMENT PERPENDICULAR TO THE REFERENCE TANGENT.

MINIMUM REINFORCEMENT LAP LENGTHS (TYP. U.N.O.)	
#4	2'-0"
#5	2'-5"
#6	3'-0"

GannettFleming
 ENGINEERS & ARCHITECTS, P.C.
 2800 CORPORATE EXCHANGE DRIVE, SUITE 230
 COLUMBUS, OHIO 43231


DESIGN AGENCY
 DATE 12/2020
 REVIEWED MTO
 DRAWN JM
 DESIGNED JAY
 CHECKED RFD
 STRUCTURE FILE NUMBER 6002854

LEFT SPAN 4, 5 AND 6 DECK REINFORCING PLAN
 BRIDGE NO. MUS-70-1159
 OVER LINDEN AVE, OHCR & CUOH RAILROADS, AND MUSKINGUM RIVER

MUS-70-10.49
 PID No. 93006



106/160
 1552
 2231

SUBMITTAL: Stage 3
 PLOT DRIVER: 000Tcodd_PDF.pltcfgr
 PENTABLE: 93006_000TV81_Pen.tbl
 pw:\gfn\pw.bentley.com\gfn\pw-0\Documents\Projects\6477\93006_401-Engineering-GannettFleming\Structures\MUS070_1159L\Sheets\06_sd004 4/6/2021 12:55:09 PM modonnell

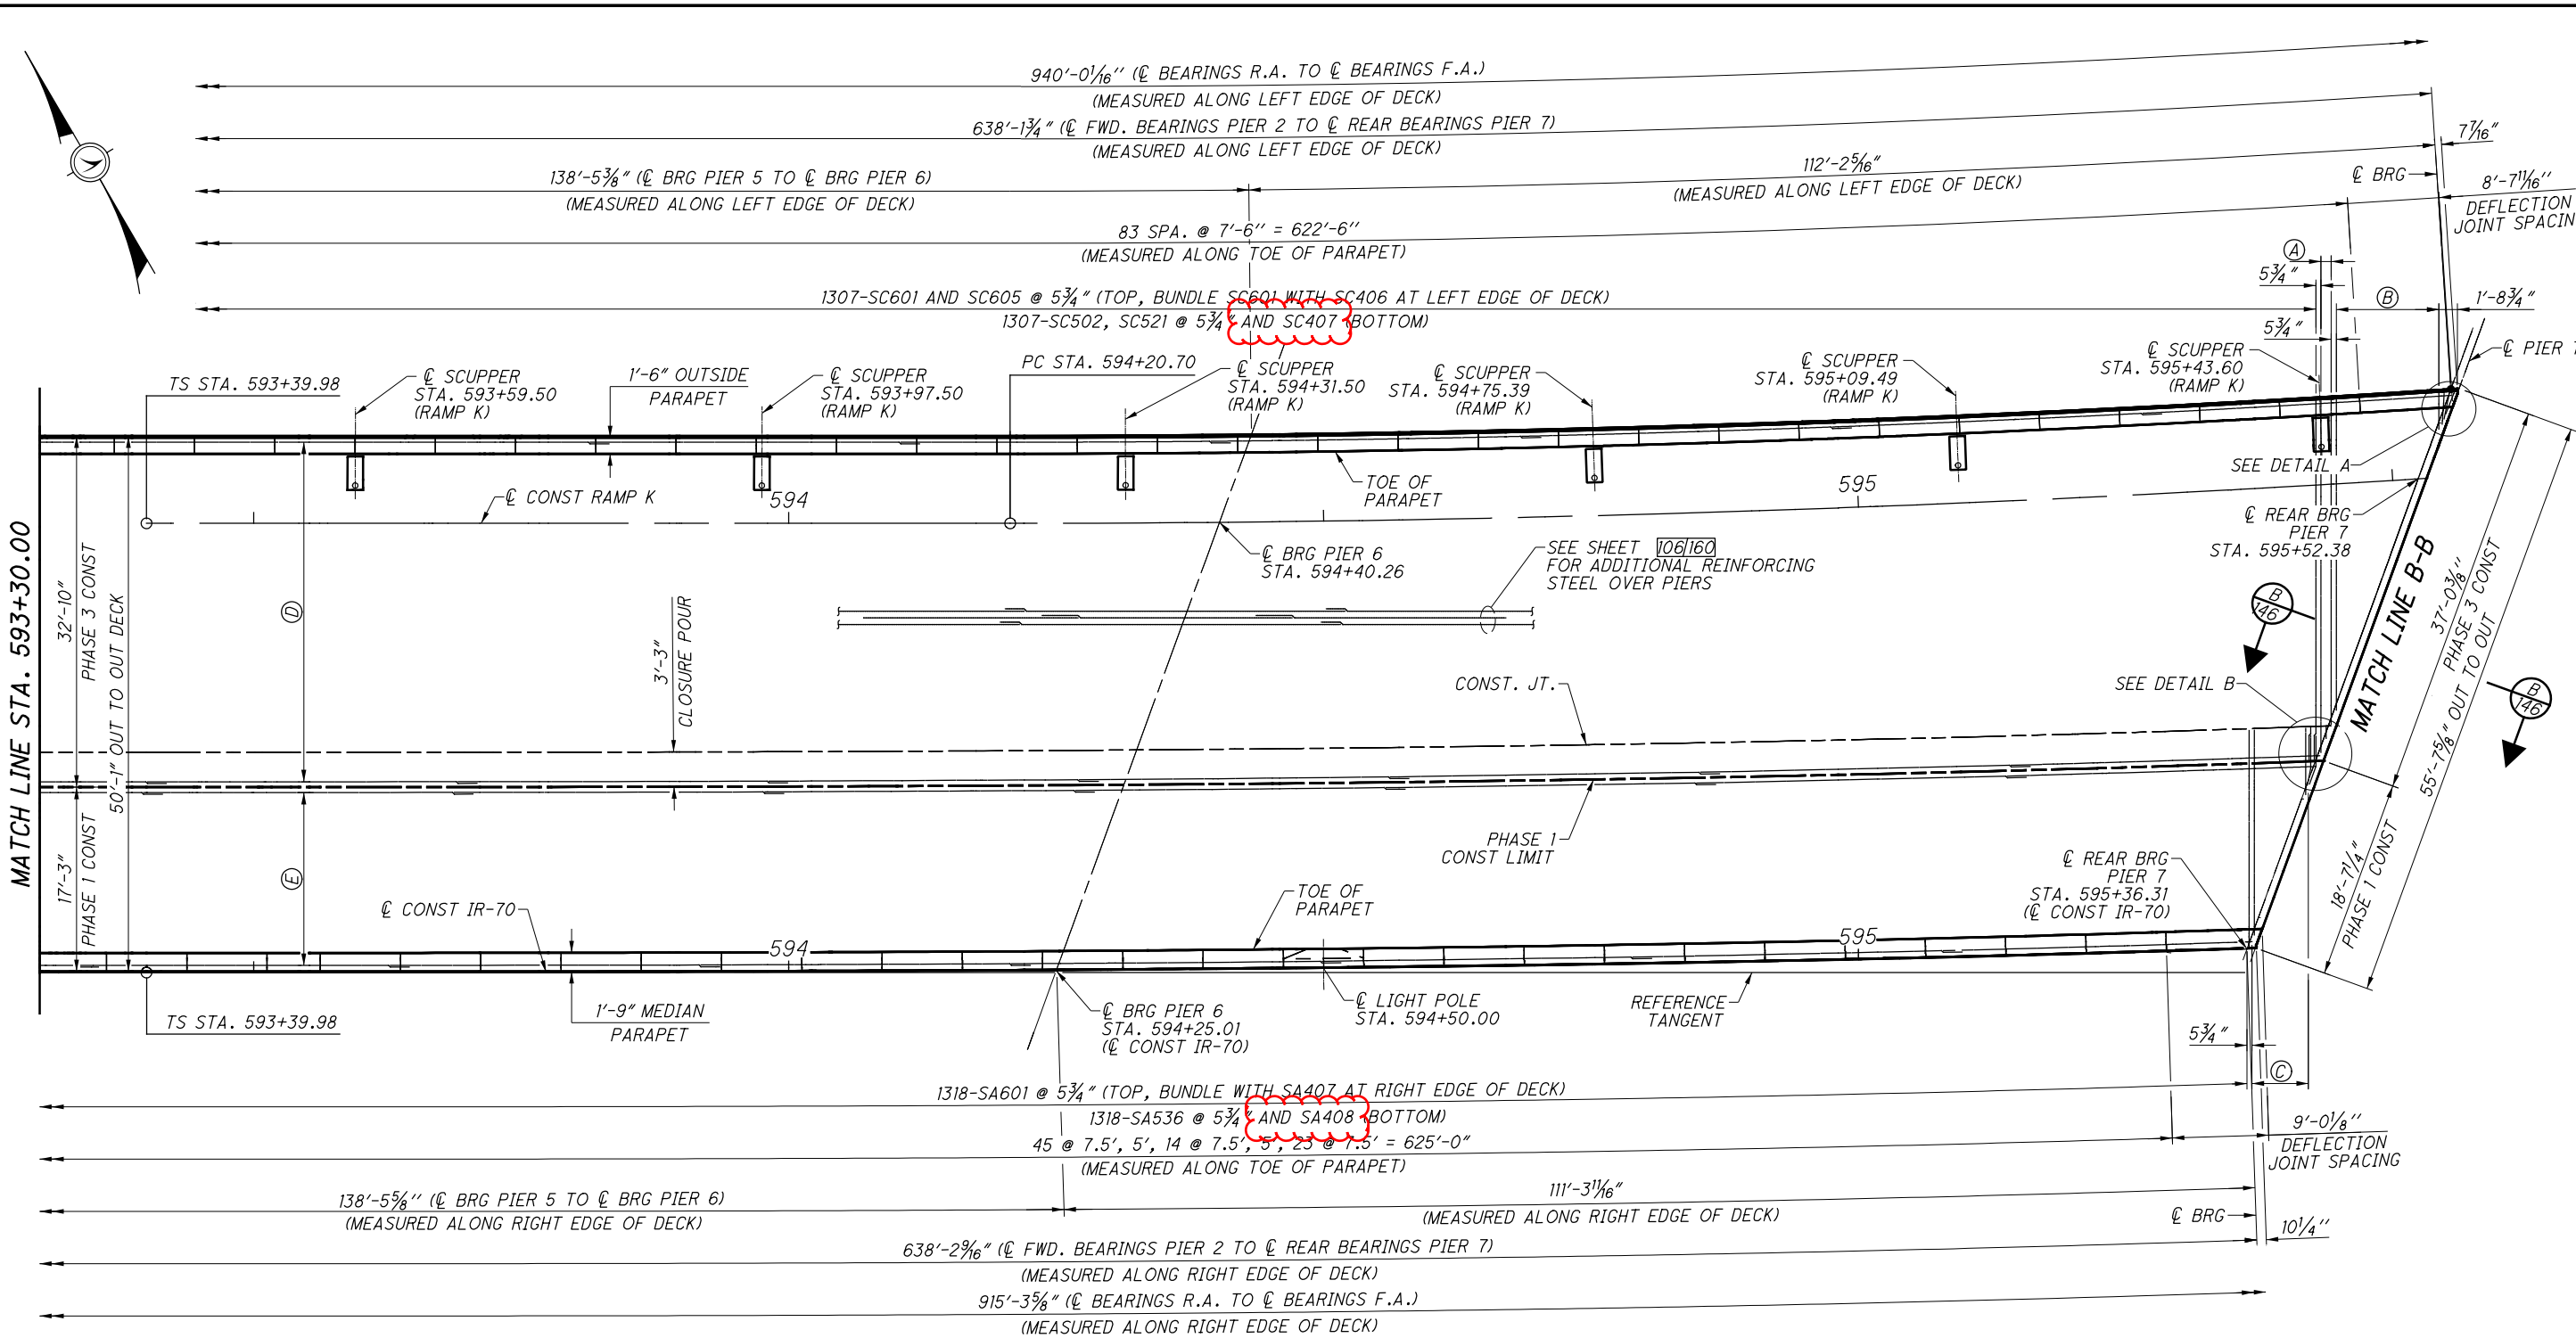

DECK REINFORCING PLAN
LEFT SPAN 6 AND 7

- (A) = 3-SC601 AND 1 S.O. 3-SC606 @ 5³/₄" (TOP, BUNDLE SC601 WITH SC406 AT LEFT EDGE OF DECK)
3-SC502 AND 1 S.O. 3-SC522 @ 5³/₄" AND SC407 (BOTTOM)
- (B) = 1 S.O. 21-SC607 @ 5³/₄" (TOP, BUNDLE WITH SC406 AT LEFT EDGE OF DECK)
1 S.O. 21-SC523 @ 5³/₄" AND SC407 (BOTTOM)
- (C) = 1 S.O. 11-SA605 @ 5³/₄" (TOP)
1 S.O. 11-SA513 @ 5³/₄" (BOTTOM)
- (D) = 56-SC402 (23 LENGTHS) LAPPED WITH 56-SC403 (TOP, SPACED AS SHOWN ON TRANSVERSE SECTION) (FAN BARS AS NECESSARY)
46-SC502 (23 LENGTHS) LAPPED WITH 46-SC504 (BOTTOM, SPACED AS SHOWN ON TRANSVERSE SECTION) (FAN BARS AS NECESSARY)
- (E) = 27-SA402 (23 LENGTHS) LAPPED WITH 27-SA403 (TOP, SPACED AS SHOWN ON TRANSVERSE SECTION) (FAN BARS AS NECESSARY)
22-SA502 (23 LENGTHS) LAPPED WITH 22-SA503 (BOTTOM, SPACED AS SHOWN ON TRANSVERSE SECTION) (FAN BARS AS NECESSARY)

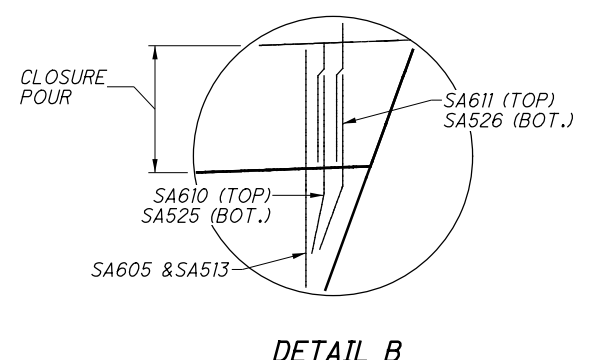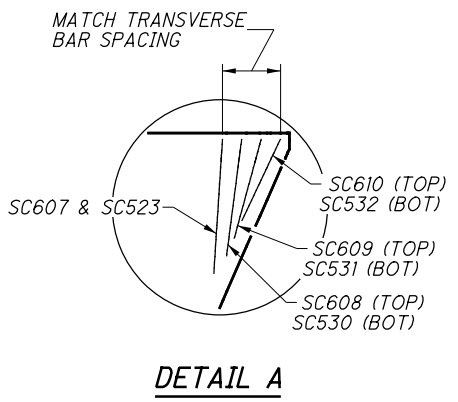

- NOTES:**
- SEE SHEET 103160 FOR ADDITIONAL NOTES AND LEGEND.
 - PLACE TRANSVERSE REINFORCEMENT PERPENDICULAR TO THE REFERENCE TANGENT.

MINIMUM REINFORCEMENT LAP LENGTHS (TYP. U.N.O.)	
#4	2'-0"
#5	2'-5"
#6	3'-0"

GannettFleming
 ENGINEERS & ARCHITECTS, P.C.
 2500 CORPORATE EXCHANGE DRIVE SUITE 230
 COLUMBUS, OHIO 43231


DESIGN AGENCY
 DATE 12/2020
 REVIEWED MTO
 DRAWN JM
 CHECKED JAY
 DESIGNED JAY
 REVISIONS
 STRUCTURE FILE NUMBER 6002854
 RFD

MUS-70-10.49
 BRIDGE NO. MUS-70-1159
 OVER LINDEN AVE., OHCR & CUOH RAILROADS, AND MUSKINGUM RIVER

LEFT SPAN 6 AND 7 DECK REINFORCING PLAN

107/160
 1553
 2231

SUBMITTAL: Stage 3
 PLOT DRIVER: 000Tcodd_PDF.plt
 PENTABLE: 93006_000T181_Pen.tbl
 pw:\gfn\pw.bentley.com\gfn\pw-01\Documents\Projects\64771\93006_401-Engineering-GannettFleming\Structures\MUS070_1159L\Sheets\07_sd005 4/6/2021 12:55:27 PM modonnell

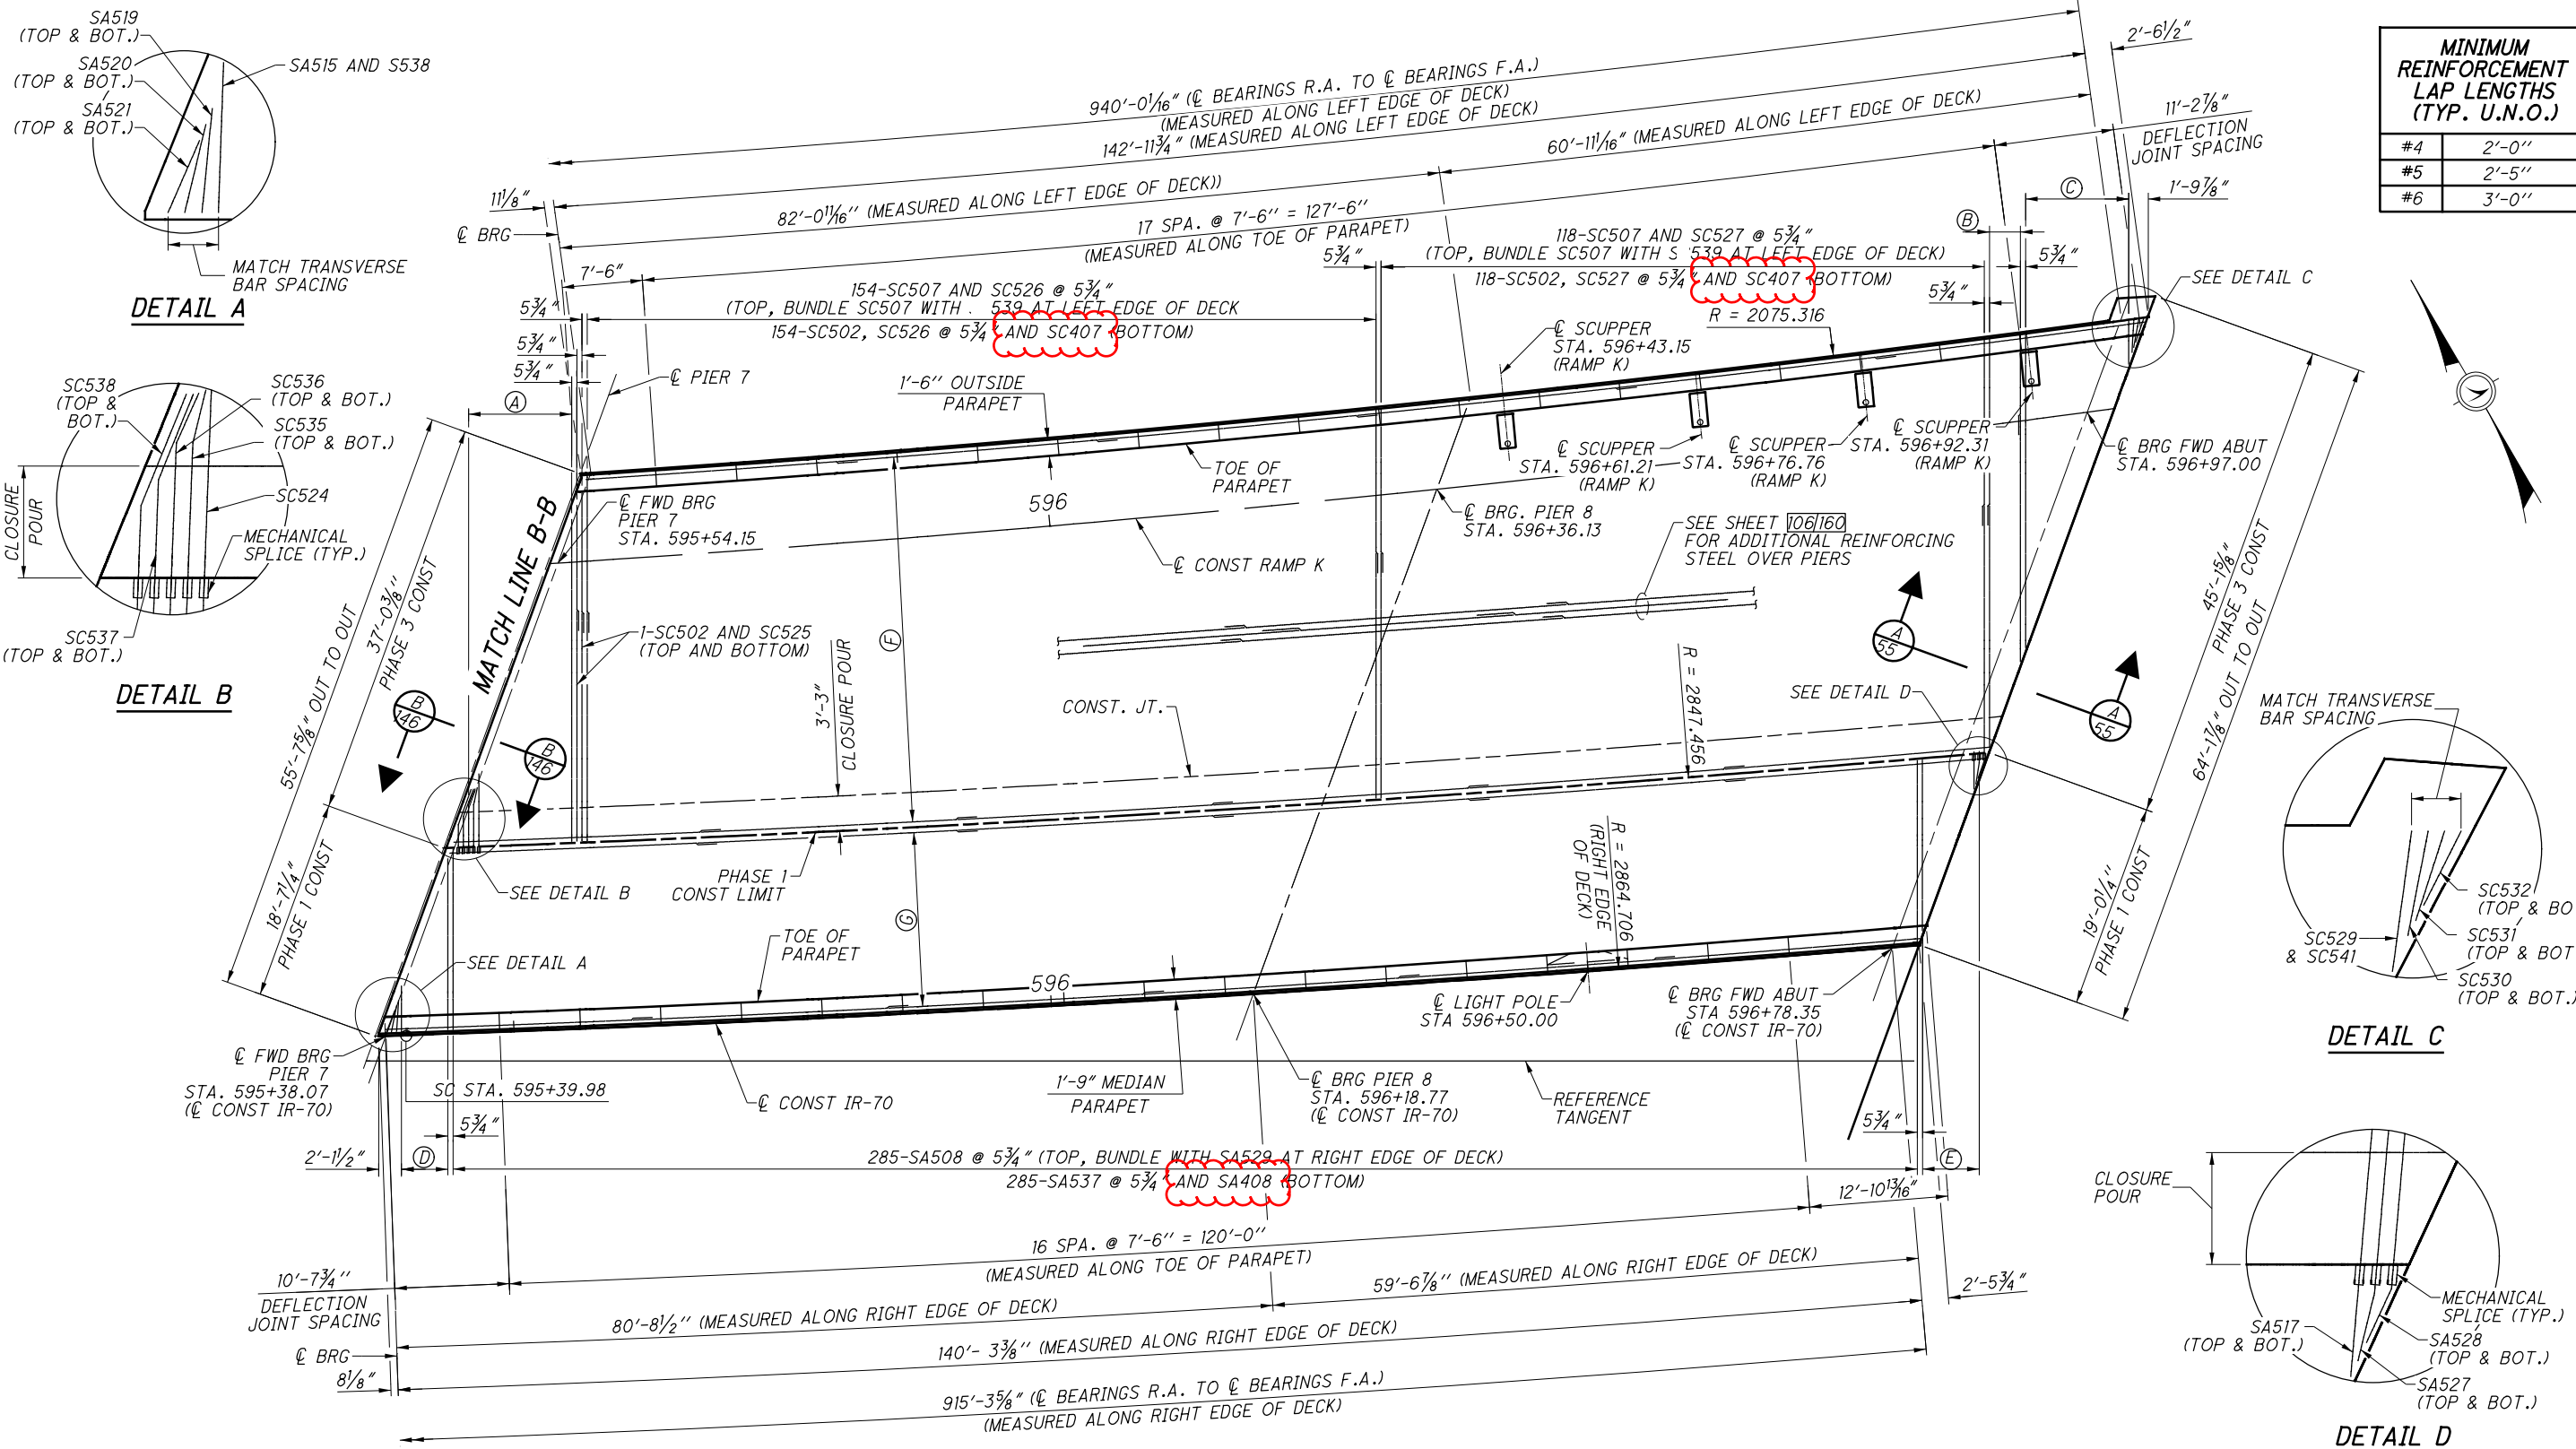

MINIMUM REINFORCEMENT LAP LENGTHS (TYP. U.N.O.)	
#4	2'-0"
#5	2'-5"
#6	3'-0"


DECK REINFORCING PLAN
LEFT SPAN 8 AND 9

- (A) = 1 S.O. 19-SC524 @ 5 3/4" (TOP)
1 S.O. 19-SC524 @ 5 3/4" (BOTTOM)
- (B) = 7-SC507 AND 1 S.O. 7-SC528 @ 5 3/4" (TOP, BUNDLE SC507 WITH SC539 AT LEFT EDGE OF DECK)
7-SC502 AND 1 S.O. 7-SC528 @ 5 3/4" AND SC407 (BOTTOM)
- (C) = 1 S.O. 21-SC529 @ 5 3/4" (TOP, BUNDLE WITH SC539 AT LEFT EDGE OF DECK)
1 S.O. 21-SC541 @ 5 3/4" AND SC407 (BOTTOM)
- (D) = 1 S.O. 10-SA515 @ 5 3/4" (TOP, BUNDLE WITH SA529 AT RIGHT EDGE OF DECK)
1 S.O. 10-SA538 @ 5 3/4" AND SA408 (BOTTOM)
- (E) = 1 S.O. 11-SA517 @ 5 3/4" (TOP)
1 S.O. 11-SA517 @ 5 3/4" (BOTTOM)
- (F) = 39-SC402 (5 LENGTHS) LAPPED WITH 39-SC404 (TOP, SPACED AS SHOWN ON TRANSVERSE SECTION) (FAN BARS AS NECESSARY)
52-SC503 (5 LENGTHS) LAPPED WITH 52-SC505 (BOTTOM, SPACED AS SHOWN ON TRANSVERSE SECTION) (FAN BARS AS NECESSARY)
- (G) = 22-SA402 (5 LENGTHS) LAPPED WITH 22-SA404 (TOP, SPACED AS SHOWN ON TRANSVERSE SECTION) (FAN BARS AS NECESSARY)
23-SA502 (5 LENGTHS) LAPPED WITH 23-SA504 (BOTTOM, SPACED AS SHOWN ON TRANSVERSE SECTION) (FAN BARS AS NECESSARY)

- NOTES:**
- SEE SHEET 103160 FOR ADDITIONAL NOTES AND LEGEND.
 - PLACE TRANSVERSE REINFORCEMENT PERPENDICULAR TO THE REFERENCE TANGENT.
 - MECHANICAL SPLICES ARE REQUIRED FOR THE TRANSVERSE BARS BETWEEN PHASE 1 AND PHASE 3 CONSTRUCTION.

SUBMITTAL: Stage 3
 PLOT DRIVER: 000Tcodd_PDF.plt/cfg
 PENTABLE: 93006_000TV81_Pen.tbl
 pw:\gfnnet-pw.bentley.com\gfnnet-pw-0\Documents\Projects\64771\93006_401-Engineering-GannettFleming\Structures\MUS070_1159L\Sheets\08_sd006_4/6/2021\2:55:39 PM modonnell



MINIMUM REINFORCEMENT LAP LENGTHS (TYP. U.N.O.)	
#4	2'-0"
#5	2'-5"
#6	3'-0"

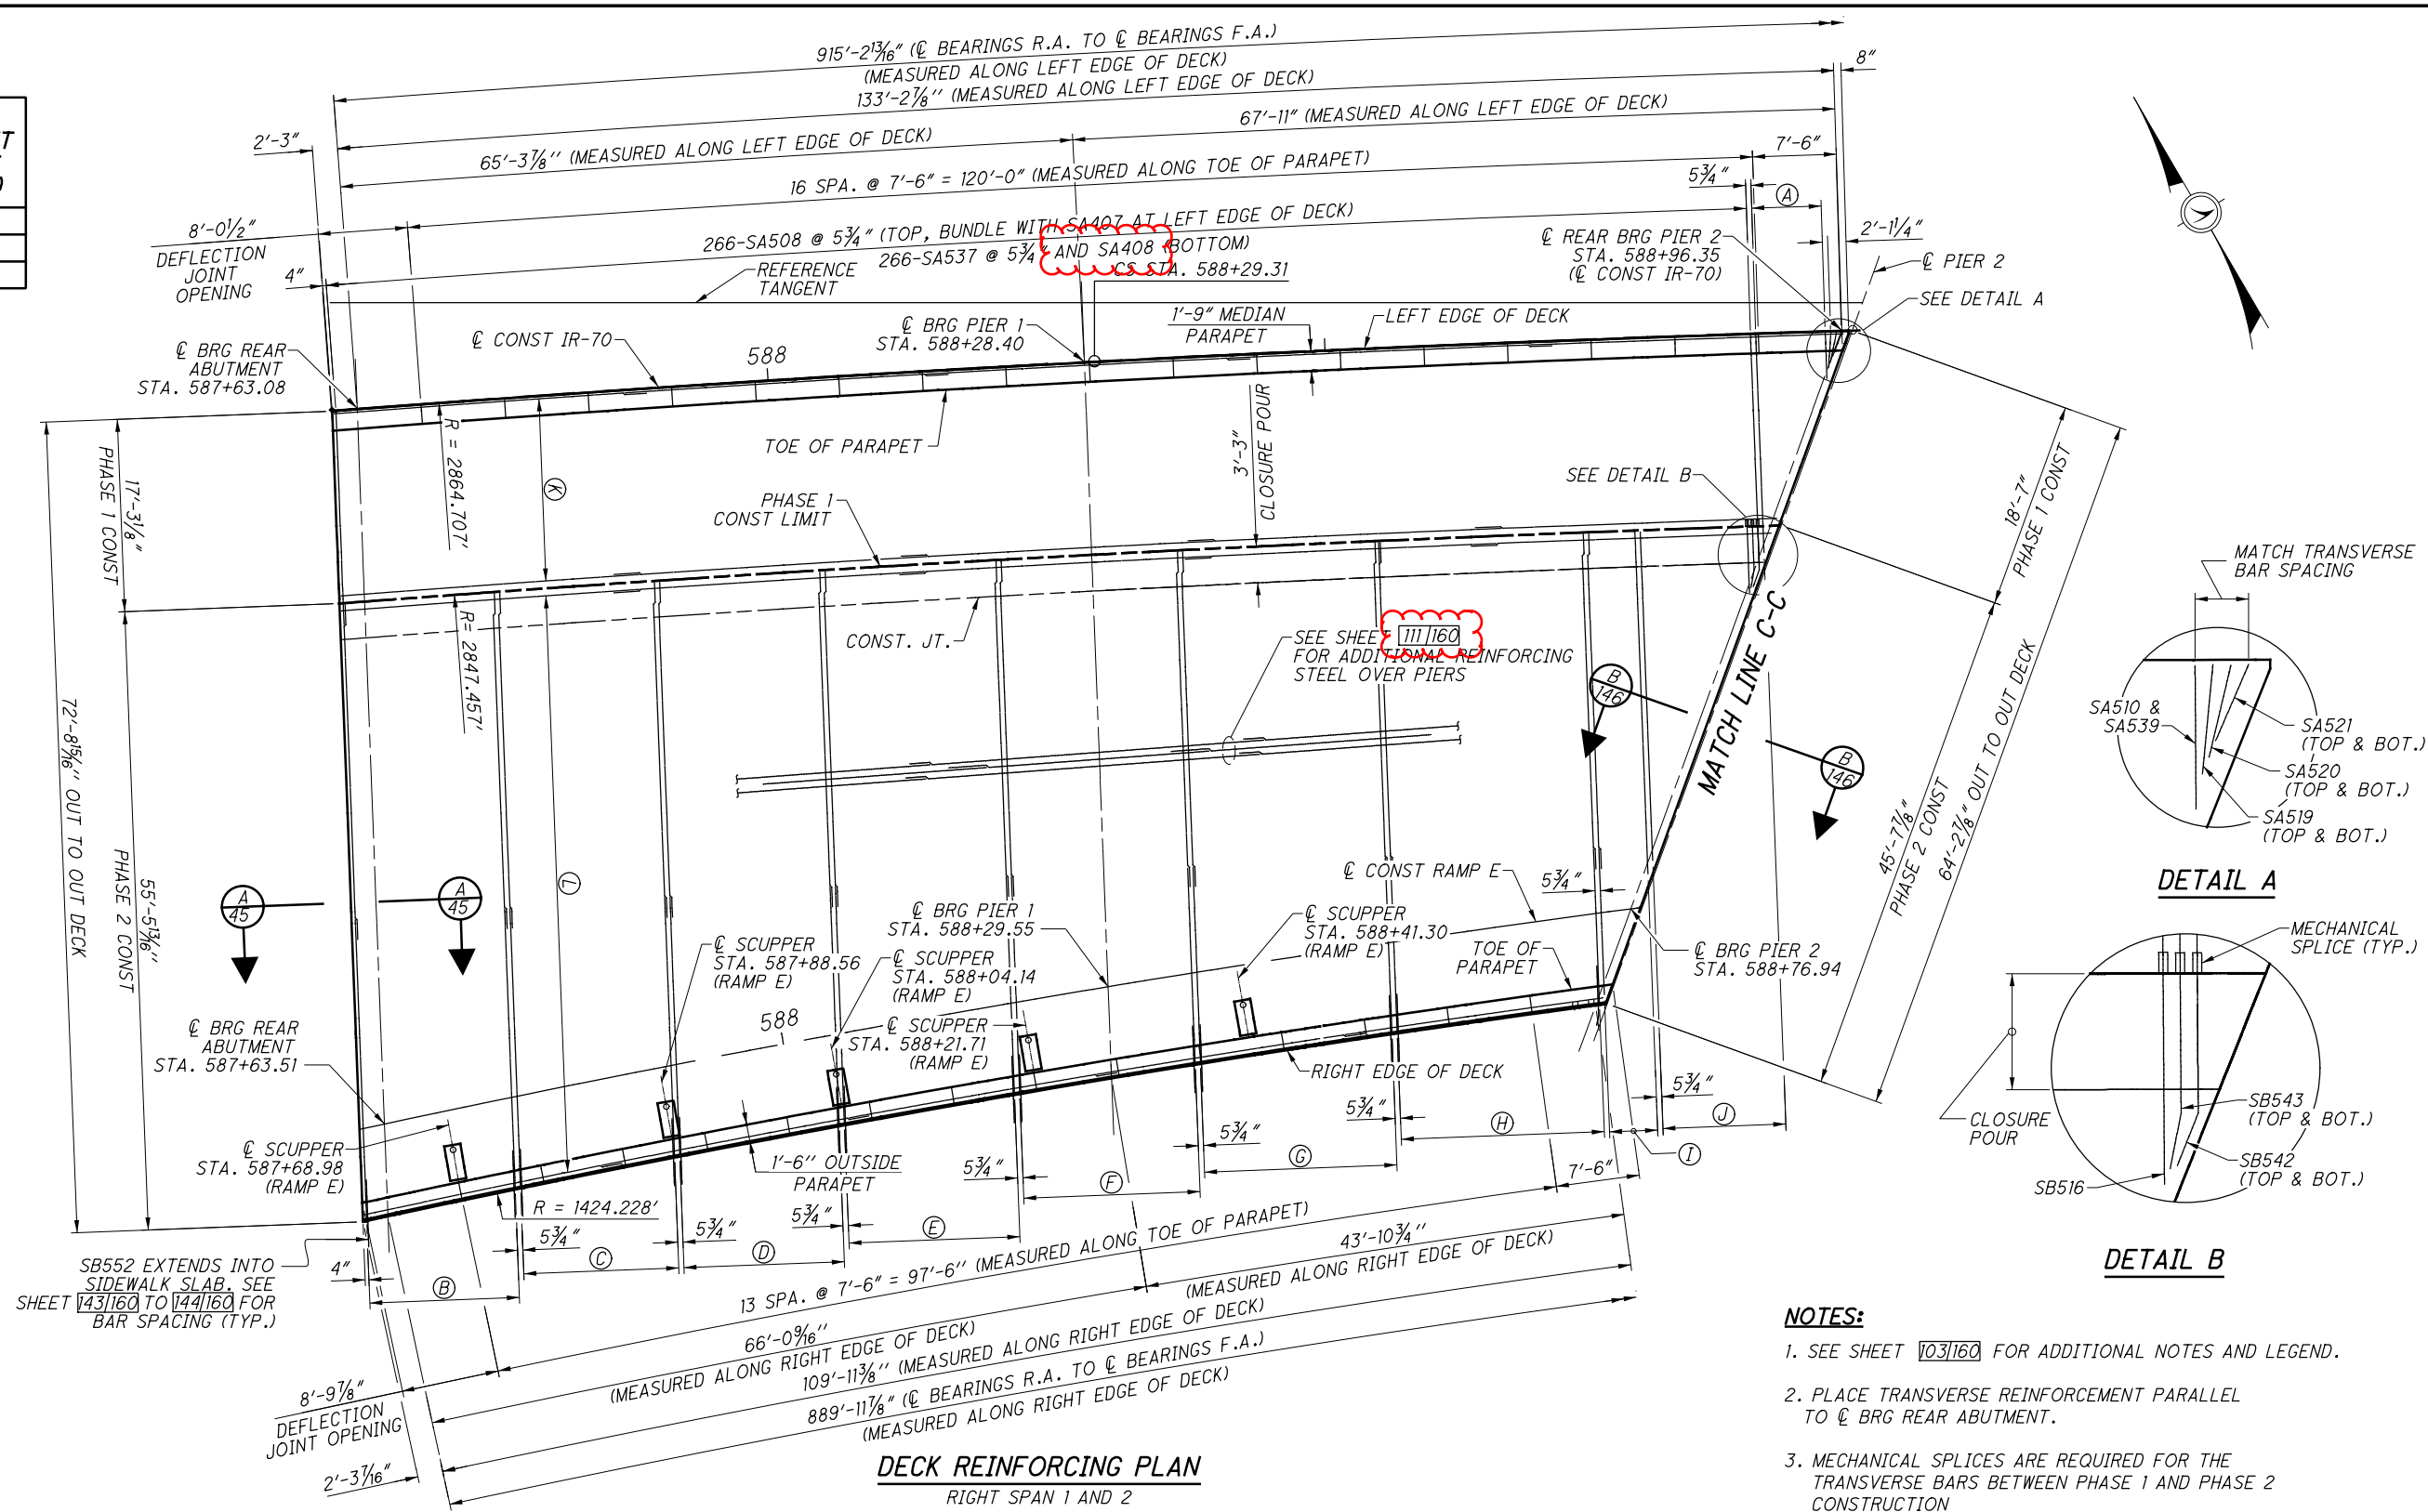

DECK REINFORCING PLAN
RIGHT SPAN 1 AND 2




- NOTES:**
- SEE SHEET 103160 FOR ADDITIONAL NOTES AND LEGEND.
 - PLACE TRANSVERSE REINFORCEMENT PARALLEL TO BRG REAR ABUTMENT.
 - MECHANICAL SPLICES ARE REQUIRED FOR THE TRANSVERSE BARS BETWEEN PHASE 1 AND PHASE 2 CONSTRUCTION

- (A) = 1 S.O. 14-SA510 @ 5 3/4" (TOP BUNDLE WITH SA407 AT LEFT EDGE OF DECK) AND 1 S.O. 14-SA539 @ 5 3/4" (BOTTOM)
- (B) = 29-SB507 AND SB508 @ 5 3/4" (TOP BUNDLE SB507 WITH SB406 AT RIGHT EDGE OF DECK) AND 29-SB502, SB508 @ 5 3/4" (BOTTOM)
- (C) = 30-SB507 AND SB509 @ 5 3/4" (TOP BUNDLE SB507 WITH SB406 AT RIGHT EDGE OF DECK) AND 30-SB502, SB509 @ 5 3/4" (BOTTOM)
- (D) = 31-SB507 AND SB510 @ 5 3/4" (TOP BUNDLE SB507 WITH SB406 AT RIGHT EDGE OF DECK) AND 31-SB502, SB510 @ 5 3/4" (BOTTOM)
- (E) = 33-SB507 AND SB511 @ 5 3/4" (TOP BUNDLE SB507 WITH SB406 AT RIGHT EDGE OF DECK) AND 33-SB502, SB511 @ 5 3/4" (BOTTOM)
- (F) = 34-SB507 AND SB512 @ 5 3/4" (TOP BUNDLE SB507 WITH SB406 AT RIGHT EDGE OF DECK) AND 34-SB502, SB512 @ 5 3/4" (BOTTOM)
- (G) = 37-SB507 AND SB513 @ 5 3/4" (TOP BUNDLE SB507 WITH SB406 AT RIGHT EDGE OF DECK) AND 37-SB502, SB513 @ 5 3/4" (BOTTOM)
- (H) = 39-SB507 AND SB514 @ 5 3/4" (TOP BUNDLE SB507 WITH SB406 AT RIGHT EDGE OF DECK) AND 39-SB502, SB514 @ 5 3/4" (BOTTOM)
- (I) = 10-SB502 AND 1 S.O. 10-SB515 @ 5 3/4" (TOP) AND 10-SB502 AND 1 S.O. 10-SB515 @ 5 3/4" (BOTTOM)
- (J) = 1 S.O. 21-SB516 @ 5 3/4" (TOP) AND 1 S.O. 21-SB516 @ 5 3/4" (BOTTOM)
- (K) = 21-SA401 (5 LENGTHS) LAPPED WITH 1 S.O. 21-SA406 (TOP, SPACED AS SHOWN ON TRANSVERSE SECTION) AND 24-SA501 (5 LENGTHS) LAPPED WITH 1 S.O. 24-SA506 (BOTTOM, SPACED AS SHOWN ON TRANSVERSE SECTION)
- (L) = 62-SB401 (5 LENGTHS) LAPPED WITH 1 S.O. 62-SB405 (TOP, SPACED AS SHOWN ON TRANSVERSE SECTION) (FAN BARS AS NECESSARY) AND 67-SB501 (5 LENGTHS) LAPPED WITH 1 S.O. 67-SB506 (BOTTOM, SPACED AS SHOWN ON TRANSVERSE SECTION) (FAN BARS AS NECESSARY)

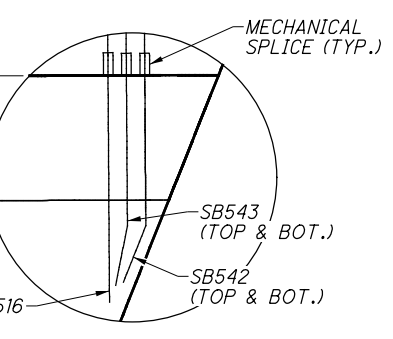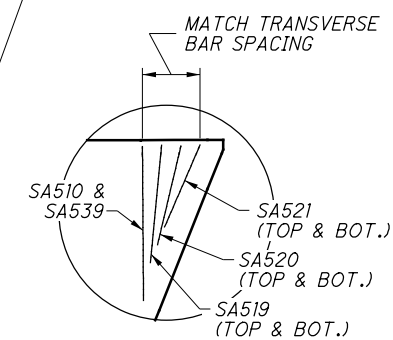

MINIMUM REINFORCEMENT LAP LENGTHS (TYP. U.N.O.)	
#4	2'-0"
#5	2'-5"
#6	3'-0"

SUBMITTAL: Stage 3
 PLOT DRIVER: 000Tcodd_PDF.plt/cfg
 PENTABLE: 93006_000T181_Pen.tbl
 pw:\gfn\p-w-bentley.com\gfn\p-w-0\Documents\Projects\6477\93006_401-Engineering-GannettFleming\Structures\MUS070_1159\Sheets\09_sd007 4/6/2021 3:01:40 PM modonnell

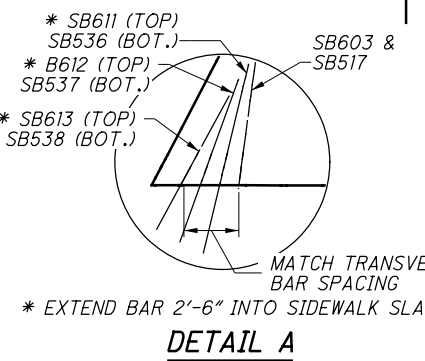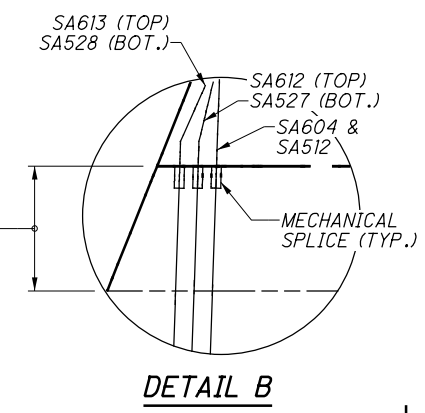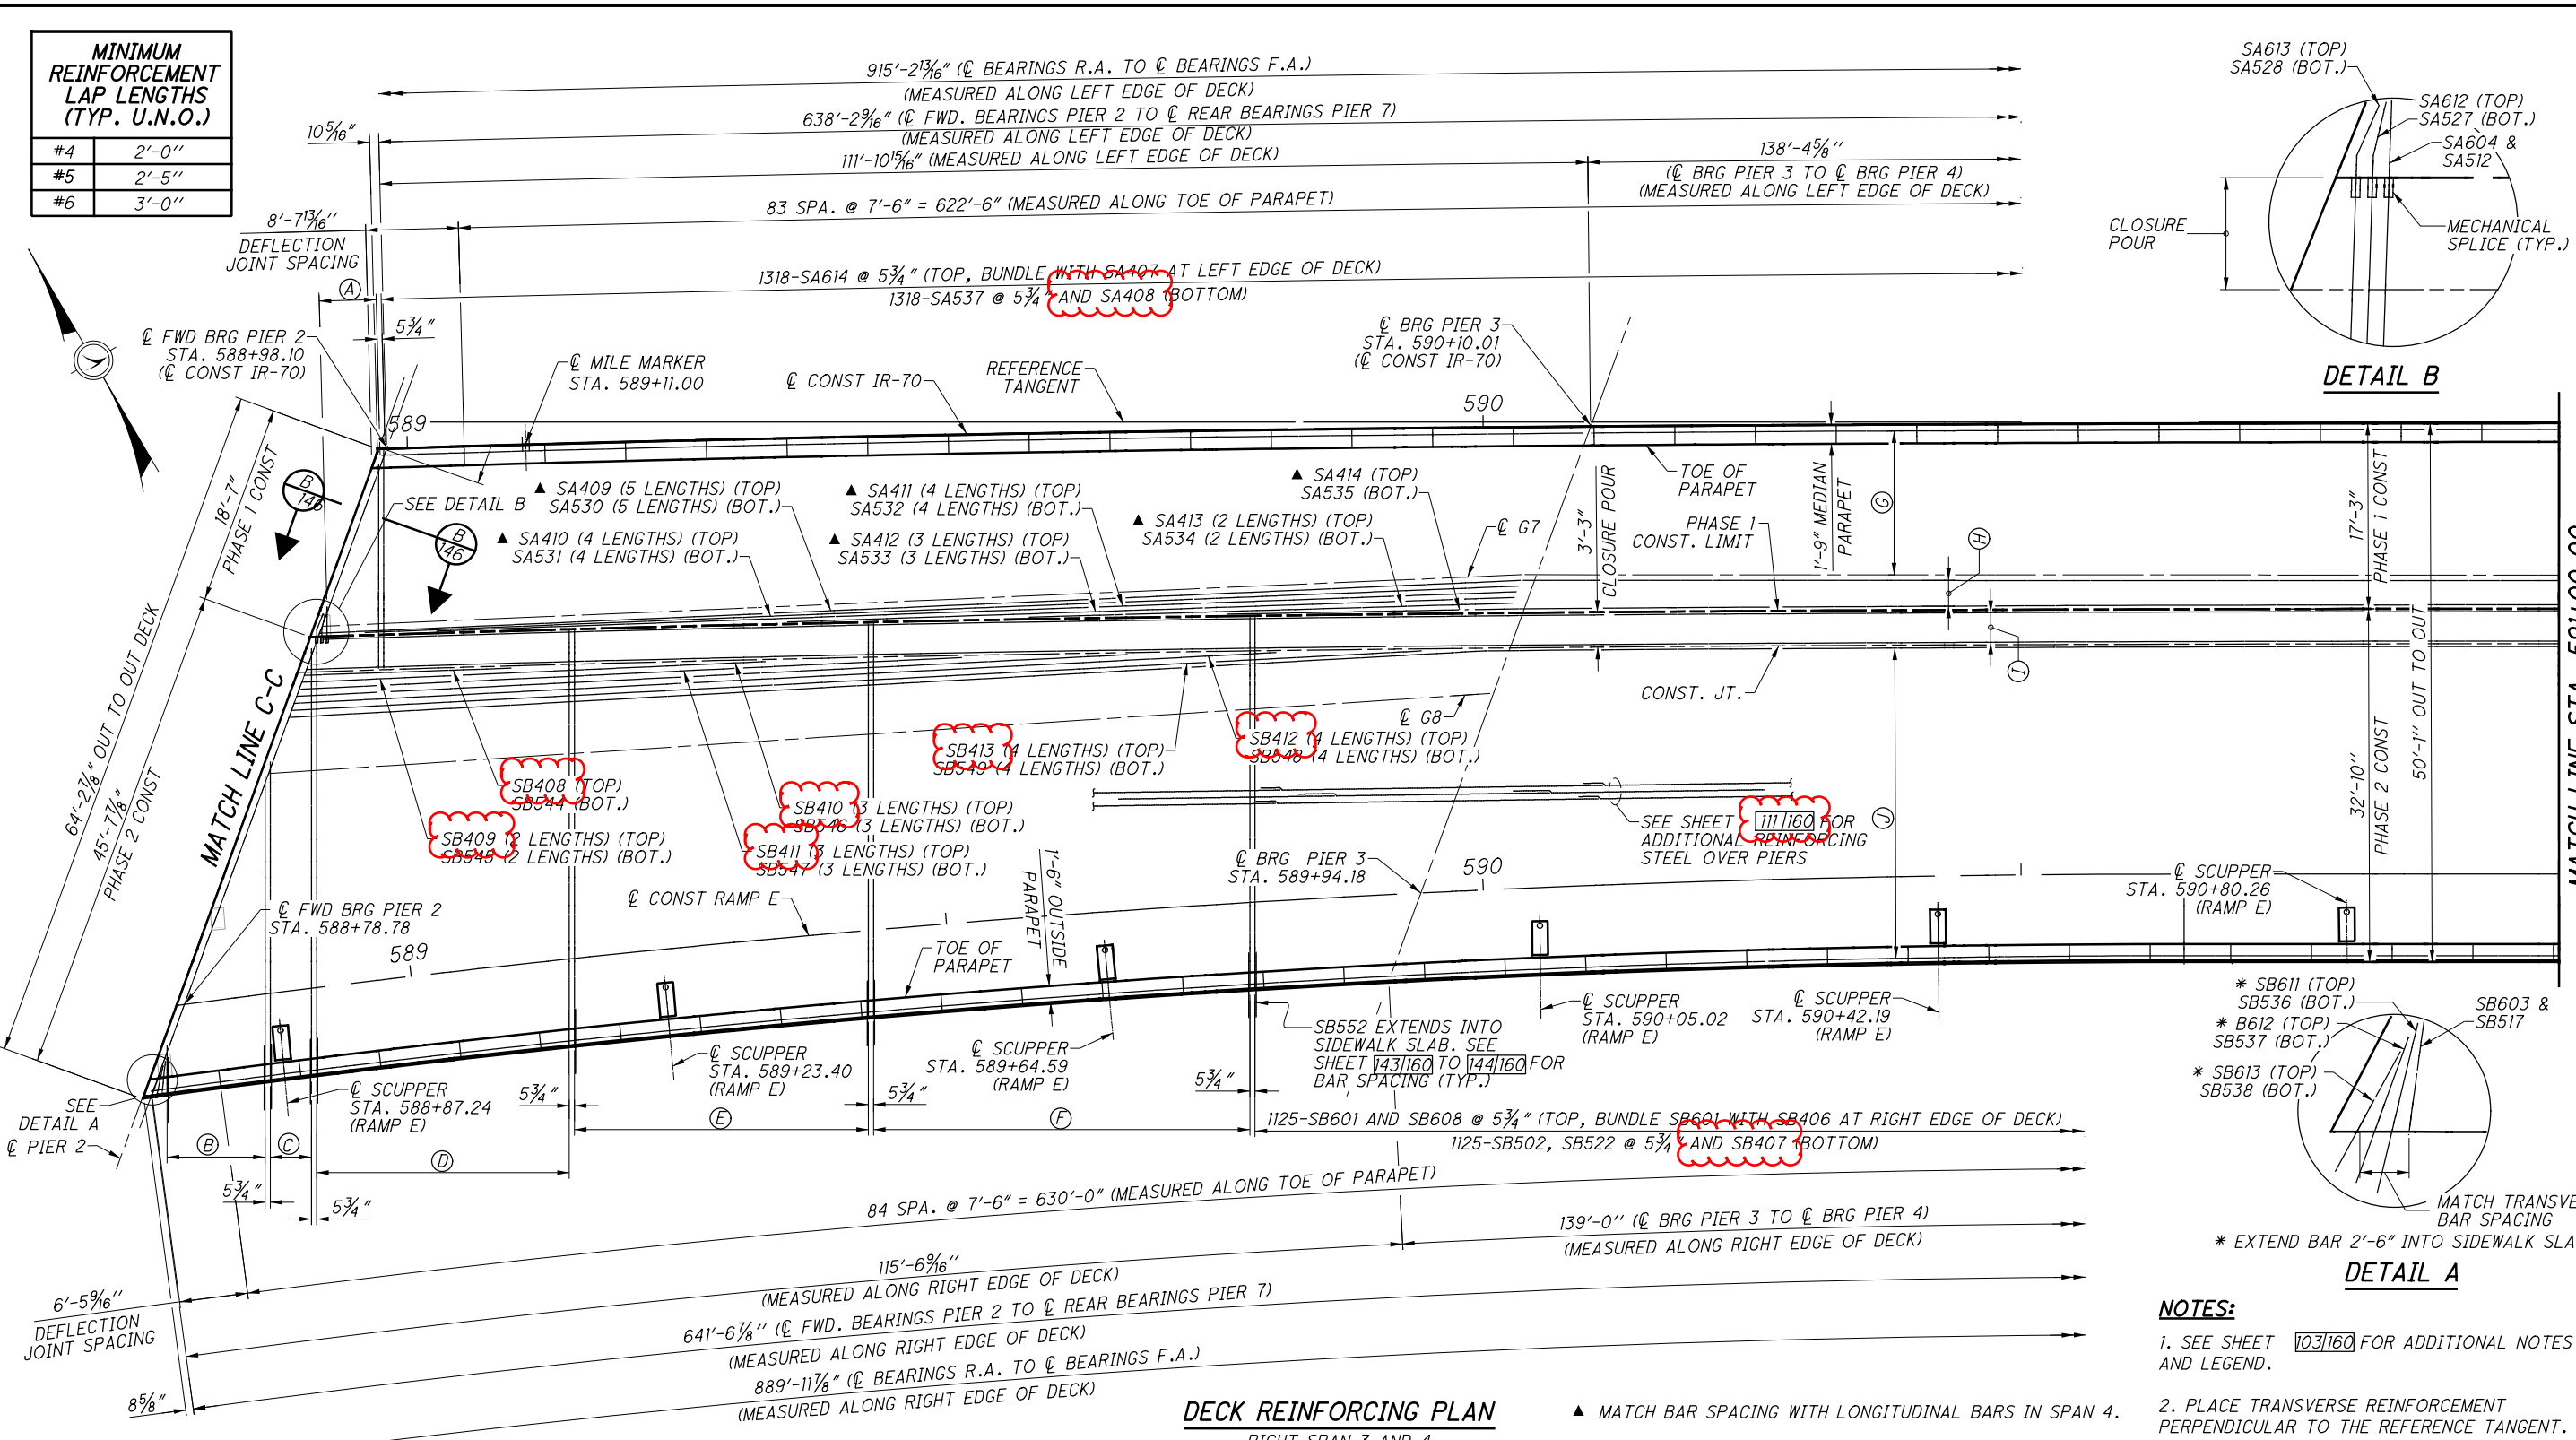

DECK REINFORCING PLAN
RIGHT SPAN 3 AND 4

- (A) = 1 S.O. 12-SA604 @ 5 3/4" (TOP)
1 S.O. 12-SA512 @ 5 3/4" (BOTTOM)
- (B) = 21-SB603 @ 5 3/4" (TOP BUNDLE WITH SB406 AT RIGHT EDGE OF DECK)
21-SB517 @ 5 3/4" AND SB407 (BOTTOM)
- (C) = 9-SB601 AND SB604 @ 5 3/4" (TOP BUNDLE SB601 WITH SB406 AT RIGHT EDGE OF DECK)
9-SB502, SB518 @ 5 3/4" AND SB407 (BOTTOM)
- (D) = 50-SB601 AND SB605 @ 5 3/4" (TOP BUNDLE SB601 WITH SB406 AT RIGHT EDGE OF DECK)
50-SB502, SB519 @ 5 3/4" AND SB407 (BOTTOM)
- (E) = 58-SB601 AND SB606 @ 5 3/4" (TOP BUNDLE SB601 WITH SB406 AT RIGHT EDGE OF DECK)
58-SB502, SB520 @ 5 3/4" AND SB407 (BOTTOM)
- (F) = 74-SB601 AND SB607 @ 5 3/4" (TOP BUNDLE SB601 WITH SB406 AT RIGHT EDGE OF DECK)
74-SB502, SB521 @ 5 3/4" AND SB407 (BOTTOM)
- (G) = 27-SA402 (23 LENGTHS) LAPPED WITH 27-SA403 (TOP, SPACED AS SHOWN ON TRANSVERSE SECTION) (FAN BARS AS NECESSARY)
21-SA502 (23 LENGTHS) LAPPED WITH 21-SA503 (BOTTOM, SPACED AS SHOWN ON TRANSVERSE SECTION) (FAN BARS AS NECESSARY)
- (H) = 6-SA402 (20 LENGTHS) LAPPED WITH 6-SA403 (TOP, SPACED AS SHOWN ON TRANSVERSE SECTION)
5-SA502 (20 LENGTHS) LAPPED WITH 5-SA503 (BOTTOM, SPACED AS SHOWN ON TRANSVERSE SECTION)
- (I) = 5-SB402 (23 LENGTHS) LAPPED WITH 5-SB403 (TOP, SPACED AS SHOWN ON TRANSVERSE SECTION)
5-SB502 (23 LENGTHS) LAPPED WITH 5-SB504 (BOTTOM, SPACED AS SHOWN ON TRANSVERSE SECTION)
- (J) = 54-SB402 (23 LENGTHS) LAPPED WITH 54-SB403 (TOP, SPACED AS SHOWN ON TRANSVERSE SECTION) (FAN BARS AS NECESSARY)
44-SB502 (23 LENGTHS) LAPPED WITH 44-SB504 (BOTTOM, SPACED AS SHOWN ON TRANSVERSE SECTION) (FAN BARS AS NECESSARY)

- NOTES:**
- SEE SHEET 103160 FOR ADDITIONAL NOTES AND LEGEND.
 - PLACE TRANSVERSE REINFORCEMENT PERPENDICULAR TO THE REFERENCE TANGENT.
 - MECHANICAL SPLICES ARE REQUIRED FOR THE TRANSVERSE BARS BETWEEN PHASE 1 AND PHASE 2 CONSTRUCTION.


GannettFleming
 DESIGN AGENCY
 ENGINEERS & ARCHITECTS, P.C.
 2800 CORPORATE EXCHANGE DRIVE SUITE 230
 COLUMBUS, OHIO 43231

DATE: 12/2020
 REVIEWED: MTO
 DRAWN: JIM
 CHECKED: JAY
 DESIGNED: JAY
 STRUCTURE FILE NUMBER: 6002854
 BRIDGE NO.: MUS-70-1159
 OVER LINDEN AVE., OHCR & CUOH RAILROADS, AND MUSKINGUM RIVER

MUS-70-10.49
 PID No. 93006


110/160
 1556
 2231

SUBMITTAL: Stage 3
 PLOT DRIVER: 000Tcodd_PDF.pltcfgr
 PENTABLE: 93006_0001V81_Pen.tbl
 pw:\gfnnet-pw.bentley.com\gfnnet-pw-01\Documents\Projects\6477\93006_401-Engineering-Gannett+Fleming\Structures\MUS070_1159L\Sheets\10_sd008 4/6/2020 12:56:04 PM modonnell

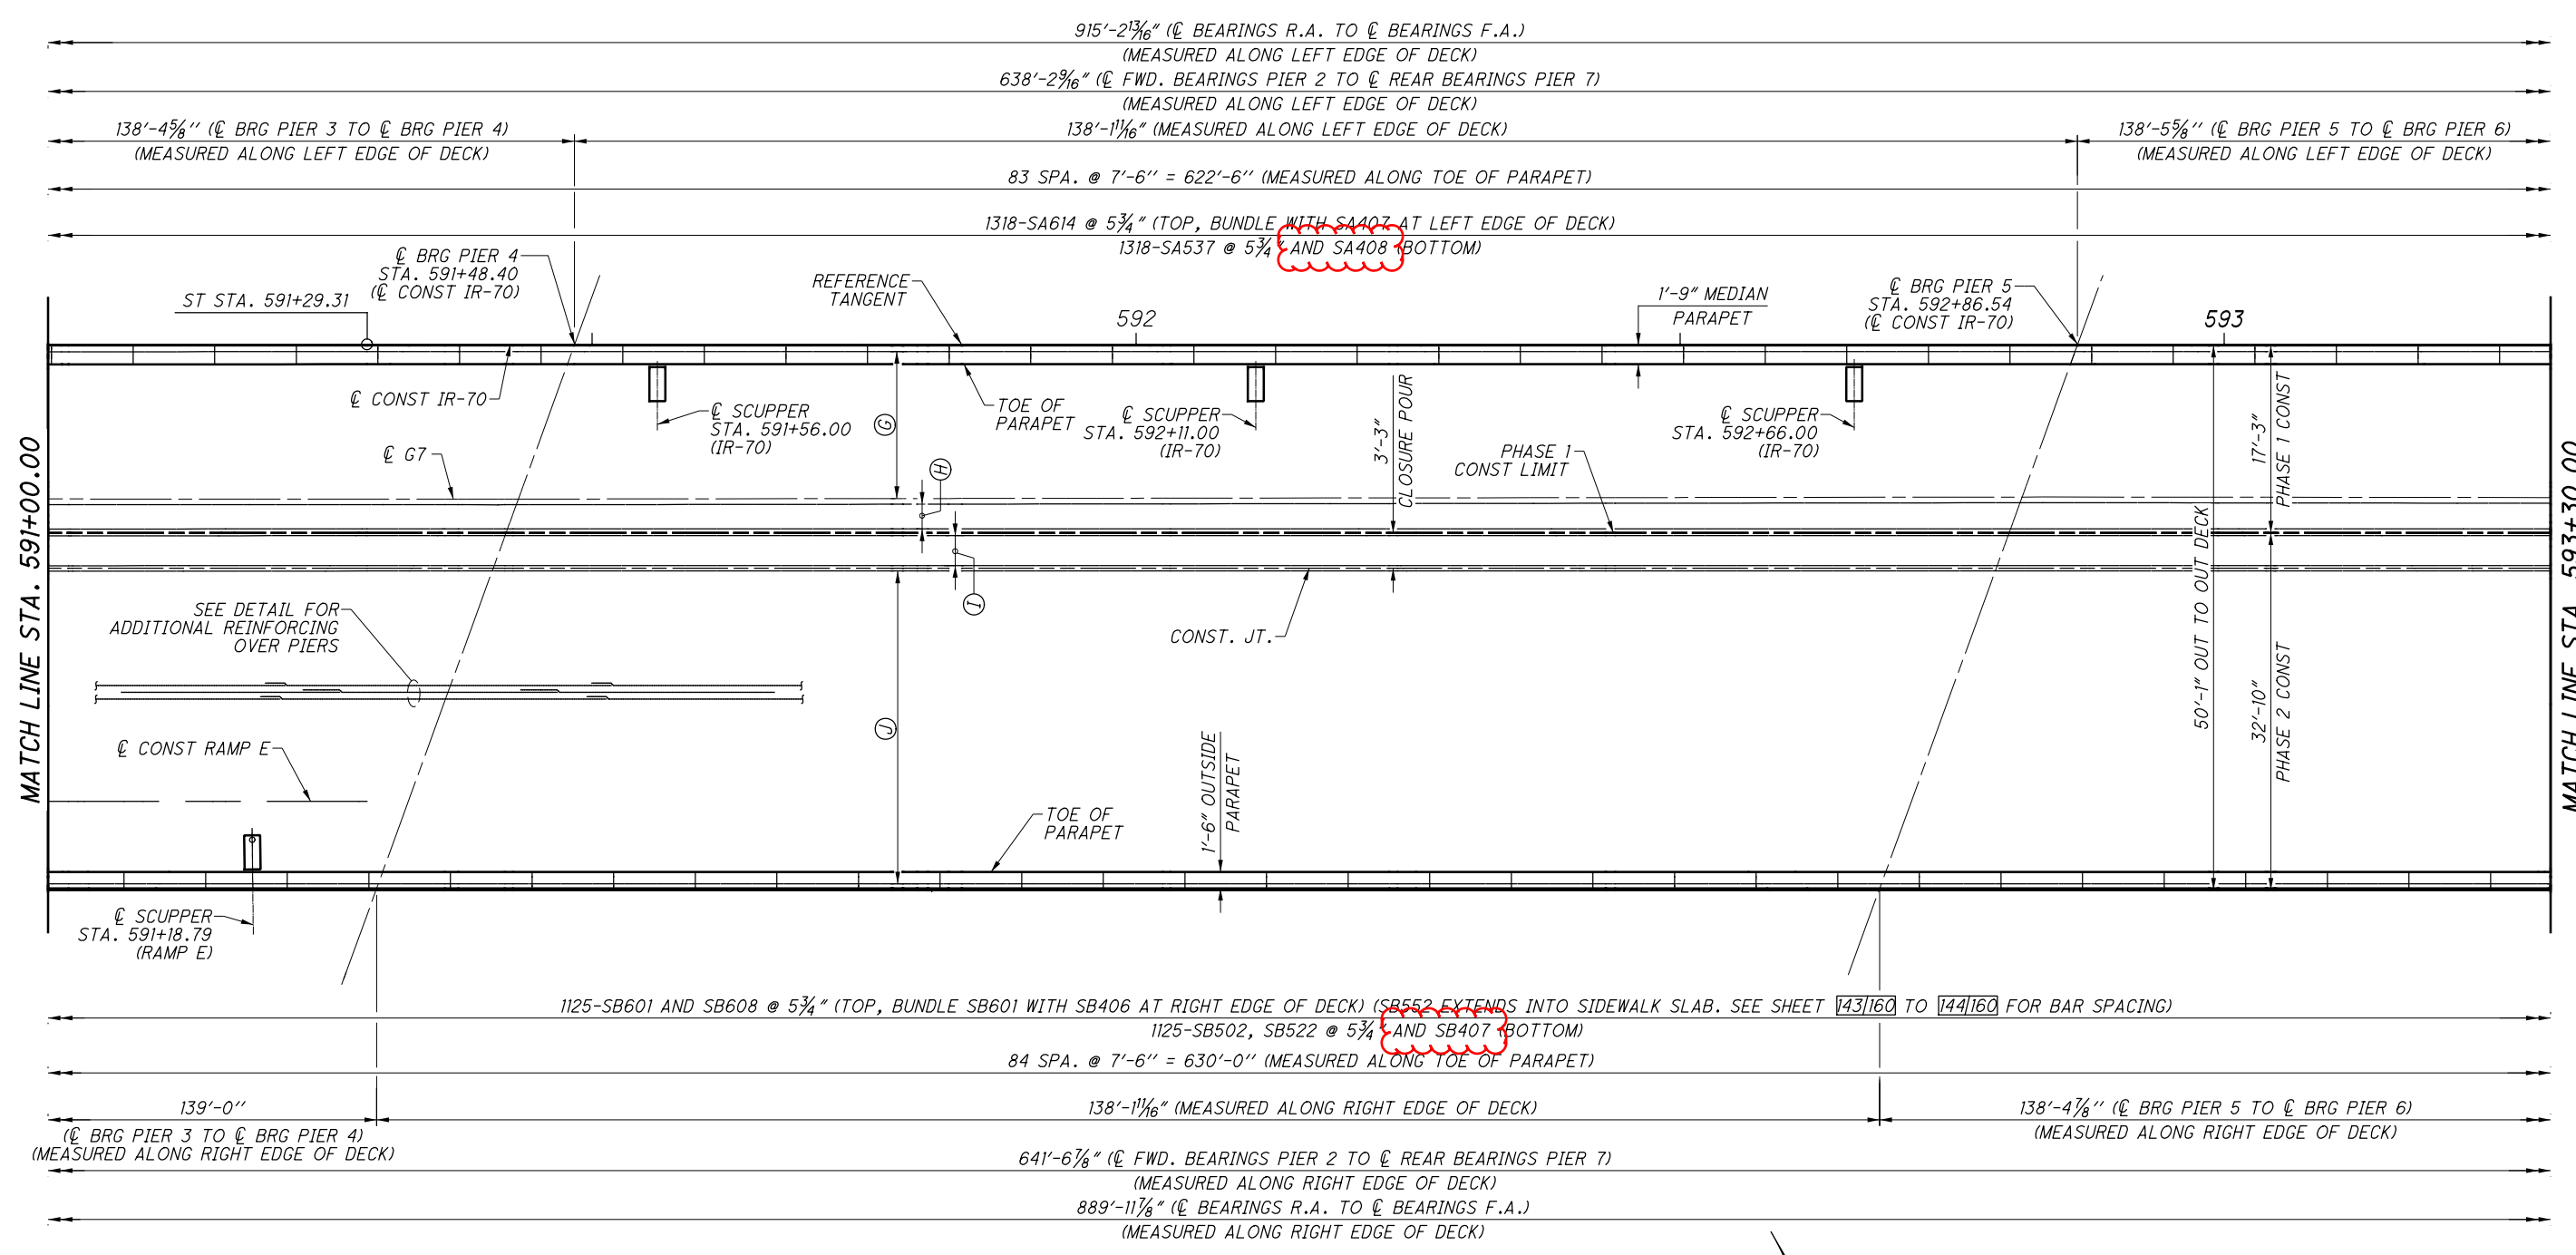

DECK REINFORCING PLAN
RIGHT SPAN 4, 5 AND 6

- Ⓒ = 27-SA402 (23 LENGTHS) LAPPED WITH 27-SA403 (TOP, SPACED AS SHOWN ON TRANSVERSE SECTION) (FAN BARS AS NECESSARY)
21-SA502 (23 LENGTHS) LAPPED WITH 21-SA503 (BOTTOM, SPACED AS SHOWN ON TRANSVERSE SECTION) (FAN BARS AS NECESSARY)
- Ⓓ = 6-SA402 (20 LENGTHS) LAPPED WITH 6-SA403 (TOP, SPACED AS SHOWN ON TRANSVERSE SECTION)
5-SA502 (20 LENGTHS) LAPPED WITH 5-SA503 (BOTTOM, SPACED AS SHOWN ON TRANSVERSE SECTION)
- Ⓔ = 5-SB402 (23 LENGTHS) LAPPED WITH 5-SB403 (TOP, SPACED AS SHOWN ON TRANSVERSE SECTION)
5-SB502 (23 LENGTHS) LAPPED WITH 5-SB504 (BOTTOM, SPACED AS SHOWN ON TRANSVERSE SECTION)
- Ⓕ = 54-SB402 (23 LENGTHS) LAPPED WITH 54-SB403 (TOP, SPACED AS SHOWN ON TRANSVERSE SECTION) (FAN BARS AS NECESSARY)
44-SB502 (23 LENGTHS) LAPPED WITH 44-SB504 (BOTTOM, SPACED AS SHOWN ON TRANSVERSE SECTION) (FAN BARS AS NECESSARY)

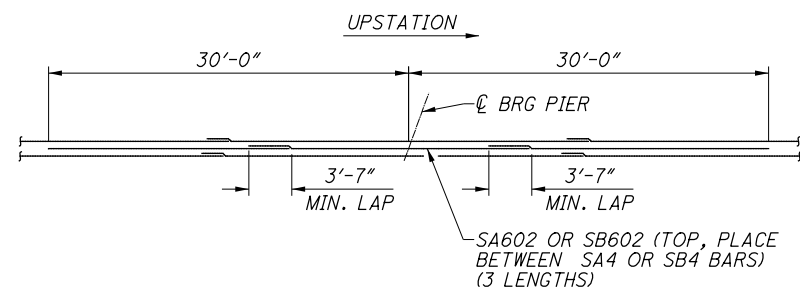

ADDITIONAL REINFORCEMENT OVER PIERS

MINIMUM REINFORCEMENT LAP LENGTHS (TYP. U.N.O.)	
#4	2'-0"
#5	2'-5"
#6	3'-0"

- NOTES:**
- SEE SHEET 103/160 FOR ADDITIONAL NOTES AND LEGEND.
 - PLACE TRANSVERSE REINFORCEMENT PERPENDICULAR TO THE REFERENCE TANGENT.
 - MECHANICAL SPLICES ARE REQUIRED FOR THE TRANSVERSE BARS BETWEEN PHASE 1 AND PHASE 2 CONSTRUCTION.


GannettFleming
 DESIGN AGENCY
 ENGINEERS & ARCHITECTS, P.C.
 2500 CORPORATE EXCHANGE DRIVE SUITE 230
 COLUMBUS, OHIO 43231

BRIDGE NO. MUS-70-1159
 OVER LINDEN AVE, OHCR & CUOH RAILROADS, AND MUSKINGUM RIVER

MUS-70-10-49
PID No. 93006


111 / 160
 1557
 2231

DESIGNED	JAY	CHECKED	RFJ
DRAWN	JM	REVISED	
REVIEWED	MTO	DATE	12/2020
STRUCTURE FILE NUMBER	6002854		

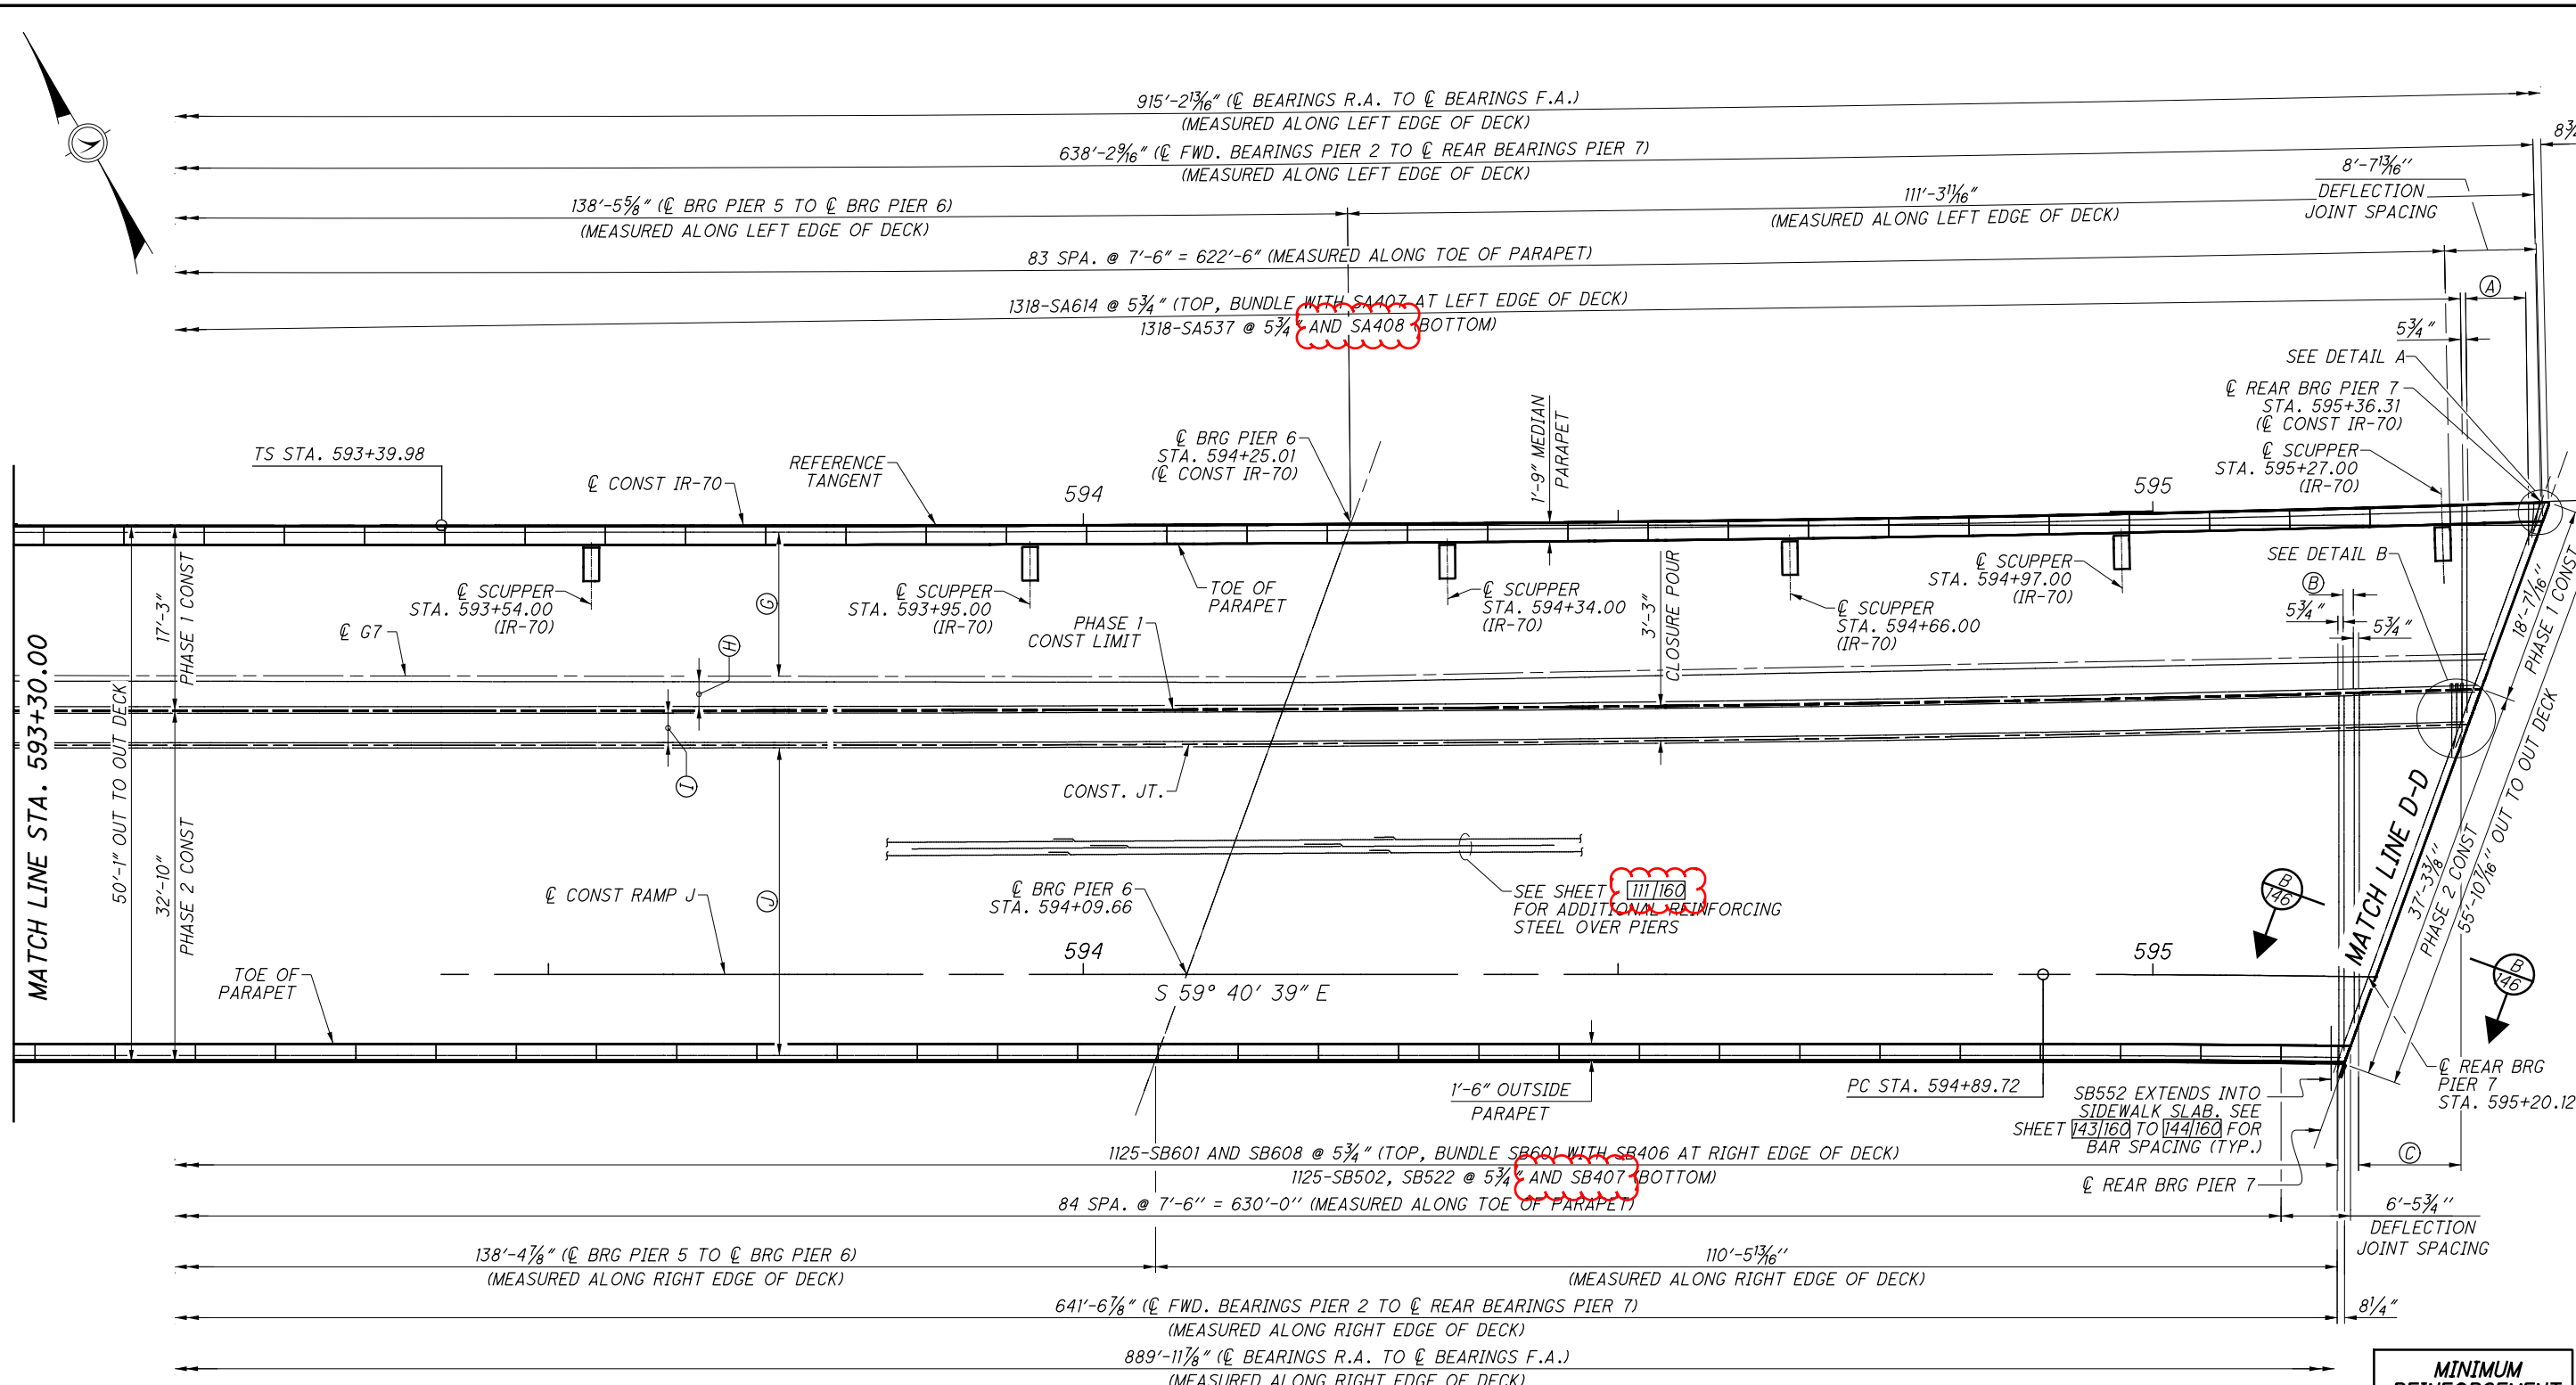

DECK REINFORCNG PLAN
 RIGHT SPAN 6 AND 7


- (A) = 1 S.O. 13-SA606 @ 5 3/4" (TOP, BUNDLE WITH SA407 AT LEFT EDGE OF DECK) 1 S.O. 13-SA514 @ 5 3/4" (BOTTOM)
- (B) = 3-SB616 AND 1 S.O. 3-SB609 @ 5 3/4" (TOP) 3-SB502 AND 1 S.O. 3-SB523 @ 5 3/4" (BOTTOM)
- (C) = 1 S.O. 19-SB610 @ 5 3/4" (TOP) 1 S.O. 19-SB524 @ 5 3/4" (BOTTOM)
- (G) = 27-SA402 (23 LENGTHS) LAPPED WITH 27-SA403 (TOP, SPACED AS SHOWN ON TRANSVERSE SECTION) (FAN BARS AS NECESSARY) 21-SA502 (23 LENGTHS) LAPPED WITH 21-SA503 (BOTTOM, SPACED AS SHOWN ON TRANSVERSE SECTION) (FAN BARS AS NECESSARY)
- (H) = 6-SA402 (20 LENGTHS) LAPPED WITH 6-SA403 (TOP, SPACED AS SHOWN ON TRANSVERSE SECTION) 5-SA502 (20 LENGTHS) LAPPED WITH 5-SA503 (BOTTOM, SPACED AS SHOWN ON TRANSVERSE SECTION)
- (I) = 5-SB402 (23 LENGTHS) LAPPED WITH 5-SB403 (TOP, SPACED AS SHOWN ON TRANSVERSE SECTION) 5-SB502 (23 LENGTHS) LAPPED WITH 5-SB504 (BOTTOM, SPACED AS SHOWN ON TRANSVERSE SECTION)
- (J) = 54-SB402 (23 LENGTHS) LAPPED WITH 54-SB403 (TOP, SPACED AS SHOWN ON TRANSVERSE SECTION) (FAN BARS AS NECESSARY) 44-SB502 (23 LENGTHS) LAPPED WITH 44-SB504 (BOTTOM, SPACED AS SHOWN ON TRANSVERSE SECTION) (FAN BARS AS NECESSARY)

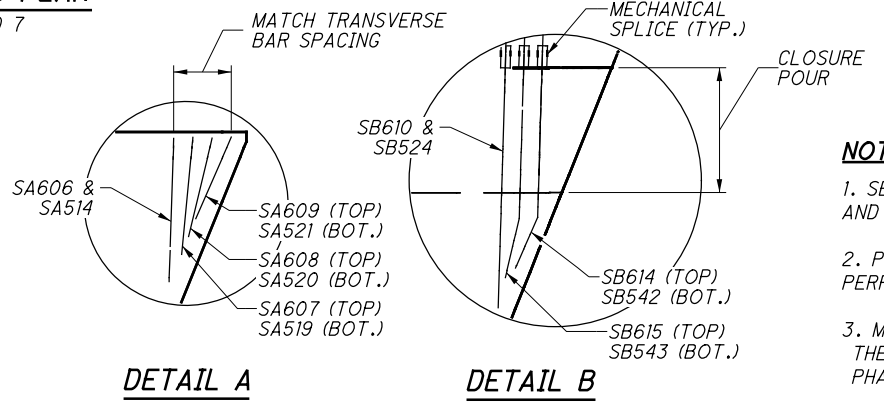

MINIMUM REINFORCEMENT LAP LENGTHS (TYP. U.N.O.)

Bar Size	Lap Length
#4	2'-0"
#5	2'-5"
#6	3'-0"

- NOTES:**
- SEE SHEET 103160 FOR ADDITIONAL NOTES AND LEGEND.
 - PLACE TRANSVERSE REINFORCEMENT PERPENDICULAR TO THE REFERENCE TANGENT.
 - MECHANICAL SPLICES ARE REQUIRED FOR THE TRANSVERSE BARS BETWEEN PHASE 1 AND PHASE 2 CONSTRUCTION.

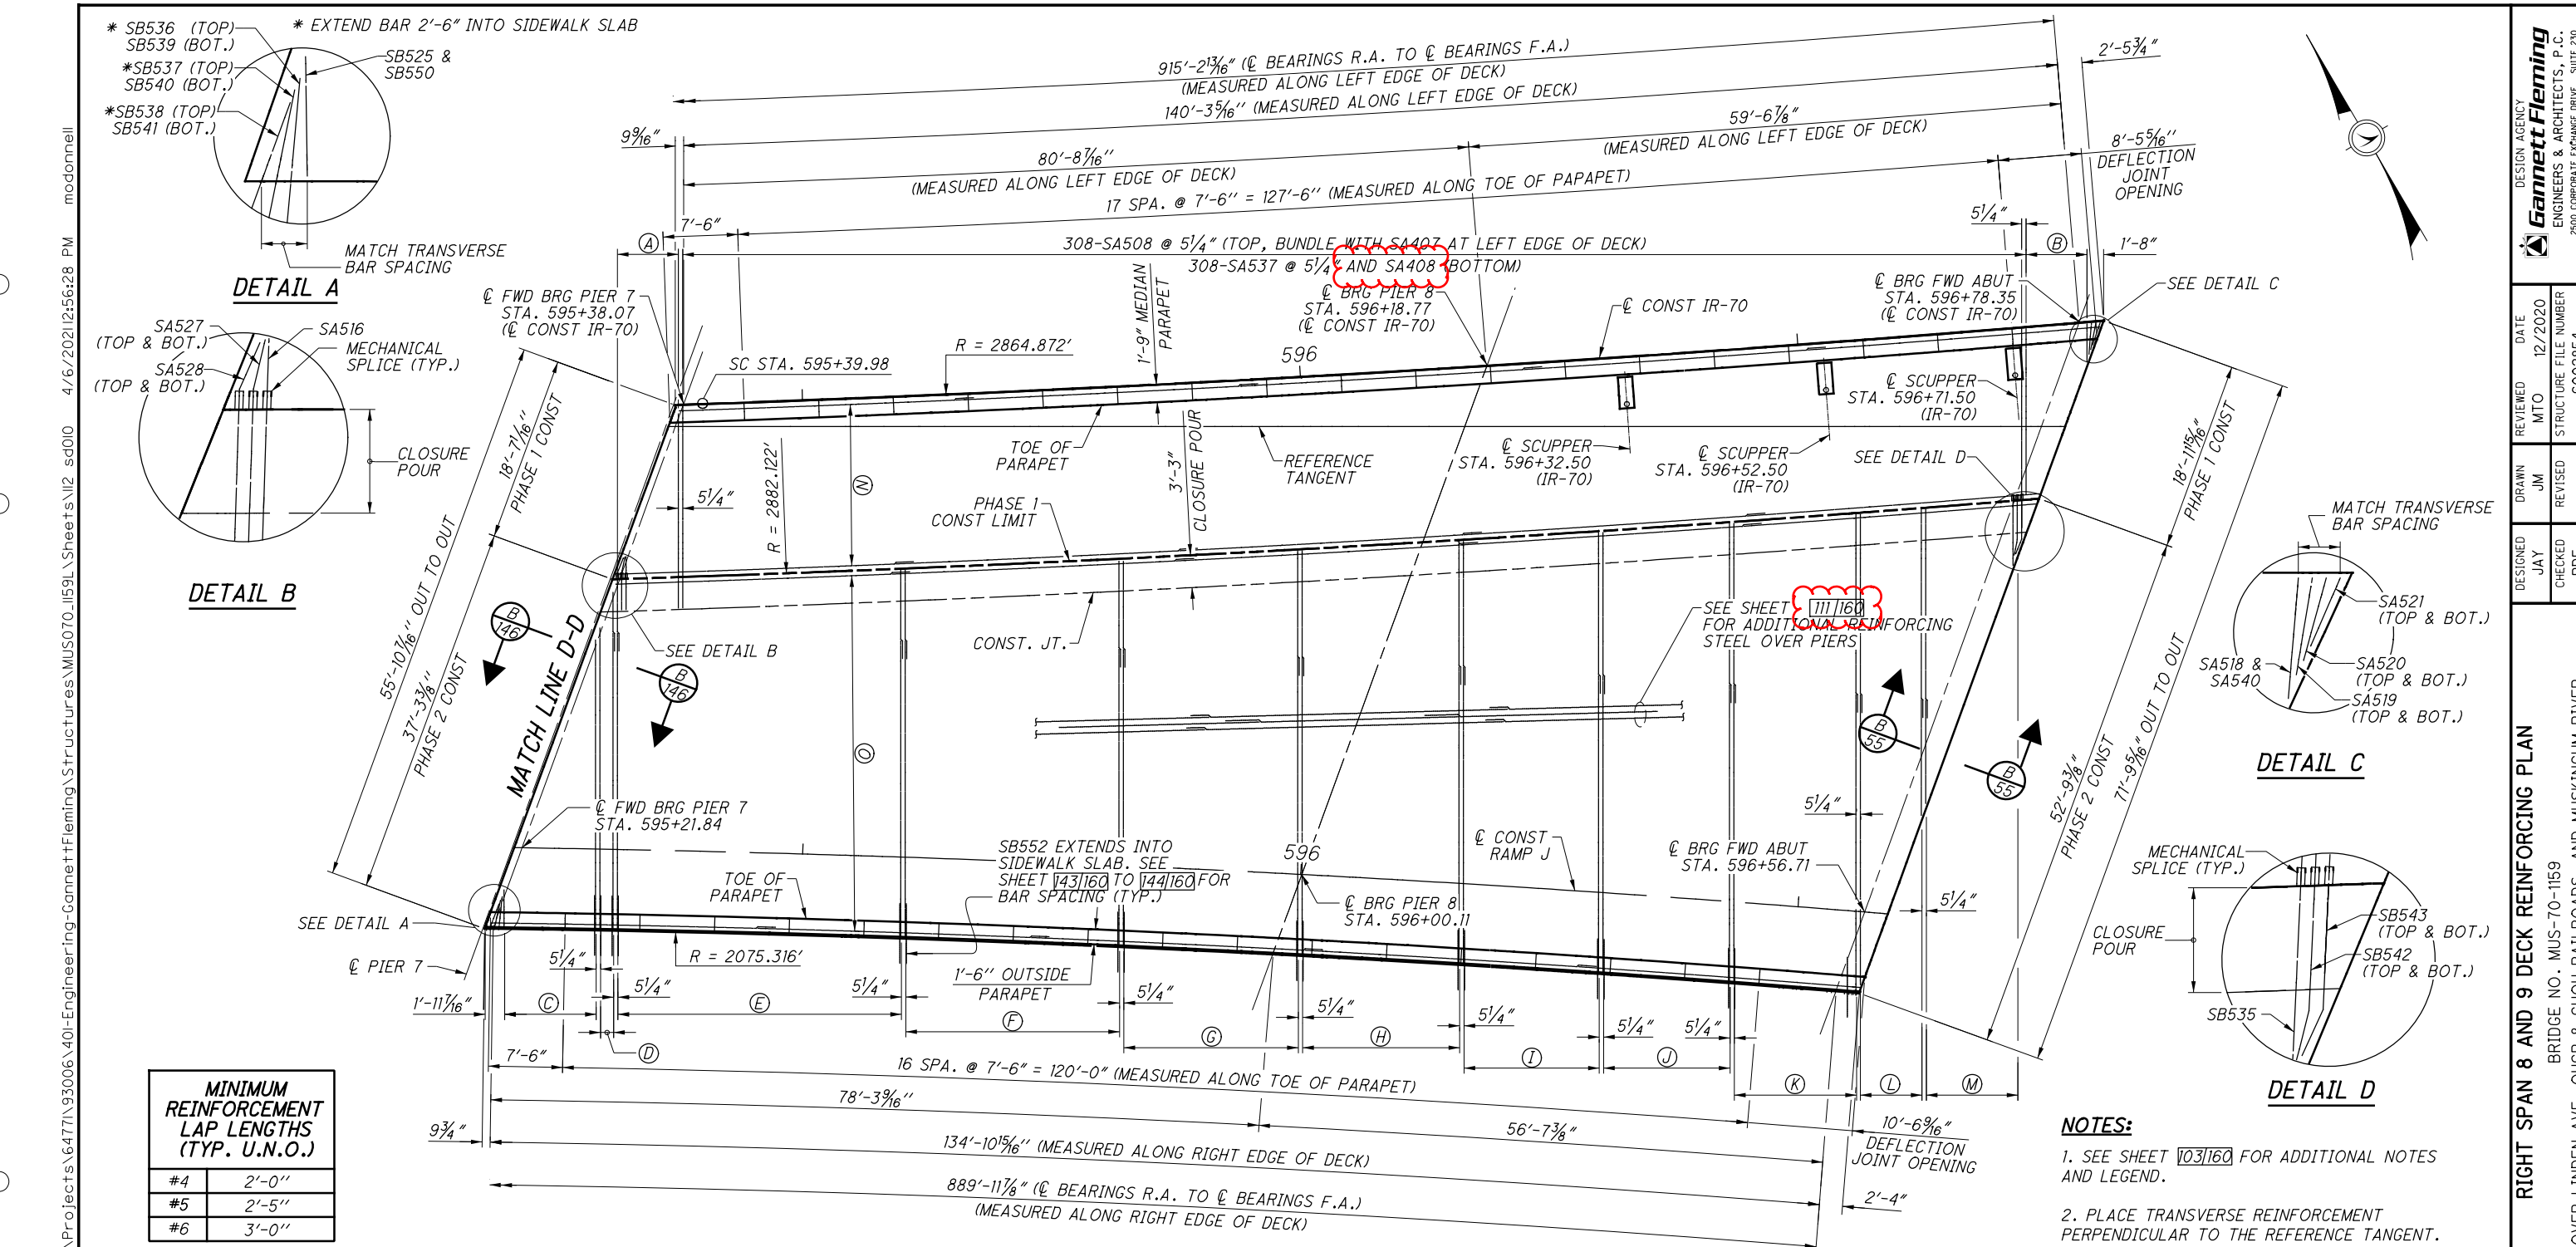


MINIMUM LAP LENGTHS (TYP. U.N.O.)	
#4	2'-0"
#5	2'-5"
#6	3'-0"

DECK REINFORCNG PLAN
RIGHT SPAN 8 AND 9

- NOTES:**
- SEE SHEET 103160 FOR ADDITIONAL NOTES AND LEGEND.
 - PLACE TRANSVERSE REINFORCEMENT PERPENDICULAR TO THE REFERENCE TANGENT.
 - MECHANICAL SPLICES ARE REQUIRED FOR THE TRANSVERSE BARS BETWEEN PHASE 1 AND PHASE 2 CONSTRUCTION.


- (A) = 1 S.O. 13-SA516 @ 5/4" (TOP AND BOTTOM)
- (B) = 1 S.O. 15-SA518 @ 5/4" (TOP BUNDLE WITH SA407 AT LEFT EDGE OF DECK) 1 S.O. 15-SA540 @ 5/4" AND SA408 (BOTTOM)
- (C) = 1 S.O. 22-SB525 @ 5/4" (TOP BUNDLE WITH SB406 AT RIGHT EDGE OF DECK) 1 S.O. 22-SB550 @ 5/4" AND SB407 (BOTTOM)
- (D) = 4-SB507 AND 1 S.O. 4-SB526 @ 5/4" (TOP BUNDLE SB507 WITH SB406 AT RIGHT EDGE OF DECK) 4-SB502 AND 1 S.O. 4-SB526 @ 5/4" AND SB407 (BOTTOM)
- (E) = 66-SB507 AND SB527 @ 5/4" (TOP BUNDLE SB507 WITH SB406 AT RIGHT EDGE OF DECK) 66-SB502 AND SB527 @ 5/4" AND SB407 (BOTTOM)
- (F) = 50-SB507 AND SB528 @ 5/4" (TOP BUNDLE SB507 WITH SB406 AT RIGHT EDGE OF DECK) 50-SB502 AND SB528 @ 5/4" AND SB407 (BOTTOM)
- (G) = 41-SB507 AND SB529 @ 5/4" (TOP BUNDLE SB507 WITH SB406 AT RIGHT EDGE OF DECK) 41-SB502, SB529 @ 5/4" AND SB407 (BOTTOM)
- (H) = 37-SB507 AND SB530 @ 5/4" (TOP BUNDLE SB507 WITH SB406 AT RIGHT EDGE OF DECK) 37-SB502, SB530 @ 5/4" AND SB407 (BOTTOM)
- (I) = 32-SB507 AND SB531 @ 5/4" (TOP BUNDLE SB507 WITH SB406 AT RIGHT EDGE OF DECK) 32-SB502, SB531 @ 5/4" AND SB407 (BOTTOM)
- (J) = 30-SB507 AND SB532 @ 5/4" (TOP BUNDLE SB507 WITH SB406 AT RIGHT EDGE OF DECK) 30-SB502, SB532 @ 5/4" AND SB407 (BOTTOM)
- (K) = 29-SB507 AND SB533 @ 5/4" (TOP BUNDLE SB507 WITH SB406 AT RIGHT EDGE OF DECK) 29-SB502, SB533 @ 5/4" AND SB407 (BOTTOM)
- (L) = 15-SB502 AND 1 S.O. 15-SB534 @ 5/4" (TOP AND BOTTOM)
- (M) = 1 S.O. 21-SB535 @ 5/4" (TOP AND BOTTOM)
- (N) = 23-SA402 (5 LENGTHS) LAPPED WITH 23-SA404 (TOP, SPACED AS SHOWN ON TRANSVERSE SECTION) (FAN BARS AS NECESSARY) 24-SA502 (5 LENGTHS) LAPPED WITH 24-SA504 (BOTTOM, SPACED AS SHOWN ON TRANSVERSE SECTION) (FAN BARS AS NECESSARY)
- (O) = 60-SB402 (6 LENGTHS) LAPPED WITH 60-SB404 (TOP, SPACED AS SHOWN ON TRANSVERSE SECTION) (FAN BARS AS NECESSARY) 61-SB503 (5 LENGTHS) LAPPED WITH 1 S.O. 61-SB505 (BOTTOM, SPACED AS SHOWN ON TRANSVERSE SECTION) (FAN BARS AS NECESSARY)

SPAN NO.	LOCATION	HORIZONTAL OFFSETS TO EDGE OF DECK							
		LEFT BRIDGE				RIGHT BRIDGE			
		LEFT OVERHANG		RIGHT OVERHANG		LEFT OVERHANG		RIGHT OVERHANG	
	STATION	OFFSET	STATION	OFFSET	STATION	OFFSET	STATION	OFFSET	
SPAN 1	R.A.	587+65.65	3.54	587+63.08	3.22	587+63.08	2.87	587+60.29	2.79
	1/4 L	587+81.50	3.06	587+79.41	2.87	587+79.41	3.21	587+77.12	2.27
	1/2 L	587+97.38	2.77	587+95.74	2.62	587+95.74	3.47	587+93.92	1.94
	3/4 L	588+13.30	2.67	588+12.07	2.45	588+12.07	3.63	588+10.69	1.80
SPAN 2	PIER 1	588+29.26	2.76	588+28.40	2.38	588+28.40	3.70	588+27.44	1.85
	1/4 L	588+50.84	3.04	588+47.76	2.43	588+45.44	3.67	588+39.21	2.00
	1/2 L	588+72.57	2.95	588+67.12	2.59	588+62.46	3.55	588+50.71	2.24
	3/4 L	588+94.55	3.21	588+86.47	2.86	588+79.43	3.33	588+62.21	2.57
SPAN 3	P2 (REAR)	589+16.93	3.84	588+96.38	3.05	588+96.32	3.04	588+71.99	2.92
	P2 (FWD)	589+18.62	2.79	588+98.13	3.11	588+98.07	2.88	588+73.85	2.87
	1/6 L	589+36.88	2.71	589+16.86	2.89	589+16.79	3.04	588+93.68	2.19
	1/3 L	589+55.20	2.75	589+35.55	2.76	589+35.49	3.11	589+13.35	1.78
SPAN 4	1/2 L	589+73.54	2.78	589+54.21	2.71	589+54.15	3.10	589+32.87	1.64
	2/3 L	589+91.90	2.82	589+72.85	2.73	589+72.78	3.02	589+52.24	1.76
	5/6 L	590+10.28	2.85	589+91.45	2.82	589+91.39	2.88	589+71.48	2.13
	PIER 3	590+28.69	2.88	590+10.04	2.95	590+09.98	2.73	589+90.60	2.76
SPAN 5	1/6 L	590+51.61	2.86	590+33.15	2.85	590+33.08	2.89	590+14.20	1.98
	1/3 L	590+74.57	2.84	590+56.22	2.81	590+56.16	3.00	590+37.62	1.61
	1/2 L	590+97.55	2.83	590+79.29	2.81	590+79.23	3.06	590+60.87	1.62
	2/3 L	591+20.57	2.81	591+02.34	2.92	591+02.28	3.09	590+83.99	1.87
SPAN 6	5/6 L	591+43.61	2.79	591+25.38	2.89	591+25.32	3.10	591+07.08	2.13
	PIER 4	591+66.66	2.76	591+48.43	3.03	591+48.37	3.19	591+30.14	2.39
	1/6 L	591+89.68	2.67	591+71.45	2.91	591+71.39	3.11	591+53.16	2.38
	1/3 L	592+12.70	2.58	591+94.48	2.88	591+94.41	3.12	591+76.19	2.36
SPAN 7	1/2 L	592+35.73	2.48	592+17.50	2.85	592+17.44	3.12	591+99.21	2.35
	2/3 L	592+58.75	2.39	592+40.52	2.82	592+40.46	3.13	592+22.23	2.34
	5/6 L	592+81.77	2.30	592+63.54	2.79	592+63.48	3.13	592+45.25	2.33
	PIER 5	593+04.13	2.21	592+86.57	2.75	592+86.51	3.13	592+68.28	2.31
SPAN 8	1/6 L	593+27.86	2.28	593+09.63	2.77	593+09.57	3.12	592+91.35	2.37
	1/3 L	593+50.93	2.35	593+32.70	2.80	593+32.64	3.11	593+14.41	2.44
	1/2 L	593+74.05	2.43	593+55.77	2.82	593+55.71	3.10	593+37.48	2.51
	2/3 L	593+97.21	2.50	593+78.84	2.83	593+78.78	3.11	593+60.59	2.58
SPAN 9	5/6 L	594+20.42	2.57	594+01.93	2.80	594+01.87	3.15	593+83.53	2.65
	PIER 6	594+43.72	2.77	594+25.04	2.72	594+24.98	3.25	594+06.49	2.72
	1/6 L	594+62.43	2.44	594+43.52	2.88	594+43.45	3.03	594+24.79	2.71
	1/3 L	594+81.24	2.24	594+62.02	3.04	594+61.95	2.86	594+43.07	2.68
SPAN 10	1/2 L	595+00.15	2.20	594+80.55	3.13	594+80.48	2.76	594+61.31	2.66
	2/3 L	595+17.71	2.34	594+99.11	3.13	594+99.04	2.75	594+79.52	2.63
	5/6 L	595+38.29	2.65	595+17.71	3.03	595+17.64	2.83	594+97.69	2.62
	P7 (REAR)	595+57.49	3.13	595+36.35	2.83	595+36.28	3.02	595+15.78	2.76
SPAN 11	P7 (FWD)	595+59.30	3.08	595+38.10	2.27	595+38.03	3.57	595+17.47	3.10
	1/4 L	595+80.05	2.54	595+58.19	2.69	595+58.12	3.15	595+36.78	2.61
	1/2 L	596+00.89	2.21	595+78.33	2.97	595+78.26	2.86	595+55.98	2.32
	3/4 L	596+21.82	2.07	595+98.54	3.11	595+98.47	2.72	595+75.10	2.20
SPAN 12	PIER 8	596+42.86	2.13	596+18.81	3.11	596+18.74	2.73	595+94.11	2.27
	1/4 L	596+58.29	2.30	596+33.65	3.01	596+33.58	2.82	596+07.94	2.44
	1/2 L	596+73.78	2.59	596+48.53	2.84	596+48.45	2.99	596+21.71	2.70
	3/4 L	596+89.33	2.98	596+63.44	2.59	596+63.36	3.24	596+35.42	3.06
SPAN 13	F.A.	597+04.93	3.49	596+78.38	2.26	596+78.31	3.57	596+49.08	3.52

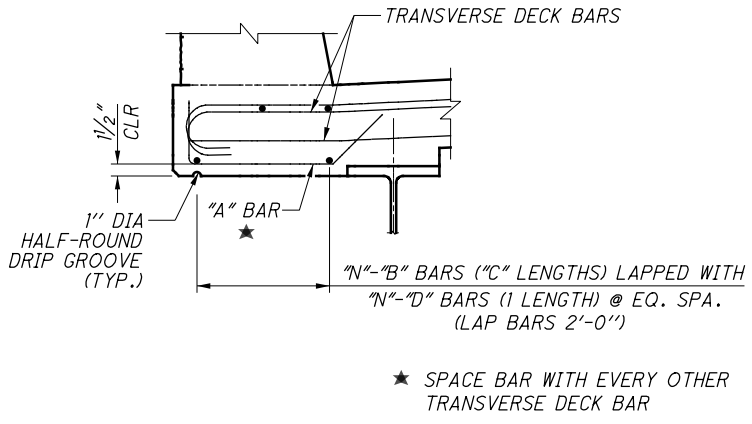

DECK OVERHANG DETAIL

DECK OVERHANG REINFORCING STEEL					
SPANS	REINFORCING BAR	LEFT BRIDGE		RIGHT BRIDGE	
		LEFT OVERHANG	RIGHT OVERHANG	LEFT OVERHANG	RIGHT OVERHANG
SPANS 1 AND 2	"N"	4	4	5	3
	"A" BAR	SC407	SA408	SA408	SB407
	"B" BAR	SC501	SA501	SA501	SB501
	"C" BAR	5	5	5	5
SPANS 3 THRU 7	"D" BAR	SC506	SA505	SA506	SB506
	"N"	4	4	4	3
	"A" BAR	SC407	SA408	SA408	SB407
	"B" BAR	SC502	SA502	SB502	SB502
SPANS 8 ANFD 9	"C" BAR	23	23	23	23
	"D" BAR	SC504	SA503	SA503	SB504
	"N"	4	4	5	4
	"A" BAR	SC407	SA408	SA408	SB407
SPANS 8 ANFD 9	"B" BAR	SC505	SA502	SA502	SB505
	"C" BAR	5	5	5	5
	"D" BAR	SC505	SA504	SA504	SB505

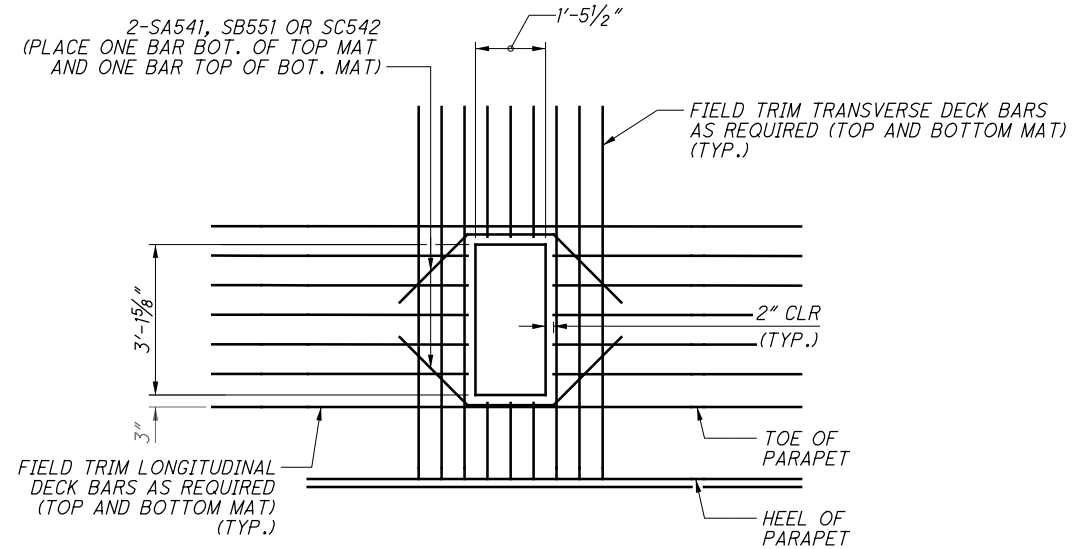

SCUPPER REINFORCING DETAIL

NOTES:

- OFFSETS ARE MEASURED NORMAL TO THE FASCIA BEAMS/GIRDERS. DIMENSIONS ARE IN FEET.
- SEE SHEETS 115/160, 120/160, 125/160 AND 130/160 FOR LAYOUT OF SCREED CONTROL POINTS.

SUBMITTAL: Stage 3
 PLOT DRIVER: 000Tcodd_PDF.pltcfgr
 PENTABLE: 93006_000T181_Pen.tbl
 pw:\gtnet-pw-0\Documents\Projects\6477\93006\401-Engineering-GannettFleming\Structures\MUS070-1159L\Sheets\52_s1001_4/7/2021\10:03 AM modonnell

Mark	NUMBER	LENGTH	WEIGHT	TYPE	DIMENSIONS				
	TOTAL		TOTAL		A	B	C	D	INC
PHASE 1 DECK SLAB									
SA401	200	26'-0"	3,474	STR.					
SA402	1,587	29'-0"	30,744	STR.					
SA403	60	18'-6"	742	STR.					
SA404	45	8'-5"	254	STR.					
	1	16'-1"							
SA405	SER OF	to	249	STR.					4 1/2"
	19	23'-0"							
	1	10'-8"							
SA406	SER OF	to	199	STR.					4"
	21	17'-8"							
SA407	3,264	8'-9"	19,079	16	8'-3"				
SA408	1916	2'-10"	3627	10	6"	6"	1'-7"	7"	
SA409	3	24'-6"	82	STR.					
SA410	4	29'-0"	78	STR.					
SA411	4	27'-3"	73	STR.					
SA412	3	24'-9"	50	STR.					
SA413	2	24'-9"	34	STR.					
SA414	1	28'-8"	20	STR.					
SA501	230	26'-0"	6,238	STR.					
SA502	1,324	30'-0"	41,428	STR.					
SA503	48	5'-8"	284	STR.					
SA504	47	5'-6"	270	STR.					
	1	18'-2"							
SA505	SER OF	to	497	STR.					3 3/4"
	22	25'-1"							
	1	13'-7"							
SA506	SER OF	to	428	STR.					3 1/2"
	24	20'-7"							
SA507	272	20'-9"	5,887	16	20'-2"				
SA508	859	17'-7"	15,754	16	17'-0"				
	2	6'-2"							
SA509	SER OF	to	289	STR.					1'-3 1/4"
	11	19'-0"							
	1	4'-7"			4'-0"				
SA510	SER OF	to	179	16	to				1'-2"
	14	19'-11"			19'-4"				
	1	4'-8"							
SA511	SER OF	to	149	STR.					1'-3 1/2"
	12	19'-1"							
	1	4'-11"							
SA512	SER OF	to	143	STR.					1'-2"
	12	17'-11"							
	1	5'-8"							
SA513	SER OF	to	140	STR.					1'-3 1/2"
	11	18'-7"							
	1	3'-9"							
SA514	SER OF	to	156	STR.					1'-3 1/2"
	13	19'-3"							
	1	5'-0"			4'-5"				
SA515	SER OF	to	113	16	to				1'-3 1/2"
	10	16'-8"			16'-1"				
	2	2'-3"							
SA516	SER OF	to	254	STR.					1'-2"
	13	16'-5"							

NOTES:

- ALL REINFORCING BARS SHALL BE EPOXY COATED. PAYMENT FOR REINFORCING, INCLUDING MECHANICAL CONNECTORS, SHALL BE MADE WITH ITEM 509 - EPOXY COATED REINFORCING STEEL.
- "STR." IN THE TYPE COLUMN INDICATES STRAIGHT BARS.
- "SER OF" DENOTES SERIES OF BARS, E.G. "X" SER OF "Y" = "X" SERIES OF "Y" BARS/SERIES.
- REFER TO CMS SECTION 509.05 FOR STANDARD BEND DIMENSIONS.
- FOR BENDING DIAGRAMS, SEE SHEET 1531160.
- MECHANICAL CONNECTORS: AN APPROVED TYPE OF MECHANICAL CONNECTOR FOR REINFORCING BARS SHALL BE PROVIDED IN ACCORDANCE WITH CMS SECTION 509.07. INSTALLATION OF CONNECTORS SHALL CONFORM WITH MANUFACTURER RECOMMENDED PROCEDURES.

MARK	NUMBER	LENGTH	WEIGHT	TYPE	DIMENSIONS				
	TOTAL		TOTAL		A	B	C	D	INC
PHASE 1 DECK SLAB CONTINUED									
	2	3'-3"							
* SA517	SER OF	to	221	STR.					1'-3 1/4"
	11	16'-0"							
	1	4'-4"			3'-9"				
SA518	SER OF	to	196	16	to				1'-2"
	15	20'-8"			20'-1"				
SA519	8	3'-1"	26	STR.					
SA520	8	2'-8"	23	STR.					
SA521	8	2'-4"	20	STR.					
SA522	2	5'-1"	11	19	3'-3"	1'-9"	3"		
SA523	2	4'-11"	11	19	3'-3"	1'-7 1/2"	4 1/2"		
SA524	2	5'-0"	11	19	3'-3"	1'-7 1/2"	8"		
SA525	1	4'-11"	6	19	3'-3"	1'-7 1/2"	4 1/2"		
SA526	1	5'-0"	6	19	3'-3"	1'-7 1/2"	8"		
* SA527	5	2'-5"	13	19	8"	1'-8"	4 1/2"		
* SA528	5	2'-5"	13	19	8"	1'-7 1/2"	8"		
SA529	567	8'-4"	4,929	16	7'-9"				
SA530	5	24'-9"	130	STR.					
SA531	4	29'-3"	123	STR.					
SA532	4	27'-6"	115	STR.					
SA533	3	25'-0"	79	STR.					
SA534	2	25'-0"	53	STR.					
SA535	1	28'-8"	30	STR.					
SA536	1,590	20'-0"	33,168	STR.					
* SA537	2,177	17'-0"	38,601	STR.					
	1	4'-5"							
SA538	SER OF	to	107	STR.					1'-3 1/2"
	10	16'-1"							
	1	4'-0"							
SA539	SER OF	to	171	STR.					1'-2"
	14	19'-4"							
	1	3'-9"							
SA540	SER OF	to	187	STR.					1'-2"
	15	20'-1"							
SA541	68	5'-10"	414	13	2'-0"	1'-4"	1'-4"	2'-0"	
SA601	1,318	20'-10"	41,243	16	20'-2"				
SA602	963	22'-5"	32,424	STR.					
	1	4'-8"							
SA603	SER OF	to	215	STR.					1'-3 1/2"
	12	19'-1"							
	1	4'-11"							
SA604	SER OF	to	206	STR.					1'-2"
	12	17'-11"							
	1	5'-8"							
SA605	SER OF	to	201	STR.					1'-3 1/2"
	11	18'-7"							
	1	3'-9"							
SA606	SER OF	to	225	STR.					1'-3 1/2"
	13	19'-3"							
SA607	2	3'-1"	10	STR.					
SA608	2	2'-8"	9	STR.					
SA609	2	2'-4"	8	STR.					
SA610	1	5'-7"	9	19	3'-10"	1'-8"	4 1/2"		
SA611	1	5'-7"	9	19	3'-10"	1'-7 1/2"	8"		
* SA612	1	2'-5"	4	19	8"	1'-8"	4 1/2"		
* SA613	1	2'-5"	4	19	8"	1'-7 1/2"	8"		
* SA614	1,318	17'-8"	34,974	16	17'-0"				
SUB-TOTAL			319,118						

MINIMUM LAP SPLICE LENGTH

- #4 BAR (DECK) = 2'-0"
- #5 BAR (PIERS) = 2'-5"
- #5 BAR (DECK) = 2'-5"
- #5 BAR (ABUTMENTS) = 3'-1"
- #6 BAR (DECK) = 3'-0"
- #6 BAR (DECK OVER PIERS) = 3'-7"
- #6 BAR (ALL OTHERS) = 4'-0"
- #8 BAR (ALL) = 5'-4"
- #9 BAR (ALL) = 6'-7"
- #10 BAR (PIERS) = 6'-3"

* = BAR WITH MECHANICAL CONNECTOR

DESIGN AGENCY
Gannett Fleming
ENGINEERS & ARCHITECTS, P.C.
2600 CORPORATE EXCHANGE DRIVE, SUITE 230
COLUMBUS, OHIO 43231

DATE
12/2020

REVIEWED
MTO

DRAWN
JAY

DESIGNED
JAY

STRUCTURE FILE NUMBER
6002854

CHECKED
RDF

REVISED

BRIDGE NO. MUS-70-1159

OVER LINDEN AVE, OHCR & CUOH RAILROADS, AND MUSKINGUM RIVER

MUS-70-10.49

PID No. 93006

152/160

1598
2231

Mark	NUMBER		LENGTH	WEIGHT	TYPE	DIMENSIONS				
	TOTAL					TOTAL	A	B	C	D
PHASE 3 DECK SLAB										
SC401	265		28'-0"	4,957	STR.					
SC402	1,483		29'-0"	28,729	STR.					
SC403	56		18'-6"	693	STR.					
SC404	39		11'-2"	291	STR.					
SC405	SER OF	1	13'-0"	723	STR.					3 1/4"
		53	27'-10"							
SC406	1,331		8'-9"	7,780	16	8'-3"				
SC407	911		2'-6"	1,622	10	6"	6"	1'-3"	7"	
SC501	308		29'-0"	9,075	STR.					
SC502	2,940		30'-0"	91,993	STR.					
SC503	260		27'-0"	7,322	STR.					
SC504	46		5'-1"	244	STR.					
SC505	52		23'-3"	1,261	STR.					
SC506	SER OF	1	10'-1"							3"
		60	24'-11"	1,096	STR.					
SC507	569		30'-0"	17,805	16	29'-5"				
SC508	42		26'-0"	1,139	STR.					
SC509	42		24'-0"	1,052	STR.					
SC510	48		22'-0"	1,102	STR.					
SC511	52		20'-0"	1,085	STR.					
SC512	56		17'-11"	1,047	STR.					
SC513	64		15'-11"	1,063	STR.					
SC514	74		13'-10"	1,068	STR.					
SC515	90		11'-9"	1,103	STR.					
SC516	104		9'-9"	1,058	STR.					
SC517	8		6'-9"	57	STR.					
SC518	SER OF	1	4'-1"			3'-6"				
		21	29'-5"	367	16	to				1'-3"
		1	5'-10"			28'-10"				
SC519	SER OF	19	29'-6"	351	STR.					1'-3 3/4"
		3	5'-10"							
SC520	3		5'-10"	19	STR.					
SC521	1,307		7'-0"	9,543	STR.					
SC522	SER OF	1	2'-11"							1'-3 1/2"
		3	5'-6"	14	STR.					
		1	3'-6"							
SC523	SER OF	21	29'-2"	358	STR.					1'-3 1/4"
		2	6'-9"							
SC524	SER OF	19	30'-0"	729	STR.					1'-3 1/2"
		4	5'-1"	22	STR.					
SC525	308		9'-2"	2,945	STR.					
SC526	236		11'-4"	2,790	STR.					
SC527	SER OF	2	3'-3"							1'-3"
		7	10'-10"	103	STR.					
SC528	SER OF	1	4'-9"			4'-2"				
		21	29'-9"	378	16	to				1'-3"
		21	29'-9"			29'-2"				


Mark	NUMBER		LENGTH	WEIGHT	TYPE	DIMENSIONS				
	TOTAL					TOTAL	A	B	C	D
PHASE 3 DECK SLAB										
SC530	5		3'-1"	17	STR.					
SC531	5		2'-8"	14	STR.					
SC532	5		2'-4"	13	STR.					
SC533	1		5'-7"	6	19	3'-10"	1'-8"	4 1/2"		
SC534	1		5'-7"	6	19	3'-10"	1'-7 1/2"	8"		
SC535	2		5'-8"	12	19	3'-11"	1'-8"	4 1/2"		
SC536	2		5'-8"	12	19	3'-11"	1'-7 1/2"	8"		
SC537	2		5'-6"	12	19	2'-10"	2'-6"	9"		
SC538	2		5'-8"	12	19	3'-6"	2'-0 1/2"	9"		
SC539	SER OF	1	3'-6"							1'-3"
		21	28'-10"	355	STR.					
		1	4'-2"							
SC541	SER OF	21	29'-2"	366	STR.					1'-3"
SC542	88		5'-10"	536	13	2'-0"	1'-4"	1'-4"	2'-0"	
SC601	1,310		30'-0"	59,029	16	29'-4"				
SC602	930		22'-5"	31,313	STR.					
		1	5'-10"							
SC603	SER OF	19	29'-6"	505	STR.					1'-3 3/4"
SC604	3		5'-10"	27	STR.					
SC605	1,307		8'-2"	16,033	STR.					
		1	4'-10"			4'-2"				
SC606	SER OF	3	7'-5"	28	16	to				1'-3 1/2"
		1	4'-2"			6'-9"				
SC607	SER OF	1	4'-2"			3'-6"				
		21	29'-10"	537	16	to				1'-3 1/4"
		1	29'-10"			29'-2"				
SC608	1		3'-1"	5	STR.					
SC609	1		2'-8"	5	STR.					
SC610	1		2'-4"	4	STR.					
SC611	1		5'-7"	9	19	3'-10"	1'-8"	4 1/2"		
SC612	1		5'-7"	9	19	3'-10"	1'-7 1/2"	8"		
SC613	3		30'-0"	136	STR.					
SUB-TOTAL				315,615						

= BAR WITH MECHANICAL CONNECTOR

NOTES:

- FOR MINIMUM LAP SPLICE LENGTHS AND ADDITIONAL NOTES, SEE SHEET 152/160.
- FOR BENDING DIAGRAMS, SEE SHEET 153/160.


I:\ProjectData\MUS\93006\400-Engineering\Structures\SFN_6002978\Sheets\070_1212C_SS001.dgn Shear Connector Details 4/7/2021 11:34:44 AM cshonk

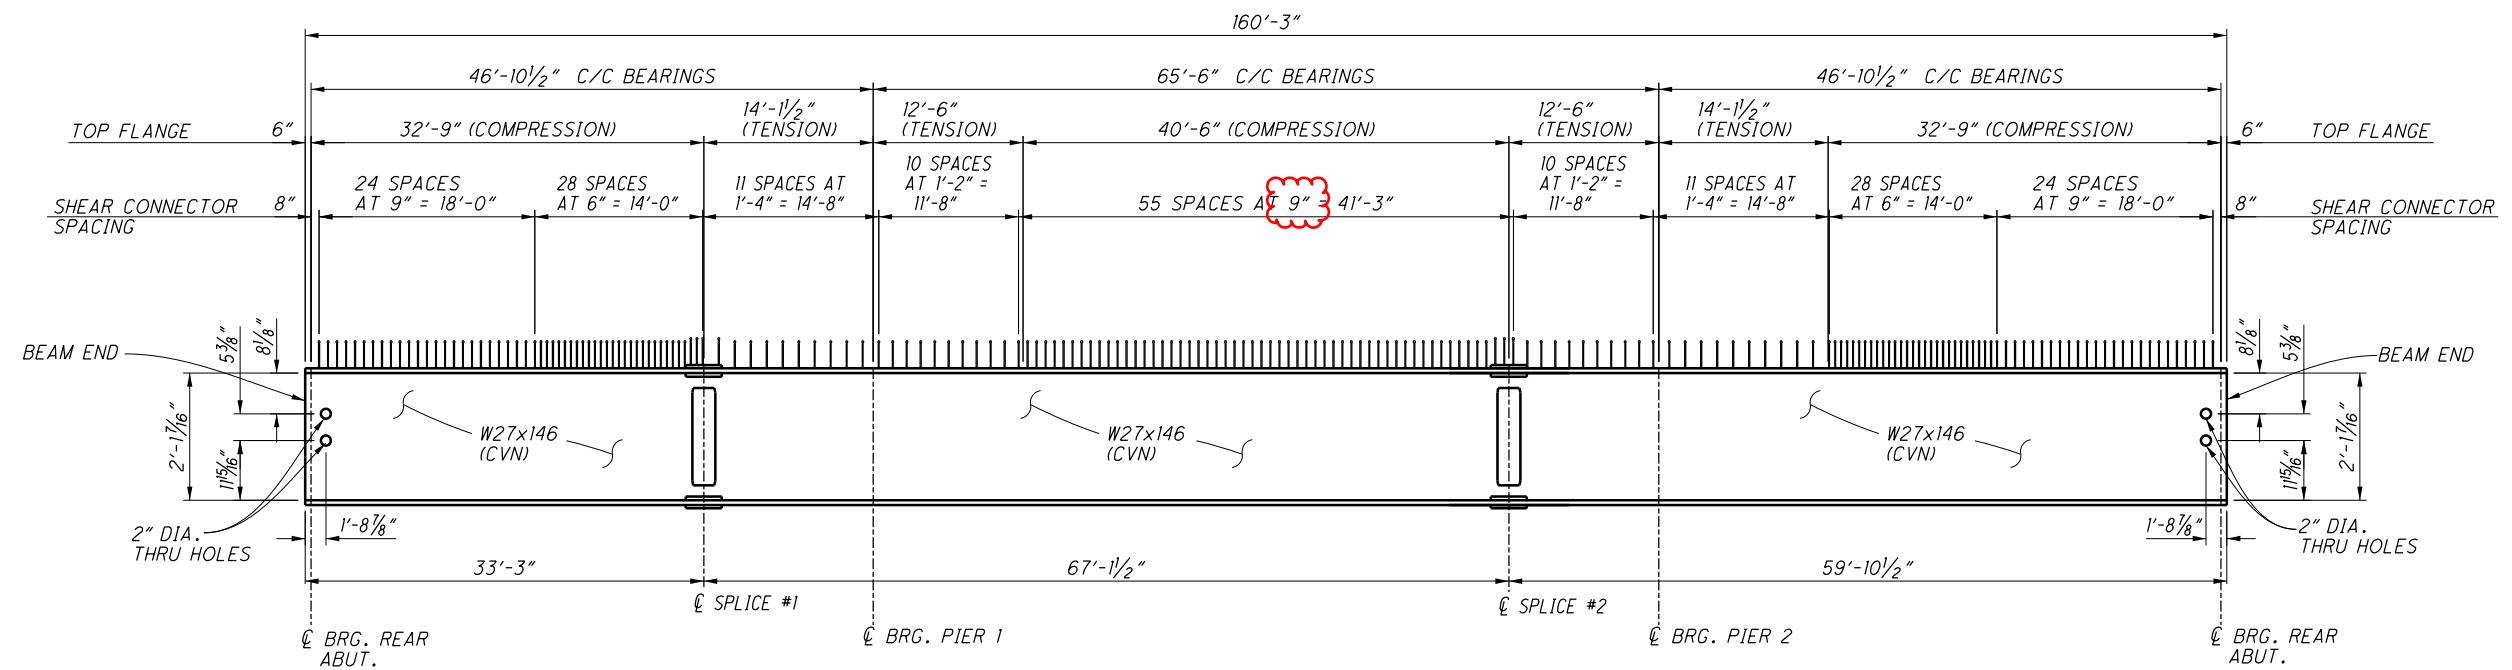

BEAM ELEVATION / SHEAR CONNECTOR SPACING
(NO CAMBER SHOWN & N.T.S.)


NOTES:
WELD ATTACHMENT OF SUPPORTS FOR CONCRETE DECK FINISHING MACHINE TO AREAS OF THE FASCIA STRINGER FLANGES DESIGNATED "COMPRESSION". DO NOT WELD ATTACHMENTS TO AREAS DESIGNATED "TENSION". FILLET WELDS TO COMPRESSION FLANGES SHALL BE AT LEAST 1" FROM EDGE OF FLANGE, BE AT LEAST 2" LONG AND BE AT LEAST 1/4" FOR THICKNESSES UP TO 3/4" OR 5/16" FOR GREATER THAN 3/4" THICK.

ALL SPLICE PLATES EXCEPT FILL PLATES SHALL BE CVN.
FOR INTERMEDIATE DIAPHRAGM LOCATIONS, SEE SHEET 46.
FOR ADDITIONAL DETAILS, SEE STANDARD DRAWING GSD-1-19.

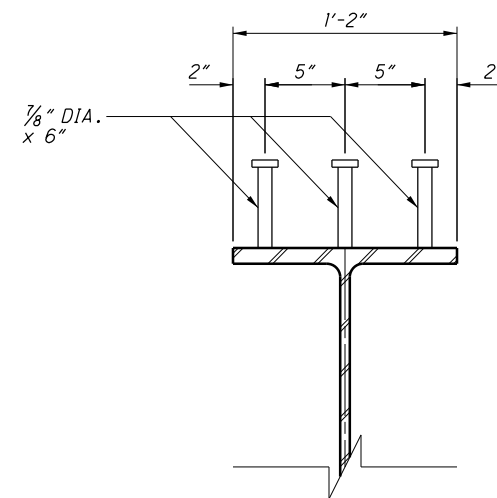


SHEAR CONNECTOR DETAILS
(W27x146)
(N.T.S.)

I:\ProjectData\MUS\93006\400-Engineering\Structures\SFN_6002978\Sheets\070_1212C_SS002.dgn Bolted Splice Details 4/12/2021 10:17:59 AM cshonk

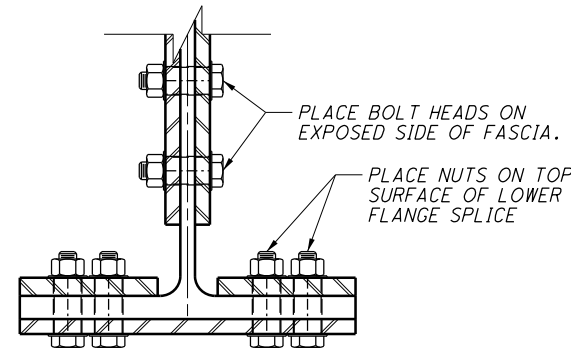


PARTIAL SECTION
(AT C OF SPLICE #1 & #2)
(NOT TO SCALE)

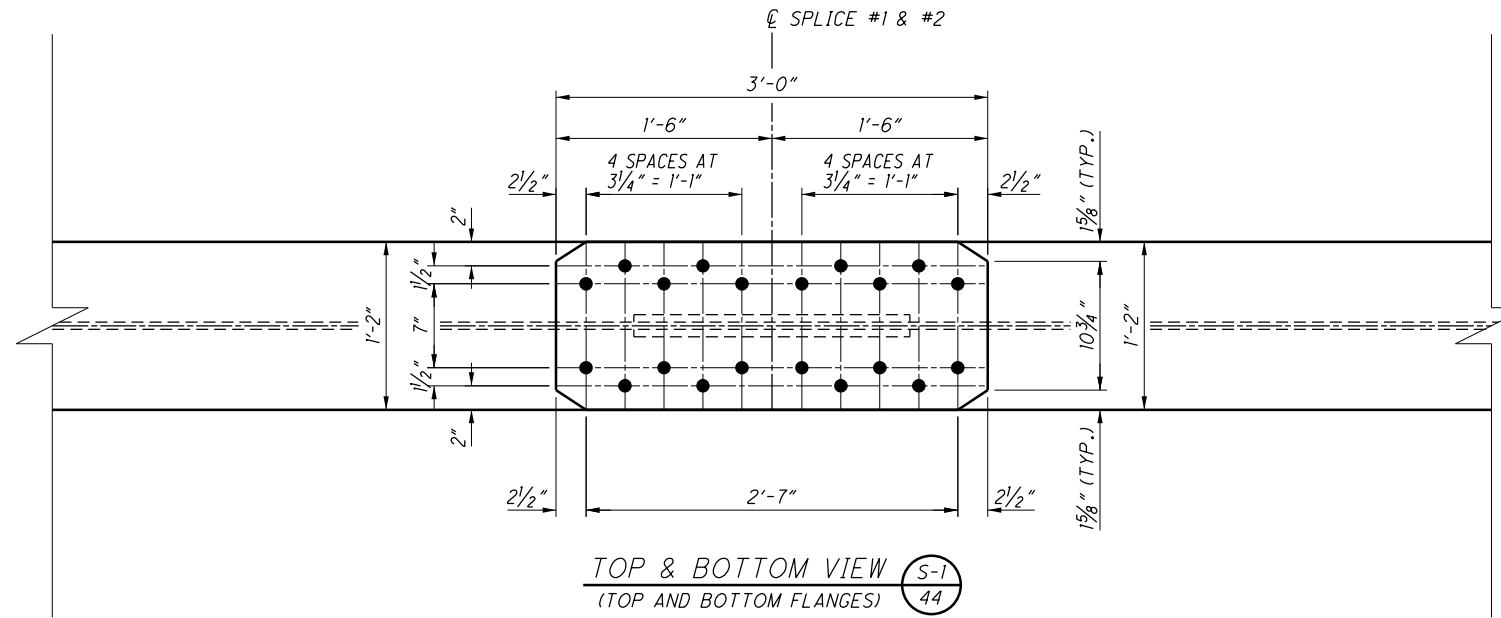


TOP & BOTTOM VIEW (S-1)
(TOP AND BOTTOM FLANGES)

NOTE:
EXCLUDE THE BOLT THREADS FROM THE SHEAR PLANES. (THE BOLT SHEAR STRENGTH FOR THE FLANGE AND WEB SPLICES HAS BEEN DESIGNED ASSUMING THAT THE THREADS ARE EXCLUDED FROM THE SHEAR PLANES.)
ALL BOLTS USED SHALL BE 1/8" DIAMETER.
ALL BOLT HOLES SHALL BE 1 3/16" DIAMETER.
BOLT SPECIFICATIONS SHALL CONFORM TO A325, TYPE 1.

(SEE FRAMING PLAN FOR LOCATION IN SPAN 1 AND 2)
(SPLICE #1 SHOWN, SPLICE #2 MIRRORED)

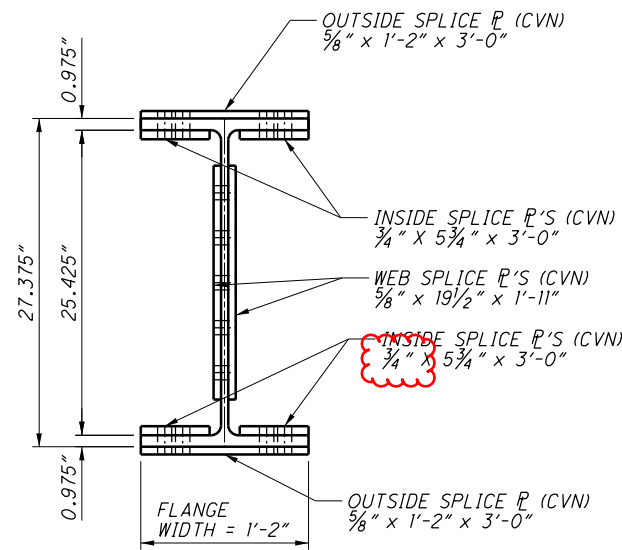

BEAM SECTION (S-2)
(REAR & FWD. OF C SPLICE)
(W 27x146)

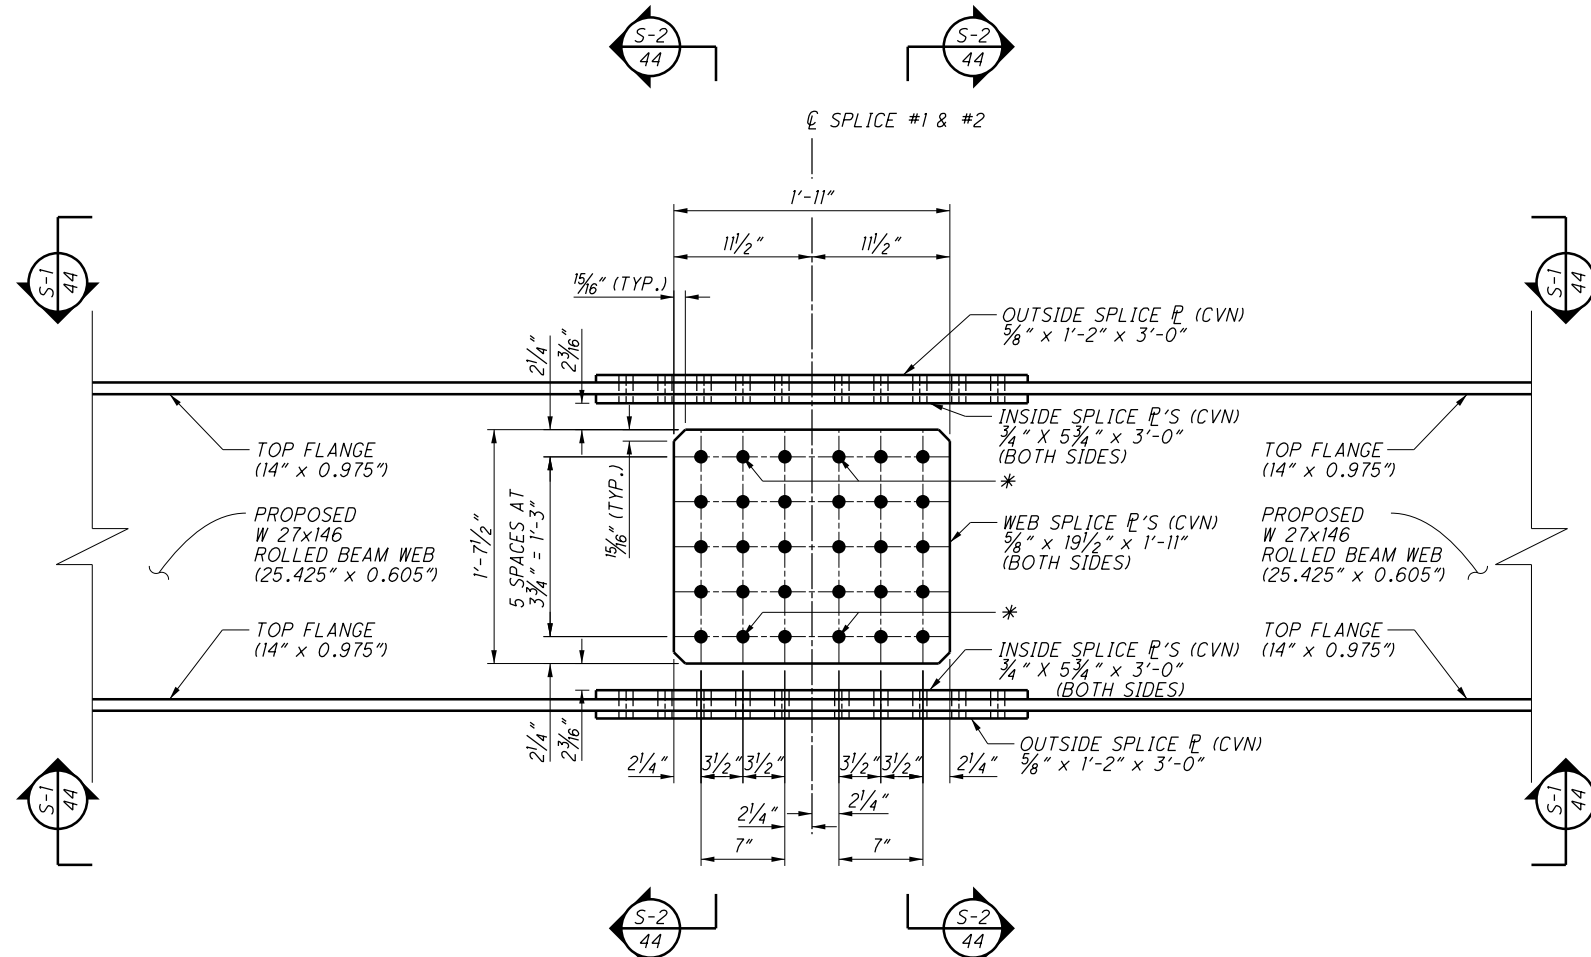

BOLTED SPLICE DETAIL
(SEE FRAMING PLAN FOR LOCATION IN SPAN 1 AND 2)


* - BOLT AND NUT LOCATIONS TO BE PLACED AND TIGHTENED LAST

DESIGNED		CPS	CHECKED	TAG
DRAWN		CPS	REVISED	
REVIEWED	CPS	DATE	12/4/2020	STRUCTURE FILE NUMBER
6002978		6002978		
DESIGN AGENCY				
OHIO DEPARTMENT OF TRANSPORTATION, DISTRICT 5				
MUS-70-10.49				
PID No. 93006				
BRIDGE NO. MUS-70-1212 OVER UNDERWOOD ST.				
BOLTED BEAM SPLICE #1 & #2 DETAILS				
44 / 74				
1876				
2231				

I:\ProjectData\MUS_93006\400-Engineering\Structures\SFN_6001920\Sheets\070_1144P_GS001.dgn_Sheet 4/5/2021 5:24:32 PM Tgreenwa

SHEET NUM.						PART.		ITEM	ITEM EXT	GRAND TOTAL	UNIT	DESCRIPTION	SEE SHEET NO.
	27	28			02/IMS/B R								
STRUCTURE OVER 20 FOOT SPAN (MUS-70-1144A or SFN6001920)													
					LS		202	11203	LS			PORTIONS OF STRUCTURE REMOVED, OVER 20 FOOT SPAN, AS PER PLAN (SUPERSTRUCTURE)	3
					128		202	11301	128	CY		PORTIONS OF STRUCTURE REMOVED, AS PER PLAN (SUBSTRUCTURES)	3
					169		202	22900	169	SY		APPROACH SLAB REMOVED	
					LS		503	21301	LS			UNCLASSIFIED EXCAVATION, AS PER PLAN	45
					65,308		509	10000	65,308	LB		EPOXY COATED REINFORCING STEEL	
					177		511	21520	177	CY		CLASS OC2 CONCRETE, SUPERSTRUCTURE	
					2		511	33501	2	EACH		SEMI-INTEGRAL DIAPHRAGM GUIDE, AS PER PLAN	20
					38		511	34448	38	CY		CLASS OC2 CONCRETE, BRIDGE DECK (PARAPET)	
					122		511	43510	122	CY		CLASS OC1 CONCRETE, ABUTMENT INCLUDING FOOTING	
					496		512	10050	496	SY		SEALING OF CONCRETE SURFACES (NON-EPOXY)	
					77		512	10100	77	SY		SEALING OF CONCRETE SURFACES (EPOXY-URETHANE): PIERS	
	2,172				2,172		513	10200	2,172	LB		STRUCTURAL STEEL MEMBERS, LEVEL UF	
		1,952			1,952		513	20000	1,952	EACH		WELDED STUD SHEAR CONNECTORS	
					6,343		514	00050	6,343	SF		SURFACE PREPARATION OF EXISTING STRUCTURAL STEEL	
					6,343		514	00056	6,343	SF		FIELD PAINTING OF EXISTING STRUCTURAL STEEL, PRIME COAT	
					6,343		514	00060	6,343	SF		FIELD PAINTING STRUCTURAL STEEL, INTERMEDIATE COAT	
					6,343		514	00066	6,343	SF		FIELD PAINTING STRUCTURAL STEEL, FINISH COAT	
					7		514	10000	7	EACH		FINAL INSPECTION REPAIR	
					12		516	13601	12	SF		1" PREFORMED EXPANSION JOINT FILLER, AS PER PLAN	3
					190		516	13901	190	SF		2" PREFORMED EXPANSION JOINT FILLER, AS PER PLAN	3
					90		516	14020	90	FT		SEMI-INTEGRAL ABUTMENT EXPANSION JOINT SEAL	
					66		516	14600	66	FT		STRUCTURAL JOINT OR JOINT SEALER, MISC.:EMSEAL WITH SLEEPER SLAB	45
					66		516	31011	66	FT		2" DEEP JOINT SEALER, AS PER PLAN	4
					8		516	44300	8	EACH		ELASTOMERIC BEARING WITH INTERNAL LAMINATES AND LOAD PLATE (NEOPRENE) (1'-4" x 1'-0" x 3.2729")	25
					4		516	44300	4	EACH		ELASTOMERIC BEARING WITH INTERNAL LAMINATES AND LOAD PLATE (NEOPRENE) (1'-7" x 1'-3" x 3.7226")	25
					4		516	44300	4	EACH		ELASTOMERIC BEARING WITH INTERNAL LAMINATES AND LOAD PLATE (NEOPRENE) (2'-0" x 1'-3" x 3.7226") WITH ANCHOR RODS	25
					LS		516	47001	LS			JACKING AND TEMPORARY SUPPORT OF SUPERSTRUCTURE, AS PER PLAN	4
					3		518	12000	3	EACH		SCUPPERS, INCLUDING SUPPORTS	
					60		518	21200	60	CY		POROUS BACKFILL WITH GEOTEXTILE FABRIC	
					66		518	40000	66	FT		6" PERFORATED CORRUGATED PLASTIC PIPE	
					64		518	40010	64	FT		6" NON-PERFORATED CORRUGATED PLASTIC PIPE, INCLUDING SPECIALS	
					801		SPECIAL	51900100	801	SF		COMPOSITE FIBER WRAP SYSTEM	4
					169		526	25001	169	SY		REINFORCED CONCRETE APPROACH SLABS (T=15"), AS PER PLAN	3
					78		613	41201	78	CY		LOW STRENGTH MORTAR BACKFILL, AS PER PLAN	4


DESIGN AGENCY	OHIO DEPARTMENT OF TRANSPORTATION, DISTRICT 5
DATE	12/1/2020
TAG	6001920
STRUCTURE FILE NUMBER	6001920
REVIEWED	TAG
DRAWN	YEL/TDF
DESIGNED	YEL
CHECKED	CPS
GENERAL SUMMARY	
BRIDGE NO. MUS-70-1144A	
RAMP 'A' OVER-McINTIRE AVE.	
MUS-70-10.49	
PID No. 93006	
5 / 45	
1923	2231

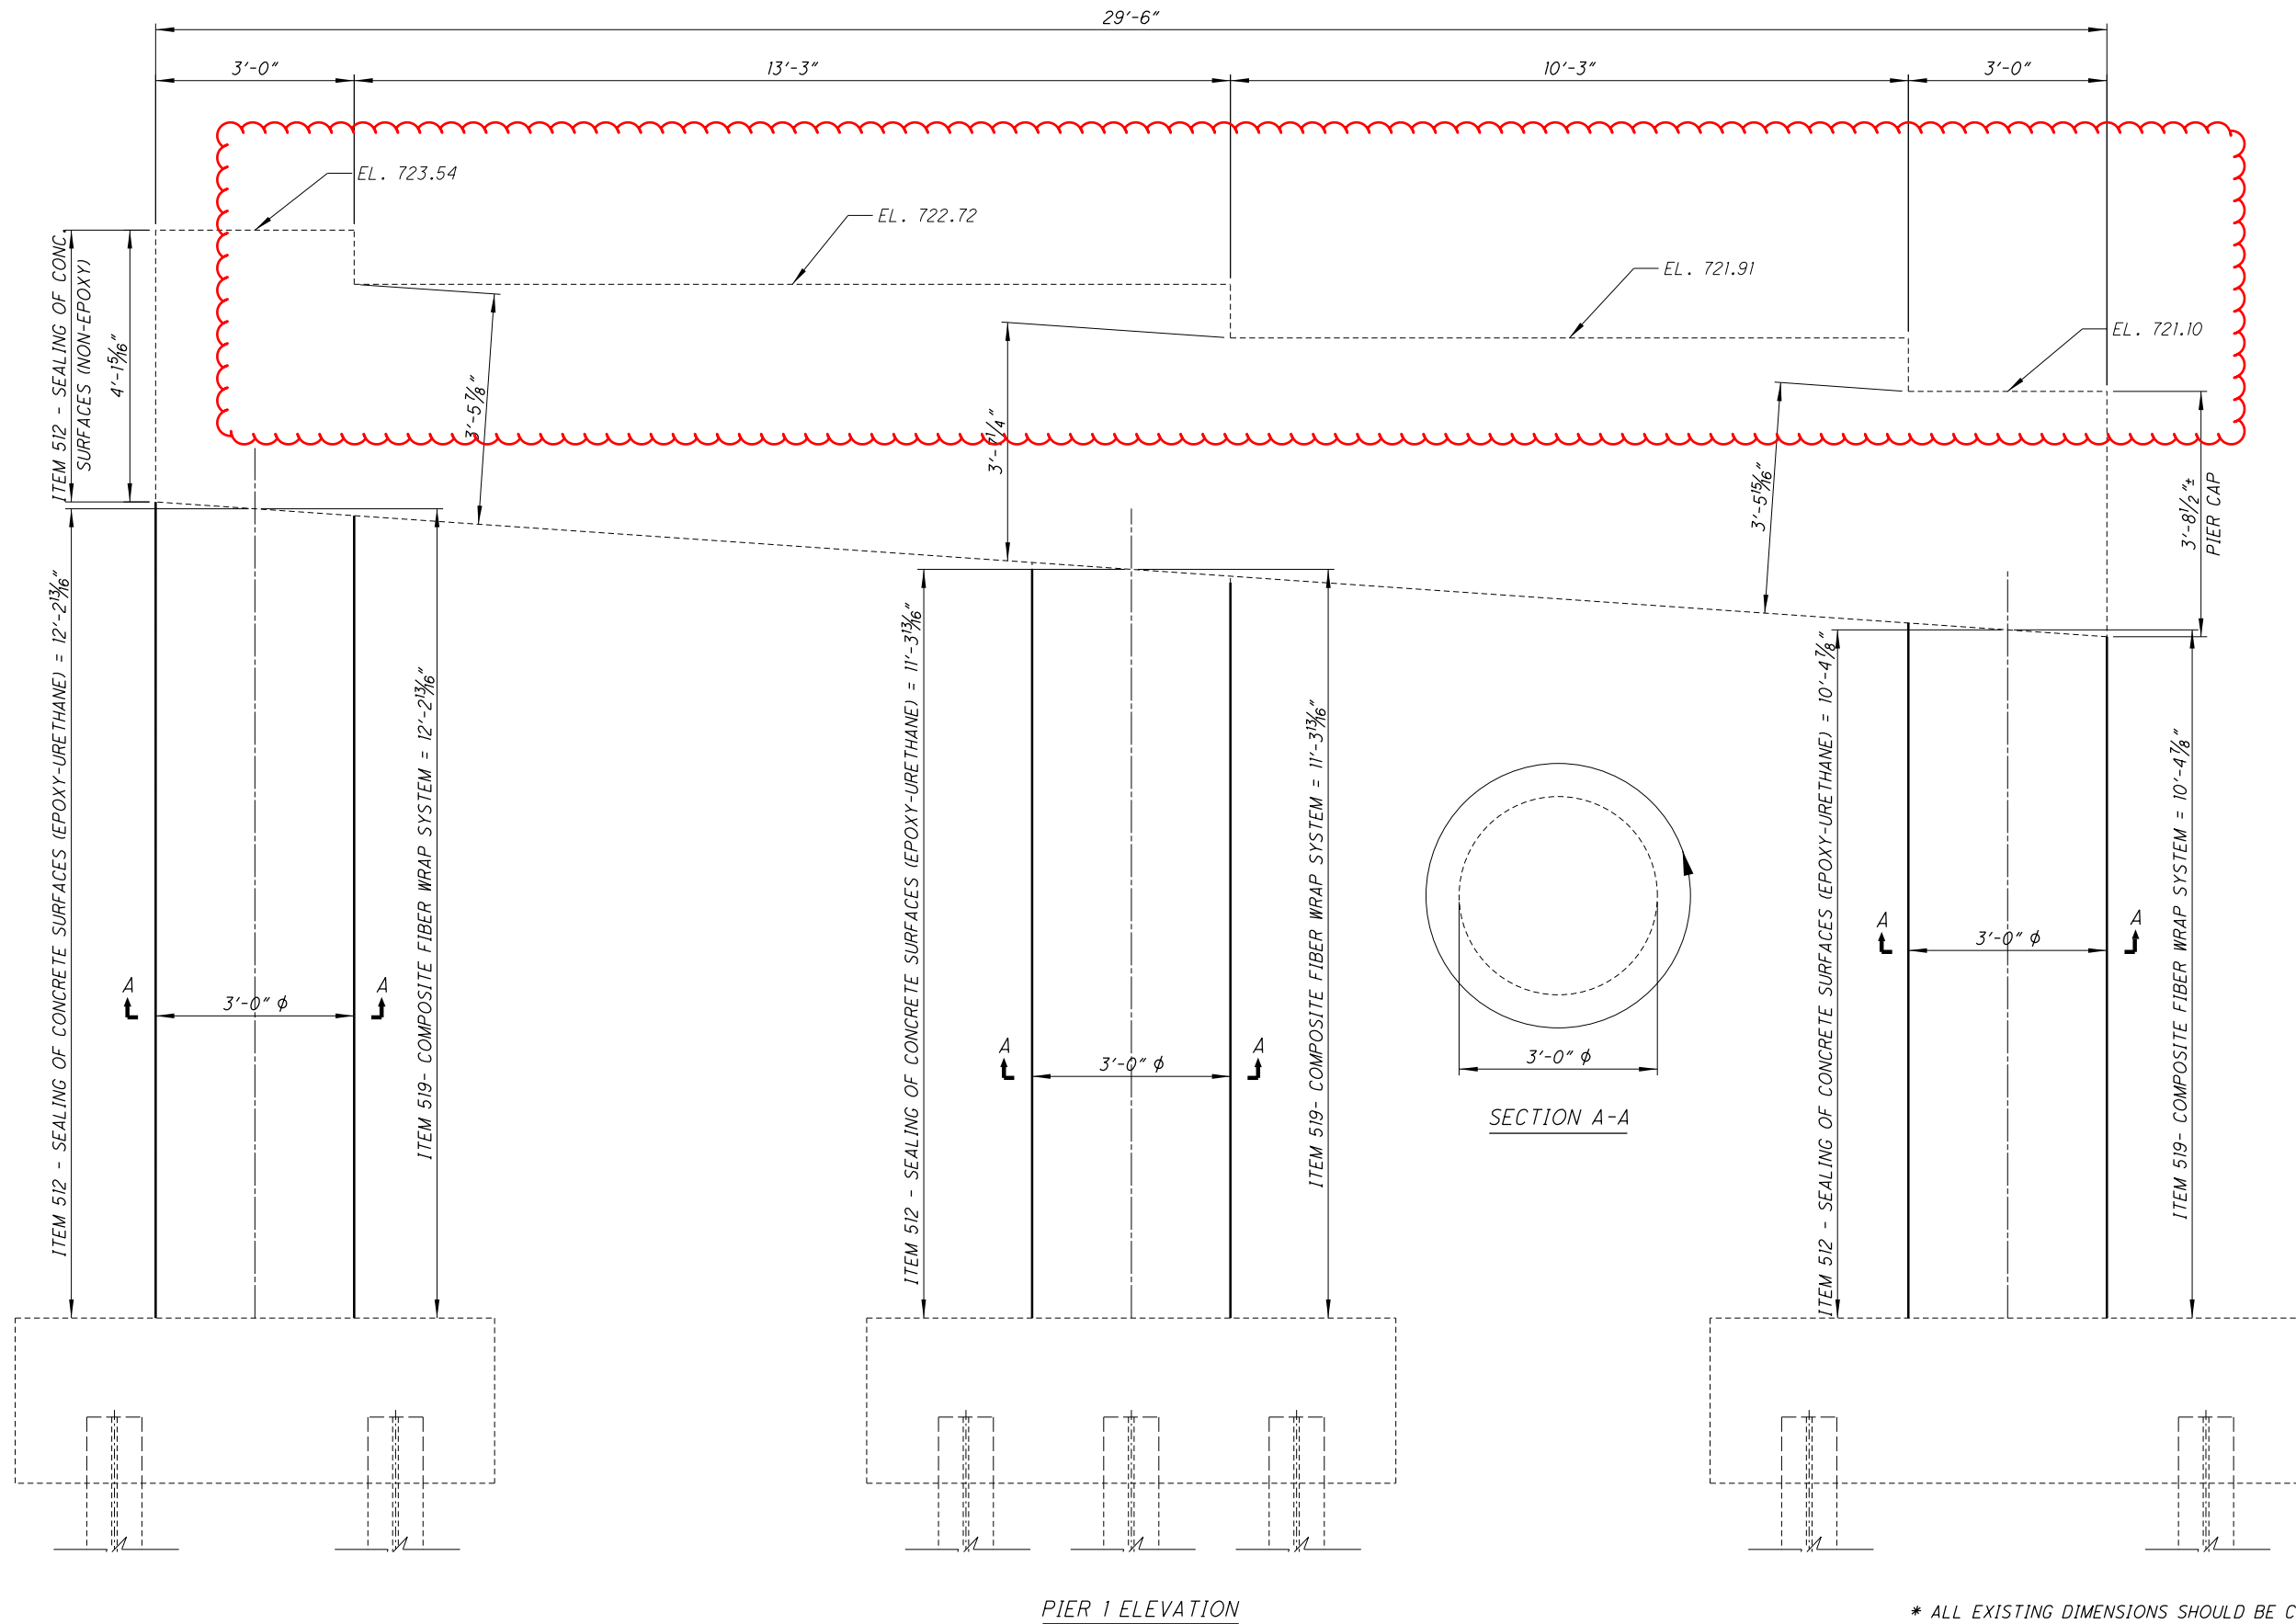

PIER 1 ELEVATION

* ALL EXISTING DIMENSIONS SHOULD BE CONSIDERED ±

DESIGNED YEL CHECKED CPS	DRAWN YEL REVIS	REVIEWED TAG	DATE 12/01/20	DESIGN AGENCY OHIO DEPARTMENT OF TRANSPORTATION, DISTRICT 5
		STRUCTURE FILE NUMBER 6001920		
EXISTING PIERS 1 BRIDGE NO. - MUS-70-1144 RAMP 'A' OVER MCINTIRE AVE				PID No. 93006
MUS-70-10.49				1939 2231
21/45				

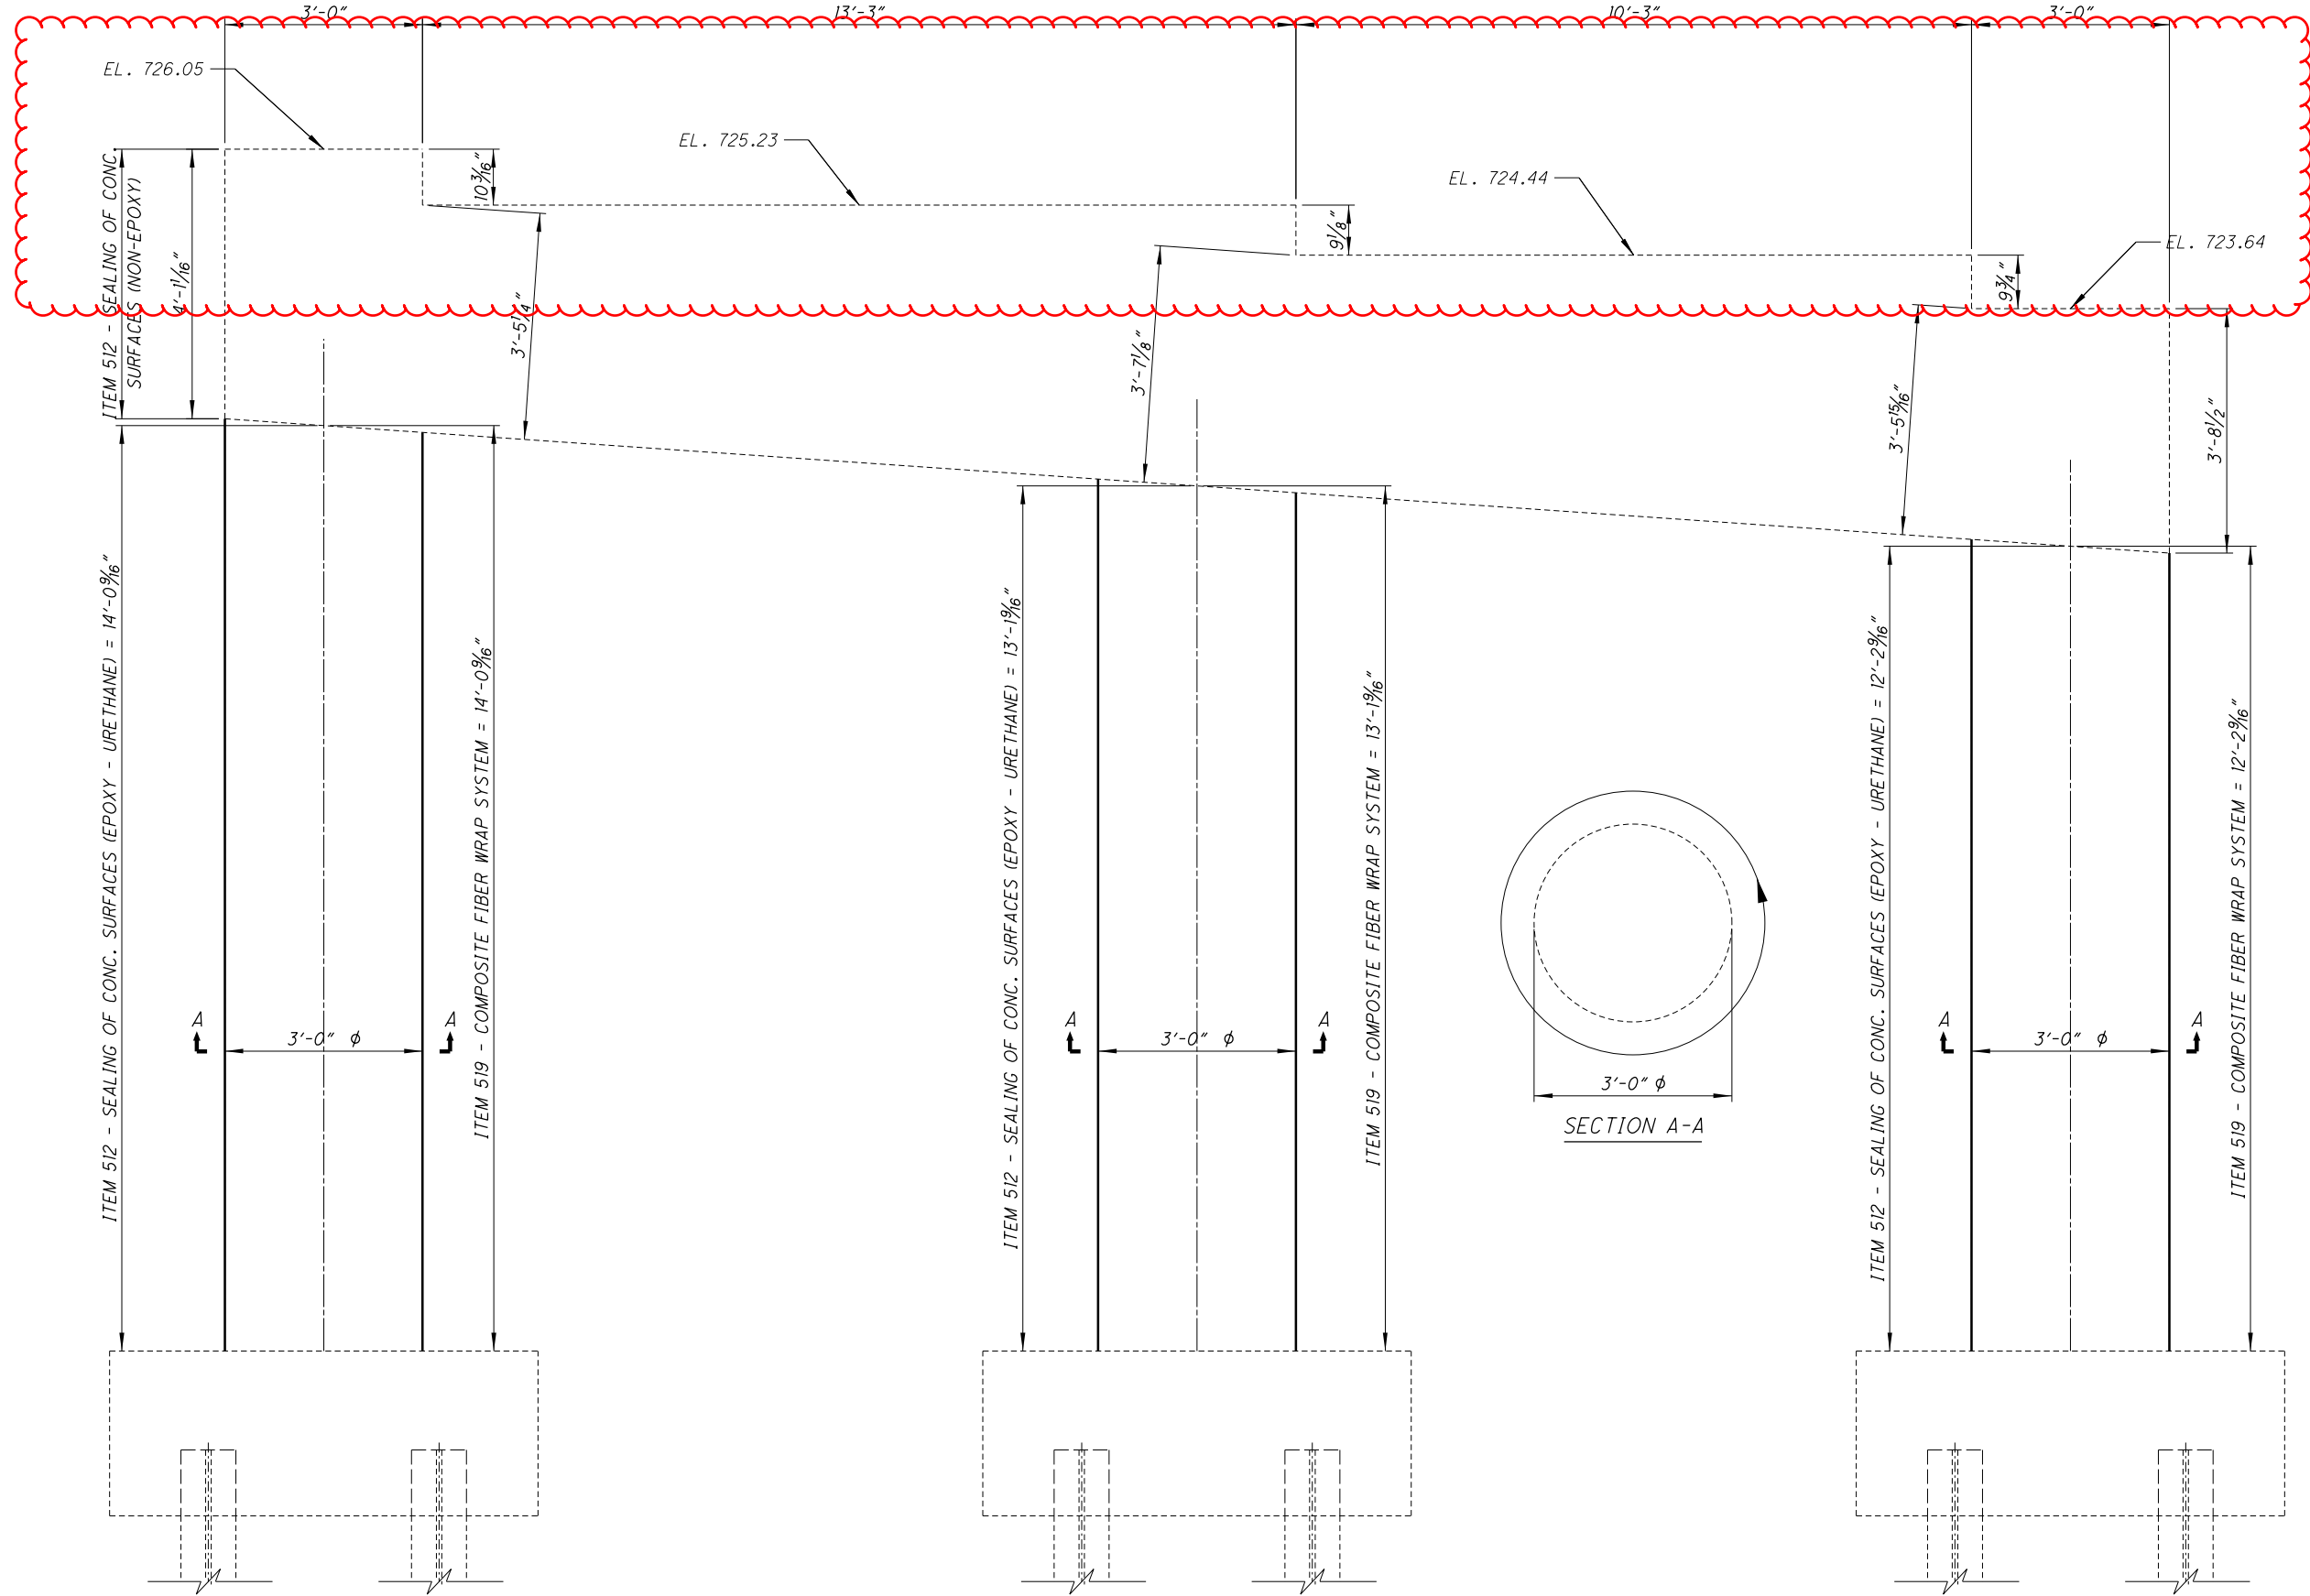

PIER 2 ELEVATION

* ALL EXISTING DIMENSIONS SHOULD BE CONSIDERED *

DESIGNED YEL	CHECKED CPS	DRAWN YEL	REVIEWED TAG	DATE	DESIGN AGENCY
				12/01/20	
				STRUCTURE FILE NUMBER	
				6001920	
MUS-70-10.49 BRIDGE NO. - MUS-70-1144 RAMP 'A' OVER MCINTIRE AVE					EXISTING PIER 2
PID No. 93006					1940 2231
22 / 45					

BASIS OF PAYMENT: THE UNIT BID PRICE SHALL INCLUDE ALL MATERIALS (INCLUDING LOAD PLATES, HP SHAPES AND ANCHOR RODS, DOWEL HOLES, LABOR, TESTING AND INCIDENTALS NECESSARY TO FURNISH AND INSTALL LAMINATED ELASTOMERIC BEARINGS, EITHER FIXED OR EXPANSION. PAYMENT WILL BE MADE AT THE CONTRACT PRICE BID FOR ITEM 516, EACH, ELASTOMERIC BEARING WITH INTERNAL LAMINATES AND LOAD PLATE (NEOPRENE) AS PER PLAN.

REAR ABUTMENT BEARING PADS: 1'-0" x 1'-4" x 3.5732" (50 DUROMETER)
 TOP STEEL LOAD PLATE: 1'-1" x 1'-2" x 1.50" BEVELED TO 2.125"
 BOTTOM STEEL LOAD PLATE: 1'-1" x 1'-5" x 1.50"

PIER 1 BEARING PADS: 1'-3" x 1'-6" x 3.7226" (50 DUROMETER)
 TOP STEEL LOAD PLATE: 1'-10" x 2'-1" x 3.8125" BEVELED TO 4.9375"

PIER 2 BEARING PADS: 1'-3" x 1'-6" x 3.7226" (50 DUROMETER)
 TOP STEEL LOAD PLATE: 1'-4" x 1'-7" x 3.8125" BEVELED TO 4.8125"

FORWARD ABUTMENT BEARING PADS:
 1'-0" x 1'-4" x 3.5732" (50 DUROMETER)
 TOP STEEL LOAD PLATE: 1'-1" x 1'-2" x 1.50" BEVELED TO 2.125"
 BOTTOM STEEL LOAD PLATE: 1'-1" x 1'-5" x 1.50"

ALL H-PILES: HP12x53

ELASTOMERIC BEARING PAD DESIGN DATA			
LOCATION	DL (K)	LL (K)	DL & LL (K)
REAR ABUTMENT	62	57	119
PIER 1	112	92	204
PIER 2	112	92	204
FWD. ABUTMENT	62	57	119


LOAD PLATE:
 THE STEEL LOAD PLATES SHALL BE MADE OF A709 STEEL. THE STEEL LOAD PLATE SHALL BE BONDED BY VULCANIZATION TO THE ELASTOMER DURING THE MOLDING PROCESS. ADDITIONAL UPPER LOAD PLATES AT THE ABUTMENTS AND ALL HP STEEL SHAPES SHALL BE INCLUDED WITH ITEM 516 FOR PAYMENT. FOR ADDITIONAL DETAILS, SEE STD DWG SICD-1-96.

WELDING:
 CONTROL WELDING SO THAT THE PLATE TEMPERATURE AT THE ELASTOMER BONDED SURFACE DOES NOT EXCEED 300 DEGREES F AS DETERMINED BY USE OF PYROMETRIC STICKS OR OTHER TEMPERATURE MONITORING DEVICES.


BEARING REPOSITIONING:
 IF THE GIRDERS ARE ERECTED AT AN AMBIENT TEMPERATURE HIGHER THAN 80 DEGREES F OR LOWER THAN 40 DEGREES F AND THE BEARING SHEAR DEFLECTION EXCEEDS 1/6 OF THE BEARING HEIGHT AT 60 DEGREES F (+/-) 10 DEGREES F, RAISE THE BEAMS OR GIRDERS TO ALLOW THE BEARINGS TO RETURN TO THEIR UNDEFORMED SHAPE AT 60 DEGREES F (+/-) 10 DEGREES F.

ELASTOMERIC BEARINGS:
 THE ELASTOMER SHALL HAVE A HARDNESS OF 50 DUROMETER. THE BEARINGS WERE DESIGNED IN ACCORDANCE WITH SECTION 14.7.5 (METHOD A) OF THE AASHTO LRFD BRIDGE DESIGN SPECIFICATIONS. PERFORM THE LONG-TERM COMPRESSION PROOF LOAD TEST IN ACCORDANCE WITH THE AASHTO STANDARD SPECIFICATIONS FOR HIGHWAY BRIDGES, DIVISION II, SECTION 18.7.2.6 AND 18.7.4.5.


MARKINGS:
 ALL BEARINGS AND LOAD PLATES SHALL BE MARKED PRIOR TO SHIPPING. THE MARKS SHALL INCLUDE THE BEARING LOCATION ON THE BRIDGE AND A DIRECTION ARROW THAT POINTS, AND IS LABELED, UP-STATION. ALL MARKS SHALL BE PERMANENT AND VISIBLE AFTER THE BEARING IS INSTALLED.

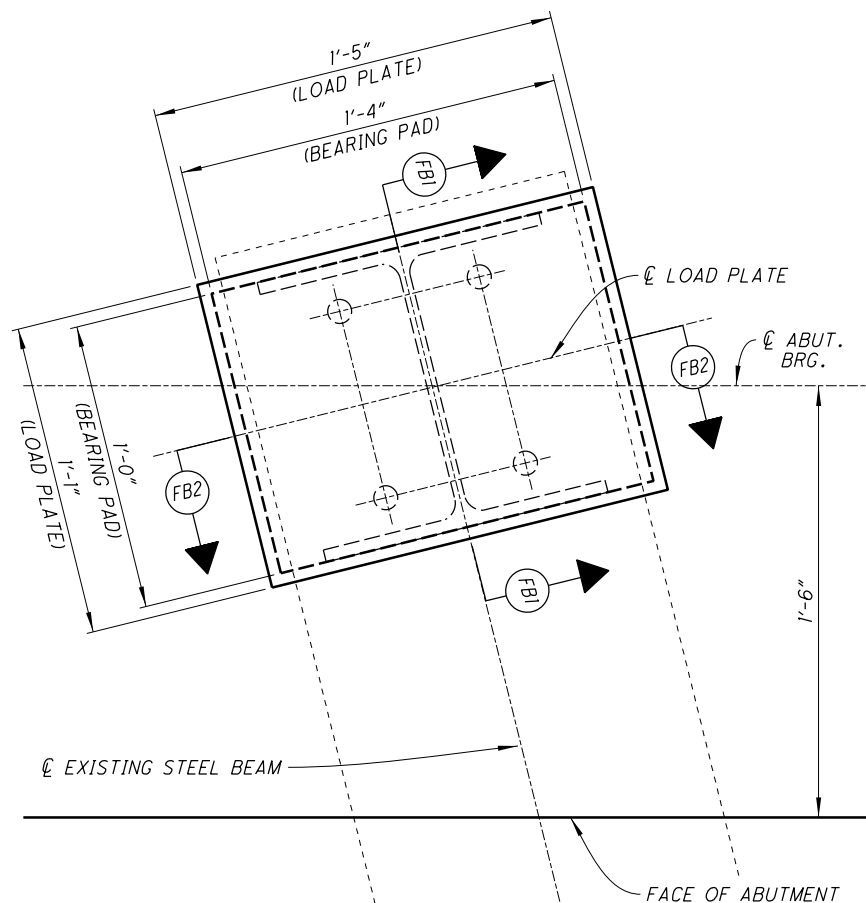

FORWARD ABUTMENT PLAN

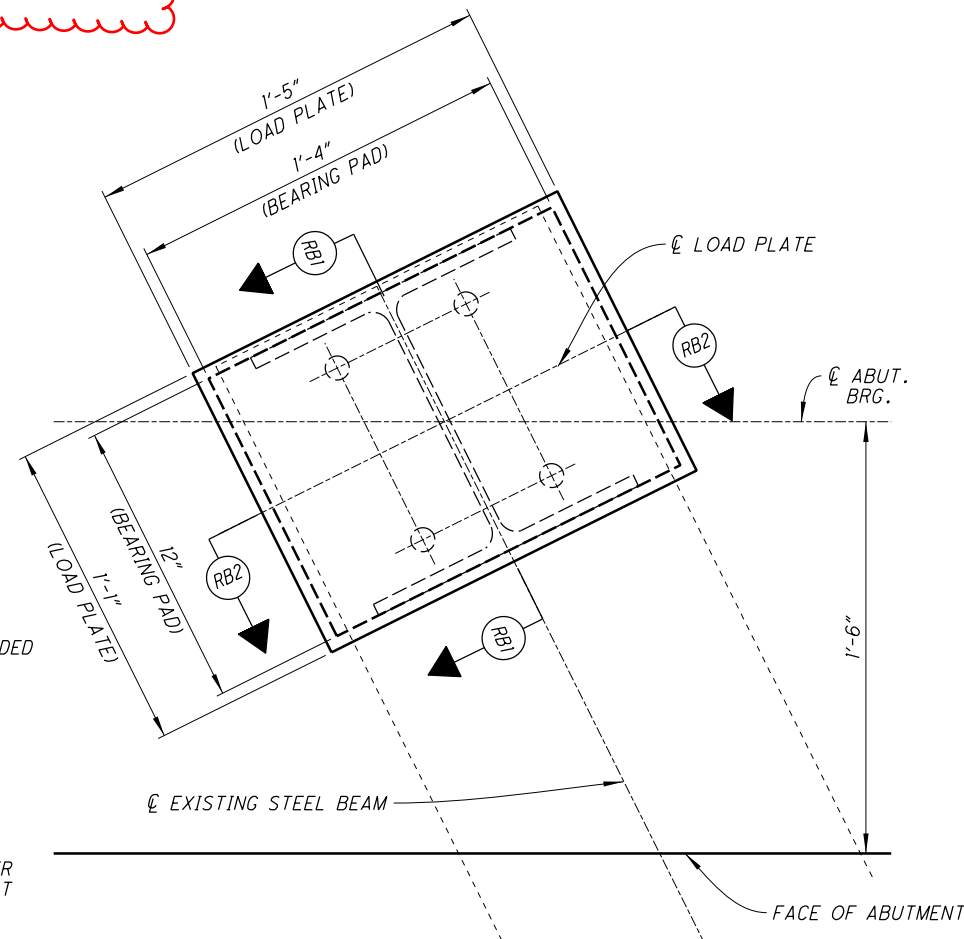

REAR ABUTMENT PLAN

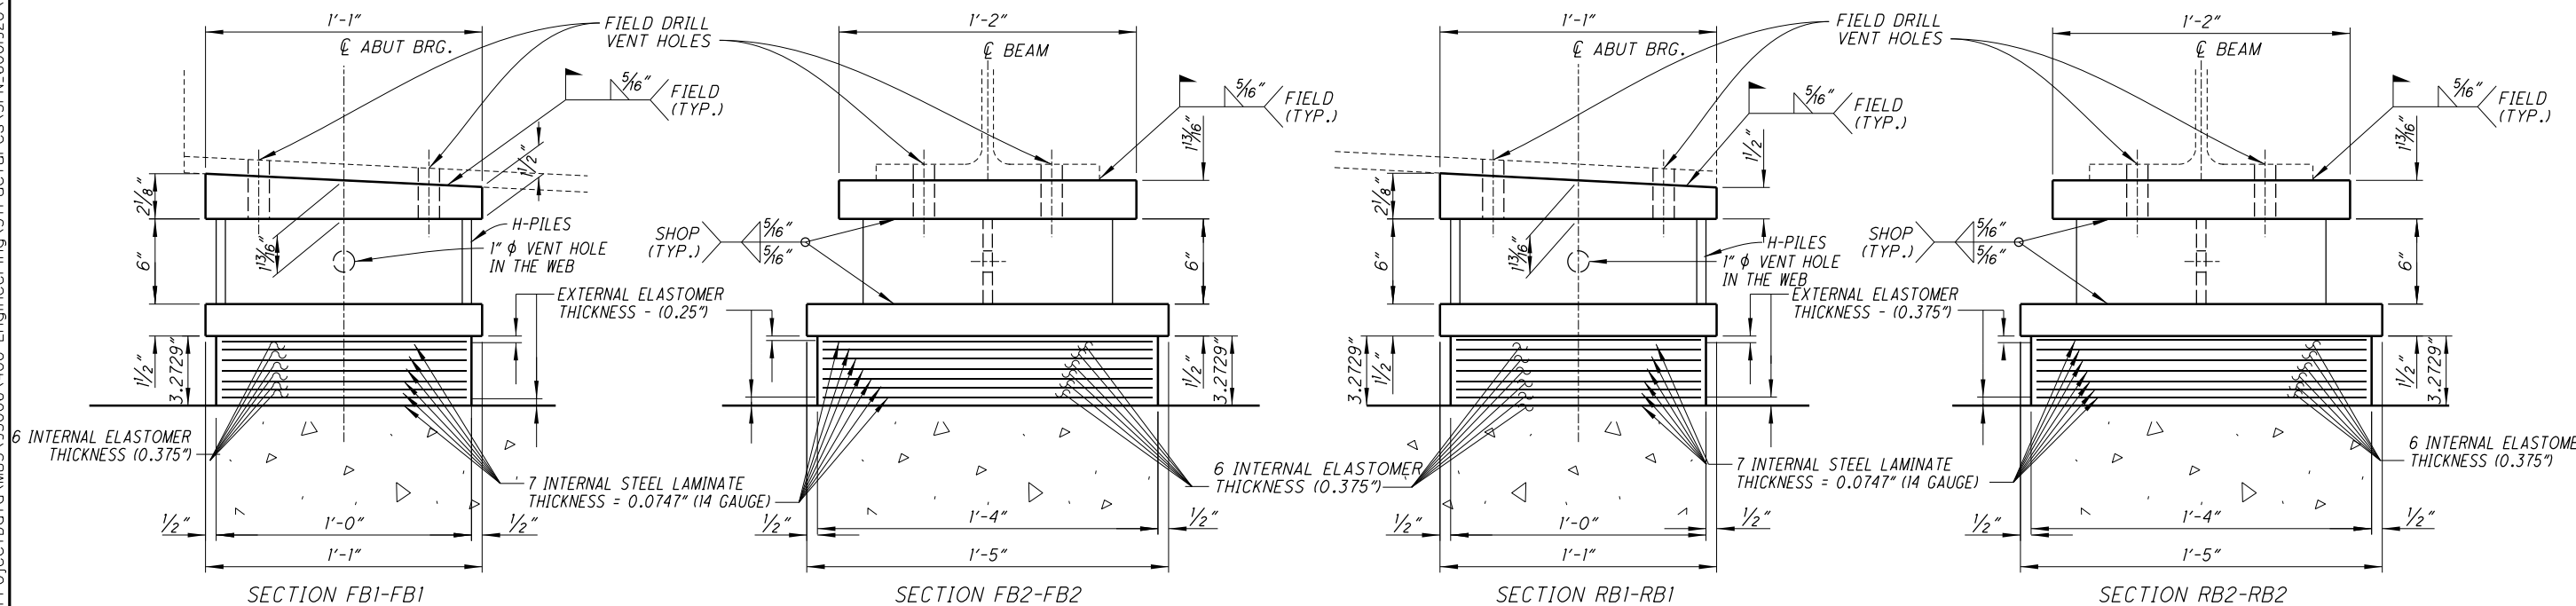

SECTION FBI-FB1

SECTION FB2-FB2







SECTION RBI-RB1

SECTION RB2-RB2

I:\ProjectData\MUS-93006-400-Engineering\Structures\SFN_6001920\Sheets\070_1144P_SB001 - TDF.dgn Sheet 4/2/2021 11:48:27 AM tgreenwa


DESIGN AGENCY	OHIO DEPARTMENT OF	TRANSPORTATION, DISTRICT 5	
REVIEWED	DATE	TAG	STRUCTURE FILE NUMBER
DRAWN	YEL/TDF	REVIS	6001920
DESIGNED	YEL	CHECKED	CPS
BEARING PAD DETAILS			
BRIDGE NO. MUS-70-1144A			
RAMP 'A' OVER-McINTIRE AVE.			
MUS-70-10.49			
PID No. 93006			
25 / 45		1943 2231	

I:\ProjectData\MUS-93006\400-Engineering\Structures\070_1144P_SB002.dgn Sheet 4/2/2021 12:44:46 PM tgreenwa

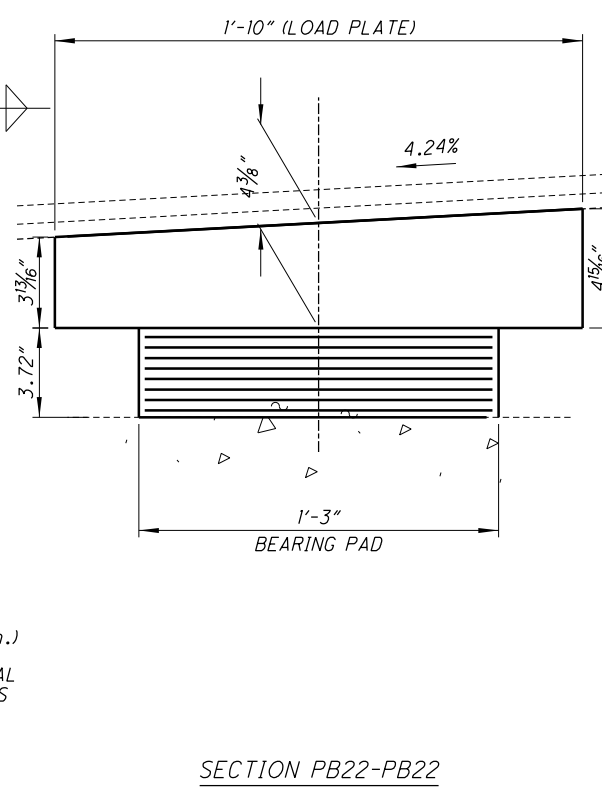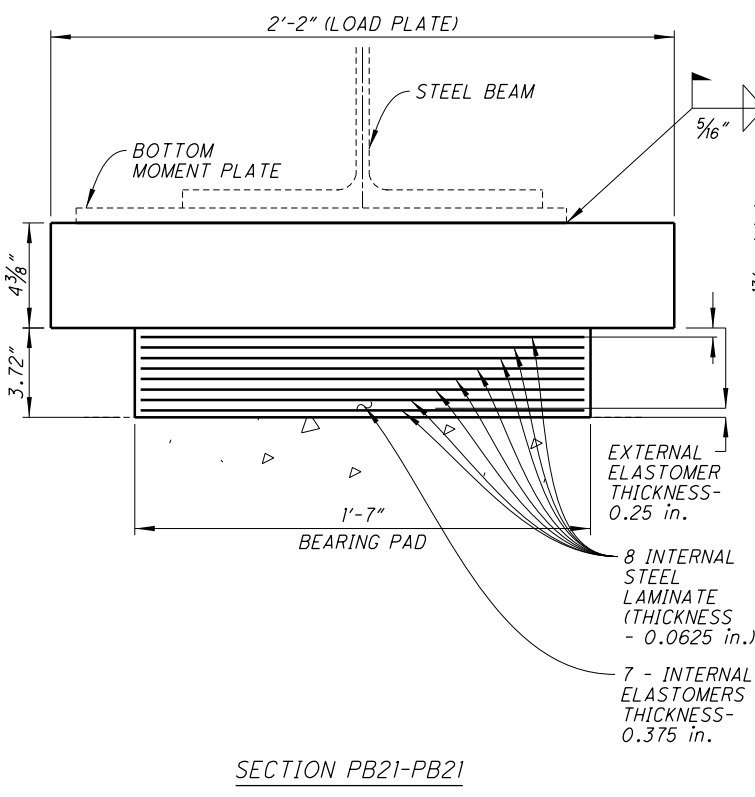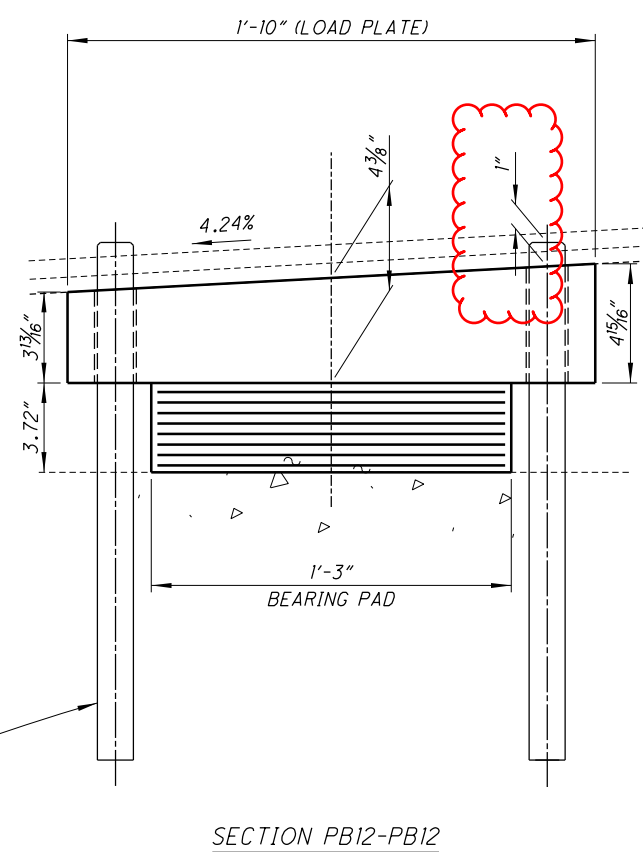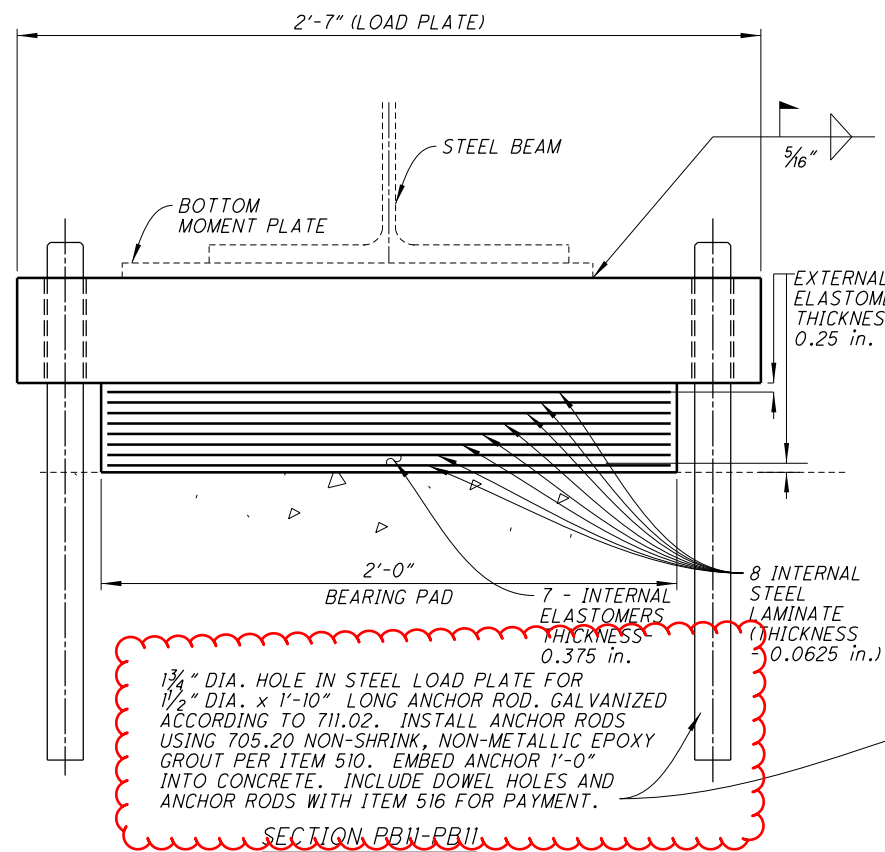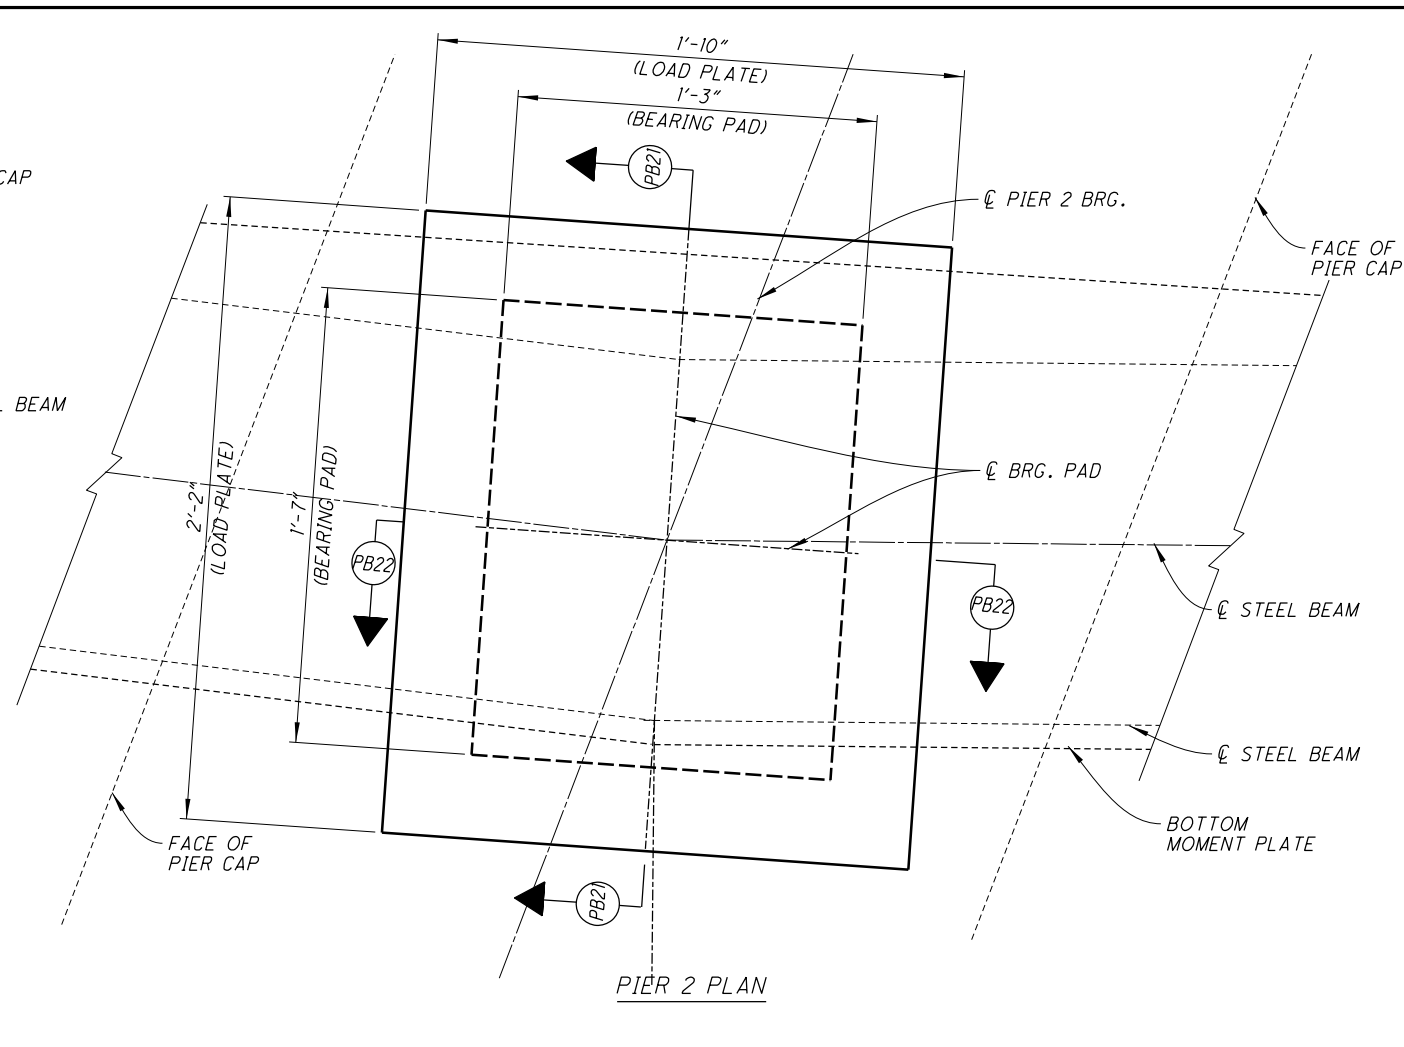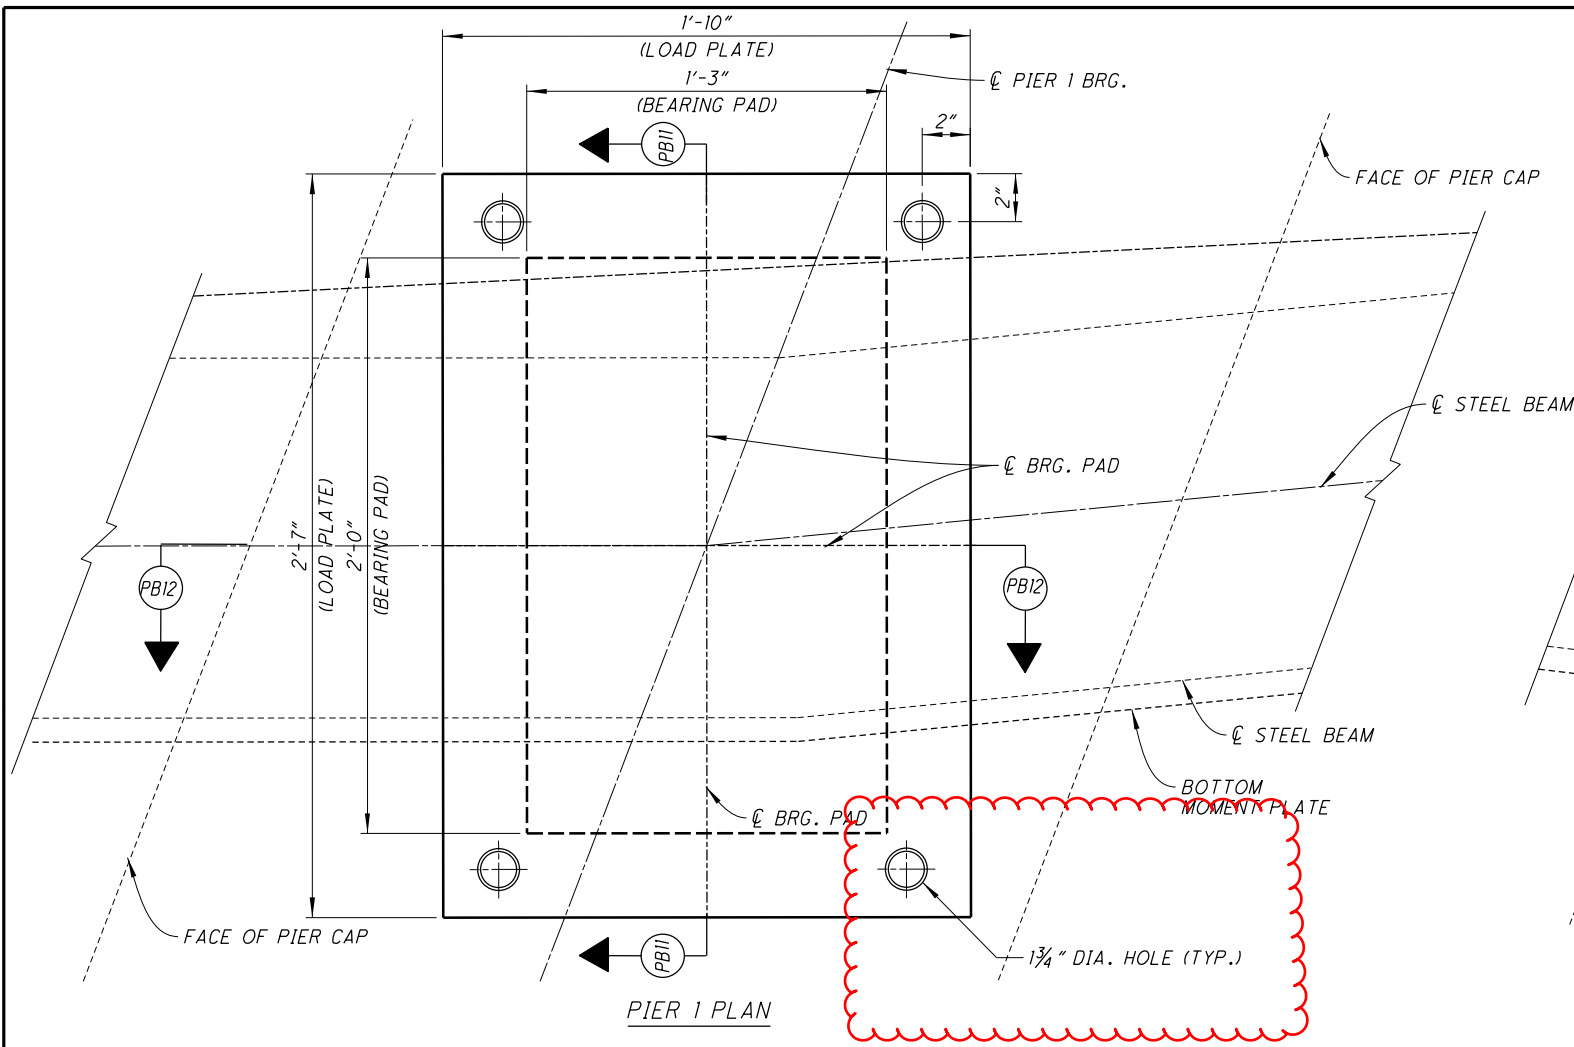

DESIGNED YEL		CHECKED CPS		DRAWN YEL/TDF		REVIEWED TAG		DATE 12/1/2020		DESIGN AGENCY OHIO DEPARTMENT OF TRANSPORTATION, DISTRICT 5	
STRUCTURE FILE NUMBER 6001920		REVIS		REVISED		TAG		FILE NUMBER 6001920			
BEARING PAD DETAILS											
BRIDGE NO. MUS-70-1144A											
RAMP 'A' OVER-McINTIRE AVE.											
MUS-70-10.49						PID No. 93006					
26 / 45											
1944 2231											

I:\ProjectData\MUS\93006\400-Engineering\Structures\070_1144P_S001.dgn Sheet 4/9/2021 11:32:41 AM tgreenwa








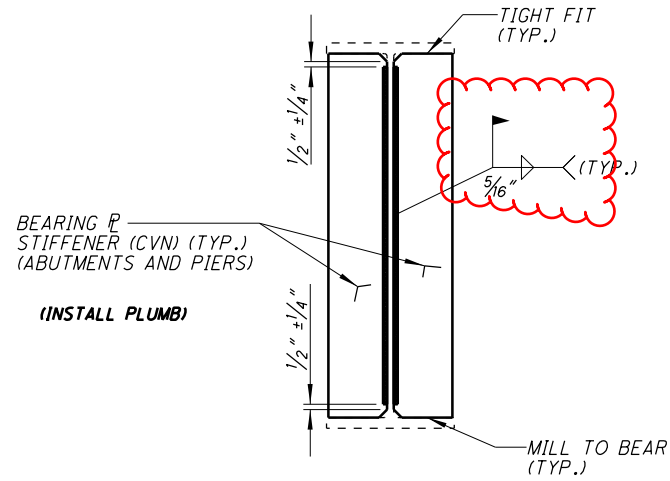


NOTE:
FOR NOTES AND ADDITIONAL
DETAILS INCLUDING WELDING
DETAILS SEE STD. DWG. GSD-1-96.
ALL PROPOSED BEARING STIFFENER
HEIGHTS SHALL BE FIELD MEASURED
AND VERIFIED BY THE CONTRACTOR
PRIOR TO FABRICATION (TYPICAL)

BEARING STIFFENERS DETAILS

ITEM 513 STRUCTURAL STEEL MEMBERS, LEVEL UF, AS PER PLAN		
STIFFENER #	NUMBER	POUNDS
7" x 0.75" x 30.4"	48	2172
TOTAL		2172

FINAL QUANTITIES FOR ITEM 513 STRUCTURAL STEEL MEMBERS, LEVEL UF, AS PER PLAN SHALL BE DETERMINED IN THE FIELD.

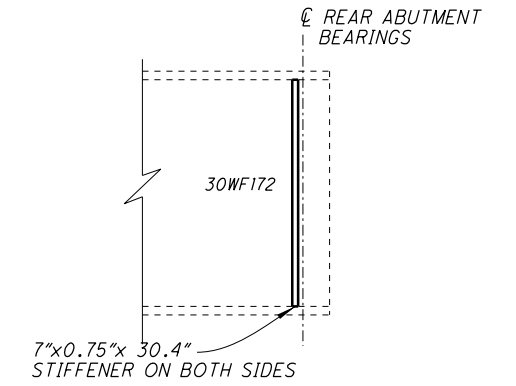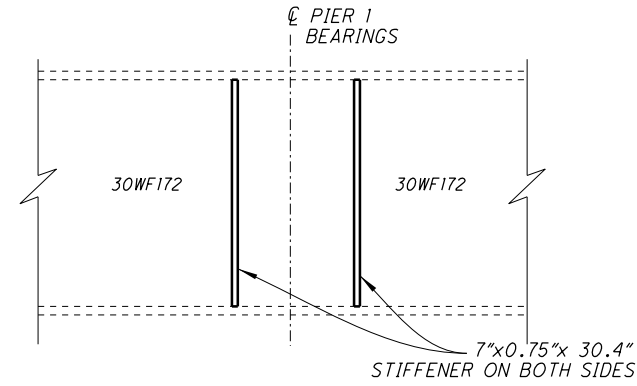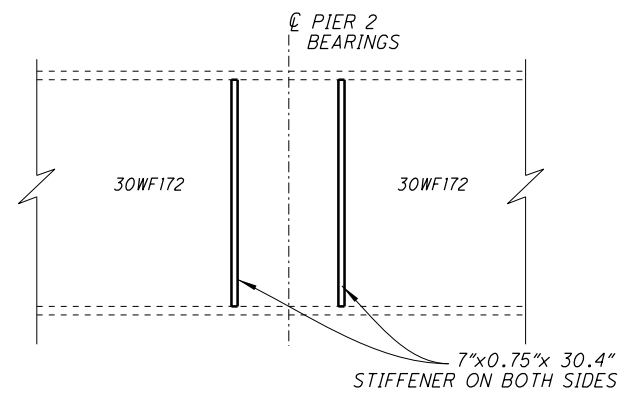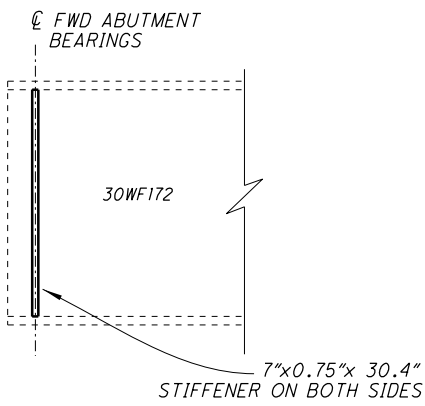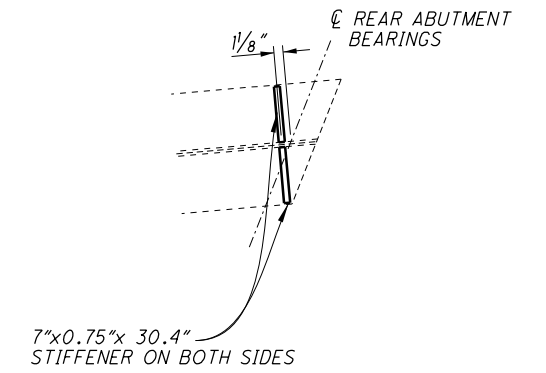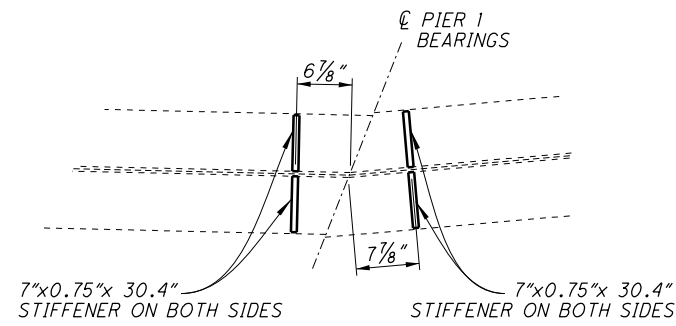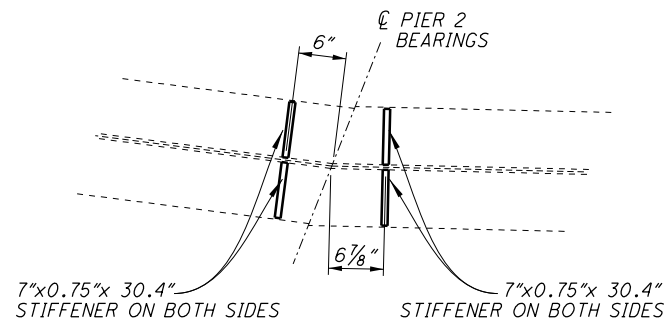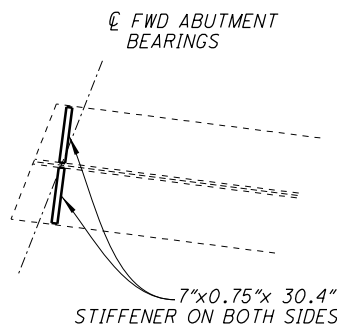


PROPOSED BEARING STIFFENERS LOCATIONS


I:\ProjectData\MUS_93006\400-Engineering\Structures\SFN_6001890\Sheets\070_1145P_GS001 - TDF.dgn Sheet 4/5/2021 11:48:03 AM tgreenwa

SHEET NUM.					PART.		ITEM	ITEM EXT	GRAND TOTAL	UNIT	DESCRIPTION	SEE SHEET NO.
	24	31			02/IMS/BR							
STRUCTURE OVER 20 FOOT SPAN (MUS-70-1142E or SFN6001890)												
					LS	202	11203	LS		PORTIONS OF STRUCTURE REMOVED, OVER 20 FOOT SPAN, AS PER PLAN (SUPERSTRUCTURE)	3	
					105	202	11301	105	CY	PORTIONS OF STRUCTURE REMOVED, AS PER PLAN (SUBSTRUCTURES)	3	
					103	202	22900	103	SY	APPROACH SLAB REMOVED		
					LS	503	21301	LS		UNCLASSIFIED EXCAVATION, AS PER PLAN	44	
					61,871	509	10000	61,871	LB	EPOXY COATED REINFORCING STEEL		
					197	511	21520	197	CY	CLASS QC2 CONCRETE, SUPERSTRUCTURE		
					2	511	33500	2	EACH	SEMI-INTEGRAL DIAPHRAGM GUIDE		
					40	511	34448	40	CY	CLASS QC2 CONCRETE, BRIDGE DECK (PARAPET)		
					116	511	43510	116	CY	CLASS QC1 CONCRETE, ABUTMENT INCLUDING FOOTING		
					451	512	10050	451	SY	SEALING OF CONCRETE SURFACES (NON-EPOXY)		
					71	512	10100	71	SY	SEALING OF CONCRETE SURFACES (EPOXY-URETHANE)		
	951	2,878			3,829	513	10201	3,829	LB	STRUCTURAL STEEL MEMBERS, LEVEL UF, AS PER PLAN	3	
					2,010	513	20000	2,010	EACH	WELDED STUD SHEAR CONNECTORS		
					6,911	514	00050	6,911	SF	SURFACE PREPARATION OF EXISTING STRUCTURAL STEEL		
					6,911	514	00056	6,911	SF	FIELD PAINTING OF EXISTING STRUCTURAL STEEL, PRIME COAT		
					6,911	514	00060	6,911	SF	FIELD PAINTING STRUCTURAL STEEL, INTERMEDIATE COAT		
					6,911	514	00066	6,911	SF	FIELD PAINTING STRUCTURAL STEEL, FINISH COAT		
					9	514	10000	9	EACH	FINAL INSPECTION REPAIR		
					12	516	13601	12	SF	1" PREFORMED EXPANSION JOINT FILLER, AS PER PLAN	3	
					180	516	13901	180	SF	2" PREFORMED EXPANSION JOINT FILLER, AS PER PLAN	3	
					95	516	14020	95	FT	SEMI-INTEGRAL ABUTMENT EXPANSION JOINT SEAL		
					71	516	14600	71	FT	STRUCTURAL JOINT OR JOINT SEALER, MISC.: EMSEAL WITH SLEEPER SLAB	44	
					71	516	31011	71	FT	2" DEEP JOINT SEALER, AS PER PLAN	4	
					10	516	44300	10	EACH	ELASTOMERIC BEARING WITH INTERNAL LAMINATES AND LOAD PLATE (NEOPRENE) (10" x 1'-2" x 3.2729")	29	
					5	516	44300	5	EACH	ELASTOMERIC BEARING WITH INTERNAL LAMINATES AND LOAD PLATE (NEOPRENE) (1'-3" x 1'-6" x 3.7226")	29	
					5	516	44300	5	EACH	ELASTOMERIC BEARING WITH INTERNAL LAMINATES AND LOAD PLATE (NEOPRENE) (1'-3" x 1'-6" x 3.7226") WITH ANCHOR RODS	29	
					LS	516	47001	LS		JACKING AND TEMPORARY SUPPORT OF SUPERSTRUCTURE, AS PER PLAN	4	
					6	518	12000	6	EACH	SCUPPERS, INCLUDING SUPPORTS		
					41	518	21200	41	CY	POROUS BACKFILL WITH GEOTEXTILE FABRIC		
					72	518	40000	72	FT	6" PERFORATED CORRUGATED PLASTIC PIPE		
					72	518	40010	72	FT	6" NON-PERFORATED CORRUGATED PLASTIC PIPE, INCLUDING SPECIALS		
					741	SPECIAL	51900100	741	SF	COMPOSITE FIBER WRAP SYSTEM	4	
					171	526	25001	171	SY	REINFORCED CONCRETE APPROACH SLABS (T=15"), AS PER PLAN	3	
					79	613	41201	79	CY	LOW STRENGTH MORTAR BACKFILL, AS PER PLAN	4	

MUS-70-10.49 PID No. 93006	PARAPET DETAILS BRIDGE NO.: MUS-70-1142E RAMP 'E' OVER MCINTIRE AVE.	DESIGN AGENCY OHIO DEPARTMENT OF TRANSPORTATION, DISTRICT 5	REVIEWED DATE TAG 11/27/2020 STRUCTURE FILE NUMBER 6001890
5 / 44	DESIGNED YEL CHECKED TAG	DRAWN YEL REVISED .	SEE SHEET NO.

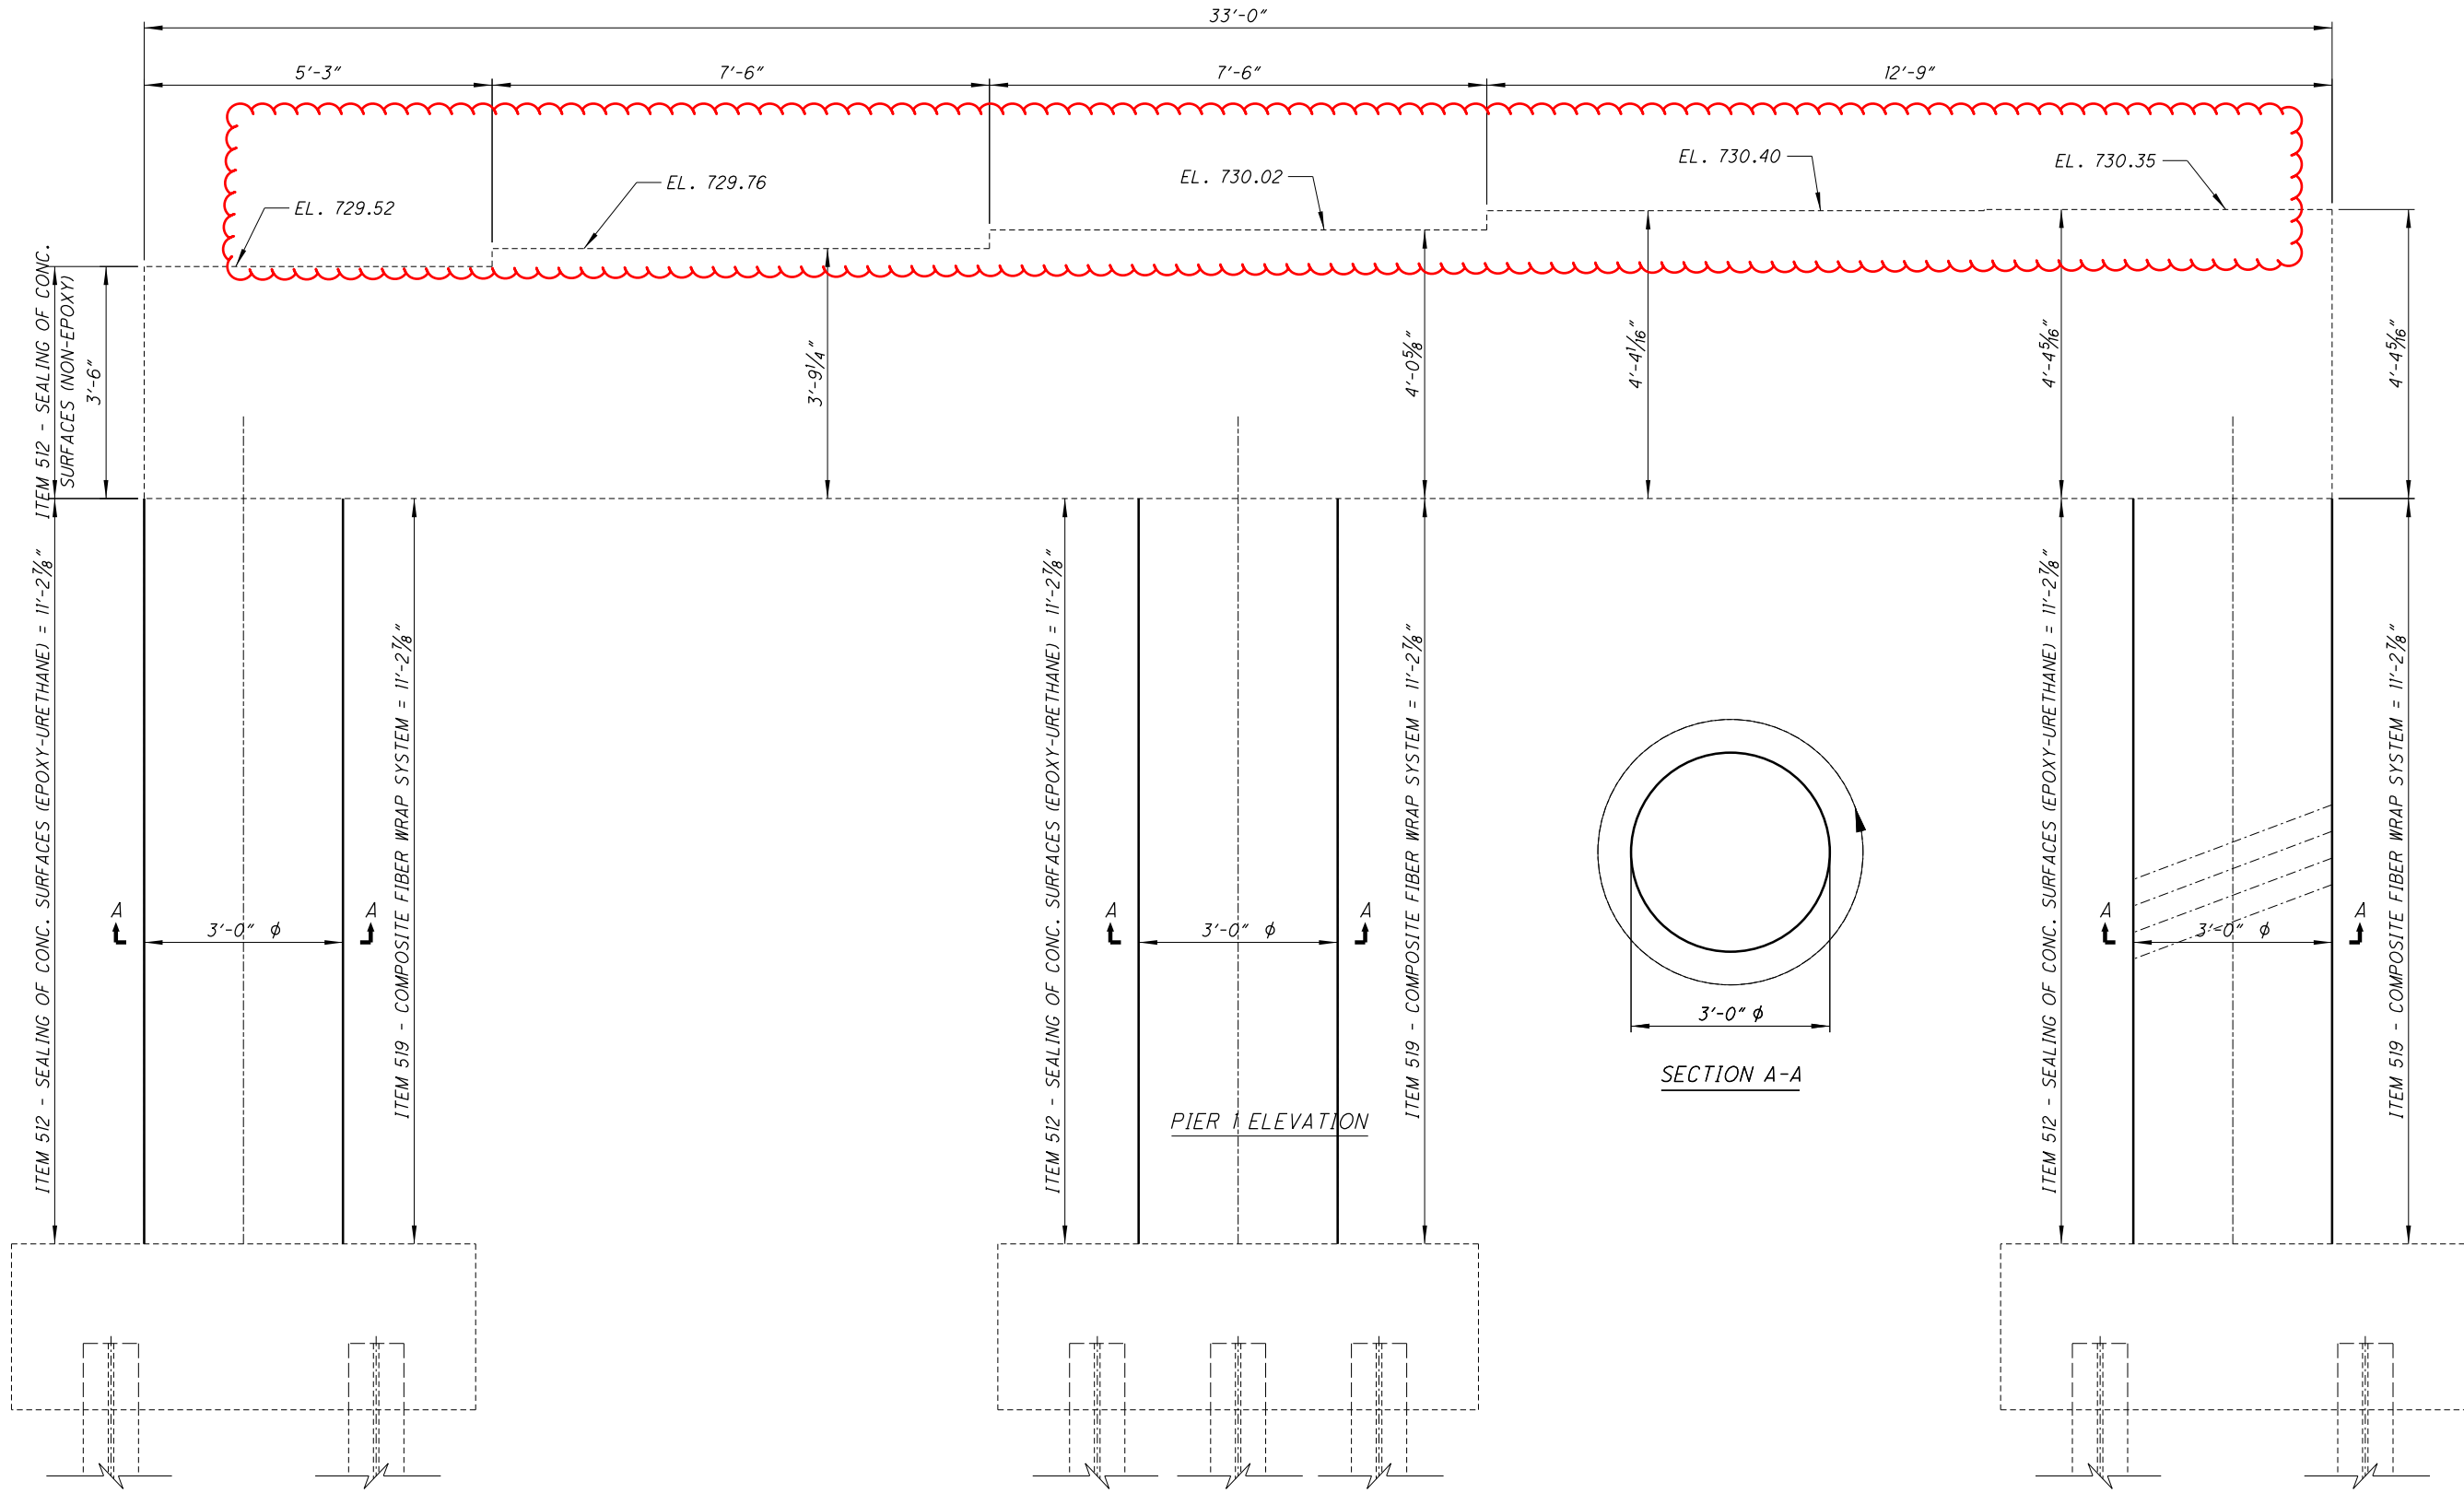



MUS-70-10.49 PID No. 93006	EXISTING PIER 1 DETAILS BRIDGE NO.: MUS-70-1142E RAMP 'E' OVER MCINTIRE AVE.		DESIGNED YEL	CHECKED TAG	DRAWN YEL	REVIEWED TAG	DATE 11/27/2020	DESIGN AGENCY OHIO DEPARTMENT OF TRANSPORTATION, DISTRICT 5
	21 / 44	1984 2231	STRUCTURE FILE NUMBER 6001890	REVISIONS

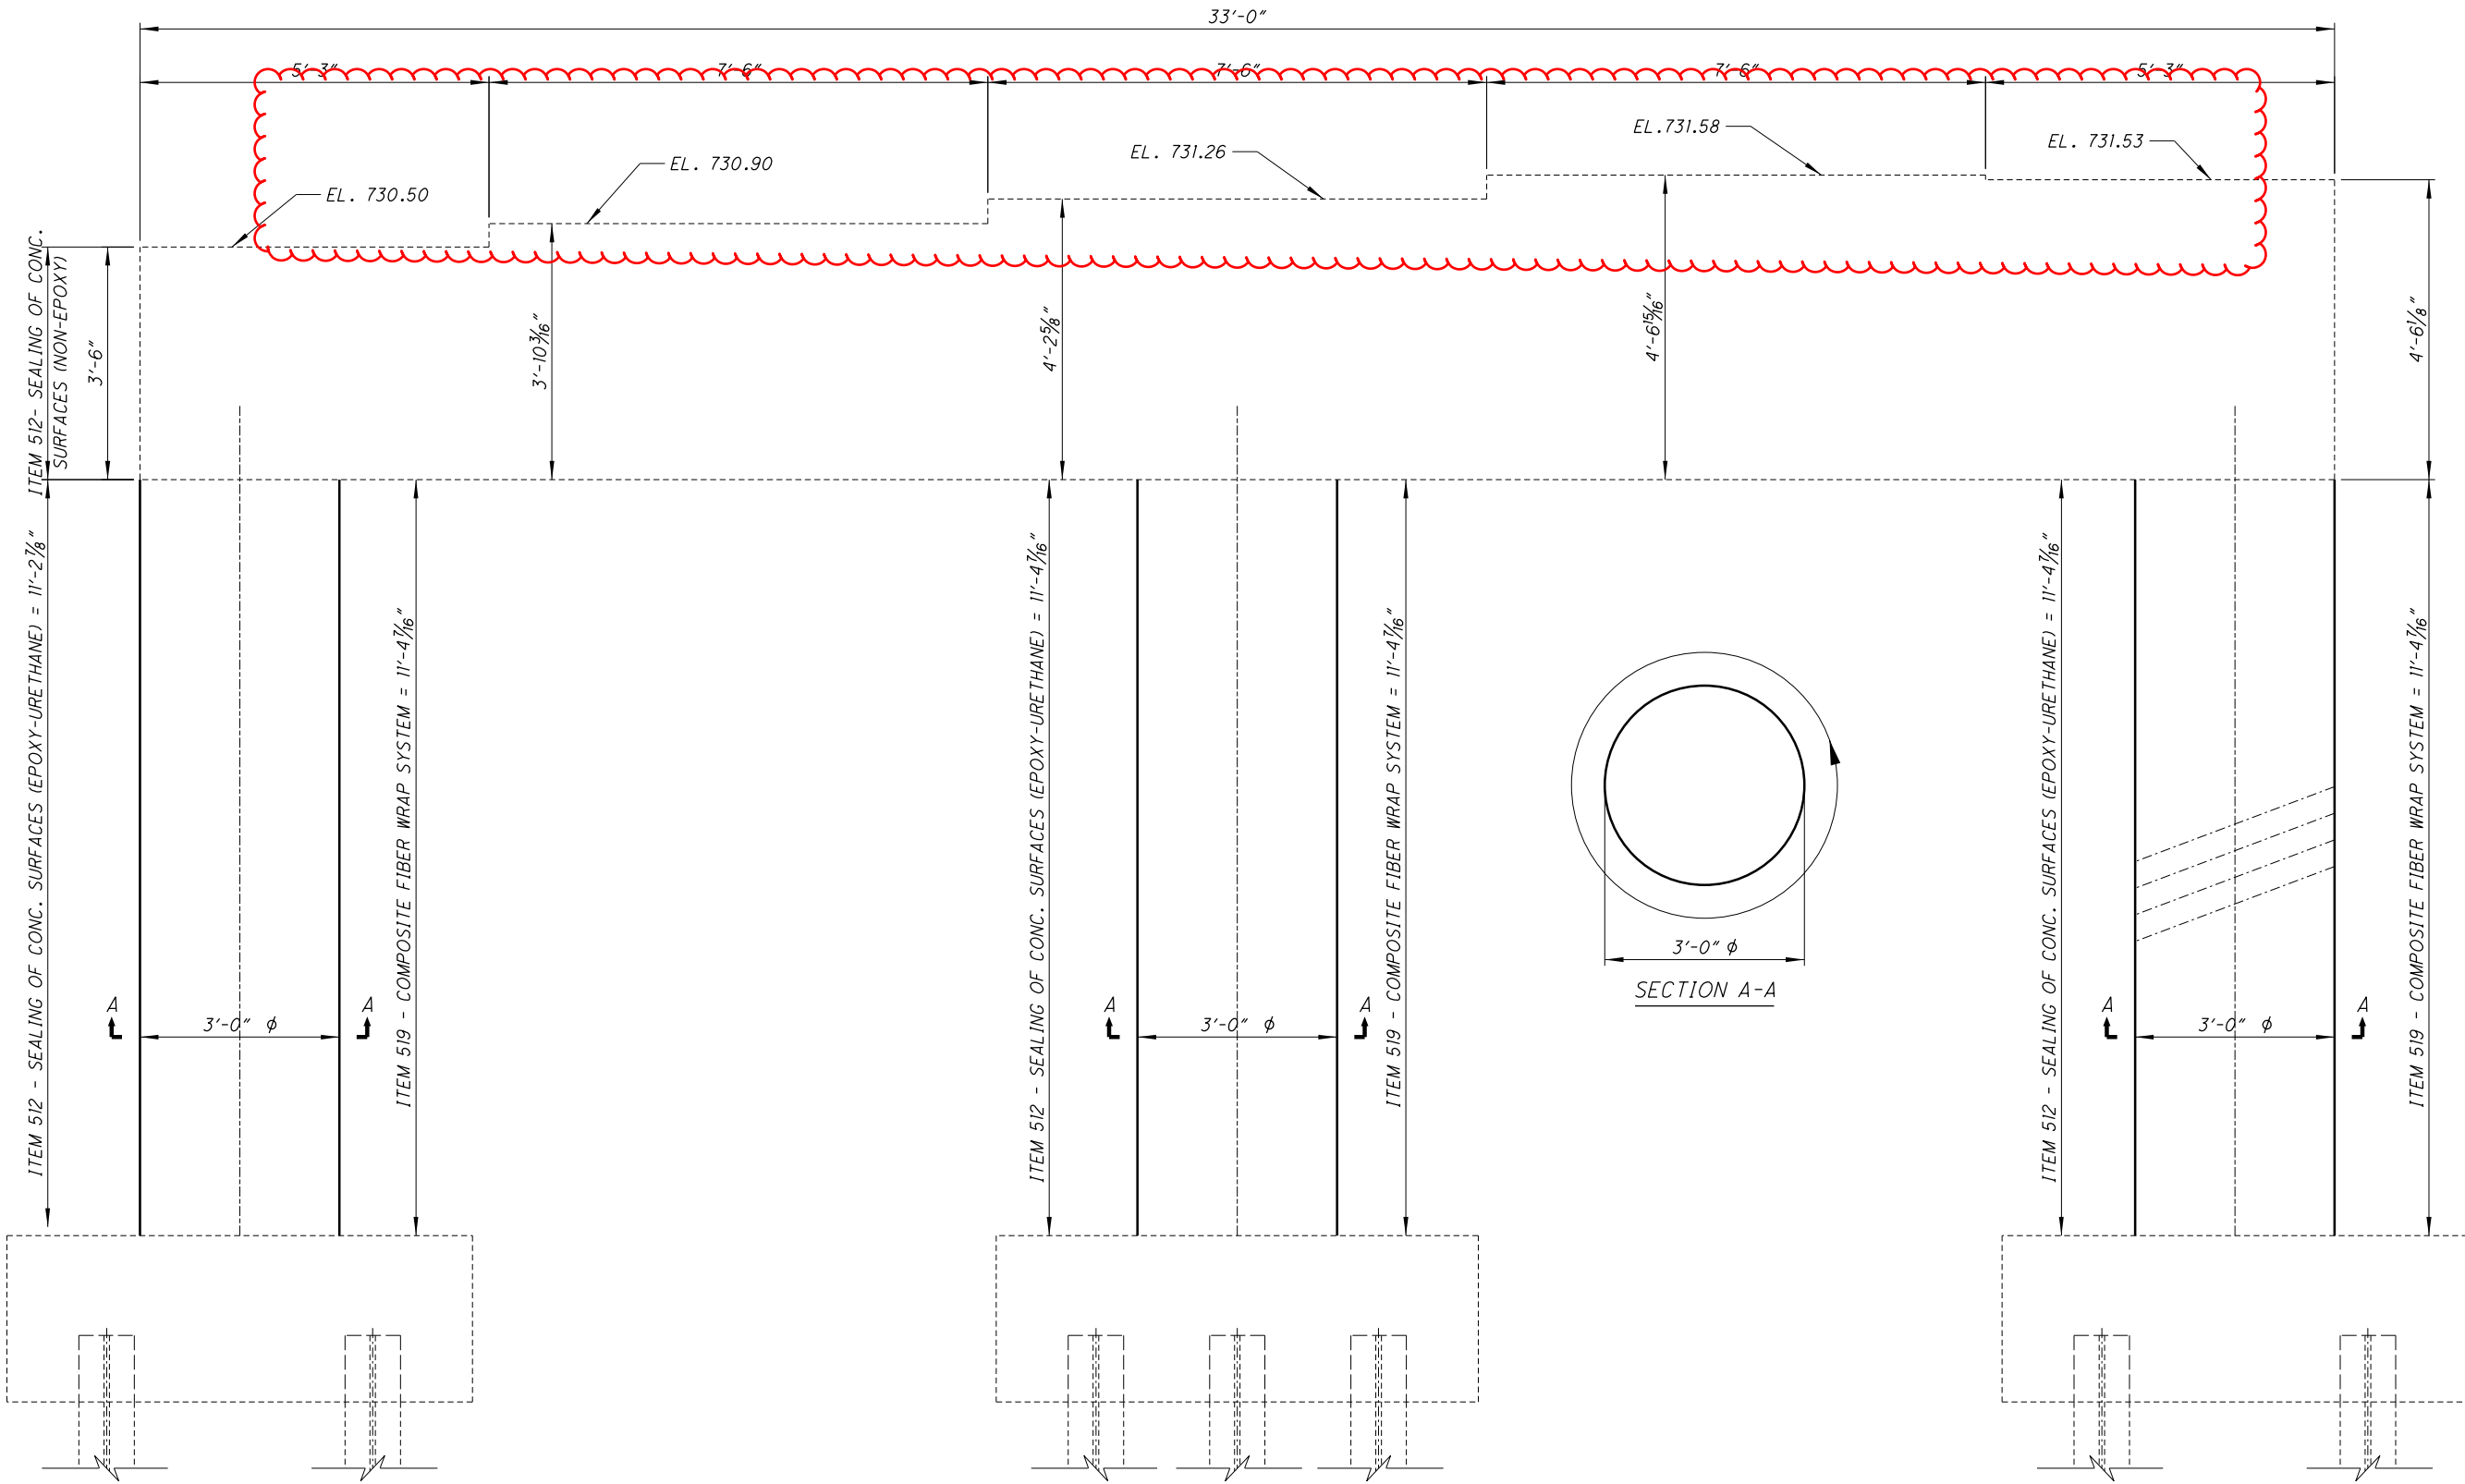

PIER 2 ELEVATION

MUS-70-10.49 PID No. 93006	EXISTING PIER 2 DETAILS BRIDGE NO.: MUS-70-1142E RAMP 'E' OVER MCINTIRE AVE.		DESIGNED YEL CHECKED TAG	DRAWN YEL REVISED	REVIEWED TAG STRUCTURE FILE NUMBER 6001890	DATE 11/27/2020	DESIGN AGENCY OHIO DEPARTMENT OF TRANSPORTATION, DISTRICT 5
	22 / 44	1985 2231					

I:\ProjectData\MUS-93006\400-Engineering\Structures\SFN_6001890\Sheets\070_1145P_ST001.dgn Sheet 4/12/2021 3:06:44 PM tgreenwa

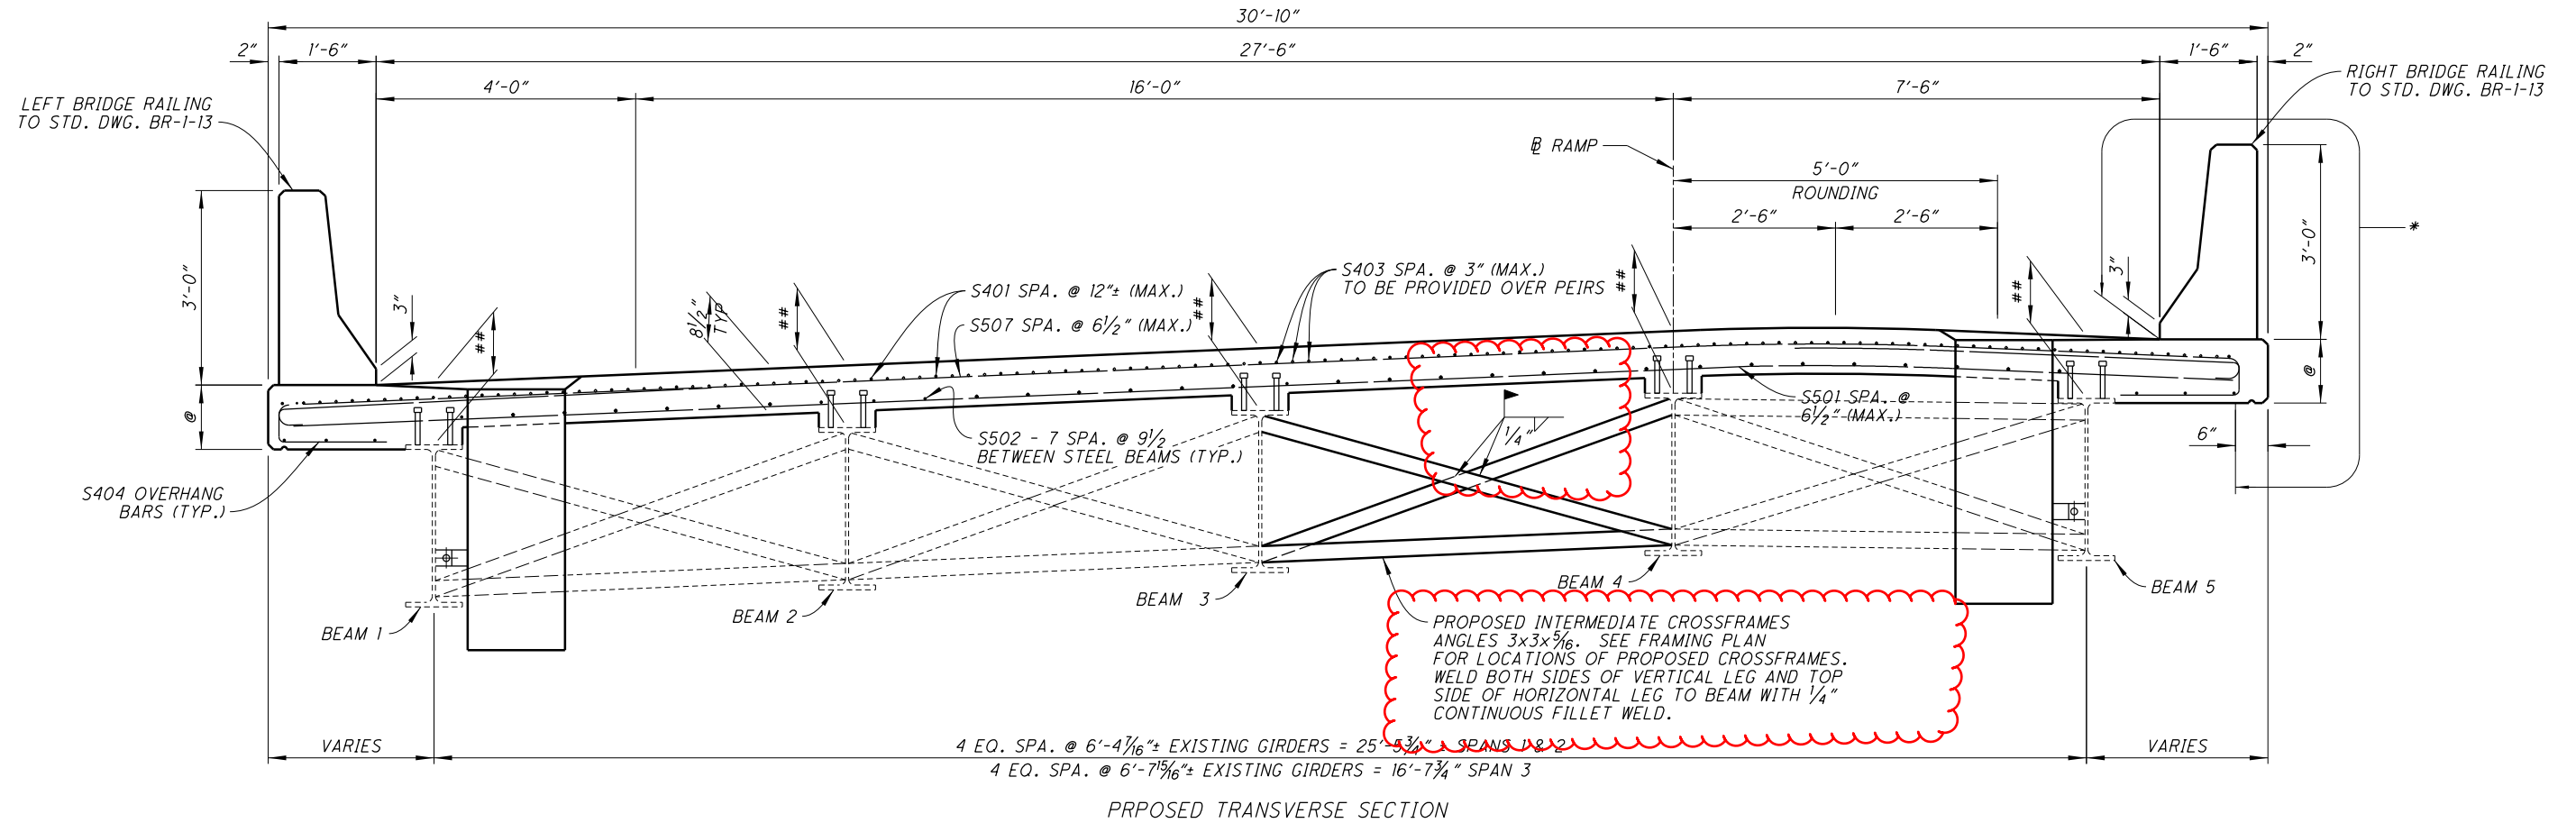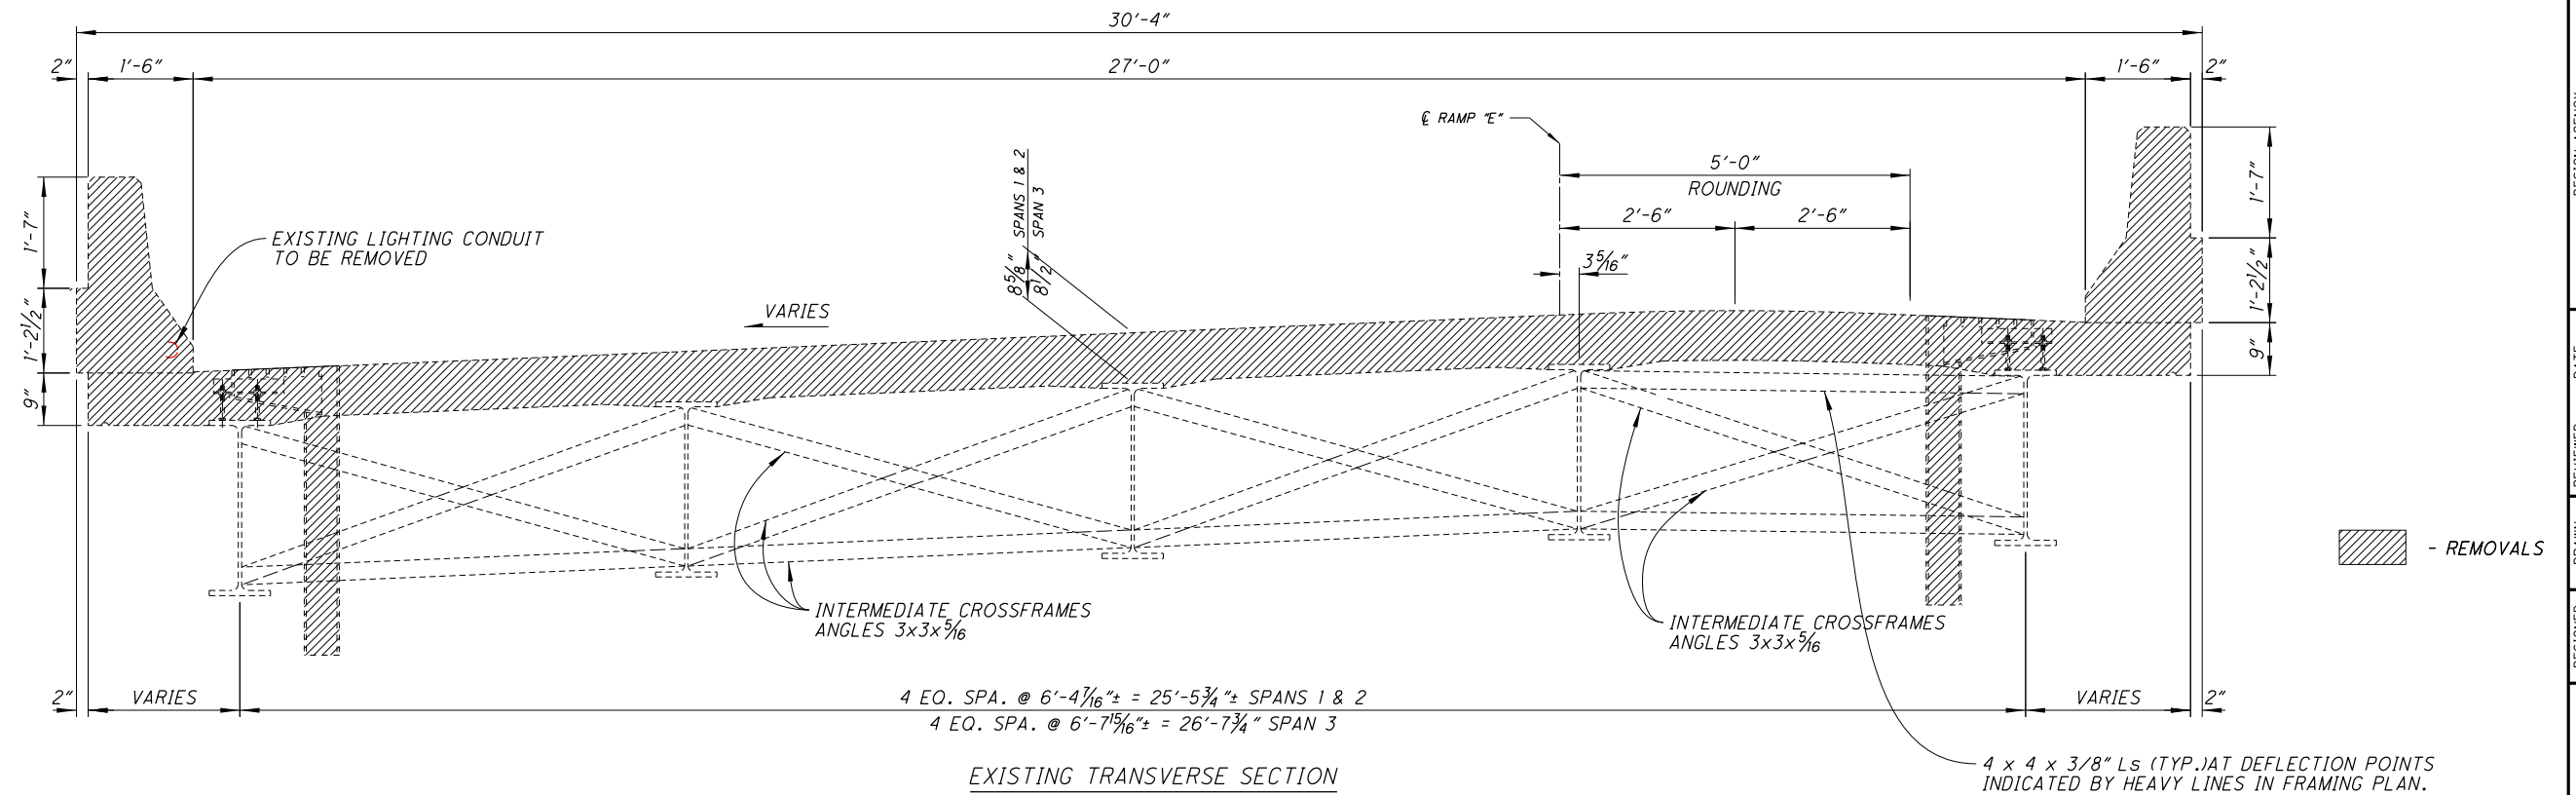

##	BEAM 1	BEAM 2	BEAM 3	BEAM 4	BEAM 5
REAR ABUTMENT	10 1/2"	10 1/2"	10 1/2"	10 1/2"	10 1/2"
PIER 1	11 7/8"	11 7/8"	11 5/8"	10 3/16"	10 11/16"
PIER 2	14 3/8"	13 3/16"	12 3/16"	12 1/16"	11 3/4"
FWD. ABUTMENT	10 1/2"	10 1/2"	10 1/2"	10 1/2"	10 1/2"

@	LT. DECK EDGE	RT. DECK EDGE
REAR ABUTMENT	10 1/2"	10 1/2"
PIER 1	11 1/2"	10 1/2"
PIER 2	13 3/4"	11 5/8"
FWD. ABUTMENT	10 1/2"	10 1/2"

* - SEALING OF CONCRETE SURFACES WITH HMWM AS PER C.M.S. 511.22

DESIGN AGENCY: OHIO DEPARTMENT OF TRANSPORTATION, DISTRICT 5

REVIEWED DATE: 11/27/2020 TAG: 6001890

DESIGNED: YEL CHECKED: TAG

DRAWN: YEL REVISED: .

TRANSVERSE SECTIONS

BRIDGE NO.: MUS-70-1142E

RAMP 'E' OVER MCINTIRE AVE.

MUS-70-10.49

PID No. 93006

23/44

1986

2231

BASIS OF PAYMENT: THE UNIT BID PRICE SHALL INCLUDE ALL MATERIALS (INCLUDING LOAD PLATES, HP SHAPES AND ANCHOR RODS, DOWEL HOLES, LABOR, TESTING AND INCIDENTALS NECESSARY TO FURNISH AND INSTALL LAMINATED ELASTOMERIC BEARINGS, EITHER FIXED OR EXPANSION. PAYMENT WILL BE MADE AT THE CONTRACT PRICE BID FOR ITEM 516, EACH, ELASTOMERIC BEARING WITH INTERNAL LAMINATES AND LOAD PLATE (NEOPRENE) AS PER PLAN.

REAR ABUTMENT BEARING PADS: 10" x 1'-2" x 3.2729" (50 DUROMETER)
TOP STEEL LOAD PLATE: 11" x 1'-3" x 1.50" BEVELED TO 1.875"
BOTTOM STEEL LOAD PLATE: 11" x 1'-3" x 1.50"

PIER 1 BEARING PADS: 1'-3" x 1'-6" x 3.7226" (50 DUROMETER)
TOP STEEL LOAD PLATE: 1'-10" x 2'-1" x 2.625" BEVELED TO 2.9375"

PIER 2 BEARING PADS: 1'-3" x 1'-6" x 3.7226" (50 DUROMETER)
TOP STEEL LOAD PLATE: 1'-4" x 1'-7" x 3.625"

FORWARD ABUTMENT BEARING PADS: 10" x 1'-2" x 3.2729" (50 DUROMETER)
TOP STEEL LOAD PLATE: 11" x 1'-3" x 1.50"
BOTTOM STEEL LOAD PLATE: 1'-1" x 1'-5" x 1.50"

ALL H-PILES: HP10x57

ELASTOMERIC BEARING PAD DESIGN DATA			
LOCATION	DL (K)	LL (K)	DL & LL (K)
REAR ABUTMENT	53	47	100
PIER 1	100	94	194
PIER 2	100	94	194
FWD. ABUTMENT	52	48	100


LOAD PLATE:
 THE STEEL LOAD PLATES SHALL BE MADE OF A709 STEEL. THE STEEL LOAD PLATE SHALL BE BONDED BY VULCANIZATION TO THE ELASTOMER DURING THE MOLDING PROCESS. ADDITIONAL UPPER LOAD PLATES AT THE ABUTMENTS AND ALL HP STEEL SHAPES SHALL BE INCLUDED WITH ITEM 516 FOR PAYMENT. FOR ADDITIONAL DETAILS, SEE STD DWG SICD-1-96.

WELDING:
 CONTROL WELDING SO THAT THE PLATE TEMPERATURE AT THE ELASTOMER BONDED SURFACE DOES NOT EXCEED 300 DEGREES F AS DETERMINED BY USE OF PYROMETRIC STICKS OR OTHER TEMPERATURE MONITORING DEVICES.

BEARING REPOSITIONING:
 IF THE GIRDERS ARE ERECTED AT AN AMBIENT TEMPERATURE HIGHER THAN 80 DEGREES F OR LOWER THAN 40 DEGREES F AND THE BEARING SHEAR DEFLECTION EXCEEDS 1/6 OF THE BEARING HEIGHT AT 60 DEGREES F (+/-) 10 DEGREES F, RAISE THE BEAMS OR GIRDERS TO ALLOW THE BEARINGS TO RETURN TO THEIR UNDEFORMED SHAPE AT 60 DEGREES F (+/-) 10 DEGREES F.


ELASTOMERIC BEARINGS:
 THE ELASTOMER SHALL HAVE A HARDNESS OF 50 DUROMETER. THE BEARINGS WERE DESIGNED IN ACCORDANCE WITH SECTION 14.7.5 (METHOD A) OF THE AASHTO LRFD BRIDGE DESIGN SPECIFICATIONS. PERFORM THE LONG-TERM COMPRESSION PROOF LOAD TEST IN ACCORDANCE WITH THE AASHTO STANDARD SPECIFICATIONS FOR HIGHWAY BRIDGES, DIVISION II, SECTION 18.7.2.6 AND 18.7.4.5.

MARKINGS:
 ALL BEARINGS AND LOAD PLATES SHALL BE MARKED PRIOR TO SHIPPING. THE MARKS SHALL INCLUDE THE BEARING LOCATION ON THE BRIDGE AND A DIRECTION ARROW THAT POINTS UP-STATION. ALL MARKS SHALL BE PERMANENT AND VISIBLE AFTER THE BEARING IS INSTALLED.

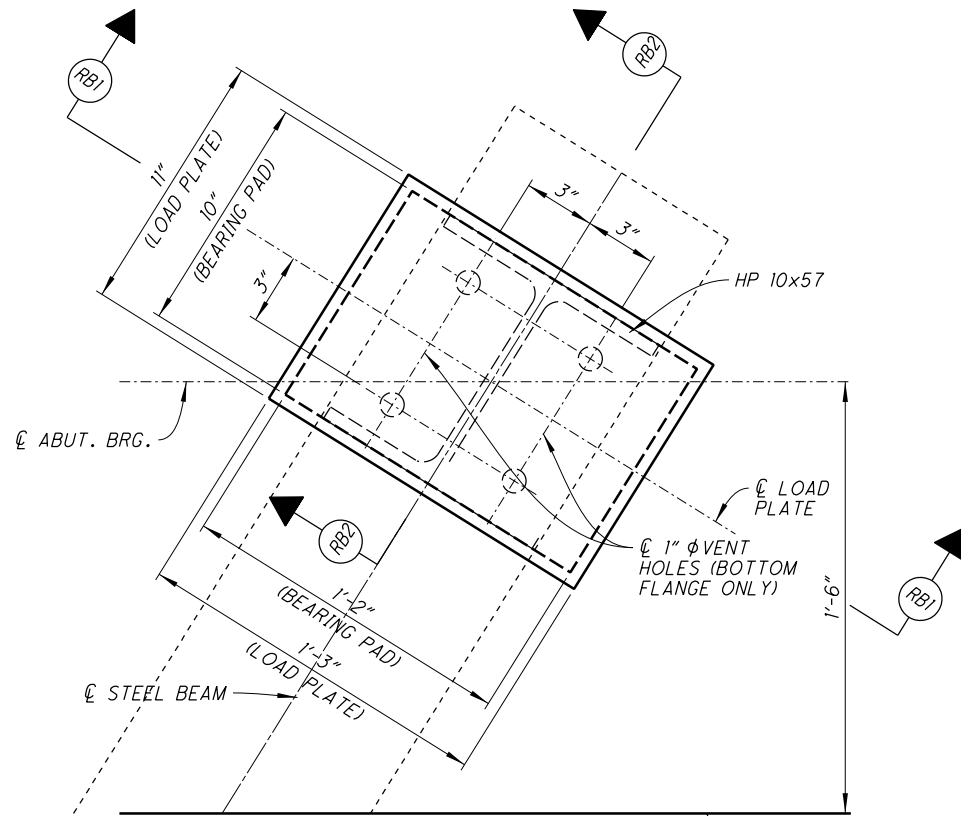


REAR ABUTMENT PLAN

FACE OF ABUTMENT

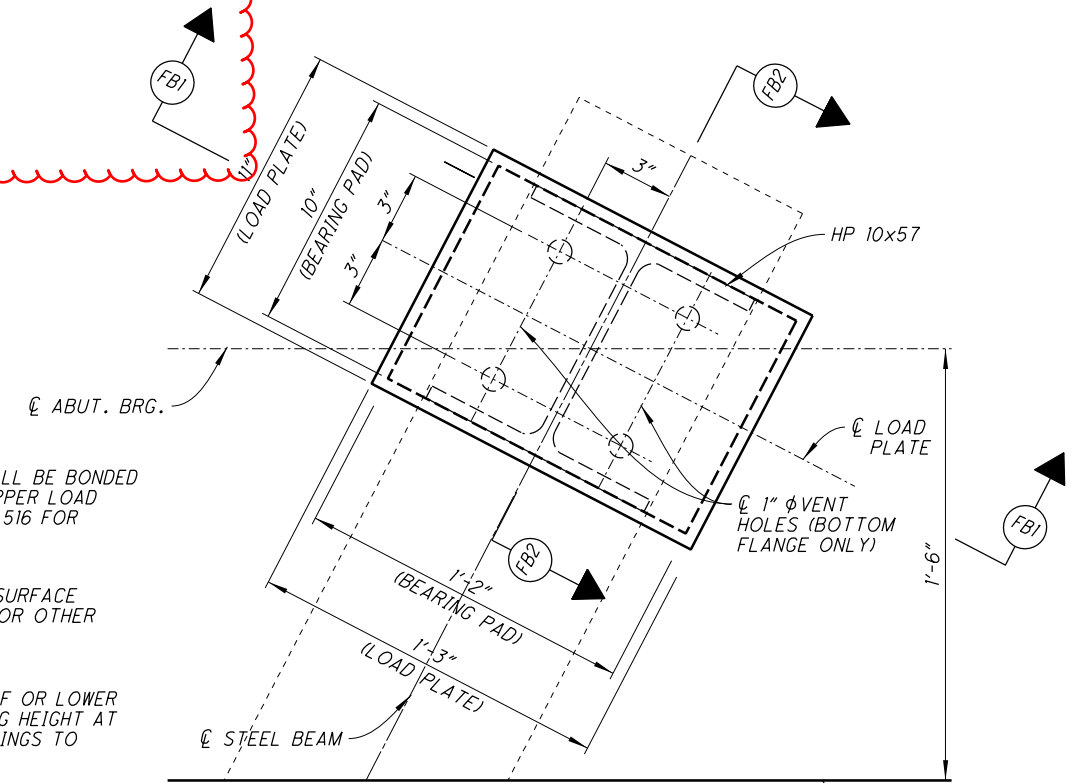


FORWARD ABUTMENT PLAN


FACE OF ABUTMENT

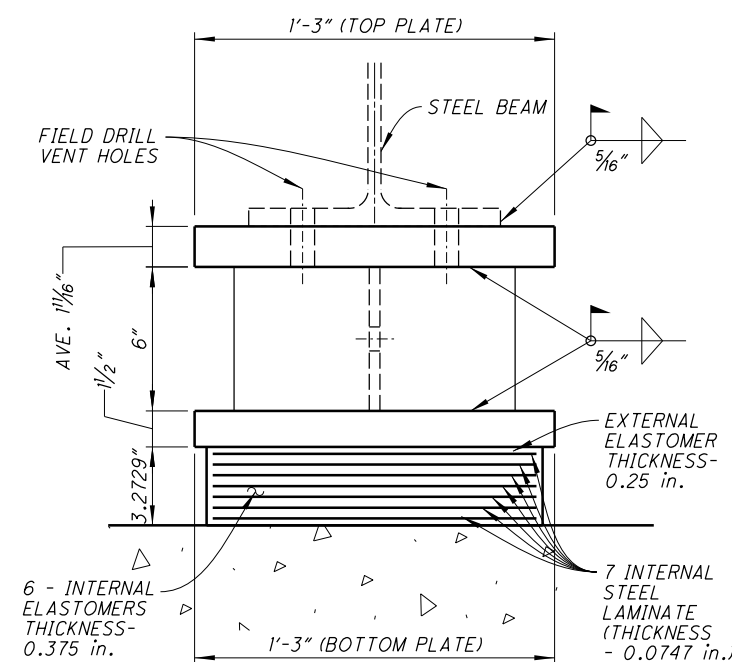


SECTION RB1-RB1

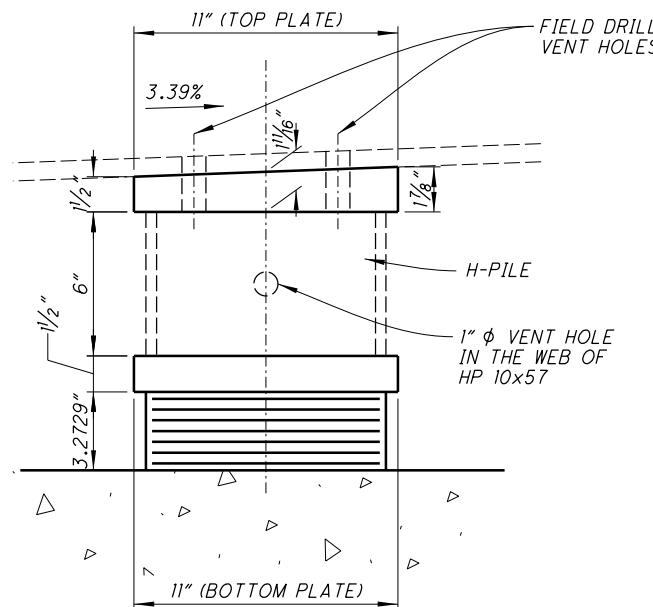

SECTION RB2-RB2

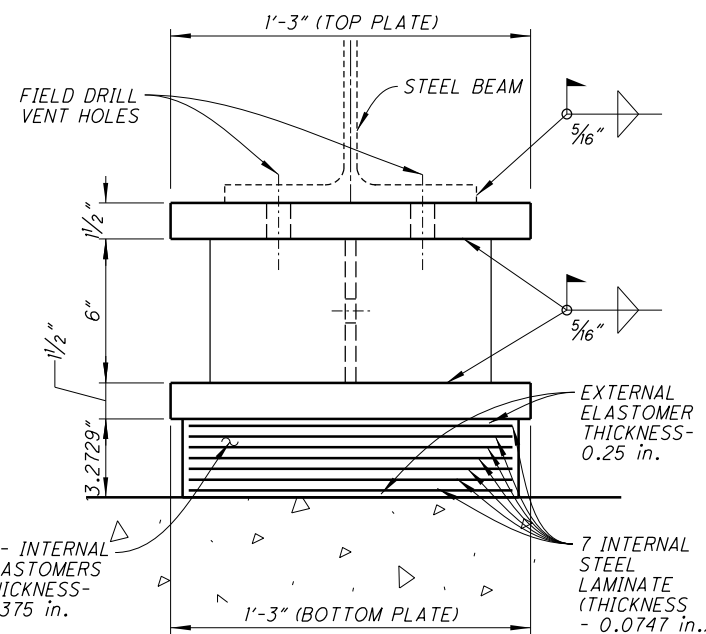


SECTION FB1-FB1

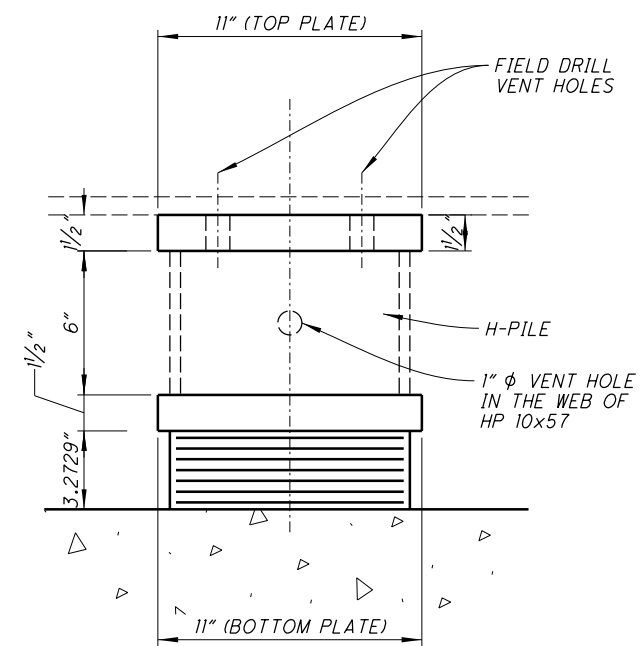

SECTION FB2-FB2

DESIGN AGENCY: OHIO DEPARTMENT OF TRANSPORTATION, DISTRICT 5
 DATE: 11/27/2020
 TAG: 6001890
 STRUCTURE FILE NUMBER: 6001890
 DRAWN: YEL
 CHECKED: YEL
 TAG: YEL
 REVISIONS: .
 BRIDGE NO.: MUS-70-1142E
 RAMP 'E' OVER MCINTIRE AVE.
 PID No. 93006
 29/44
 1992
 2231

I:\ProjectData\MUS-93006\400-Engineering\Structures\SFN_600890\Sheets\070_1145P_SM001.dgn Sheet 4/9/2021 10:07:47 AM tgreenwa

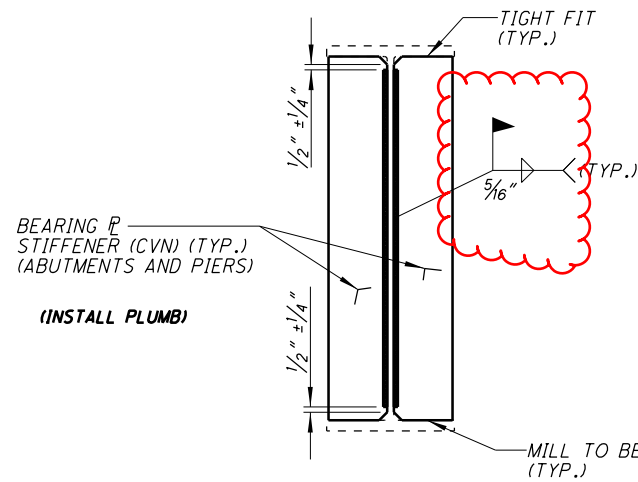



NOTE:
FOR NOTES AND ADDITIONAL
DETAILS INCLUDING WELDING
DETAILS SEE STD. DWG. GSD-1-96.

ALL PROPOSED BEARING STIFFENER
HEIGHTS SHALL BE FIELD MEASURED
AND VERIFIED BY THE CONTRACTOR
PRIOR TO FABRICATION (TYPICAL)

BEARING STIFFENERS DETAILS

ITEM 513 STRUCTURAL STEEL MEMBERS, LEVEL UF, AS PER PLAN		
STIFFENER \bar{L}	NUMBER	POUNDS
4.5" x 0.625" x 29.8"	40	951
4.5" x 0.625" x 30"	40	957
4.5" x 0.625" x 30.4"	40	970
TOTAL		2878

FINAL QUANTITIES FOR ITEM 513 STRUCTURAL
STEEL MEMBERS, LEVEL UF, AS PER PLAN SHALL
BE DETERMINED IN THE FIELD.

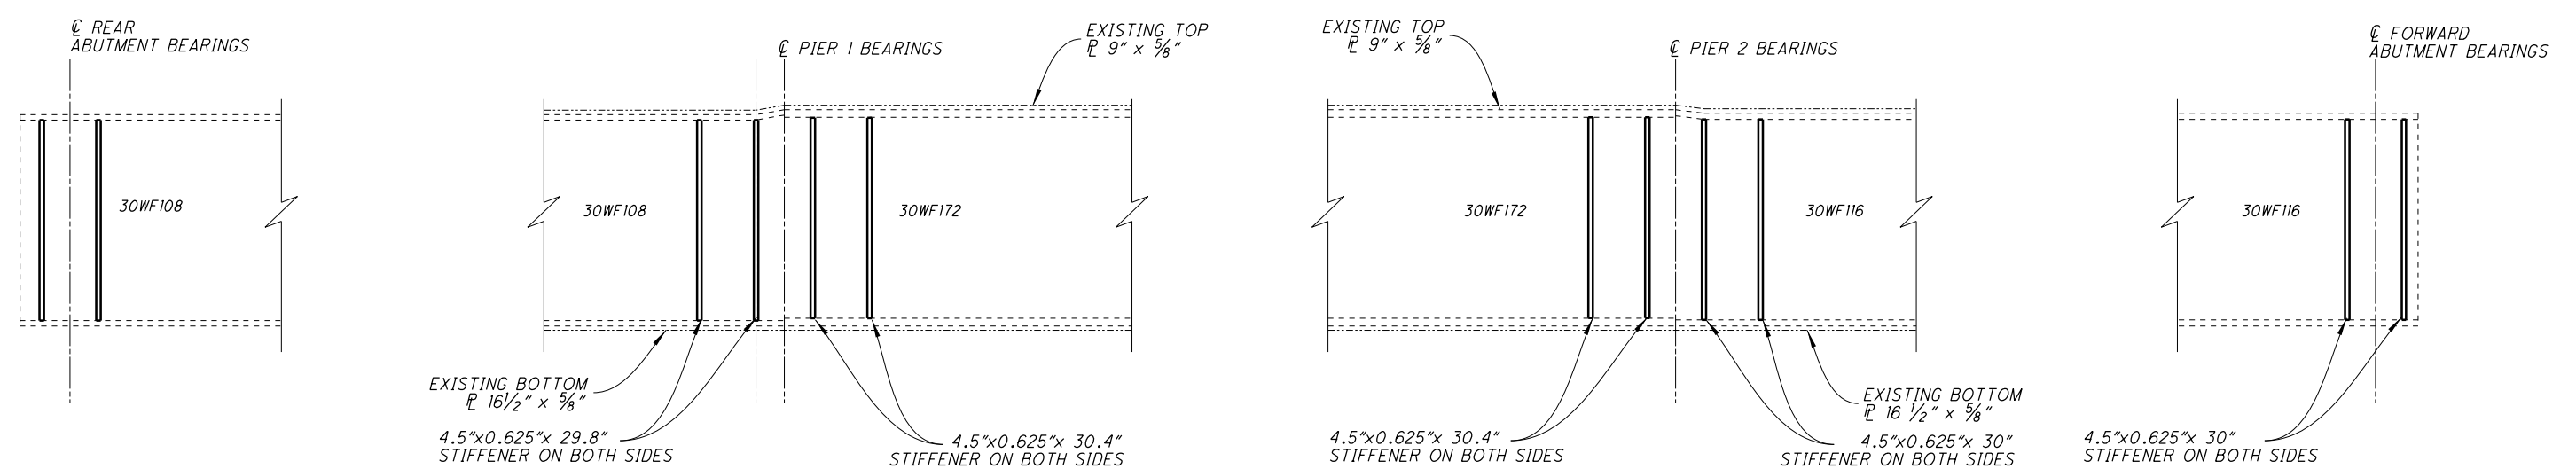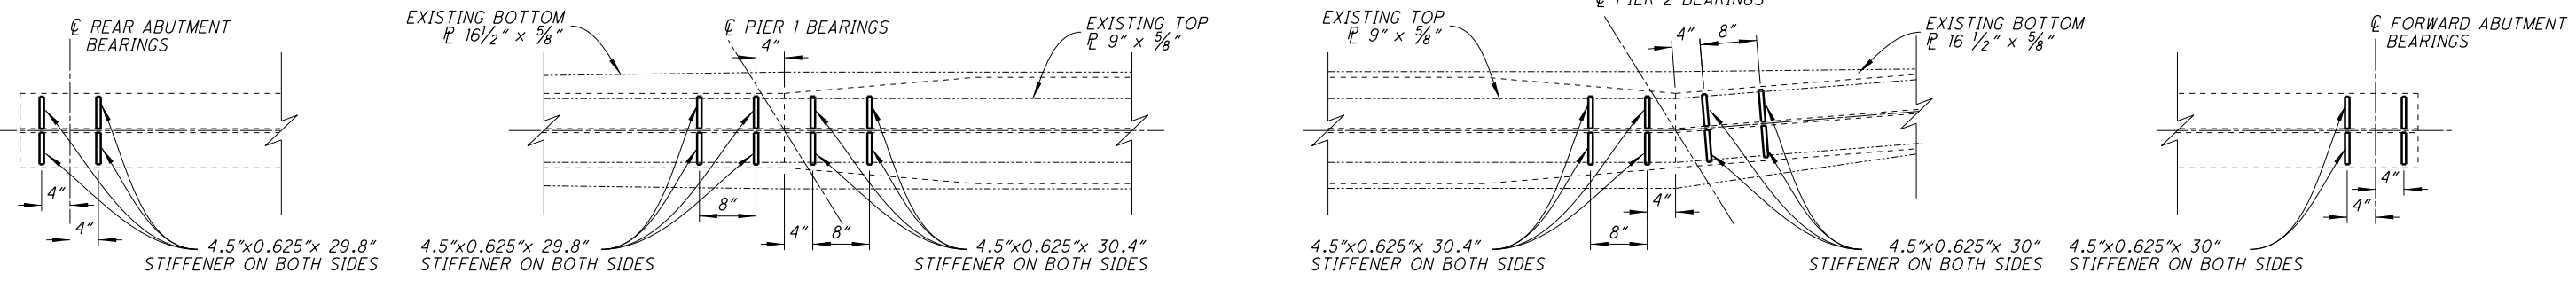

PROPOSED BEARING STIFFENERS LOCATIONS