


EDGE LINE DATA												
LOCATION	COUNTY	ROUTE	S.L.M.		TOTAL LENGTH (MILES)	INFORMATION ONLY			642	644	646	REMARKS
			FROM	TO		EDGE LINE QUANTITIES			REMOVAL OF PAVEMENT MARKING	EDGE LINE, 6"	EDGE LINE, 6"	
						TOTAL MILES	ROADWAY MILES	BRIDGE MILES				
1A	PER	S.R. 93	0.00	1.04	1.04	2.08	2.08					
			2.16	5.90	3.74	7.40	7.32	0.08	0.08	7.32	0.08	EX. FAST DRY, PR. EPOXY ON BRIDGES PER-93-0500,0516
			11.50	12.08	0.58	1.16	1.16			1.16		
LOCATION 1A TOTALS (CARRIED TO SUB-SUMMARY)									0.08	10.56	0.08	
1B	PER	S.R. 93	5.90	11.50	5.60	11.20	11.20					
			LOCATION 1B TOTALS (CARRIED TO SUB-SUMMARY)									11.20

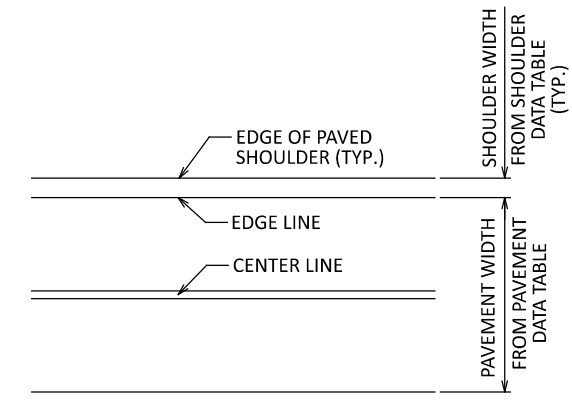

WIDTHS CALCULATED FROM CENTER OF MARKING AND SHALL NOT BE PLACED CLOSER THAN 6" FROM EDGE OF PAVEMENT WHEN NO SHOULDER IS PRESENT

LONG LINE MARKING DATA

CENTER LINE DATA															
LOCATION	COUNTY	ROUTE	S.L.M.		TOTAL LENGTH (MILES)	INFORMATION ONLY				618	642	644	646	REMARKS	
			FROM	TO		CENTER LINE QUANTITIES				*RUMBLE STRIPES, CENTER LINE (ASPHALT CONCRETE)	REMOVAL OF PAVEMENT MARKING	CENTER LINE	CENTER LINE		REMOVAL OF PAVEMENT MARKING
						TOTAL MILES	ROADWAY MILES	BRIDGE MILES	EQUIVALENT SOLID LINE						
1A	PER	S.R. 93	0.00	1.04	1.04	1.04	1.04		2.08						
			2.16	3.90	1.74	1.74	1.74		3.28						
			3.90	5.90	2.00	2.00	1.96	0.04	3.27	1.96	0.04	1.96	0.04		EX. FAST DRY, PR. EPOXY ON BRIDGES PER-93-0500,0516
			11.50	12.57	1.07	1.07	1.06	0.01	2.14			1.06	0.01	0.01	EPOXY ON BRIDGE PER-93-1232
SIDE ROADS											0.01				DUTCH RIDGE, AIRPORT
LOCATION 1A TOTALS (CARRIED TO SUB-SUMMARY)									1.96	0.04	5.81	0.05	0.01		
1B	PER	S.R. 93	5.90	11.50	5.60	5.60	5.60		9.68	5.60					
			SIDE ROADS											0.02	
LOCATION 1B TOTALS (CARRIED TO SUB-SUMMARY)									5.60		5.62				

LOCATION 1A TOTALS										ITEM	ITEM EXT.	TOTAL	UNIT	DESCRIPTION	
3	4		11	12	13	14	16	17	19						
															ROADWAY
					2,675					202	23500	2,675	SY	WEARING COURSE REMOVED	
9.56										209	60500	9.56	MILE	LINEAR GRADING	
				10.67						209	72051	10.67	MILE	PREPARING SUBGRADE FOR SHOULDER PAVING, AS PER PLAN	
															DRAINAGE
	8									611	98630	8	EACH	CATCH BASIN ADJUSTED TO GRADE	
	8									611	99654	8	EACH	MANHOLE ADJUSTED TO GRADE	
	2									638	10800	2	EACH	VALVE BOX ADJUSTED TO GRADE	
															PAVEMENT
500										253	02000	500	CY	PAVEMENT REPAIR	
	860		72,213	4,070		3,312				254	01000	80,455	SY	PAVEMENT PLANING, ASPHALT CONCRETE, 1.50"	
			7,395							254	01000	7,395	SY	PAVEMENT PLANING, ASPHALT CONCRETE, 3.00"	
			7,167	326	215	265				407	20000	7,973	GAL	NON-TRACKING TACK COAT	
				4,995						408	10001	4,995	GAL	PRIME COAT, AS PER PLAN	
	37		3,236	170		138				441	10100	3,581	CY	ASPHALT CONCRETE SURFACE COURSE, TYPE 1, (446), PG70-22M	
			757							441	10200	757	CY	ASPHALT CONCRETE INTERMEDIATE COURSE, TYPE 2, (446)	
					91					441	70000	91	CY	ASPHALT CONCRETE SURFACE COURSE, TYPE 1, (449), PG64-22	
						213				516	31011	213	FT	2" DEEP JOINT SEALER, AS PER PLAN (A)	
				694						617	10101	694	CY	COMPACTED AGGREGATE, AS PER PLAN	
							1.96			618	43000	1.96	MILE	RUMBLE STRIPES, CENTER LINE (ASPHALT CONCRETE)	
	2.00									874	21000	2.00	MILE	LONGITUDINAL JOINT PREPARATION	
															TRAFFIC CONTROL
									480	621	00100	480	EACH	RPM	
									480	621	54000	480	EACH	RAISED PAVEMENT MARKER REMOVED	
	2									632	26501	2	EACH	DETECTOR LOOP, AS PER PLAN	
							0.12			642	30030	0.12	MILE	REMOVAL OF PAVEMENT MARKING	
							10.56			644	00104	10.56	MILE	EDGE LINE, 6"	
							5.81			644	00300	5.81	MILE	CENTER LINE	
								70		644	00400	70	FT	CHANNELIZING LINE, 8"	
								396		644	00500	396	FT	STOP LINE	
								169		644	00620	169	FT	CROSSWALK LINE, 12"	
								2		644	01000	2	EACH	RAILROAD SYMBOL MARKING	
								2		644	01300	2	EACH	LANE ARROW	



LOCATION TOTALS		PLAN SPLITS		ITEM	ITEM EXT.	GRAND TOTAL	UNIT	DESCRIPTION	SEE SHEET
1A	1B	01/STR/05	02/STR/04						
PAVEMENT (CONT'D)									
3,581	3,381	3,581	3,381	441	10100	6,962	CY	ASPHALT CONCRETE SURFACE COURSE, TYPE 1, (446), PG70-22M	
757	4,582	757	4,582	441	10200	5,339	CY	ASPHALT CONCRETE INTERMEDIATE COURSE, TYPE 2, (446)	
91	27	91	27	441	70000	118	CY	ASPHALT CONCRETE SURFACE COURSE, TYPE 1, (449), PG64-22	
	180		180	512	33010	180	SY	TYPE 3 WATERPROOFING	
213	112	213	112	516	31011	325	FT	2" DEEP JOINT SEALER, AS PER PLAN (A)	3
694	1,093	694	1,093	617	10101	1,787	CY	COMPACTED AGGREGATE, AS PER PLAN	
1.96	5.60	1.96	5.60	618	43000	7.56	MILE	RUMBLE STRIPES, CENTER LINE (ASPHALT CONCRETE)	
	32,534		32,534	SPECIAL	69012050	32,534	SY	REINFORCED MESH FOR TRANSVERSE AND/OR LONGITUDINAL JOINTS AND CRACKS	4
2.00	5.60	2.00	5.60	874	21000	7.60	MILE	LONGITUDINAL JOINT PREPARATION	
TRAFFIC CONTROL									
480	417	480	417	621	00100	897	EACH	RPM	
480	417	480	417	621	54000	897	EACH	RAISED PAVEMENT MARKER REMOVED	
	174		174	626	00110	174	EACH	BARRIER REFLECTOR, TYPE 2 (BIDIRECTIONAL)	
2		2		632	26501	2	EACH	DETECTOR LOOP, AS PER PLAN	
	112.5		112.5	630	03100	112.5	FT	GROUND MOUNTED SUPPORT, NO. 3 POST	
	42.9		42.9	630	80100	42.9	SF	SIGN, FLAT SHEET	
	10		10	630	84900	10	EACH	REMOVAL OF GROUND MOUNTED SIGN AND DISPOSAL	
	10		10	630	86002	10	EACH	REMOVAL OF GROUND MOUNTED POST SUPPORT AND DISPOSAL	
0.12		0.12		642	30030	0.12	MILE	REMOVAL OF PAVEMENT MARKING	
10.56	11.20	10.56	11.20	644	00104	21.76	MILE	EDGE LINE, 6"	
5.81	5.62	5.81	5.62	644	00300	11.43	MILE	CENTER LINE	
70		70		644	00400	70	FT	CHANNELIZING LINE, 8"	
396	120	396	120	644	00500	516	FT	STOP LINE	
169		169		644	00620	169	FT	CROSSWALK LINE, 12"	
2		2		644	01000	2	EACH	RAILROAD SYMBOL MARKING	
2		2		644	01300	2	EACH	LANE ARROW	
0.08		0.08		646	10010	0.08	MILE	EDGE LINE, 6"	
0.05		0.05		646	10200	0.05	MILE	CENTER LINE	
12		12		646	50100	12	FT	REMOVAL OF PAVEMENT MARKING	
0.01		0.01		646	50300	0.01	MILE	REMOVAL OF PAVEMENT MARKING	
2		2		647	20212	2	EACH	HANDICAP SYMBOL MARKING, TYPE B125	
25		25		647	20512	25	FT	PARKING LOT STALL MARKING, TYPE B125	

DESIGN AGENCY



DESIGNER

RMA

REVIEWER

JSL 09/01/23

PROJECT ID

102709

SHEET TOTAL

25 | 44