


PW = PAVEMENT WIDTH
PS = PAVED SHOULDER
AS = AGGREGATE SHOULDER

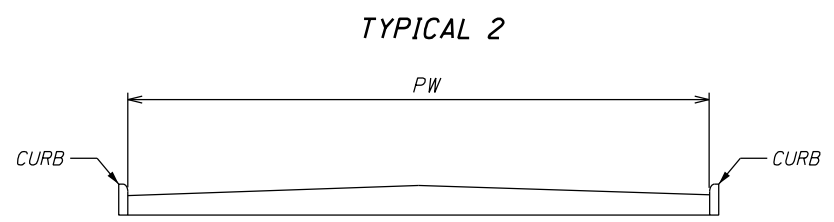

SHOULDER DATA


LOCATION	COUNTY	ROUTE	BEGIN LOG POINT SLM	END LOG POINT SLM	LENGTH		TYPICAL	PAVED SHOULDER WIDTH (FEET)		SHOULDER AREA	897	407	408	424		617	
								(WIDTHS ARE AVERAGE THROUGHOUT SECTION)			PAVEMENT PLANING, ASPHALT CONCRETE, CLASS A, 1.00"	NON-TRACKING TACK COAT (@ 0.08 Gal/SY)	PRIME COAT, AS PER PLAN	THICKNESS	FINE GRADED POLYMER ASPHALT CONCRETE, TYPE B	THICKNESS	COMPACTED AGGREGATE, AS PER PLAN (2' WIDTH)
								A	B								
MILES	LIN. FT.	SQ. YD.	SQ. YD.	GAL.	GAL.	INCH	CU. YD.	INCH	CU. YD.								
1	PER	S.R.37	0.00	2.86	2.86	15,100.80	1	1.5	1.5	5,033.60	33.3*	402.7	2,684.6	1.00	139.9	2.00	372.9
			2.86	3.26	0.40	2,112.00	1	1.5	1.5	704.00	704.0	56.4	375.5	1.00	19.6	2.00	52.1
			3.26	3.54	0.28	1,478.40	1	11.5	4.5	2,628.27	2,628.3	210.3	262.9	1.00	73.1	2.00	36.5
			3.54	4.00	0.46	2,428.80	2										
			4.00	4.23	0.23	1,214.40	1	1.5	1.5	404.80	404.8	32.4	215.9	1.00	11.3	2.00	30.0
			4.23	8.10	3.87	20,433.60	1	1.5	1.5	6,811.20		544.9	3,632.7	1.00	189.2	2.00	504.5
			8.10	8.59	0.49	2,587.20	1	1.5	1.5	862.40	862.4	69.0	460.0	1.00	24.0	2.00	63.9
BRIDGE DEDUCTIONS										(138.4)		(11.0)	(73.9)	1.00	(3.8)	2.00	(10.3)
LOCATION 1 TOTALS (CARRIED TO GENERAL SUMMARY)											4,633	1,305	7,558		454		1,050

I:\ProjectData\PER\95988\Roadway\Design\Sheets\95988_00002.dgn_Sheet_8/5/2021 5:26:43 PM jltzj

I:\ProjectData\PER\95988\Design\Roadway\Sheets\95988_I0002.dgn_Sheet 7/20/2021 10:34 AM jutzl

EDGE LINE DATA											
LOCATION	COUNTY	ROUTE	SLM		LENGTH	INFORMATION ONLY			644	646	COMMENTS
						WHITE EDGE LINE QUANTITIES			EDGE LINE, 6"	EDGE LINE, 6"	
			FROM	TO	MILE	TOTAL MILES	ROADWAY MILES	BRIDGE MILES			
1	PER	S.R.37	0.00	3.54	3.54	7.08	7.08		7.08		
			3.54	4.00	0.46	NO EDGE LINES (CURB SECTION)					
			4.00	8.59	4.59	9.18	9.17	0.01	9.17	0.02	EPOXY ON STRUCTURE PER-37-0628
									0.04		ADDITIONAL FOR SIDE ROADS
LOCATION 1 TOTALS (CARRIED TO GENERAL SUMMARY)									16.29	0.02	

CENTER LINE DATA										
LOCATION	COUNTY	ROUTE	SLM		LENGTH	INFORMATION ONLY		644	646	COMMENTS
						CENTER LINE QUANTITIES		CENTER LINE	CENTER LINE	
			FROM	TO	MILE	TOTAL MILES	EQUIVALENT SOLID LINE			
1	PER	S.R. 37	0.00	8.59	8.59	8.59	11.84	8.58	0.01	EPOXY ON STRUCTURE PER-37-0628
								0.02		ADDITIONAL FOR SIDE ROADS
LOCATION 1 TOTALS (CARRIED TO GENERAL SUMMARY)								8.60	0.01	

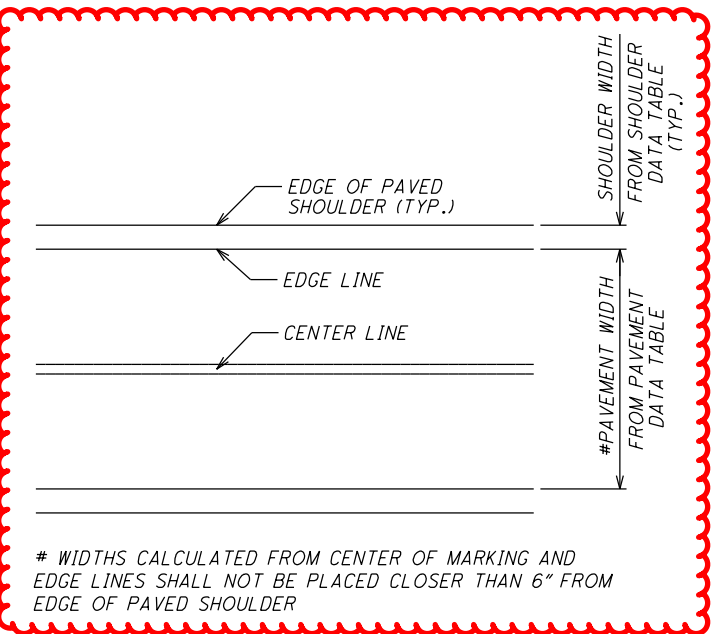

CALCULATED
PTB
CHECKED
JSL

PAVEMENT MARKING DATA (LONG LINE)

PER-37-0.00