
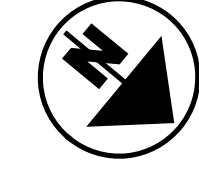
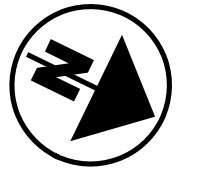
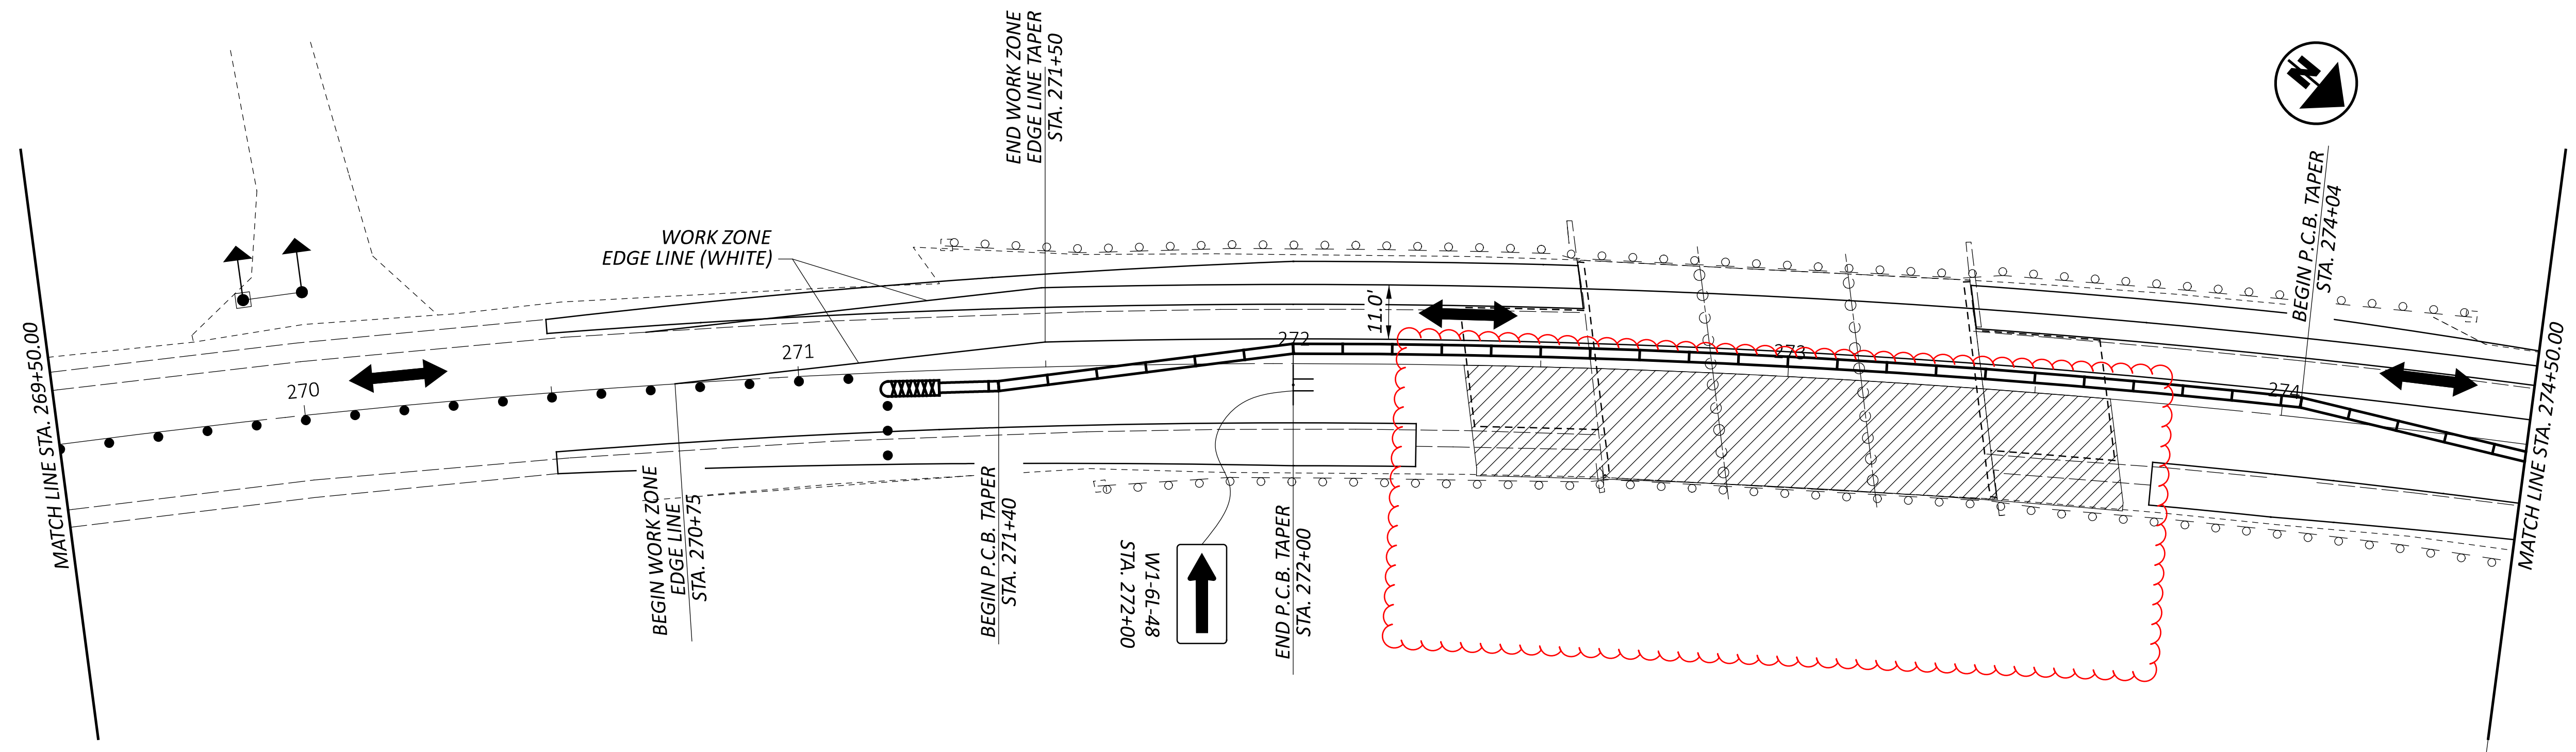


LEGEND

| | | | | | |
|--|------------------------|--|-----------------------------|--|---------------------|
| | - DRUMS / CONES | | - WORK AREA | | - IMPACT ATTENUATOR |
| | - DIRECTION OF TRAFFIC | | - PORTABLE CONCRETE BARRIER | | - TEMPORARY SIGNAL |

SEE SHEET 32/127 FOR SIGNAL TIMING DIAGRAM

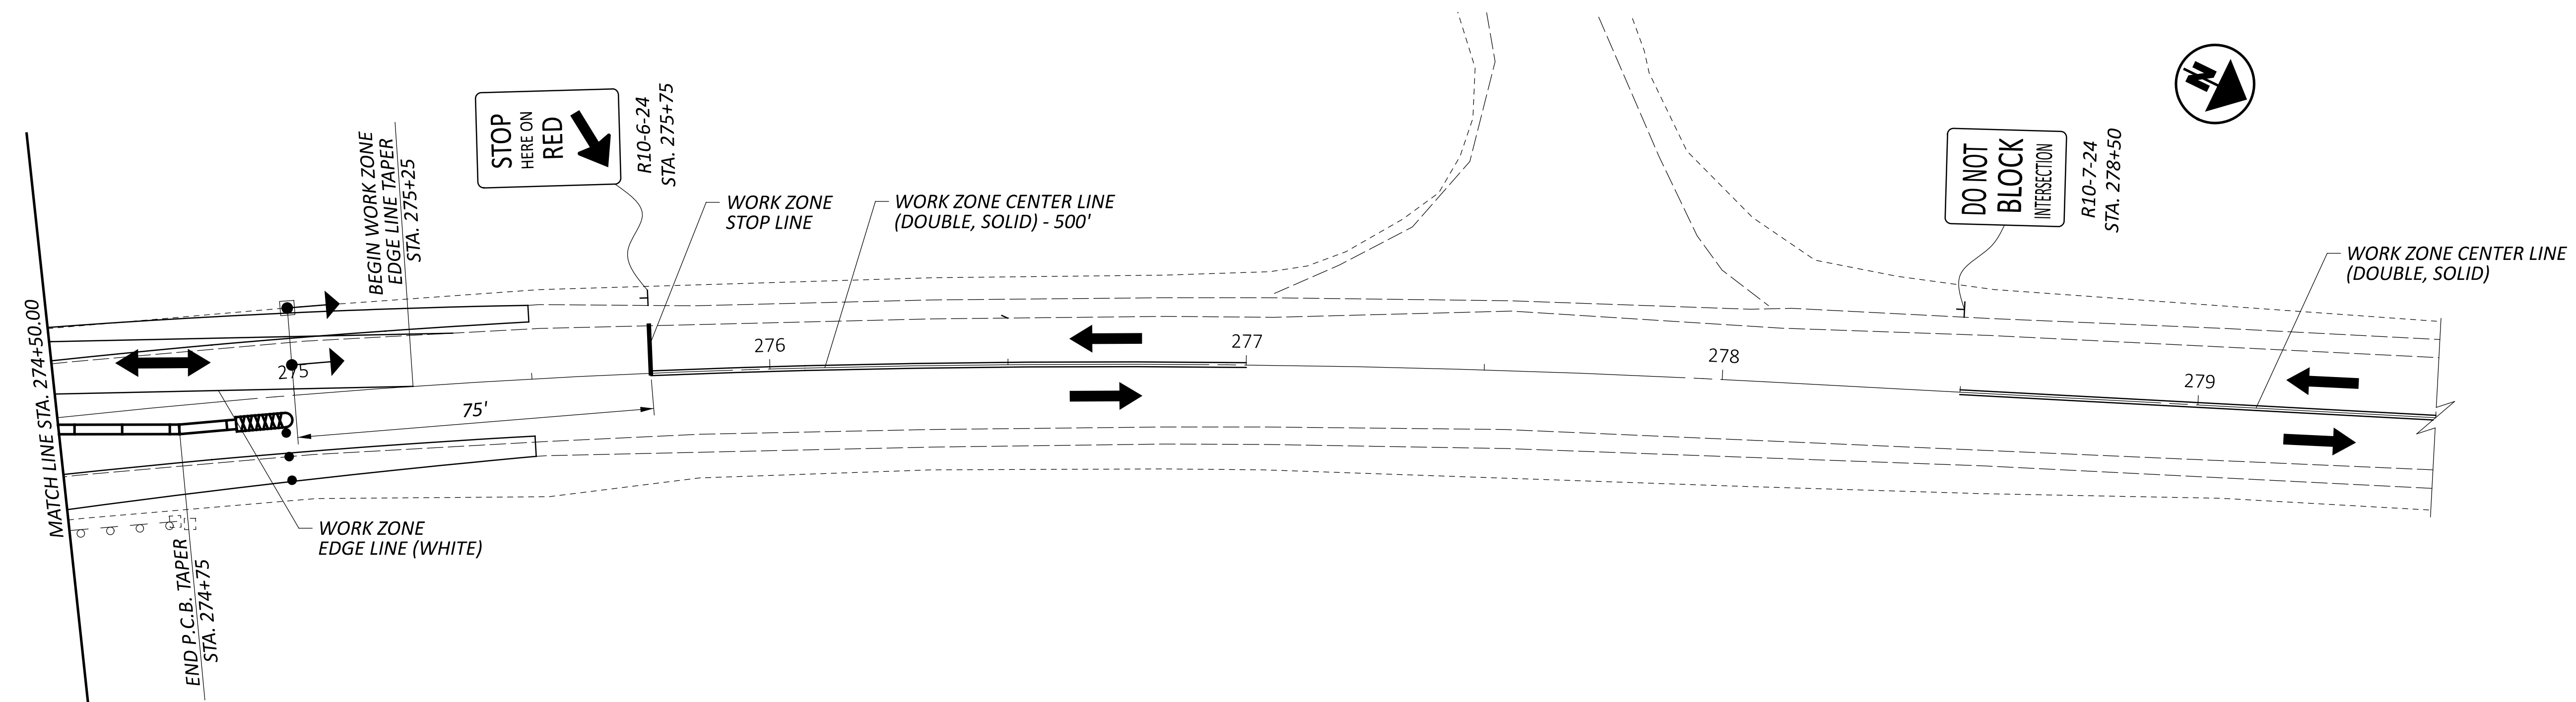

DESIGN AGENCY



DESIGNER

TDF

REVIEWER

TAG 09/26/23


PROJECT ID




96323

SHEET TOTAL

P.28 127

MAINTENANCE OF TRAFFIC (PHASE 1)
 STA. 269+50 TO STA. 279+50

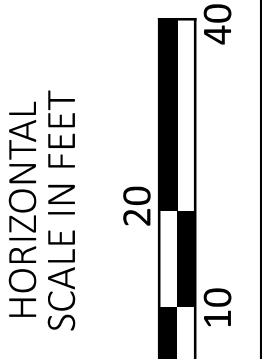


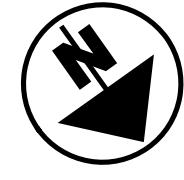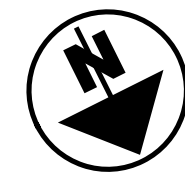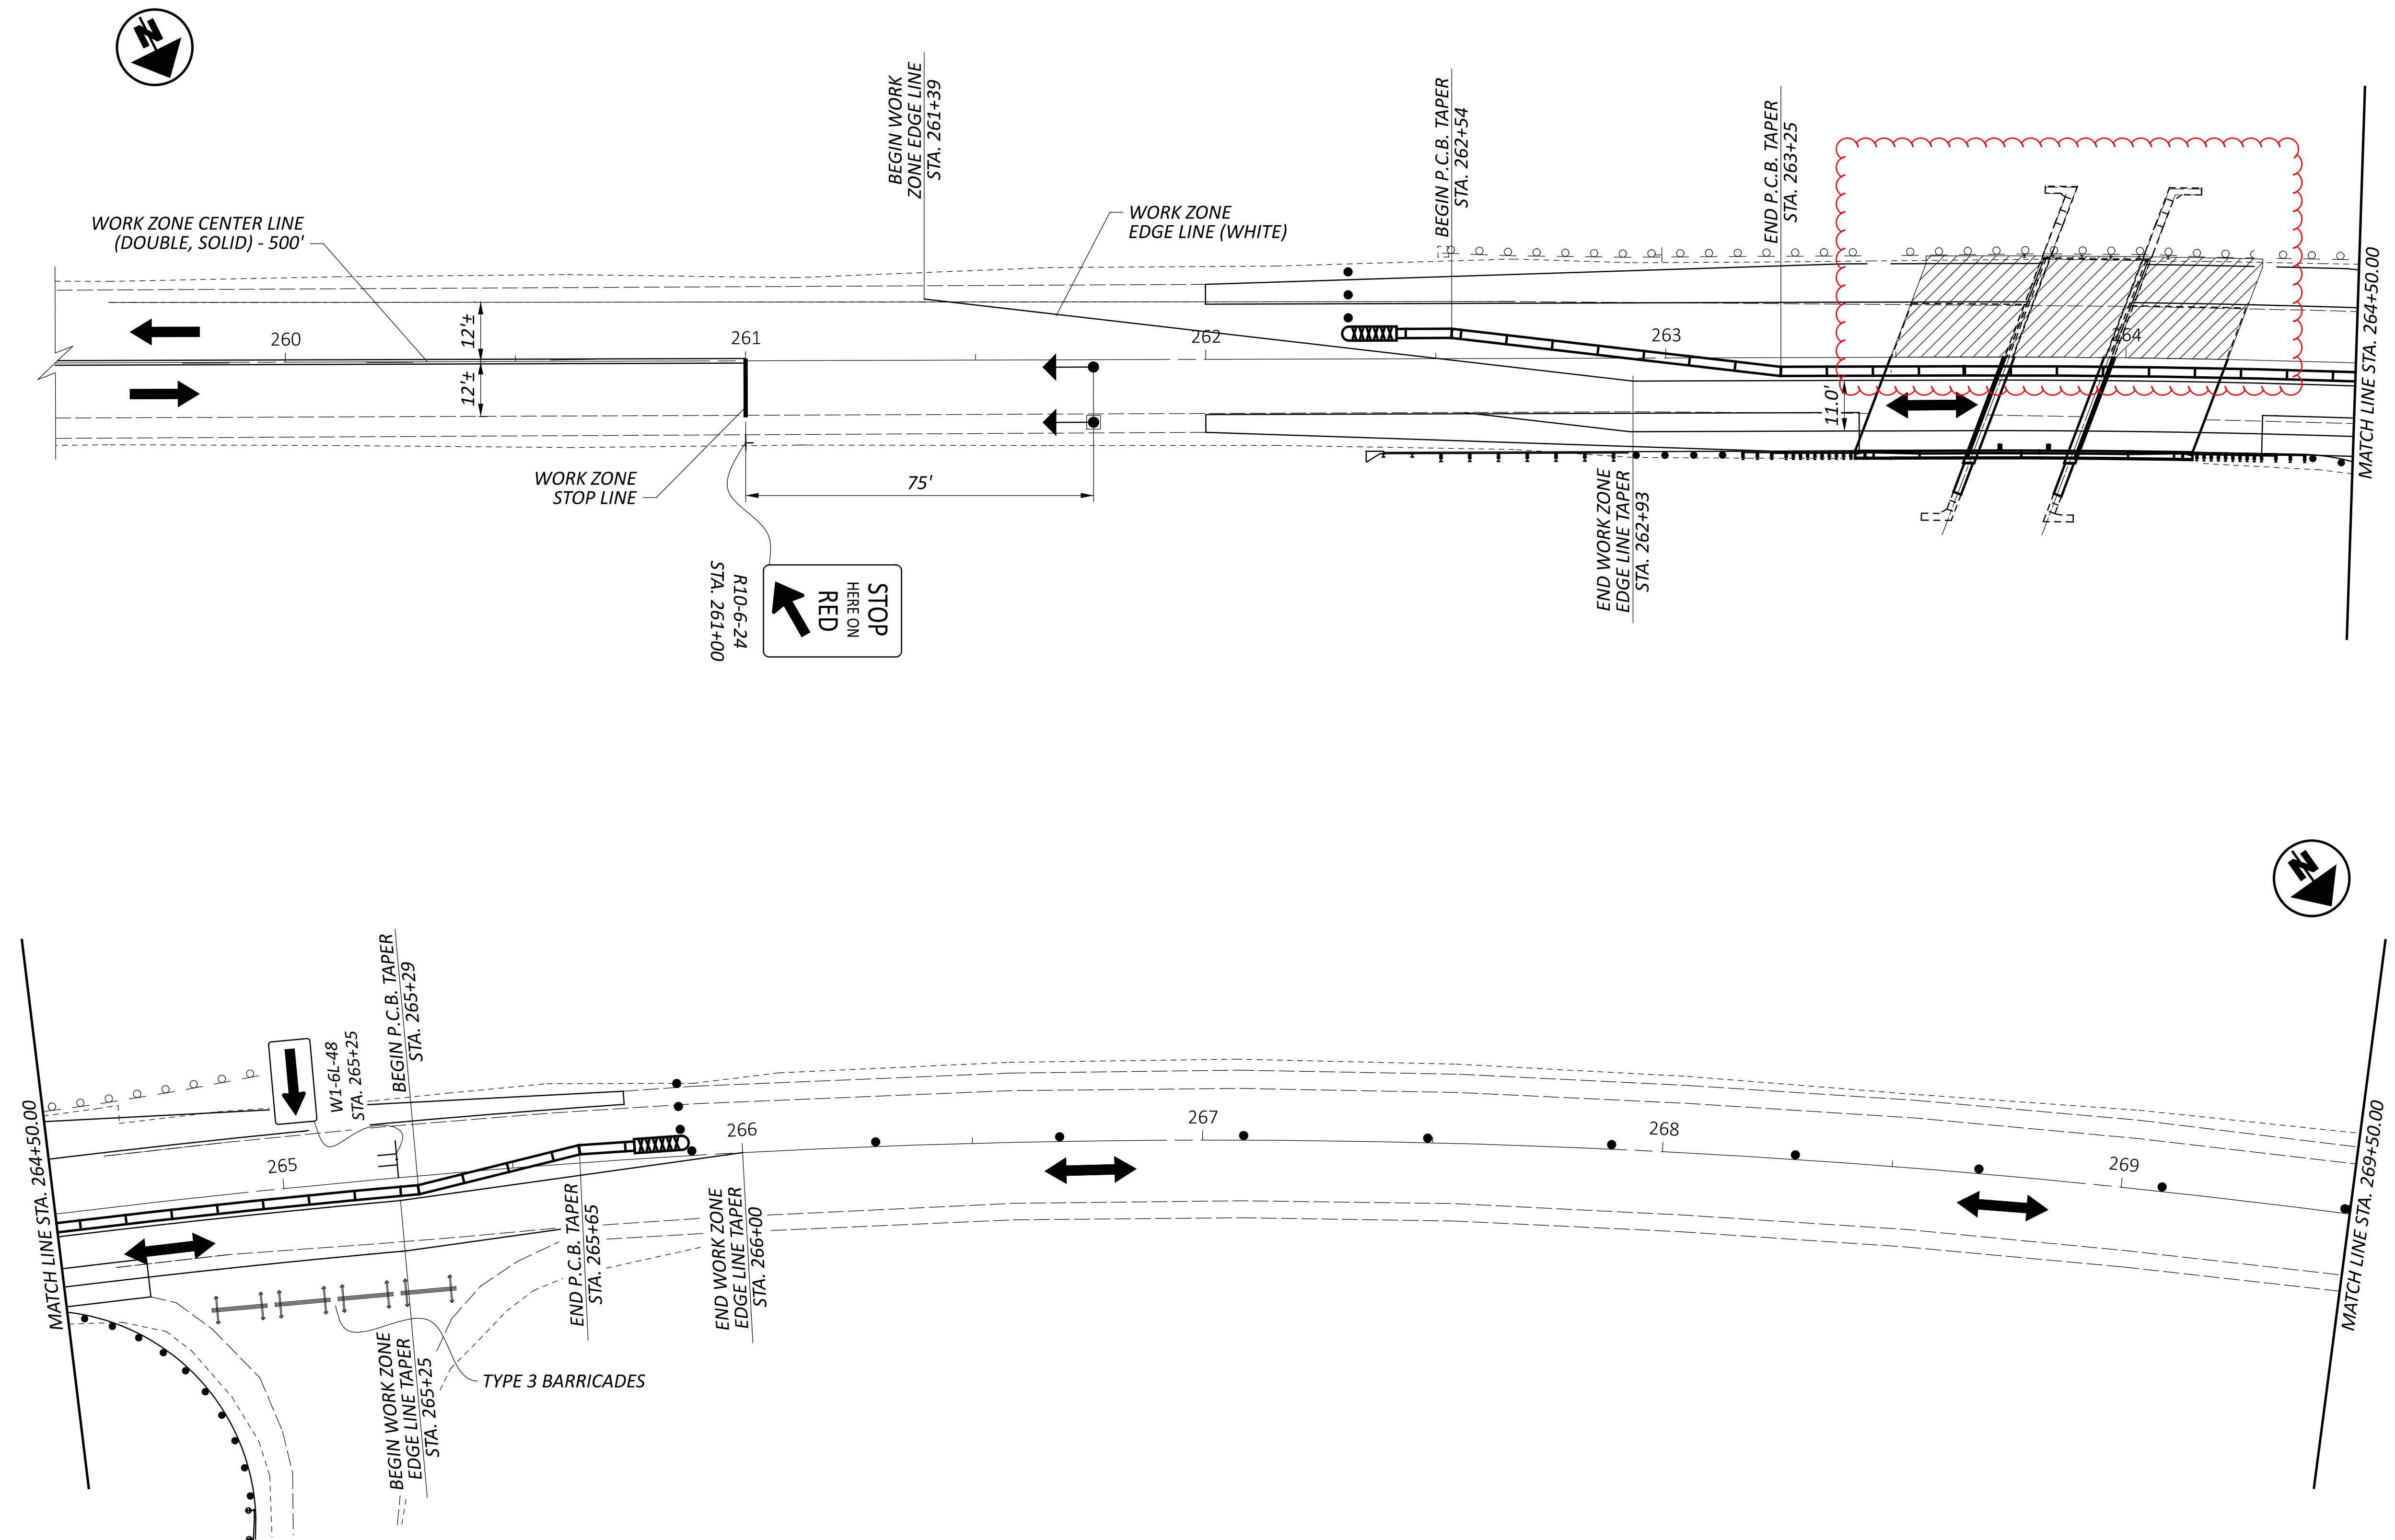

LEGEND

| | | | | | |
|--|------------------------|--|-----------------------------|--|---------------------|
| | - DRUMS / CONES | | - WORK AREA | | - IMPACT ATTENUATOR |
| | - DIRECTION OF TRAFFIC | | - PORTABLE CONCRETE BARRIER | | - TEMPORARY SIGNAL |

SEE SHEET 32/127 FOR SIGNAL TIMING DIAGRAM

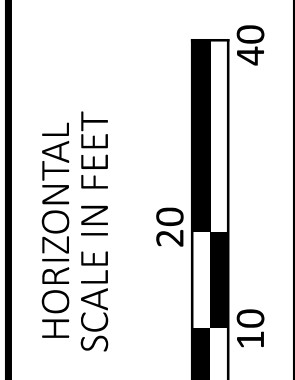




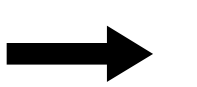


MAINTENANCE OF TRAFFIC (PHASE 2)
 STA. 259+50 TO STA. 269+50

DESIGN AGENCY






| | |
|------------|----------|
| DESIGNER | TDF |
| REVIEWER | |
| TAG | 09/26/23 |
| PROJECT ID | 96323 |
| SHEET | TOTAL |
| P.30 | 127 |

LEGEND

| | | | | | |
|---|------------------------|--|-----------------------------|---|---------------------|
|  | - DRUMS / CONES |  | - WORK AREA |  | - IMPACT ATTENUATOR |
|  | - DIRECTION OF TRAFFIC |  | - PORTABLE CONCRETE BARRIER |  | - TEMPORARY SIGNAL |

SEE SHEET 32/127 FOR SIGNAL TIMING DIAGRAM

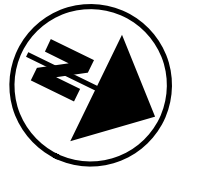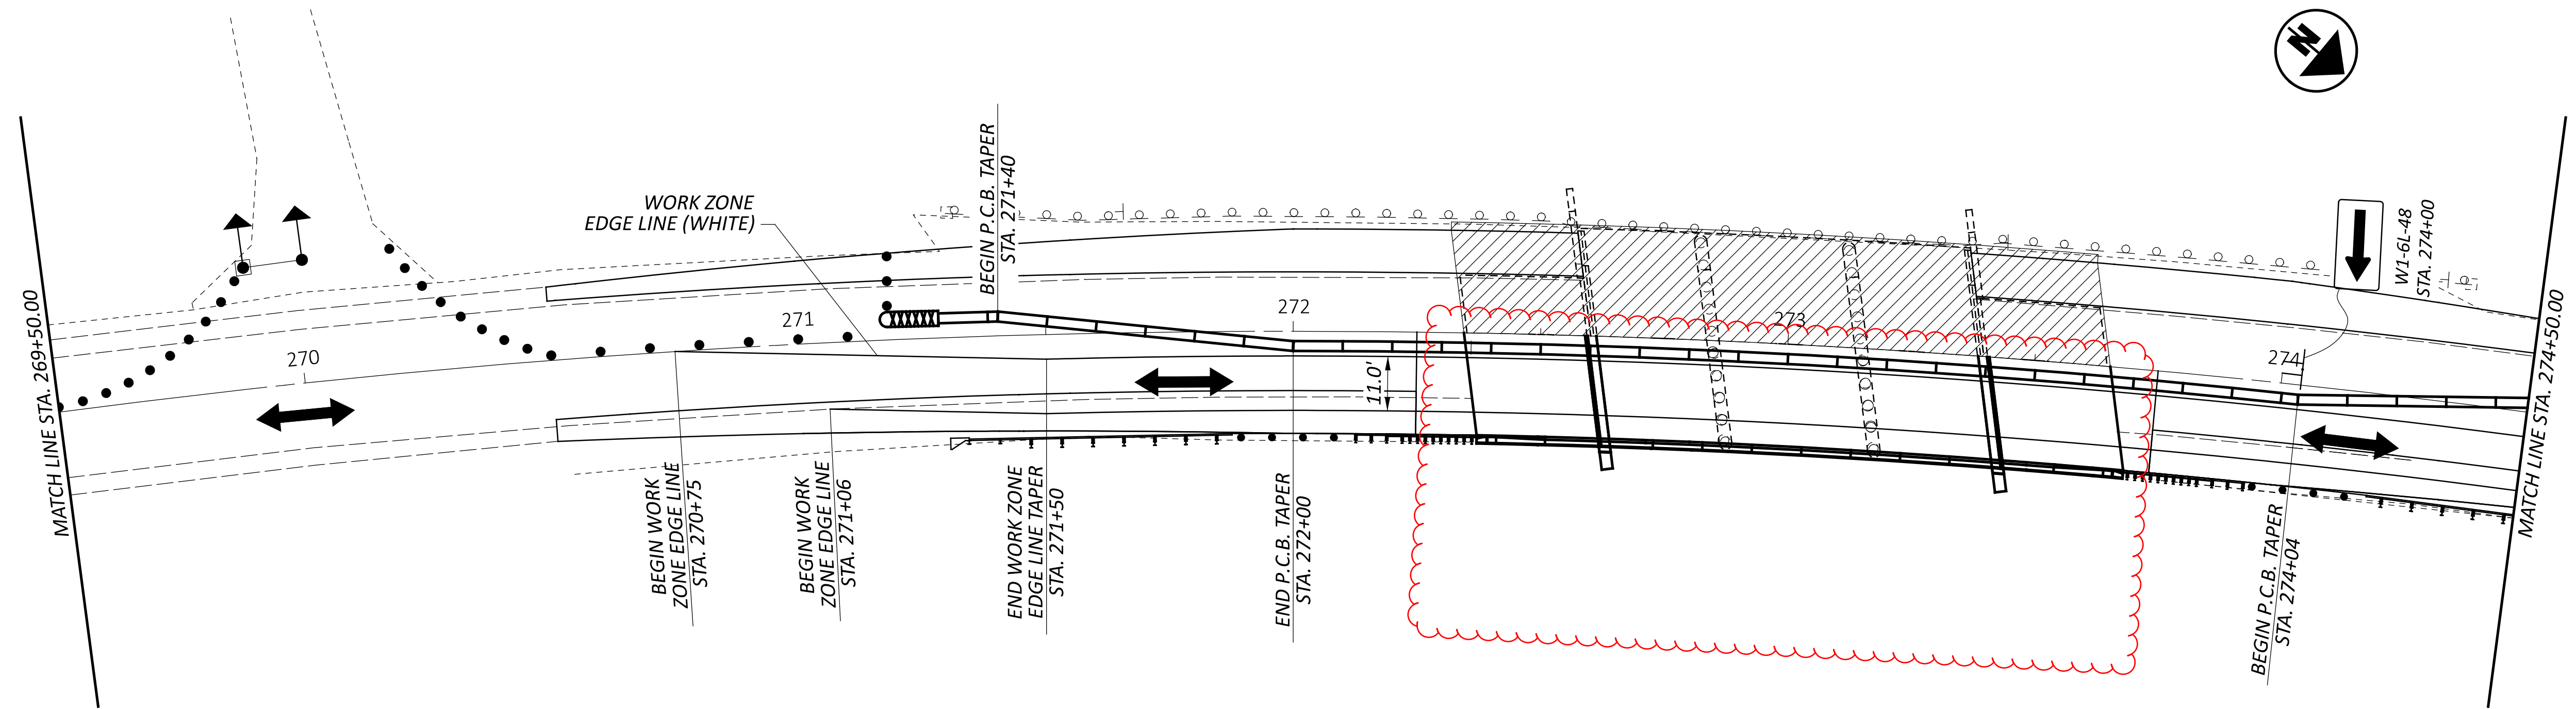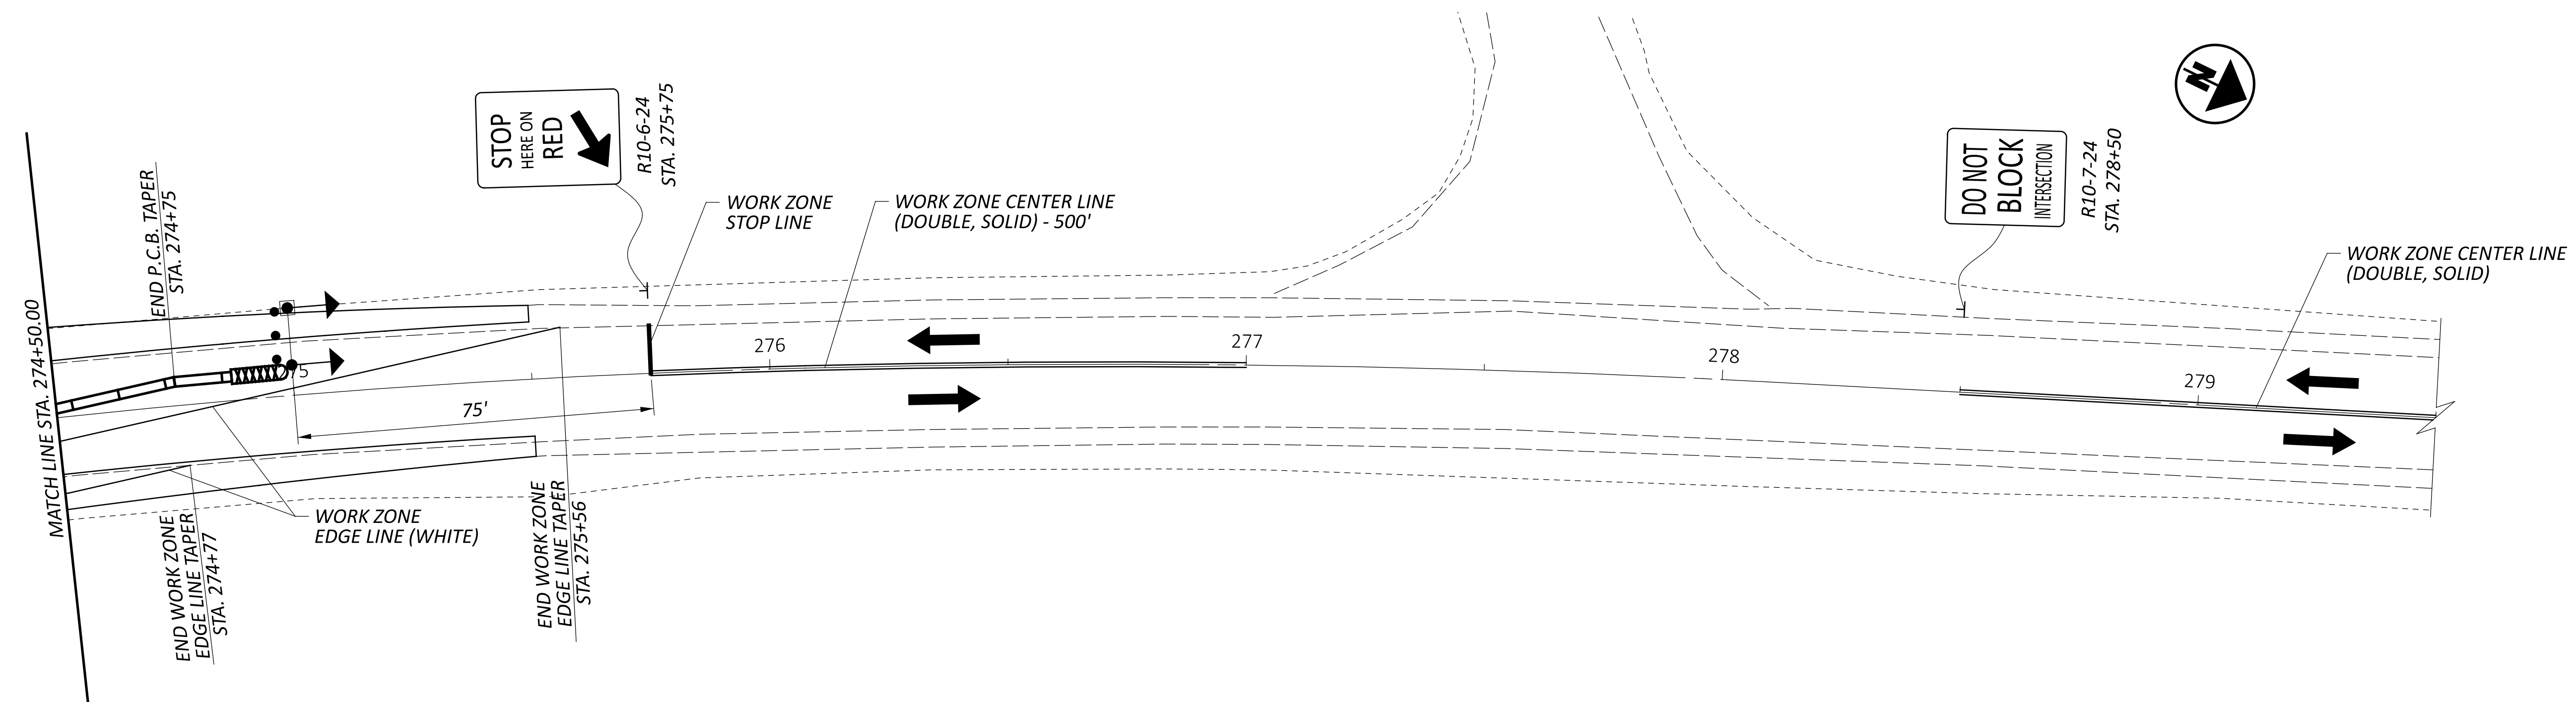

DESIGN AGENCY



DESIGNER

TDF

REVIEWER

TAG 09/26/23


PROJECT ID

96323

SHEET TOTAL


P.31 127




MAINTENANCE OF TRAFFIC (PHASE 2)
 STA. 269+50 TO STA. 279+50

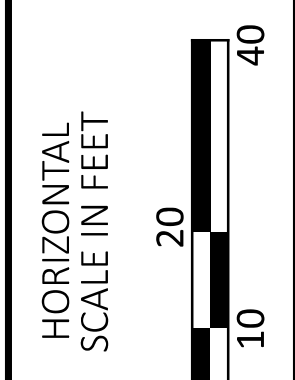

| SHEET NUM. | | | | | | | | | | | PART. | | ITEM | ITEM EXT | GRAND TOTAL | UNIT | DESCRIPTION | SEE SHEET NO. |
|------------|---|----|----|----|--|--|--|--|--|--|-----------|-----------|------|----------|-------------|------|--|---------------|
| 8 | 9 | 15 | 32 | 64 | | | | | | | 01/STR/13 | 02/STR/04 | | | | | | |
| | | | | | | | | | | | | | | | | | STRUCTURE OVER 20 FOOT SPAN (PER-93-0500, SFN 6401295) | 68 |
| | | | | | | | | | | | | | | | | | STRUCTURE OVER 20 FOOT SPAN (PER-93-0516, SFN 6401325) | 91 |
| | | | | | | | | | | | | | | | | | STRUCTURE OVER 20 FOOT SPAN (PER-93-0618, SFN 6401392) | 121 |
| | | | | | | | | | | | | | | | | | STRUCTURE OVER 20 FOOT SPAN (PER-93-0772, SFN 6401422) | 127 |
| | | | | | | | | | | | | | | | | | MAINTENANCE OF TRAFFIC | |
| | | | | | | | | | | | | | | | | | WORK ZONE IMPACT ATTENUATOR, 24" WIDE HAZARDS, (BIDIRECTIONAL) | 15 |
| | | | | | | | | | | | | | | | | | ASPHALT CONCRETE FOR MAINTAINING TRAFFIC, AS PER PLAN | |
| | | | | | | | | | | | | | | | | | BARRIER REFLECTOR, TYPE 1 (BIDIRECTIONAL) | |
| | | | | | | | | | | | | | | | | | BARRIER REFLECTOR, TYPE 2 (BIDIRECTIONAL) | |
| | | | | | | | | | | | | | | | | | OBJECT MARKER, TWO WAY | |
| | | | | | | | | | | | | | | | | | WORK ZONE EDGE LINE, CLASS I, 6" | |
| | | | | | | | | | | | | | | | | | WORK ZONE STOP LINE, CLASS I | |
| | | | | | | | | | | | | | | | | | PORTABLE BARRIER, UNANCHORED | |
| | | | | | | | | | | | | | | | | | INCIDENTALS | |
| | | | | | | | | | | | | | | | | | MAINTAINING TRAFFIC | 9 |
| | | | | | | | | | | | | | | | | | CONSTRUCTION LAYOUT STAKES AND SURVEYING, AS PER PLAN | |
| | | | | | | | | | | | | | | | | | MOBILIZATION | |

GENERAL SUMMARY

DESIGN AGENCY

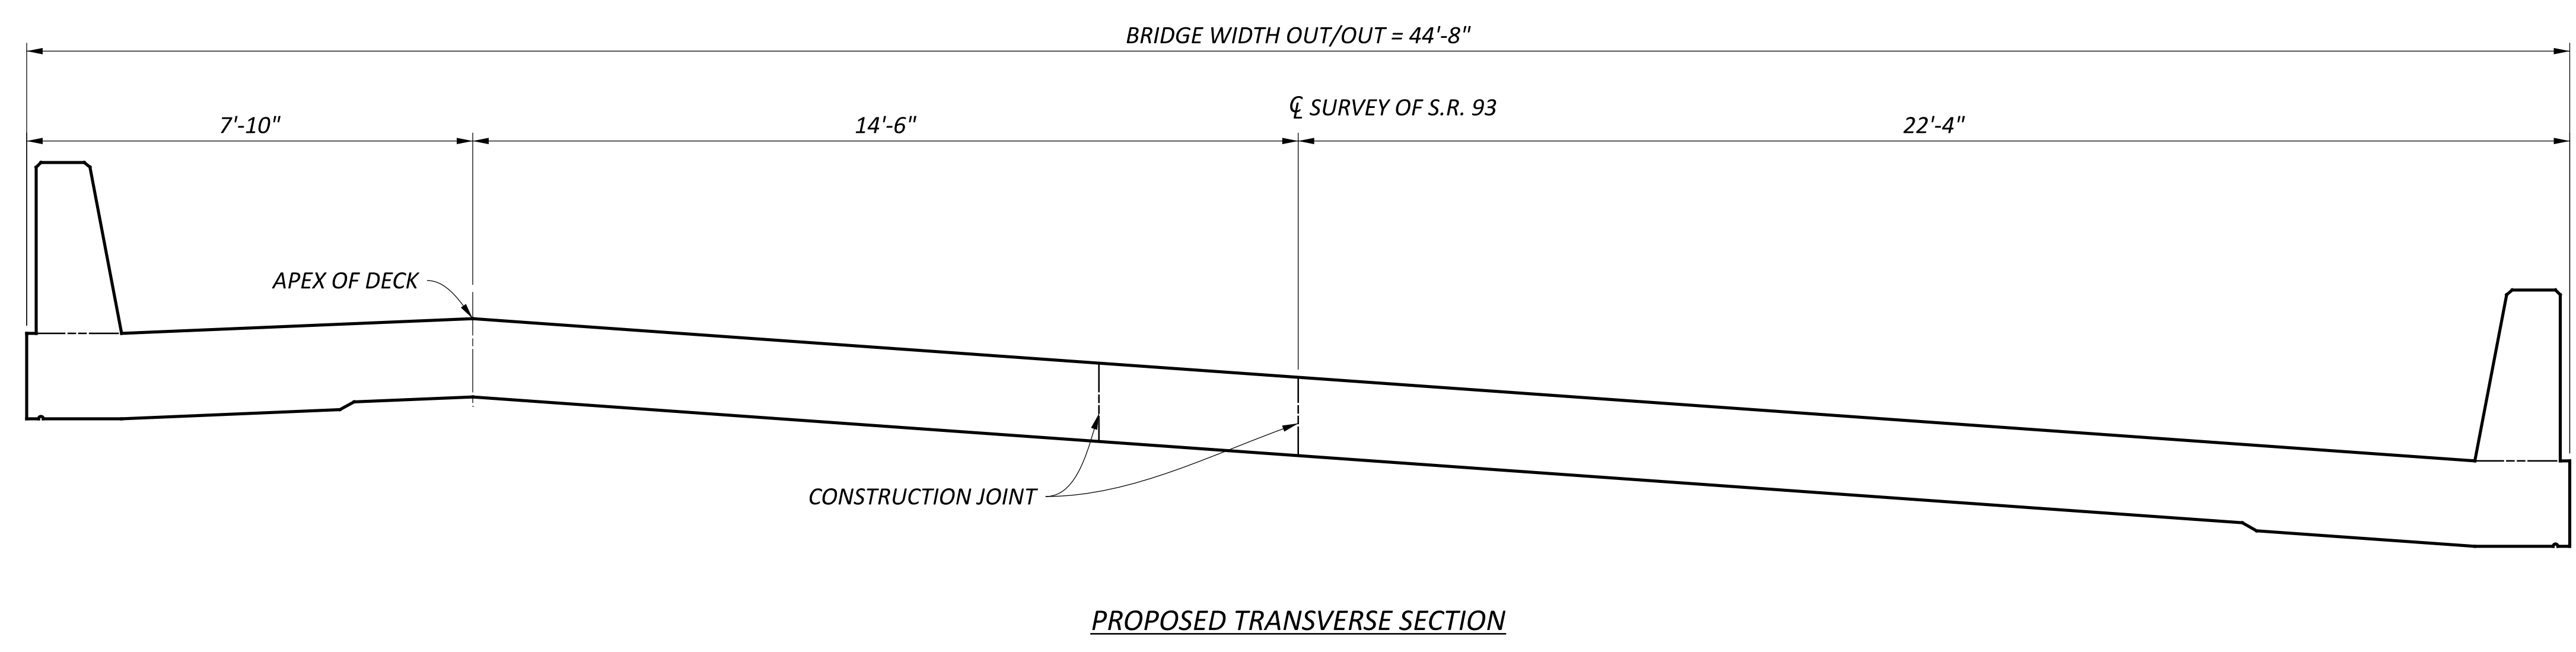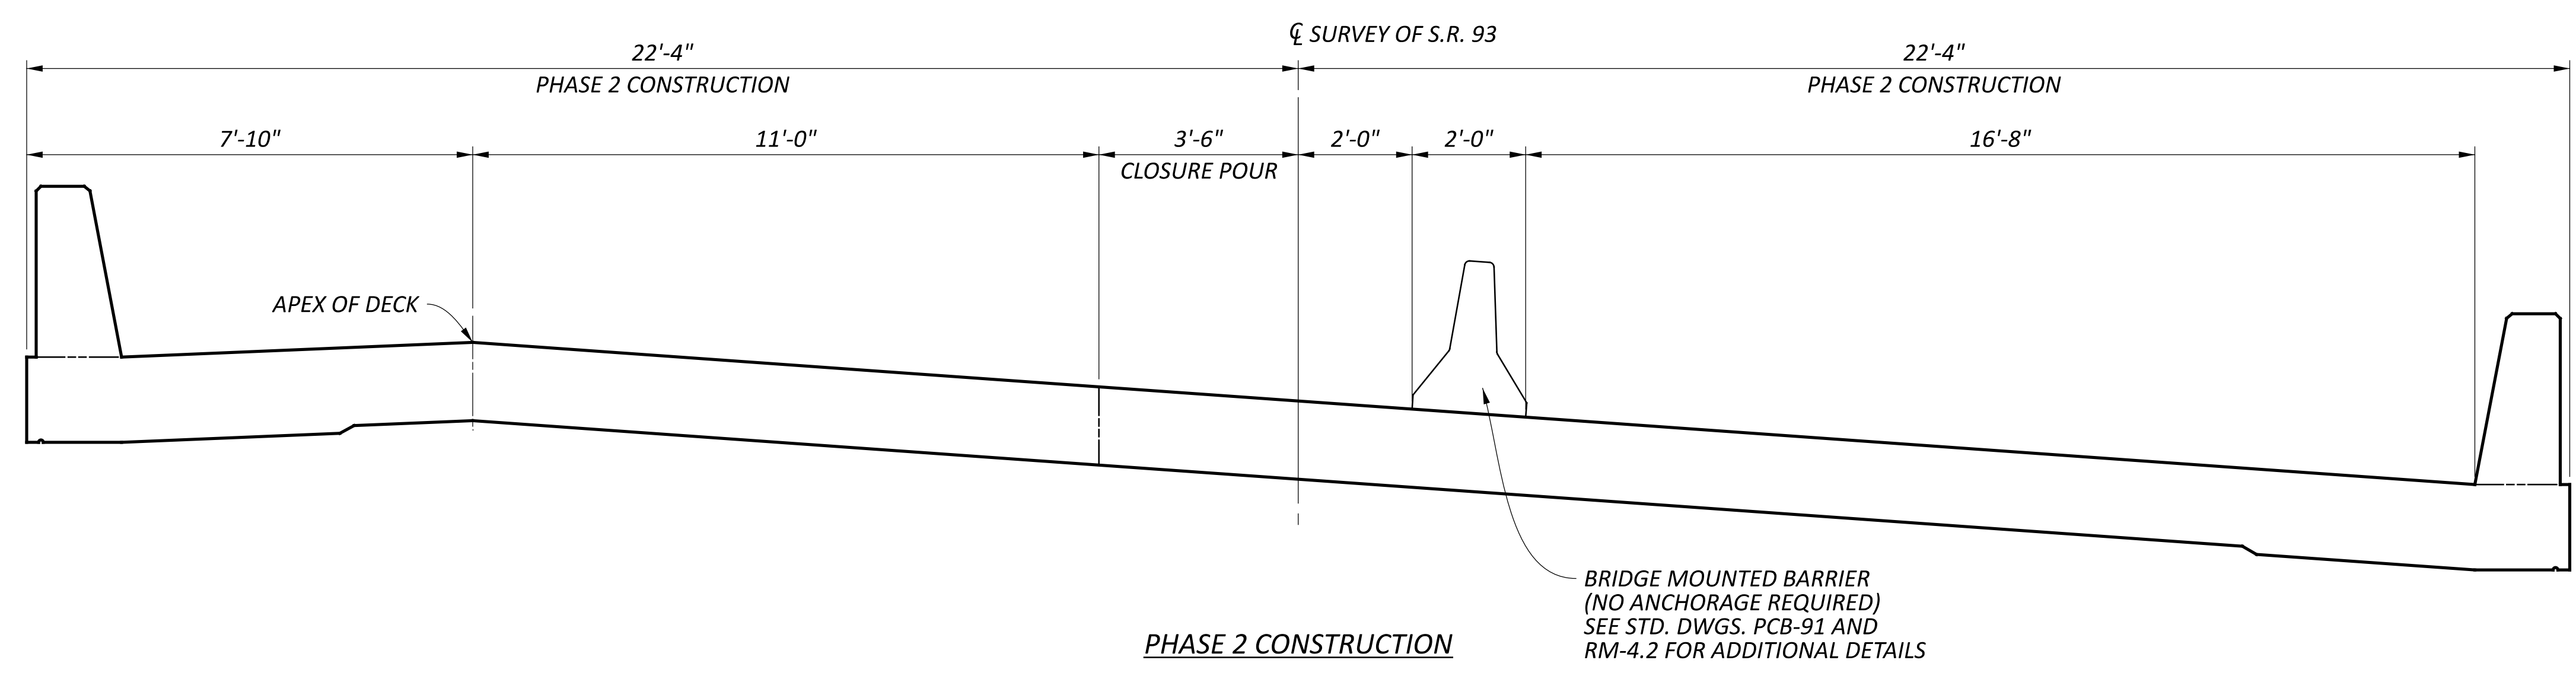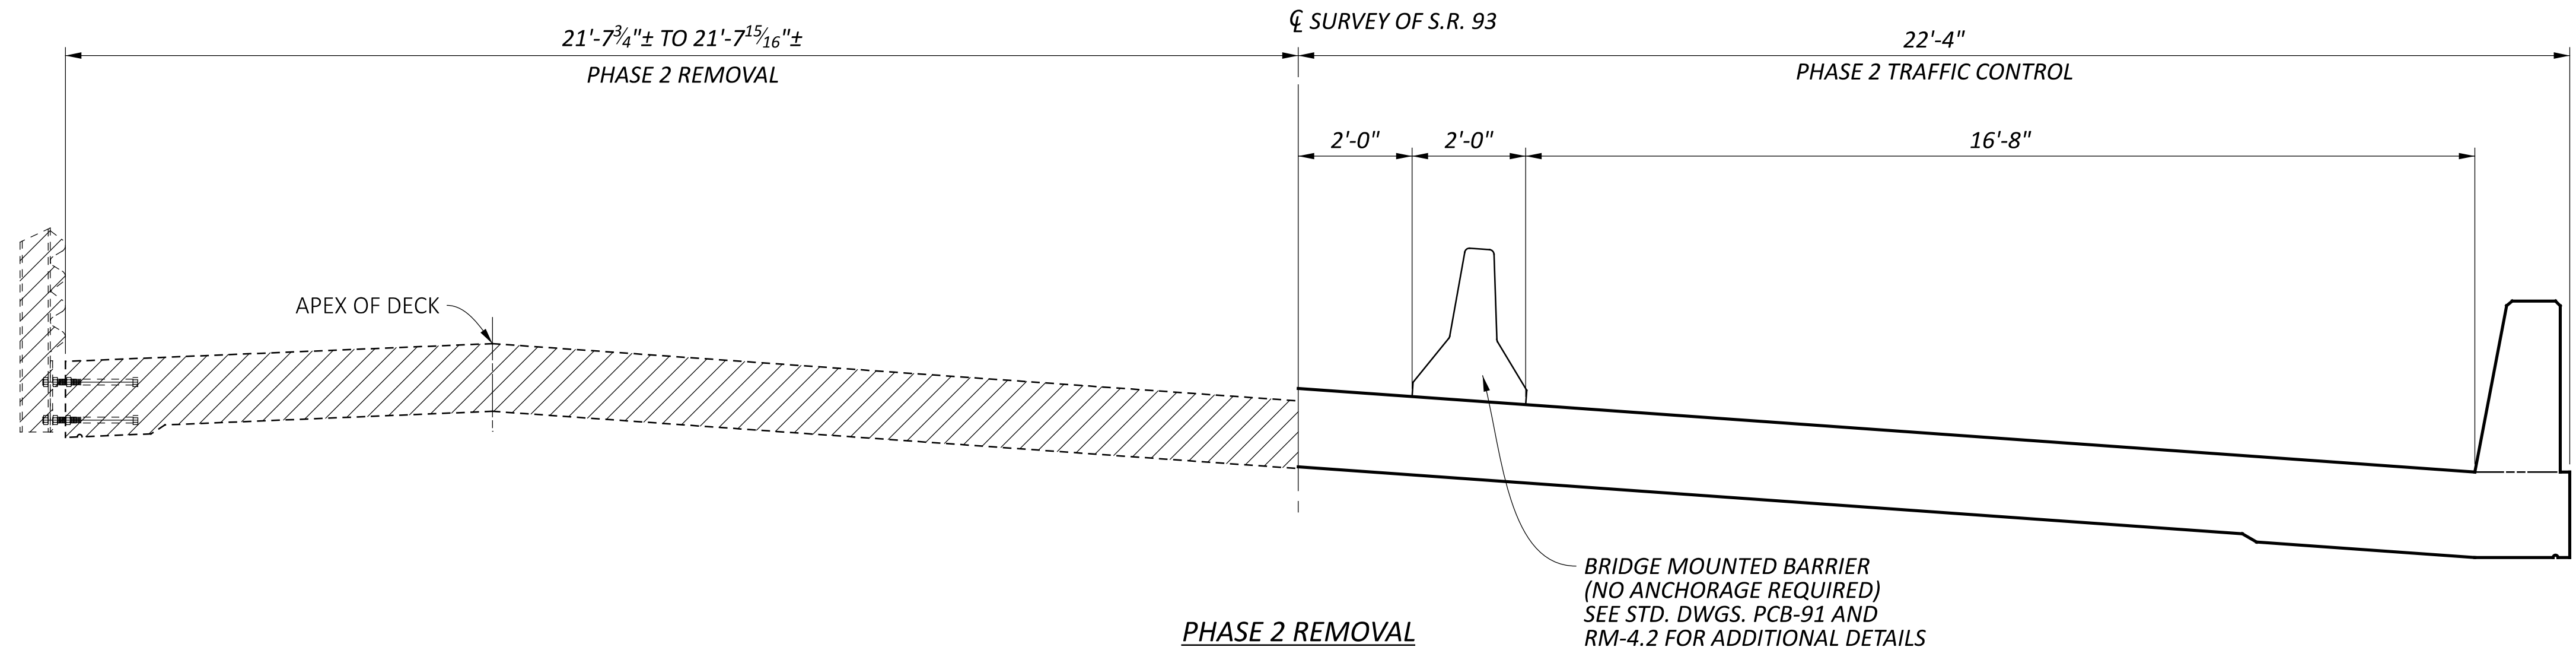 DESIGNER
TDF
 REVIEWER
 TAG 09/26/23
 PROJECT ID
 96323
 SHEET TOTAL
 P.34 | 127



STAGED CONSTRUCTION DETAILS
 BRIDGE NO. PER-93-0516
 OVER MONDAY CREEK

| | |
|---------------|---------|
| SFN | |
| 6401325 | |
| DESIGN AGENCY | |
| | |
| DESIGNER | CHECKER |
| TDF | TAG |
| REVIEWER | |
| TAG 09/26/23 | |
| PROJECT ID | |
| 96323 | |
| SUBSET | TOTAL |
| 5 | 28 |
| SHEET | TOTAL |
| P.95 | 127 |