


TYPICAL SECTION #1 - U.S. 23
 SECTION APPLIES TO THE FOLLOWING STATIONS:
 STA. 680+53.51 TO STA. 894+52.91
 (SLM 12.89 TO SLM 16.94)

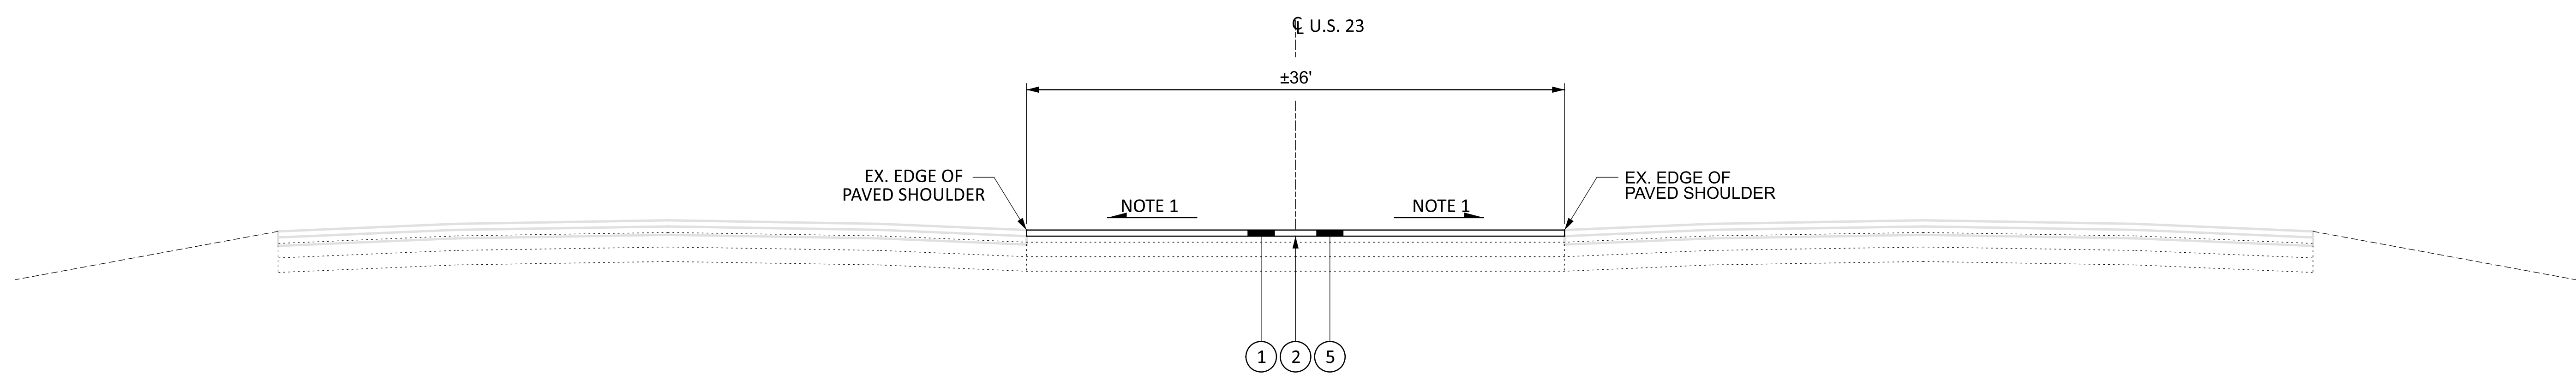


TYPICAL SECTION #2 - PAVED MEDIAN CROSSOVER
 SECTION APPLIES TO THE FOLLOWING STATIONS:
 US-23 STA. 702+98.40 @ PAVED CROSSOVER
 US-23 STA. 712+62.04 @ PAVED CROSSOVER
 US-23 STA. 728+45.91 @ PAVED CROSSOVER
 US-23 STA. 744+28.29 @ PAVED CROSSOVER
 US-23 STA. 758+31.07 @ PAVED CROSSOVER
 US-23 STA. 814+25.89 @ PAVED CROSSOVER
 US-23 STA. 833+26.66 @ PAVED CROSSOVER
 US-23 STA. 842+54.80 @ PAVED CROSSOVER
 US-23 STA. 861+21.59 @ PAVED CROSSOVER

NOTE 1:
 MATCH EXISTING PAVEMENT CROSS SLOPE

LEGEND:

- A** PAVEMENT WIDTHS - SEE PAVEMENT CALCS
- 1** ITEM 254 - (1.50") PAVEMENT PLANING, ASPHALT CONCRETE
- 2** ITEM 407 - NON-TRACKING TACK COAT (RATE AS PER CMS 407.06-1)
- 3** ITEM 442 - ANTI-SEGREGATION EQUIPMENT
- 4** ITEM 442 - (1.50") ASPHALT CONCRETE SURFACE COURSE, 12.5MM, TYPE A (447)
- 5** ITEM 442 - (1.50") ASPHALT CONCRETE SURFACE COURSE, 12.5MM, TYPE A (449)
- 6** ITEM 617 - (2.00" X 2.0') COMPACTED AGGREGATE (OUTSIDE SHOULDER ONLY)
- 7** ITEM 618 - RUMBLE STRIPS, (ASPHALT CONCRETE) (OUTSIDE SHOULDER ONLY)
- 8** ITEM 875 - LONGITUDINAL JOINT ADHESIVE (INCIDENTAL TO 447)
- 9** ITEM 617 - SHOULDER PREPARATION
- A** EXISTING COMPOSITE PAVEMENT

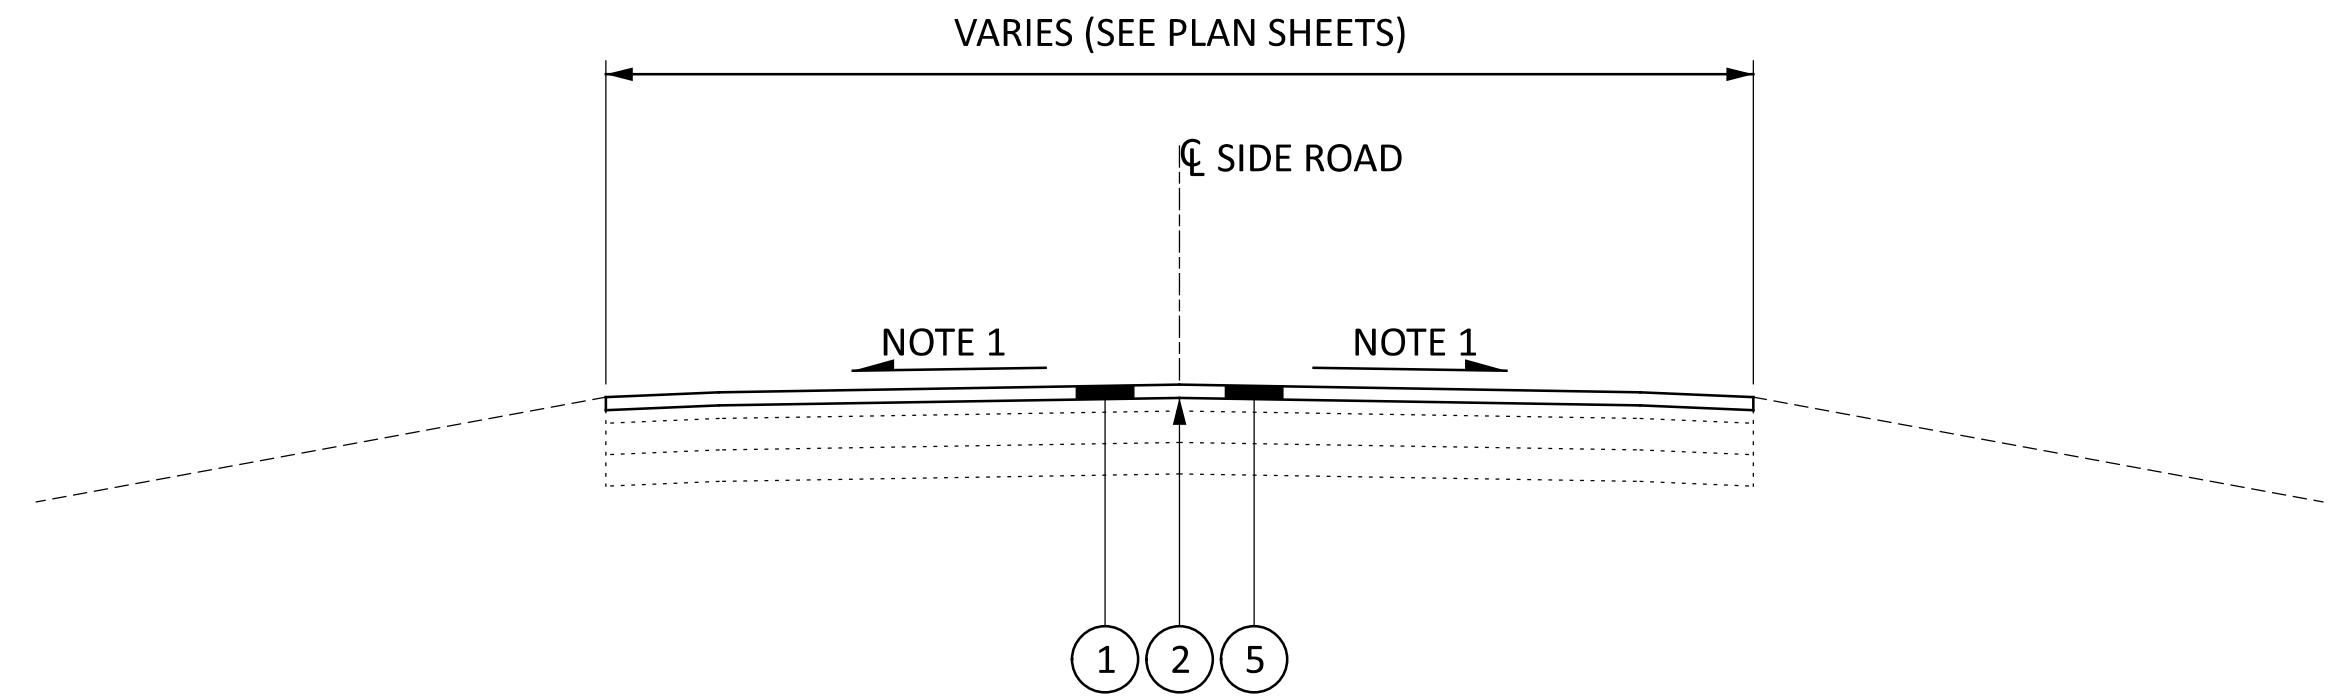

TYPICAL SECTION #3 - PAVED SIDE ROADS
 SECTION APPLIES TO THE FOLLOWING STATIONS:
 US-23 STA. 702+98.40 @ ISLAND RD
 US-23 STA. 744+28.29 @ LITTLE WALNUT (SOUTH)
 US-23 STA. 804+62.89 @ LITTLE WALNUT (NORTH)

