

MODEL: Sheet PAPERSIZE: 34x22 (in.) DATE: 9/5/2025 TIME: 10:12:15 AM PLTDRV: OHDOT_PDF.pltgr PENTBL: OHDOT_Pen.tbl USER: Jeremiah.Masey@dot.ohio.gov WORKSPACE: OHDOTCEv02 WORKSET: 122160 PRODUCT: OpenRoadsDesigner 24.00.00.2025
pw:\ohiodot-pw.bentley.com\ohiodot-pw\02\Documents\01 Active Projects\District 06\Pickaway\122160\400-Engineering\Roadway\Sheets\122160_GG001.dgn

[illegible]

GENERAL SUMMARY

DESIGN AGENCY



DESIGNER

MAK

REVIEWER


JPH 11/22/24

PROJECT ID

122160

SHEET	TOTAL
-------	-------

P 09 | 1

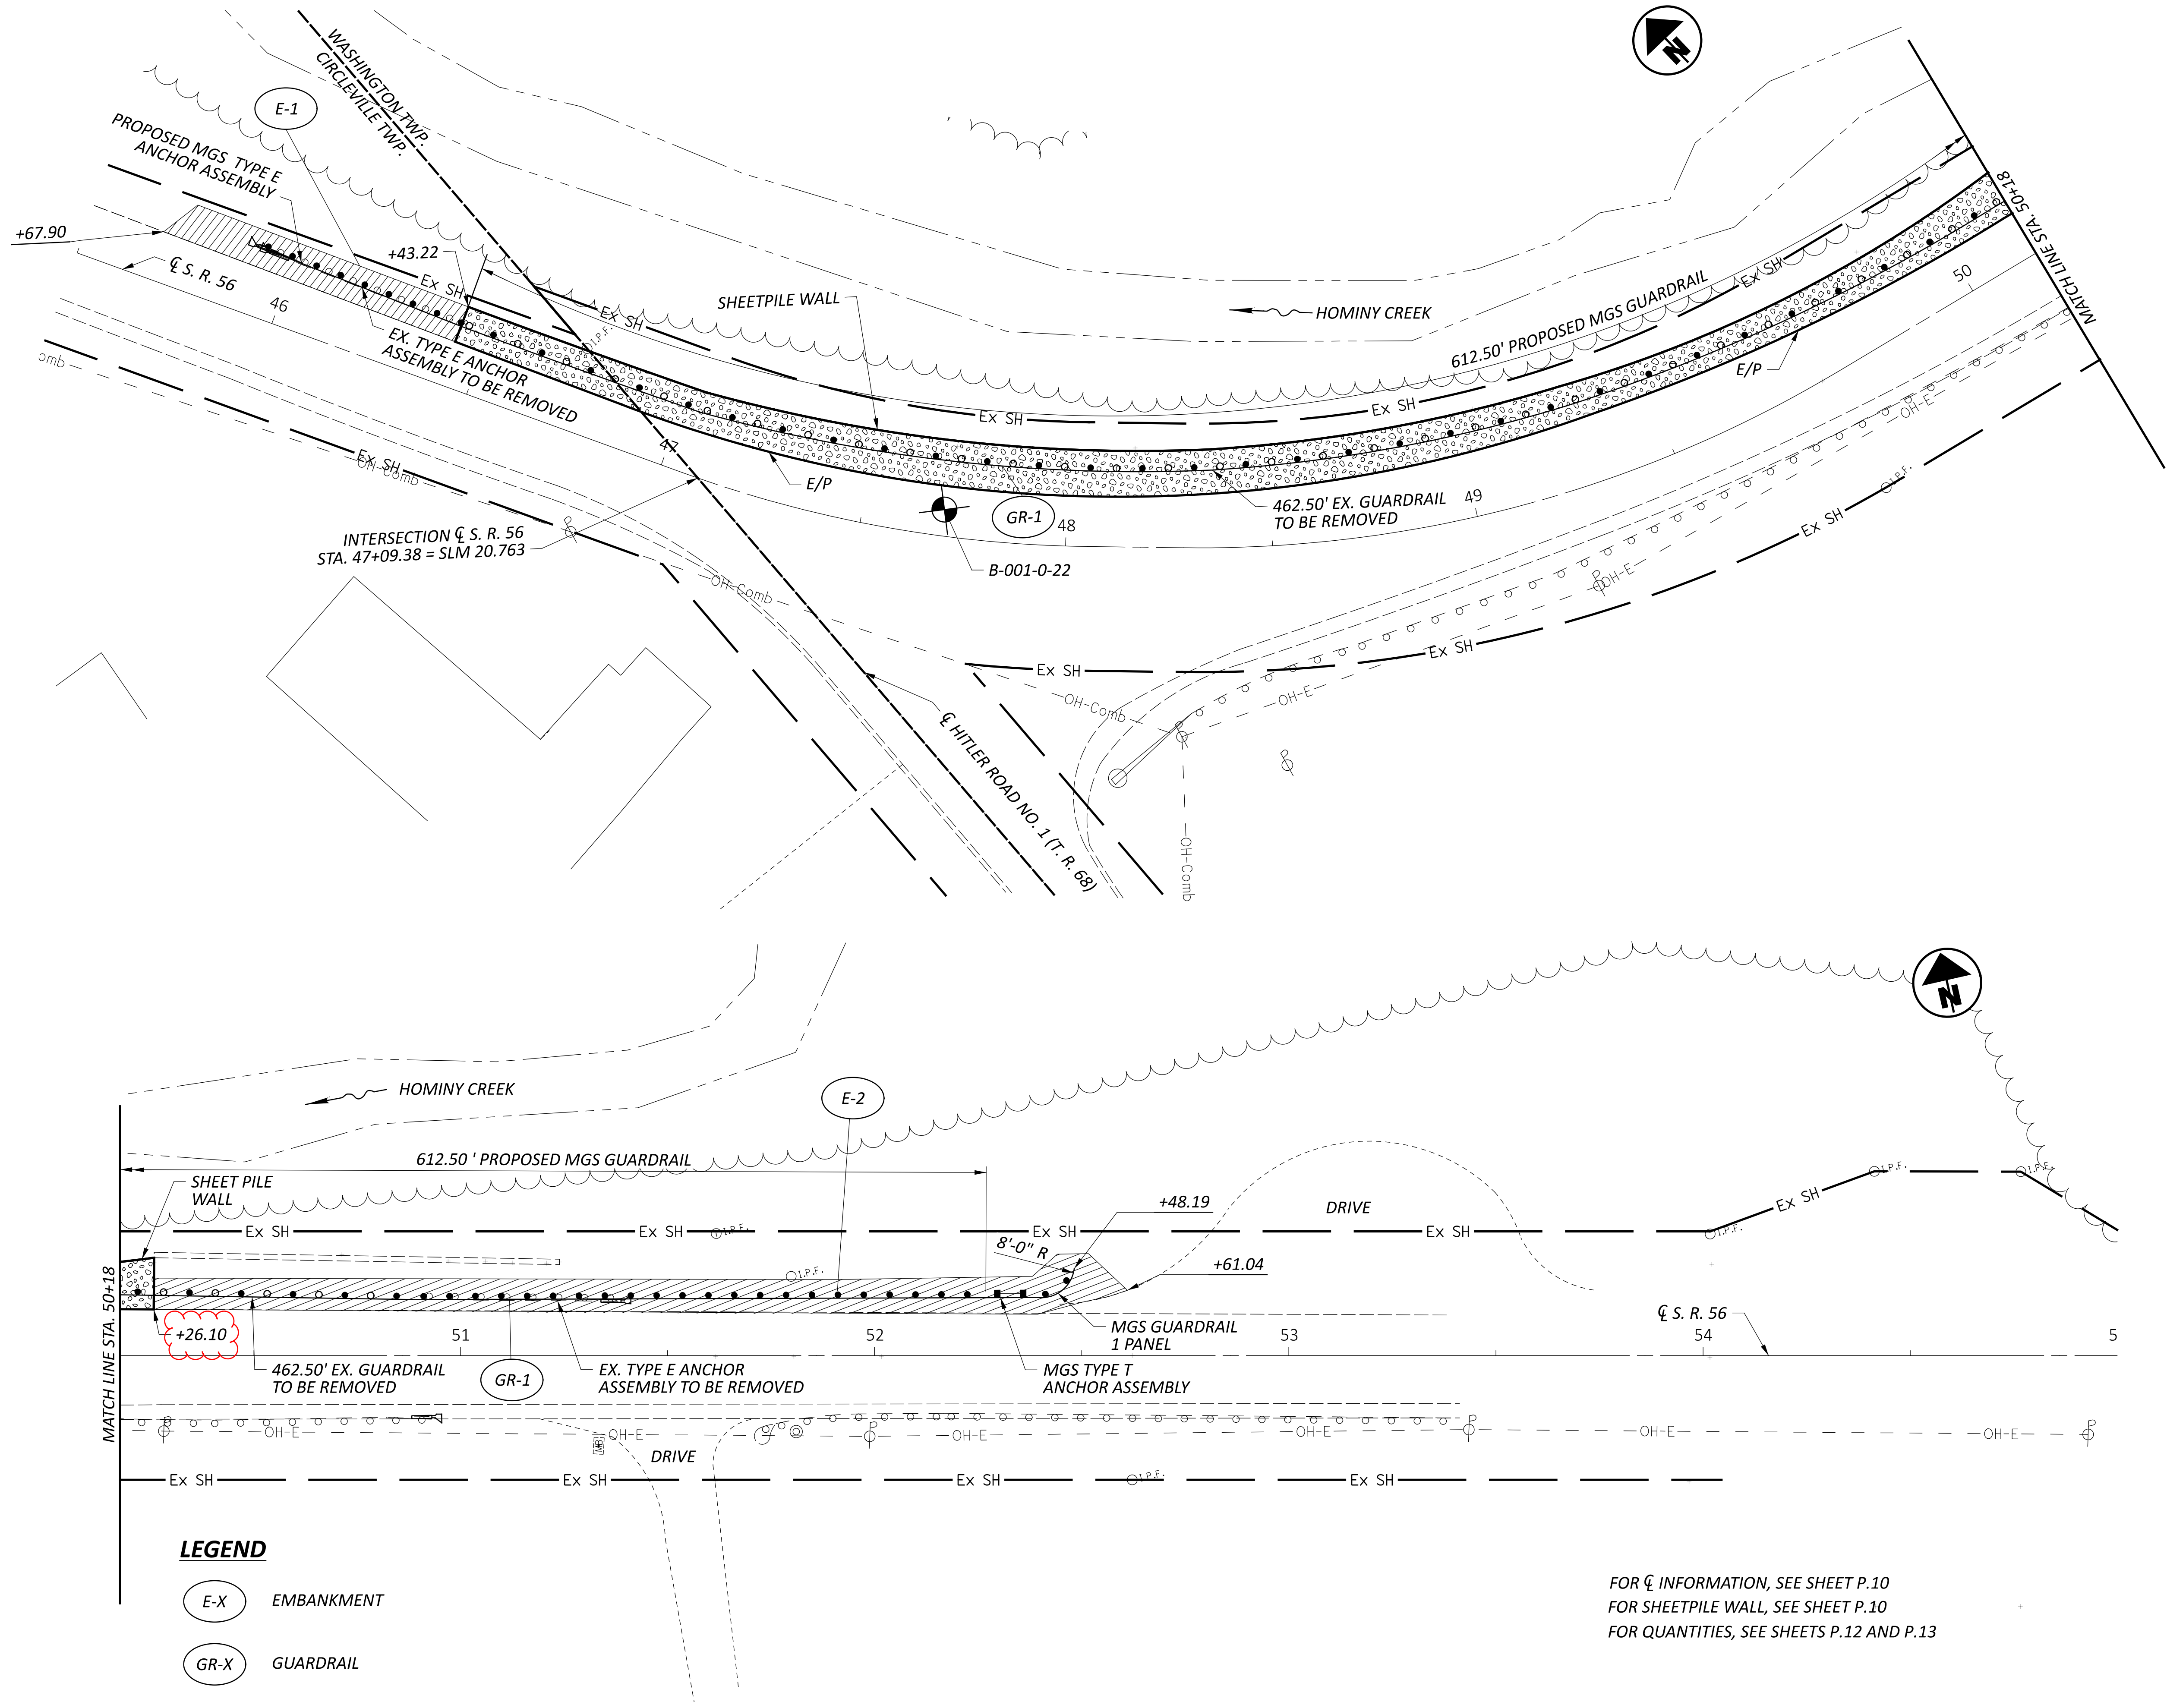

FOR ∇ INFORMATION, SEE SHEET P.10
FOR SHEETPILE WALL, SEE SHEET P.10
FOR QUANTITIES, SEE SHEETS P.12 AND P.13

HORIZONTAL
SCALE IN FEET
0 10 20 40

GUARDRAIL PLAN
STA. 45+50 TO STA. 55+00

DESIGN AGENCY



DESIGNER
MAK

REVIEWER
JPH 11/22/24

PROJECT ID
122160

SHEET TOTAL
P.11 15

ITEM 659 - TOPSOIL:

$$288 \text{ SQ YD} / 1000 = 0.3$$
$$0.3 \times 111 \text{ CU YDS} = 33 \text{ CU YDS}$$

TOTAL CARRIED TO GENERAL SUMMARY:

ITEM 659 - TOPSOIL = 33 CU YD

ITEM 659 - COMMERCIAL FERTILIZER:

288 SQ YD OF SEEDING AND
MULCHING (FROM TABLE)

$$288 \times 9 \text{ SQ FT} / \text{SQ YD} = 2,595 \text{ SQ FT}$$
$$2595 / 1.000 = 2.6$$

2.6 X 30 POUNDS = 78 POUNDS = 0.04 TONS

TOTAL CARRIED TO GENERAL SUMMARY:

ITEM 659 - COMMERCIAL FERTILIZER = 0.04 TON

ITEM 659 - LIME:

288 SQ YD OF SEEDING AND
MULCHING (FROM TABLE)

$$288 \times 9 \text{ SQ FT} / \text{SQ YD} = 2.595 \text{ SQ FT}$$
$$2595 / 43.560 \text{ SQ FT} / \text{ACRE} = 0.06 \text{ ACRE}$$

TOTAL CARRIED TO GENERAL SUMMARY:

ITEM 659 - LIME = 0.06 ACRE

ITEM 659 - WATER:

288 SQ YD OF SEEDING AND
MULCHING (FROM TABLE)

$$288 \times 9 \text{ SQ FT} / \text{SQ YD} = 2.595 \text{ SQ FT}$$
$$2595 / 1,000 = 2.6$$
$$2.6 \times 300 \text{ GAL.} \times 2 = 1.560 \text{ GALLONS} = 2 \text{ MGAL}$$

TOTAL CARRIED TO GENERAL SUMMARY:

ITEM 659 - WATER = 2 M GAL



DESIGNER

MAK

REVIEWER

JB 11/22/24

PROJECT ID
112160

SHEET	TOTAL
P.13	1