SFN	
	VARIOU:
DES	GN AGENCY




ΞR	CHECKER
5	TJP
VIE	WER
0	6-09-22
. ID	
10	672
	TOTAL
	VIE O

DESIGNER CHECKE							
KMB	TJP						
REVI	WER						
MJA 0	6-09-22						
PROJECT ID							
110	672						
SUBSET	TOTAL						
2	8						
SHEET	TOTAL						
P.15	21						

												CHECKE	ED: MJA DATE	: 6/9/2022
									F.	STIMATED	OHANTITI	FS		
ESTIMATED QUANT										QUANTITI				
	T	В	RIDGE NO.	. / STRUCTU	JRE FILE N	0.	T	I I						
5-0590 1187 IS/BR	5-0655)217 IS/BR	5-1171)241 IS/BR	5-1266)276 IS/BR	5-1529 3306 IS/BR	4-1918)853 R/BR	4-2001)942 R/BR	4-2208)977 R/BR	POR-183-0512 6703739 05/STR/BR	ITEM	EXTENSION	UNIT	DESCRIPTION		SEE
POR-5-0590 6700187 04/NHS/BR	POR-5-0655 6700217 03/NHS/BR	POR-5-1171 6700241 04/NHS/BR	POR-5-1266 6700276 04/NHS/BR	POR-5-1529 6700306 03/NHS/BR	POR-14-1918 6700853 05/STR/BR	POR-14-2001 6700942 05/STR/BR	POR-14-2208 6700977 05/STR/BR	POR-18 6703 05/ST						SHEET
LUMP	LUMP	LUMP	LUMP	LUMP	LUMP	LUMP	LUMP	LUMP	201	11001	LUMP	CLEARING AND GRUBBING, AS PER PLAN, AROUND BRIDGES/STRUCTURES/CULVERTS		1/8
LUMP			LUMP		LUMP	LUMP		75 LUMP	202	38000 98000	FT LUMP	GUARDRAIL REMOVED REMOVAL MISC.:CHANNEL CLEANOUT		1/6
LUIVIP			5 LOIVIP		LUIVIP	LUIVIP		LUIVIP	202	40000	CY	BORROW		/8
120		78	3			J				10050	SV	SEALING OF CONCRETE SURFACES (NON-EDOYV)		000-
120		70			25	50			SPECIAL	51275500	SY	SEALING, SEALING OF CONCRETE SURFACES Pay Item	Added - Updated	3/8
		25							516	13600	SF	1" PREFORMED EXPANSION JOINT FILLER		
					25	50		25	519	11101		PATCHING CONCRETE STRUCTURE, AS PER PLAN		1/8
20		20							519	11101		PATCHING CONCRETE STRUCTURE, AS PER PLAN, QUICK SETTING CONCRETE MORTAR	₹	1/8
			5			5			601	26000		DUMPED ROCK FILL, TYPE B		
								75	606	15050	FT	GUARDRAIL, TYPE MGS		
15	15	15	15	15	15	15	15	15	630	02100	FT	GROUND MOUNTED SUPPORT, NO. 2 POST		
2	2	2	2	2	2	2	2	2	630	80100		SIGN, FLAT SHEET, 730.20		
2	2	2	2	2	2	2	2	2	630	84900		REMOVAL OF GROUND MOUNTED SIGN AND DISPOSAL		
2	2	2	2	2	2	2	2	2	630	86002		REMOVAL OF GROUND MOUNTED POST SUPPORT AND DISPOSAL		

POR-5/VAR-5.09/VAR

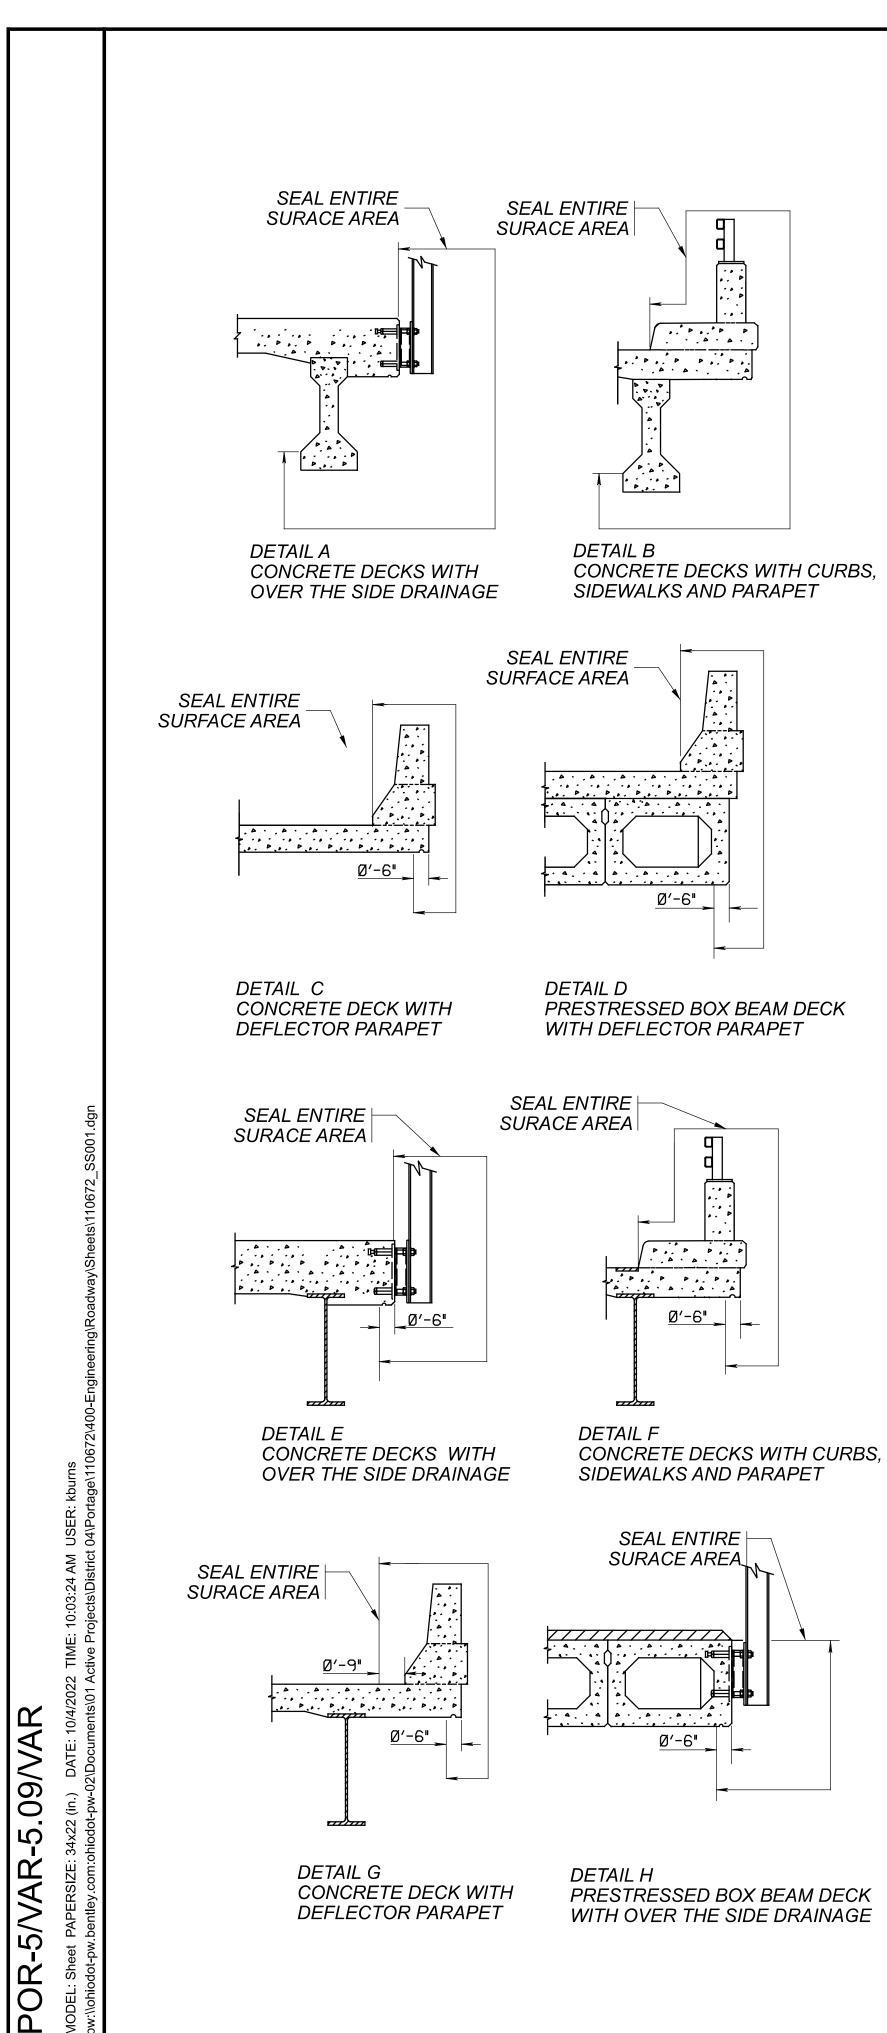

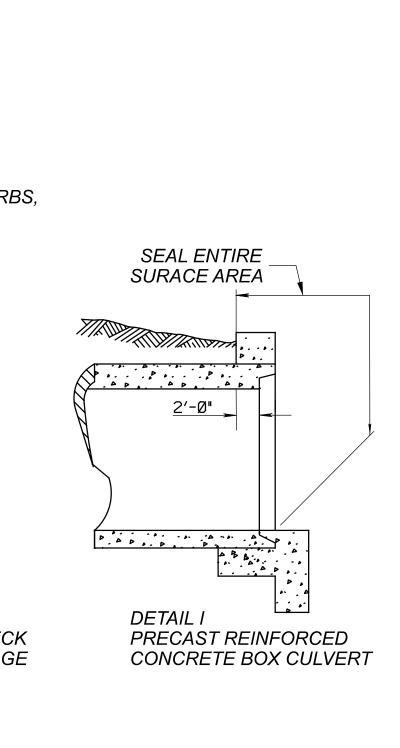


Table updated

ı			i i			ITITIES			
BRIDGE NUMBER	SEALING PAY ITEM	STRUCTURE TYPE	PROPOSED SEALING COLOR N OF TOP	NUMBER	ABUT (SQ YD)	PIER (SQ YD)	SUPER (SQ YD)	GENERAL (SQ YD)	TOTA (SQ Y
		CONODETE							
POR-5-0590	ITEM 512 – SEALING OF CONCRETE SURFACES (NON-EPOXY)		SEAL ALL PATCHED CONCRETE SURFACES SEAL HEADWALLS AND WINGWALLS PER DETAIL I				25	95	120
POR-5-1171	ITEM 512 – SEALING OF CONCRETE SURFACES (NON-EPOXY)		SEAL ALL PATCHED CONCRETE SURFACES SEAL HEADWALLS AND WINGWALLS PER DETAIL I				25	53	78
POR-14-1918	ITEM 512 – SEALING, SEALING OF CONCRETE SURFACES	CONCRETE CULVERT	SEAL ALL PATCHED CONCRETE SURFACES MATCH E	XISTING				25	25
POR-14-2001	ITEM 512 – SEALING, SEALING OF CONCRETE SURFACES	CONCRETE CULVERT	SEAL ALL PATCHED CONCRETE SURFACES MATCH E	XISTING				50	50
	CONCILIE GONI ACES	COLVEIN							

ITEM SPECIAL - SEALING, SEALING OF CONCRETE SURFACES

SEAL ALL SURFACES OF CONCRETE USING BRIDGE COTE XL-70 W/SILANE,
LISTED ON THE APPROVED NOISE BARRIER SUPPLIER LIST UNDER
APPROVED SEALERS FOR NOISE BARRIERS LOCATED AT
https://www.transportation.ohio.gov/static/Programs/
Noise/ApprovedNoiseSuppliersList.pdf

MEET THE REQUIREMENTS OF THE BRIDGE COTE XL-70 W/SILANE
TECHNICAL DATA SHEET WITH THE EXCEPTION OF THE SURFACE
PREPARATION WILL FOLLOW THE REQUIREMENTS LISTED UNDER
CMS 512 FOR EPOXY URETHANE SEALERS.

THE COLOR OF THE SEALER SHALL BE FEDERAL COLOR NUMBER 17778 (LIGHT NEUTRAL) UNLESS SHOWN OTHERWISE IN THE SEALING TABLE.

VARIOUS
DESIGN AGENCY

VARIOUS

RIVER,

OVER MAHONING

CREEK

SILVER

OVER

REEK

OVER

VARIOUS

E SEALING DETAILS 1918, POR-183-0512

STRUCTURE

POR-

-5-0590,

OR.

<u>Δ</u>



_								
ESIGNER	CHECKER							
KMB	TJP							
REVIE	EWER							
/JA 0	6-09-22							
ROJECT ID								
110	672							
UBSET	TOTAL							
3	8							
HEET	TOTAL							

P.16 21