


ODOT Dist 4 - Portage Co - FINAL
No Passing Zone Log (POR)

Route: **0014R (SPORSR00014**C)**
 Length: **22.085** Direction: **East**

From: **6.750 LEAVE STREETSBORO**
 To: **28.835 ENTER MAH CO**

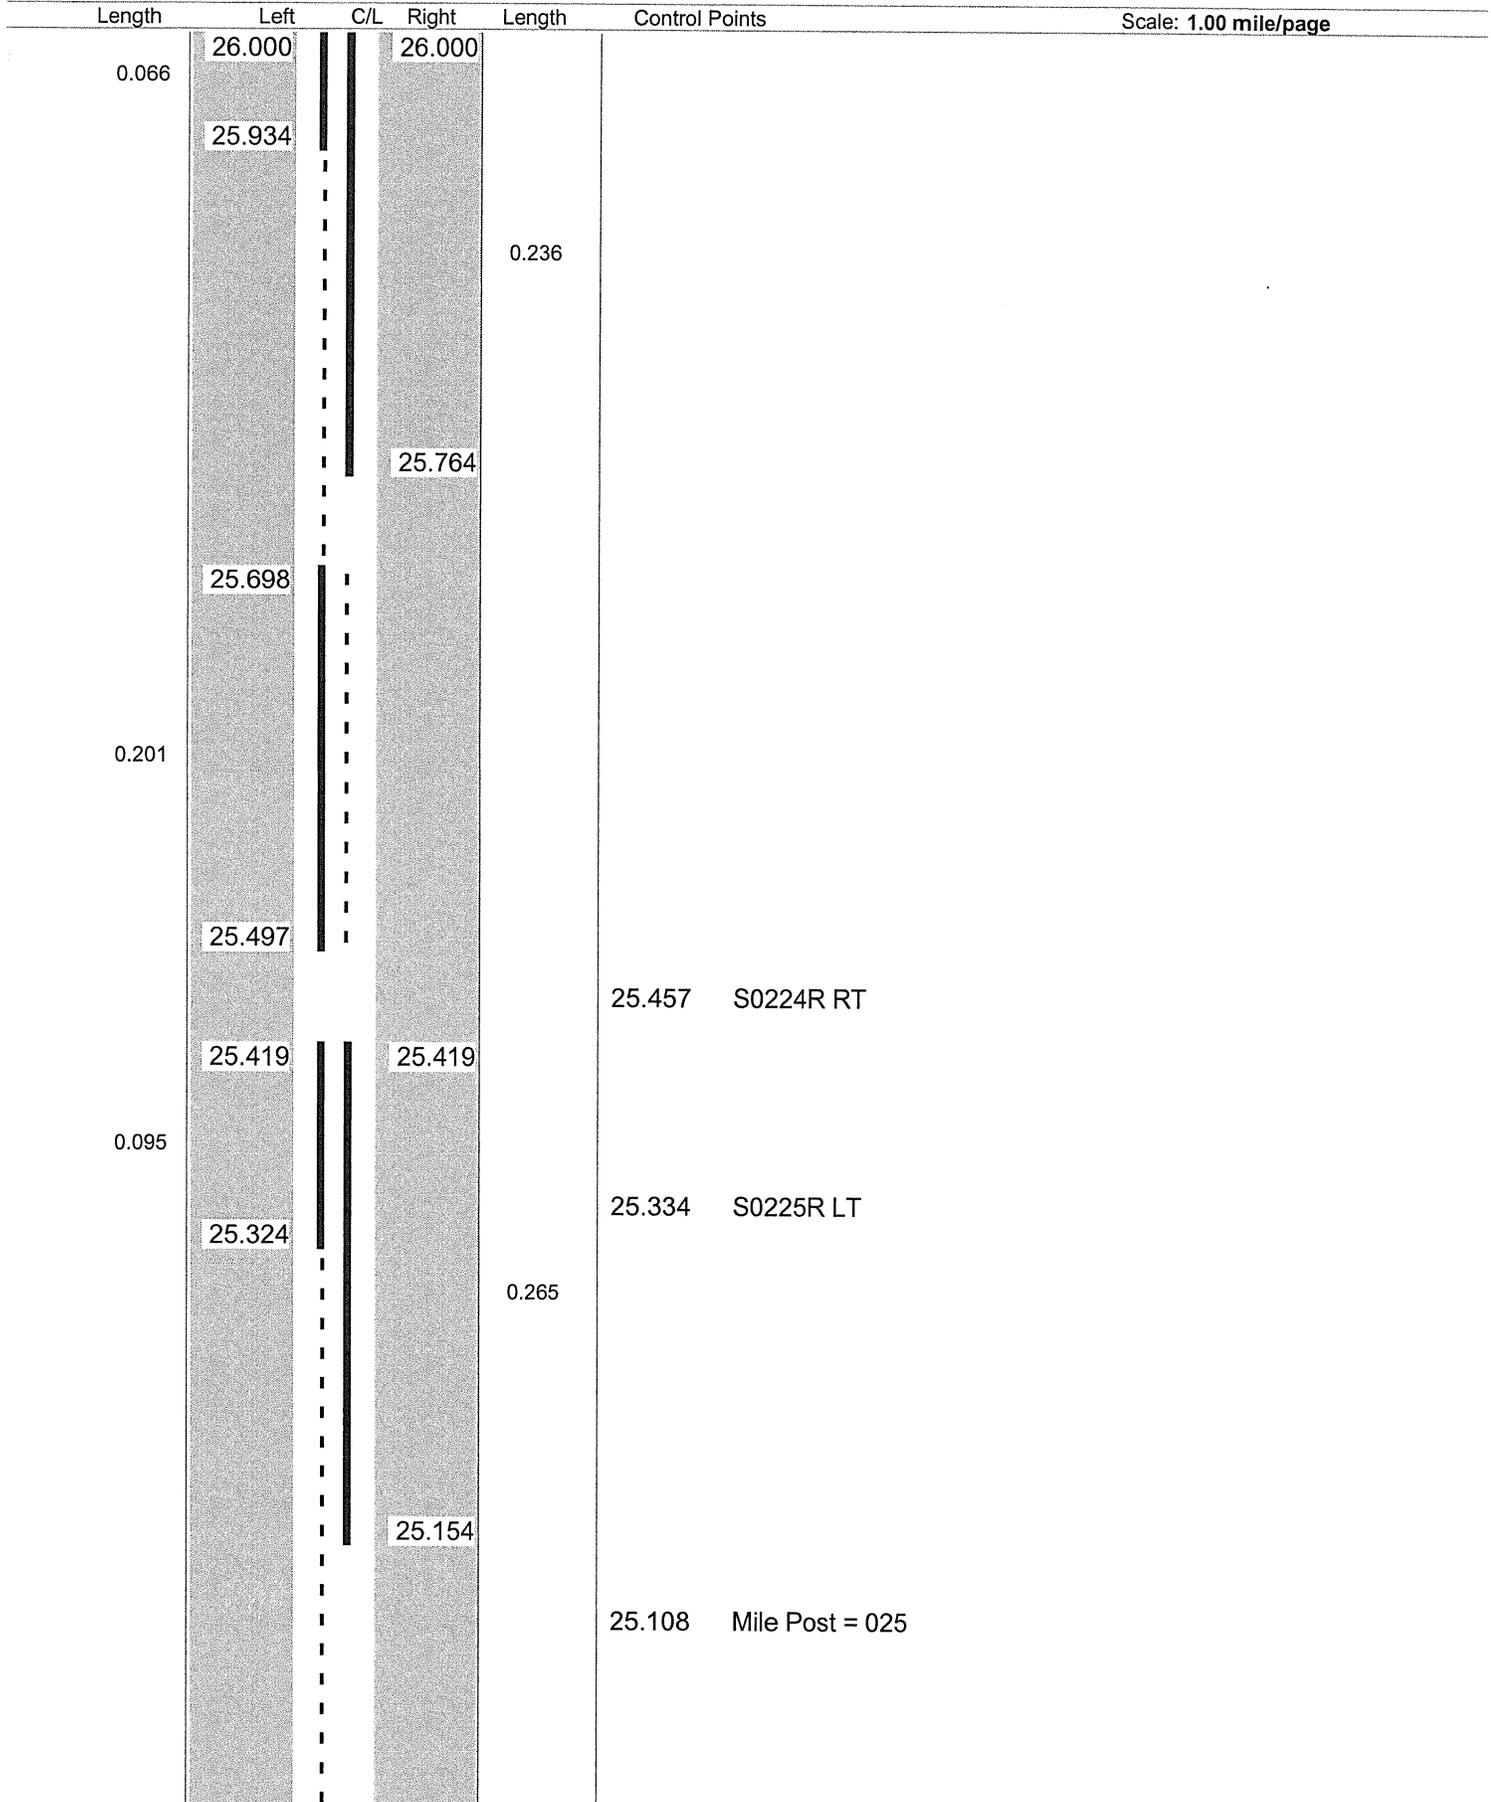

**ODOT District 4
No Passing Zone Log (POR)**

Route: 0014R (SPORSR00014**C)
Length: 0.999 Direction: East

From: 26.000 LEAVE STREETSBORO
To: 26.999 ENTER MAH CO

Length	Left	C/L	Right	Length	Control Points
			26.942		
			26.847	0.095	26.923 T0901 LAKE RT
					26.798 T0061 CARTER FORD LT
	26.648				26.578 BRIDGE
					26.537 T0904 TWIN OAKS RT
			26.478		
					26.399 T0061 BRIDGE VIEW LT
0.648					
				0.478	
					26.194 T0059 BERLIN HEIGHTS LT
					26.176 T0059 BANDT RT
					26.099 Mile Post = 026
	26.000		26.000		

**ODOT District 4
No Passing Zone Log (POR)**

Route: 0014R (SPORSR00014**C)
Length: 0.999 Direction: East

From: 27.000 LEAVE STREETSBORO
To: 27.999 ENTER MAH CO

Scale: 1.00 mile/page

Length	Left	C/L	Right	Length	Control Points
			27.999	0.050	
			27.950		
0.095	27.815				
	27.720				
			27.693		27.698 T0062 HICKORY GROVE LT
					27.662 T0062 SEBRING RT
				0.215	
			27.478		
0.095	27.160				
					27.105 Mile Post = 027
	27.065				

**ODOT District 4
No Passing Zone Log (POR)**

Route: 0014R (SPORSR00014**C)
Length: 0.835 Direction: East

From: 28.000 LEAVE STREETSBORO
To: 28.835 ENTER MAH CO

Length	Left	C/L	Right	Length	Control Points
0.021			28.835 28.814	0.021	28.835 ENTER MAH CO
0.601	28.641		28.508	0.508	28.514 T0454 HAWTHORNE LT 28.293 T0065 KIRKBRIDGE LT
	28.040		28.000		28.102 Mile Post = 028 28.031 T0058 WAGNER