

STATE OF OHIO
DEPARTMENT OF TRANSPORTATION

PRE-IR70-02.946
PREBLE COUNTY

PROJECT DESCRIPTION




BRIDGE PAINTING AND OTHER VARIOUS MAINTENANCE WORK INCLUDING SCUPPER EXTENSIONS, CONCRETE SEALING, RESETTING BEARINGS AND SEALING WEARING SURFACES. ALSO, REPLACEMENT OF RIGHT REAR APPROACH SLAB ON BRIDGE NO. PRE-70-20.101.

1997 SPECIFICATIONS

THE STANDARD SPECIFICATIONS OF THE STATE OF OHIO, DEPARTMENT OF TRANSPORTATION, INCLUDING CHANGES AND SUPPLEMENTAL SPECIFICATIONS LISTED IN THE PROPOSAL SHALL GOVERN THIS IMPROVEMENT.

I HEREBY APPROVE THESE PLANS AND DECLARE THAT THE MAKING OF THIS IMPROVEMENT WILL NOT REQUIRE THE CLOSING TO TRAFFIC OF THE HIGHWAY AND THAT PROVISIONS FOR THE MAINTENANCE AND SAFETY OF TRAFFIC WILL BE AS SET FORTH ON THE PLANS AND ESTIMATES.

TITLE SHEET ----- 1
GENERAL NOTES ----- 2-3
GENERAL SUMMARY ----- 4-5
FRAMING PLANS ----- 6-17
DETAILS ----- 18

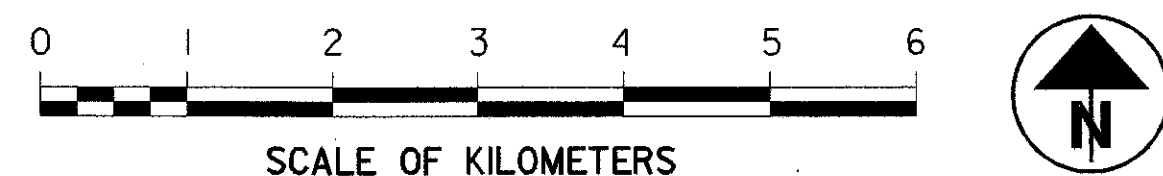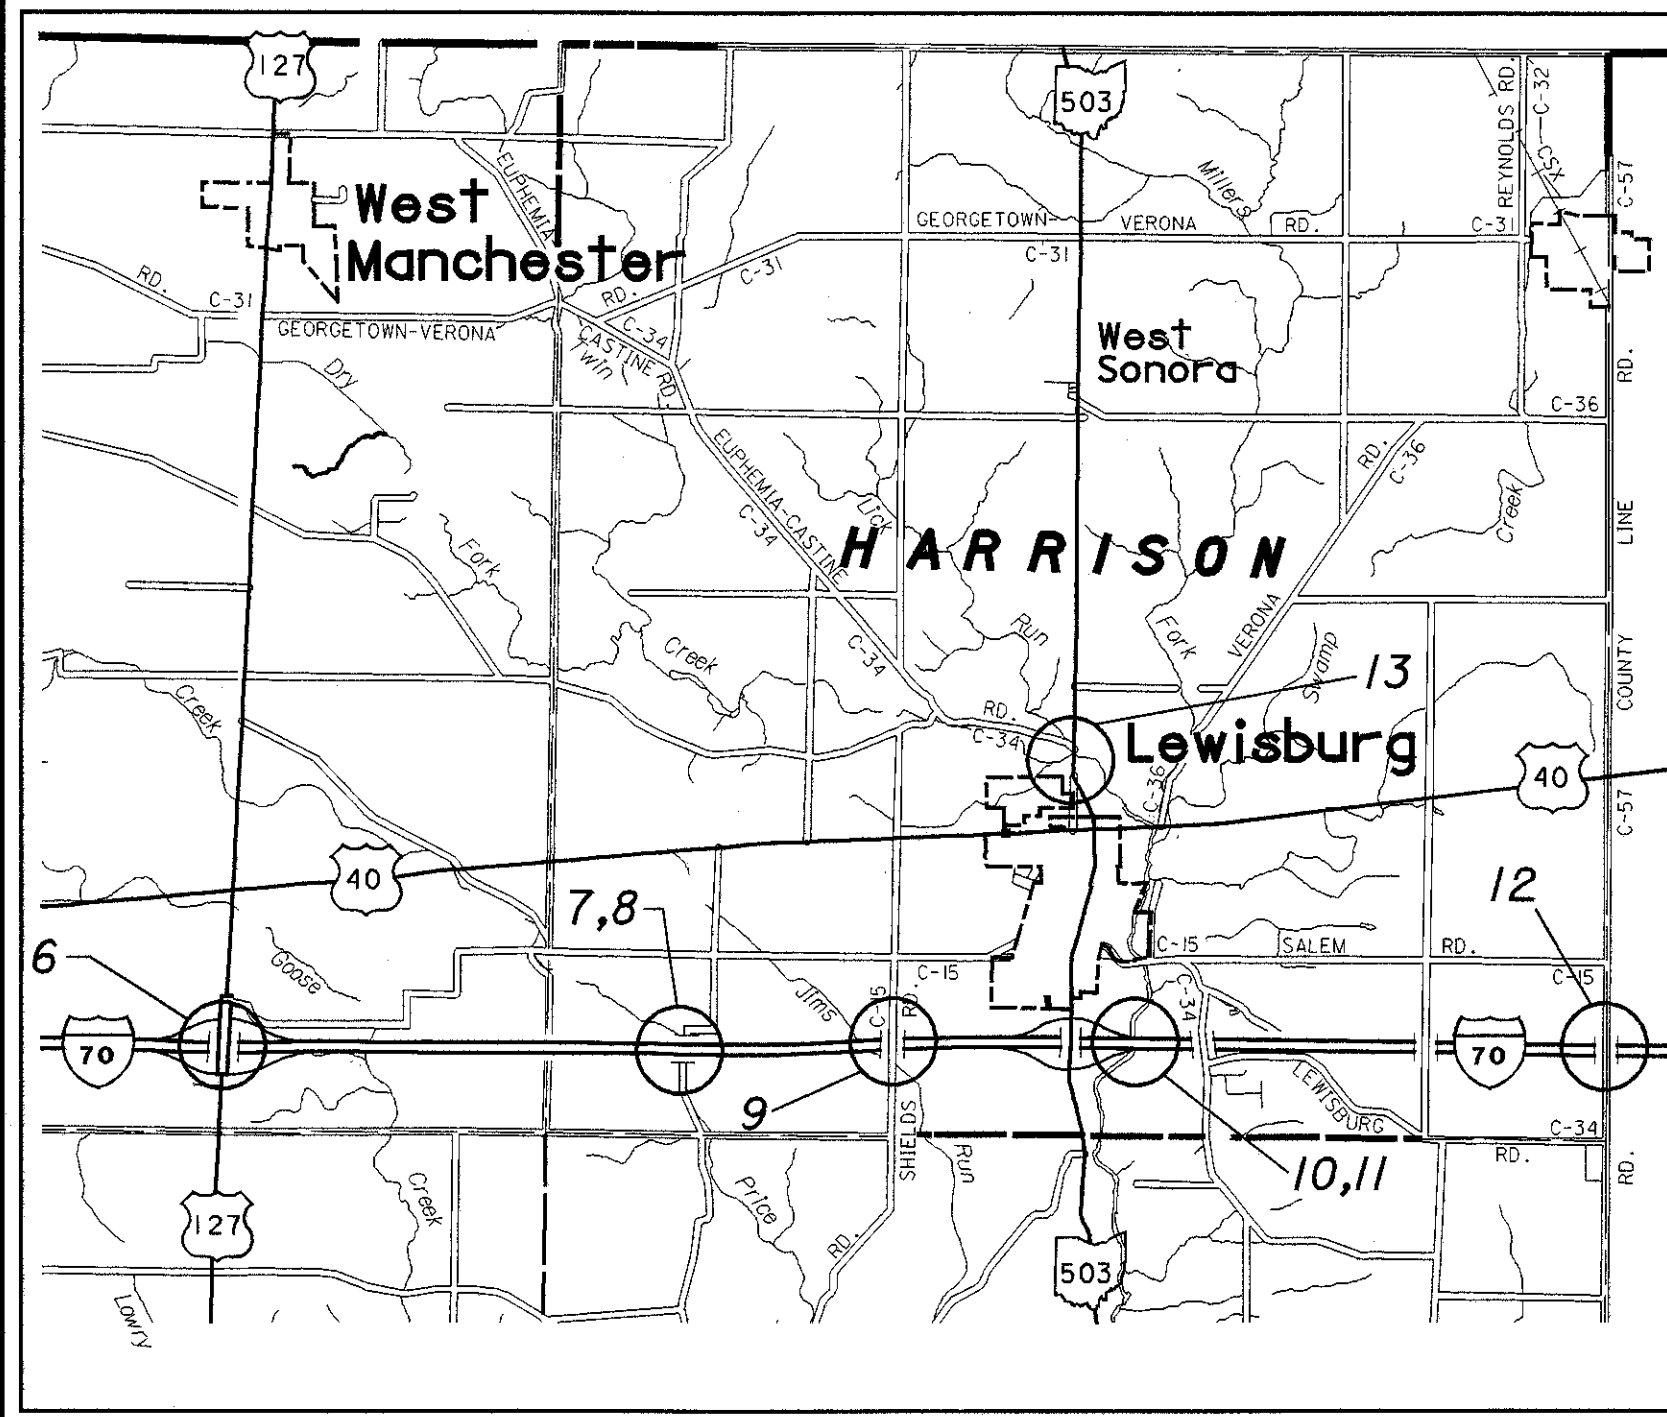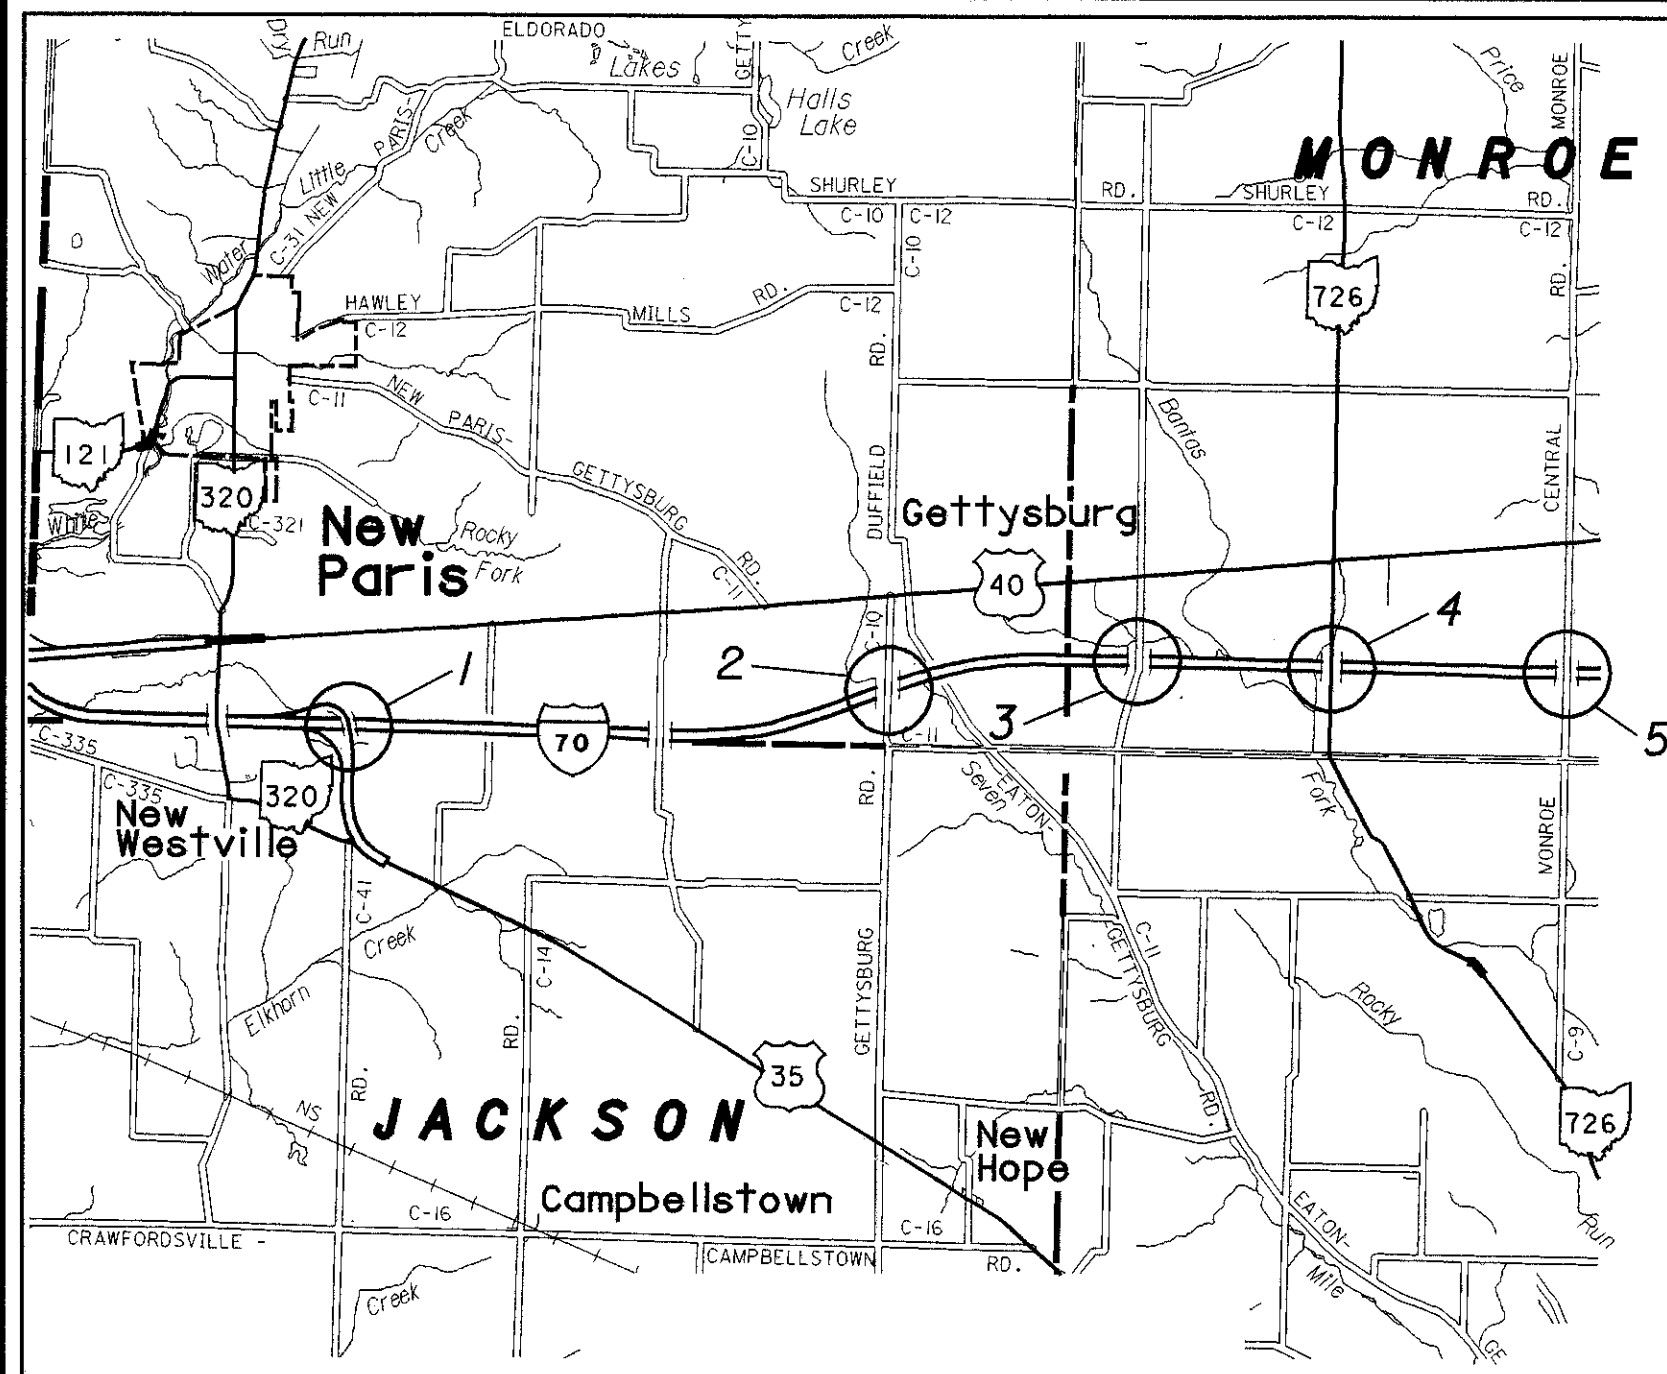

PART	COUNTY	BRIDGE NO.	INTERSECTED FEATURE
1	PRE	PRE-35-2.832L	I-70
2	PRE	PRE-70-7.870	OXFORD-GETTYSBURG RD
3	PRE	PRE-70-10.171	PENCE-SHEWMAN RD
4	PRE	PRE-726-6.888	I-70
5	PRE	PRE-70-14.033	MONROE CENTRAL RD
6	PRE	PRE-127-30.755	I-70
7	PRE	PRE-70-20.101L	PRICE RD/PRICE CREEK
8	PRE	PRE-70-20.101R	PRICE RD/PRICE CREEK
9	PRE	PRE-70-21.984	SHIELDS RD
10	PRE	PRE-70-24.140L	TWIN CREEK
11	PRE	PRE-70-24.140R	TWIN CREEK
12	PRE	PRE-70-28.421	COUNTY LINE RD
13	PRE	PRE-503-34.134	TWIN CREEK

UNDERGROUND UTILITIES
TWO WORKING DAYS
BEFORE YOU DIG
CALL 1-800-362-2764 (TOLL FREE)
OHIO UTILITIES PROTECTION SERVICE
NON-MEMBERS
MUST BE CALLED DIRECTLY

ENGINEERS SEAL:
STATE OF OHIO
SCOTT D CAMPBELL
E-56888
REGISTERED PROFESSIONAL ENGINEER
SIGNED: *[Signature]*
DATE: 12-29-98

STANDARD CONSTRUCTION DRAWINGS			SUPPLEMENTAL SPECIFICATIONS	
AS-1-81M	10-25-94		806	9-9-97
MT-35.10M	1-30-95		815	5-30-96
MT-35.11M	1-30-95		910	7-28-98
MT-95.30M	4-25-94			
MT-95.40M	4-25-94			
MT-97.10M	4-25-94			
MT-98.14M	6-24-93			
MT-98.15M	6-24-93			
MT-105.10M	4-25-94			
MT-105.11M	4-25-94			
TC-41.20M	7-1-94			
			SPECIAL PROVISIONS	

PLAN PREPARED BY:
OHIO DEPARTMENT OF
TRANSPORTATION
DIST. 8 BRIDGE PRODUCTION

APPROVED *Michael C. Flynn*
DATE 12/29/98 DISTRICT DEPUTY DIRECTOR

APPROVED *[Signature]*
DATE 1-6-99 DIRECTOR, DEPARTMENT OF
TRANSPORTATION

PRE-IR 70-2.946
990212
DIST 08
PID# 18899
04-14-99

FEDERAL PROJECT NO. **TE21-G990 (273)**
CONSTRUCTION PROJECT NO. **18899**
RAILROAD INVOLVEMENT **NONE**
PRE-IR70-02.946
18

Reference shall be made to Standard Drawings:

AS-1-81M	10-25-94	MT-98.15M	6-24-93
MT-95.30M	4-25-94	MT-105.10M	4-25-94
MT-95.40M	4-25-94	MT-105.11M	4-25-94
MT-97.10M	4-25-94	TC-41.20M	7-1-94
MT-98.14M	6-24-93		

and Supplemental Specifications:

806	9-9-97
815	5-30-96
910	7-28-98

PROPOSED WORK:

Proposed work shall be as follows for Parts 2, 3, 4, 5, 6, 7:

- 1) Reset abutment rocker bearings.
- 2) Extend scuppers so that outlet is 200mm below bottom flange.
- 3) Paint structural steel with System OZEU. Color shall be Federal Color Standard 14260 (Green).
- 4) Seal concrete surfaces with epoxy-urethane. Color shall be Federal Color Standard 37722 (Buff).

Proposed work shall be as follows for Part 1:

- 1) Extend scuppers so that outlet is 200mm below bottom flange.
- 2) Paint structural steel with System OZEU. Color shall be Federal Color Standard 14260 (Green).
- 3) Seal concrete surfaces with epoxy-urethane. Color shall be Federal Color Standard 37722 (Buff).
- 4) Seal concrete deck with Gravity-fed Resin.

Proposed work shall be as follows for Part 8:

- 1) Reset abutment rocker bearings.
- 2) Extend scuppers so that outlet is 200mm below bottom flange.
- 2) Paint structural steel with System OZEU. Color shall be Federal Color Standard 14260 (Green).
- 3) Seal concrete surfaces with epoxy-urethane. Color shall be Federal Color Standard 37722 (Buff).
- 4) Replace rear approach slab.

Proposed work shall be as follows for Parts 9 and 12:

- 1) Extend scuppers so that outlet is 200mm below bottom flange.
- 2) Paint structural steel with System OZEU. Color shall be Federal Color Standard 14260 (Green).
- 3) Seal concrete surfaces with epoxy-urethane. Color shall be Federal Color Standard 37722 (Buff).

Proposed work shall be as follows for Parts 10 and 11:

- 1) Refurbish abutment rocker bearings.
- 2) Extend scuppers so that outlet is 200mm below bottom flange.
- 3) Paint structural steel with System OZEU. Color shall be Federal Color Standard 14260 (Green).
- 4) Seal concrete surfaces with epoxy-urethane. Color shall be Federal Color Standard 37722 (Buff).

Proposed work shall be as follows for Part 13:

- 1) Paint structural steel with System OZEU. Color shall be Federal Color Standard 14260 (Green).

Note for all Parts: Paint color shall not be changed without written authorization from the District Structure Maintenance Engineer.

EXISTING STRUCTURE VERIFICATION

Details and dimensions shown on these plans pertaining to the existing structures have been obtained from plans of the existing structure and from field observations and measurements. Consequently, they are indicative of the existing structures and the proposed work but they shall be considered tentative and approximate. The Contractor is referred to CMS sections 102.05, 105.02, and 513.02.

Contract bid prices shall be based upon a recognition of the uncertainties described above and upon a prebid examination of the existing structure by the Contractor. However, all project work shall be based upon actual details and dimensions which have been verified by the Contractor in the field. Plans of the existing bridges are available for reference at the ODOT District 8 Headquarters in Lebanon, Ohio or at the Bureau of Bridges and Structural Design in Columbus, Ohio.

ITEM 614 - MAINTAINING TRAFFIC

It is the intention to perform the required work with the least inconvenience to and the maximum safety of the Contractor and the traveling public. Any variances from these maintenance of traffic notes must be approved in advance by the Director except as modified below or as shown in the maintenance of traffic plans. The requirements for maintaining traffic as indicated in the Ohio Manual of Uniform Traffic Control Devices for Streets and Highways, current edition with latest revisions, and pertinent items of the specifications and proposal shall apply.

The Contractor shall arrange his operations so as to prevent any interference to the continuous flow of traffic. All vehicles, equipment, men and their activities are restricted at all times to one side of the pavement. Vehicles and equipment shall not park or stop except within designated work areas, and shall enter and leave work areas in a manner which will not be hazardous to, or interfere with the normal traffic flow. Personal vehicles will not be permitted to park within the Right-of-Way except in specific areas designated by the Engineer.

The use of berms to maintain traffic is prohibited unless otherwise approved by the Engineer or as shown in the plans. Should any existing berm areas become damaged or destroyed due to the Contractor's negligence or failure to provide adequate signs, barricades, flagger, or other traffic control devices, the restoration of the berms will be at the Contractor's expense. A "Road Construction Ahead" sign (OW-128) shall be placed on all ramps approaching the work area for any affected parts. There shall be available on the job, at all times, eight (8) special black and orange "Watch for Stopped Traffic" signs (OW-166 1220x1220) with Type A flashing warning lights on top. There shall be two for each direction of traffic and four spares. These signs shall be mounted on a portable barricade and are to be used in the event that traffic backs up. They shall be located approximately 400 meters in advance of the backup and will be moved back as the backup increases.

For Parts 7 and 8, the contractor shall maintain a minimum of one lane on Price Road while painting the bridge over the roadway. The contractor shall use the traffic control shown on Std. Construction Drawing MT97.10M. The use of a temporary traffic signal will not be permitted. The contractor shall repair the shoulder using Item 410, Traffic Compacted Surface, As Per Plan per the direction of the Project Engineer. An estimated quantity of 20 Cu. M. has been carried to the General Summary to be used as directed by the Engineer.

For Parts 10 and 11, the contractor shall use an outside shoulder closure on I-70 for the work per Plate C-12 of the OMUTCD. In addition an estimated quantity of 100 meters Portable Concrete Barrier has been provided in the plans for protection of the workers and equipment.

The Contractor will be required to provide, erect, maintain (in proper position, keep clean and legible, and good working condition) and remove lights, signs, barricades, cones and all other traffic control devices necessary for the maintenance of traffic, including regulatory signs and pavement markings. All signs that are to convey their messages during the hours of darkness shall be reflectorized or illuminated. All signs shall be post mounted, unless otherwise directed by the Engineer. Placement of all traffic control devices shall start and proceed in the direction of the flow of traffic. Removal of traffic control devices shall start at the end of the construction area and proceed toward oncoming traffic. The Contractor shall provide for the installation of all necessary traffic control devices before beginning work and then immediate removal as soon as work is suspended or completed. One 3300 lane of traffic per direction shall be maintained at all times. (See Holiday note below).

In any instance where either the acceleration lane or the deceleration lane is shortened or obstructed due to work and/or standard lane closures, such work shall be completed "as soon as possible" so as to permit the lane closures to be moved to a location where said acceleration or deceleration lanes are no longer shortened.

No lane restrictions will be permitted during the following periods: When a holiday (Memorial Day, Fourth of July, Labor Day, Thanksgiving, Christmas, New Year and the Indianapolis 500 race and time trials) is on:

- A) Monday or Tuesday: from 12 noon on Friday before until 12 noon the following day.
- B) Wednesday: from 12 noon on the day before until 12 noon on the following day.
- C) Thursday and Friday: from 12 noon on the day before until 12 noon on the Monday following.
- D) Saturday and Sunday: From 12 noon on Friday to 12 noon on Monday.

No extensions of time shall be granted for delays in material deliveries, unless such delays are industry-wide, or for labor strikes, unless such strikes are area-wide.

Should the contractor fail to meet any of these requirements, the contractor shall be assessed liquidated damages in the amount of \$3000 per day.

A quantity of Item 614 Temporary Edge Line, Class I, 740.06 Type I is added to the summary for lane closure tapers.

COOPERATION BETWEEN CONTRACTORS

The bidders will be expected to review and comply with the provisions of 105.07 of the Construction and Materials Specifications. In addition to the requirements of the Contractors working within a project to coordinate work, the specification is expanded to include that the Contractor coordinate work and/or traffic control with adjacent ODOT projects.

PAINT MANUFACTURER'S REPRESENTATIVE

The contractor shall arrange to have a technical representative of the coating manufacturer on site during the initial application of each coat. The representative shall provide advice on mixing, equipment suitability, and application, to the Contractor and Engineer. The representative shall remain at the job site until such time as he and the Engineer agree that the contractor is qualified in all aspects of the application of the coatings. All cost associated with providing the technical representative, as specified above, shall be included in the bid price per square foot for each of the three Item 815 coating applications, Prime Coat, Intermediate Coat, and Finish Coat.

FINISH COAT INSPECTION AND CORRECTION

In addition to the requirements of Supplemental Specification 815, the following time limitation shall govern the inspection and correction of the finish coat. Upon completion of QCP #9 (Finish Coat Application), final mil readings shall be taken, and all defects shall be repaired in any work area within ten (10) days of the application of the finish coat. A work area shall be as agreed to by the Contractor and the Engineer. Failure to comply with this note shall be justification for suspension of work at other areas until such work is completed. This review does not constitute final acceptance of the area. Final review (QCP #10) and acceptance will not be made until work is completed on the entire structure.

ITEM 518 - SCUPPER MODIFICATION

This item of work shall consist of modifying the scuppers in accordance with details shown in these plans. Downspout extensions shall be 10 mm thick galvanized steel pipe. The actual length of each extension depends on the deterioration of the existing downspout as determined by the Engineer. The Contractor shall remove the deteriorated section by flame cutting and grinding the surface smooth to accommodate the new section. Joint connections shall be welded as required by 513.17. Any damaged areas resulting from this welding are to be coated with zinc rich paint. Galvanizing is to be in accordance with 711.02. Scuppers shall be cleared of all debris. All work associated with scupper modification shall be completed prior to painting the structure. Payment for the above work shall be included in the contract bid price for Item 518 - Scupper Lengthening which shall include all materials, labor, tools, and incidentals necessary to complete the item.

ITEM 202 - APPROACH SLAB REMOVED, AS PER PLAN

This item of work shall include removal of the existing backwall down to the approach slab seat. Care shall be taken during removal not to damage reinforcing steel that is to remain or existing end finishes including end dam cheese plates. Reinforcing steel or end dam finishes damaged by the Contractor during removal operations shall be replaced at no additional cost to the State. Payment for this work shall be included in the contract bid price for Item 202 Approach Slab Removed, As Per Plan.

ITEM 304 - AGGREGATE BASE, AS PER PLAN

This item of work shall include the excavation of existing base material and any other work necessary to place the proposed 150mm of 304 Aggregate Base.

ITEM 516 - RESET BEARING DEVICES

This item shall include all work necessary to properly align bridge bearings. Included shall be replacement of any damaged sheet lead (711.19), installation of any necessary steel shims of the same size as the bearings to provide a snug fit, realignment of the upper bearing plate by removing existing welds and rewelding so that the bearings are vertically aligned at 60 degrees F and lubricating sliding surfaces, and reassembly of the bearings. Note realignment of the bearing by moving the cover plate as opposed to the upper bearing plate is unacceptable. The Contractor shall be sure that all bearings are shimmed adequately and that no beams and/or bearing devices are "floating". All work shall be to the satisfaction of the Engineer. All work shall be completed prior to painting the structure. Payment for all the above described labor and materials will be made at the contract price bid for Item 516 - Reset Bearing Devices.

If during the jacking operations, cracking of the concrete superstructure, separation of the concrete deck from the steel stringers, or other damage to the structure is visually observed, the jacking operation shall immediately cease and approved supports shall be installed. The Contractor shall then analyze the damage and submit a method of correction to the Engineer for approval. Any beams that separate from the deck shall be epoxy injected for the distance of the separation in accordance with the proposal note "Concrete Repair by Epoxy Injection". Cost of this epoxy injection or other required repairs shall be borne by the Contractor.

The jacking operation shall be directed by a Professional Engineer employed by the Contractor. Failure to have a Professional Engineer present shall be cause for ceasing jacking operations.

Payment shall be made at the lump sum bid price for Item 516, Jacking and Temporary Support of Superstructure, As Per Plan and shall include all necessary tools, labor, equipment and materials necessary to complete this item of work.

ITEM 516 - REFURBISH BEARING DEVICES, AS PER PLAN

This item shall include all work necessary to properly align bridge bearings as well as their cleaning and painting. Included shall be the disassembly of the bearings, hand tool cleaning (grinding if necessary), replacement of any damaged sheet lead (711.19), installation of any necessary steel shims of the same size as the bearings to provide a snug fit, realignment of the upper bearing plate by removing existing welds and rewelding so that the bearings are vertically aligned at 60 degrees F, lubricating sliding surfaces, and reassembly of the bearings. Note realignment of the bearing by moving the cover plate as opposed to the upper bearing plate is unacceptable. The Contractor shall be sure that all bearings are shimmed adequately and that no beams and/or bearing devices are "floating". At the option of the Contractor and at no additional cost to the State, new bearings of the same type as the existing may be installed in lieu of refurbishing the bearings. All work shall be to the satisfaction of the Engineer. All work shall be completed prior to painting the structure. Payment for all the above described labor and materials will be made at the contract price bid for Item 516 - Refurbish Bearing Devices, As Per Plan.

ITEM 516, JACKING AND TEMPORARY SUPPORT OF SUPERSTRUCTURE, AS PER PLAN:

This item shall consist of furnishing all necessary labor, materials, and equipment to raise or reposition any existing structures as necessary to complete the proposed work.

The Contractor shall be responsible for the design, installation and operation of an adequate jacking system, including any temporary or permanent supports necessary to perform the work described in the project plans. Three (3) sets of jacking plans, which include the information described in this note, shall be submitted to the director for approval at least thirty (30) days before actual work is to begin. The plans shall be prepared and stamped by a registered Professional Engineer.

The entire system including jacks shall have 20% more capacity than required based on calculated loads.

Jacks shall have a swivel load cap, a domed piston head or some other device to protect against the effects of side load on the jack.

Jacks alone shall not be used to support loads except during the actual jacking operation. Temporary supports, blocking or other methods approved by the Director shall be used.

Single acting rams with no over-travel protection system shall not be used.

Spare equipment shall be available on site for the required structure raising to proceed in the event of a breakdown. A list of spare equipment shall be provided to the engineer.

At a minimum, a jacking operation shall lift all beams at any one abutment or pier simultaneously. The only exception is the situation where the work involves replacing or rehabilitating individual bearings; no permanent shimming is required and the height of the lift shall not exceed 6mm.

Maximum differential jacking height between any adjacent substructures shall be 25mm or less.

CALCULATED
CHECKED

GENERAL NOTES

PRE-IR70-02.946

3
18

ITEM	ITEM EXT.	GRAND TOTAL	UNIT	DESCRIPTION
(1) PRE-35-2.832L				
SPECIAL	51267510	771	SQ METER	SEALING OF CONCRETE SURFACES (EPOXY-URETHANE)
SPECIAL	51273500	740	SQ METER	TREATING CONCRETE BRIDGE DECKS WITH GRAVITY FED RESIN
518	12900	22	EACH	SCUPPER, LENGTHENING
815	00050	1440	SQ METER	SURFACE PREPARATION OF EXISTING STEEL, SYSTEM OZEU
815	00056	1440	SQ METER	FIELD PAINTING OF EXISTING STEEL, PRIME COAT, SYSTEM OZEU
815	00060	1440	SQ METER	FIELD PAINTING OF EXISTING STEEL, INTERMEDIATE COAT, SYSTEM OZEU
815	00066	1440	SQ METER	FIELD PAINTING OF EXISTING STEEL, FINISH COAT, SYSTEM OZEU
815	00504	100	MAN HOUR	GRINDING FINS, TEARS, SLIVERS
815	00508	113	METER	GRINDING FLANGE EDGES
(2) PRE-70-7.870				
SPECIAL	51267510	790	SQ METER	SEALING OF CONCRETE SURFACES (EPOXY-URETHANE)
516	46700	3	EACH	RESET BEARING
516	47001	LUMP	LUMP	JACKING AND TEMPORARY SUPPORT OF SUPERSTRUCTURE, AS PER PLAN
518	12900	8	EACH	SCUPPER, LENGTHENING
815	00050	1289	SQ METER	SURFACE PREPARATION OF EXISTING STEEL, SYSTEM OZEU
815	00056	1289	SQ METER	FIELD PAINTING OF EXISTING STEEL, PRIME COAT, SYSTEM OZEU
815	00060	1289	SQ METER	FIELD PAINTING OF EXISTING STEEL, INTERMEDIATE COAT, SYSTEM OZEU
815	00066	1289	SQ METER	FIELD PAINTING OF EXISTING STEEL, FINISH COAT, SYSTEM OZEU
815	00504	100	MAN HOUR	GRINDING FINS, TEARS, SLIVERS
815	00508	109	METER	GRINDING FLANGE EDGES
(3) PRE-70-10.171				
SPECIAL	51267510	741	SQ METER	SEALING OF CONCRETE SURFACES (EPOXY-URETHANE)
516	46700	1	EACH	RESET BEARING
516	47001	LUMP	LUMP	JACKING AND TEMPORARY SUPPORT OF SUPERSTRUCTURE, AS PER PLAN
518	12900	12	EACH	SCUPPER, LENGTHENING
815	00050	1110	SQ METER	SURFACE PREPARATION OF EXISTING STEEL, SYSTEM OZEU
815	00056	1110	SQ METER	FIELD PAINTING OF EXISTING STEEL, PRIME COAT, SYSTEM OZEU
815	00060	1110	SQ METER	FIELD PAINTING OF EXISTING STEEL, INTERMEDIATE COAT, SYSTEM OZEU
815	00066	1110	SQ METER	FIELD PAINTING OF EXISTING STEEL, FINISH COAT, SYSTEM OZEU
815	00504	100	MAN HOUR	GRINDING FINS, TEARS, SLIVERS
815	00508	103	METER	GRINDING FLANGE EDGES
(4) PRE-726-6.888				
SPECIAL	51267510	760	SQ METER	SEALING OF CONCRETE SURFACES (EPOXY-URETHANE)
516	46700	1	EACH	RESET BEARING
516	47001	LUMP	LUMP	JACKING AND TEMPORARY SUPPORT OF SUPERSTRUCTURE, AS PER PLAN
518	12900	12	EACH	SCUPPER, LENGTHENING
815	00050	1206	SQ METER	SURFACE PREPARATION OF EXISTING STEEL, SYSTEM OZEU
815	00056	1206	SQ METER	FIELD PAINTING OF EXISTING STEEL, PRIME COAT, SYSTEM OZEU
815	00060	1206	SQ METER	FIELD PAINTING OF EXISTING STEEL, INTERMEDIATE COAT, SYSTEM OZEU
815	00066	1206	SQ METER	FIELD PAINTING OF EXISTING STEEL, FINISH COAT, SYSTEM OZEU
815	00504	100	MAN HOUR	GRINDING FINS, TEARS, SLIVERS
815	00508	102	METER	GRINDING FLANGE EDGES

ITEM	ITEM EXT.	GRAND TOTAL	UNIT	DESCRIPTION
(5) PRE-70-14.033				
SPECIAL	51267510	737	SQ METER	SEALING OF CONCRETE SURFACES (EPOXY-URETHANE)
516	46700	2	EACH	RESET BEARING
516	47001	LUMP	LUMP	JACKING AND TEMPORARY SUPPORT OF SUPERSTRUCTURE, AS PER PLAN
518	12900	12	EACH	SCUPPER, LENGTHENING
815	00050	1114	SQ METER	SURFACE PREPARATION OF EXISTING STEEL, SYSTEM OZEU
815	00056	1114	SQ METER	FIELD PAINTING OF EXISTING STEEL, PRIME COAT, SYSTEM OZEU
815	00060	1114	SQ METER	FIELD PAINTING OF EXISTING STEEL, INTERMEDIATE COAT, SYSTEM OZEU
815	00066	1114	SQ METER	FIELD PAINTING OF EXISTING STEEL, FINISH COAT, SYSTEM OZEU
815	00504	100	MAN HOUR	GRINDING FINS, TEARS, SLIVERS
815	00508	102	METER	GRINDING FLANGE EDGES
(6) PRE-127-30.755				
SPECIAL	51267510	1012	SQ METER	SEALING OF CONCRETE SURFACES (EPOXY-URETHANE)
516	45305	11	EACH	REFURBISH BEARING DEVICE, AS PER PLAN
516	46700	5	EACH	RESET BEARING
516	47001	LUMP	LUMP	JACKING AND TEMPORARY SUPPORT OF SUPERSTRUCTURE, AS PER PLAN
518	12900	12	EACH	SCUPPER, LENGTHENING
815	00050	3033	SQ METER	SURFACE PREPARATION OF EXISTING STEEL, SYSTEM OZEU
815	00056	3033	SQ METER	FIELD PAINTING OF EXISTING STEEL, PRIME COAT, SYSTEM OZEU
815	00060	3033	SQ METER	FIELD PAINTING OF EXISTING STEEL, INTERMEDIATE COAT, SYSTEM OZEU
815	00066	3033	SQ METER	FIELD PAINTING OF EXISTING STEEL, FINISH COAT, SYSTEM OZEU
815	00504	100	MAN HOUR	GRINDING FINS, TEARS, SLIVERS
815	00508	103	METER	GRINDING FLANGE EDGES
(7) PRE-70-20.101L				
SPECIAL	51267510	81	SQ METER	SEALING OF CONCRETE SURFACES (EPOXY-URETHANE)
516	46700	2	EACH	RESET BEARING
516	47001	LUMP	LUMP	JACKING AND TEMPORARY SUPPORT OF SUPERSTRUCTURE, AS PER PLAN
518	12900	18	EACH	SCUPPER, LENGTHENING
815	00050	1352	SQ METER	SURFACE PREPARATION OF EXISTING STEEL, SYSTEM OZEU
815	00056	1352	SQ METER	FIELD PAINTING OF EXISTING STEEL, PRIME COAT, SYSTEM OZEU
815	00060	1352	SQ METER	FIELD PAINTING OF EXISTING STEEL, INTERMEDIATE COAT, SYSTEM OZEU
815	00066	1352	SQ METER	FIELD PAINTING OF EXISTING STEEL, FINISH COAT, SYSTEM OZEU
815	00504	100	MAN HOUR	GRINDING FINS, TEARS, SLIVERS
(8) PRE-70-20.101R				
202	22901	59	SQ METER	APPROACH SLAB REMOVED, AS PER PLAN
301	46010	1.4	CU METER	BITUMINOUS AGGREGATE BASE, PG64-28
304	20001	8.4	CU METER	AGGREGATE BASE, AS PER PLAN
410	14001	20	CU METER	TRAFFIC COMPACTED SURFACE, AS PER PLAN
448	47020	0.4	CU METER	ASPHALT CONCRETE SURFACE COURSE, TYPE I, PG64-22
511	51100	1.0	CU METER	CLASS C CONCRETE, MISC.: BACKWALL
SPECIAL	51267510	96	SQ METER	SEALING OF CONCRETE SURFACES (EPOXY-URETHANE)
516	46700	2	EACH	RESET BEARING
516	47001	LUMP	LUMP	JACKING AND TEMPORARY SUPPORT OF SUPERSTRUCTURE, AS PER PLAN
518	12900	18	EACH	SCUPPER, LENGTHENING
611	25000	56	SQ METER	REINFORCED CONCRETE APPROACH SLAB (T=380MM)
815	00050	1352	SQ METER	SURFACE PREPARATION OF EXISTING STEEL, SYSTEM OZEU
815	00056	1352	SQ METER	FIELD PAINTING OF EXISTING STEEL, PRIME COAT, SYSTEM OZEU
815	00060	1352	SQ METER	FIELD PAINTING OF EXISTING STEEL, INTERMEDIATE COAT, SYSTEM OZEU
815	00066	1352	SQ METER	FIELD PAINTING OF EXISTING STEEL, FINISH COAT, SYSTEM OZEU
815	00504	100	MAN HOUR	GRINDING FINS, TEARS SLIVERS

CALCULATED B.J.F. CHECKED

GENERAL SUMMARY


PRE-IR70-02.946

4
18

ITEM	ITEM EXT.	GRAND TOTAL	UNIT	DESCRIPTION
(9) PRE-70-21.984				
SPECIAL	51267510	762	SQ METER	SEALING OF CONCRETE SURFACES (EPOXY-URETHANE)
518	12900	12	EACH	SCUPPER, LENGTHENING
815	00050	1208	SQ METER	SURFACE PREPARATION OF EXISTING STEEL, SYSTEM OZEU
815	00056	1208	SQ METER	FIELD PAINTING OF EXISTING STEEL, PRIME COAT, SYSTEM OZEU
815	00060	1208	SQ METER	FIELD PAINTING OF EXISTING STEEL, INTERMEDIATE COAT, SYSTEM OZEU
815	00066	1208	SQ METER	FIELD PAINTING OF EXISTING STEEL, FINISH COAT, SYSTEM OZEU
815	00504	100	MAN HOUR	GRINDING FINS, TEARS, SLIVERS
815	00508	103	METER	GRINDING FLANGE EDGES
(10) PRE-70-24.140L				
SPECIAL	51267510	81	SQ METER	SEALING OF CONCRETE SURFACES (EPOXY-URETHANE)
516	45304	5	EACH	REFURBISH BEARING DEVICE
516	47001	LUMP	LUMP	JACKING AND TEMPORARY SUPPORT OF SUPERSTRUCTURE, AS PER PLAN
518	12900	26	EACH	SCUPPER, LENGTHENING
815	00050	1511	SQ METER	SURFACE PREPARATION OF EXISTING STEEL, SYSTEM OZEU
815	00056	1511	SQ METER	FIELD PAINTING OF EXISTING STEEL, PRIME COAT, SYSTEM OZEU
815	00060	1511	SQ METER	FIELD PAINTING OF EXISTING STEEL, INTERMEDIATE COAT, SYSTEM OZEU
815	00066	1511	SQ METER	FIELD PAINTING OF EXISTING STEEL, FINISH COAT, SYSTEM OZEU
815	00504	100	MAN HOUR	GRINDING FINS, TEARS, SLIVERS
(11) PRE-70-24.140R				
SPECIAL	51267510	96	SQ METER	SEALING OF CONCRETE SURFACES (EPOXY-URETHANE)
516	45304	5	EACH	REFURBISH BEARING DEVICE
516	47001	LUMP	LUMP	JACKING AND TEMPORARY SUPPORT OF SUPERSTRUCTURE, AS PER PLAN
518	12900	26	EACH	SCUPPER, LENGTHENING
815	00050	1804	SQ METER	SURFACE PREPARATION OF EXISTING STEEL, SYSTEM OZEU
815	00056	1804	SQ METER	FIELD PAINTING OF EXISTING STEEL, PRIME COAT, SYSTEM OZEU
815	00060	1804	SQ METER	FIELD PAINTING OF EXISTING STEEL, INTERMEDIATE COAT, SYSTEM OZEU
815	00066	1804	SQ METER	FIELD PAINTING OF EXISTING STEEL, FINISH COAT, SYSTEM OZEU
815	00504	100	MAN HOUR	GRINDING FINS, TEARS, SLIVERS
(12) PRE-70-28.421				
SPECIAL	51267510	722	SQ METER	SEALING OF CONCRETE SURFACES (EPOXY-URETHANE)
518	12900	12	EACH	SCUPPER, LENGTHENING
815	00050	1122	SQ METER	SURFACE PREPARATION OF EXISTING STEEL, SYSTEM OZEU
815	00056	1122	SQ METER	FIELD PAINTING OF EXISTING STEEL, PRIME COAT, SYSTEM OZEU
815	00060	1122	SQ METER	FIELD PAINTING OF EXISTING STEEL, INTERMEDIATE COAT, SYSTEM OZEU
815	00066	1122	SQ METER	FIELD PAINTING OF EXISTING STEEL, FINISH COAT, SYSTEM OZEU
815	00504	100	MAN HOUR	GRINDING FINS, TEARS, SLIVERS
815	00508	102	METER	GRINDING FLANGE EDGES
(13) PRE-503-34.134				
815	00050	520	SQ METER	SURFACE PREPARATION OF EXISTING STEEL, SYSTEM OZEU
815	00056	520	SQ METER	FIELD PAINTING OF EXISTING STEEL, PRIME COAT, SYSTEM OZEU
815	00060	520	SQ METER	FIELD PAINTING OF EXISTING STEEL, INTERMEDIATE COAT, SYSTEM OZEU
815	00066	520	SQ METER	FIELD PAINTING OF EXISTING STEEL, FINISH COAT, SYSTEM OZEU
815	00504	100	MAN HOUR	GRINDING FINS, TEARS, SLIVERS

ITEM	ITEM EXT.	GRAND TOTAL	UNIT	DESCRIPTION
MAINTAINING TRAFFIC				
614	11000	LUMP	LUMP	MAINTAINING TRAFFIC
614	13300	415	EACH	BARRIER REFLECTORS, TYPE B
614	13350	400	EACH	OBJECT MARKERS
614	22200	10	KILOMETER	TEMPORARY EDGE LINE, CLASS I, 740.06, TYPE I
622	40020	5800	METER	PORTABLE CONCRETE BARRIER, 813MM
624	10000	LUMP	LUMP	MOBILIZATION
806	16000	6	MNTH	FIELD OFFICE, TYPE A

CALCULATED B.J.F.	GENERAL SUMMARY
CHECKED	
PRE-IR70-02.946	
5 18	

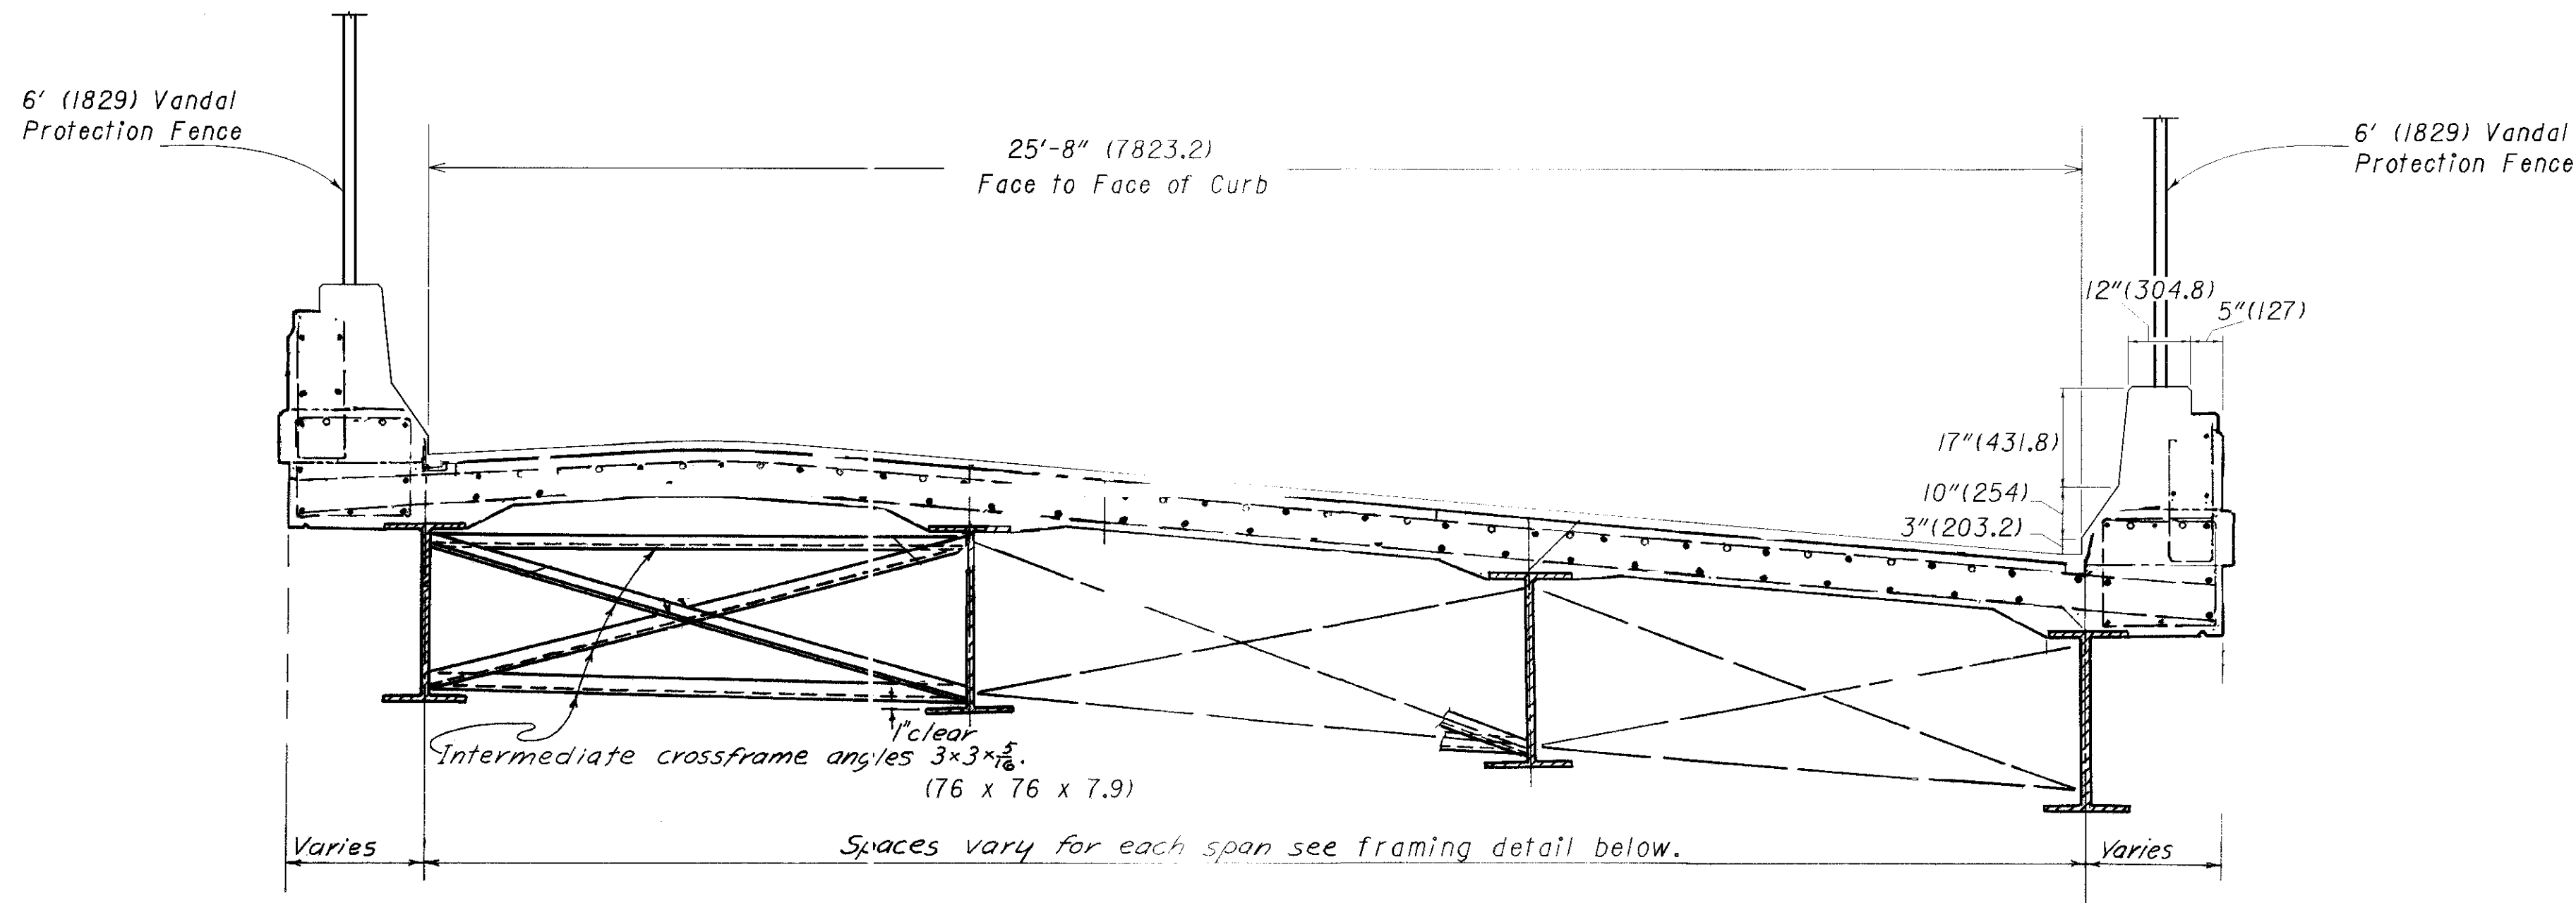

EXISTING TRANSVERSE DECK SECTION

Note: All horizontal dimensions are radial.


Bridge No. PRE-35-2.832L - PART 1

Proposed work shall be as follows:

- 1) Extend scuppers so that outlet is 200mm below bottom flange.
- 2) Paint structural steel with System OZEU. Color shall be Federal Color Standard 14260 (Green).
- 3) Seal concrete surfaces with epoxy-urethane. Color shall be Federal Color Standard 37722 (Buff).
- 4) Seal concrete deck with gravity-fed resin.


For standard details, see sheet 18/18.

Note: Drawings of existing structure are scanned from the original drawing. Dimensions shown are from original construction plans and have not been field verified. Contractor is responsible for field verification of dimensions. Dimension shown in parentheses are metric conversions (millimeters) from the english dimensions.

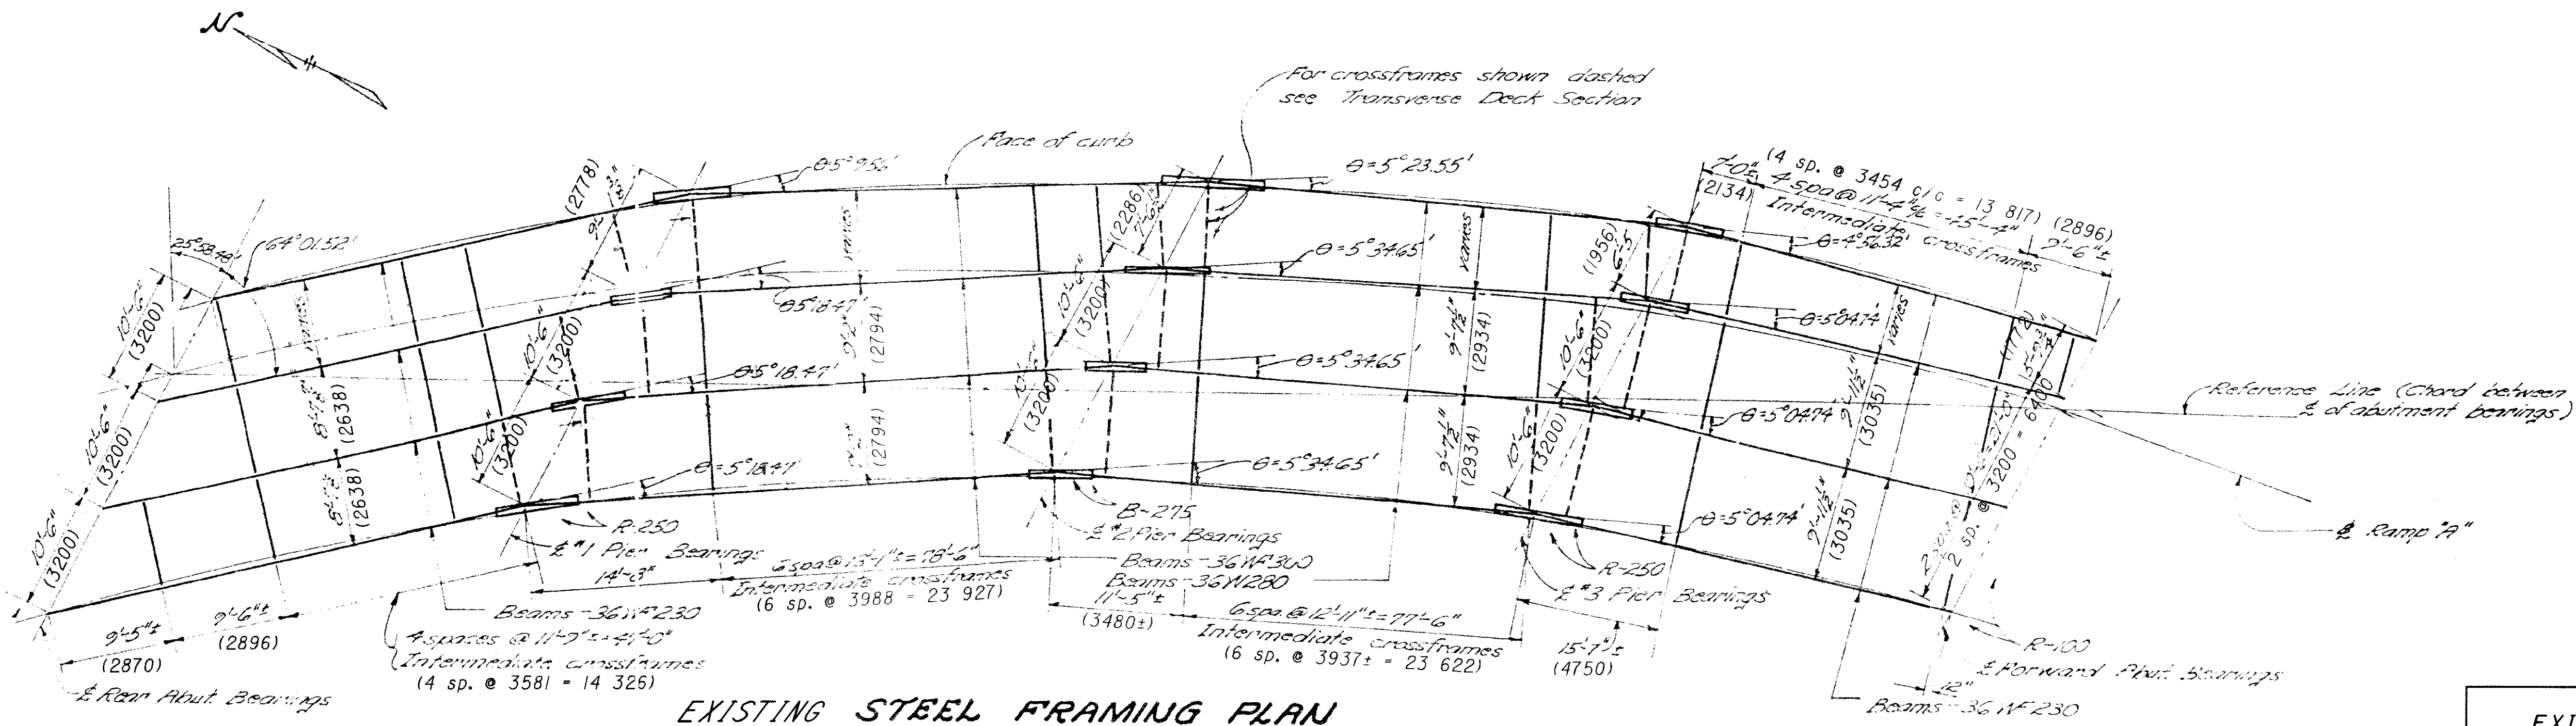


EXISTING STEEL FRAMING PLAN

EXISTING STRUCTURE DATA	
TYPE:	Continuous steel beams with reinforced conc. deck and substructure
SPANS:	19 812, 28 285, 26 975, 18 898 c/c brgs.
ROADWAY:	7823 1/1 f curbs
LOAD FREQUENCY:	CF=2000(57)
SKEW:	25°45'29" L.F.
ALIGNMENT:	6° R.C.

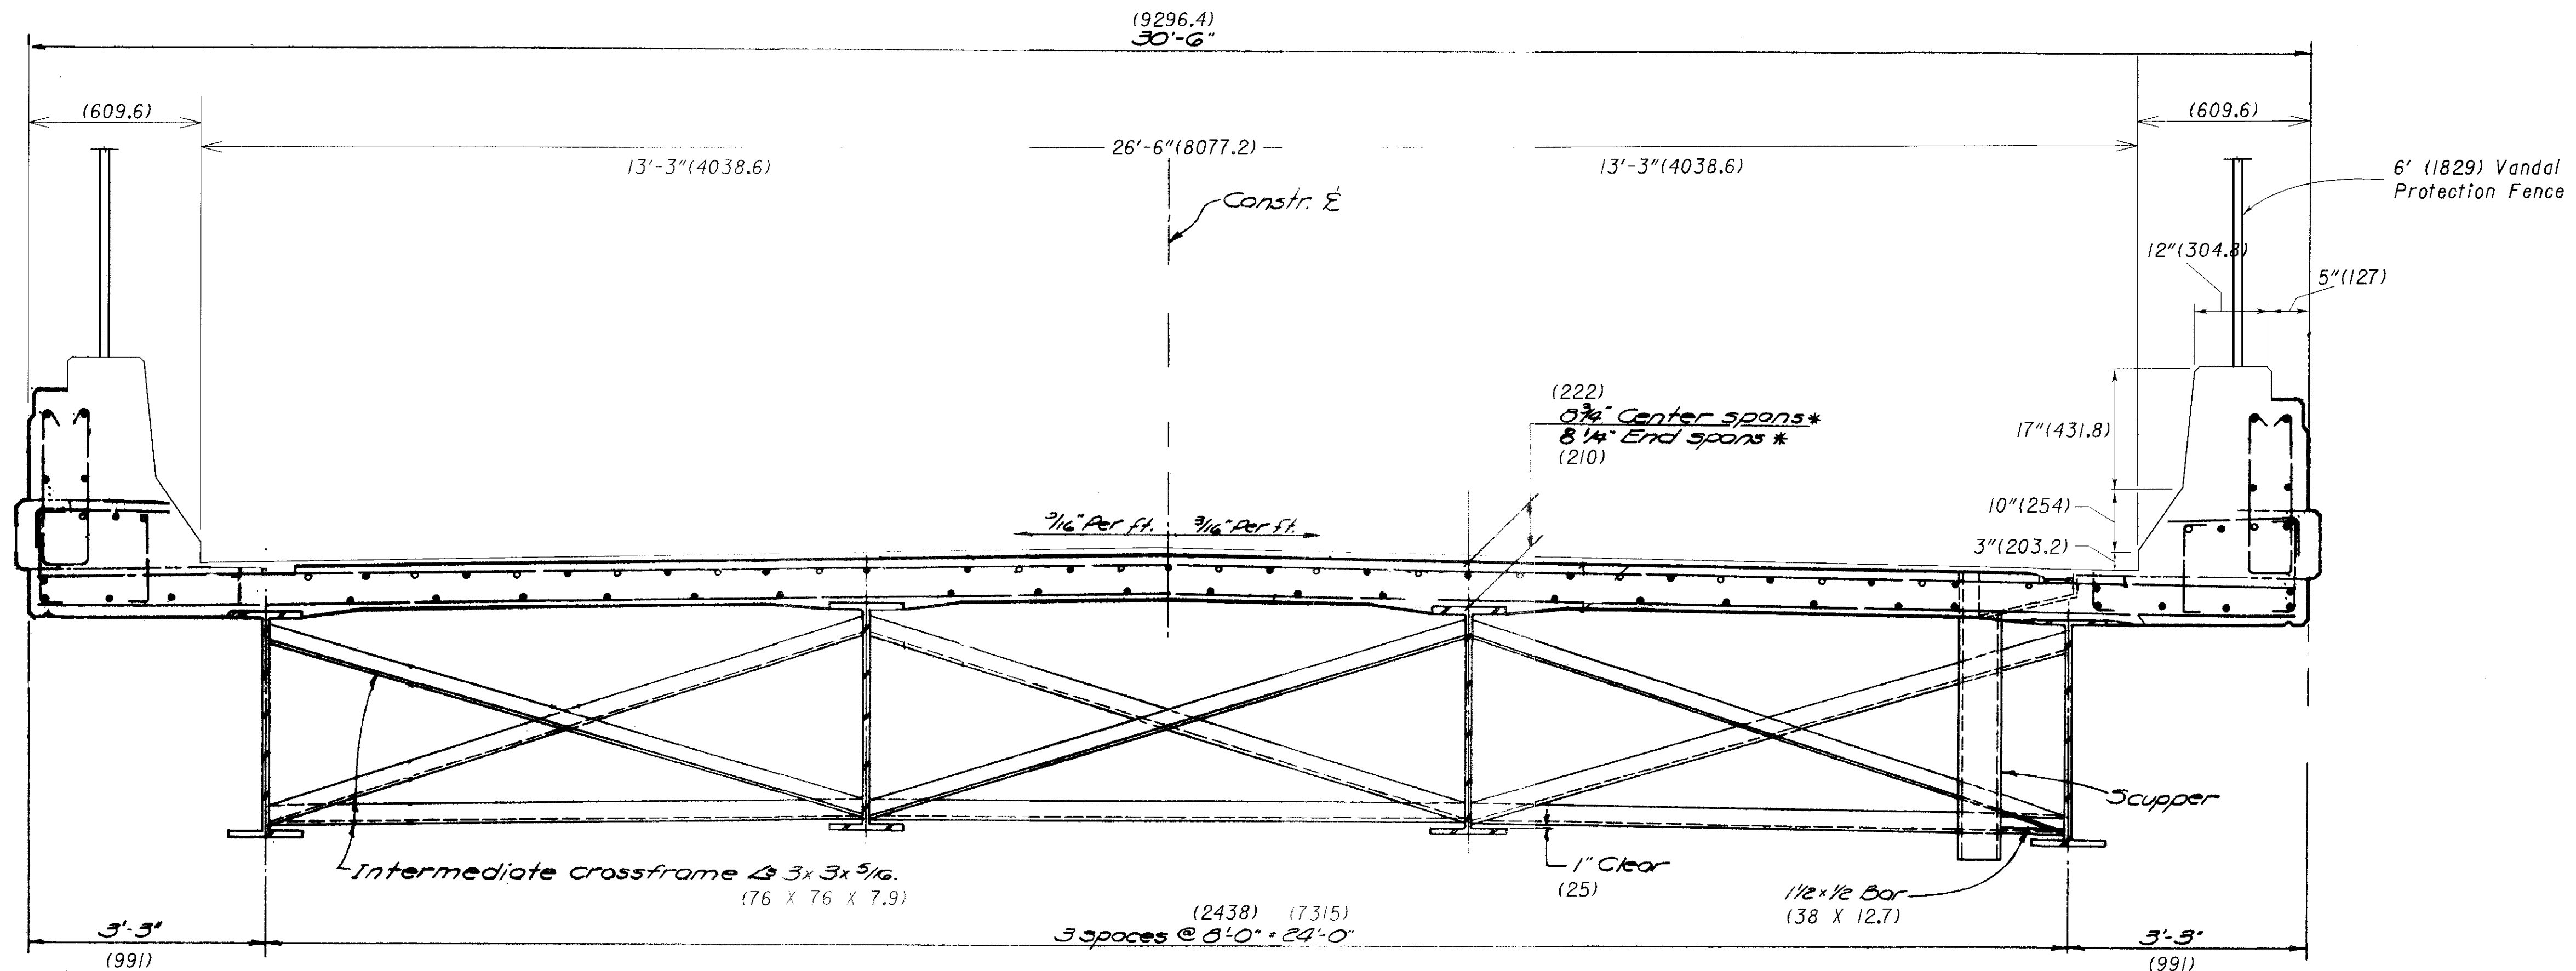

EXISTING TYPICAL TRANSVERSE DECK SECTION

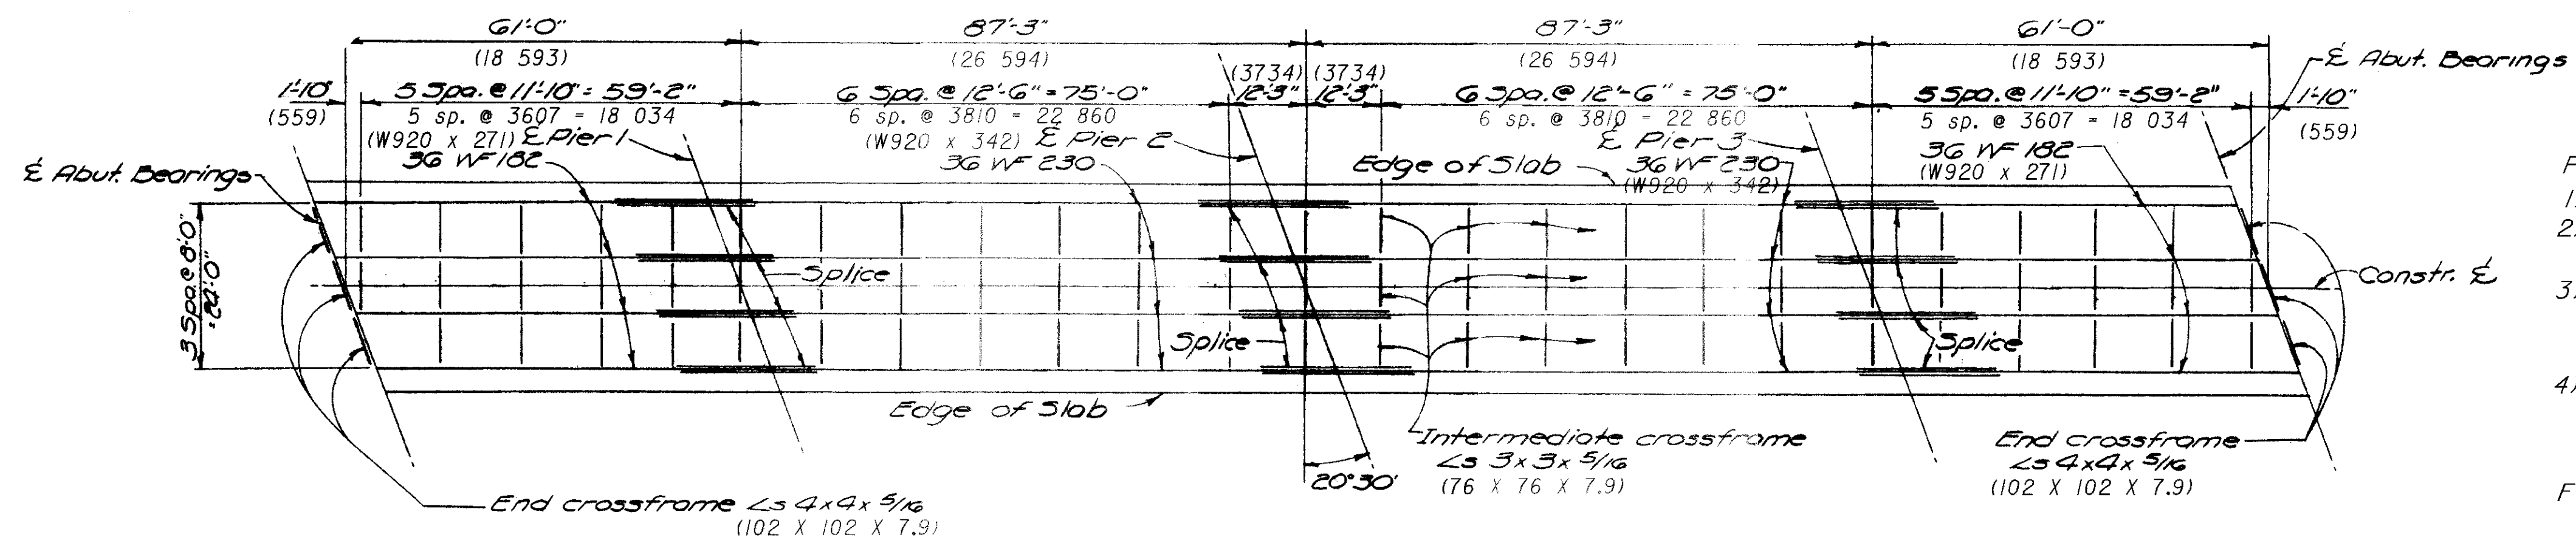


EXISTING OUTLINE OF STEEL FRAMING

- Proposed work shall be as follows for PART 2:
- 1) Reset abutment rocker bearings.
 - 2) Extend scuppers so that outlet is 200mm below bottom flange.
 - 3) Paint structural steel with System OZEU. Color shall be Federal Color Standard 14260 (Green).
 - 4) Seal concrete surfaces with epoxy-urethane. Color shall be Federal Color Standard 37722 (Buff).
- For standard details, see sheet 18/18.


EXISTING STRUCTURE DATA

TYPE: Continuous steel beams with reinforced conc. deck and substructure
 SPANS: 18 593, 26 594, 26 594, 18 593 c/c brgs.
 ROADWAY: 8077 f/f
 LOAD FREQUENCY: CF=130(57)
 SKEW: 20°30' R.F.
 ALIGNMENT: Tangent

Note: Drawings of existing structure are scanned from the original drawing. Dimensions shown are from original construction plans and have not been field verified. Contractor is responsible for field verification of dimensions. Dimension shown in parentheses are metric conversions (millimeters) from the english dimensions.

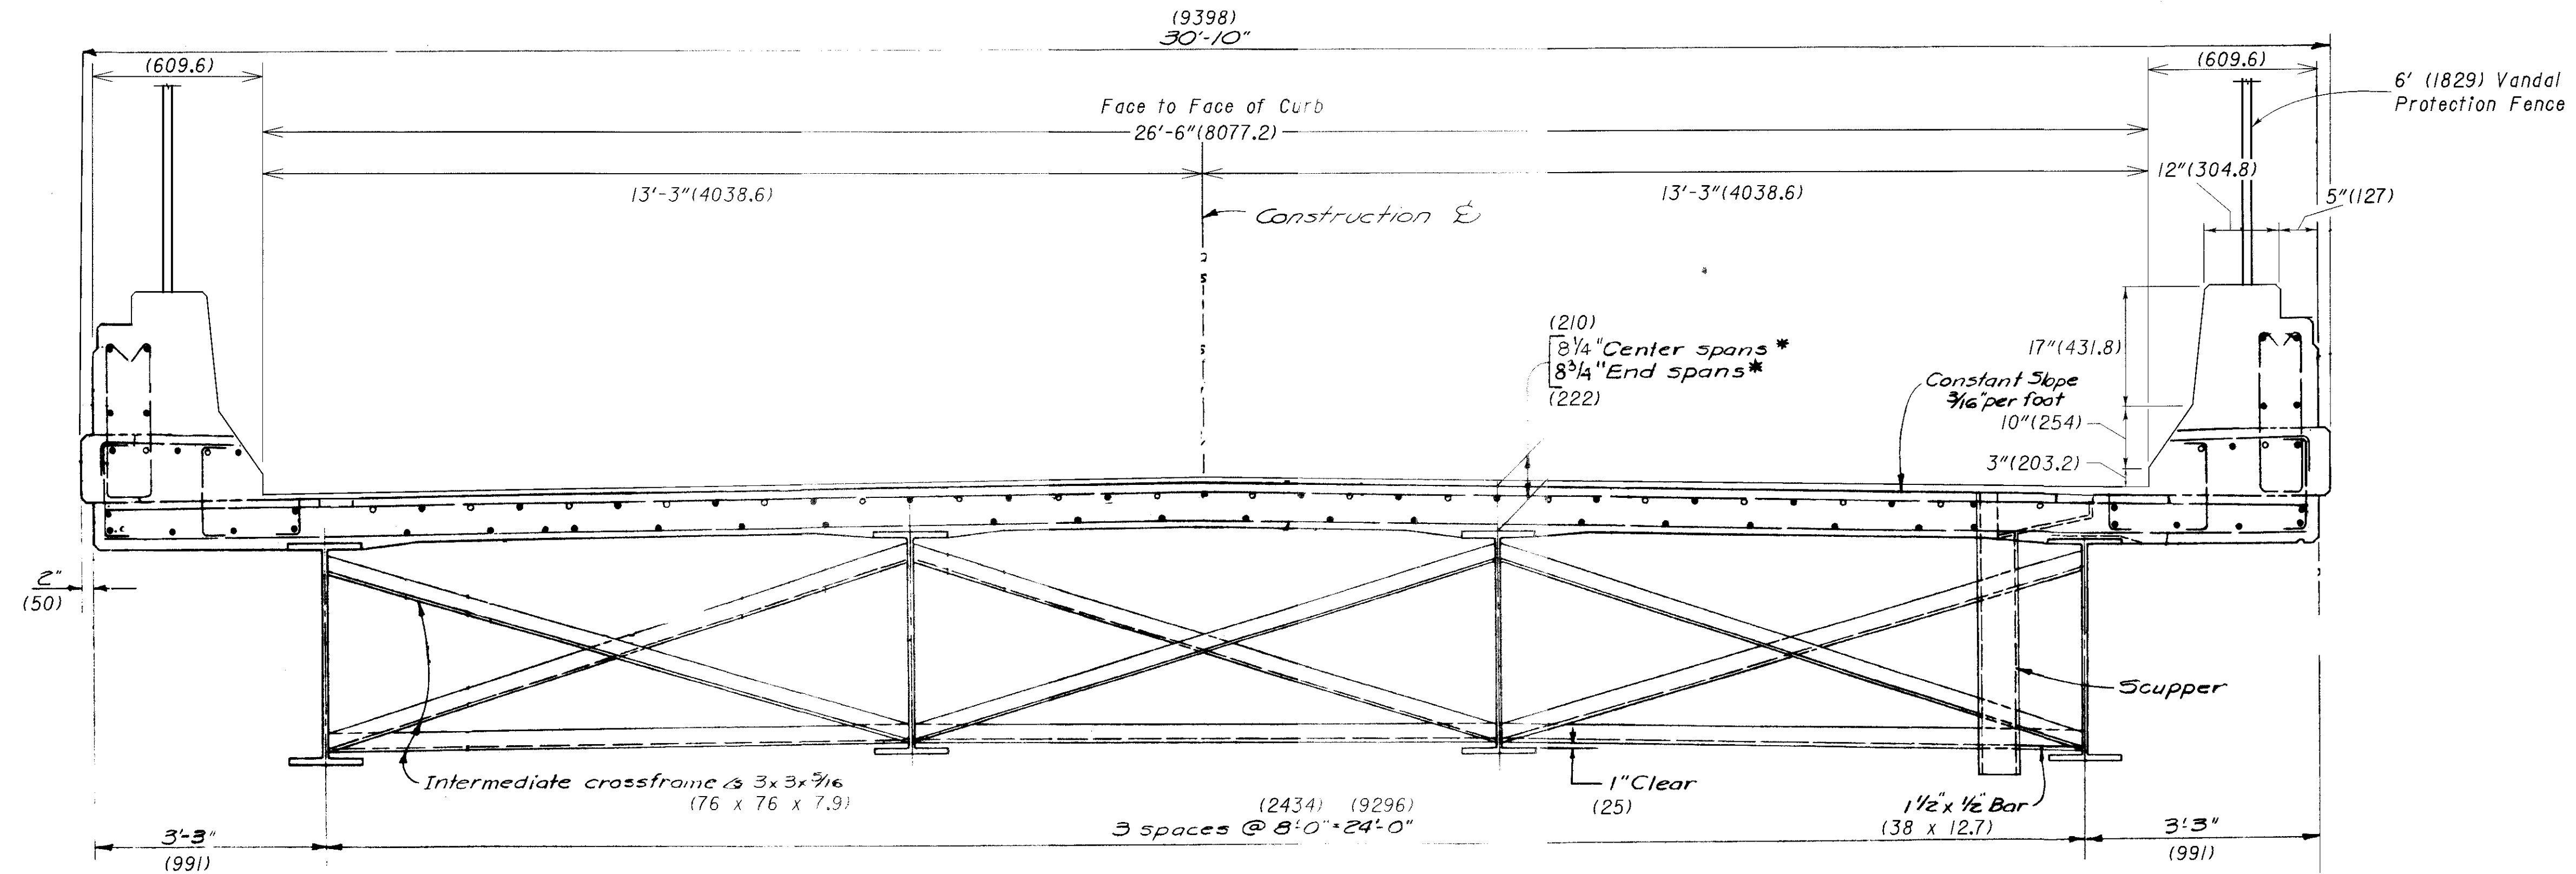

EXISTING TYPICAL TRANSVERSE DECK SECTION

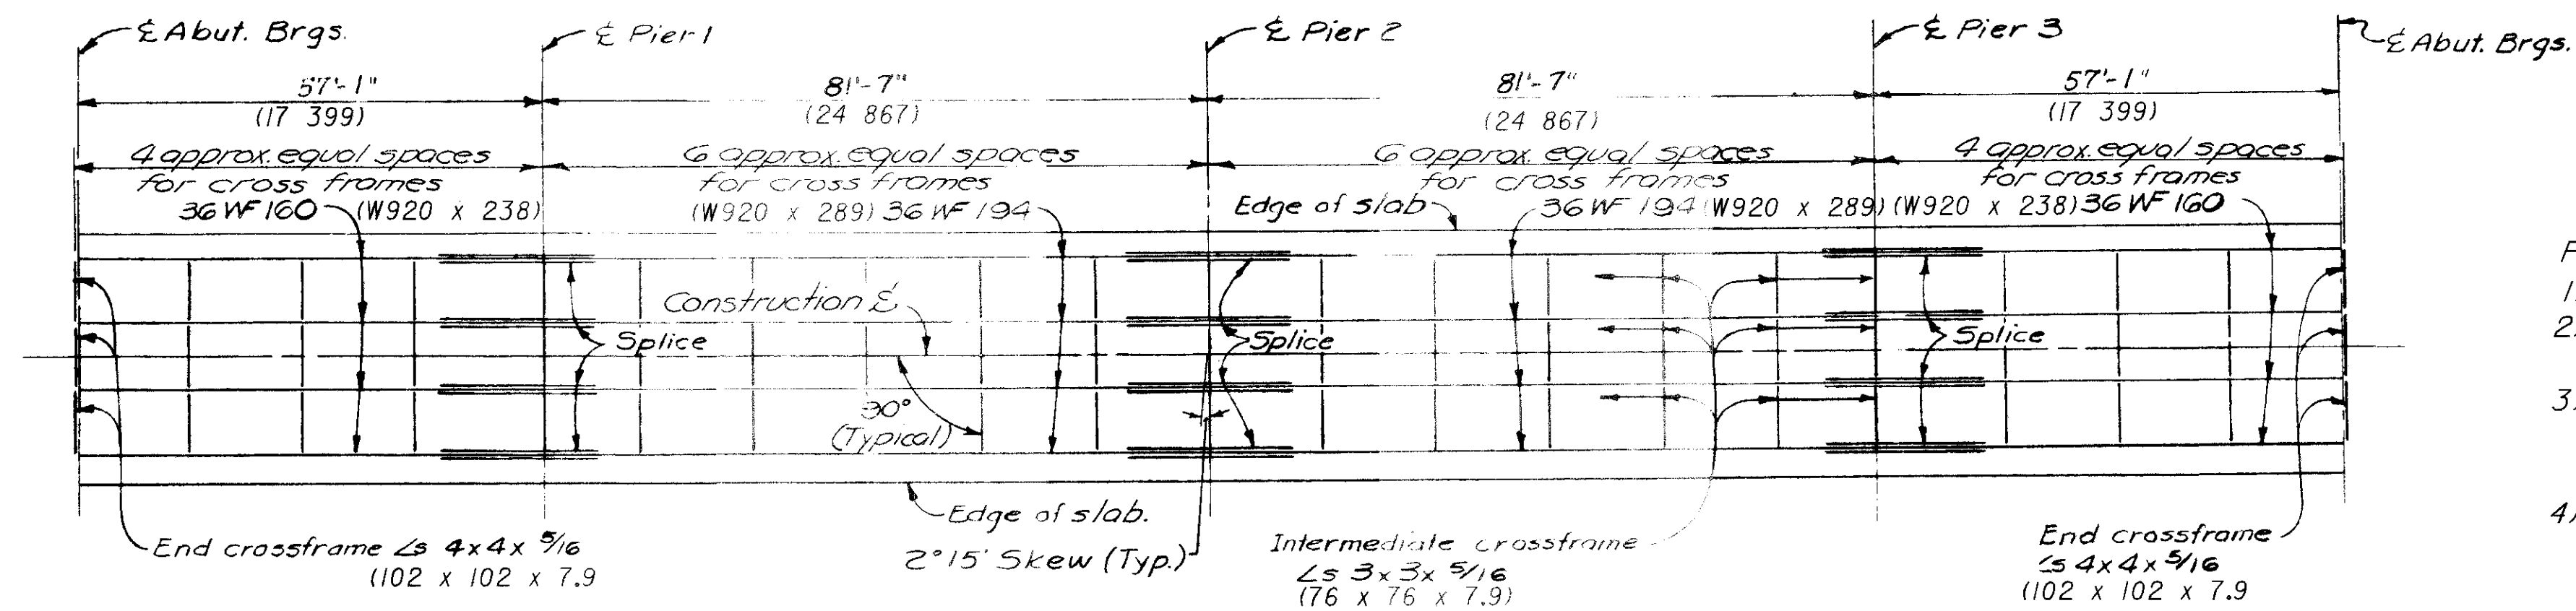


EXISTING OUTLINE OF STEEL FRAMING

- Proposed work shall be as follows for PART 3:
- 1) Reset abutment rocker bearings.
 - 2) Extend scuppers so that outlet is 200mm below bottom flange.
 - 3) Paint structural steel with System OZEU. Color shall be Federal Color Standard 14260 (Green).
 - 4) Seal concrete surfaces with epoxy-urethane. Color shall be Federal Color Standard 37722 (Buff).
- For standard details, see sheet 18/18.


Note: Drawings of existing structure are scanned from the original drawing. Dimensions shown are from original construction plans and have not been field verified. Contractor is responsible for field verification of dimensions. Dimension shown in parentheses are metric conversions (millimeters) from the english dimensions.

EXISTING STRUCTURE DATA

TYPE: Continuous steel beams with reinforced conc. deck and substructure
 SPANS: 17 399, 24 867, 24 867, 17 399 c/c brgs.
 ROADWAY: 8077 f/f curb
 LOAD FREQUENCY: CF-130(57)
 SKEW: 2°15' R.F.
 ALIGNMENT: Tangent

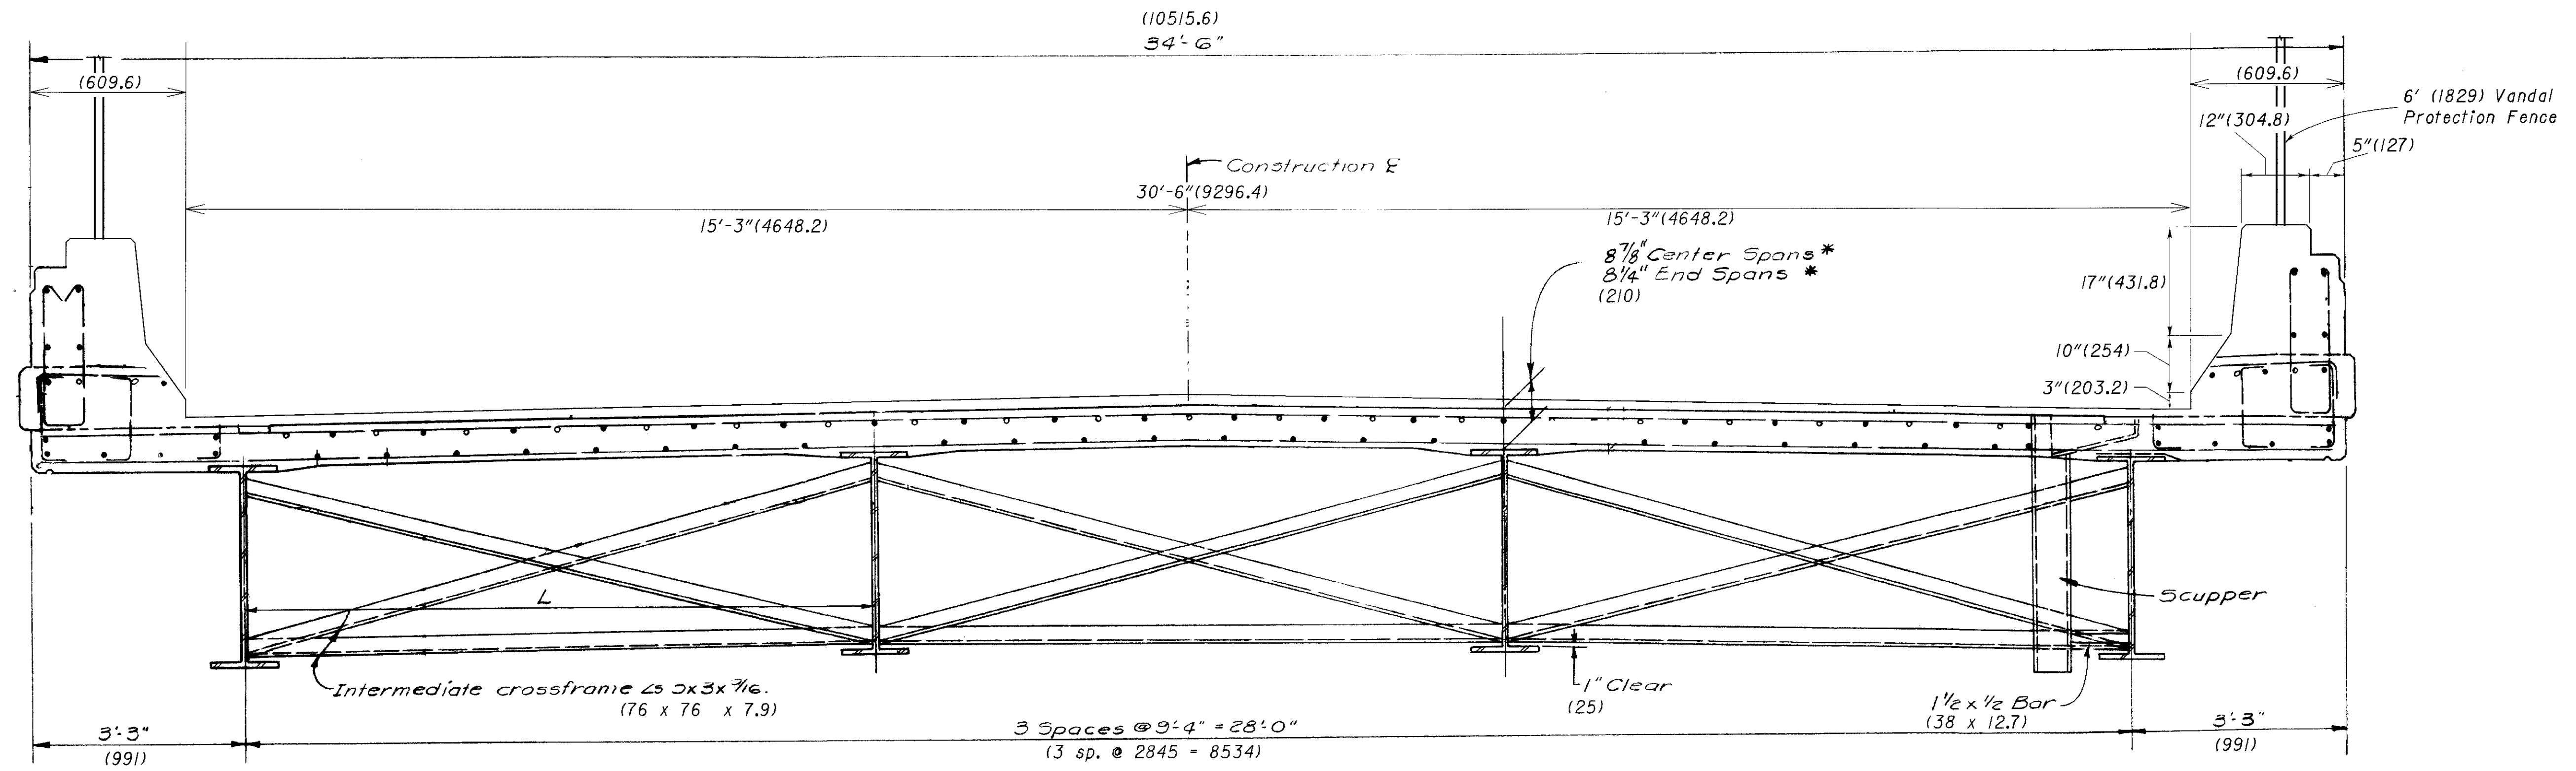

EXISTING TYPICAL TRANSVERSE DECK SECTION

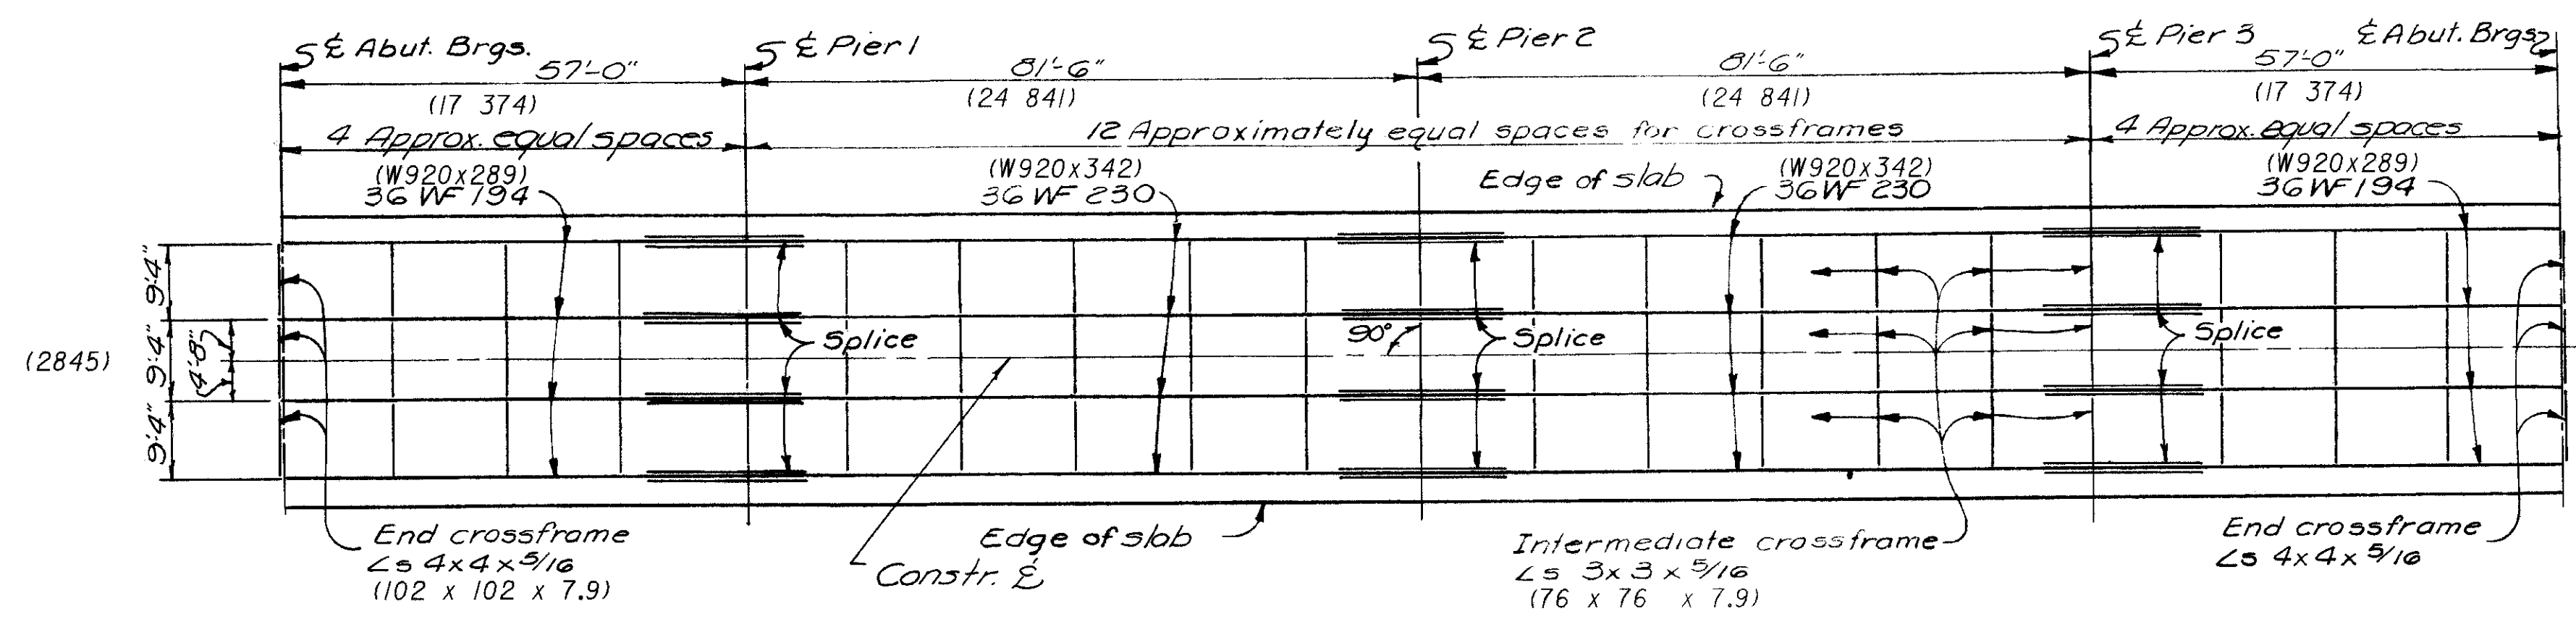


EXISTING OUTLINE OF STEEL FRAMING


- Proposed work shall be as follows for PART 4:
- 1) Reset abutment rocker bearings.
 - 2) Extend scuppers so that outlet is 200mm below bottom flange.
 - 3) Paint structural steel with System OZEU. Color shall be Federal Color Standard 14260 (Green).
 - 4) Seal concrete surfaces with epoxy-urethane. Color shall be Federal Color Standard 37722 (Buff).
- For standard details, see sheet 18/18.

EXISTING STRUCTURE DATA	
TYPE:	Continuous steel beams with reinforced conc. deck and substructure
SPANS:	17 374, 24 841, 24 841, 17 374 c/c brgs.
ROADWAY:	9296 toe/toe parapets
LOAD FREQUENCY:	CF=130(57)
SKIEW:	0°
ALIGNMENT:	Tangent

Note: Drawings of existing structure are scanned from the original drawing. Dimensions shown are from original construction plans and have not been field verified. Contractor is responsible for field verification of dimensions. Dimension shown in parentheses are metric conversions (millimeters) from the english dimensions.

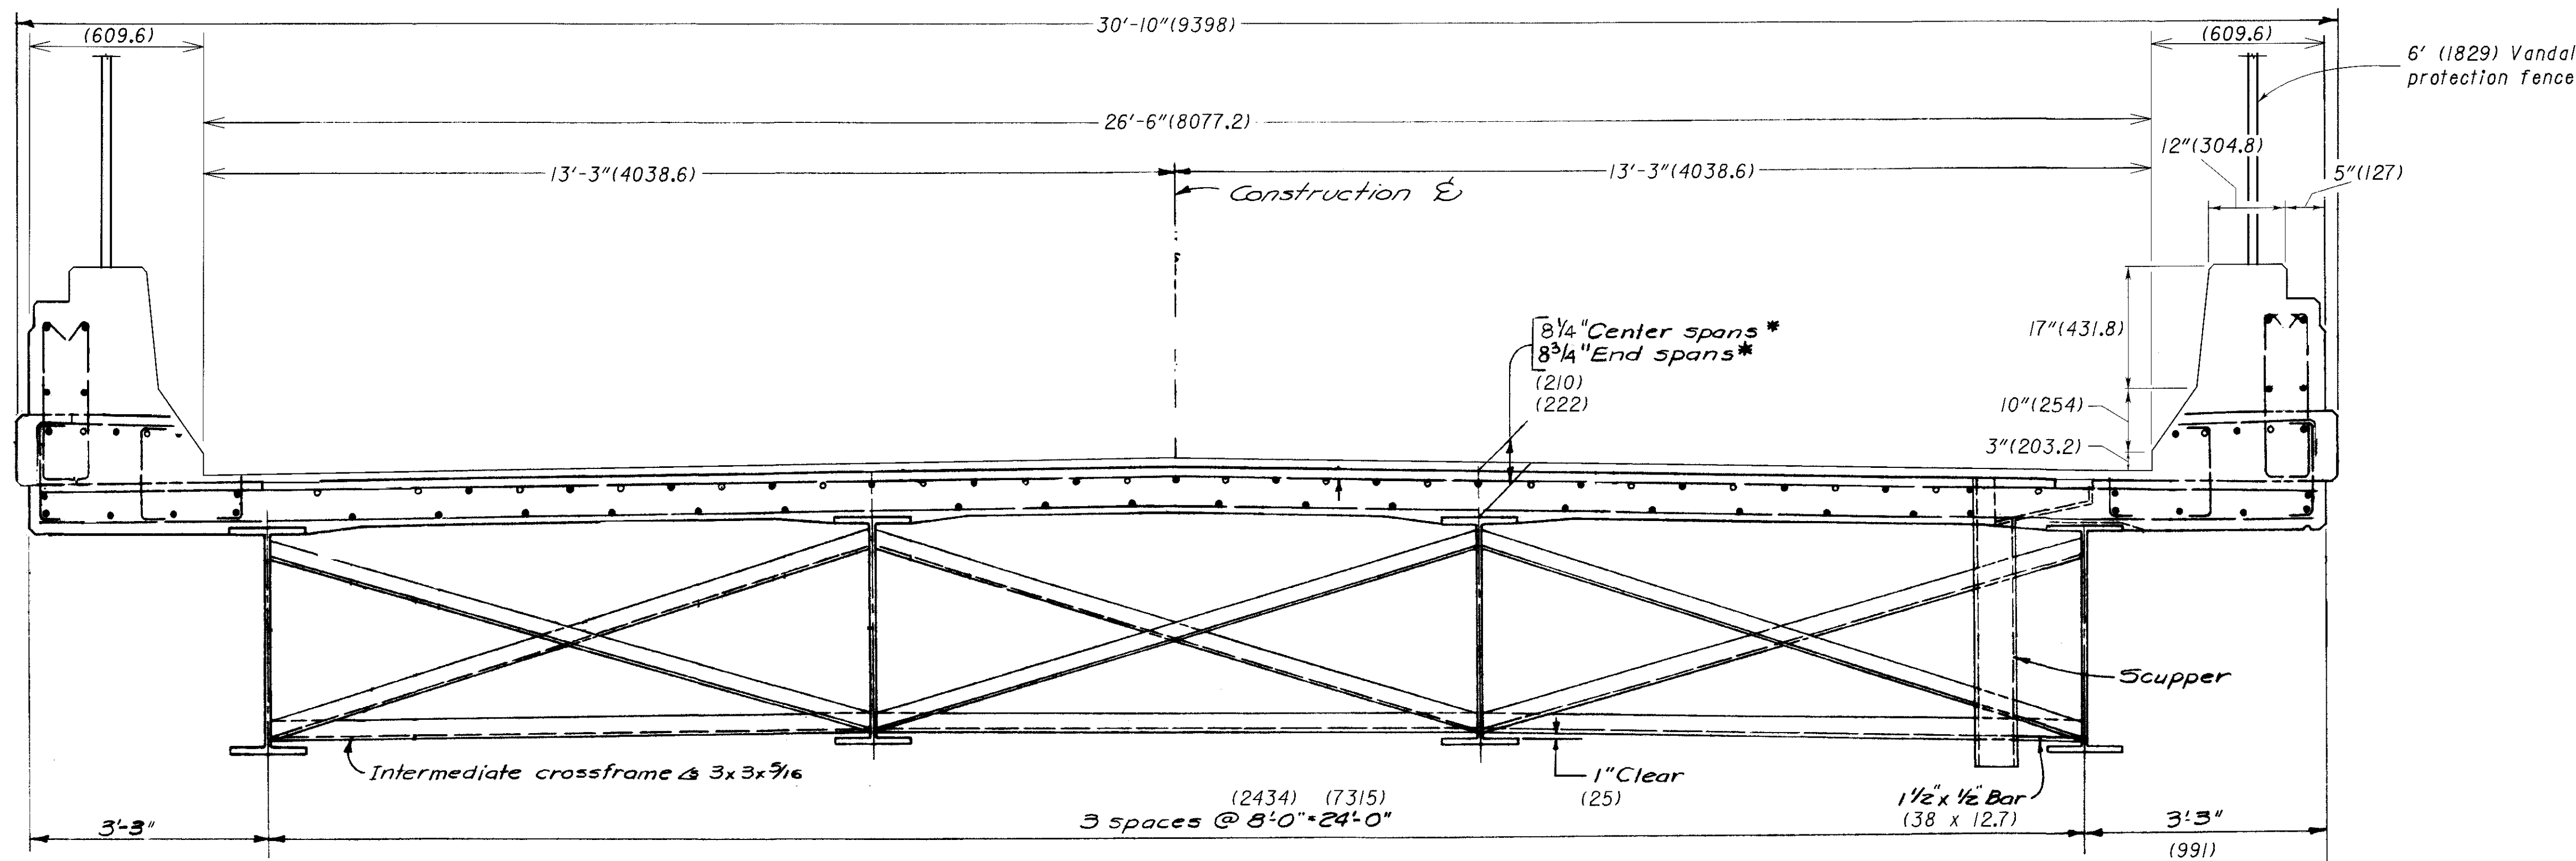

EXISTING TYPICAL TRANSVERSE DECK SECTION

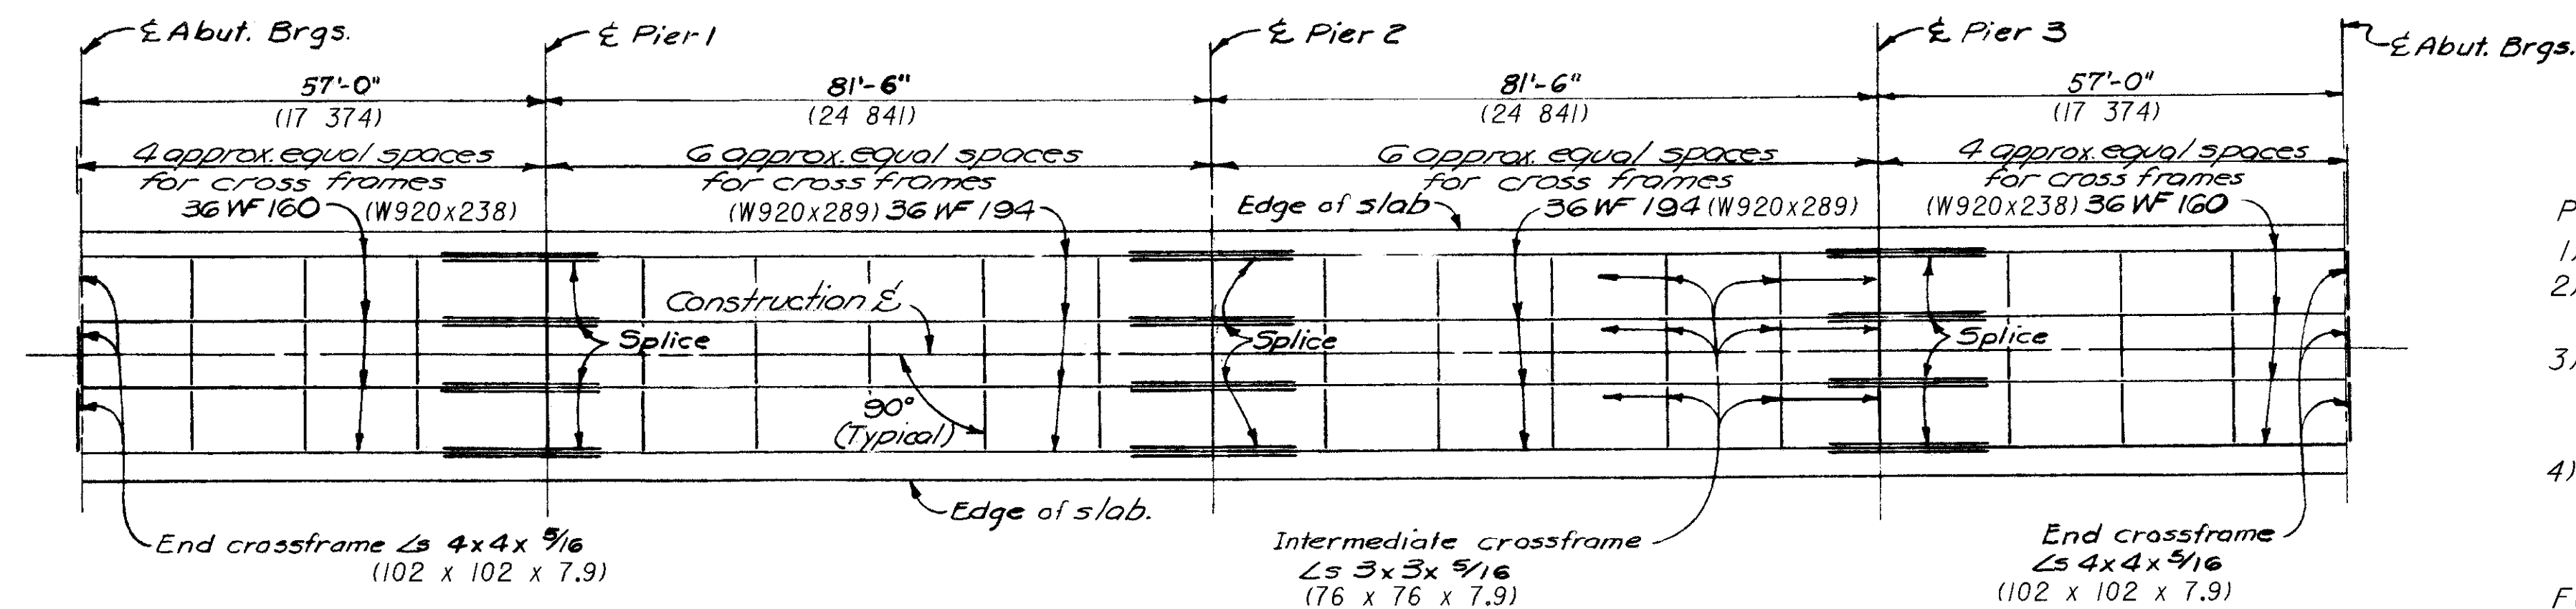


EXISTING OUTLINE OF STEEL FRAMING

- Proposed work shall be as follows for PART 5:
- 1) Reset abutment rocker bearings.
 - 2) Extend scuppers so that outlet is 200mm below bottom flange.
 - 3) Paint structural steel with System OZEU. Color shall be Federal Color Standard 14260 (Green).
 - 4) Seal concrete surfaces with epoxy-urethane. Color shall be Federal Color Standard 37722 (Buff).
- For standard details, see sheet 18/18.


EXISTING STRUCTURE DATA

TYPE: Continuous steel beams with reinforced conc. deck and substructure
 SPANS: 17 374, 24 841, 24 841, 17 374 c/c brgs.
 ROADWAY: 8077 f/f curb
 LOAD FREQUENCY: CF=130(57)
 SKEW: 0°
 ALIGNMENT: Tangent

Note: Drawings of existing structure are scanned from the original drawing. Dimensions shown are from original construction plans and have not been field verified. Contractor is responsible for field verification of dimensions. Dimension shown in parentheses are metric conversions (millimeters) from the english dimensions.

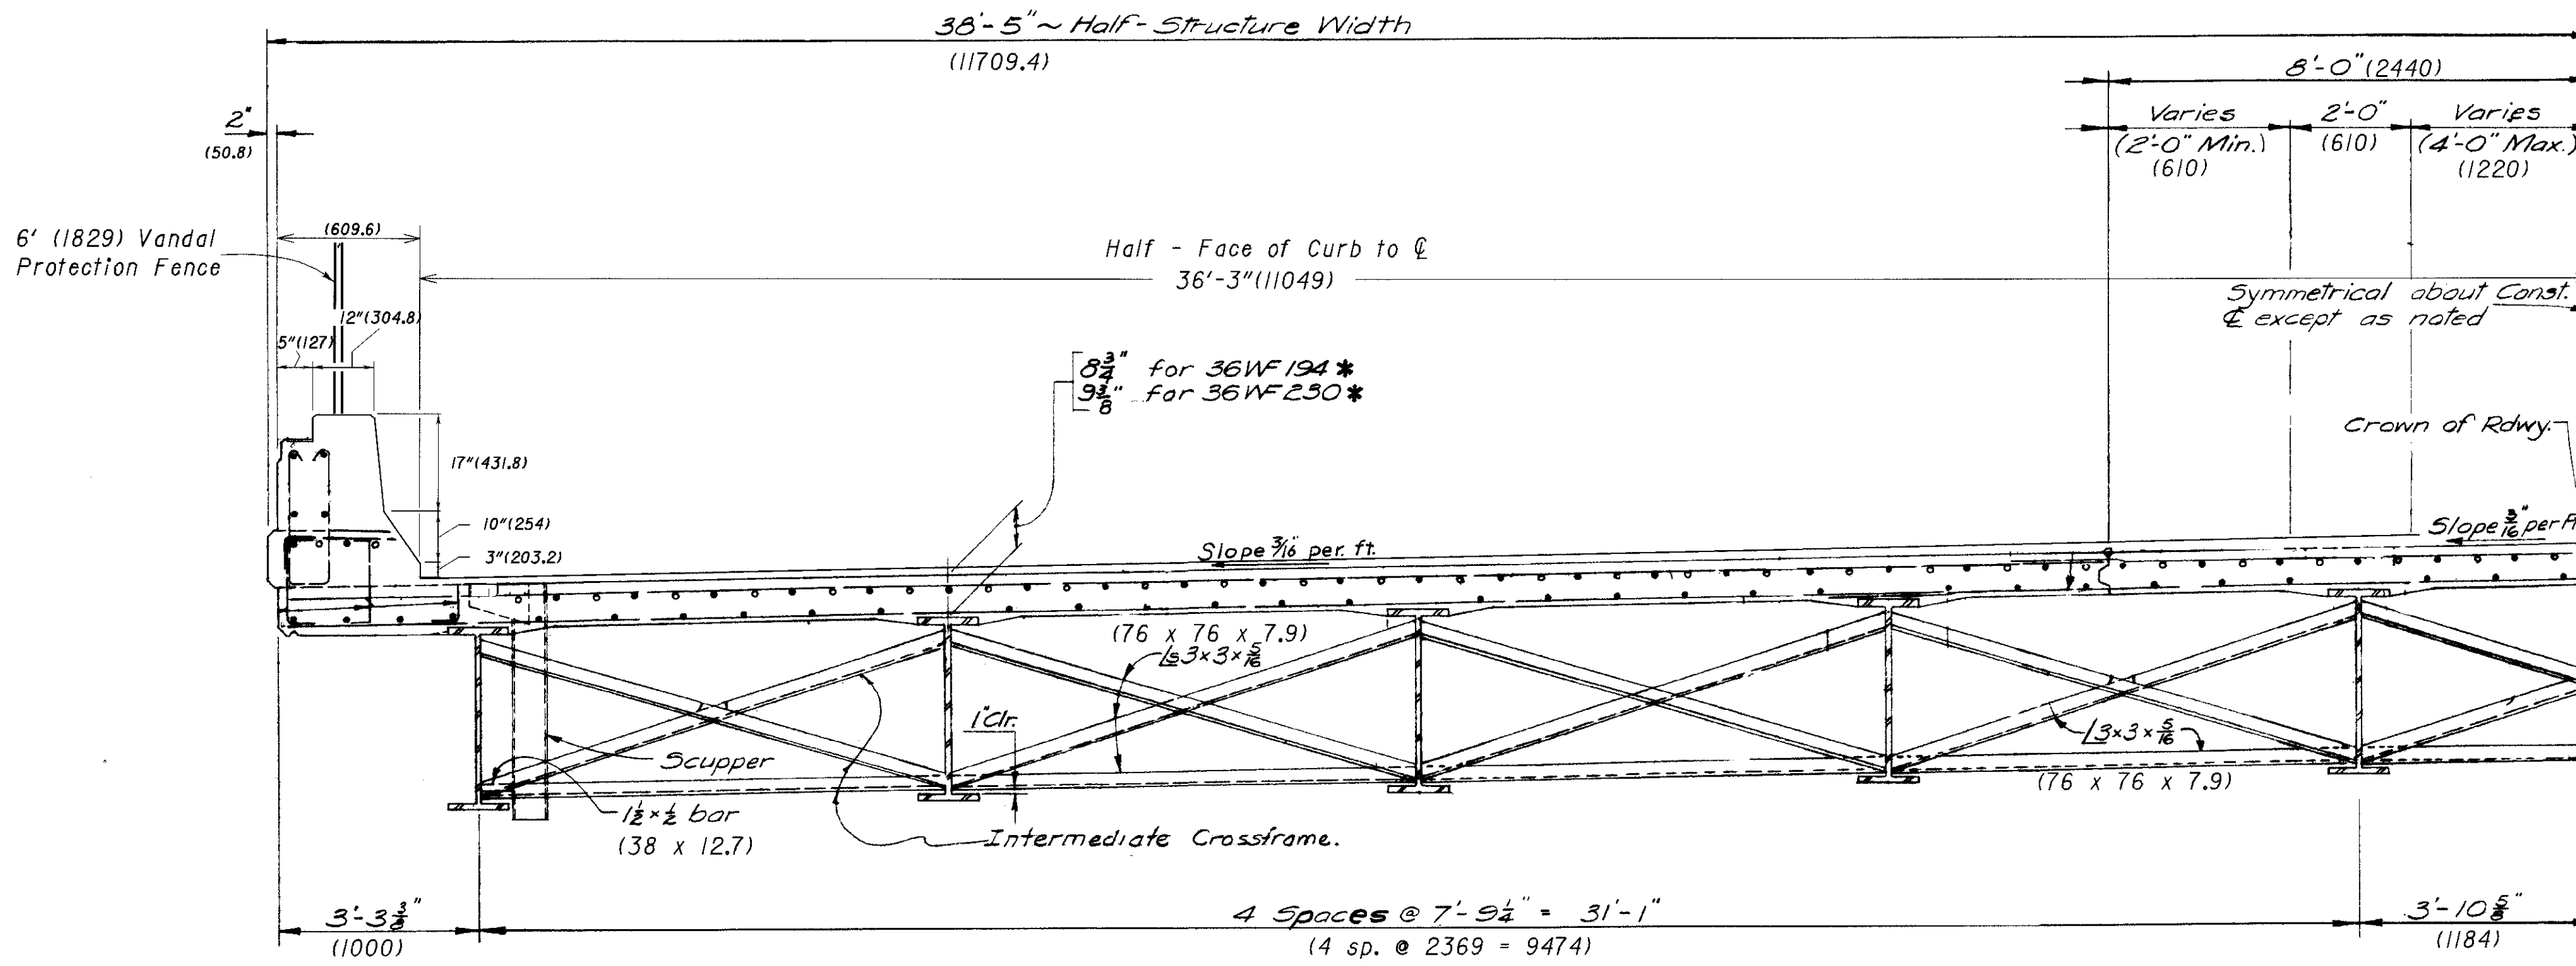

EXISTING TYPICAL TRANSVERSE DECK HALF-SECTION

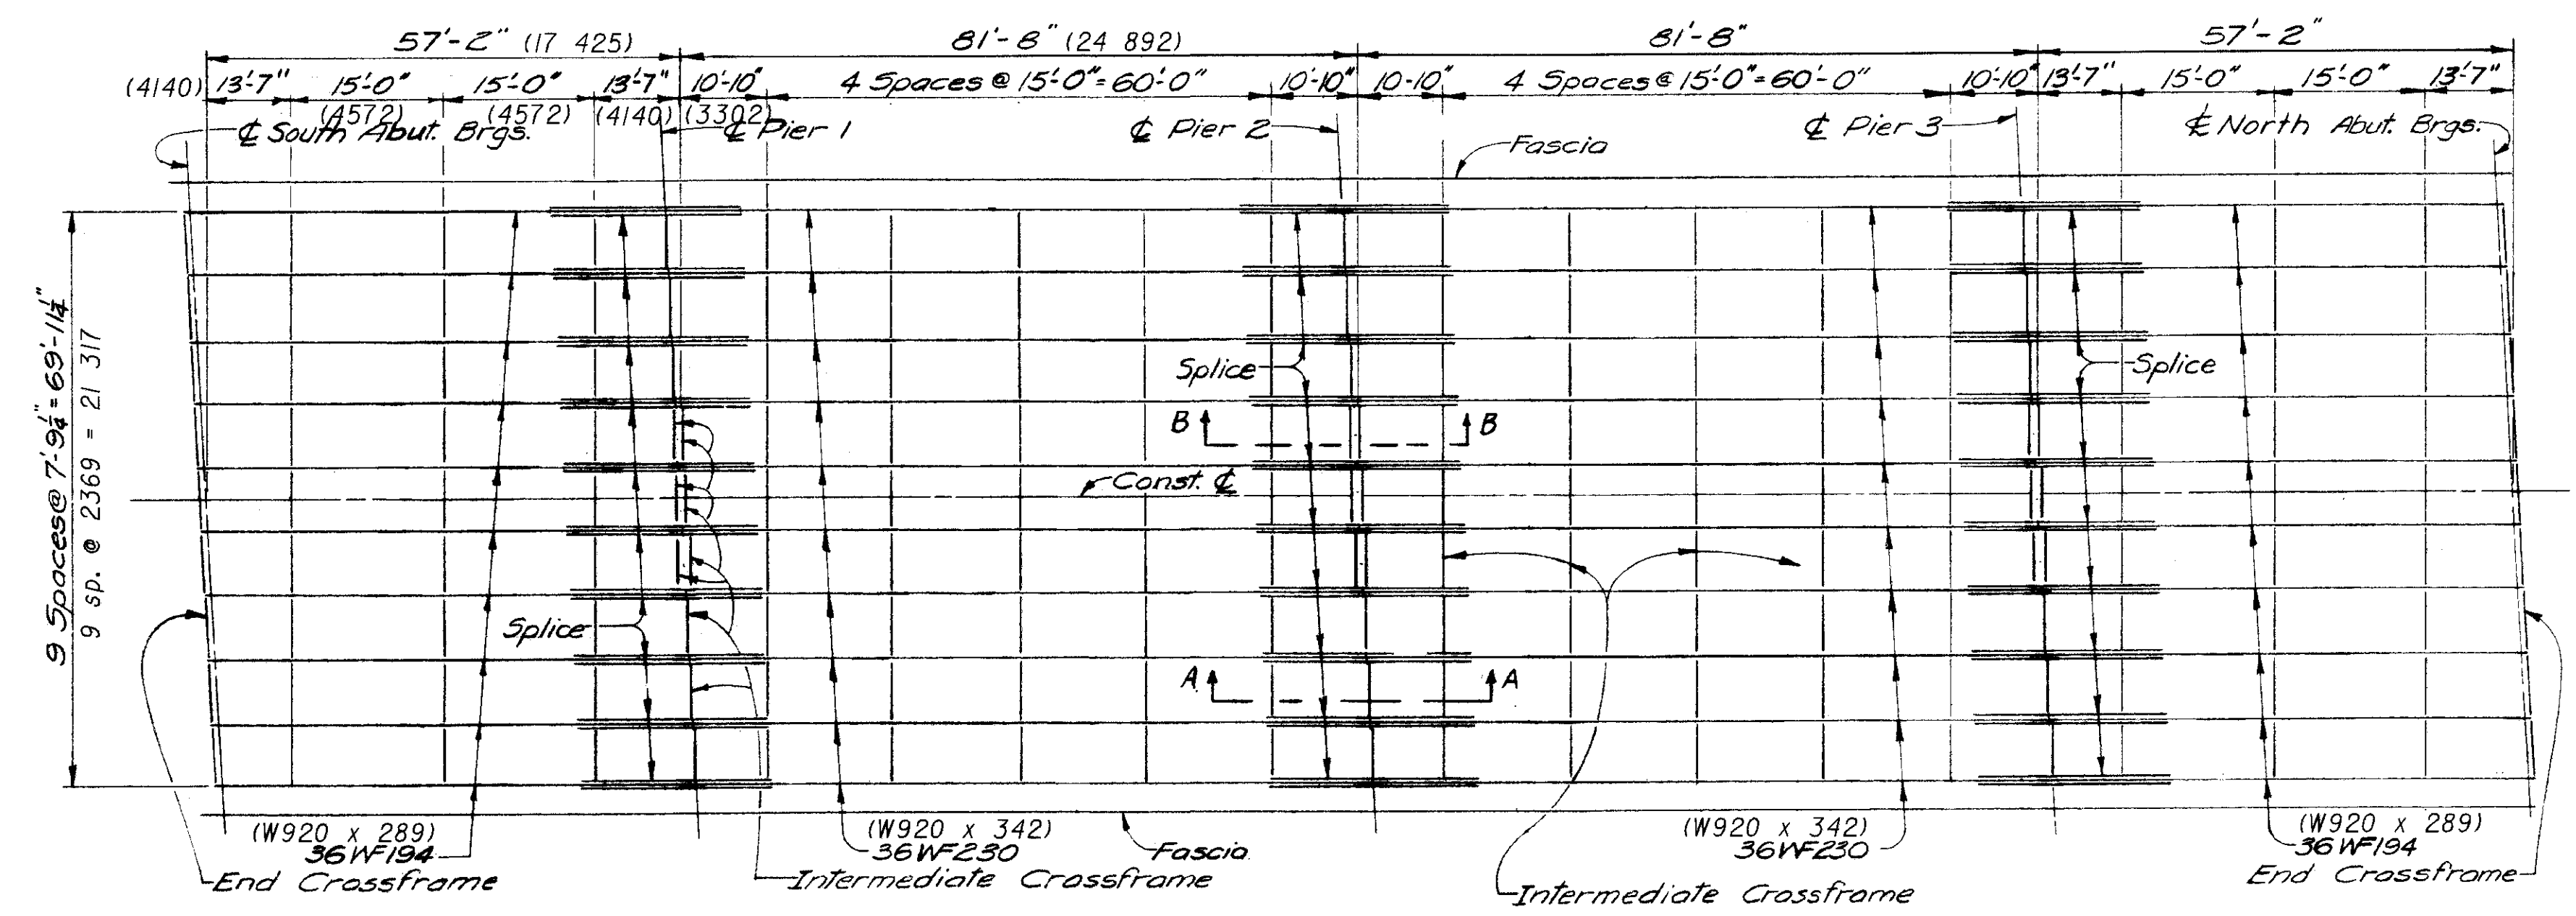


EXISTING OUTLINE OF STEEL FRAMING

- Proposed work shall be as follows for PART 6:
- 1) Reset abutment rocker bearings.
 - 2) Extend scuppers so that outlet is 200mm below bottom flange.
 - 3) Paint structural steel with System OZEU. Color shall be Federal Color Standard 14260 (Green).
 - 4) Seal concrete surfaces with epoxy-urethane. Color shall be Federal Color Standard 37722 (Buff).
- For standard details, see sheet 18/18.

Note: Drawings of existing structure are scanned from the original drawing. Dimensions shown are from original construction plans and have not been field verified. Contractor is responsible for field verification of dimensions. Dimension shown in parentheses are metric conversions (millimeters) from the english dimensions.


EXISTING STRUCTURE DATA	
TYPE:	Continuous steel beams with reinforced conc. deck and substructure
SPANS:	17 426, 24 893, 24 893, 17 426 c/c brgs.
ROADWAY:	22 098 t/f curb
LOAD FREQUENCY:	CF=400
SKEW:	2°58' R.F.
ALIGNMENT:	Tangent

12-JAN-1999 16:22 etucker
 i:\br\bf\unke\pre\35var\dgn\5\glifram.dgn

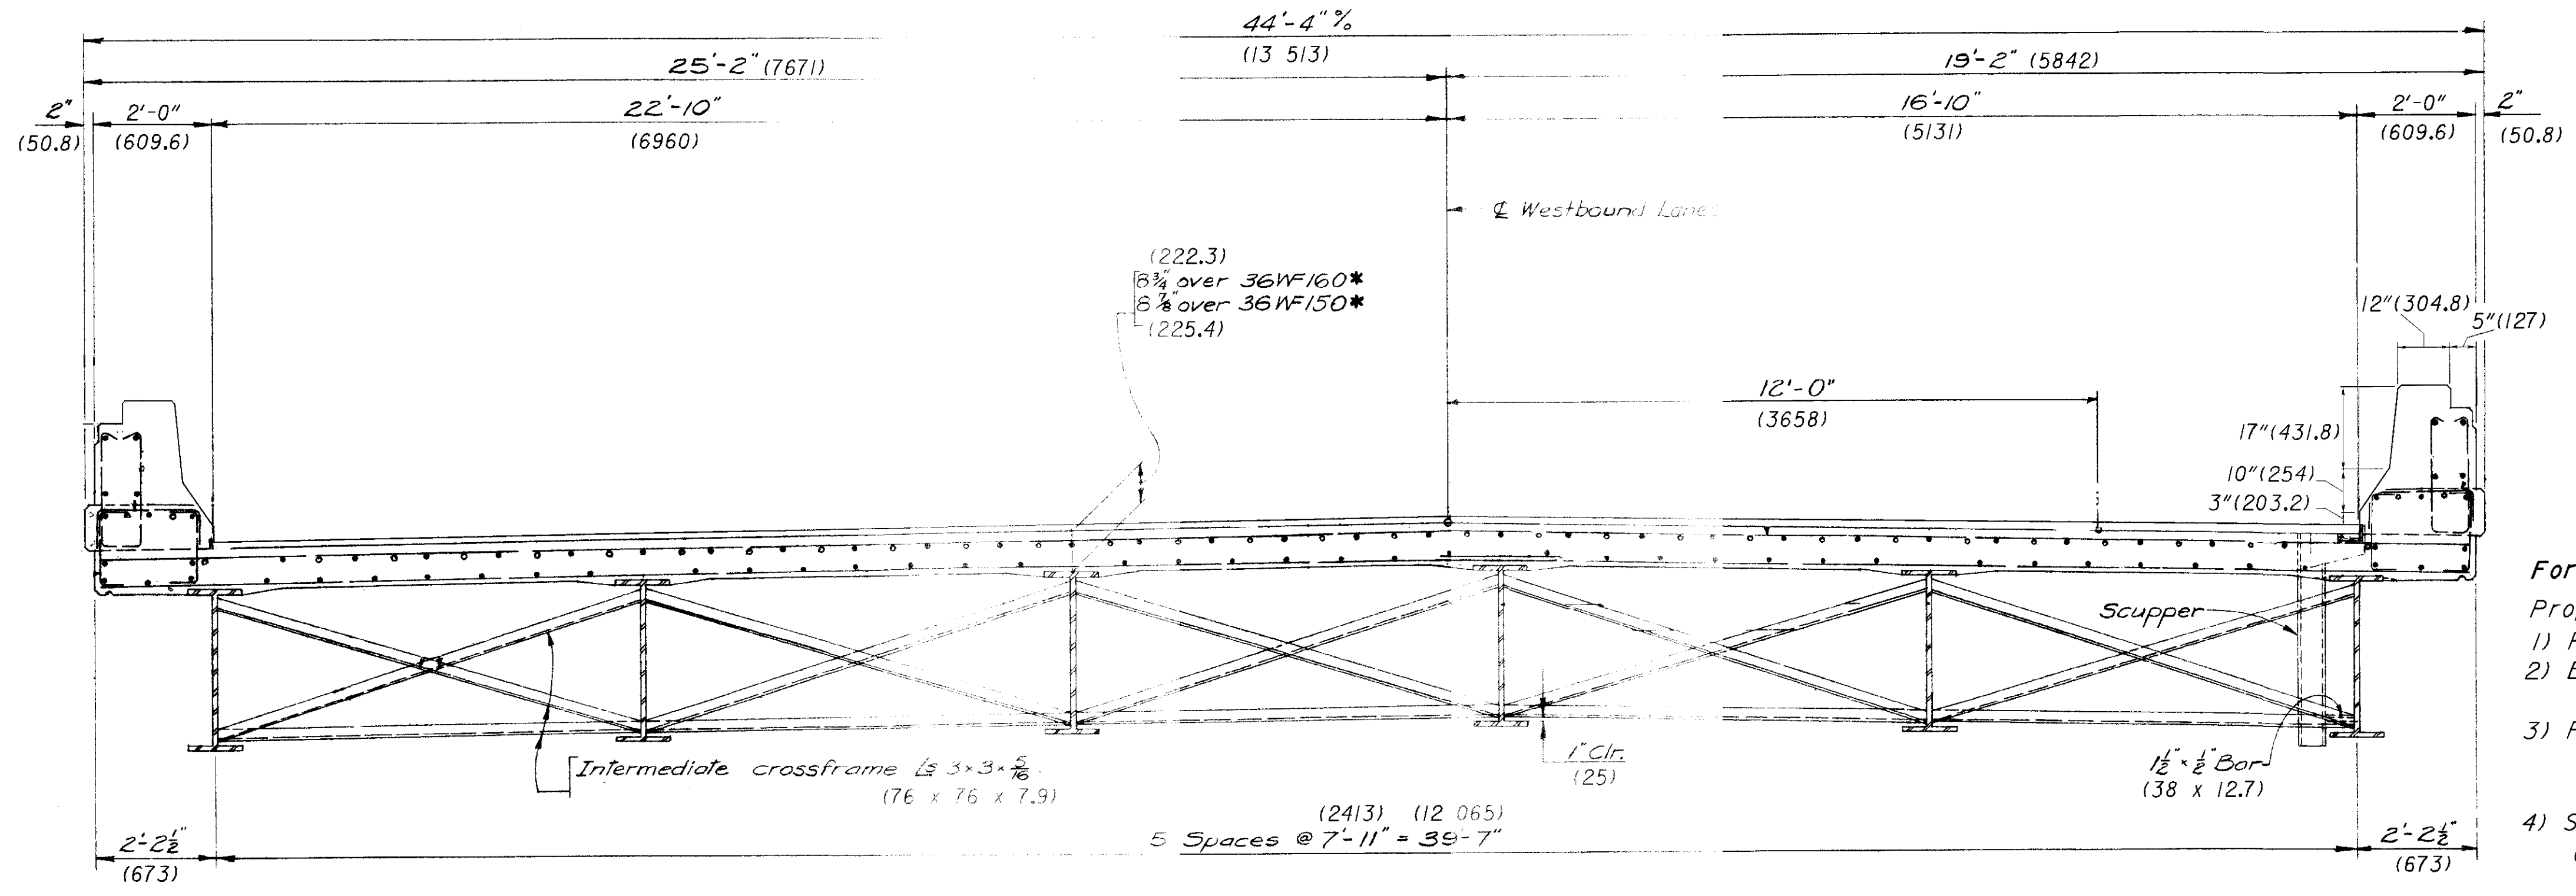

EXISTING TYPICAL TRANSVERSE DECK SECTION
Looking East at PRE-40-1250L


For Bridge no. PRE-70-20.101L - PART 7:
Proposed work shall be as follows:
1) Reset abutment rocker bearings.
2) Extend scuppers so that outlet is 200mm below bottom flange.
3) Paint structural steel with System OZEU. Color shall be Federal Color Standard 14260 (Green).
4) Seal concrete surfaces with epoxy-urethane. Color shall be Federal Color Standard 37722 (Buff).
For standard details, see sheet 18/18.

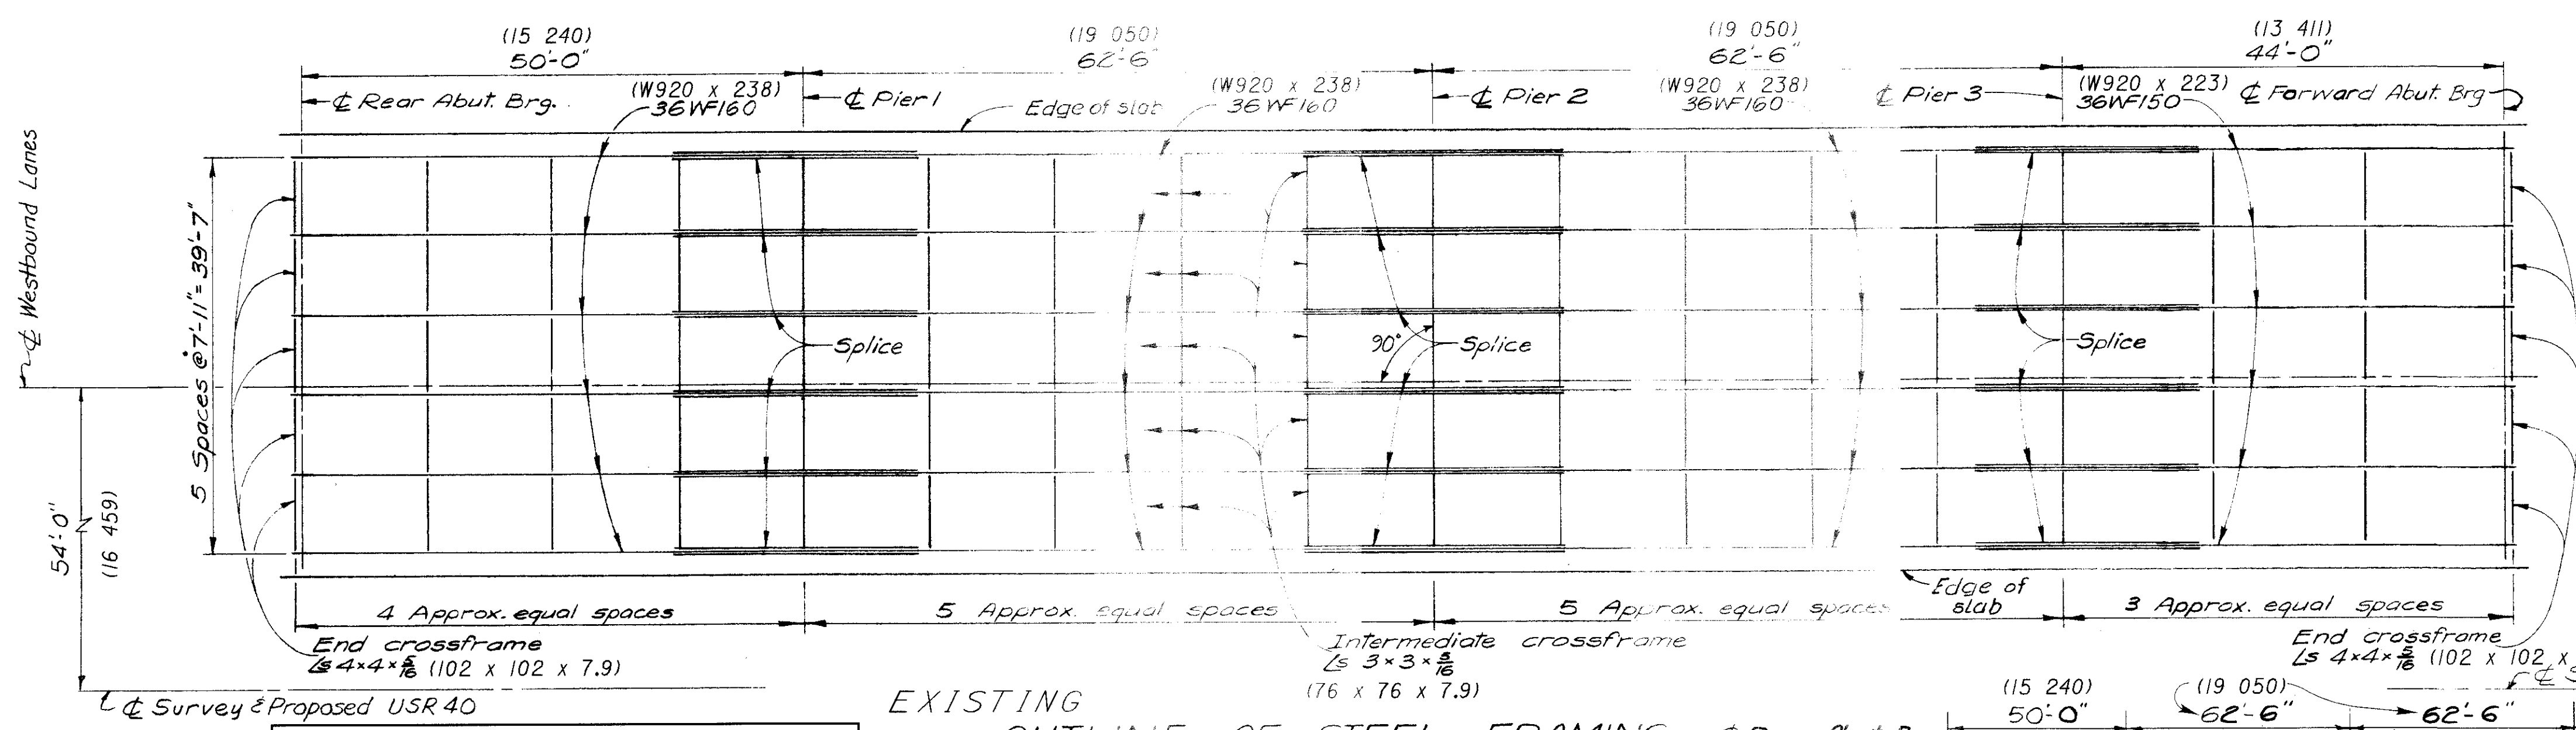

EXISTING OUTLINE OF STEEL FRAMING
(Bridge PRE-40-1250L shown)


For Bridge no. PRE-70-20.101R - PART 8:
Proposed work shall be as follows:
1) Reset abutment rocker bearings.
2) Extend scuppers so that outlet is 200mm below bottom flange.
3) Paint structural steel with System OZEU. Color shall be Federal Color Standard 14260 (Green).
4) Seal concrete surfaces with epoxy-urethane. Color shall be Federal Color Standard 37722 (Buff).
5) Replace rear approach slab.
For standard details, see sheet 18/18.

EXISTING STRUCTURES DATA	
TYPE:	Continuous steel beams with reinforced conc. deck and substructure
SPANS:	15 240, 19 050, 19 050, 13 411 c/c brgs.
ROADWAY:	12 090 f/f curb
LOAD FREQUENCY:	CF-2000(57)
SKEW:	0°
ALIGNMENT:	Tangent

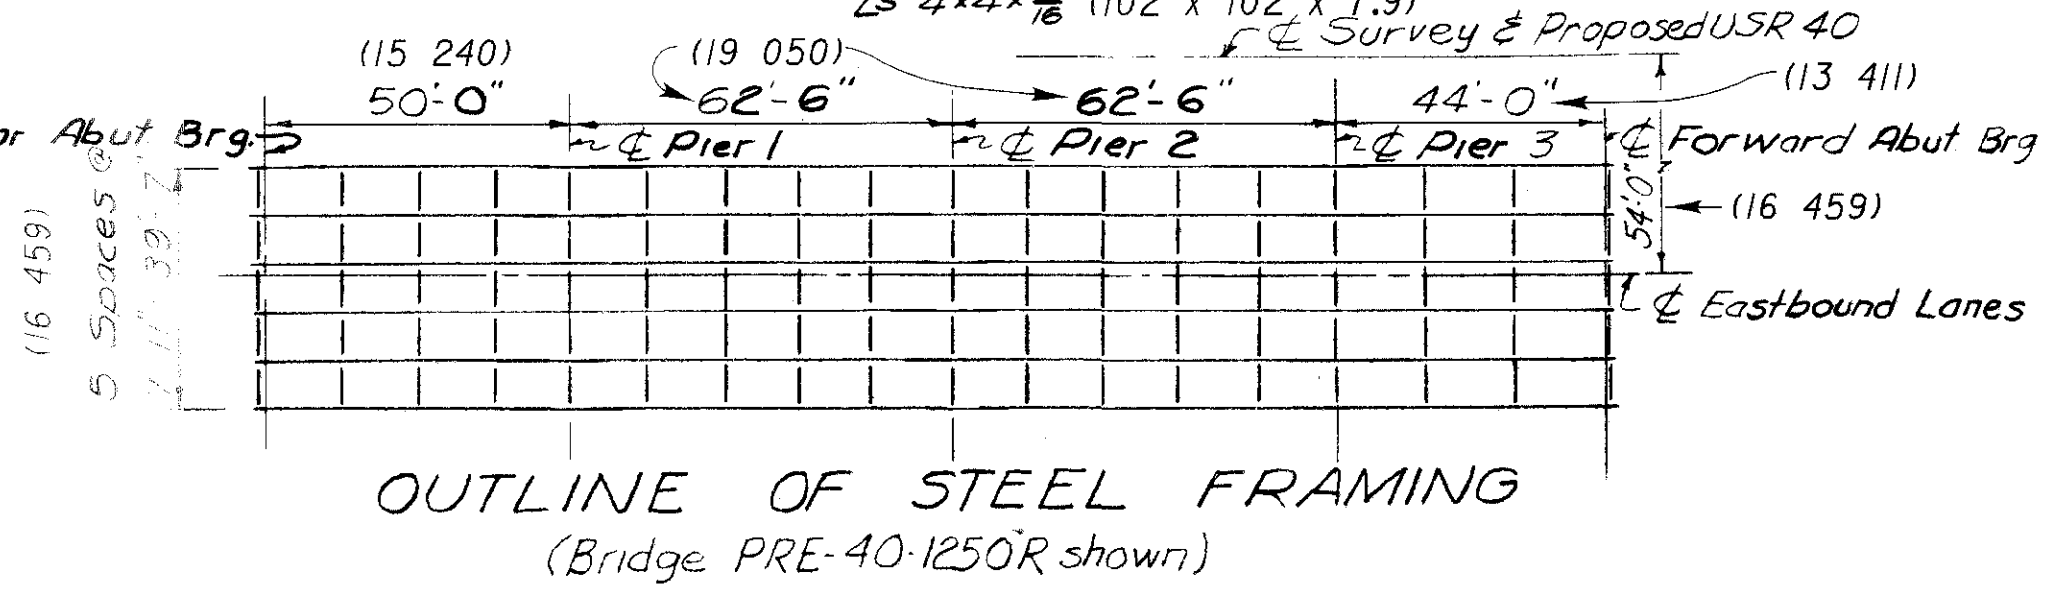


OUTLINE OF STEEL FRAMING
(Bridge PRE-40-1250R shown)

12 -JAN-1999 16:25 eTucker
i:\br\vb\funke\pr\935\var\dgm's\1249fram.dgn

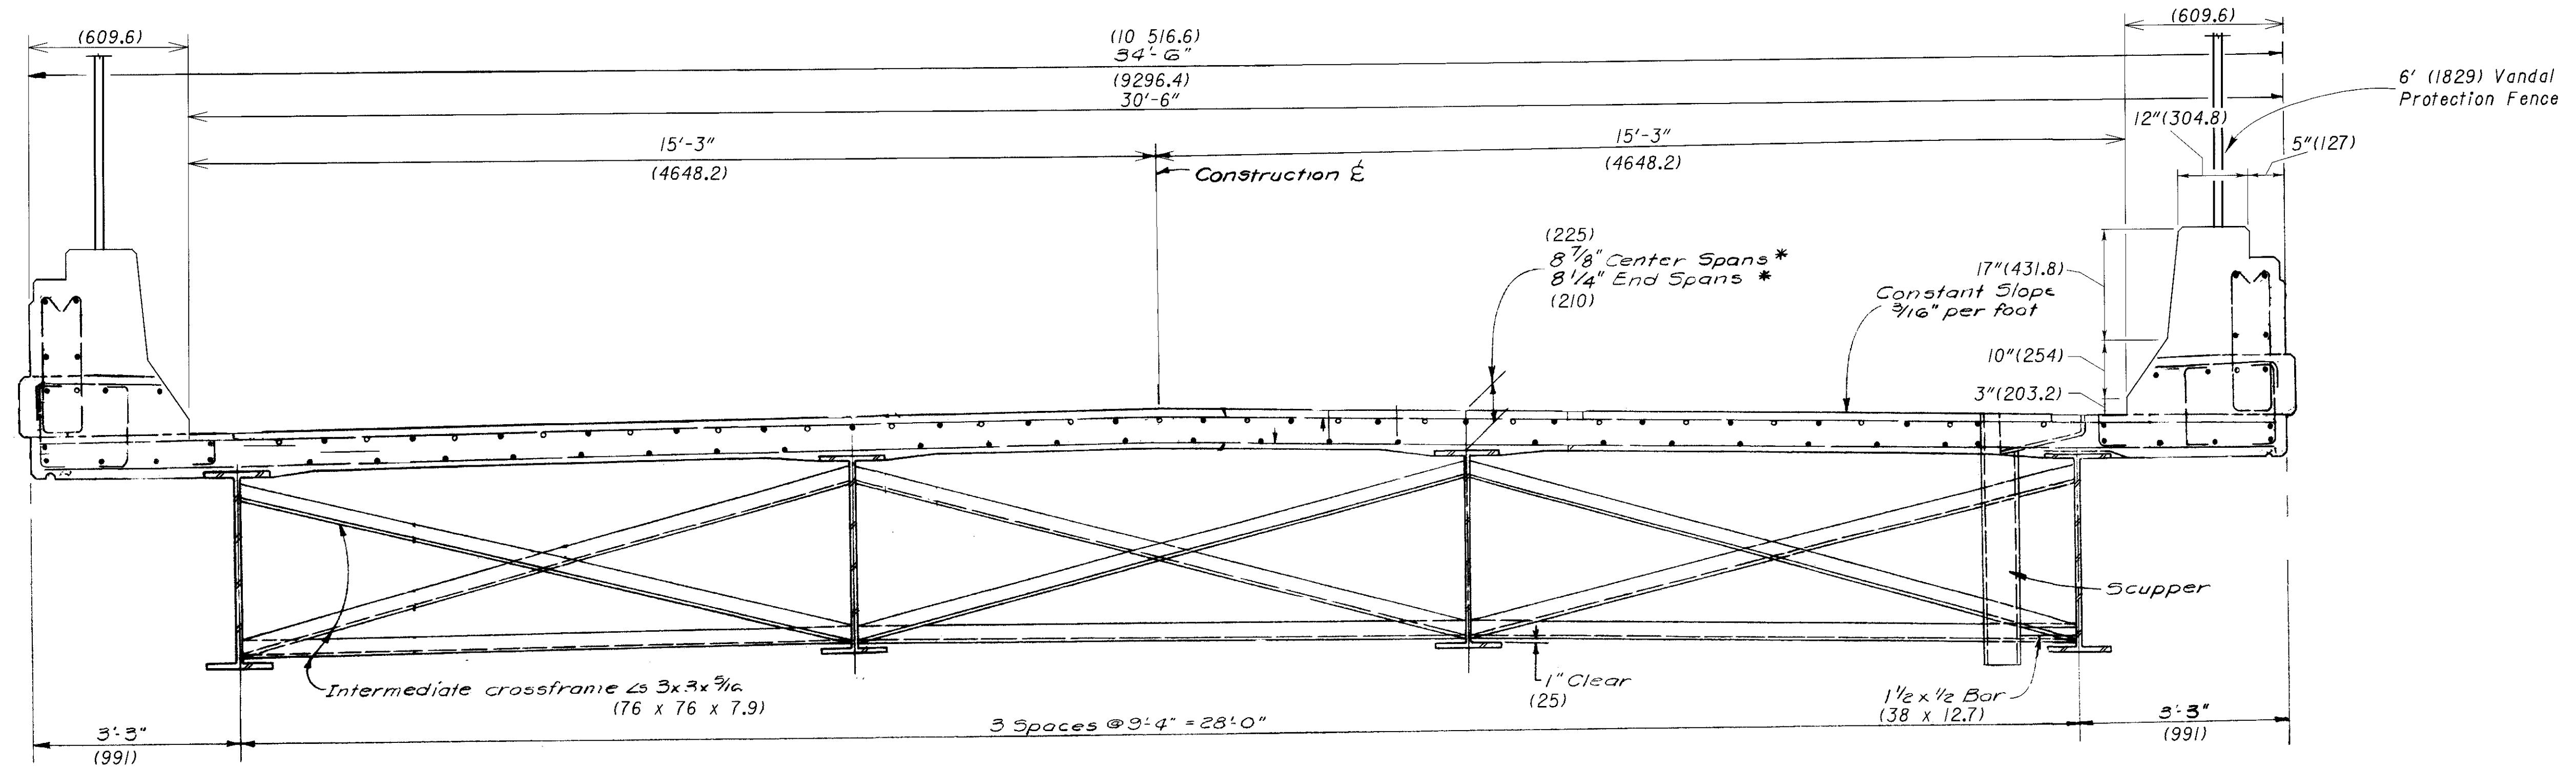

EXISTING TYPICAL TRANSVERSE DECK SECTION

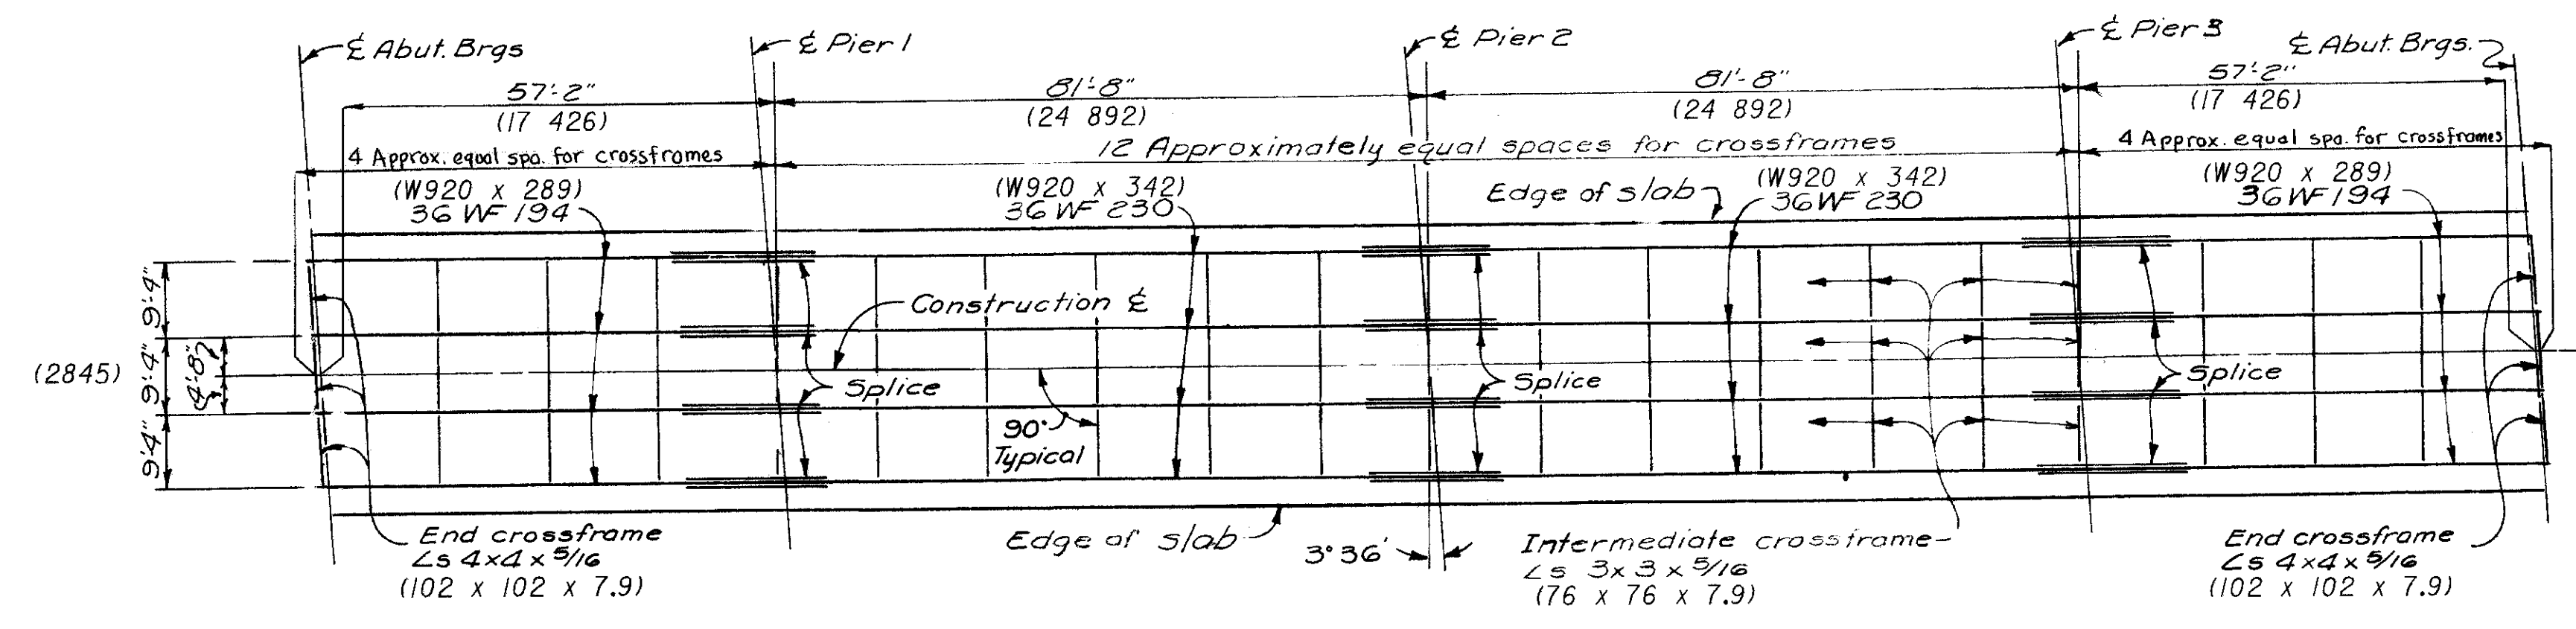


EXISTING OUTLINE OF STEEL FRAMING


- Proposed work shall be as follows - PART 9:
- 1) Extend scuppers so that outlet is 200mm below bottom flange.
 - 2) Paint structural steel with System OZEU. Color shall be Federal Color Standard 14260 (Green).
 - 3) Seal concrete surfaces with epoxy-urethane. Color shall be Federal Color Standard 37722 (Buff).
- For standard details, see sheet 18/18.

EXISTING STRUCTURE DATA	
TYPE:	Continuous steel beams with reinforced conc. deck and substructure
SPANS:	17 425, 24 892, 24 892, 17 425 c/c brgs.
ROADWAY:	9245 toe/toe parapets
LOAD FREQUENCY:	CF-130(57)
SKEW:	3°36'
ALIGNMENT:	Tangent

Note: Drawings of existing structure are scanned from the original drawing. Dimensions shown are from original construction plans and have not been field verified. Contractor is responsible for field verification of dimensions. Dimension shown in parentheses are metric conversions (millimeters) from the english dimensions.

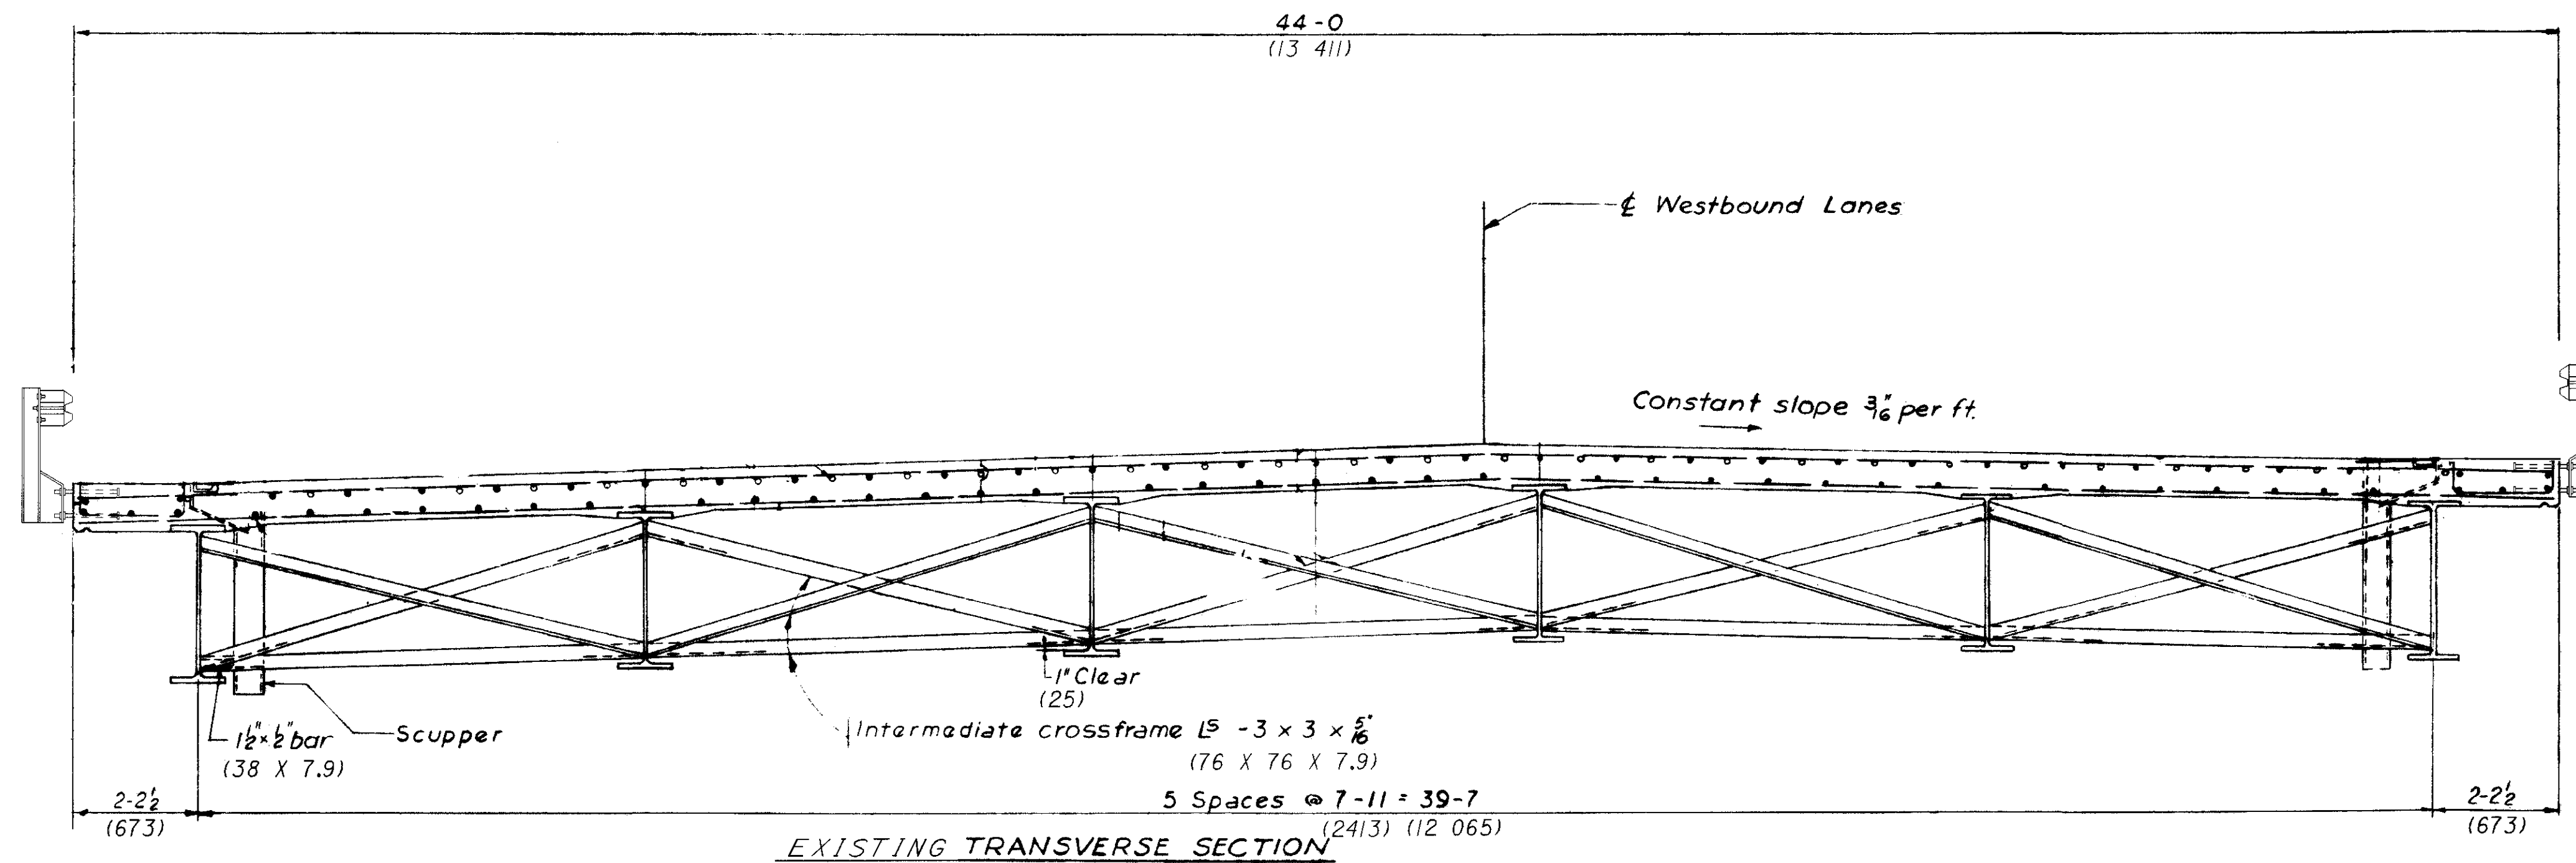

NOTE:
Details not shown are same
as opposite side.

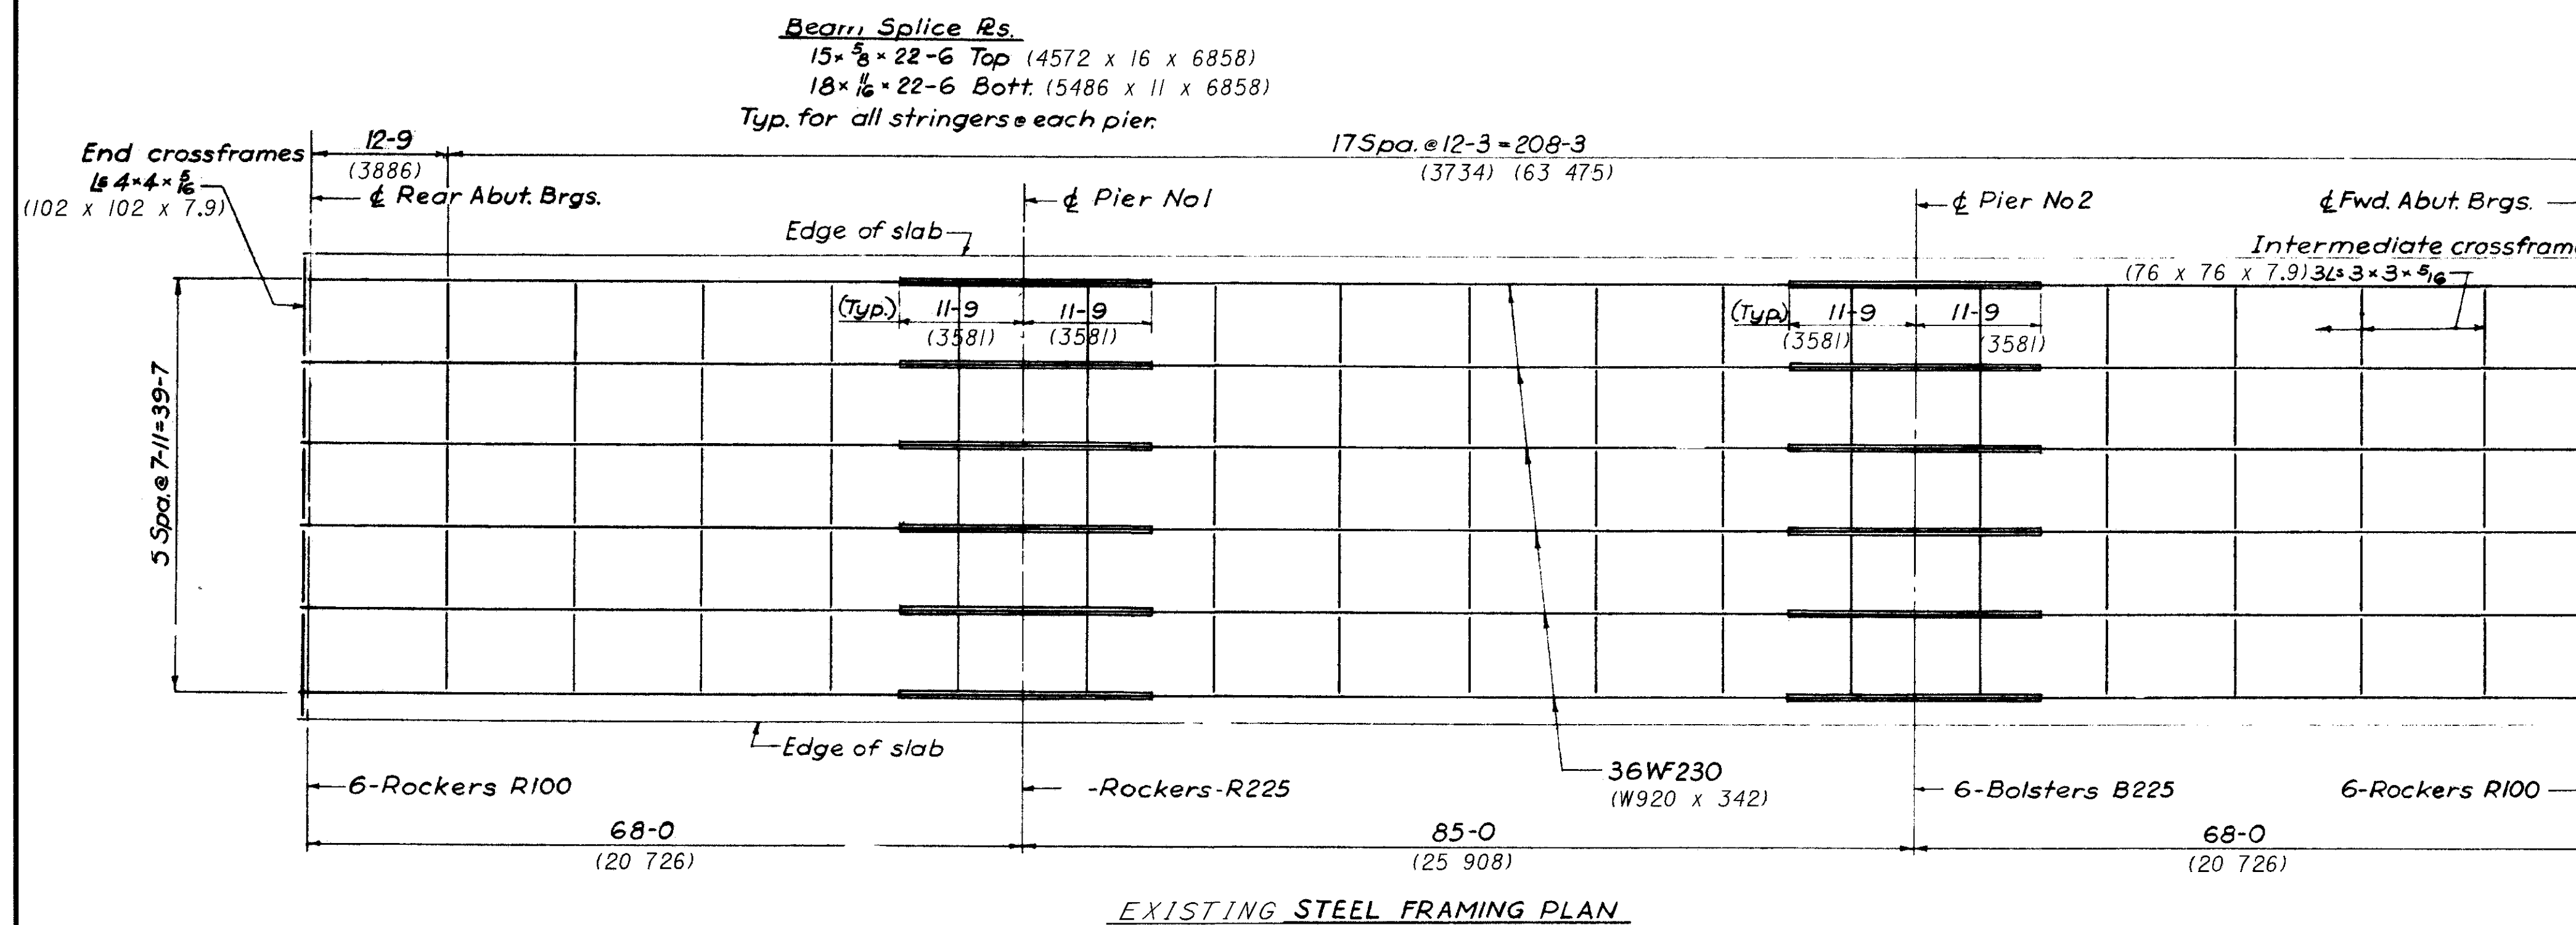


Bearr. Splice Rs.
 15 x 5/8 x 22-6 Top (4572 x 16 x 6858)
 18 x 1/2 x 22-6 Bott. (5486 x 11 x 6858)
 Typ. for all stringers each pier.

- Proposed work shall be as follows for PART 10:
- 1) Refurbish abutment rocker bearings.
 - 2) Extend scuppers so that outlet is 200mm below bottom flange.
 - 3) Paint structural steel with System OZEU. Color shall be Federal Color Standard 14260 (Green).
 - 4) Seal concrete surfaces with epoxy-urethane. Color shall be Federal Color Standard 37722 (Buff).
- For standard details, see sheet 18/18.


EXISTING STRUCTURE DATA	
TYPE:	Continuous steel beams with reinforced conc. deck and substructure
SPANS:	20 726, 25 908, 20 726 c/c brgs.
ROADWAY:	13 411 t/f railing
LOAD FREQUENCY:	CF=2000(57)
SKEW:	0°
ALIGNMENT:	Tangent

Note: Drawings of existing structure are scanned from the original drawing. Dimensions shown are from original construction plans and have not been field verified. Contractor is responsible for field verification of dimensions. Dimension shown in parentheses are metric conversions (millimeters) from the english dimensions.

12-JAN-1999 16:43 eTucker
 I:\br\bfunke\pre35\var\vgm\51500\fr a.dgn

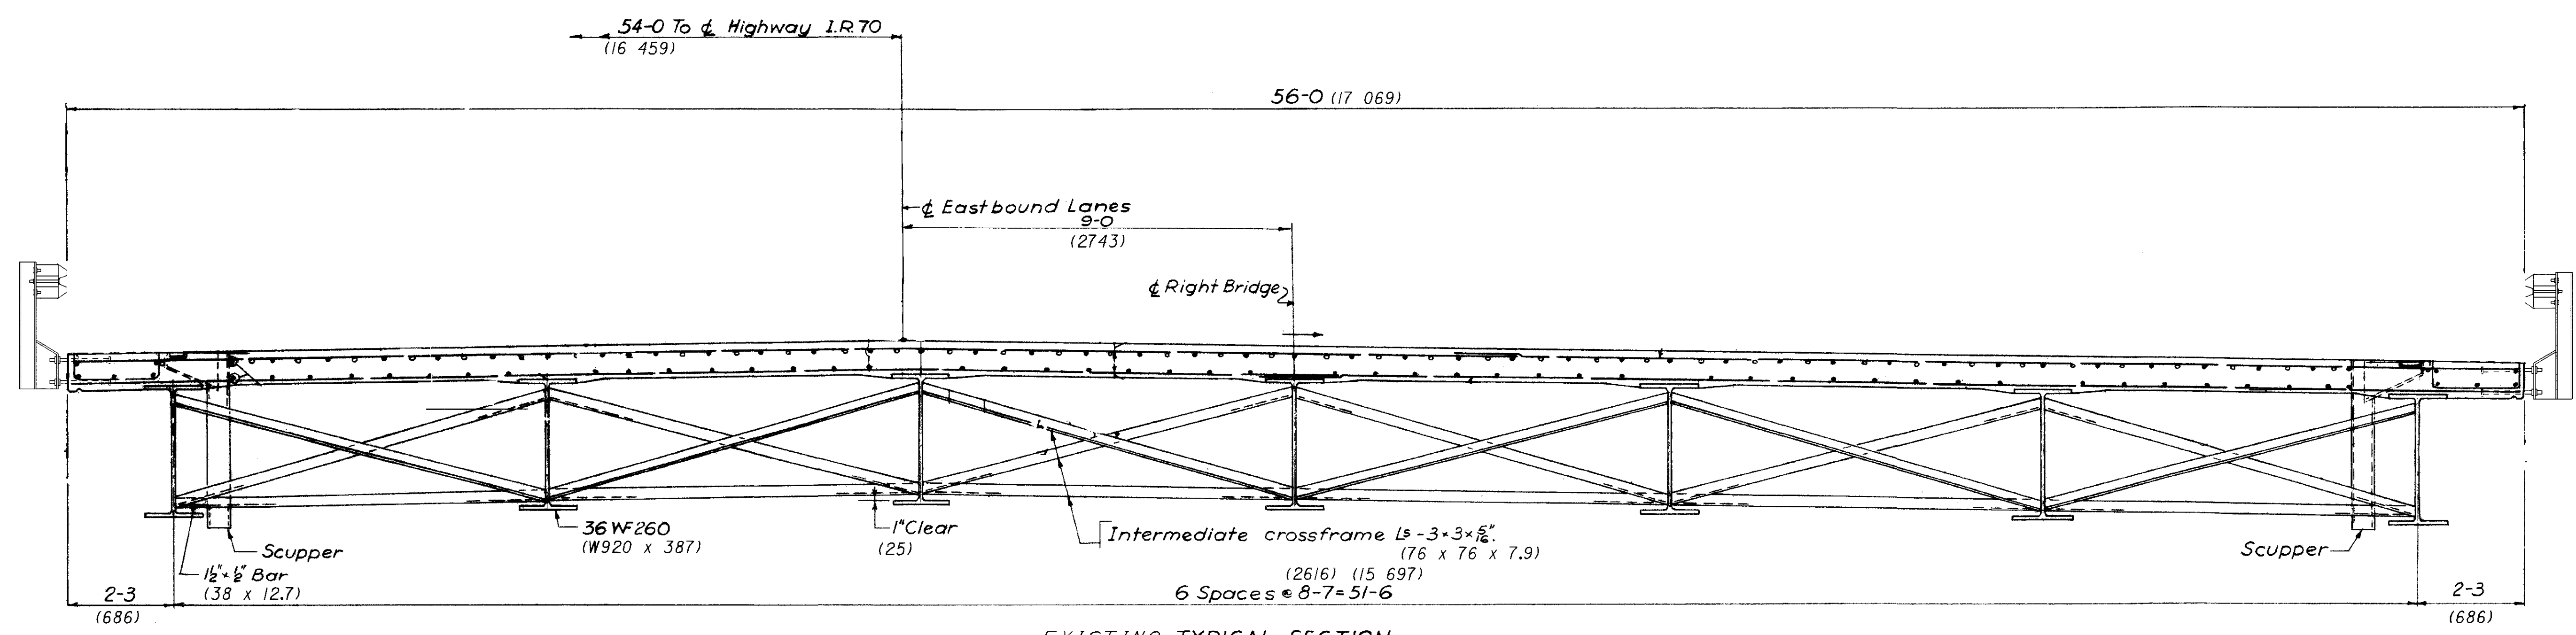

EXISTING TYPICAL SECTION

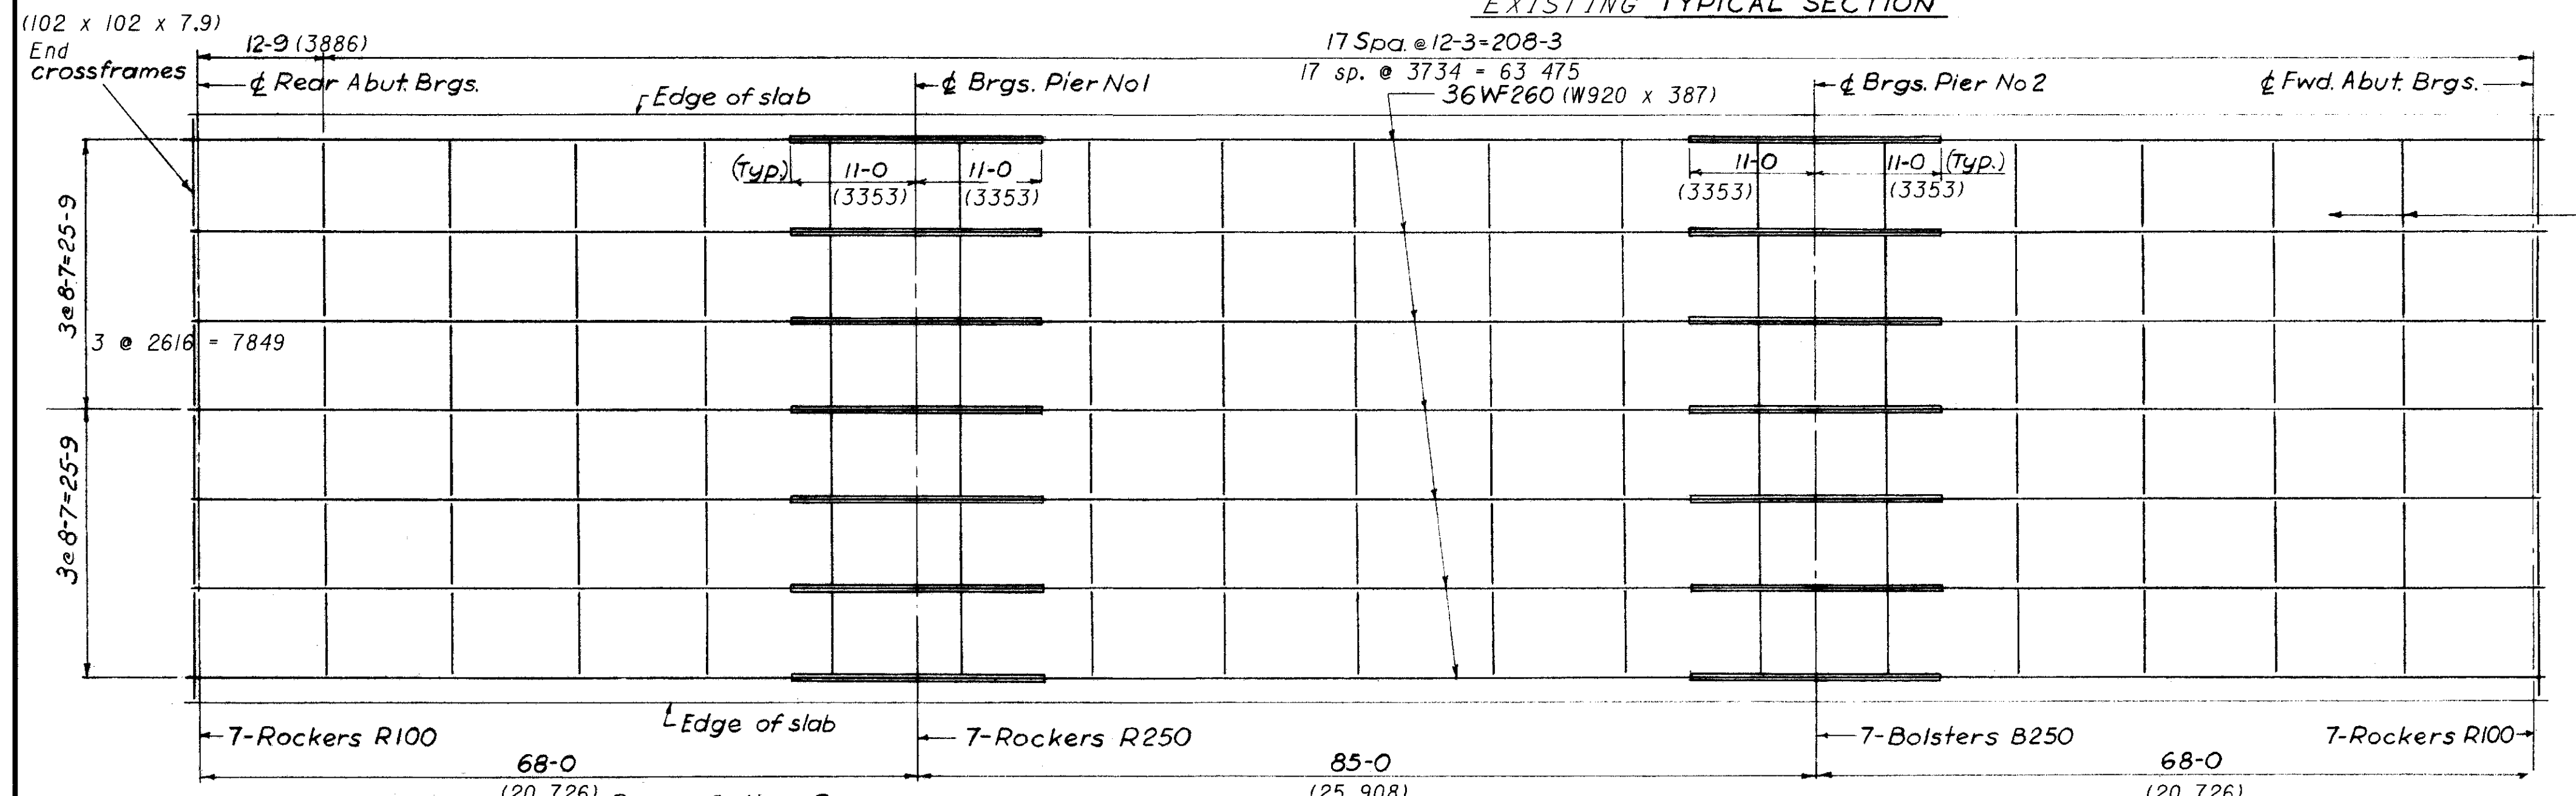


EXISTING STEEL FRAMING PLAN


- Proposed work shall be as follows for PART II:
- 1) Refurbish abutment rocker bearings.
 - 2) Extend scuppers so that outlet is 200mm below bottom flange.
 - 3) Paint structural steel with System OZEU. Color shall be Federal Color Standard 14260 (Green).
 - 4) Seal concrete surfaces with epoxy-urethane. Color shall be Federal Color Standard 37722 (Buff).
- For standard details, see sheet 18/18.

EXISTING STRUCTURE DATA	
TYPE:	Continuous steel beams with reinforced conc. deck and substructure
SPANS:	20 726, 25 908, 20 726 c/c brgs.
ROADWAY:	17 069 f/f railing
LOAD FREQUENCY:	CF-2000(57)
SKEW:	0°
ALIGNMENT:	Tangent

Note: Drawings of existing structure are scanned from the original drawing. Dimensions shown are from original construction plans and have not been field verified. Contractor is responsible for field verification of dimensions. Dimension shown in parentheses are metric conversions (millimeters) from the english dimensions.

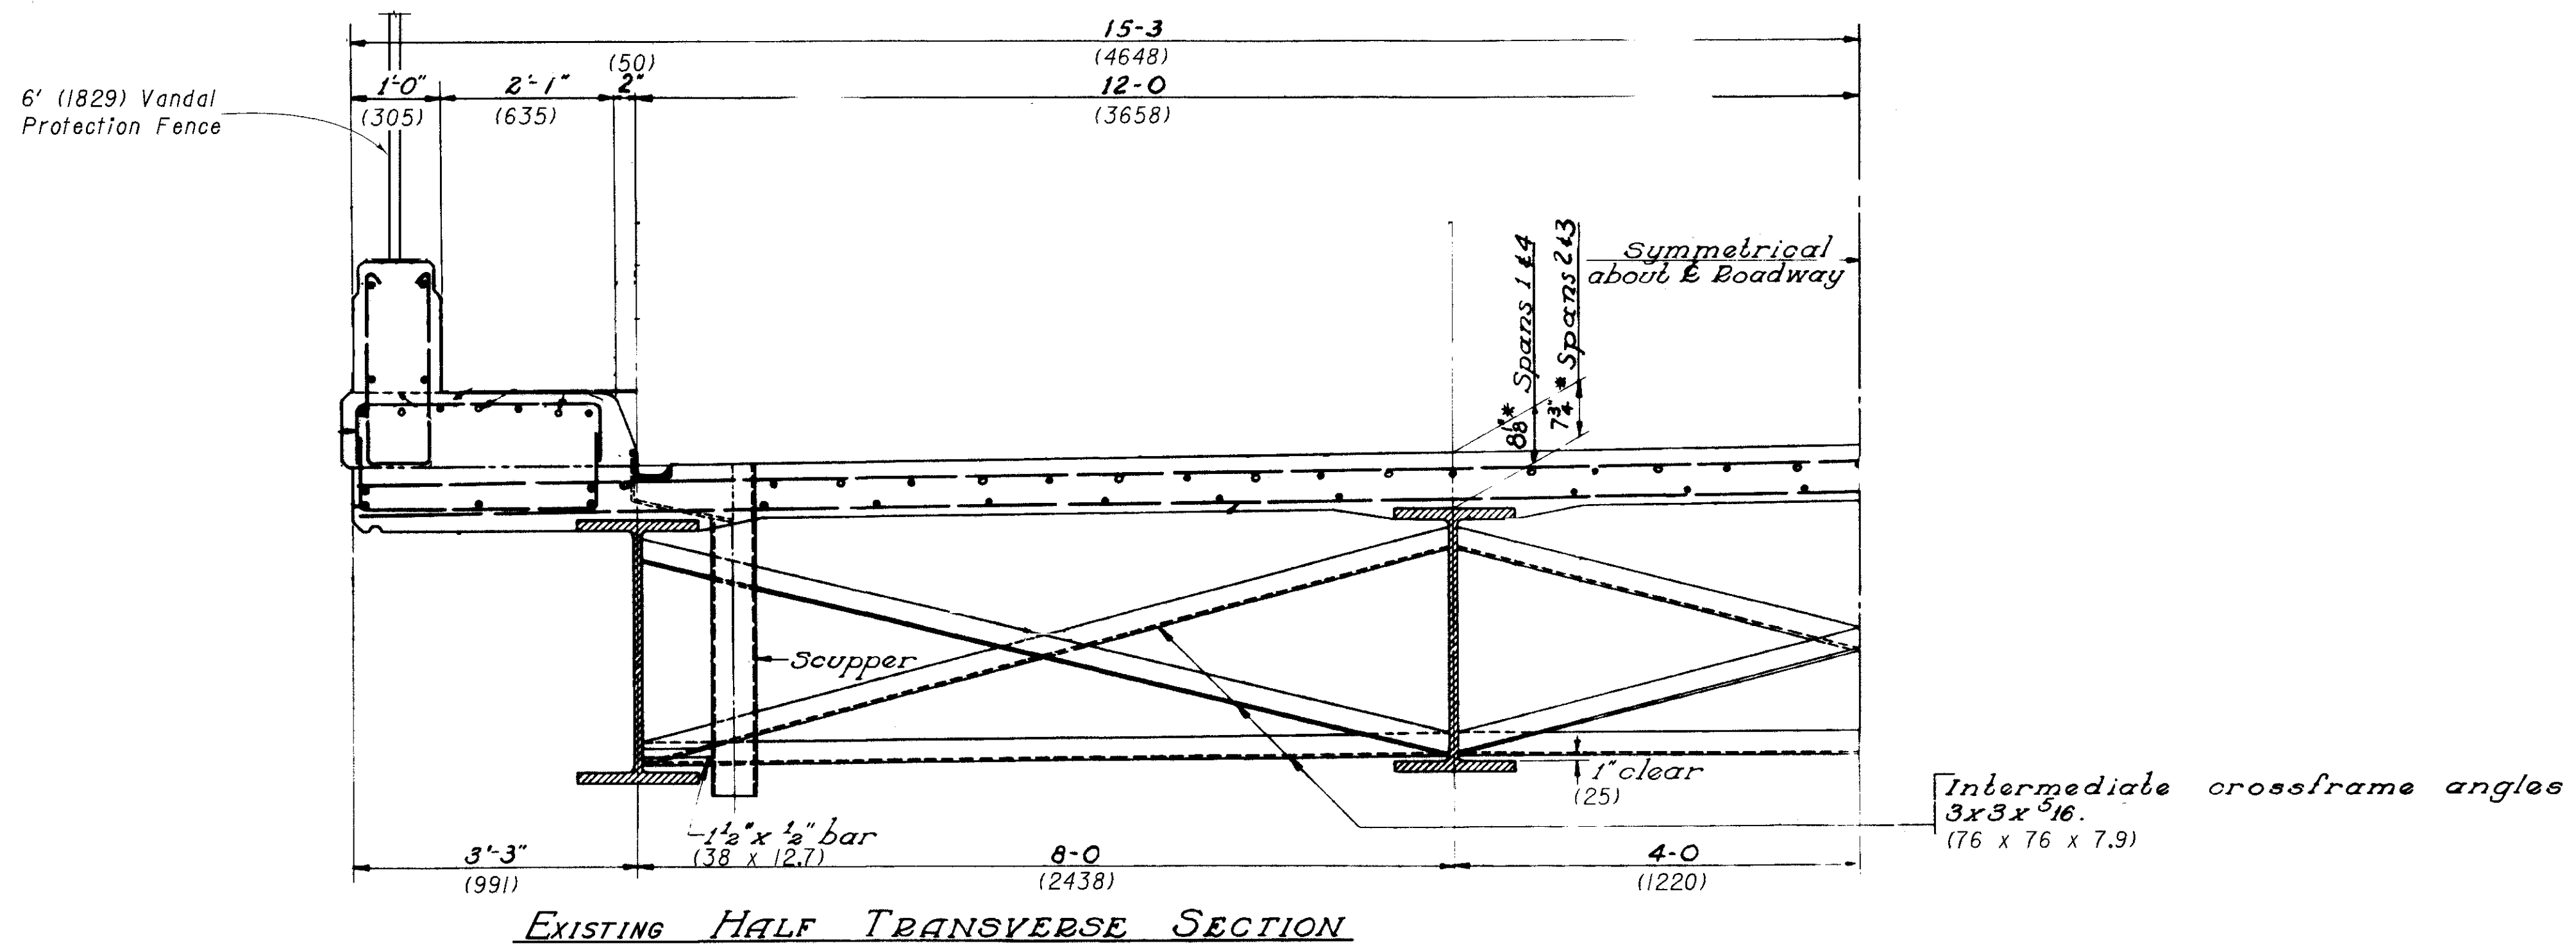


EXISTING HALF TRANSVERSE SECTION

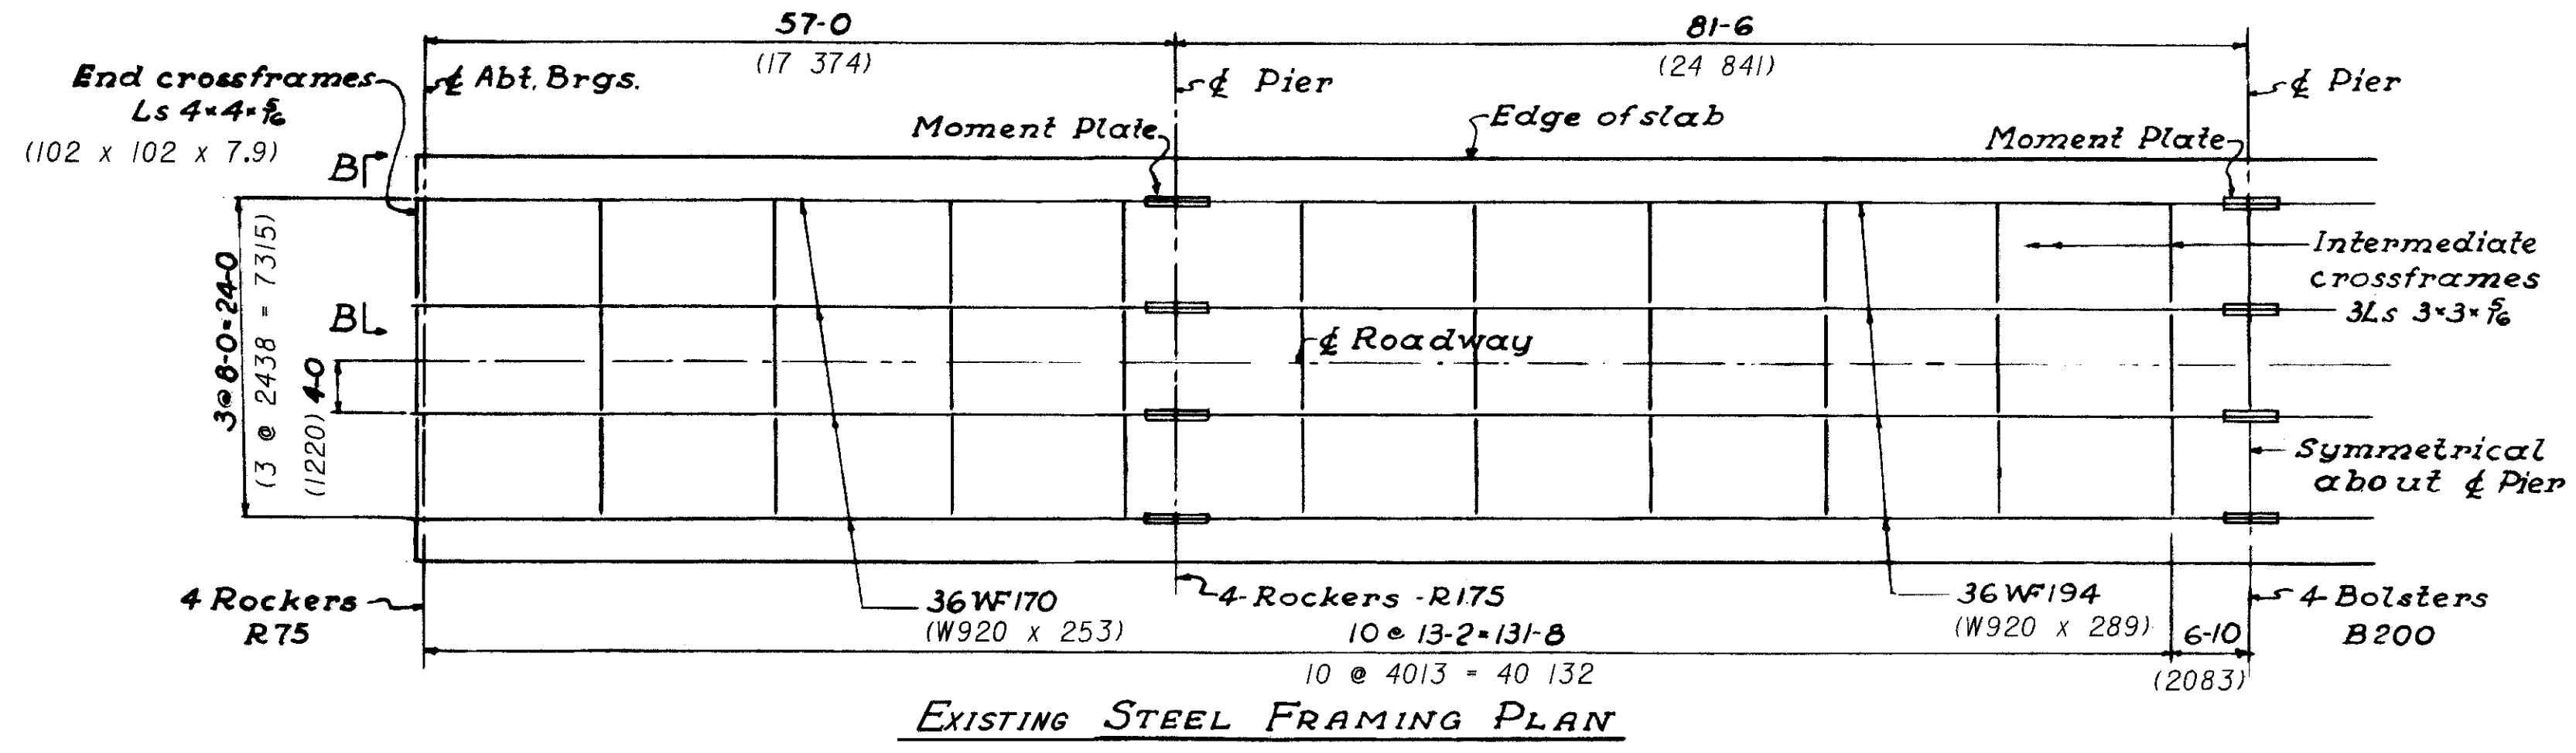

EXISTING STEEL FRAMING PLAN



- Proposed work shall be as follows for PART 12:
- 1) Extend scuppers so that outlet is 200mm below bottom flange.
 - 2) Paint structural steel with System OZEU. Color shall be Federal Color Standard 14260 (Green).
 - 3) Seal concrete surfaces with epoxy-urethane. Color shall be Federal Color Standard 37722 (Buff).
- For standard details, see sheet 18/18.

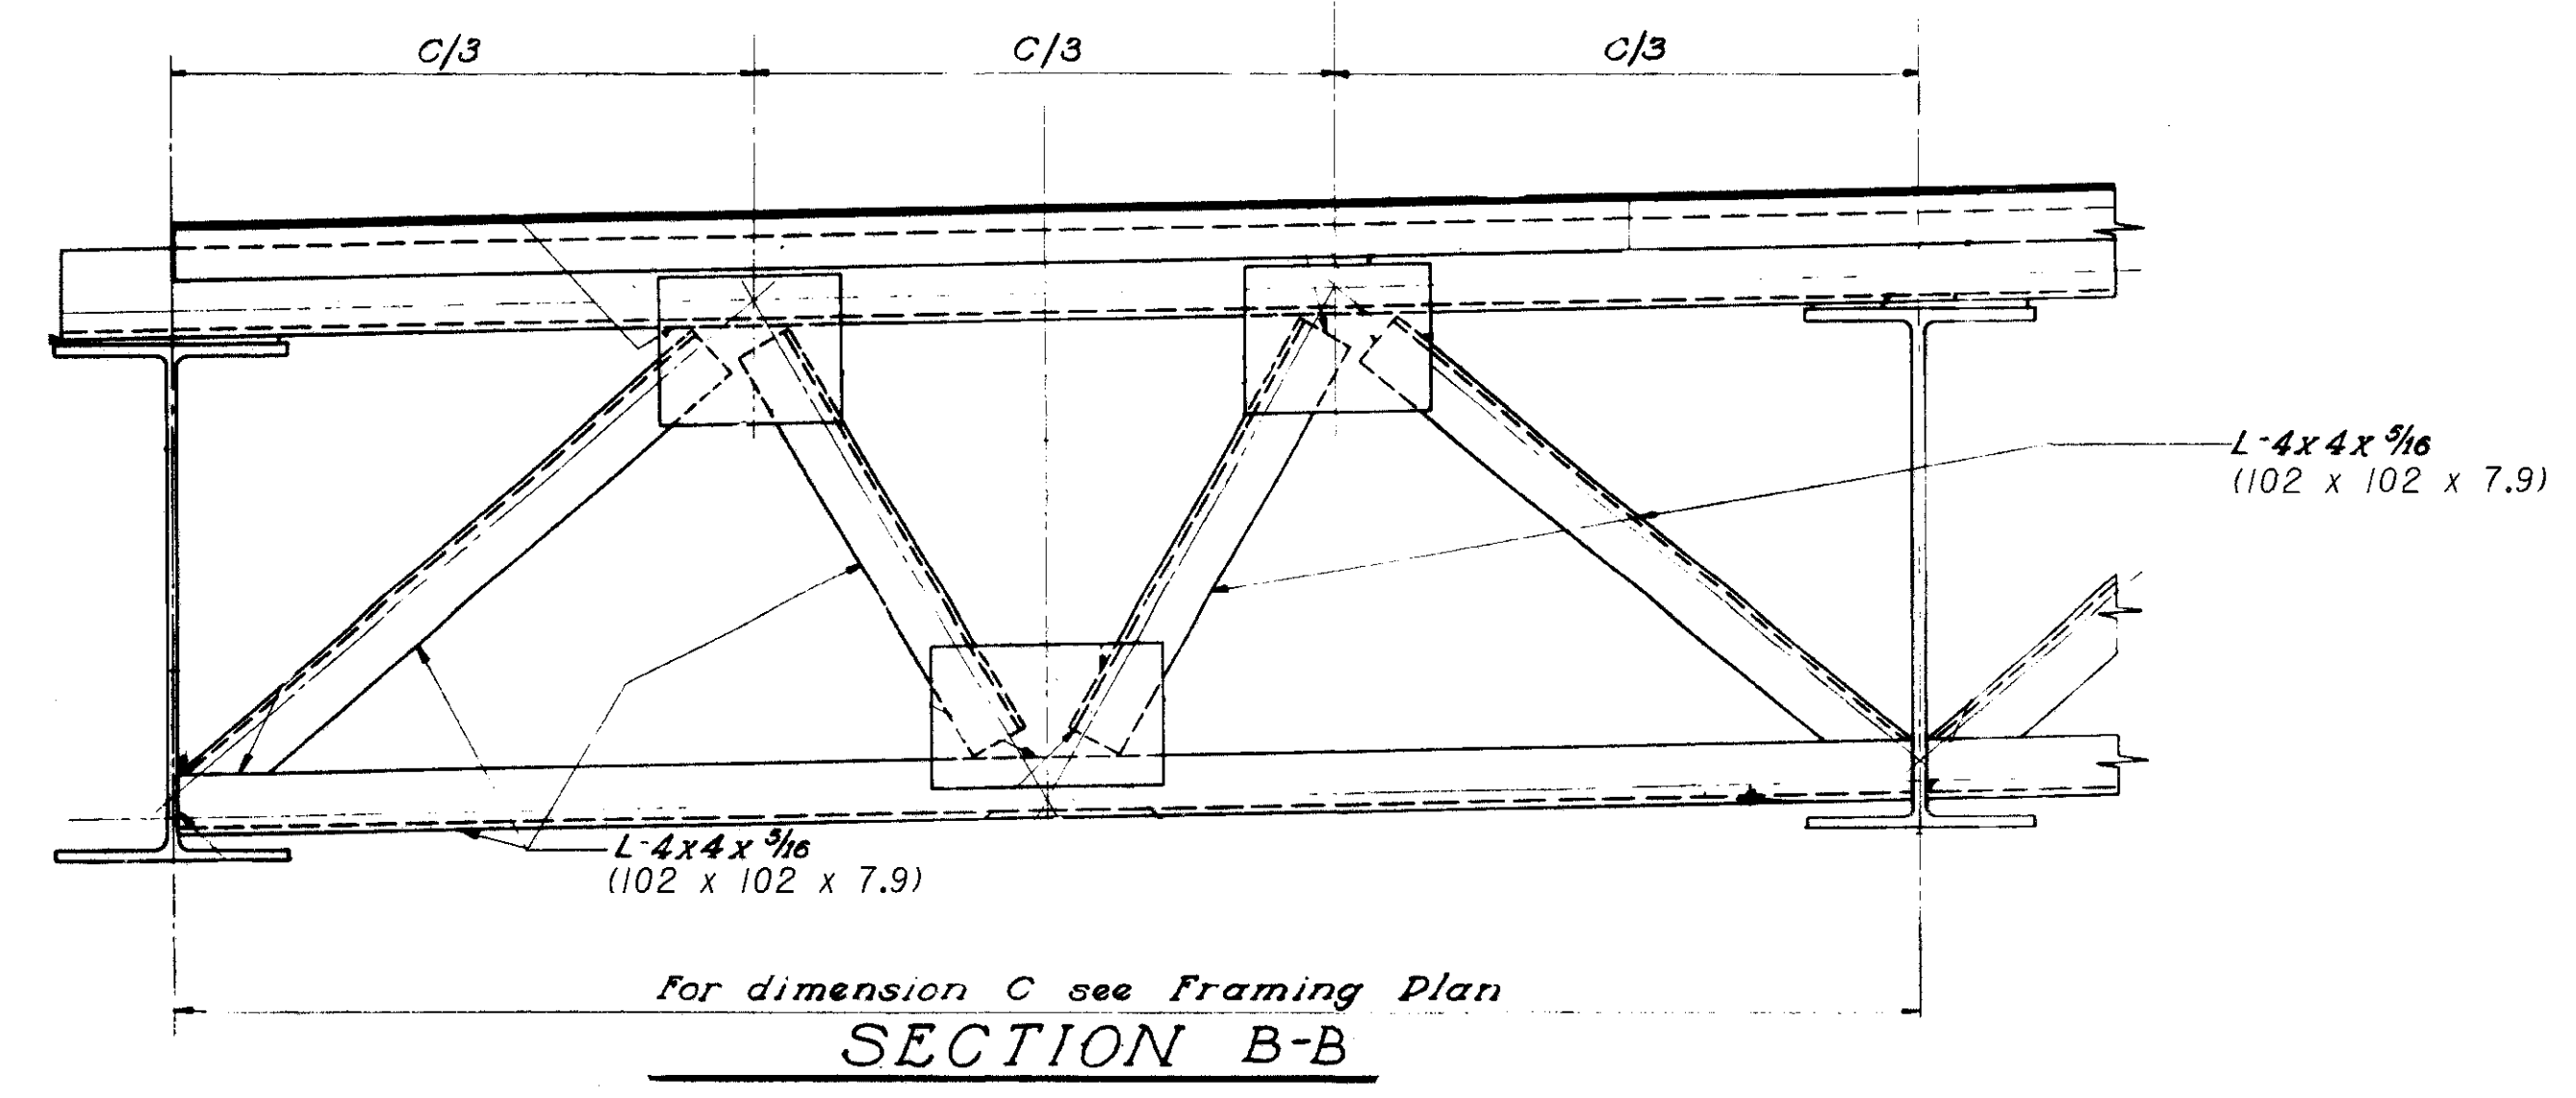

SECTION B-B

Note: Drawings of existing structure are scanned from the original drawing. Dimensions shown are from original construction plans and have not been field verified. Contractor is responsible for field verification of dimensions. Dimension shown in parentheses are metric conversions (millimeters) from the english dimensions.

EXISTING STRUCTURE DATA	
TYPE:	Continuous steel beams with reinforced conc. deck and substructure
SPANS:	17 374, 24 841, 24 841, 17 374 c/c brgs.
ROADWAY:	8026 toe/toe parapet
LOAD FREQUENCY:	CF=130(57)
SKEW:	0°
ALIGNMENT:	Tangent

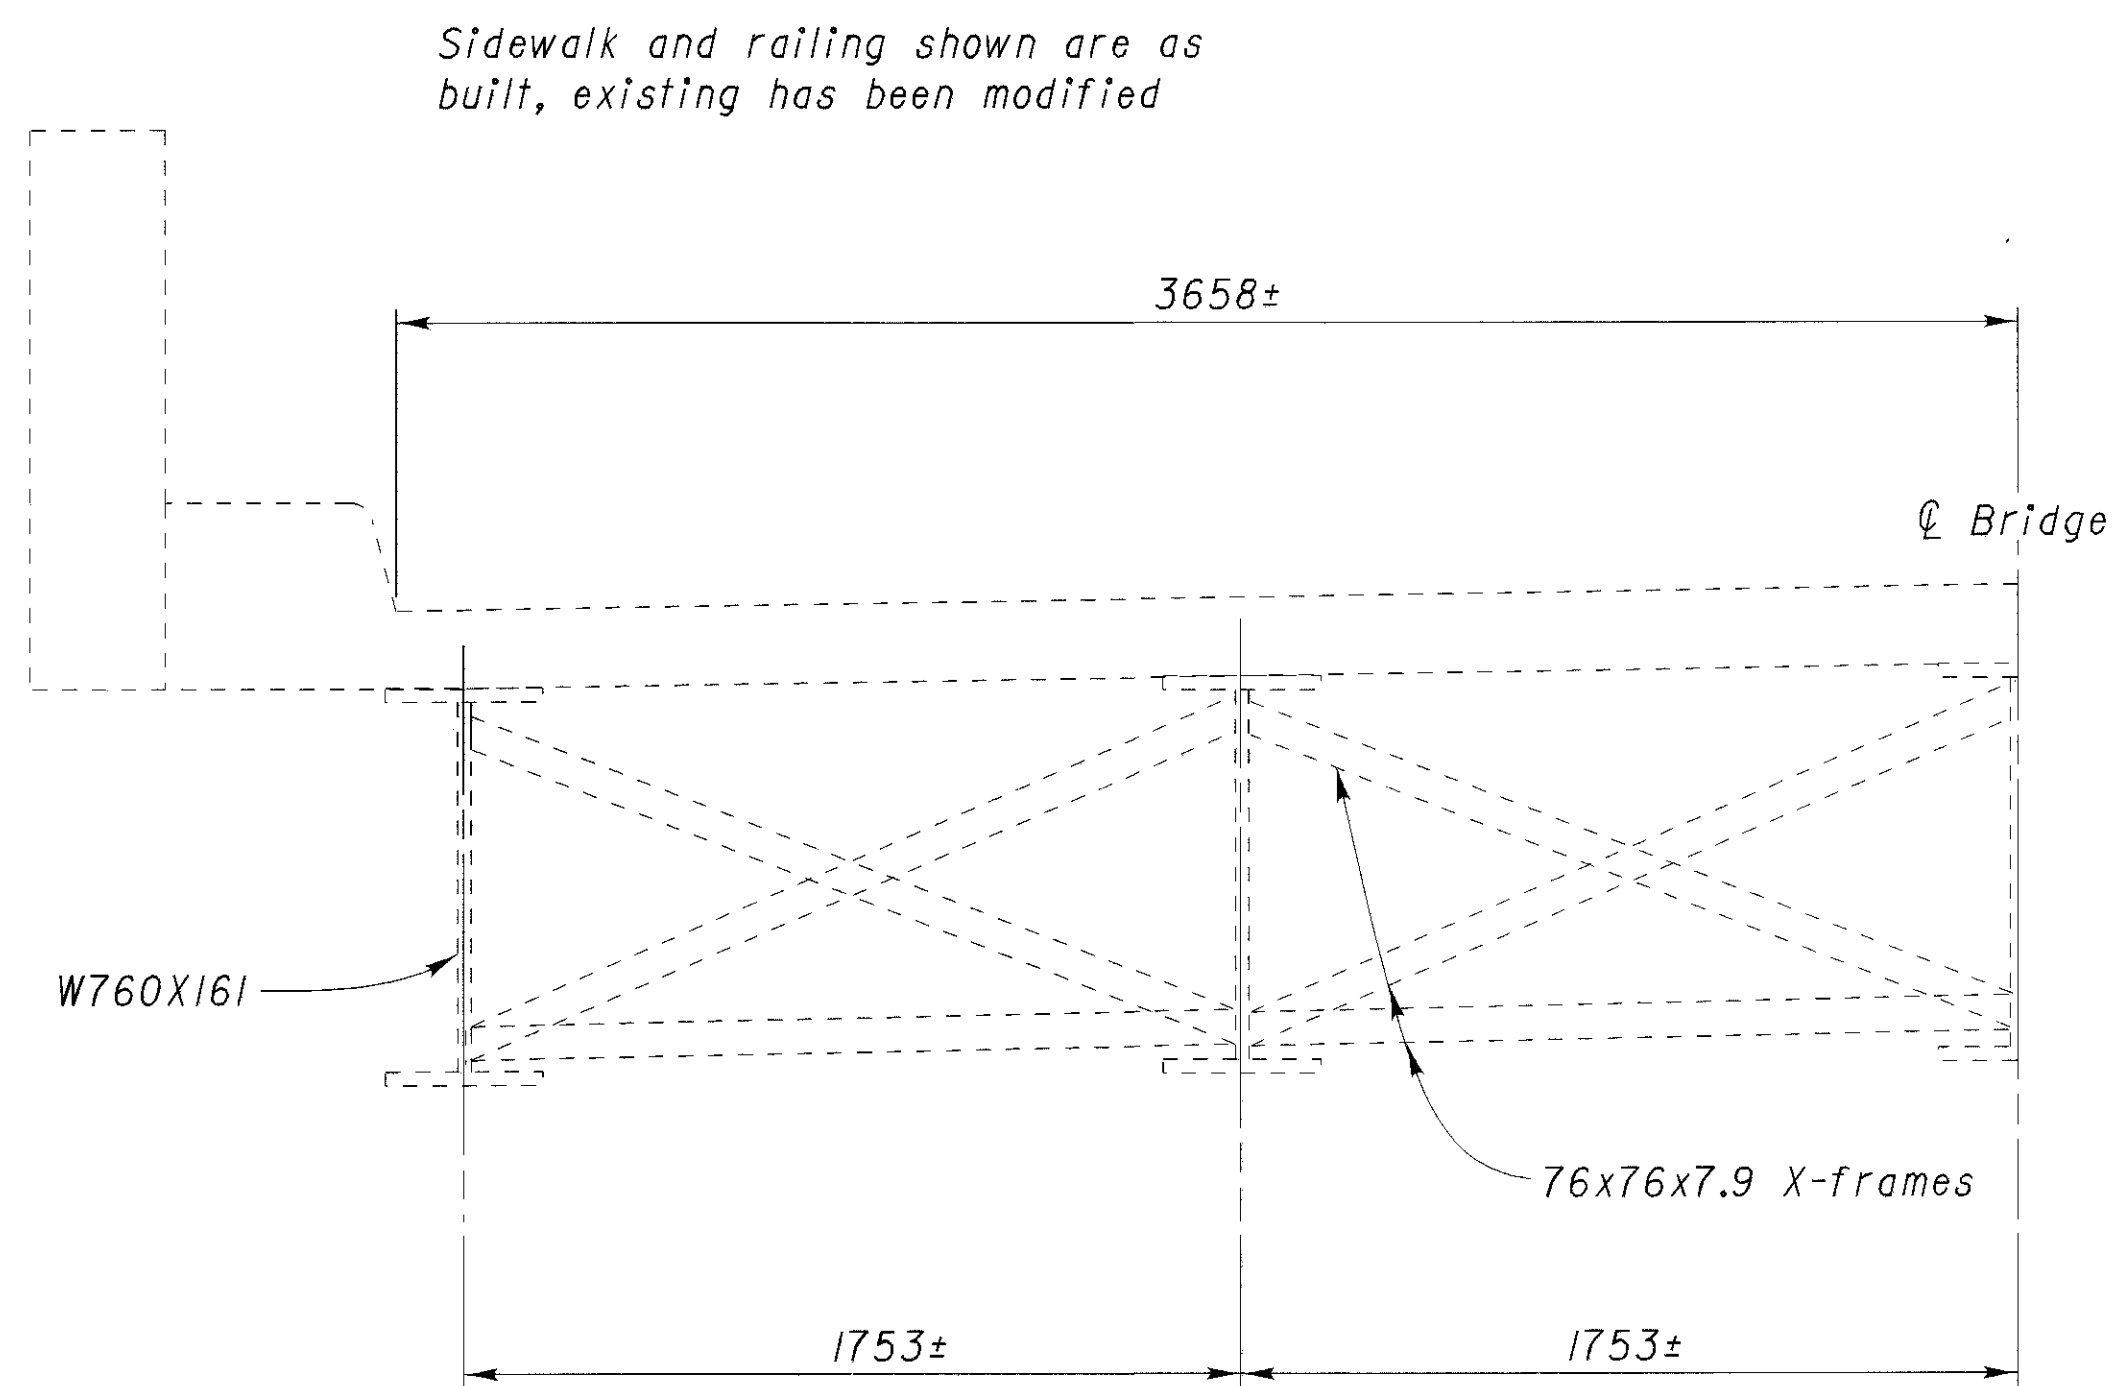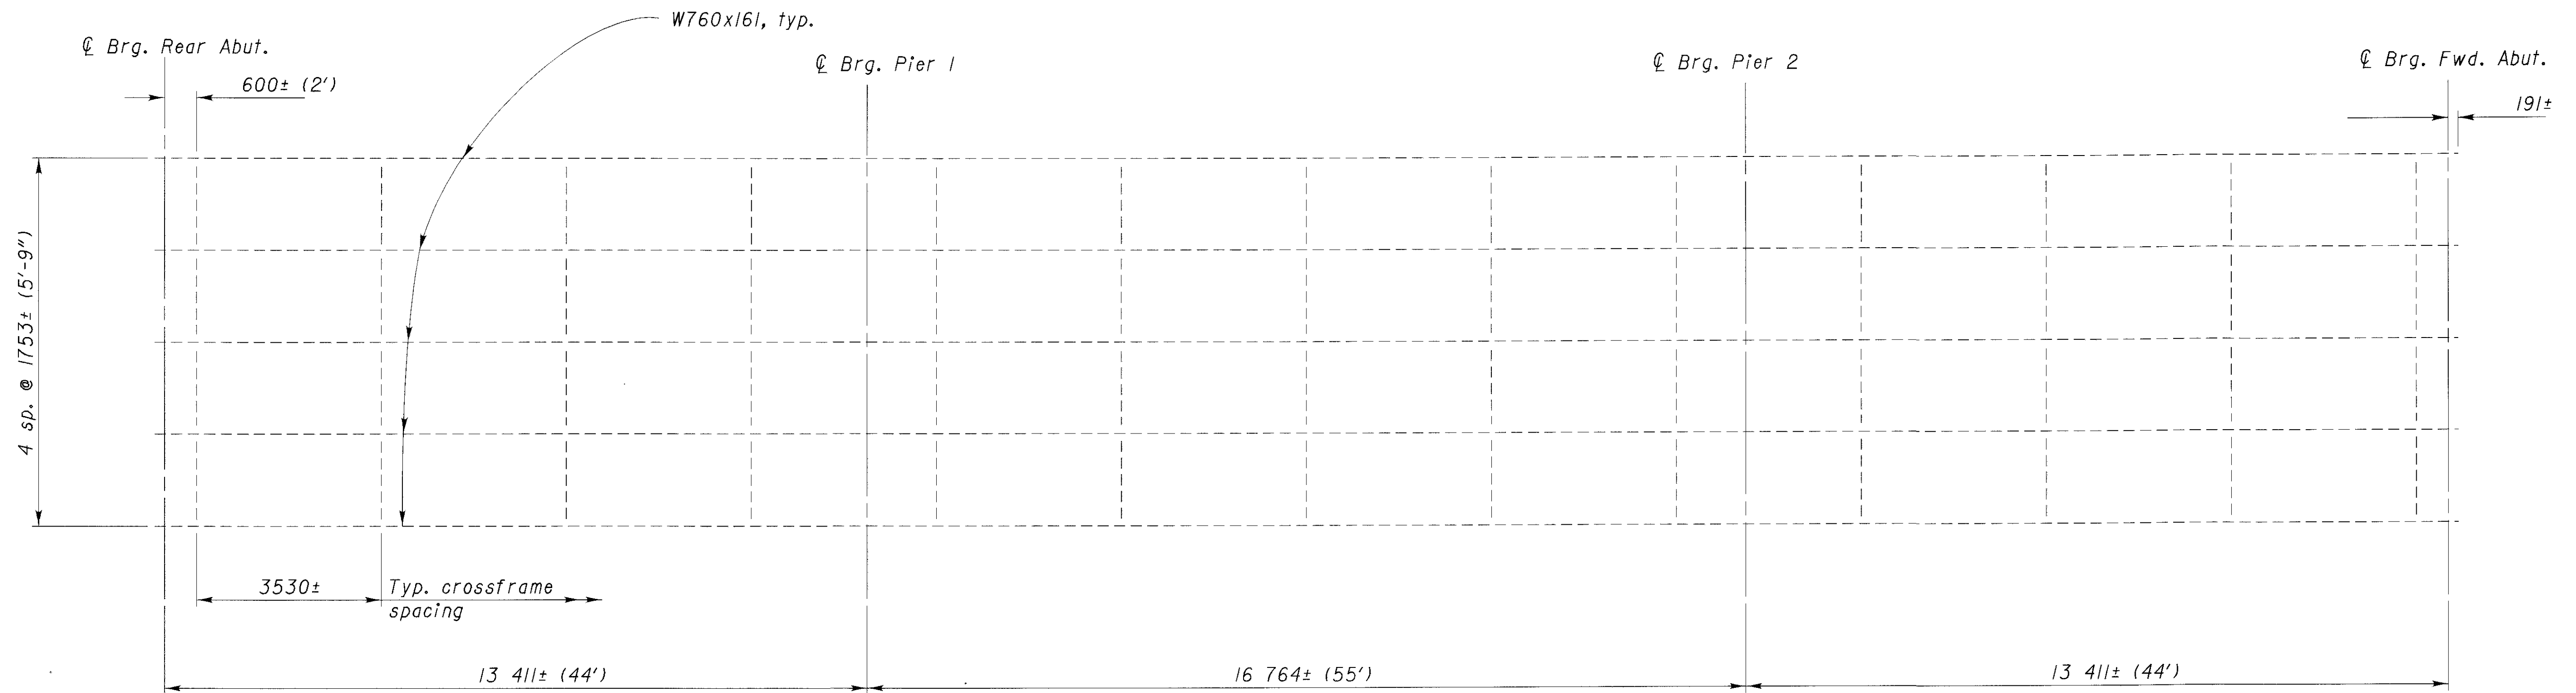

Bridge No. PRE-503-34.134 - PART 13:

Proposed work shall be as follows:

- 1) Paint structural steel with System OZEU. Color shall be Federal Color Standard 14260 (Green).


Note: Paint color shall not be changed without written authorization from the District Structure Maintenance Engineer.

EXISTING STRUCTURE DATA

TYPE: Continuous steel beams with reinforced conc. deck and substructure
 SPANS: 13 411, 16 764, 13 411 c/c brgs.
 ROADWAY: 7315 f/f curb (as built)
 SKEW: None
 ALIGNMENT: Tangent



DETAIL FOR SEALING

All structures except PRE-503-34.134 (2I2I)

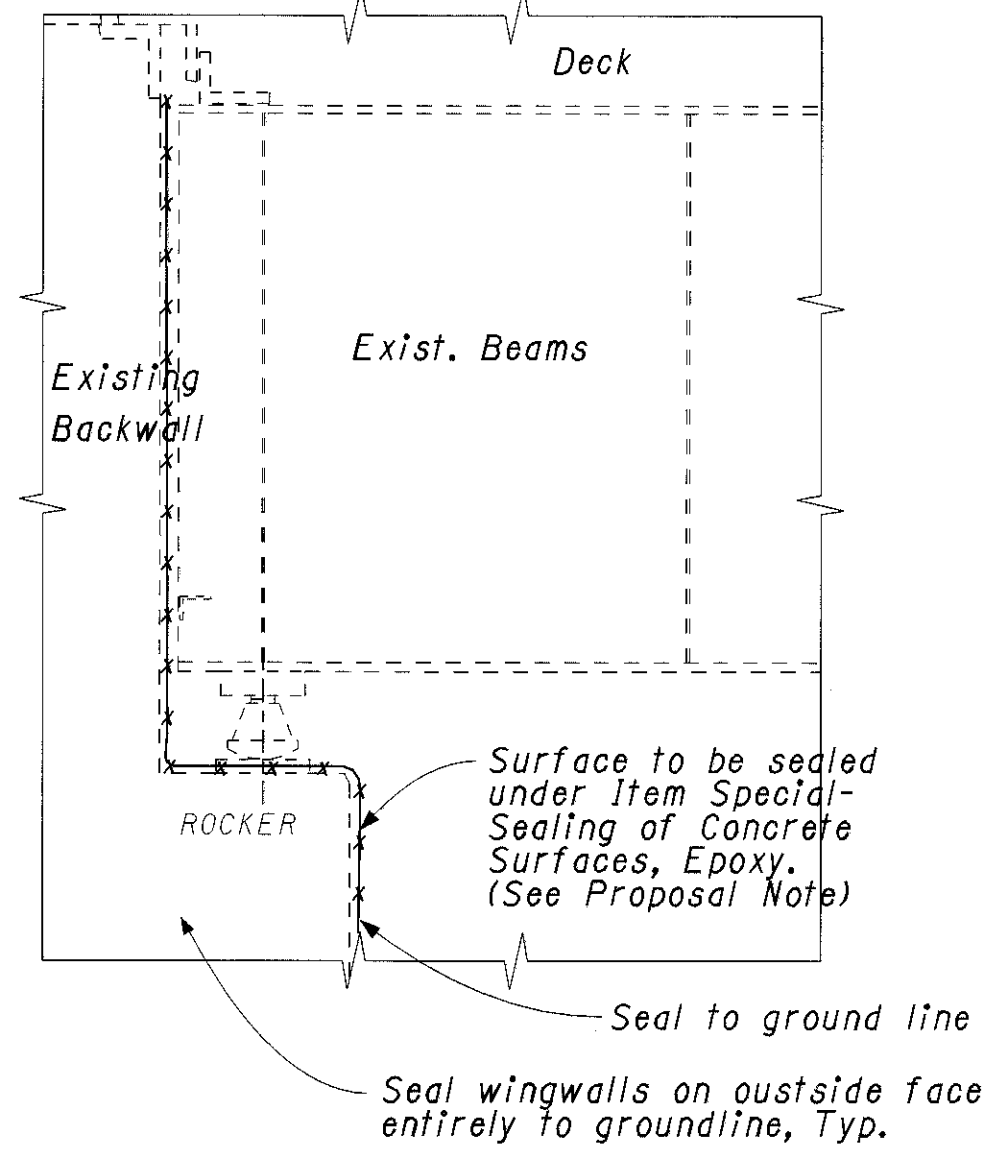

DECK EDGE SEALING DETAIL

All structures except PRE-70-24.140 L/R (1500 L/R)

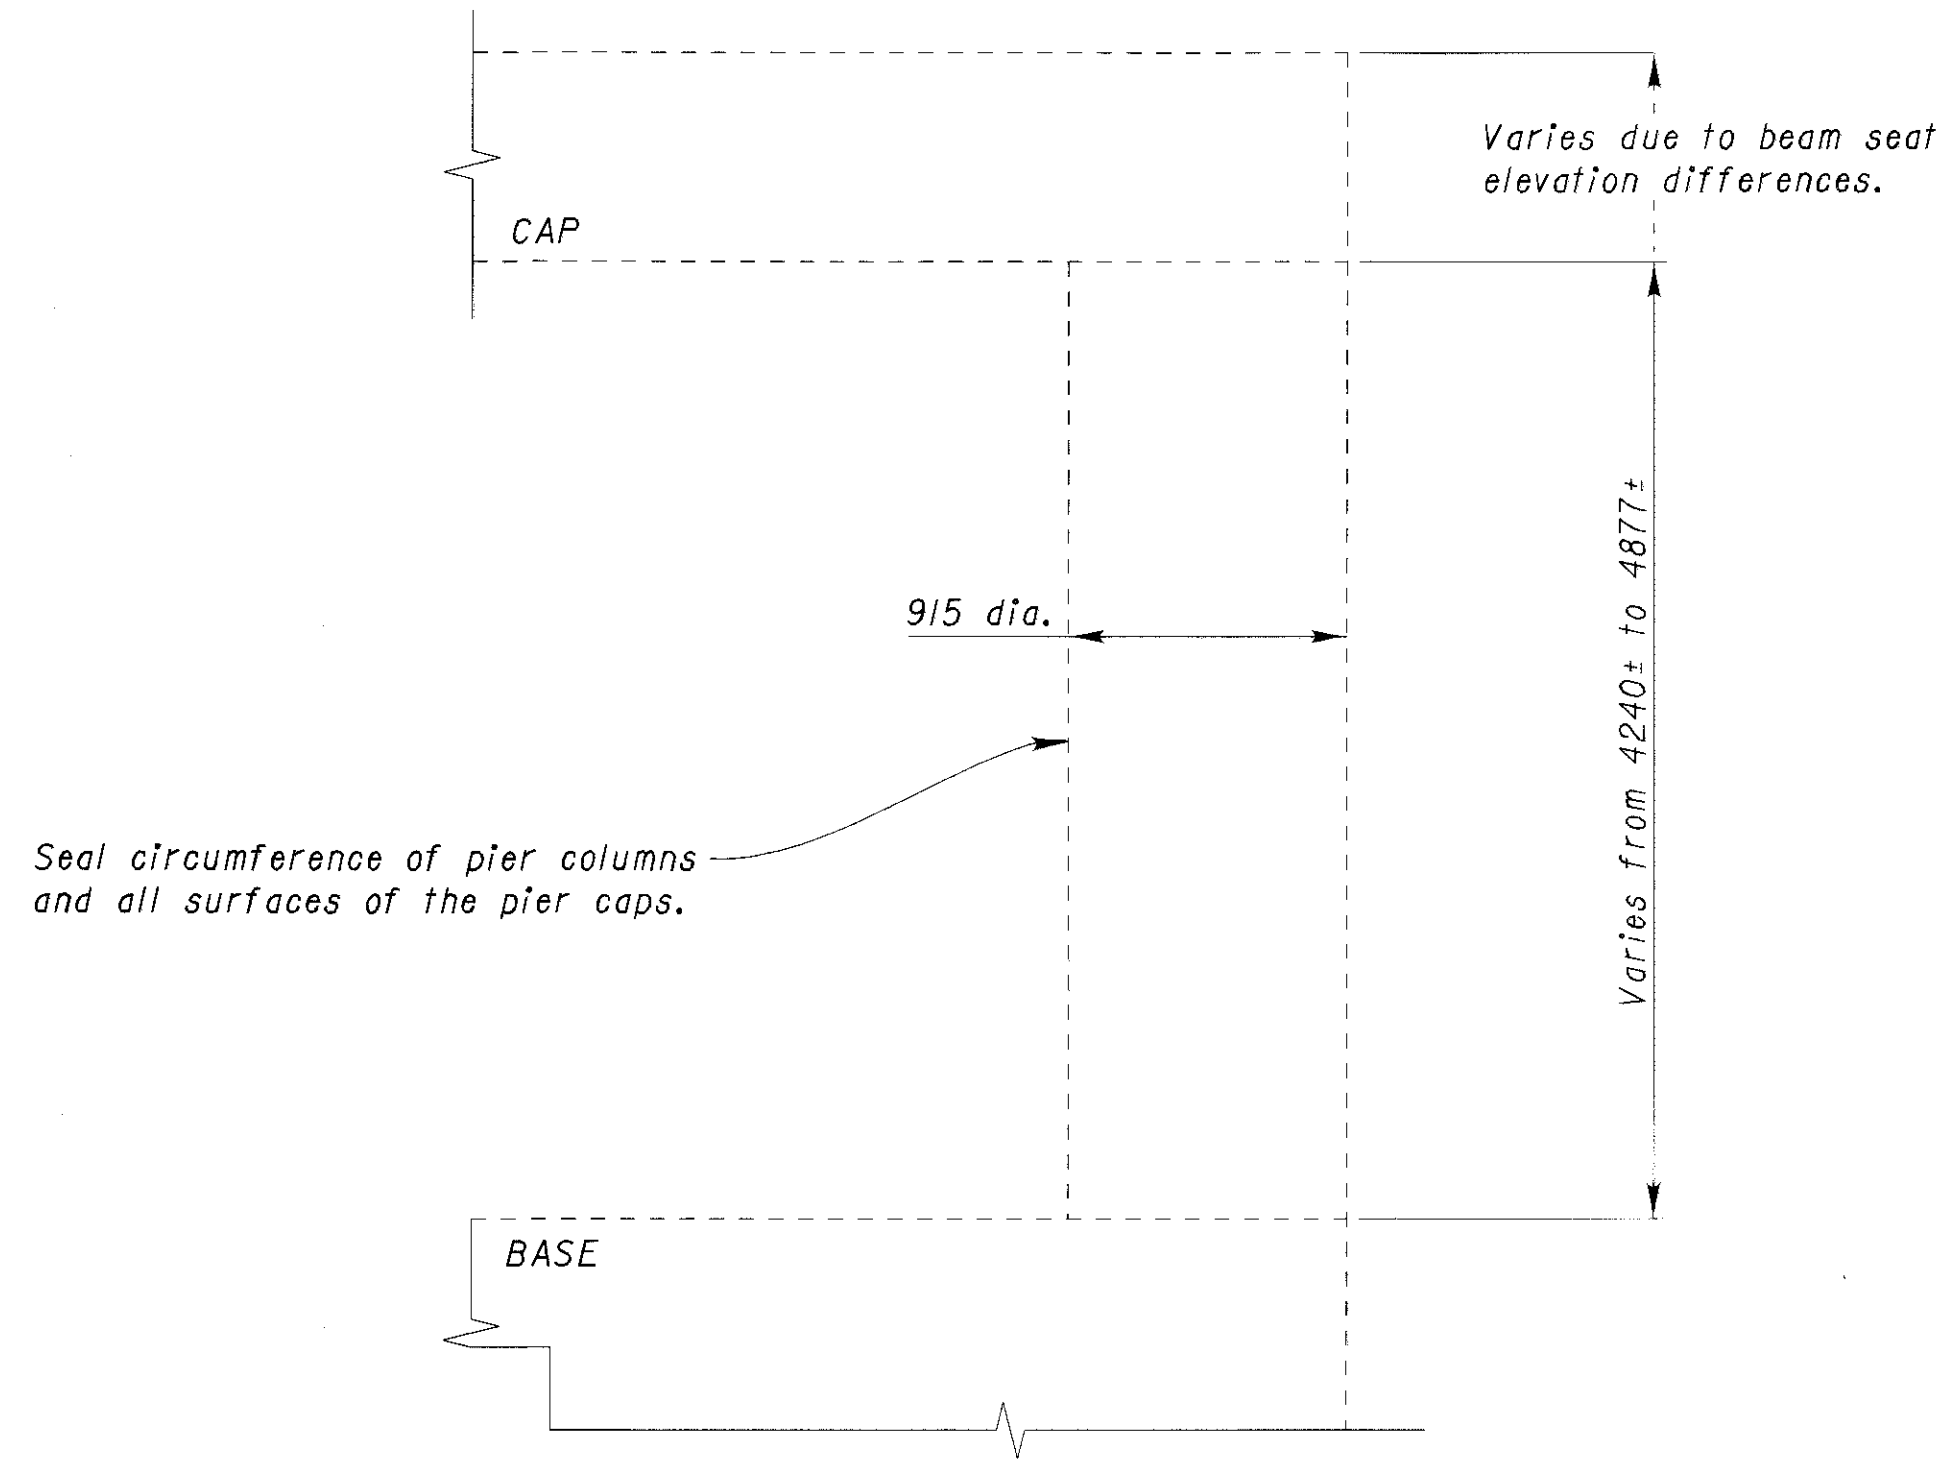
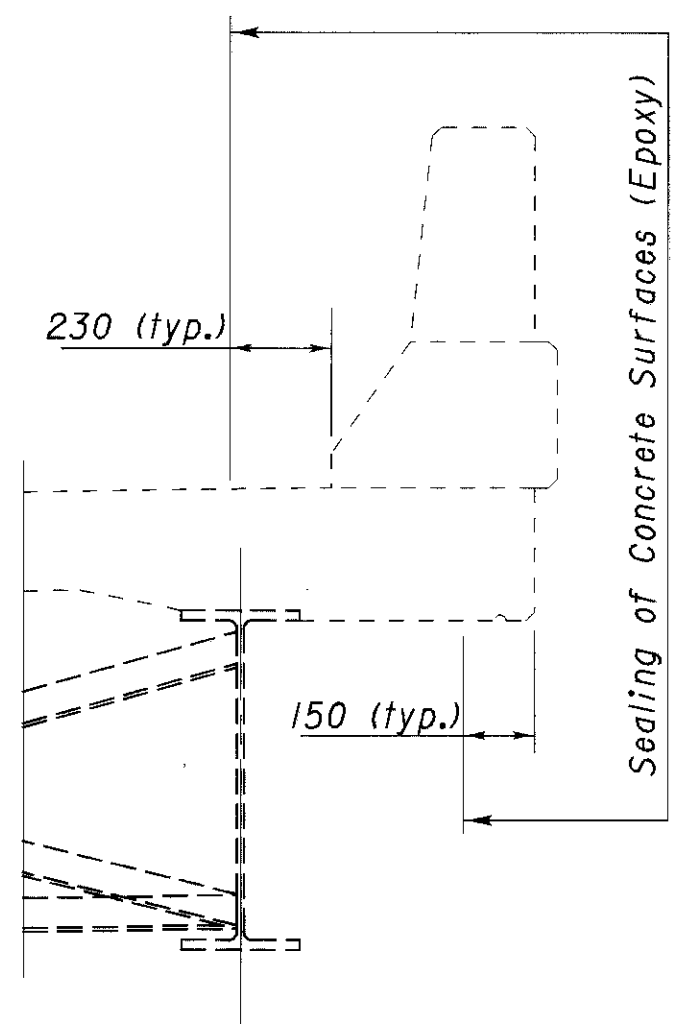


SEAL PIERS 1 AND 3 (PIER CAP AND COLUMNS)

For all structures except:
PRE-70-20.101 L/R (1249 L/R),
PRE-70-24.140 L/R (1500 L/R) and
PRE-503-34.134 (2I2I)

STRUCTURAL STEEL SHIM DETAILS

Shims are to be welded around their perimeter, dimensions B and L, shown below. These dimensions shall be determined by field observation and measurements of the existing structure. Payment included under Item 516 - Refurbish Bearing Device, as per plan.

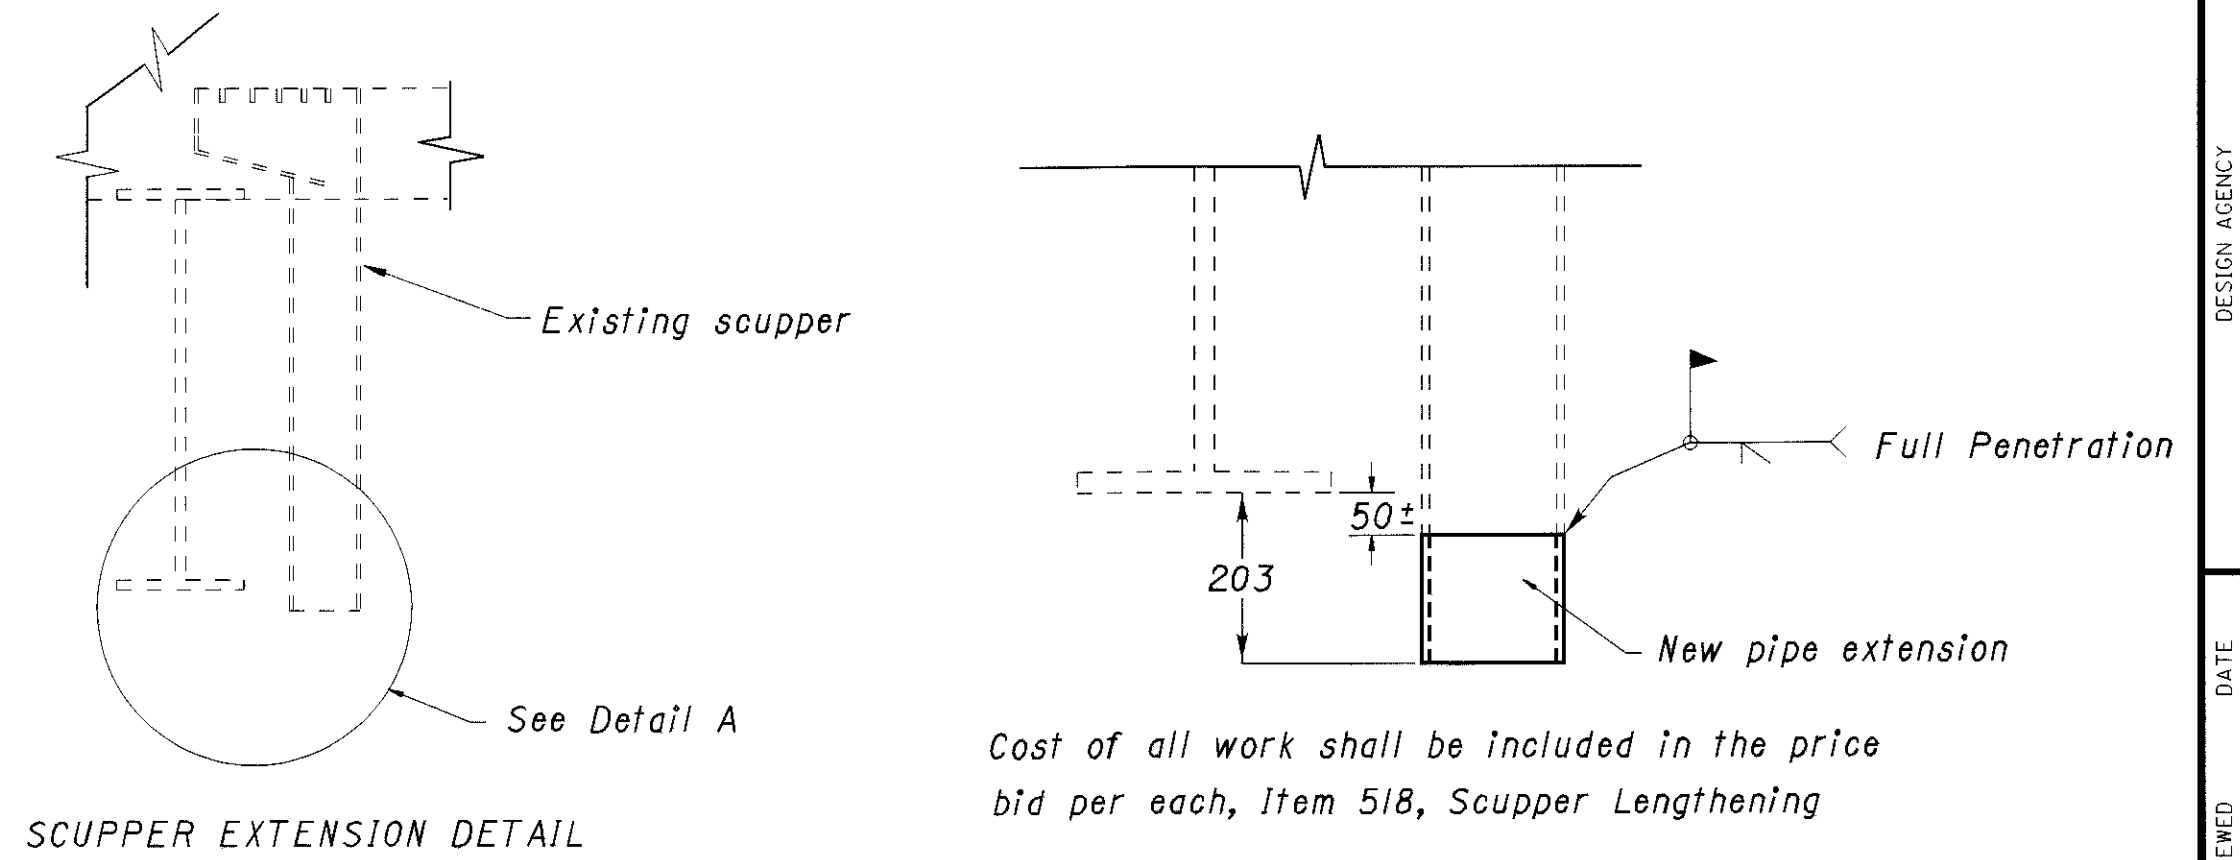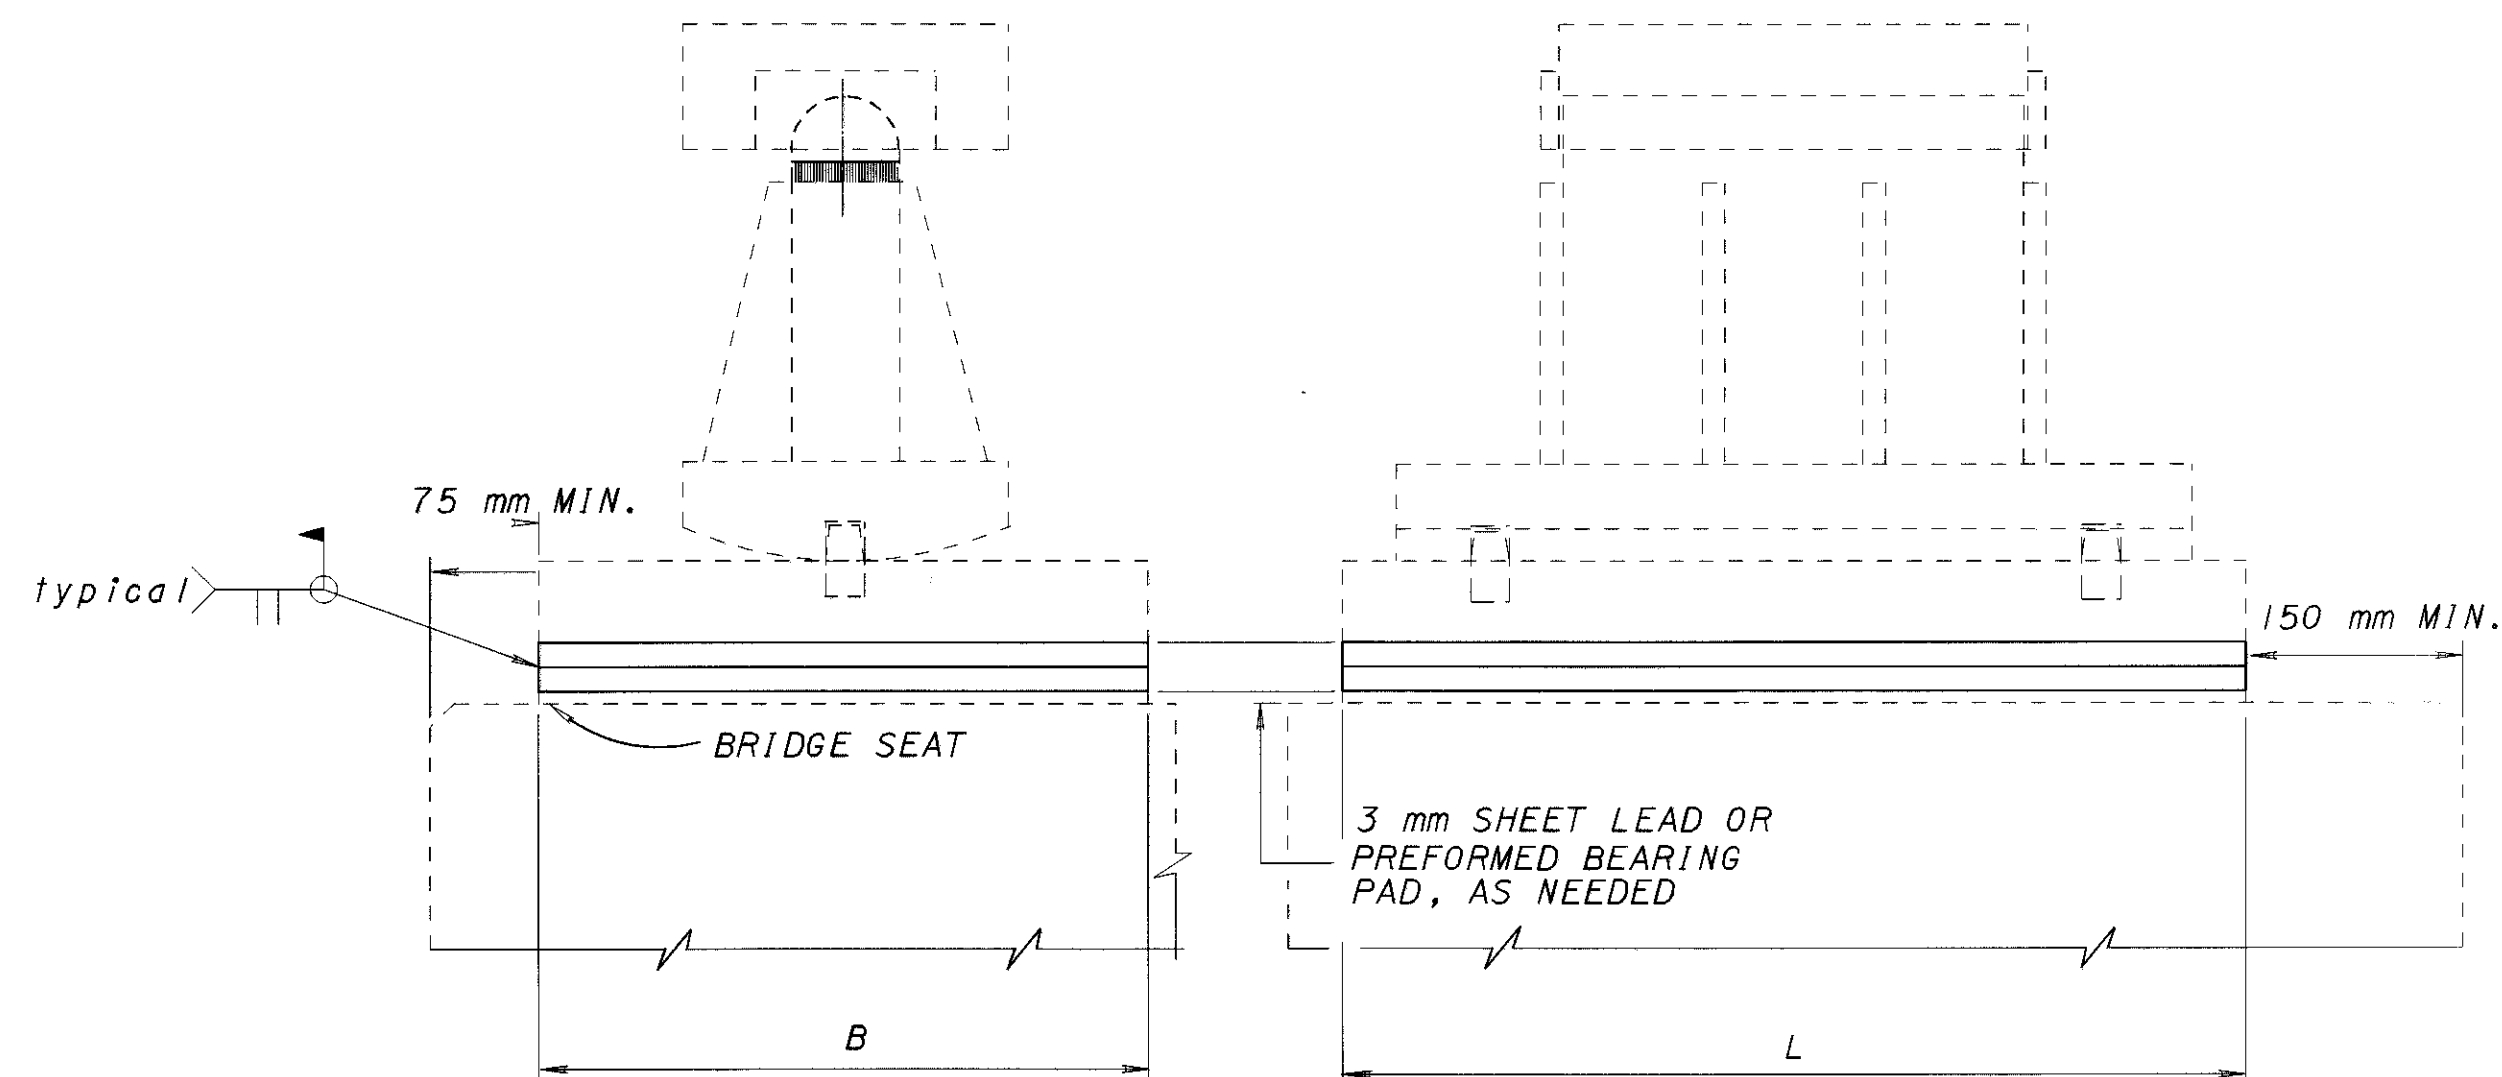


SCUPPER EXTENSION DETAIL

DETAIL A



SCUPPER LENGTHENING DETAILS

Cost of all work shall be included in the price bid per each, Item 518, Scupper Lengthening

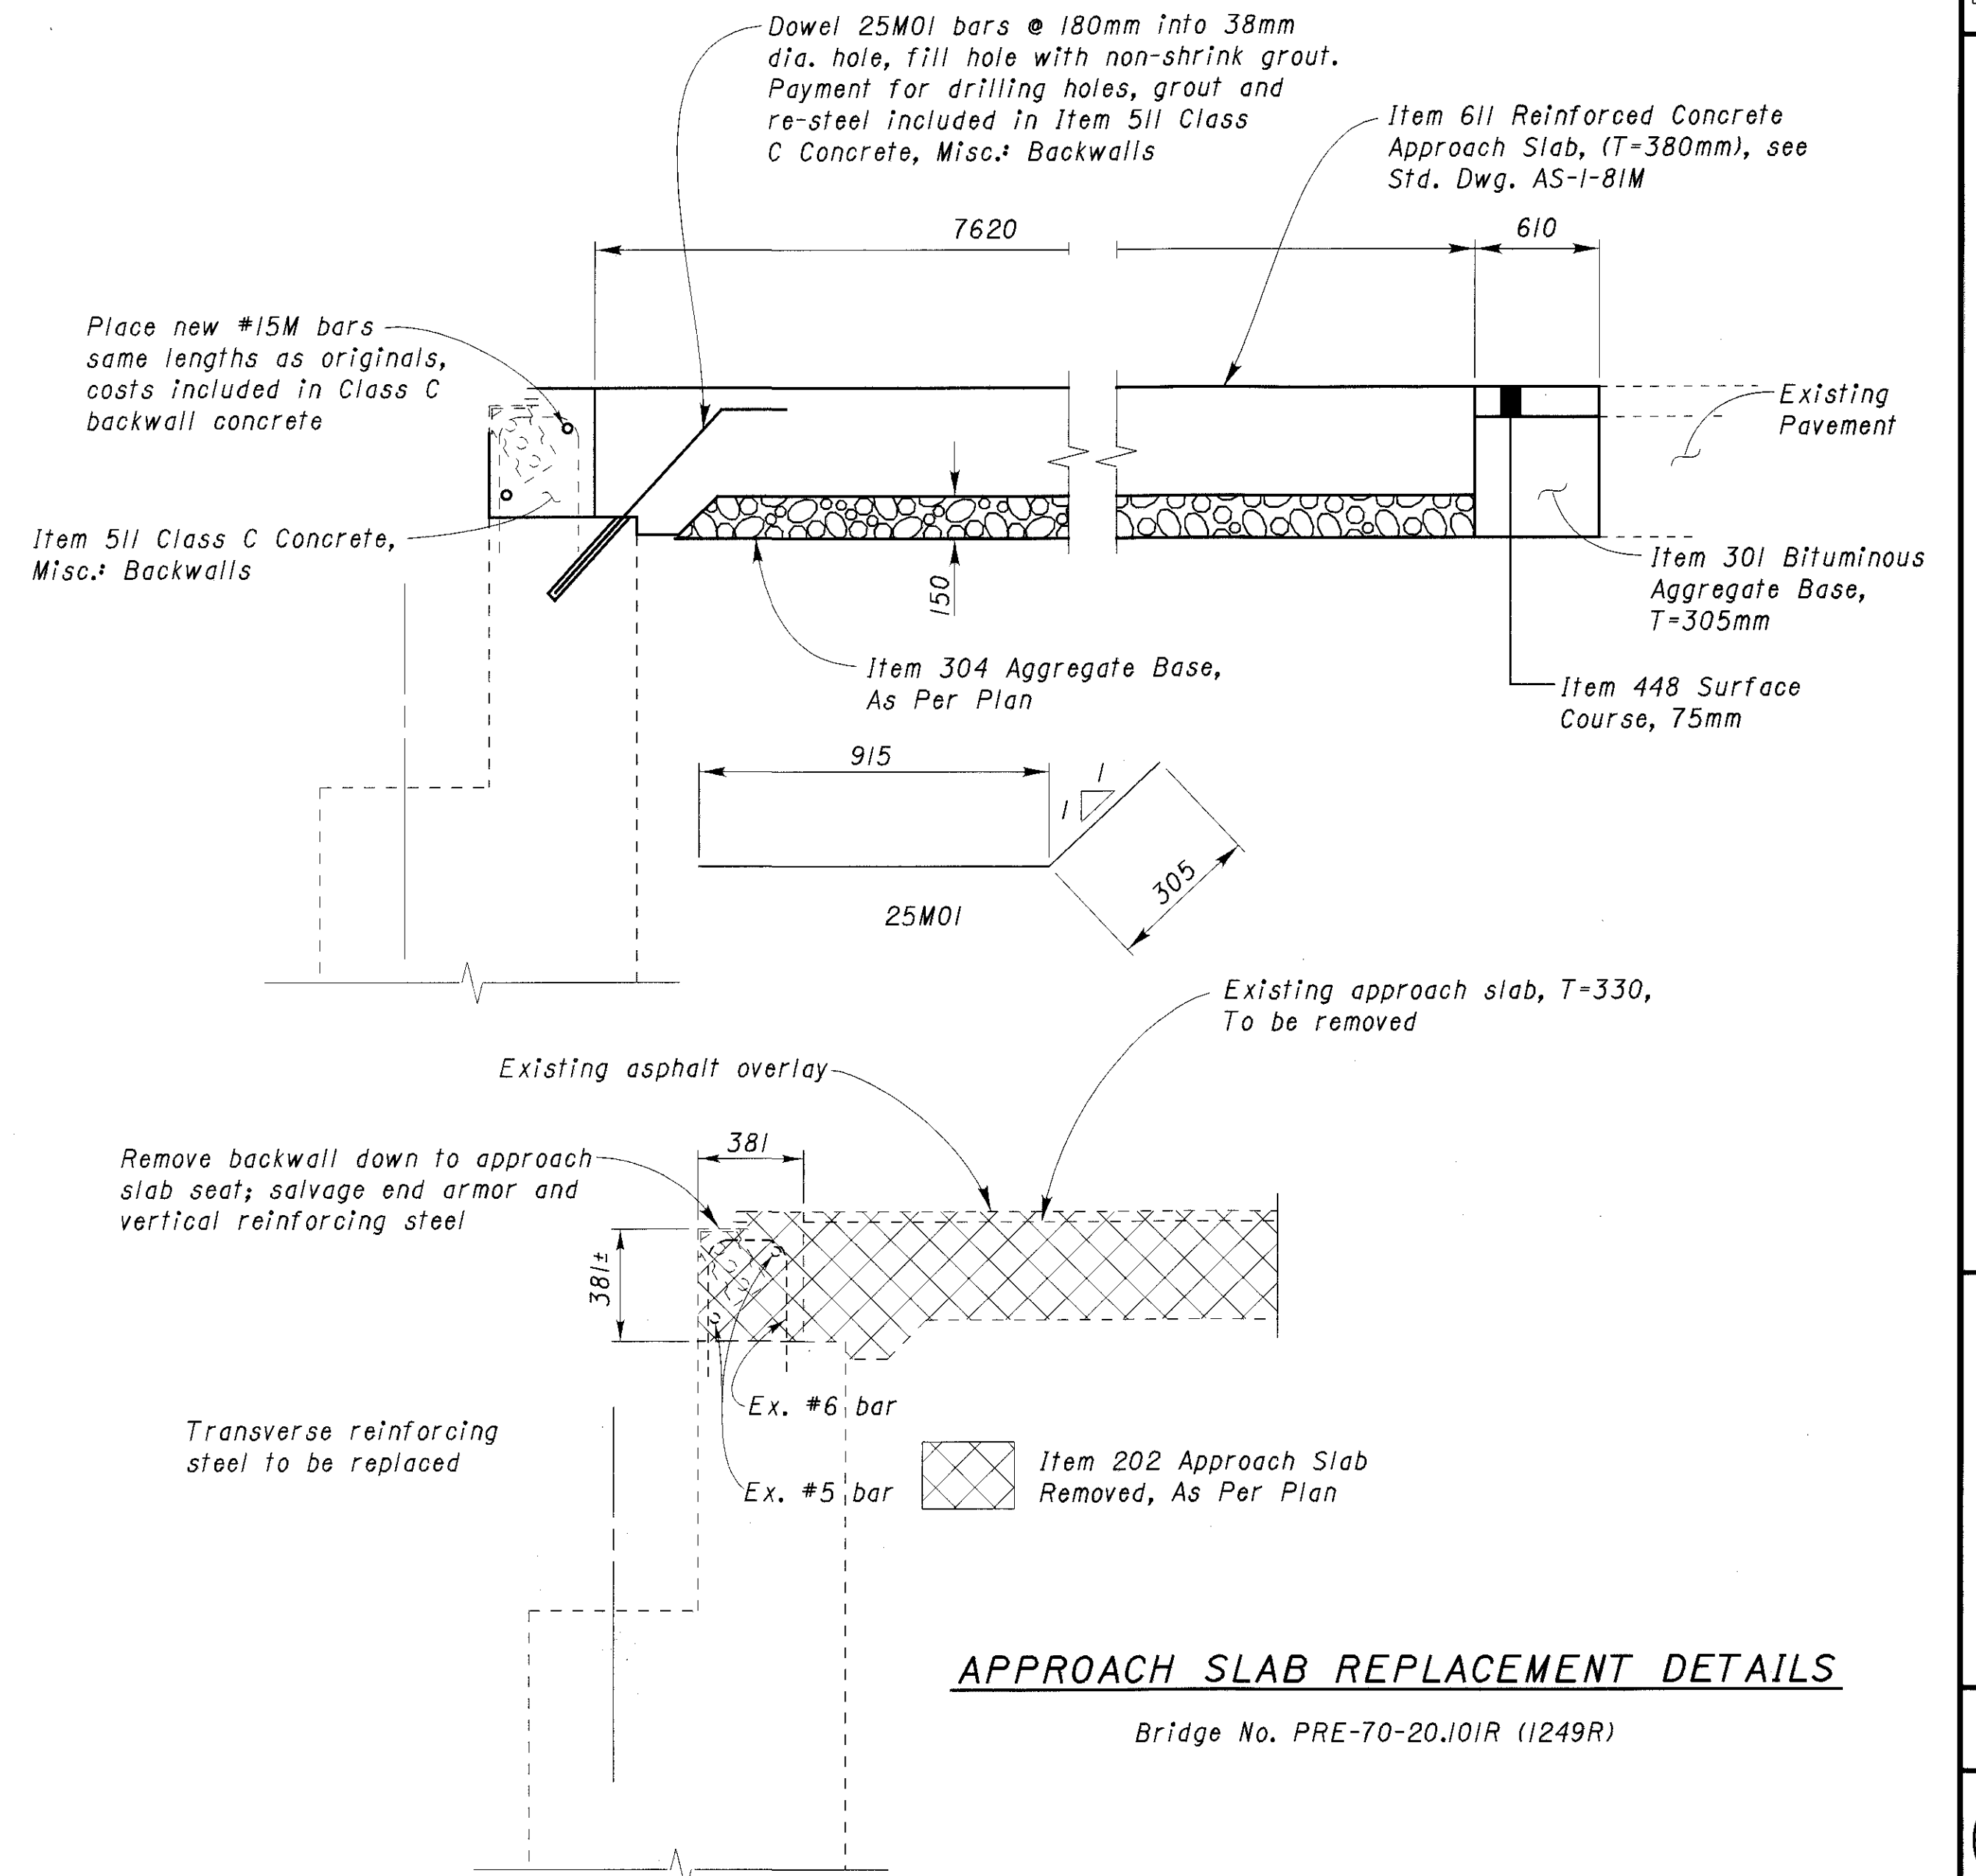

APPROACH SLAB REPLACEMENT DETAILS

Bridge No. PRE-70-20.101R (1249R)

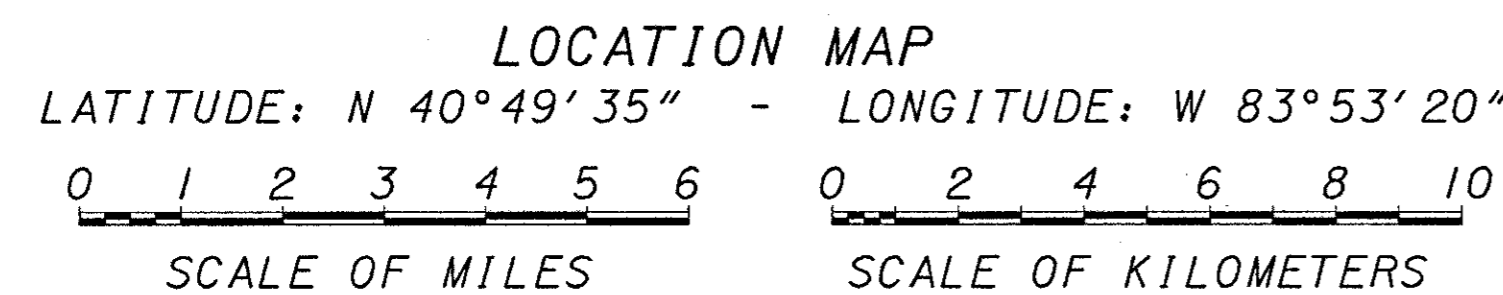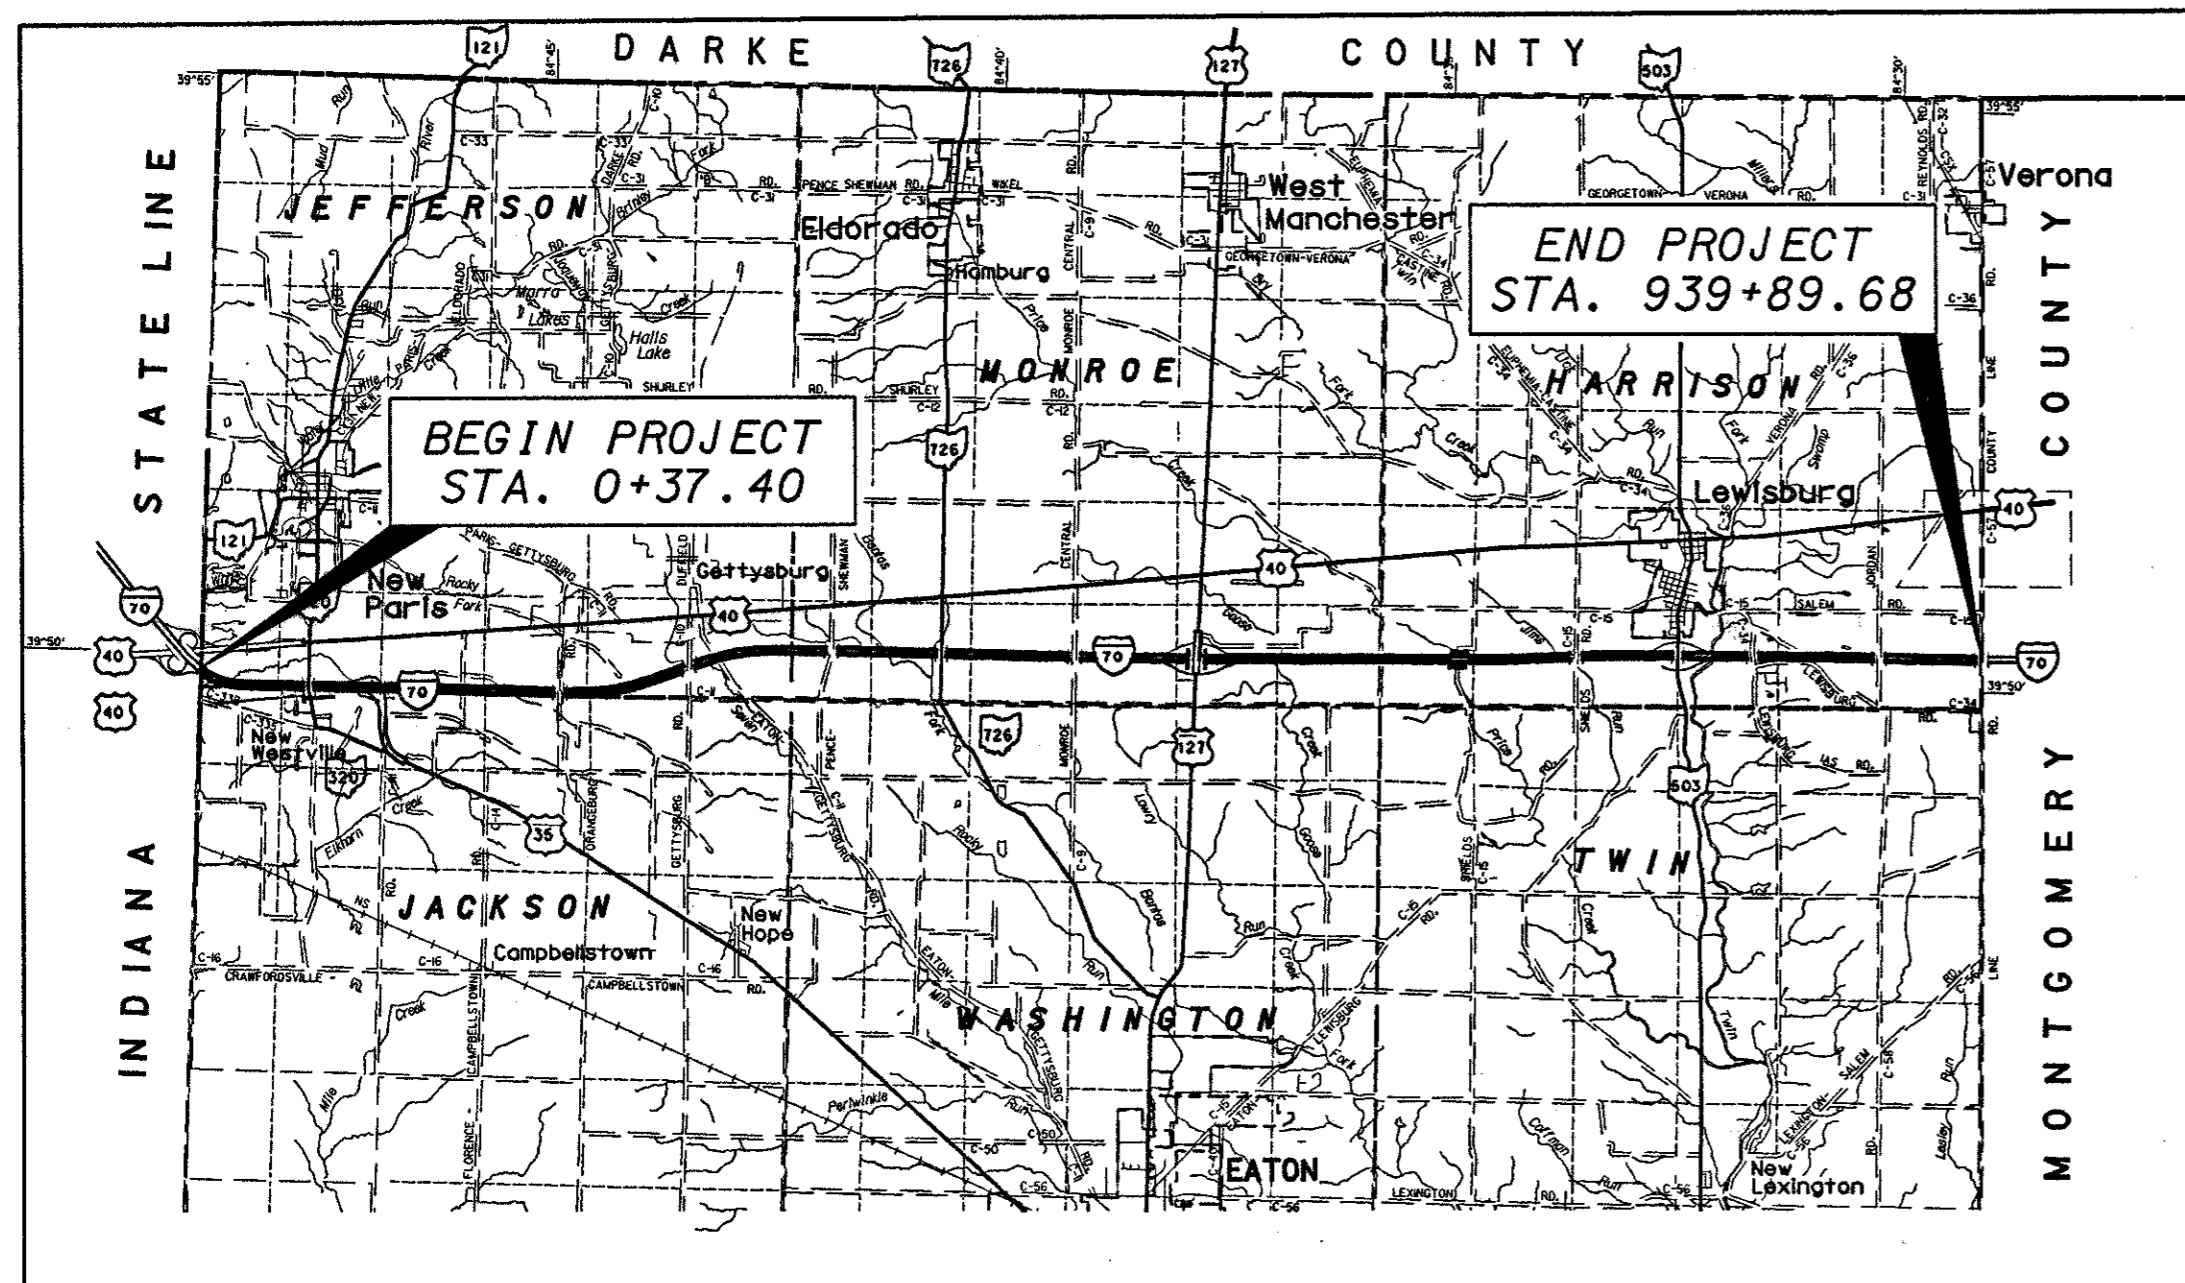

PORTION TO BE IMPROVED
STATE & FEDERAL ROUTES.....
OTHER ROADS.....

DESIGN DESIGNATION

CURRENT ADT (2001) 35860
DESIGN YEAR ADT (2021) 50800
DESIGN HOURLY VOLUME (2021) 5080
DIRECTIONAL DISTRIBUTION 55 %
TRUCKS (24 HOUR B&C) 39 %
DESIGN SPEED 65 MPH
LEGAL SPEED 65 MPH

DESIGN FUNCTIONAL CLASSIFICATION - RURAL INTERSTATE

DESIGN EXCEPTIONS


NONE REQUIRED

UNDERGROUND UTILITIES
TWO WORKING DAYS
BEFORE YOU DIG
CALL 1-800-362-2764 (TOLL FREE)
OHIO UTILITIES PROTECTION SERVICE
NON-MEMBERS
MUST BE CALLED DIRECTLY

PLAN PREPARED BY:

KZF DESIGN
Architecture | Engineering | Interiors | Planning
KZF DESIGN INC. 655 Eden Park Drive Cincinnati, OH 45202-8000
TEL 513.621.6211 FAX 513.621.36530 WEB www.kzf.com

ENGINEERS SEAL

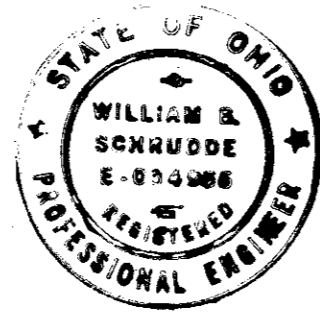

SIGNED: William A. Schrudde
DATE: 8/05/2002

STATE OF OHIO DEPARTMENT OF TRANSPORTATION PRE-70-0.00 JEFFERSON, JACKSON, MONROE, AND HARRISON TOWNSHIPS PREBLE COUNTY

INDEX OF SHEETS:

TITLE SHEET 1
SCHEMATIC PLAN 2-4
TYPICAL SECTIONS 5-9
GENERAL NOTES 10
PLAN (MAINLINE) 11-48
PROFILES (MAINLINE WIDENING) 49-66
CROSS SECTIONS (MAINLINE WIDENING) 67-115
PLAN (CROSS ROADS AND RAMPS A/B (U.S. R 35)) 116-122
MISCELLANEOUS DETAILS 123-125
DRAINAGE DETAILS 126
SIGN ELEVATIONS 127-128
LIGHTING 129-133
STRUCTURES (OVER 20' -MAINLINE) 134-259
STRUCTURES (OVER 20' -OVERHEAD) 260-283

"AS BUILT" PLANS

PROJECT DESCRIPTION

PLANING, FILLING, AND OVERLAY OF PAVEMENT, REPAIR/PAVEMENT, REPLACE GUARDRAILS, REHAB STRUCTURES, MAINTAIN TRAFFIC, REPLACE SIGNS, REPLACE LIGHTING SYSTEM AT WEIGH STATION, AND WIDEN MAINLINE STRUCTURES WITHIN PROJECT LIMITS. PROJECT LIMITS ARE ROUTE 1-70 FROM THE INDIANA STATE LINE TO THE MONTGOMERY COUNTY LINE.

LIMITED ACCESS

THIS IMPROVEMENT IS ESPECIALLY DESIGNED FOR THROUGH TRAFFIC AND HAS BEEN DECLARED A LIMITED ACCESS HIGHWAY OR FREEWAY BY THE PROVISIONS OF SECTION 5511.02 OF THE REVISED CODE OF OHIO.

1997 SPECIFICATIONS

THE STANDARD SPECIFICATIONS OF THE STATE OF OHIO, DEPARTMENT OF TRANSPORTATION, INCLUDING CHANGES AND SUPPLEMENTAL SPECIFICATIONS LISTED IN THE PROPOSAL SHALL GOVERN THIS IMPROVEMENT.

I HEREBY APPROVE THESE PLANS AND DECLARE THAT THE MAKING OF THIS IMPROVEMENT DID NOT REQUIRE THE CLOSING TO TRAFFIC OF THE HIGHWAY AND THAT PROVISIONS FOR THE MAINTENANCE AND SAFETY OF TRAFFIC WERE SET FORTH IN THE PLANS AND ESTIMATES.

APPROVED _____
DATE _____ DISTRICT PROJECT ENGINEER



APPROVED _____
DATE _____ DISTRICT CONSTRUCTION ENGINEER



STANDARD CONSTRUCTION DRAWINGS								SUPPLEMENTAL SPECIFICATIONS					
BP-3.1	07/28/00	GR-1.1M	10/21/97	AS-1-81	09/15/94	HL-10.11M	05/01/95	TC-41.50M	07/01/94	815	05/30/96		
BP-9.1	07/28/00	GR-1.2M	01/03/96	BR-1	01/06/99	HL-10.12M	05/01/95	TC-42.10M	07/01/94	816	04/21/97		
BP-5.1	07/28/00	GR-1.3M	11/30/94	CS-1-93	05/11/93	HL-10.13M	05/01/95	TC-42.20M	03/31/94	842	01/06/99		
		GR-2.1M	04/14/98	CPP-2-94	12/19/94	HL-20.11M	03/31/95	TC-51.11M	09/30/94	844	01/06/99		
		CB-3.1M	07/12/95	GR-3.1M	10/21/97	GSD-1-96M	02/12/97	HL-30.11M	03/31/95	TC-51.12M	03/31/94	846	09/09/97
		CB-3.3M	07/12/95	GR-3.2M	10/21/97	RB-1-55	02/02/59	HL-30.21M	05/01/95	TC-52.10M	07/29/94	863	09/09/97
				GR-4.2M	10/21/97	SICD-1-96M	02/12/97	HL-30.22M	03/31/95	TC-52.20M	07/29/94	899	10/21/98
		DM-1.1M	10/21/97	GR-4.3M	10/21/97	BS-1-93	12/12/94	HL-40.10M	03/31/95	TC-61.10M	03/31/94	954	09/09/97
		DM-1.2M	10/21/97	GR-5.2M	10/30/94			HL-60.11M	05/01/95	TC-65.10M	07/29/94	910	07/28/98
		DM-2.1M	06/30/95	GR-5.3M	11/30/94			HL-60.12M	03/31/95	TC-65.11M	11/01/95	911	07/10/97
		DM-4.1M	06/30/95	GR-6.1M	01/03/96			HL-60.31M	03/31/95	TC-65.12M	11/01/95	954	09/09/97
		DM-4.3	04/29/99	GR-6.2M	01/03/96					TC-65.13M	11/03/93		
		DM-4.4	04/29/99							TC-72.20M	09/01/93		
								TC-31.21M	03/31/94				
								TC-32.10M	03/31/94				
								TC-41.10M	03/31/94				
								TC-41.20M	07/01/94				

SPECIAL PROVISION
NWP # 14
CORPS OF ENGINEERS



SCHEMATIC PLAN

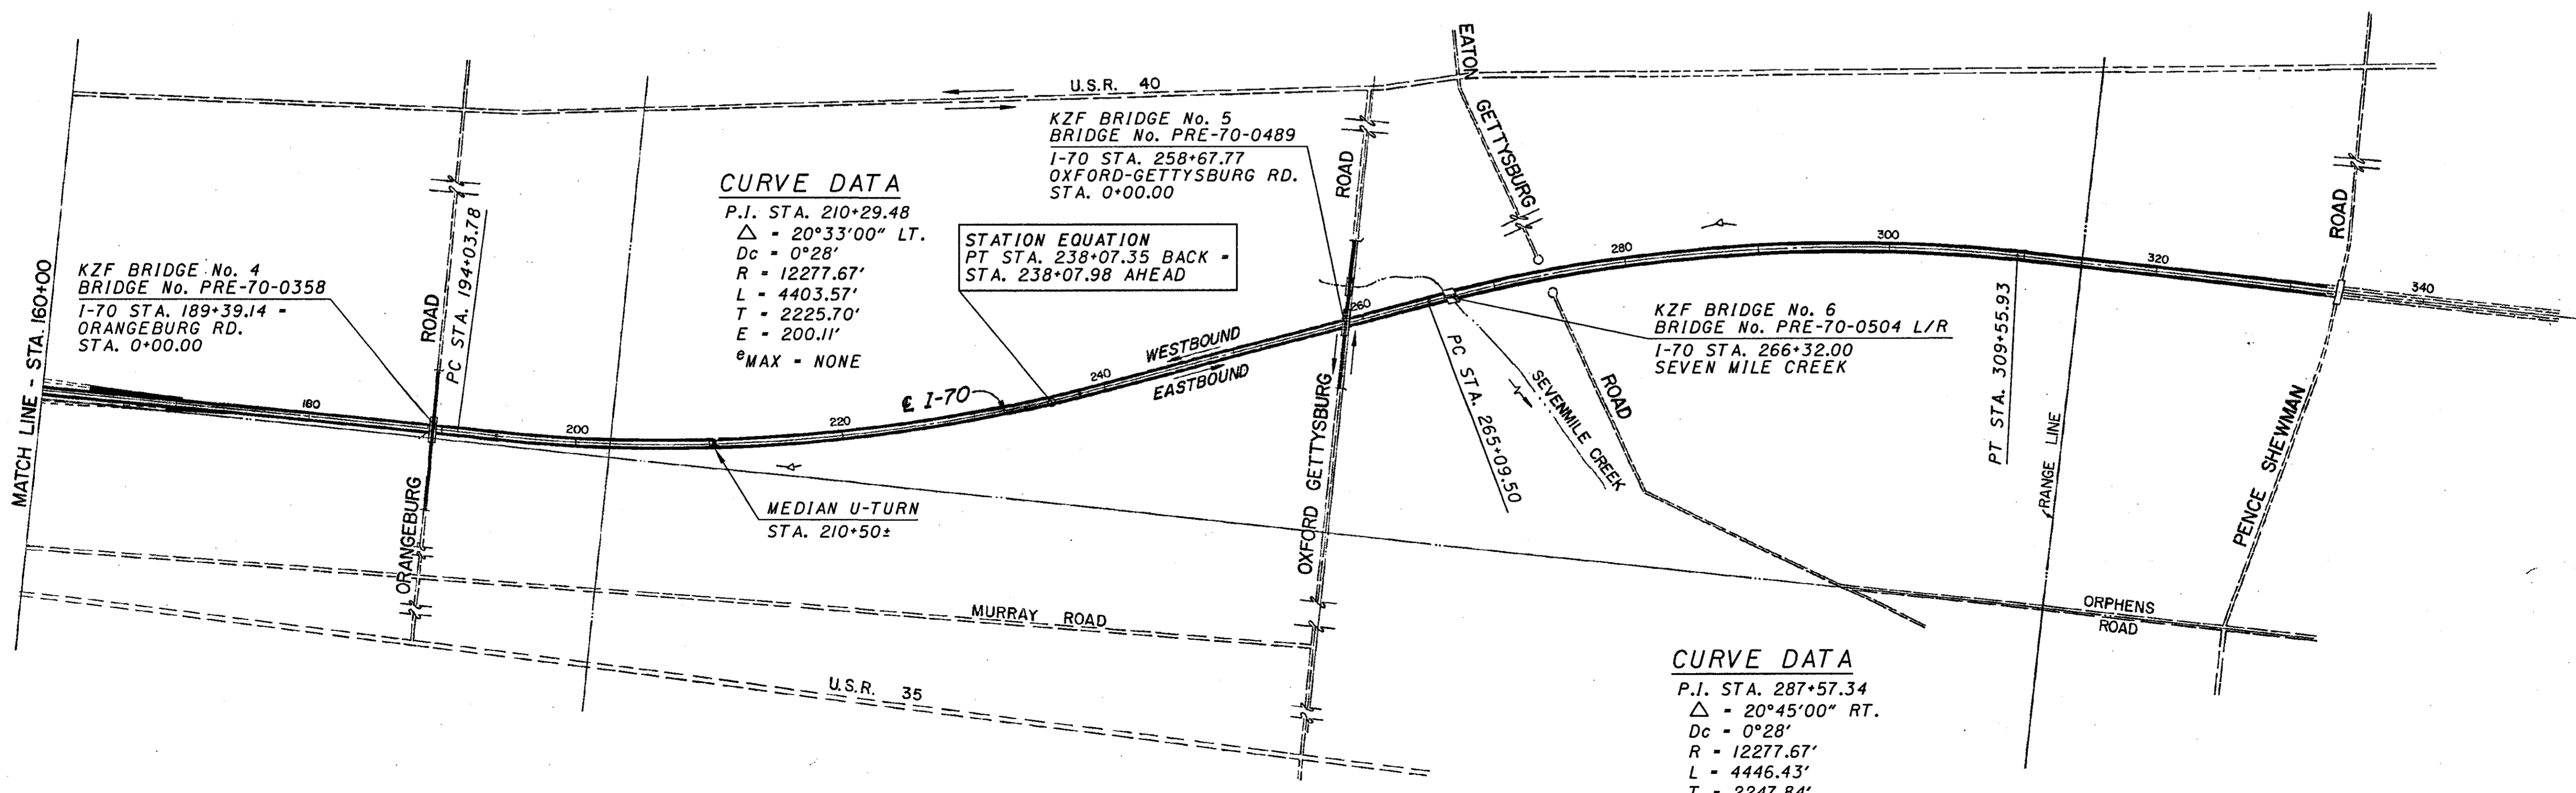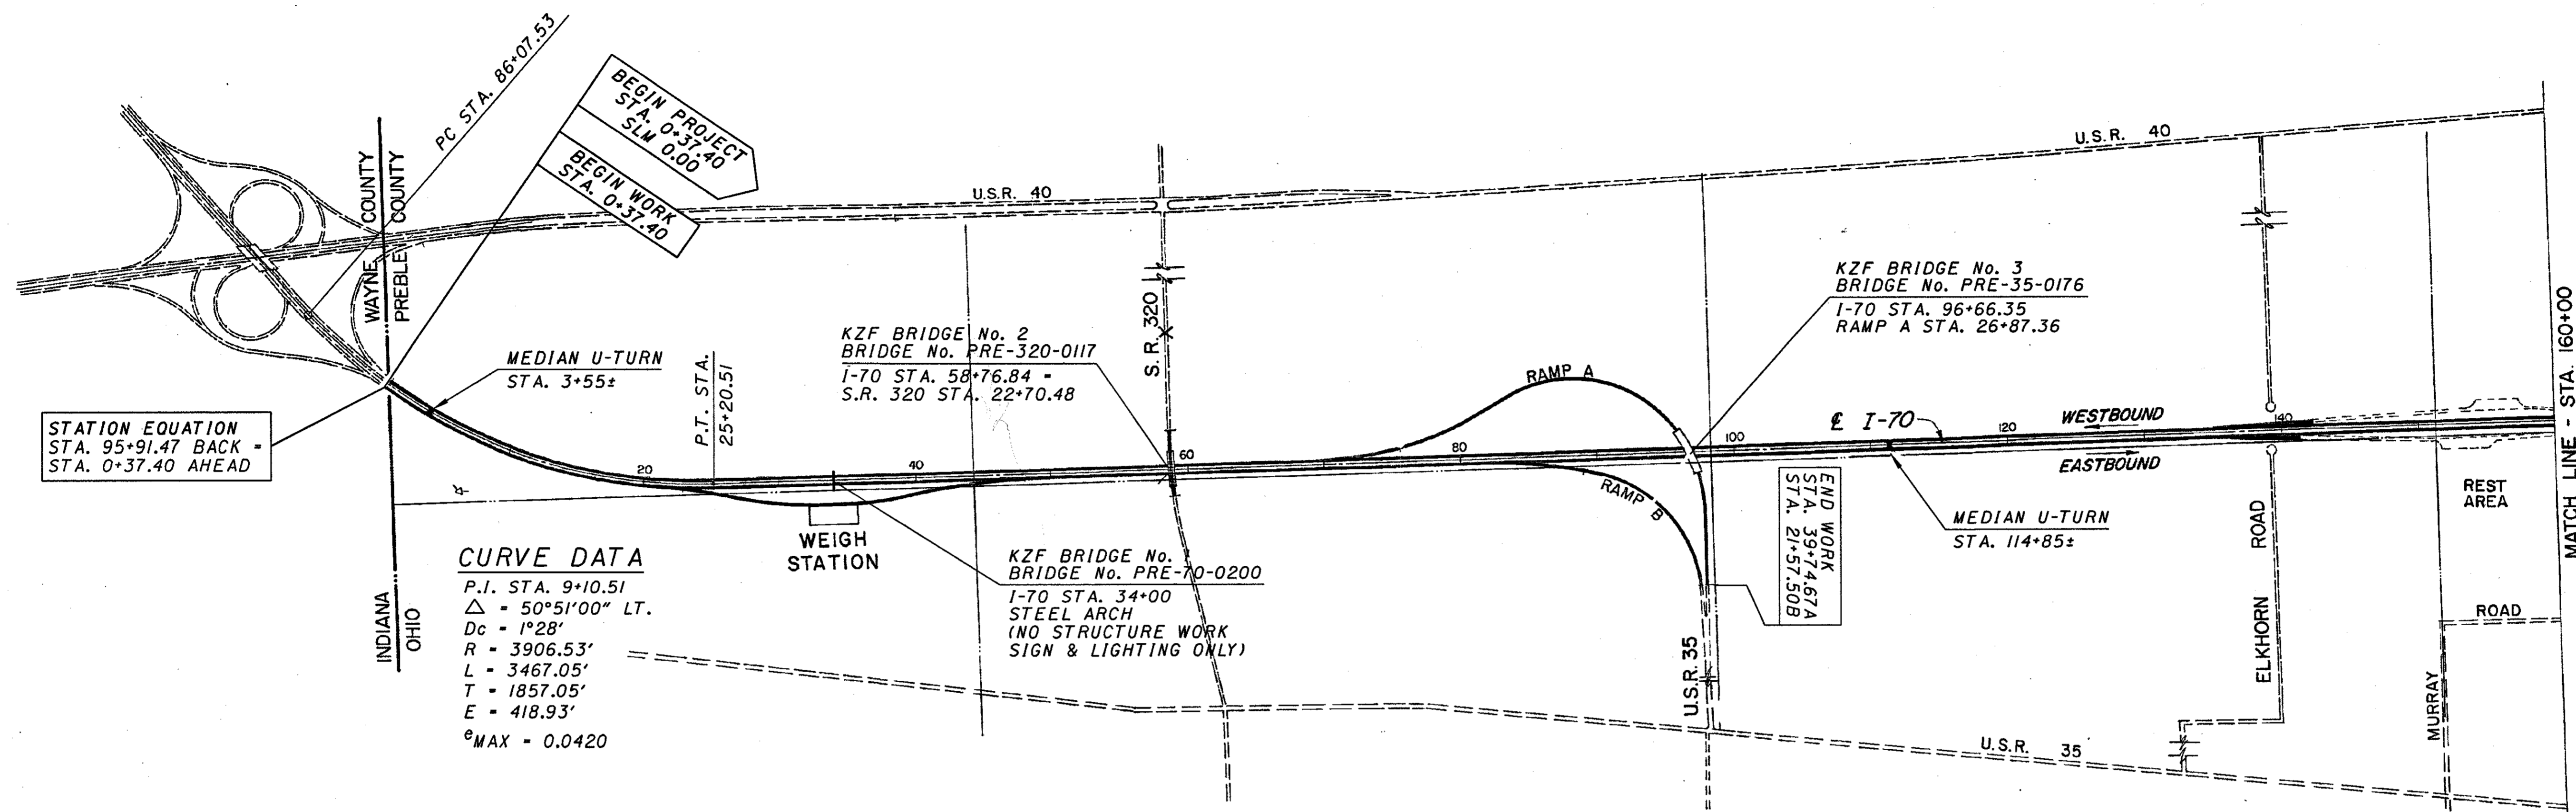


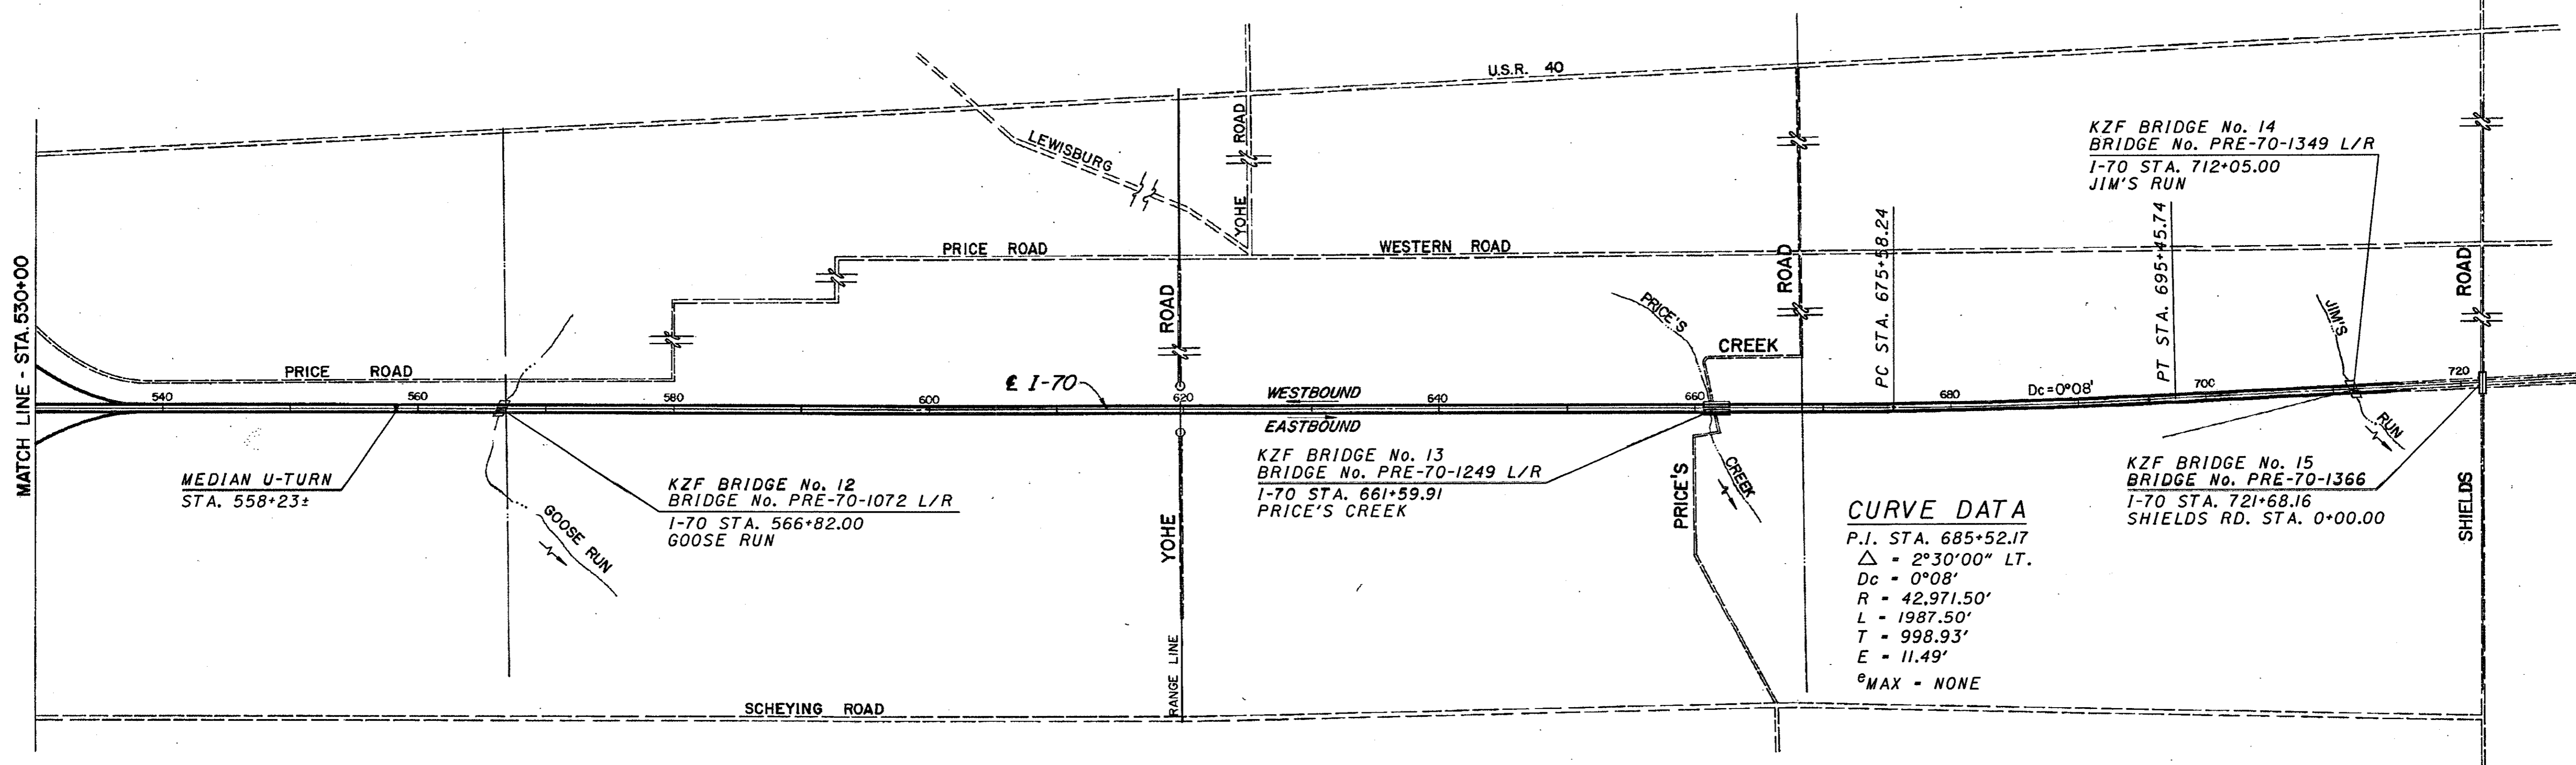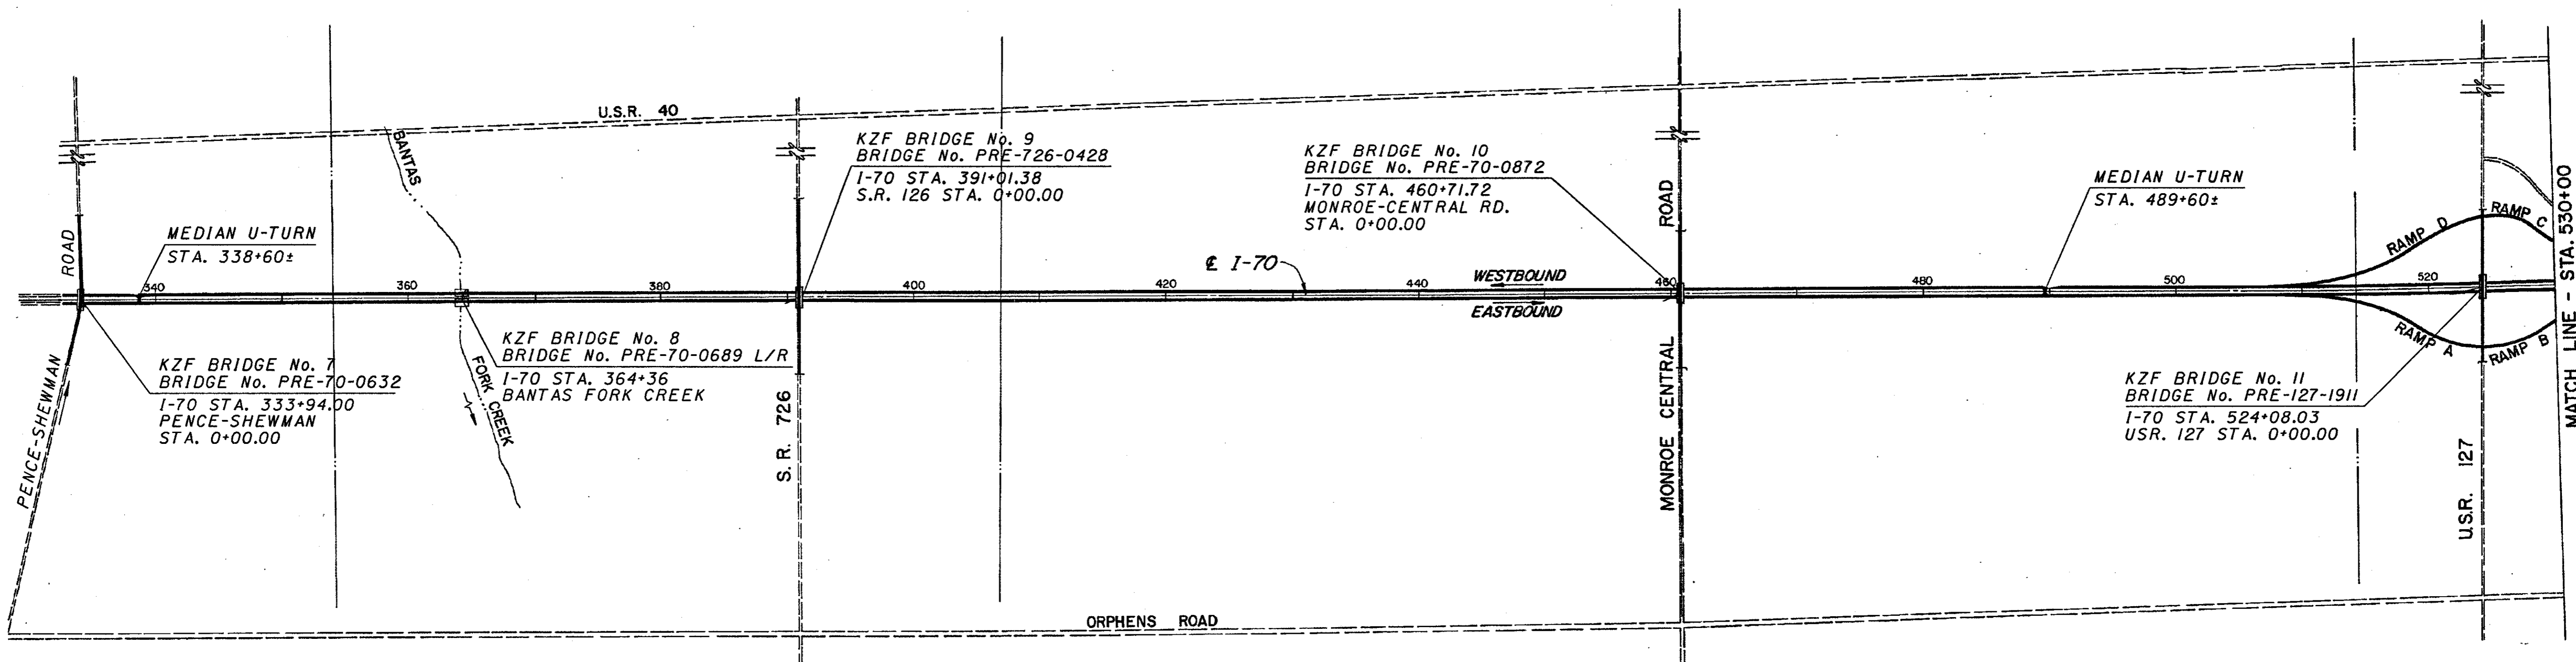

CURVE DATA
 P.I. STA. 685+52.17
 $\Delta = 2^{\circ}30'00''$ LT.
 $D_c = 0^{\circ}08'$
 $R = 42,971.50'$
 $L = 1987.50'$
 $T = 998.93'$
 $E = 11.49'$
 $e_{MAX} = NONE$


SCHEMATIC PLAN

PRE-70-0.00

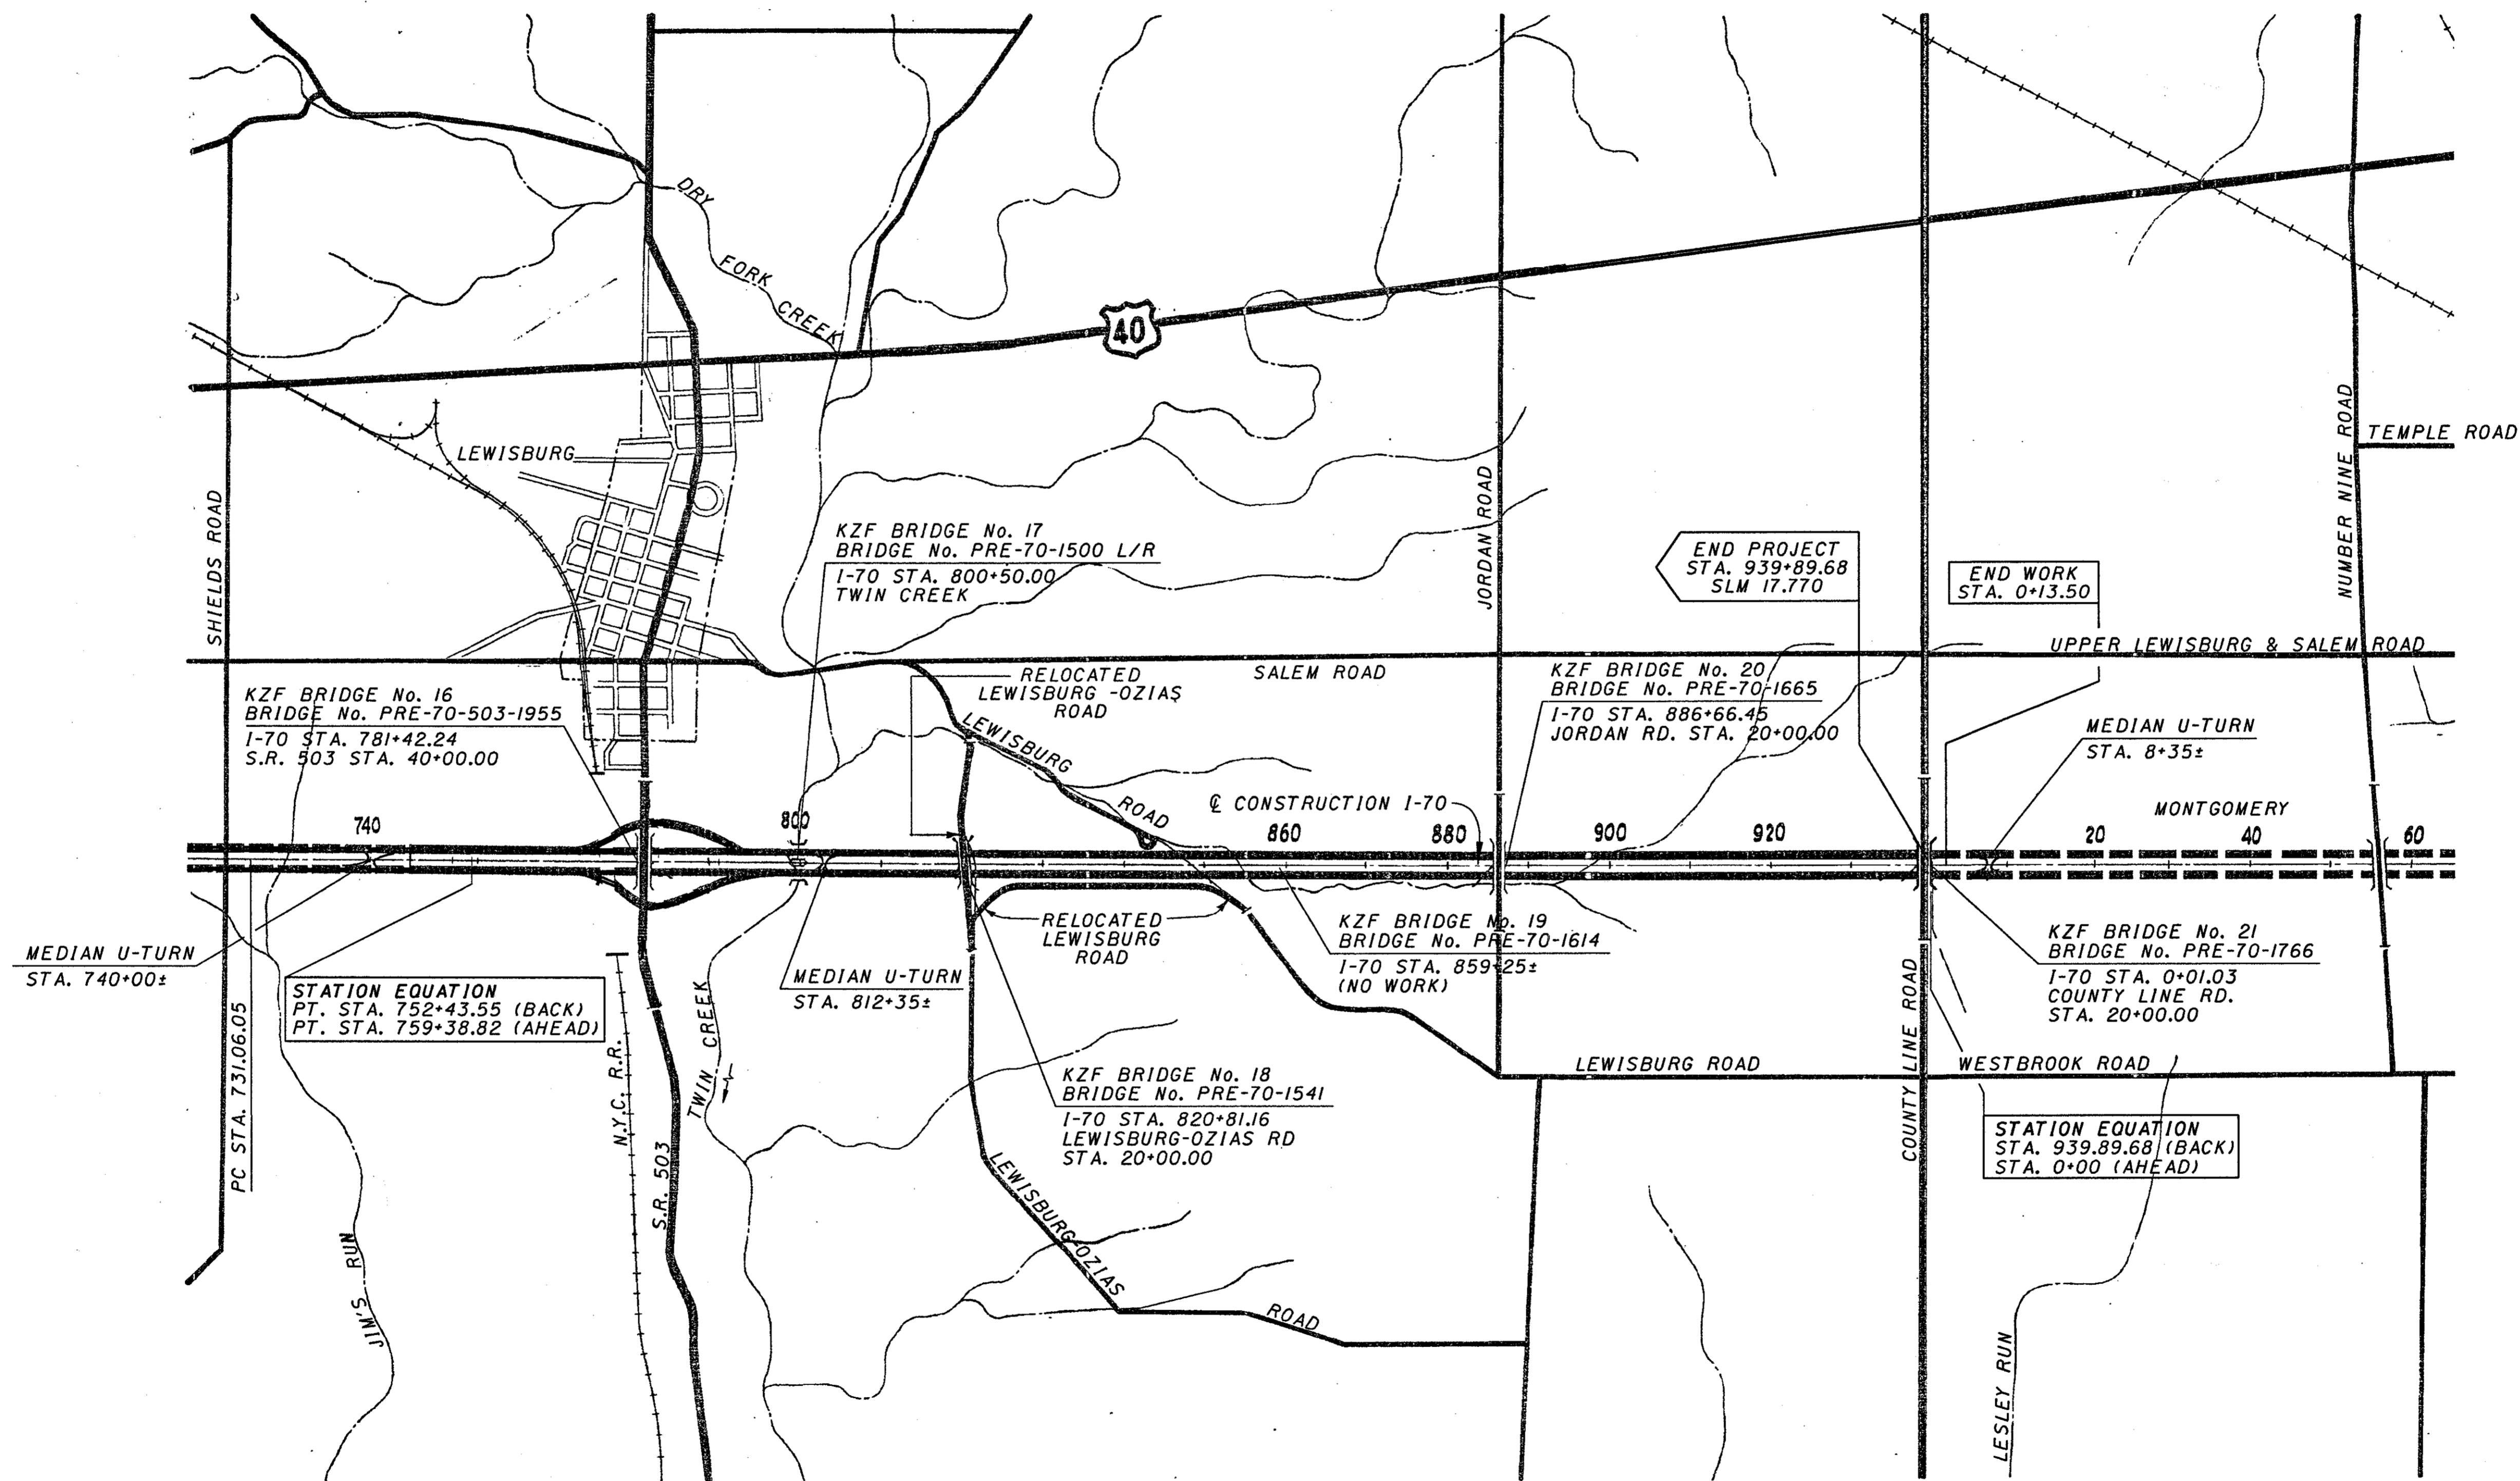


CURVE DATA

P.I. STA. 741+75.02
 Δ = 2°51'00" RT.
 Dc = 0°08'
 R = 42971.85'
 L = 237.50'
 T = 1068.97'
 E = 13.30'
 MAX = NONE

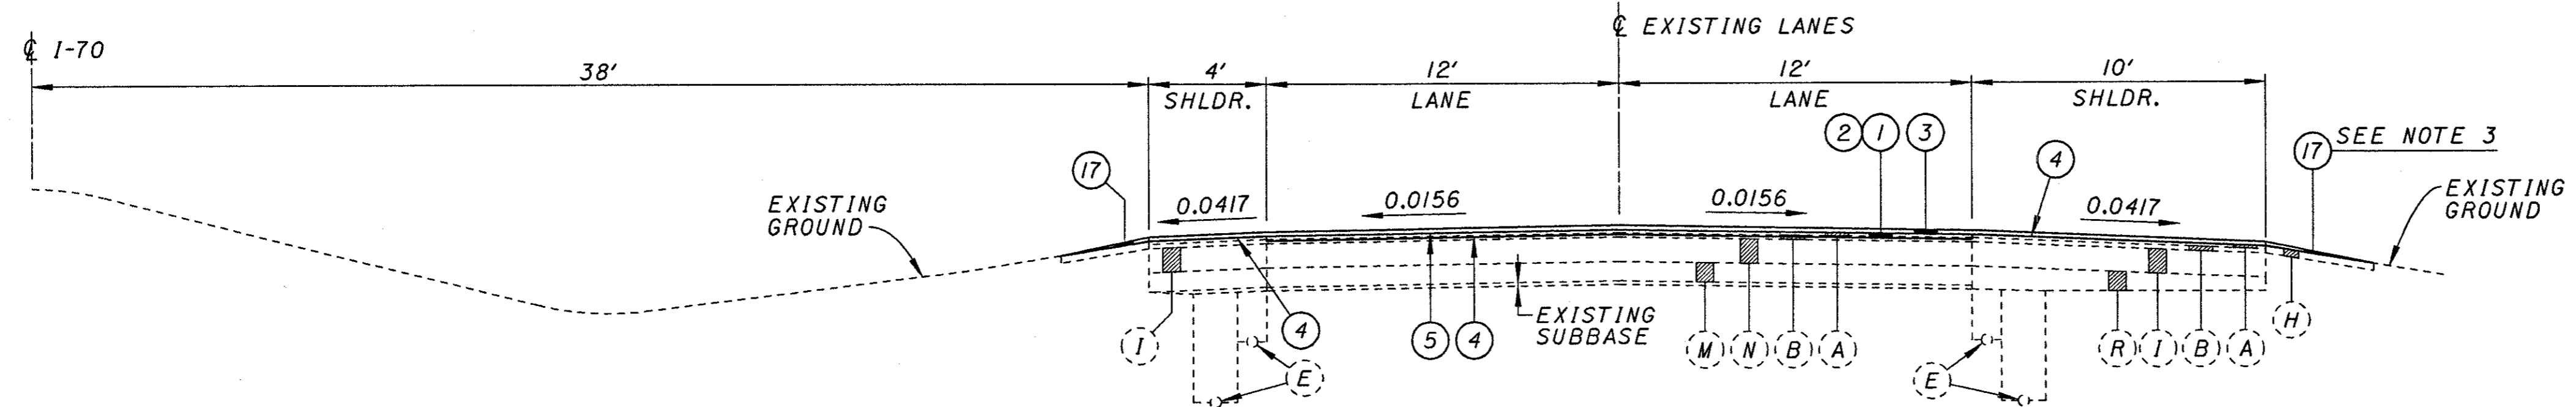


NORMAL SECTION - MAINLINE RESURFACING

WESTBOUND (OPP. HAND)		EASTBOUND		
STA. 262+67.32 TO	STA. 265+42.58	STA. 263+17.33 TO	STA. 265+92.46	BRIDGE No. PRE-70-0504 R/L (SEVEN MILE CREEK)
STA. 266+71.80 TO	STA. 269+46.62	STA. 267+22.49 TO	STA. 269+97.34	
STA. 360+56.00 TO	STA. 363+80.95	STA. 360+56.00 TO	STA. 363+80.79	BRIDGE No. PRE-70-0689 R/L (BANTAS FORK CREEK)
STA. 364+90.99 TO	STA. 368+16.00	STA. 364+90.92 TO	STA. 368+41.00	
STA. 563+23.50 TO	STA. 566+48.47	STA. 562+61.00 TO	STA. 565+86.03	BRIDGE No. PRE-70-1072 R/L (GOOSE RUN)
STA. 567+77.89 TO	STA. 571+04.00	STA. 567+15.62 TO	STA. 570+40.00	
STA. 656+39.00 TO	STA. 659+64.29	STA. 656+39.00 TO	STA. 659+64.29	BRIDGE No. PRE-70-1249 R/L (PRICE'S CREEK)
STA. 662+37.79 TO	STA. 665+62.00	STA. 662+37.79 TO	STA. 665+62.00	
STA. 708+14.00 TO	STA. 711+36.46	STA. 708+74.00 TO	STA. 711+98.91	BRIDGE No. PRE-70-1349 R/L (JIM'S RUN CREEK)
STA. 712+10.84 TO	STA. 715+35.94	STA. 712+73.29 TO	STA. 715+98.29	
STA. 795+86.93 TO	STA. 799+11.93	STA. 795+86.93 TO	STA. 799+11.93	BRIDGE No. PRE-70-1500 R/L (TWIN CREEK)
SEE NOTE 4 [STA. 801+87.43 TO	STA. 805+12.43	STA. 801+87.43 TO	STA. 805+12.43	

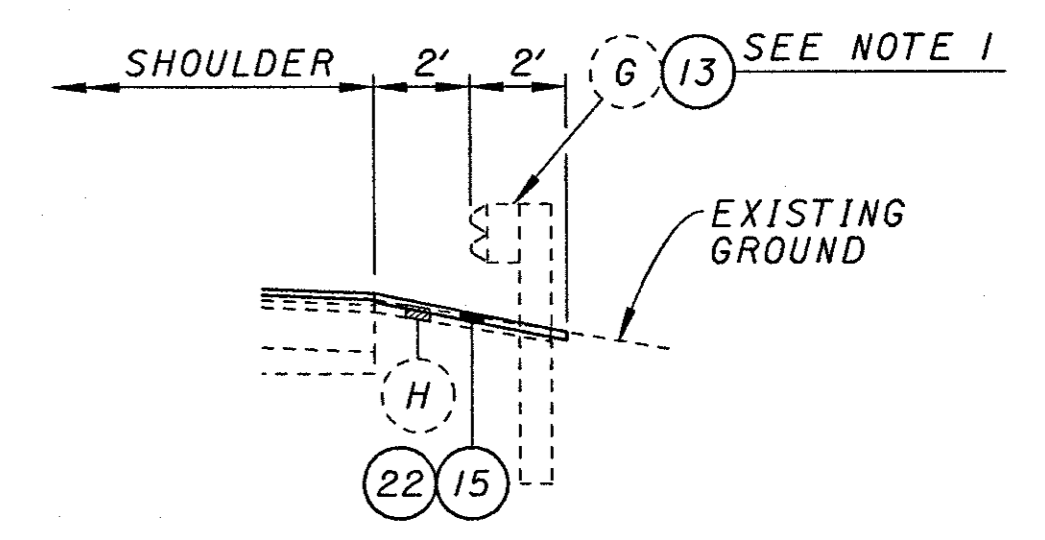

TYPICAL GUARDRAIL SECTION

THIS APPLIES TO THE FOLLOWING LOCATIONS: I-70, U.S. 35 (RAMP A), S.R. 503, & S.R. 726.

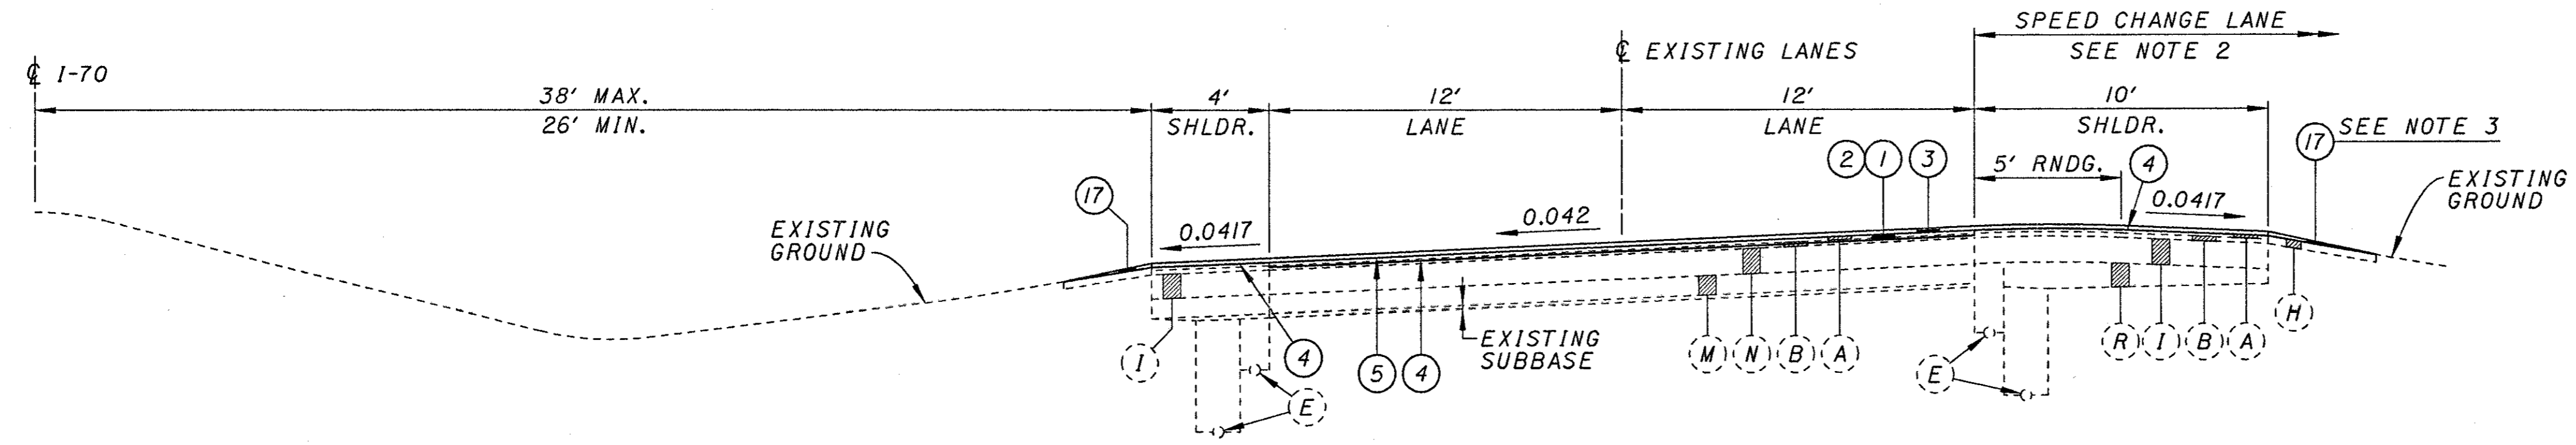

SUPERELEVATED SECTION - MAINLINE RESURFACING

WESTBOUND (OPP. HAND)		EASTBOUND	
STA. 0+37.40 TO	STA. 1+87.40	STA. 0+37.40 TO	STA. 1+87.40


NOTES

- FOR LIMITS OF GUARDRAIL SEE PLAN SHEETS.
- FOR SPEED CHANGE LANE LIMITS, SEE SHEET 9.
- ITEM 617 - COMPACTED AGGREGATE SHALL BE PLACED IF THE DROP-OFF AT THE SHOULDER EDGE IS 2" OR GREATER.
- PREVIOUS REMOVAL OF THE CONCRETE PAVEMENT AND ASPHALT REPLACEMENT AS SHOWN HAS NOT BEEN CONFIRMED.

ITEM LEGEND


- | | | | |
|---|---|--|---|
| (1) ITEM 254 - PAVEMENT PLANING, BITUMINOUS | (13) ITEM 606 - GUARDRAIL, TYPE 5 | (A) EXISTING 1 1/4" ASPHALT OVERLAY | (N) EXISTING 10" BITUMINOUS AGGREGATE BASE |
| (2) ITEM 446 - 1 3/4" ASPHALT CONCRETE INTERMEDIATE COURSE, TYPE 2, PG64-28 | (14) NOT USED | (B) EXISTING 1 3/4" ASPHALT OVERLAY | (P) EXISTING 3" BITUMINOUS AGGREGATE BASE |
| (3) ITEM 446 - 1 1/2" ASPHALT CONCRETE SURFACE COURSE, TYPE IH | (15) ITEM 203 - LINEAR GRADING | (C) EXISTING 4 1/2" BITUMINOUS AGGREGATE BASE | (Q) EXISTING 3" AGGREGATE BASE |
| (4) ITEM 407 - TACK COAT, 702.13 (0.075 GAL/SQ.YD.) | (16) ITEM 617 - SHOULDER PREPARATION | (D) EXISTING 9" BREAK AND SEAT CONCRETE PAVEMENT | (R) EXISTING AGGREGATE BASE, VARIABLE DEPTH |
| (5) ITEM 407 - TACK COAT FOR INTERMEDIATE COURSE (0.04 GAL/SQ.YD.) | (17) ITEM 617 - COMPACTED AGGREGATE, TYPE B | (E) EXISTING SHALLOW UNDERDRAIN | (S) EXISTING 5" CRUSHED AGGREGATE |
| (6) ITEM 302 - 12" BITUMINOUS AGGREGATE BASE | (18) ITEM 830 - CURB, TYPE 4A | (F) EXISTING 6" AGGREGATE BASE | (T) EXISTING 5 1/2" BITUMINOUS AGGREGATE BASE |
| (7) ITEM 304 - 9" AGGREGATE BASE | (19) ITEM 611 - REINFORCED CONCRETE APPROACH SLAB (T-15") | (G) EXISTING GUARDRAIL | |
| (8) ITEM 203 - SUBGRADE COMPACTION | (20) ITEM 304 - 6" AGGREGATE BASE | (H) EXISTING COMPACTED AGGREGATE | |
| (9) NOT USED | (21) ITEM 203 - EXCAVATION NOT INCLUDING EMBANKMENT CONSTRUCTION | (I) EXISTING 8" BITUMINOUS AGGREGATE BASE | |
| (10) ITEM 605 - 4" SHALLOW PIPE UNDERDRAIN (30" DEPTH TYP.) | (22) ITEM 448 - 2" ASPHALT CONCRETE INTERMEDIATE COURSE, TYPE I, UNDER GUARDRAIL, PG64-22 | (K) EXISTING 12" CONCRETE PAVEMENT | |
| (11) ITEM 203 - EMBANKMENT | (23) ITEM 830 - CURB, TYPE 6, AS PER PLAN | (L) EXISTING 9" CONCRETE PAVEMENT | |
| (12) ITEM 870 - SEEDING AND MULCHING | | (M) EXISTING 8" AGGREGATE BASE | |

REF: 1-70-0.00
 DESIGNED BY: J. W. B. / J. W. B.
 CHECKED BY: J. W. B. / J. W. B.
 DATE: 10/1/70
 ACTIVE LEVELS ON: 1-70-0.00

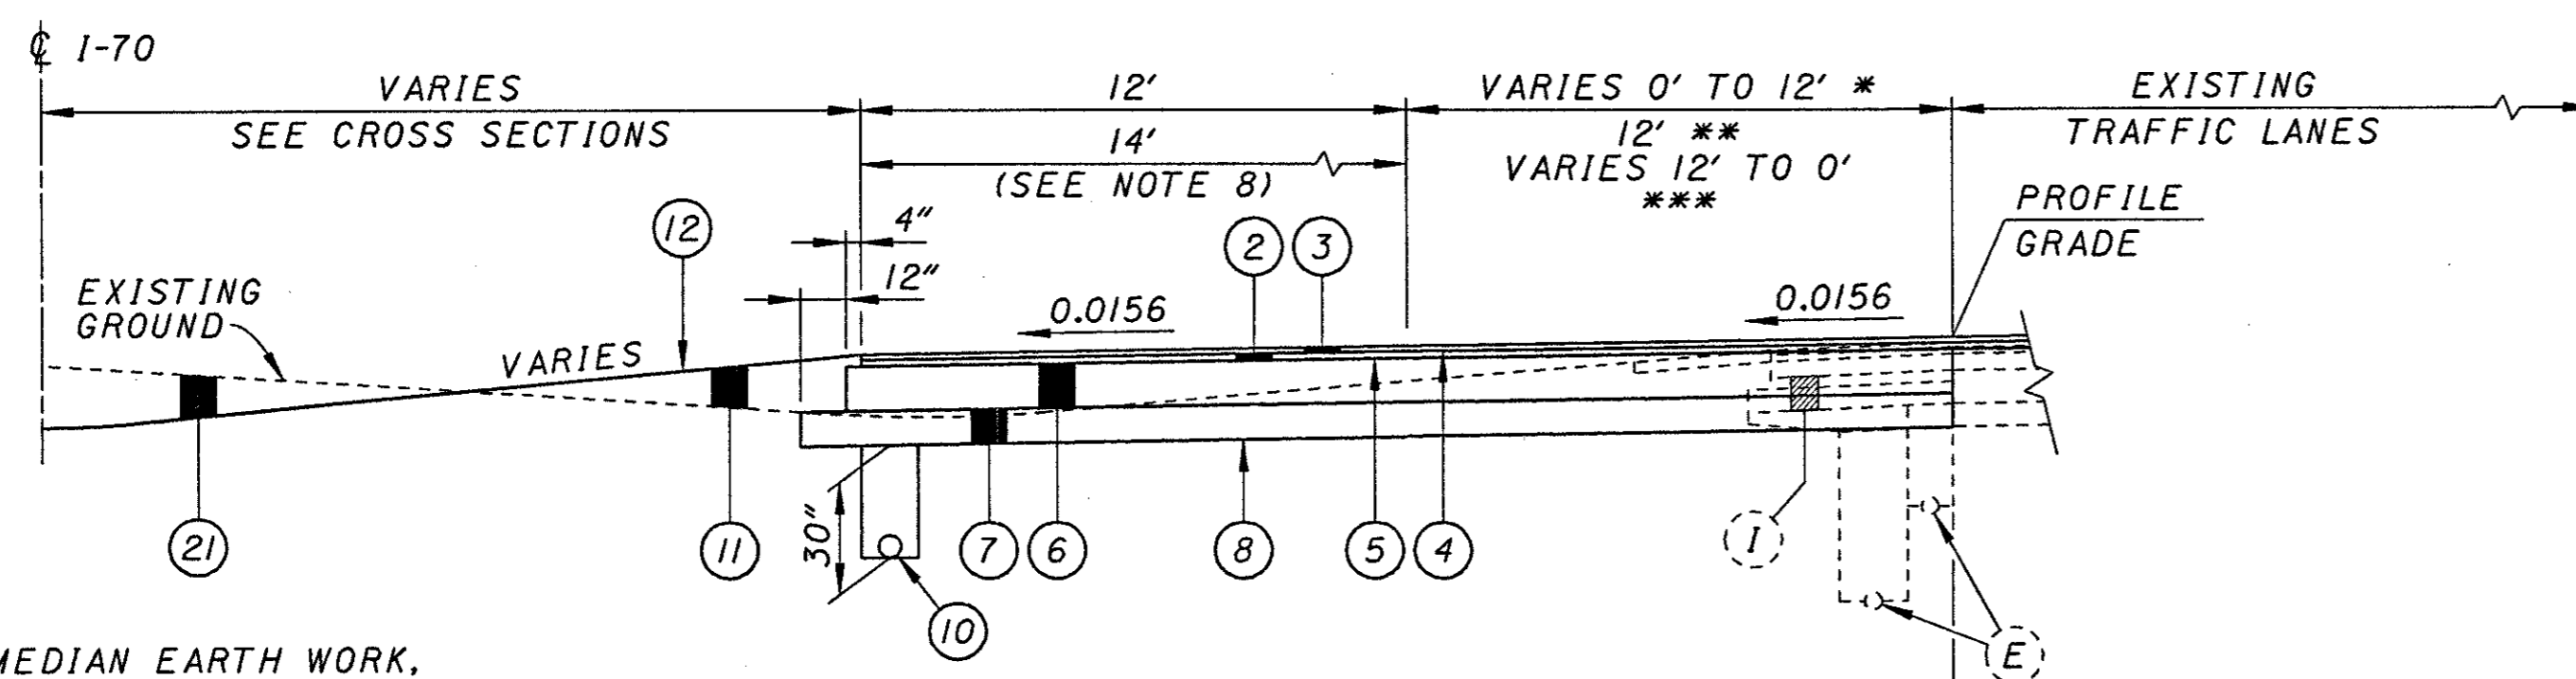


FOR MEDIAN EARTH WORK,
SEE CROSS SECTION SHEETS.


MEDIAN PAVEMENT WIDENING - LANE TAPERS

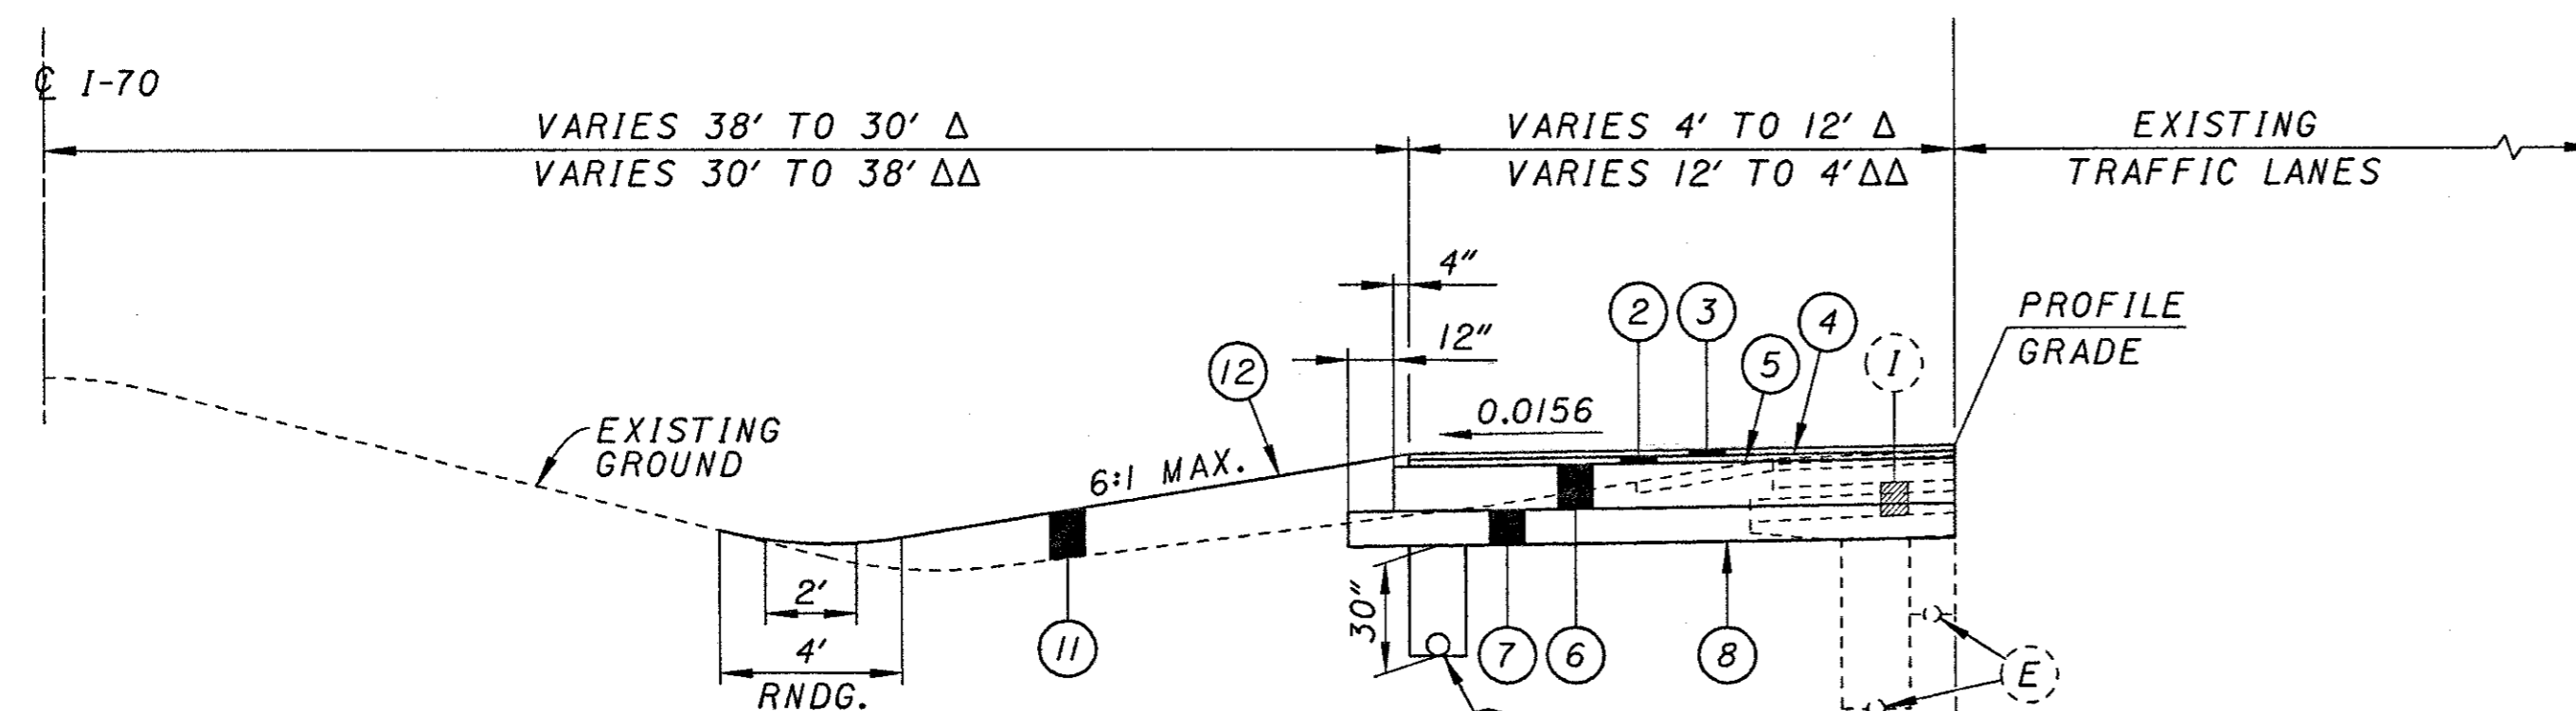

MEDIAN PAVEMENT WIDENING - SHOULDER TAPERS

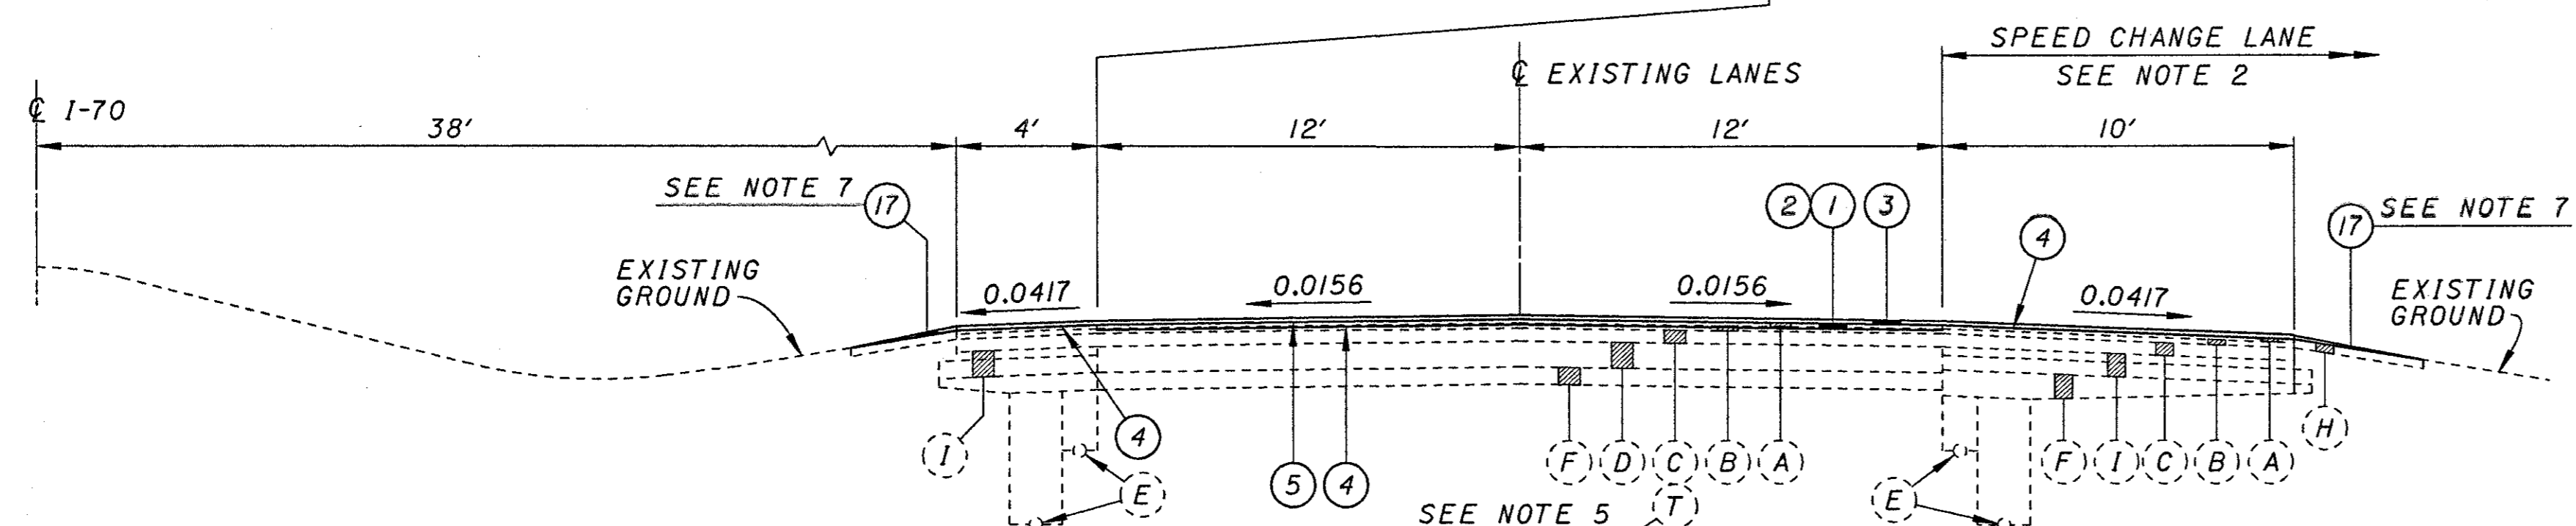

**NORMAL SECTION
MAINLINE RESURFACING**

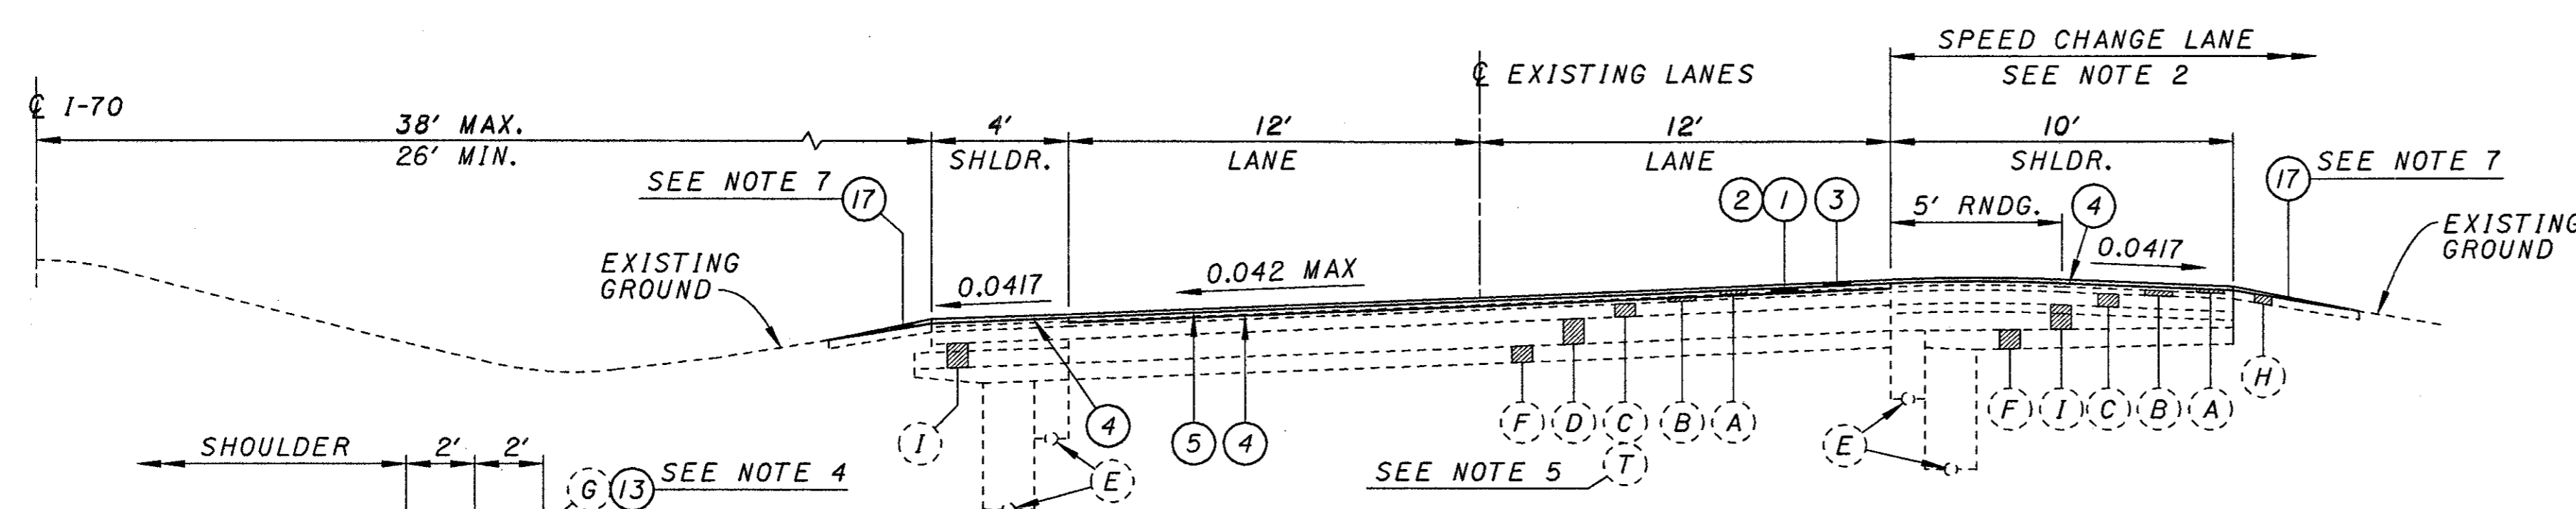

**SUPERELEVATED SECTION
MAINLINE RESURFACING**

MEDIAN PAVEMENT WIDENING - LANE TAPERS

WESTBOUND (OPP. HAND)				EASTBOUND			
BRIDGE No. PRE-70-0504 R/L (SEVEN MILE CREEK)							
* STA. 257+69.42	TO	STA. 265+49.19	*	STA. 257+95.66	TO	STA. 265+75.30	*
** STA. 265+49.19	TO	STA. 265+59.19	**	STA. 267+05.37	TO	STA. 267+15.37	**
*** STA. 266+88.85	TO	STA. 274+68.77	***	STA. 267+15.37	TO	STA. 274+95.22	***
BRIDGE No. PRE-70-0689 R/L (BANTAS FORK CREEK)							
* STA. 355+91.00	TO	STA. 363+71.00	*	STA. 356+01.00	TO	STA. 363+71.00	*
** STA. 363+71.00	TO	STA. 363+81.00	**	STA. 364+91.00	TO	STA. 365+01.00	**
*** STA. 364+91.00	TO	STA. 372+71.00	***	STA. 365+01.00	TO	STA. 372+81.00	***
BRIDGE No. PRE-70-1072 R/L (GOOSE RUN)							
* STA. 558+37.51	TO	STA. 566+17.51	*	STA. 558+26.74	TO	STA. 566+06.74	*
** STA. 566+17.51	TO	STA. 566+27.51	**	STA. 567+36.48	TO	STA. 567+46.48	**
*** STA. 567+57.27	TO	STA. 575+37.27	***	STA. 567+46.48	TO	STA. 575+26.48	***
BRIDGE No. PRE-70-1249 R/L (PRICE'S CREEK)							
* STA. 651+74.29	TO	STA. 659+54.29	*	STA. 651+84.29	TO	STA. 659+64.29	*
** STA. 659+54.29	TO	STA. 659+64.29	**	STA. 662+37.79	TO	STA. 662+47.79	**
*** STA. 662+37.79	TO	STA. 670+17.79	***	STA. 662+47.79	TO	STA. 670+27.79	***
BRIDGE No. PRE-70-1349 R/L (JIM'S RUN)							
* STA. 703+46.46	TO	STA. 711+26.46	*	STA. 703+98.19	TO	STA. 711+78.19	*
** STA. 711+26.46	TO	STA. 711+36.46	**	STA. 712+73.29	TO	STA. 712+83.29	**
*** STA. 712+31.33	TO	STA. 720+11.33	***	STA. 712+83.29	TO	STA. 720+63.29	***
BRIDGE No. PRE-70-1500 R/L (TWIN CREEK)							
* STA. 791+21.93	TO	STA. 799+01.93	*	STA. 791+31.93	TO	STA. 799+11.93	*
** STA. 799+01.93	TO	STA. 799+11.93	**	STA. 801+87.43	TO	STA. 801+97.43	**
*** STA. 801+87.43	TO	STA. 809+67.43	***	STA. 801+97.43	TO	STA. 809+77.43	***

MEDIAN PAVEMENT WIDENING - SHOULDER TAPERS

WESTBOUND (OPP. HAND)				EASTBOUND			
BRIDGE No. PRE-70-0504 R/L (SEVEN MILE CREEK)							
Δ STA. 252+49.41	TO	STA. 257+69.42	Δ	STA. 252+75.57	TO	STA. 257+95.66	Δ
ΔΔ STA. 274+68.77	TO	STA. 279+88.60	ΔΔ	STA. 274+95.22	TO	STA. 280+15.40	ΔΔ
BRIDGE No. PRE-70-0689 R/L (BANTAS FORK CREEK)							
Δ STA. 350+71.00	TO	STA. 355+91.00	Δ	STA. 350+81.00	TO	STA. 356+01.00	Δ
ΔΔ STA. 372+71.00	TO	STA. 377+91.00	ΔΔ	STA. 372+81.00	TO	STA. 378+01.00	ΔΔ
BRIDGE No. PRE-70-1072 R/L (GOOSE RUN)							
Δ STA. 553+17.51	TO	STA. 558+37.51	Δ	STA. 553+06.74	TO	STA. 558+26.74	Δ
ΔΔ STA. 575+37.27	TO	STA. 580+57.27	ΔΔ	STA. 575+26.48	TO	STA. 580+46.48	ΔΔ
BRIDGE No. PRE-70-1249 R/L (PRICE'S CREEK)							
Δ STA. 646+54.29	TO	STA. 651+74.29	Δ	STA. 646+64.29	TO	STA. 651+84.29	Δ
ΔΔ STA. 670+17.79	TO	STA. 675+37.79	ΔΔ	STA. 670+27.79	TO	STA. 675+47.79	ΔΔ
BRIDGE No. PRE-70-1349 R/L (JIM'S RUN)							
Δ STA. 698+26.46	TO	STA. 703+46.46	Δ	STA. 698+78.19	TO	STA. 703+98.19	Δ
ΔΔ STA. 720+11.33	TO	STA. 725+31.33	ΔΔ	STA. 720+63.29	TO	STA. 725+83.29	ΔΔ
BRIDGE No. PRE-70-1500 R/L (TWIN CREEK)							
Δ STA. 786+01.93	TO	STA. 791+21.93	Δ	STA. 786+11.93	TO	STA. 791+31.93	Δ
ΔΔ STA. 809+67.43	TO	STA. 814+87.43	ΔΔ	STA. 809+77.43	TO	STA. 814+97.43	ΔΔ

NORMAL SECTION - MAINLINE RESURFACING

WESTBOUND (OPP. HAND)		EASTBOUND				
STA. 24+46.32	TO	STA. 262+67.32	TO	STA. 25+96.98	TO	STA. 263+17.33
STA. 269+46.62	TO	STA. 360+56.00	TO	STA. 269+97.34	TO	STA. 360+56.00
STA. 368+16.00	TO	STA. 563+23.50	TO	STA. 368+41.00	TO	STA. 562+61.00
STA. 571+04.00	TO	STA. 656+39.00	TO	STA. 570+40.00	TO	STA. 656+39.00
STA. 665+62.00	TO	STA. 708+14.00	TO	STA. 665+62.00	TO	STA. 708+74.00
STA. 715+35.94	TO	STA. 795+86.93	TO	STA. 715+98.29	TO	STA. 795+86.93
STA. 805+12.43	TO	STA. 939+89.68	TO	STA. 805+12.43	TO	STA. 939+89.68

SUPERELEVATED SECTION - MAINLINE RESURFACING

WESTBOUND (OPP. HAND)		EASTBOUND				
STA. 1+87.40	TO	STA. 24+46.32	TO	STA. 1+87.40	TO	STA. 25+96.98

NOTES


- 1) FOR ITEM LEGEND, SEE SHEET 5.
- 2) FOR FURTHER INFORMATION ABOUT THE MEDIAN LANE TAPERS, SEE THE PLAN SHEETS.
- 3) SEE THE CROSS SECTIONS FOR PROPOSED GRADING AND SEEDING AND MULCHING LIMITS.
- 4) FOR LIMITS OF GUARDRAIL, SEE PLAN SHEETS.
- 5) BALLOON "T" APPLYS FROM STA. 333+14 TO STA. 708+74 EB.
- 6) FOR SPEED CHANGE LANE LIMITS, SEE SHEET 9.
- 7) ITEM 617 - COMPACTED AGGREGATE SHALL BE PLACED IF THE DROP-OFF AT THE SHOULDER EDGE IS 2" OR GREATER.
- 8) FOR CURB DETAIL AT APPROACH SLABS, SEE SHEET 123. FOR LOCATIONS SEE ROADWAY PLANS AND BRIDGE SITE PLANS

ALL DIMENSIONS UNLESS OTHERWISE SPECIFIED ARE IN FEET AND INCHES.
 DIMENSIONS IN FEET AND INCHES SHALL BE CONSIDERED AS THE BASIS FOR CONSTRUCTION.
 ALL DIMENSIONS SHALL BE TO FACE UNLESS OTHERWISE SPECIFIED.
 ALL DIMENSIONS SHALL BE TO CENTERLINE UNLESS OTHERWISE SPECIFIED.
 ALL DIMENSIONS SHALL BE TO ADJACENT SURFACES UNLESS OTHERWISE SPECIFIED.
 ALL DIMENSIONS SHALL BE TO ADJACENT SURFACES UNLESS OTHERWISE SPECIFIED.

TYPICAL GUARDRAIL SECTION


TYPICAL SECTIONS
MEDIAN PAVEMENT WIDENING & MAINLINE RESURFACING

PRE-70-0.00

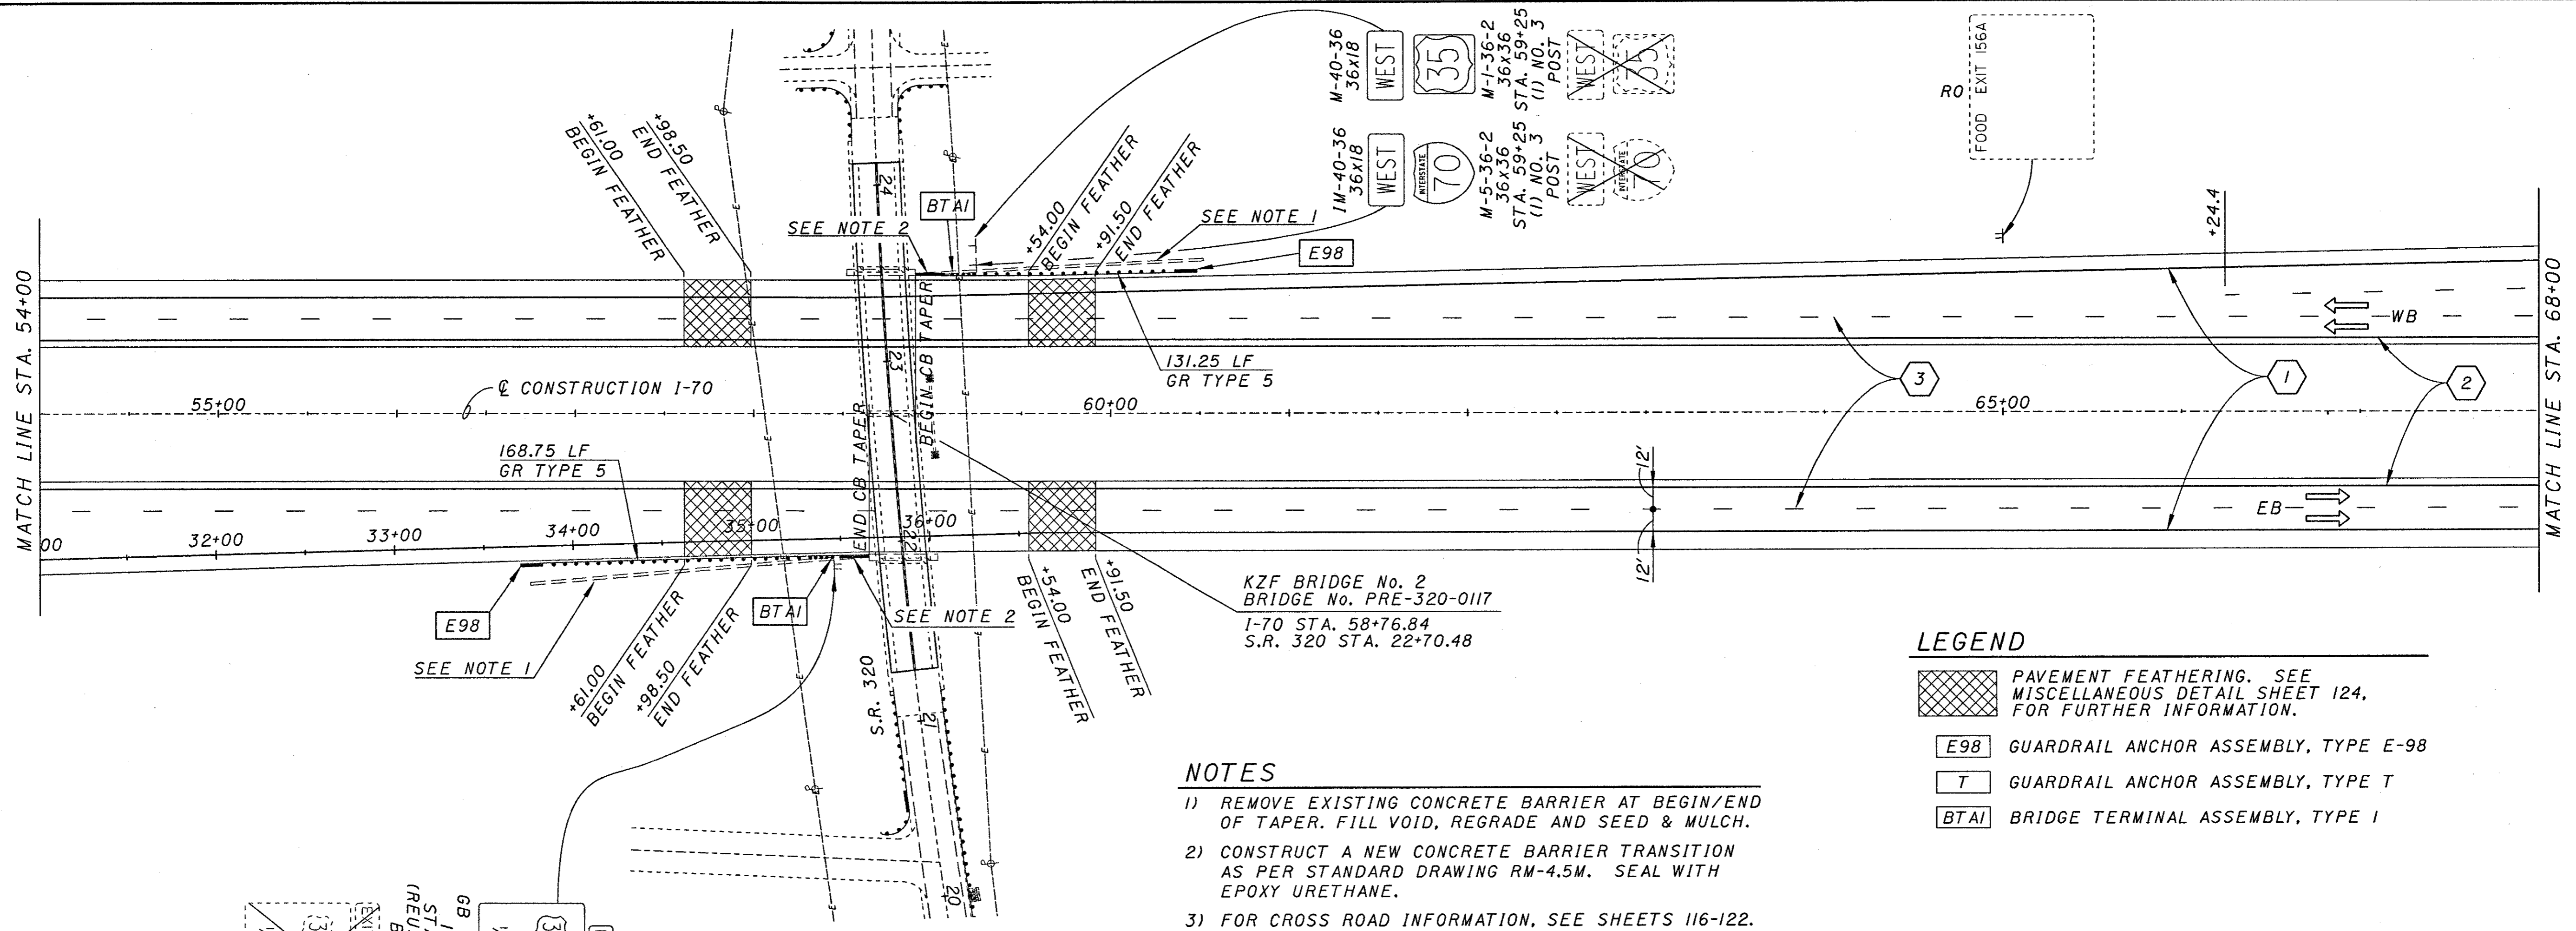

- NOTES**
- 1) REMOVE EXISTING CONCRETE BARRIER AT BEGIN/END OF TAPER. FILL VOID, REGRADE AND SEED & MULCH.
 - 2) CONSTRUCT A NEW CONCRETE BARRIER TRANSITION AS PER STANDARD DRAWING RM-4.5M. SEAL WITH EPOXY URETHANE.
 - 3) FOR CROSS ROAD INFORMATION, SEE SHEETS 116-122.
 - 4) FOR OVERHEAD STRUCTURE INFORMATION, SEE SHEETS 260-283.

FOR CONTINUATION, SEE SHEET 121.

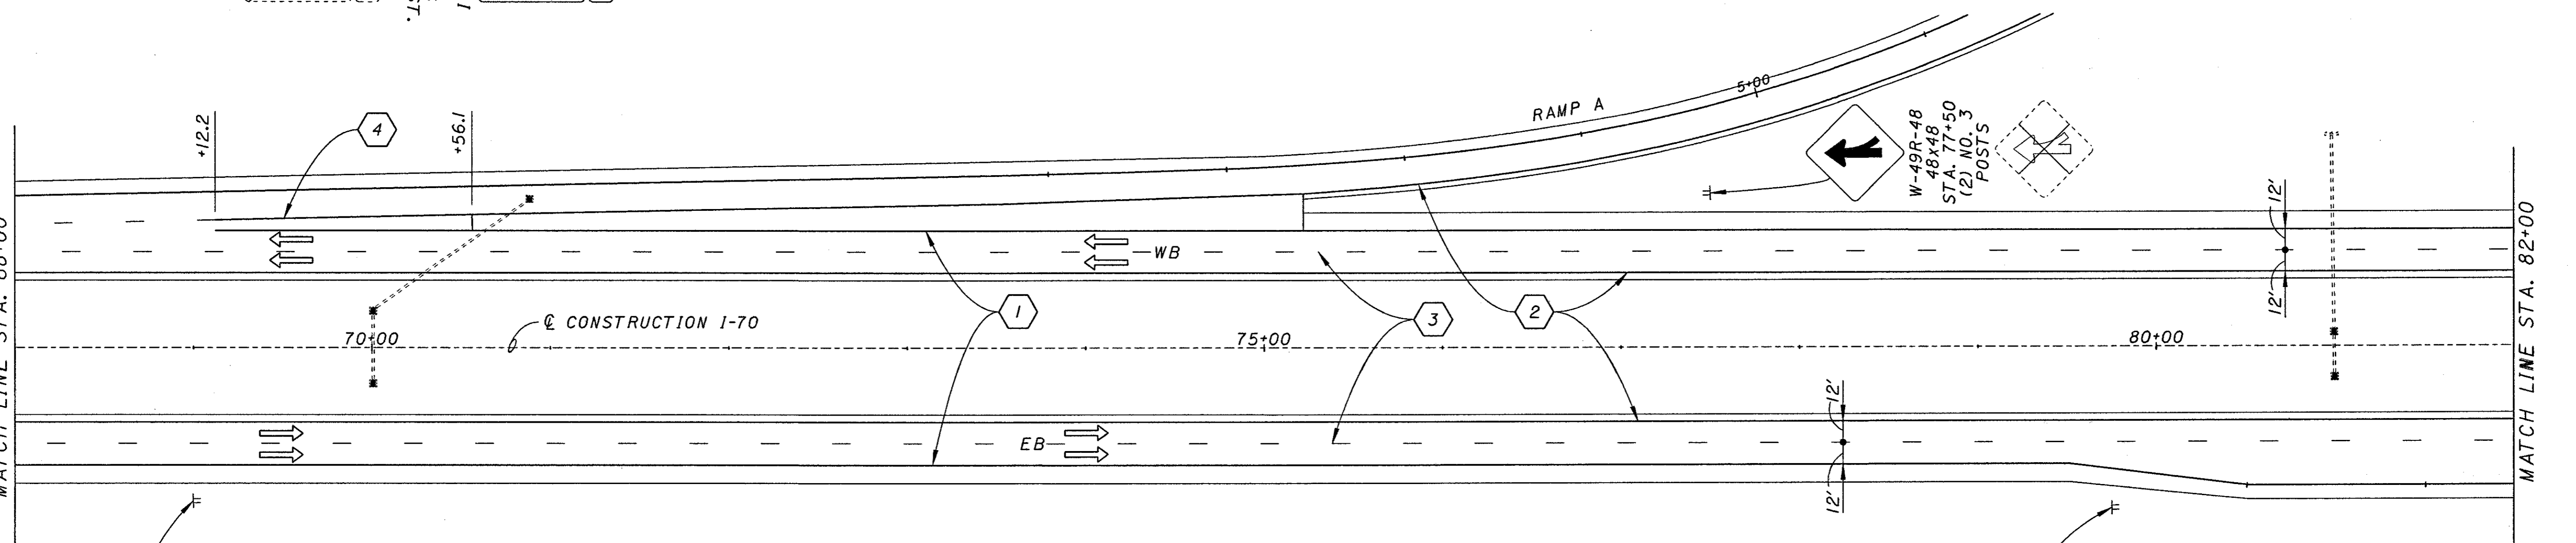

- SIGN LEGEND**
- NEW SIGN
 - EXISTING SIGN, TO REMAIN
 - EXISTING SIGN, TO BE REMOVED
 - RO INDICATES SIGN TO BE CONSIDERED FOR REMOVAL AND REERECTION. REMOVAL AND REERECTION BY OTHERS.

HIGHWAY PATROL MONITORS CB - 9
KNN 3083
NEED HELP?
1-877-7-PATROL
EMERGENCY CALL 9-1-1

HIGHWAY PATROL MONITORS CB - 9
KNN 3083
NEED HELP?
1-877-7-PATROL
EMERGENCY CALL 9-1-1

GSP
156x66
HIGHWAY PATROL MONITORS CB - 9
KNN 3083
NEED HELP?
1-877-7-PATROL
EMERGENCY CALL 9-1-1





DESIGNER: [unreadable]
CHECKER: [unreadable]
DATE: [unreadable]
PROJECT: [unreadable]
SHEET: [unreadable] OF [unreadable]
ACTIVE LEVELS ON: #4116**

PAVEMENT MARKING LEGEND

- 1 4" EDGE LINE, WHITE
- 2 4" EDGE LINE, YELLOW
- 3 4" LANE LINE
- 4 8" CHANNELIZING LINE, WHITE
- 5 24" TRANSVERSE LINE, WHITE, 12' SPACING

SIGN LEGEND

- NEW SIGN
- EXISTING SIGN, TO REMAIN
- EXISTING SIGN, TO BE REMOVED
- R0 INDICATES SIGN TO BE CONSIDERED FOR REMOVAL AND REERECTION. REMOVAL AND REERECTION BY OTHERS.

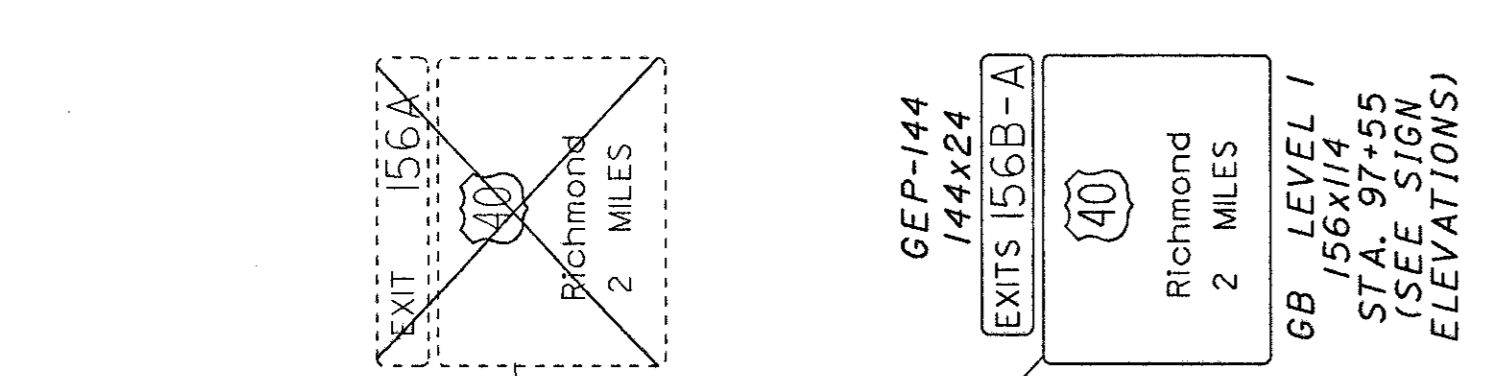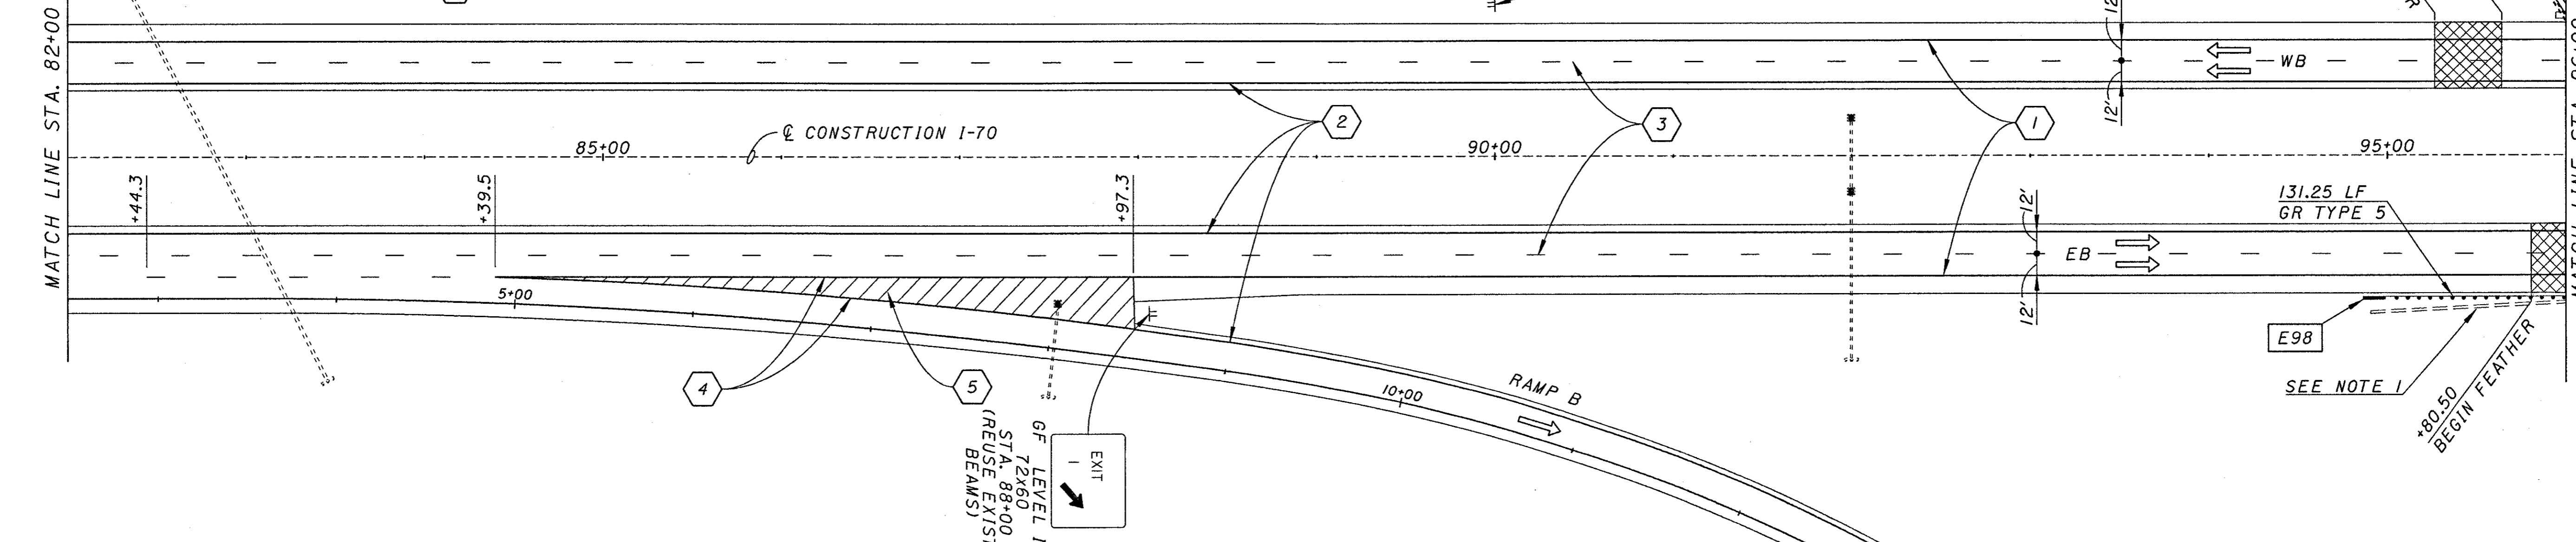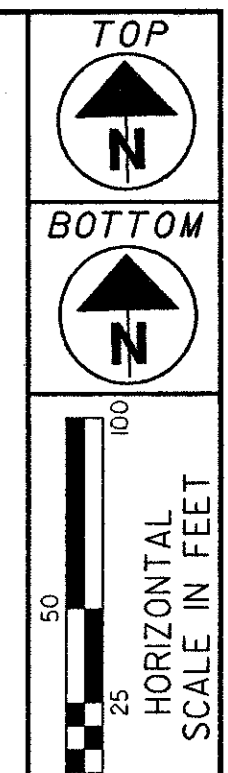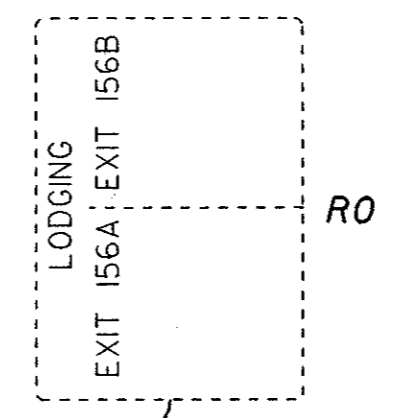


LEGEND

- PAVEMENT FEATHERING. SEE MISCELLANEOUS DETAIL, SHEET 124, FOR FURTHER INFORMATION.
- GUARDRAIL ANCHOR ASSEMBLY, TYPE E-98
- BRIDGE TERMINAL ASSEMBLY, TYPE I





FOR CONTINUATION, SEE SHEET 122.

NOTES

- 1) REMOVE EXISTING CONCRETE BARRIER AT BEGIN/END OF TAPER. FILL VOID, REGRADE AND SEED & MULCH.
- 2) CONSTRUCT A NEW CONCRETE BARRIER TRANSITION AS PER STANDARD DRAWING RM-4.5M. SEAL WITH EPOXY URETHANE.
- 3) FOR RAMP A AND B INFORMATION, SEE SHEETS 121-122.
- 4) FOR OVERHEAD STRUCTURE INFORMATION, SEE SHEETS 260-283.
- 5) FOR SIGN ELEVATIONS, SEE SHEETS 127-128.

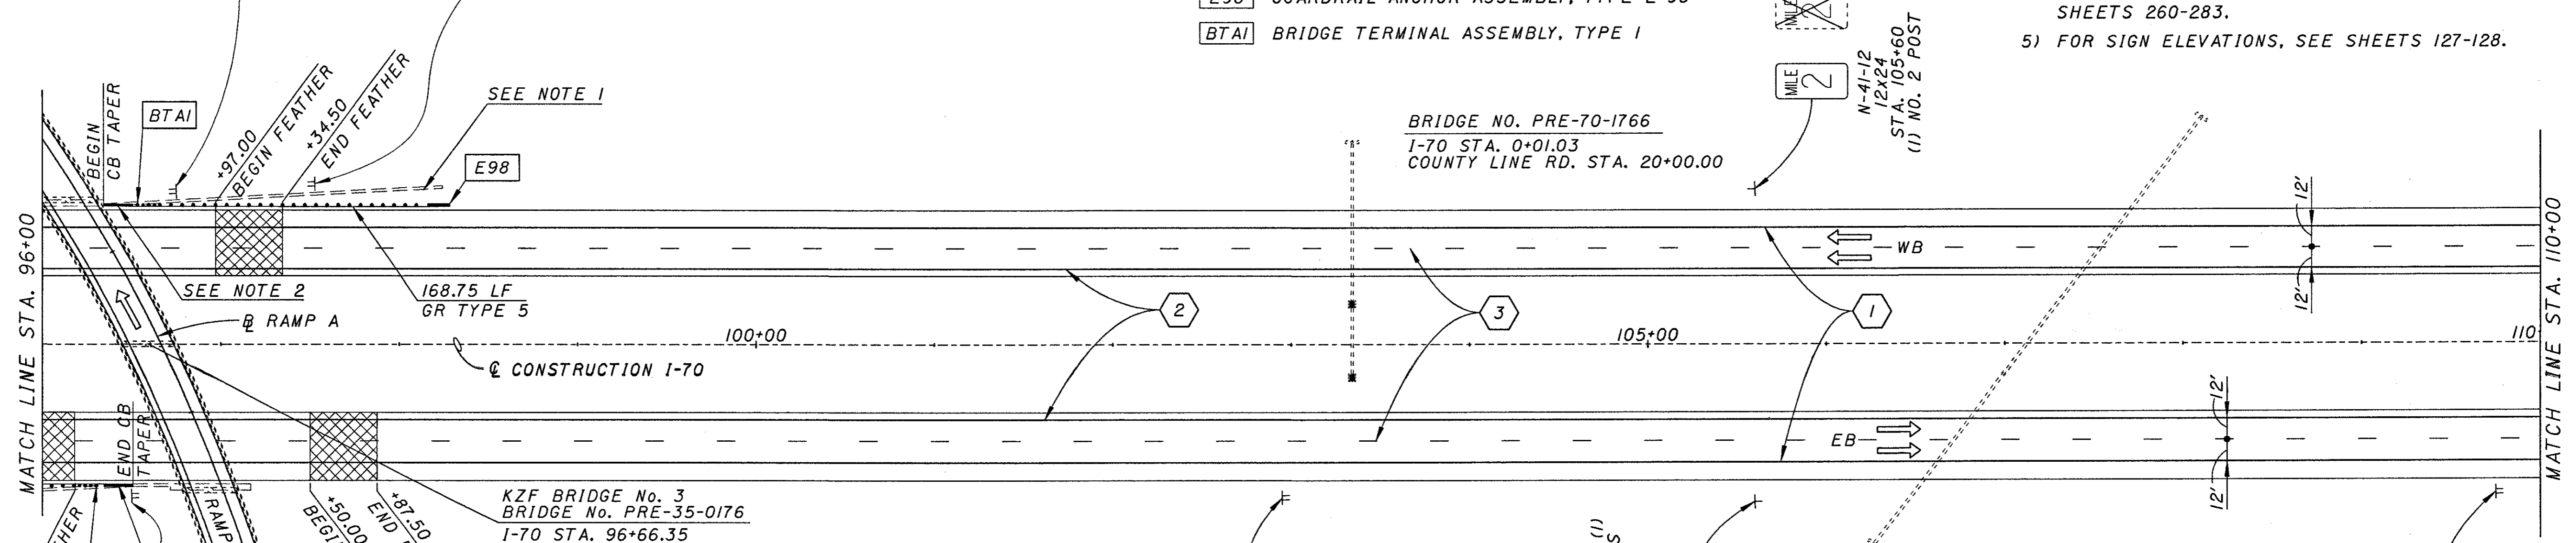

KZF BRIDGE No. 3
BRIDGE No. PRE-35-0176
I-70 STA. 96+66.35
RAMP A STA. 26+87.36

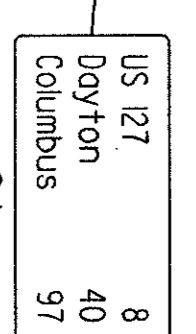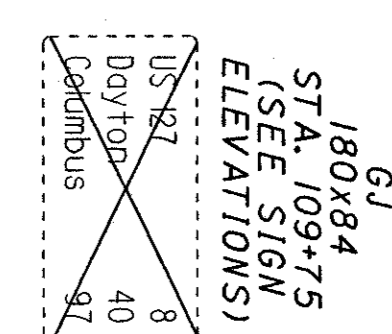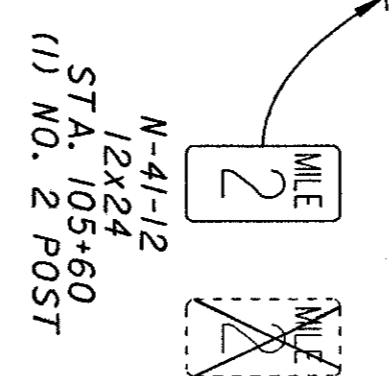
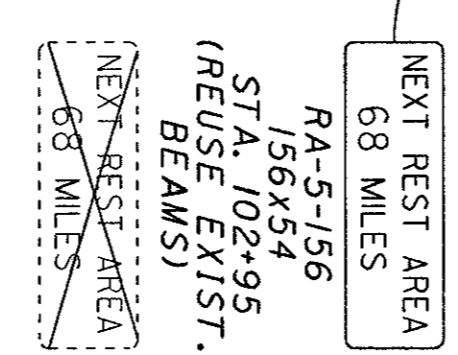


PLAN STA. 82+00 TO STA. 110+00

PRE-70-0.00

REVISIONS:
 REF: PRE-70-0.00
 DES: J. L. DUNN
 DATE: 10/1/68
 ACT: J. L. DUNN

DATE: 11/15/05
 DESIGNED BY: J. J. WILSON
 CHECKED BY: J. J. WILSON
 APPROVED BY: J. J. WILSON
 ACTING LEVELS: J. J. WILSON

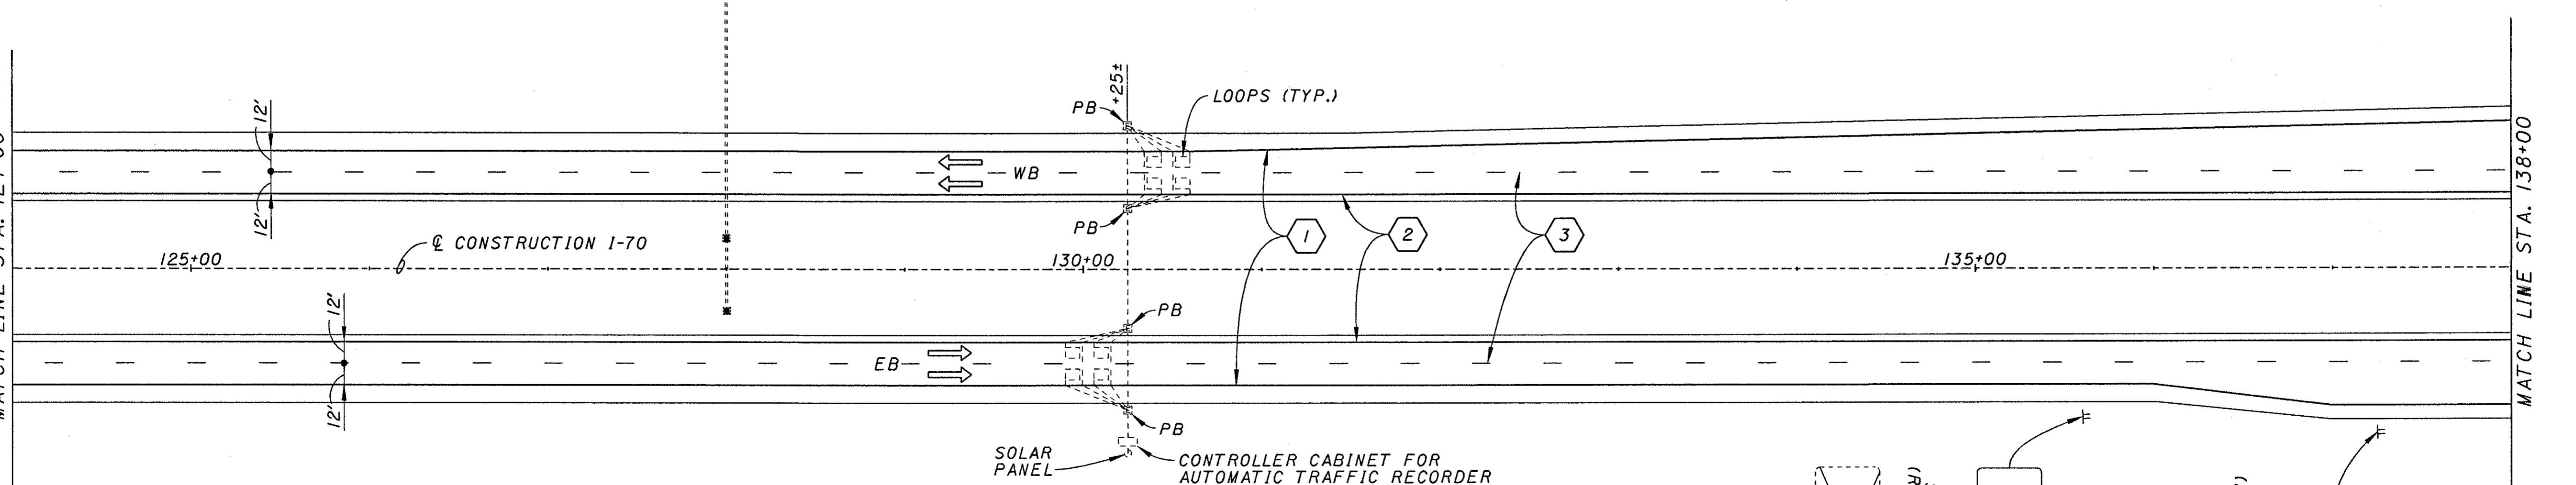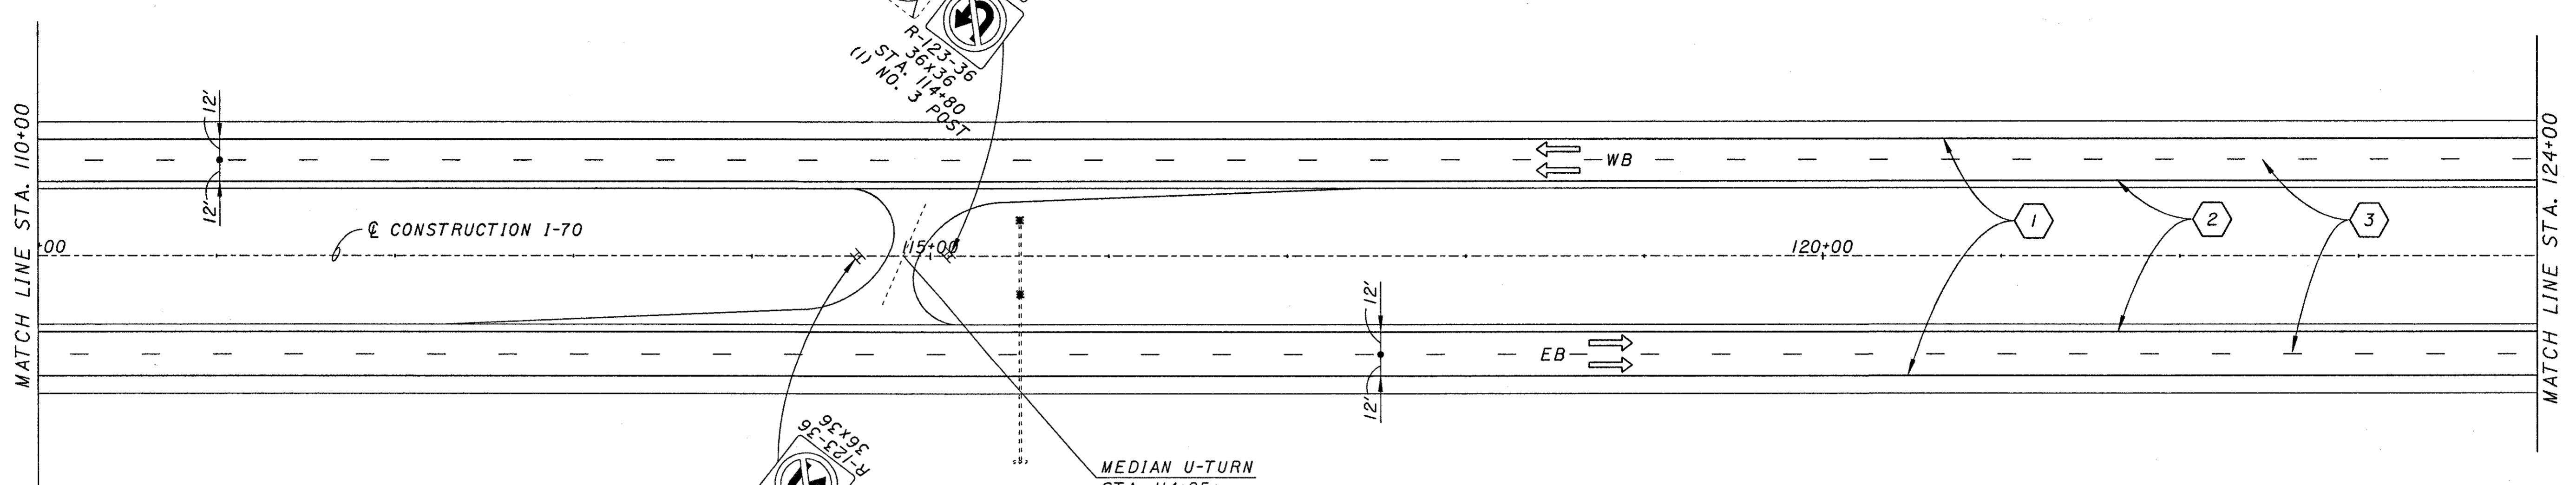

PAVEMENT MARKING LEGEND


- ① 4" EDGE LINE, WHITE
- ② 4" EDGE LINE, YELLOW
- ③ 4" LANE LINE
- ④ 8" CHANNELIZING LINE, WHITE
- ⑤ 24" TRANSVERSE LINE, WHITE, 12' SPACING

SIGN LEGEND


- [Solid Box] NEW SIGN
- [Dashed Box] EXISTING SIGN, TO REMAIN
- [Box with X] EXISTING SIGN, TO BE REMOVED
- RO INDICATES SIGN TO BE CONSIDERED FOR REMOVAL AND REERECTION, REMOVAL AND REERECTION BY OTHERS.

NOTES


1) FOR MEDIAN U-TURN INFORMATION, SEE SHEET 125.

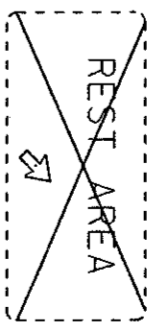


RA-2-132
132x60
STA. 135+60
(REUSE EXIST.
BEAMS)

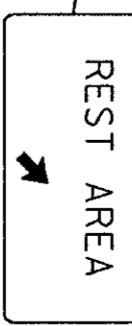

REST AREA

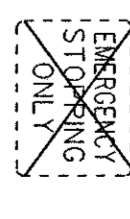


R-70-48
48x36
STA. 137+25
(2) NO. 3 POSTS

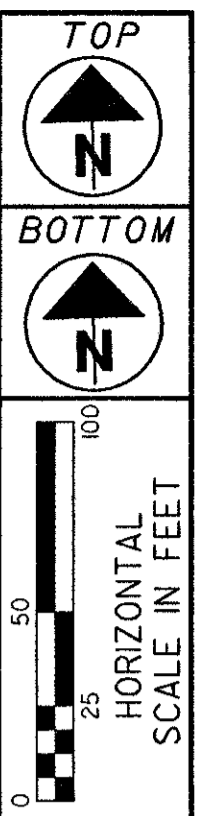

PLAN
STA. 110+00 TO STA. 138+00

PRE-70-0.00

 REF: PRELIMINARY
 DESIGNED BY: [REDACTED]
 CHECKED BY: [REDACTED]
 DATE: [REDACTED]
 PROJECT: [REDACTED]

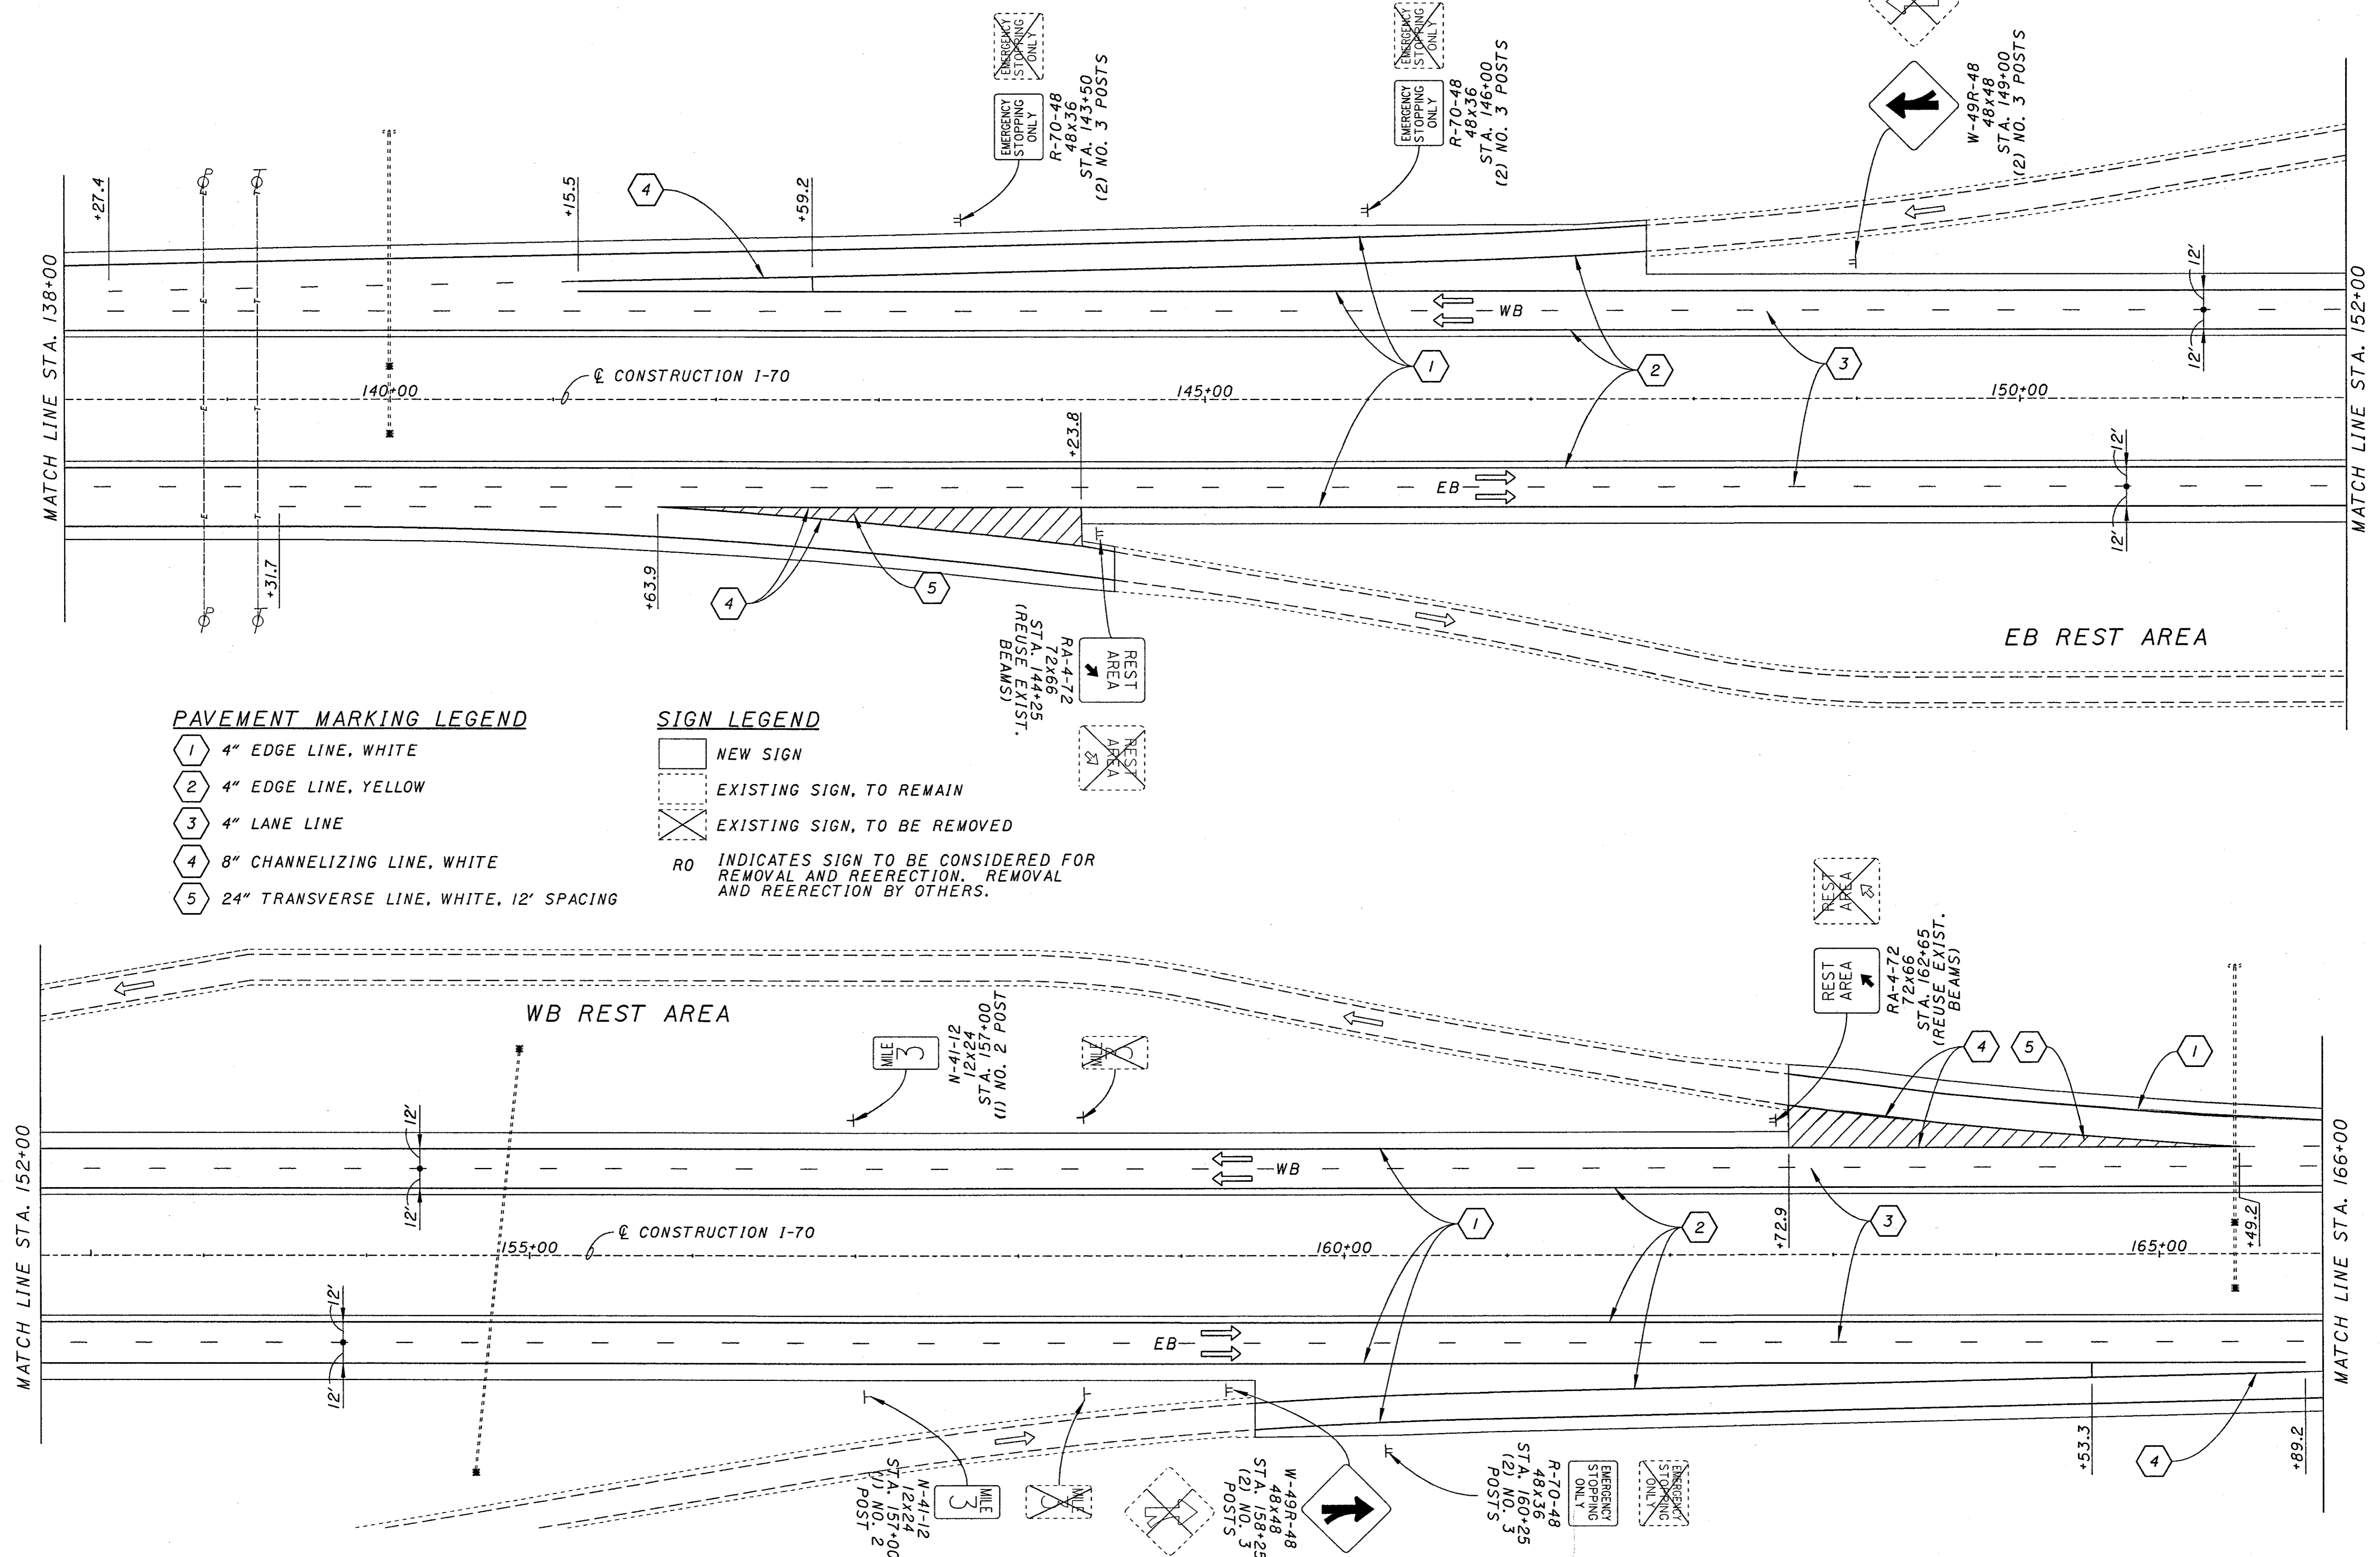


PAVEMENT MARKING LEGEND

- 1 4" EDGE LINE, WHITE
- 2 4" EDGE LINE, YELLOW
- 3 4" LANE LINE
- 4 8" CHANNELIZING LINE, WHITE
- 5 24" TRANSVERSE LINE, WHITE, 12' SPACING



SIGN LEGEND

- [Solid Box] NEW SIGN
- [Dashed Box] EXISTING SIGN, TO REMAIN
- [Crossed Box] EXISTING SIGN, TO BE REMOVED
- RO INDICATES SIGN TO BE CONSIDERED FOR REMOVAL AND REERECTION. REMOVAL AND REERECTION BY OTHERS.

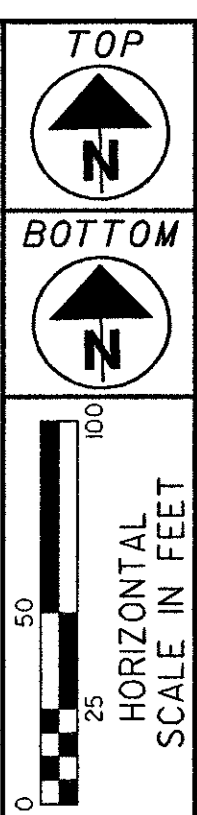

PLAN
STA. 138+00 TO STA. 166+00

PRE-70-0.00

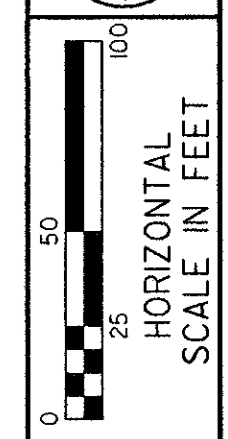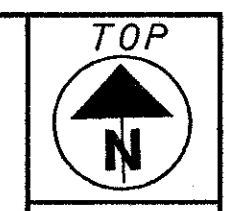

PLAN
STA. 166+00 TO STA. 194+00


PRE-70-0.00
17
283

PAVEMENT MARKING LEGEND

- ① 4" EDGE LINE, WHITE
- ② 4" EDGE LINE, YELLOW
- ③ 4" LANE LINE
- ④ 8" CHANNELIZING LINE, WHITE
- ⑤ 24" TRANSVERSE LINE, WHITE, 12' SPACING

SIGN LEGEND

- NEW SIGN
- EXISTING SIGN, TO REMAIN
- EXISTING SIGN, TO BE REMOVED
- RO INDICATES SIGN TO BE CONSIDERED FOR REMOVAL AND REERECTION. REMOVAL AND REERECTION BY OTHERS.

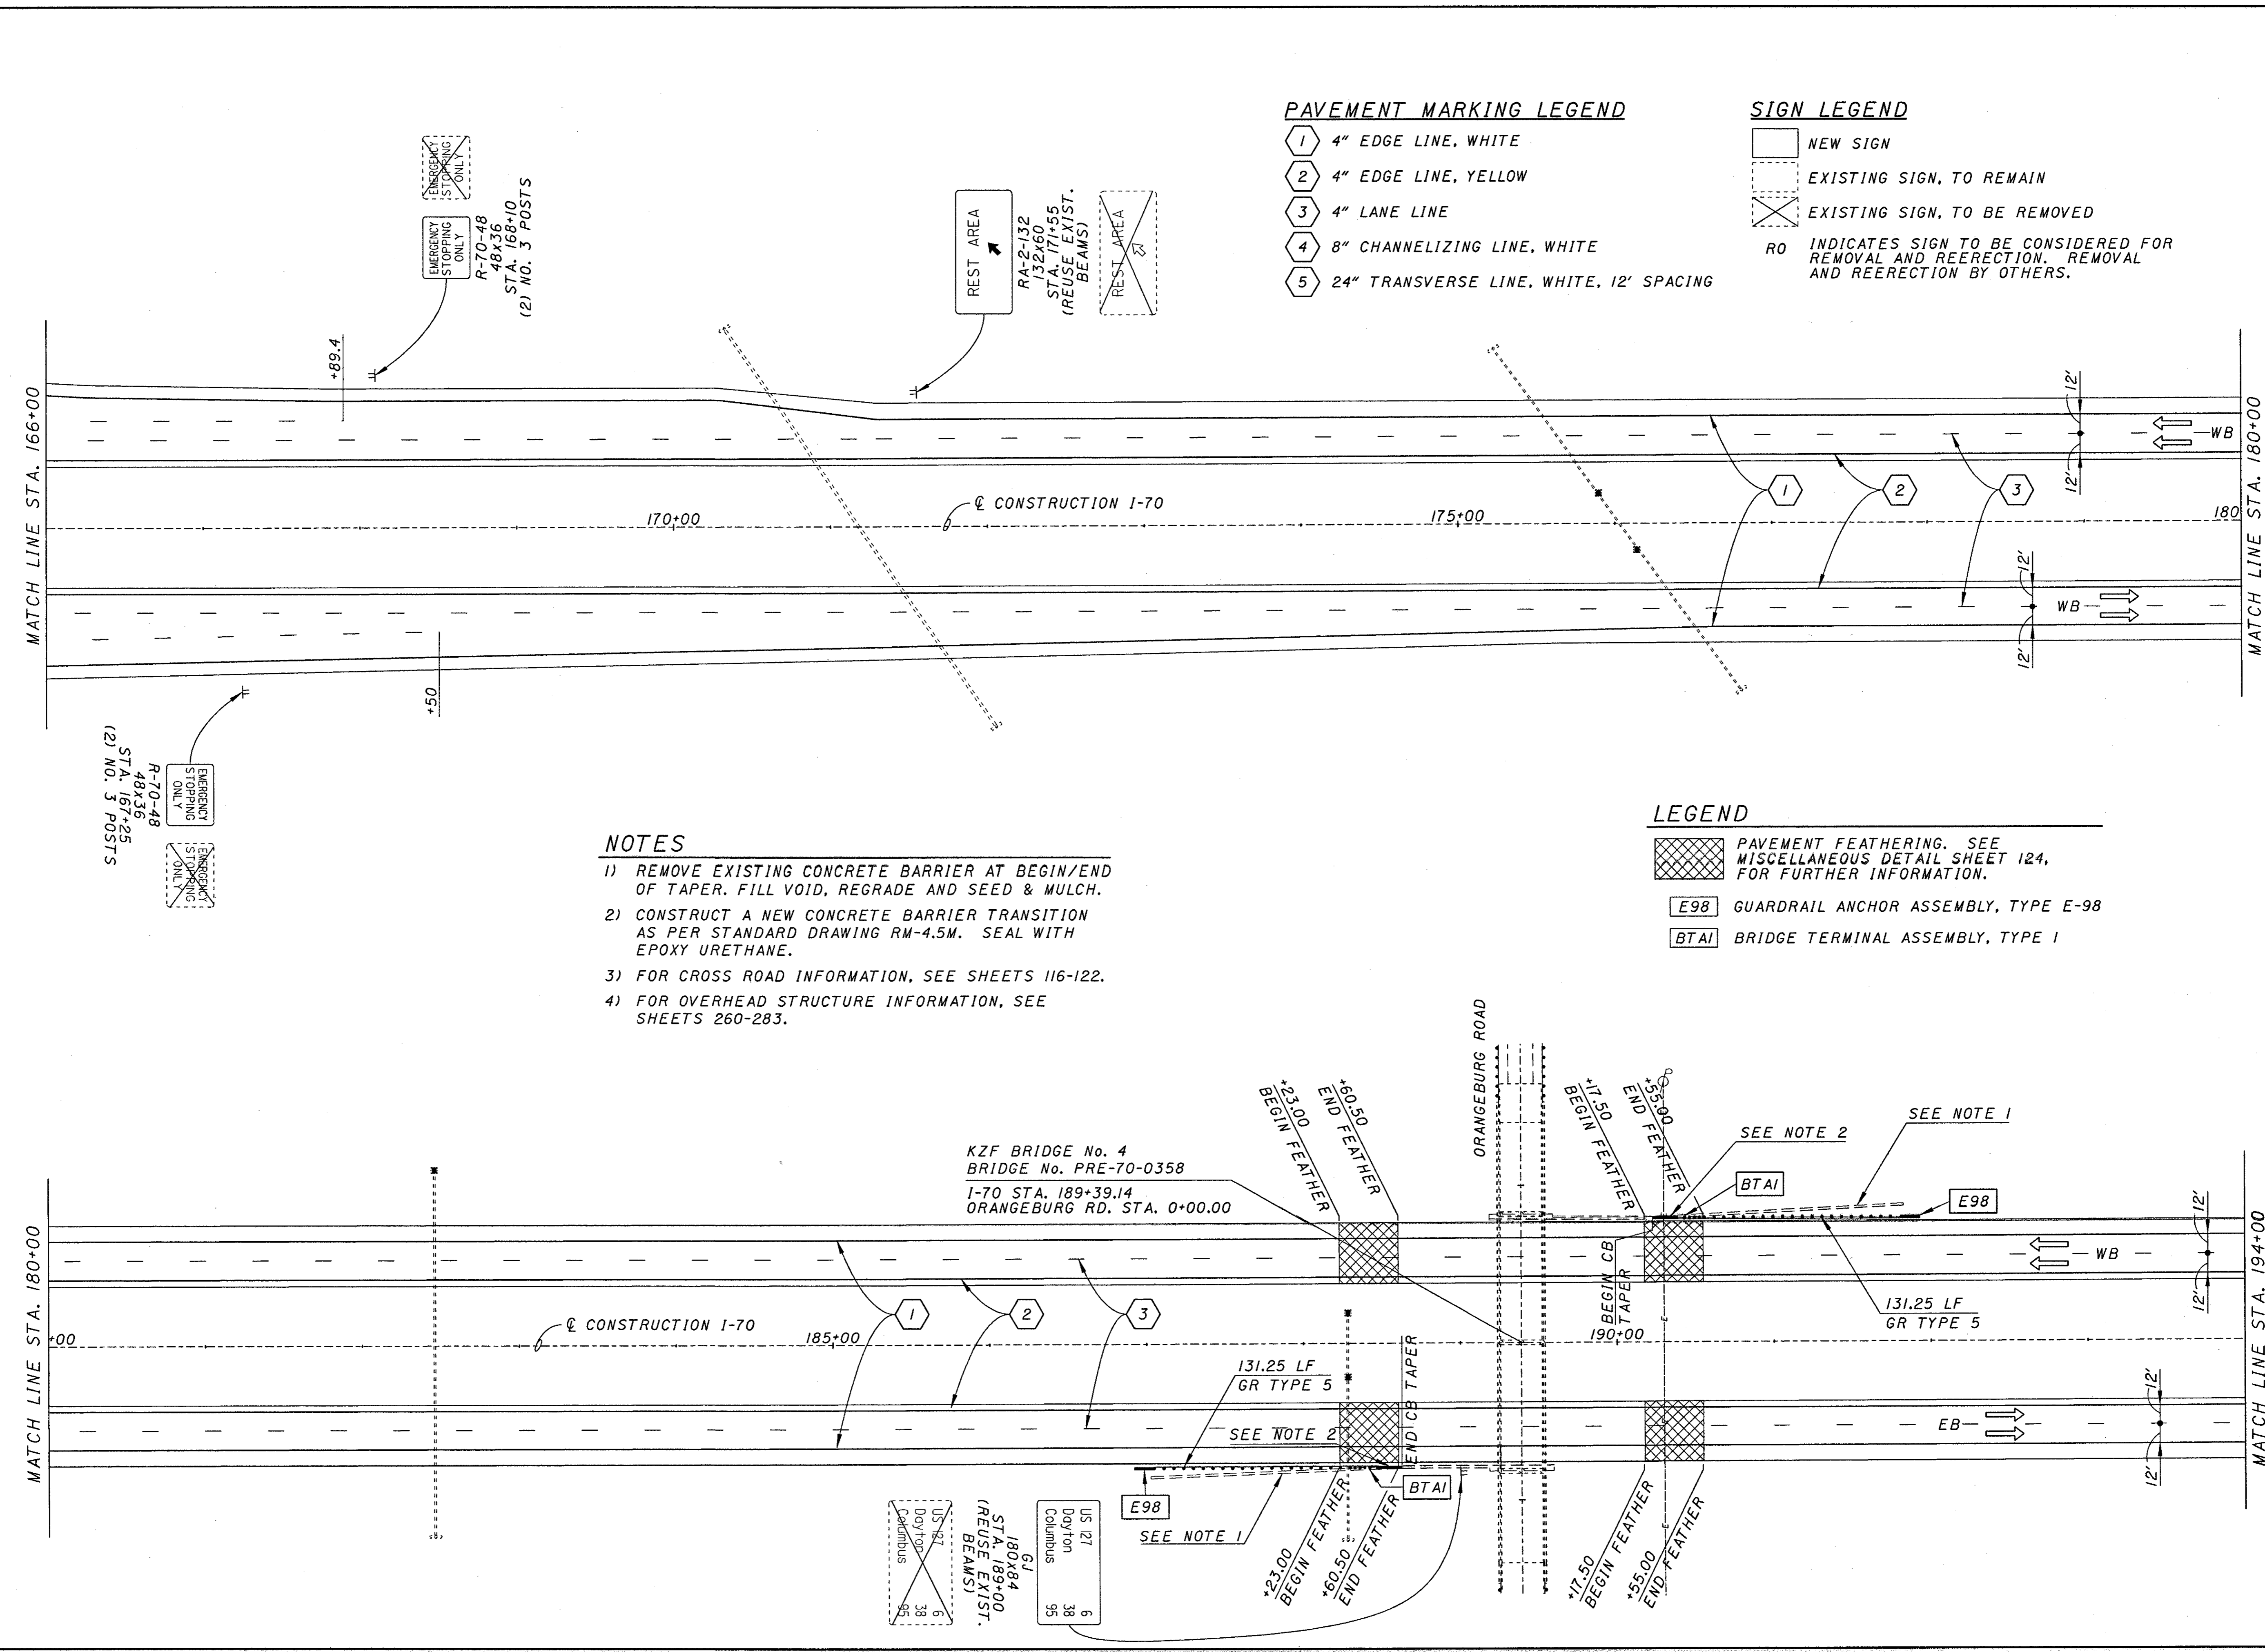

LEGEND

- PAVEMENT FEATHERING. SEE MISCELLANEOUS DETAIL SHEET 124, FOR FURTHER INFORMATION.
- E98 GUARDRAIL ANCHOR ASSEMBLY, TYPE E-98
- BTAI BRIDGE TERMINAL ASSEMBLY, TYPE I

NOTES

- 1) REMOVE EXISTING CONCRETE BARRIER AT BEGIN/END OF TAPER. FILL VOID, REGRADE AND SEED & MULCH.
- 2) CONSTRUCT A NEW CONCRETE BARRIER TRANSITION AS PER STANDARD DRAWING RM-4.5M. SEAL WITH EPOXY URETHANE.
- 3) FOR CROSS ROAD INFORMATION, SEE SHEETS 116-122.
- 4) FOR OVERHEAD STRUCTURE INFORMATION, SEE SHEETS 260-283.

US 127
Dov Top
Columbus
6
38
95



US 187
Dov Top
Columbus
6
38
95

STA. 180+84
STA. 189+00
(REUSE EXIST. BEAMS)

DATE: 11/16/88
 DESIGNED BY: [illegible]
 DRAWN BY: [illegible]
 CHECKED BY: [illegible]
 ACT. LEVELS: 0111 0112 0113 0200

- PAVEMENT MARKING LEGEND**
- 1 4" EDGE LINE, WHITE
 - 2 4" EDGE LINE, YELLOW
 - 3 4" LANE LINE
 - 4 8" CHANNELIZING LINE, WHITE
 - 5 24" TRANSVERSE LINE, WHITE, 12' SPACING

- SIGN LEGEND**
- NEW SIGN
 - EXISTING SIGN, TO REMAIN
 - X EXISTING SIGN, TO BE REMOVED
 - RO INDICATES SIGN TO BE CONSIDERED FOR REMOVAL AND REERECTION. REMOVAL AND REERECTION BY OTHERS.

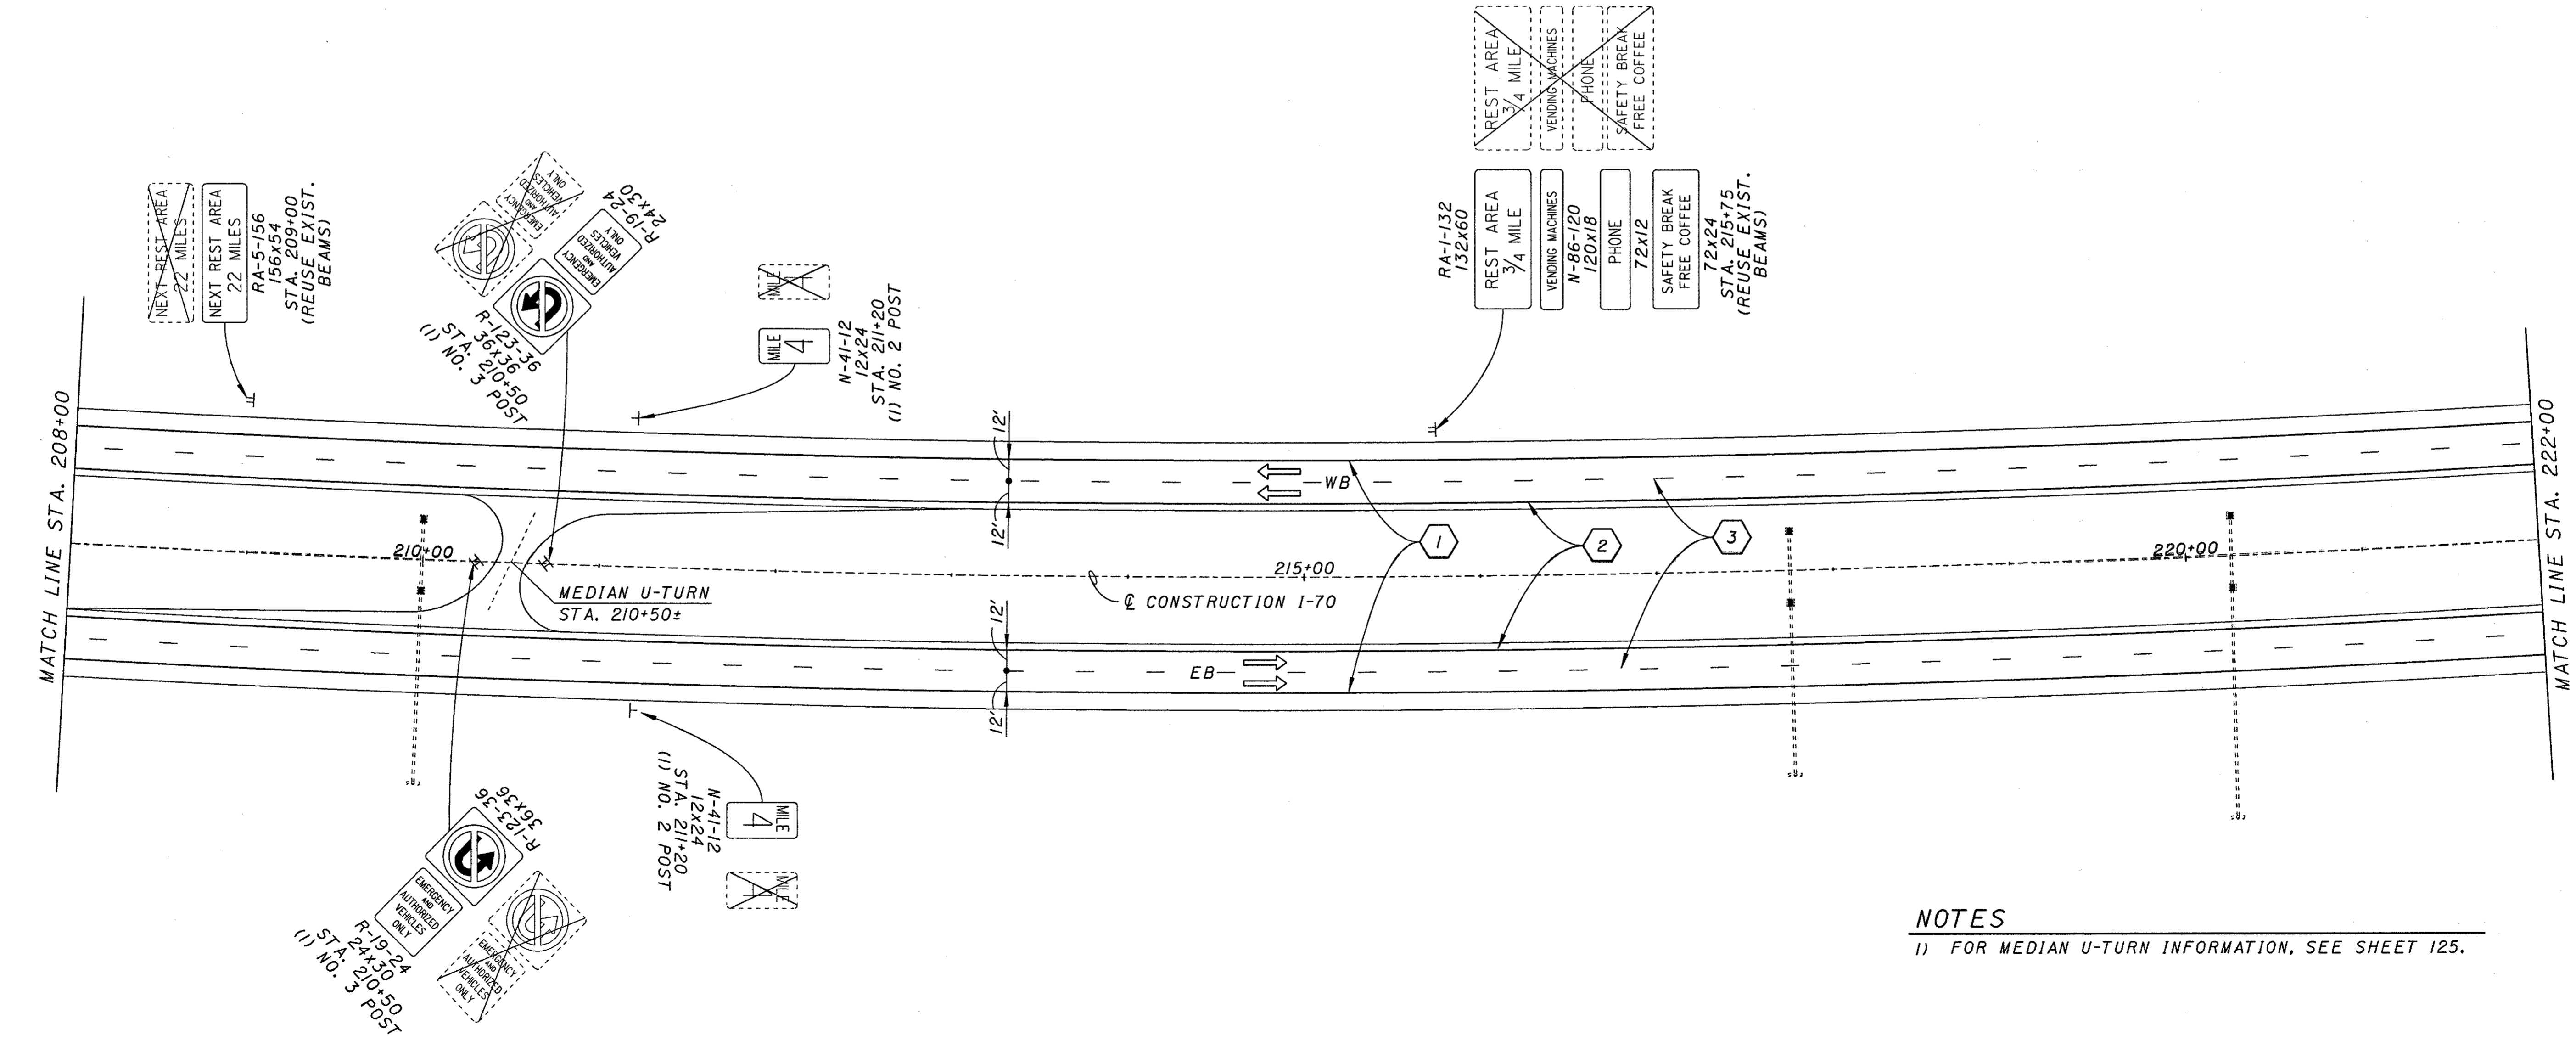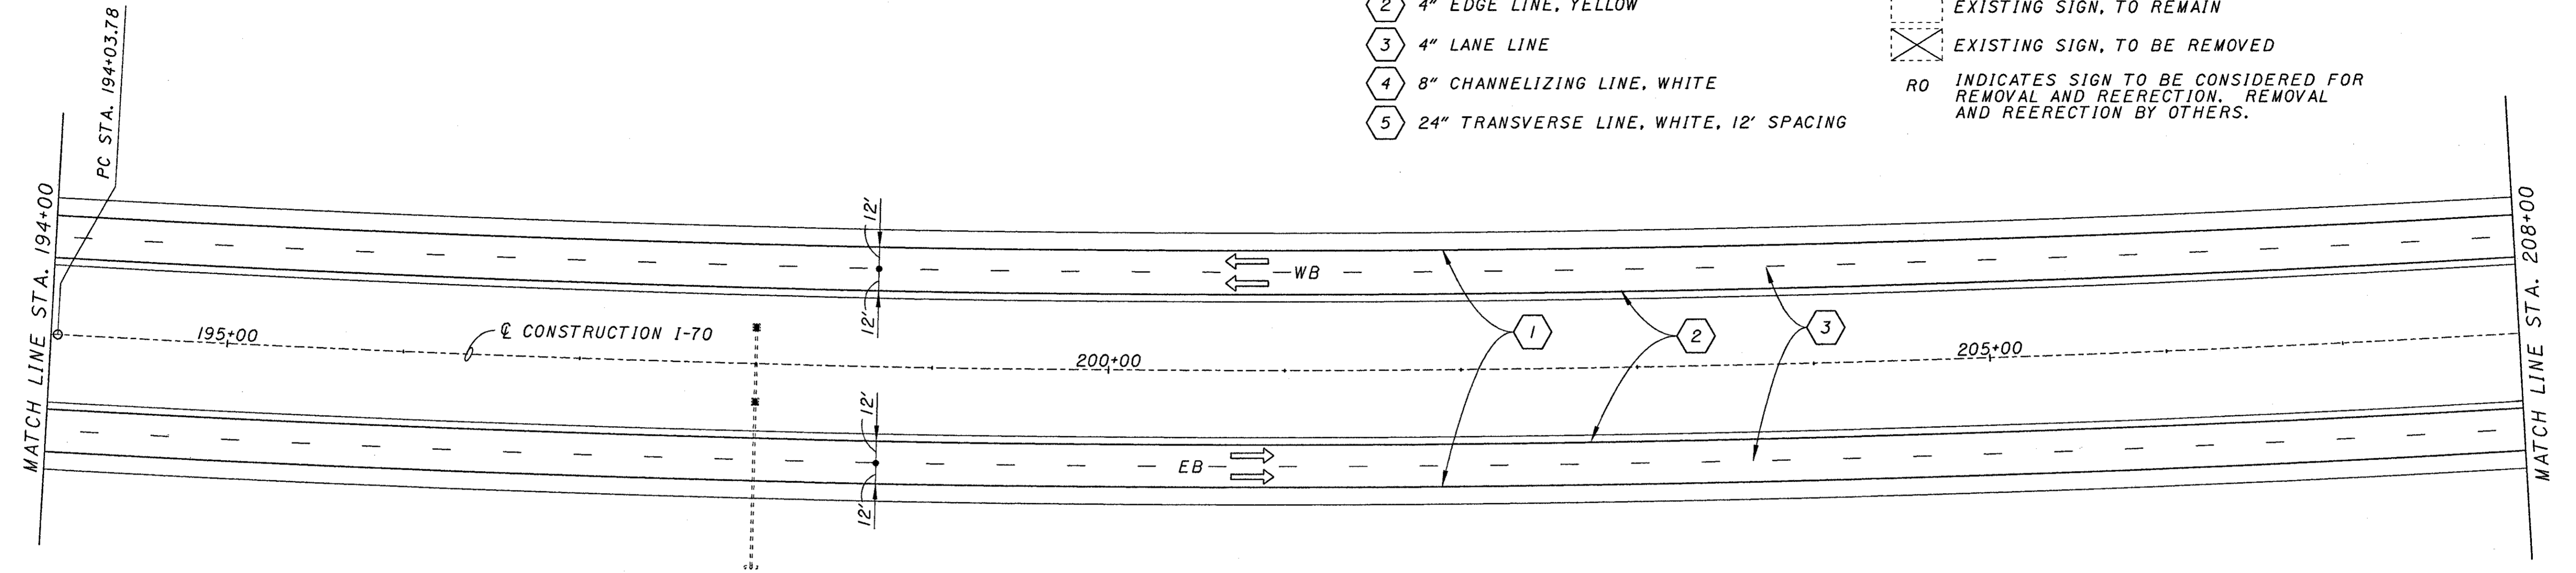


NOTES
1) FOR MEDIAN U-TURN INFORMATION, SEE SHEET 125.

REVISIONS: REF: 001, 002, 003, 999, 1000.

DATE: 07/10/08
 DESIGNED BY: J. W. WILSON
 CHECKED BY: J. W. WILSON
 ACTIVE LEVELS ON: 08/11/08

REF: PREVIOUS EDITIONS
 REF: PREVIOUS EDITIONS
 REF: PREVIOUS EDITIONS

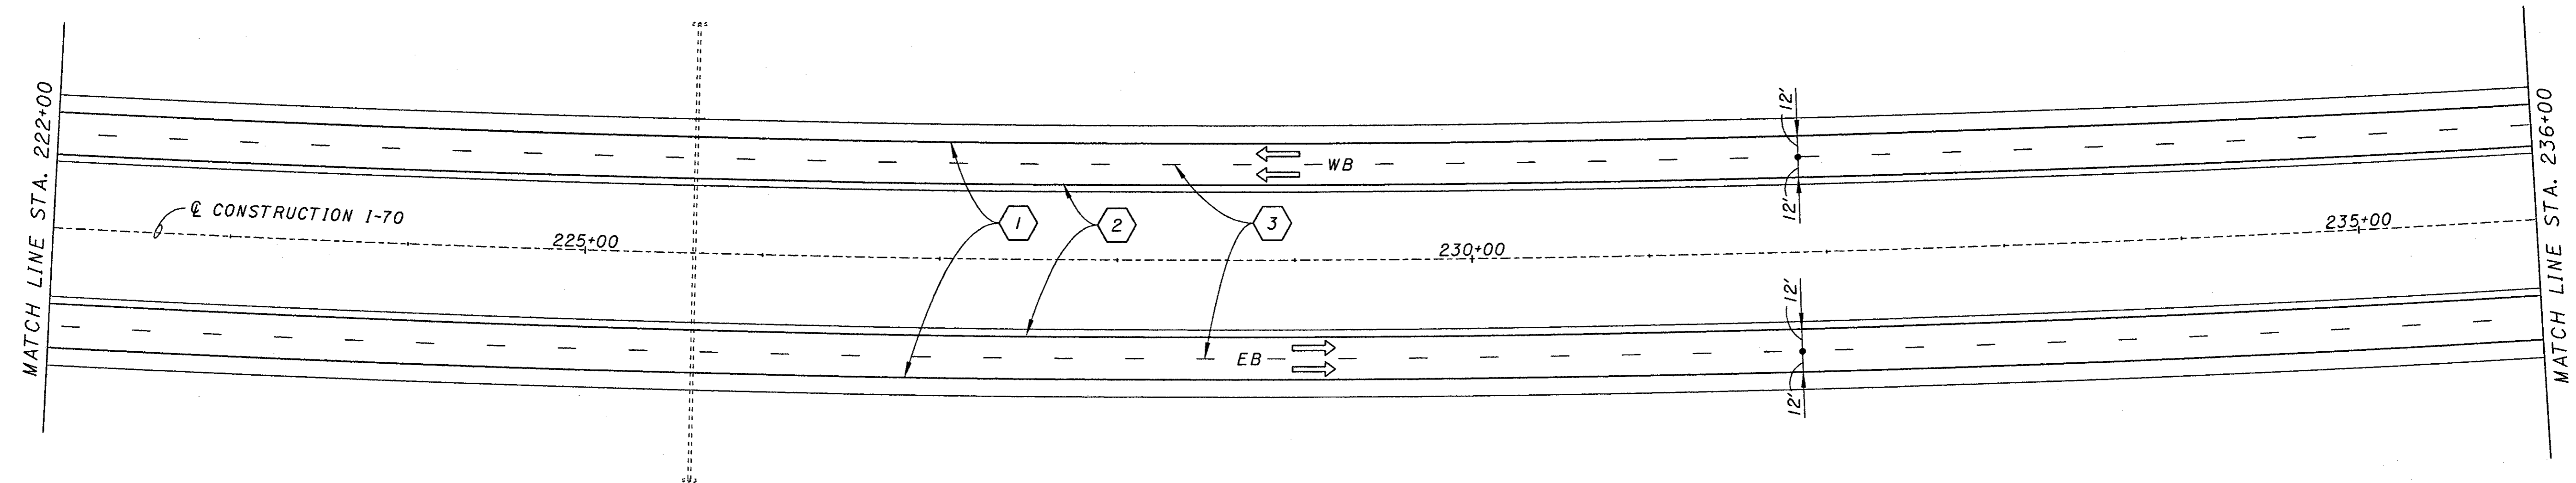



STATION EQUATION
 PT STA. 238+07.35 (BACK)
 STA. 236+07.98 (AHEAD)

PAVEMENT MARKING LEGEND

- 1 4" EDGE LINE, WHITE
- 2 4" EDGE LINE, YELLOW
- 3 4" LANE LINE
- 4 8" CHANNELIZING LINE, WHITE
- 5 24" TRANSVERSE LINE, WHITE, 12' SPACING

SIGN LEGEND

- [Solid Box] NEW SIGN
- [Dashed Box] EXISTING SIGN, TO REMAIN
- [Crossed Box] EXISTING SIGN, TO BE REMOVED
- RO INDICATES SIGN TO BE CONSIDERED FOR REMOVAL AND REERECTION. REMOVAL AND REERECTION BY OTHERS.

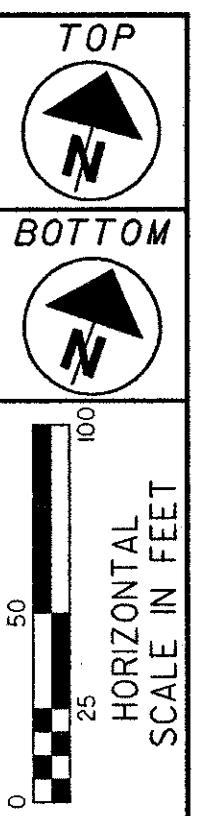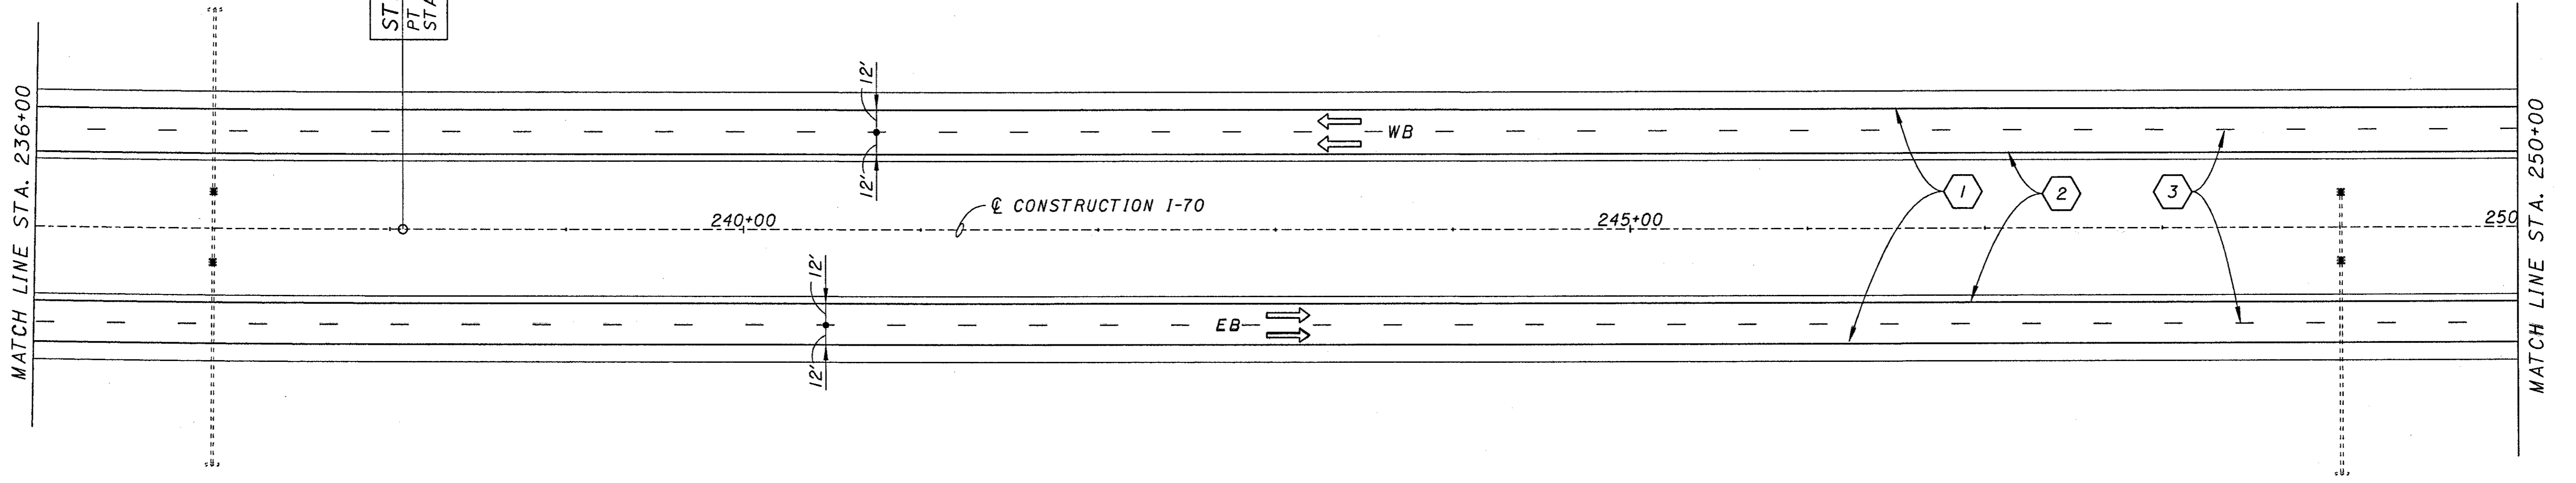

PLAN
 STA. 222+00 TO STA. 250+00


PRE-70-0.00

PAVEMENT MARKING LEGEND

- 1 4" EDGE LINE, WHITE
- 2 4" EDGE LINE, YELLOW
- 3 4" LANE LINE
- 4 8" CHANNELIZING LINE, WHITE
- 5 24" TRANSVERSE LINE, WHITE, 12' SPACING


SIGN LEGEND

- [] NEW SIGN
- [] EXISTING SIGN, TO REMAIN
- [] EXISTING SIGN, TO BE REMOVED
- RO INDICATES SIGN TO BE CONSIDERED FOR REMOVAL AND REERECTION. REMOVAL AND REERECTION BY OTHERS.

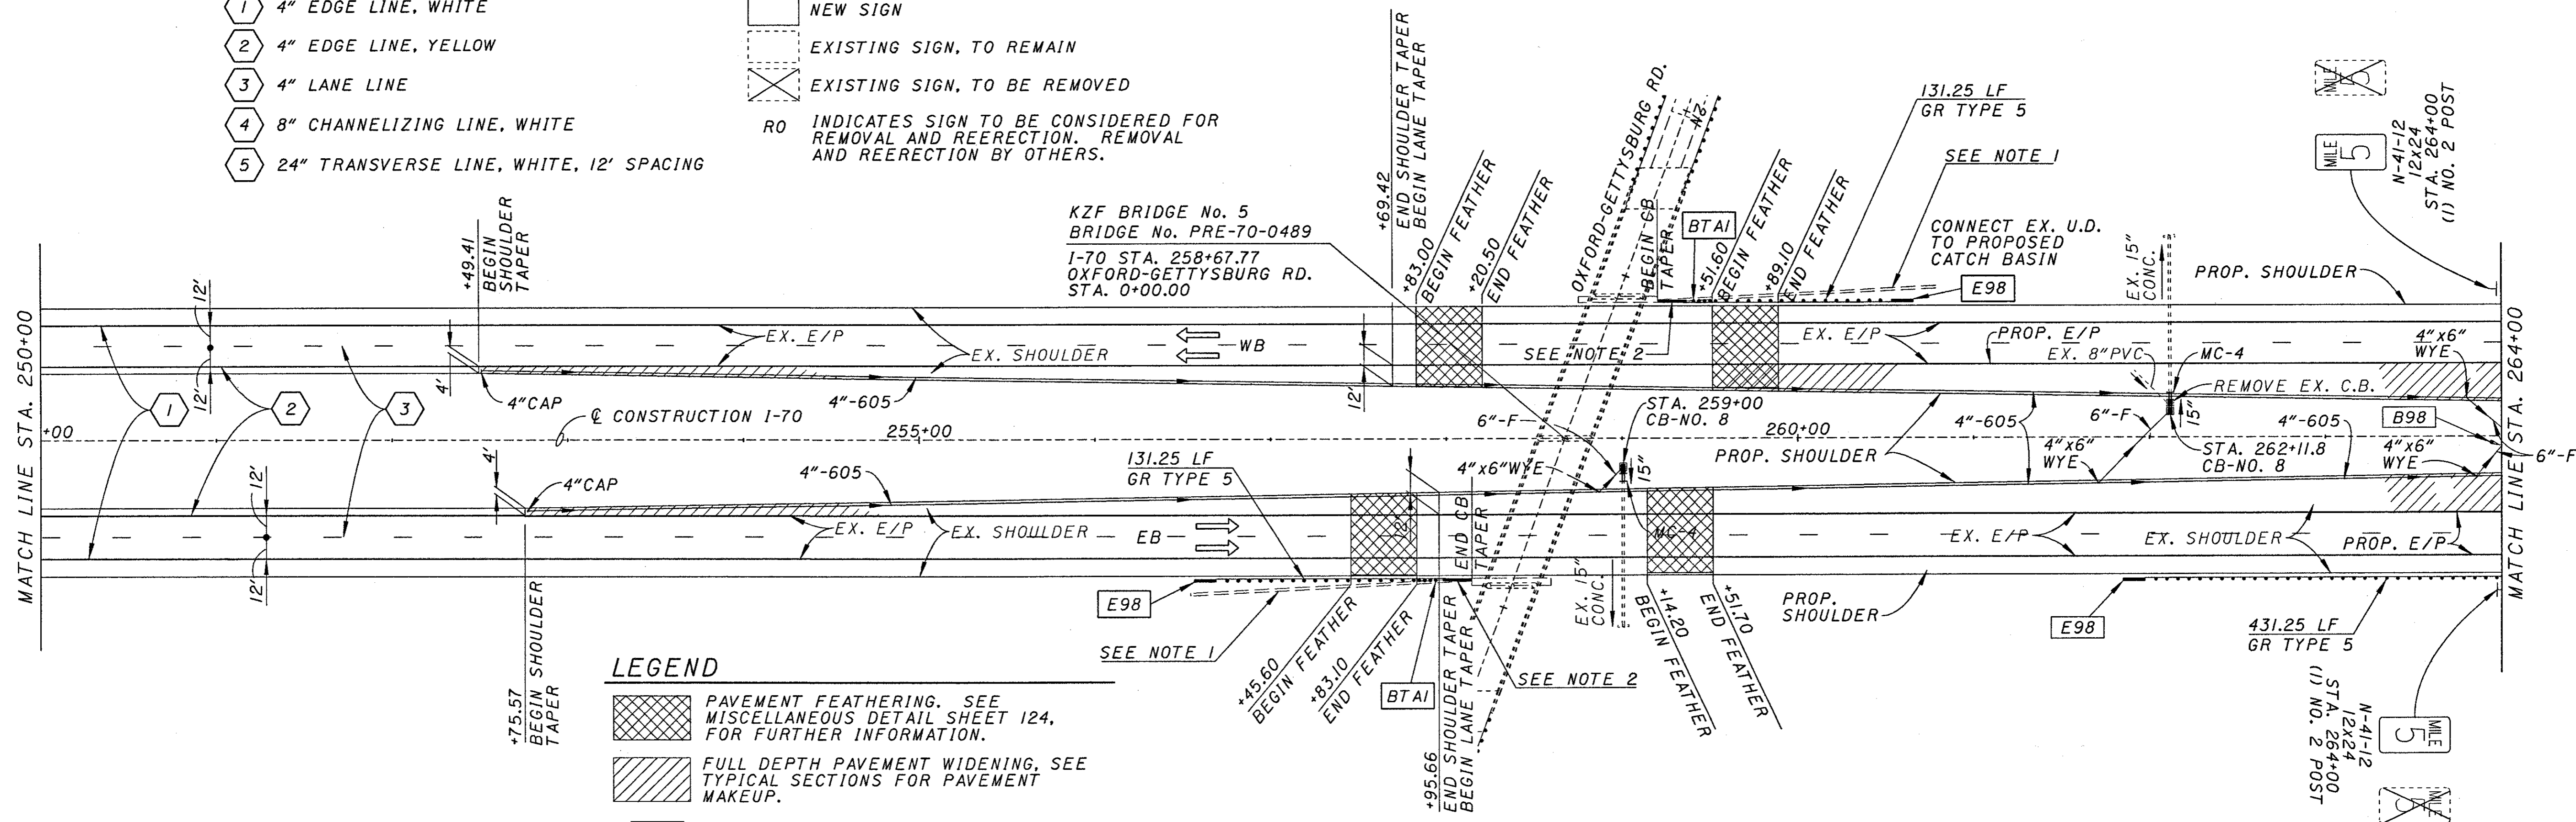

LEGEND

- [] PAVEMENT FEATHERING. SEE MISCELLANEOUS DETAIL SHEET 124, FOR FURTHER INFORMATION.
- [] FULL DEPTH PAVEMENT WIDENING, SEE TYPICAL SECTIONS FOR PAVEMENT MAKEUP.
- [B98] GUARDRAIL ANCHOR ASSEMBLY, TYPE B-98
- [E98] GUARDRAIL ANCHOR ASSEMBLY, TYPE E-98
- [BTAI] BRIDGE TERMINAL ASSEMBLY, TYPE I
- MC-4 MC-4 MASONRY COLLAR

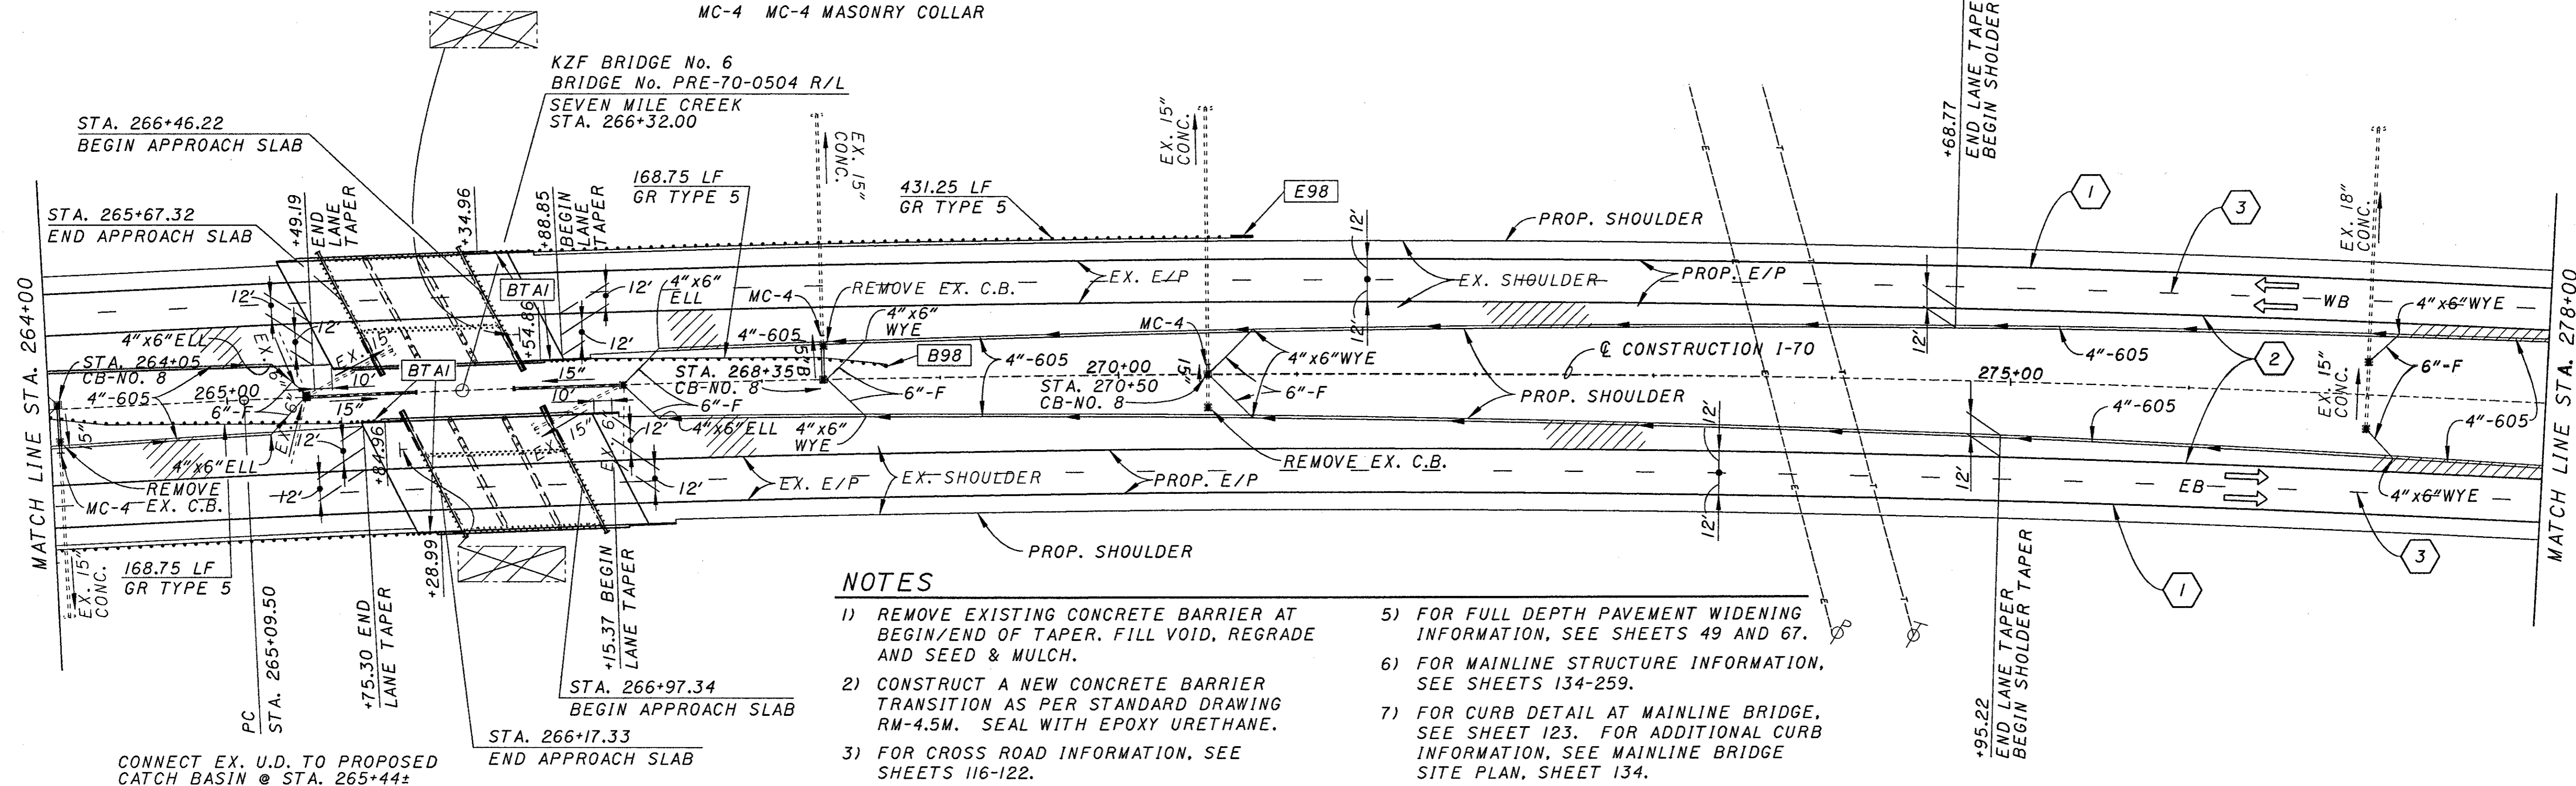


NOTES

- 1) REMOVE EXISTING CONCRETE BARRIER AT BEGIN/END OF TAPER, FILL VOID, REGRADE AND SEED & MULCH.
- 2) CONSTRUCT A NEW CONCRETE BARRIER TRANSITION AS PER STANDARD DRAWING RM-4.5M. SEAL WITH EPOXY URETHANE.
- 3) FOR CROSS ROAD INFORMATION, SEE SHEETS 116-122.
- 4) FOR OVERHEAD STRUCTURE INFORMATION, SEE SHEETS 260-283.
- 5) FOR FULL DEPTH PAVEMENT WIDENING INFORMATION, SEE SHEETS 49 AND 67.
- 6) FOR MAINLINE STRUCTURE INFORMATION, SEE SHEETS 134-259.
- 7) FOR CURB DETAIL AT MAINLINE BRIDGE, SEE SHEET 123. FOR ADDITIONAL CURB INFORMATION, SEE MAINLINE BRIDGE SITE PLAN, SHEET 134.

PLAN
STA. 250+00 TO STA. 278+00

PRE-70-0.00

REVISIONS:
 NO. DATE BY
 1 10/1/70 JMM
 2 10/1/70 JMM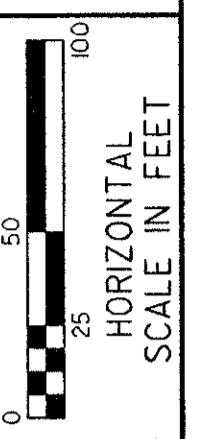
PAVEMENT MARKING LEGEND


- 1 4" EDGE LINE, WHITE
- 2 4" EDGE LINE, YELLOW
- 3 4" LANE LINE
- 4 8" CHANNELIZING LINE, WHITE
- 5 24" TRANSVERSE LINE, WHITE, 12' SPACING

SIGN LEGEND

- NEW SIGN
- EXISTING SIGN, TO REMAIN
- EXISTING SIGN, TO BE REMOVED
- RO INDICATES SIGN TO BE CONSIDERED FOR REMOVAL AND REERECTION. REMOVAL AND REERECTION BY OTHERS.

LEGEND

- FULL DEPTH PAVEMENT WIDENING, SEE TYPICAL SECTIONS FOR PAVEMENT MAKEUP.

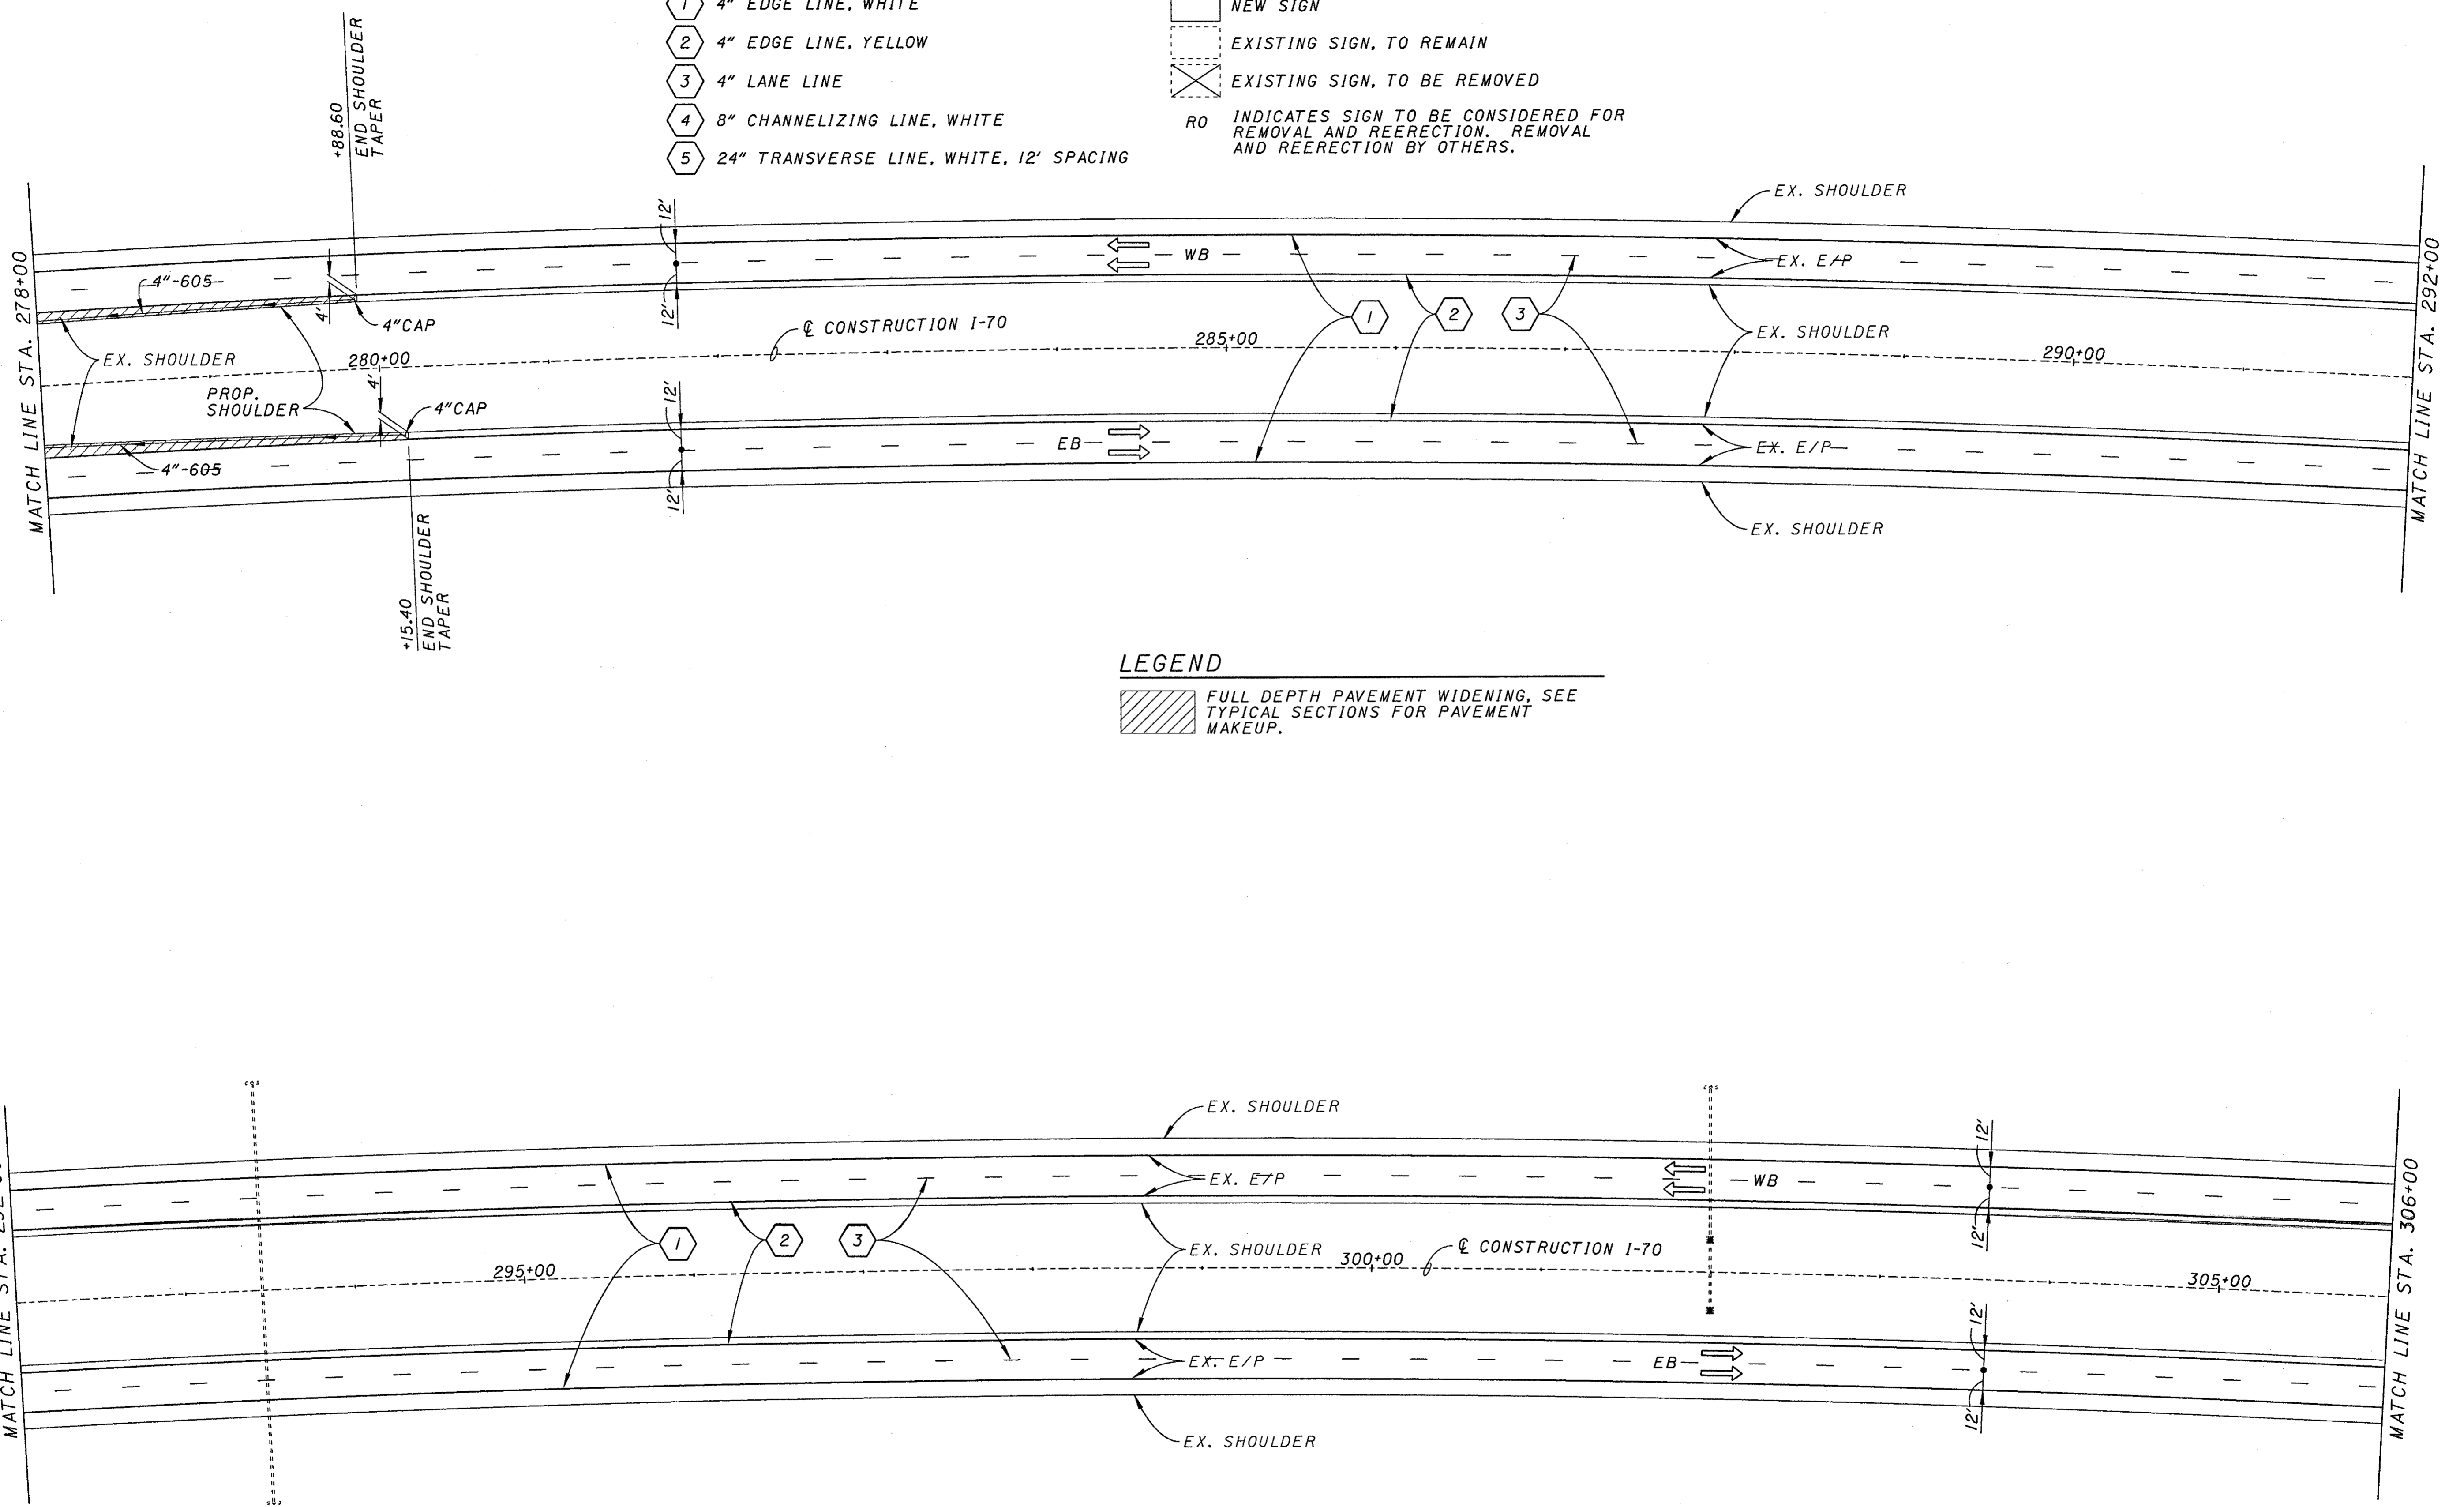


PLAN
STA. 278+00 TO STA. 306+00

PRE-70-0.00

REF: REF 01
 REF 02
 REF 03
 REF 04
 REF 100

NOTES

- 1) REMOVE EXISTING CONCRETE BARRIER AT BEGIN/END OF TAPER. FILL VOID, REGRADE AND SEED & MULCH.
- 2) CONSTRUCT A NEW CONCRETE BARRIER TRANSITION AS PER STANDARD DRAWING RM-4.5M. SEAL WITH EPOXY URETHANE.
- 3) FOR CROSS ROAD INFORMATION, SEE SHEETS 116-122.
- 4) FOR OVERHEAD STRUCTURE INFORMATION, SEE SHEETS 260-283.

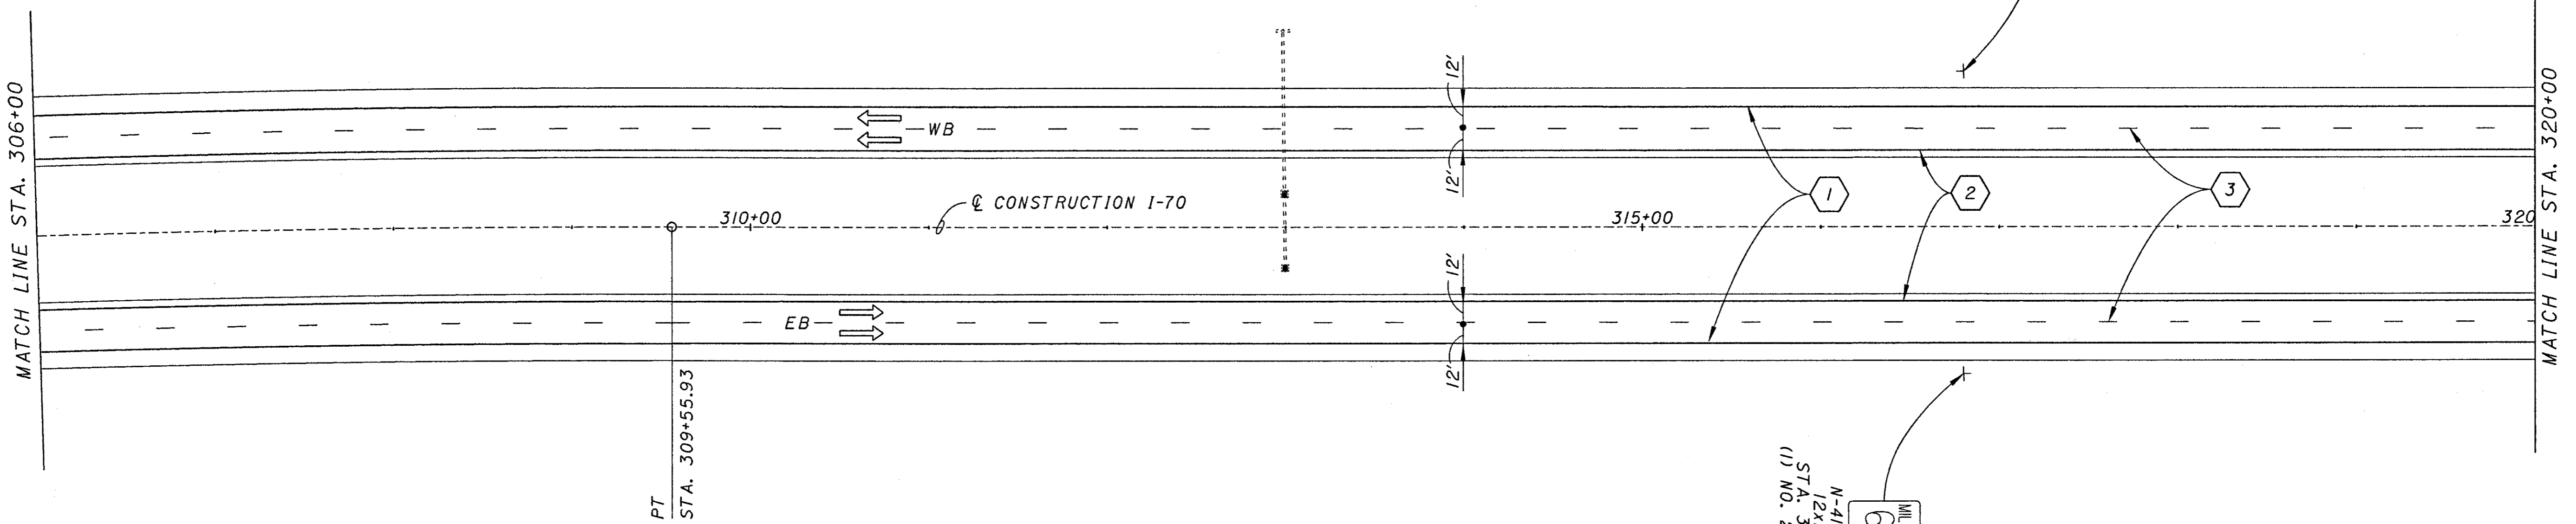

LEGEND


- PAVEMENT FEATHERING. SEE MISCELLANEOUS DETAILS SHEET 124. FOR FURTHER INFORMATION.
- GUARDRAIL ANCHOR ASSEMBLY, TYPE E-98
- BRIDGE TERMINAL ASSEMBLY, TYPE 1

PAVEMENT MARKING LEGEND

- 4" EDGE LINE, WHITE
- 4" EDGE LINE, YELLOW
- 4" LANE LINE
- 8" CHANNELIZING LINE, WHITE
- 24" TRANSVERSE LINE, WHITE, 12' SPACING


SIGN LEGEND

- NEW SIGN
- EXISTING SIGN, TO REMAIN
- EXISTING SIGN, TO BE REMOVED
- R0 INDICATES SIGN TO BE CONSIDERED FOR REMOVAL AND REERECTION. REMOVAL AND REERECTION BY OTHERS.

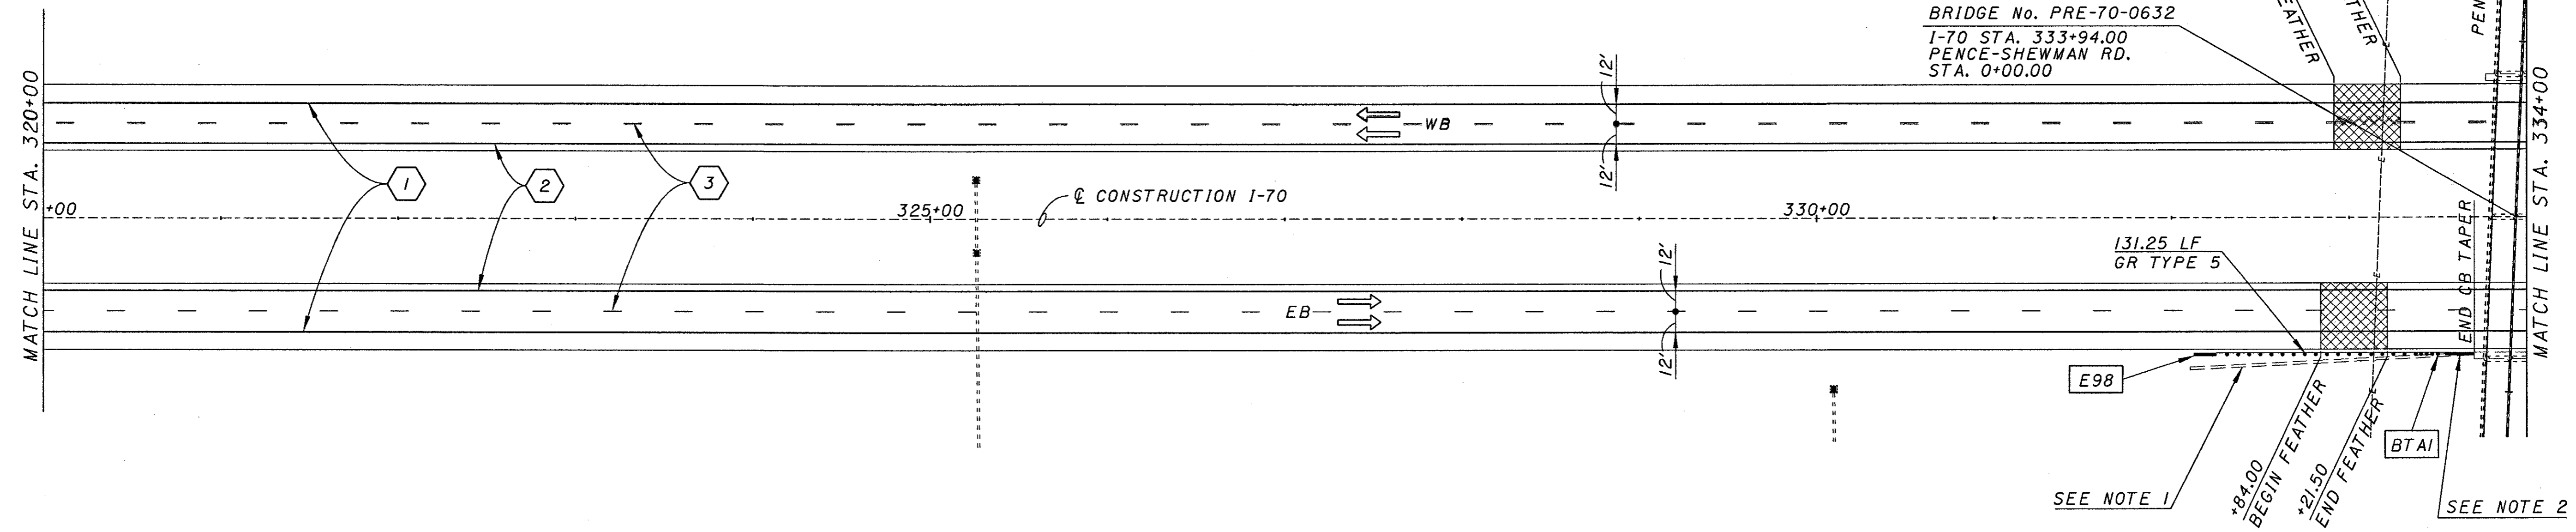

PLAN
STA. 306+00 TO STA. 334+00

PRE-70-0.00

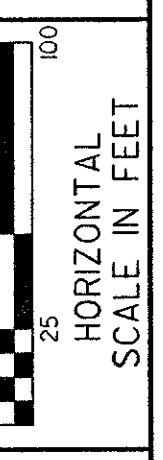

PLAN
STA. 334+00 TO STA. 362+00


PRE-70-0.00

PAVEMENT MARKING LEGEND

- 1 4" EDGE LINE, WHITE
- 2 4" EDGE LINE, YELLOW
- 3 4" LANE LINE
- 4 8" CHANNELIZING LINE, WHITE
- 5 24" TRANSVERSE LINE, WHITE, 12' SPACING

SIGN LEGEND

- NEW SIGN
- EXISTING SIGN, TO REMAIN
- EXISTING SIGN, TO BE REMOVED
- INDICATES SIGN TO BE CONSIDERED FOR REMOVAL AND REERECTION. REMOVAL AND REERECTION BY OTHERS.

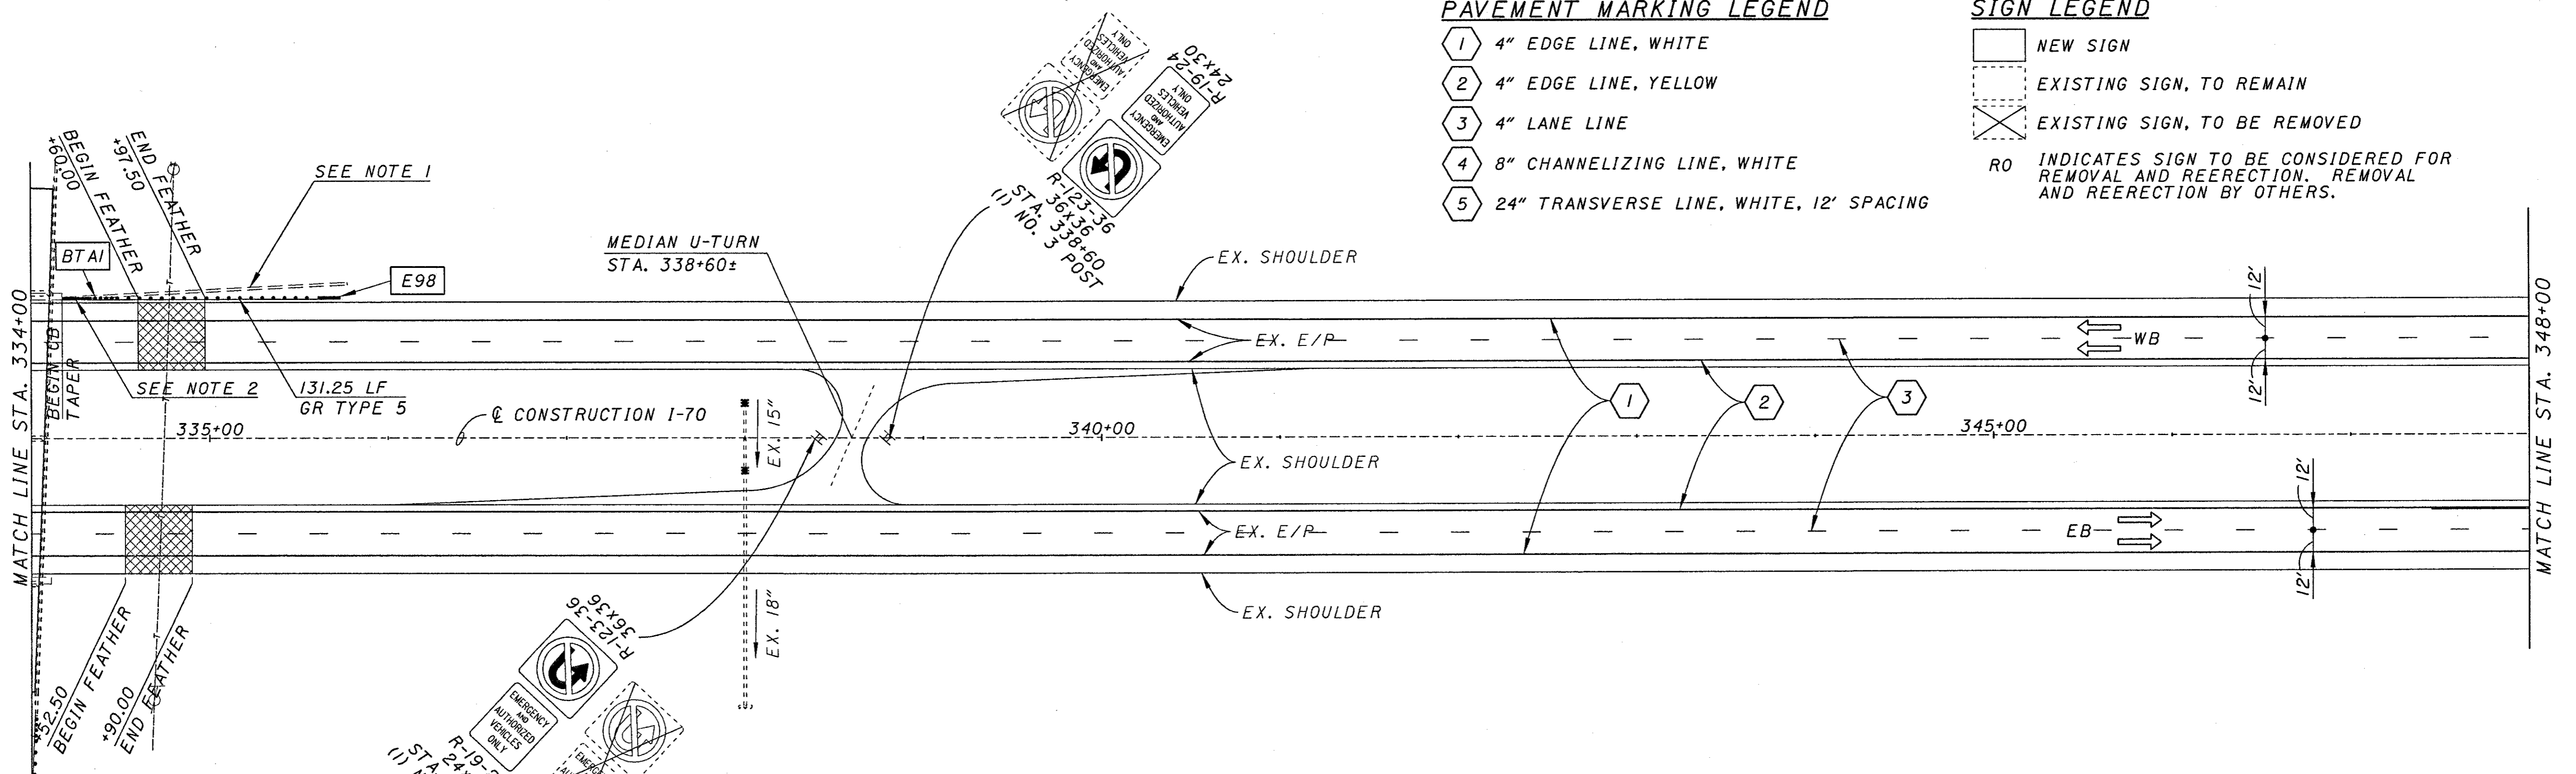



NOTES

- 1) REMOVE EXISTING CONCRETE BARRIER AT BEGIN/END OF TAPER. FILL VOID, REGRADE AND SEED & MULCH.
- 2) CONSTRUCT A NEW CONCRETE BARRIER TRANSITION AS PER STANDARD DRAWING RM-4.5M. SEAL WITH EPOXY URETHANE.
- 3) FOR CROSS ROAD INFORMATION, SEE SHEETS 116-122.
- 4) FOR OVERHEAD STRUCTURE INFORMATION, SEE SHEETS 260-283.
- 5) FOR FULL DEPTH PAVEMENT WIDENING INFORMATION, SEE SHEETS 49-115.
- 6) FOR MEDIAN U-TURN INFORMATION, SEE SHEET 125.

LEGEND

- PAVEMENT FEATHERING. SEE MISCELLANEOUS DETAILS SHEET 124. FOR FURTHER INFORMATION.
- FULL DEPTH PAVEMENT WIDENING, SEE TYPICAL SECTIONS FOR PAVEMENT MAKEUP.
- GUARDRAIL ANCHOR ASSEMBLY, TYPE E-98
- BRIDGE TERMINAL ASSEMBLY, TYPE I
- MC-4 MC-4 MASONRY COLLAR

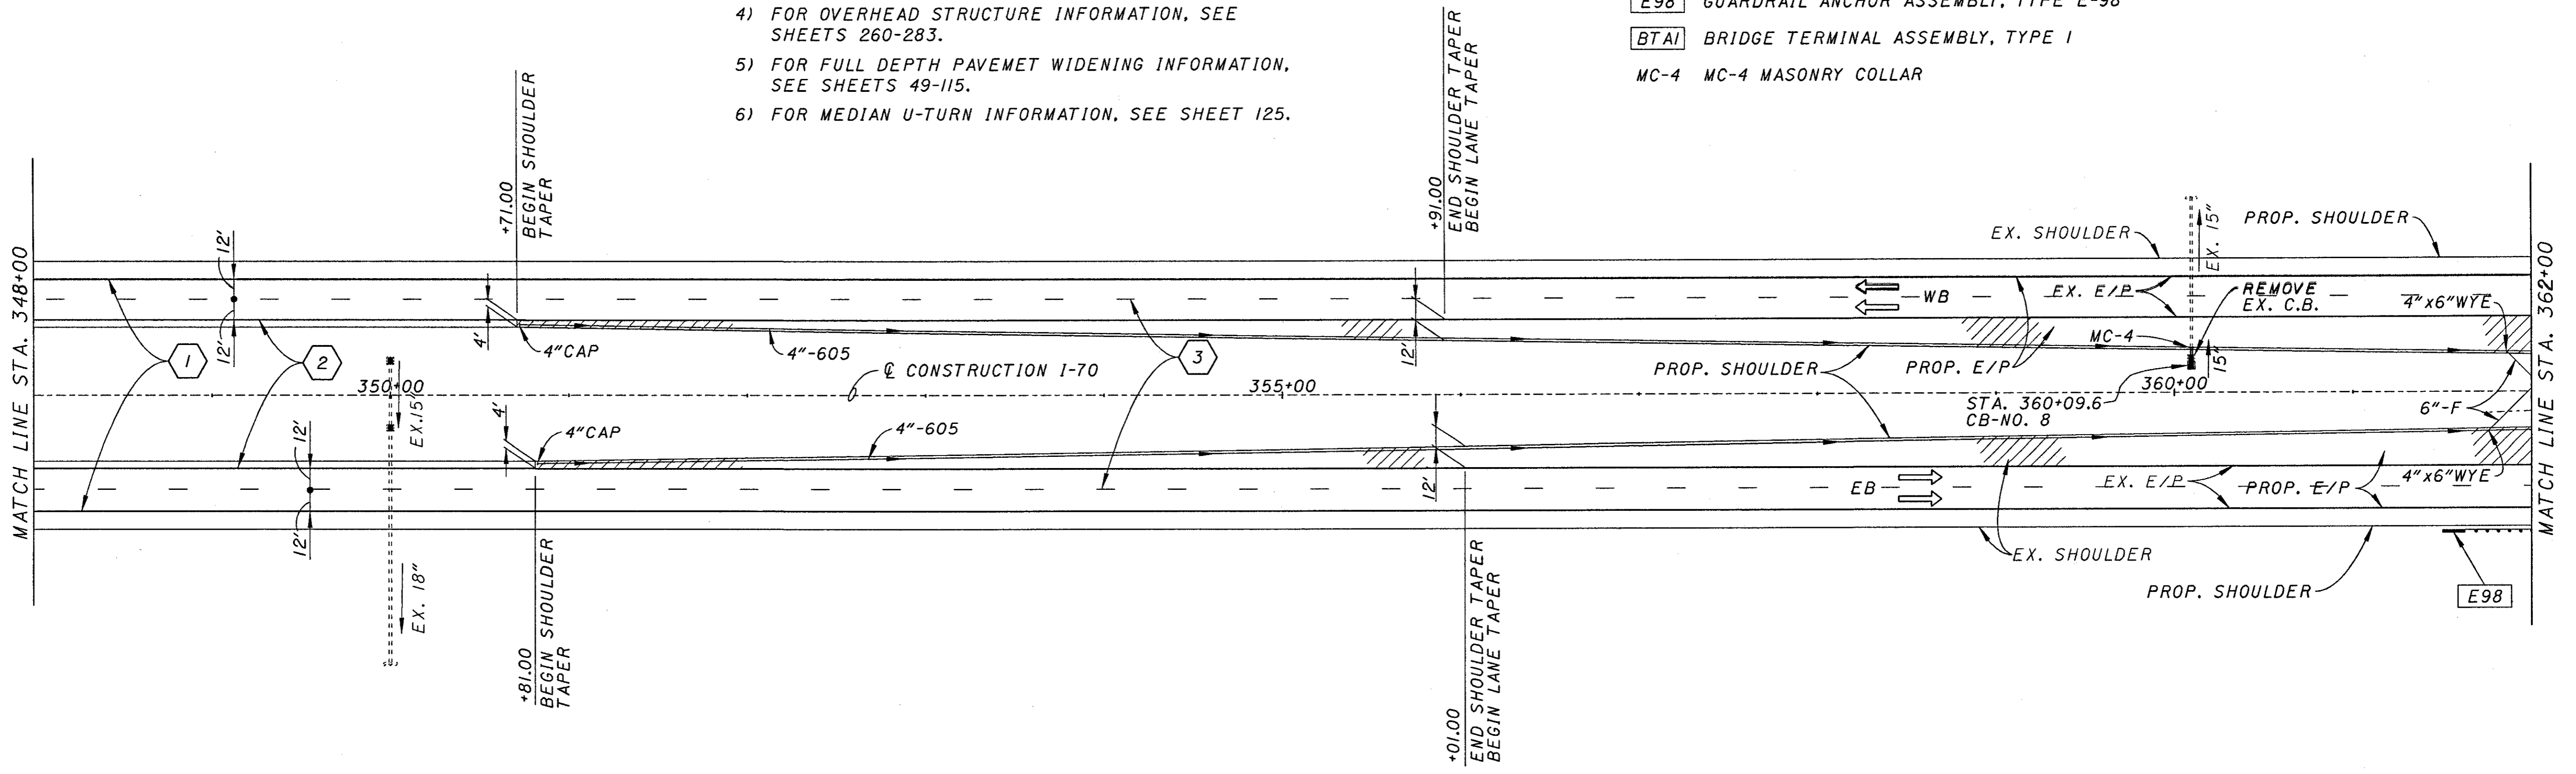


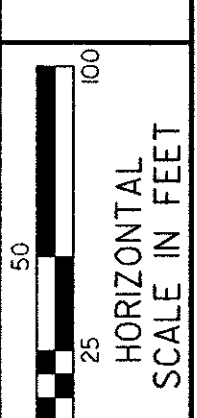

PLAN
STA. 362+00 TO STA. 390+00

PRE-70-0.00

KZF BRIDGE No. 8
BRIDGE No. PRE-70-0689 R/L
BANTAS FORK CREEK
STA. 364+36.00

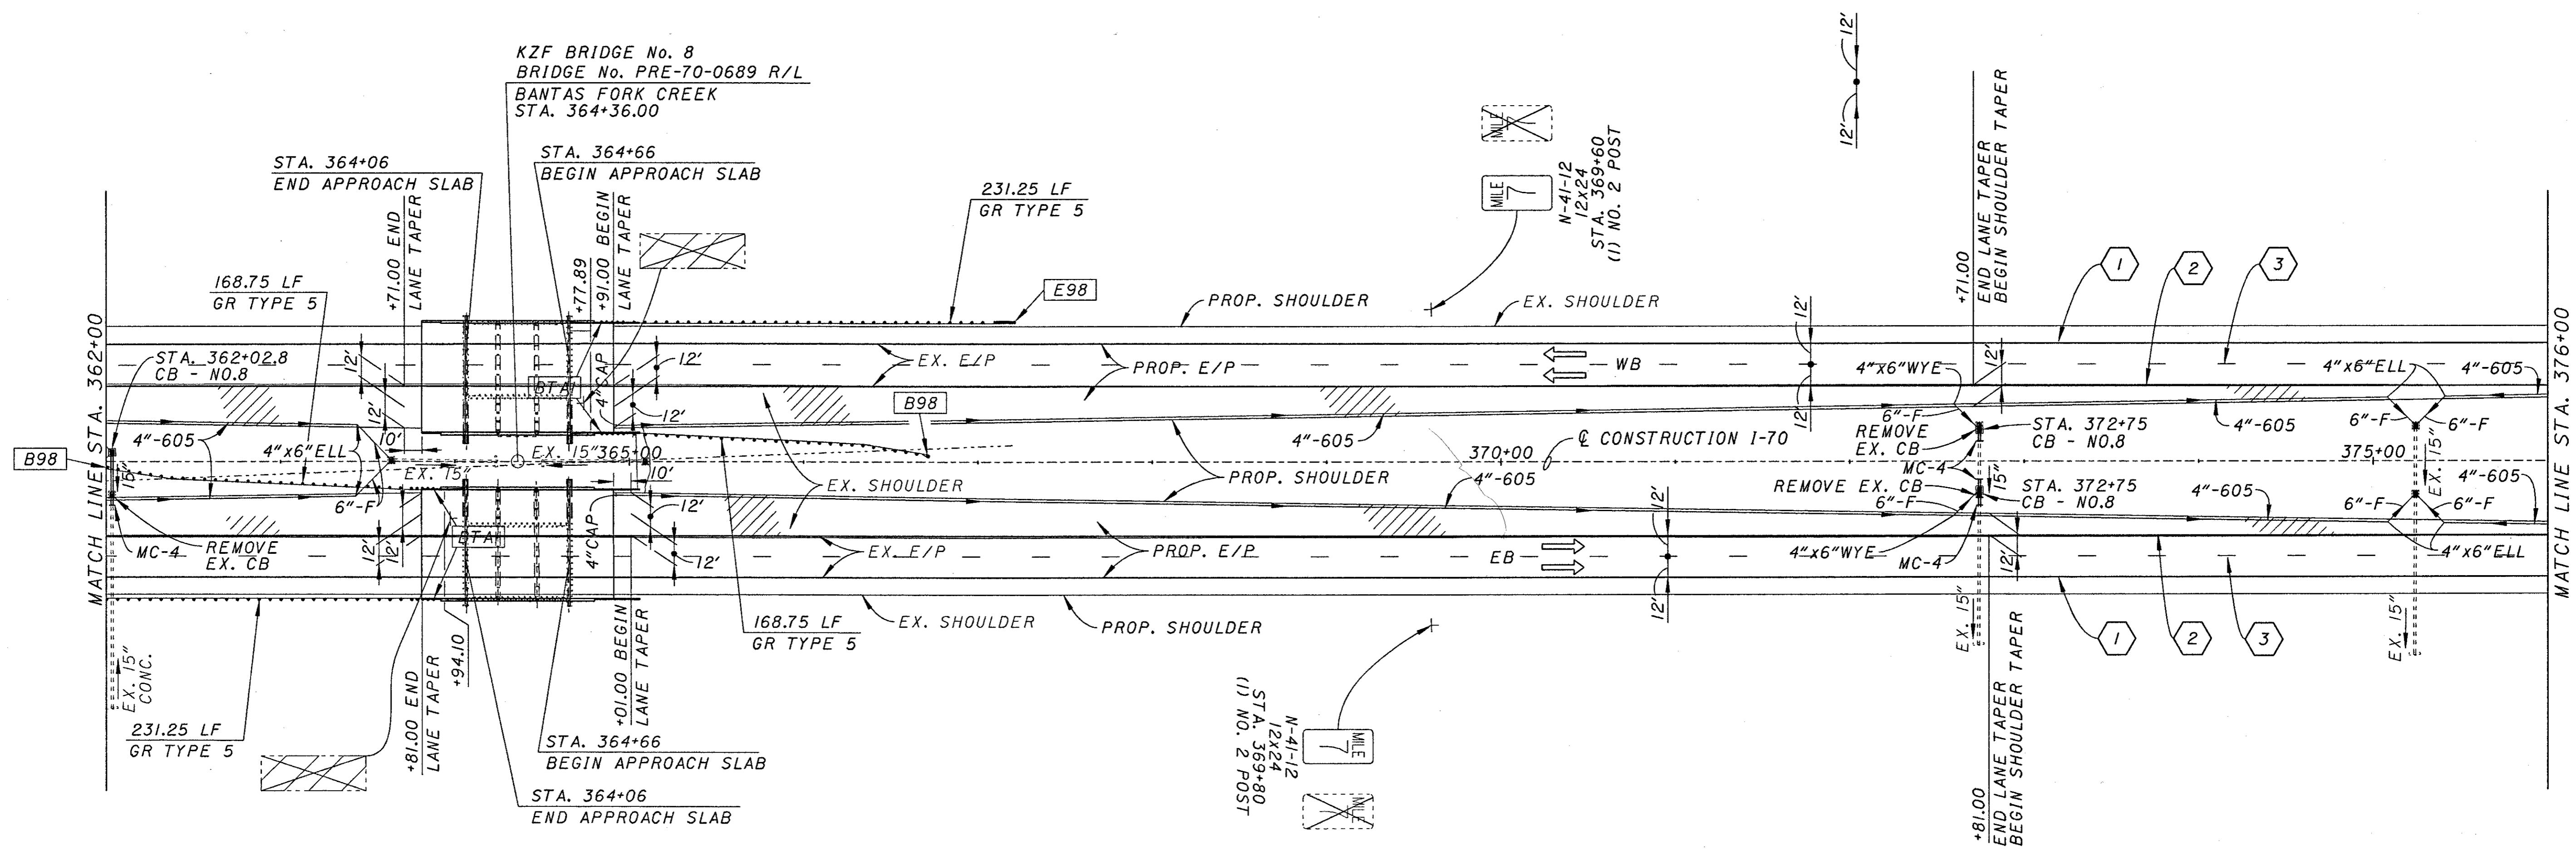

PAVEMENT MARKING LEGEND


- ① 4" EDGE LINE, WHITE
- ② 4" EDGE LINE, YELLOW
- ③ 4" LANE LINE
- ④ 8" CHANNELIZING LINE, WHITE
- ⑤ 24" TRANSVERSE LINE, WHITE, 12' SPACING

SIGN LEGEND

- NEW SIGN
- EXISTING SIGN, TO REMAIN
- EXISTING SIGN, TO BE REMOVED
- RO INDICATES SIGN TO BE CONSIDERED FOR REMOVAL AND REERECTION. REMOVAL AND REERECTION BY OTHERS.

LEGEND

- PAVEMENT FEATHERING. SEE MISCELLANEOUS DETAIL SHEET 124, FOR FURTHER INFORMATION.
- FULL DEPTH PAVEMENT WIDENING. SEE TYPICAL SECTIONS FOR PAVEMENT MAKEUP.
- B98 GUARDRAIL ANCHOR ASSEMBLY, TYPE B-98
- E98 GUARDRAIL ANCHOR ASSEMBLY, TYPE E-98
- BTAI BRIDGE TERMINAL ASSEMBLY, TYPE I
- MC-4 MC-4 MASONRY COLLAR

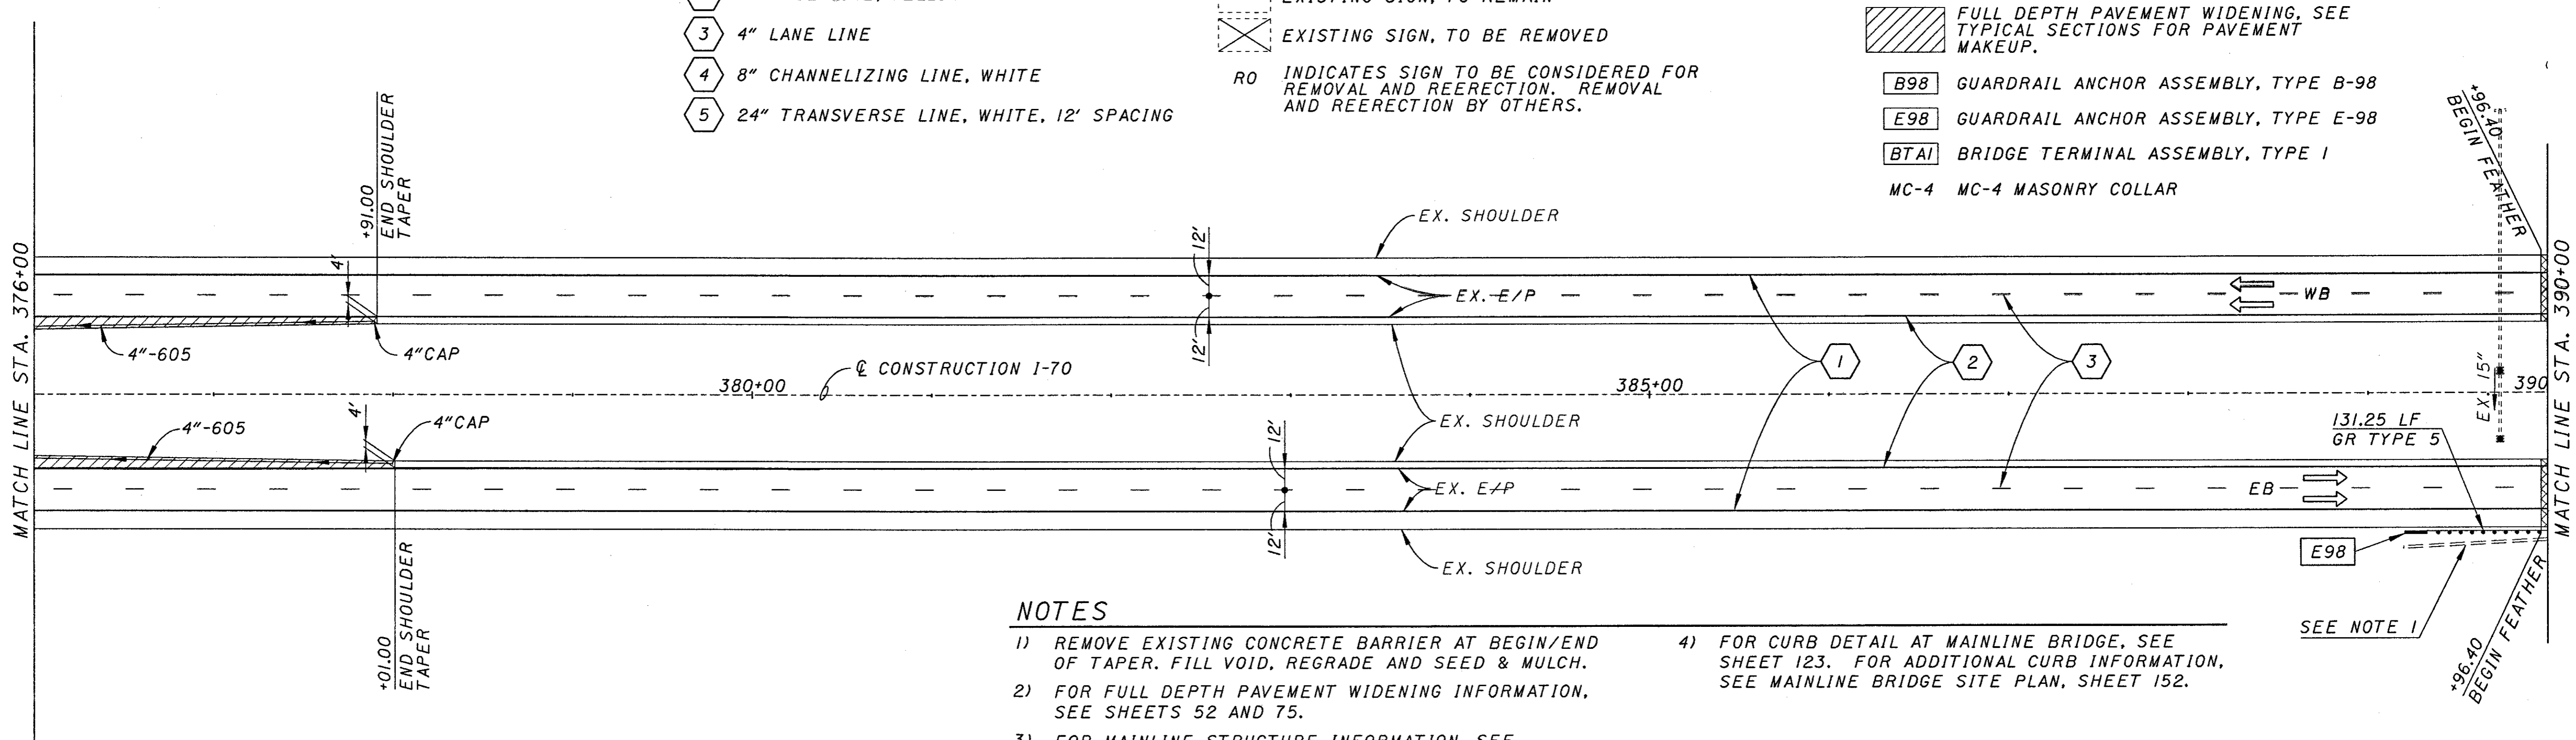


NOTES

- 1) REMOVE EXISTING CONCRETE BARRIER AT BEGIN/END OF TAPER. FILL VOID, REGRADE AND SEED & MULCH.
- 2) FOR FULL DEPTH PAVEMENT WIDENING INFORMATION, SEE SHEETS 52 AND 75.
- 3) FOR MAINLINE STRUCTURE INFORMATION, SEE SHEETS 134-259.
- 4) FOR CURB DETAIL AT MAINLINE BRIDGE, SEE SHEET 123. FOR ADDITIONAL CURB INFORMATION, SEE MAINLINE BRIDGE SITE PLAN, SHEET 152.

SEE NOTE 1

NOTES

- 1) REMOVE EXISTING CONCRETE BARRIER AT BEGIN/END OF TAPER. FILL VOID, REGRADE AND SEED & MULCH.
- 2) CONSTRUCT A NEW CONCRETE BARRIER TRANSITION AS PER STANDARD DRAWING RM-4.5M. SEAL WITH EPOXY URETHANE.
- 3) FOR CROSS ROAD INFORMATION, SEE SHEETS 116-122.
- 4) FOR OVERHEAD STRUCTURE INFORMATION, SEE SHEETS 260-283.

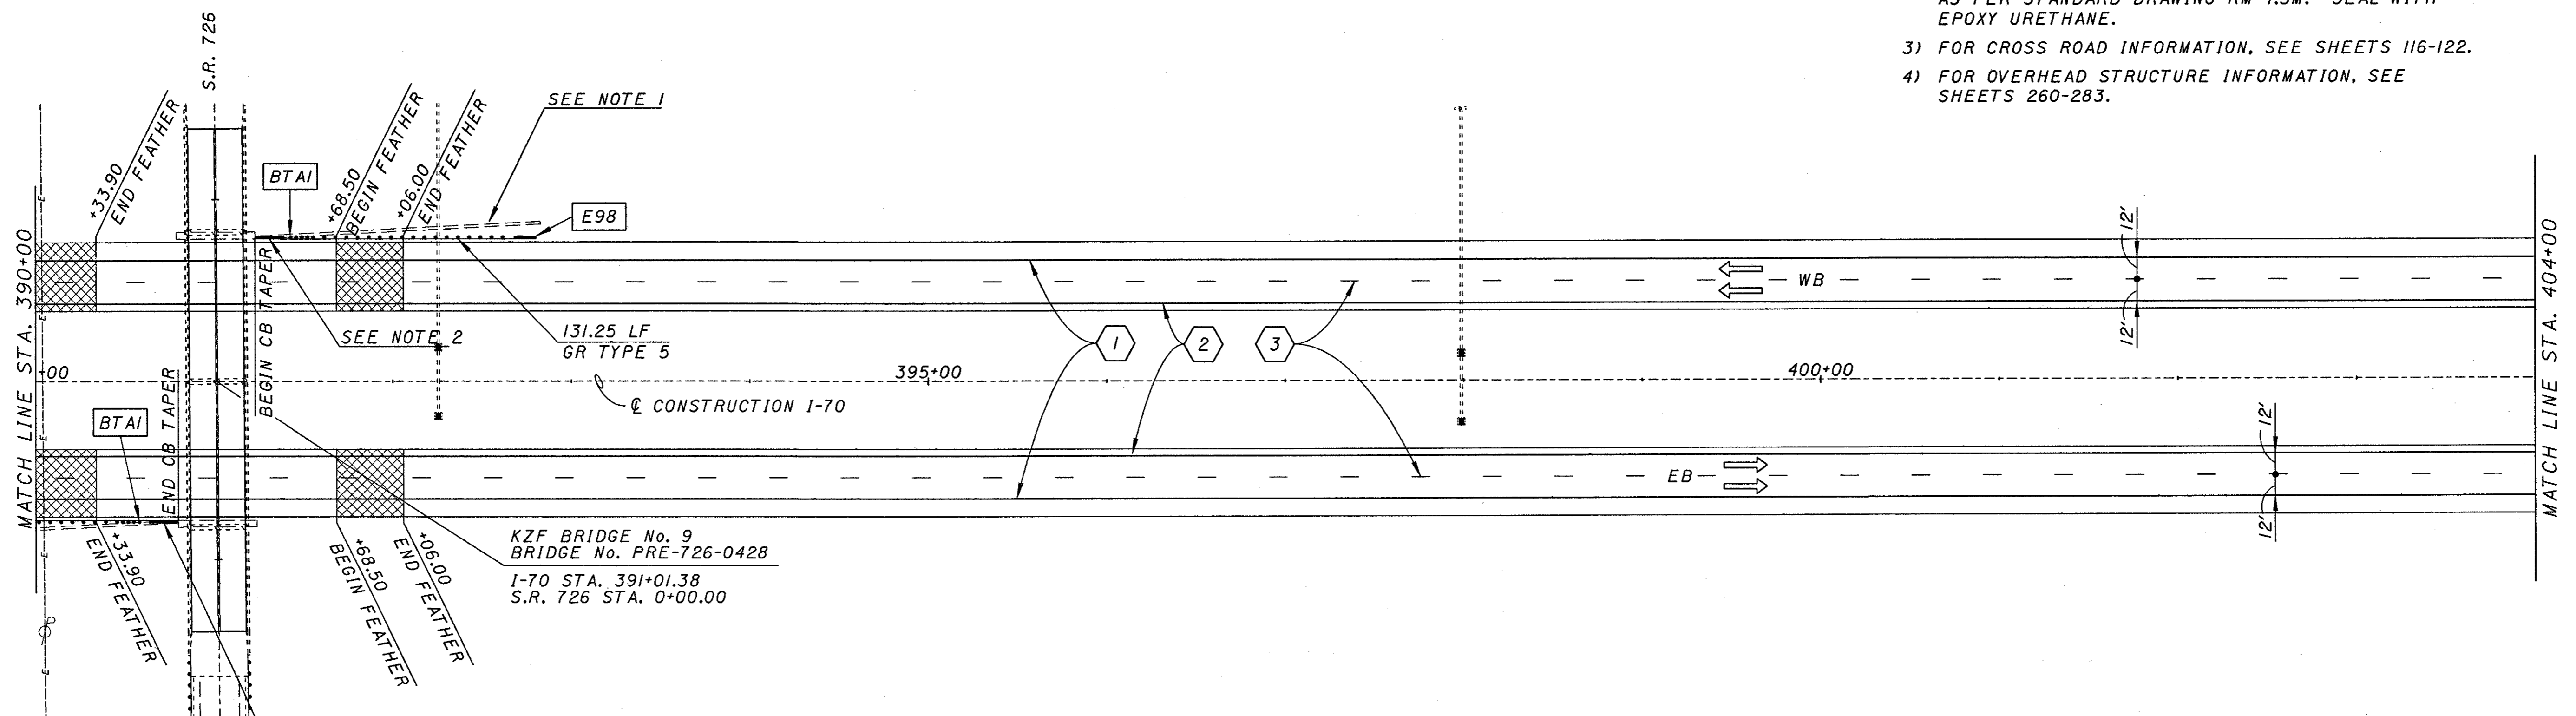

KZF BRIDGE No. 9
 BRIDGE No. PRE-726-0428
 I-70 STA. 391+01.38
 S.R. 726 STA. 0+00.00

LEGEND


- PAVEMENT FEATHERING. SEE MISCELLANEOUS DETAIL SHEET 124. FOR FURTHER INFORMATION.
- GUARDRAIL ANCHOR ASSEMBLY, TYPE E-98
- BRIDGE TERMINAL ASSEMBLY, TYPE I

PAVEMENT MARKING LEGEND

- 4" EDGE LINE, WHITE
- 4" EDGE LINE, YELLOW
- 4" LANE LINE
- 8" CHANNELIZING LINE, WHITE
- 24" TRANSVERSE LINE, WHITE, 12' SPACING


SIGN LEGEND

- NEW SIGN
- EXISTING SIGN, TO REMAIN
- EXISTING SIGN, TO BE REMOVED
- RO INDICATES SIGN TO BE CONSIDERED FOR REMOVAL AND REERECTION, REMOVAL AND REERECTION BY OTHERS.

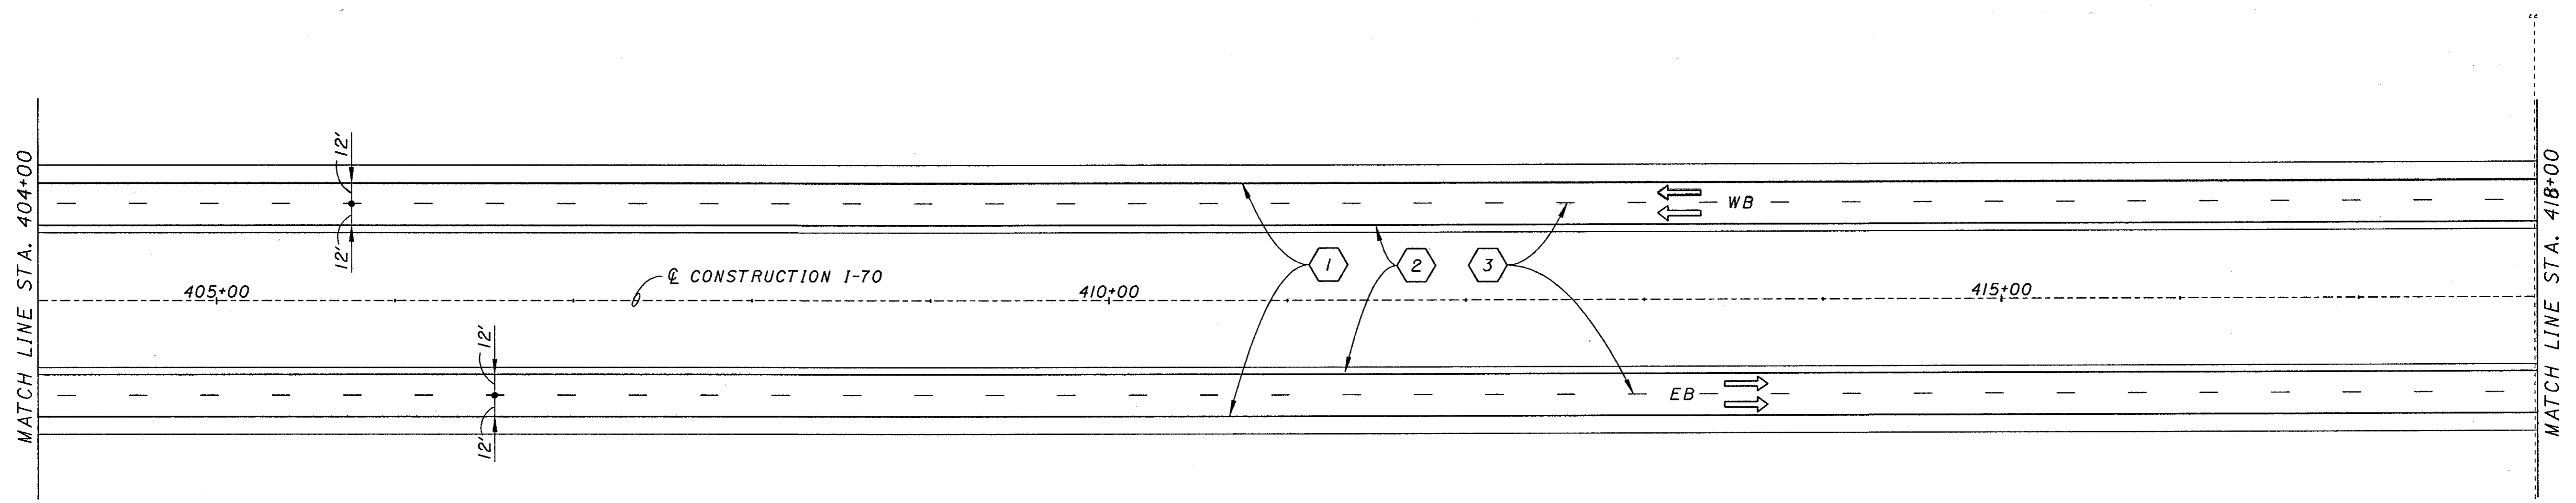

C:\WORK\PROJECTS\2004\11\11-11-04\11-11-04.DWG
 DATE: 11/11/04
 TIME: 11:11:11
 USER: JEFFREY
 PLOT: 11/11/04 11:11:11
 ACTIVE LEVELS ON: 11/11/04

 USER: *****
 PROJECT: *****
 DATE: *****
 ACTIVE LEVEL ON: *****

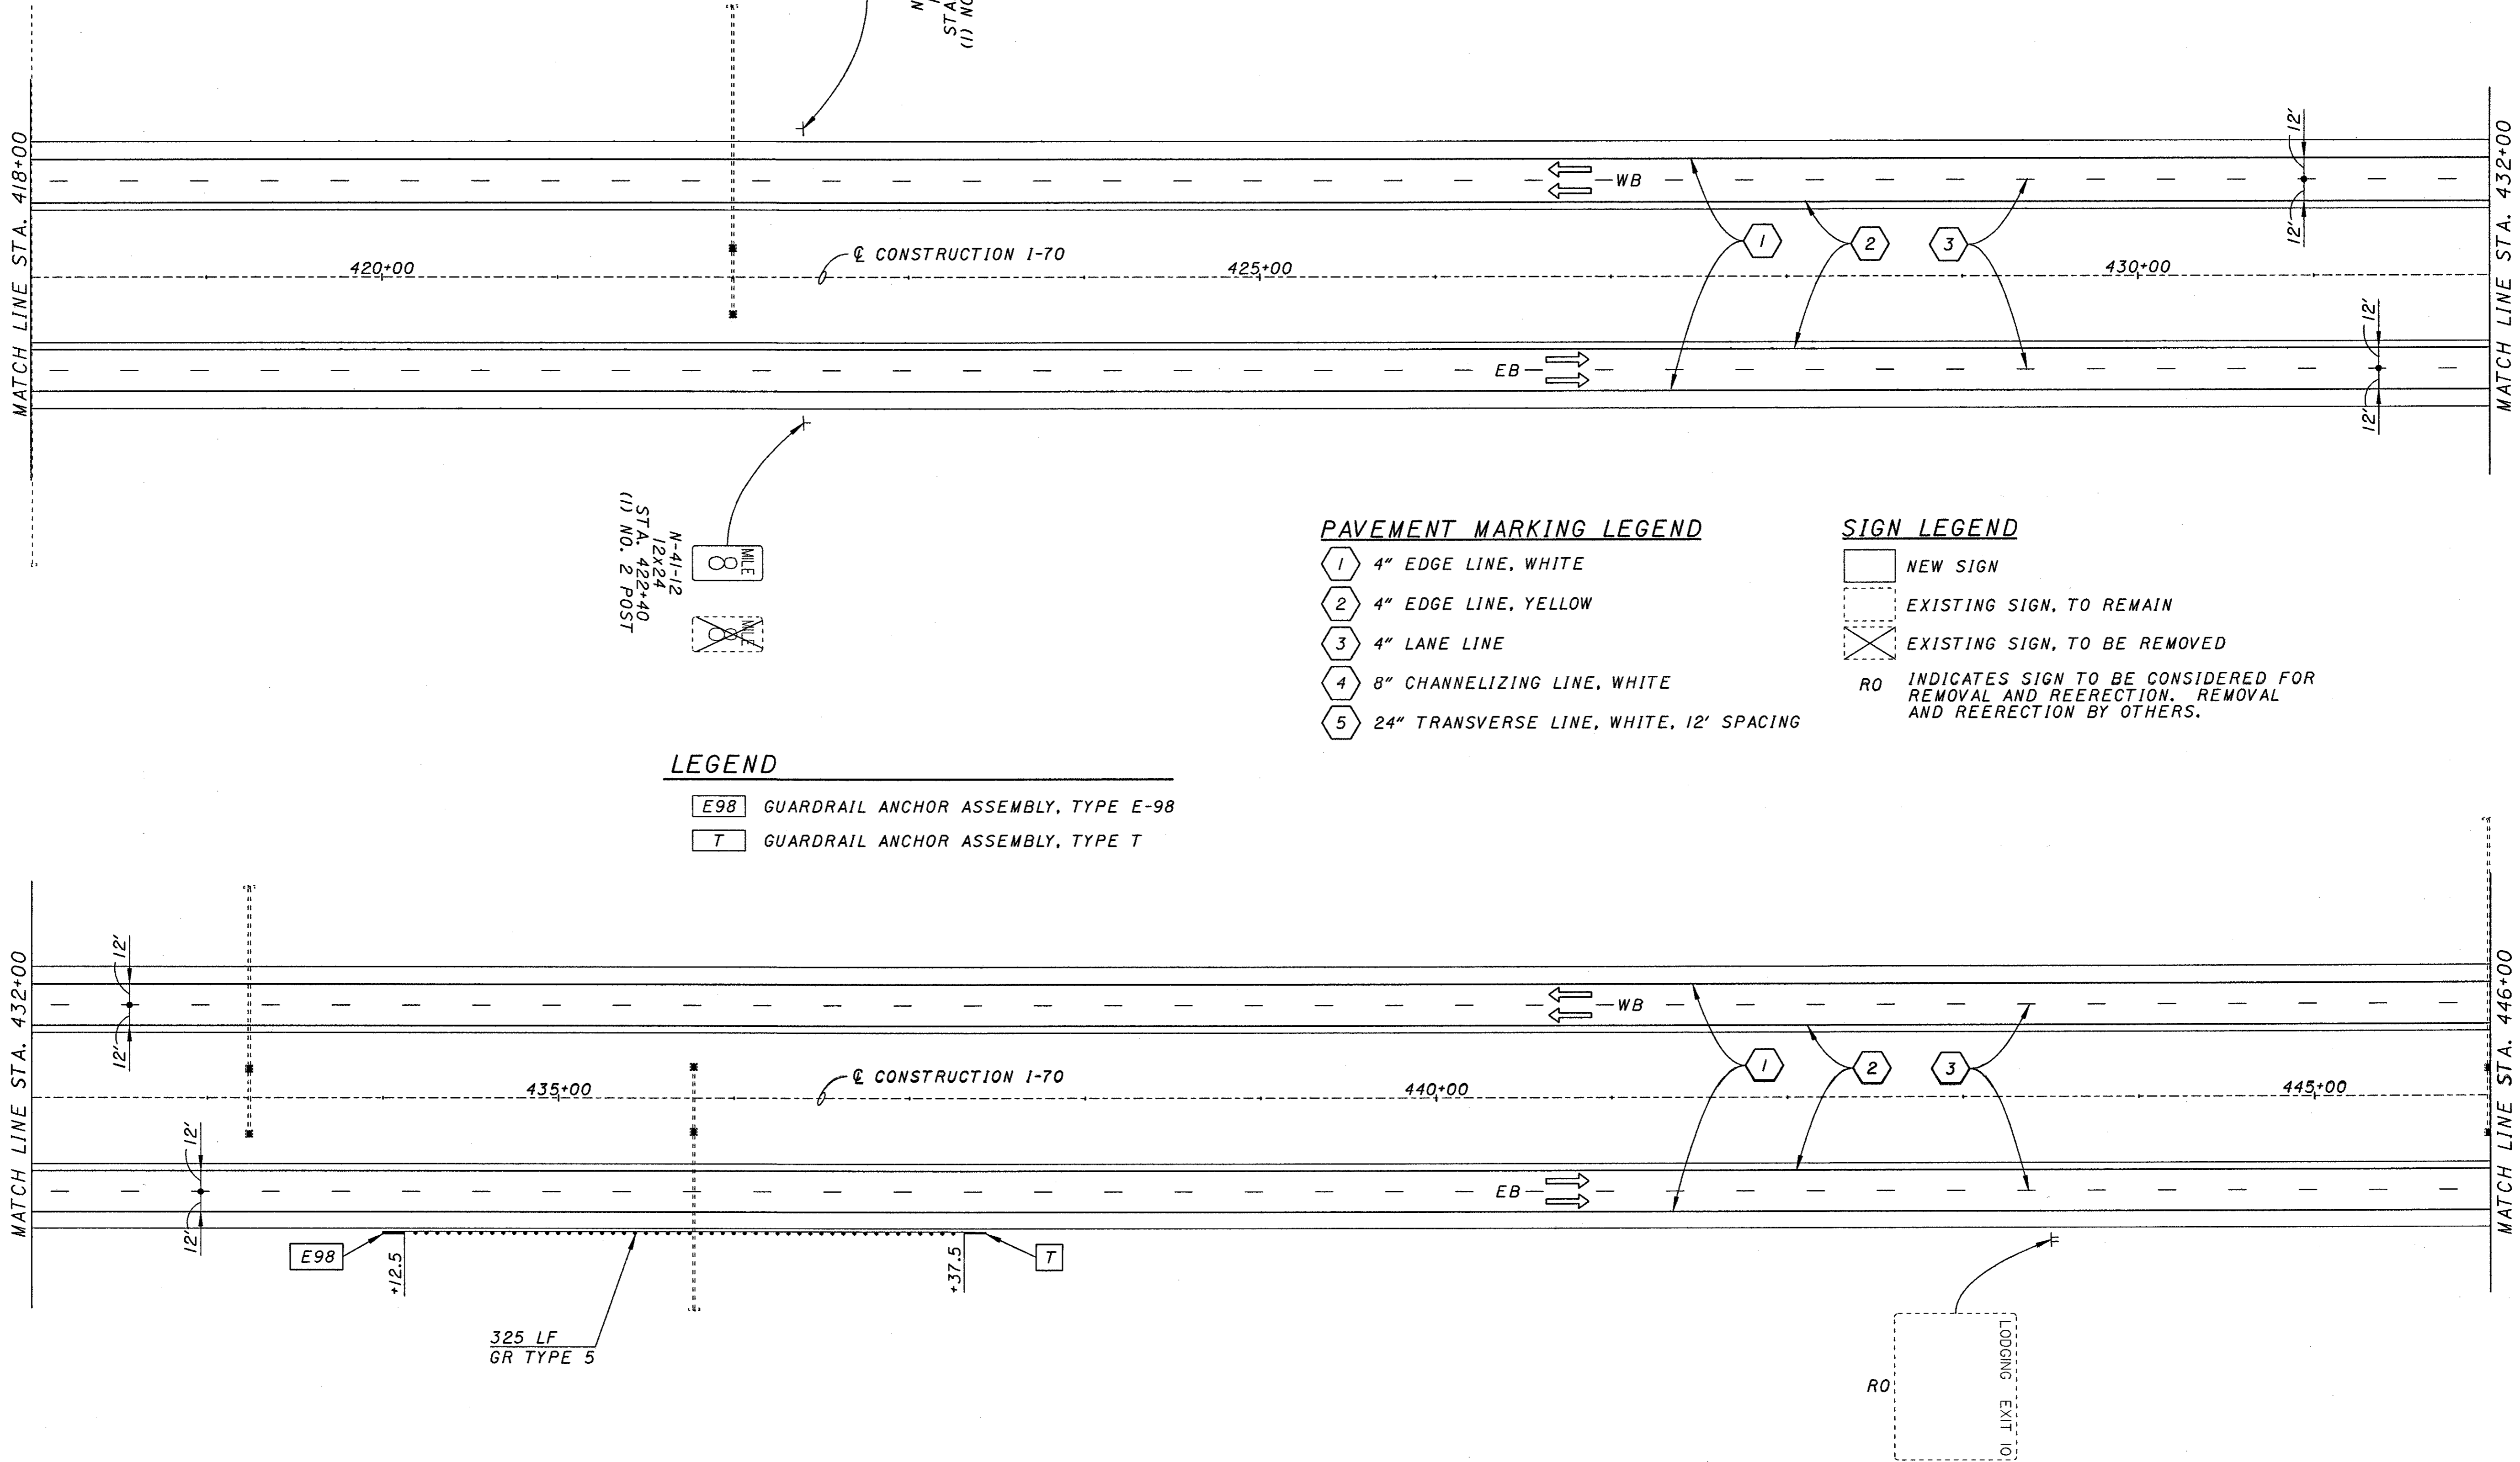

N-41-12
 STA. 422+40
 (1) NO. 2 POST

LEGEND


E98 GUARDRAIL ANCHOR ASSEMBLY, TYPE E-98
 T GUARDRAIL ANCHOR ASSEMBLY, TYPE T

PAVEMENT MARKING LEGEND

- 1 4" EDGE LINE, WHITE
- 2 4" EDGE LINE, YELLOW
- 3 4" LANE LINE
- 4 8" CHANNELIZING LINE, WHITE
- 5 24" TRANSVERSE LINE, WHITE, 12' SPACING


SIGN LEGEND

- NEW SIGN
- EXISTING SIGN, TO REMAIN
- EXISTING SIGN, TO BE REMOVED
- RO INDICATES SIGN TO BE CONSIDERED FOR REMOVAL AND REERECTION. REMOVAL AND REERECTION BY OTHERS.

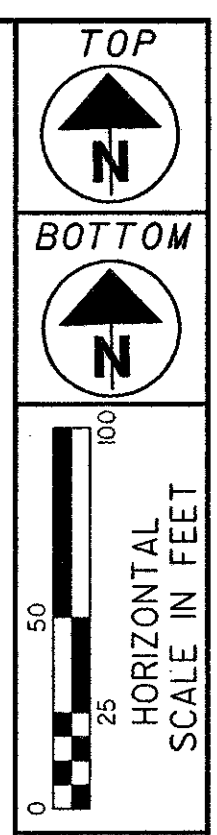

PLAN
STA. 418+00 TO STA. 446+00

PRE-70-0.00

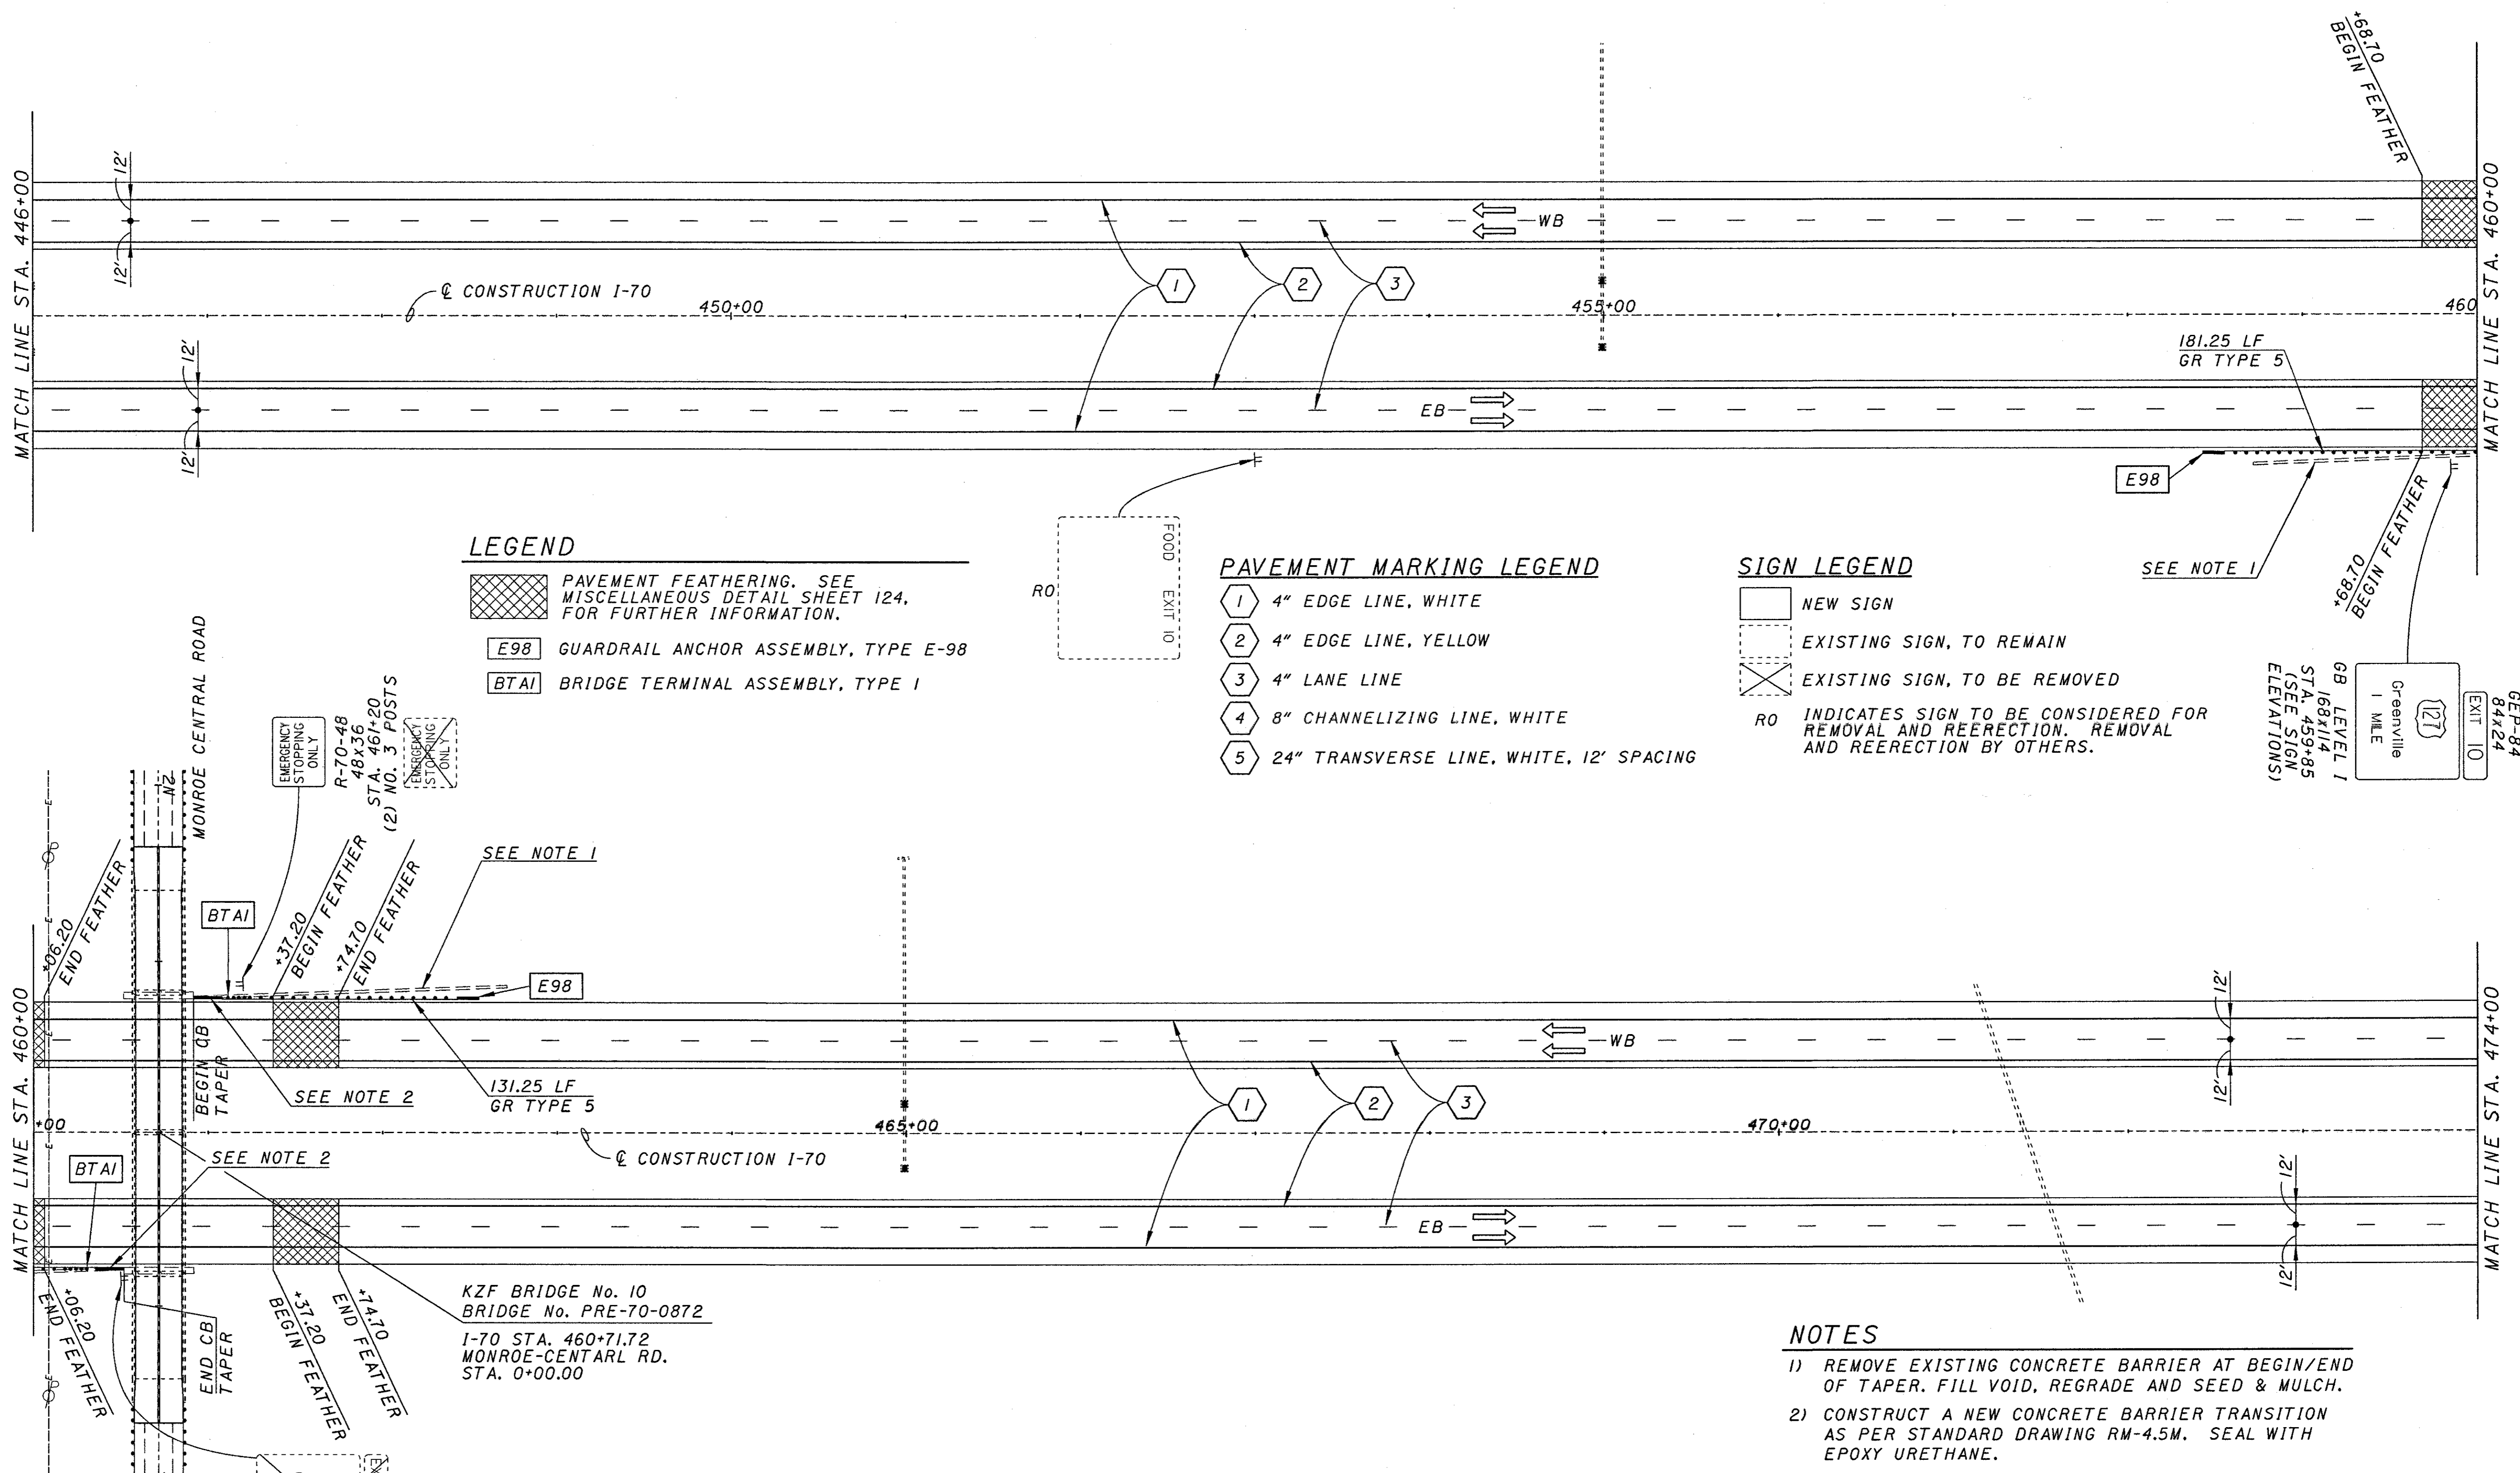

LEGEND

PAVEMENT FEATHERING. SEE MISCELLANEOUS DETAIL SHEET 124, FOR FURTHER INFORMATION.

E98 GUARDRAIL ANCHOR ASSEMBLY, TYPE E-98

BTAI BRIDGE TERMINAL ASSEMBLY, TYPE I

PAVEMENT MARKING LEGEND

4" EDGE LINE, WHITE

4" EDGE LINE, YELLOW

4" LANE LINE

8" CHANNELIZING LINE, WHITE

24" TRANSVERSE LINE, WHITE, 12' SPACING

SIGN LEGEND

NEW SIGN

EXISTING SIGN, TO REMAIN


EXISTING SIGN, TO BE REMOVED

RO INDICATES SIGN TO BE CONSIDERED FOR REMOVAL AND REERECTION. REMOVAL AND REERECTION BY OTHERS.

GP-84
84x24
EXIT 10
Greenville
1 MILE
127
GB LEVEL 1
168x114
STA. 459+85
(SEE SIGN ELEVATIONS)

- NOTES**
- 1) REMOVE EXISTING CONCRETE BARRIER AT BEGIN/END OF TAPER. FILL VOID, REGRADE AND SEED & MULCH.
 - 2) CONSTRUCT A NEW CONCRETE BARRIER TRANSITION AS PER STANDARD DRAWING RM-4.5M. SEAL WITH EPOXY URETHANE.
 - 3) FOR CROSS ROAD INFORMATION, SEE SHEETS 116-122.
 - 4) FOR OVERHEAD STRUCTURE INFORMATION, SEE SHEETS 260-283.
 - 5) FOR SIGN ELEVATIONS, SEE SHEETS 127-128.

 USER'S MANUAL
 PREPARED BY THE
 ACTIVE LEVELS ON: 8/1/88

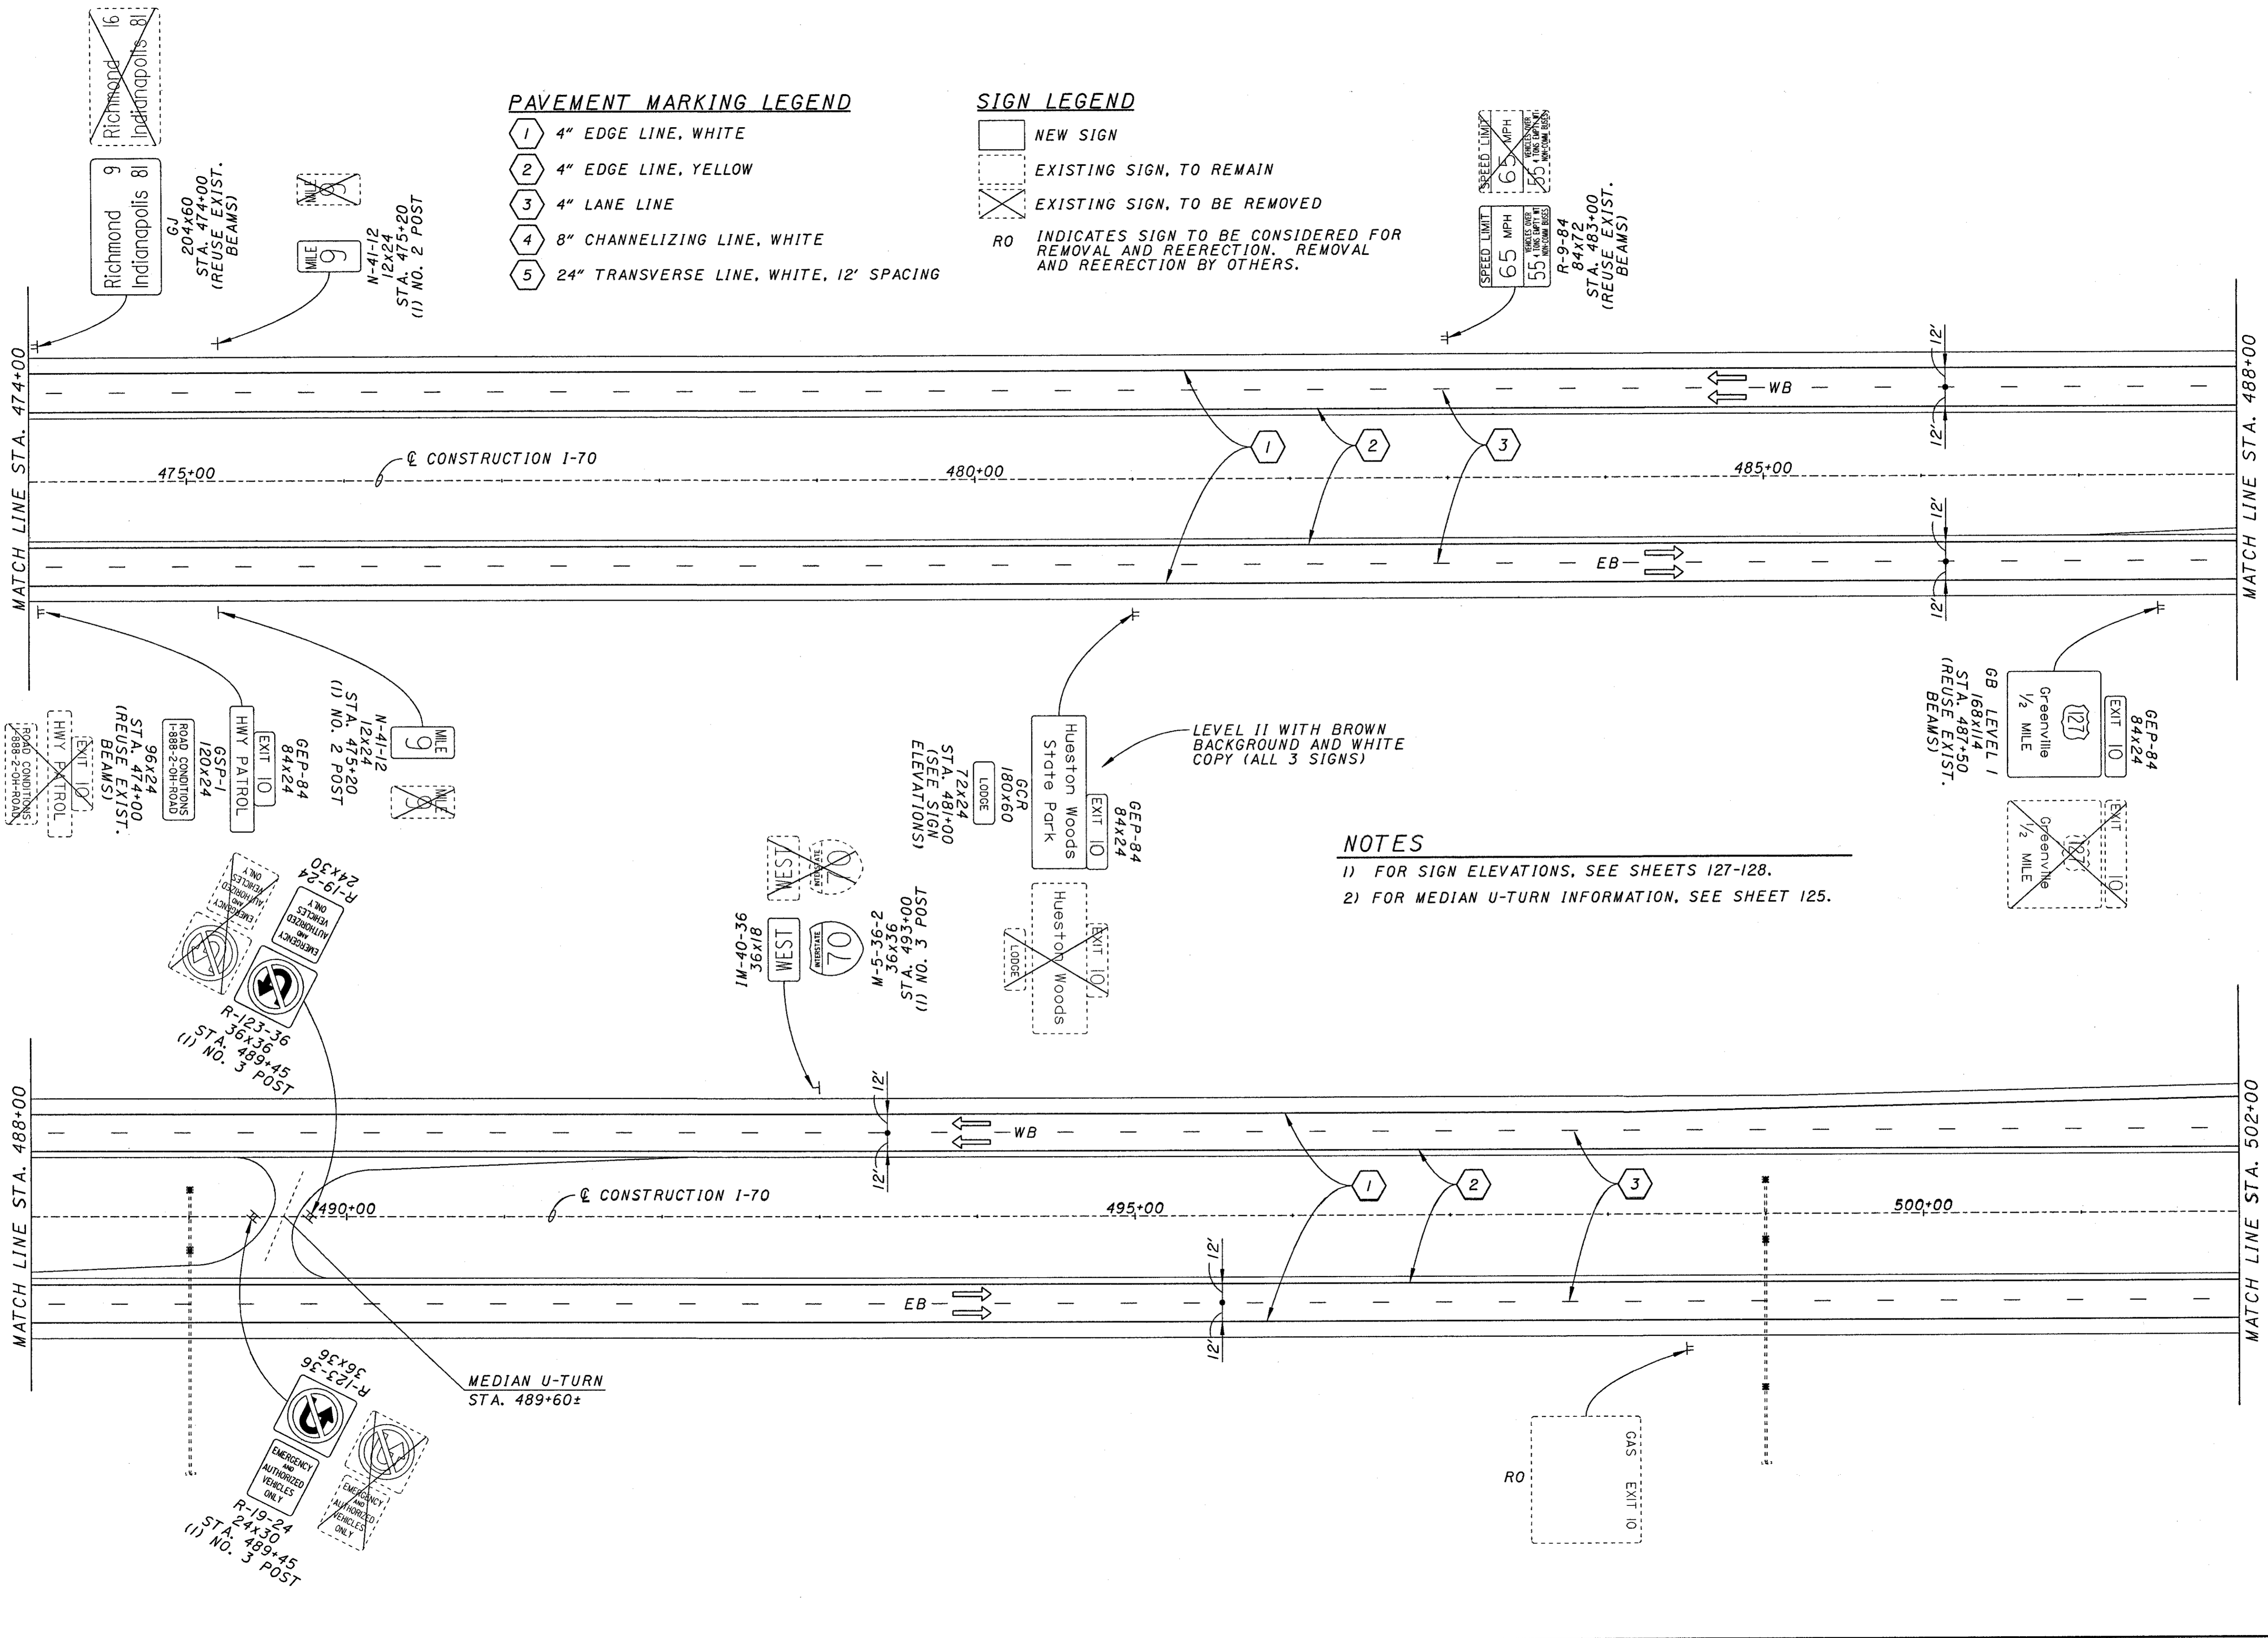

PAVEMENT MARKING LEGEND


- 1 4" EDGE LINE, WHITE
- 2 4" EDGE LINE, YELLOW
- 3 4" LANE LINE
- 4 8" CHANNELIZING LINE, WHITE
- 5 24" TRANSVERSE LINE, WHITE, 12' SPACING

SIGN LEGEND

- NEW SIGN
- EXISTING SIGN, TO REMAIN
- EXISTING SIGN, TO BE REMOVED
- RO INDICATES SIGN TO BE CONSIDERED FOR REMOVAL AND REERECTION. REMOVAL AND REERECTION BY OTHERS.

NOTES


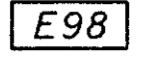
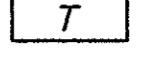

- 1) FOR SIGN ELEVATIONS, SEE SHEETS 127-128.
- 2) FOR MEDIAN U-TURN INFORMATION, SEE SHEET 125.

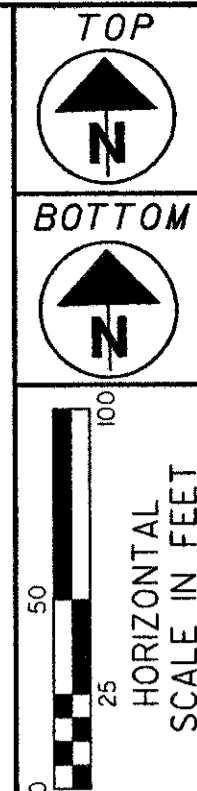


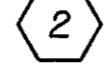
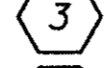

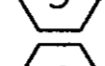

PLAN
STA. 474+00 TO STA. 502+00

PRE-70-0.00


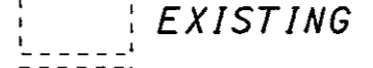
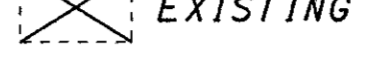

LEGEND


-  PAVEMENT FEATHERING. SEE MISCELLANEOUS DETAIL SHEET 124, FOR FURTHER INFORMATION.
-  GUARDRAIL ANCHOR ASSEMBLY, TYPE E-98
-  GUARDRAIL ANCHOR ASSEMBLY, TYPE T
-  BRIDGE TERMINAL ASSEMBLY, TYPE I

PAVEMENT MARKING LEGEND

-  4" EDGE LINE, WHITE
-  4" EDGE LINE, YELLOW
-  4" LANE LINE
-  8" CHANNELIZING LINE, WHITE
-  24" TRANSVERSE LINE, WHITE, 12' SPACING
-  CENTER LINE, SOLID DOUBLE


SIGN LEGEND

-  NEW SIGN
-  EXISTING SIGN, TO REMAIN
-  EXISTING SIGN, TO BE REMOVED
-  RO INDICATES SIGN TO BE CONSIDERED FOR REMOVAL AND REERECTION. REMOVAL AND REERECTION BY OTHERS.

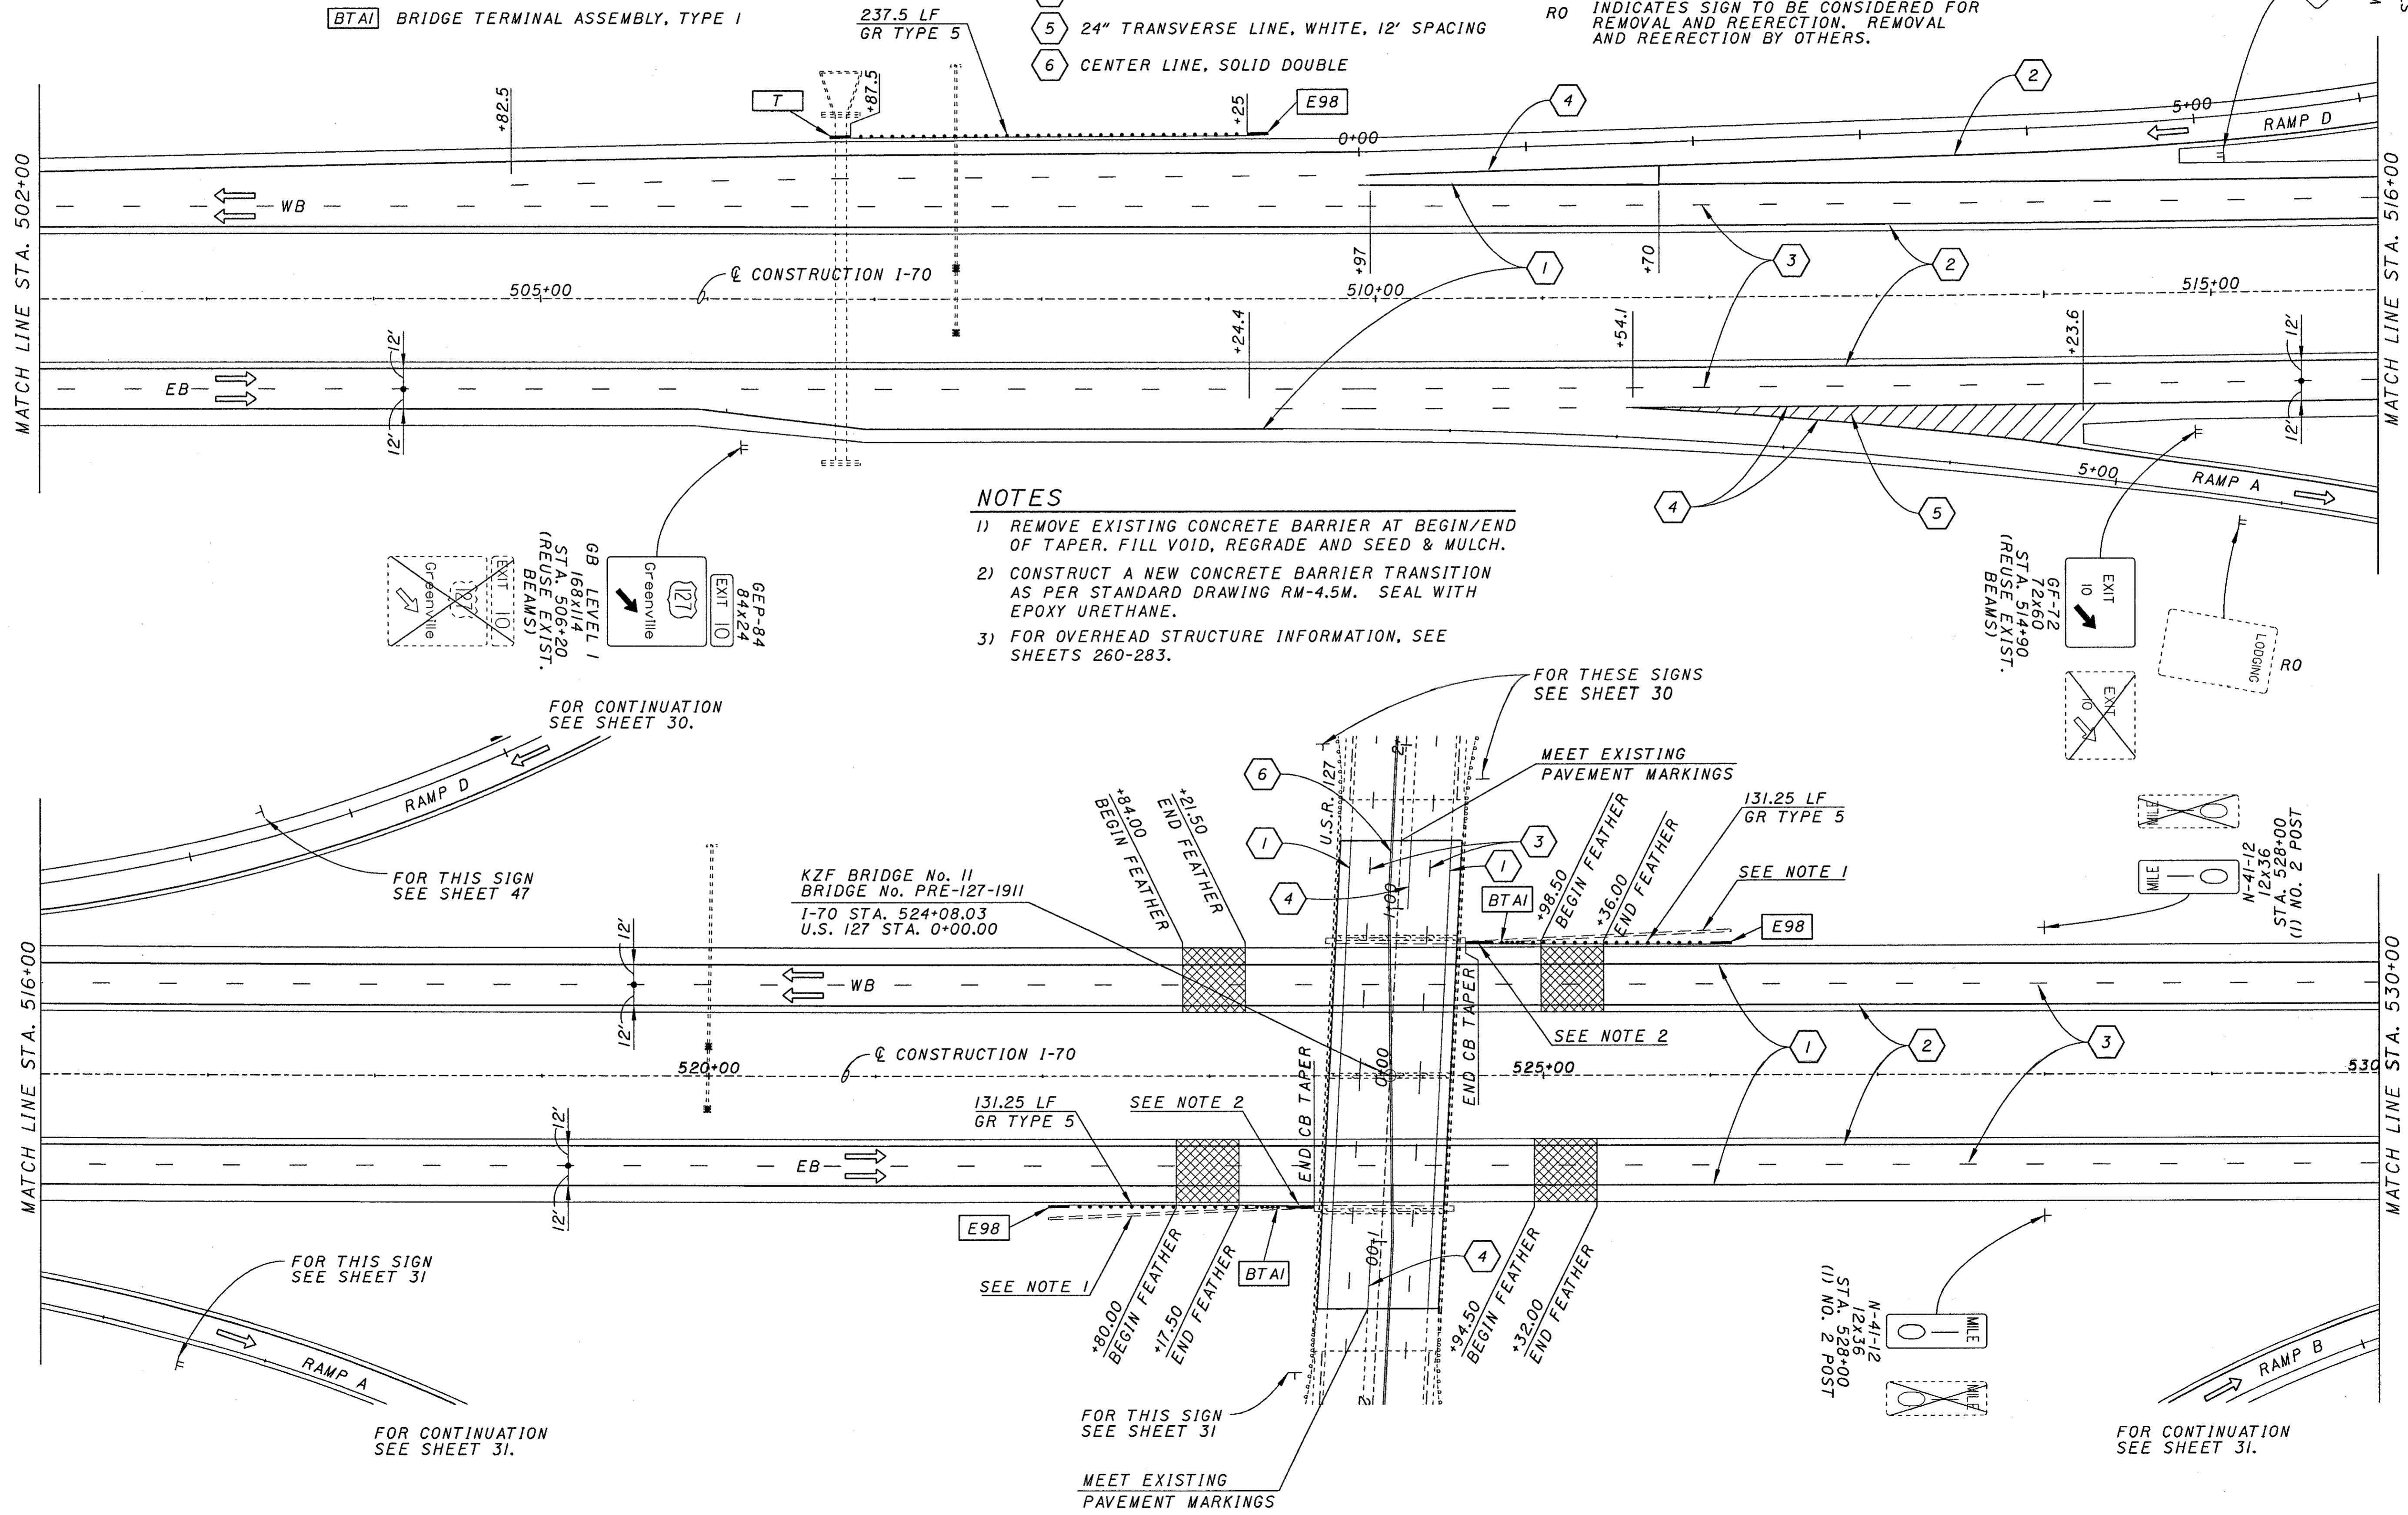

NOTES


- 1) REMOVE EXISTING CONCRETE BARRIER AT BEGIN/END OF TAPER. FILL VOID, REGRADE AND SEED & MULCH.
- 2) CONSTRUCT A NEW CONCRETE BARRIER TRANSITION AS PER STANDARD DRAWING RM-4.5M. SEAL WITH EPOXY URETHANE.
- 3) FOR OVERHEAD STRUCTURE INFORMATION, SEE SHEETS 260-283.

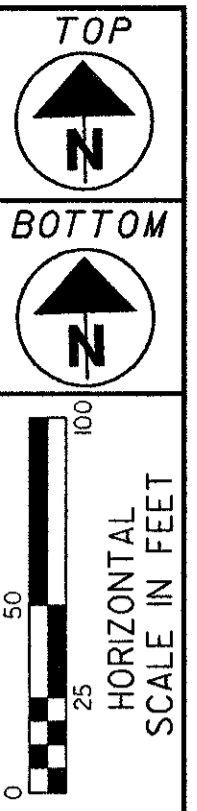


PLAN
STA. 502+00 TO STA. 530+00

PRE-70-0.00


REVISIONS:
 USER: SAUL W. WILSON
 DATE: 08/14/00
 DESCRIPTION: REVISIONS TO SHEET PRE-70-0.00
 ACTIVE LEVELS ON: 84LEVA8

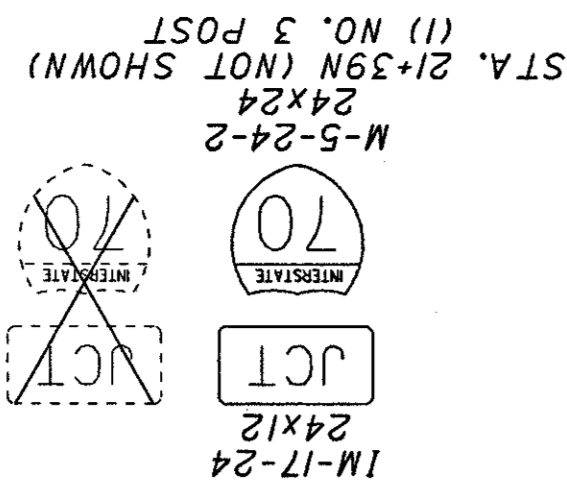


SIGN LEGEND

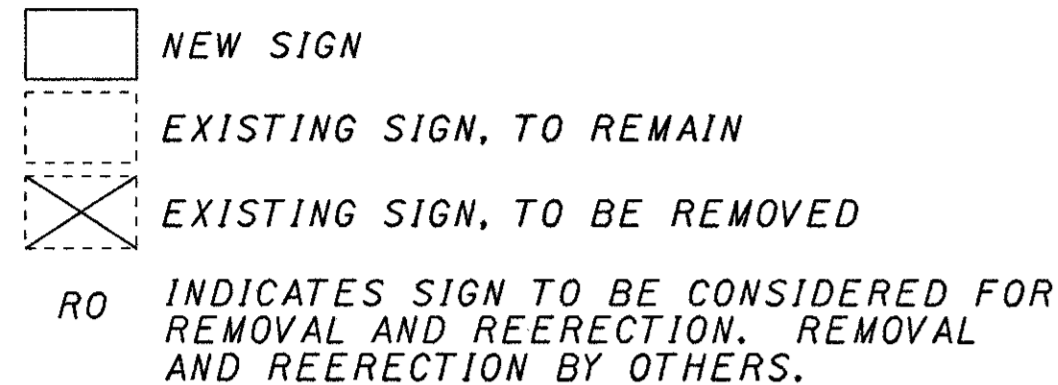

PAVEMENT MARKING LEGEND

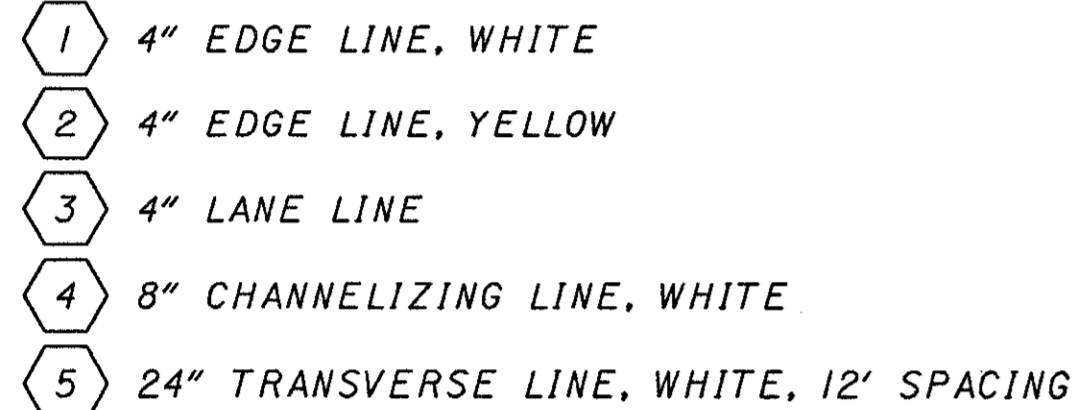


LEGEND

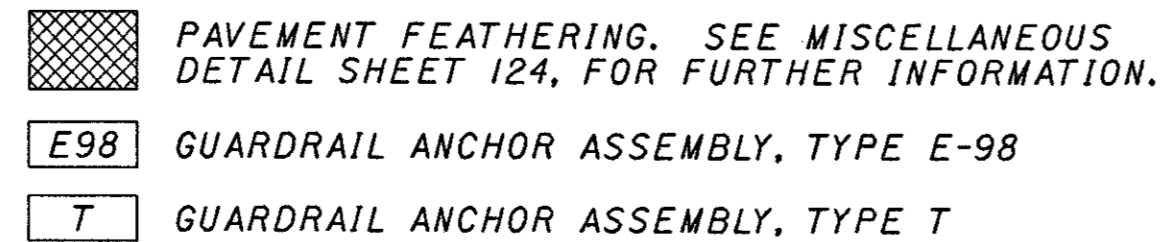

NOTES


- 1) SPLICE NEW GUARDRAIL AT THE NEAREST GUARDRAIL JOINT.
- 2) FOR SIGNING ELEVATIONS, SEE 127-128.



FOR CONTINUATION SEE SHEET 31.

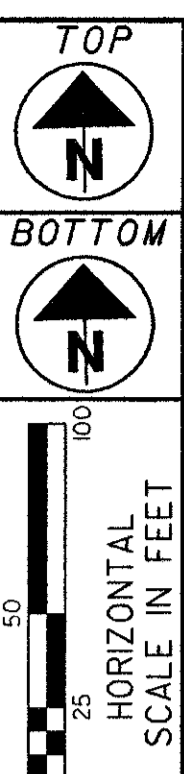

PLAN

STA. 502+00 TO STA. 530+00

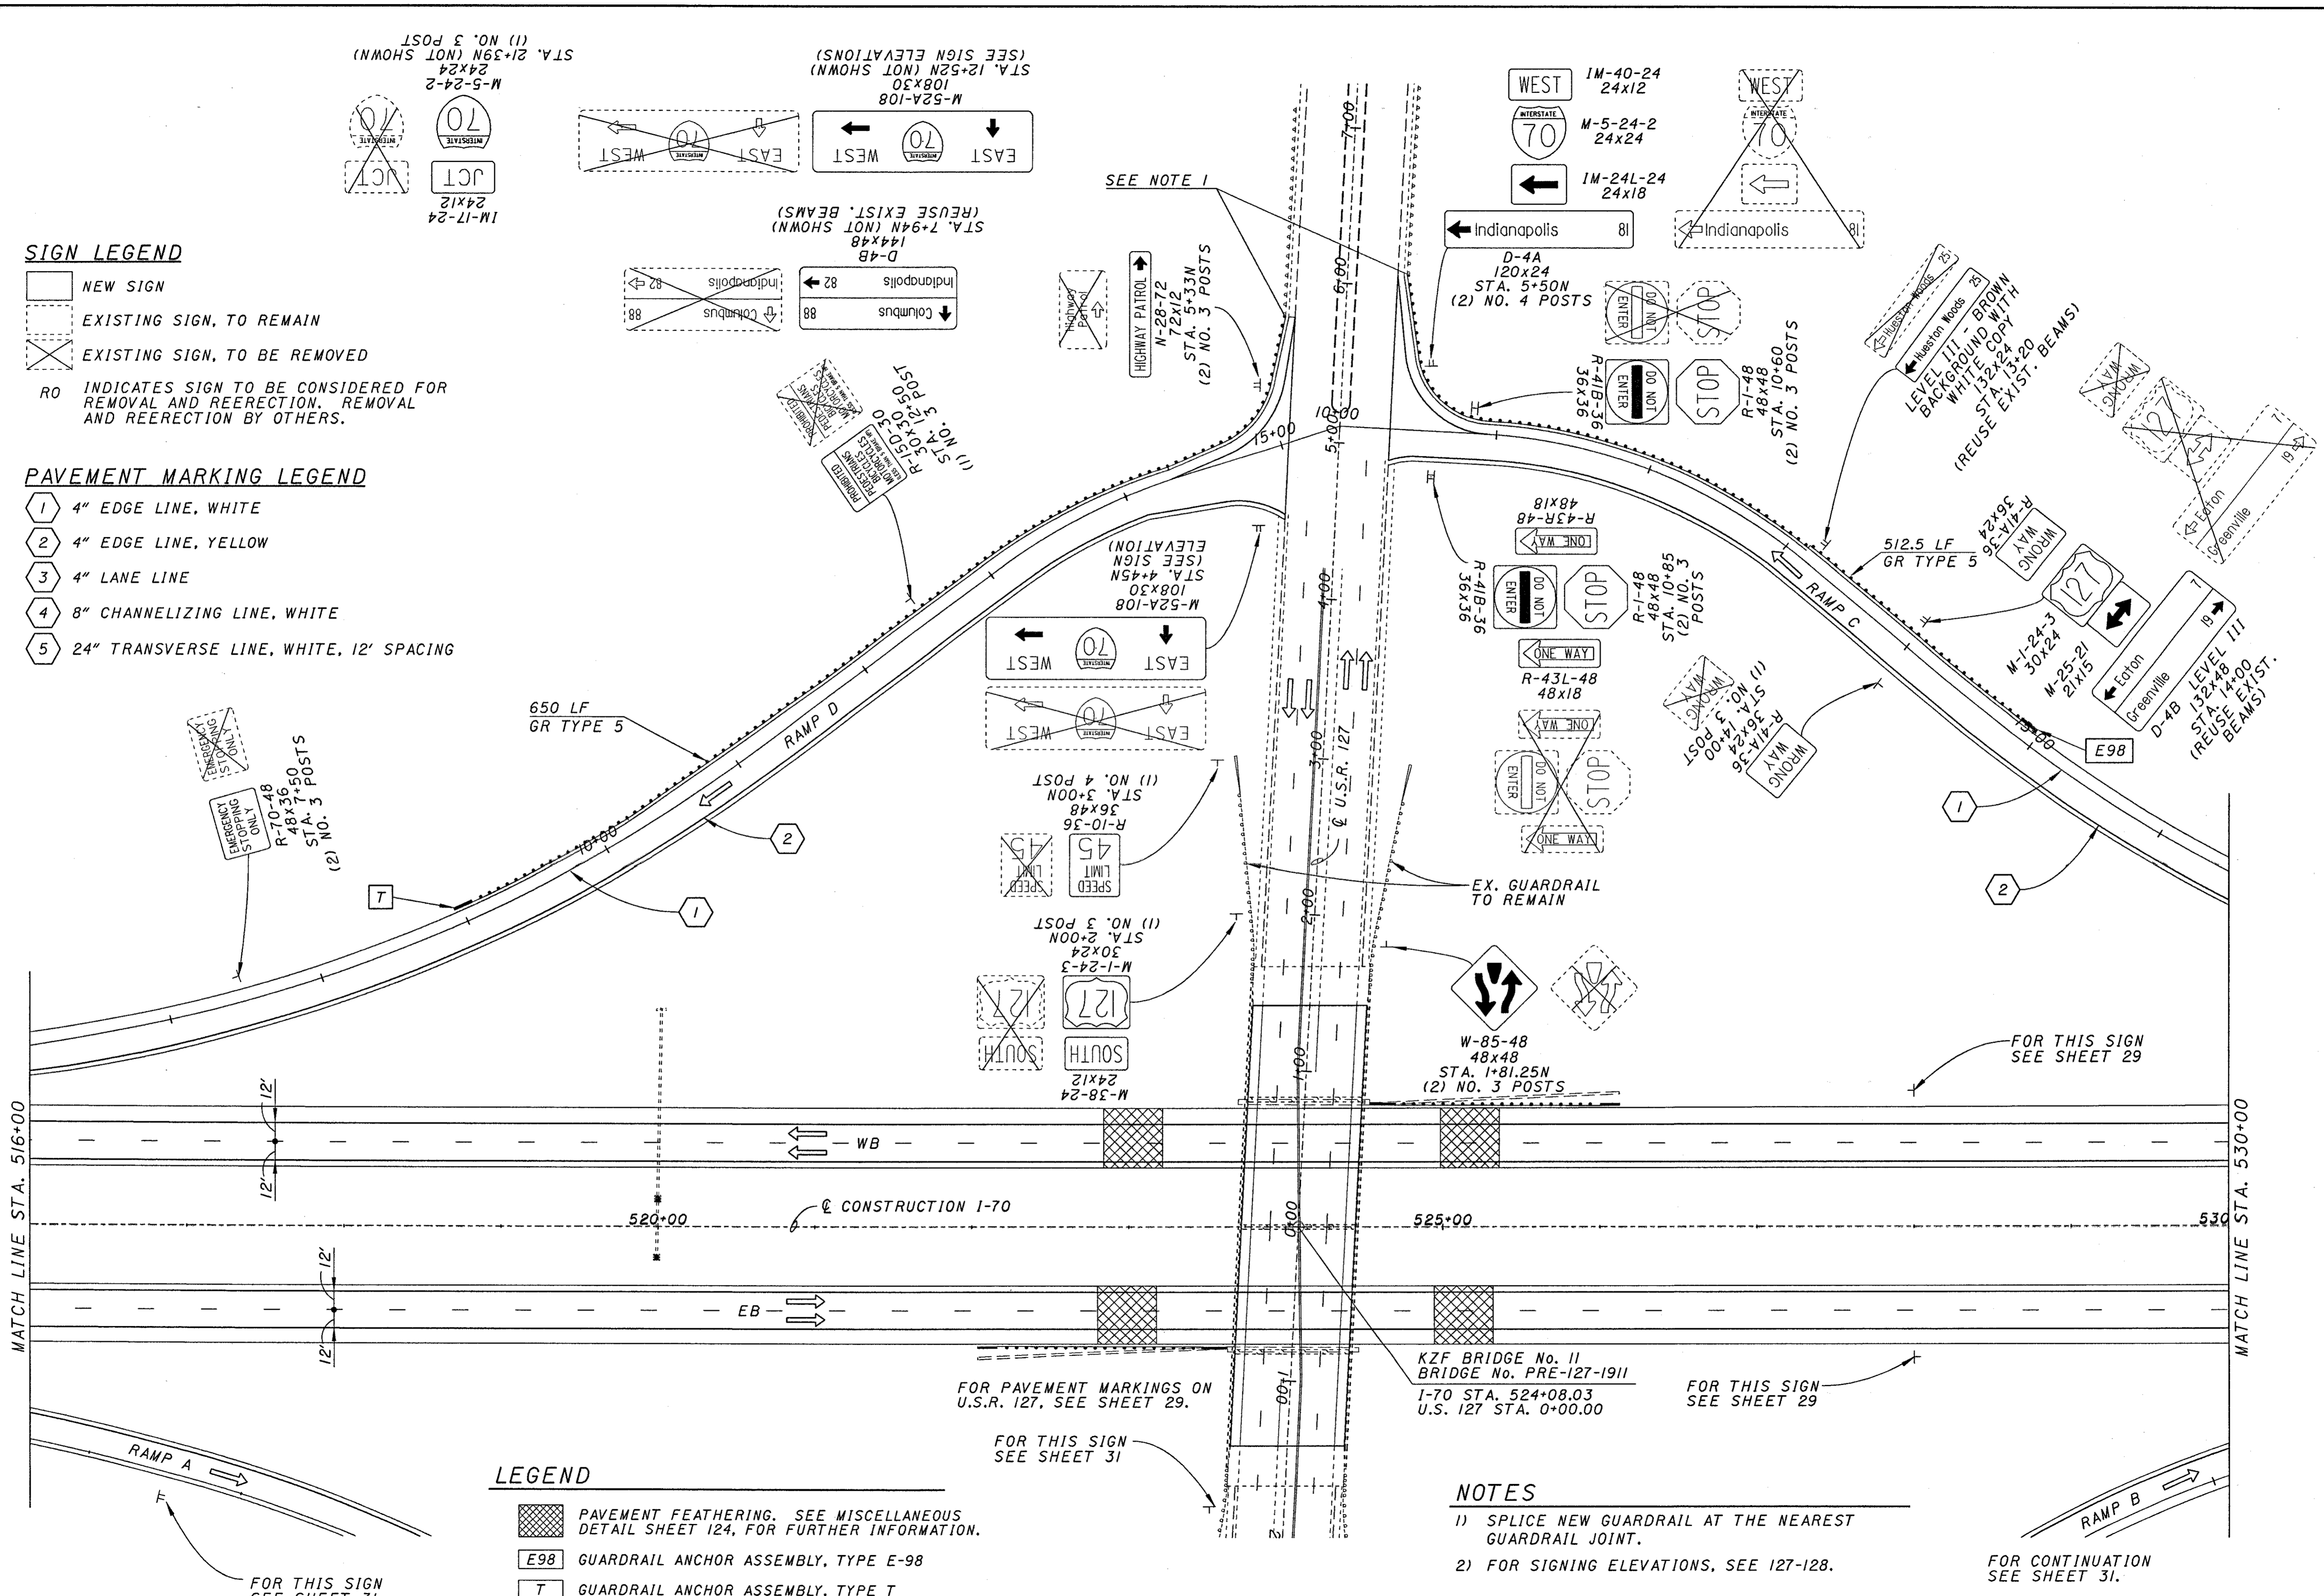

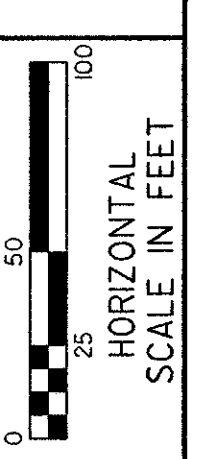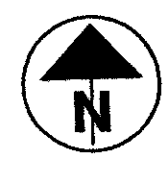

PLAN
STA. 530+00 TO STA. 558+00

PRE-70-0.00

PAVEMENT MARKING LEGEND


- 1 4" EDGE LINE, WHITE
- 2 4" EDGE LINE, YELLOW
- 3 4" LANE LINE
- 4 8" CHANNELIZING LINE, WHITE
- 5 24" TRANSVERSE LINE, WHITE, 12' SPACING

SIGN LEGEND

- NEW SIGN
- EXISTING SIGN, TO REMAIN
- EXISTING SIGN, TO BE REMOVED
- R0 INDICATES SIGN TO BE CONSIDERED FOR REMOVAL AND REERECTION. REMOVAL AND REERECTION BY OTHERS.

LEGEND


- FULL DEPTH PAVEMENT WIDENING, SEE TYPICAL SECTIONS FOR PAVEMENT MAKEUP.

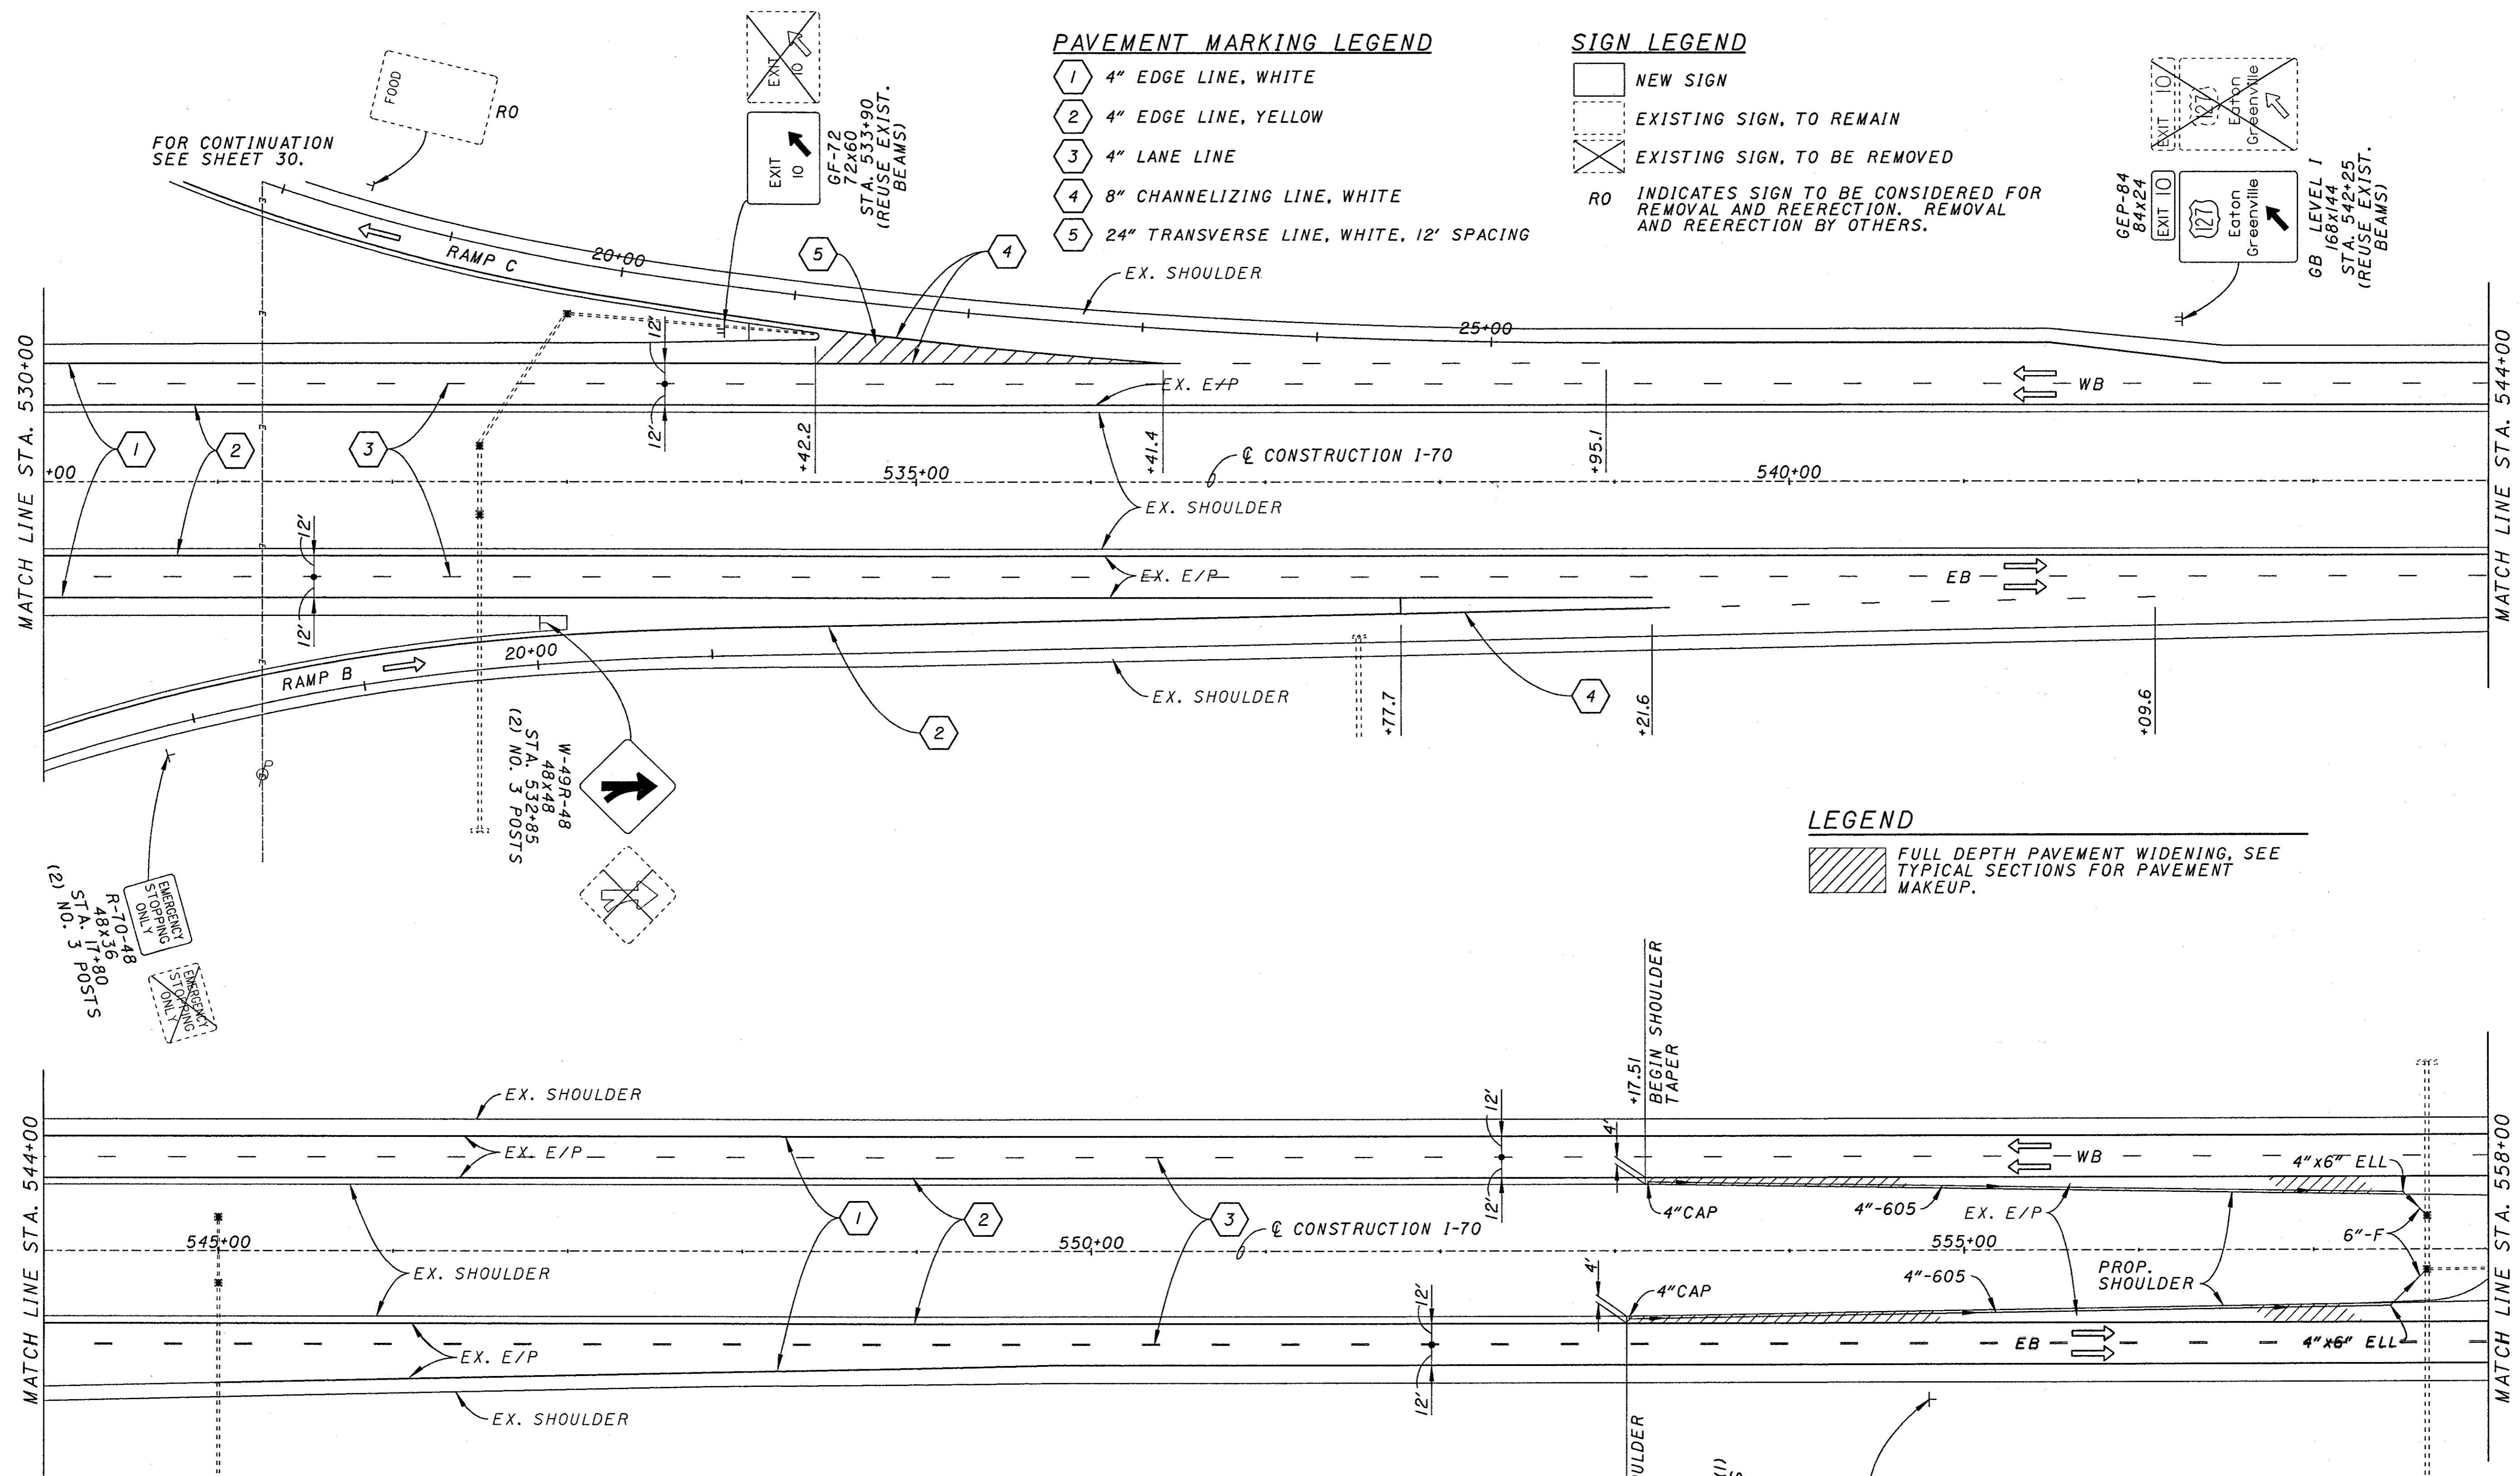

NOTES


- 1) FOR FULL DEPTH PAVEMENT WIDENING INFORMATION, SEE SHEETS 49-115.

REVISIONS
 USER: ***
 DATE: ***
 ACTIVE LEVELS: ON: #4LEV#

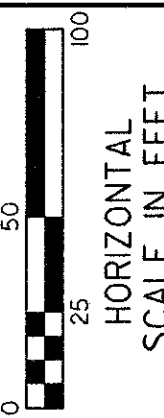

PLAN
STA. 558+00 TO STA. 586+00

PRE-70-0.00

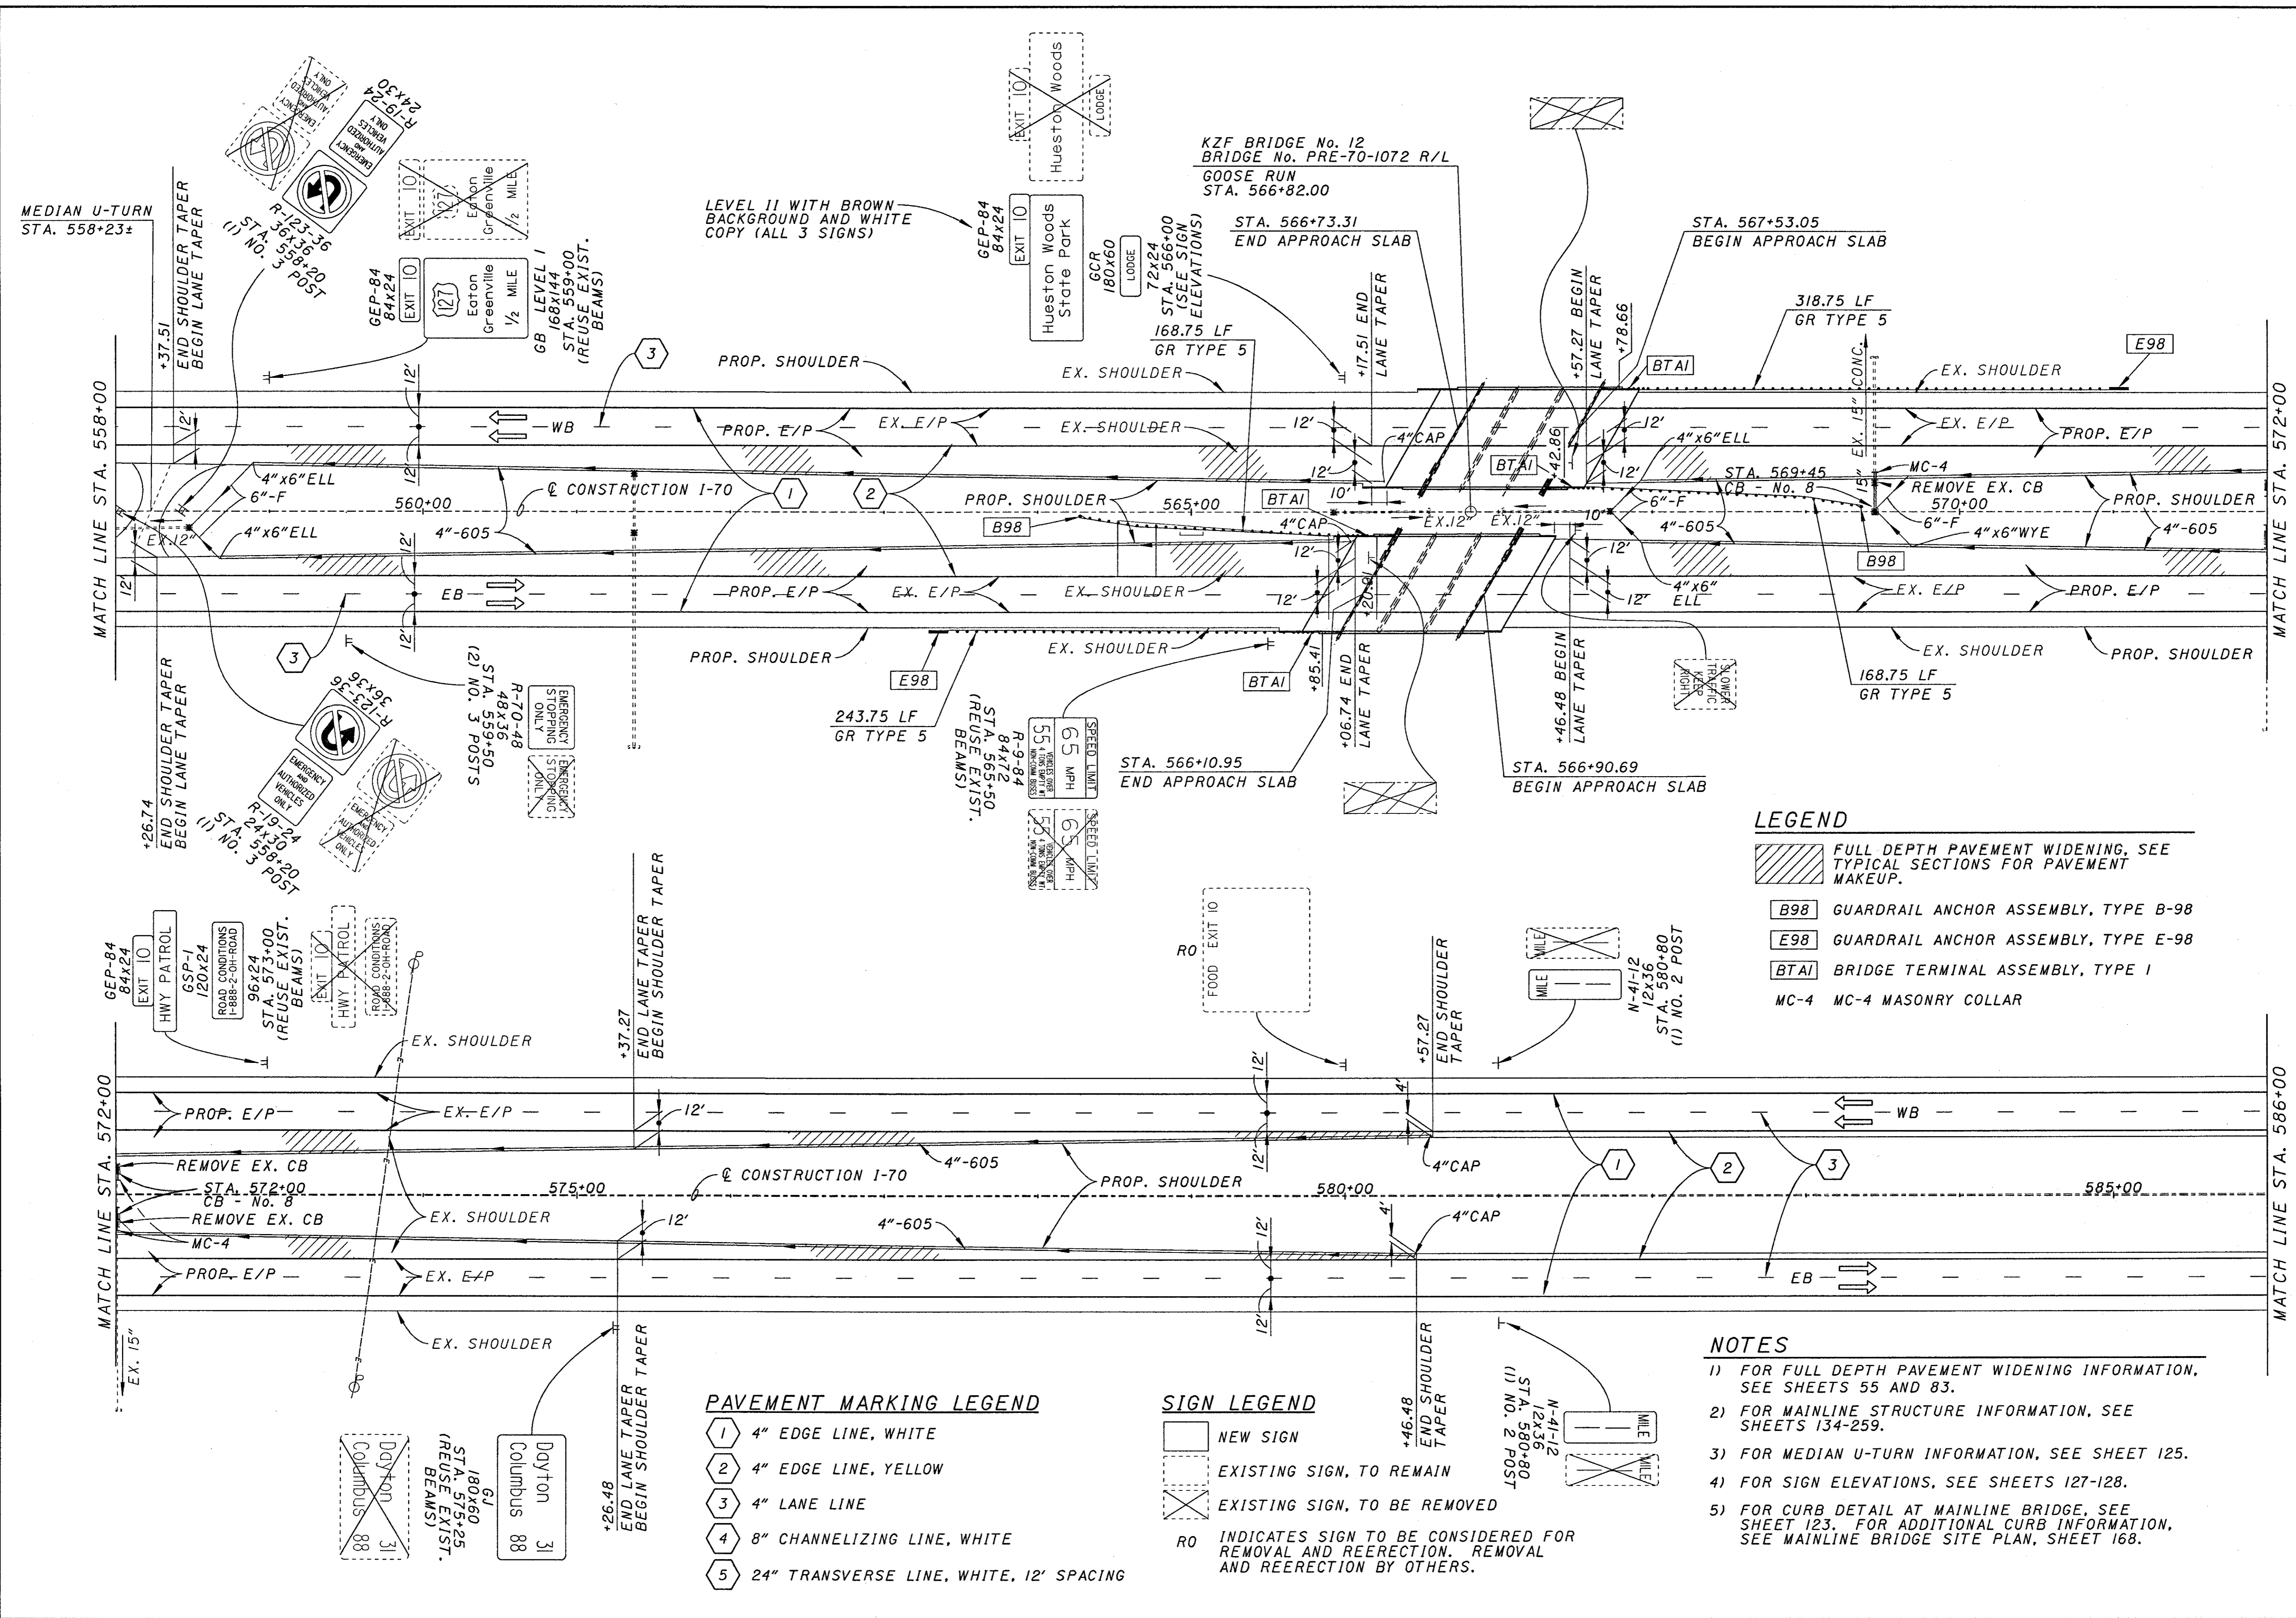

LEGEND

- FULL DEPTH PAVEMENT WIDENING, SEE TYPICAL SECTIONS FOR PAVEMENT MAKEUP.
- B98 GUARDRAIL ANCHOR ASSEMBLY, TYPE B-98
- E98 GUARDRAIL ANCHOR ASSEMBLY, TYPE E-98
- BTAI BRIDGE TERMINAL ASSEMBLY, TYPE I
- MC-4 MC-4 MASONRY COLLAR

NOTES

- 1) FOR FULL DEPTH PAVEMENT WIDENING INFORMATION, SEE SHEETS 55 AND 83.
- 2) FOR MAINLINE STRUCTURE INFORMATION, SEE SHEETS 134-259.
- 3) FOR MEDIAN U-TURN INFORMATION, SEE SHEET 125.
- 4) FOR SIGN ELEVATIONS, SEE SHEETS 127-128.
- 5) FOR CURB DETAIL AT MAINLINE BRIDGE, SEE SHEET 123. FOR ADDITIONAL CURB INFORMATION, SEE MAINLINE BRIDGE SITE PLAN, SHEET 168.

PAVEMENT MARKING LEGEND

- 4" EDGE LINE, WHITE
- 4" EDGE LINE, YELLOW
- 4" LANE LINE
- 8" CHANNELIZING LINE, WHITE
- 24" TRANSVERSE LINE, WHITE, 12' SPACING


SIGN LEGEND

- NEW SIGN
- EXISTING SIGN, TO REMAIN
- EXISTING SIGN, TO BE REMOVED
- RO INDICATES SIGN TO BE CONSIDERED FOR REMOVAL AND REERECTION. REMOVAL AND REERECTION BY OTHERS.

 USER: *****
 PROJECT: *****
 SHEET: *****
 DATE: *****
 ACTIVE LEVELS ON: *****

REF001**REF002**
 REF003**REF004**
 REF005**REF006**
 REF007**REF008**

 USER: SAJ/SE/AN/MS
 DES: FILED/DONE/SPECIFICATION/*****
 ACTIVE LEVELS: ON: *B1*E1*V*8

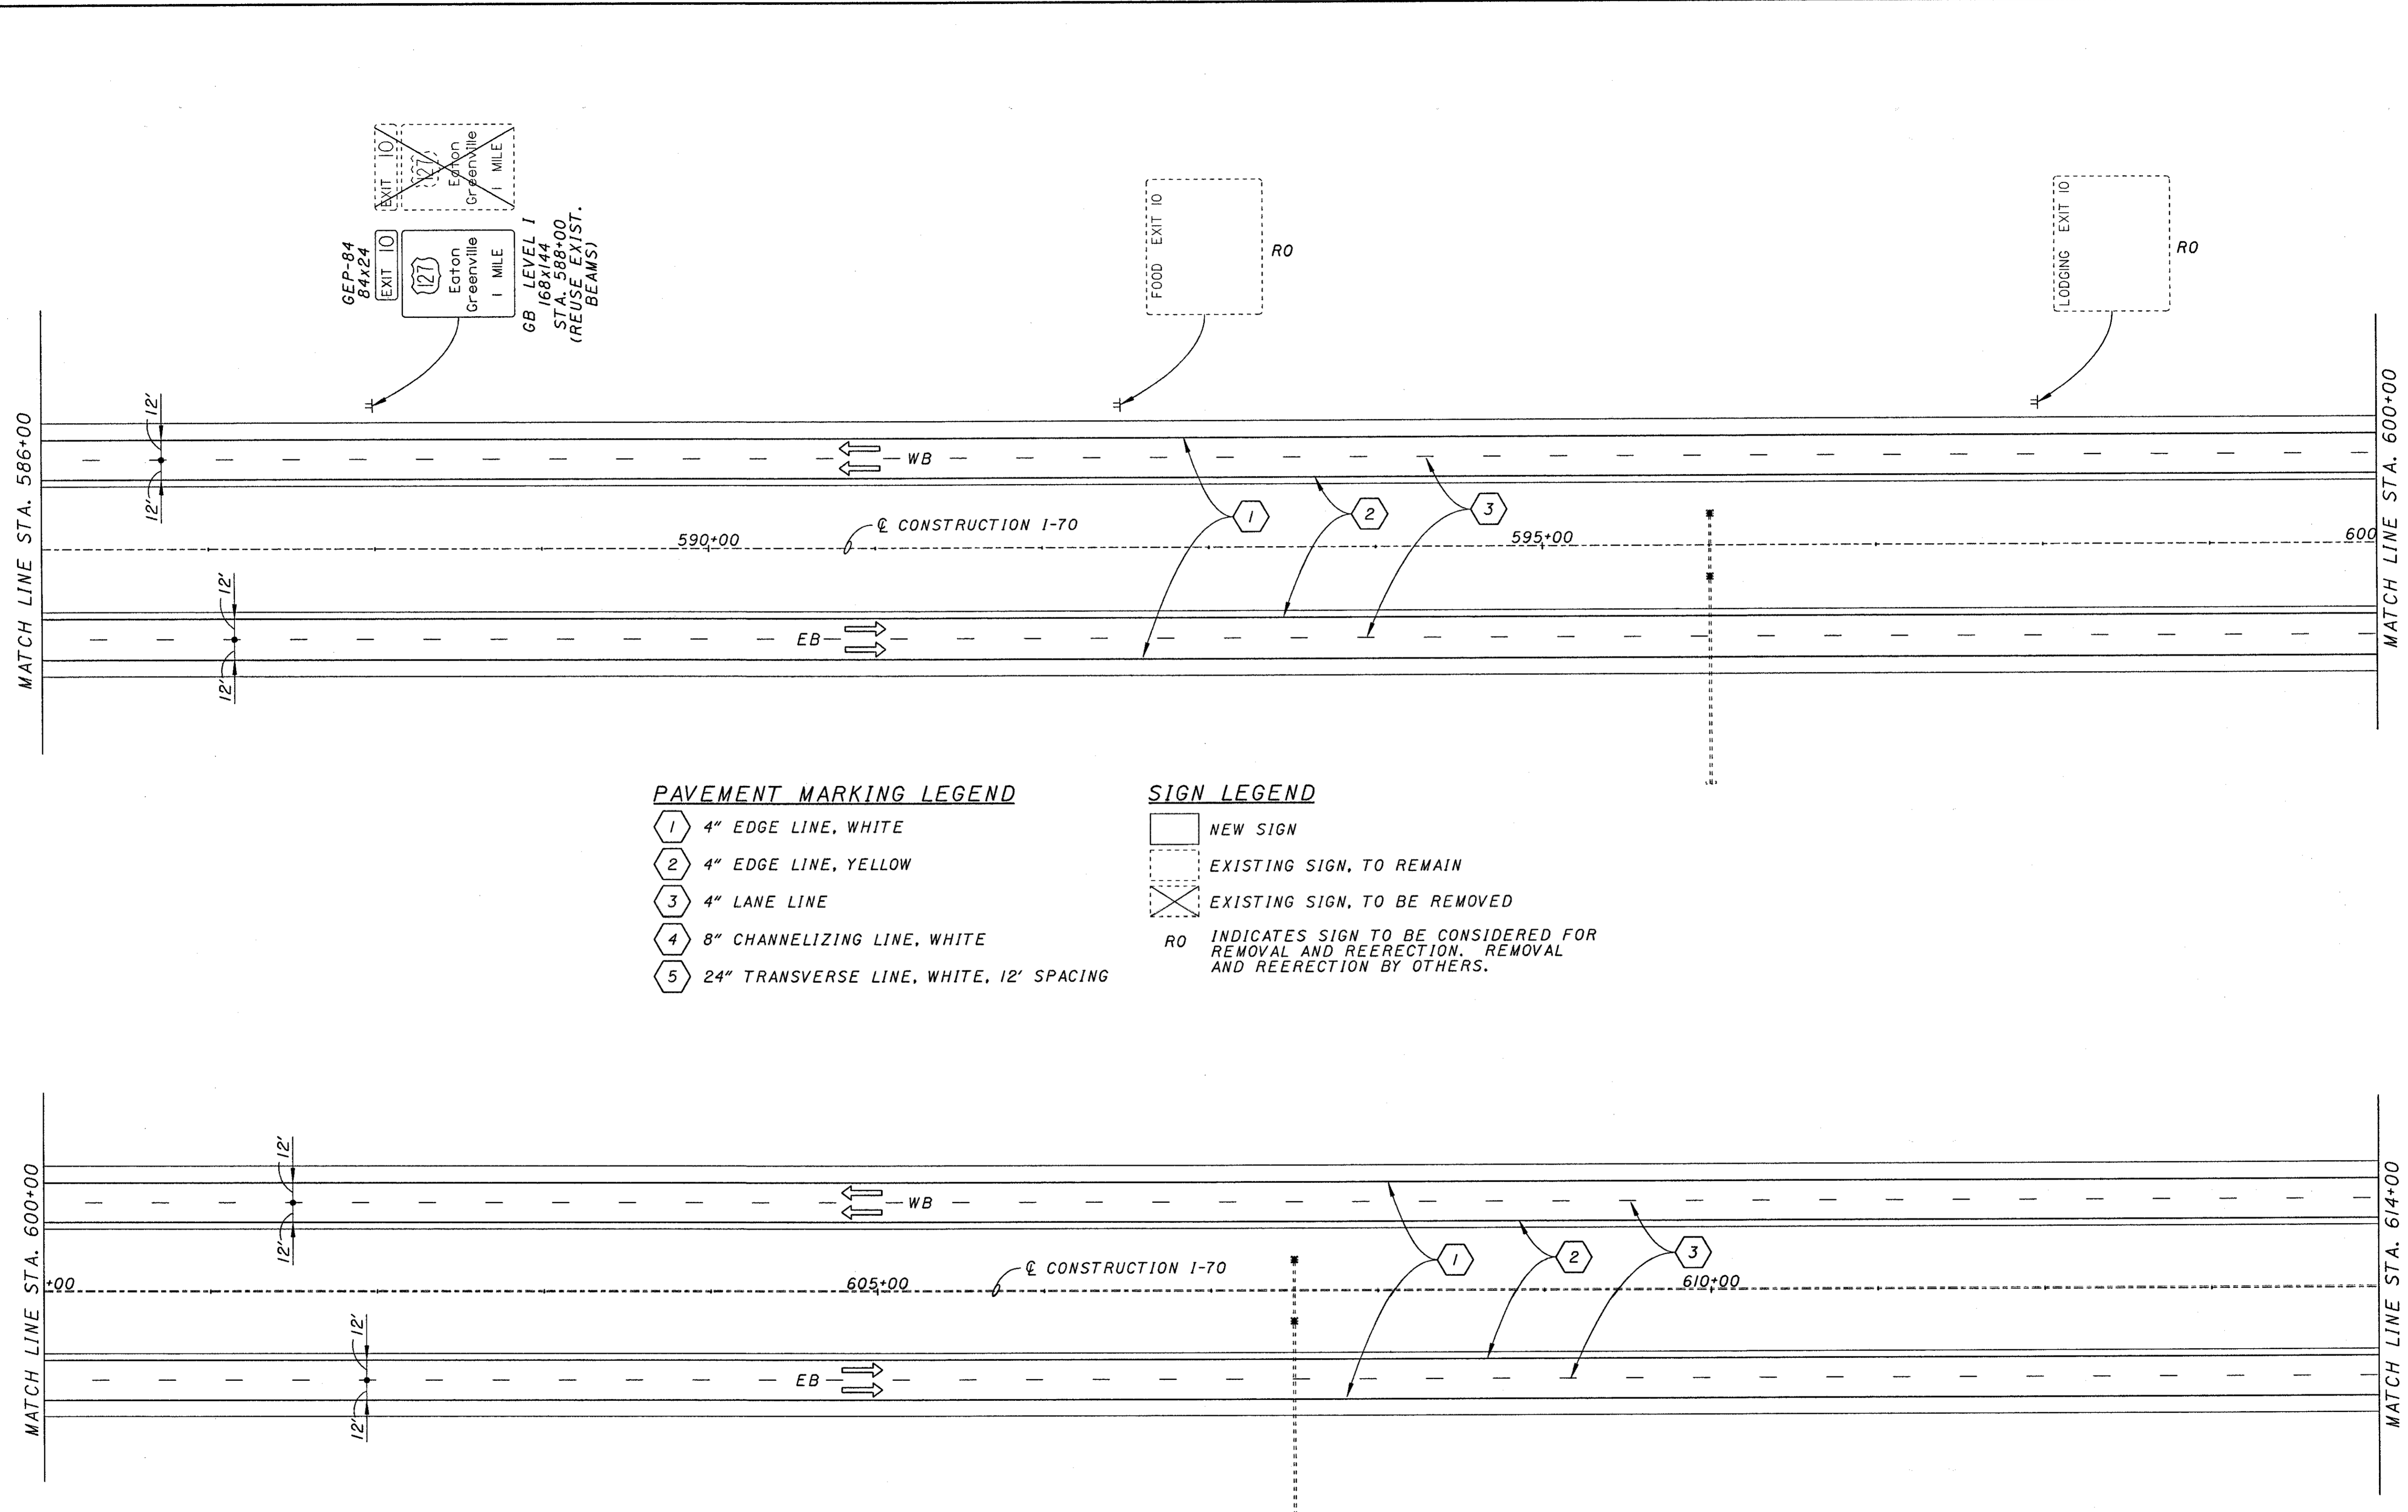

GEP-84
 84x24
 EXIT 10
 Edgton
 Greenville
 1 MILE

GB LEVEL I
 168x144
 STA. 588+00
 (REUSE EXIST.
 BEAMS)

FOOD EXIT 10
 R0

LODGING EXIT 10
 R0

PAVEMENT MARKING LEGEND

- ① 4" EDGE LINE, WHITE
- ② 4" EDGE LINE, YELLOW
- ③ 4" LANE LINE
- ④ 8" CHANNELIZING LINE, WHITE
- ⑤ 24" TRANSVERSE LINE, WHITE, 12' SPACING

SIGN LEGEND

- [Solid Box] NEW SIGN
- [Dashed Box] EXISTING SIGN, TO REMAIN
- [Dashed Box with X] EXISTING SIGN, TO BE REMOVED
- R0 INDICATES SIGN TO BE CONSIDERED FOR REMOVAL AND REERECTION. REMOVAL AND REERECTION BY OTHERS.

MATCH LINE STA. 586+00

MATCH LINE STA. 600+00

MATCH LINE STA. 600+00

MATCH LINE STA. 614+00

TOP


 BOTTOM

 0 25 50 100
 HORIZONTAL
 SCALE IN FEET

PLAN
STA. 586+00 TO STA. 614+00


PRE-70-0.00

REFORMATION
 USER: 841167
 PROJECT: 12X36
 SHEET: 35
 DATE: 11/11/00
 ACTIVE LEVELS ON: 841167

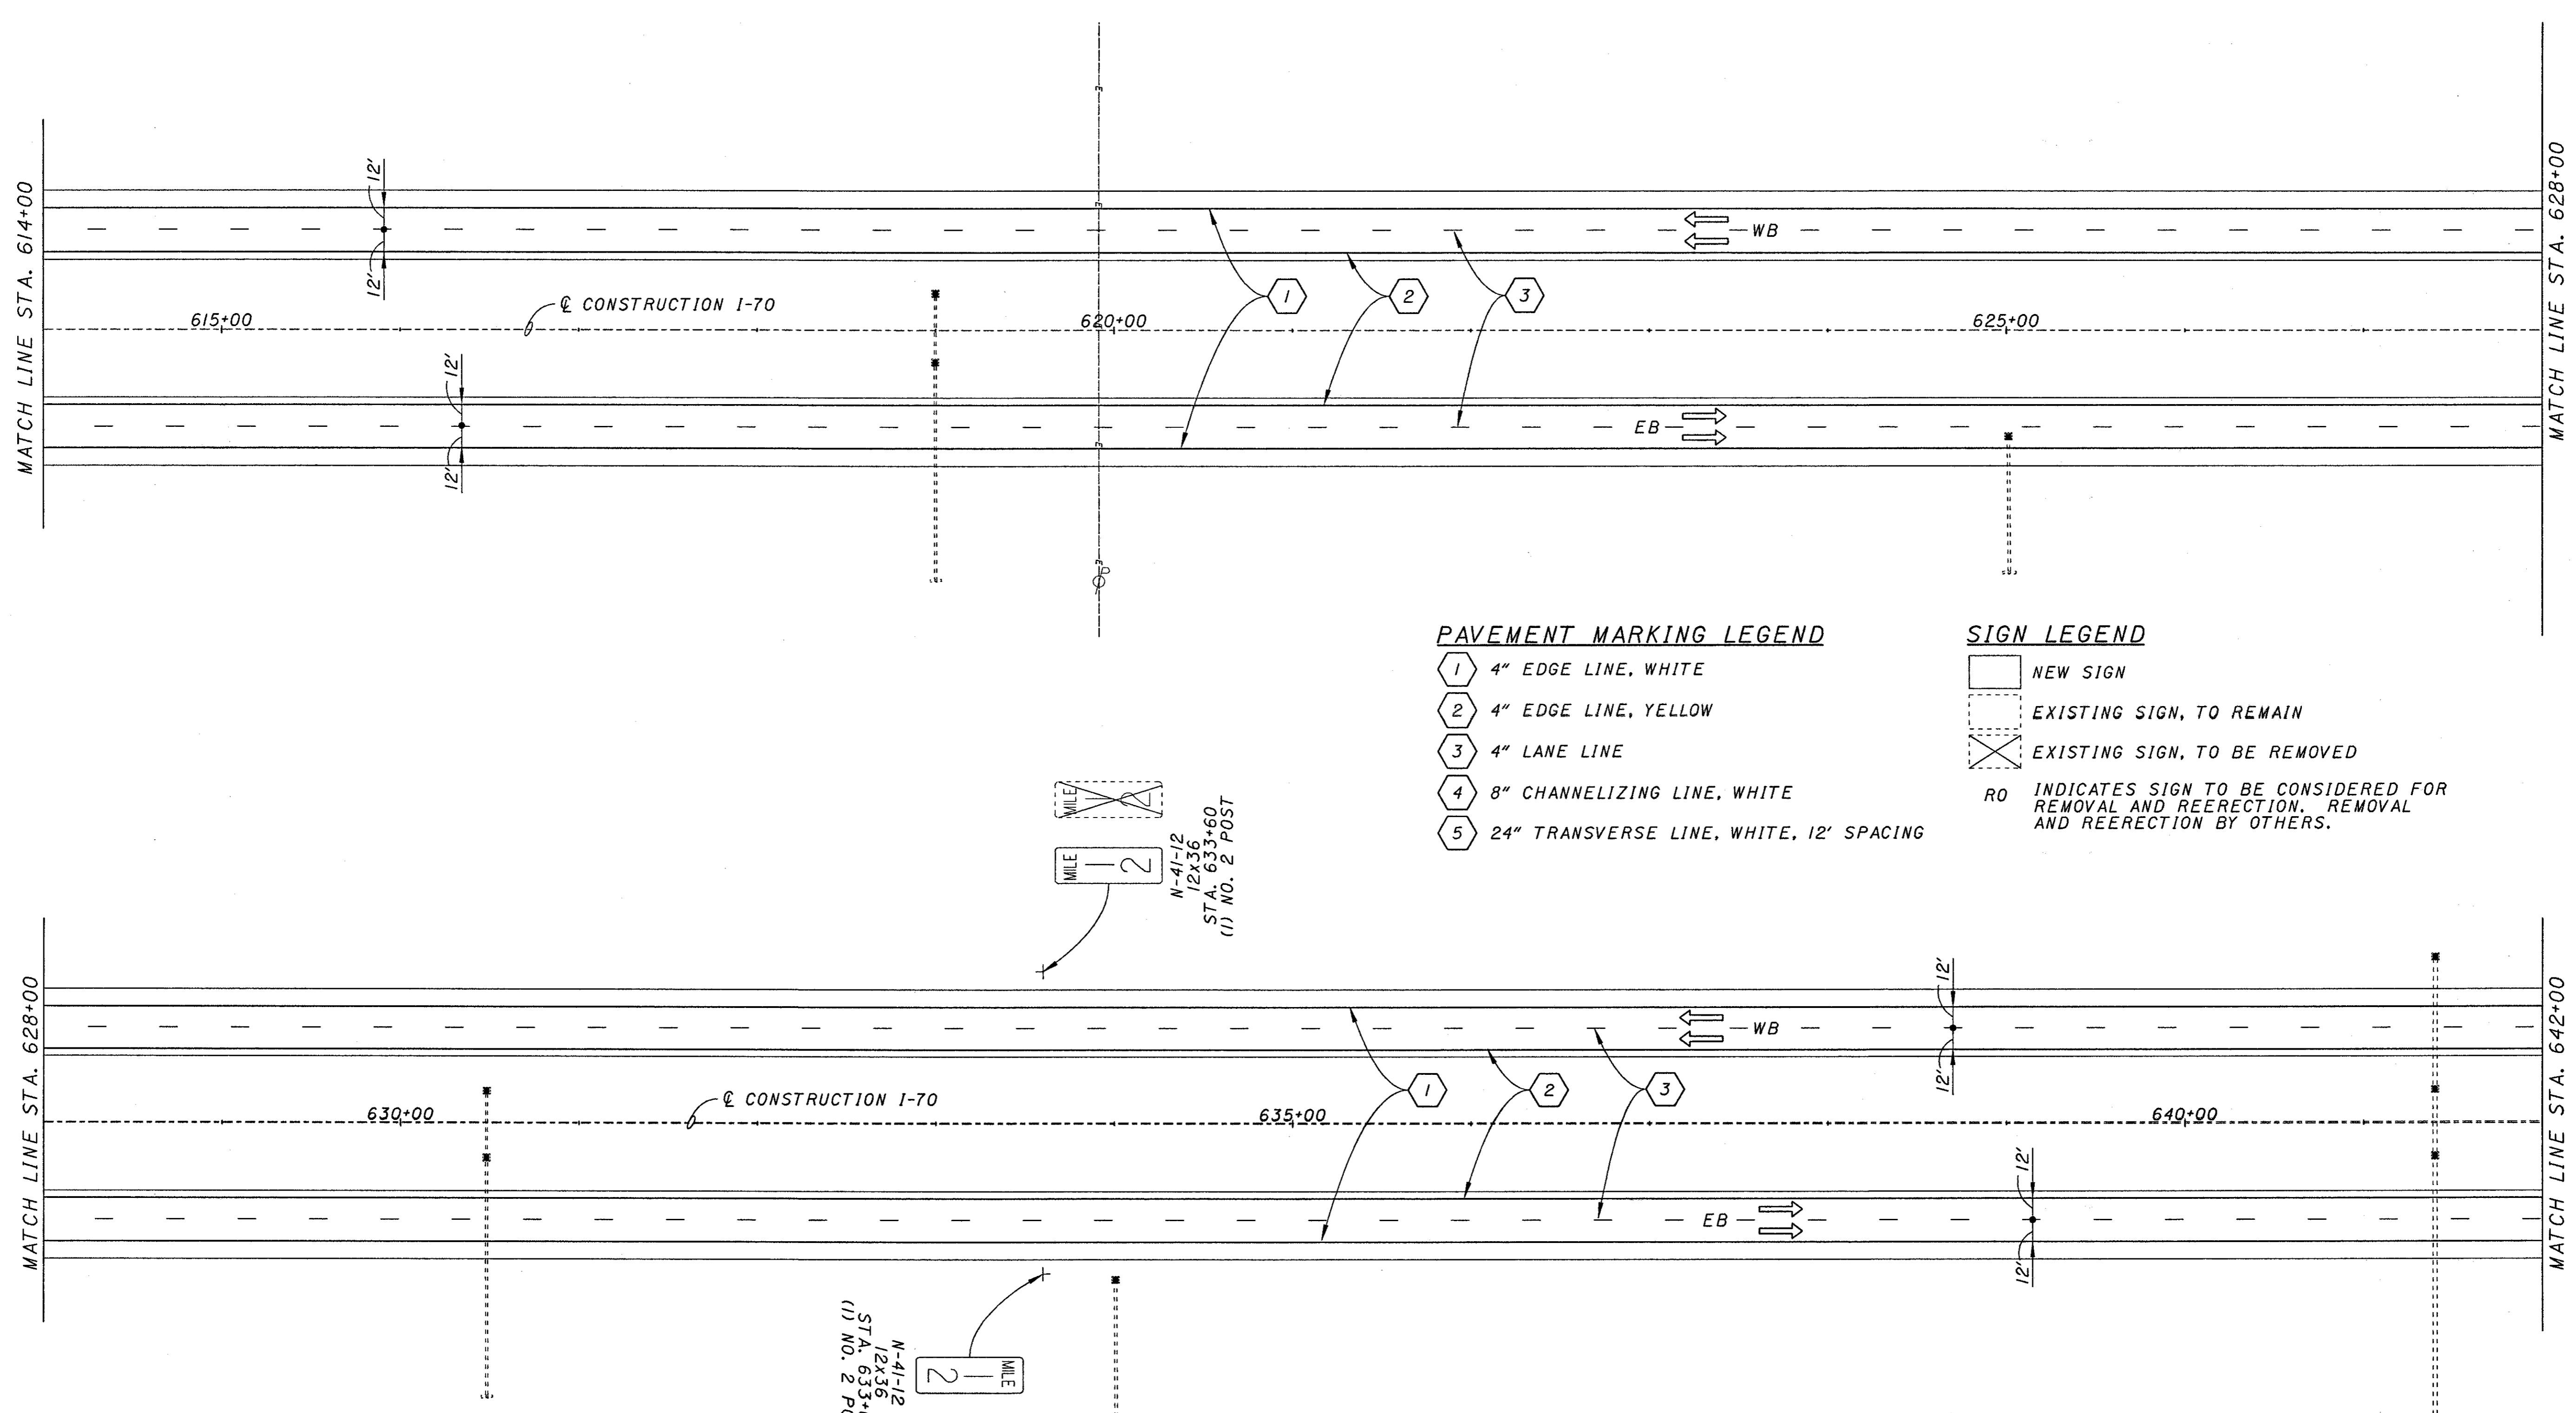

- PAVEMENT MARKING LEGEND**
- ① 4" EDGE LINE, WHITE
 - ② 4" EDGE LINE, YELLOW
 - ③ 4" LANE LINE
 - ④ 8" CHANNELIZING LINE, WHITE
 - ⑤ 24" TRANSVERSE LINE, WHITE, 12' SPACING

- SIGN LEGEND**
- NEW SIGN
 - EXISTING SIGN, TO REMAIN
 - EXISTING SIGN, TO BE REMOVED
 - RO INDICATES SIGN TO BE CONSIDERED FOR REMOVAL AND REERECTION. REMOVAL AND REERECTION BY OTHERS.

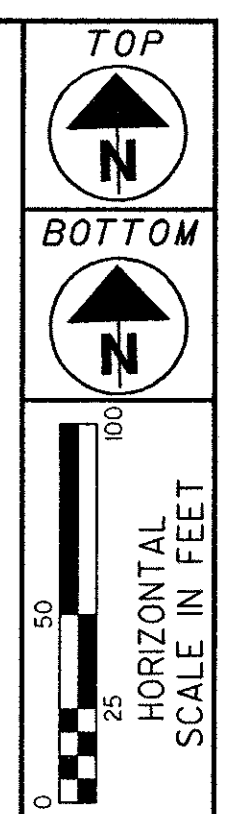

PLAN
STA. 614+00 TO STA. 642+00



PRE-70-0.00

PAVEMENT MARKING LEGEND

- ① 4" EDGE LINE, WHITE
- ② 4" EDGE LINE, YELLOW
- ③ 4" LANE LINE
- ④ 8" CHANNELIZING LINE, WHITE
- ⑤ 24" TRANSVERSE LINE, WHITE, 12' SPACING

SIGN LEGEND

- NEW SIGN
- ▭ EXISTING SIGN, TO REMAIN
- ⊗ EXISTING SIGN, TO BE REMOVED
- R0 INDICATES SIGN TO BE CONSIDERED FOR REMOVAL AND REERECTION. REMOVAL AND REERECTION BY OTHERS.

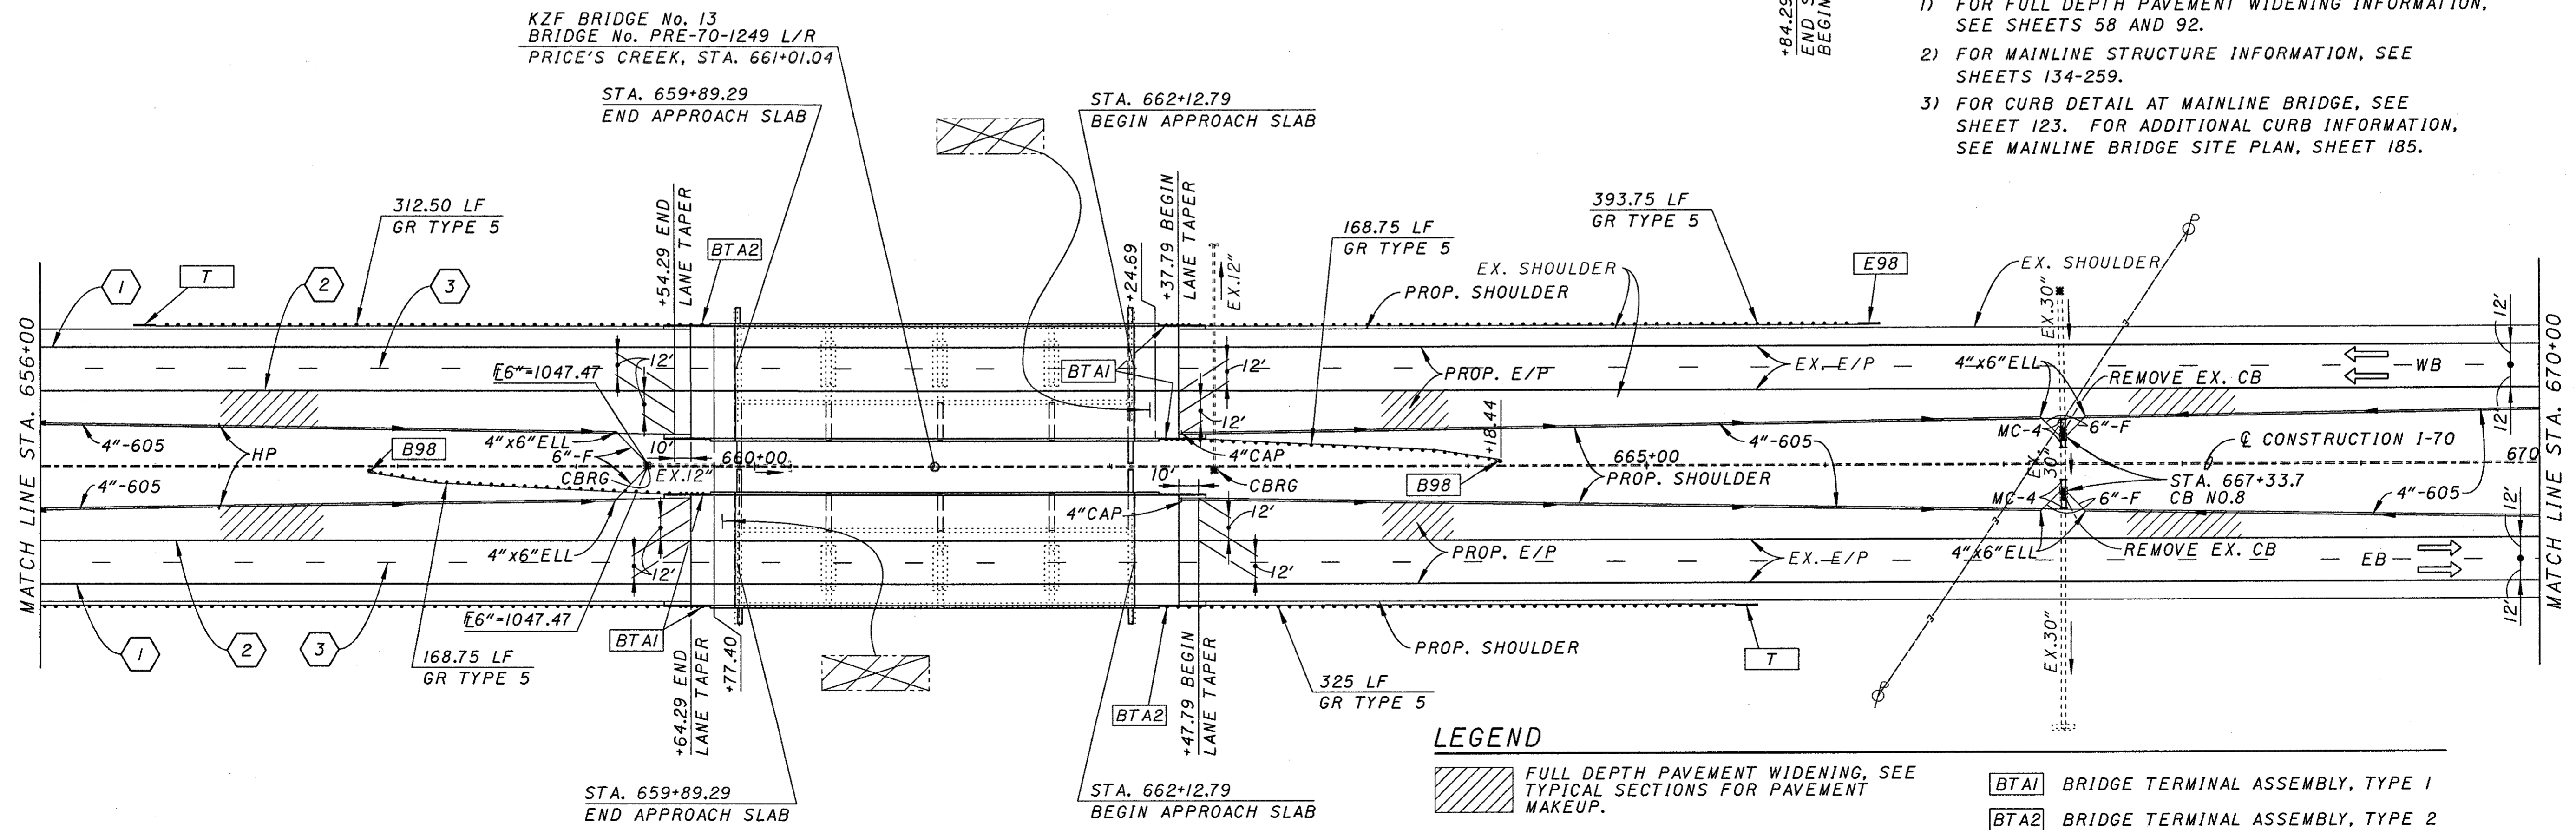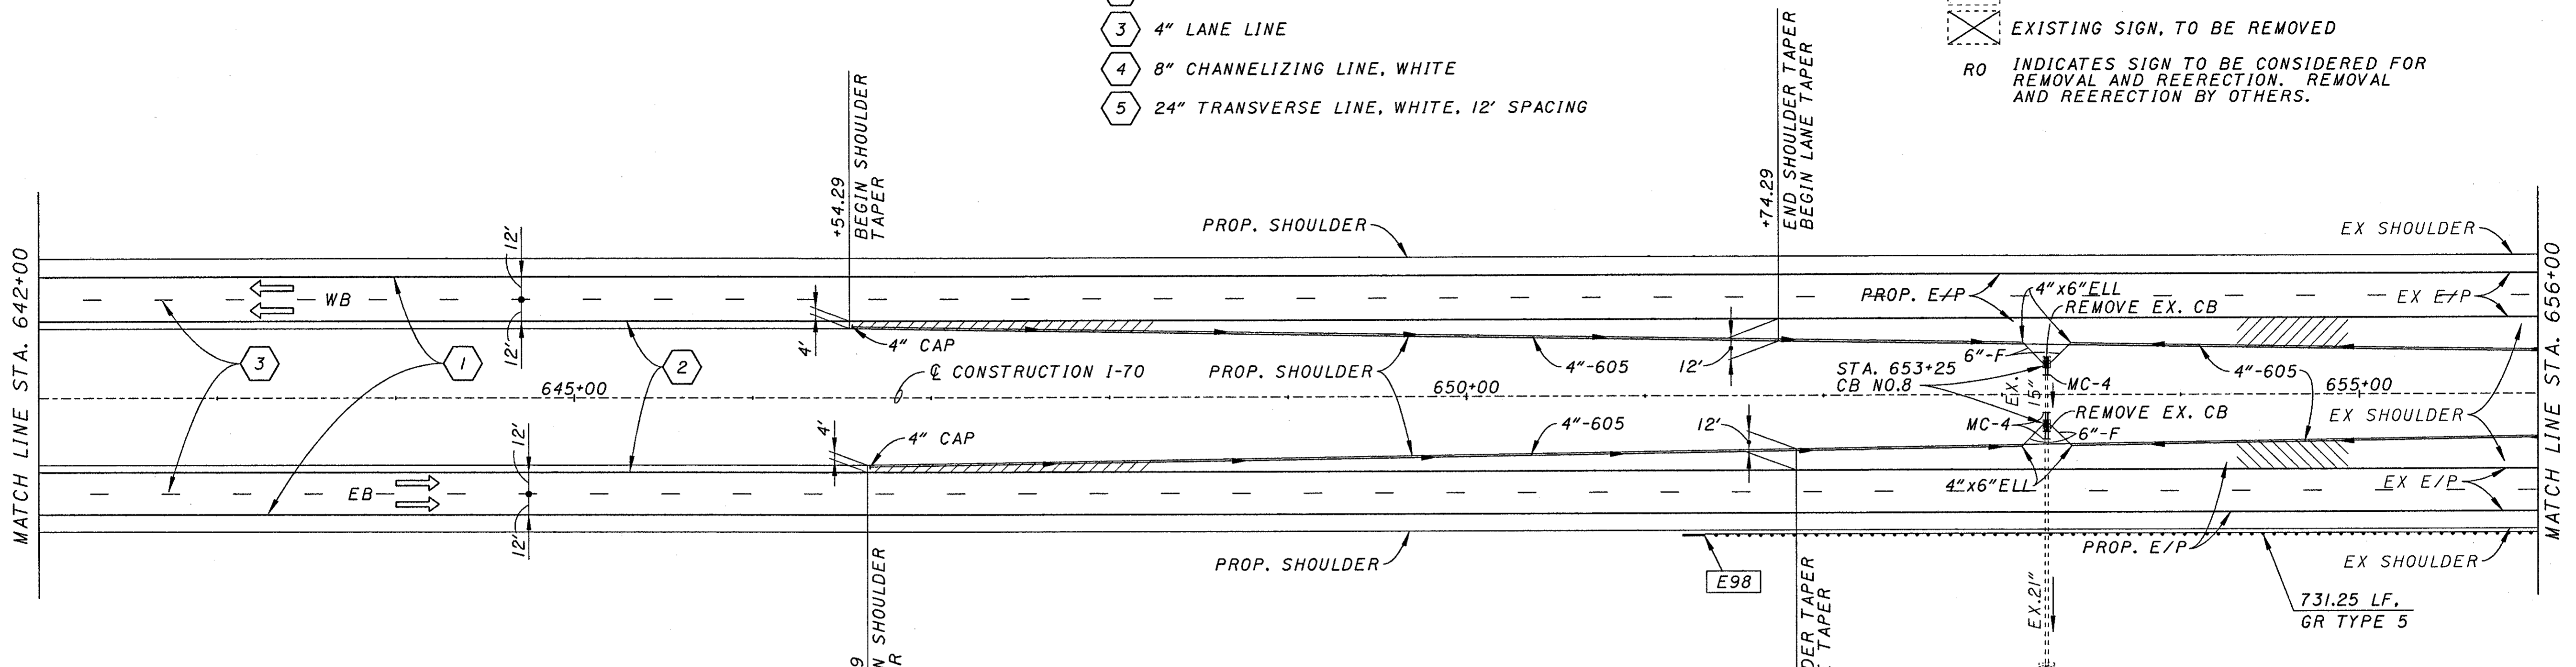

NOTES

- 1) FOR FULL DEPTH PAVEMENT WIDENING INFORMATION, SEE SHEETS 58 AND 92.
- 2) FOR MAINLINE STRUCTURE INFORMATION, SEE SHEETS 134-259.
- 3) FOR CURB DETAIL AT MAINLINE BRIDGE, SEE SHEET 123. FOR ADDITIONAL CURB INFORMATION, SEE MAINLINE BRIDGE SITE PLAN, SHEET 185.

LEGEND



- FULL DEPTH PAVEMENT WIDENING, SEE TYPICAL SECTIONS FOR PAVEMENT MAKEUP.
- GUARDRAIL ANCHOR ASSEMBLY, TYPE B-98
- GUARDRAIL ANCHOR ASSEMBLY, TYPE E-98
- GUARDRAIL ANCHOR ASSEMBLY, TYPE T
- BRIDGE TERMINAL ASSEMBLY, TYPE 1
- BRIDGE TERMINAL ASSEMBLY, TYPE 2
- MC-4 MASONRY COLLAR
- HP HIGH POINT (UNDERDRAIN)
- CBRG CATCH BASIN RECONSTRUCTED TO GRADE

PLAN STA. 642+00 TO STA. 670+00

PRE-70-0.00

REVISIONS
 NO. DATE BY
 1 11/15/00 JLM
 2 11/15/00 JLM
REVISIONS
 NO. DATE BY
 1 11/15/00 JWS
 2 11/15/00 JWS
 3 11/15/00 JWS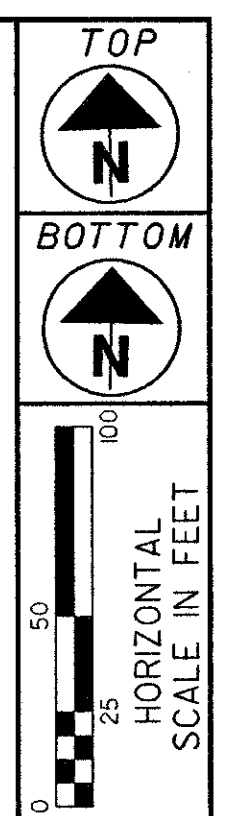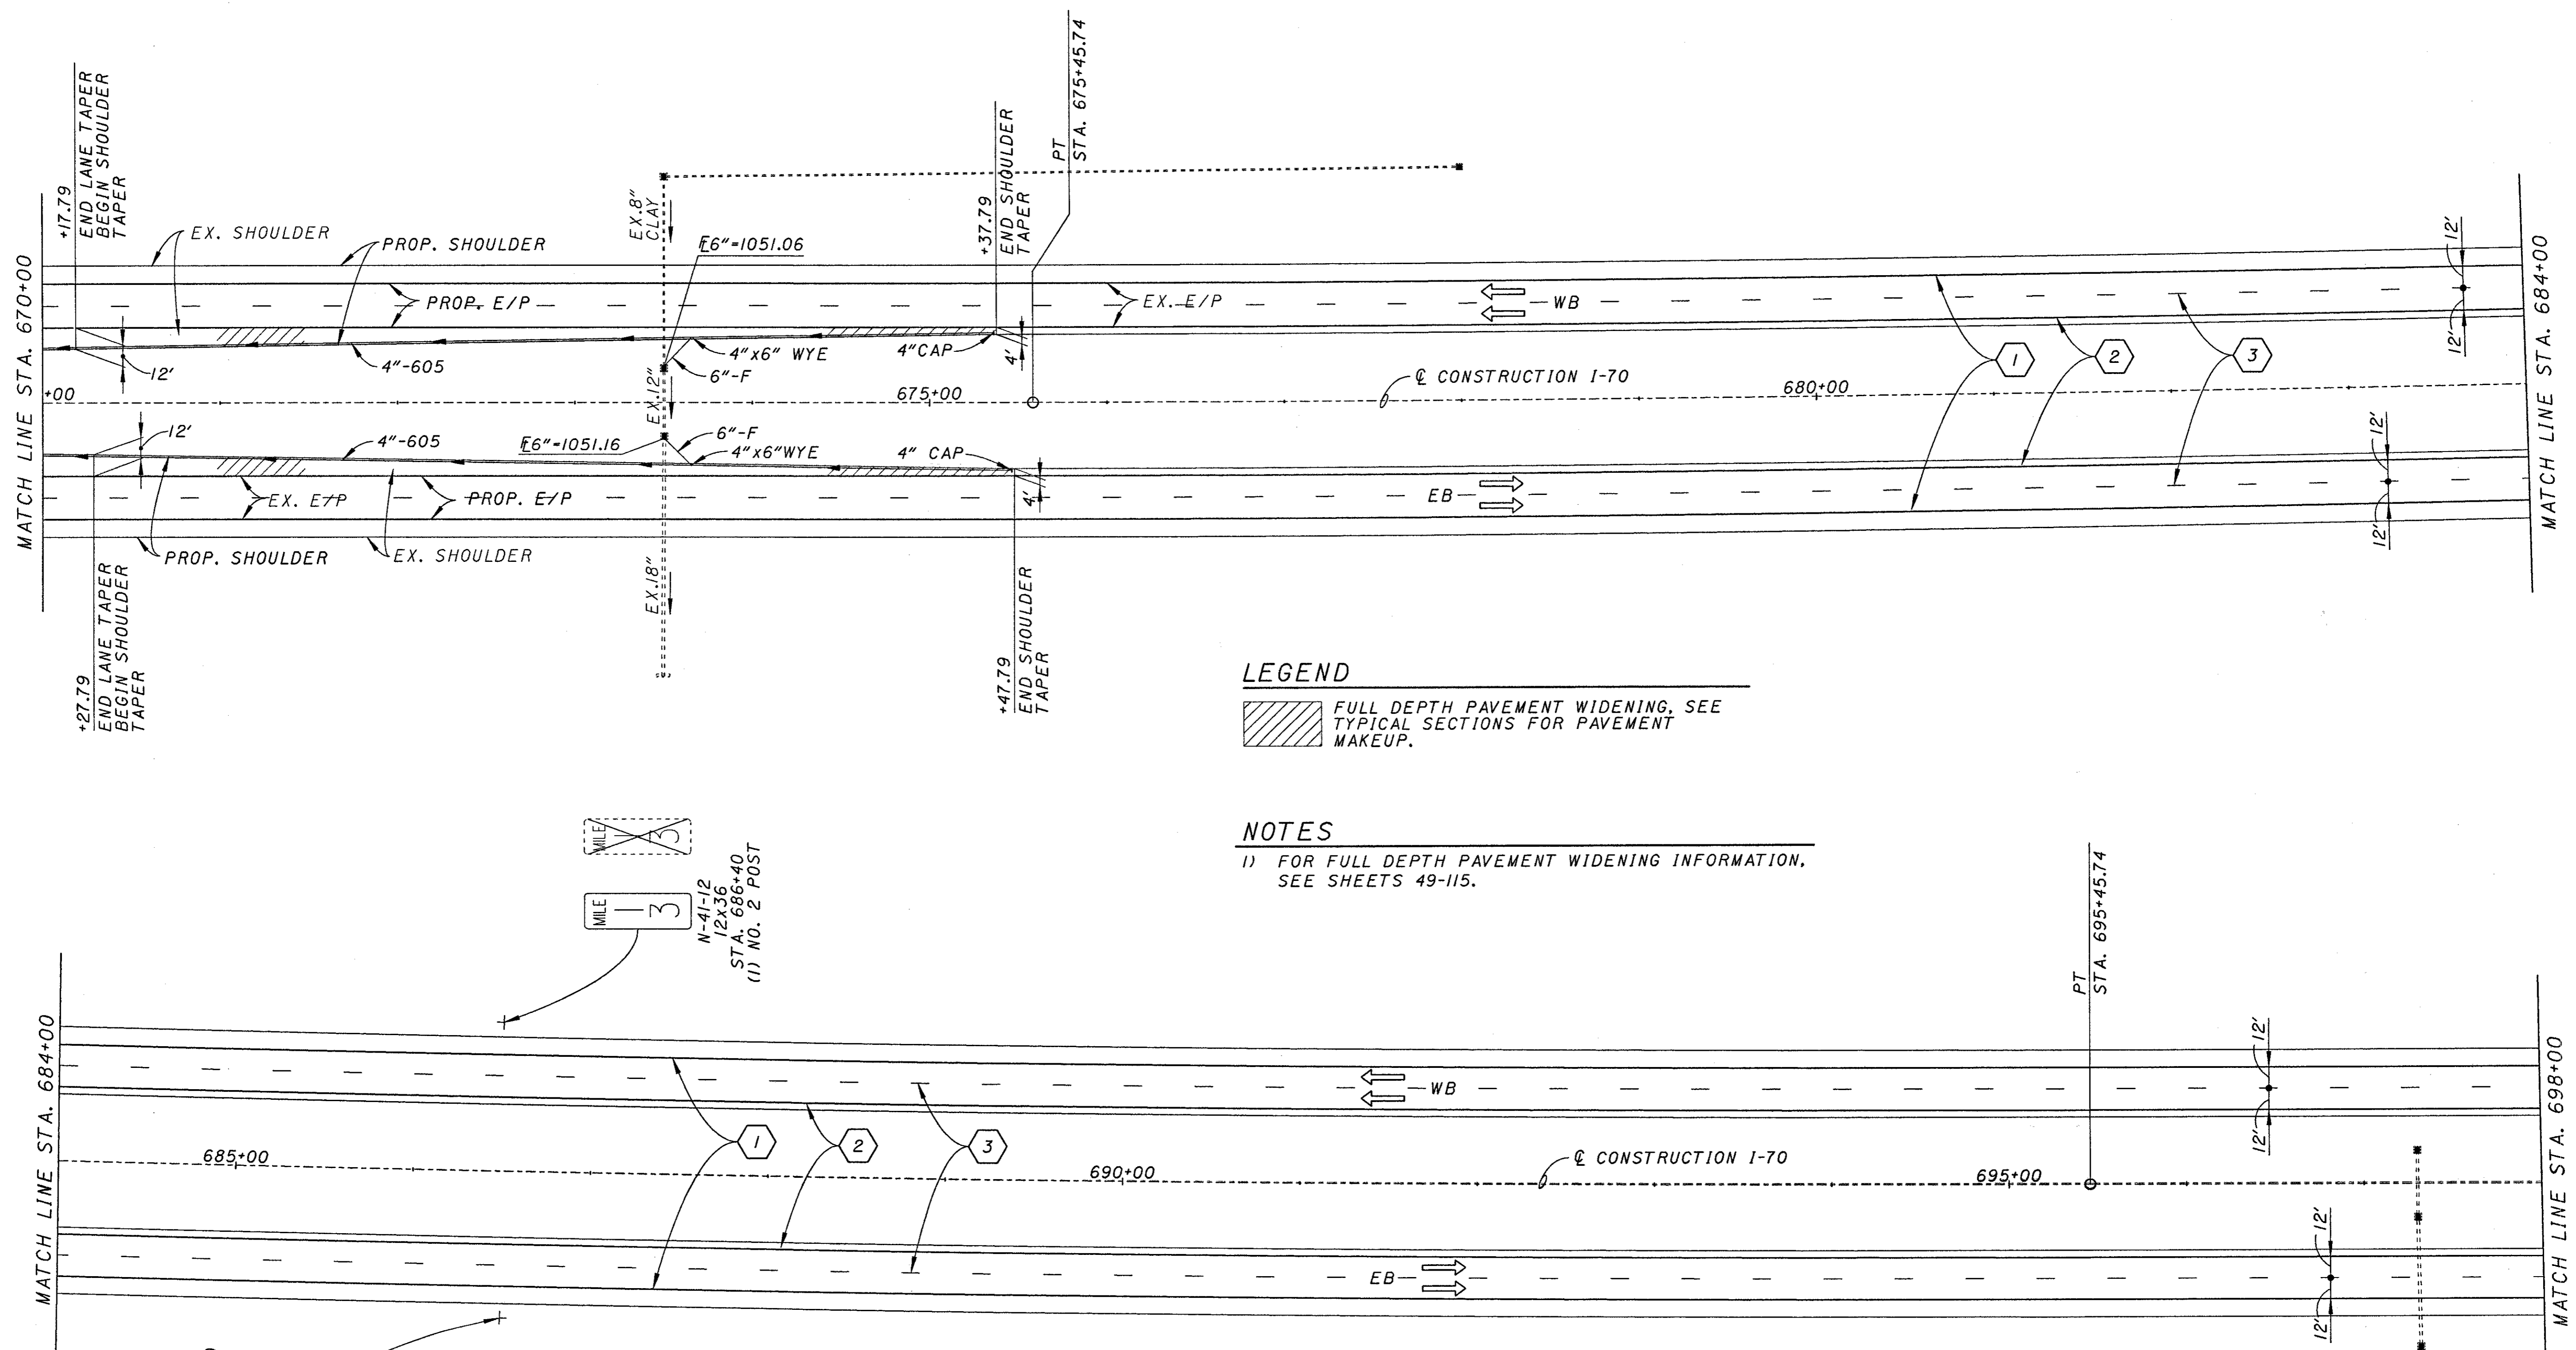
PLAN
STA. 670+00 TO STA. 698+00

PRE-70-0.00

LEGEND

FULL DEPTH PAVEMENT WIDENING, SEE TYPICAL SECTIONS FOR PAVEMENT MAKEUP.

NOTES

1) FOR FULL DEPTH PAVEMENT WIDENING INFORMATION, SEE SHEETS 49-115.

PAVEMENT MARKING LEGEND

- ① 4" EDGE LINE, WHITE
- ② 4" EDGE LINE, YELLOW
- ③ 4" LANE LINE
- ④ 8" CHANNELIZING LINE, WHITE
- ⑤ 24" TRANSVERSE LINE, WHITE, 12' SPACING

SIGN LEGEND

- NEW SIGN
- EXISTING SIGN, TO REMAIN
- EXISTING SIGN, TO BE REMOVED
- RO INDICATES SIGN TO BE CONSIDERED FOR REMOVAL AND REERECTION. REMOVAL AND REERECTION BY OTHERS.

N-41-12
 STA. 686+40
 (1) NO. 2 POST


N-41-12
 STA. 686+40
 (1) NO. 2 POST

PAVEMENT MARKING LEGEND

- 1 4" EDGE LINE, WHITE
- 2 4" EDGE LINE, YELLOW
- 3 4" LANE LINE
- 4 8" CHANNELIZING LINE, WHITE
- 5 24" TRANSVERSE LINE, WHITE, 12' SPACING

SIGN LEGEND

- NEW SIGN
- EXISTING SIGN, TO REMAIN
- EXISTING SIGN, TO BE REMOVED
- RO INDICATES SIGN TO BE CONSIDERED FOR REMOVAL AND REERECTION. REMOVAL AND REERECTION BY OTHERS.

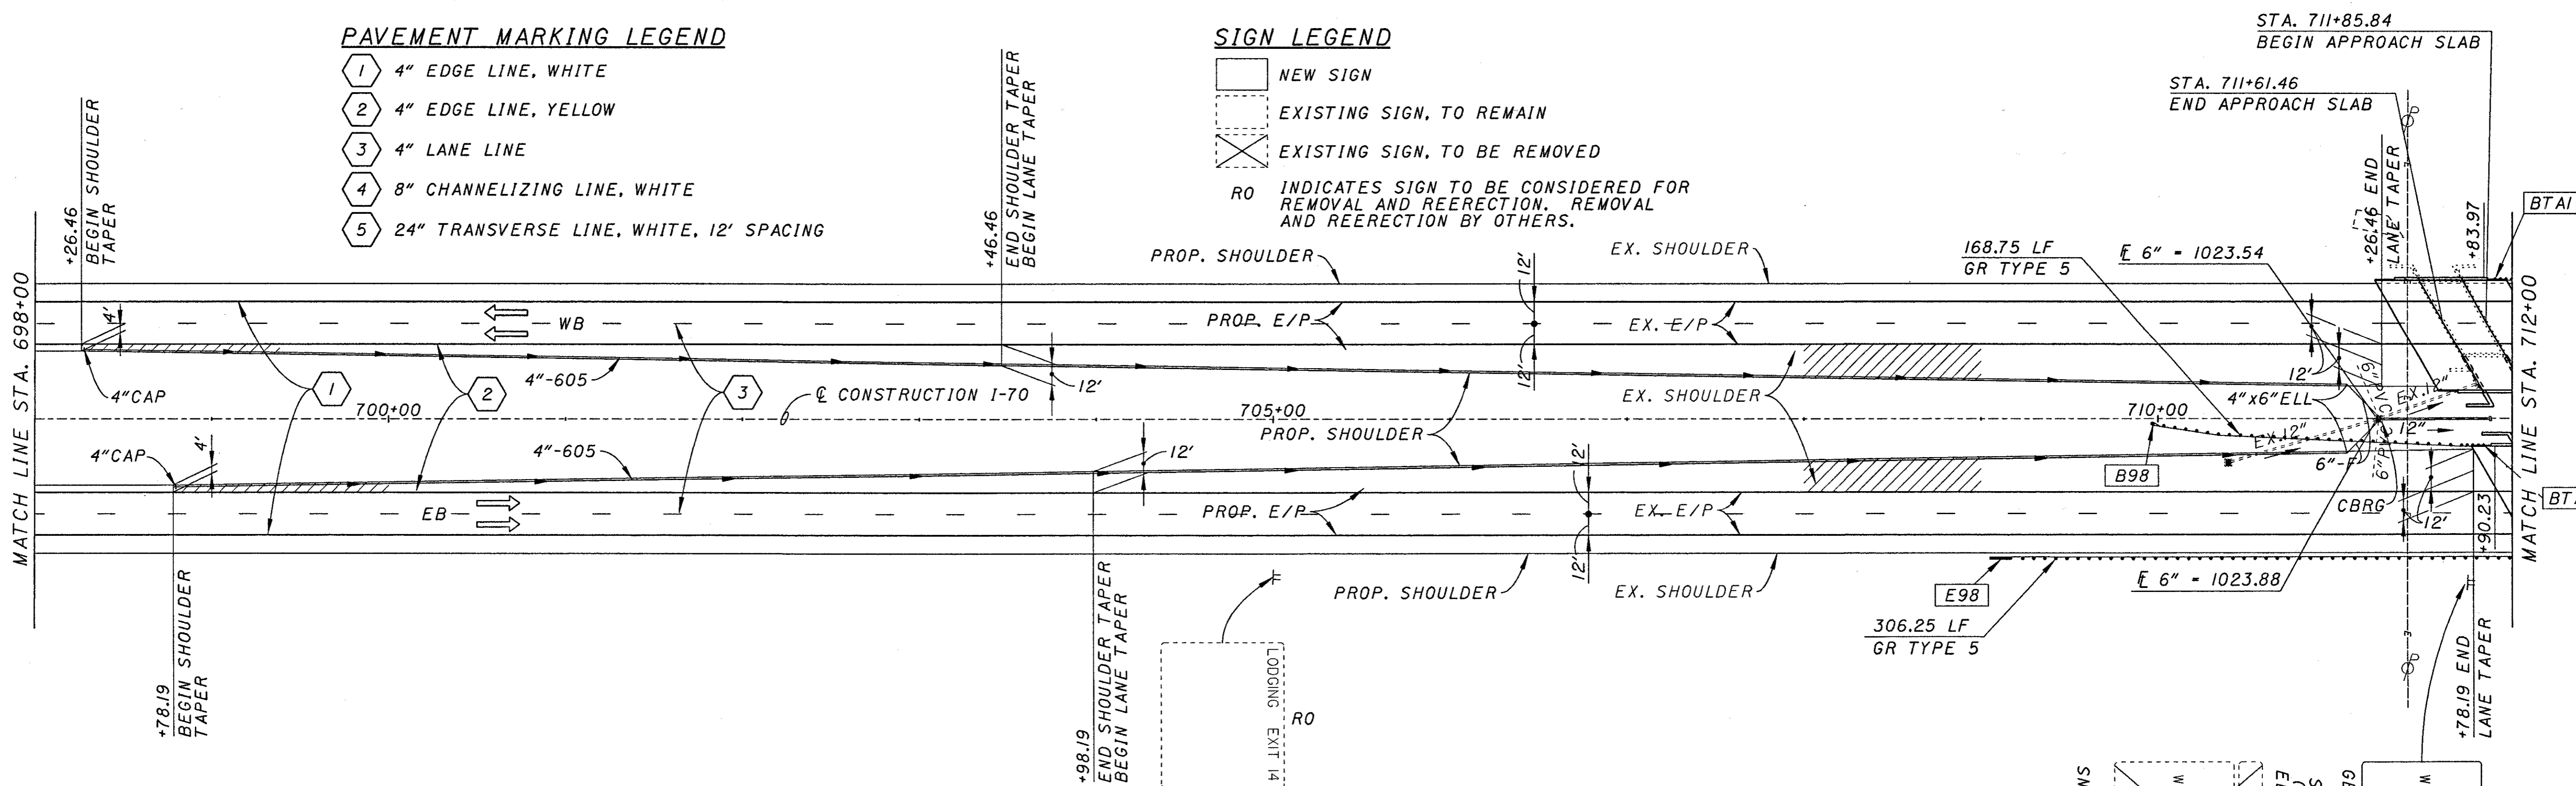


LEGEND

- FULL DEPTH PAVEMENT WIDENING, SEE TYPICAL SECTIONS FOR PAVEMENT MAKEUP.
- PAVEMENT FEATHERING, SEE MISCELLANEOUS DETAIL SHEET 124, FOR FURTHER INFORMATION.
- MC-4 MC-4 MASONRY COLLAR
- CBRG CATCH BASIN RECONSTRUCTED TO GRADE
- B98 GUARDRAIL ANCHOR ASSEMBLY, TYPE B-98
- E98 GUARDRAIL ANCHOR ASSEMBLY, TYPE E-98
- BTAI BRIDGE TERMINAL ASSEMBLY, TYPE I
- CBAPP CONCRETE BARRIER, TYPE D, AS PER PLAN

NOTES

- 1) CONSTRUCT A NEW CONCRETE BARRIER TRANSITION AS PER STANDARD DRAWING RM-4.5M. SEAL WITH EPOXY URETHANE. FOR FURTHER INFORMATION, SEE SHEET 123.
- 2) FOR CROSS ROAD INFORMATION, SEE SHEETS 116-122.
- 3) FOR OVERHEAD STRUCTURE INFORMATION, SEE SHEETS 260-283.
- 4) FOR FULL DEPTH PAVEMENT WIDENING INFORMATION, SEE SHEETS 61 AND 100.
- 5) FOR MAINLINE STRUCTURE INFORMATION, SEE SHEETS 134-259.
- 6) FOR SIGN ELEVATIONS, SEE SHEETS 127-128.

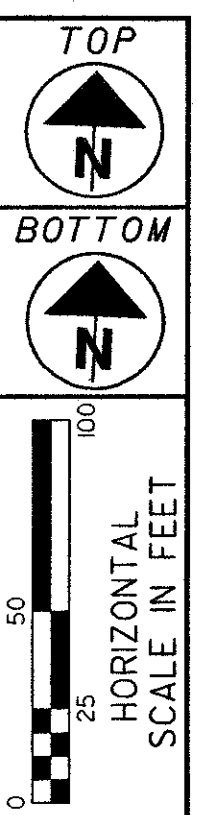

PLAN STA. 698+00 TO STA. 726+00

PRE-70-0.00

REVISIONS:
 1. DATE: 08/11/00
 2. DATE: 08/11/00
 3. DATE: 08/11/00


REVISIONS
 REVISION NUMBER
 REVISION DESCRIPTION
 REVISION DATE
 REVISION BY
 REVISION CHECKED BY
 REVISION APPROVED BY
 REVISION SCALE
 REVISION ELEVATION
 REVISION STATIONING
 REVISION TYPE

PAVEMENT MARKING LEGEND

- 1 4" EDGE LINE, WHITE
- 2 4" EDGE LINE, YELLOW
- 3 4" LANE LINE
- 4 8" CHANNELIZING LINE, WHITE
- 5 24" TRANSVERSE LINE, WHITE, 12' SPACING

SIGN LEGEND


- NEW SIGN
- EXISTING SIGN, TO REMAIN
- EXISTING SIGN, TO BE REMOVED
- RO INDICATES SIGN TO BE CONSIDERED FOR REMOVAL AND REERECTION. REMOVAL AND REERECTION BY OTHERS.

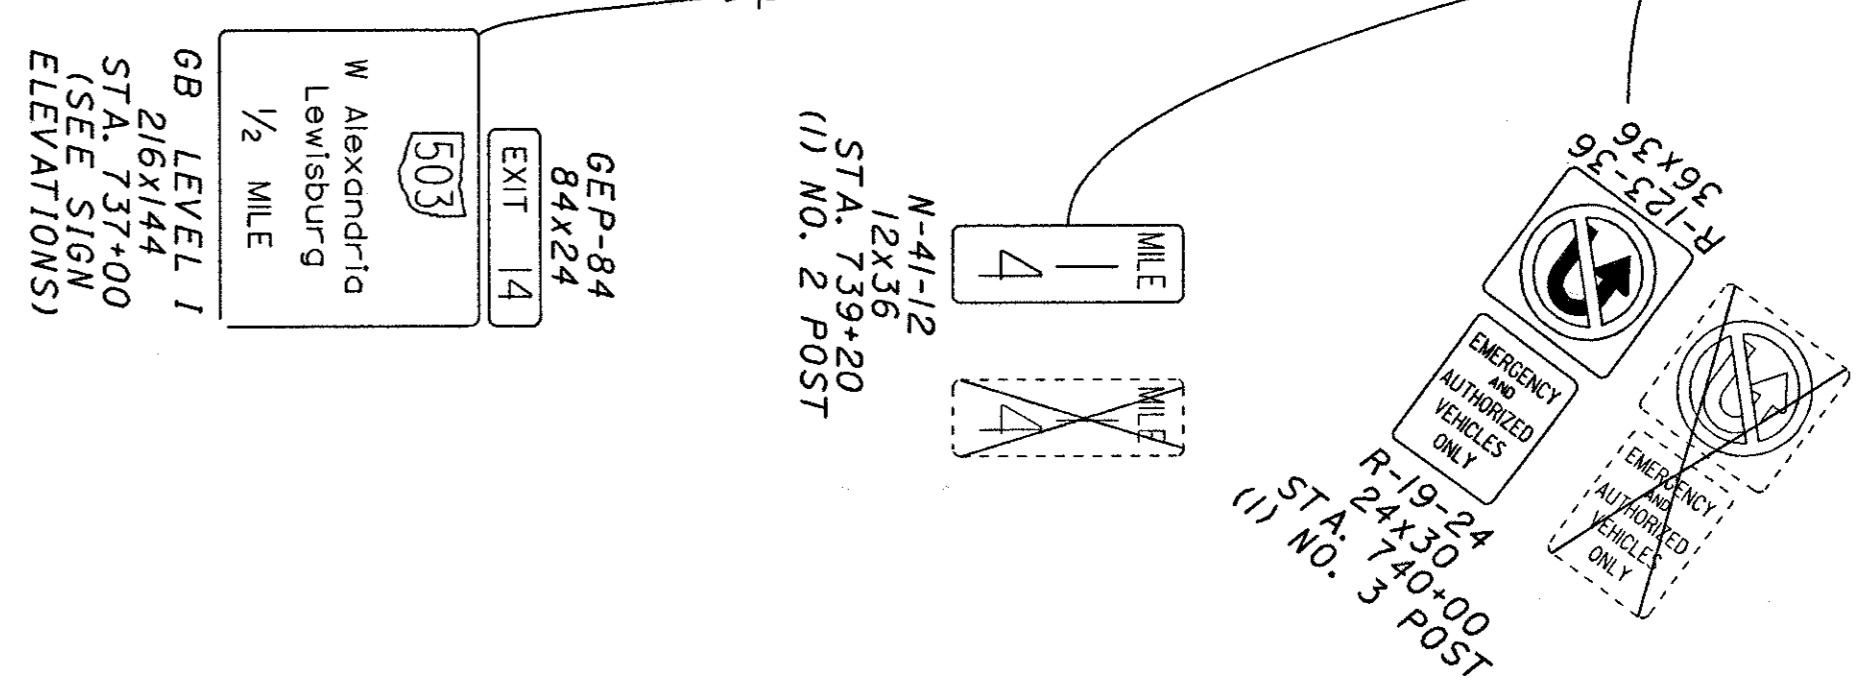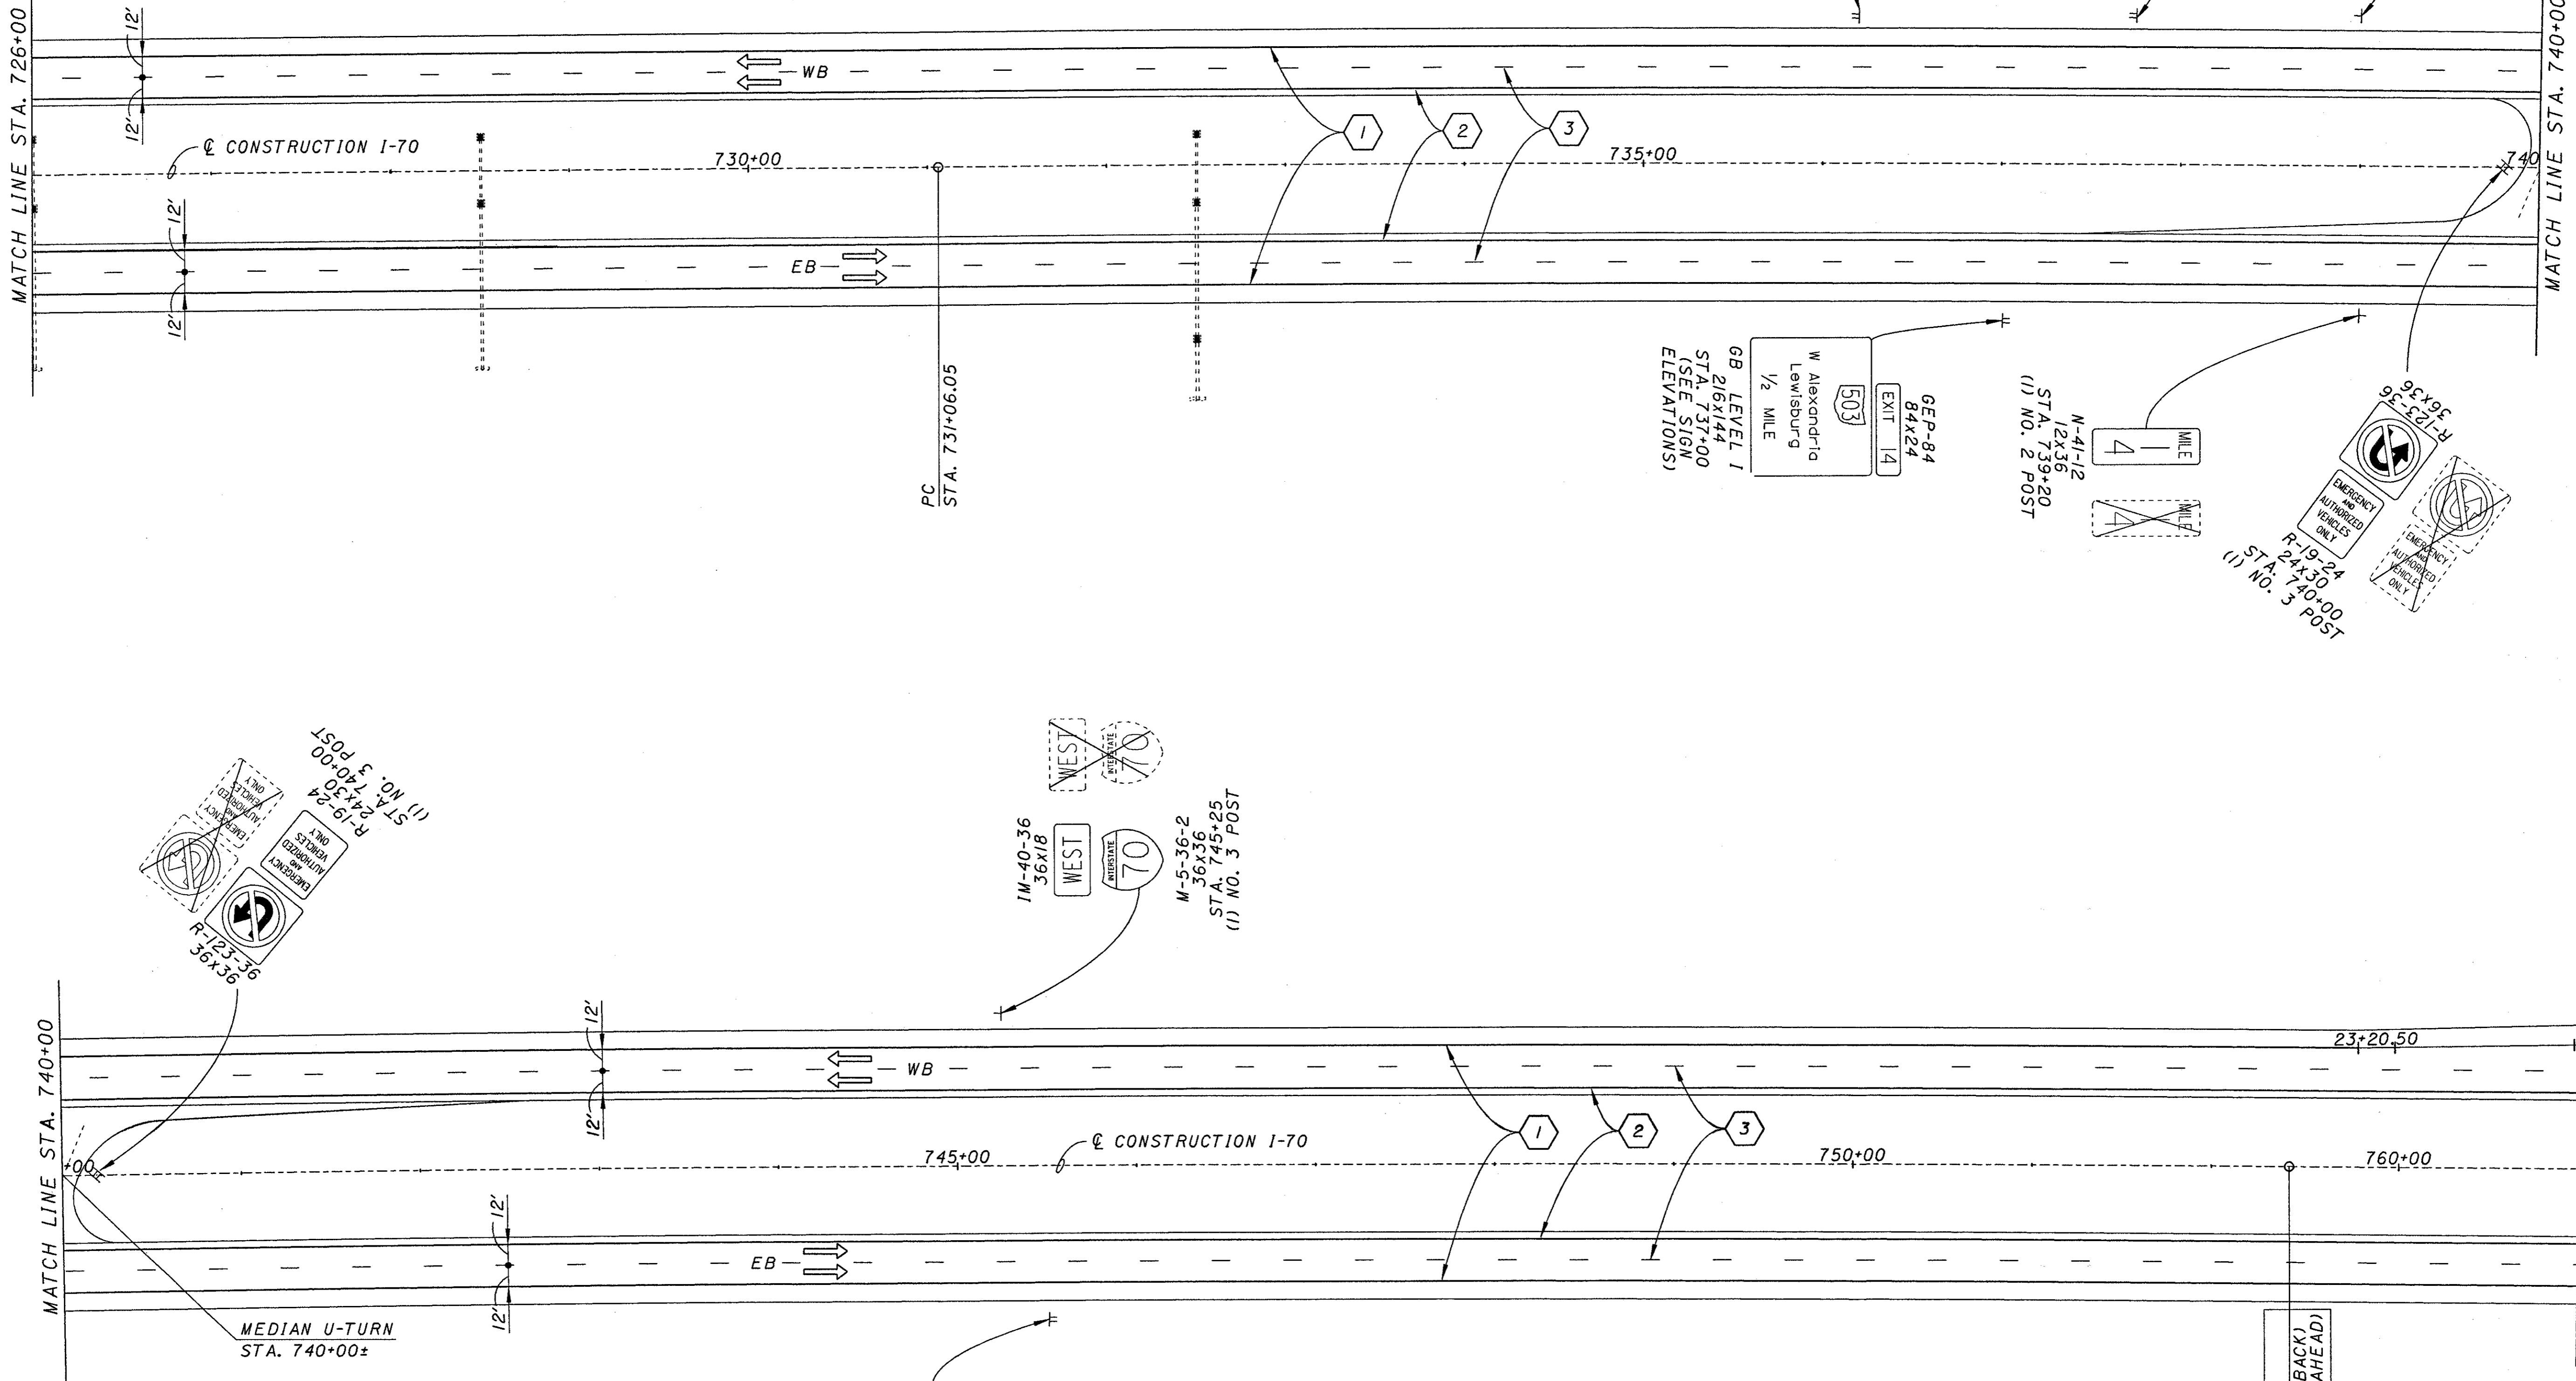

NOTES


- 1) FOR MEDIAN U-TURN INFORMATION, SEE SHEET 125.
- 2) FOR SIGN ELEVATIONS, SEE SHEETS 127-128.

STATION EQUATION
 PT STA. 752+43.55 (BACK)
 PT STA. 759+38.82 (AHEAD)

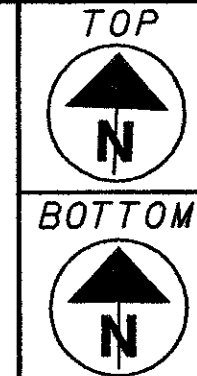

PLAN
 STA. 726+00 TO STA. 761+00

PRE-70-0.00

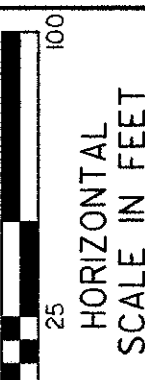

PLAN STA. 761+00 TO STA. 789+00

PRE-70-0.00

PAVEMENT MARKING LEGEND


- 1 4" EDGE LINE, WHITE
- 2 4" EDGE LINE, YELLOW
- 3 4" LANE LINE
- 4 8" CHANNELIZING LINE, WHITE
- 5 24" TRANSVERSE LINE, WHITE, 12' SPACING
- 6 4" DOUBLE YELLOW LINE

SIGN LEGEND

- NEW SIGN
- EXISTING SIGN, TO REMAIN
- EXISTING SIGN, TO BE REMOVED
- R0 INDICATES SIGN TO BE CONSIDERED FOR REMOVAL AND REERECTION. REMOVAL AND REERECTION BY OTHERS.

NOTES

- 1) CONSTRUCT A NEW CONCRETE BARRIER TRANSITION AS PER STANDARD DRAWING RM-4.5M. SEAL WITH EPOXY URETHANE. FOR FURTHER INFORMATION, SEE SHEET 123.
- 2) FOR OVERHEAD STRUCTURE INFORMATION, SEE SHEETS 260-283.
- 3) FOR FULL DEPTH PAVEMENT WIDENING INFORMATION, SEE SHEETS 49-115.
- 4) FOR SIGN ELEVATIONS, SEE SHEETS 127-128.

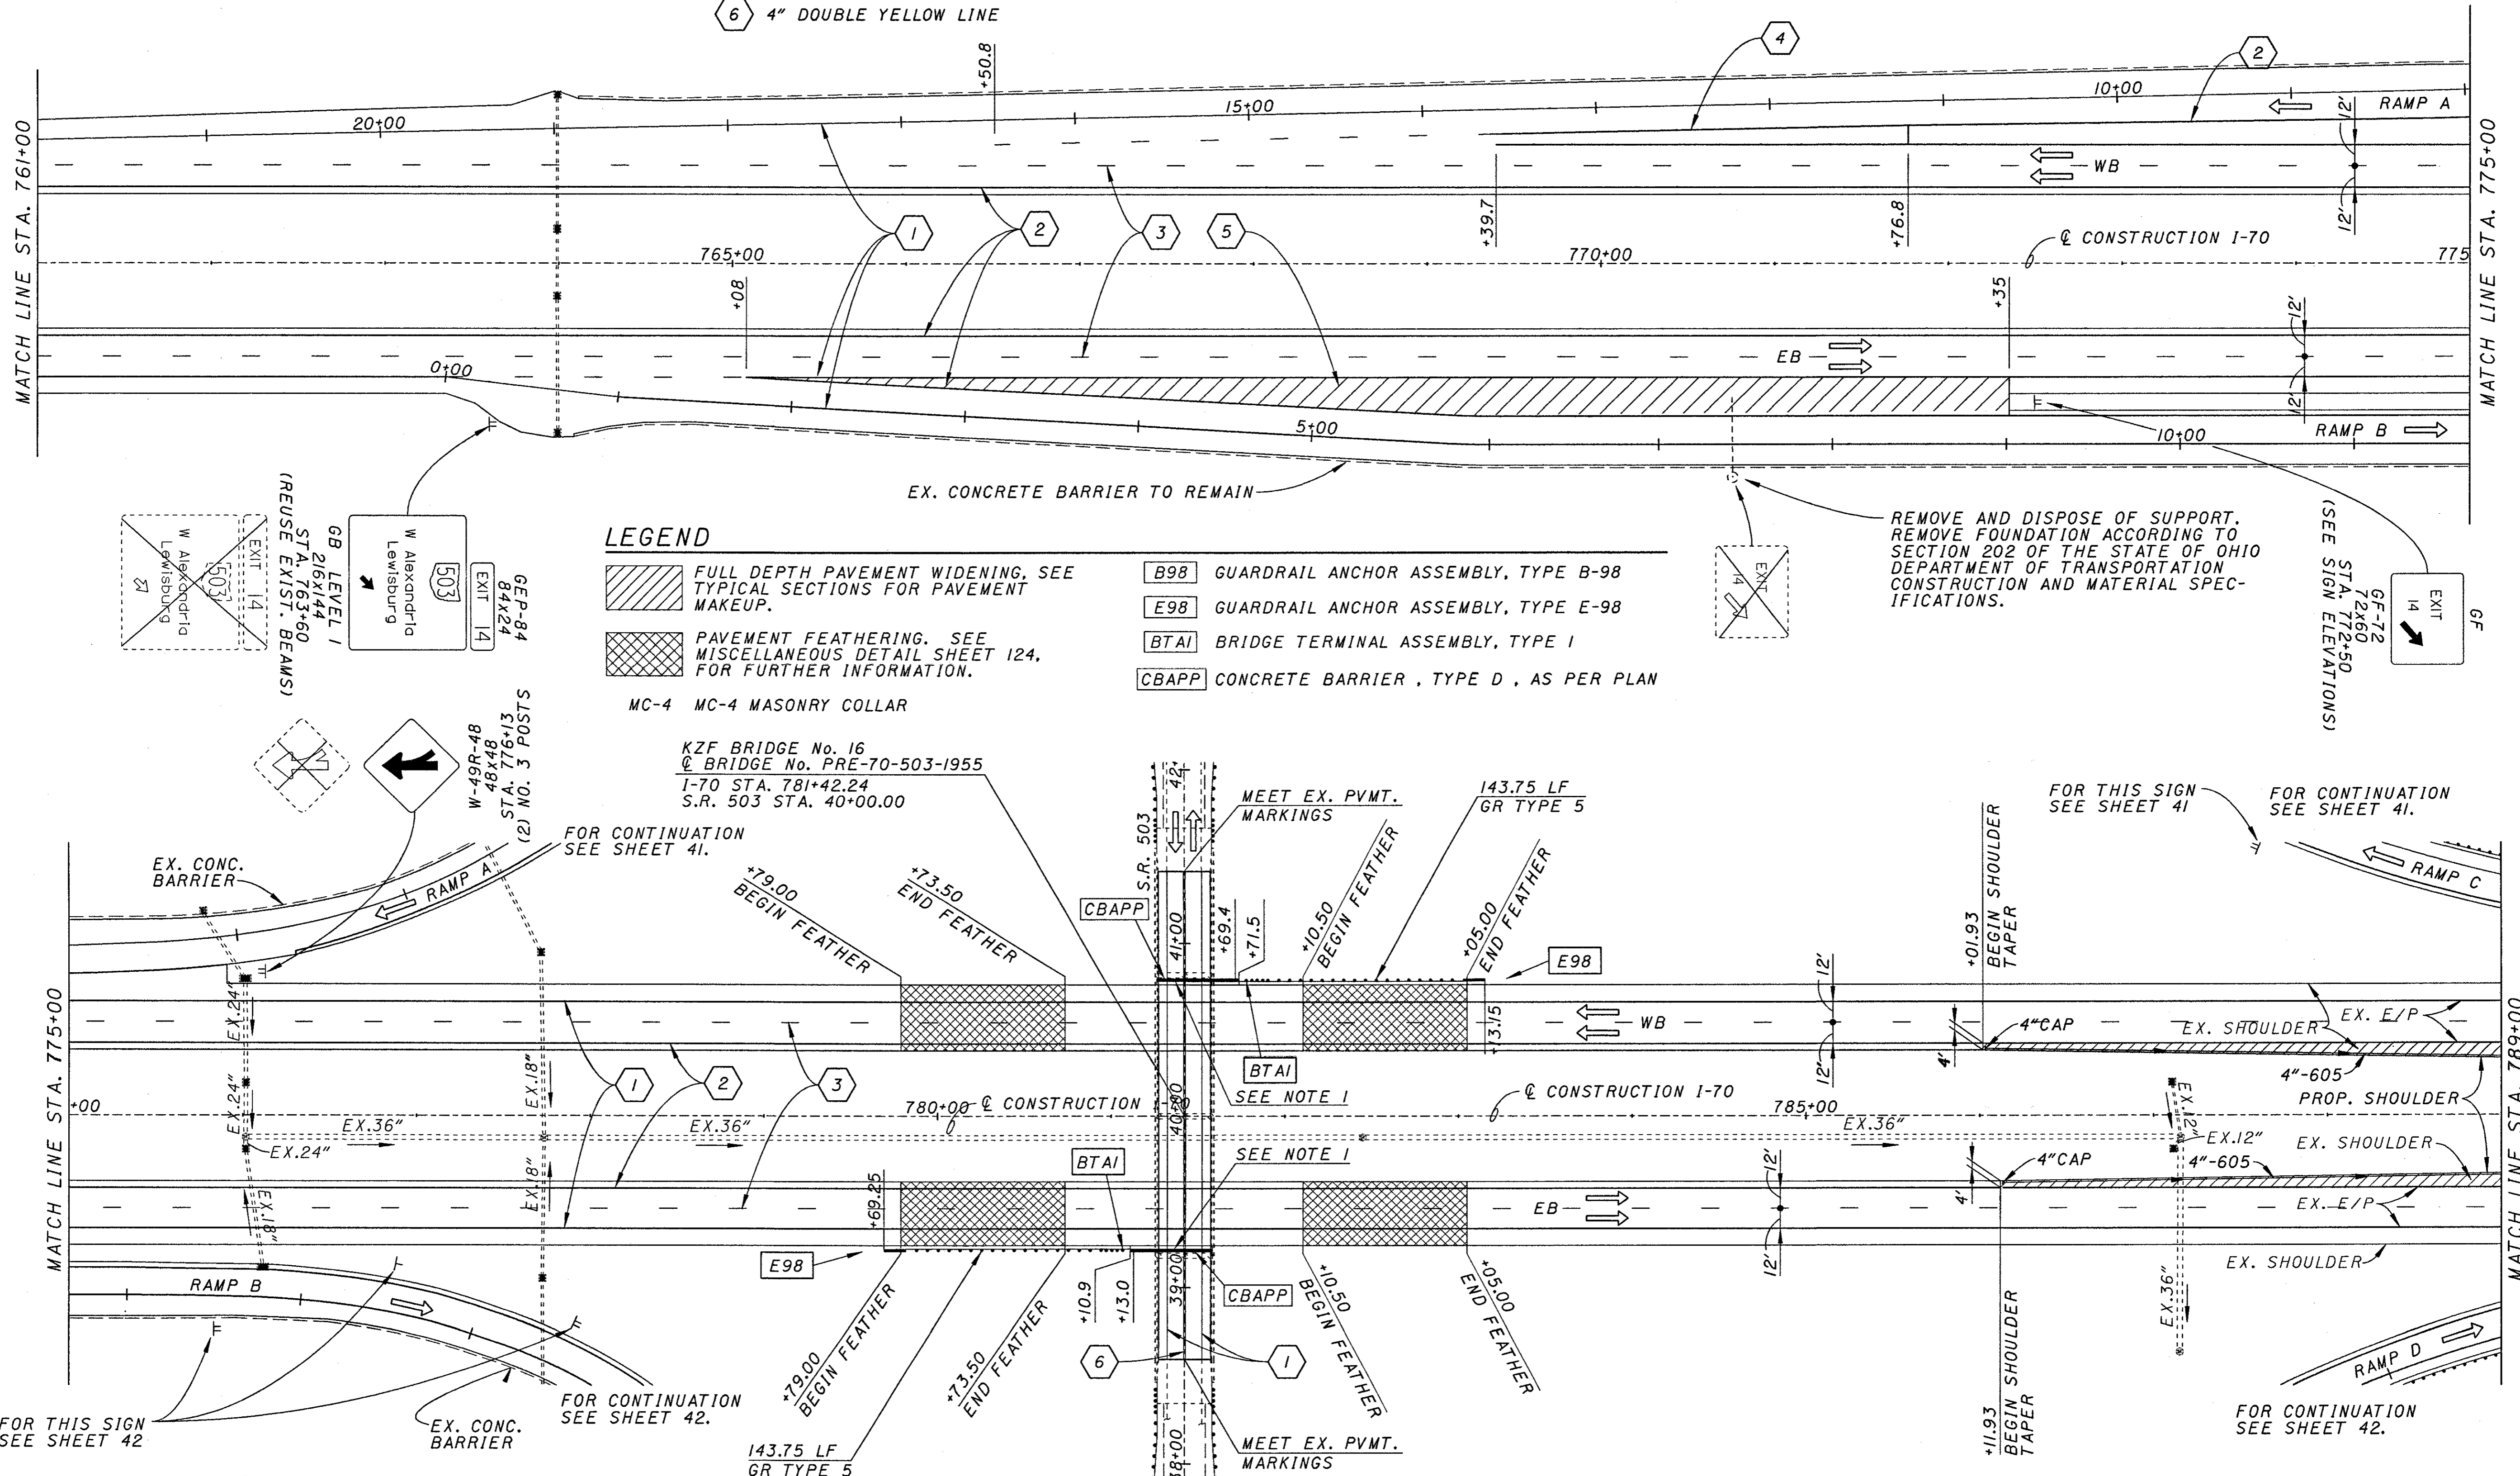

LEGEND

- FULL DEPTH PAVEMENT WIDENING, SEE TYPICAL SECTIONS FOR PAVEMENT MAKEUP.
- PAVEMENT FEATHERING. SEE MISCELLANEOUS DETAIL SHEET 124, FOR FURTHER INFORMATION.
- MC-4 MC-4 MASONRY COLLAR
- B98 GUARDRAIL ANCHOR ASSEMBLY, TYPE B-98
- E98 GUARDRAIL ANCHOR ASSEMBLY, TYPE E-98
- BTAI BRIDGE TERMINAL ASSEMBLY, TYPE I
- CBAPP CONCRETE BARRIER, TYPE D, AS PER PLAN

*****REFORM*****
 USCA USER NAME *****
 REF: *****
 REF: *****
 ACTIVE LEVELS ON **LEVE**

FOR THIS SIGN SEE SHEET 42

FOR CONTINUATION SEE SHEET 42.

143.75 LF GR TYPE 5

MEET EX. PVMT. MARKINGS

+11.93 BEGIN SHOULDER TAPER

FOR CONTINUATION SEE SHEET 42.

GEP-84
 84x24
 EXIT 14
 W Alexander Rd
 Lewisburg
 (REUSE EXIST. BEAMS)
 STA. 163+60
 STA. 216+44
 GB LEVEL 1

W-49R-48
 48x48
 STA. 776+13
 (2) NO. 3 POSTS

KZF BRIDGE No. 16
 Q BRIDGE No. PRE-70-503-1955
 I-70 STA. 781+42.24
 S.R. 503 STA. 40+00.00

S.R. 503

143.75 LF GR TYPE 5

FOR THIS SIGN SEE SHEET 41

FOR CONTINUATION SEE SHEET 41.



0 25 50 100
HORIZONTAL SCALE IN FEET


PLAN
STA. 761+00 TO STA. 789+00

PRE-70-0.00

41
283

NOTES
1) FOR SIGN ELEVATIONS, SEE SHEETS 127-128.

- LEGEND**
- PAVEMENT FEATHERING. SEE MISCELLANEOUS DETAIL SHEET 124, FOR FURTHER INFORMATION.
 - BRIDGE TERMINAL ASSEMBLY, TYPE I
 - GUARDRAIL ANCHOR ASSEMBLY, TYPE E-98
 - GUARDRAIL ANCHOR ASSEMBLY, TYPE T
 - GUARDRAIL ANCHOR ASSEMBLY, TYPE A

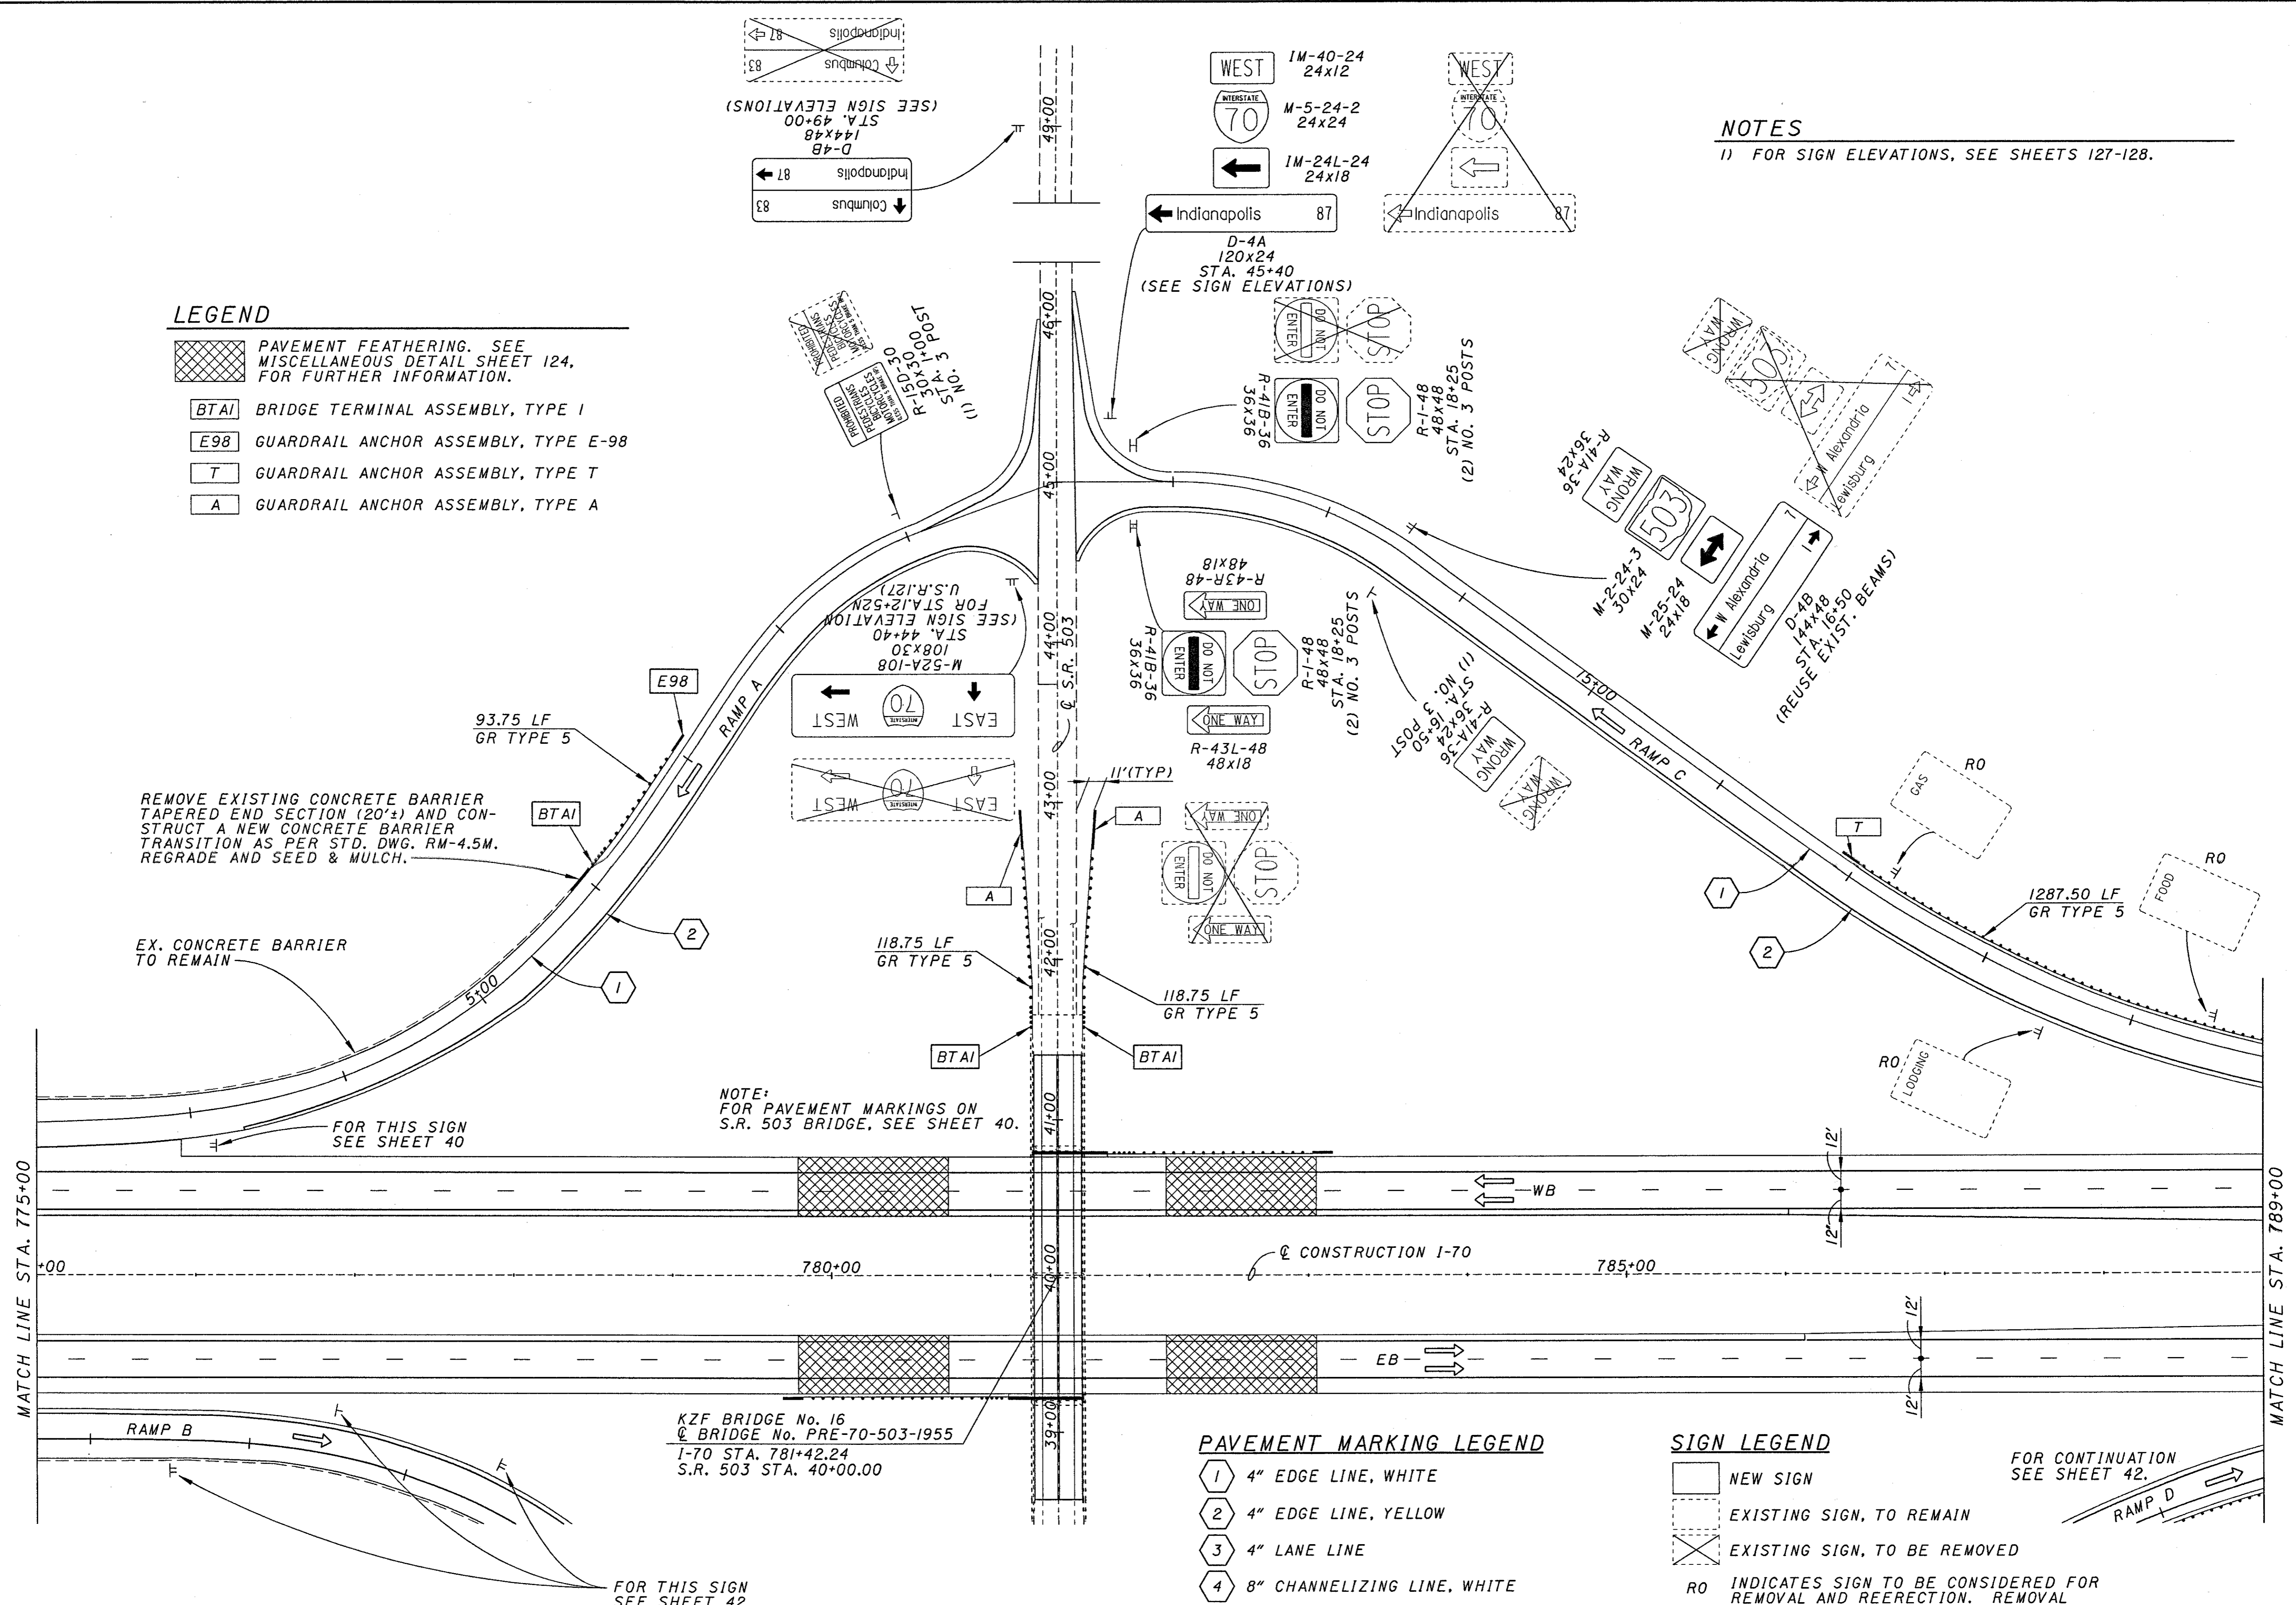

REMOVE EXISTING CONCRETE BARRIER TAPERED END SECTION (20'+) AND CONSTRUCT A NEW CONCRETE BARRIER TRANSITION AS PER STD. DWG. RM-4.5M. REGRADE AND SEED & MULCH.

EX. CONCRETE BARRIER TO REMAIN

FOR THIS SIGN SEE SHEET 40

NOTE: FOR PAVEMENT MARKINGS ON S.R. 503 BRIDGE, SEE SHEET 40.

KZF BRIDGE No. 16
BRIDGE No. PRE-70-503-1955
I-70 STA. 781+42.24
S.R. 503 STA. 40+00.00



FOR THIS SIGN SEE SHEET 42

- PAVEMENT MARKING LEGEND**
- 4" EDGE LINE, WHITE
 - 4" EDGE LINE, YELLOW
 - 4" LANE LINE
 - 8" CHANNELIZING LINE, WHITE
 - 24" TRANSVERSE LINE, WHITE, 12' SPACING

- SIGN LEGEND**
- NEW SIGN
 - EXISTING SIGN, TO REMAIN
 - EXISTING SIGN, TO BE REMOVED
 - RO INDICATES SIGN TO BE CONSIDERED FOR REMOVAL AND REERECTION. REMOVAL AND REERECTION BY OTHERS.

FOR CONTINUATION SEE SHEET 42.

USDA

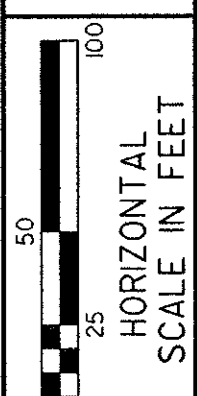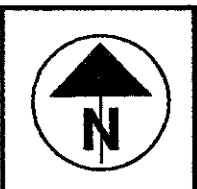

PLAN
STA. 761+00 TO STA. 789+00

PRE-70-0.00

LEGEND

- PAVEMENT FEATHERING. SEE MISCELLANEOUS DETAIL SHEET 124. FOR FURTHER INFORMATION.
- BRIDGE TERMINAL ASSEMBLY, TYPE I
- GUARDRAIL ANCHOR ASSEMBLY, TYPE E-98
- GUARDRAIL ANCHOR ASSEMBLY, TYPE A


FOR CONTINUATION SEE SHEET 41.

FOR CONTINUATION SEE SHEET 41.

FOR THIS SIGN SEE SHEET 40

KZF BRIDGE No. 16
 @ BRIDGE No. PRE-70-503-1955
 I-70 STA. 781+42.24
 S.R. 503 STA. 40+00.00

NOTE:
 FOR PAVEMENT MARKINGS ON
 S.R. 503 BRIDGE, SEE SHEET 40.

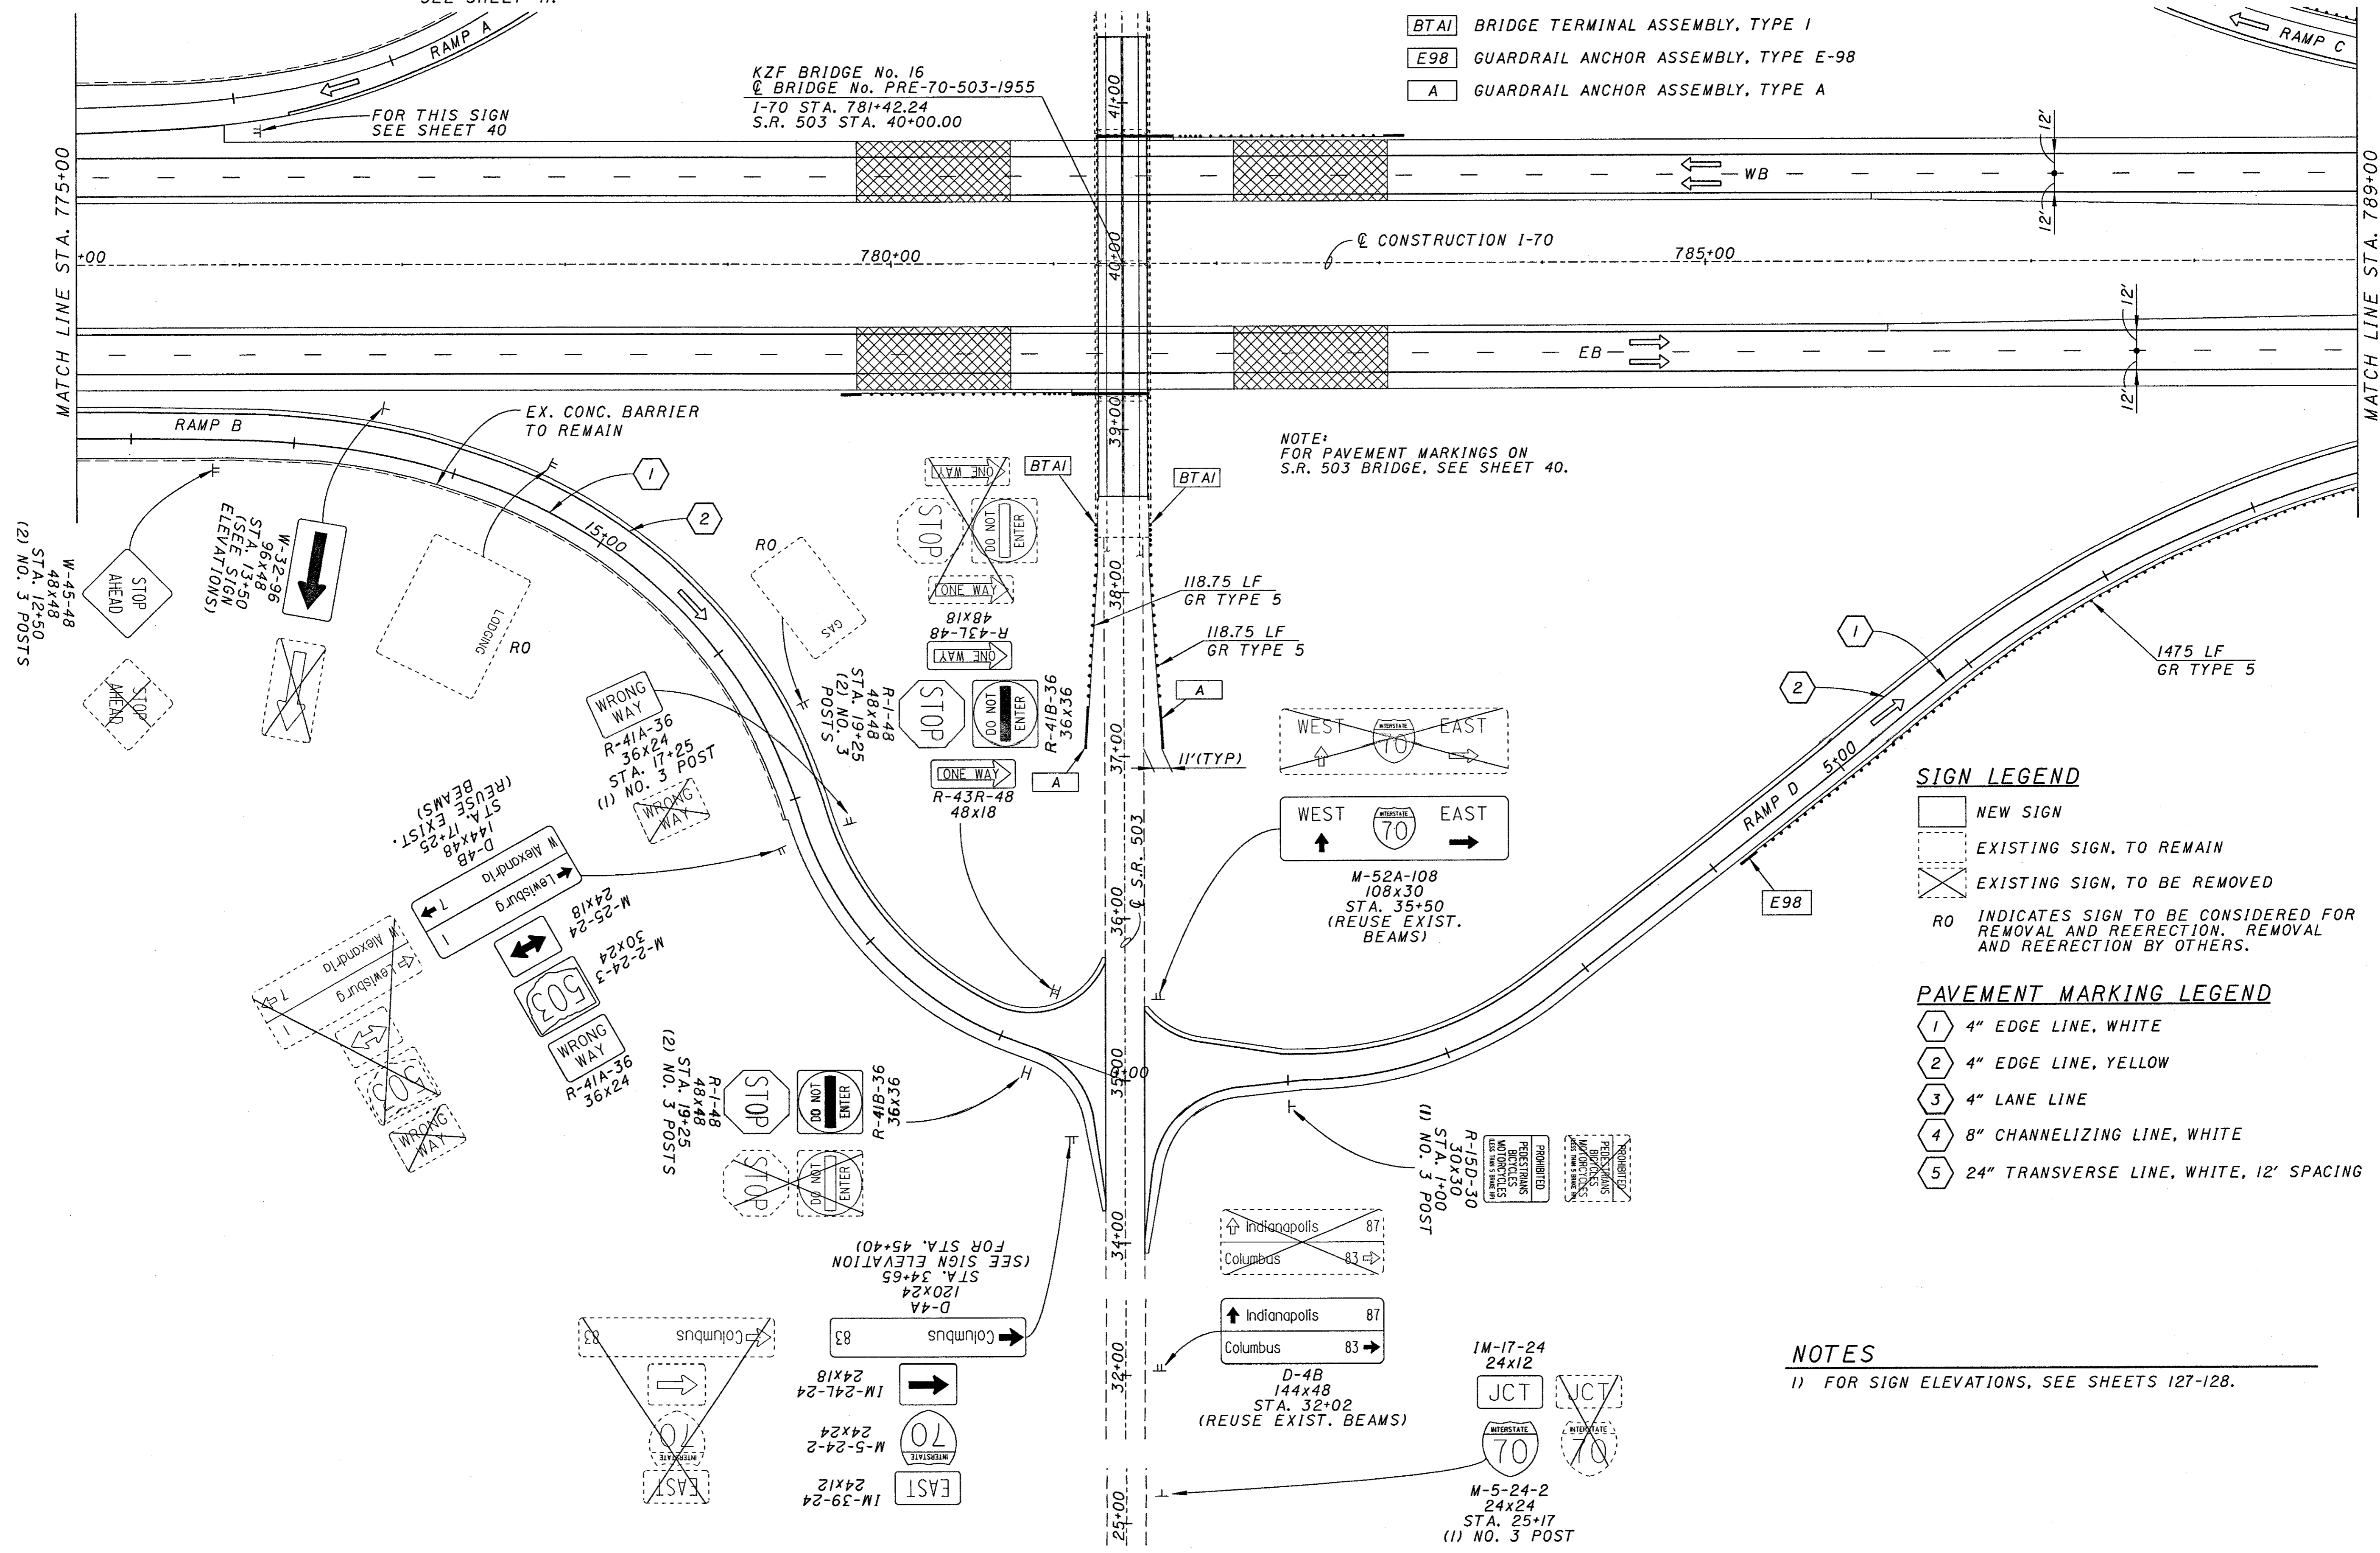

SIGN LEGEND

- NEW SIGN
- EXISTING SIGN, TO REMAIN
- EXISTING SIGN, TO BE REMOVED
- RO INDICATES SIGN TO BE CONSIDERED FOR REMOVAL AND REERECTION. REMOVAL AND REERECTION BY OTHERS.

PAVEMENT MARKING LEGEND

- 4" EDGE LINE, WHITE
- 4" EDGE LINE, YELLOW
- 4" LANE LINE
- 8" CHANNELIZING LINE, WHITE
- 24" TRANSVERSE LINE, WHITE, 12' SPACING

NOTES

1) FOR SIGN ELEVATIONS, SEE SHEETS 127-128.

*****REFORM*****
 USE FILED DRAWING INFORMATION*****
 REFORM*****REFORM*****
 REFORM*****REFORM*****
 REFORM*****REFORM*****
 ACTIVE LEVELS ON 8/16/88

PAVEMENT MARKING LEGEND

- 1 4" EDGE LINE, WHITE
- 2 4" EDGE LINE, YELLOW
- 3 4" LANE LINE
- 4 8" CHANNELIZING LINE, WHITE
- 5 24" TRANSVERSE LINE, WHITE, 12' SPACING



SIGN LEGEND

- [Solid] NEW SIGN
- [Dashed] EXISTING SIGN, TO REMAIN
- [Crossed] EXISTING SIGN, TO BE REMOVED
- RO INDICATES SIGN TO BE CONSIDERED FOR REMOVAL AND REERECTION. REMOVAL AND REERECTION BY OTHERS.

KZF BRIDGE No. 17
BRIDGE No. PRE-70-1500 L/R
TWIN CREEK, STA. 800+49.68

STA. 799+36.93
END APPROACH SLAB

STA. 801+62.43
BEGIN APPROACH SLAB

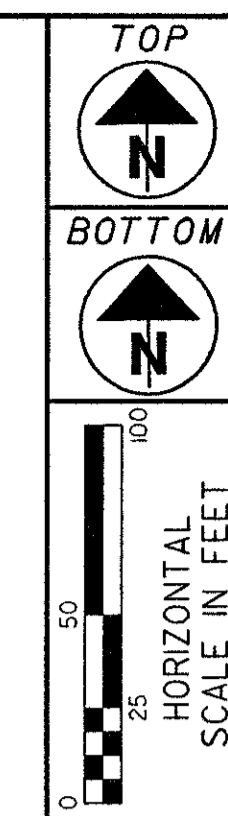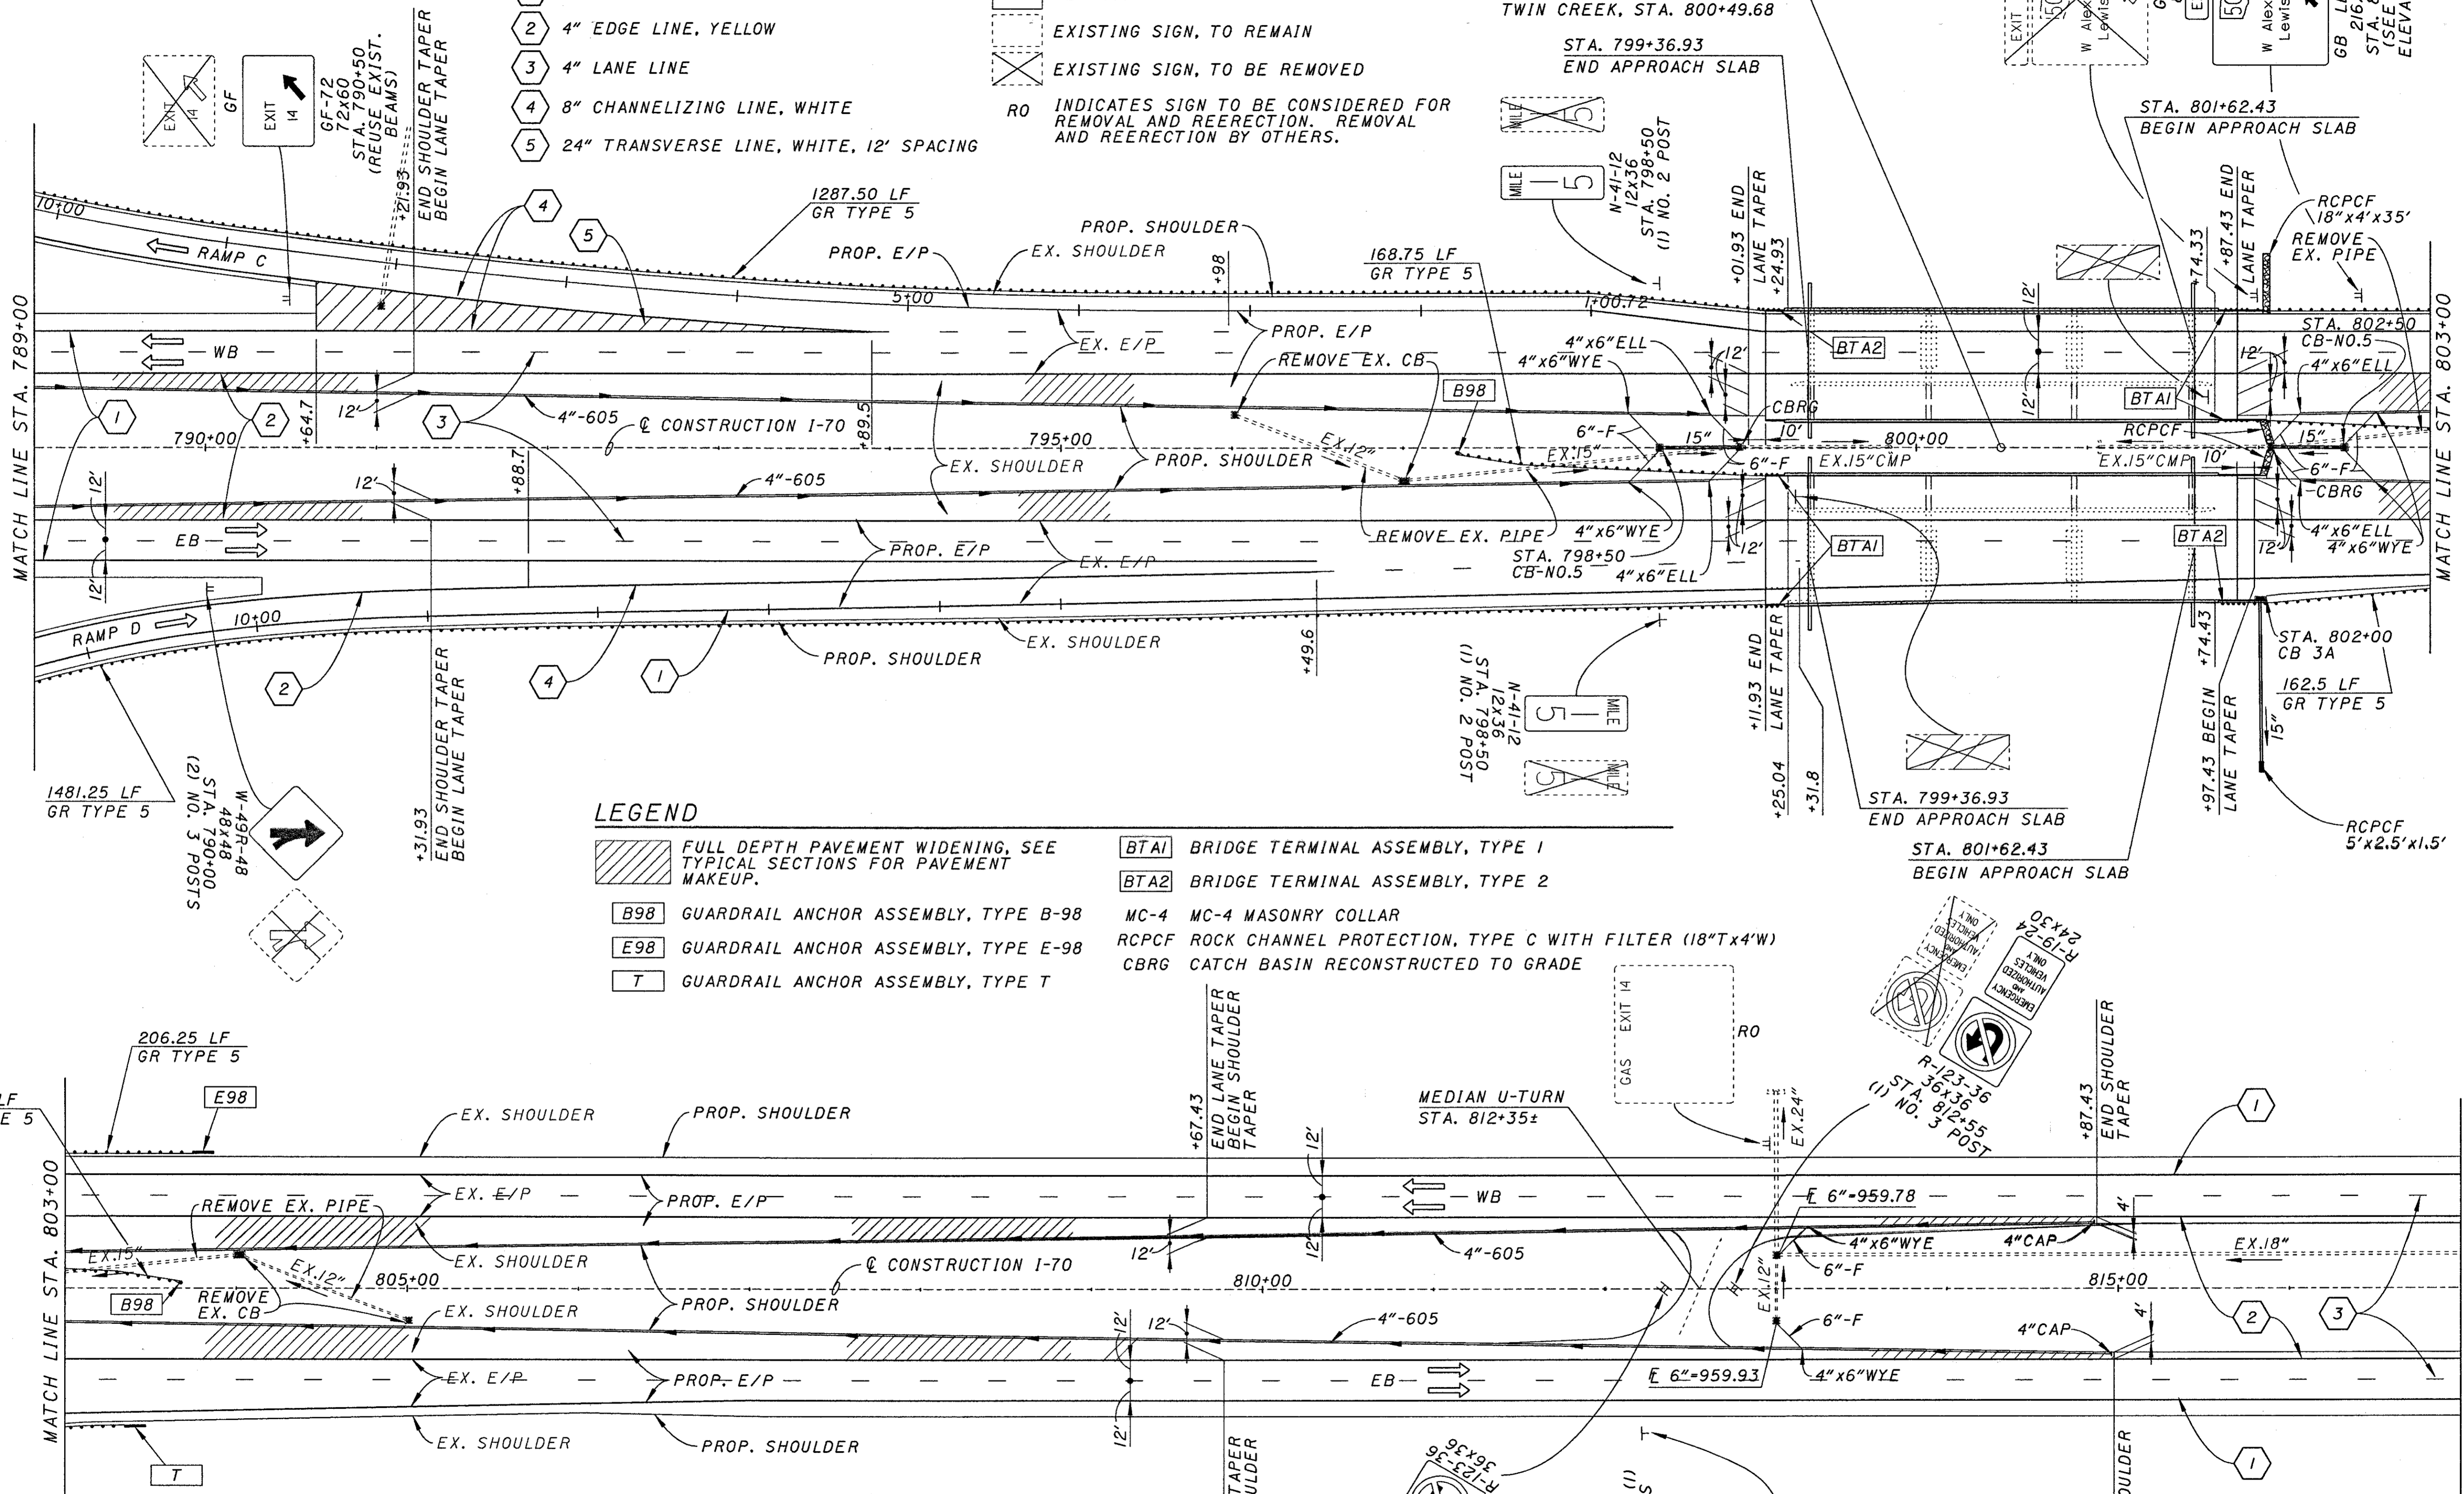

LEGEND

- [Hatched] FULL DEPTH PAVEMENT WIDENING, SEE TYPICAL SECTIONS FOR PAVEMENT MAKEUP.
- [B98] GUARDRAIL ANCHOR ASSEMBLY, TYPE B-98
- [E98] GUARDRAIL ANCHOR ASSEMBLY, TYPE E-98
- [T] GUARDRAIL ANCHOR ASSEMBLY, TYPE T
- [BTA1] BRIDGE TERMINAL ASSEMBLY, TYPE 1
- [BTA2] BRIDGE TERMINAL ASSEMBLY, TYPE 2
- MC-4 MC-4 MASONRY COLLAR
- RCPCF ROCK CHANNEL PROTECTION, TYPE C WITH FILTER (18"x4'w)
- CBRG CATCH BASIN RECONSTRUCTED TO GRADE


NOTES

- 1) FOR FULL DEPTH PAVEMENT WIDENING, SEE SHEETS 64 AND 108.
- 2) FOR MAINLINE STRUCTURE INFORMATION, SEE SHEETS 134-259.
- 3) FOR DRAINAGE DETAIL @ STA. 802+00 RT, SEE SHEET 126.
- 4) FOR MEDIAN U-TURN INFORMATION, SEE SHEET 125.
- 5) FOR SIGN ELEVATIONS, SEE SHEETS 127-128.
- 6) FOR CURB DEATIL AT MAINLINE BRIDGE, SEE SHEET 123. FOR ADDITIONAL CURB INFORMATION SEE MAINLINE BRIDGE SITE PLAN, SHEET 228.

REVISIONS:
DATE
BY
CHECKED
APPROVED

ACTIVE LEVELS ON SHEETS

PLAN
STA. 789+00 TO STA. 817+00
PRE-70-0.00

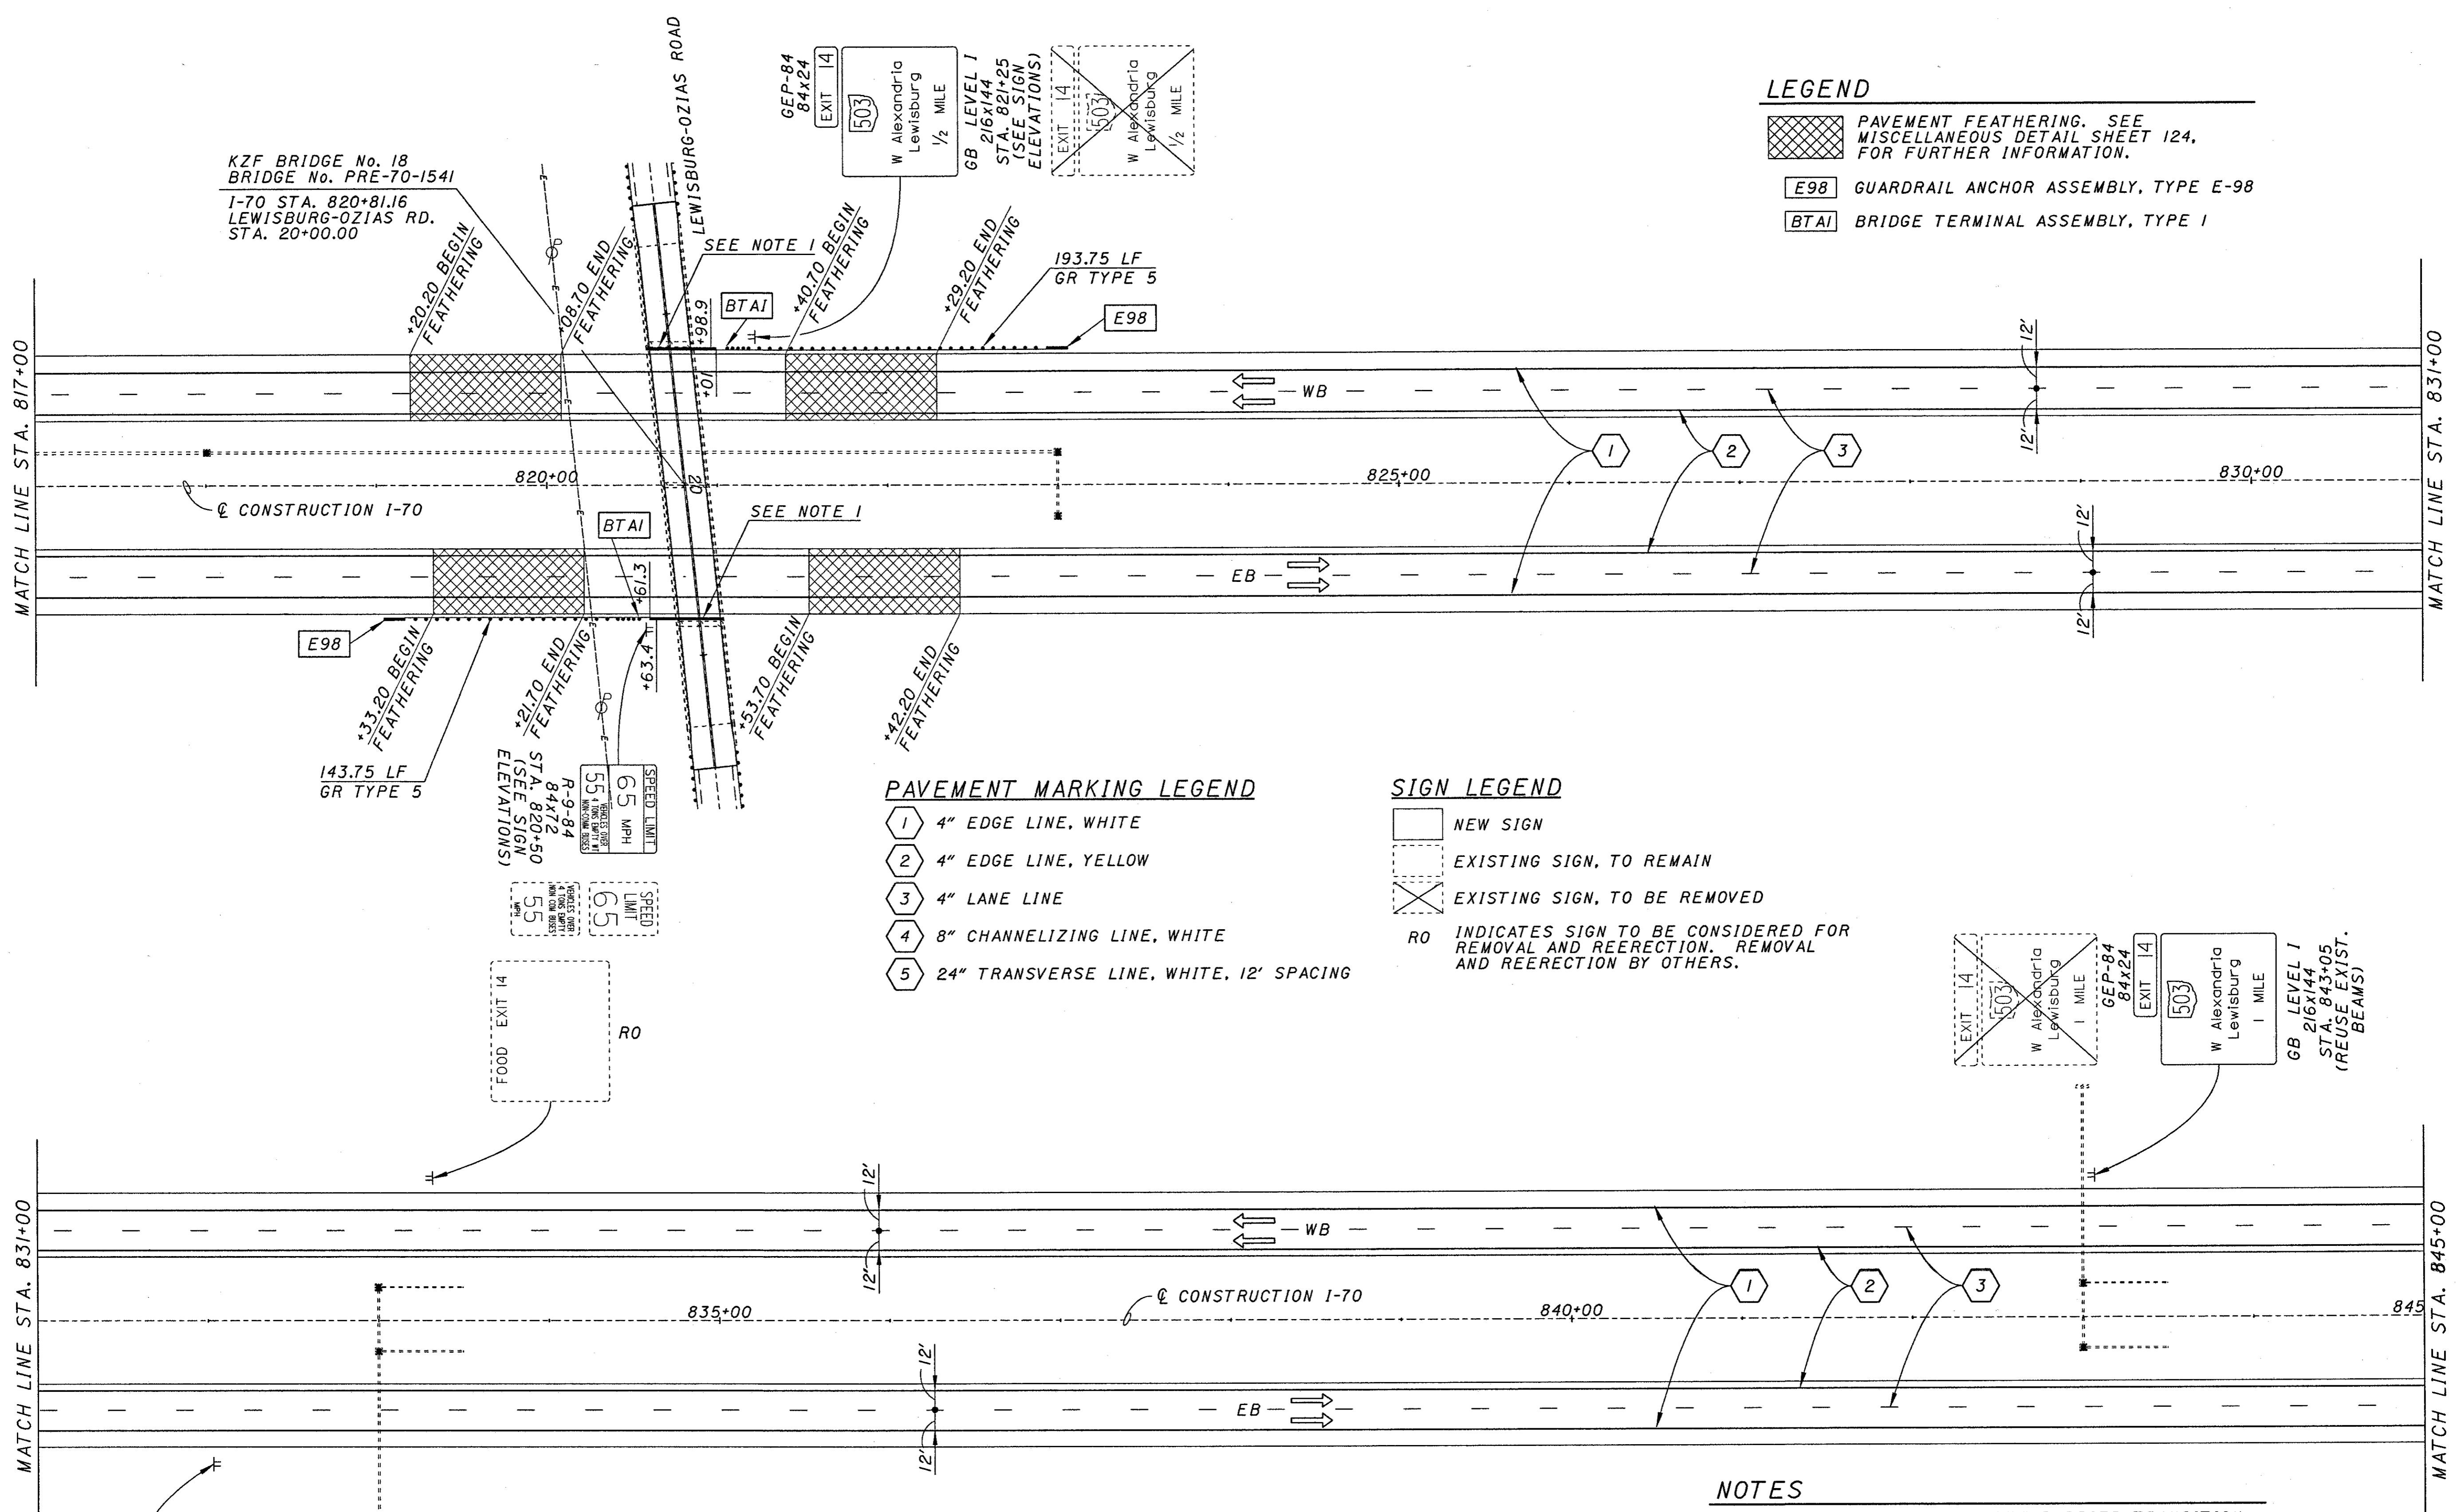

LEGEND

PAVEMENT FEATHERING. SEE MISCELLANEOUS DETAIL SHEET 124. FOR FURTHER INFORMATION.

GUARDRAIL ANCHOR ASSEMBLY, TYPE E-98

BRIDGE TERMINAL ASSEMBLY, TYPE I

PAVEMENT MARKING LEGEND

1 4" EDGE LINE, WHITE

2 4" EDGE LINE, YELLOW

3 4" LANE LINE

4 8" CHANNELIZING LINE, WHITE

5 24" TRANSVERSE LINE, WHITE, 12' SPACING

SIGN LEGEND

NEW SIGN

EXISTING SIGN, TO REMAIN

EXISTING SIGN, TO BE REMOVED

RO INDICATES SIGN TO BE CONSIDERED FOR REMOVAL AND REERECTION. REMOVAL AND REERECTION BY OTHERS.

NOTES

- 1) CONSTRUCT A NEW CONCRETE BARRIER TRANSITION AS PER STANDARD DRAWING RM-4.5M. SEAL WITH EPOXY URETHANE. FOR FURTHER INFORMATION, SEE SHEET 123.
- 2) FOR CROSS ROAD INFORMATION, SEE SHEETS 116-122.
- 3) FOR OVERHEAD STRUCTURE INFORMATION, SEE SHEETS 260-283.
- 4) FOR SIGN ELEVATIONS, SEE SHEETS 127-128.

KZF BRIDGE No. 18
 BRIDGE No. PRE-70-1541
 I-70 STA. 820+81.16
 LEWISBURG-OZIAS RD.
 STA. 20+00.00

143.75 LF
 GR TYPE 5


193.75 LF
 GR TYPE 5

61
 180x84
 STA. 832+00.
 (REUSE EXIST.
 BEAMS)

Doyton
 Columbus
 19
 26
 83

REF: **REF**
 DES: **DES**
 CON: **CON**
 ACT: **ACT**

 DESIGNED BY: [REDACTED]
 DRAWN BY: [REDACTED]
 CHECKED BY: [REDACTED]
 DATE: [REDACTED]
 PROJECT: [REDACTED]
 SHEET: [REDACTED] OF [REDACTED]
 TITLE: [REDACTED]

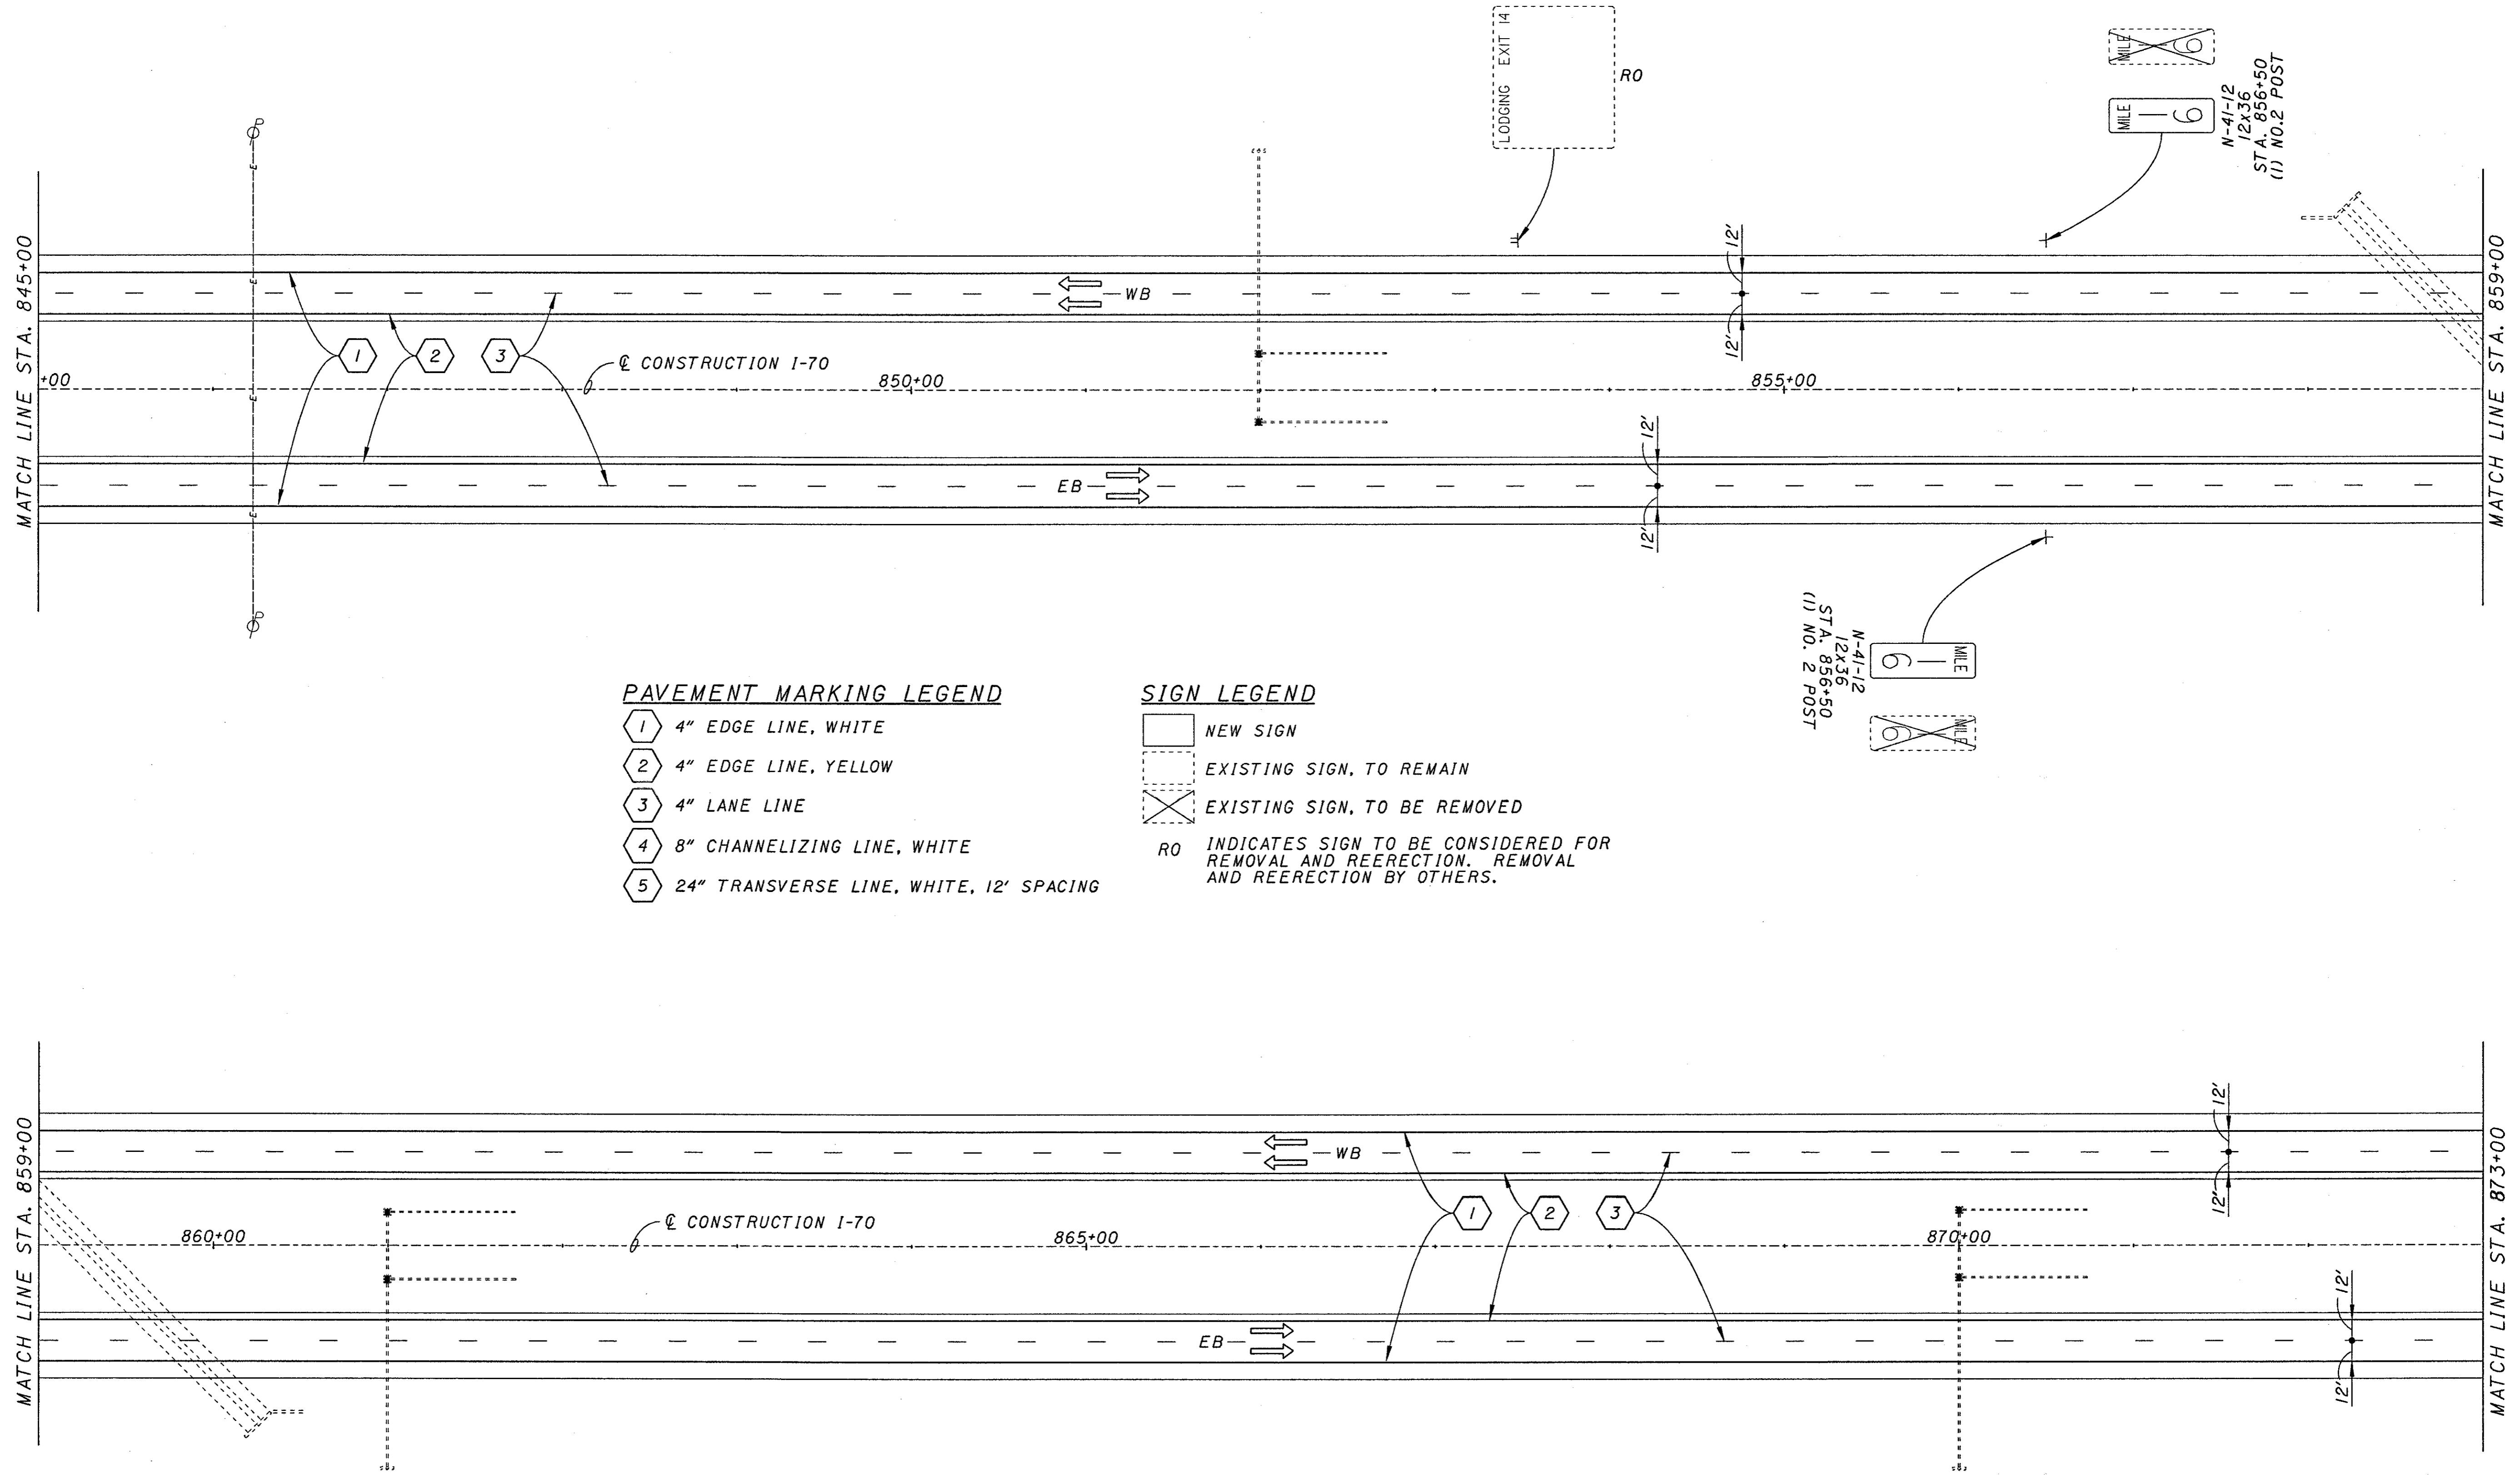


PAVEMENT MARKING LEGEND

- 1 4" EDGE LINE, WHITE
- 2 4" EDGE LINE, YELLOW
- 3 4" LANE LINE
- 4 8" CHANNELIZING LINE, WHITE
- 5 24" TRANSVERSE LINE, WHITE, 12' SPACING

SIGN LEGEND


- [Solid Box] NEW SIGN
- [Dashed Box] EXISTING SIGN, TO REMAIN
- [Crossed Box] EXISTING SIGN, TO BE REMOVED
- RO INDICATES SIGN TO BE CONSIDERED FOR REMOVAL AND REERECTION. REMOVAL AND REERECTION BY OTHERS.

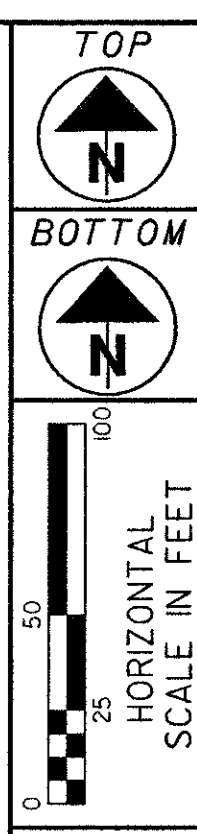

PLAN
STA. 845+00 TO STA. 873+00

PRE-70-0.00

 USER: *****
 PROJECT: *****
 SHEET: *****
 DATE: *****
 ACTIVE LEVELS ON: *****

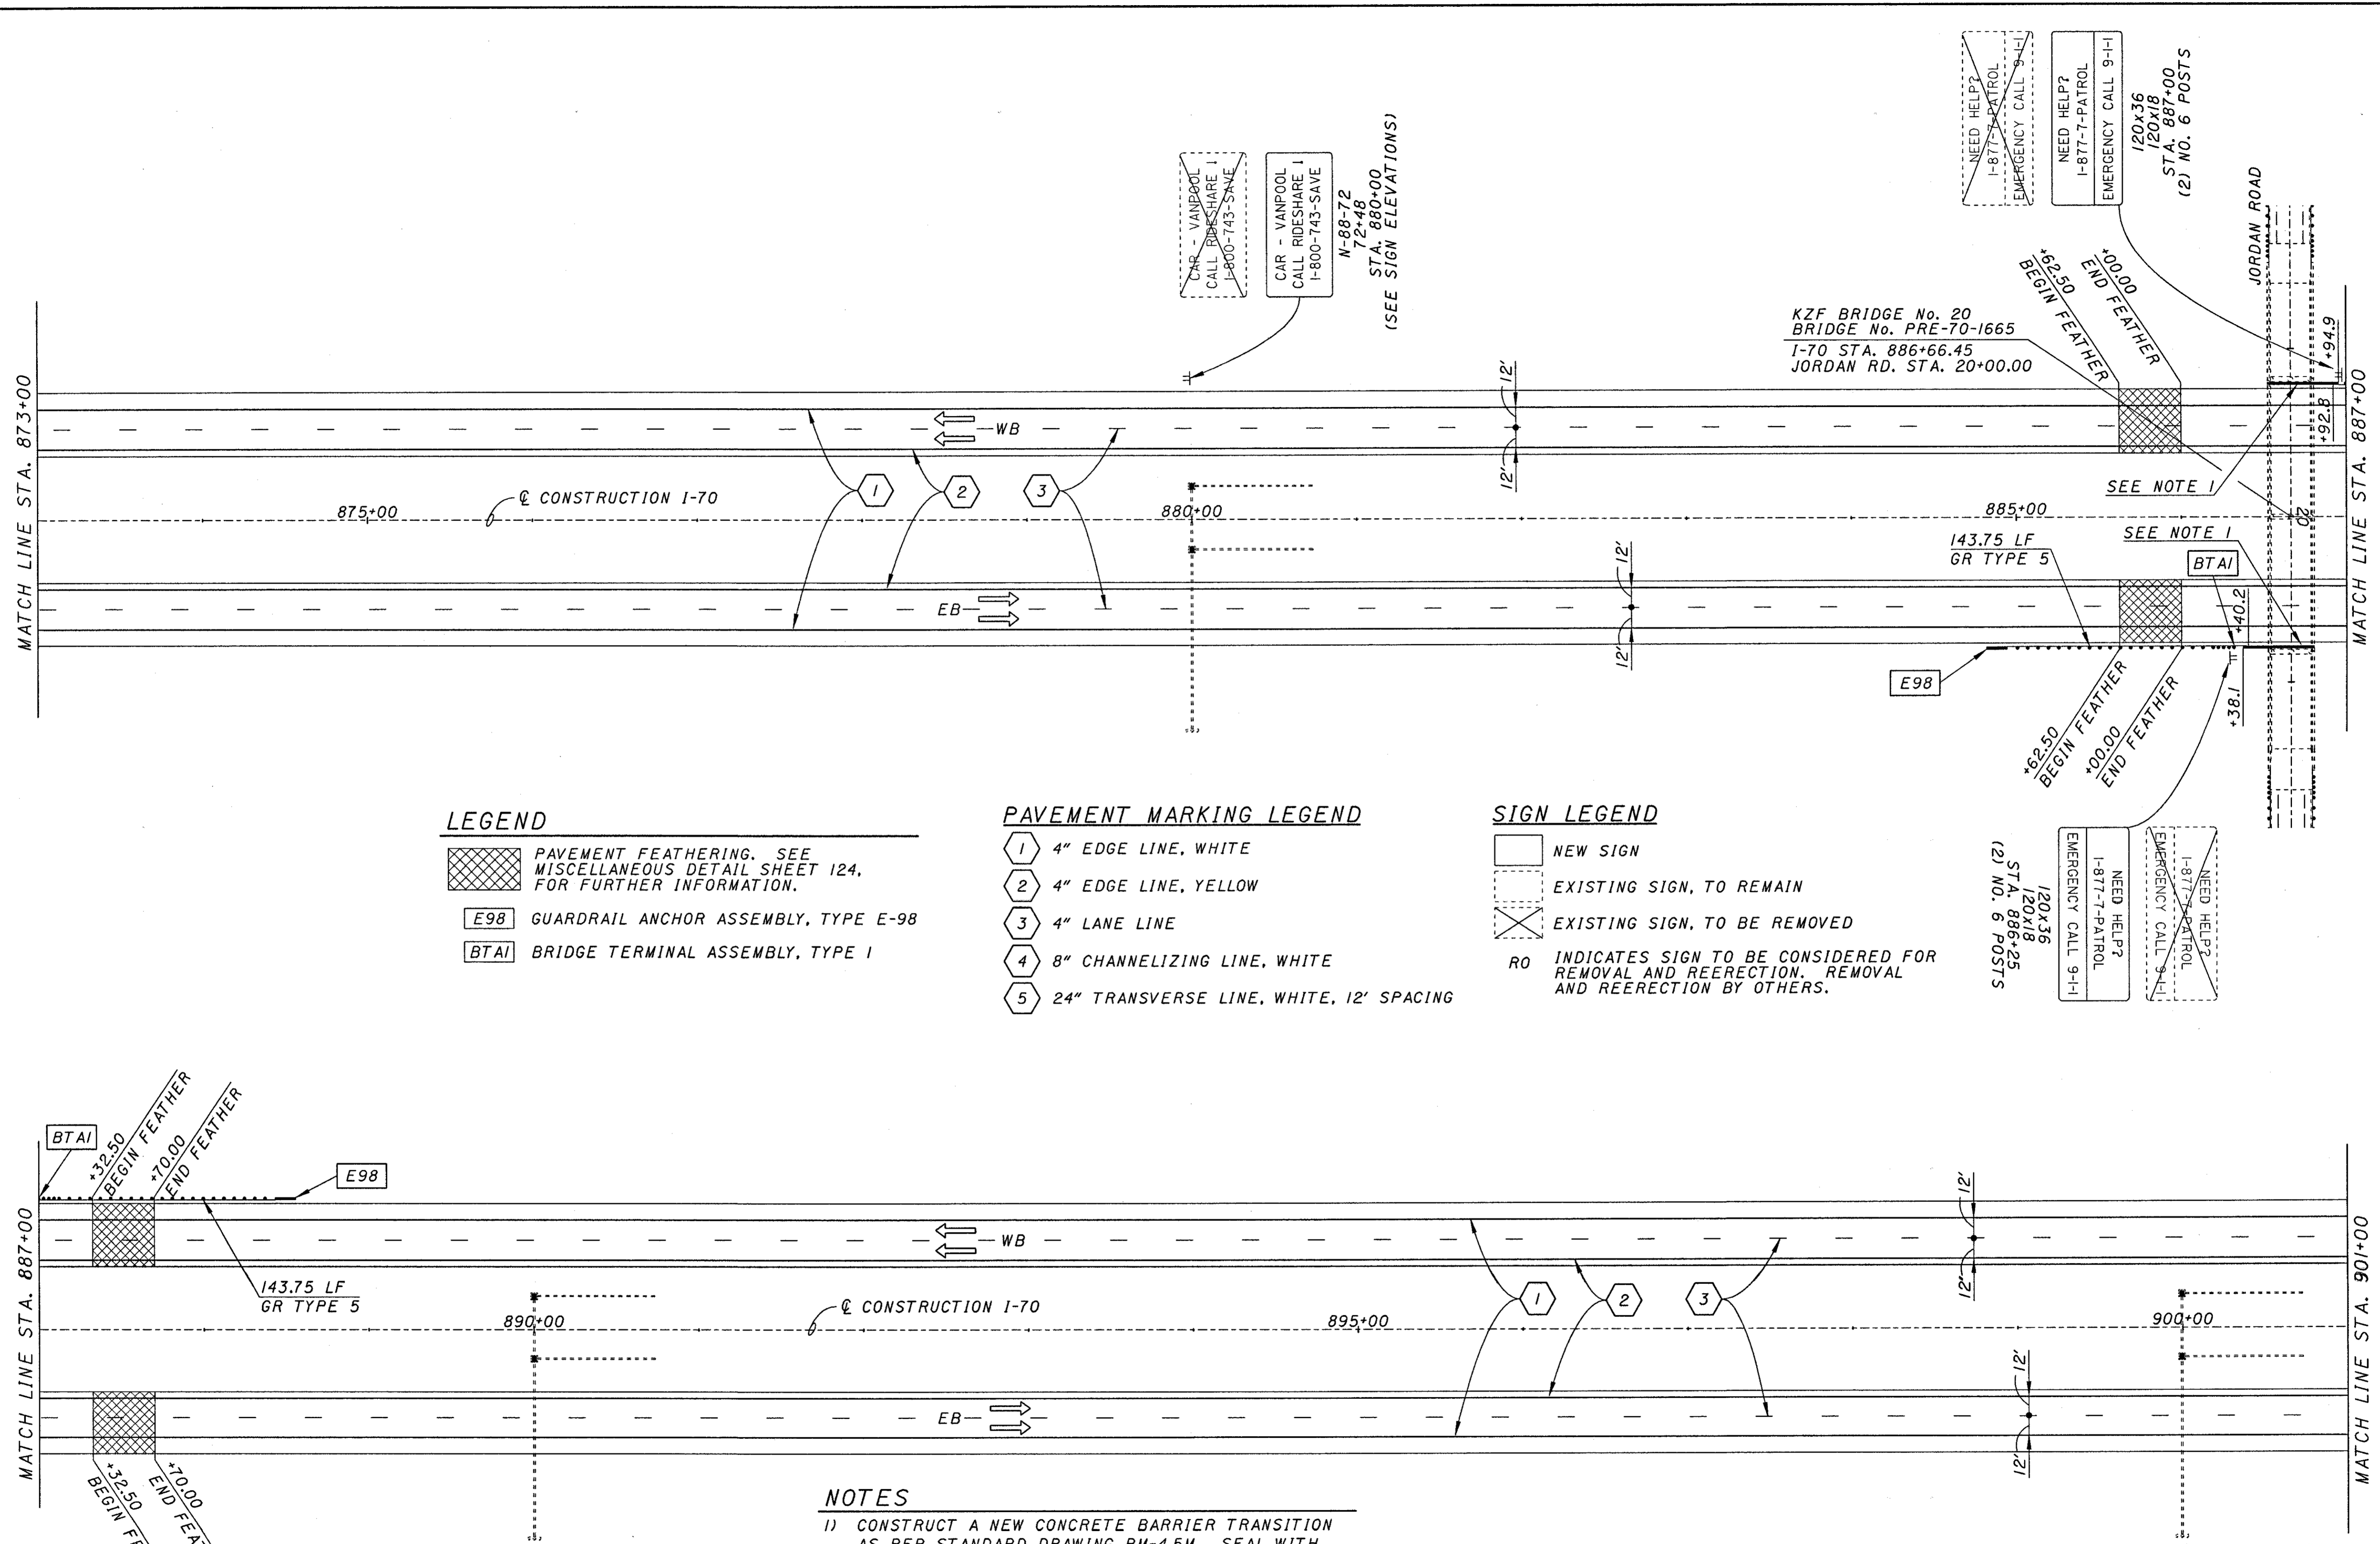

LEGEND

- PAVEMENT FEATHERING. SEE MISCELLANEOUS DETAIL SHEET 124, FOR FURTHER INFORMATION.
- GUARDRAIL ANCHOR ASSEMBLY, TYPE E-98
- BRIDGE TERMINAL ASSEMBLY, TYPE I

PAVEMENT MARKING LEGEND


- 4" EDGE LINE, WHITE
- 4" EDGE LINE, YELLOW
- 4" LANE LINE
- 8" CHANNELIZING LINE, WHITE
- 24" TRANSVERSE LINE, WHITE, 12' SPACING

SIGN LEGEND

- NEW SIGN
- EXISTING SIGN, TO REMAIN
- EXISTING SIGN, TO BE REMOVED
- INDICATES SIGN TO BE CONSIDERED FOR REMOVAL AND REERECTION. REMOVAL AND REERECTION BY OTHERS.

NOTES


- 1) CONSTRUCT A NEW CONCRETE BARRIER TRANSITION AS PER STANDARD DRAWING RM-4.5M. SEAL WITH EPOXY URETHANE. FOR FURTHER INFORMATION, SEE SHEET 123.
- 2) FOR CROSS ROAD INFORMATION, SEE SHEETS 116-122..
- 3) FOR OVERHEAD STRUCTURE INFORMATION, SEE SHEETS 260-283.
- 4) FOR SIGN ELEVATIONS, SEE SHEETS 127-128.

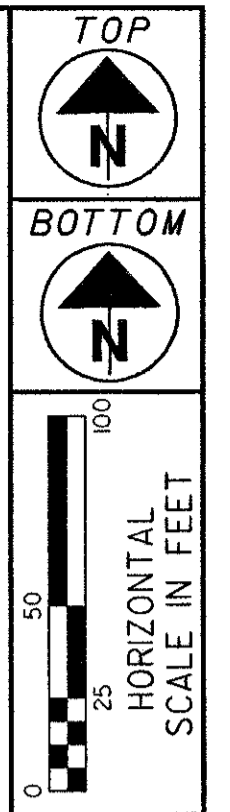

PLAN
STA. 873+00 TO STA. 901+00

PRE-70-0.00

 USER: *****
 PROJECT: *****
 DATE: *****
 TIME: *****
 ACTIVE LEVELS ON: *****

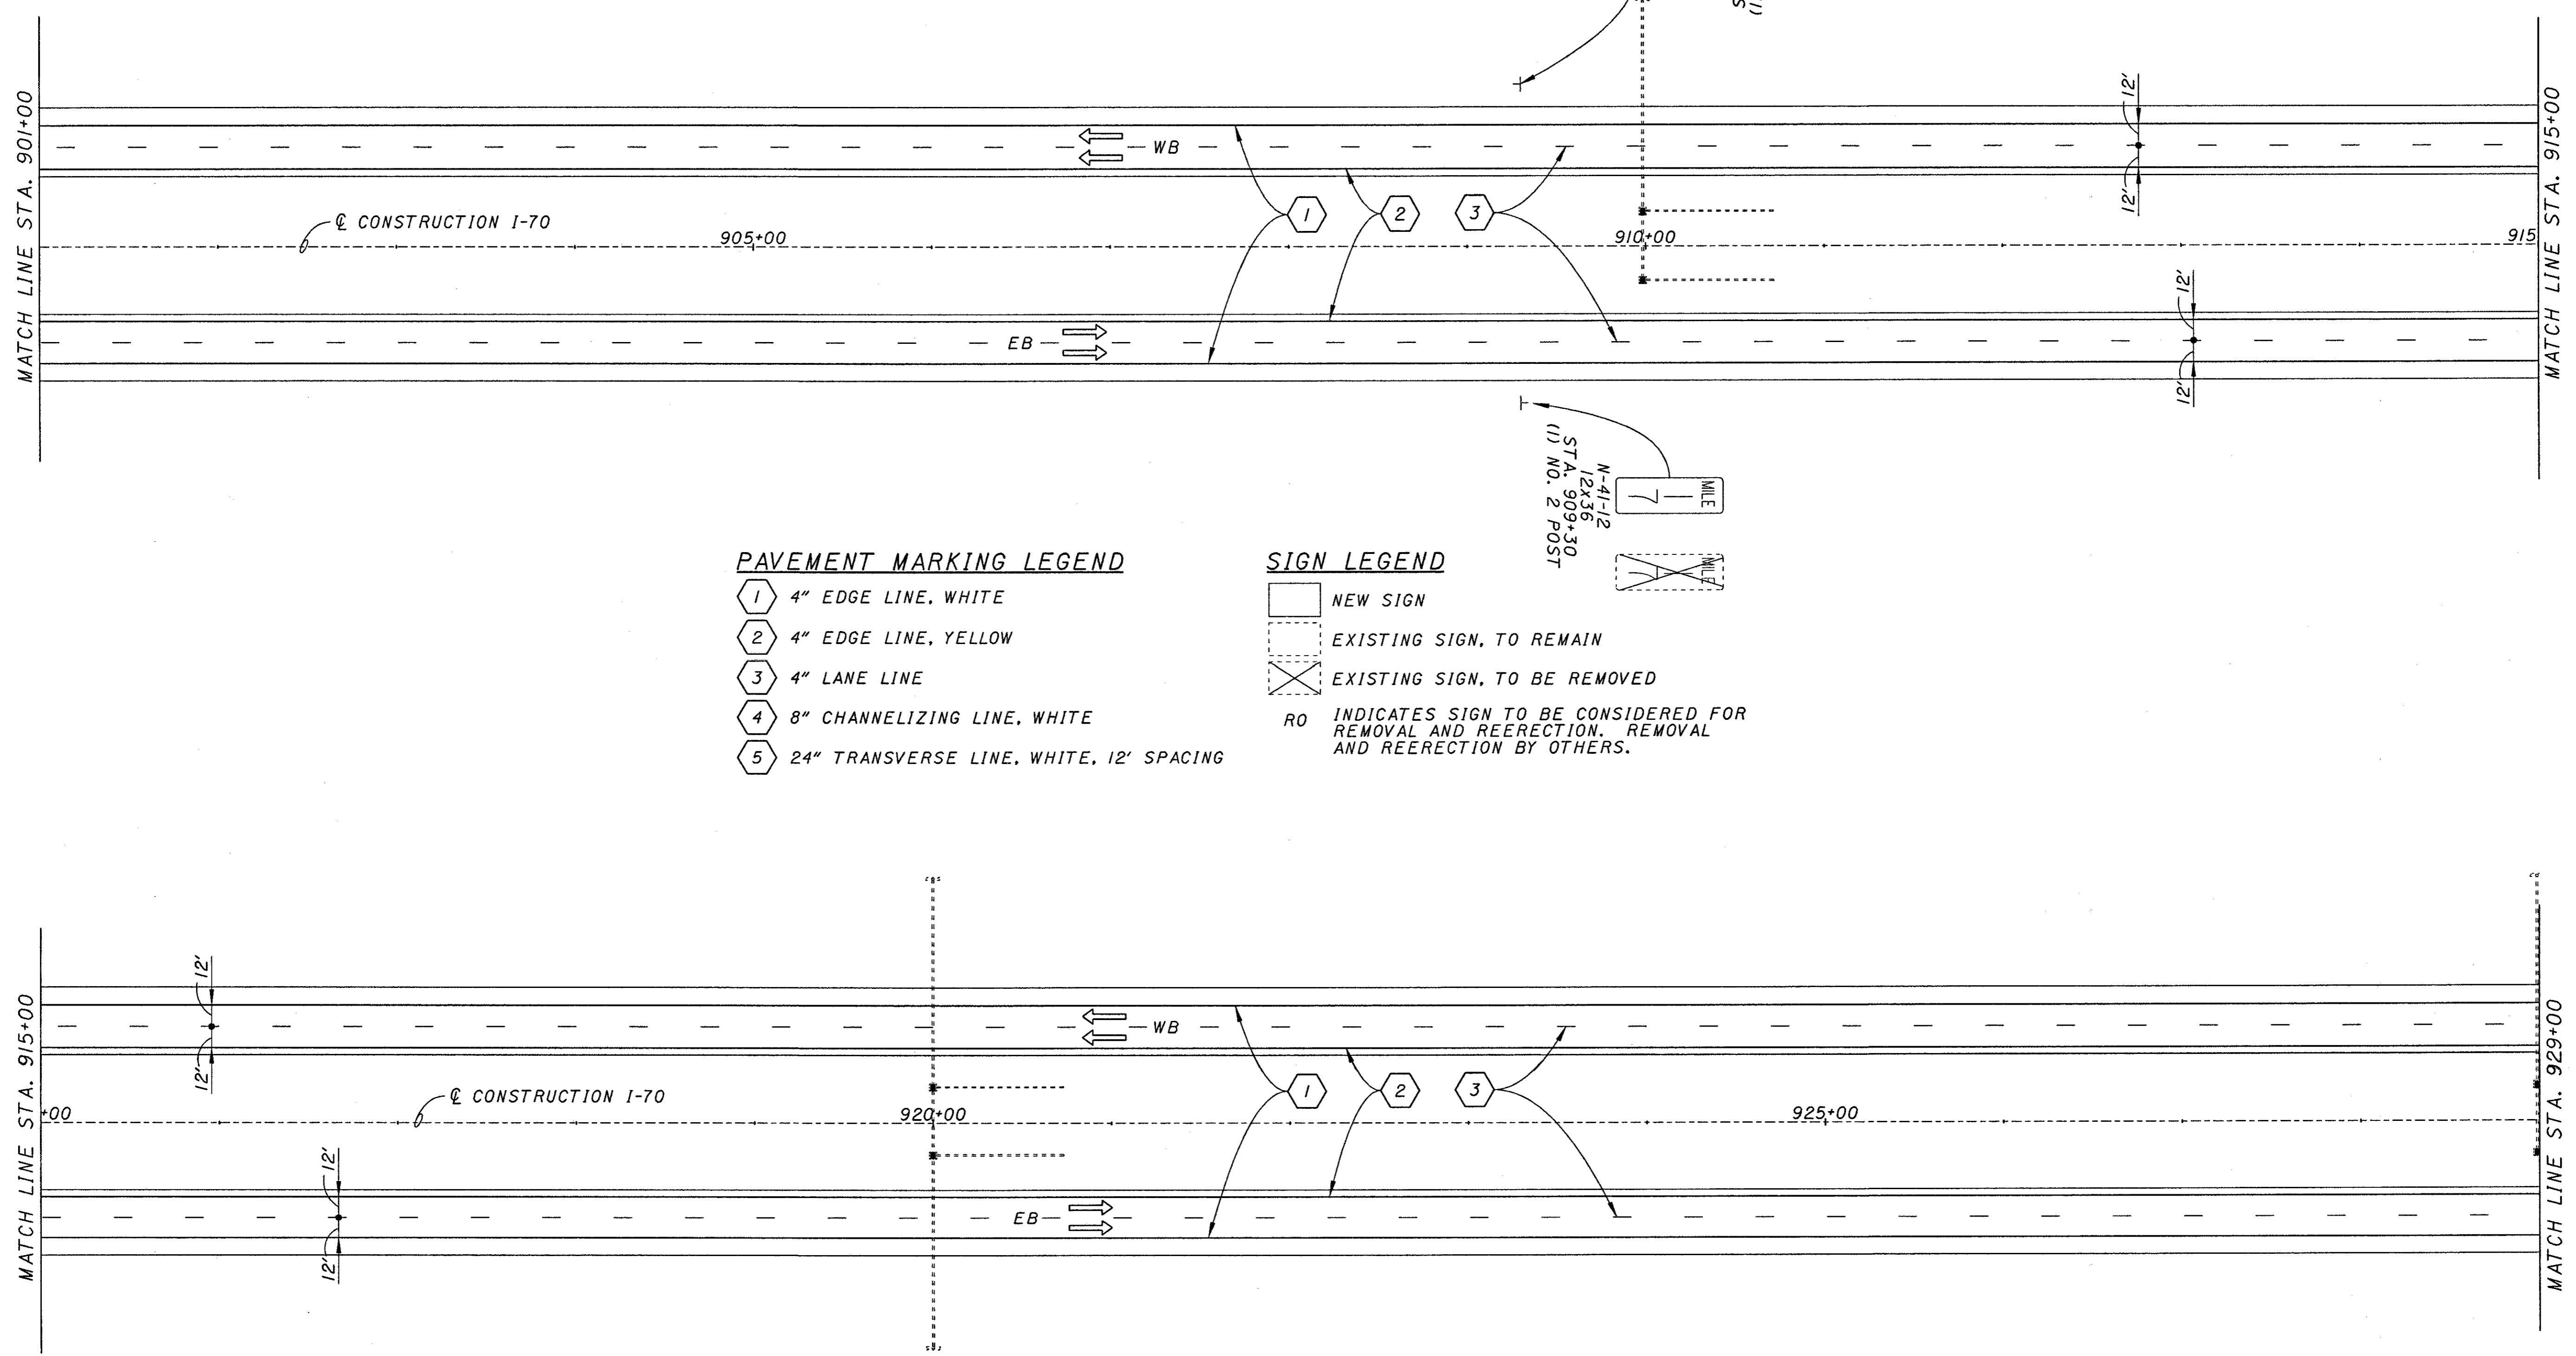


PAVEMENT MARKING LEGEND

- 1 4" EDGE LINE, WHITE
- 2 4" EDGE LINE, YELLOW
- 3 4" LANE LINE
- 4 8" CHANNELIZING LINE, WHITE
- 5 24" TRANSVERSE LINE, WHITE, 12' SPACING

SIGN LEGEND

- [Solid Box] NEW SIGN
- [Dashed Box] EXISTING SIGN, TO REMAIN
- [Crossed Box] EXISTING SIGN, TO BE REMOVED
- RO INDICATES SIGN TO BE CONSIDERED FOR REMOVAL AND REERECTION. REMOVAL AND REERECTION BY OTHERS.

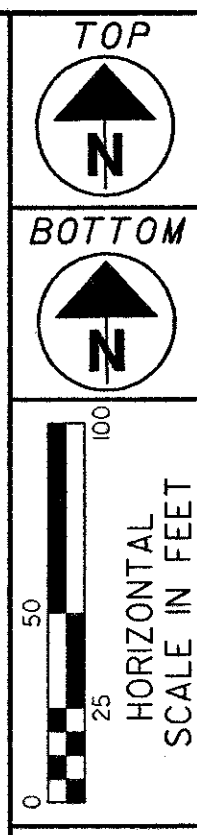


PLAN
STA. 901+00 TO STA. 929+00

PRE-70-0.00

MATCH LINE STA. 929+00

MATCH LINE STA. 3+00

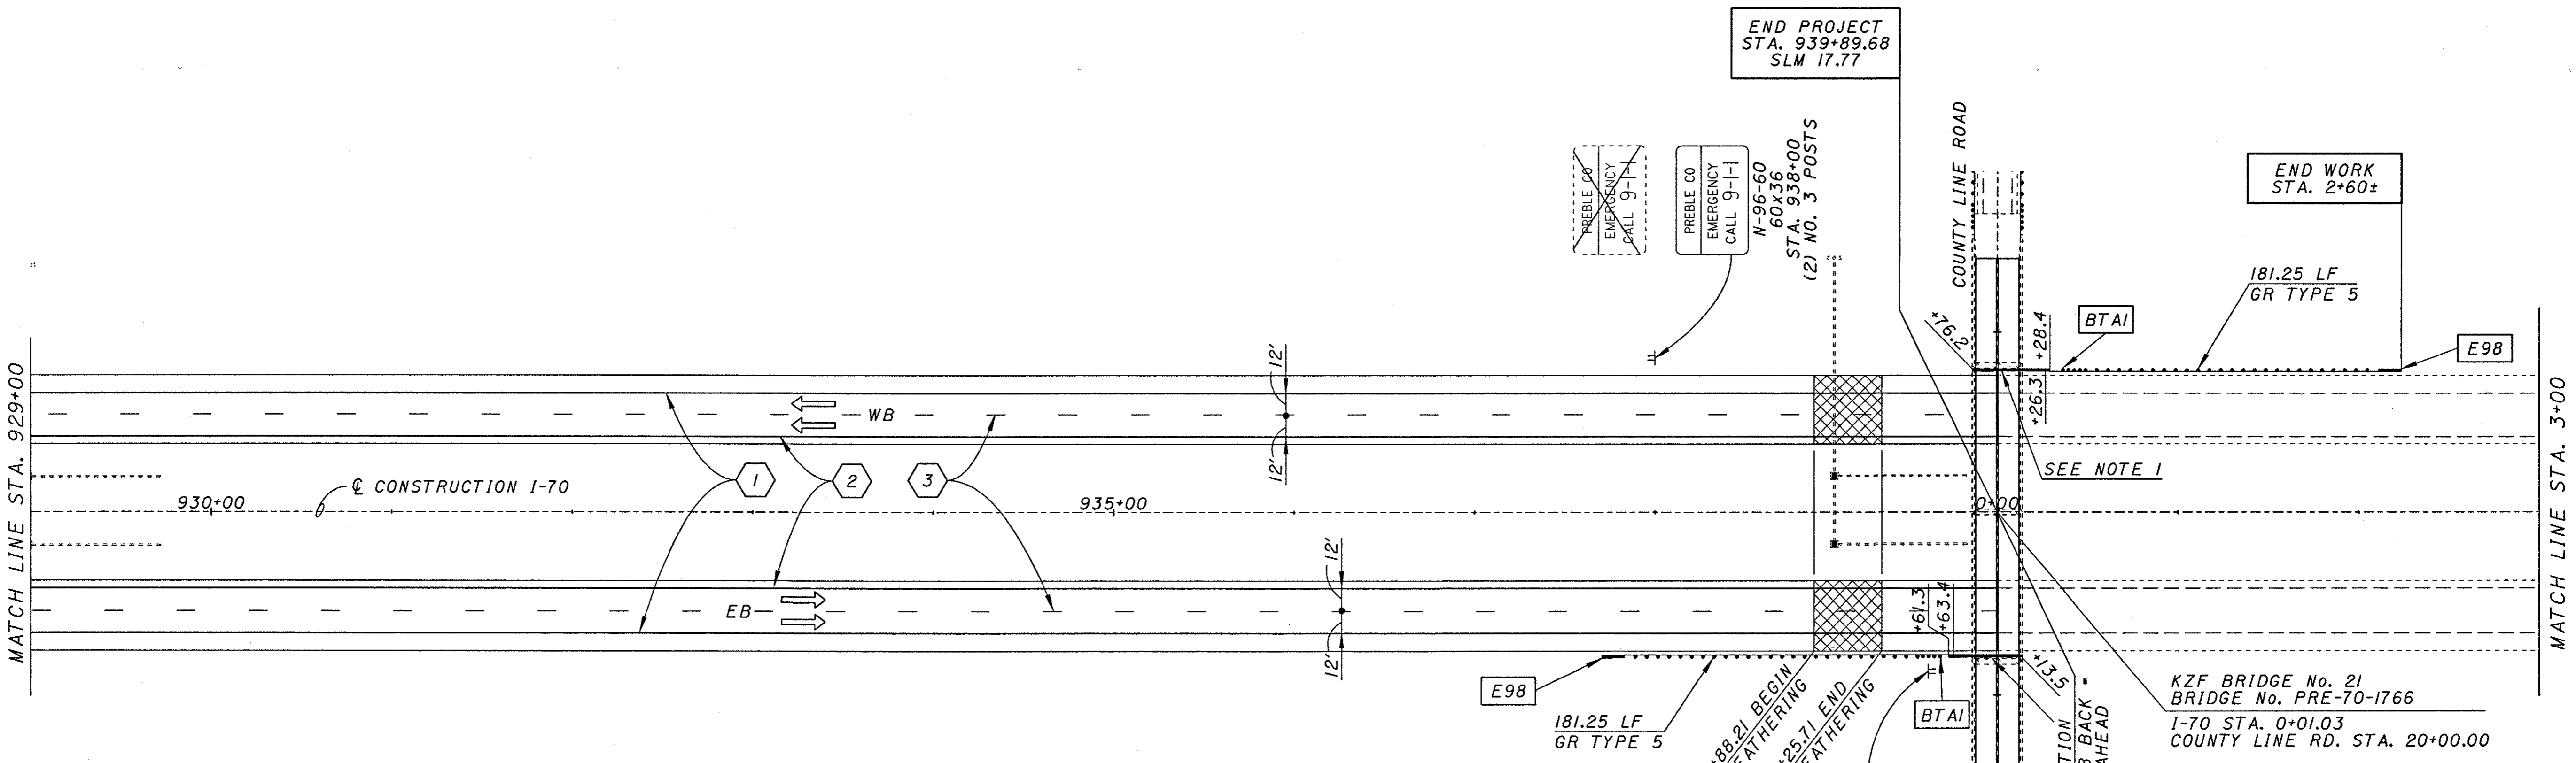

PAVEMENT MARKING LEGEND

- 1 4" EDGE LINE, WHITE
- 2 4" EDGE LINE, YELLOW
- 3 4" LANE LINE
- 4 8" CHANNELIZING LINE, WHITE
- 5 24" TRANSVERSE LINE, WHITE, 12' SPACING


SIGN LEGEND

- [Solid Box] NEW SIGN
- [Dashed Box] EXISTING SIGN, TO REMAIN
- [Cross-hatched Box] EXISTING SIGN, TO BE REMOVED
- RO INDICATES SIGN TO BE CONSIDERED FOR REMOVAL AND REERECTION. REMOVAL AND REERECTION BY OTHERS.

LEGEND

- [Cross-hatched Area] PAVEMENT FEATHERING. SEE MISCELLANEOUS DETAIL SHEET 123, FOR FURTHER INFORMATION.
- [E98] GUARDRAIL ANCHOR ASSEMBLY, TYPE E-98
- [BTAI] BRIDGE TERMINAL ASSEMBLY, TYPE I

MATCH LINE STA. 3+00

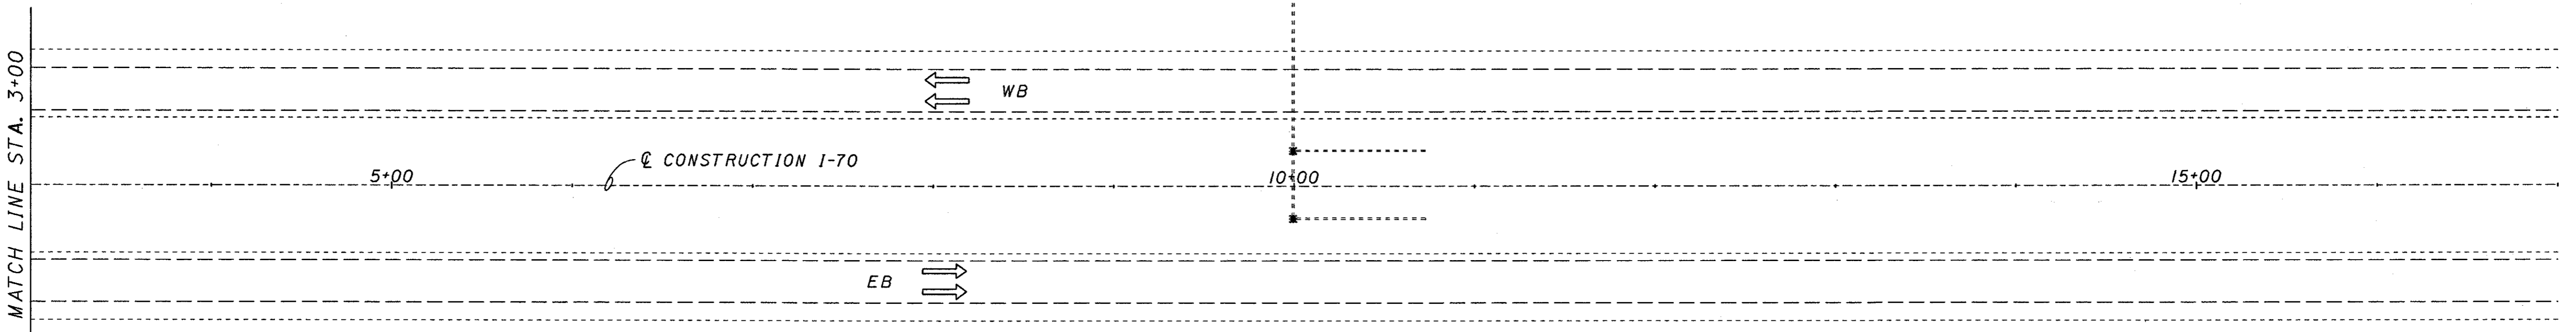

NOTES


- 1) CONSTRUCT A NEW CONCRETE BARRIER TRANSITION AS PER STANDARD DRAWING RM-4.5M. SEAL WITH EPOXY URETHANE. FOR FURTHER INFORMATION, SEE SHEET 123.
- 2) FOR CROSS ROAD INFORMATION, SEE SHEETS 116-122.
- 3) FOR OVERHEAD STRUCTURE INFORMATION, SEE SHEETS 260-283.

PLAN
STA. 929+00 TO STA. 17+00

PRE-70-0.00

REVISIONS
 USER: WLS/STONER
 DATE: 11/11/03
 REVISION: 1
 REVISION: 2
 REVISION: 3
 REVISION: 4
 REVISION: 5
 REVISION: 6
 REVISION: 7
 REVISION: 8
 REVISION: 9
 REVISION: 10
 ACTIVE LEVELS ON: #1LEVS

WEST BOUND PROFILE

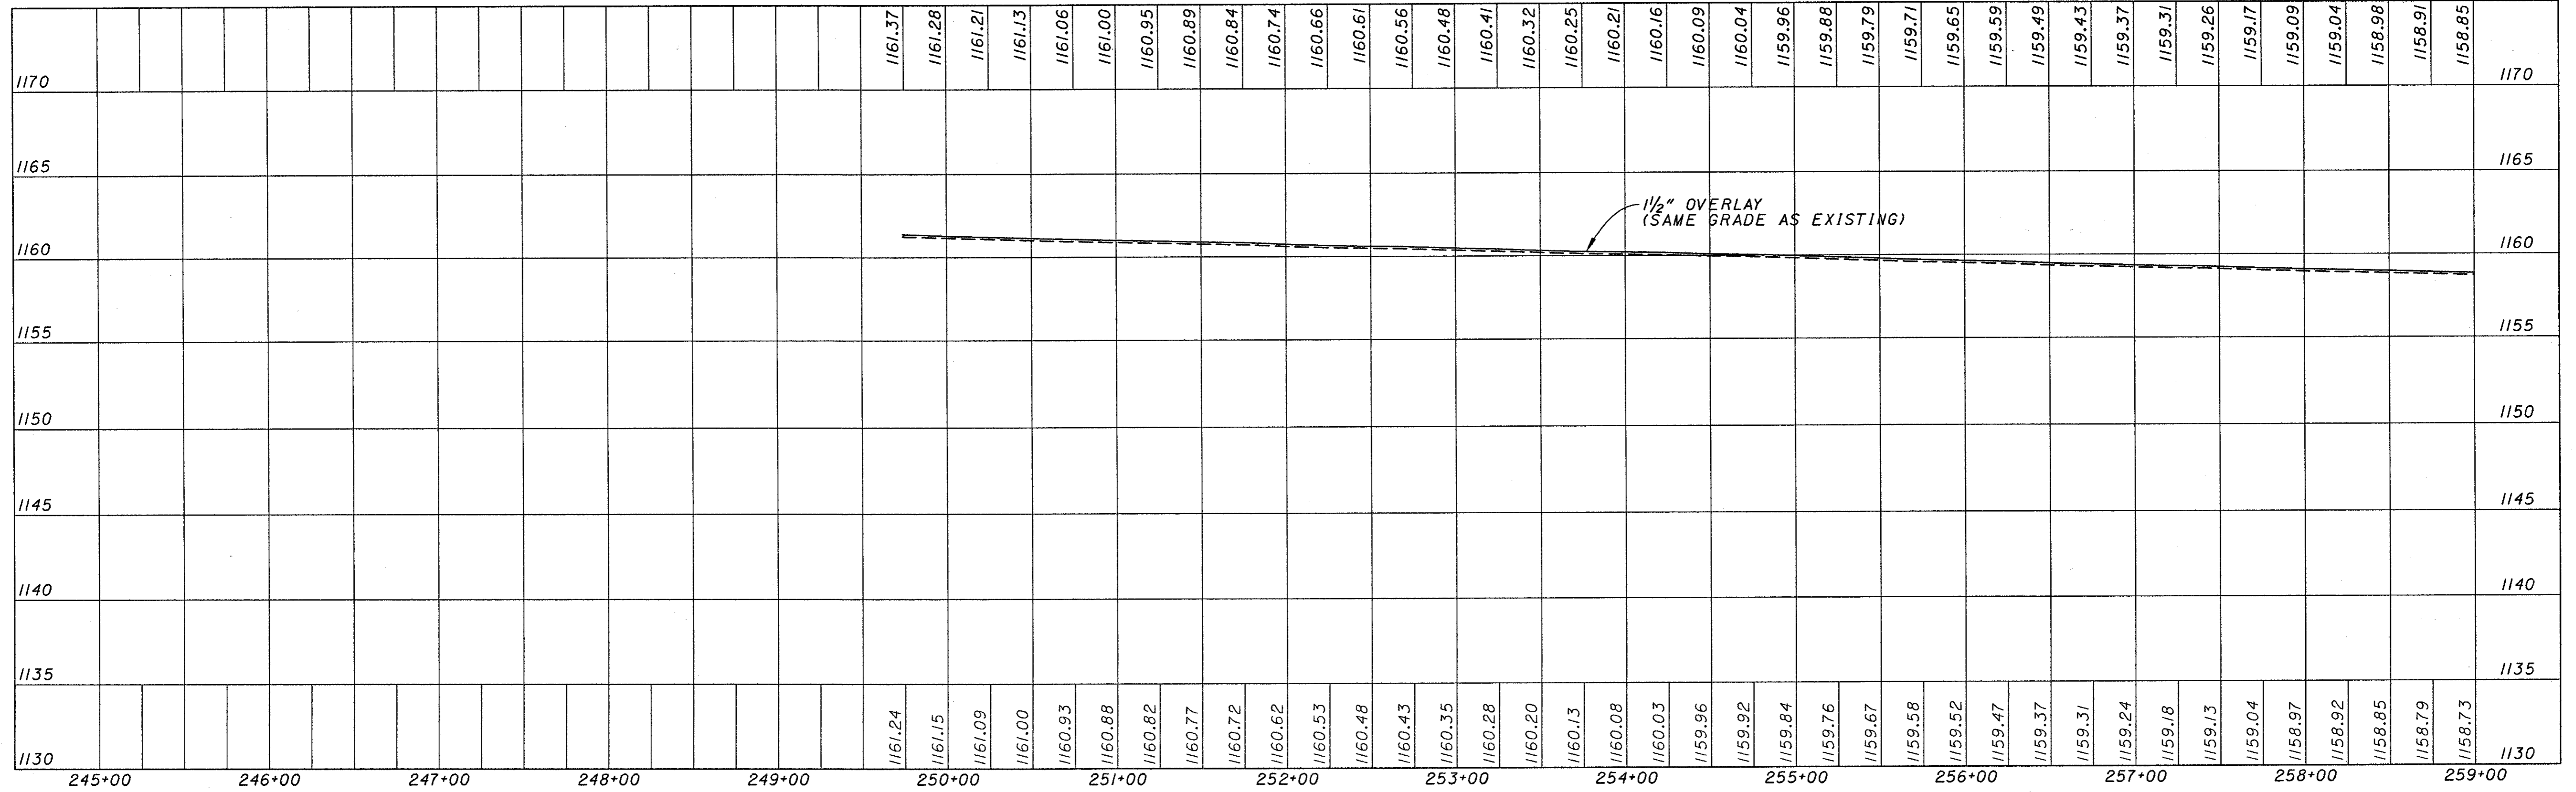


PROFILE GRADES
STA 245+00 TO STA 259+00


PRE-70-0.00

49
283


EAST BOUND PROFILE

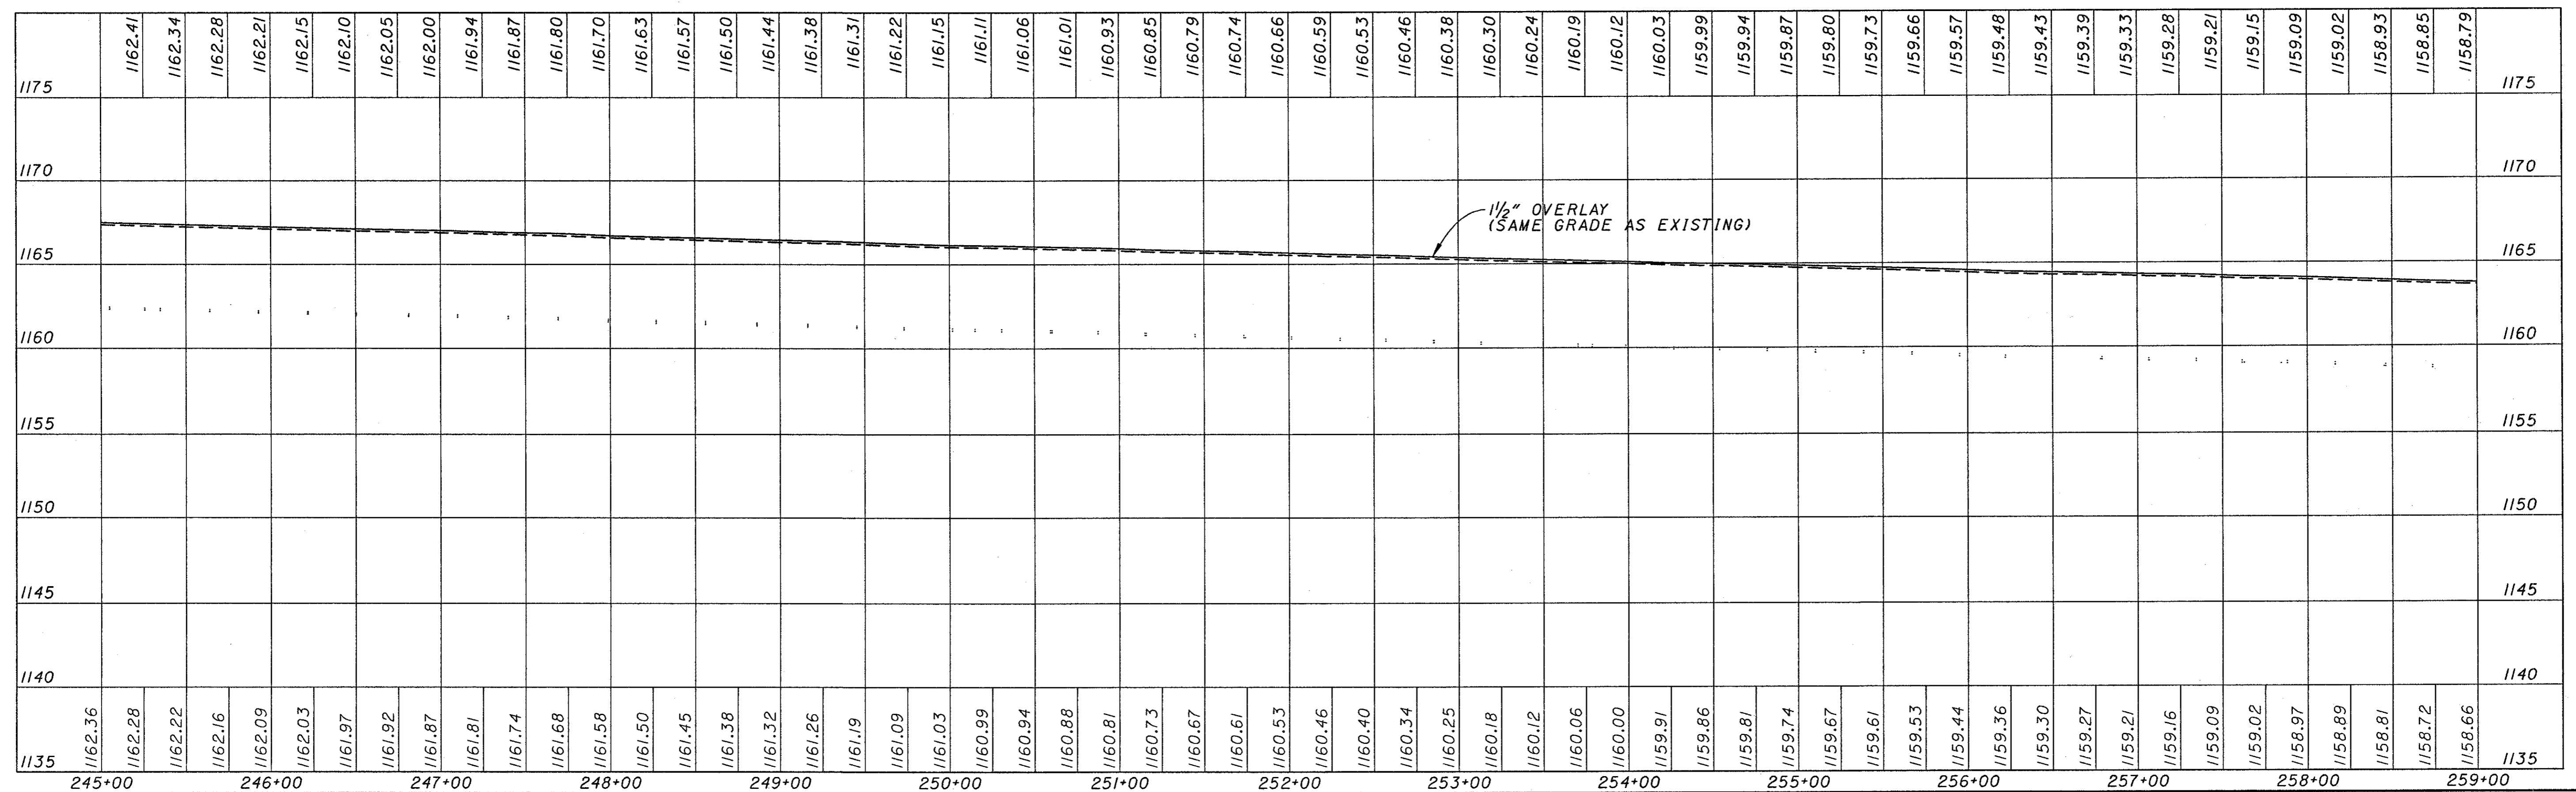

WEST BOUND PROFILE

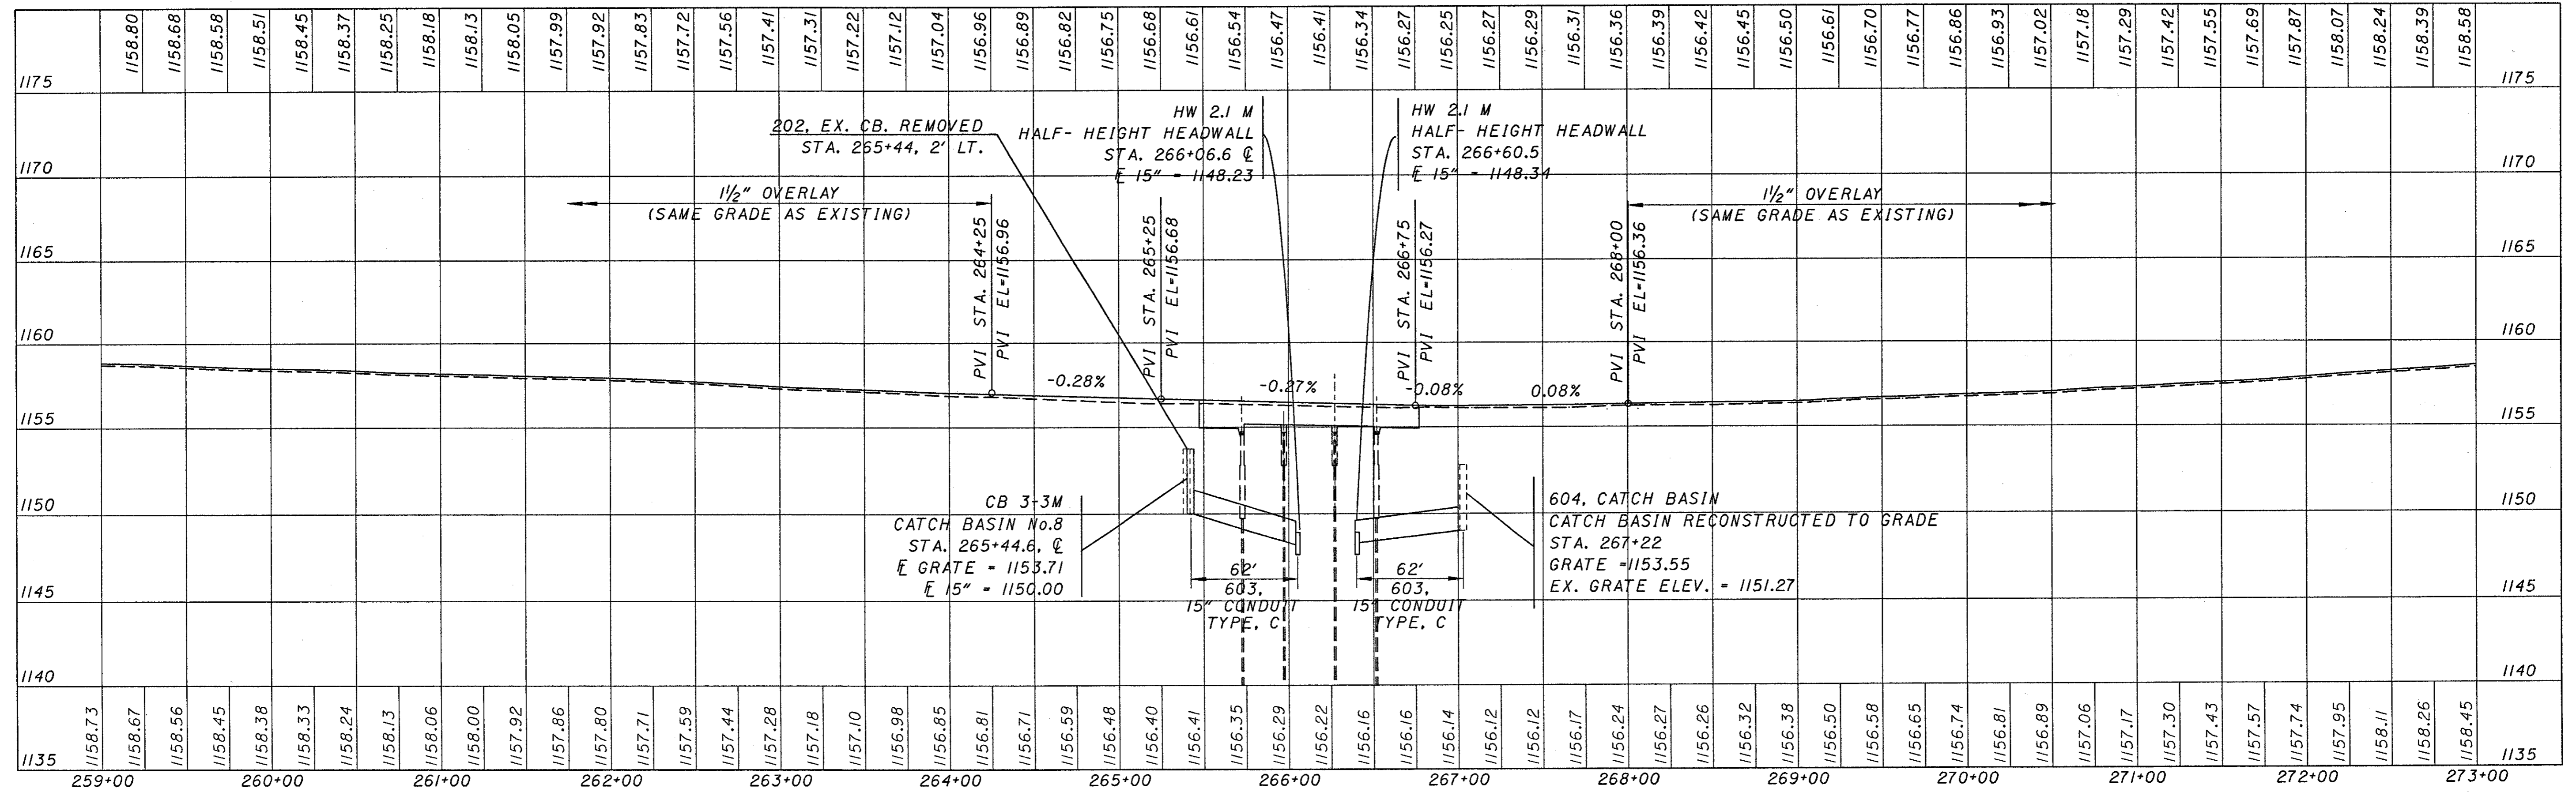

EAST BOUND PROFILE

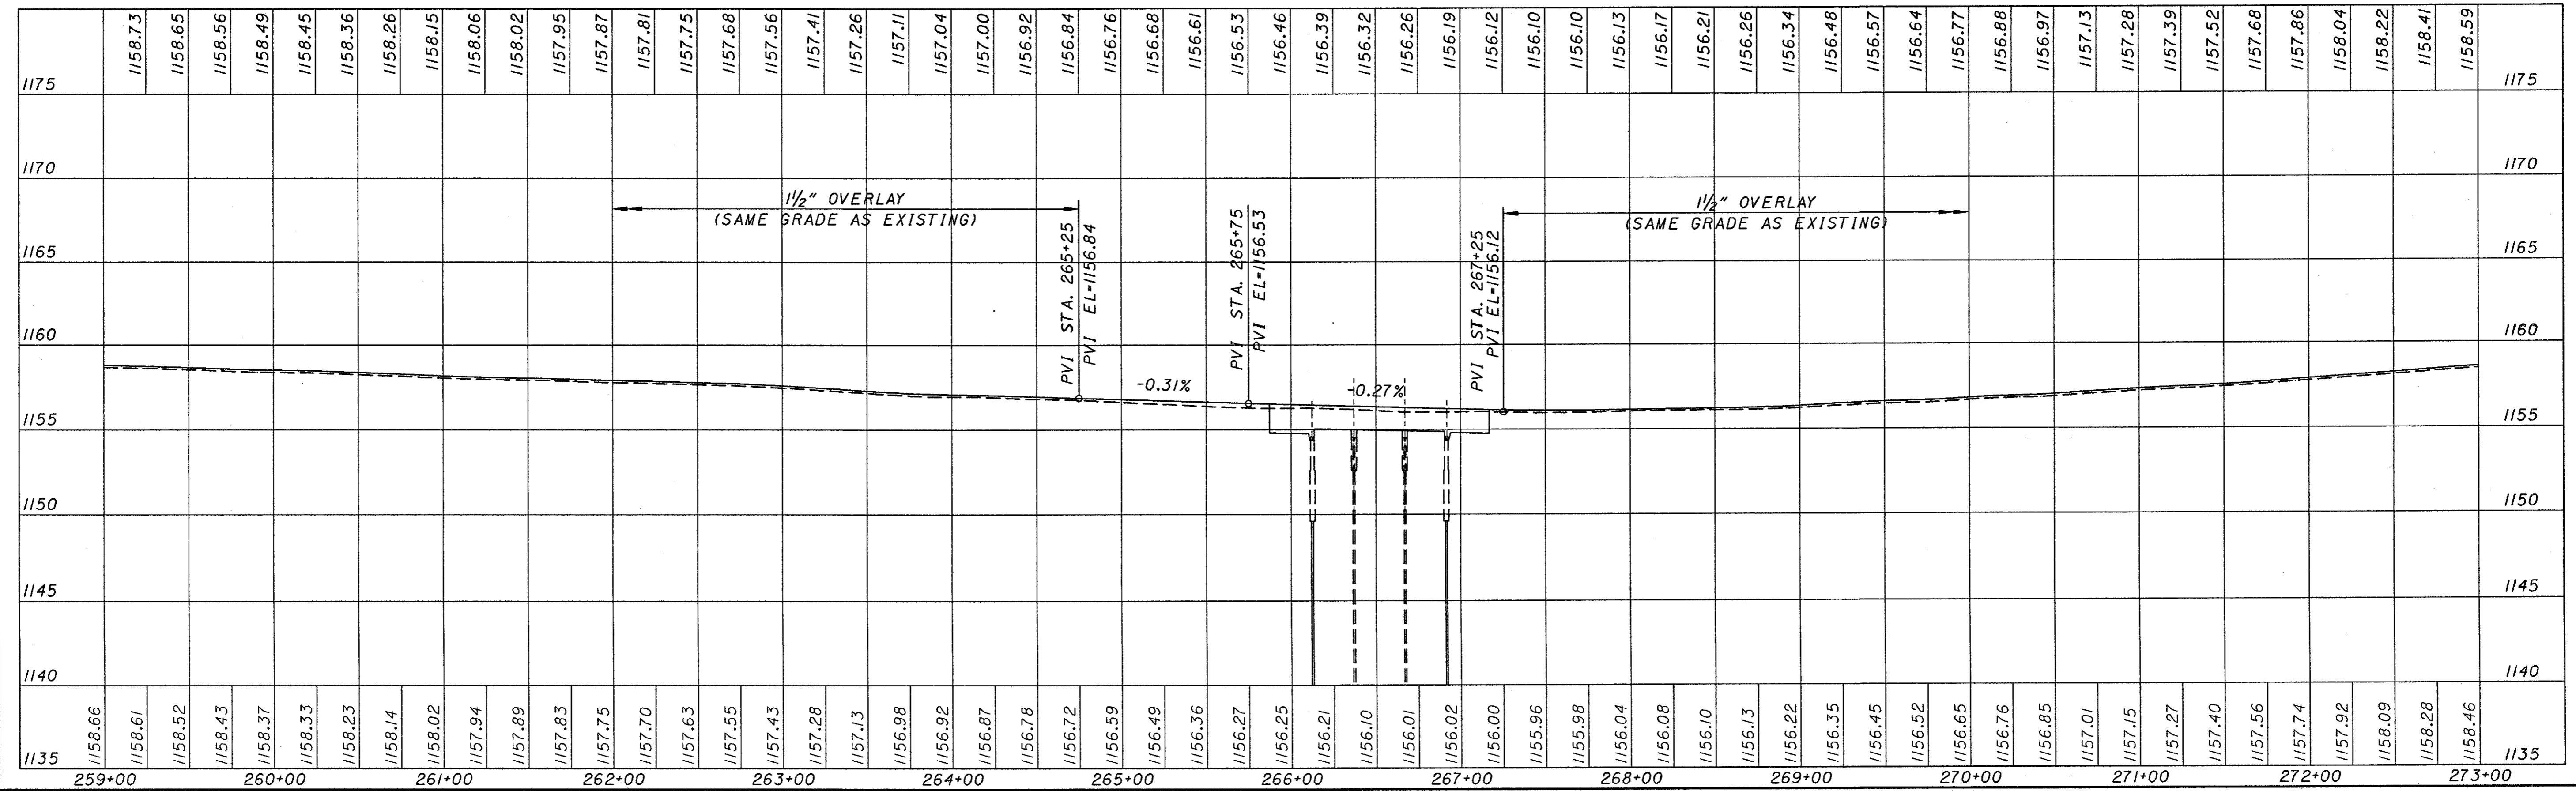



**PROFILE GRADES
STA 259+00 TO STA 273+00**

PRE-70-0.00

50
283


REF:01
REF:02
REF:03
REF:100

WEST BOUND PROFILE

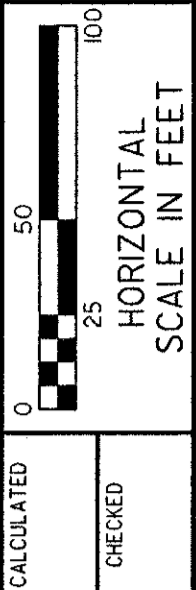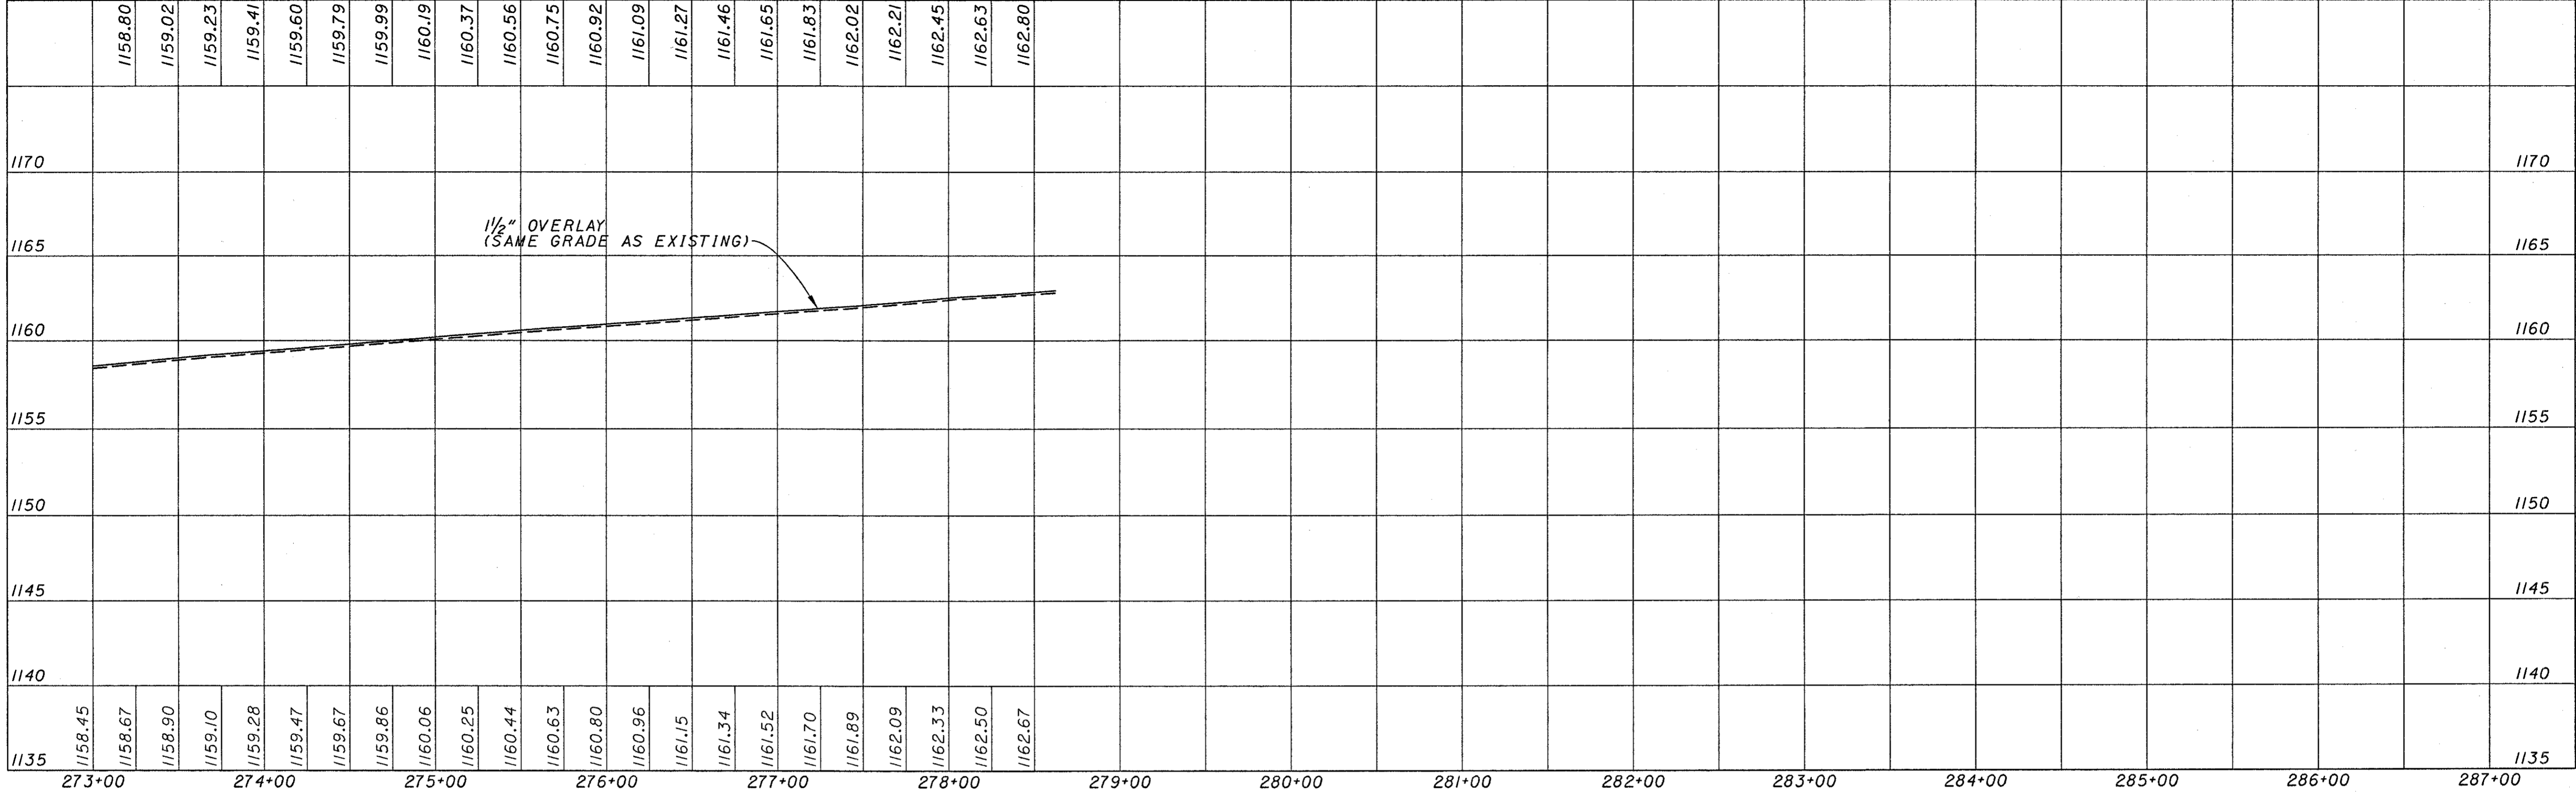

PROFILE GRADES STA 273+00 TO STA 287+00

EAST BOUND PROFILE

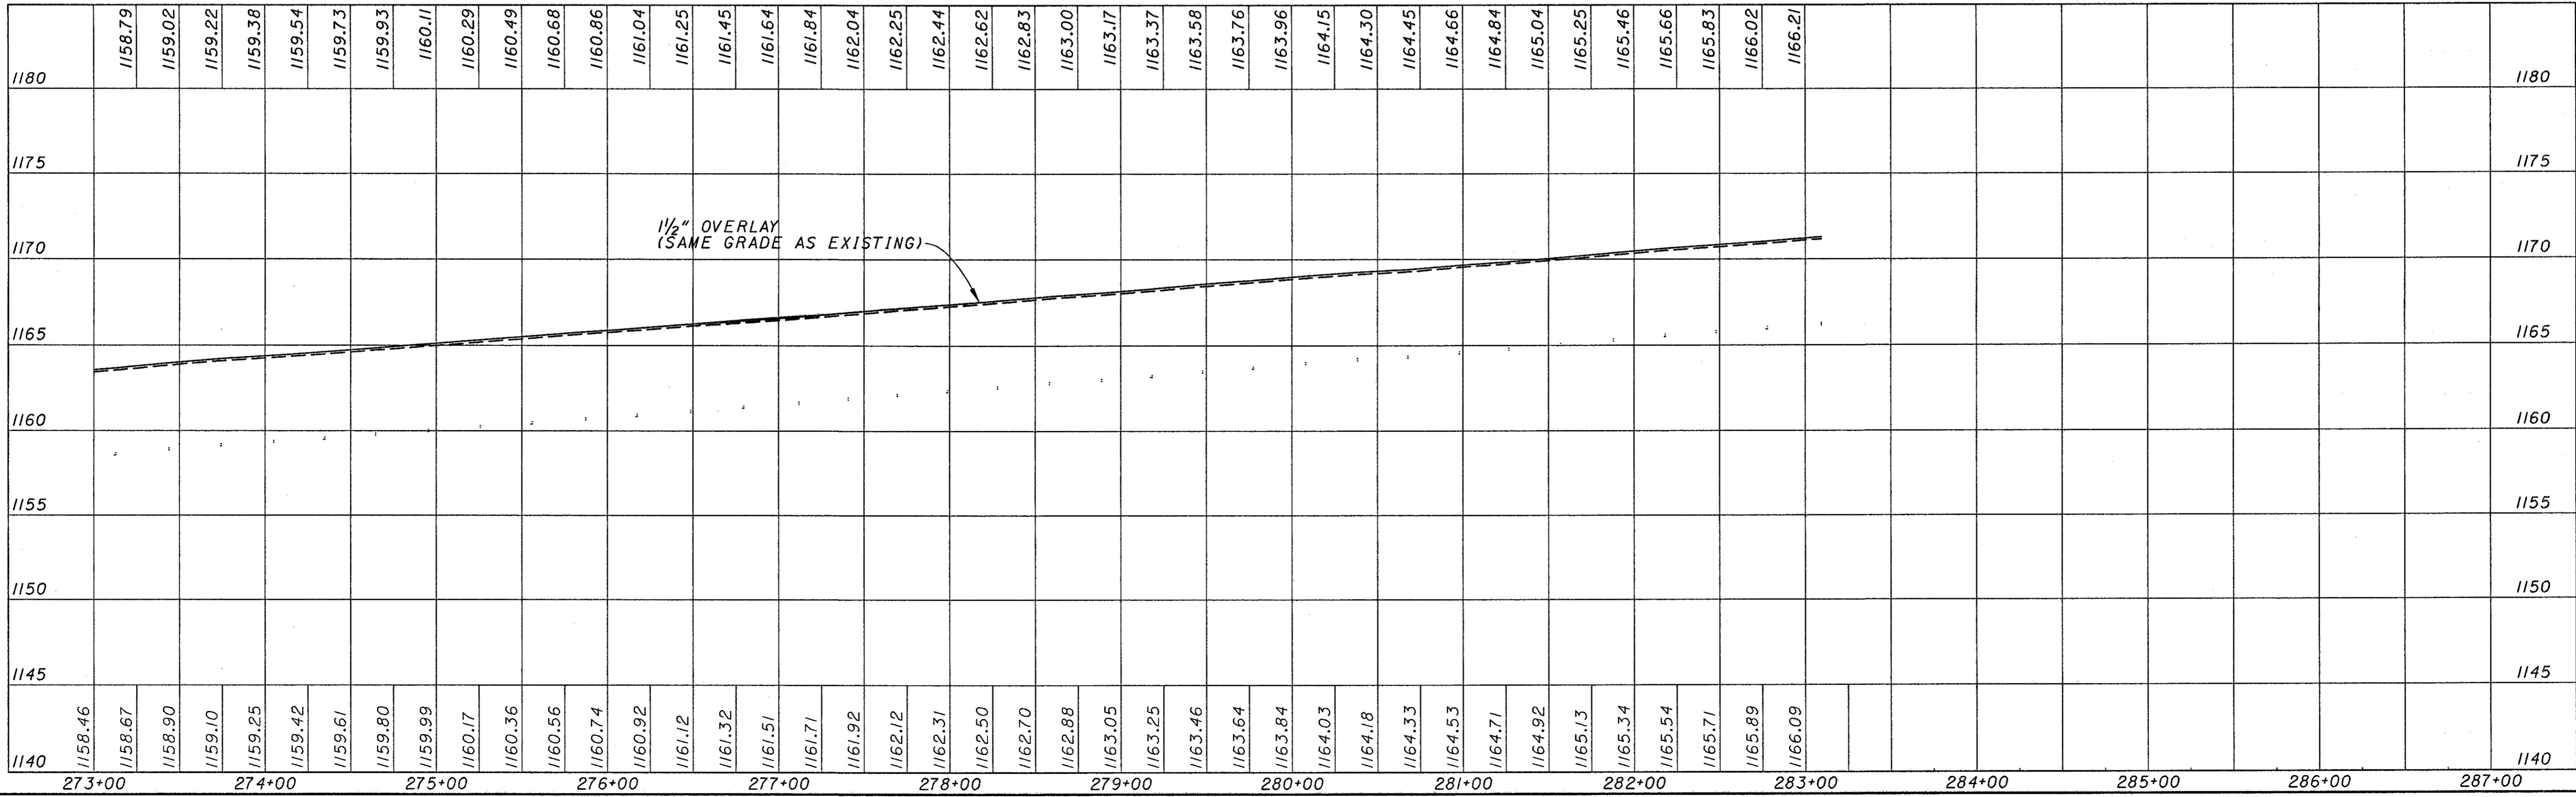


PRE-70-0.00



51
283

REFERENCE: PREVIOUS DRAWINGS
 USER: J. W. ...
 DRAWN: J. W. ...
 CHECKED: J. W. ...
 DATE: ...

WEST BOUND PROFILE

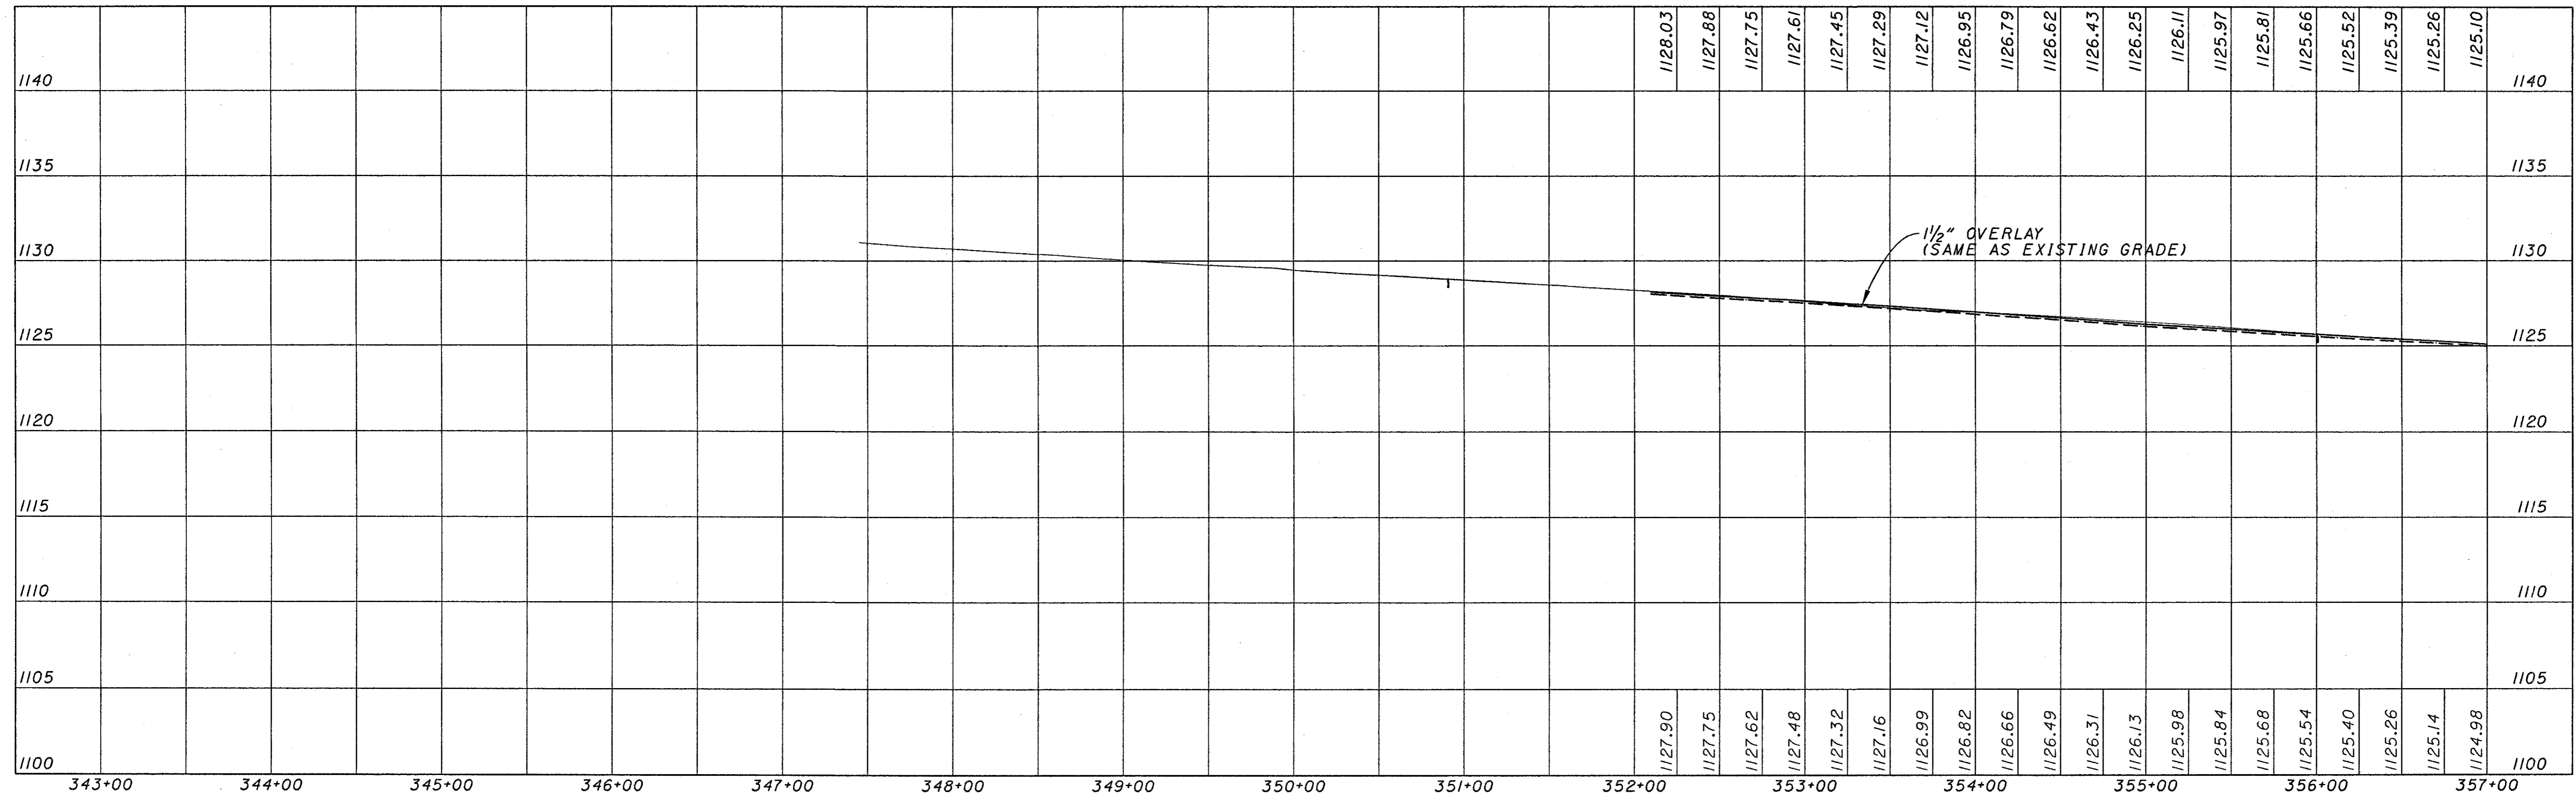

EAST BOUND PROFILE

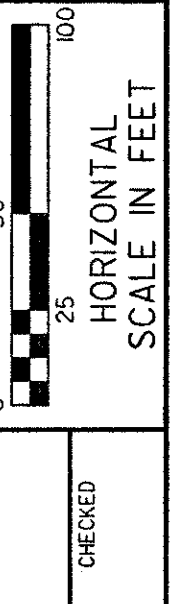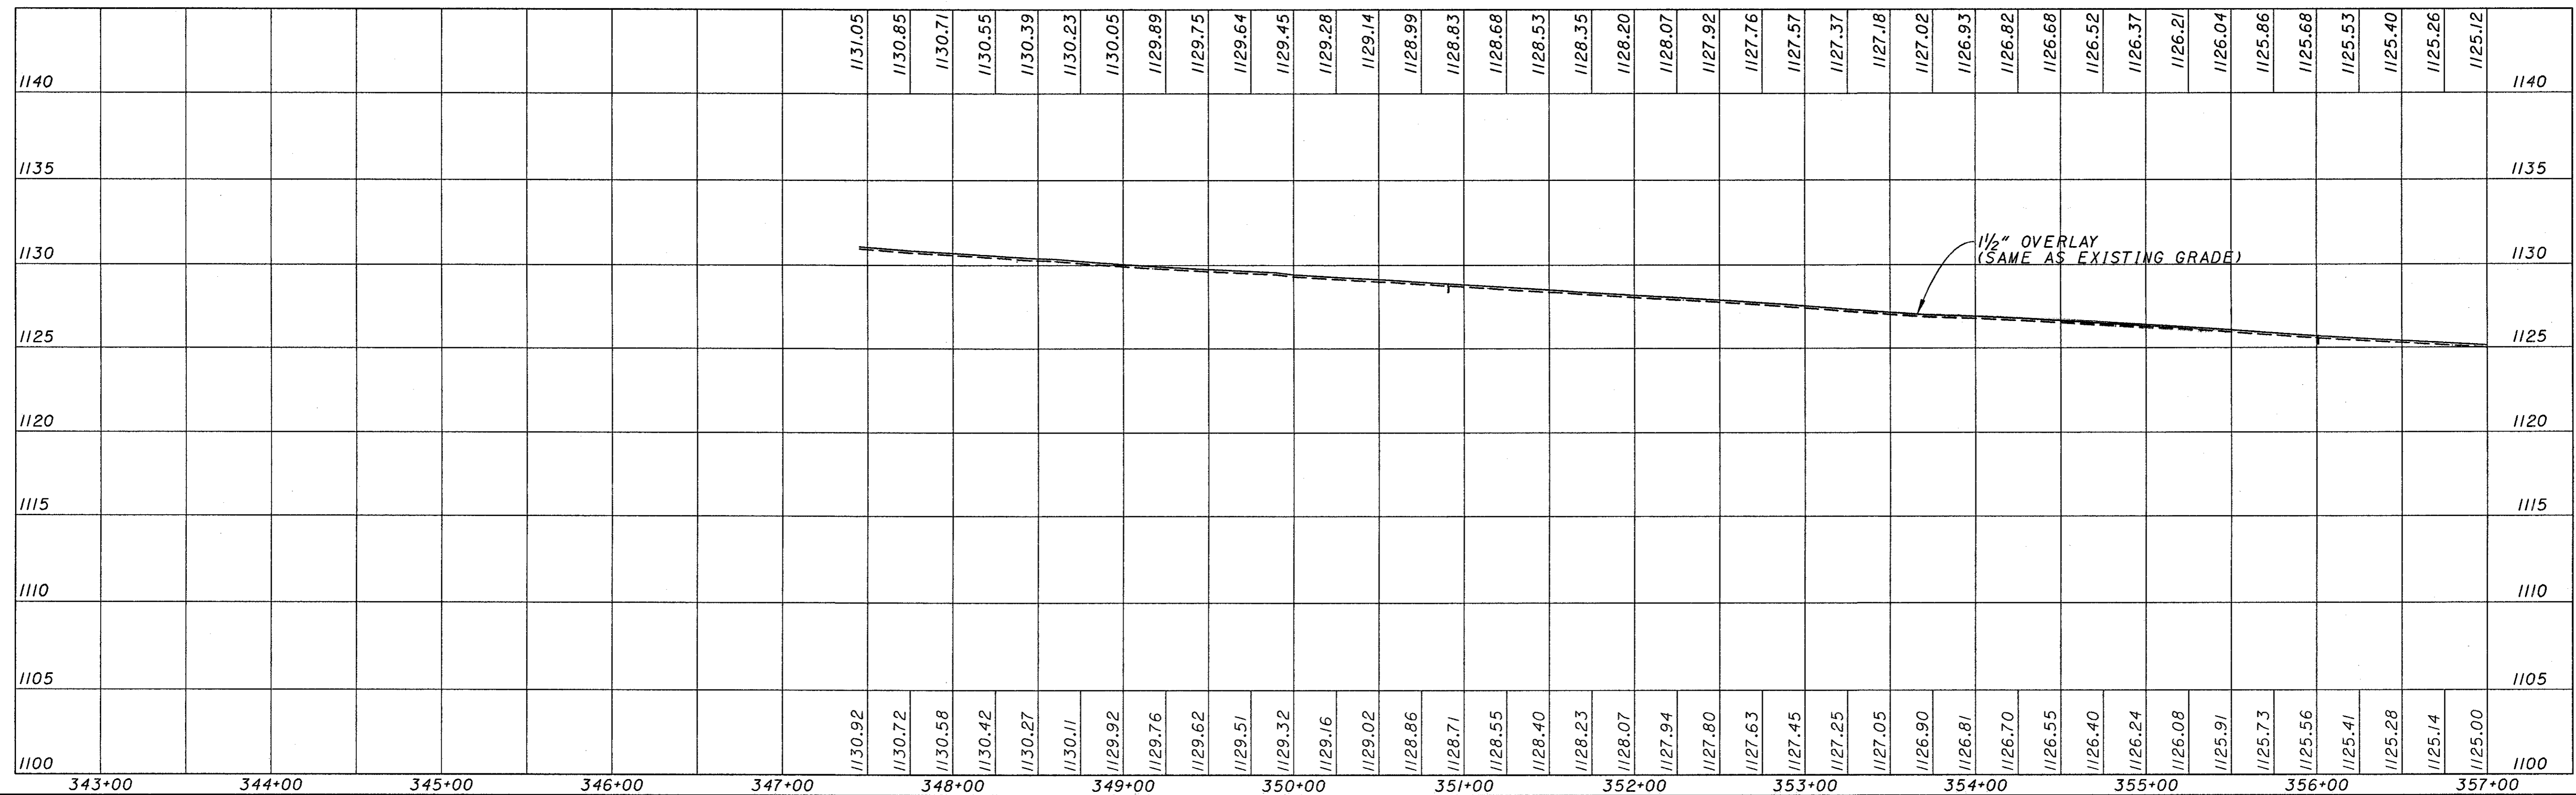


PROFILE GRADES
STA 347+00 TO STA 357+00


PRE-70-0.00

REF: PRE-70-0.00
DES: PRE-70-0.00
CHK: PRE-70-0.00
APP: PRE-70-0.00
DATE: 11/11/11

WEST BOUND PROFILE

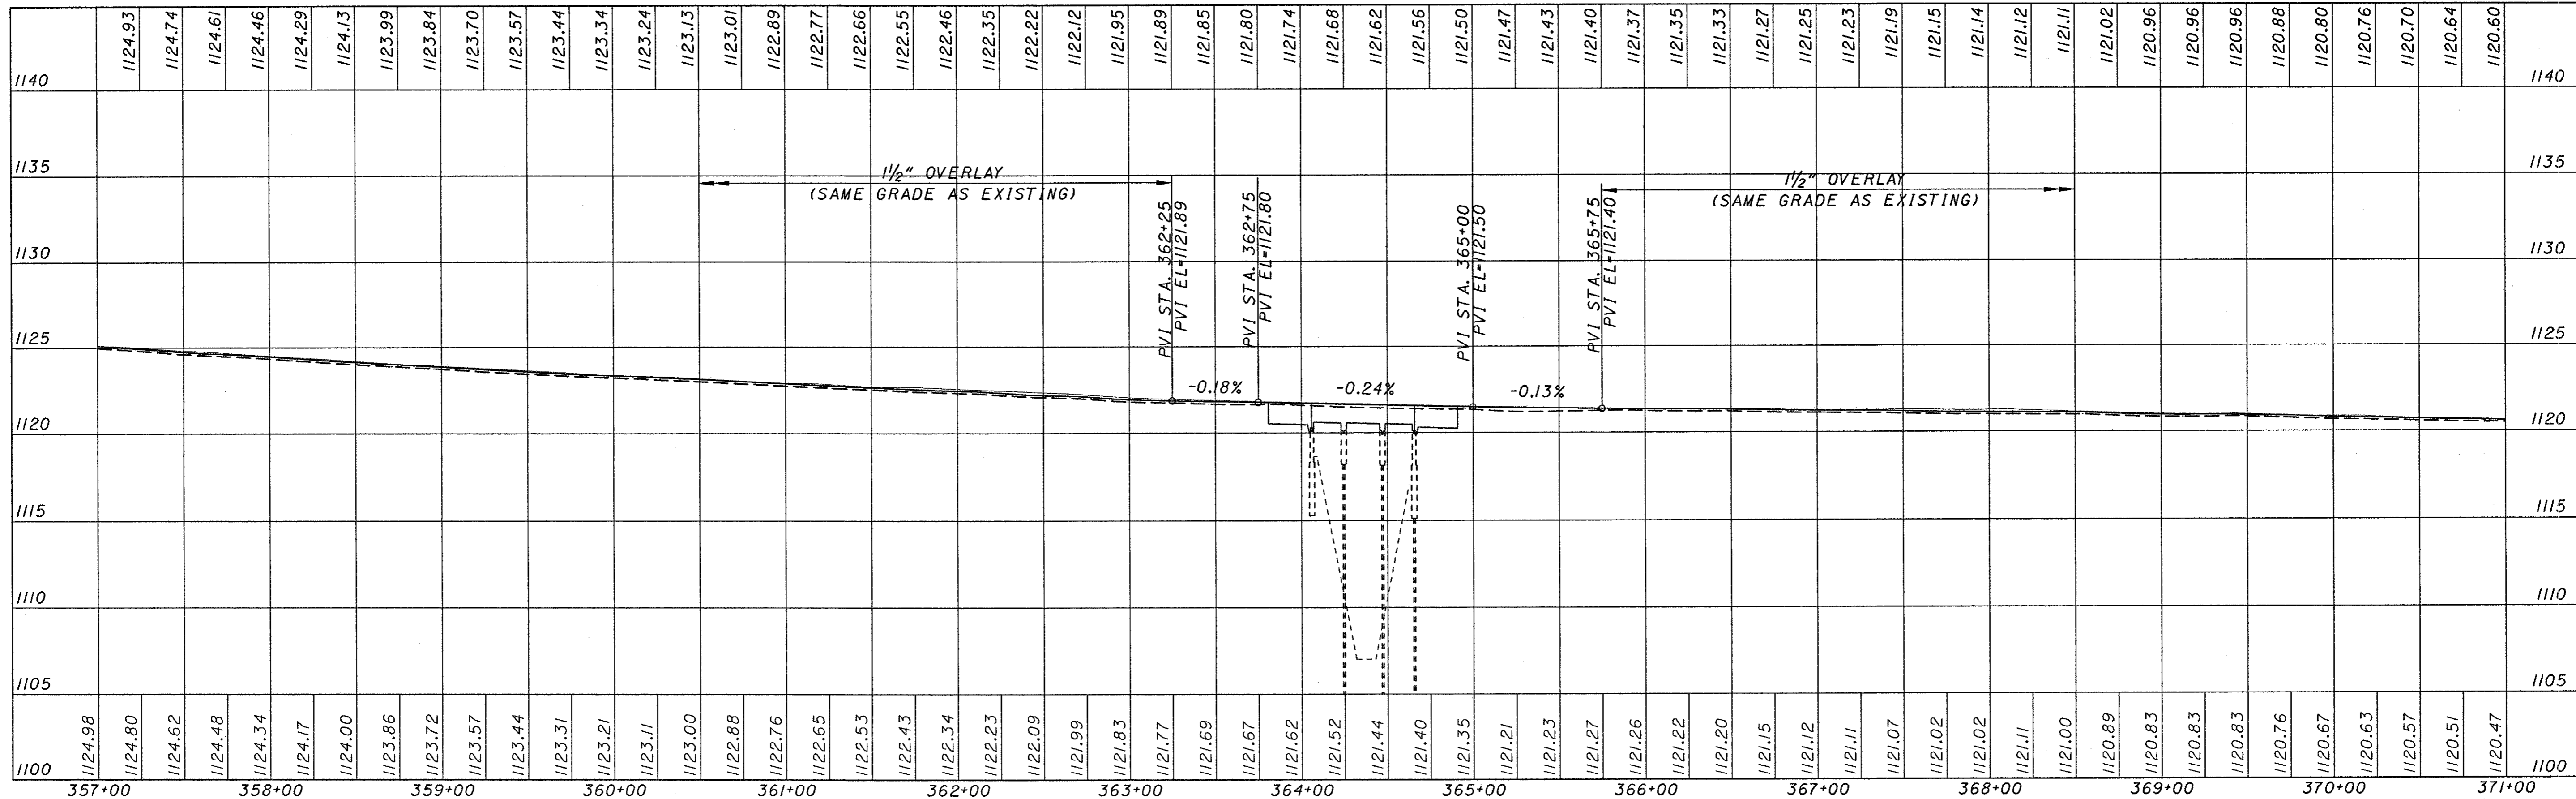

EAST BOUND PROFILE

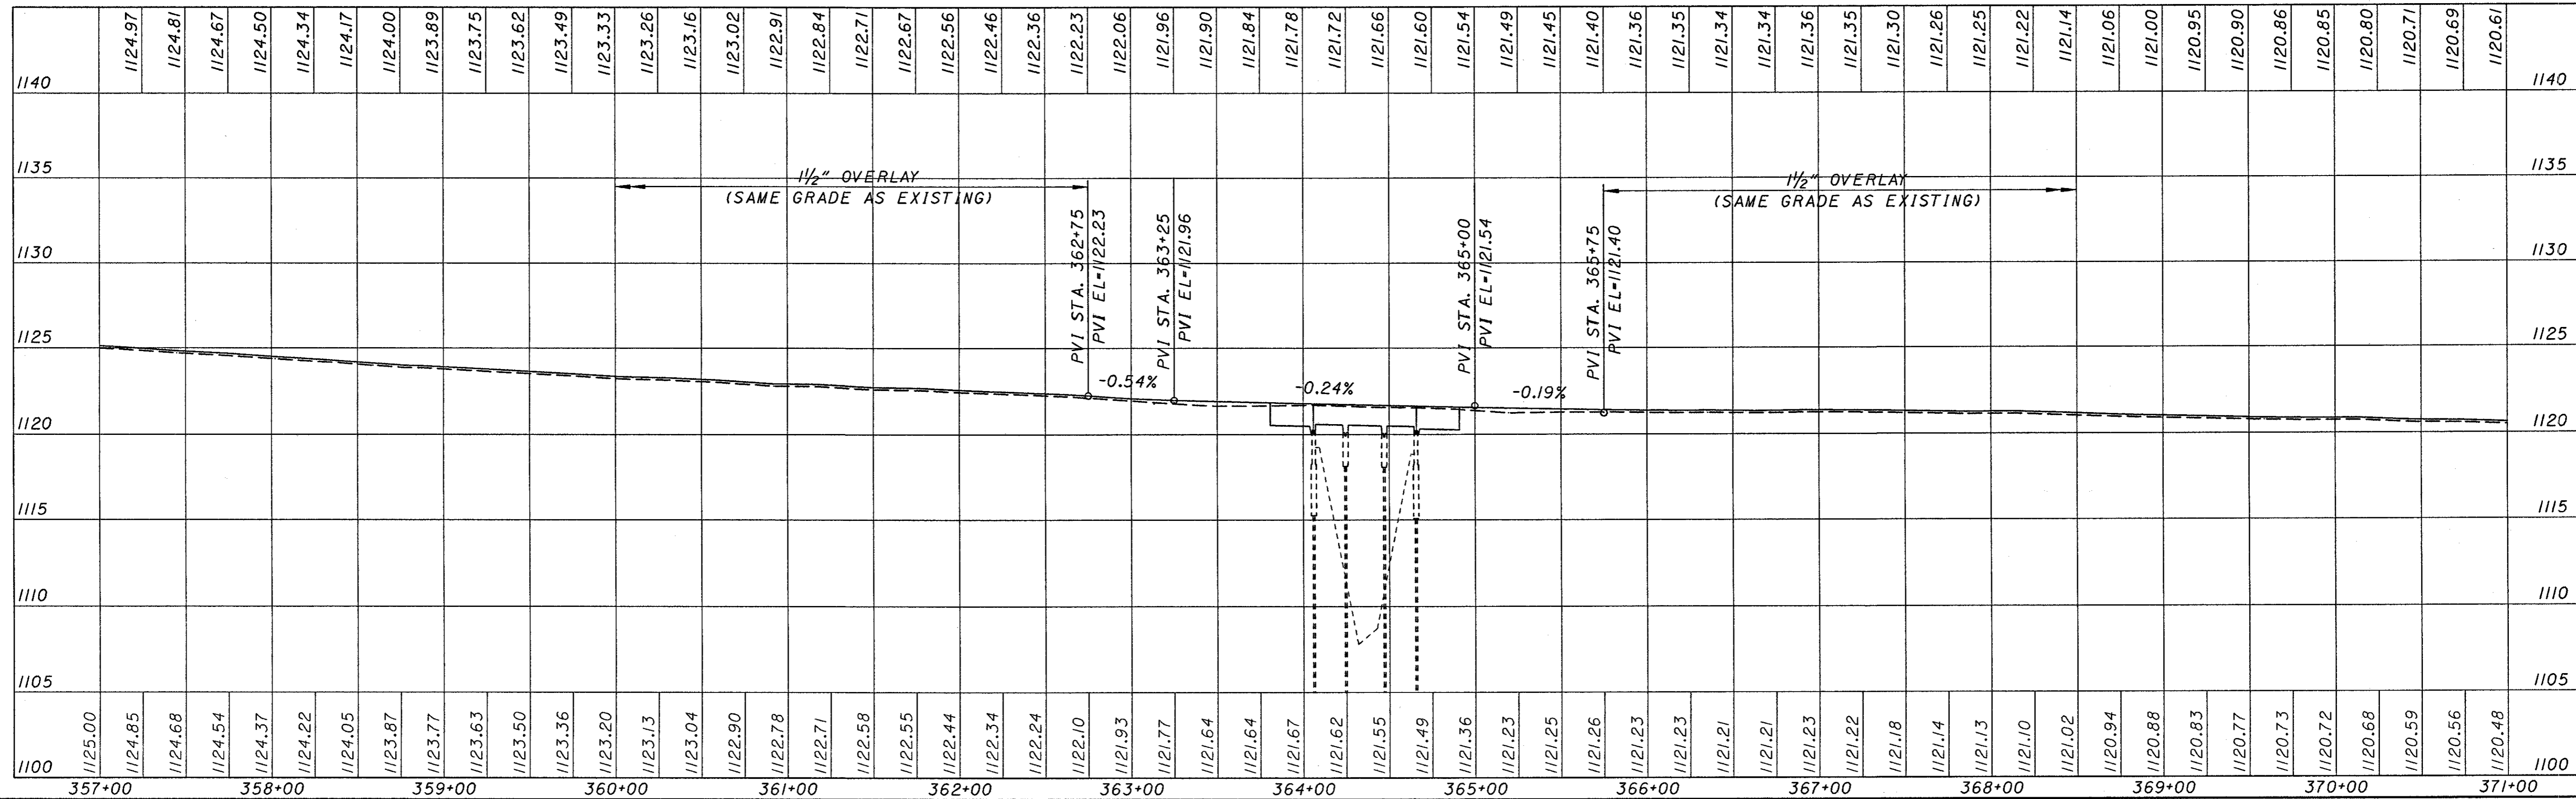



**PROFILE GRADES
STA 357+00 TO STA 371+00**

PRE-70-0.00

53
283


REF. TO SHEET NO. 10
DESIGNER'S SIGNATURE
DATE OF DESIGN
ACTIVE LEVELS ON SHEETS

WEST BOUND PROFILE

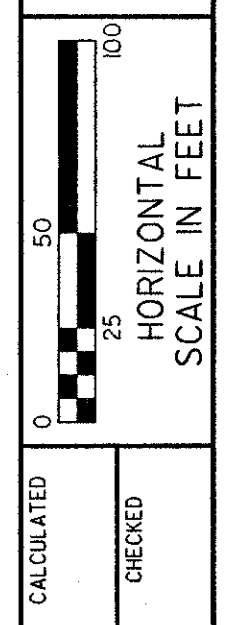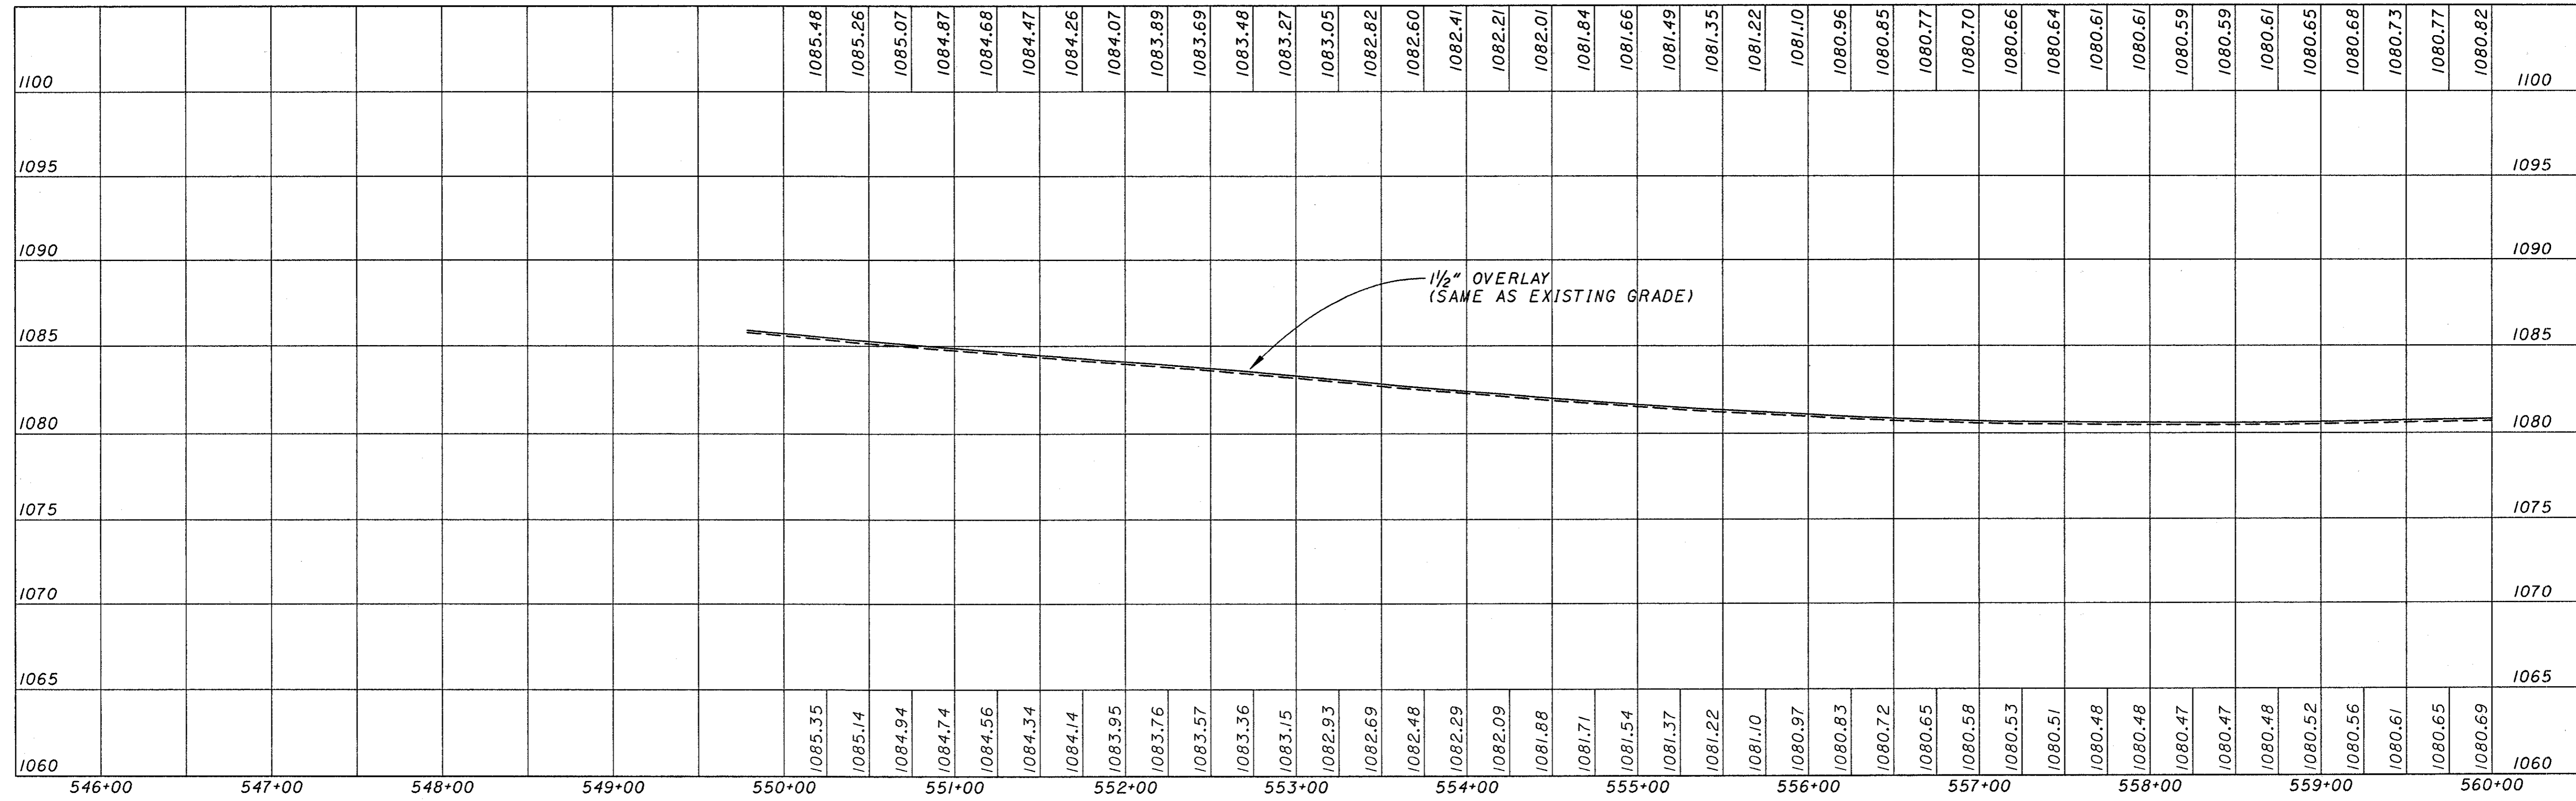


PROFILE GRADES
 STA 546+00 TO STA 560+00

EAST BOUND PROFILE


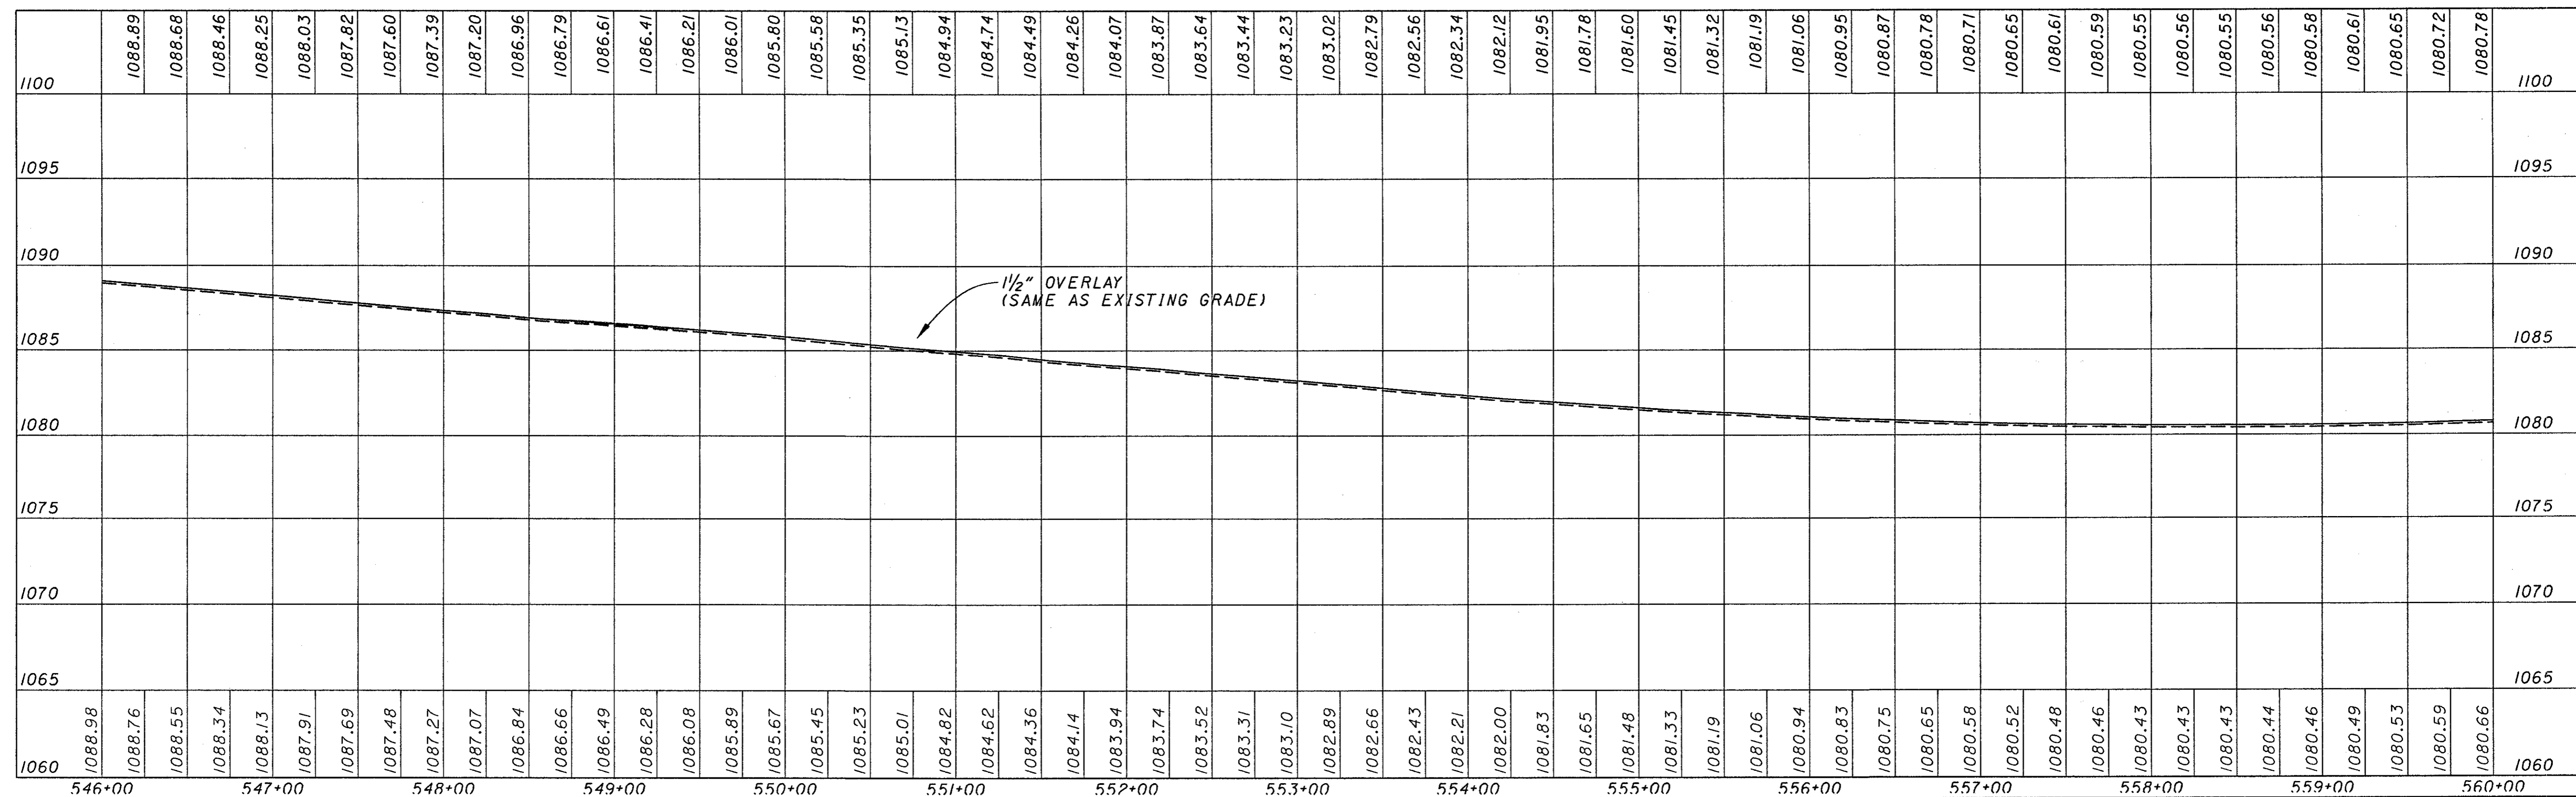


PRE-70-0.00

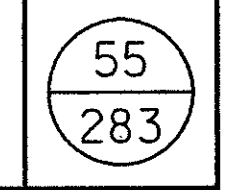

REVISIONS: REF: 01, 02, 03, 99, 100.

WEST BOUND PROFILE

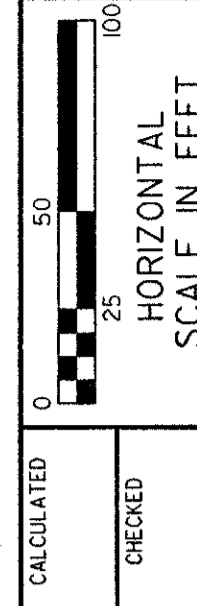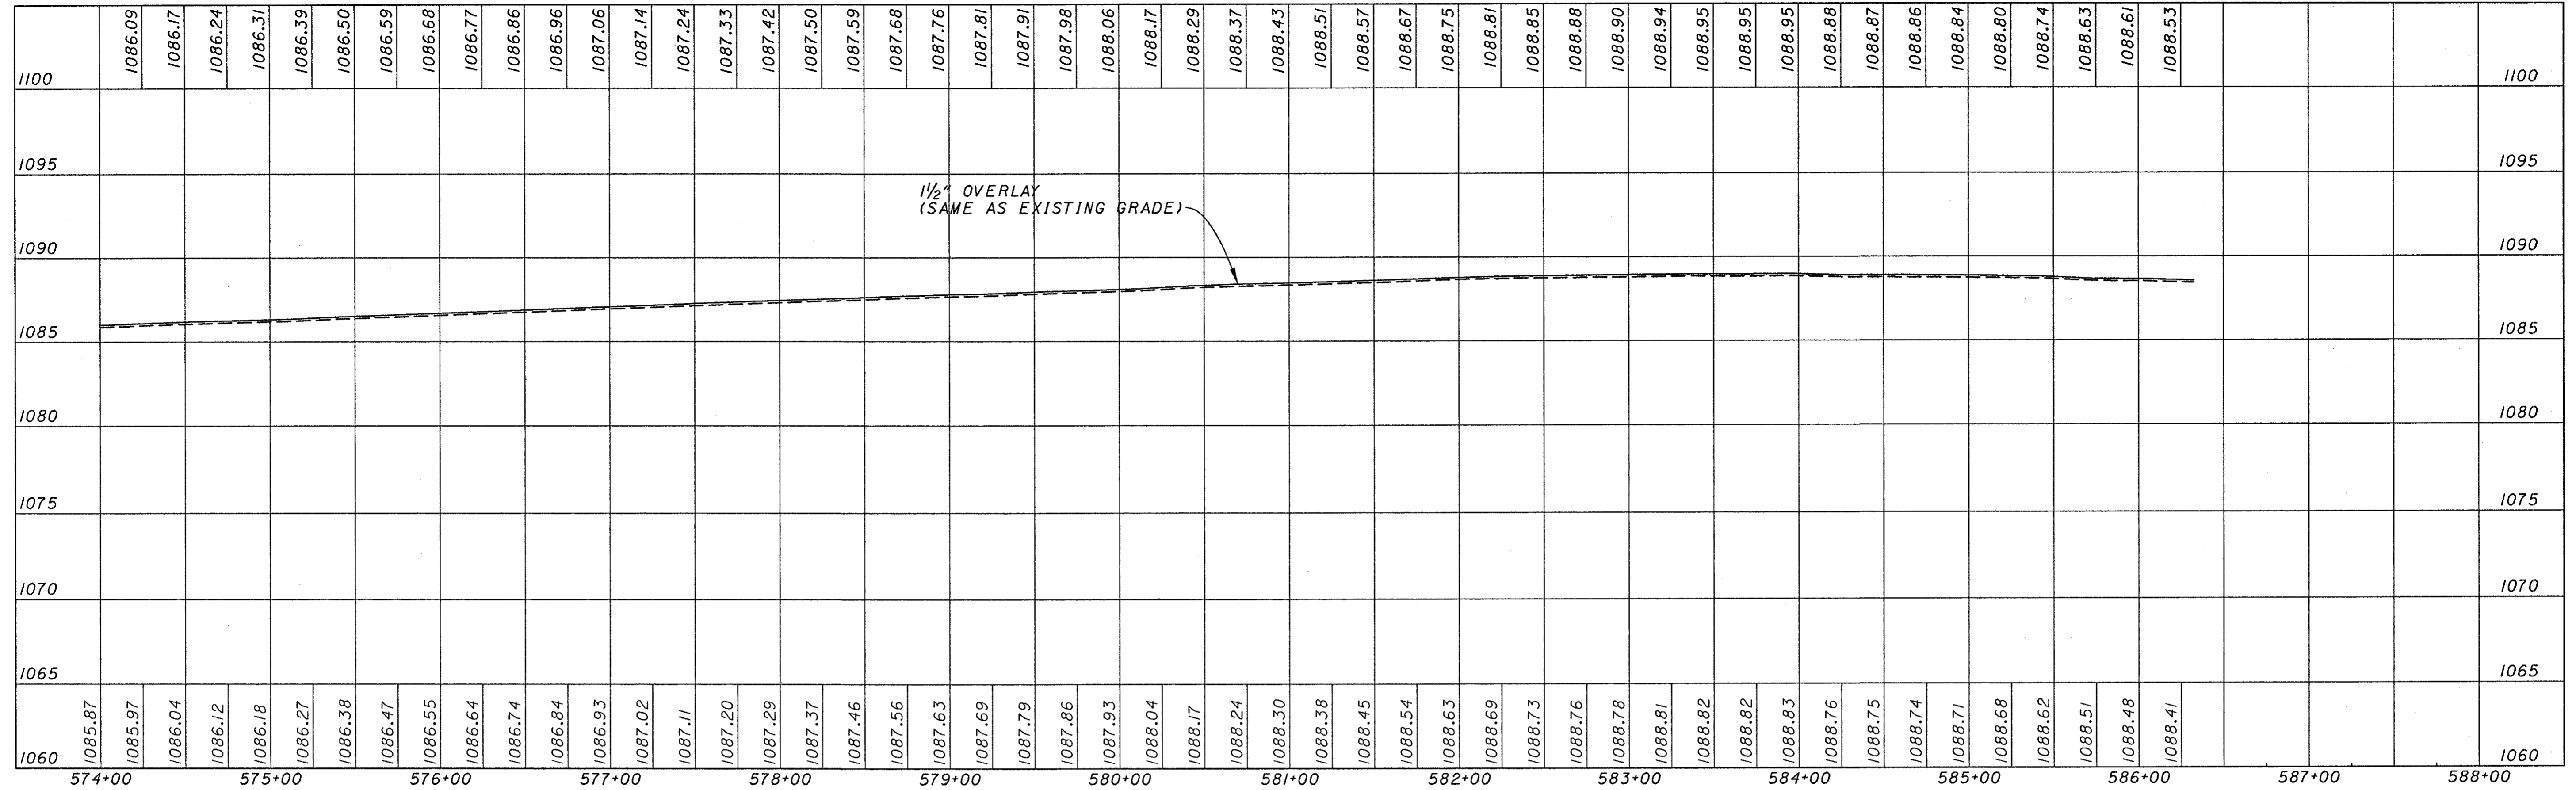


CALCULATED
CHECKED

PROFILE GRADES
STA 574+00 TO STA 588+00

PRE-70-0.00



57
283

EAST BOUND PROFILE

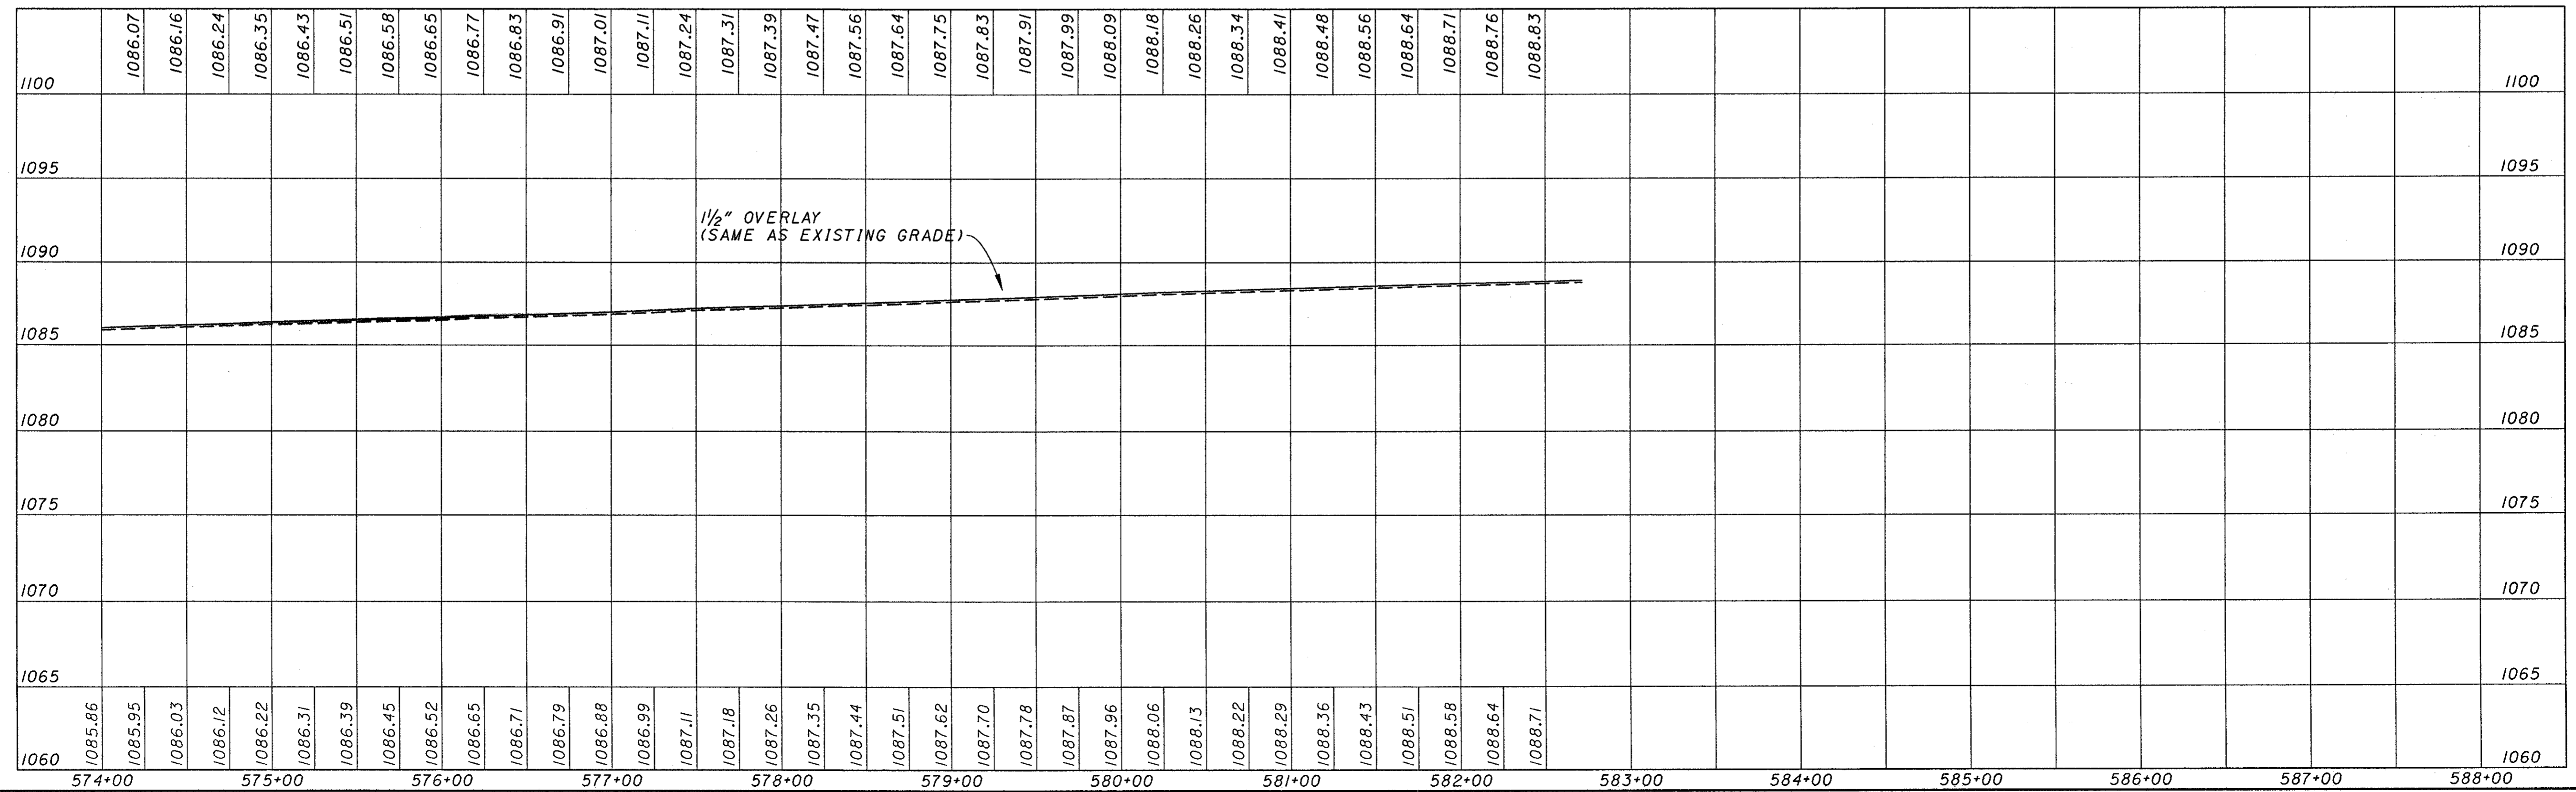


USER: 11/11/2008 10:00 AM
 PROJECT: 11/11/2008 10:00 AM
 DRAWING: 11/11/2008 10:00 AM
 SCALE: 1"=40'

WEST BOUND PROFILE

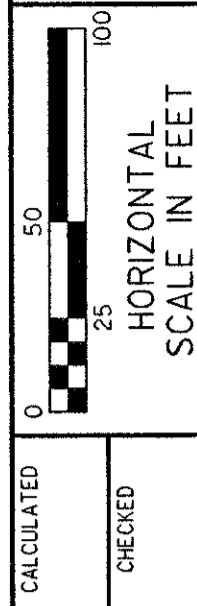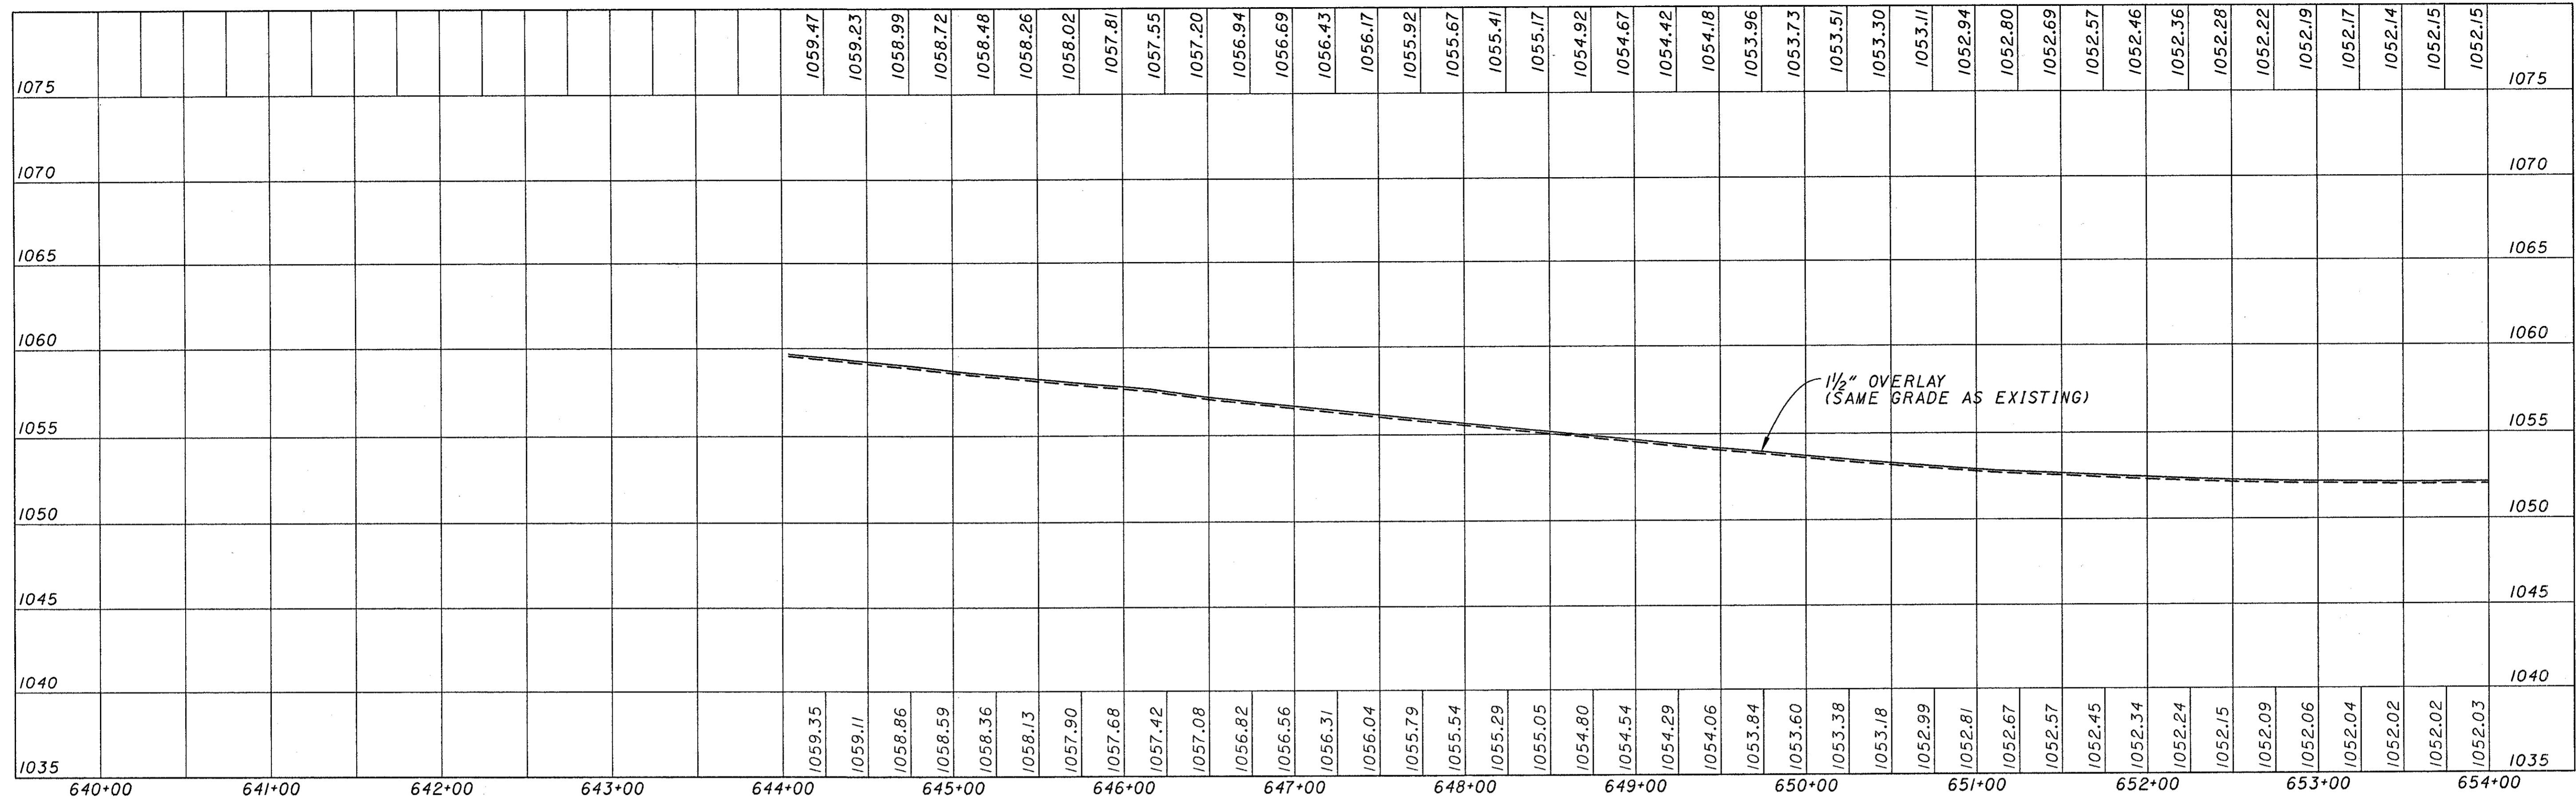

EAST BOUND PROFILE

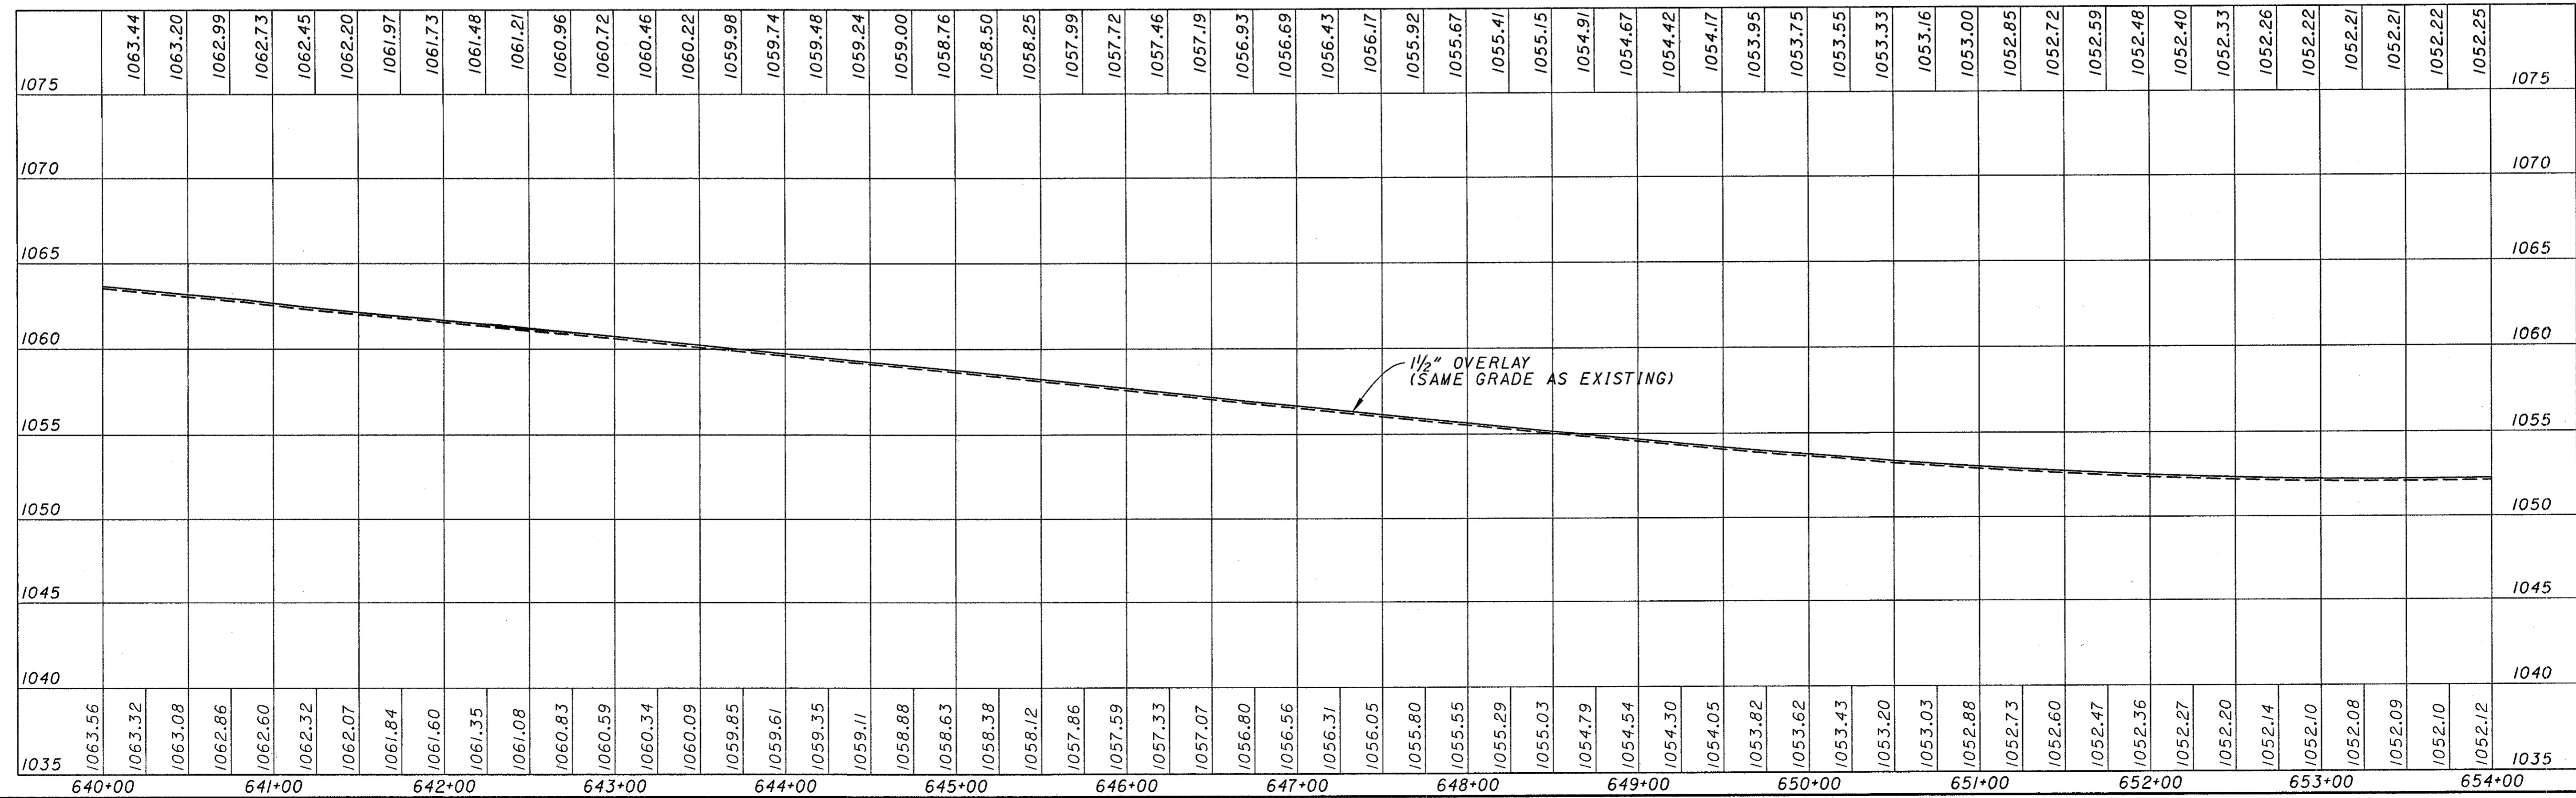


PROFILE GRADES
STA 640+00 TO STA 654+00

PRE-70-0.00


518
 283

 USER: *****
 PROJECT: *****
 DATE: *****
 ACTIVE LEVELS ON: #LEVE#

WEST BOUND PROFILE

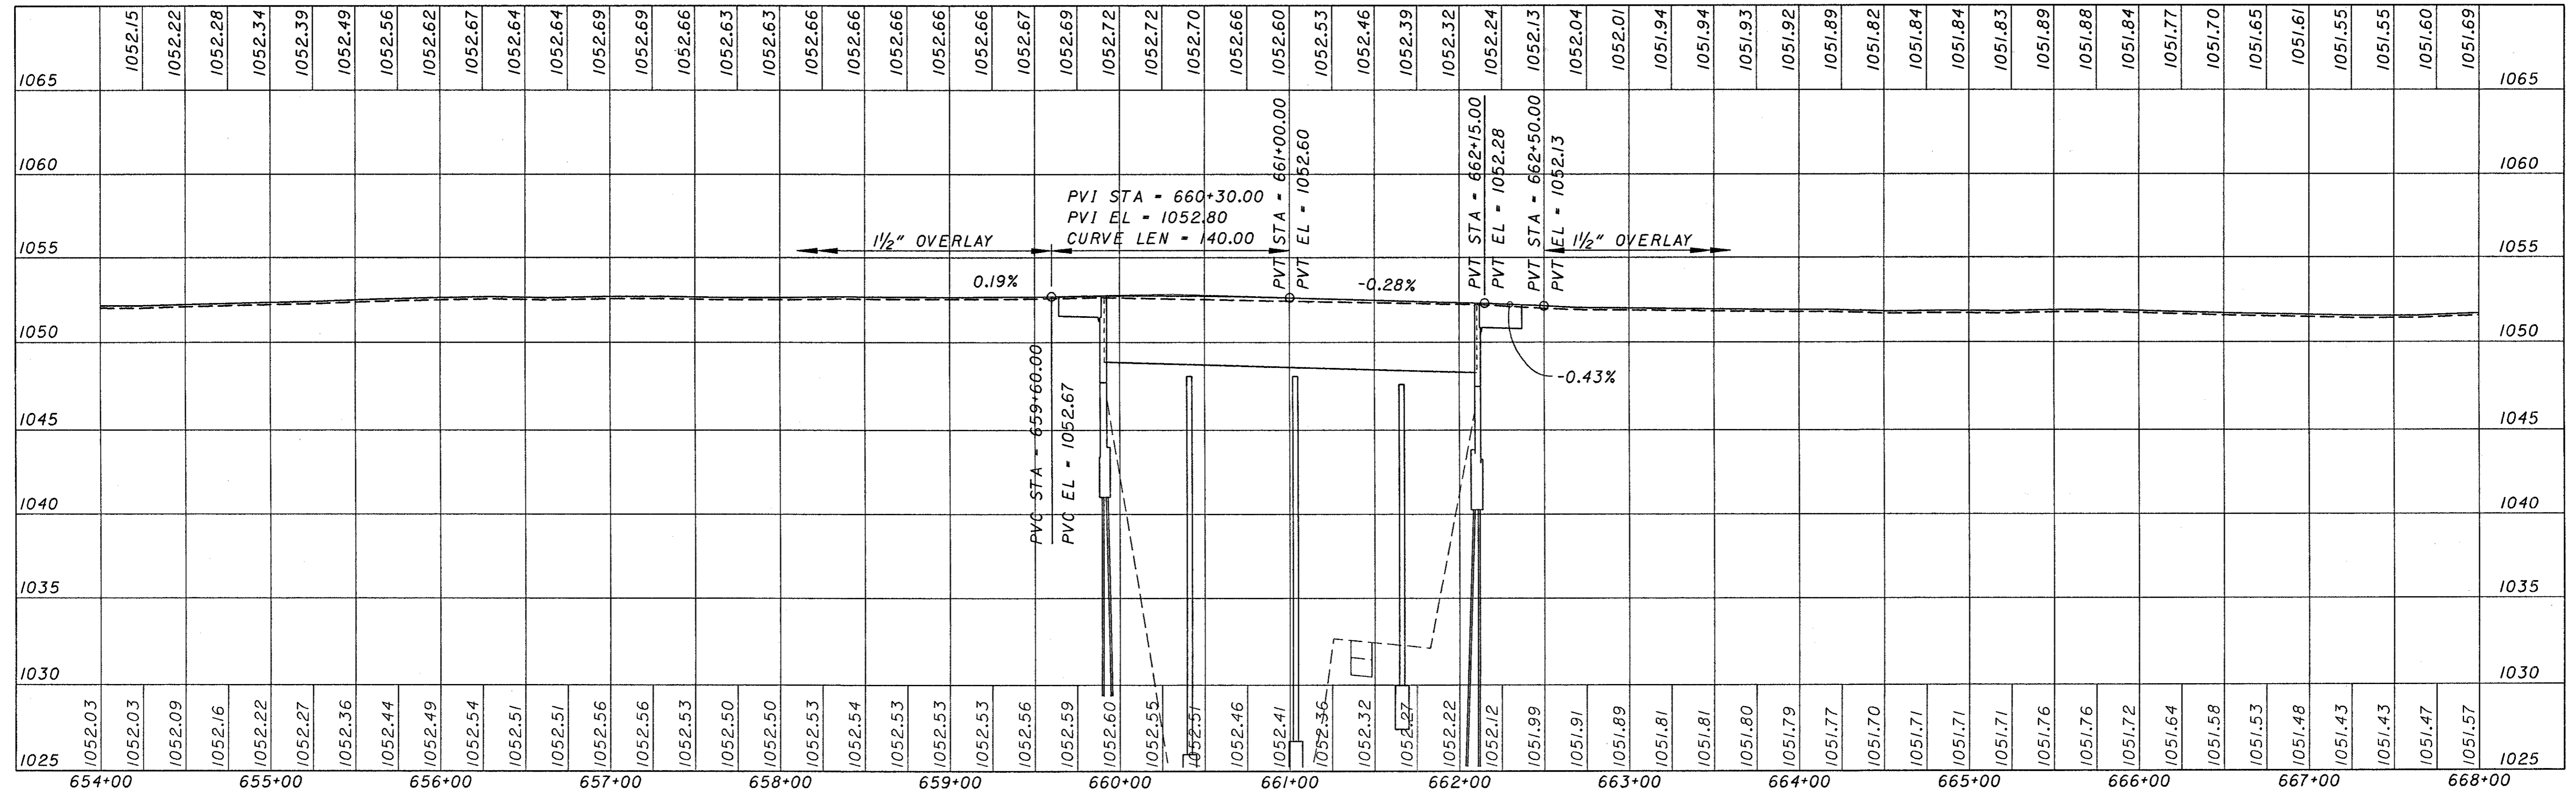

EAST BOUND PROFILE


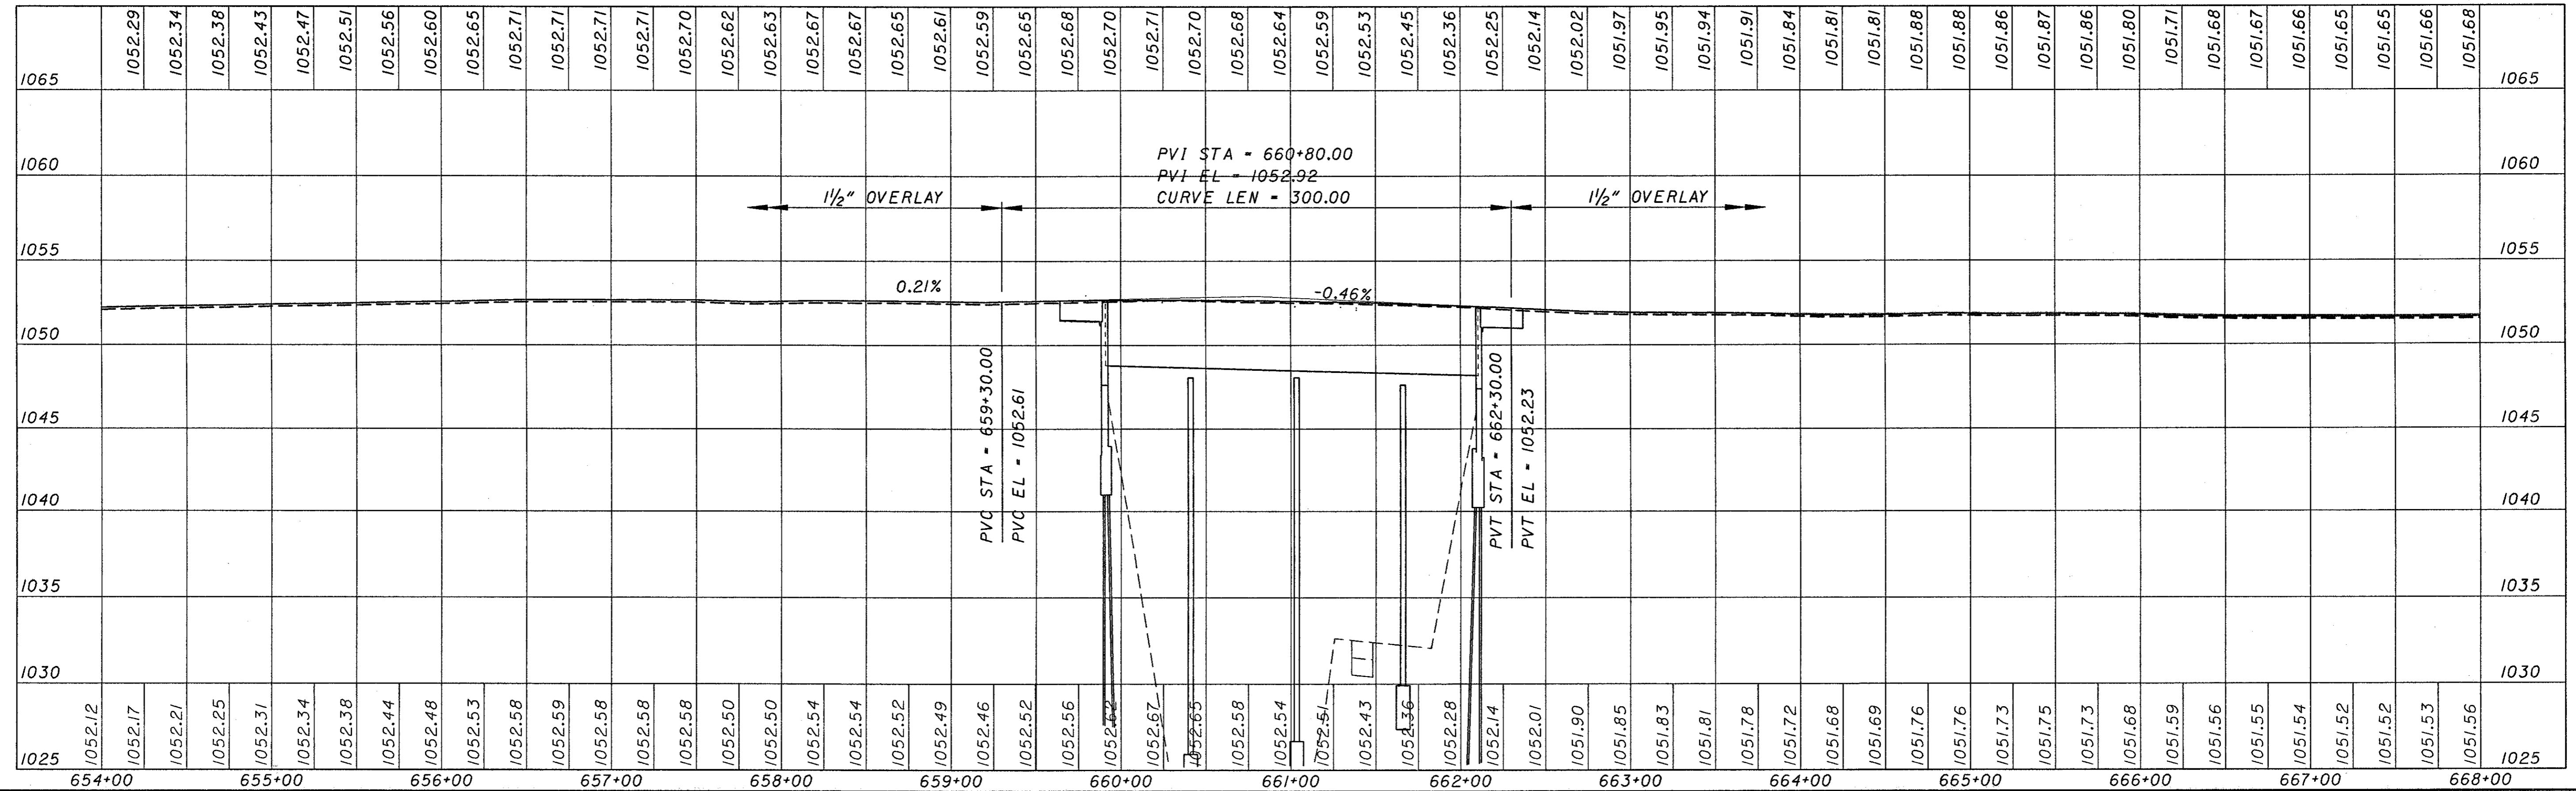


PROFILE GRADES
STA 654+00 TO STA 668+00


PRE-70-0.00

PROJECT: REF100
USER: REF100
DATE: REF100
TIME: REF100
ACTIVE LEVELS ON: REF100

WEST BOUND PROFILE

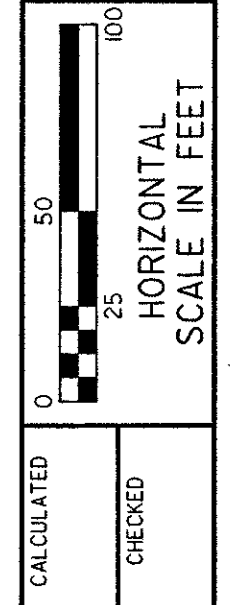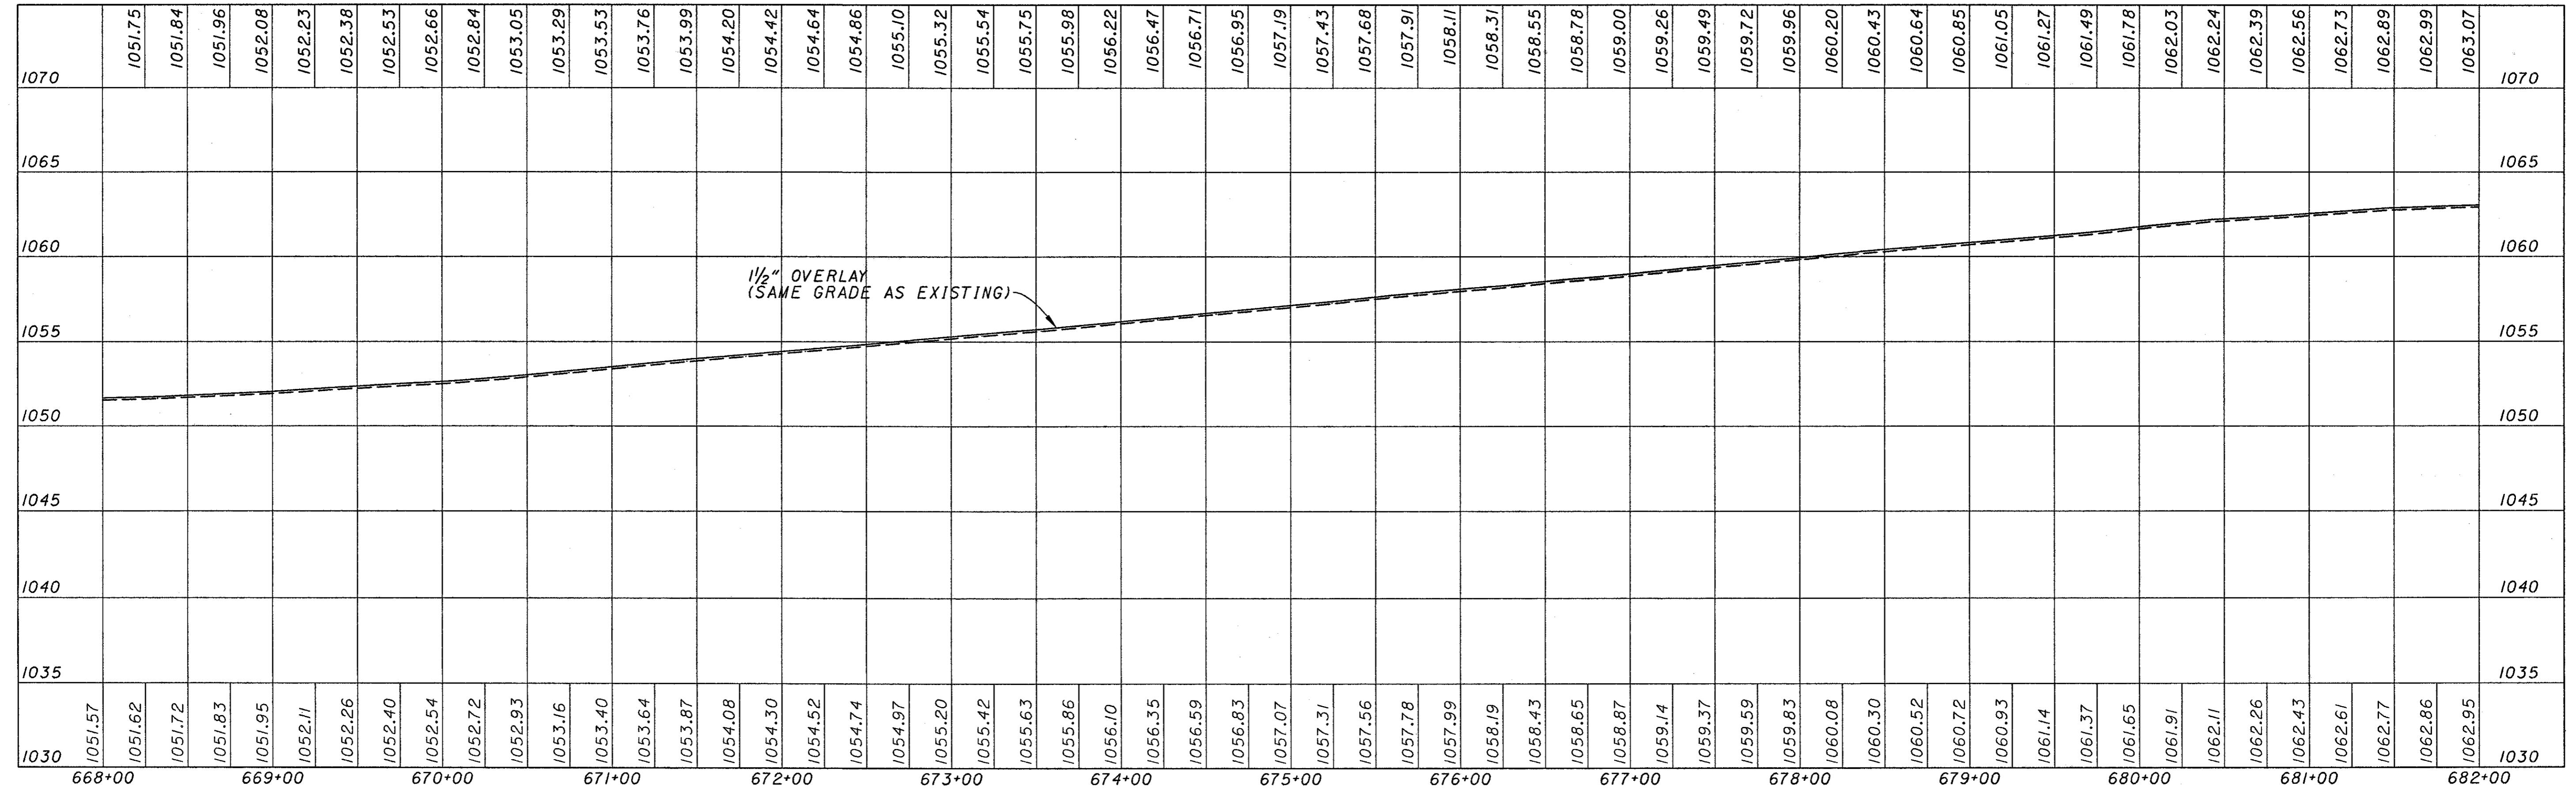

EAST BOUND PROFILE

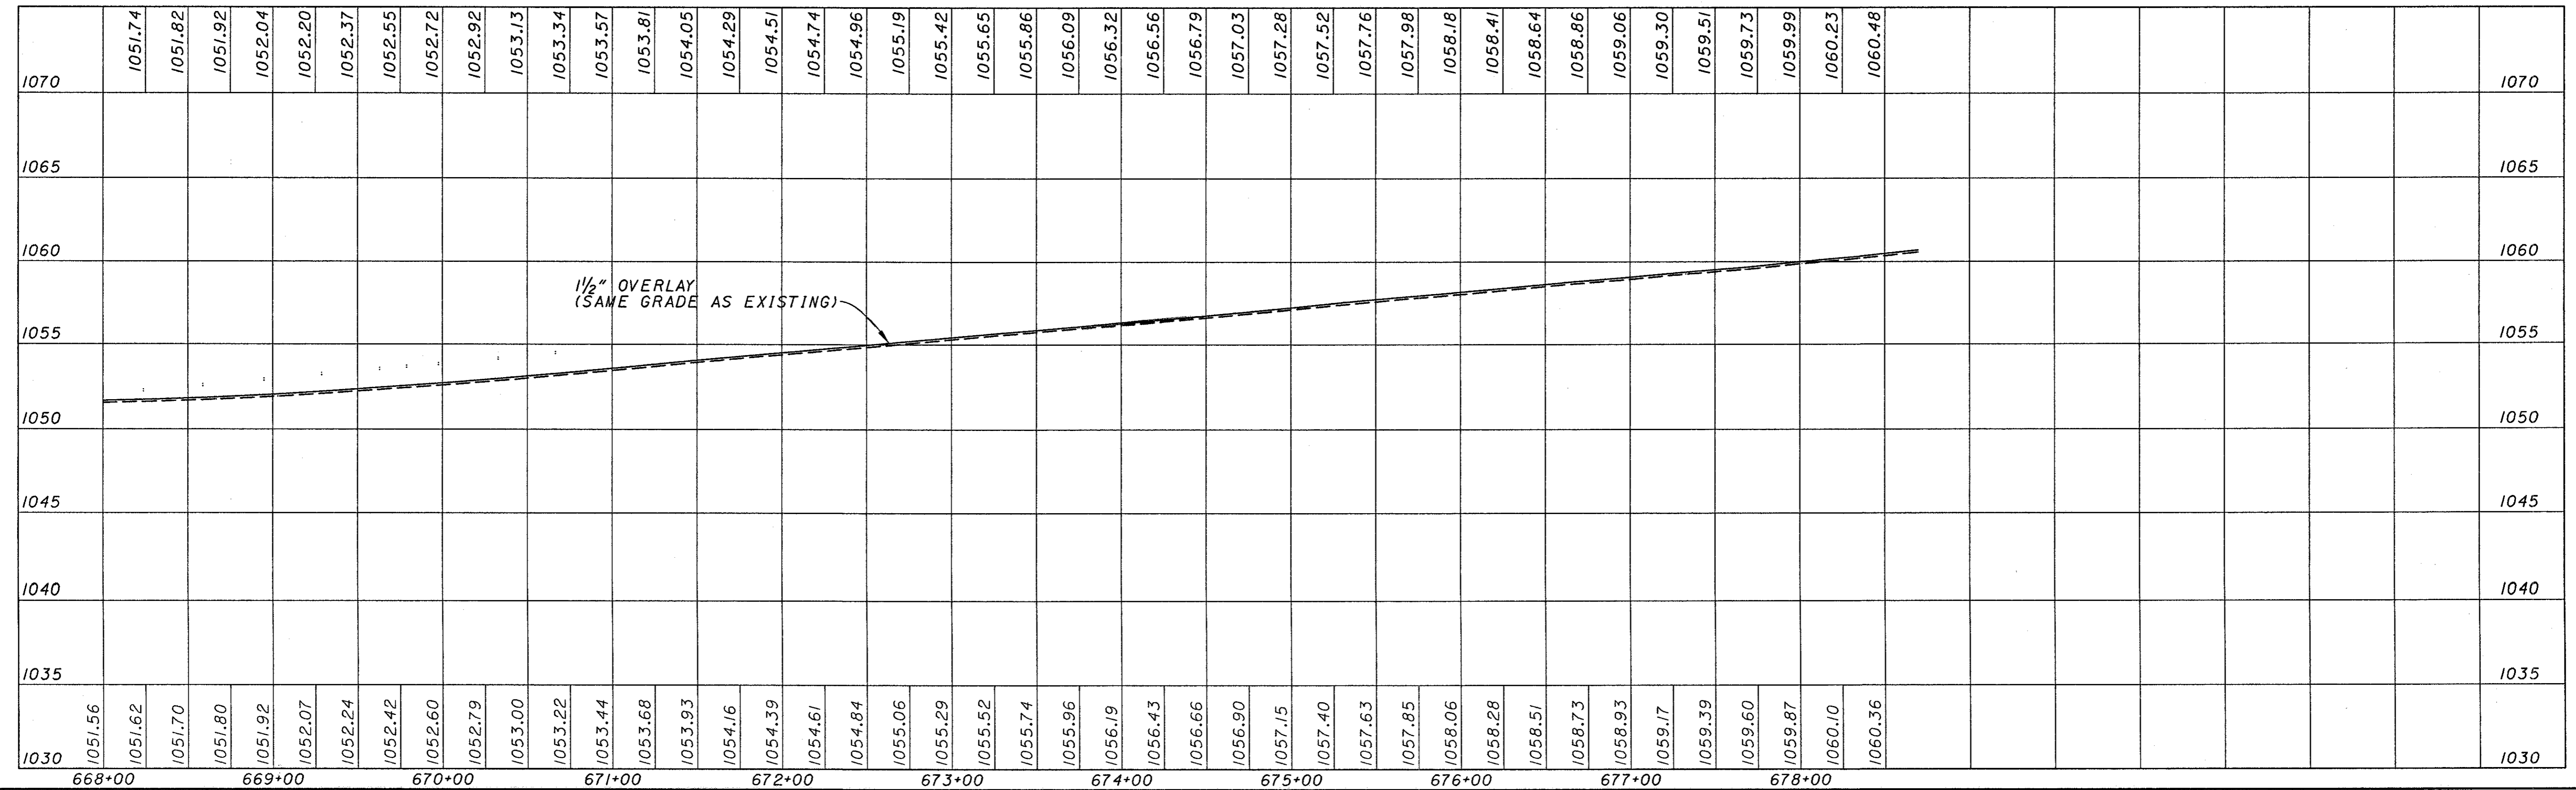


PROFILE GRADES
STA 668+00 TO STA 682+00

PRE-70-0.00



60
 283

 USER: *****
 PROJECT: *****
 DATE: *****
 TIME: *****
 ACTIVE LEVELS: ON: *\$LEV**

WEST BOUND PROFILE

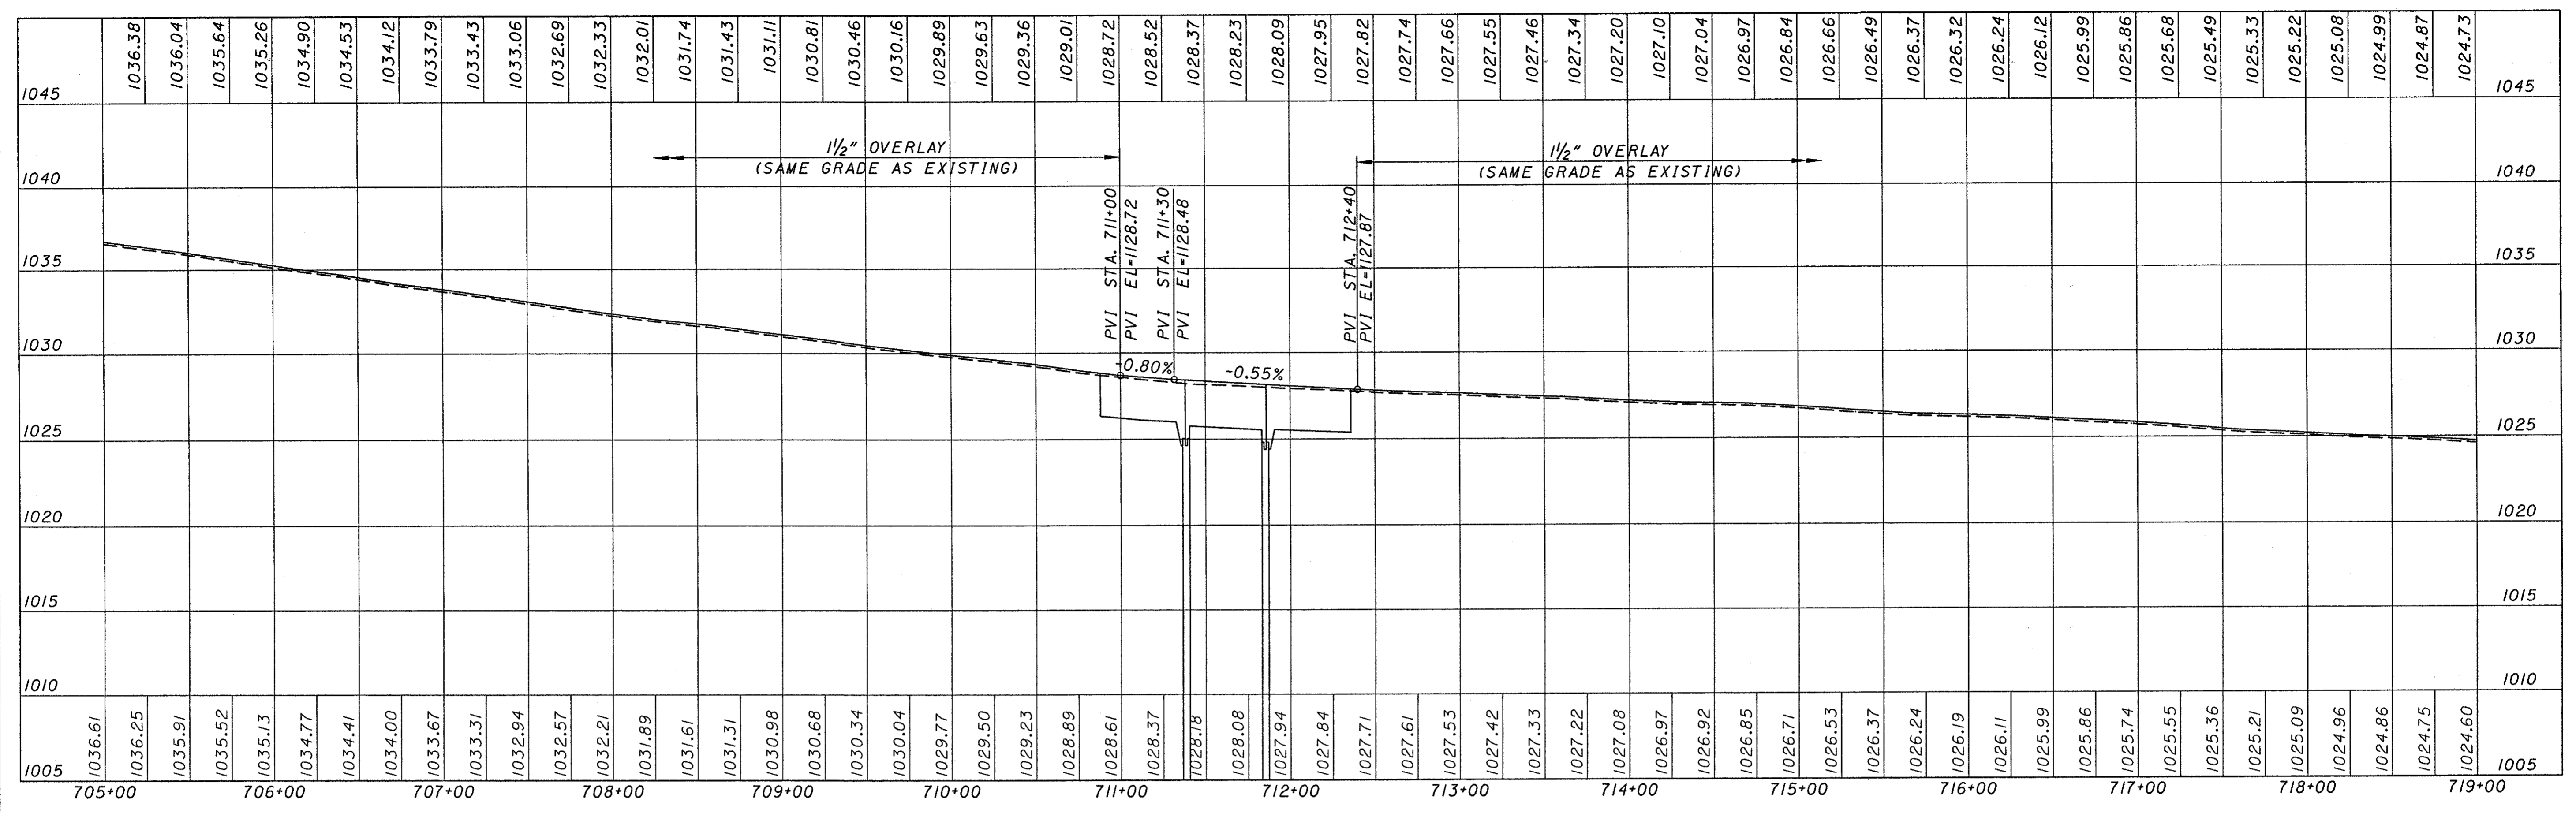

EAST BOUND PROFILE

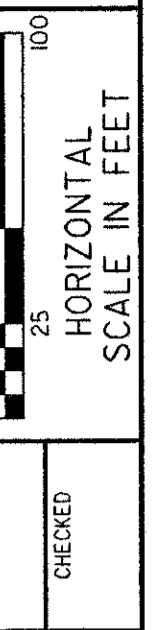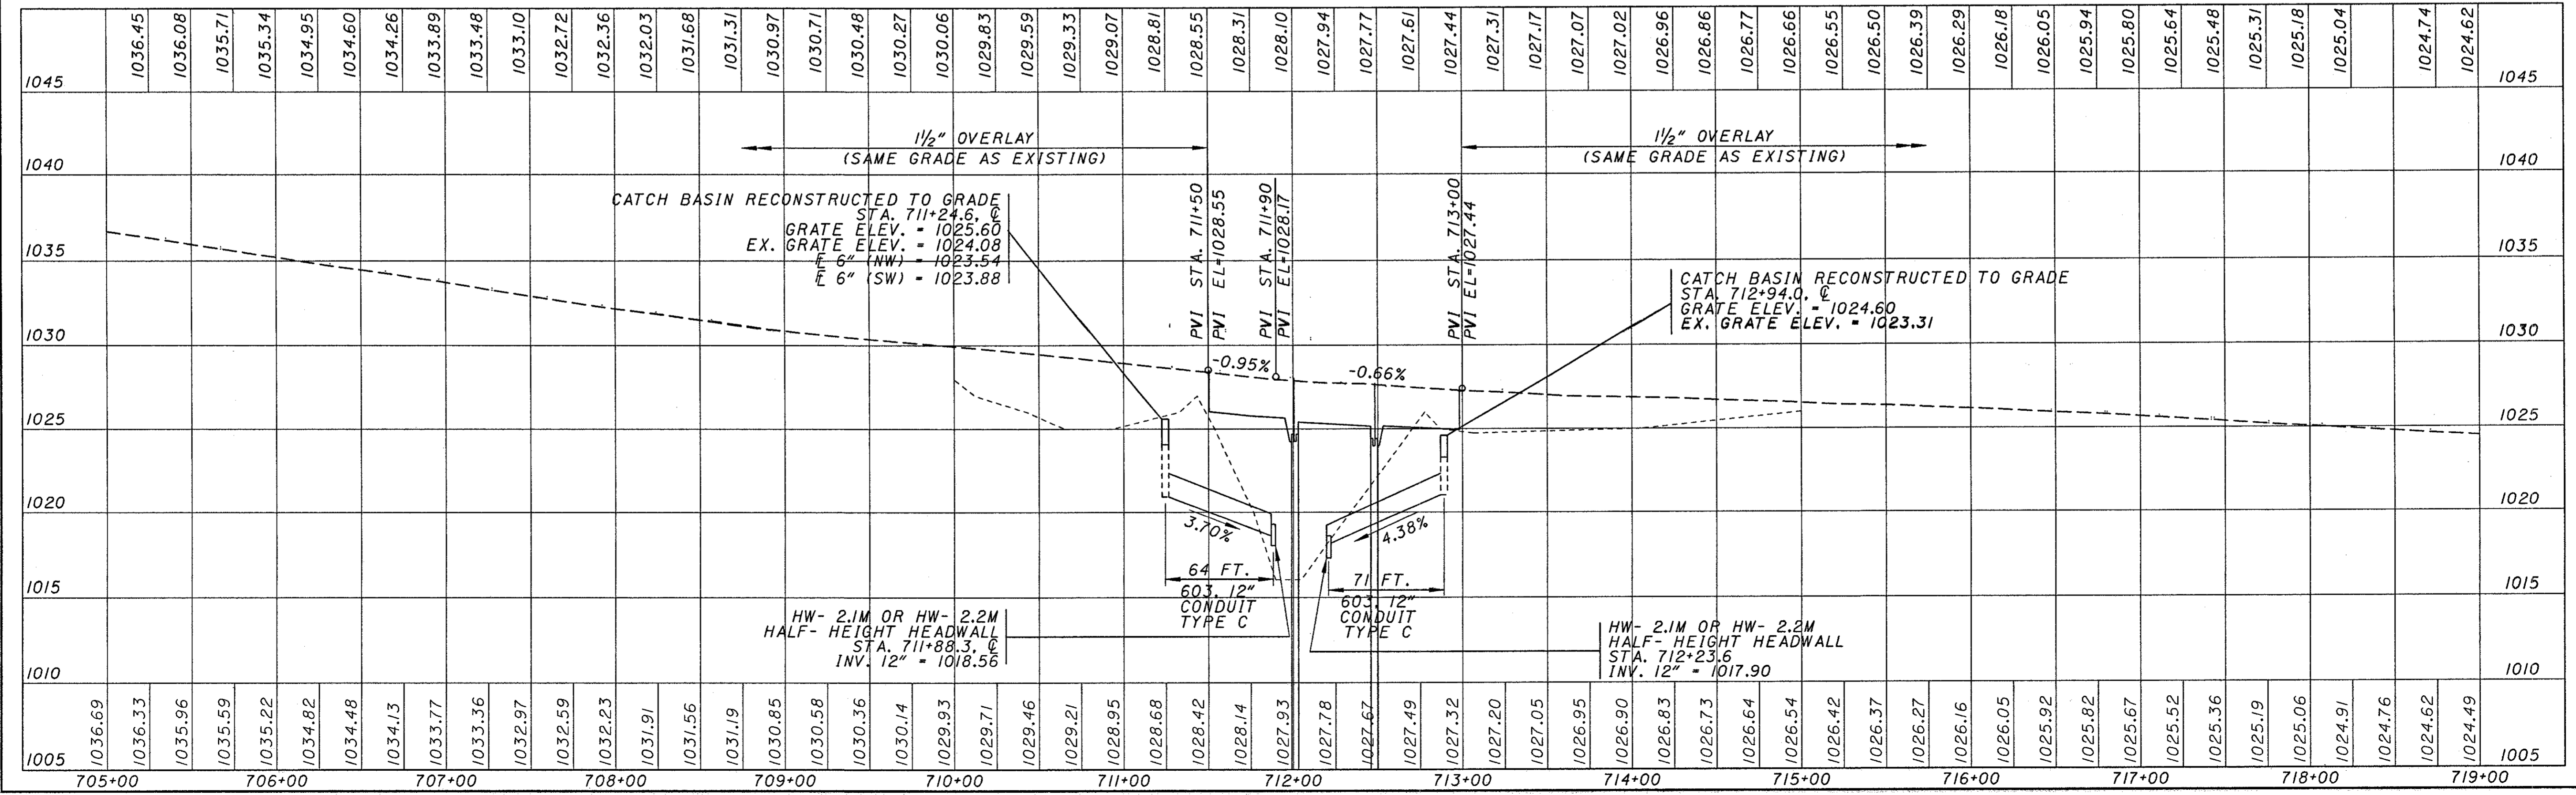


PROFILE GRADES
STA 705+00 TO STA 719+00



PRE-70-0.00

REF: 1001, 1002, 1003, 1004, 1005
USER: 1001, 1002, 1003, 1004, 1005
DATE: 10/10/00
ACTIVE LEVELS ON: 1001, 1002, 1003, 1004, 1005

WEST BOUND PROFILE

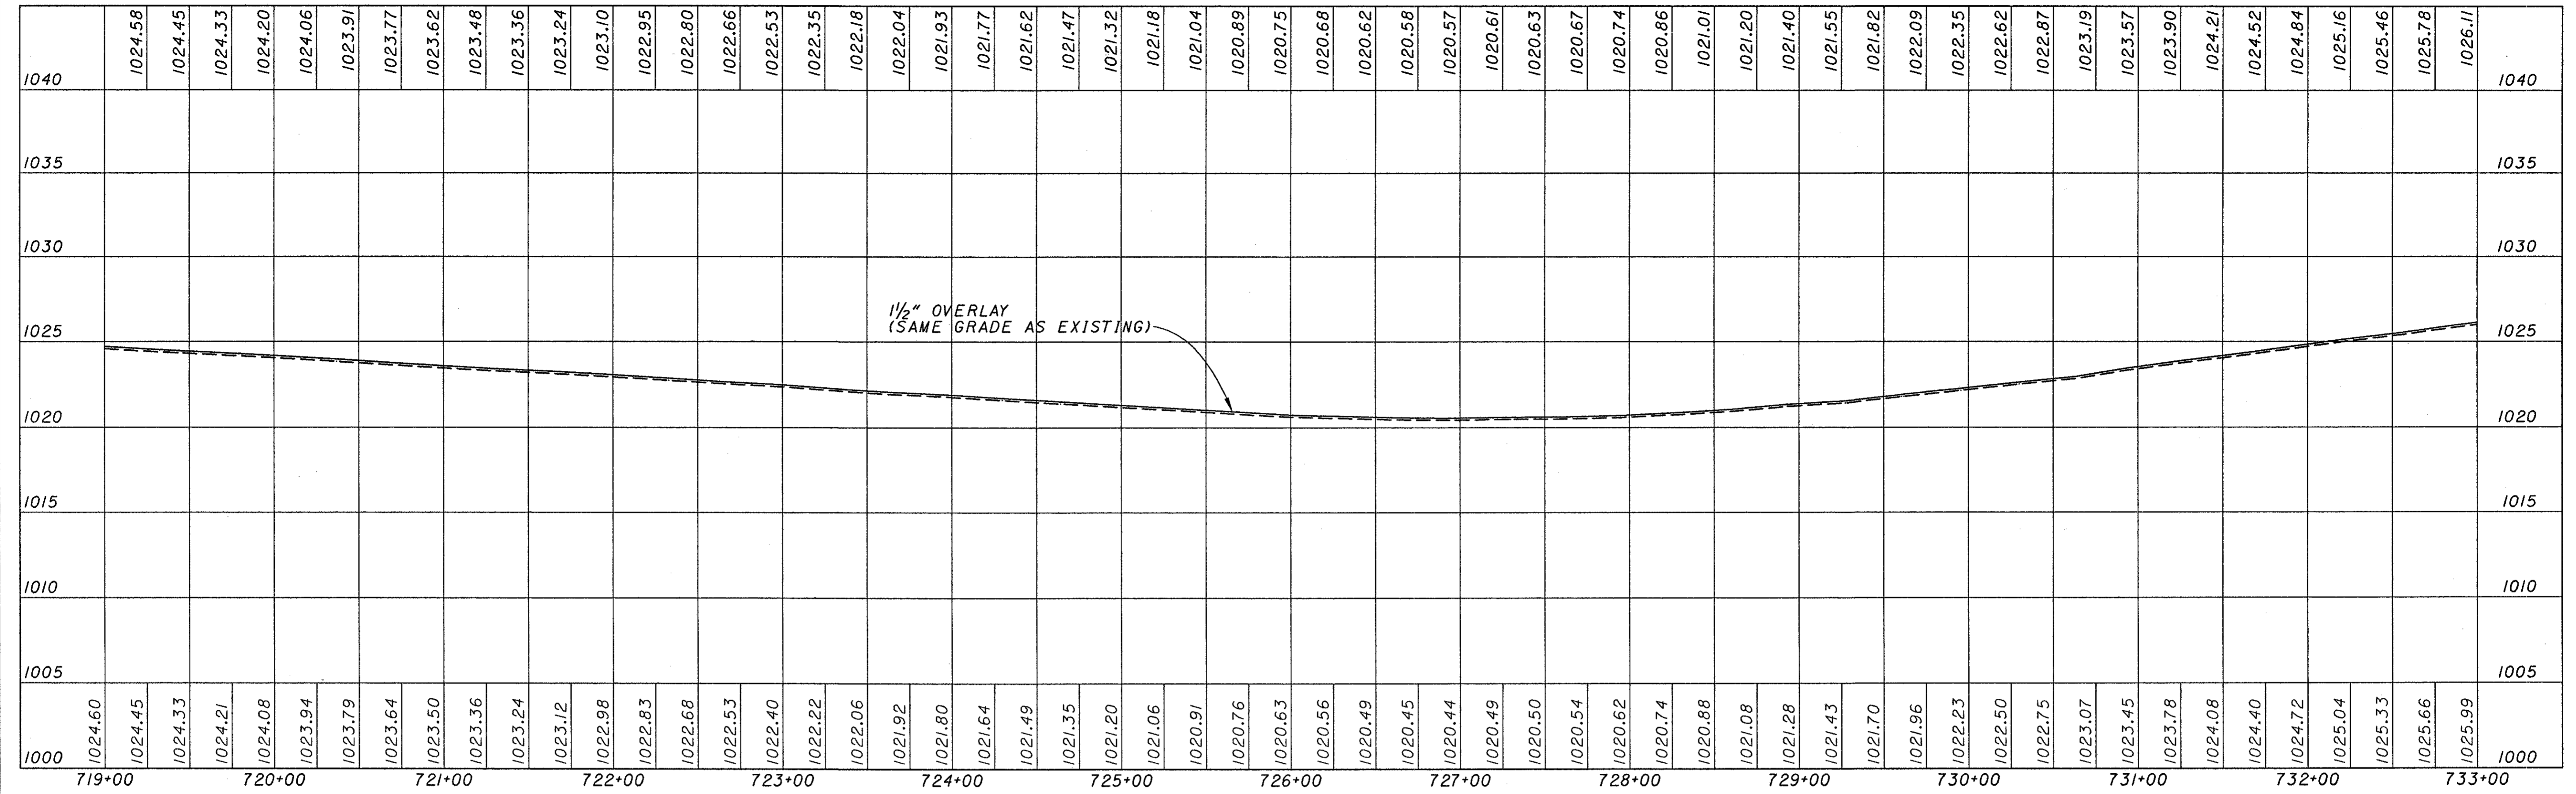

EAST BOUND PROFILE

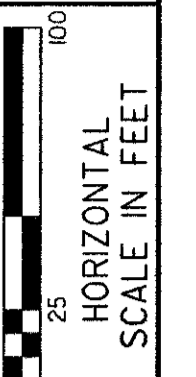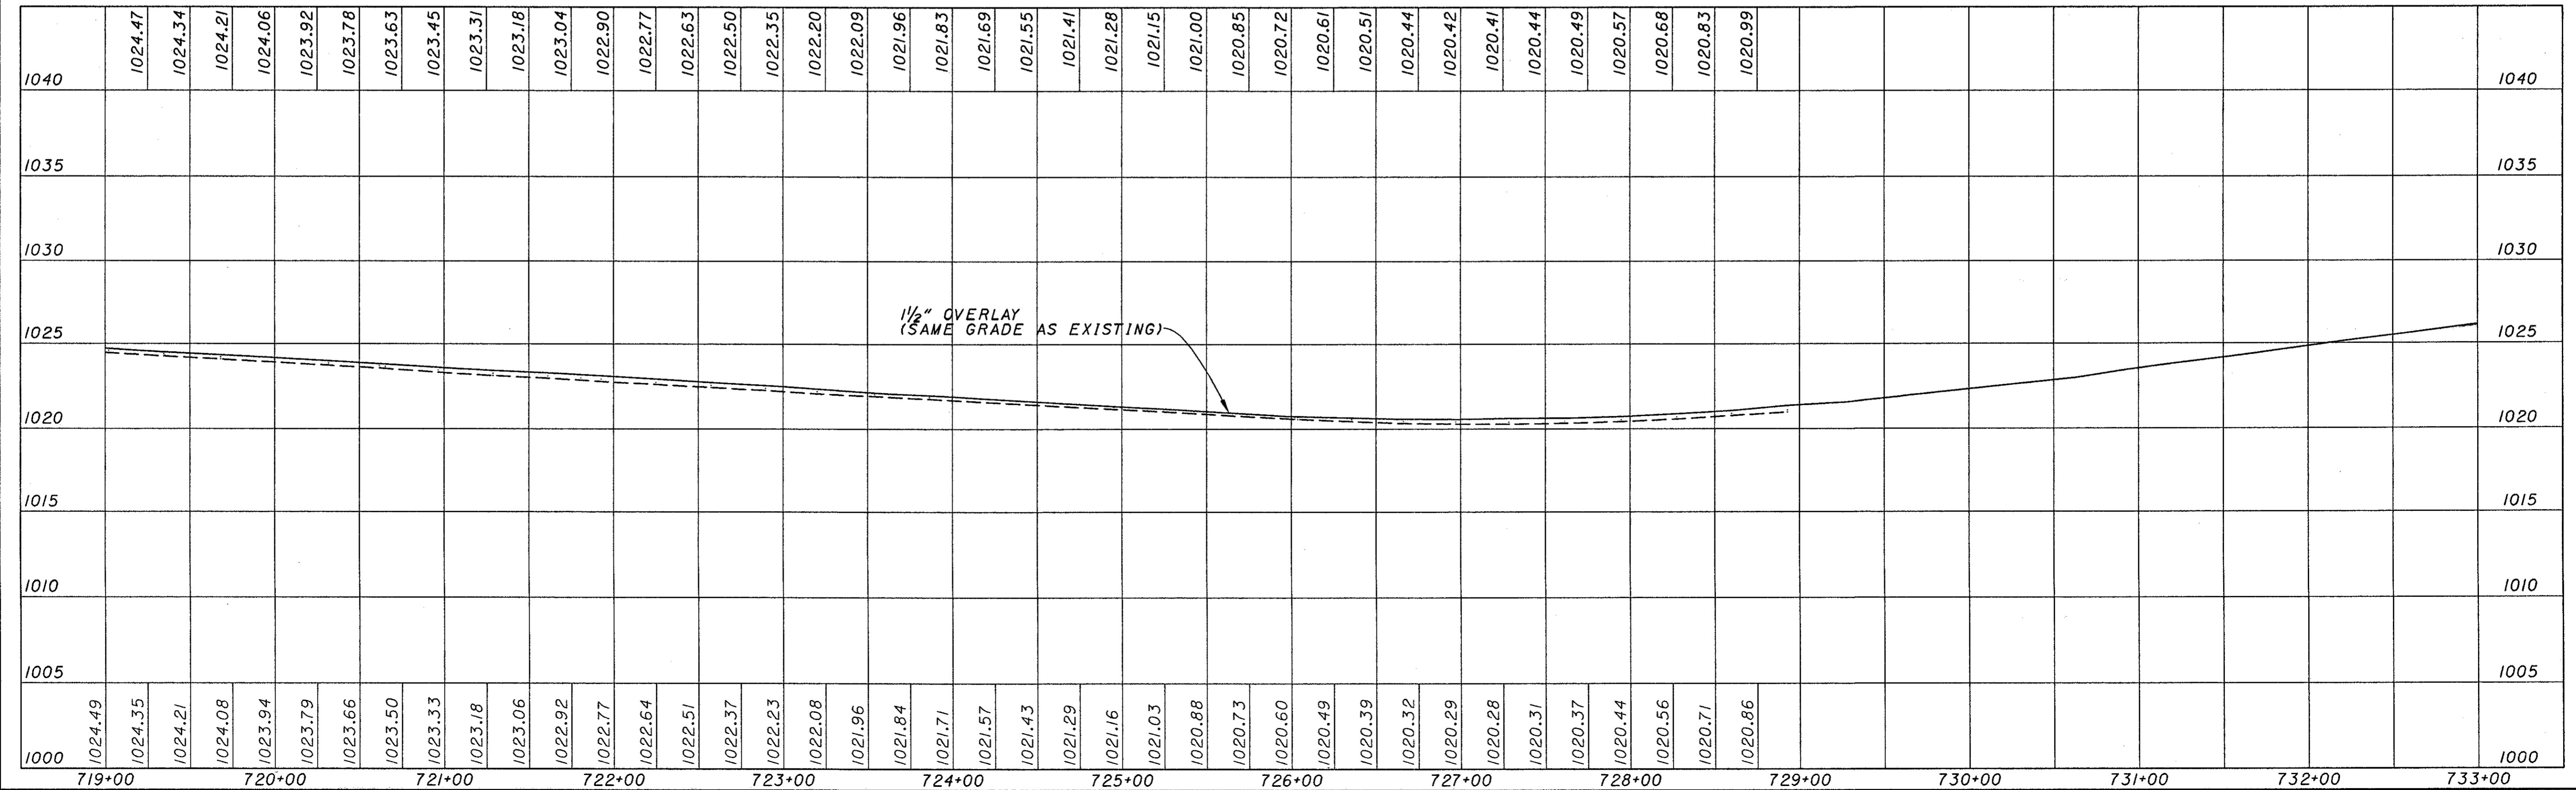



CALCULATED
CHECKED

**PROFILE GRADES
STA 719+00 TO STA 733+00**

PRE-70-0.00


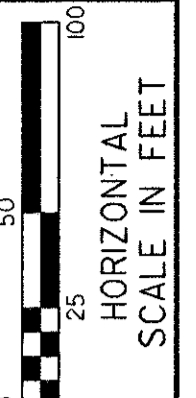
DATE: 11/15/2011
 USER: JLM
 PROJECT: I-75/US-90
 DRAWING: PRE-70-0.00
 SHEET: 283 OF 283
 SCALE: AS SHOWN
 STATUS: ACTIVE

 USER: *****
 PROJECT: *****
 DRAWING: *****
 SHEET: *****
 ACTIVE LEVELS ON: *****

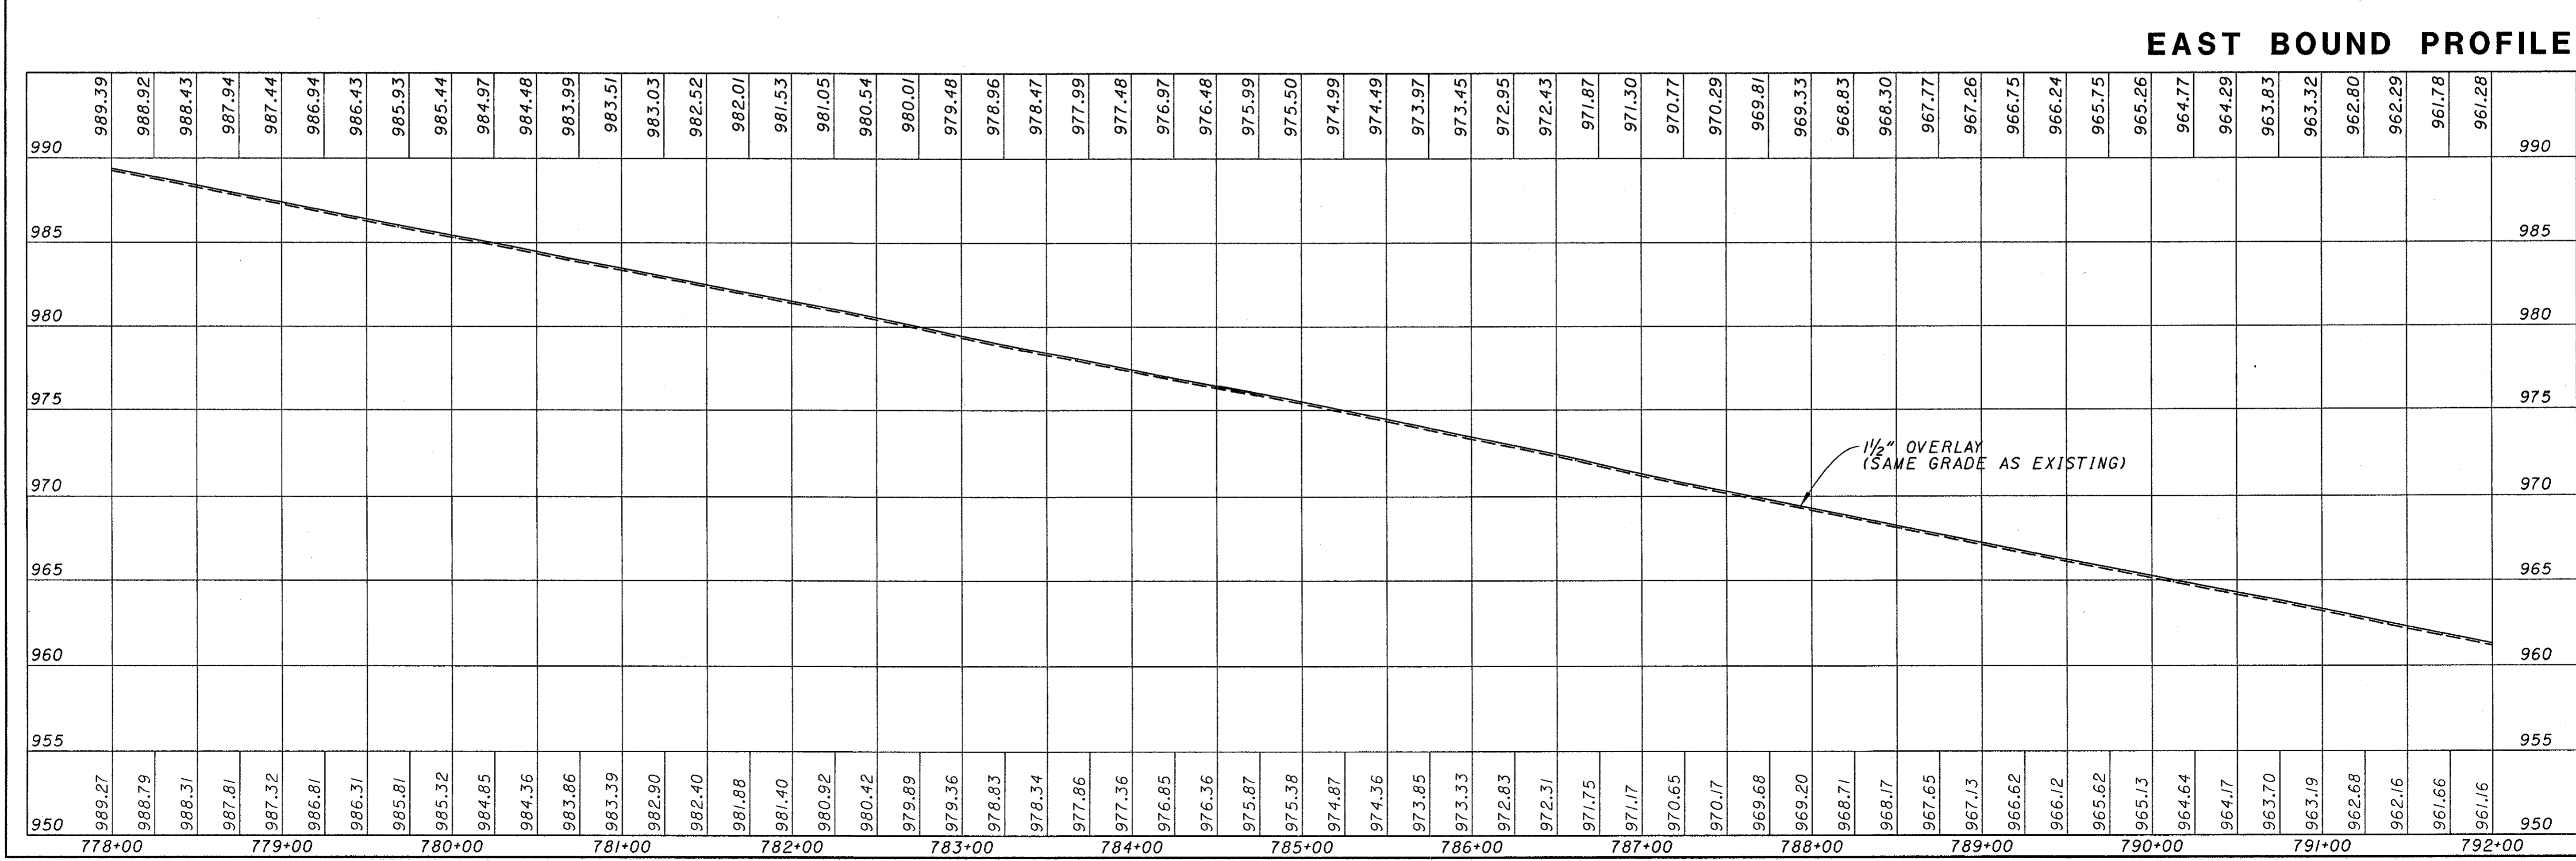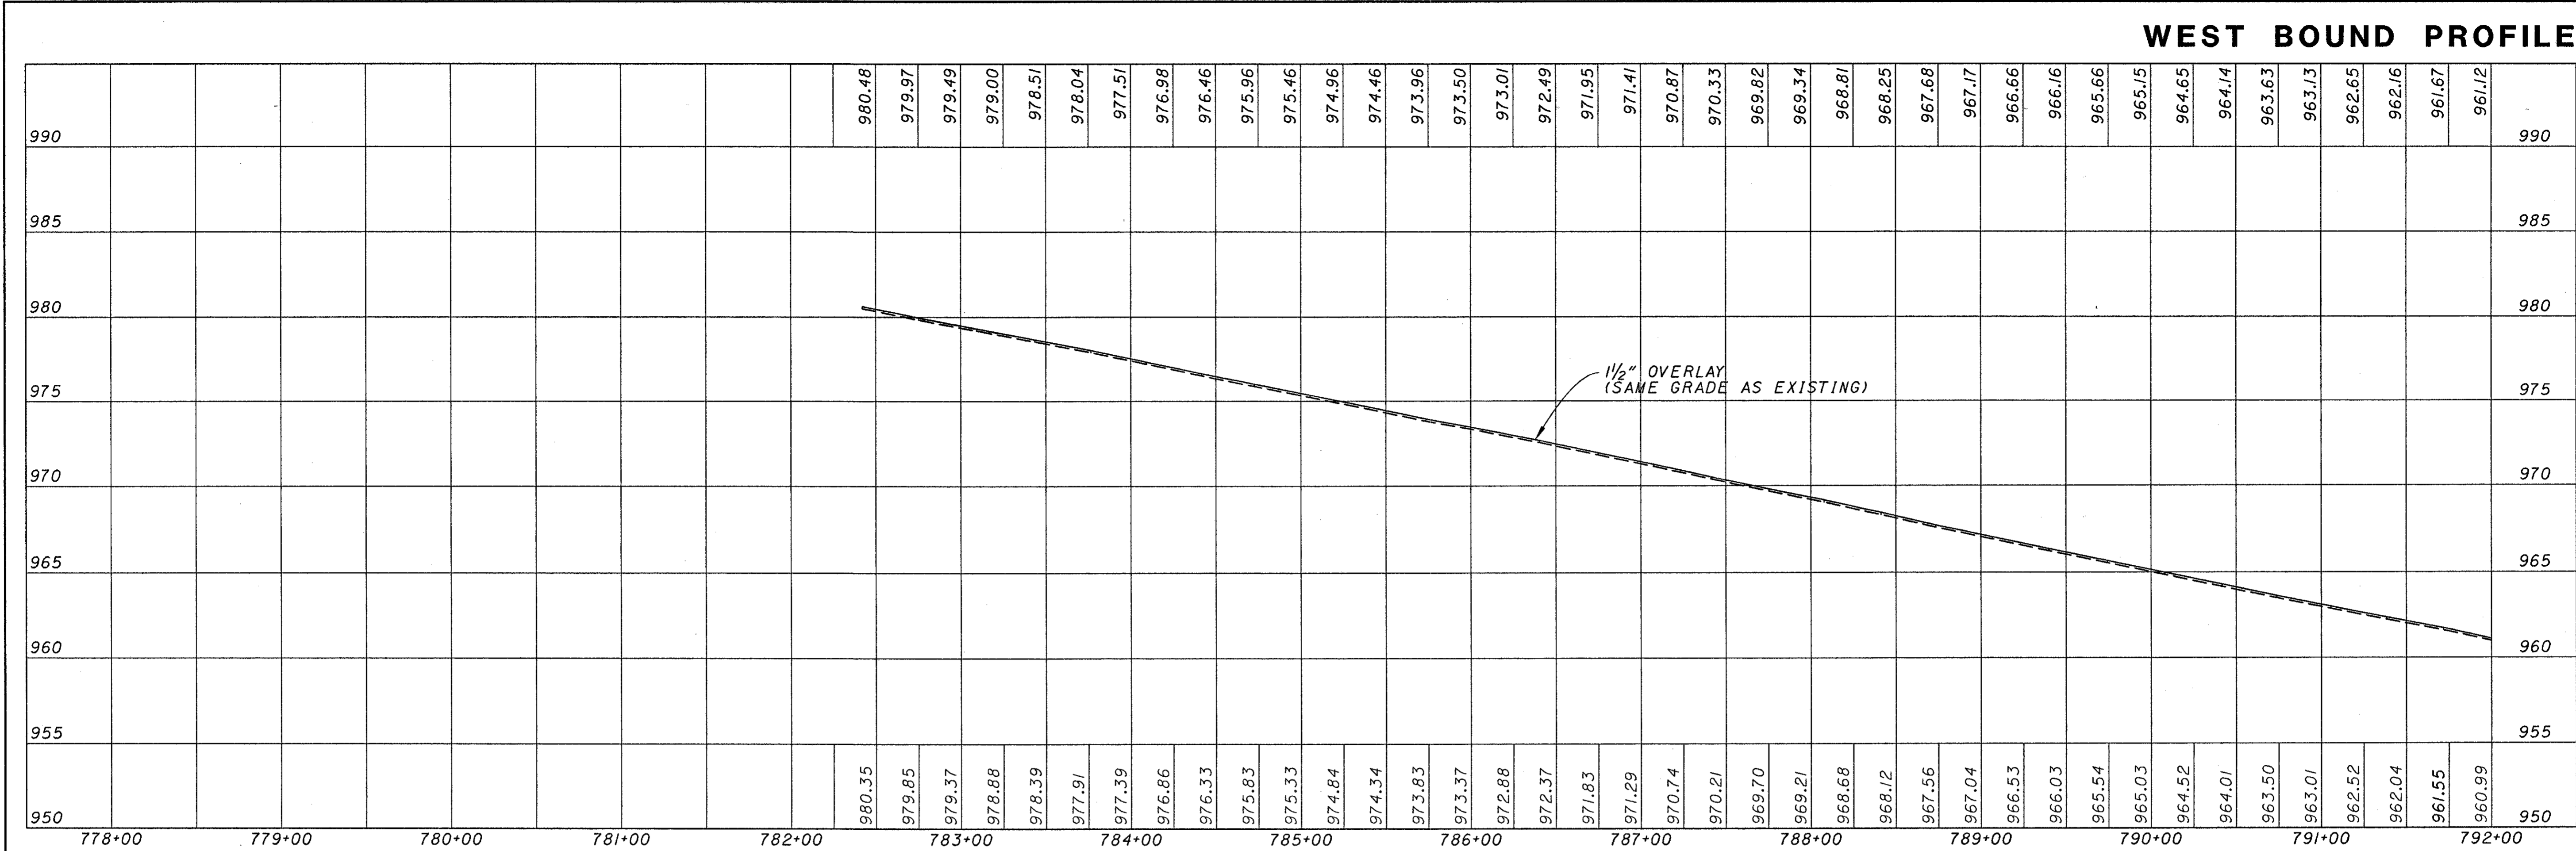

PROFILE GRADES
STA 778+00 TO STA 792+00



CALCULATED: _____
 CHECKED: _____

PRE-70-0.00

64
283


WEST BOUND PROFILE

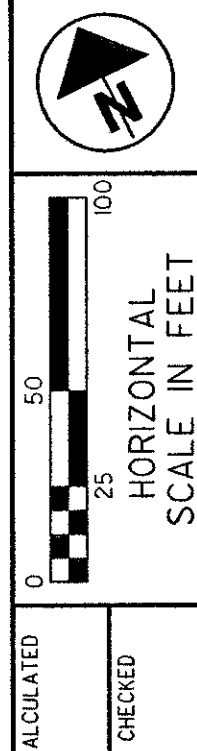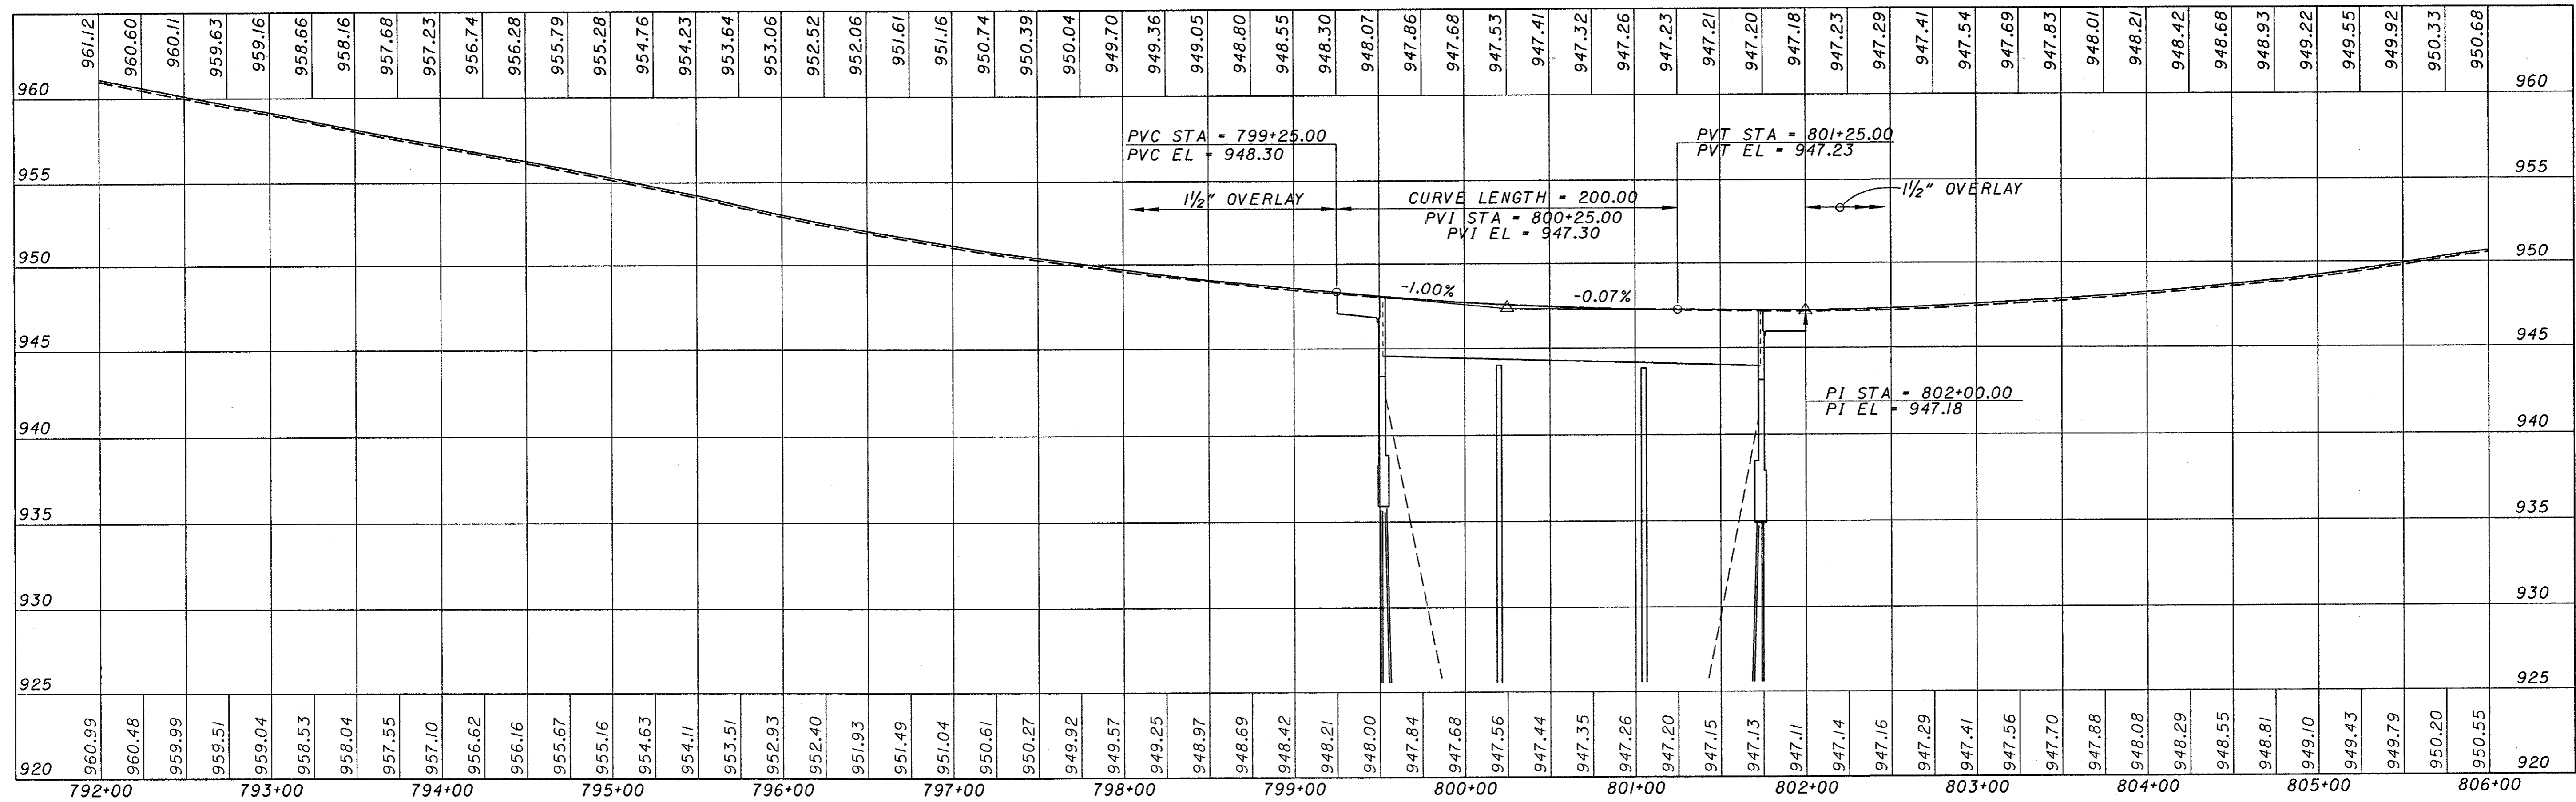

CALCULATED
CHECKED

**PROFILE GRADES
STA 792+00 TO STA 806+00**

EAST BOUND PROFILE

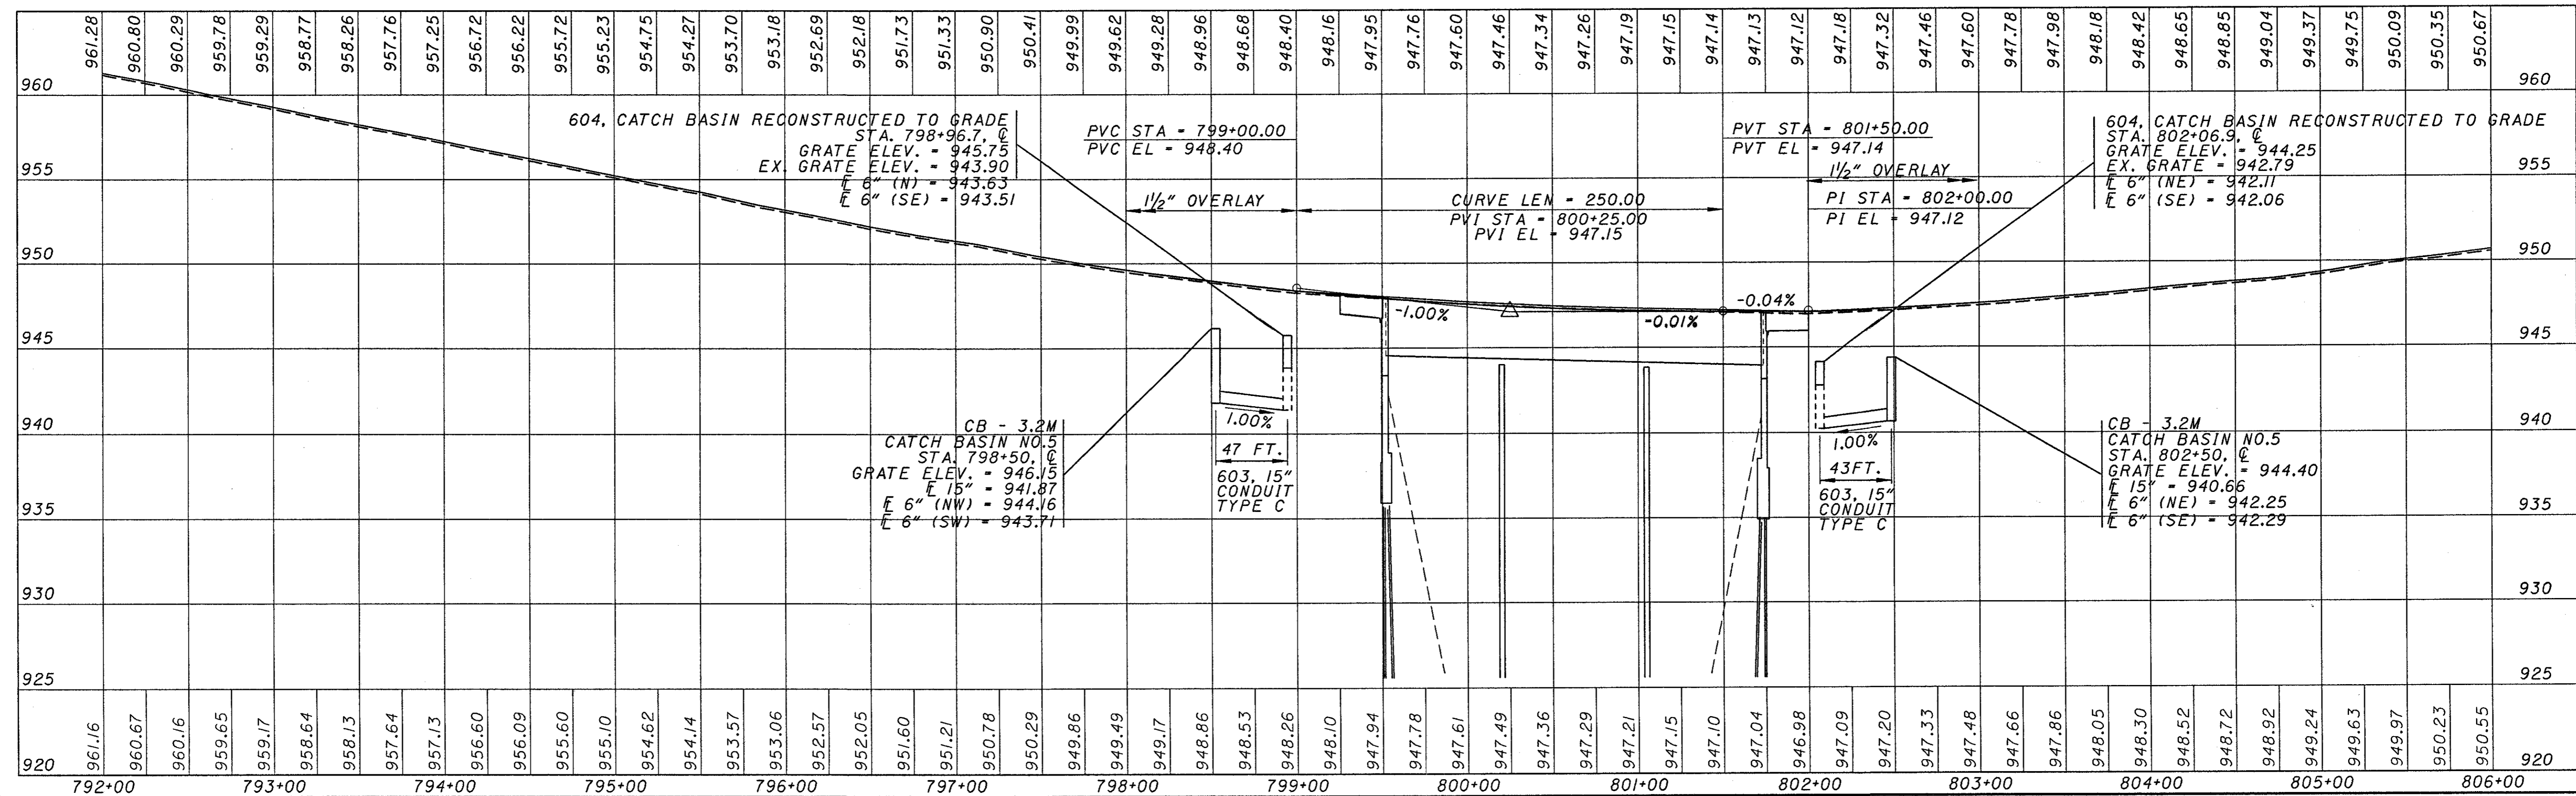


REF: **REF: **
 USER: **REF: **
 PROJ: **REF: **
 ACTIVE LEVELS ON: **LEV: **



PRE-70-0.00

65
283

WEST BOUND PROFILE

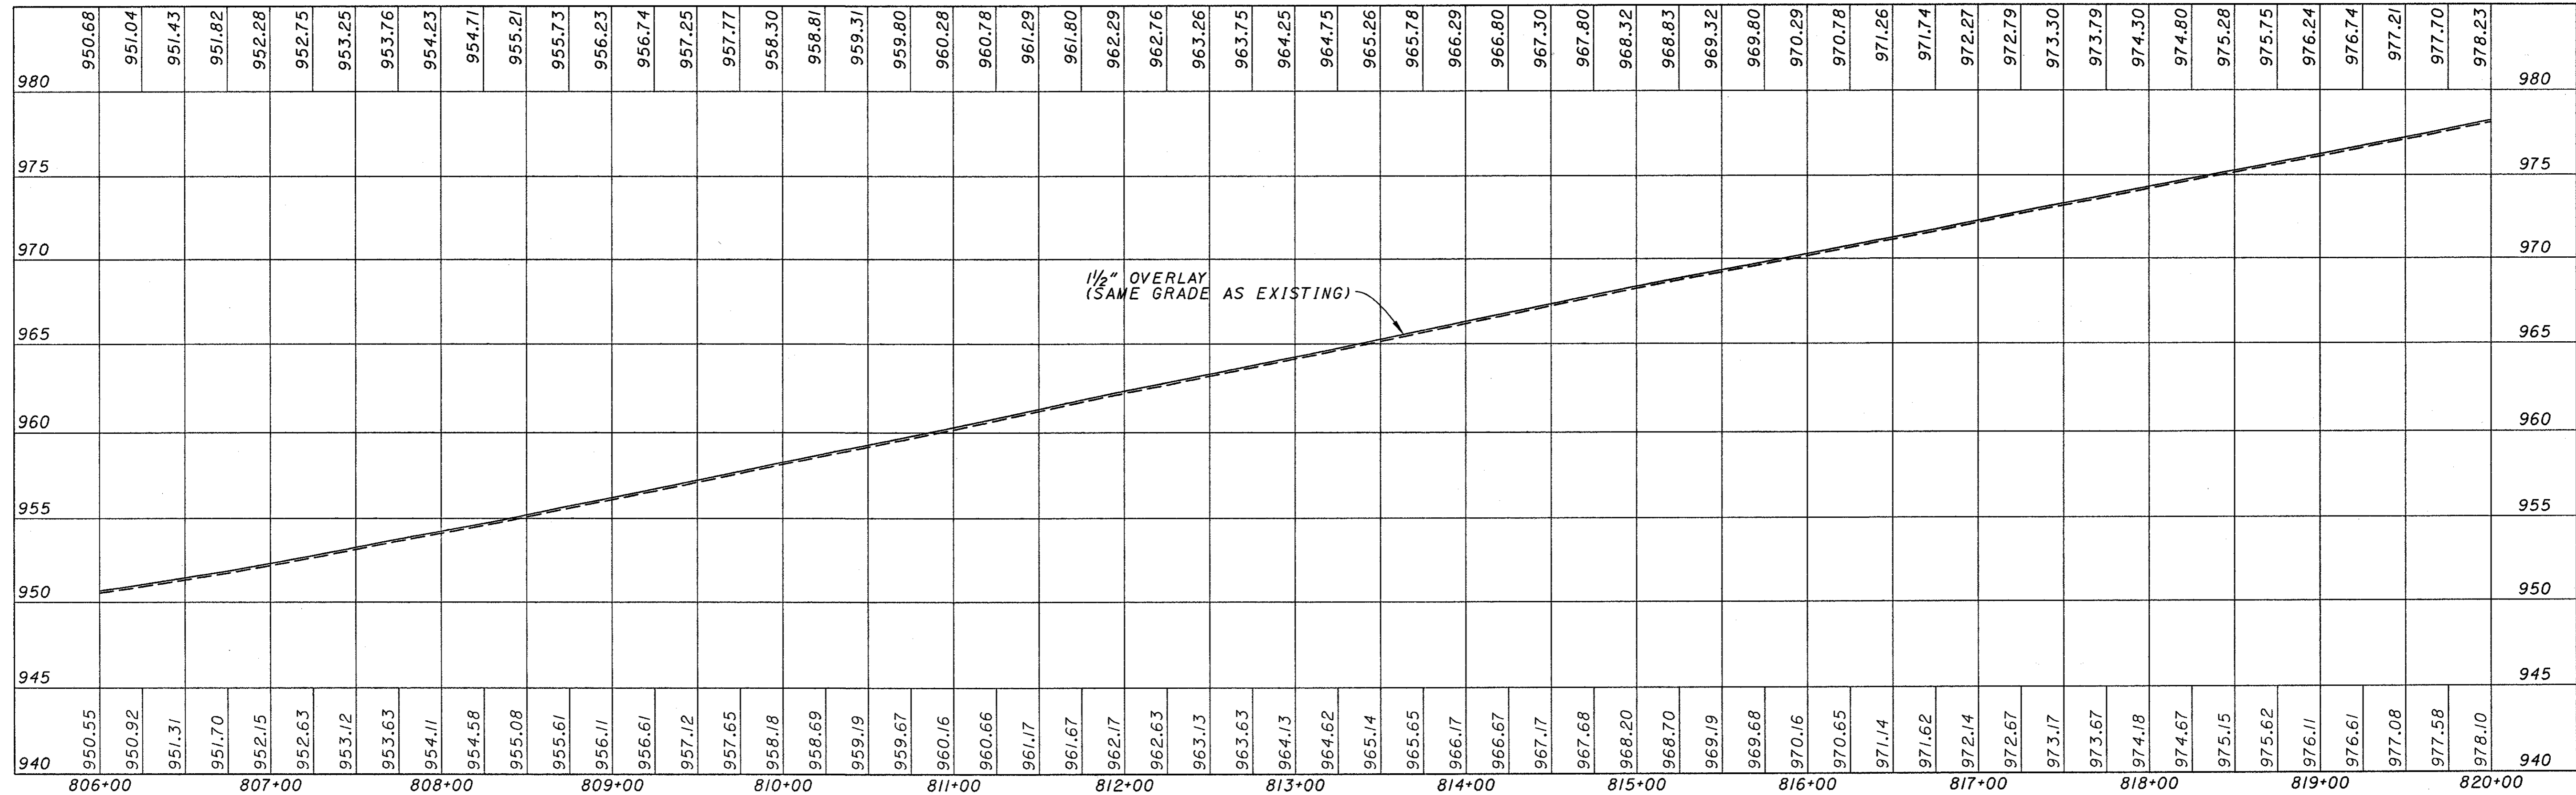

EAST BOUND PROFILE

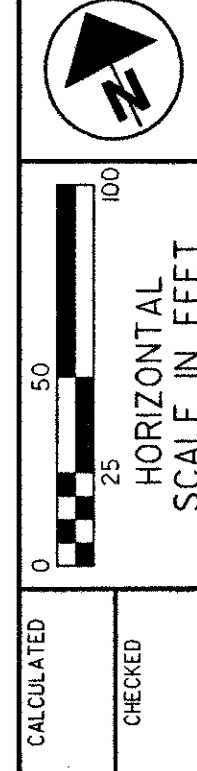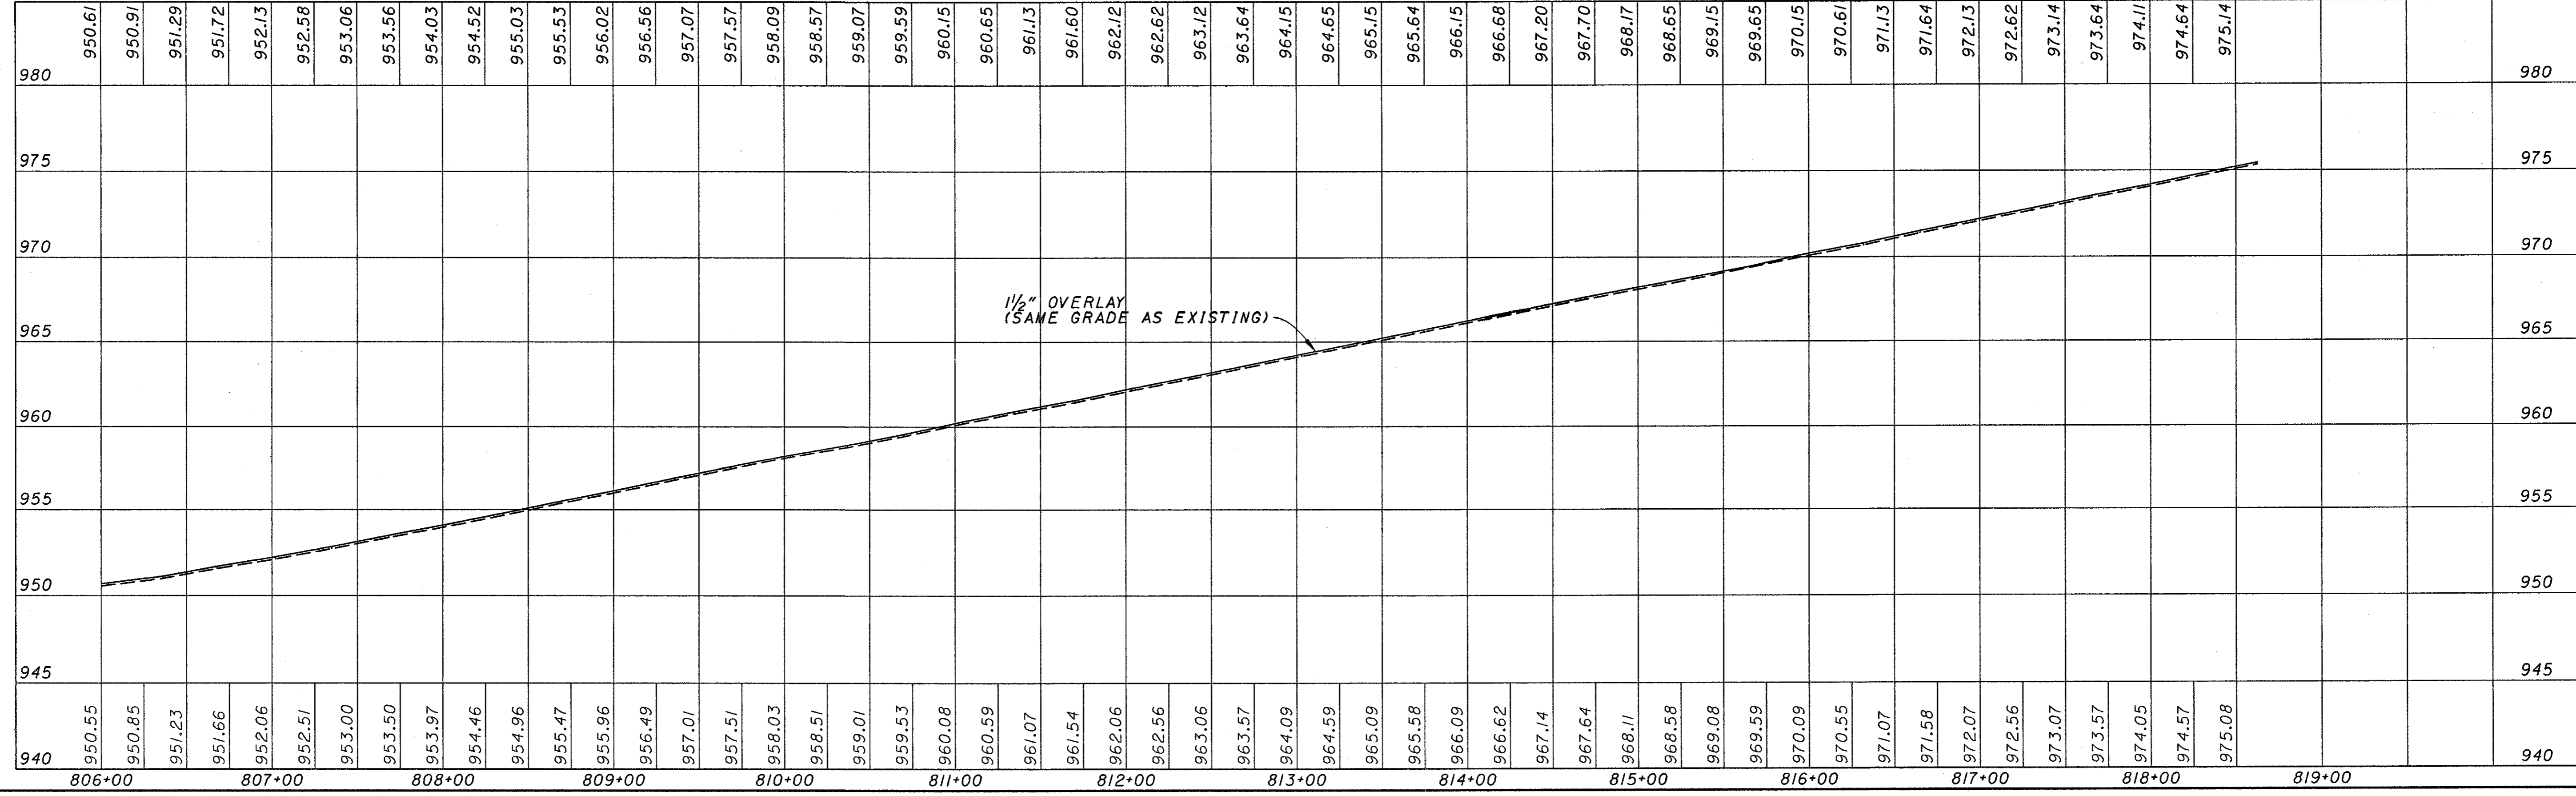


CALCULATED
CHECKED

PROFILE GRADES
STA 806+00 TO STA 820+00

PRE-70-0.00

86
283

REVISIONS
DATE: 11/11/11
BY: JMM
CHECKED: JMM
ACTIVE LEVELS ON: 86ELEV

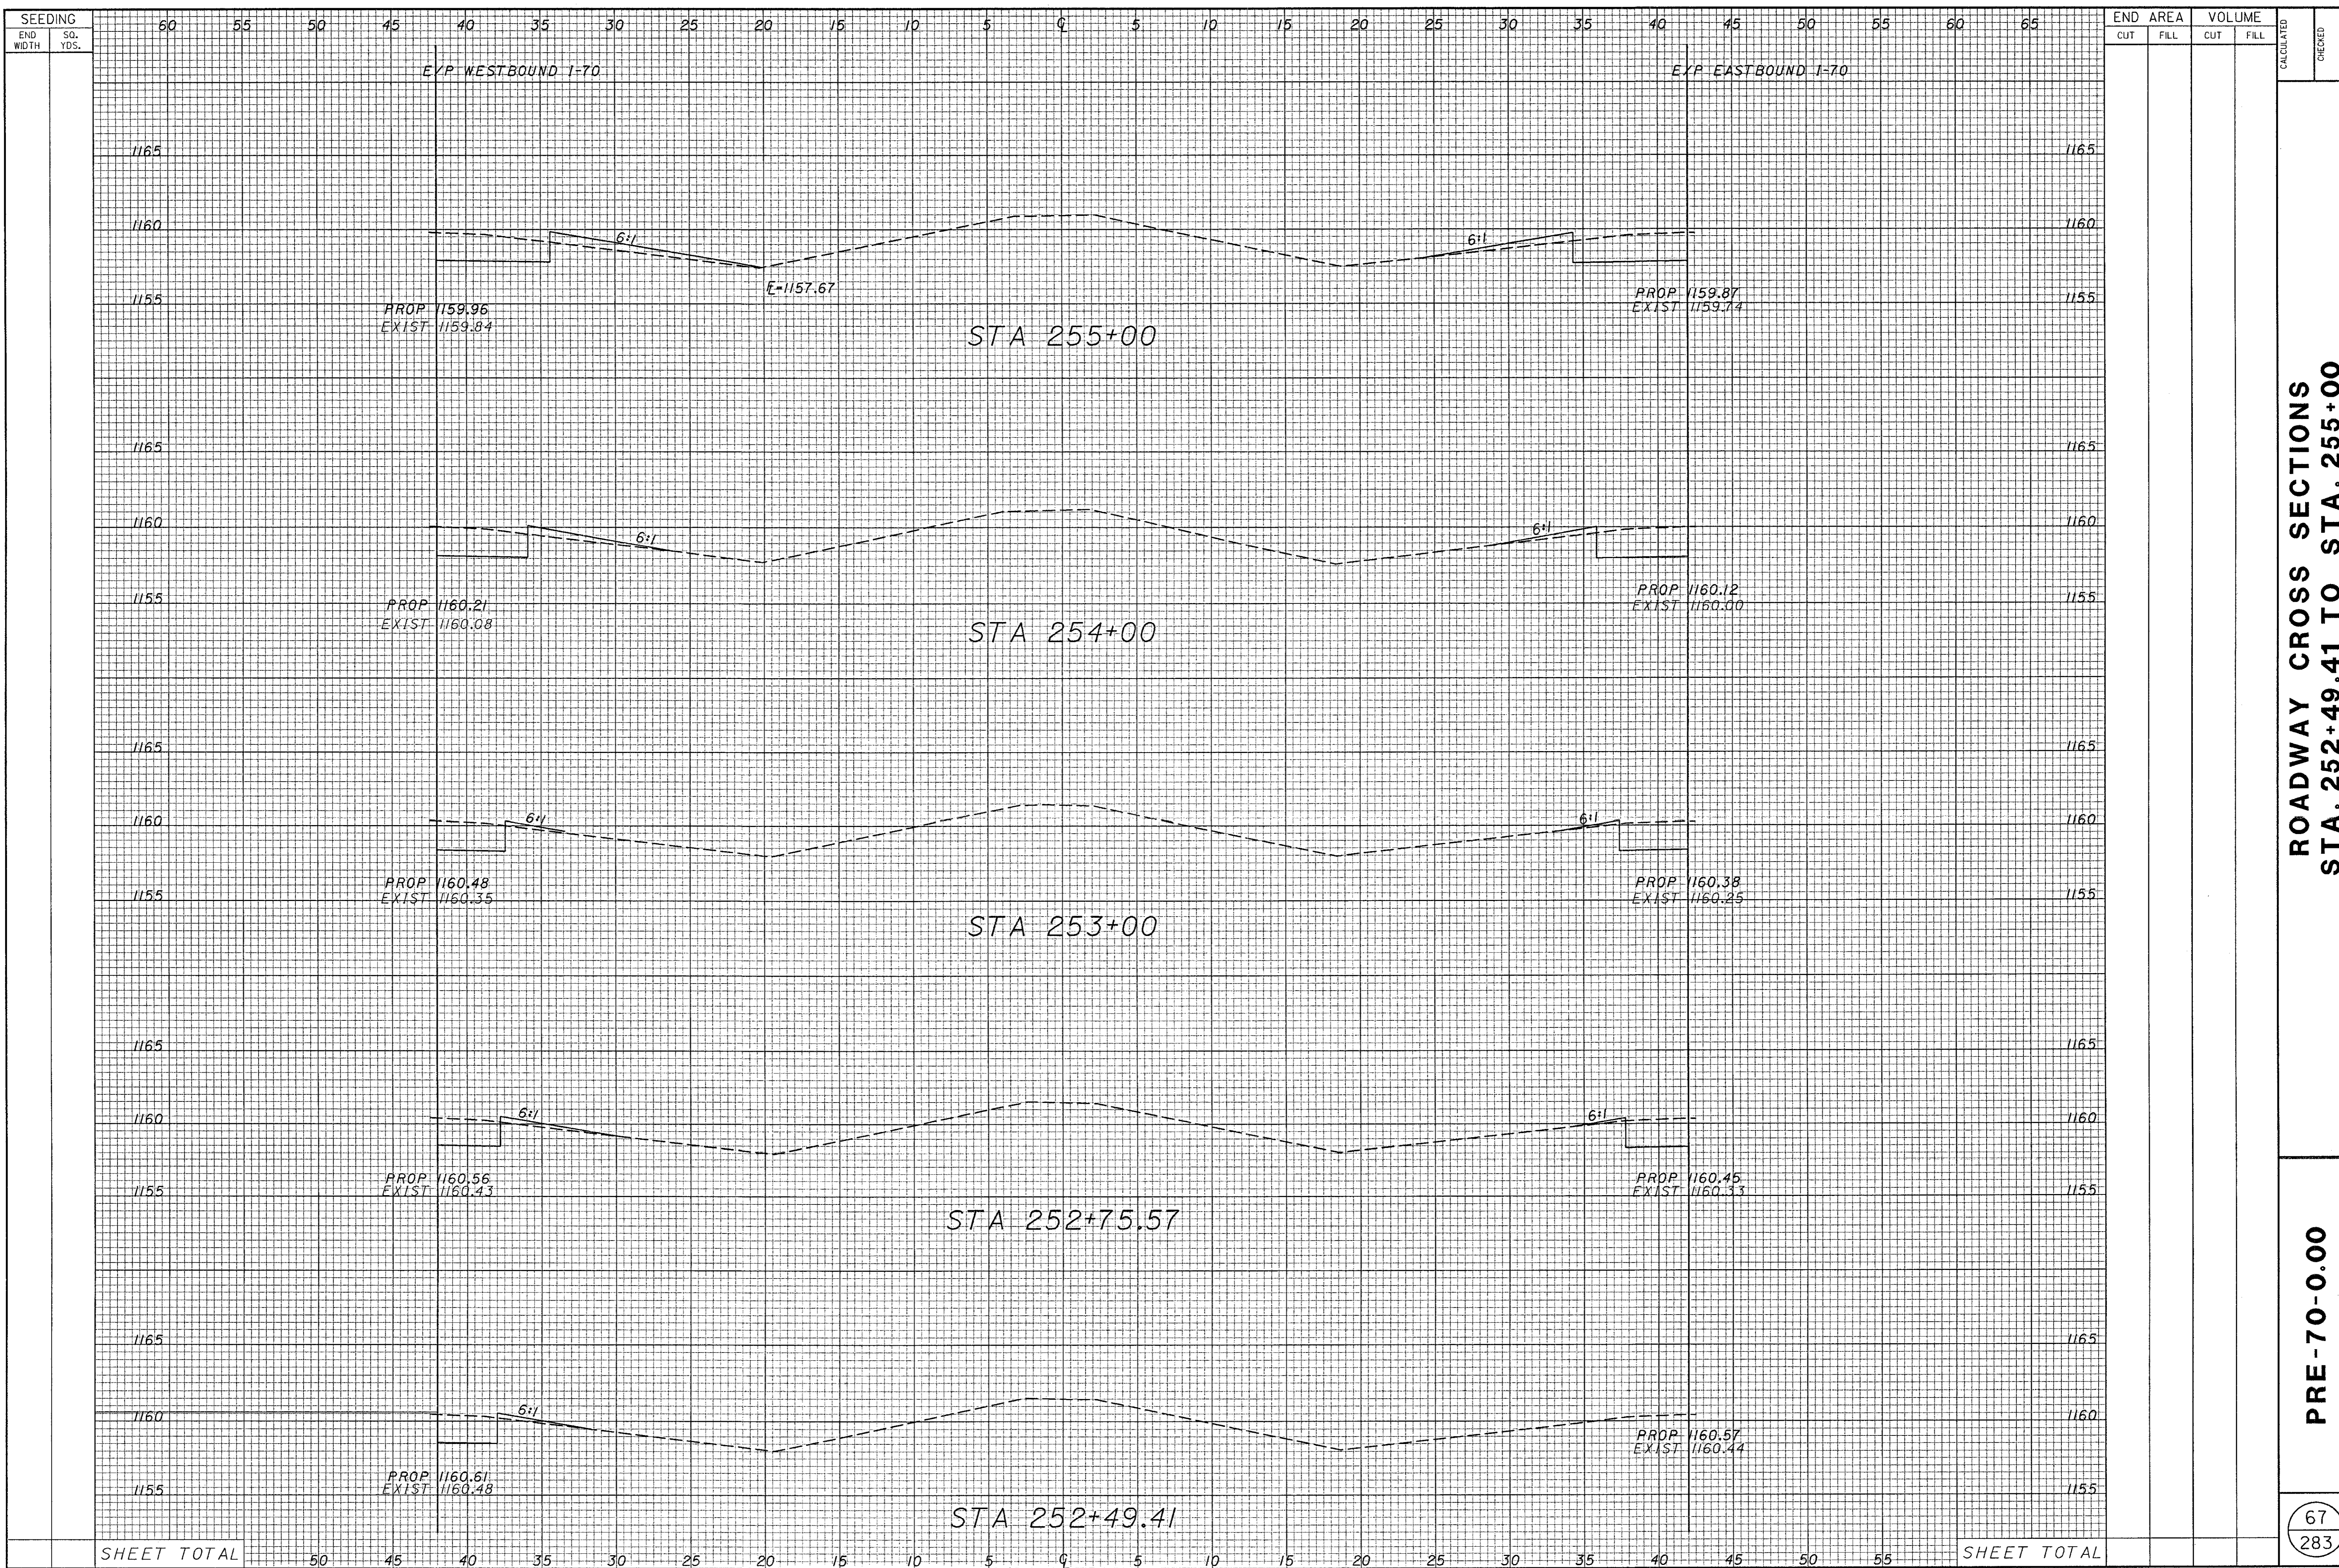

ROADWAY CROSS SECTIONS
STA. 252+49.41 TO STA. 255+00


PRE-70-0.00

SEEDING END WIDTH	sq. YDS.

END AREA		VOLUME	
CUT	FILL	CUT	FILL

SHEET TOTAL

SHEET TOTAL

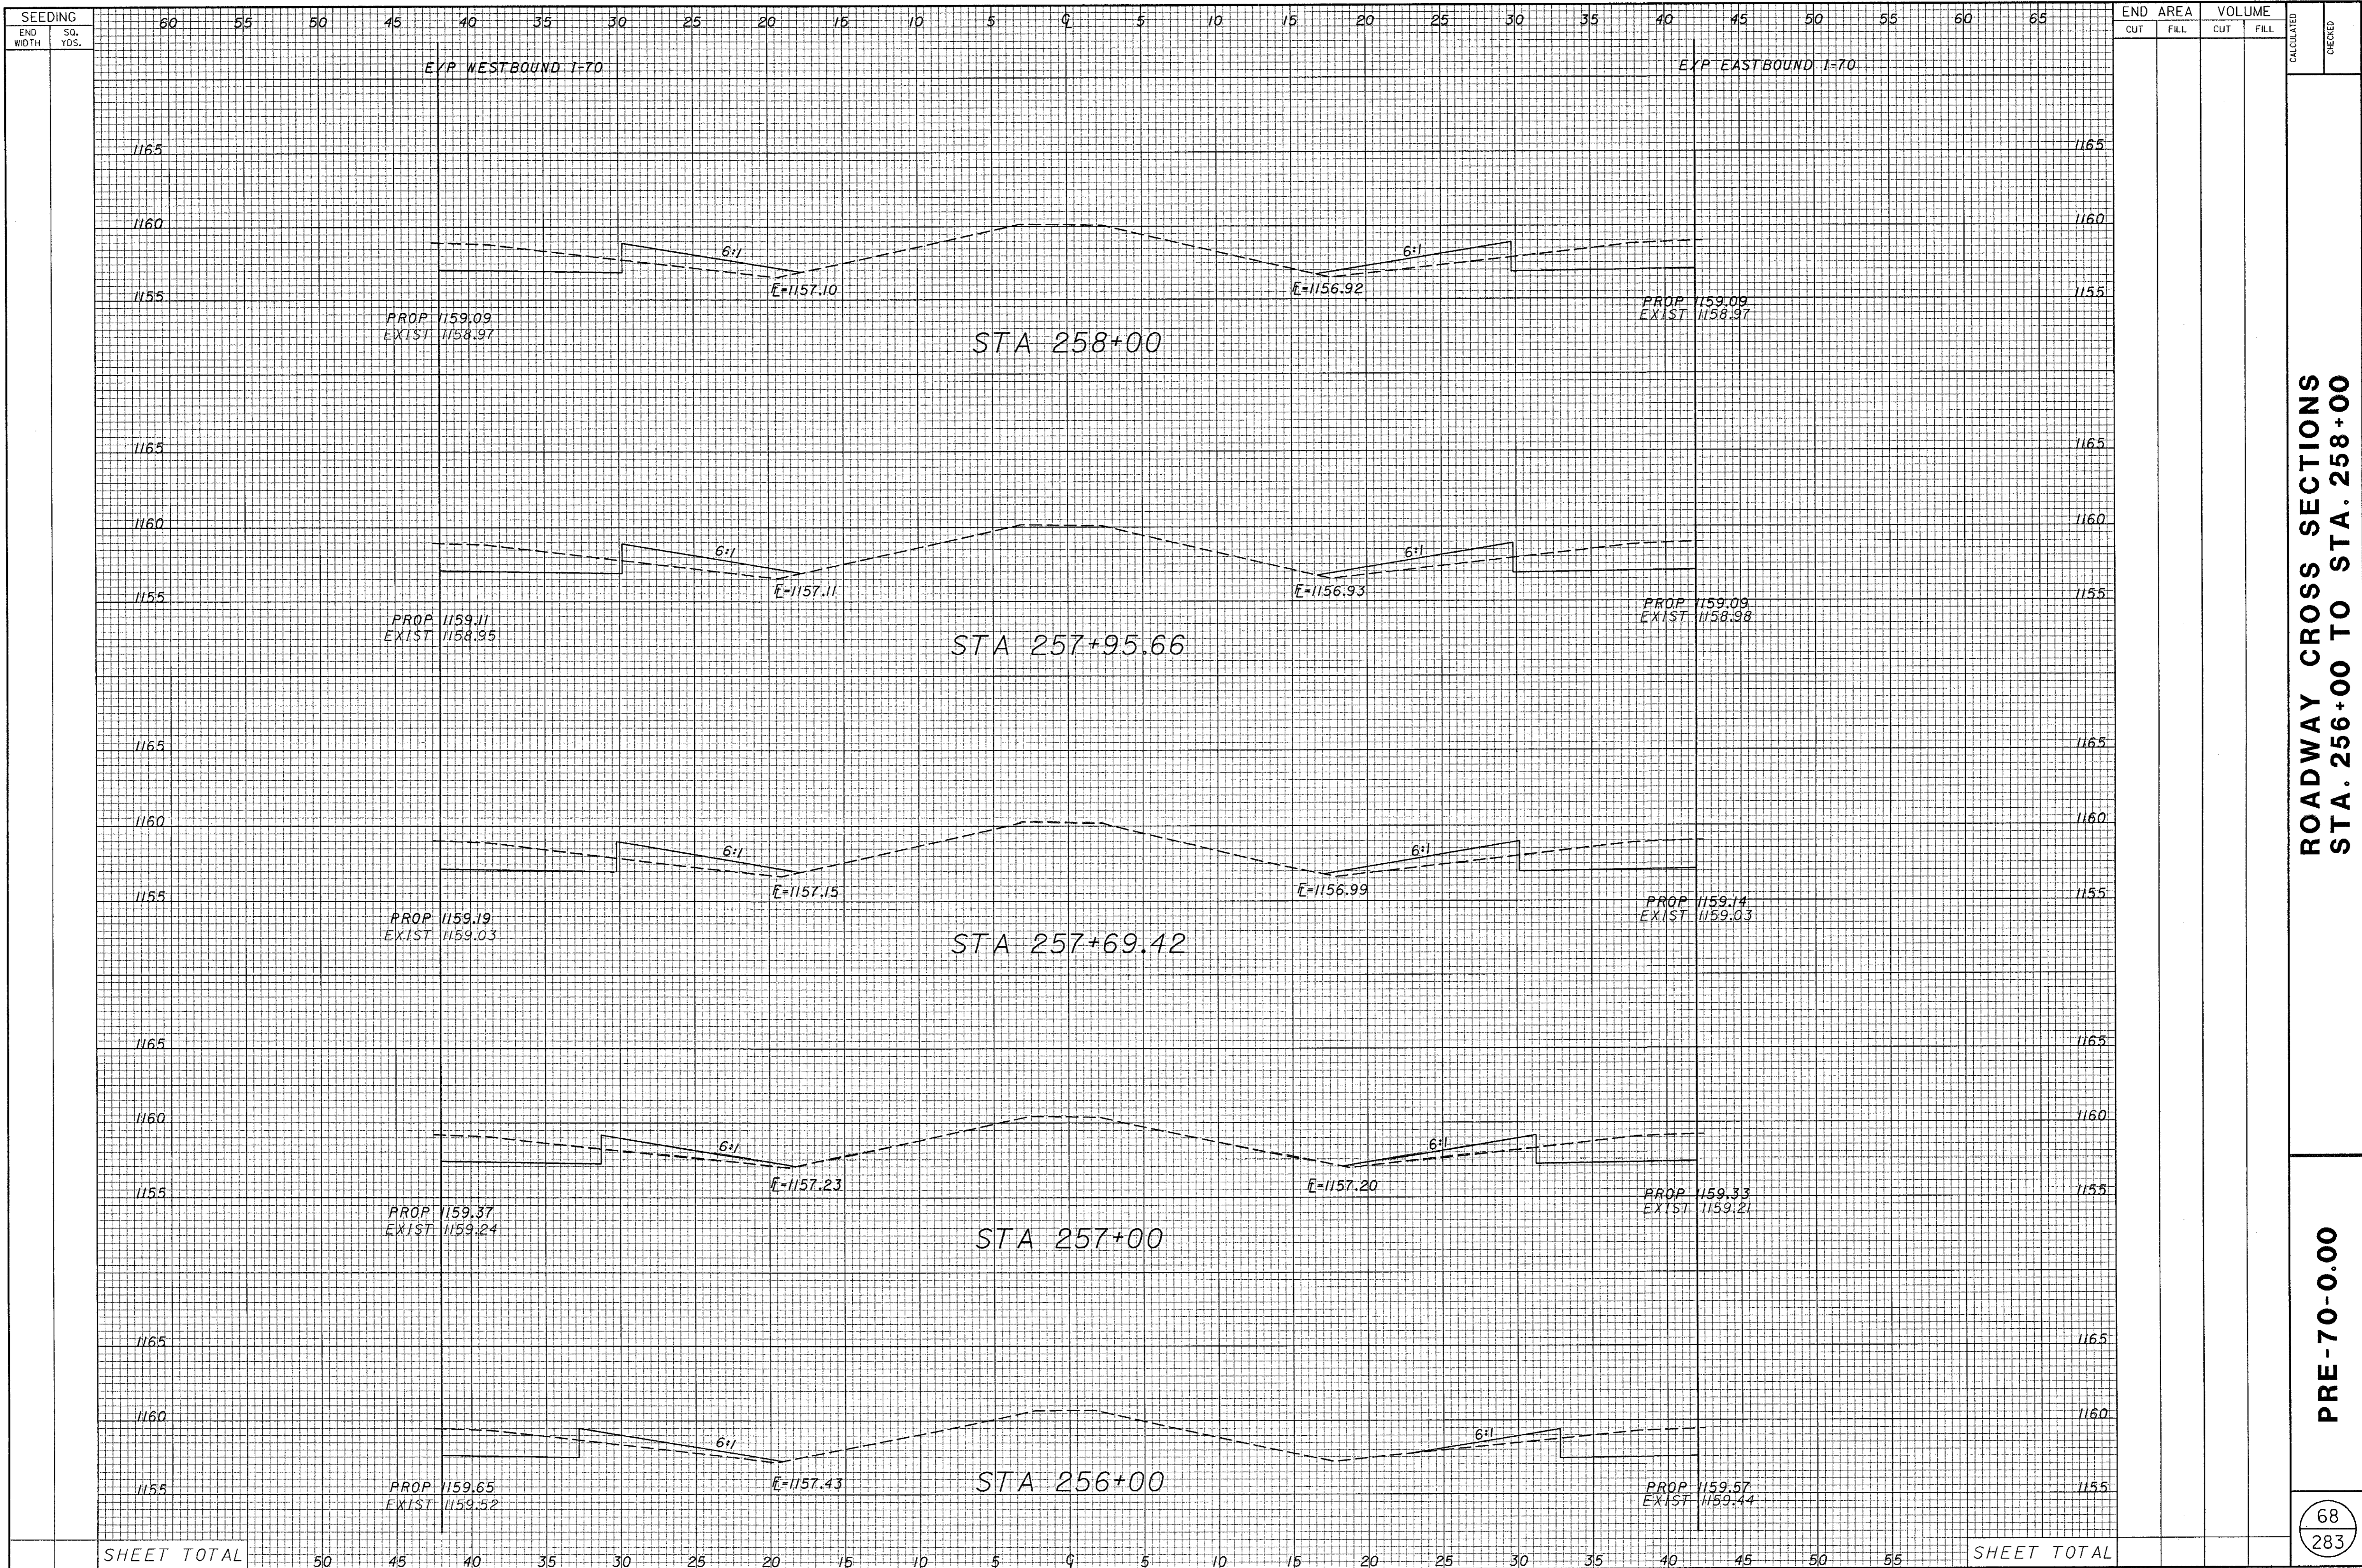


ROADWAY CROSS SECTIONS
STA. 256+00 TO STA. 258+00

PRE-70-0.00

68
283

SHEET TOTAL

SHEET TOTAL

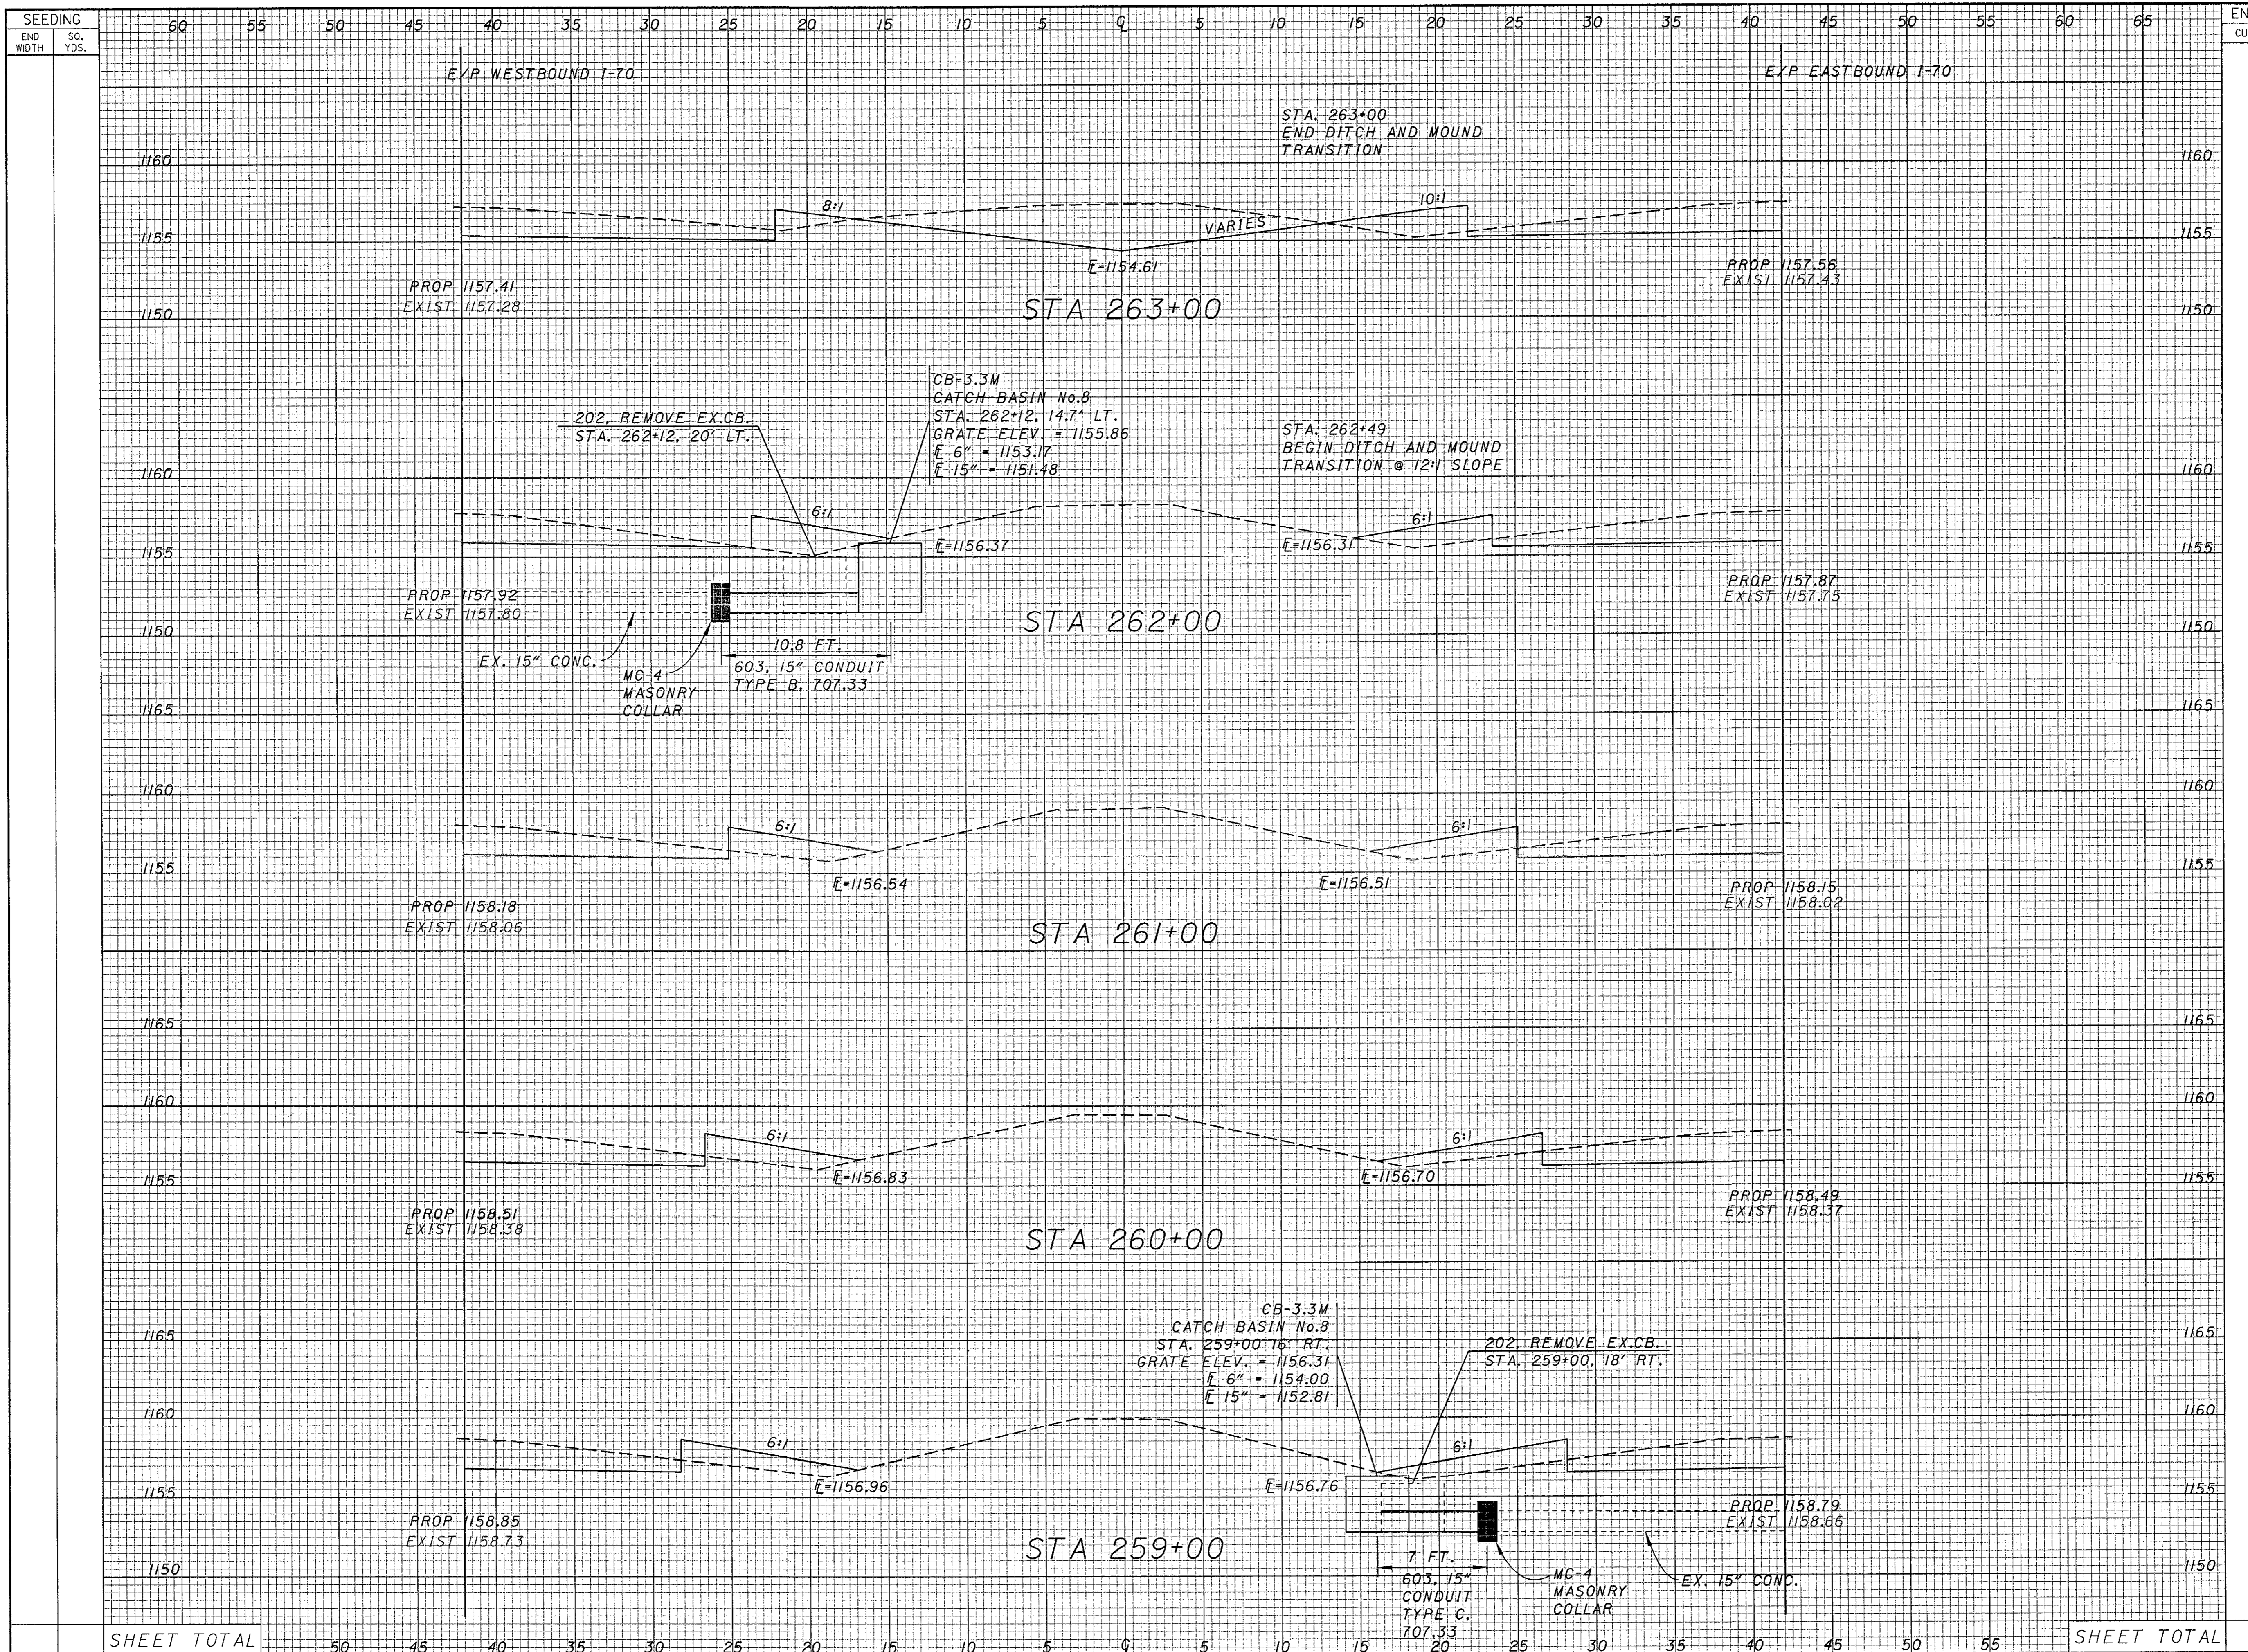


SEEDING														END AREA		VOLUME		CALCULATED	CHECKED												
END WIDTH	SO. YDS.	60	55	50	45	40	35	30	25	20	15	10	5	0	5	10	15			20	25	30	35	40	45	50	55	60	65	CUT	FILL


ROADWAY CROSS SECTIONS
STA. 259+00 TO STA. 263+00

PRE-70-0.00

SHEET TOTAL

SHEET TOTAL

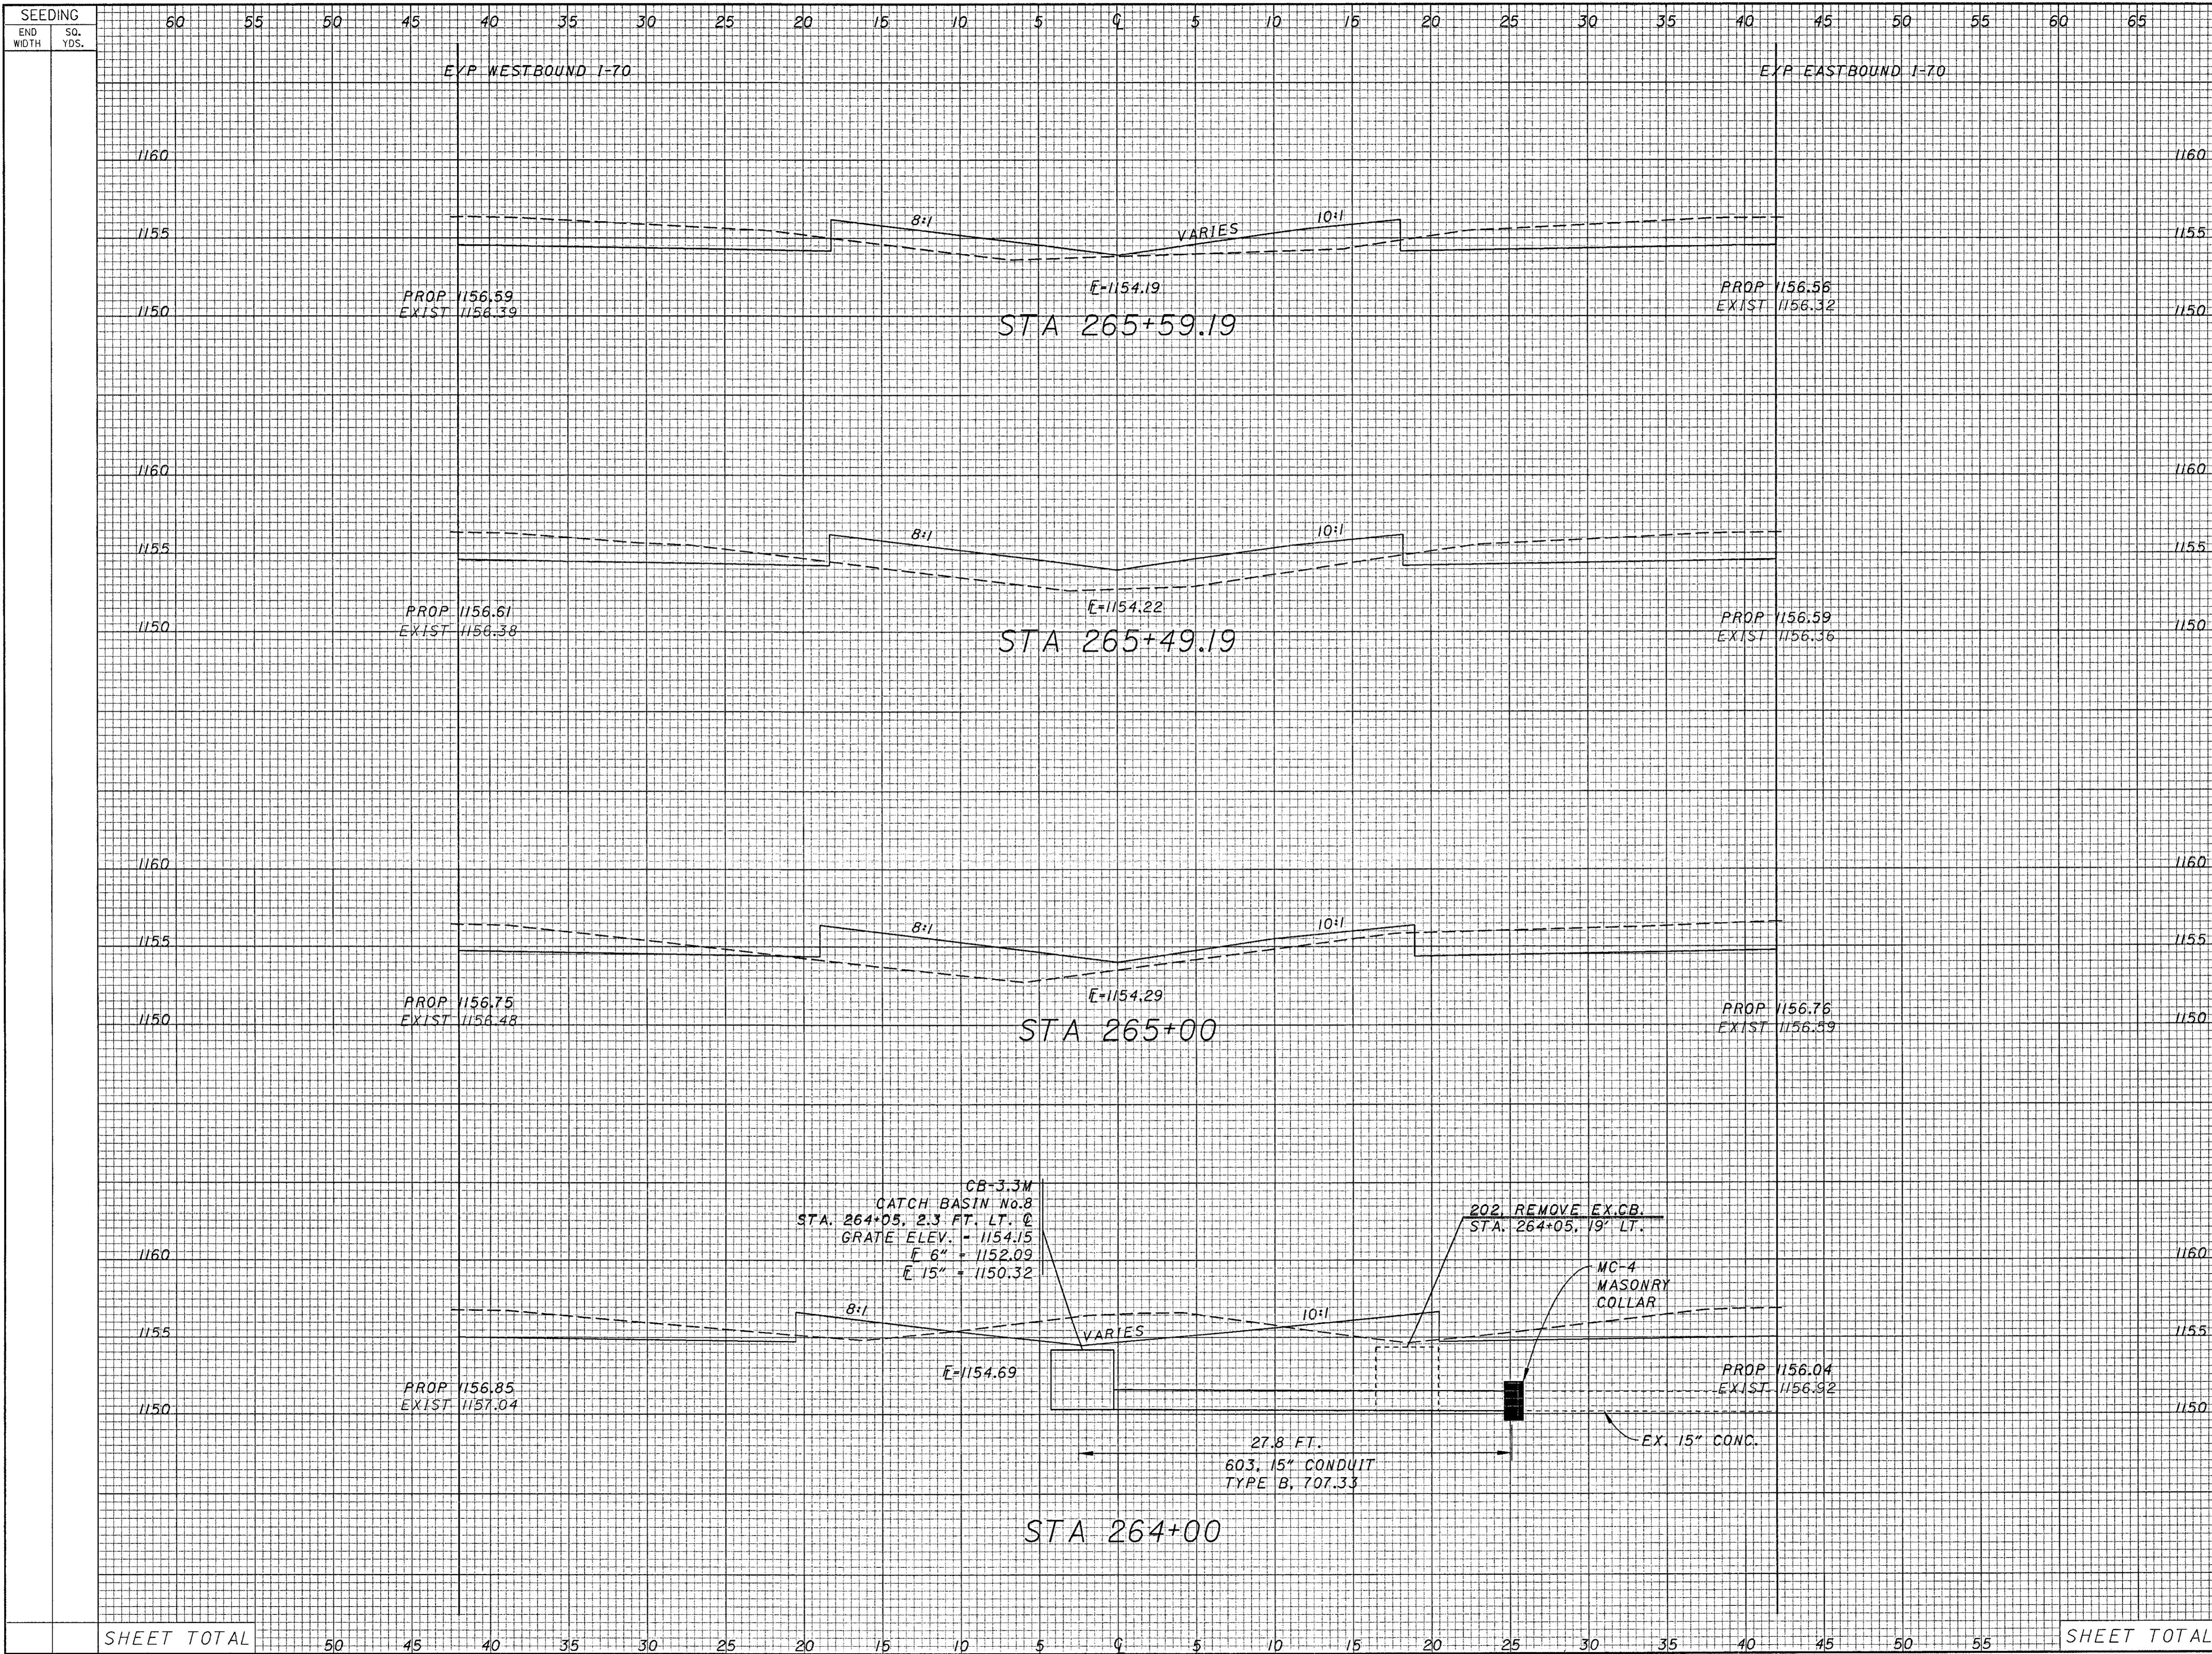

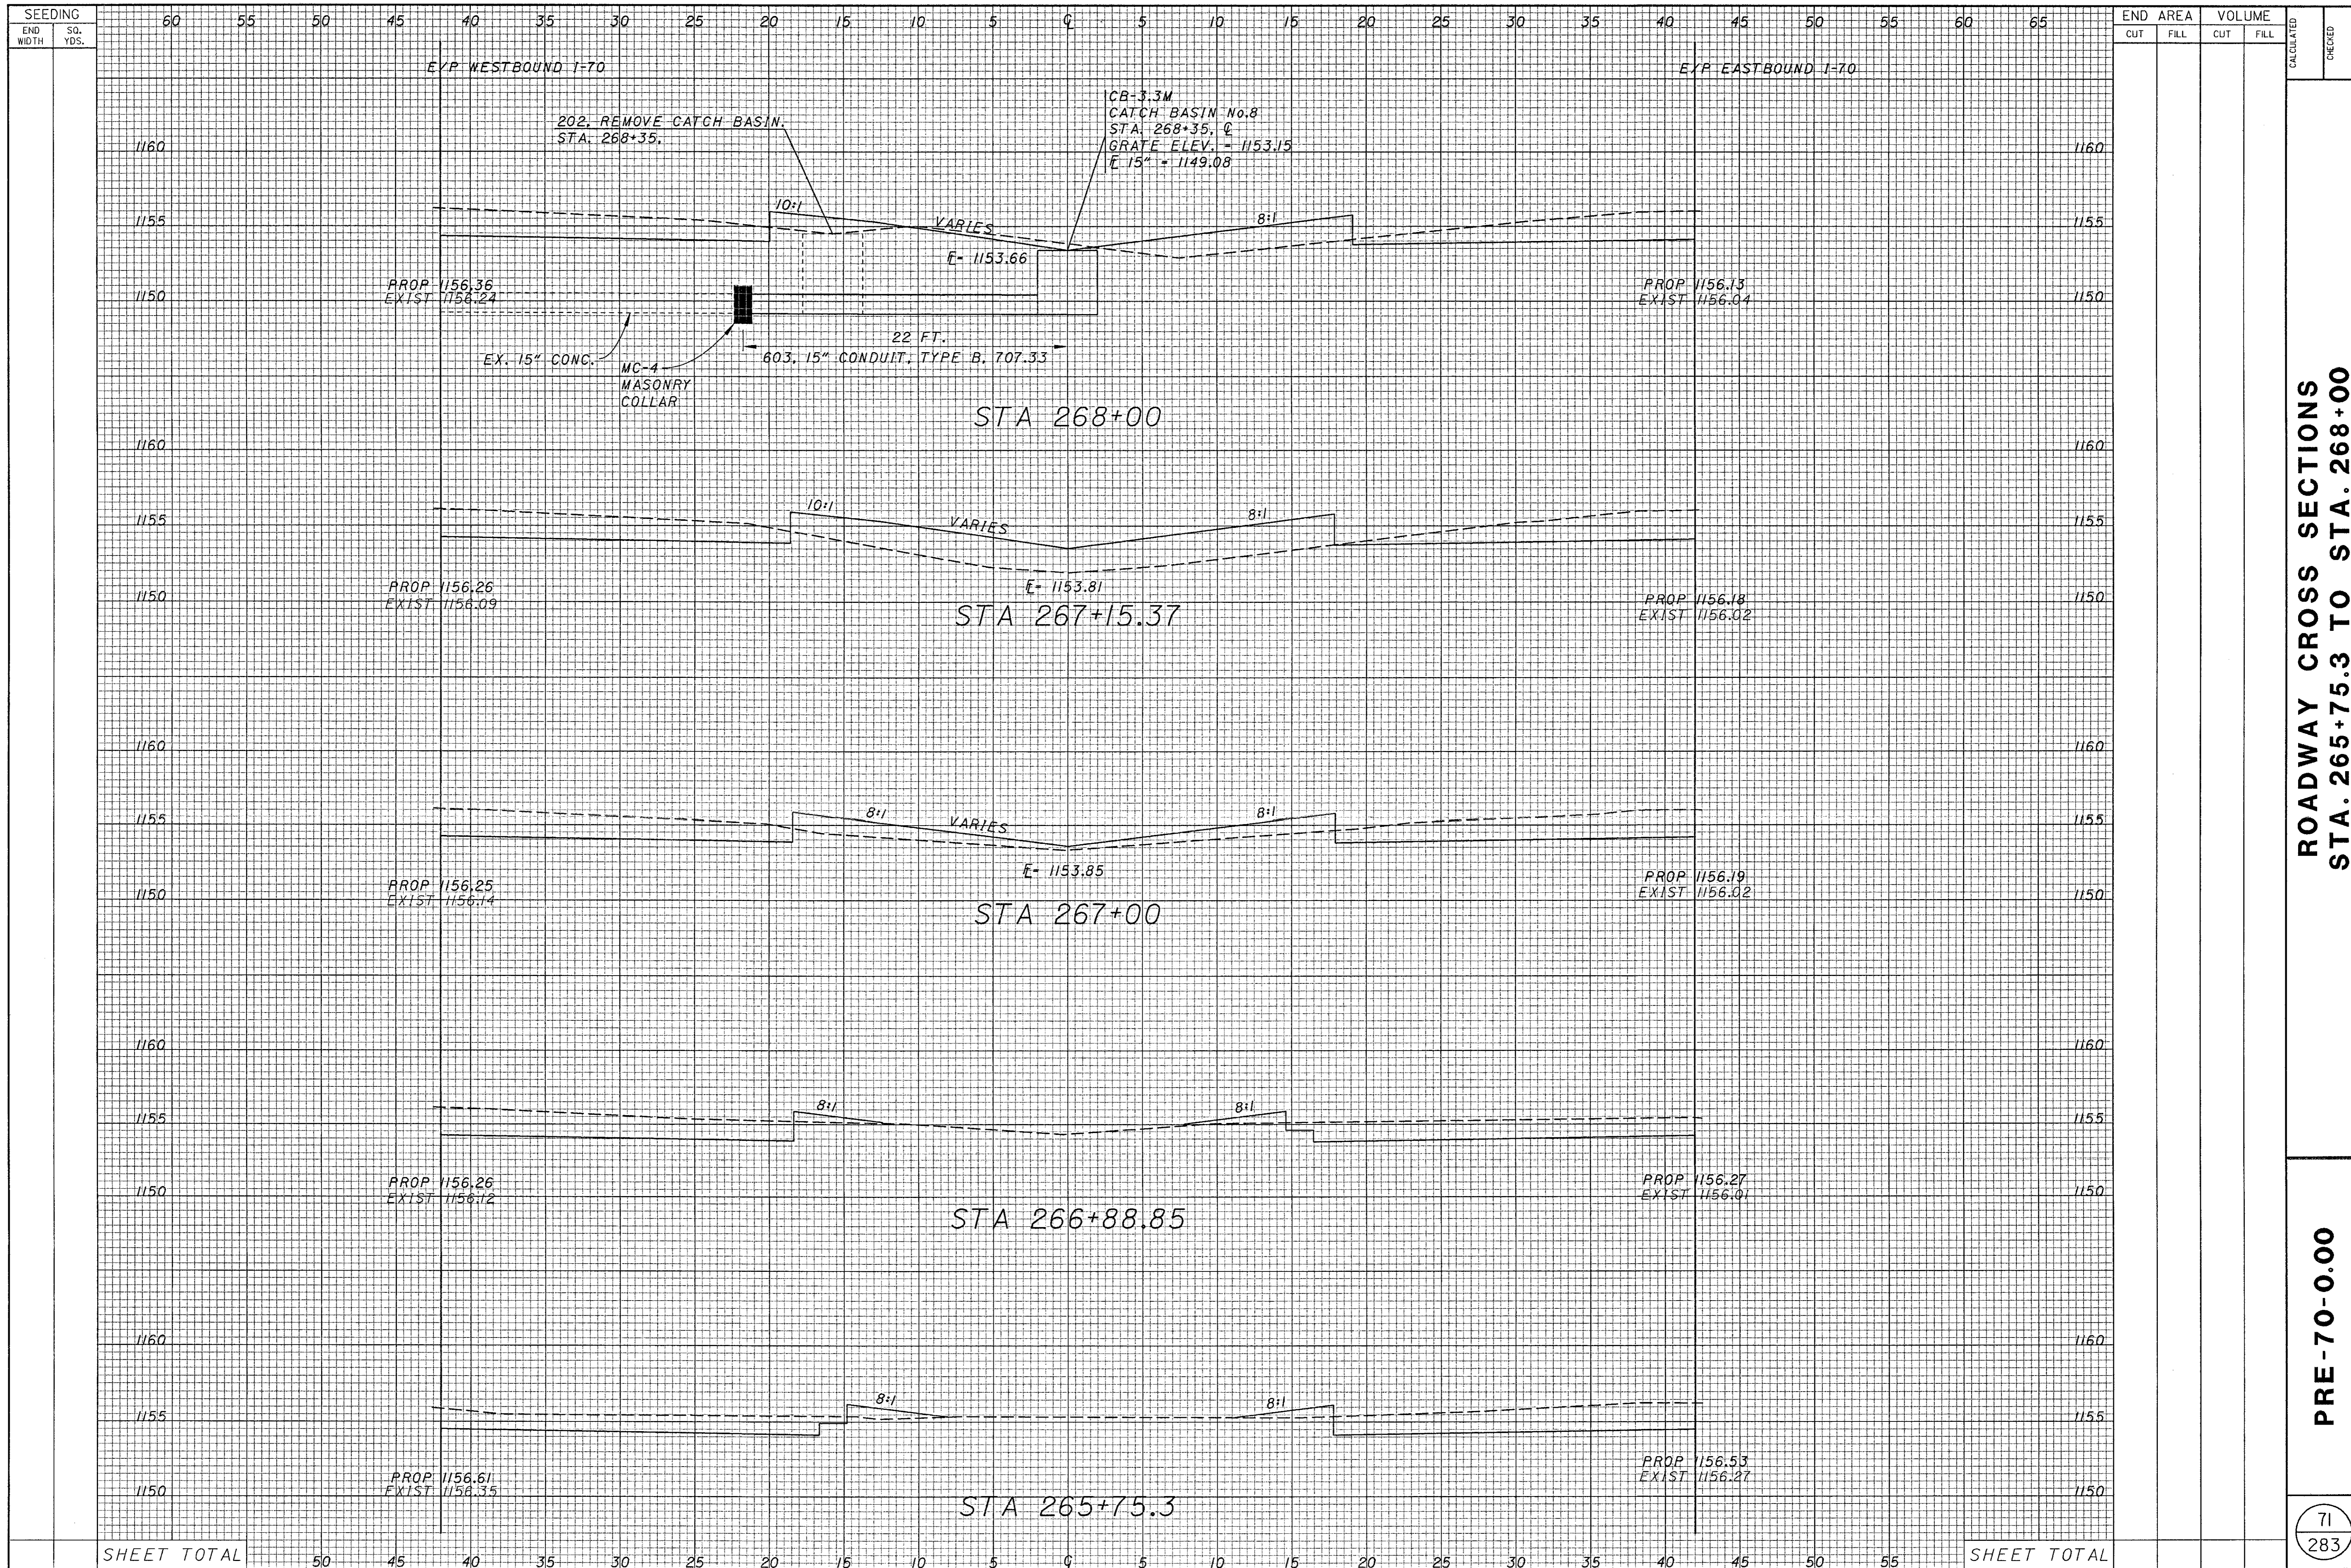


ROADWAY CROSS SECTIONS
STA. 265+75.3 TO STA. 268+00

PRE-70-0.00

SEEDING
END WIDTH SQ. YDS.

END AREA VOLUME
CUT FILL CUT FILL

CALCULATED
CHECKED

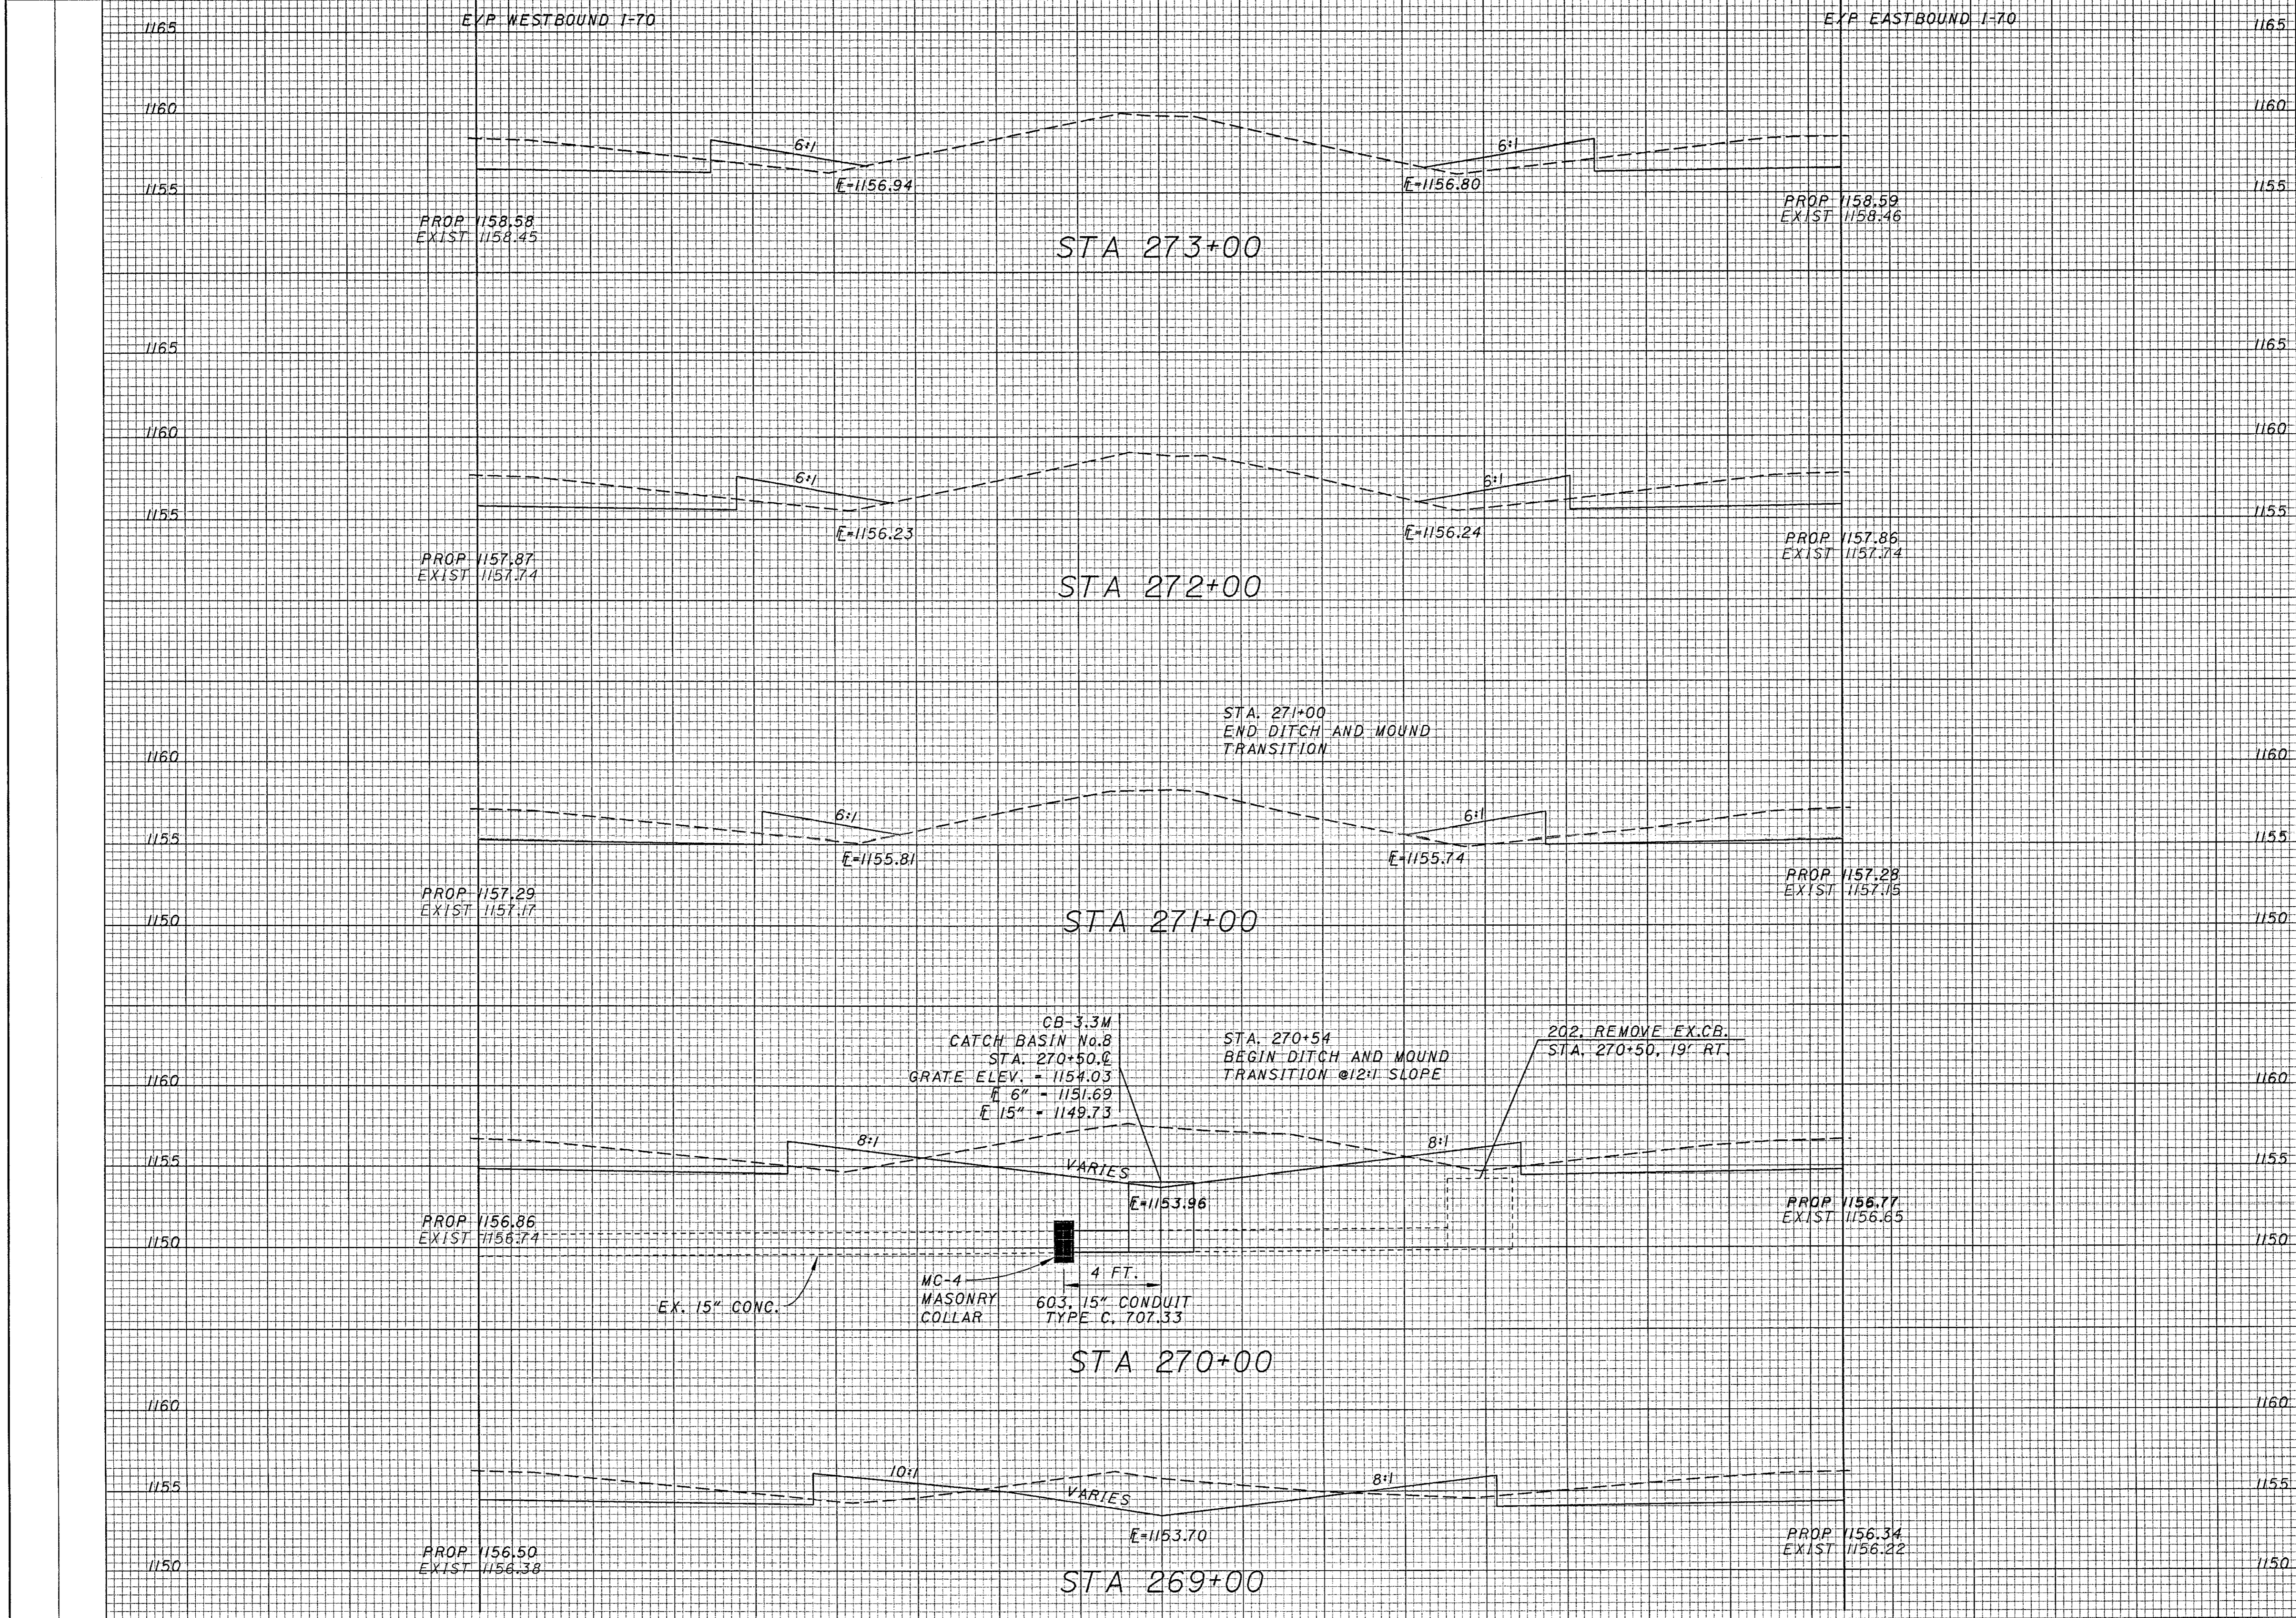

ROADWAY CROSS SECTIONS
STA. 269+00 TO STA. 273+00

PRE-70-0.00

72
283

SHEET TOTAL

SHEET TOTAL

SEEDING
END WIDTH SQ. YDS.


END AREA VOLUME
CUT FILL CUT FILL

CALCULATED
CHECKED

60 55 50 45 40 35 30 25 20 15 10 5 0 5 10 15 20 25 30 35 40 45 50 55 60 65

E/P WESTBOUND I-70

E/P EASTBOUND I-70

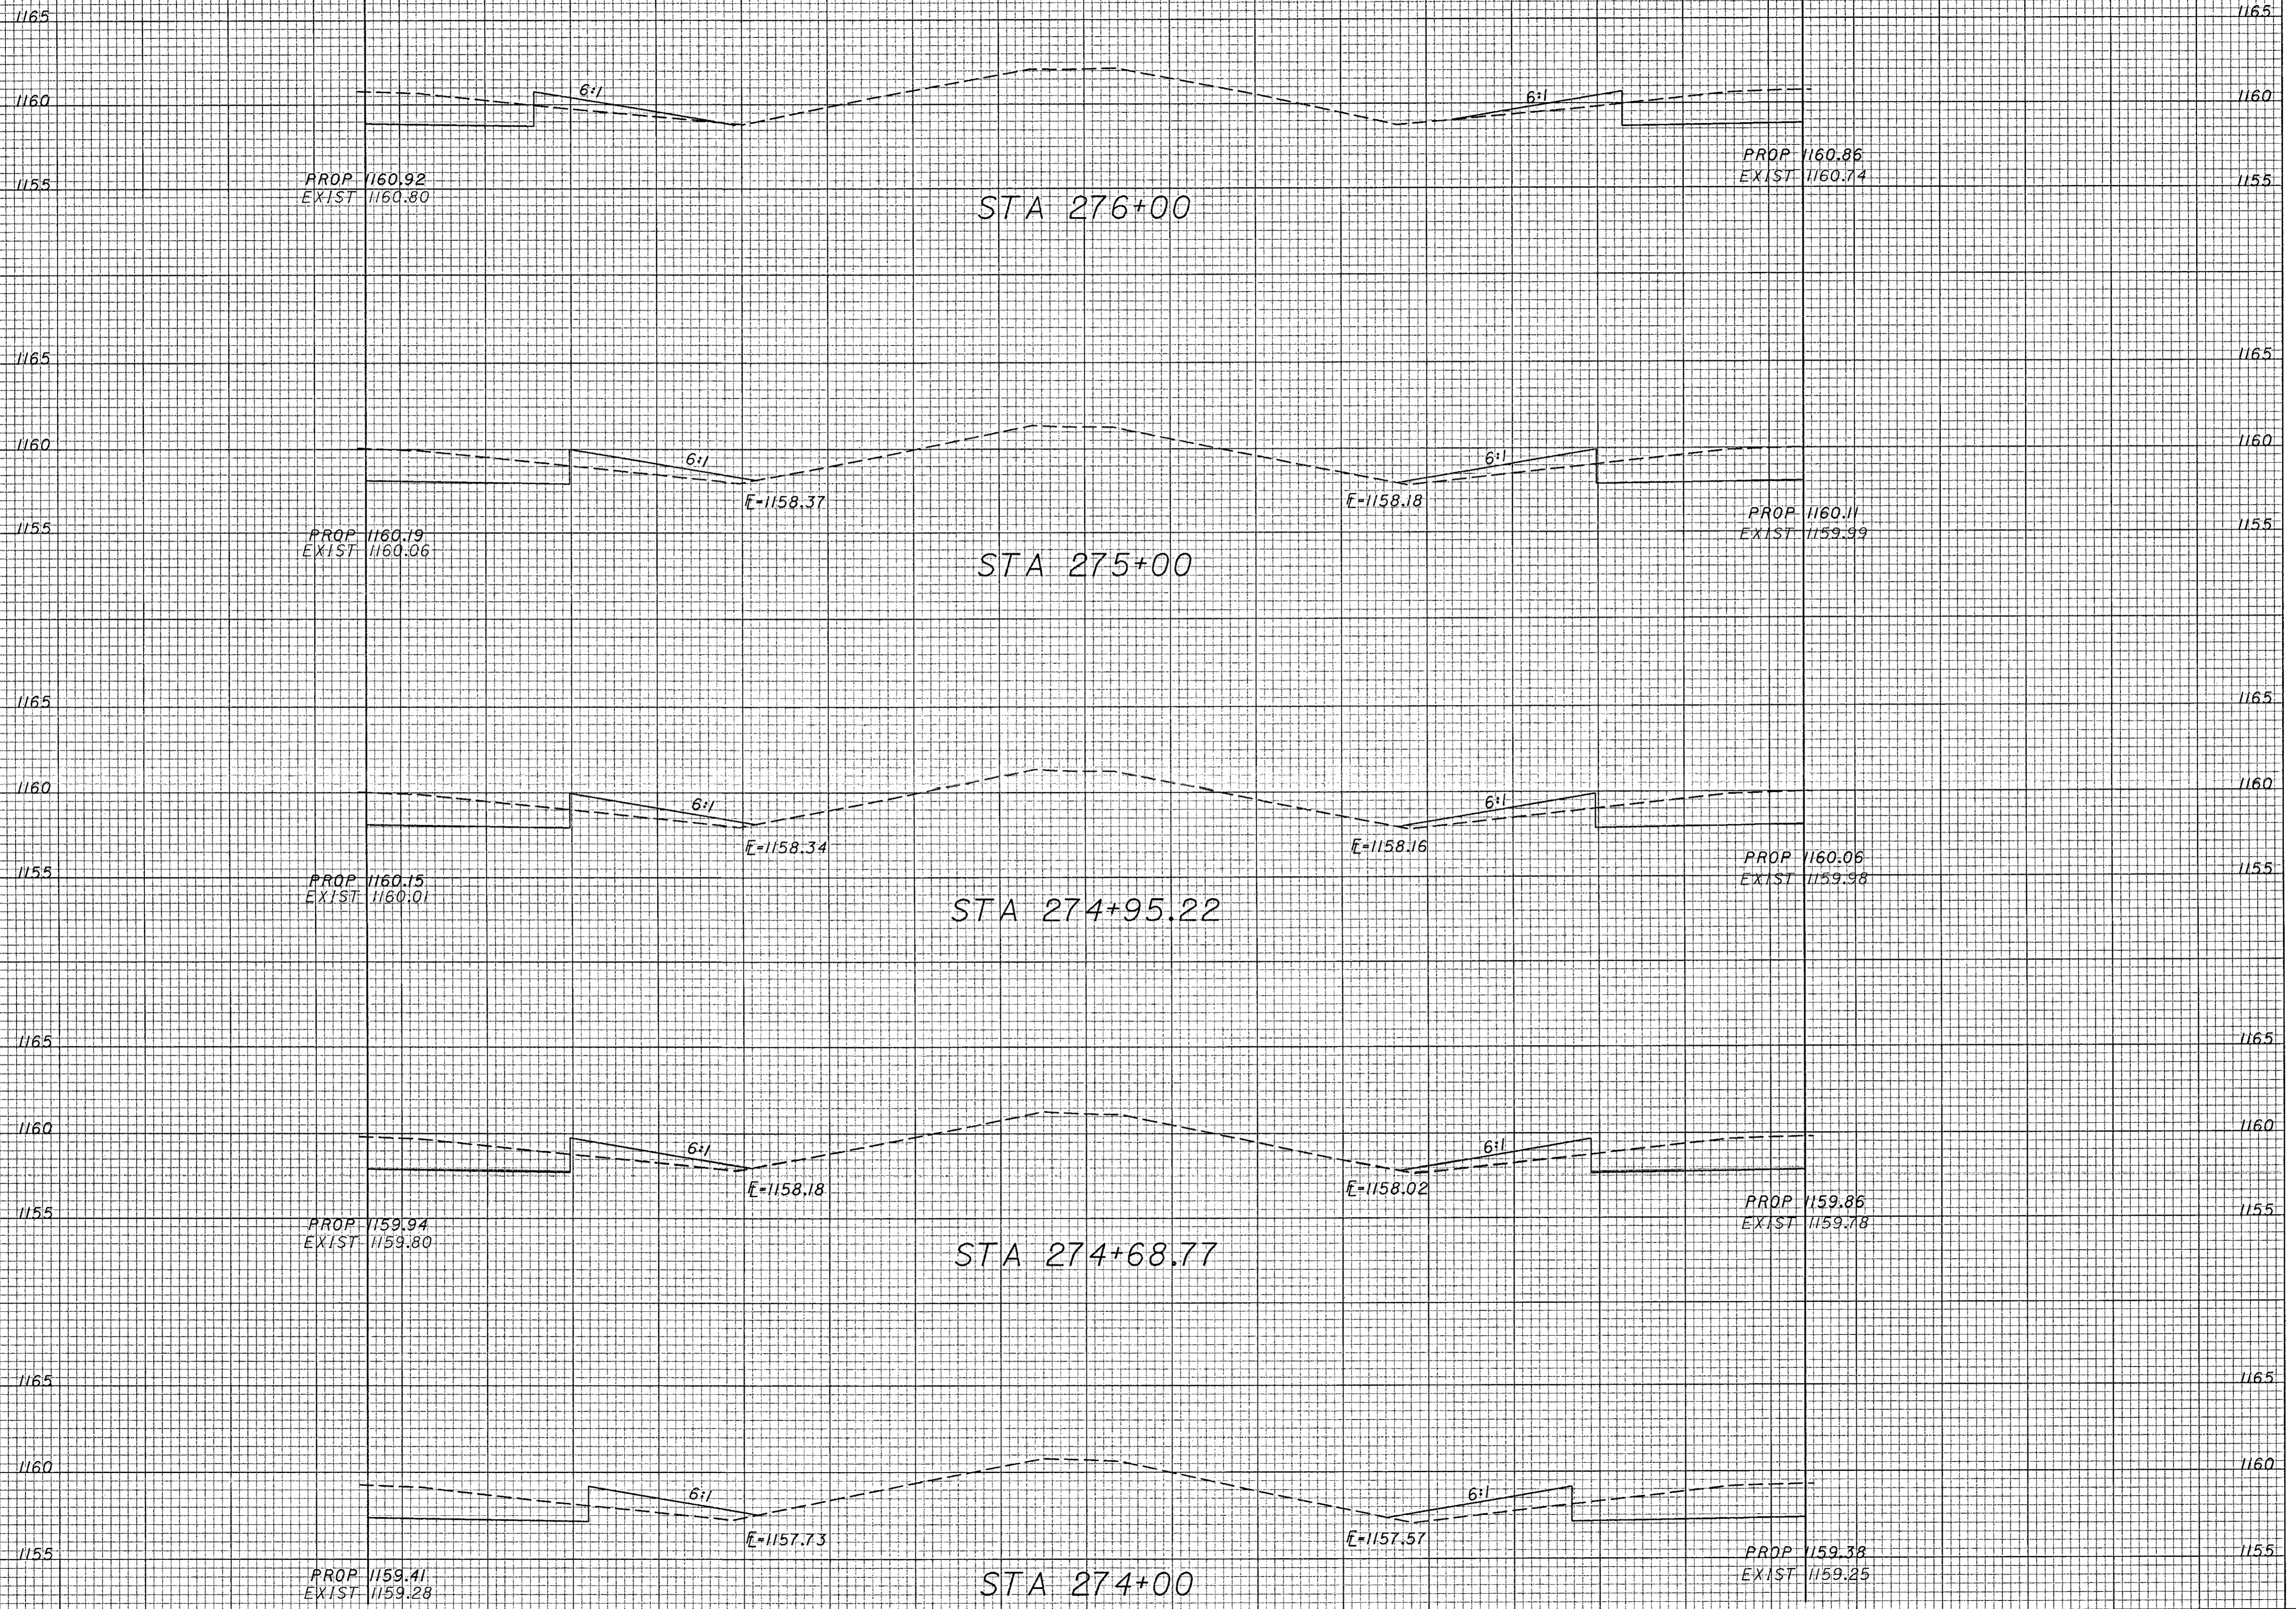

SHEET TOTAL

SHEET TOTAL

ROADWAY CROSS SECTIONS
STA. 274+00 TO STA. 276+00


PRE-70-0.00

73
283

SEEDING
END WIDTH SQ. YDS.

END AREA VOLUME
CUT FILL CUT FILL

CALCULATED
CHECKED

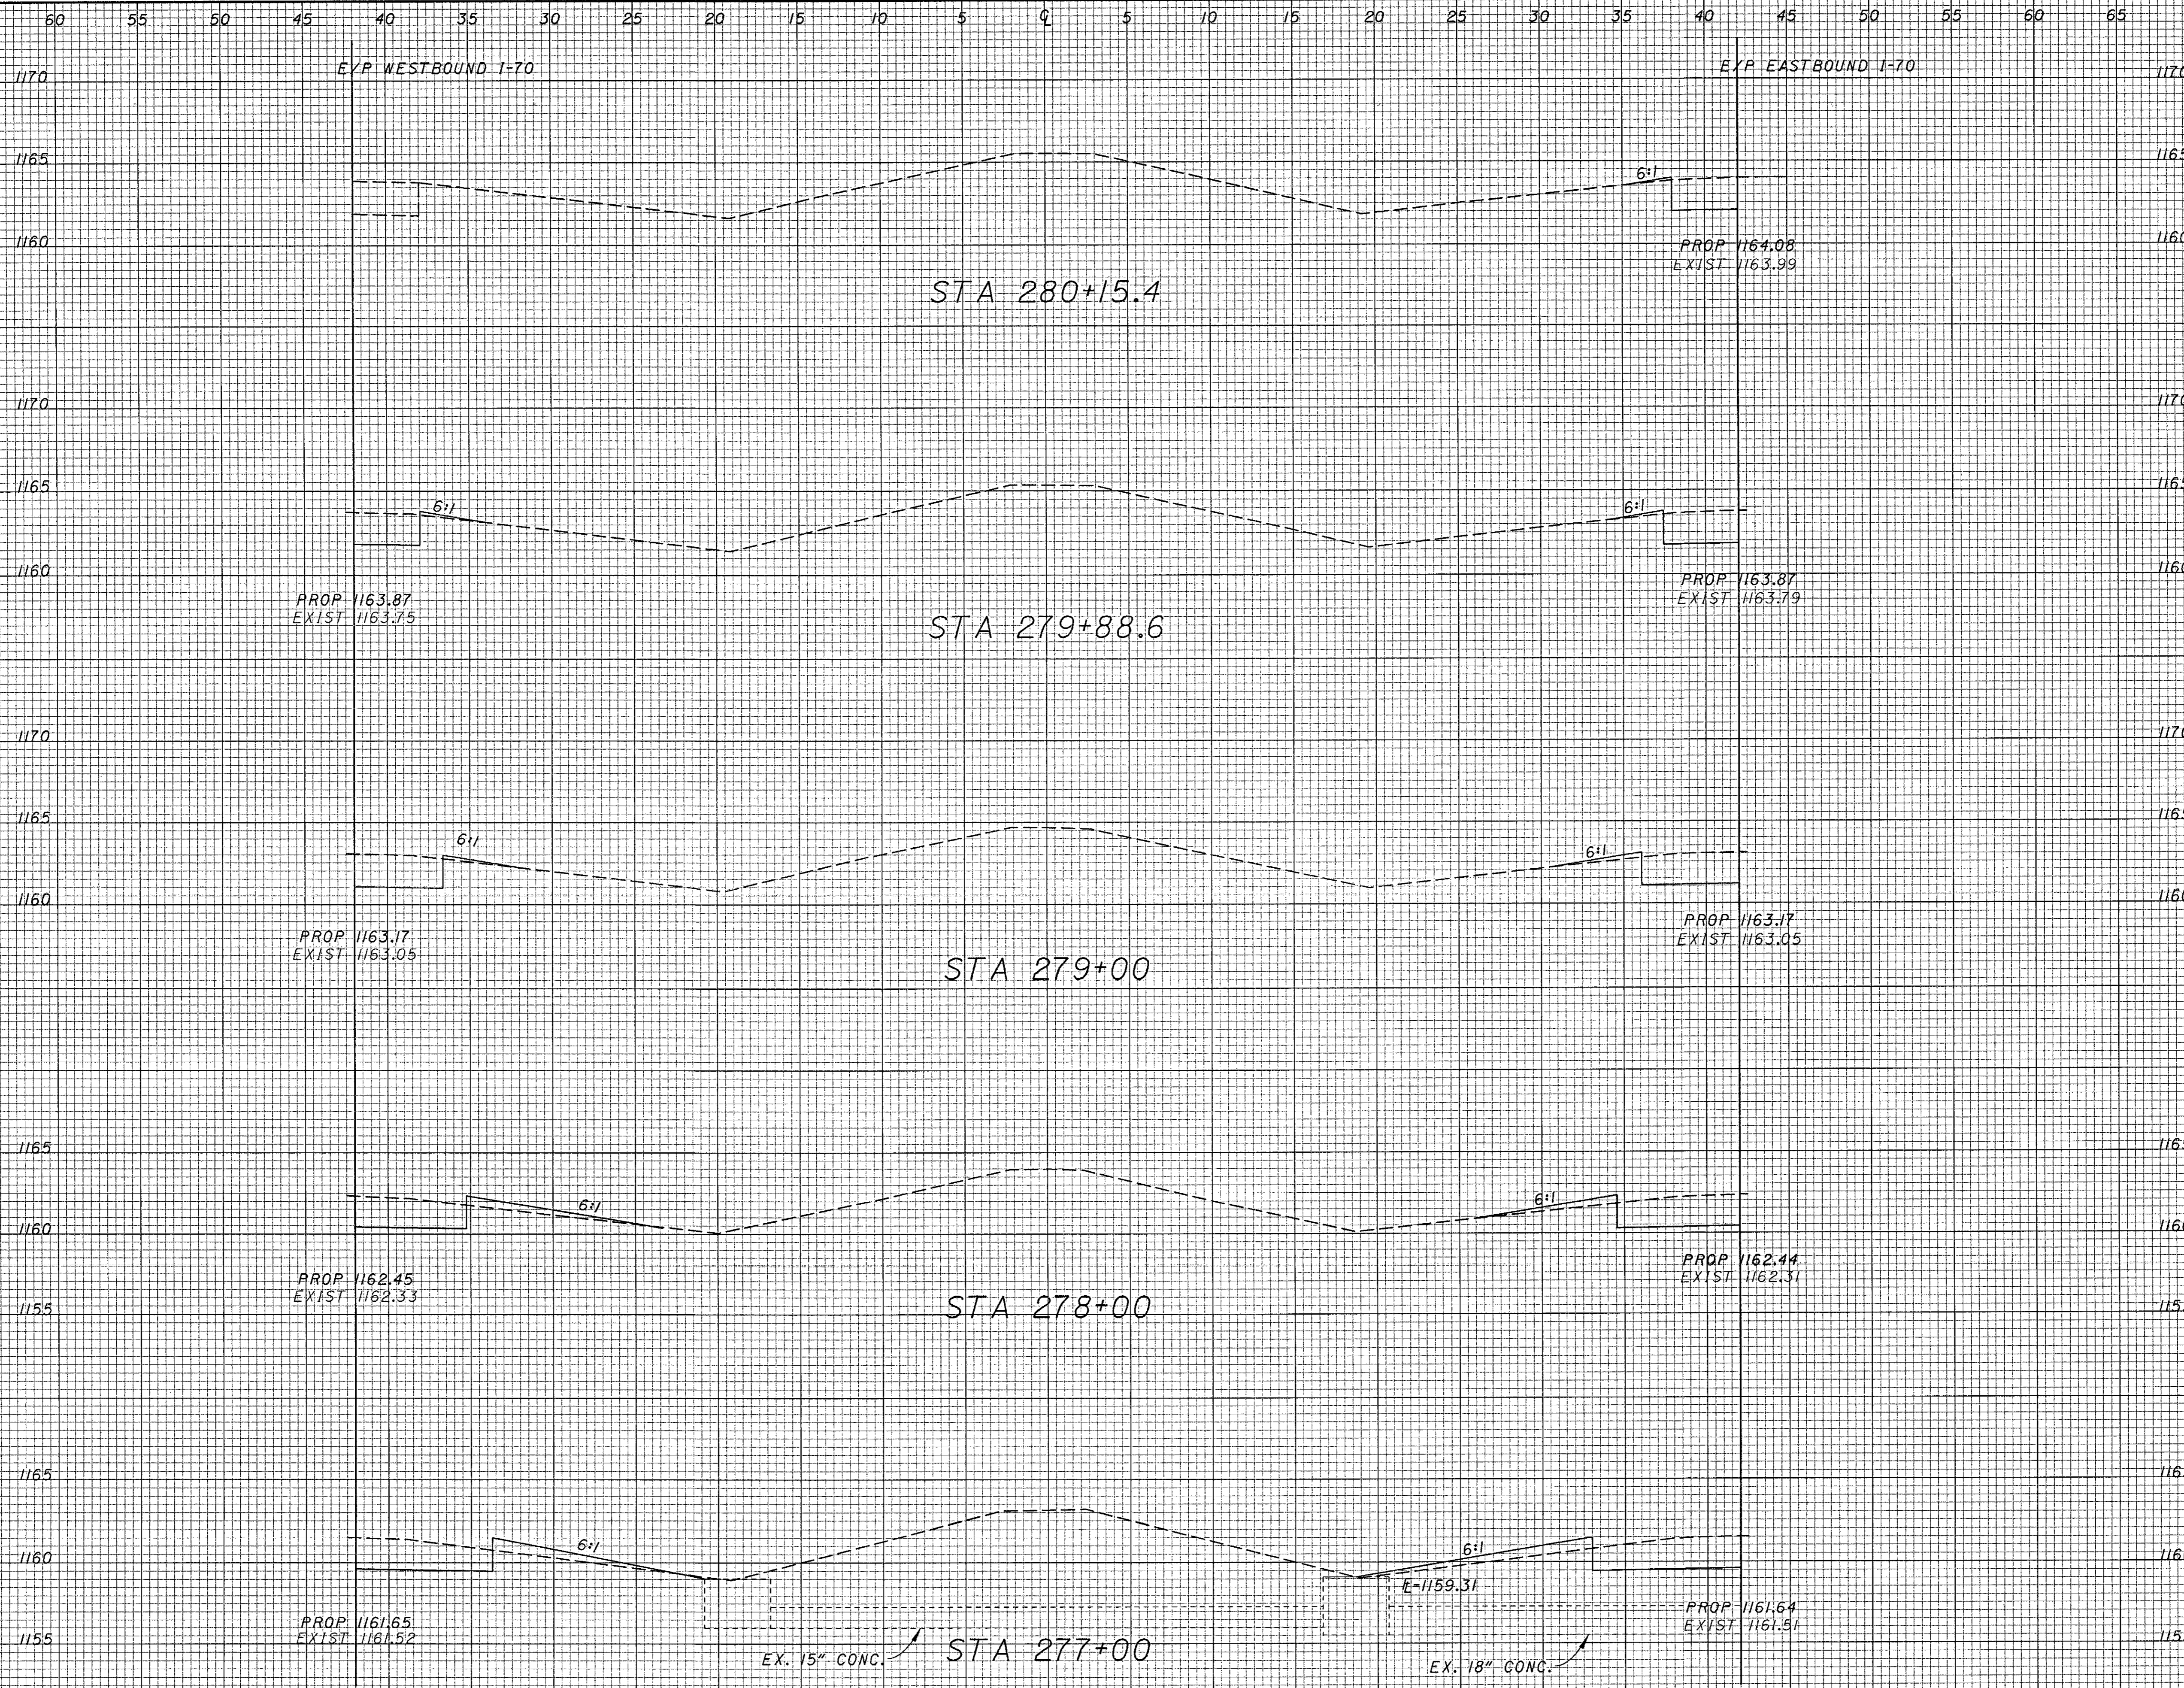


SHEET TOTAL

SHEET TOTAL

ROADWAY CROSS SECTIONS
STA. 277+00 TO STA. 280+15.4

PRE-70-0.00

74
283

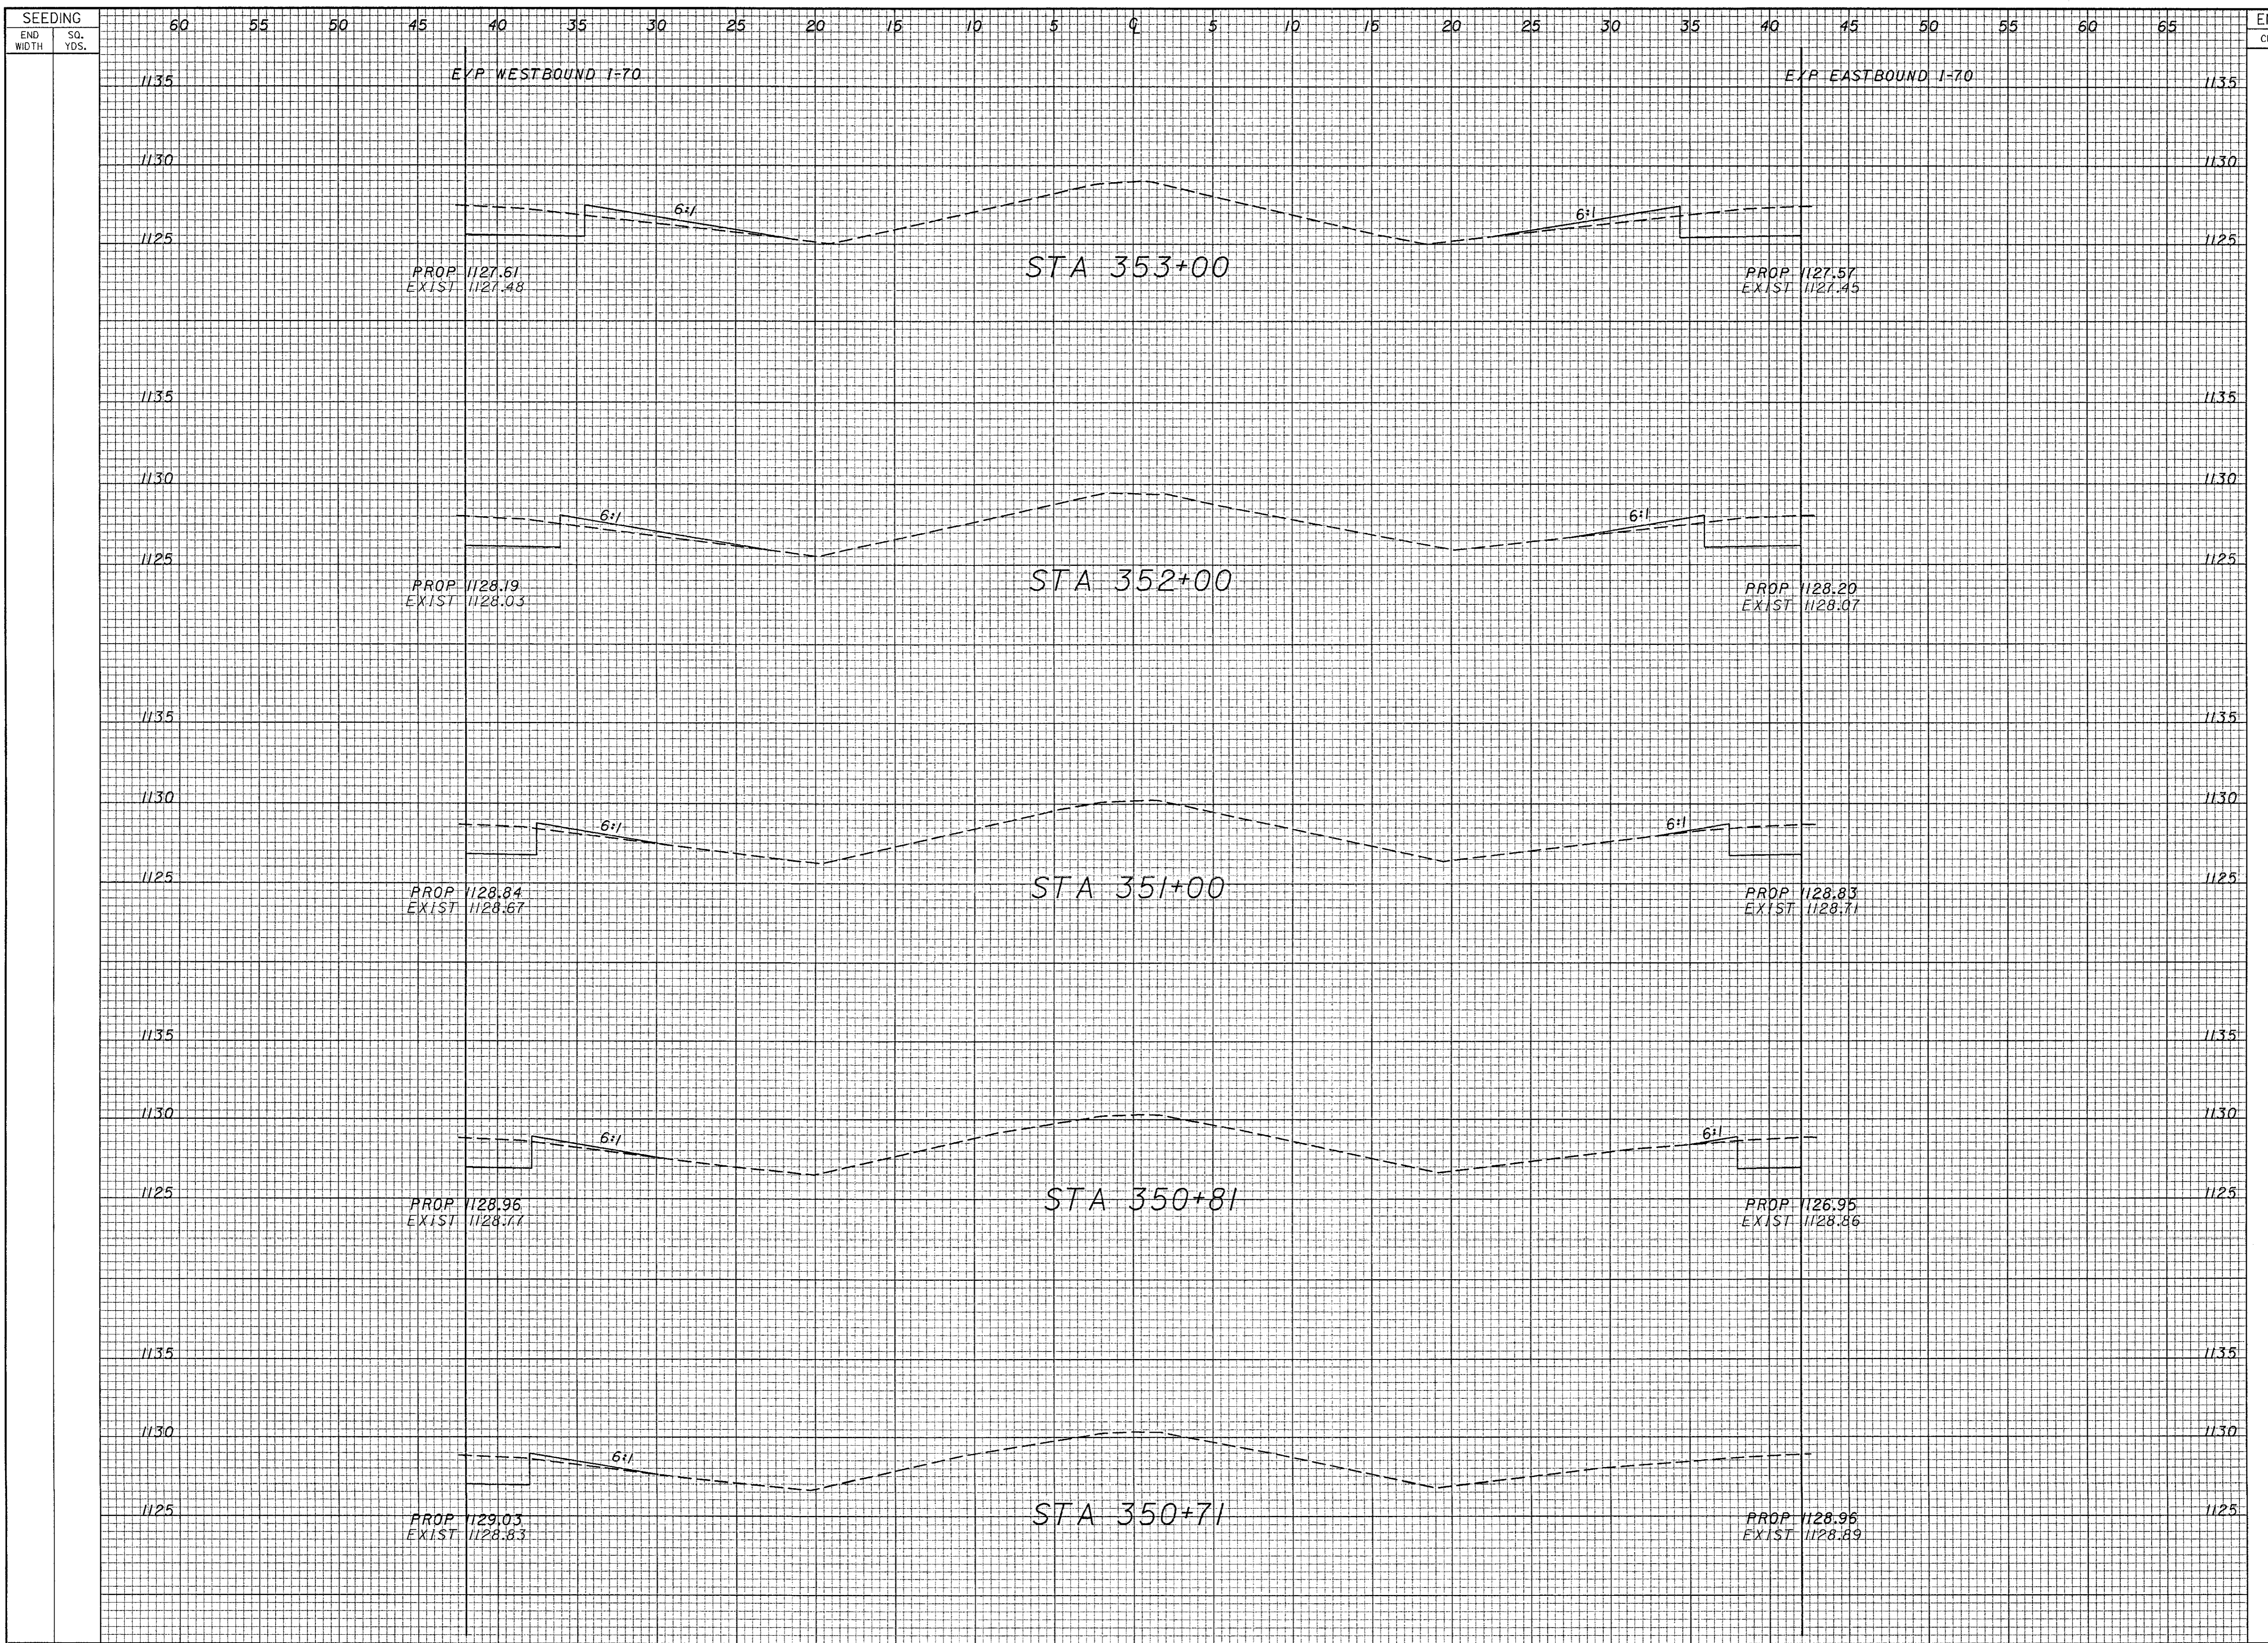

SEEDING
END WIDTH SQ. YDS.

END AREA VOLUME
CUT FILL CUT FILL

ROADWAY CROSS SECTIONS
STA. 350+71 TO STA. 353+00

PRE-70-0.00

75
283

SHEET TOTAL

SHEET TOTAL

SEEDING	
END WIDTH	SQ. YDS.


60 55 50 45 40 35 30 25 20 15 10 5 0 5 10 15 20 25 30 35 40 45 50 55 60 65

END AREA		VOLUME	
CUT	FILL	CUT	FILL

CALCULATED	CHECKED
------------	---------

E/P WESTBOUND I-70

E/P EASTBOUND I-70

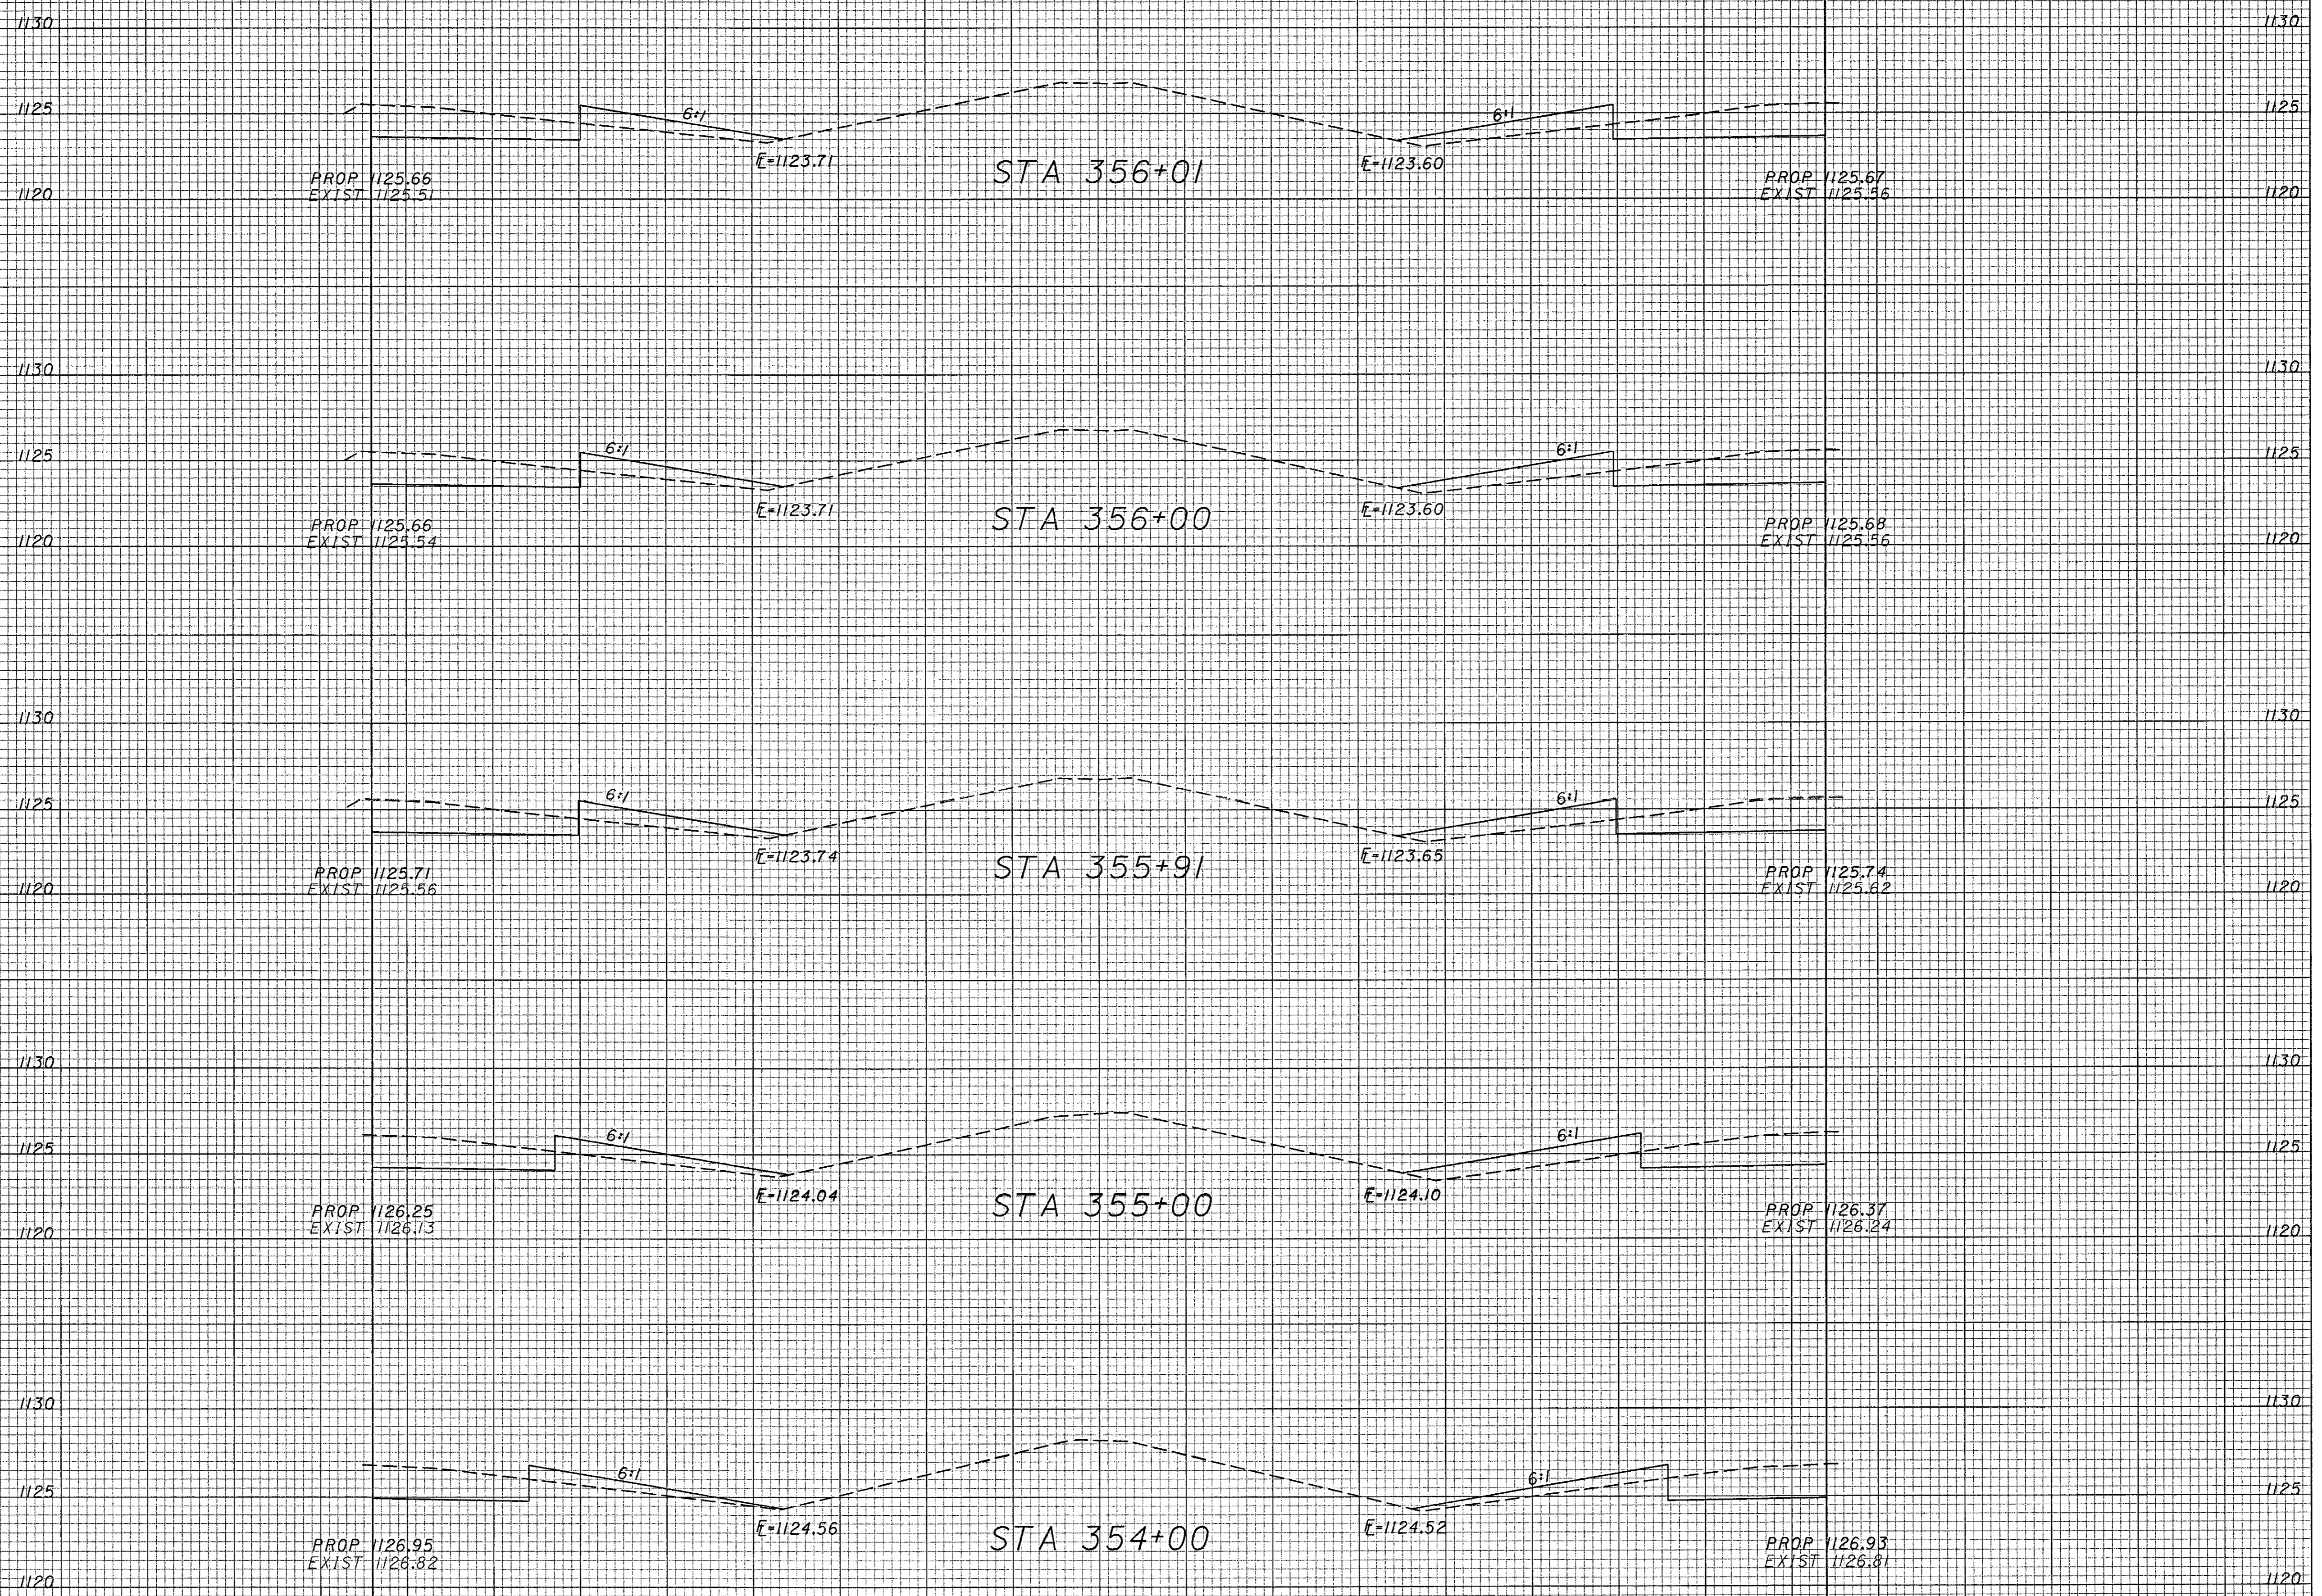

SHEET TOTAL


50 45 40 35 30 25 20 15 10 5 0 5 10 15 20 25 30 35 40 45 50 55

SHEET TOTAL

ROADWAY CROSS SECTIONS
STA. 354+00 TO STA. 356+01


PRE-70-0.00

76
283

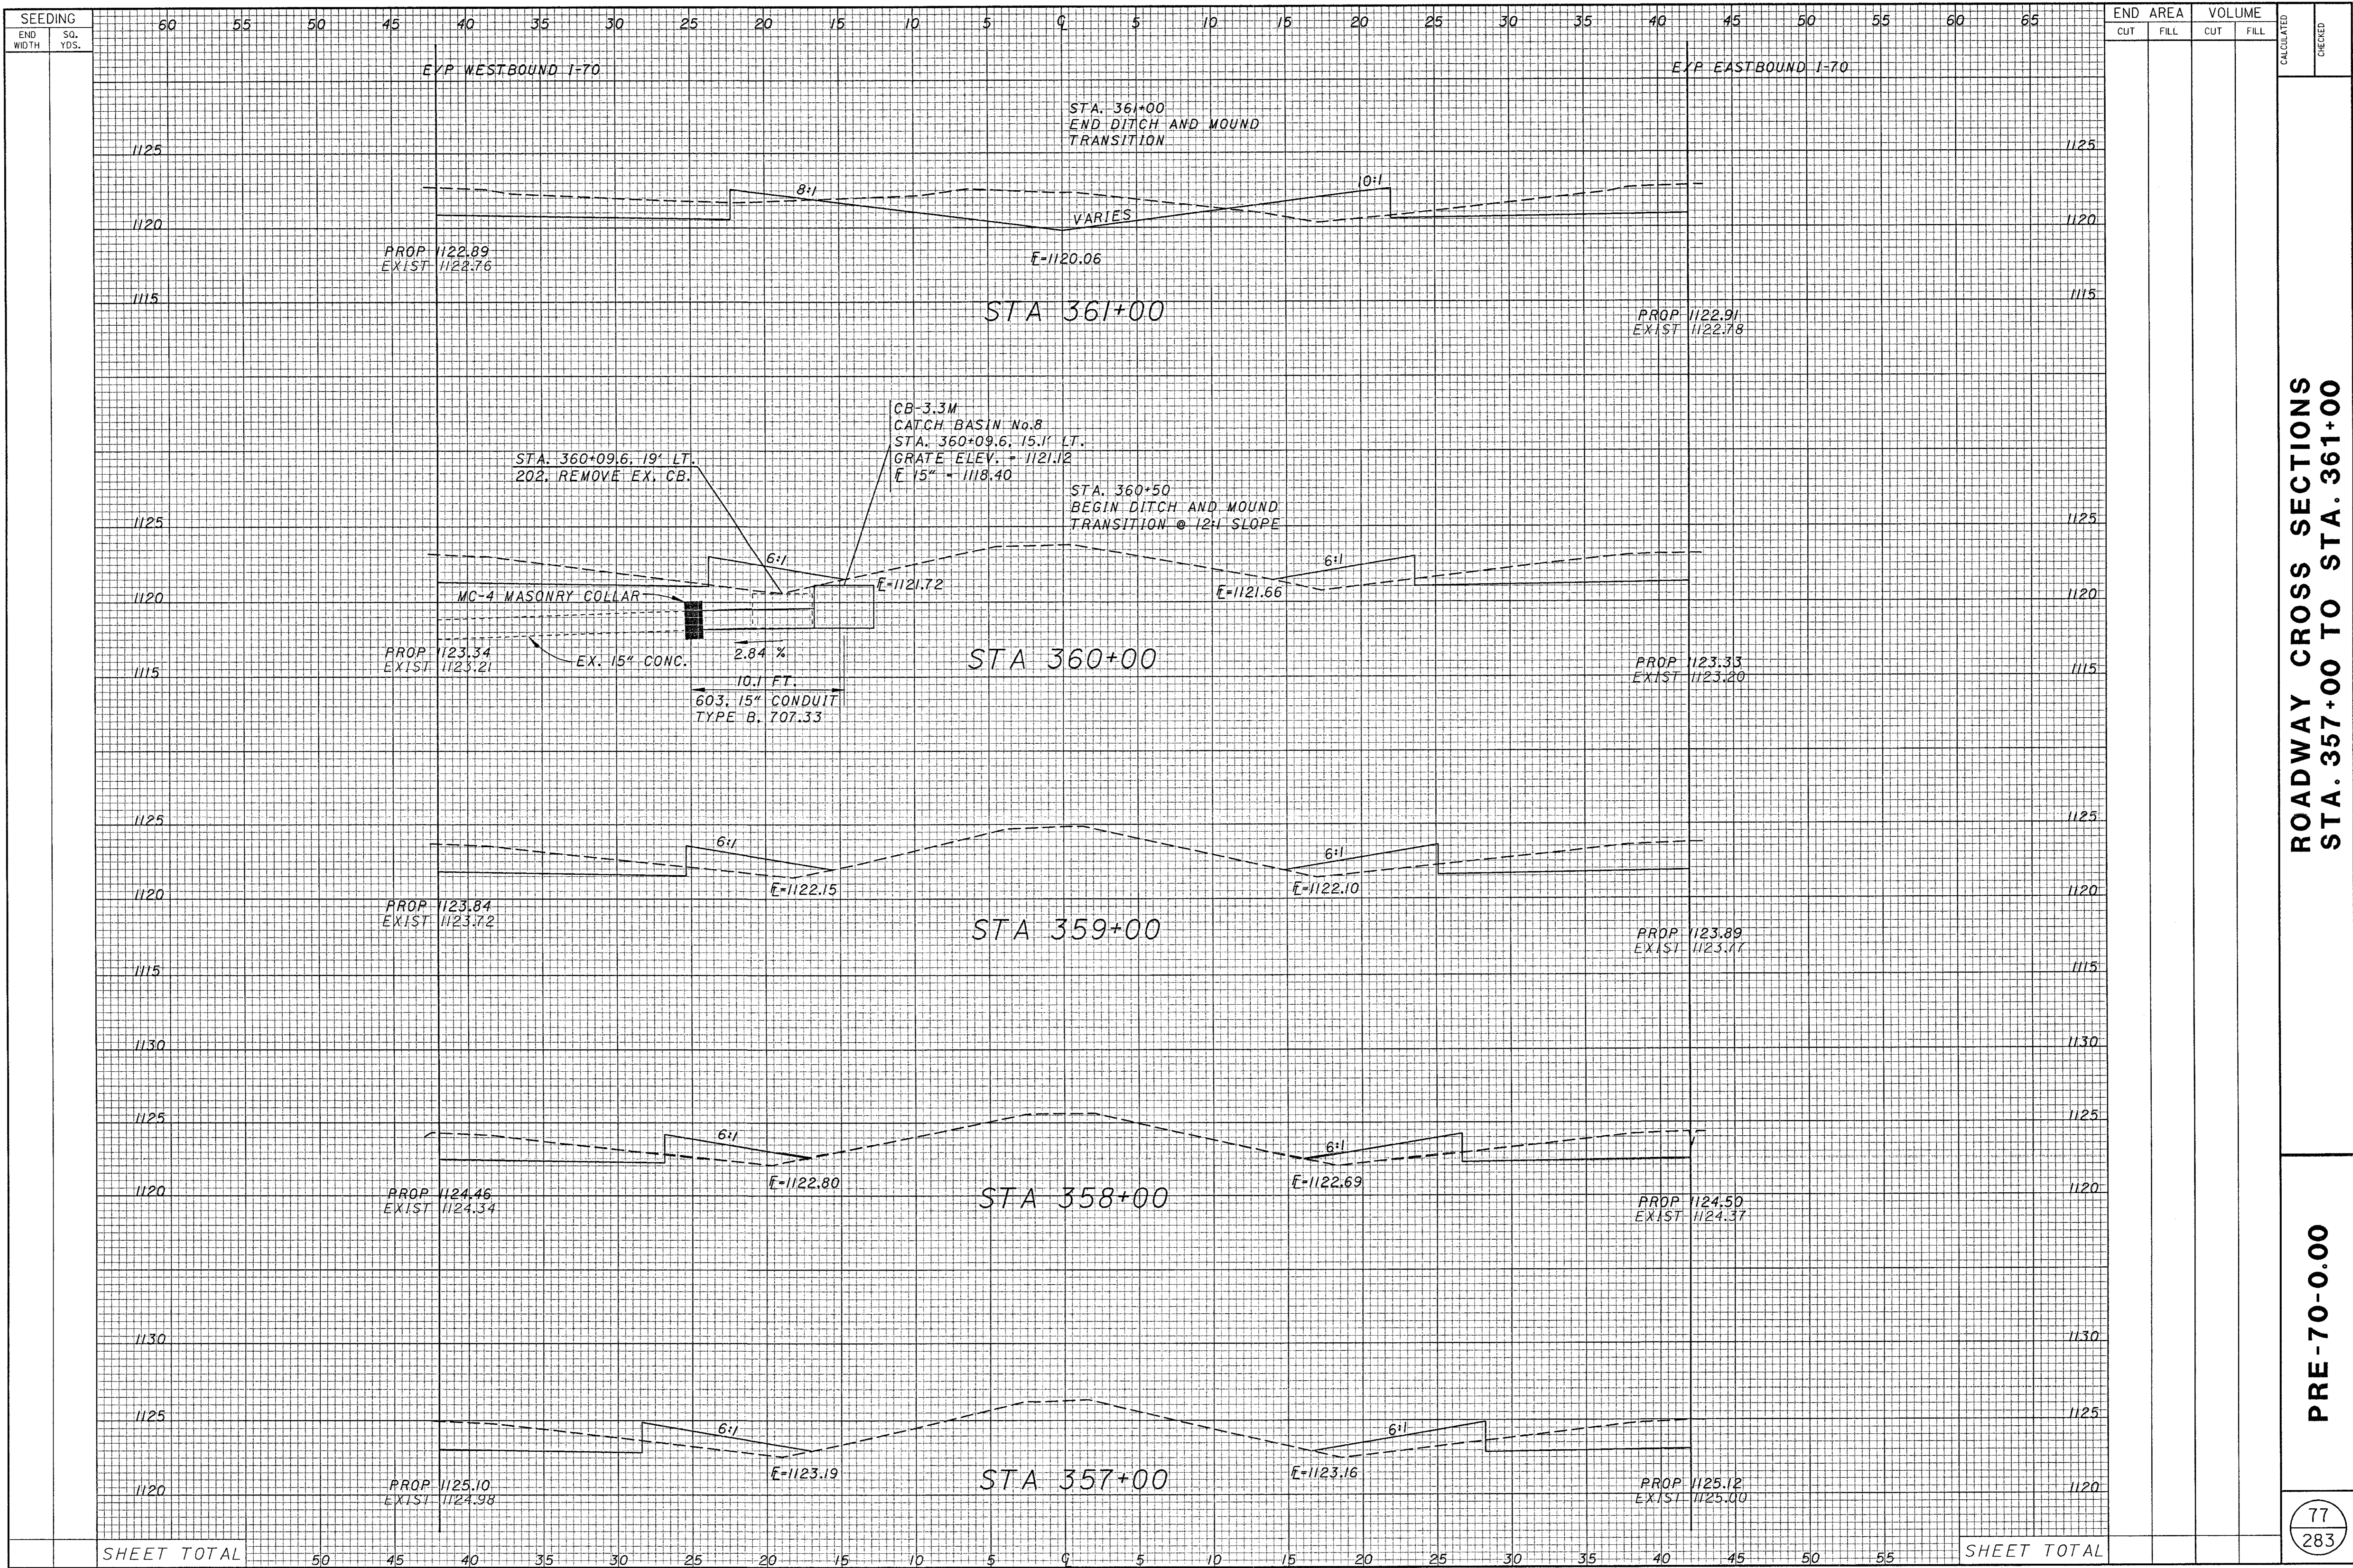

ROADWAY CROSS SECTIONS
STA. 357+00 TO STA. 361+00

PRE-70-0.00

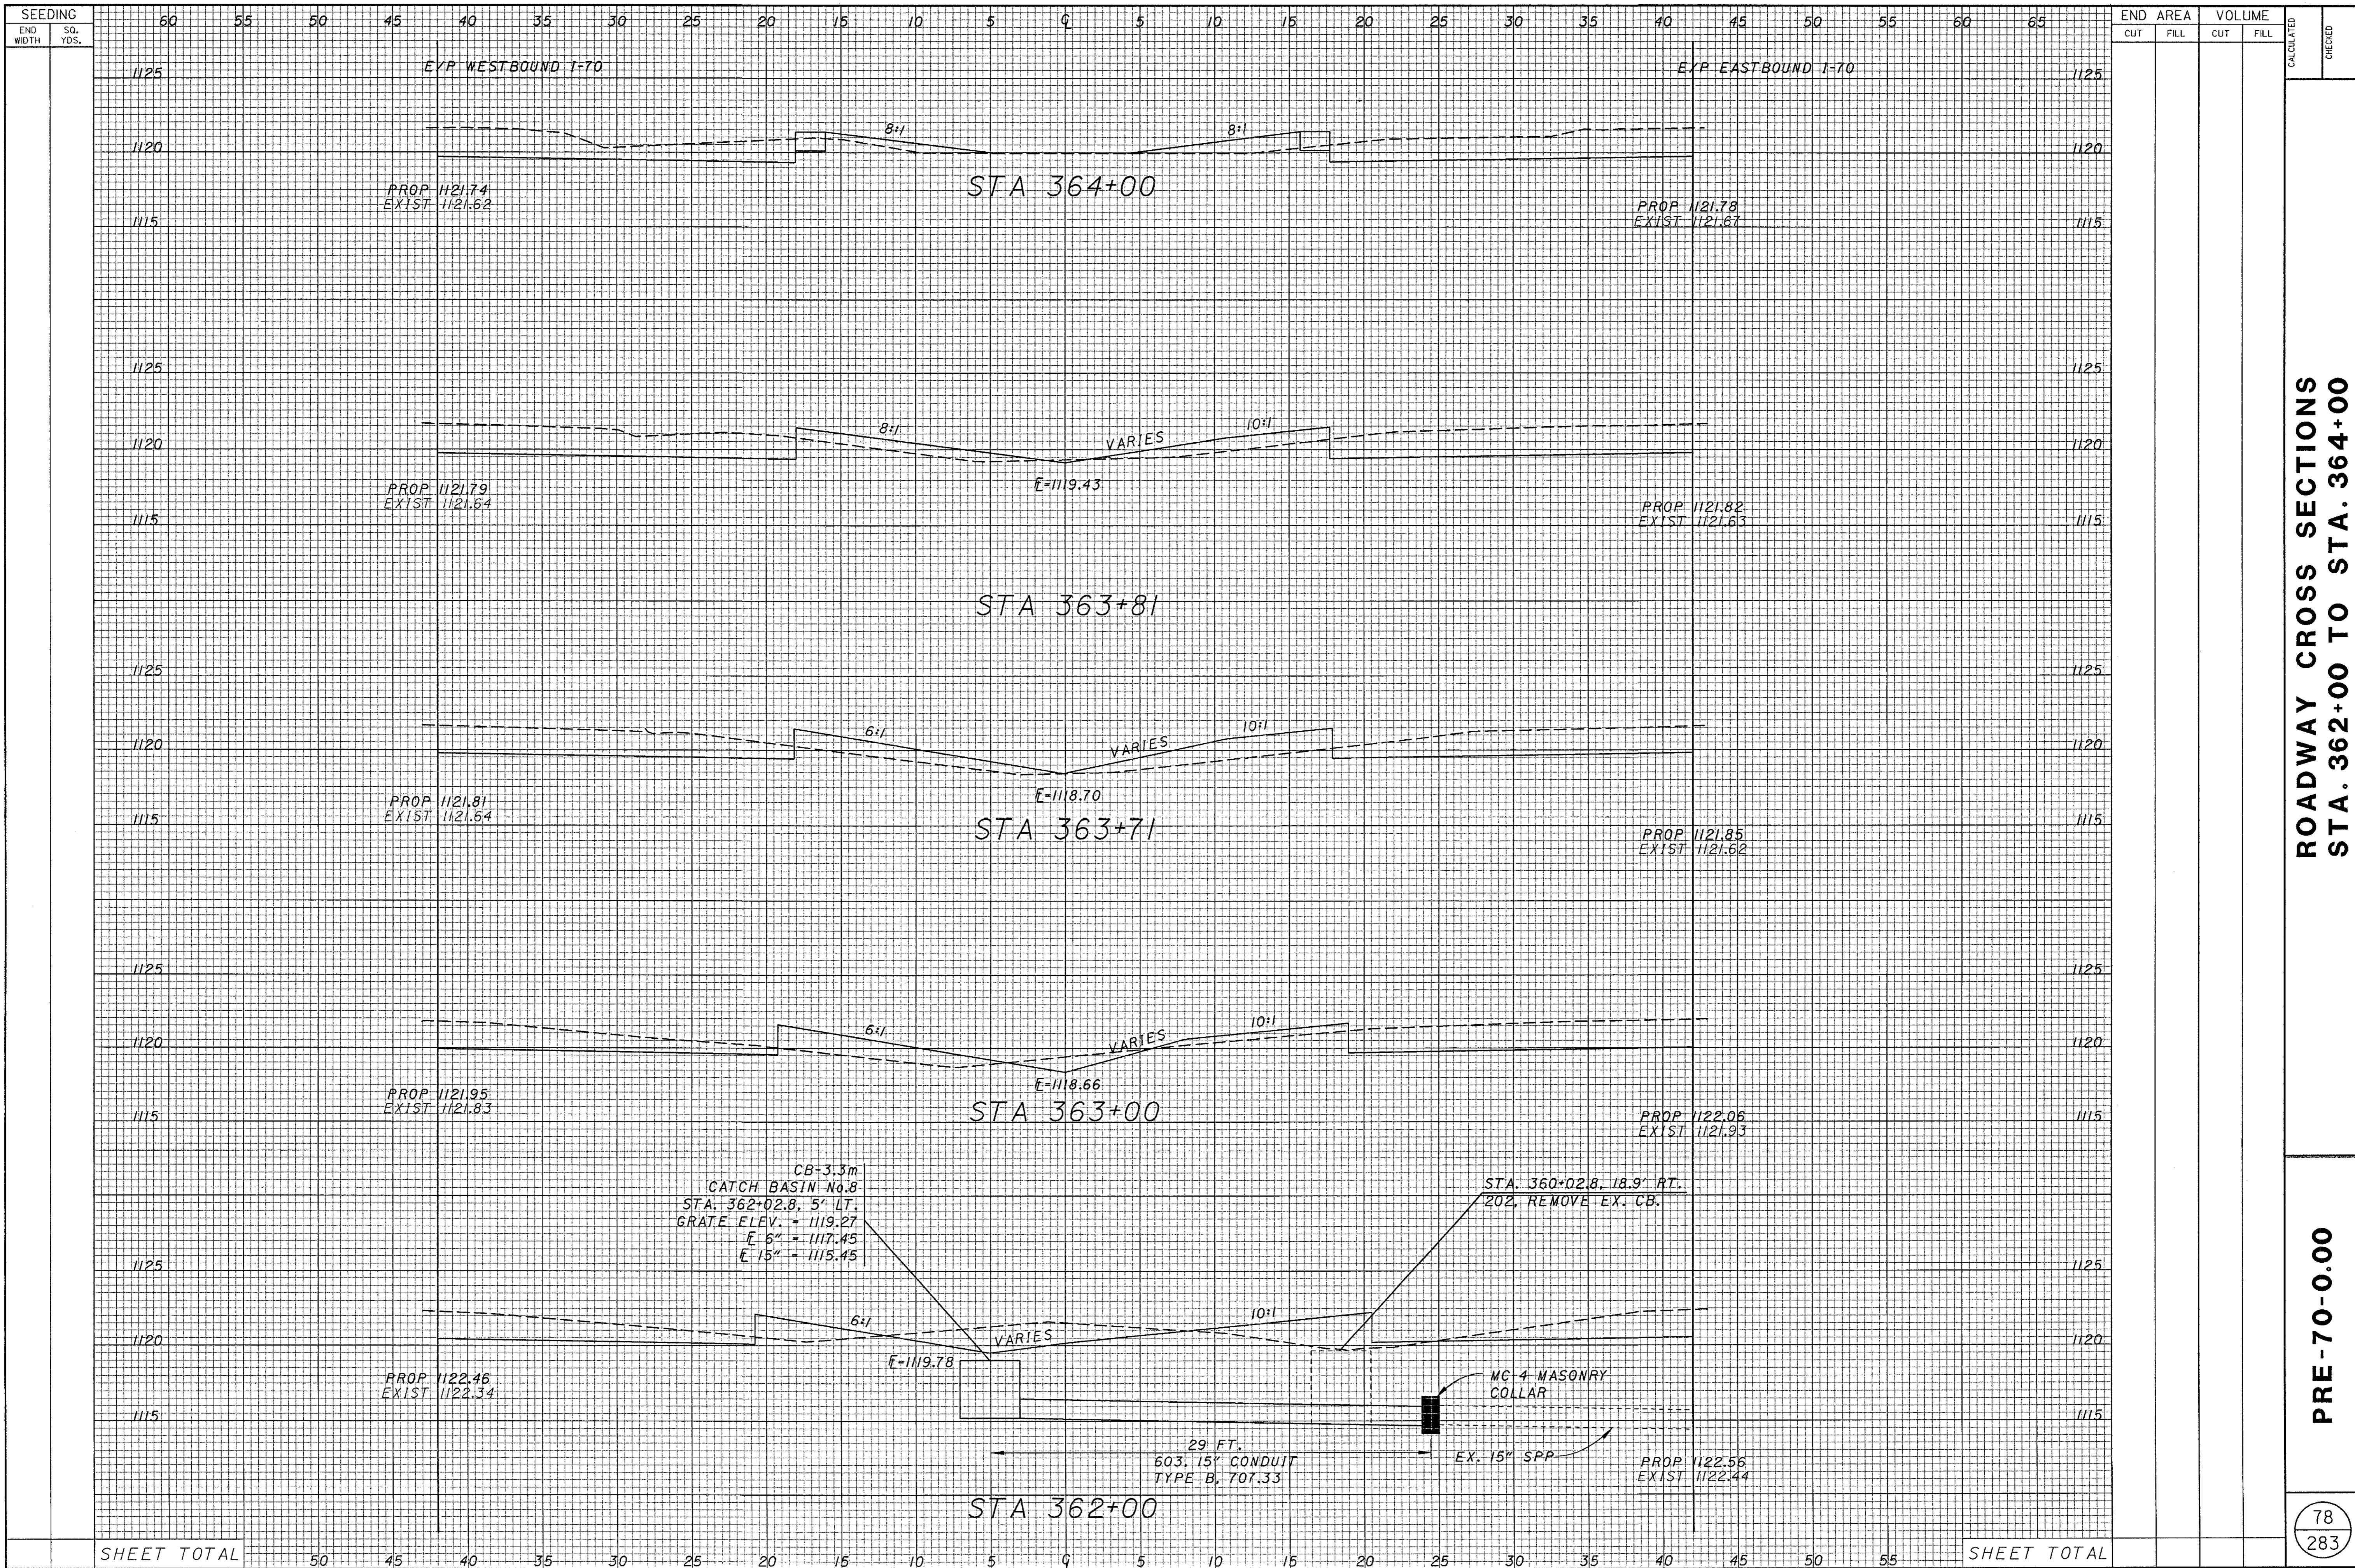

ROADWAY CROSS SECTIONS
 STA. 362+00 TO STA. 364+00

PRE-70-0.00

SEEDING
END
WIDTH
SQ.
YDS.

END AREA
CUT
FILL
VOLUME
CUT
FILL
CALCULATED
CHECKED

60 55 50 45 40 35 30 25 20 15 10 5 0 5 10 15 20 25 30 35 40 45 50 55 60 65

E/P WESTBOUND I-70

E/P EASTBOUND I-70

1125 1125

1120 1120

1115 1115

PROP 1121.14
EXIST 1121.02

VARIES

E=1117.39

STA 368+00

PROP 1121.25
EXIST 1121.13

1125 1125

1120 1120

1115 1115

PROP 1121.25
EXIST 1121.12

VARIES

E=1118.25

STA 367+00

PROP 1121.36
EXIST 1121.23

1125 1125

1120 1120

1115 1115

PROP 1121.37
EXIST 1121.26

VARIES

E=1118.87

STA 366+00

PROP 1121.36
EXIST 1121.23

1125 1125

1120 1120

1115 1115

PROP 1121.50
EXIST 1121.35

VARIES

E=1119.21

STA 365+01

PROP 1121.34
EXIST 1121.36

1125 1125

1120 1120

1115 1115

PROP 1121.52
EXIST 1121.38

VARIES

E=1119.24

STA 364+91

PROP 1121.41
EXIST 1121.36

SHEET TOTAL


50 45 40 35 30 25 20 15 10 5 0 5 10 15 20 25 30 35 40 45 50 55

SHEET TOTAL


ROADWAY CROSS SECTIONS
STA. 364+91 TO STA. 368+00

PRE-70-0.00

79
283

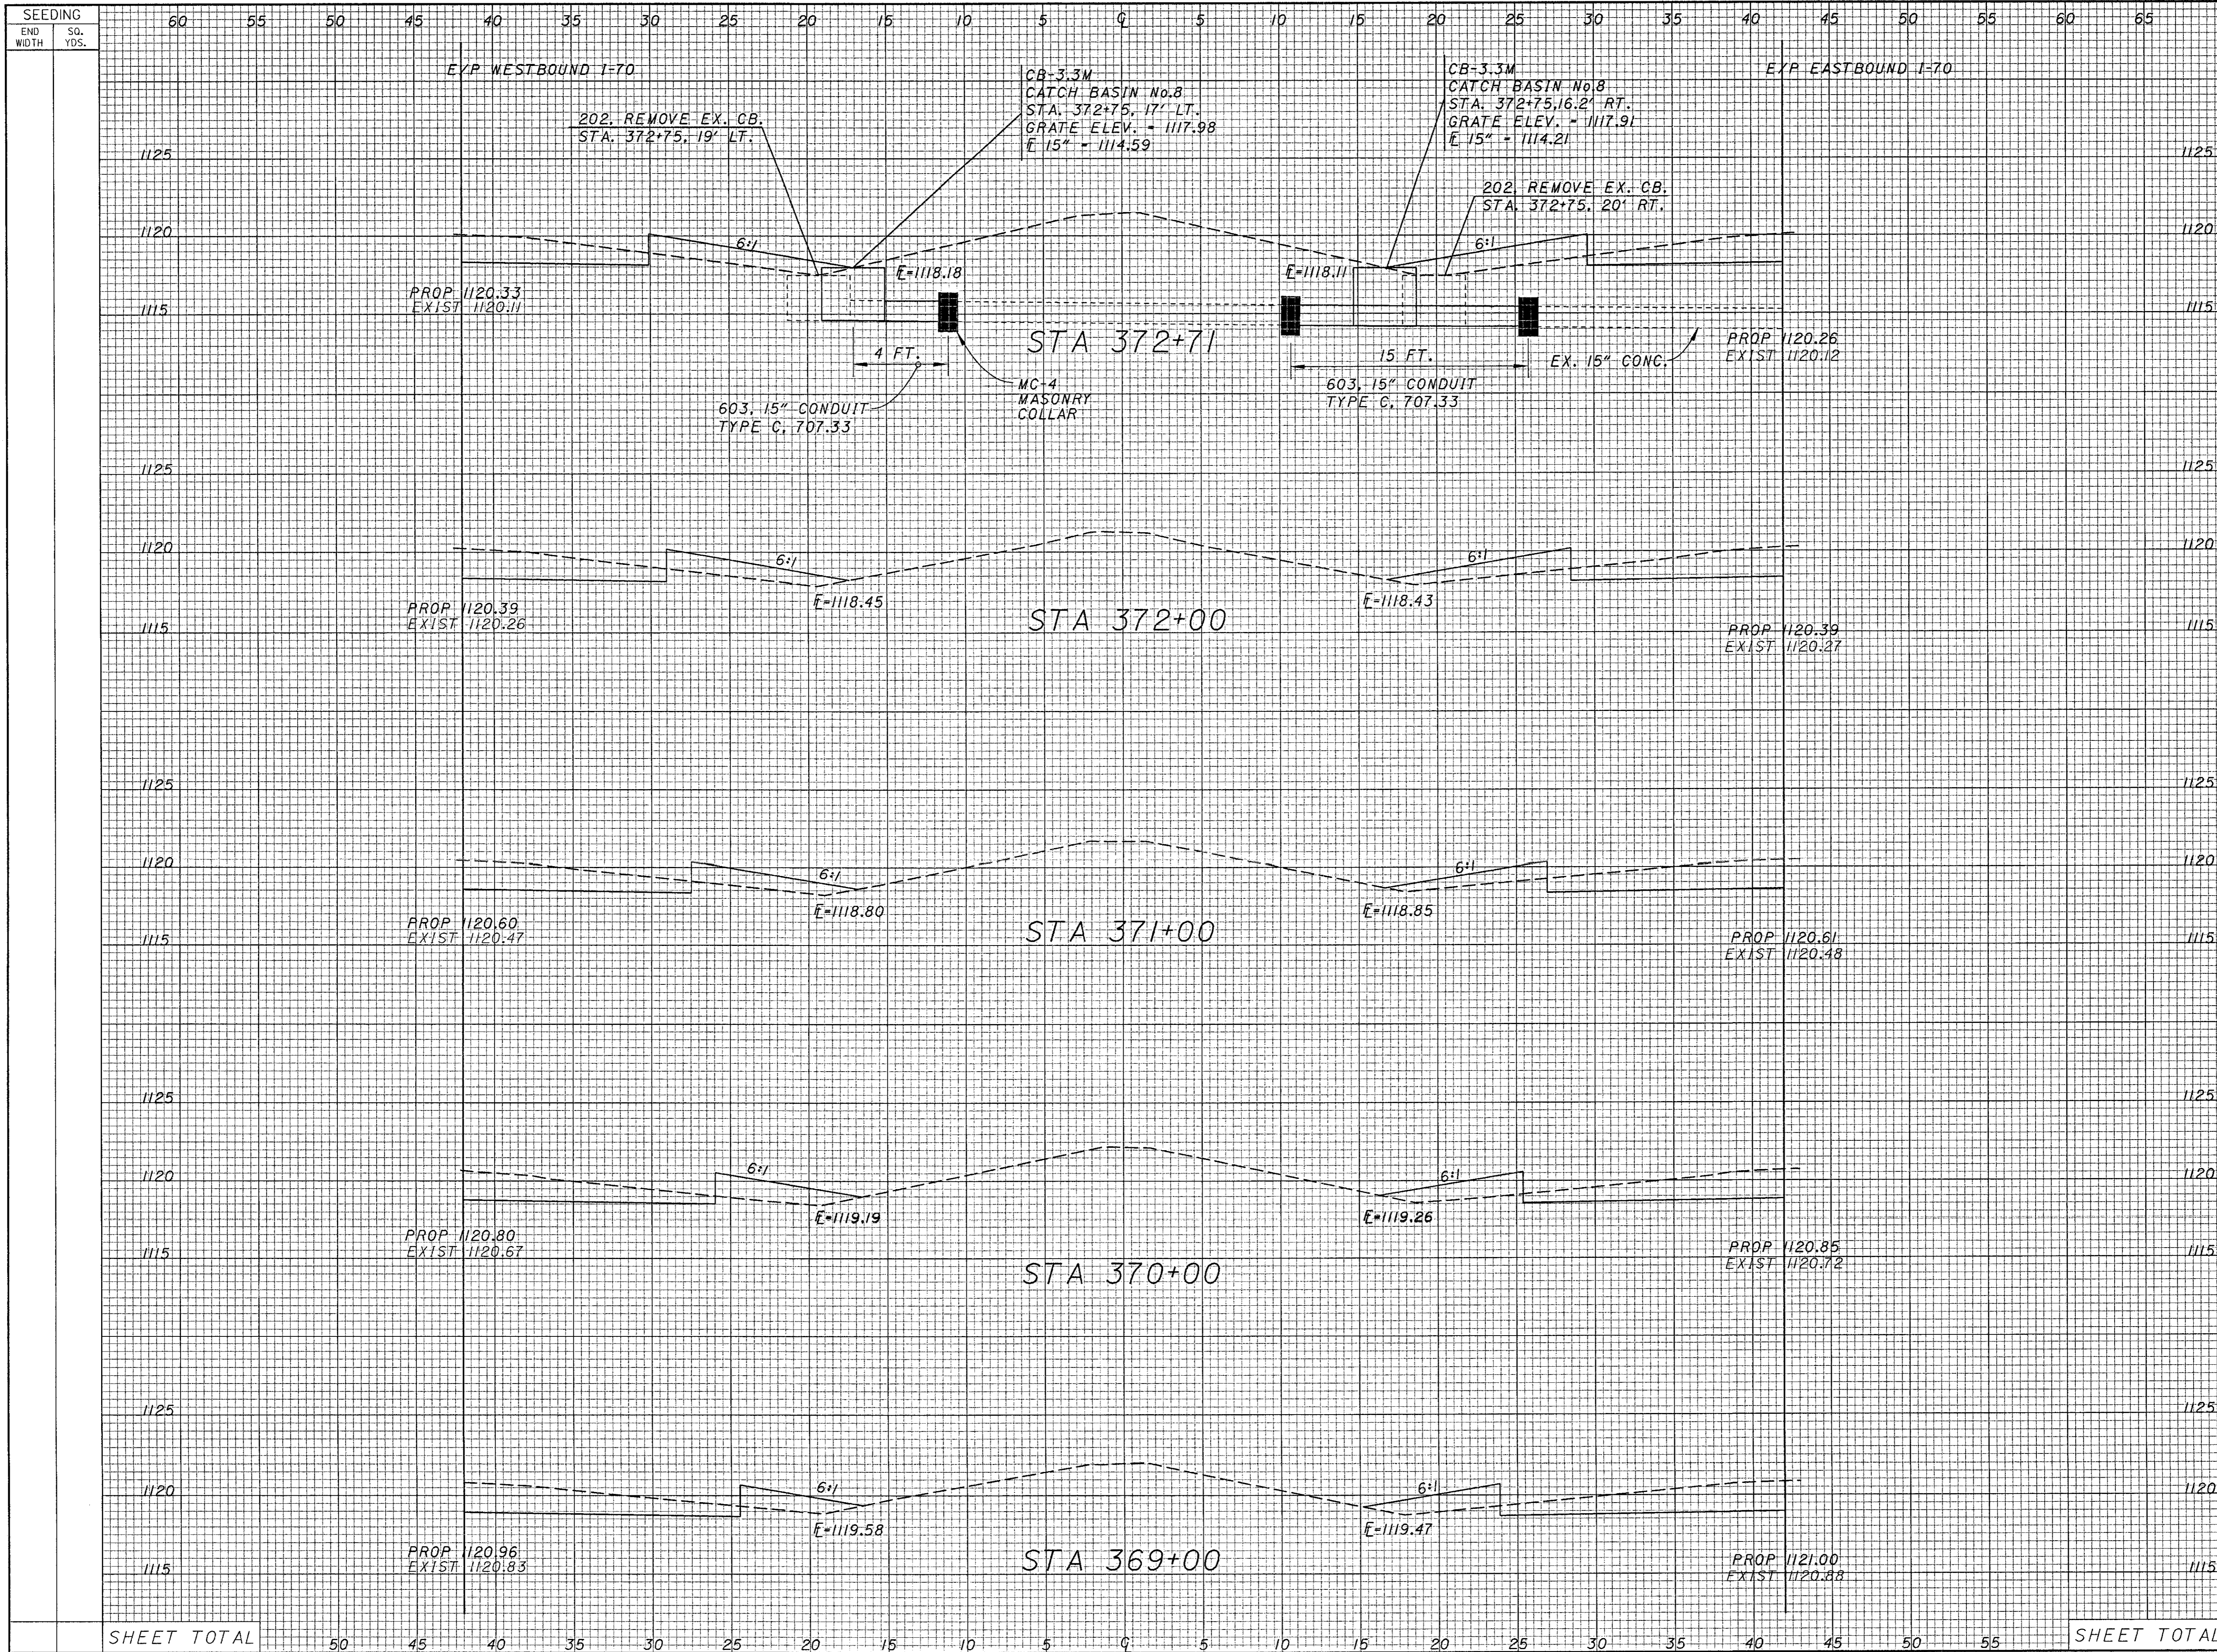

SHEET TOTAL

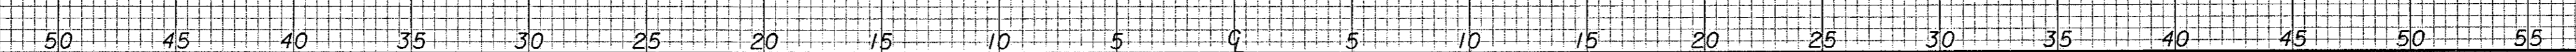


SHEET TOTAL

END	AREA		VOLUME		CALCULATED	CHECKED
	CUT	FILL	CUT	FILL		

ROADWAY CROSS SECTIONS
STA. 369+00 TO STA. 372+71

PRE-70-0.00

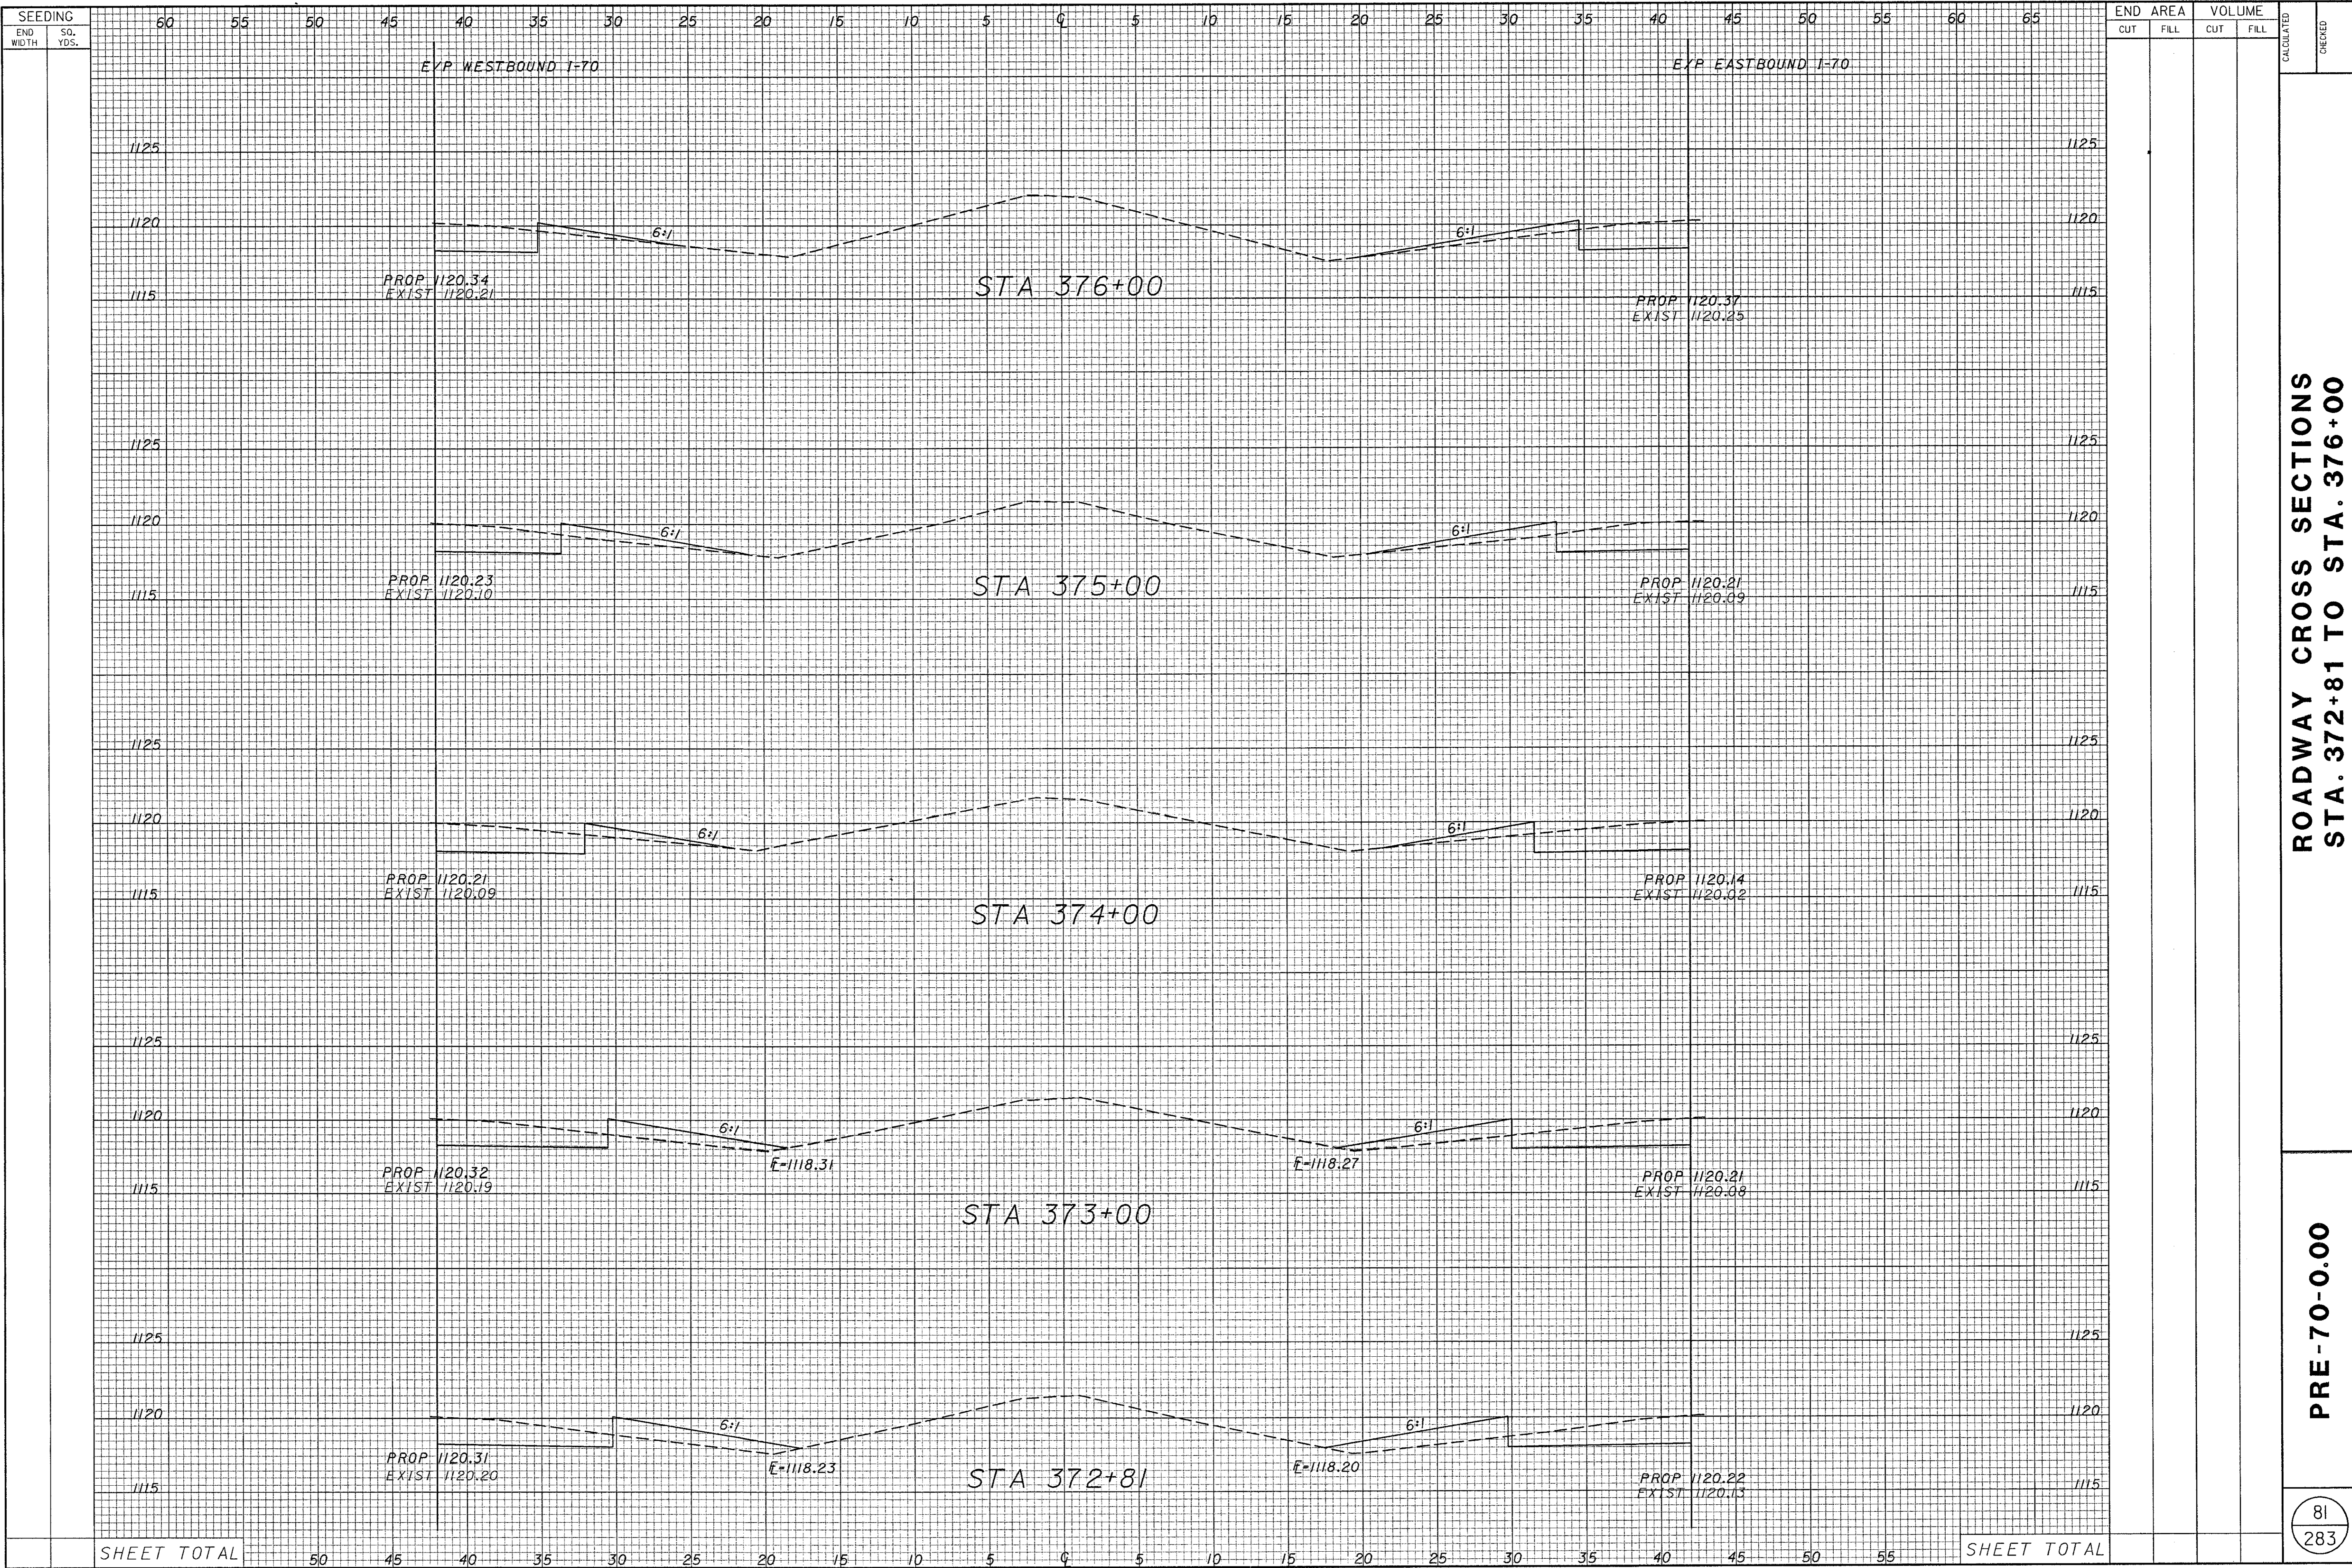

ROADWAY CROSS SECTIONS
STA. 372+81 TO STA. 376+00

PRE-70-0.00

81
283

END AREA
CUT FILL

VOLUME
CUT FILL

CALCULATED

CHECKED

SEEDING
END WIDTH
SO. YDS.

60 55 50 45 40 35 30 25 20 15 10 5 0 5 10 15 20 25 30 35 40 45 50 55 60 65

END CUT	AREA FILL	VOLUME CUT	VOLUME FILL
---------	-----------	------------	-------------

CALCULATED	CHECKED
------------	---------

E/P WESTBOUND I-70

E/P EASTBOUND I-70

1125

1125

1120

1120

1115

1115

STA 378+01

EXIST 1120.72

PROP 1120.75
EXIST 1120.65

6:1

1125

1125

1120

1120

1115

1115

STA 377+91

PROP 1120.83
EXIST 1120.70

PROP 1120.76
EXIST 1120.64

6:1

6:1

1125

1125

1120

1120

1115

1115

STA 377+00

PROP 1120.61
EXIST 1120.48

PROP 1120.65
EXIST 1120.52

6:1

6:1

SHEET TOTAL


50 45 40 35 30 25 20 15 10 5 0 5 10 15 20 25 30 35 40 45 50 55

SHEET TOTAL

ROADWAY CROSS SECTIONS
STA. 377+00 TO STA. 378+01


PRE-70-0.00

82
283

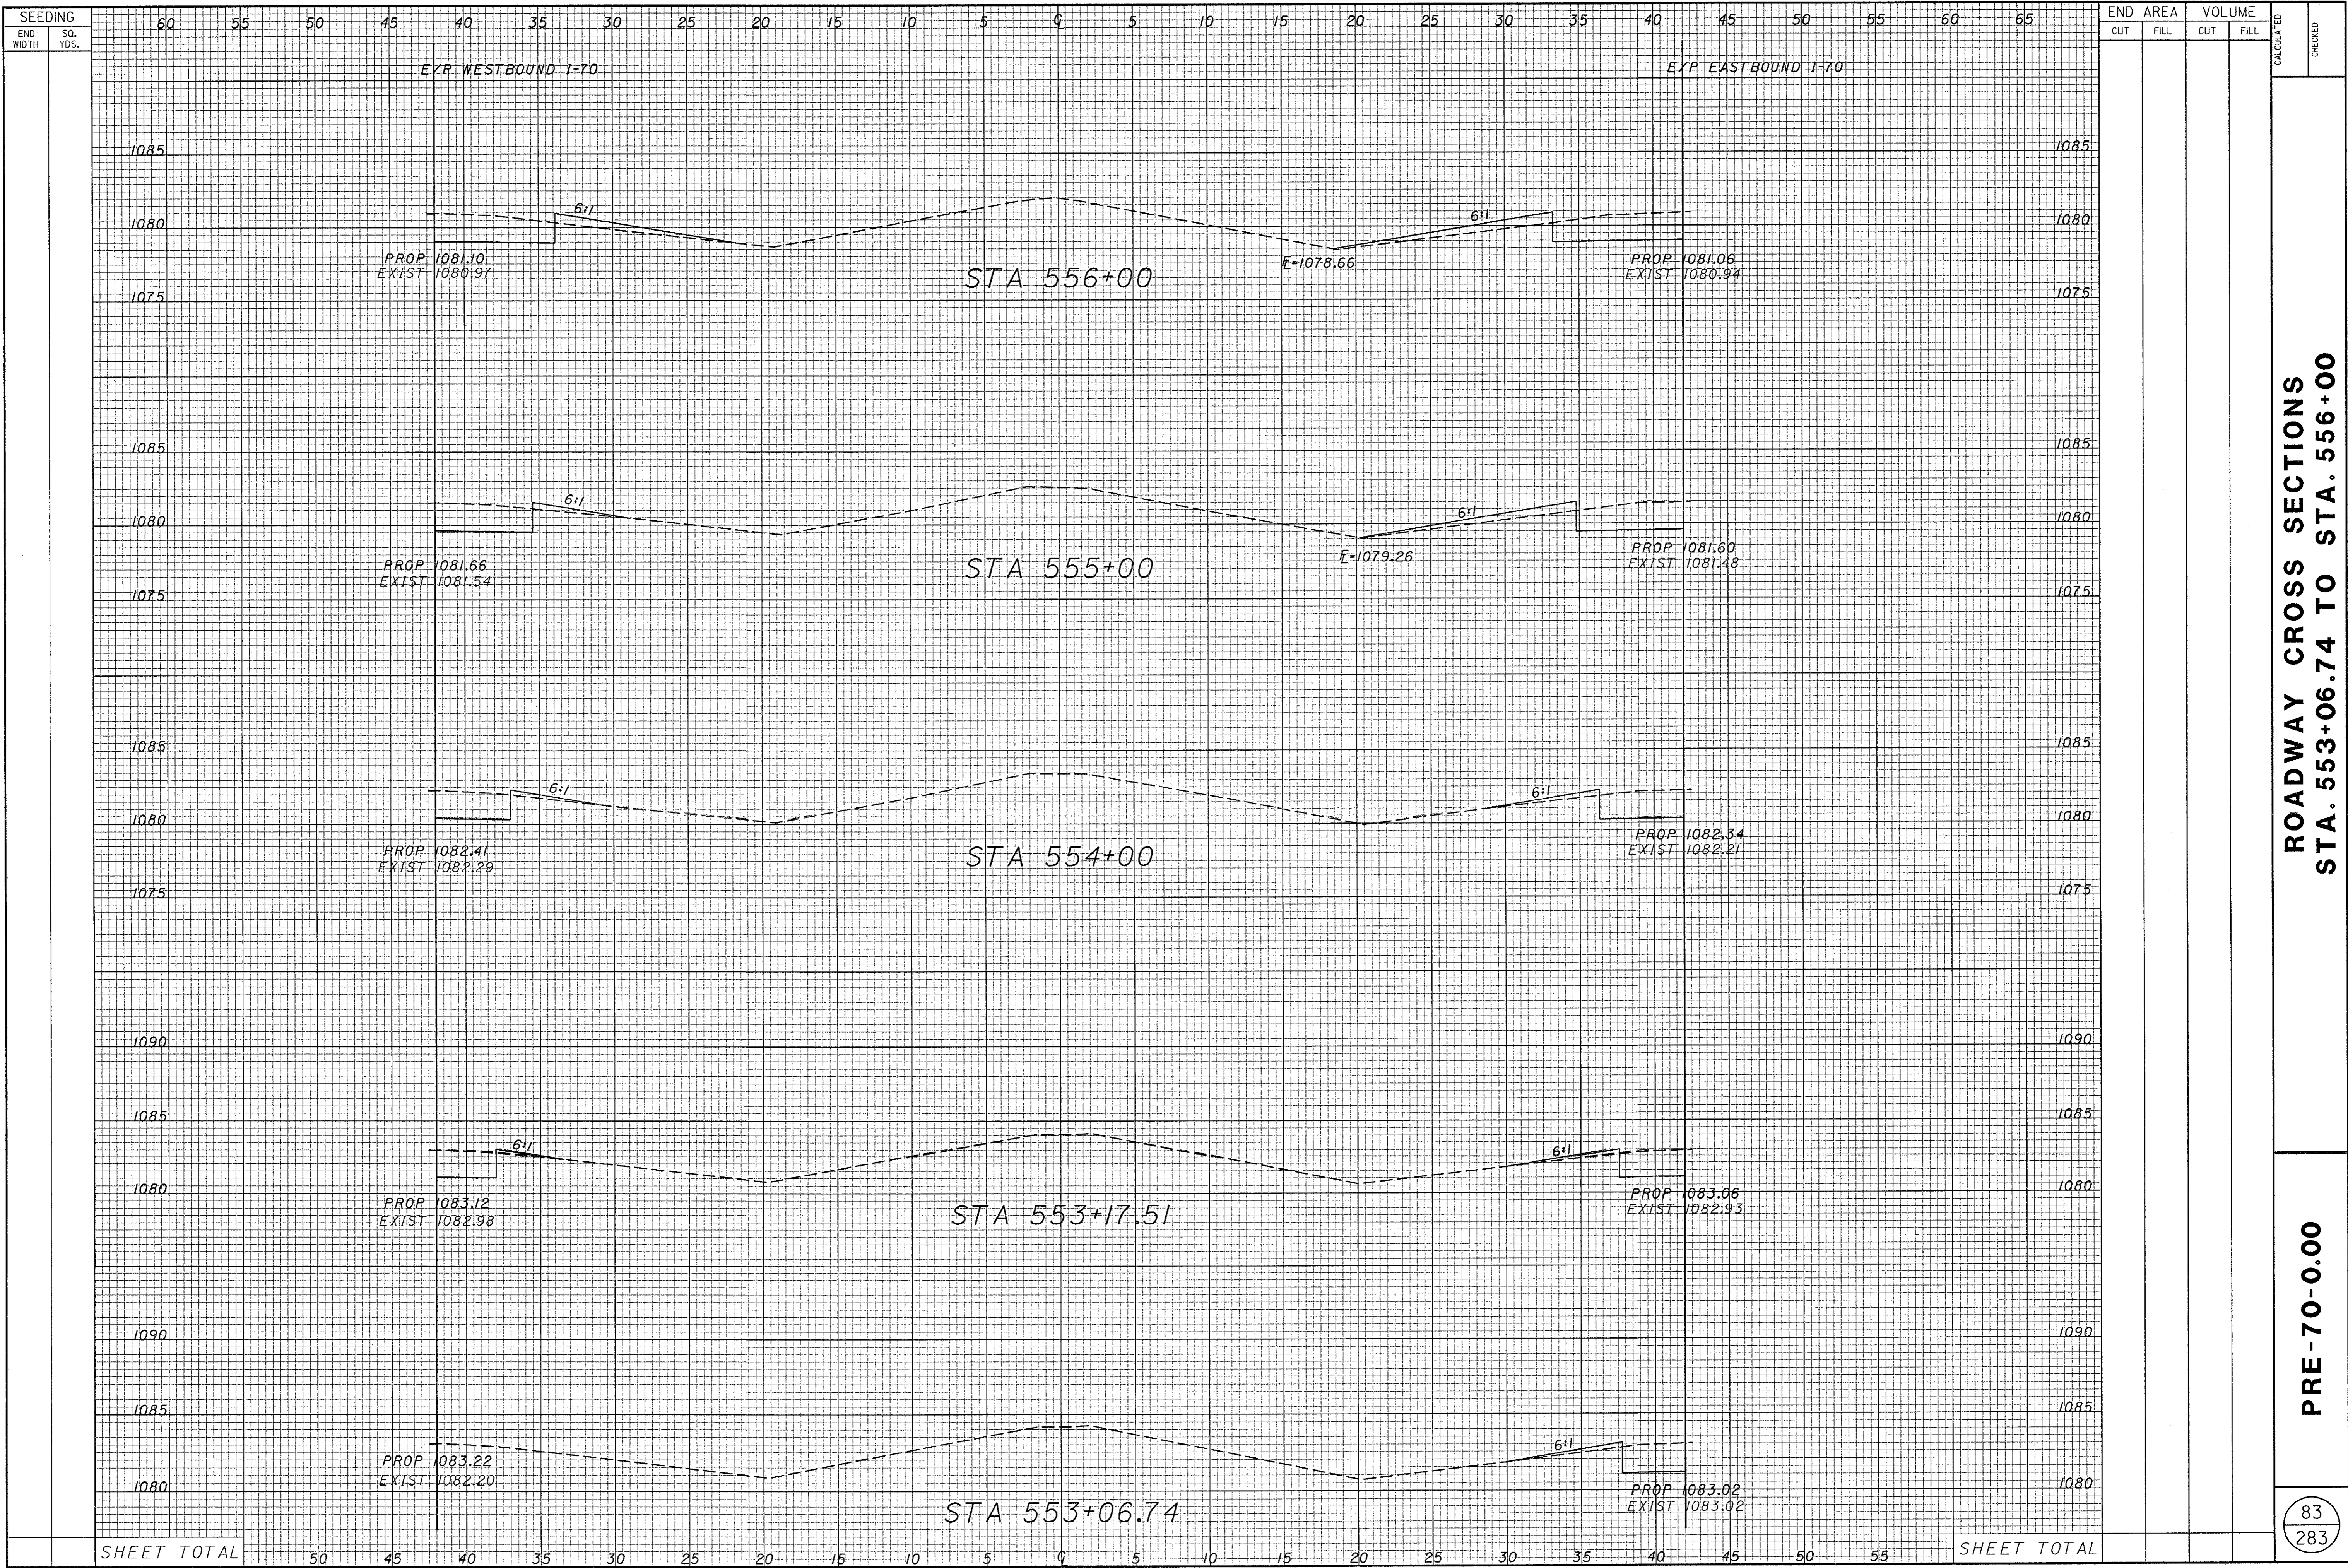

SEEDING
END
WIDTH
SO.
YDS.

END AREA
CUT FILL
VOLUME
CUT FILL
CALCULATED
CHECKED

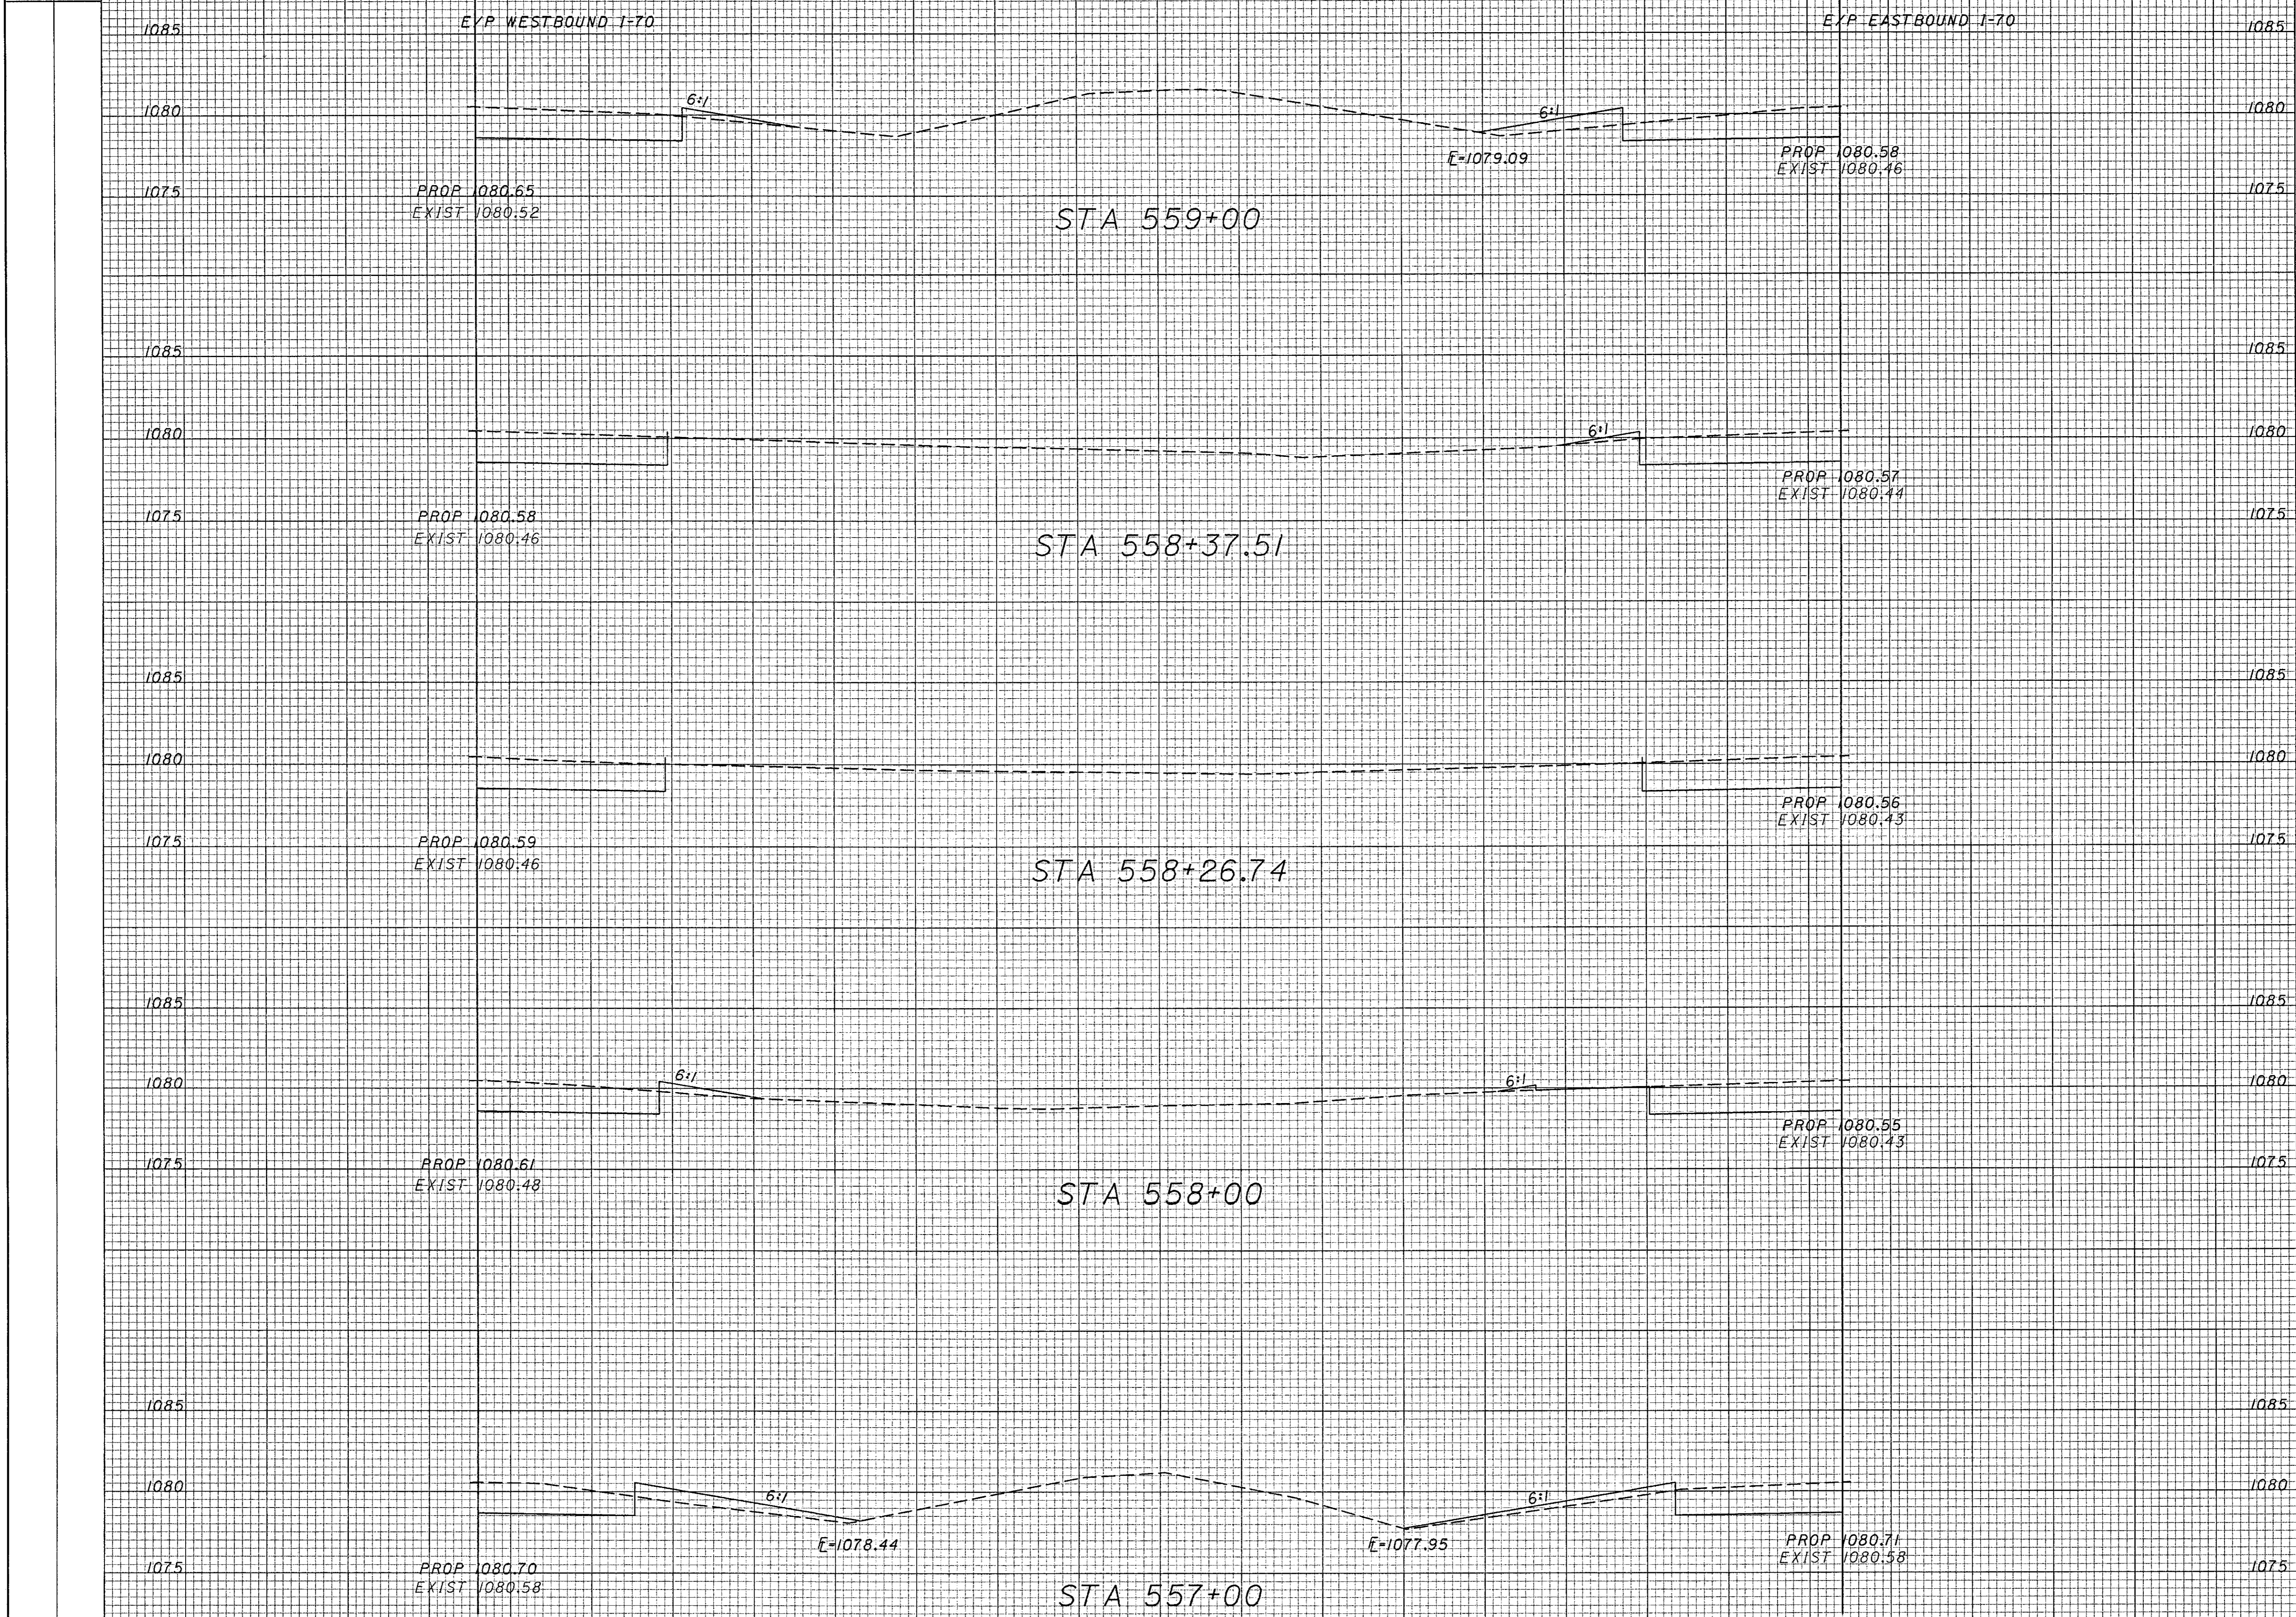


ROADWAY CROSS SECTIONS
STA. 557+00 TO STA. 559+00

PRE-70-0.00

84
283

SHEET TOTAL

SHEET TOTAL

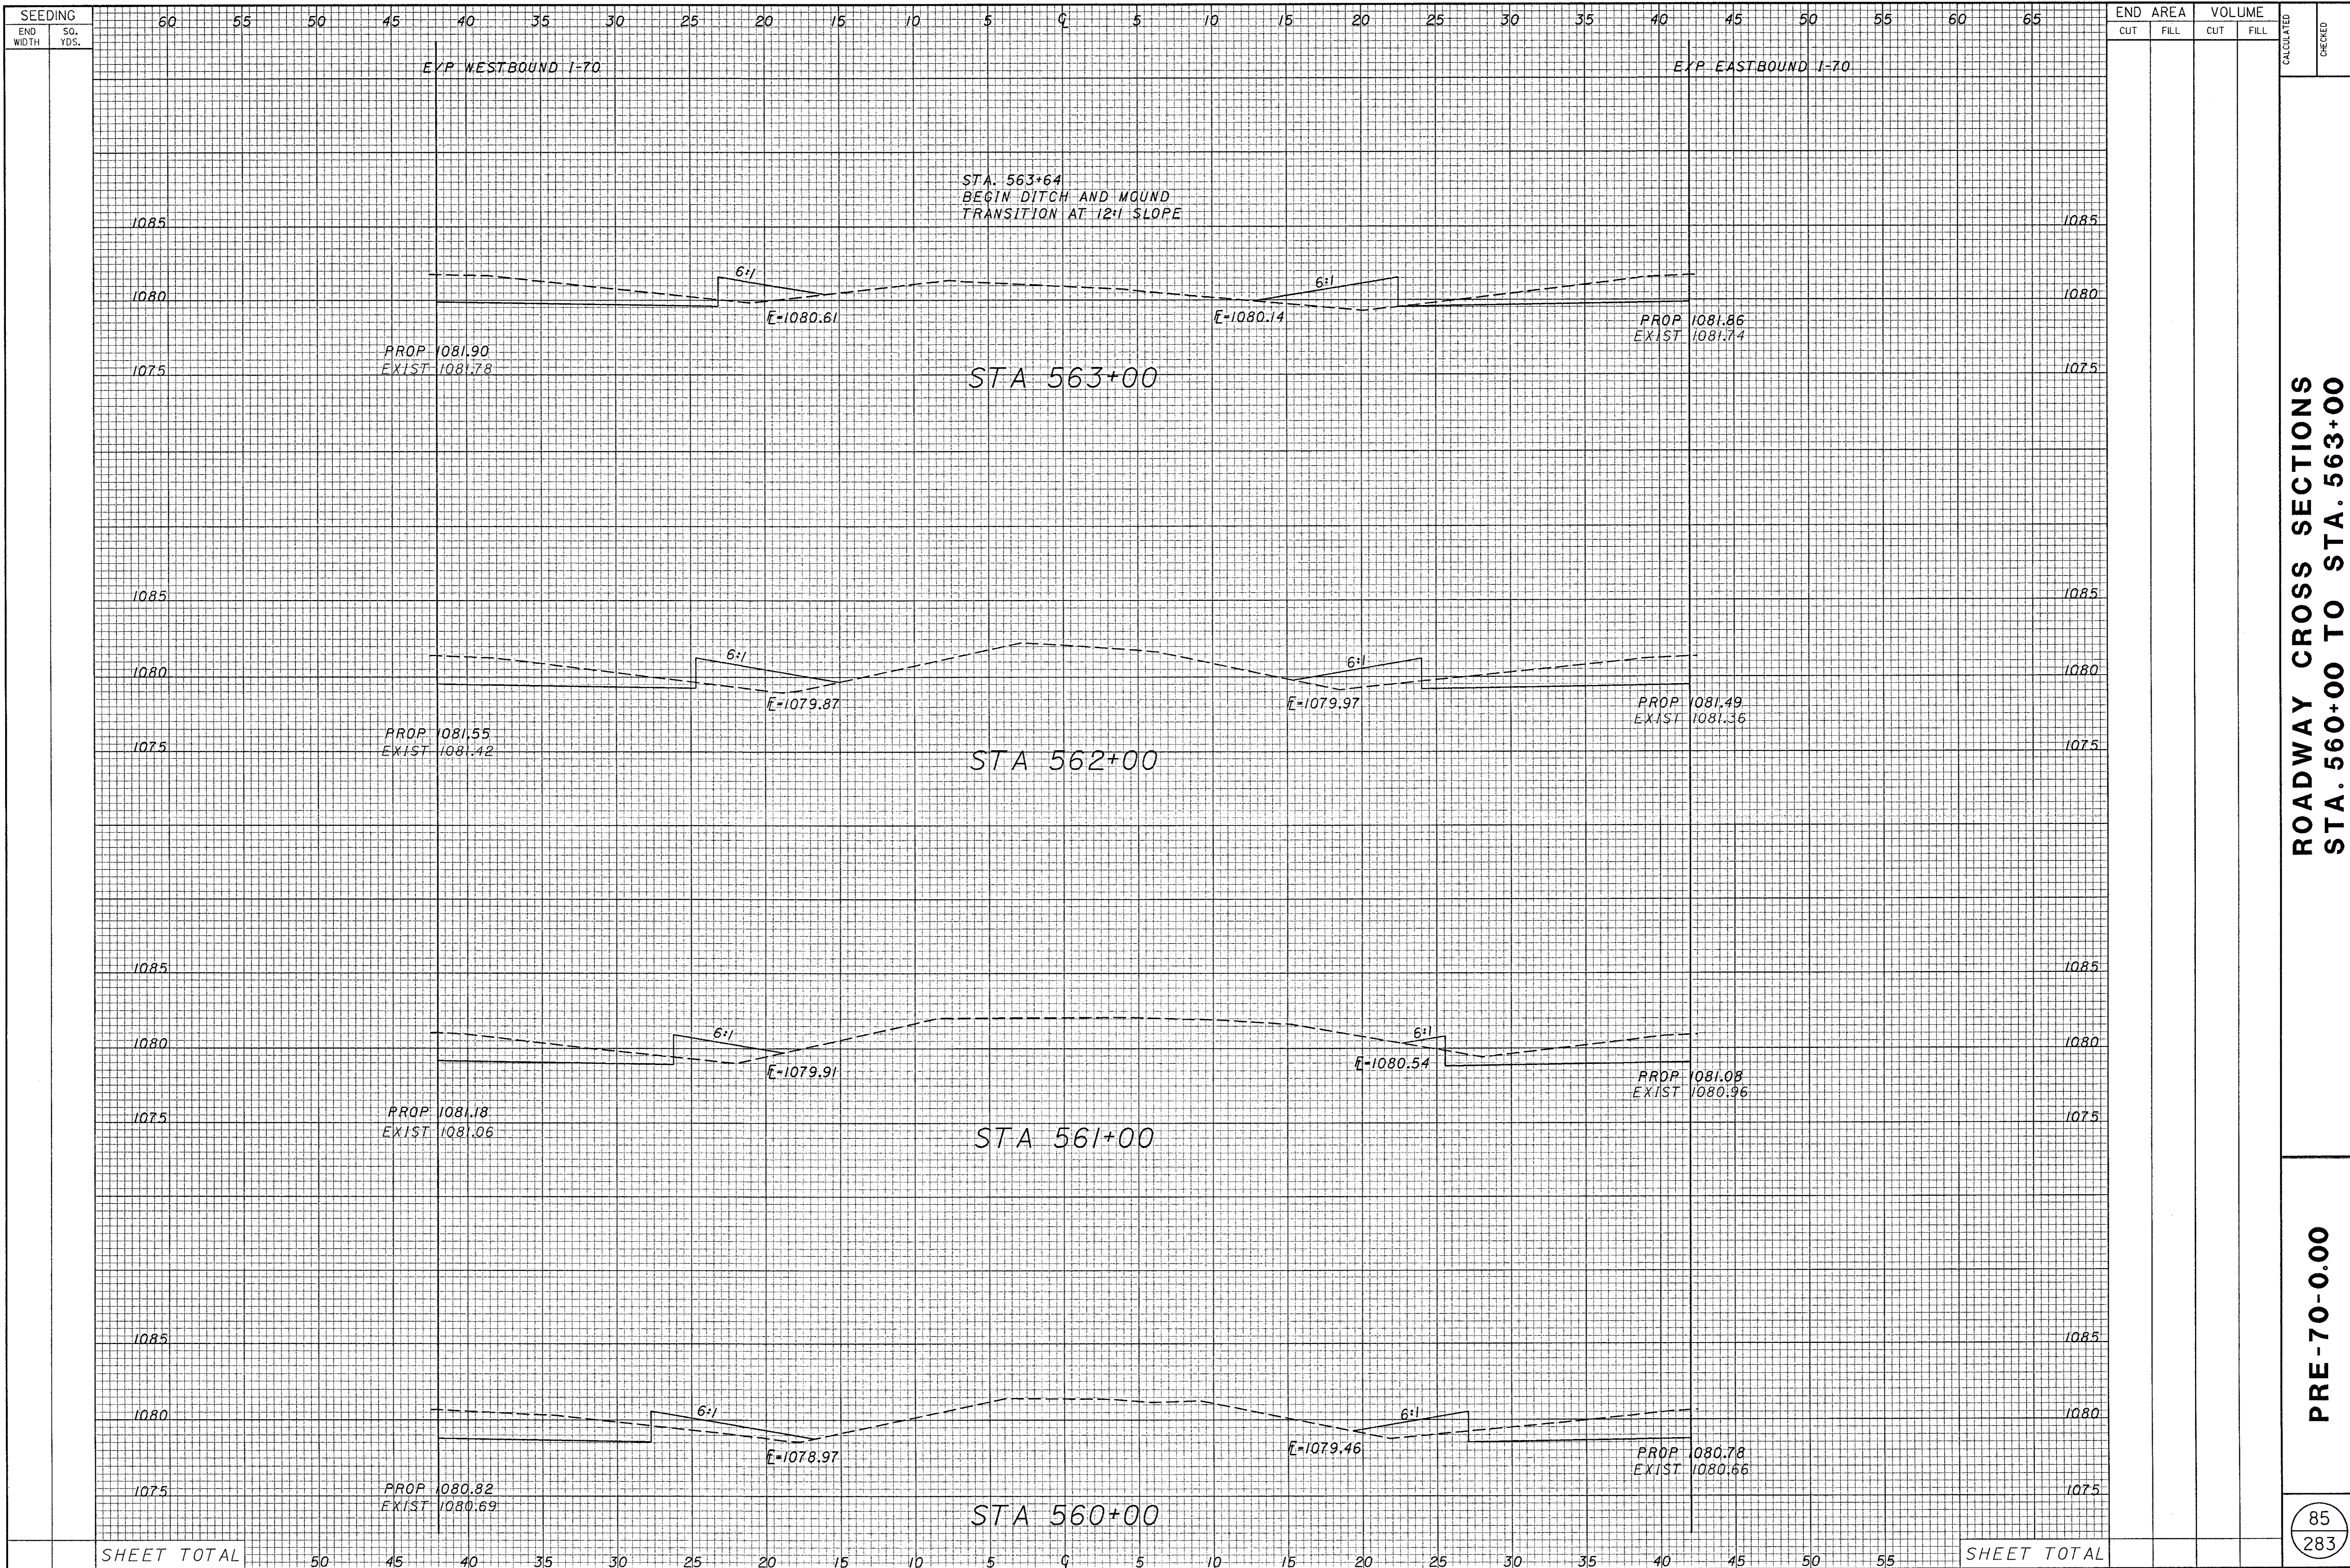

ROADWAY CROSS SECTIONS
STA. 560+00 TO STA. 563+00

PRE-70-0.00

85
283

SEEDING
END WIDTH SO. YDS.

END AREA VOLUME
CUT FILL CUT FILL
CALCULATED CHECKED

60 55 50 45 40 35 30 25 20 15 10 5 0 5 10 15 20 25 30 35 40 45 50 55 60 65

E/P WESTBOUND I-70

E/P EASTBOUND I-70

1085 1085

1080 1080

1075 1075

1085 1085

1080 1080

1075 1075

PROP 1082.61
EXIST 1082.45

STA 566+17.51

PROP 1082.46
EXIST 1082.48

PROP 1082.58
EXIST 1082.44

STA 566+06.74

PROP 1082.55
EXIST 1082.40

604. CATCH BASIN RECONSTRUCTED
TO GRADE
STA. 565+93.0
GRATE ELEV. = 1079.60
EX. GRATE ELEV. = 1078.22

PROP 1082.57
EXIST 1082.44

STA 566+00

PROP 1082.53
EXIST 1082.38

PROP 1082.23
EXIST 1082.10

STA 565+00

PROP 1082.23
EXIST 1082.10

STA. 564+00
END DITCH AND MOUND
TRANSITION

PROP 1082.17
EXIST 1082.05

STA 564+00

PROP 1082.05
EXIST 1081.93

SHEET TOTAL

SHEET TOTAL

ROADWAY CROSS SECTIONS
STA. 564+00 TO STA. 566+17.51


PRE-70-0.00

86
283

SEEDING
END WIDTH SQ. YDS.

END AREA VOLUME
CUT FILL CUT FILL

CALCULATED
CHECKED

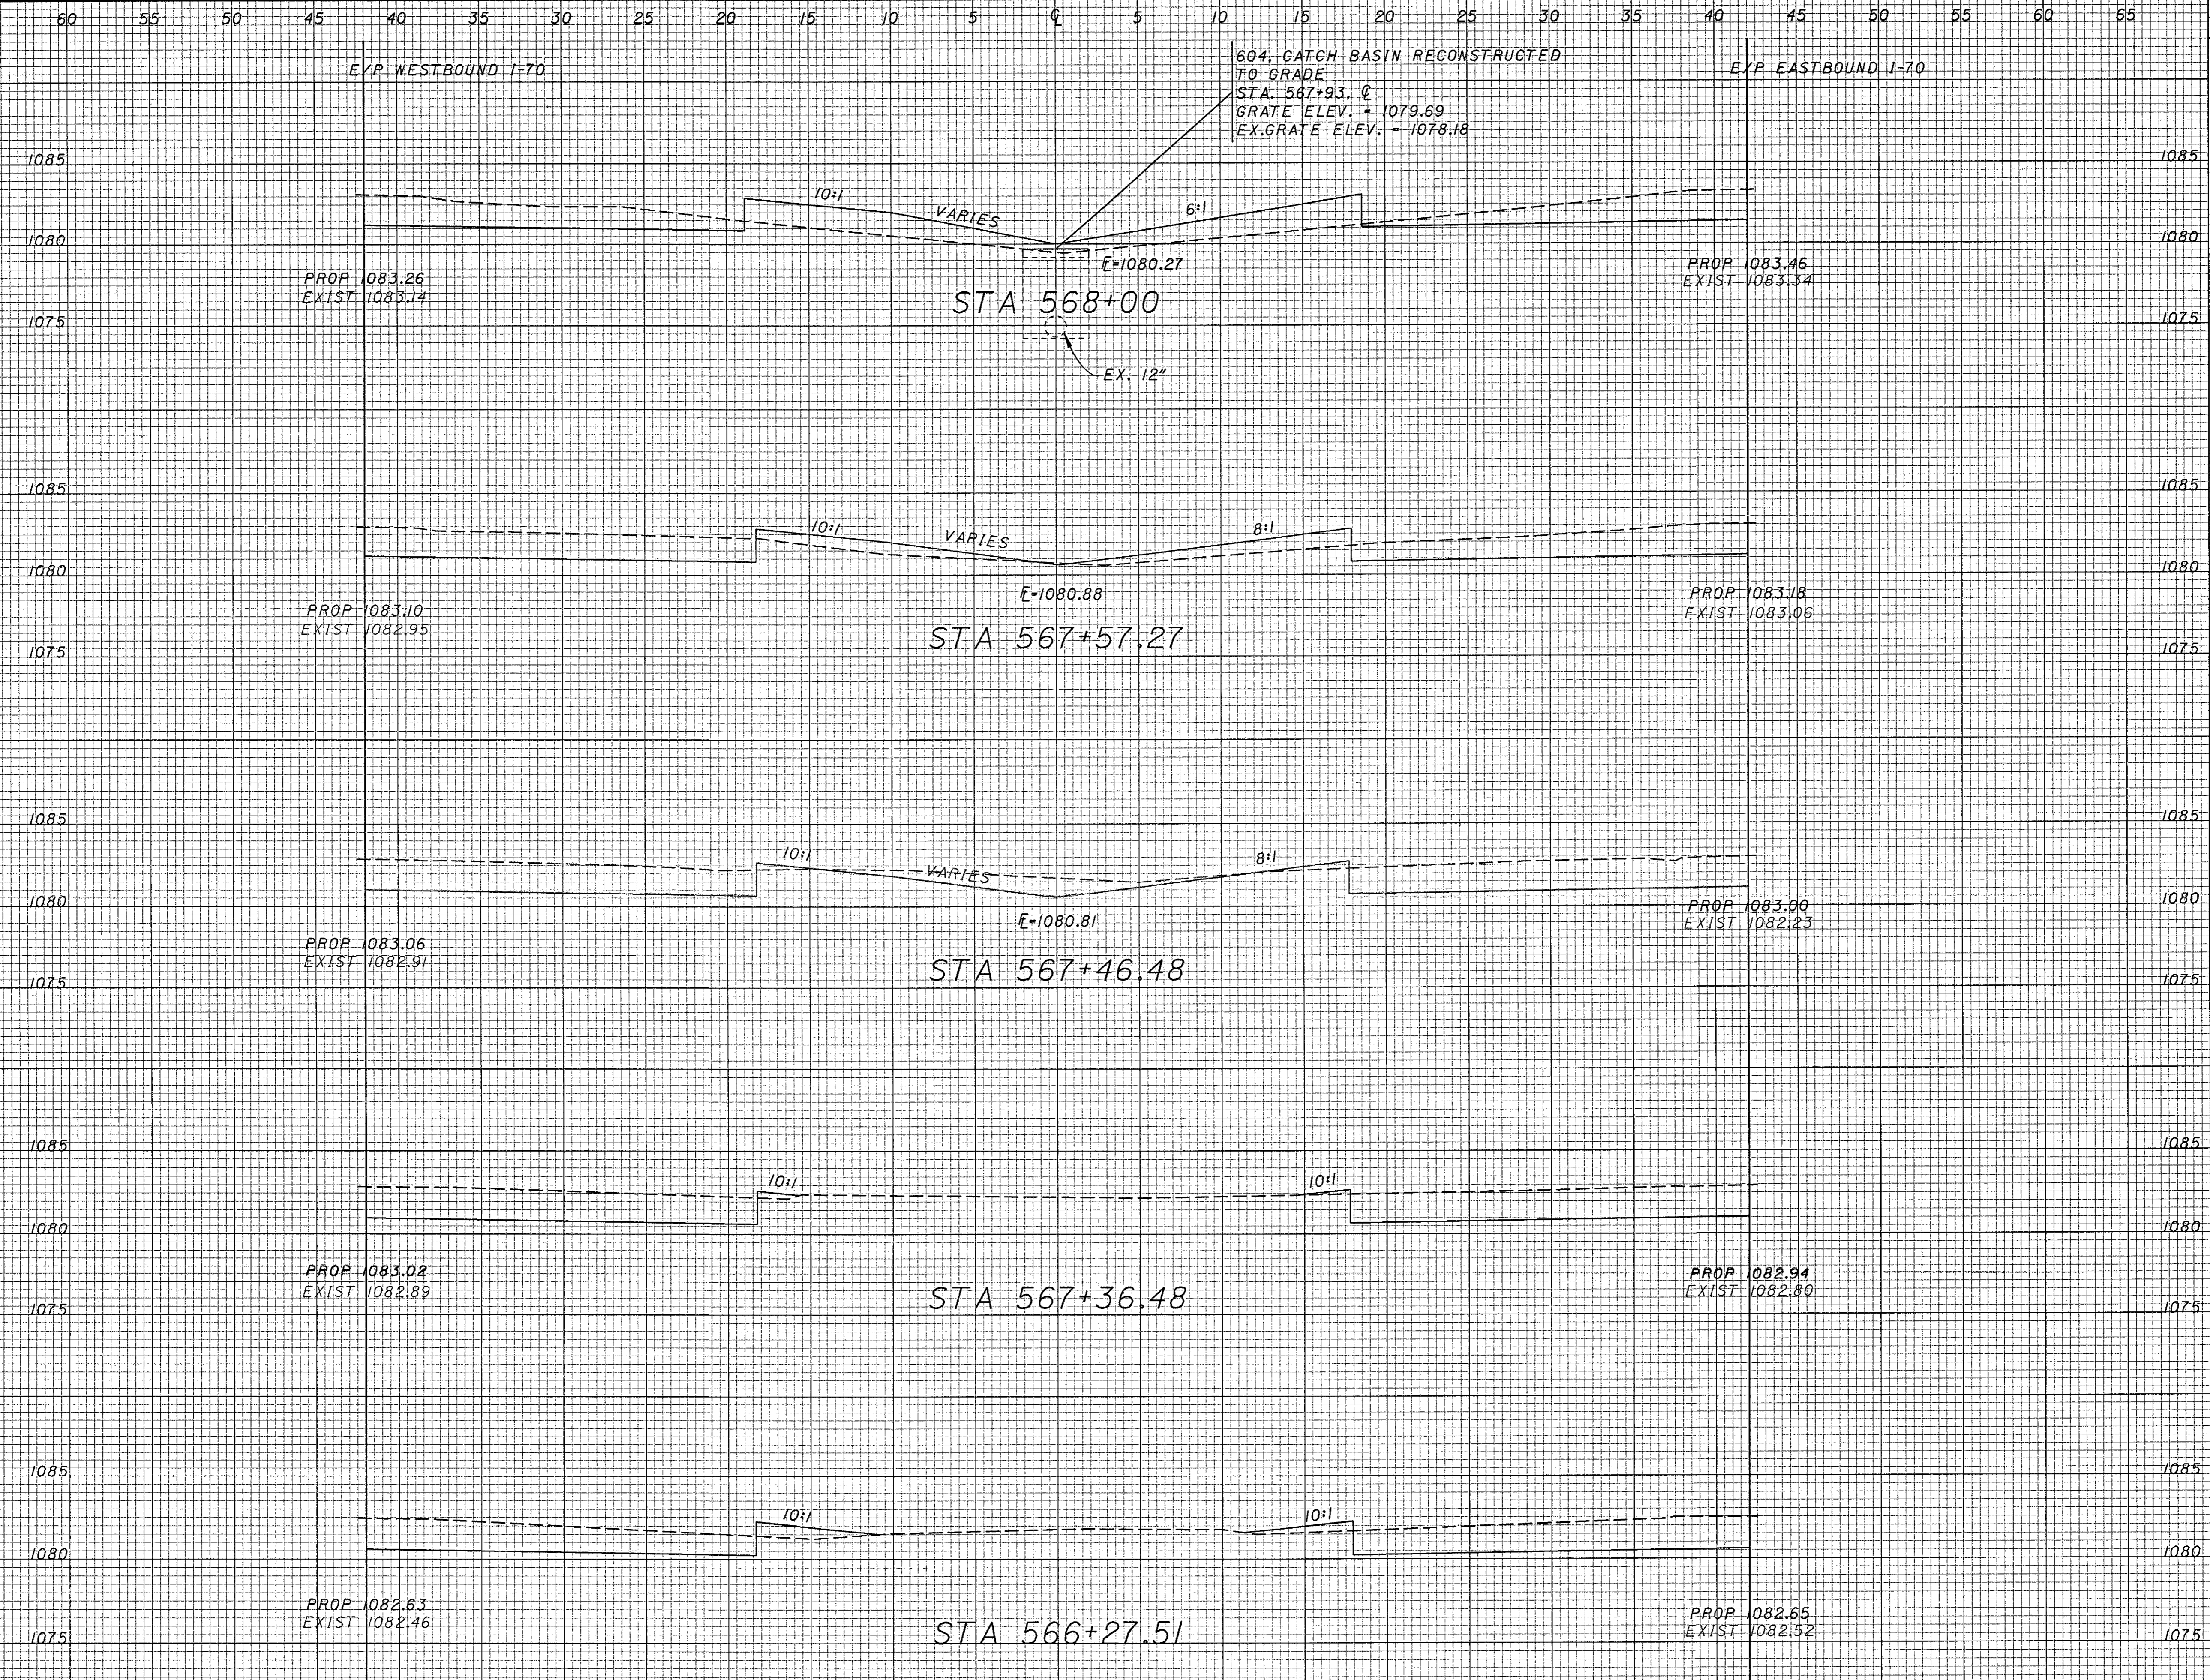


SHEET TOTAL

SHEET TOTAL

ROADWAY CROSS SECTIONS
STA. 566+27.51 TO STA. 568+00

PRE-70-0.00

87
283

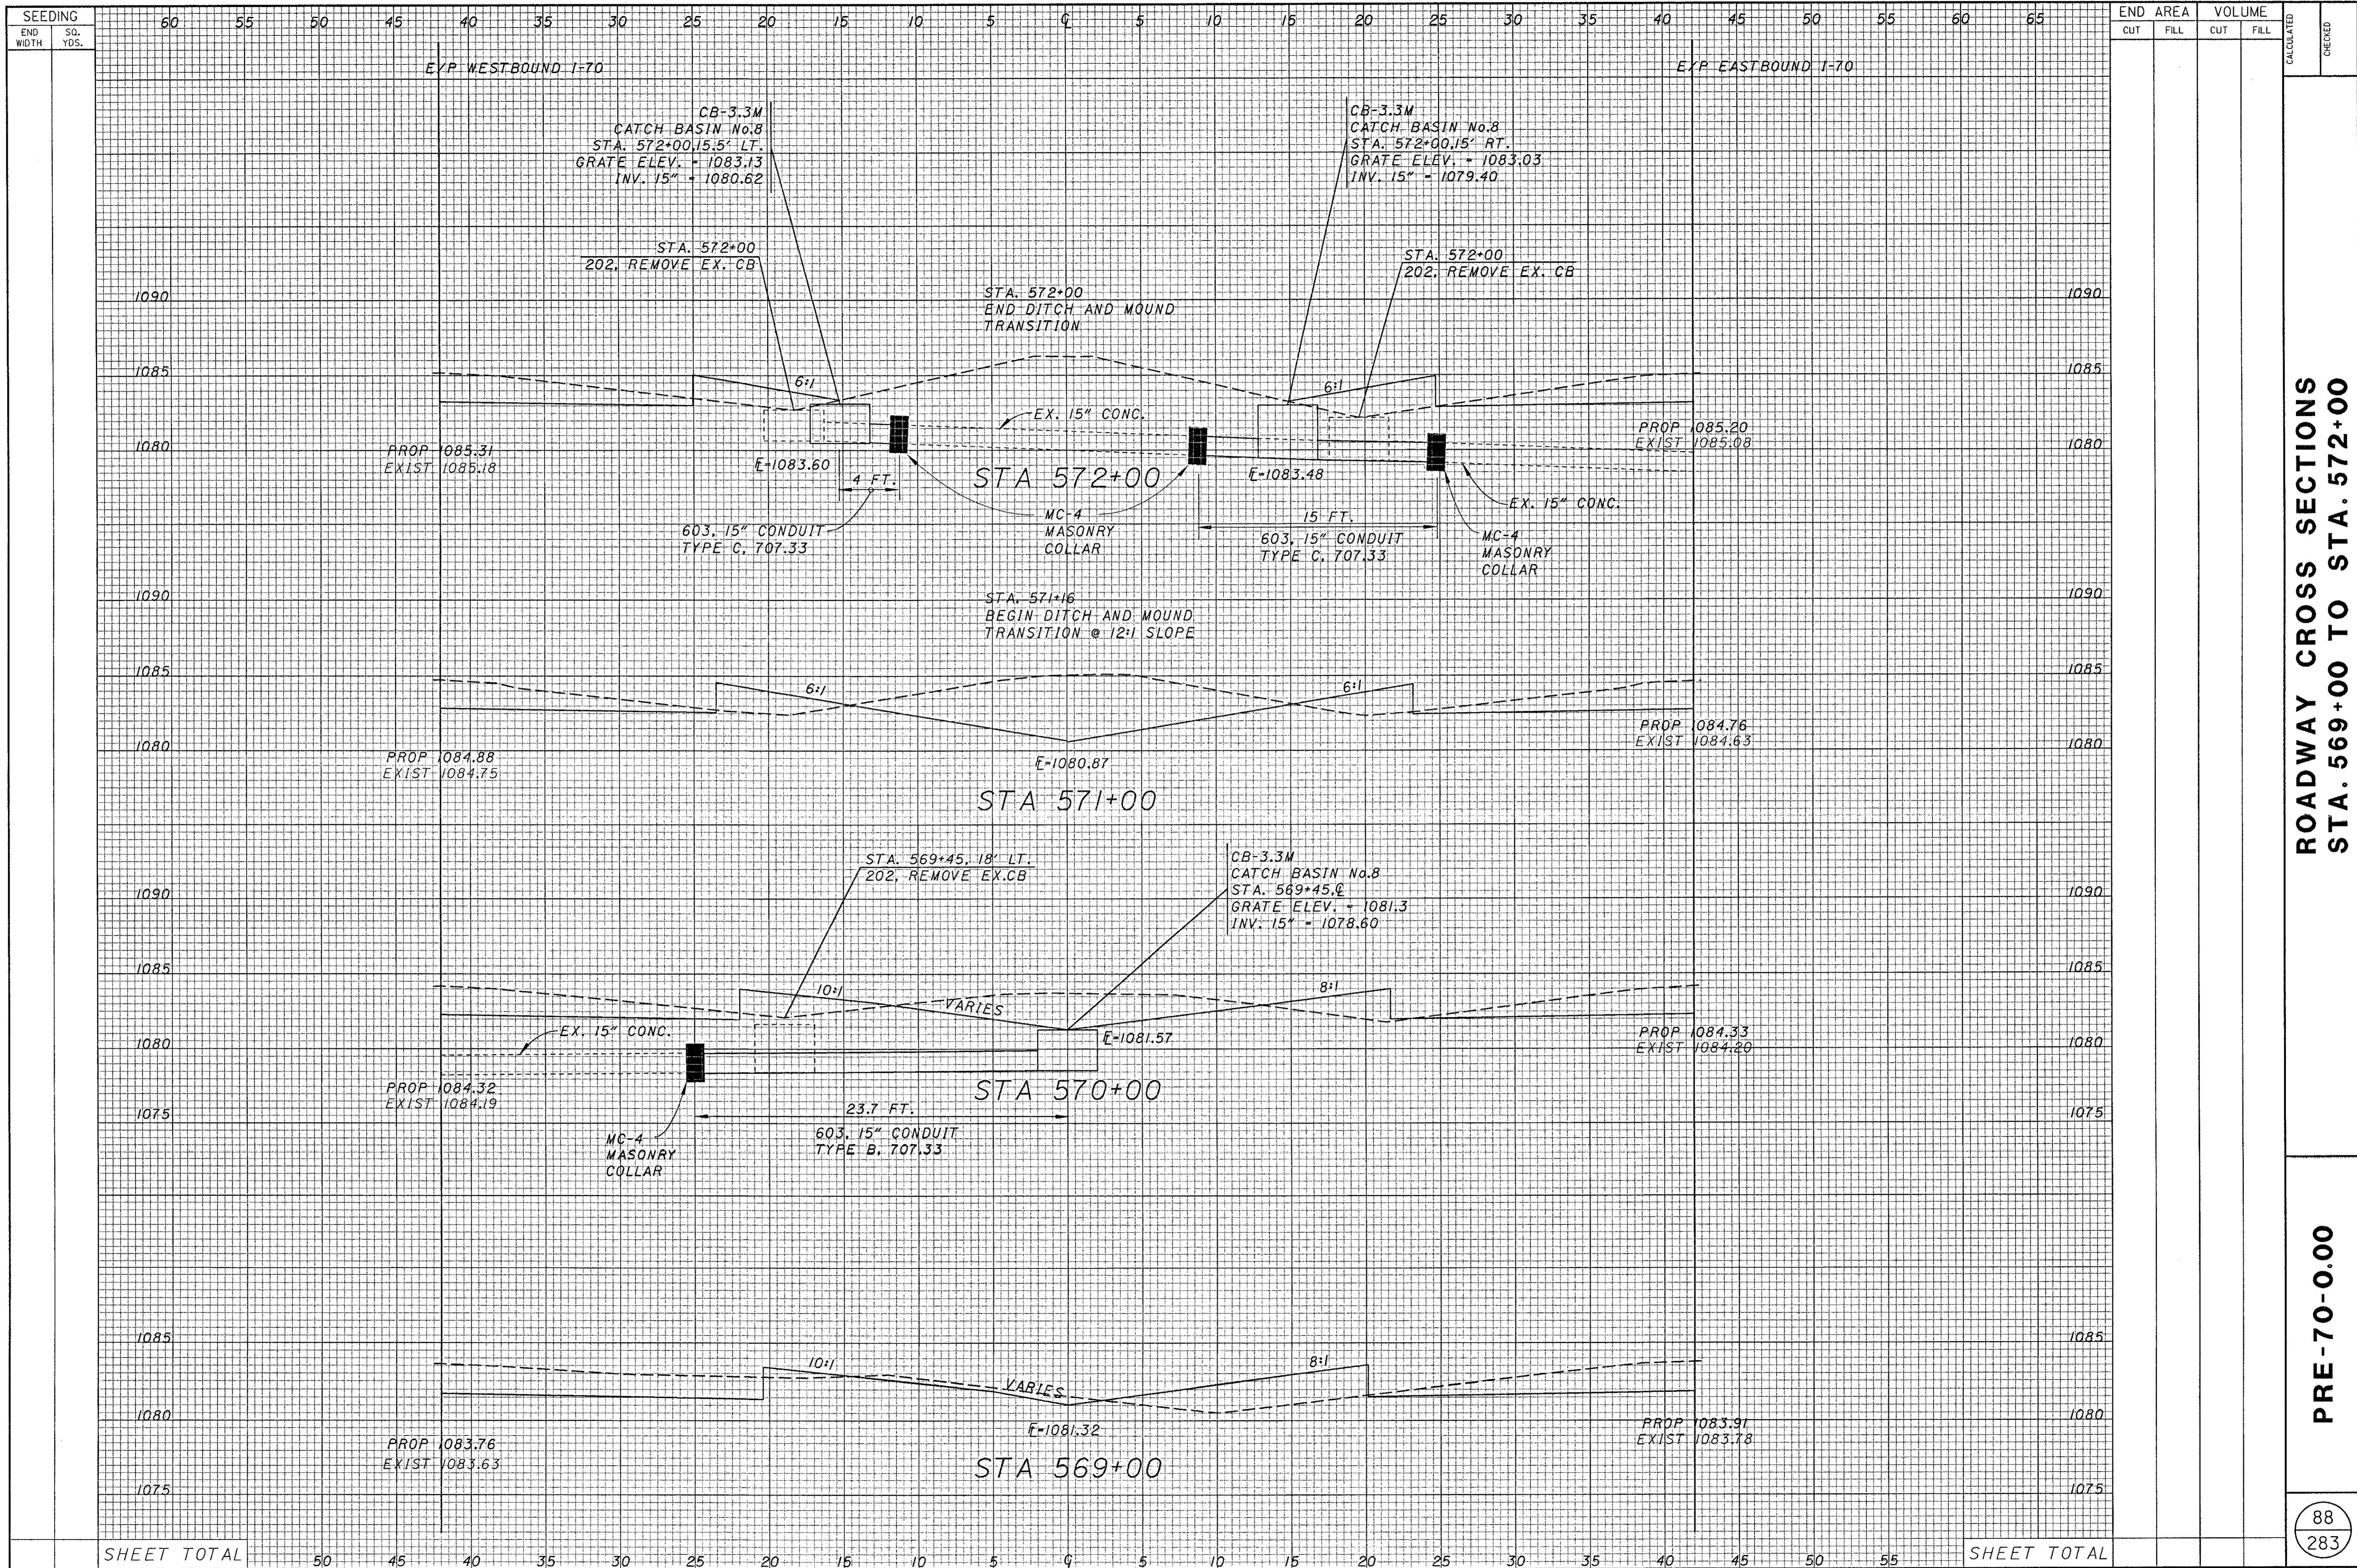

**ROADWAY CROSS SECTIONS
STA. 569+00 TO STA. 572+00**


PRE-70-0.00

END AREA		VOLUME	
CUT	FILL	CUT	FILL

CALCULATED		CHECKED	

SEEDING
END WIDTH SQ. YDS.

END AREA VOLUME
CUT FILL CUT FILL
CALCULATED CHECKED

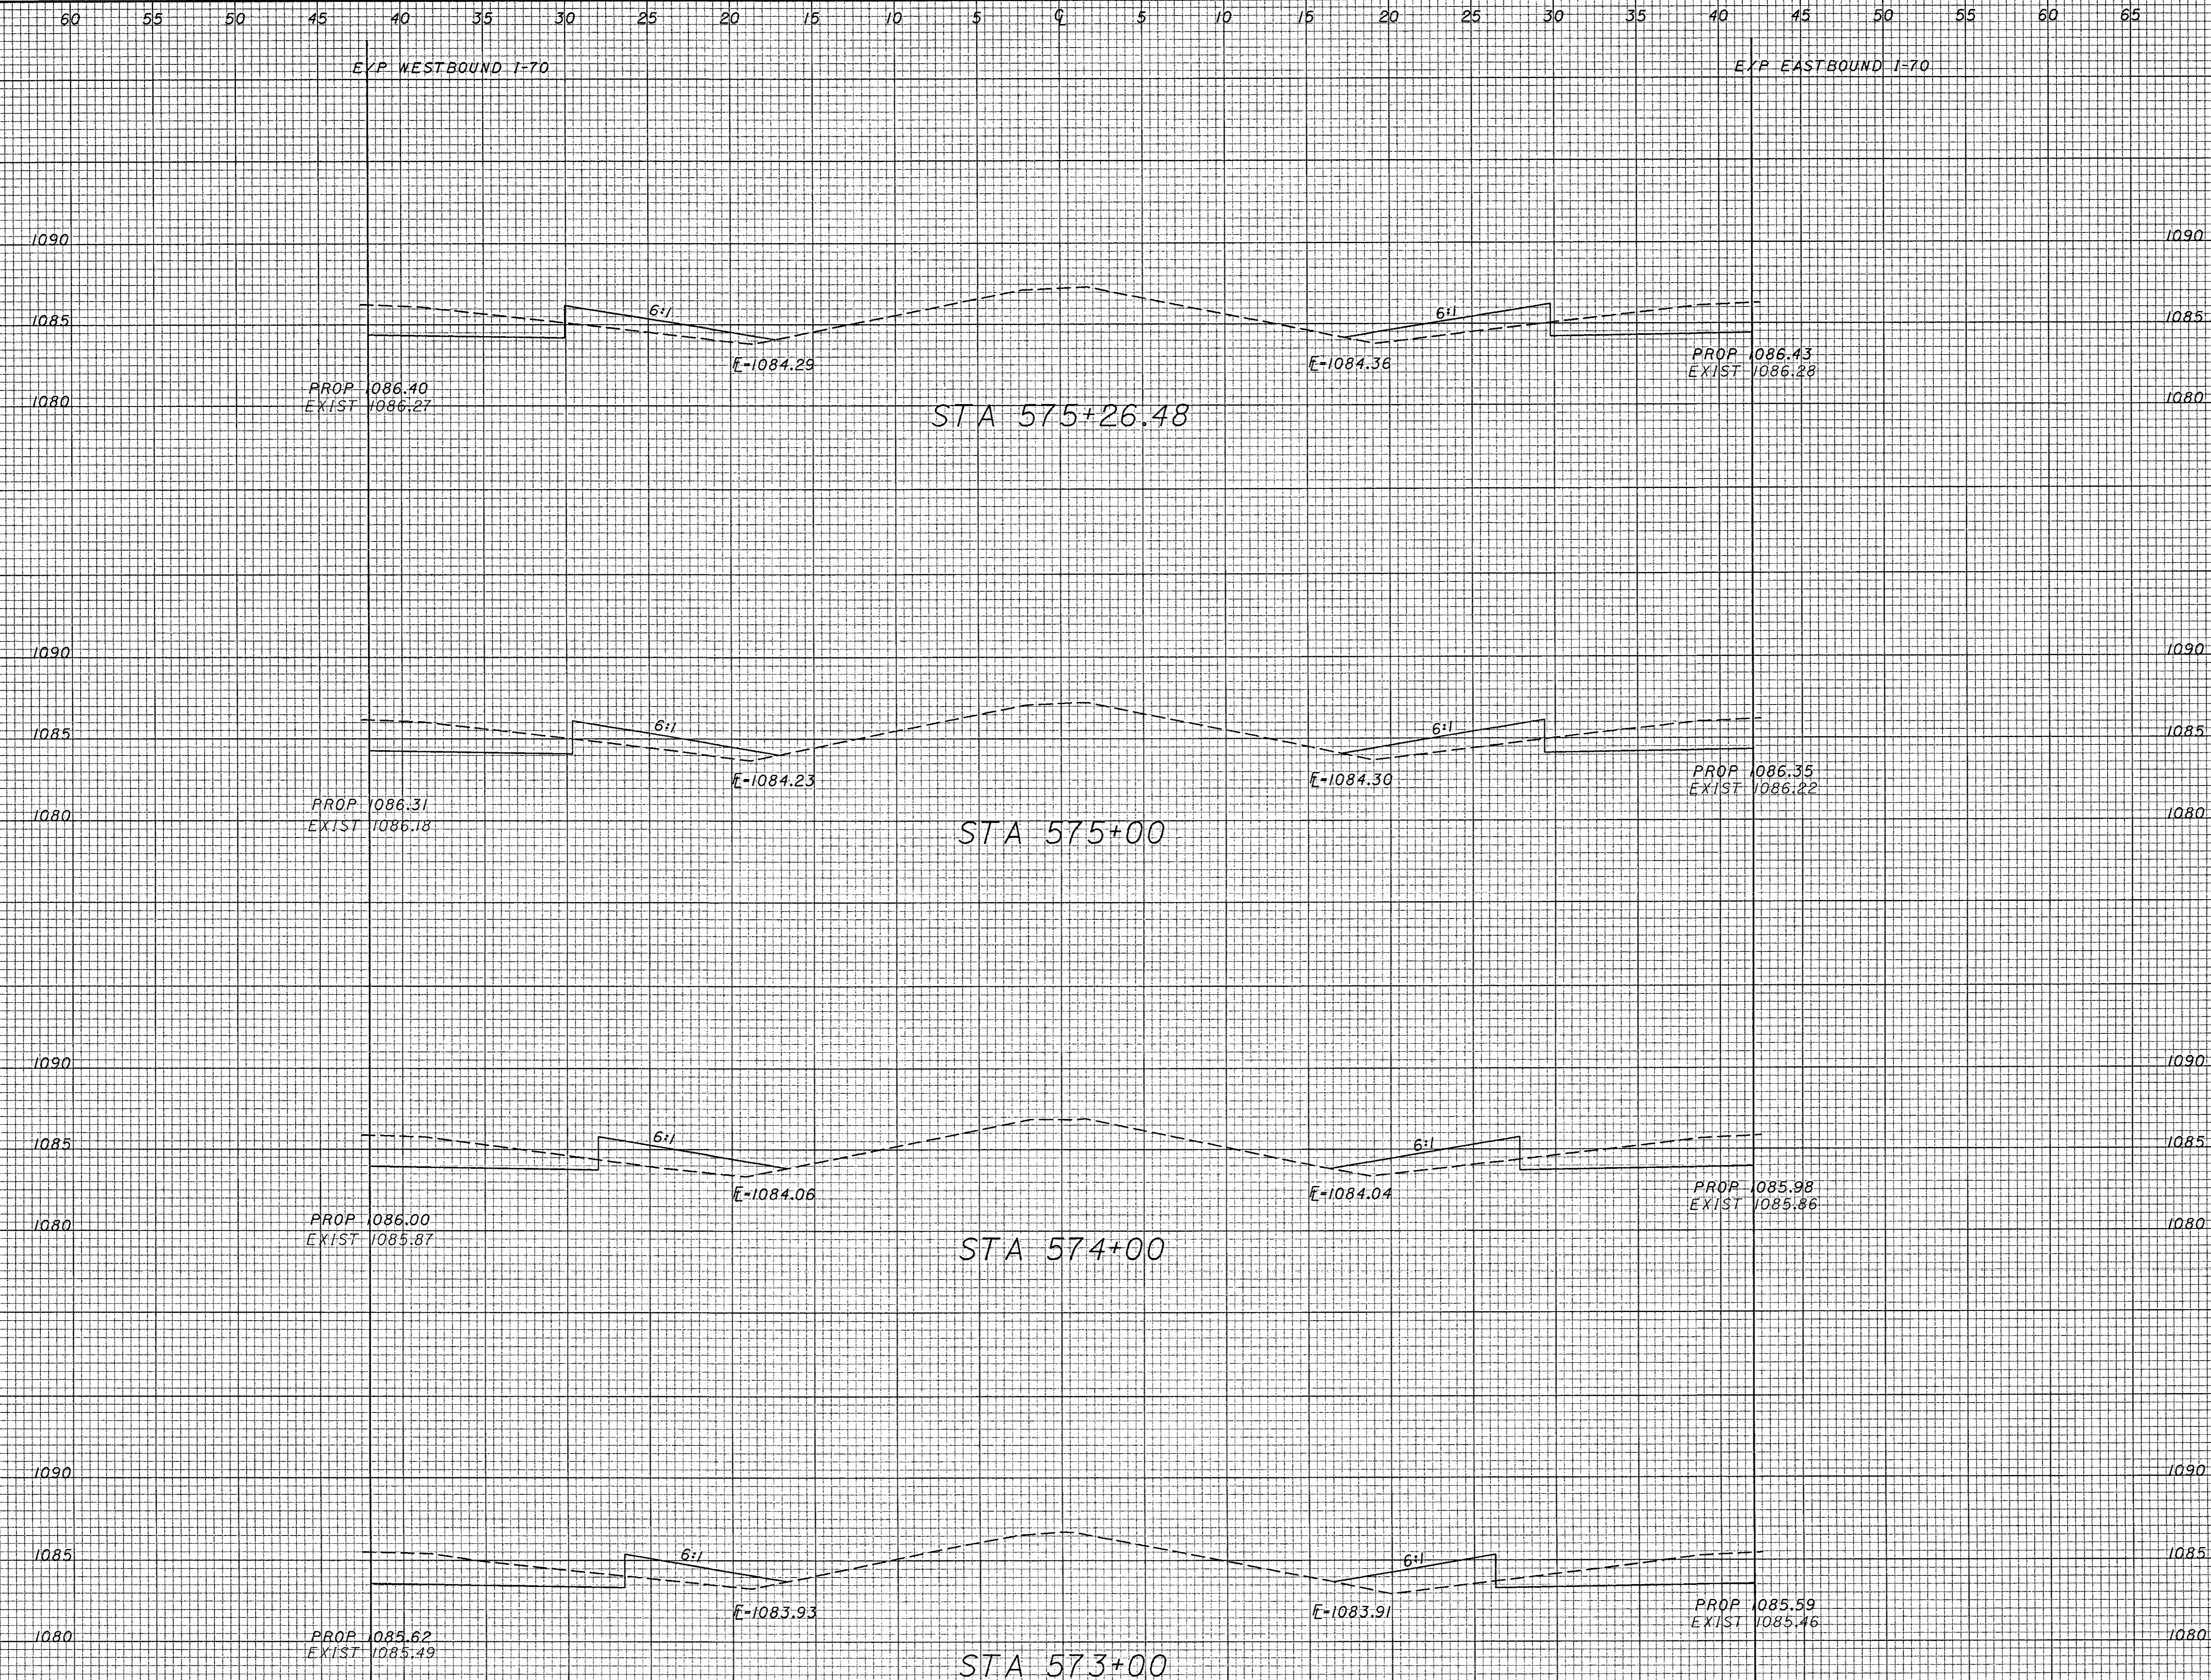


SHEET TOTAL

SHEET TOTAL

ROADWAY CROSS SECTIONS
STA. 573+00 TO STA. 575+26.48

PRE-70-0.00

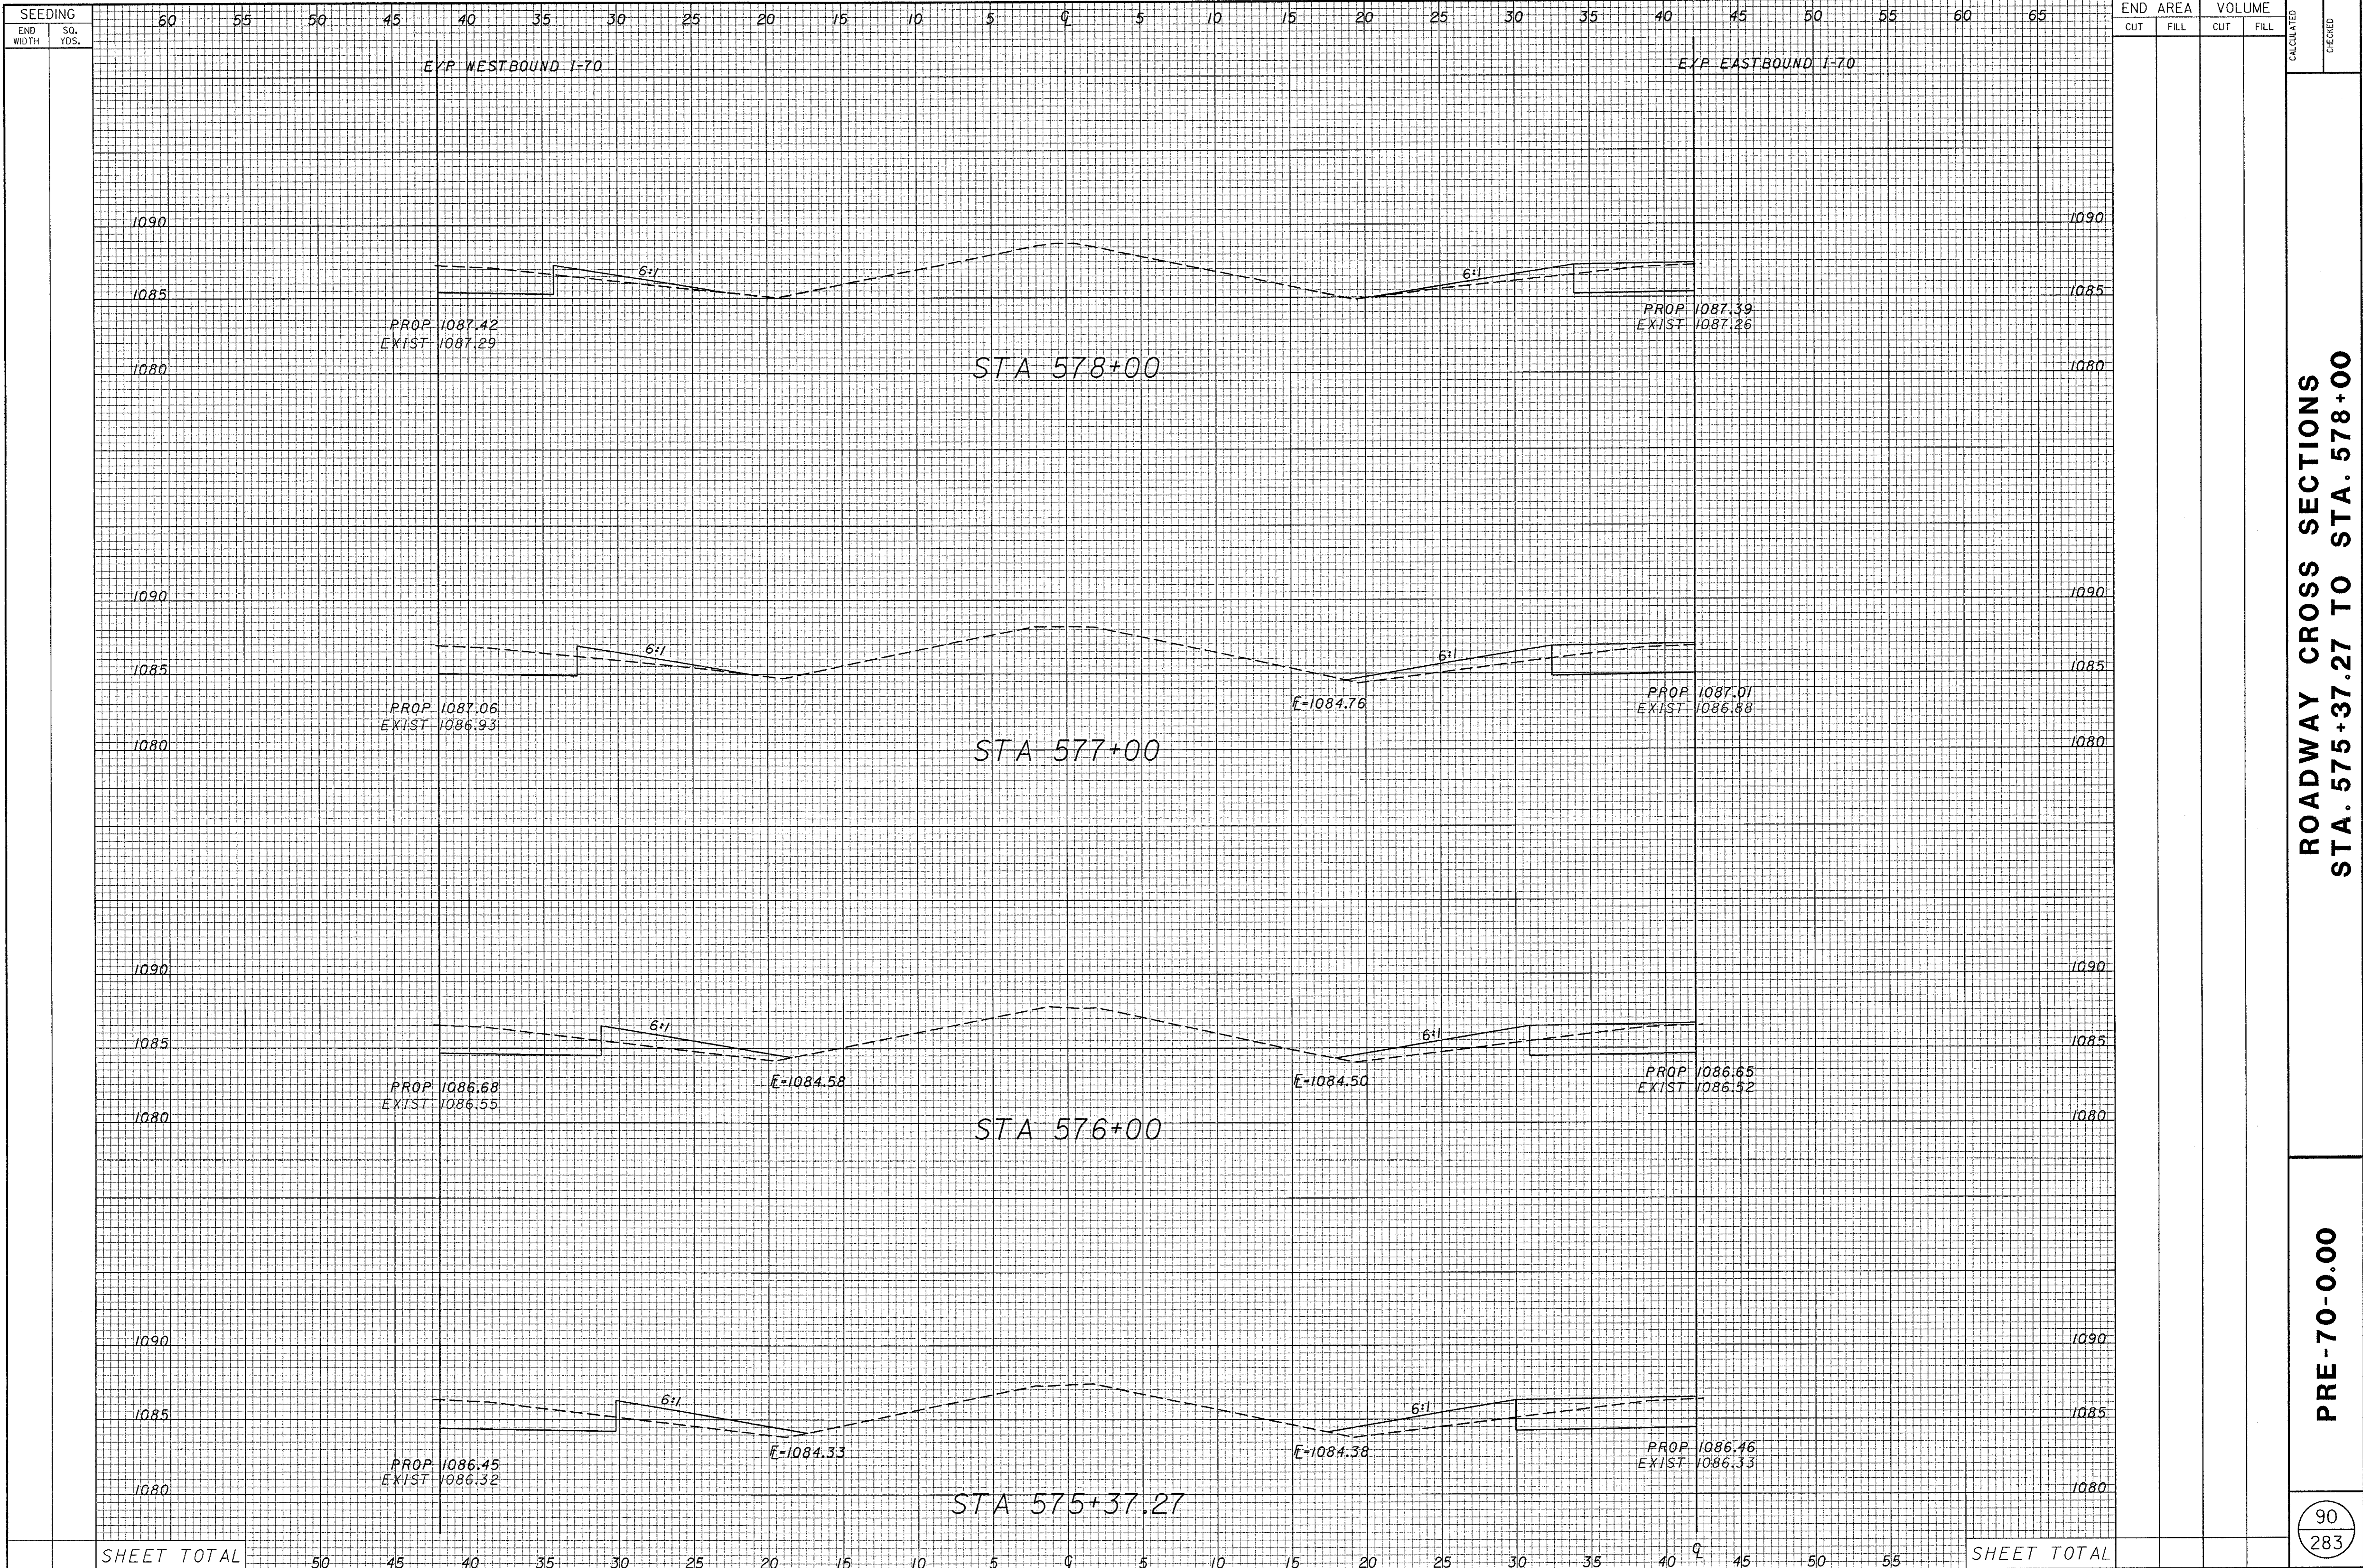

ROADWAY CROSS SECTIONS
STA. 575+37.27 TO STA. 578+00

PRE-70-0.00

90
283

SEEDING	
END WIDTH	SO. YDS.


60 55 50 45 40 35 30 25 20 15 10 5 0 5 10 15 20 25 30 35 40 45 50 55 60 65

END AREA		VOLUME	
CUT	FILL	CUT	FILL


CALCULATED	CHECKED
------------	---------

E/P WESTBOUND I-70


E/P EASTBOUND I-70

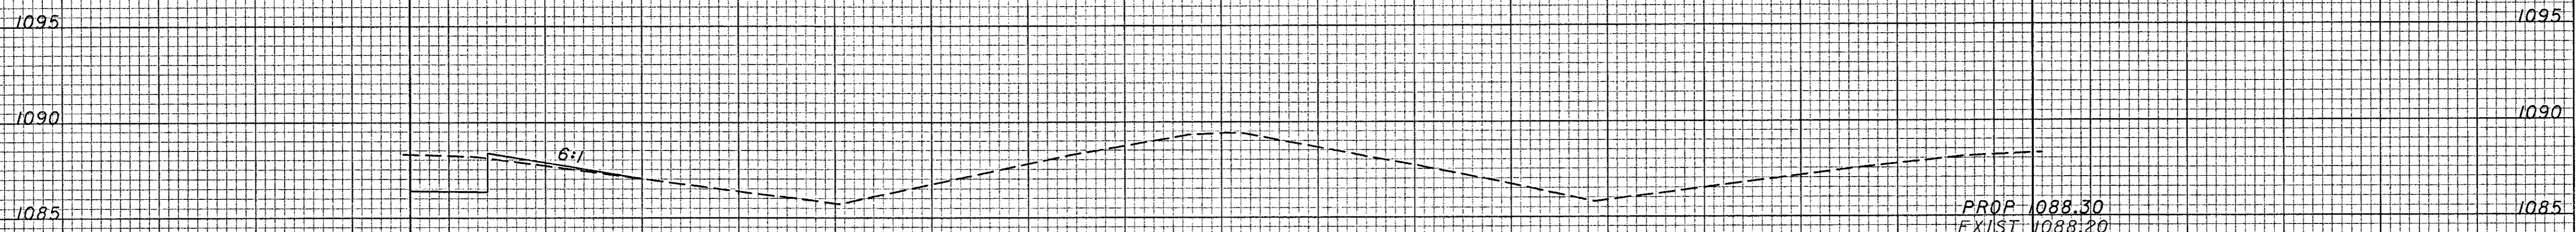


STA 580+57.27

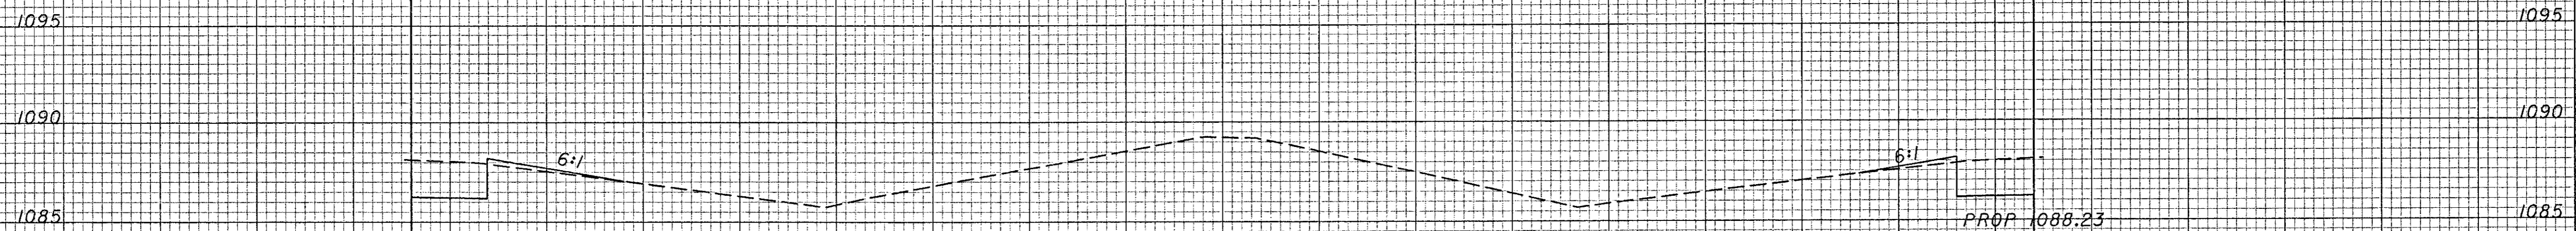

STA 580+46.48

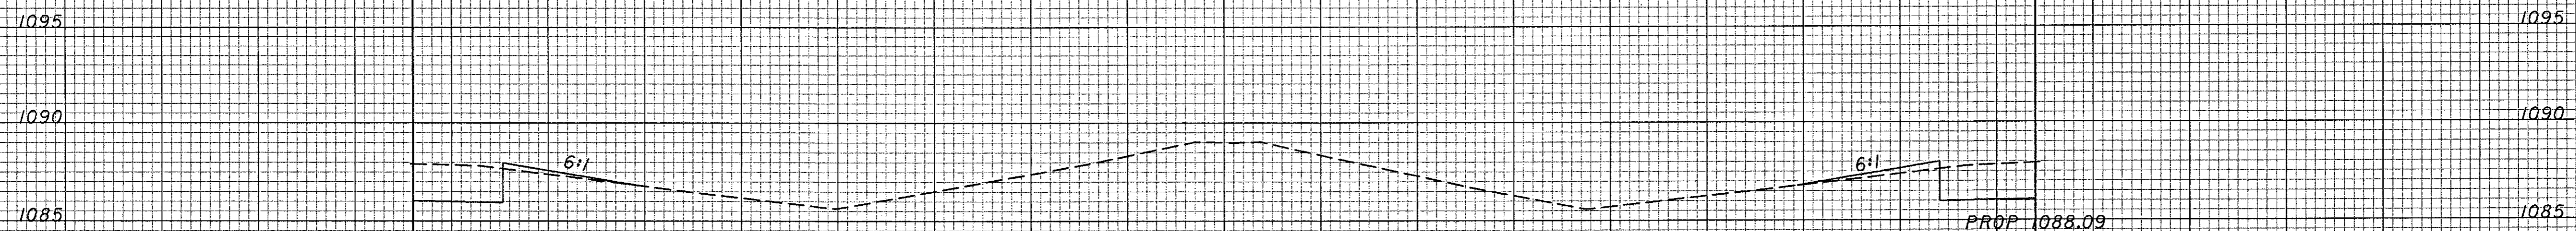

STA 580+00

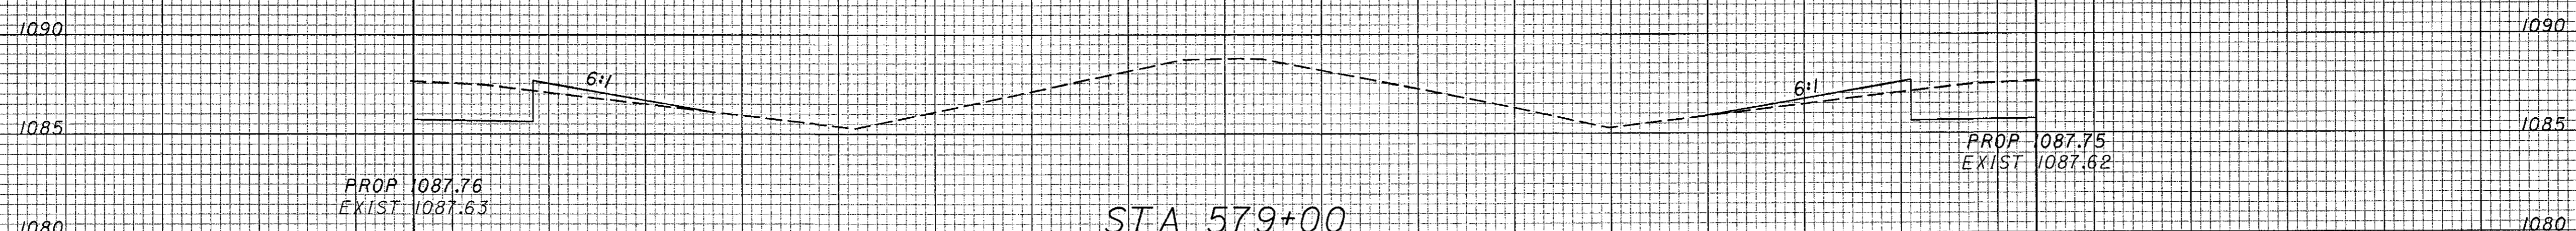

STA 579+00

SHEET TOTAL

50 45 40 35 30 25 20 15 10 5 0 5 10 15 20 25 30 35 40 45 50 55

SHEET TOTAL

ROADWAY CROSS SECTIONS
STA. 579+00 TO STA. 580+57.27

PRE-70-0.00

91
283

SEEDING	
END WIDTH	SQ. YDS.


END AREA		VOLUME	
CUT	FILL	CUT	FILL

CALCULATED	CHECKED
------------	---------

ROADWAY CROSS SECTIONS
STA. 646+54.29 TO STA. 649+00


PRE-70-0.00

92
283

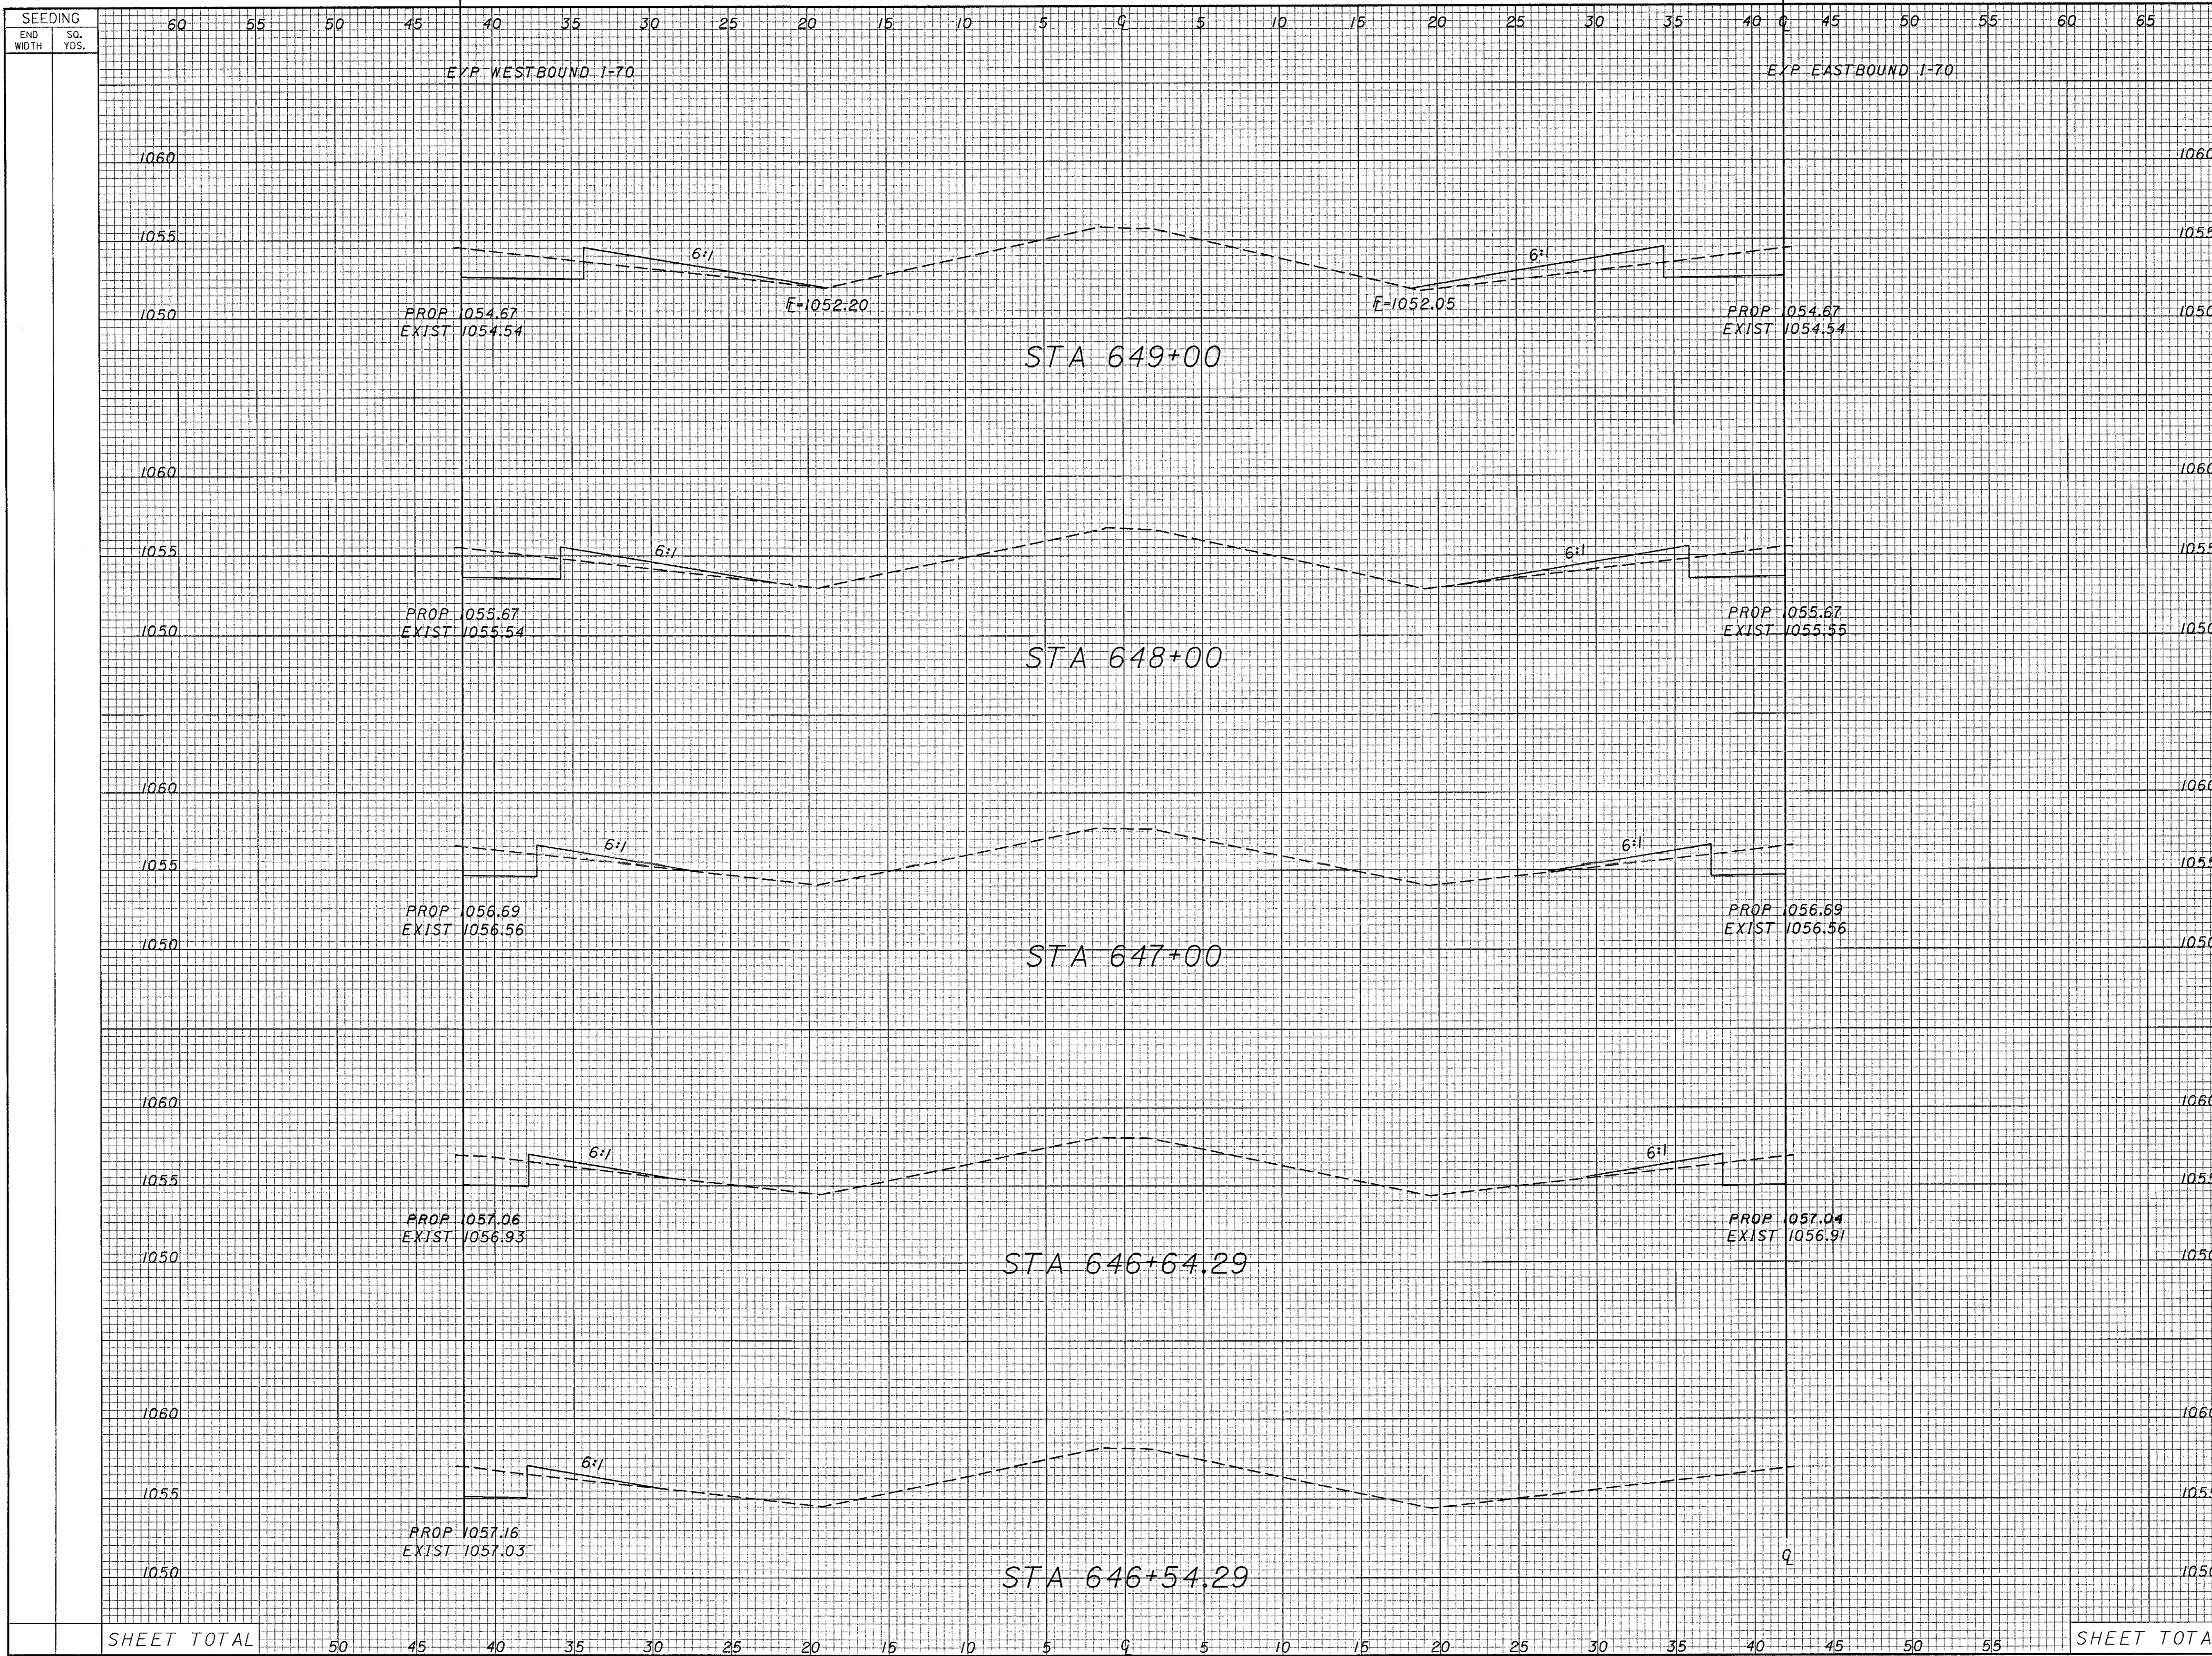

SHEET TOTAL

SHEET TOTAL

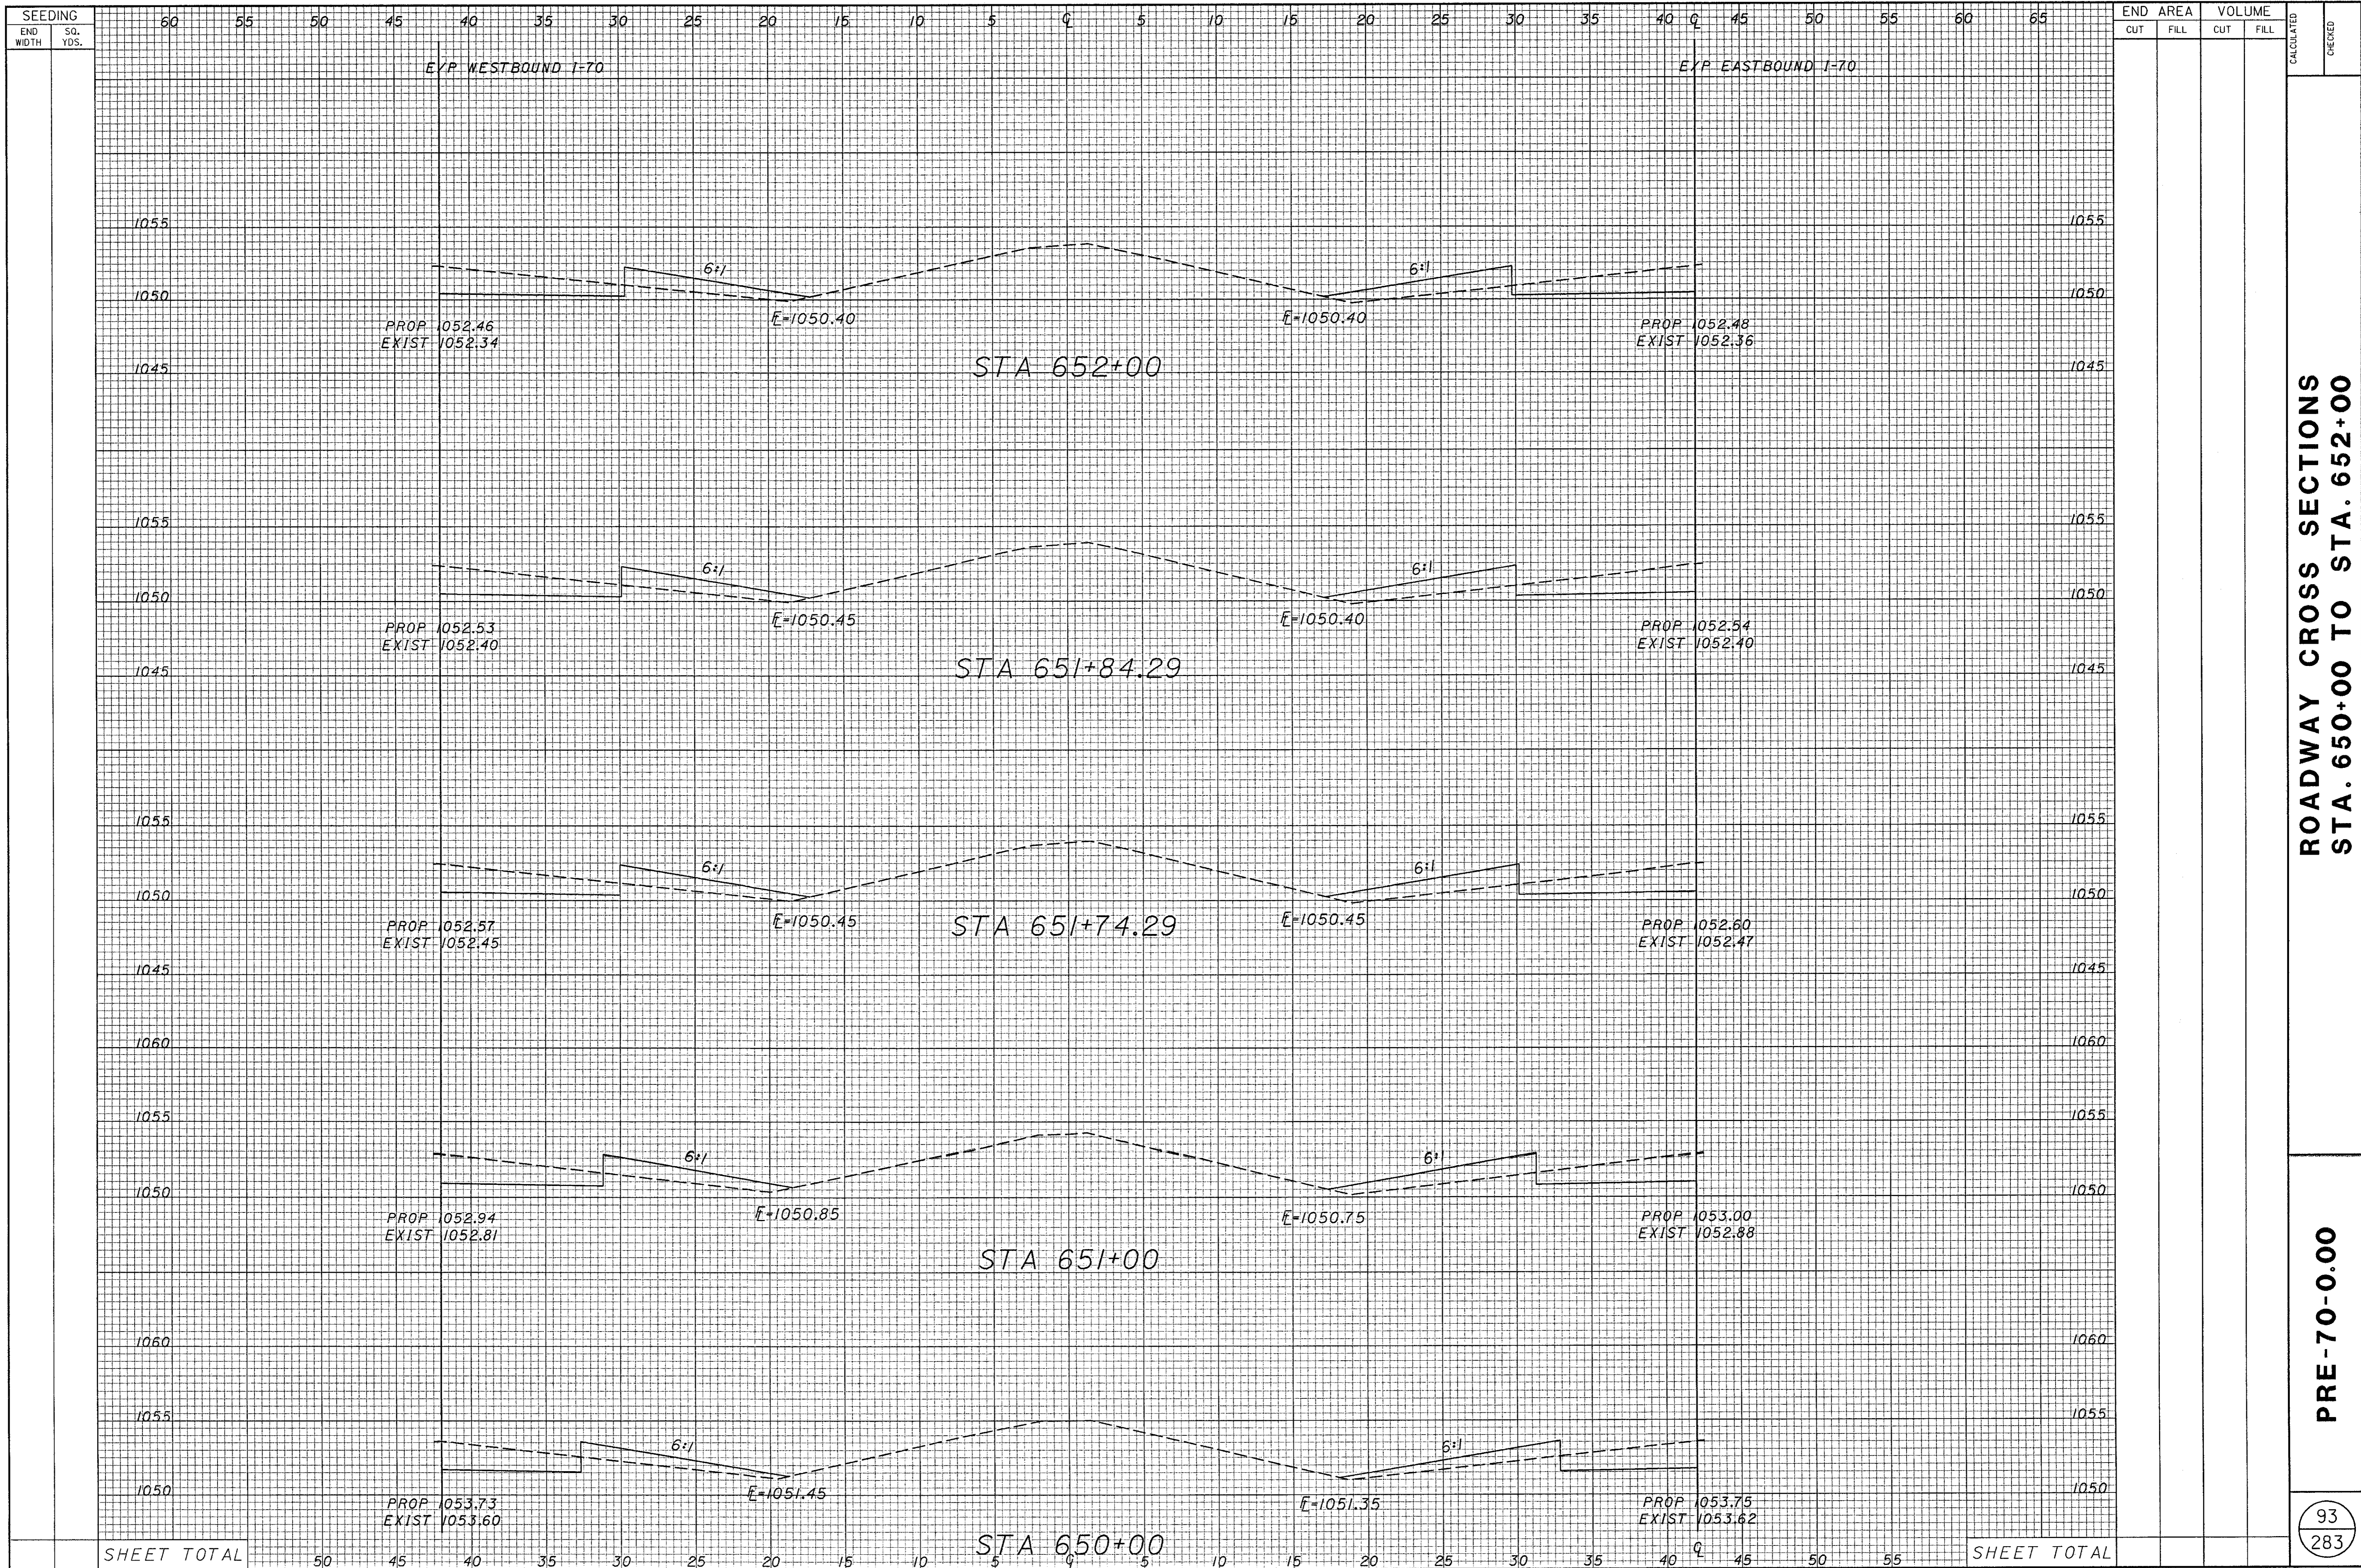


ROADWAY CROSS SECTIONS
 STA. 650+00 TO STA. 652+00

PRE-70-0.00

93
 283

SEEDING
END WIDTH SQ. YDS.

END AREA VOLUME
CUT FILL CUT FILL
CALCULATED CHECKED

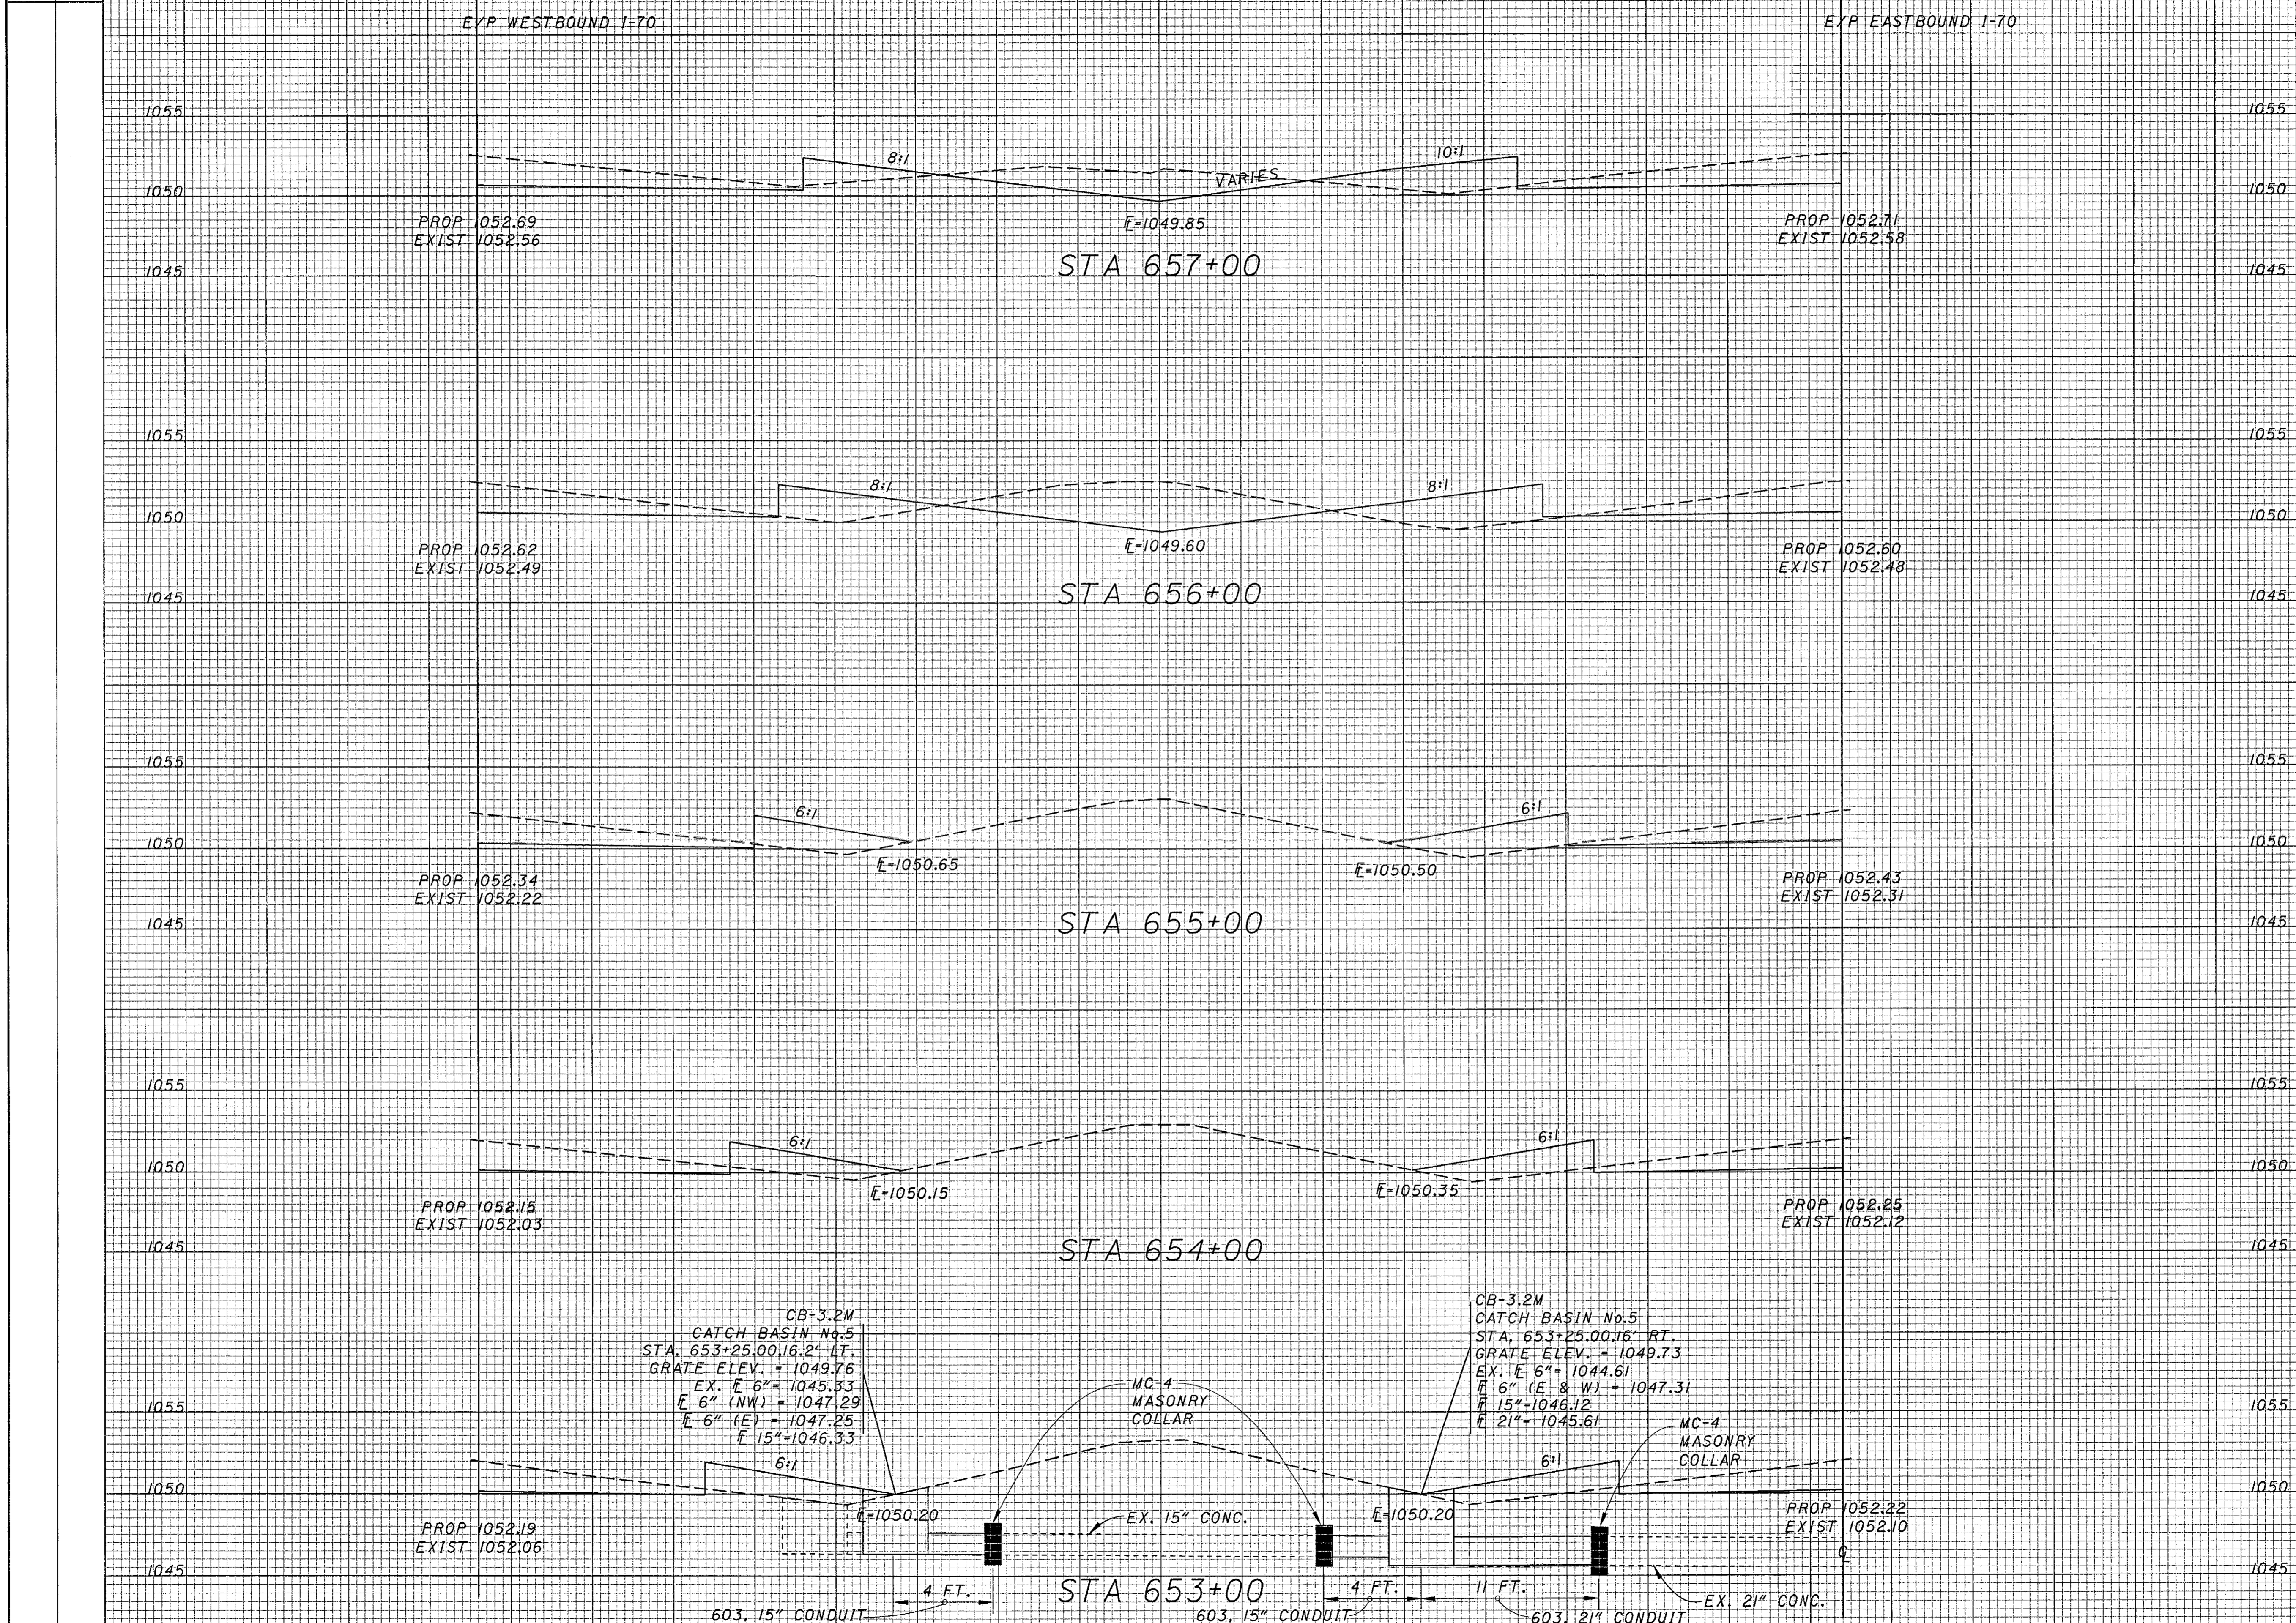


SHEET TOTAL

SHEET TOTAL

ROADWAY CROSS SECTIONS
STA. 653+00 TO STA. 675+00

PRE-70-0.00

94
283

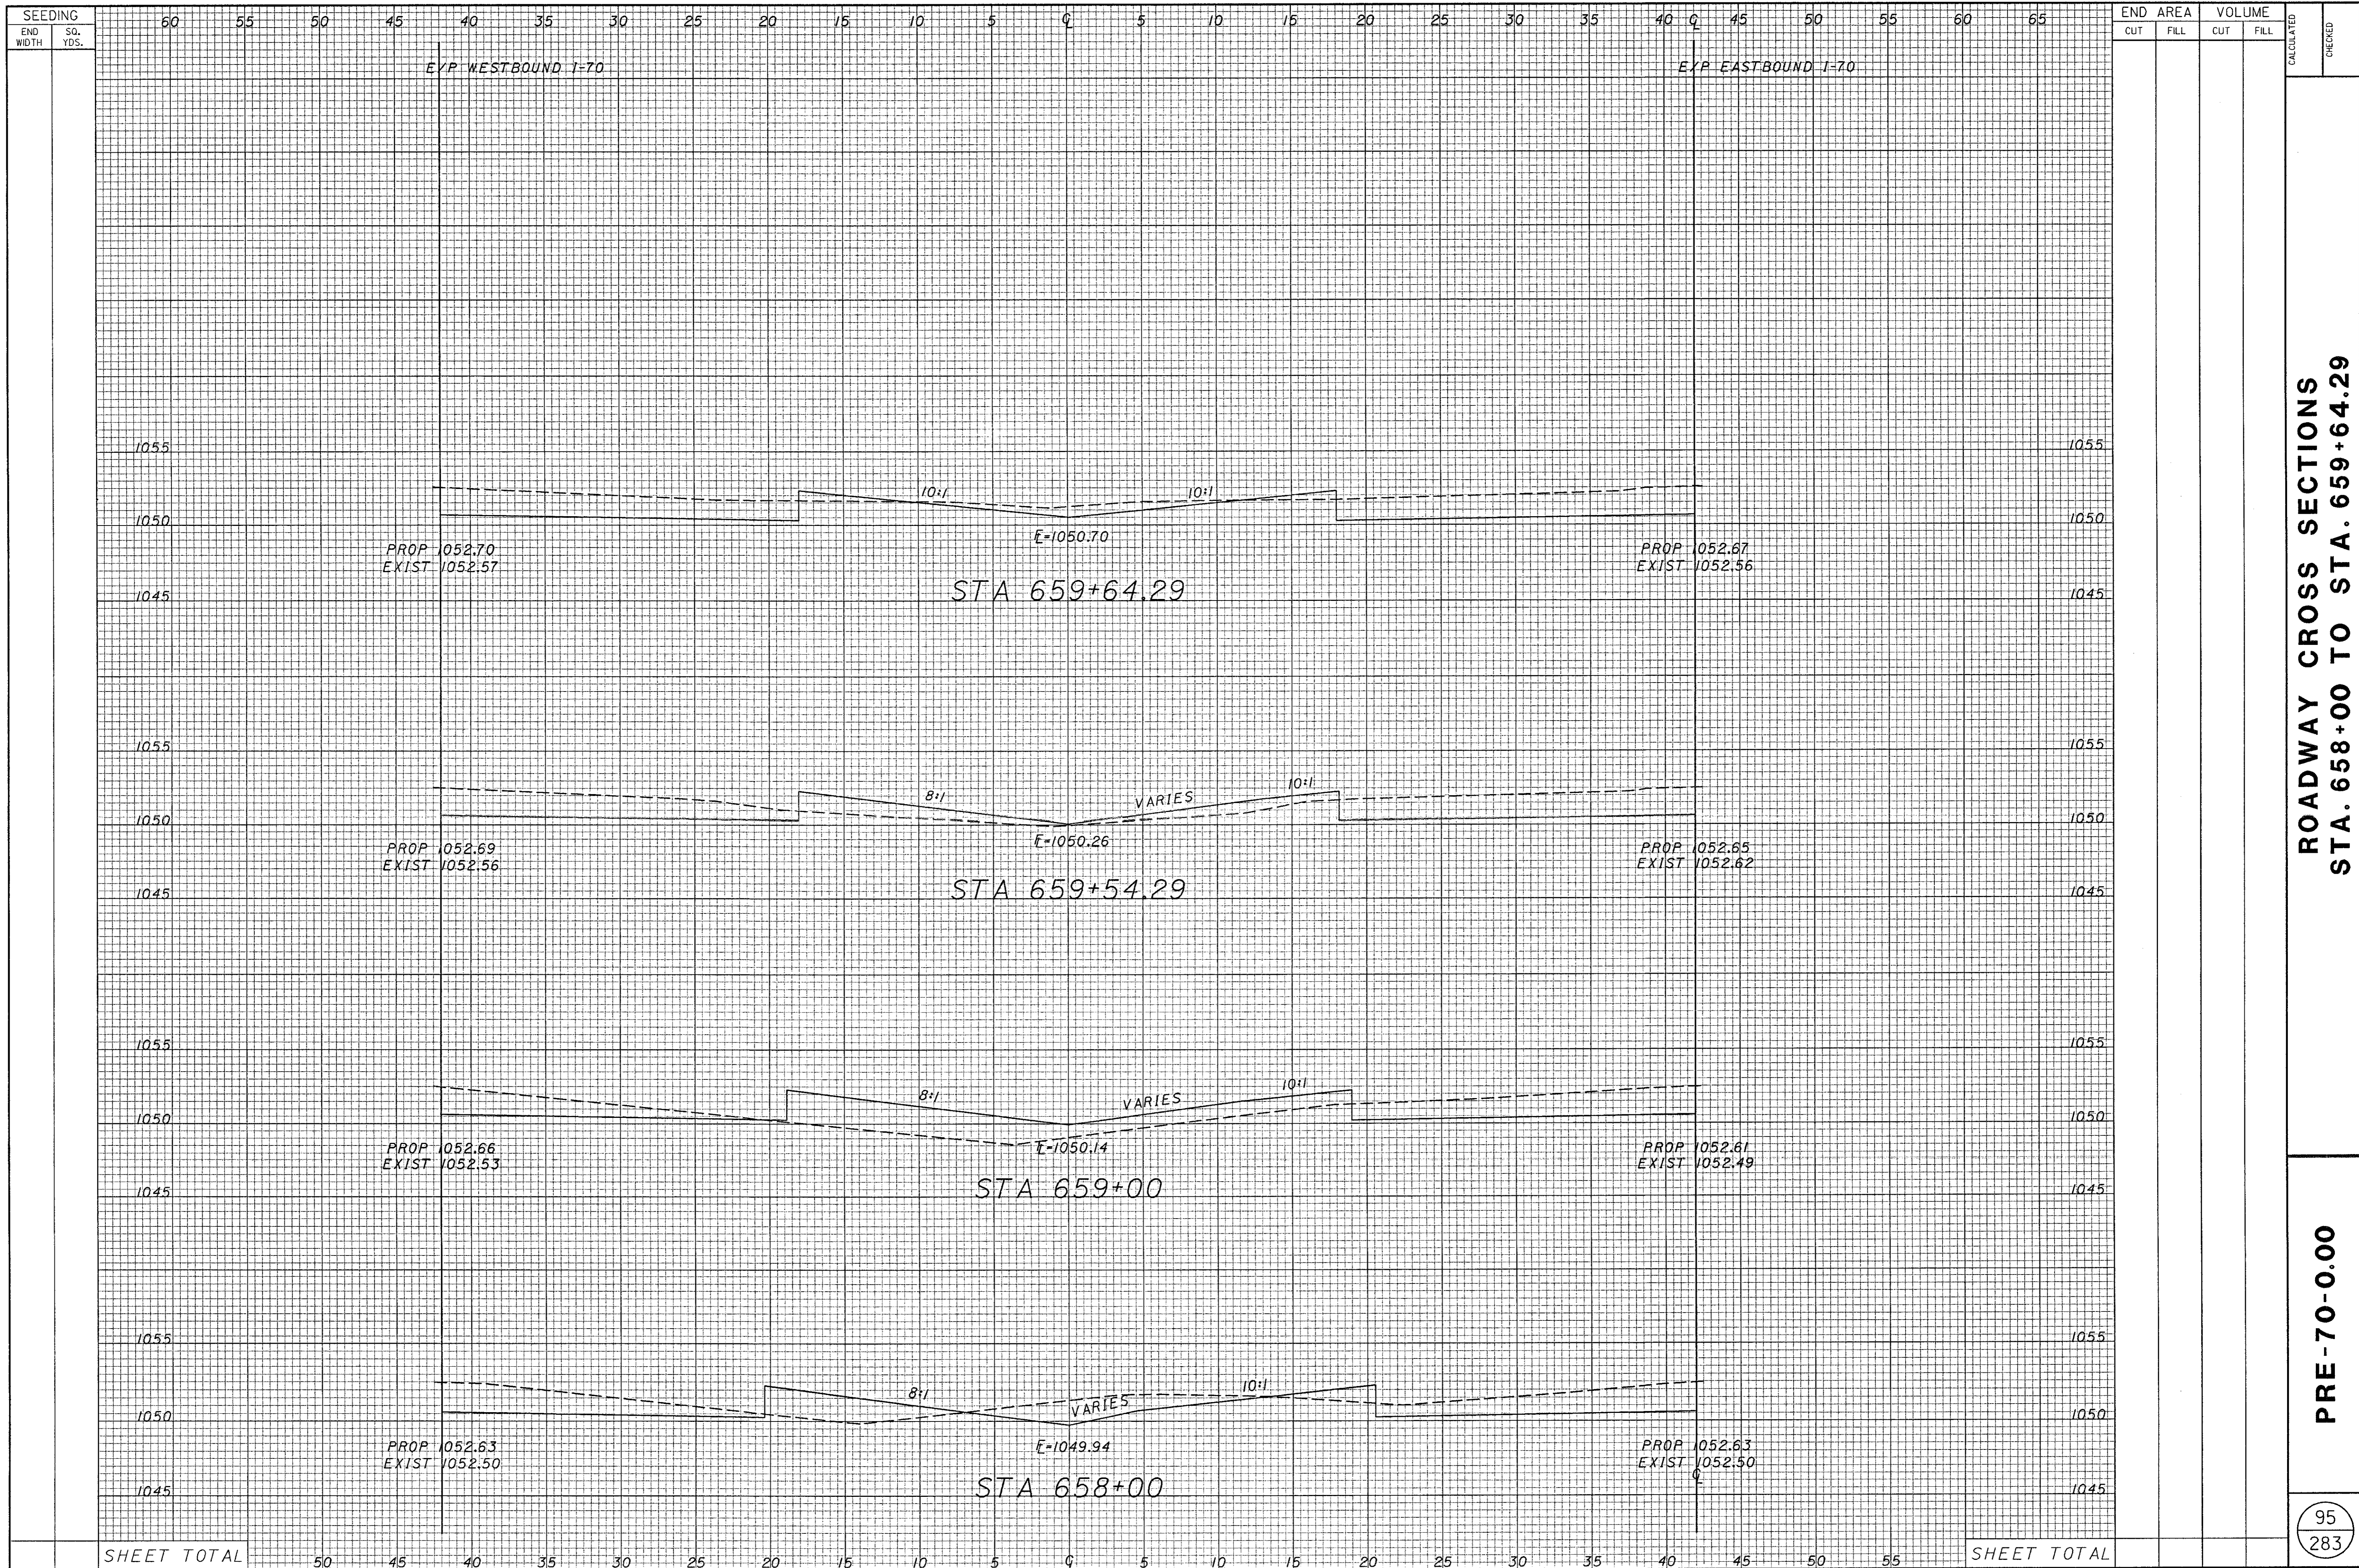


ROADWAY CROSS SECTIONS
STA. 658+00 TO STA. 659+64.29

PRE-70-0.00

95
283

SEEDING
END WIDTH SQ. YDS.

END AREA VOLUME
CUT FILL CUT FILL
CALCULATED CHECKED

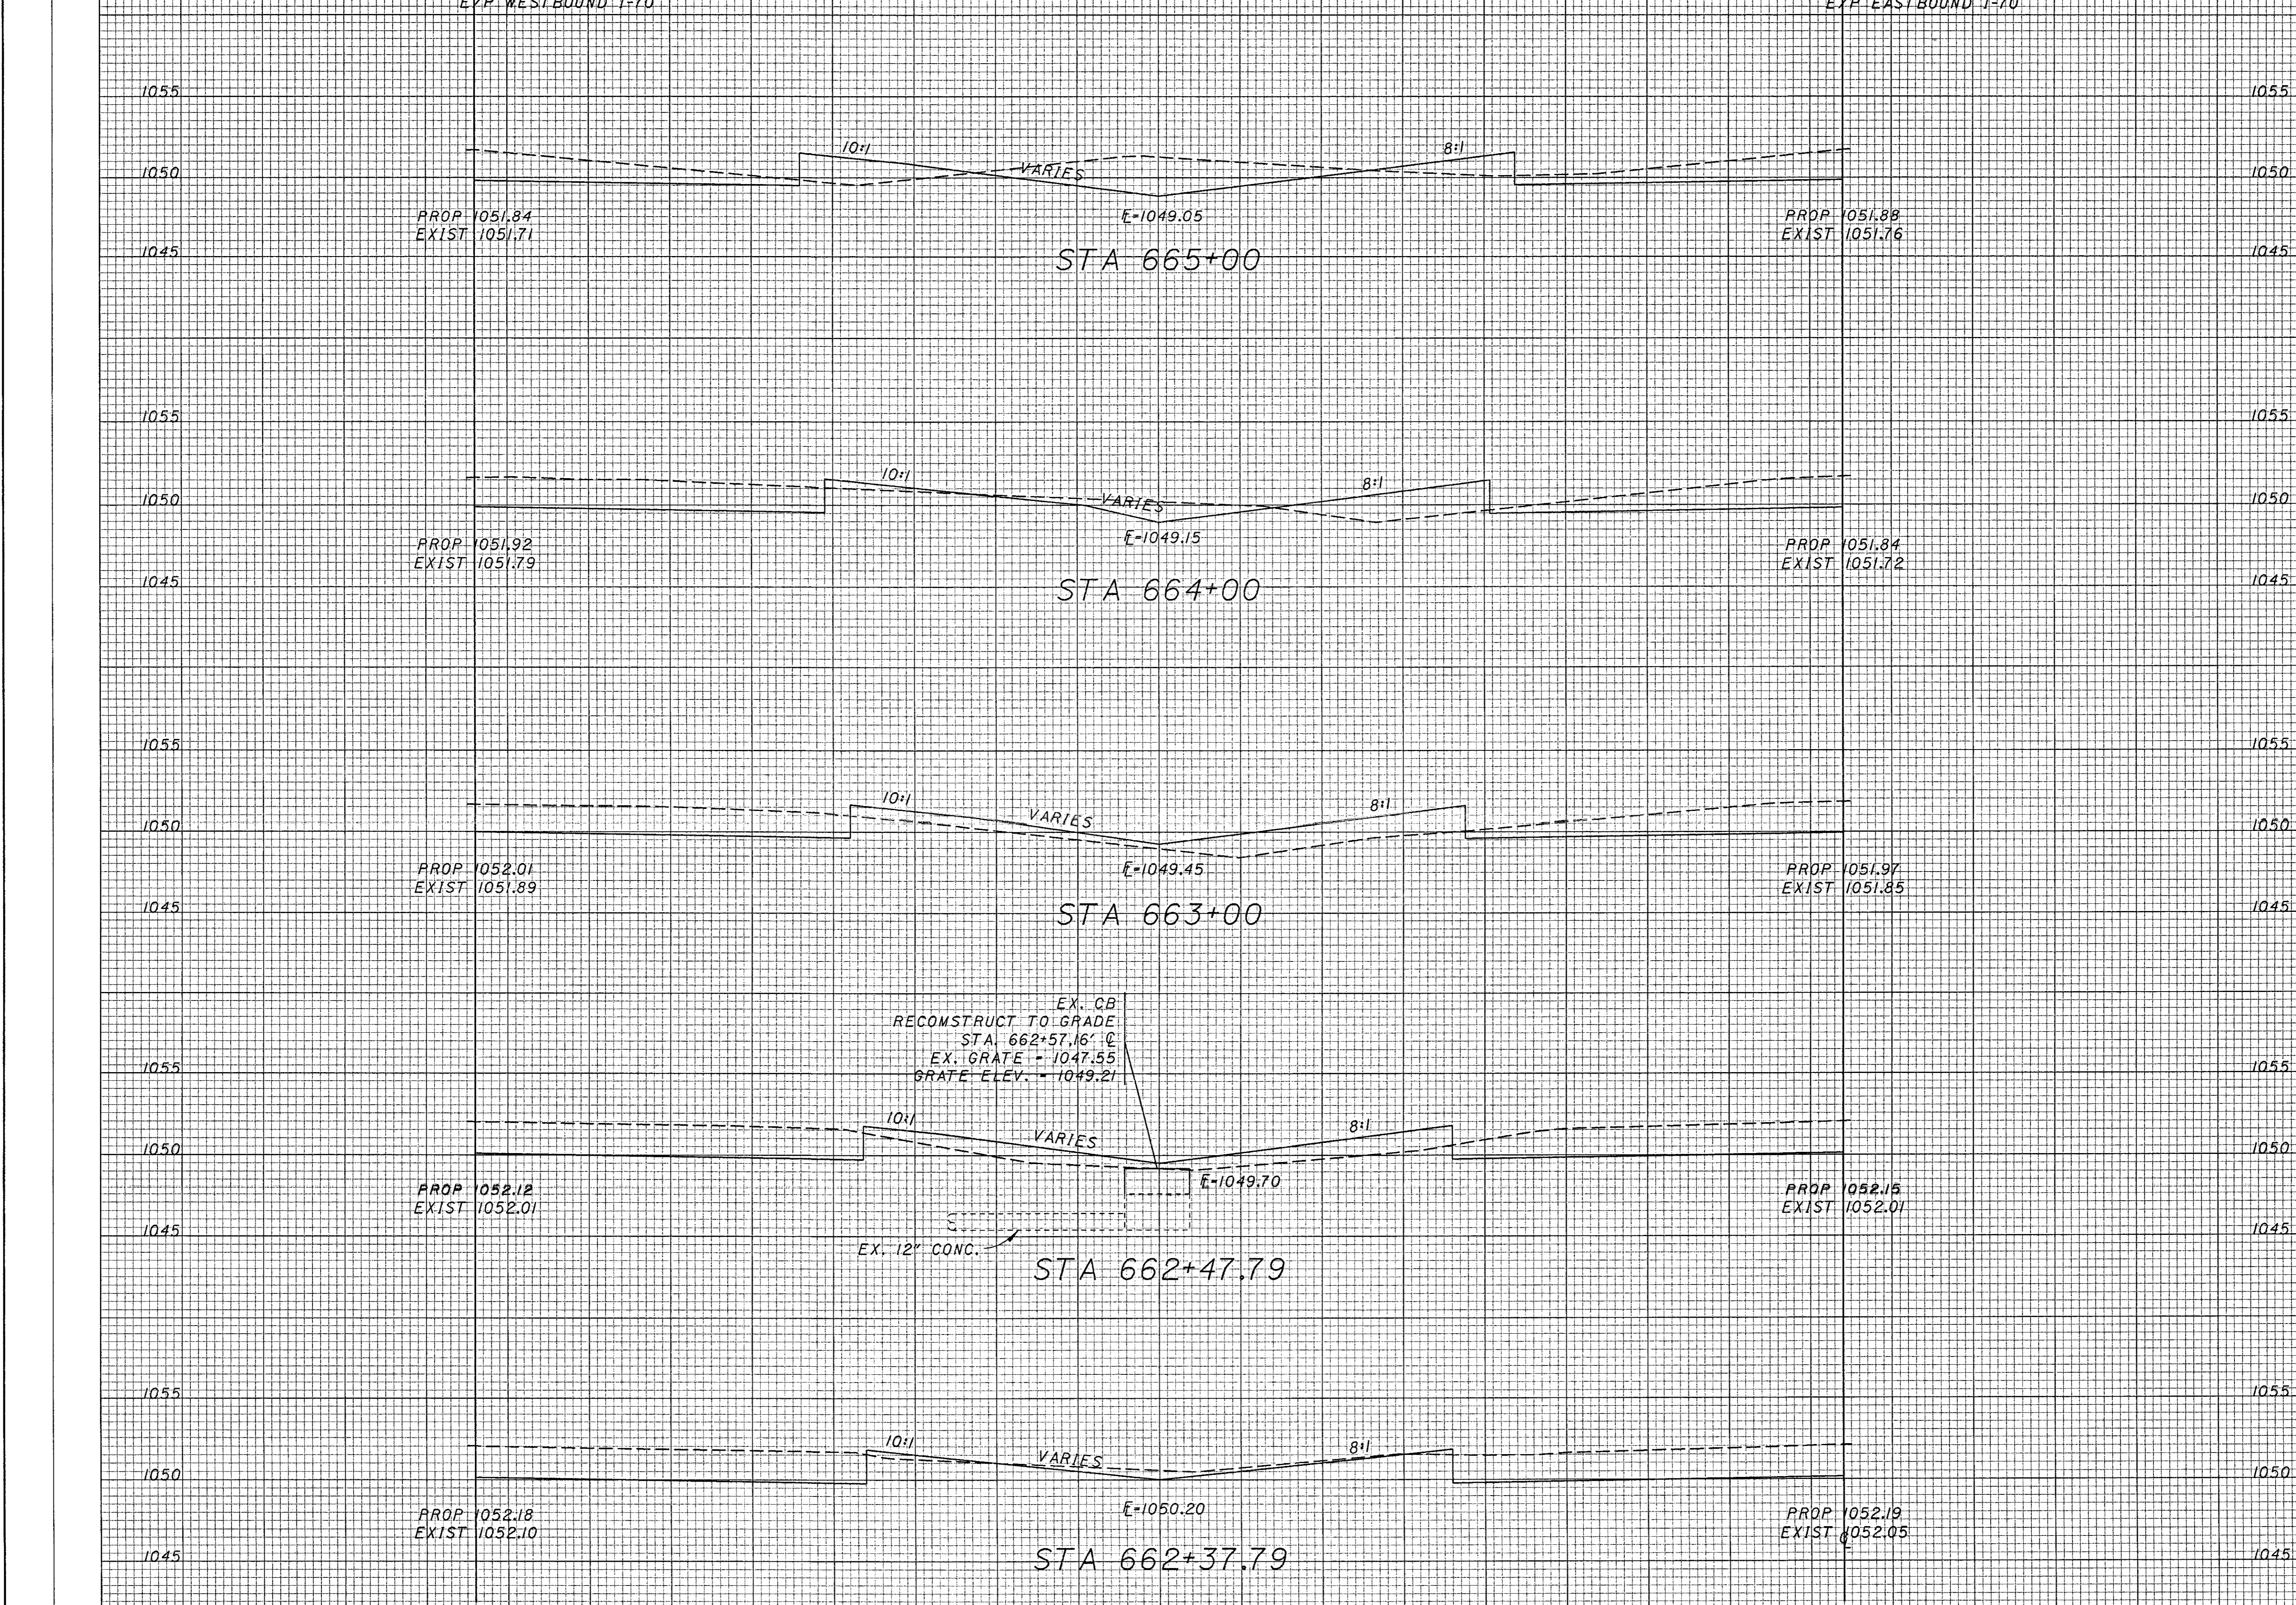


ROADWAY CROSS SECTIONS
STA. 662.37.79 TO STA. 665+00

PRE-70-0.00

96
283

SHEET TOTAL

SHEET TOTAL

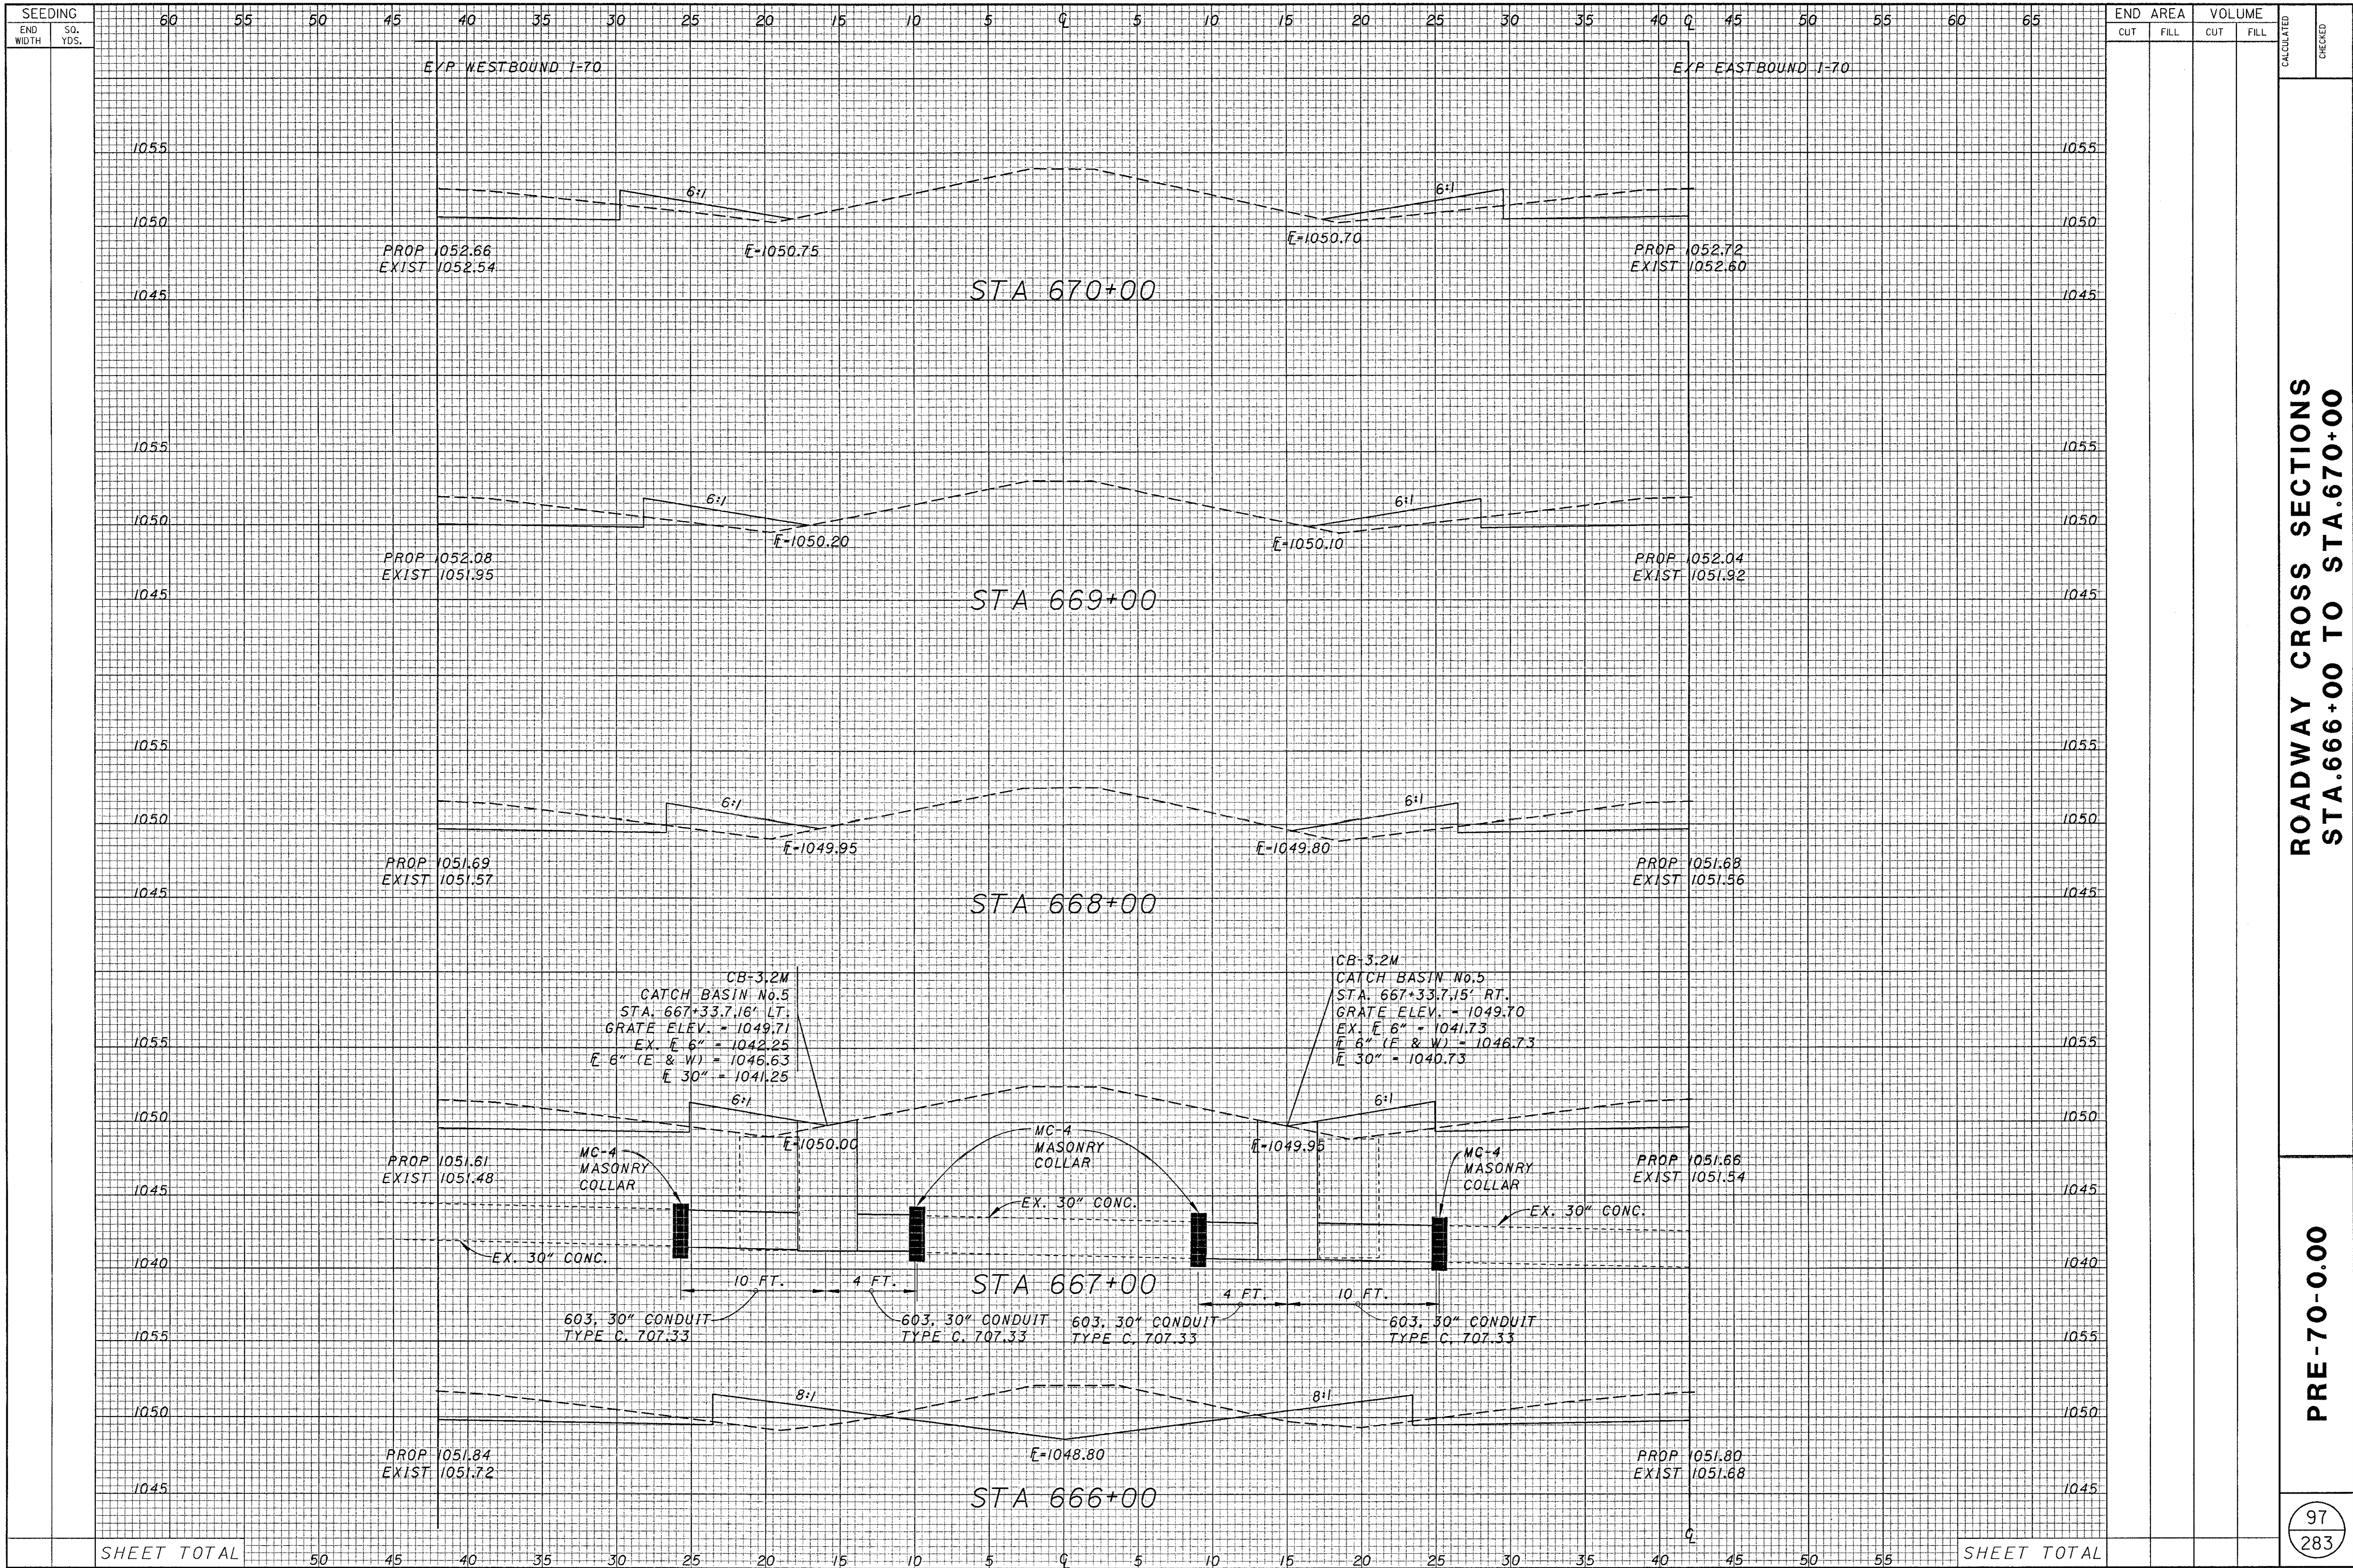

SEEDING
END WIDTH SO. YDS.

END AREA		VOLUME	
CUT	FILL	CUT	FILL


ROADWAY CROSS SECTIONS
STA. 666+00 TO STA. 670+00

PRE-70-0.00

97
283

SHEET TOTAL

SHEET TOTAL

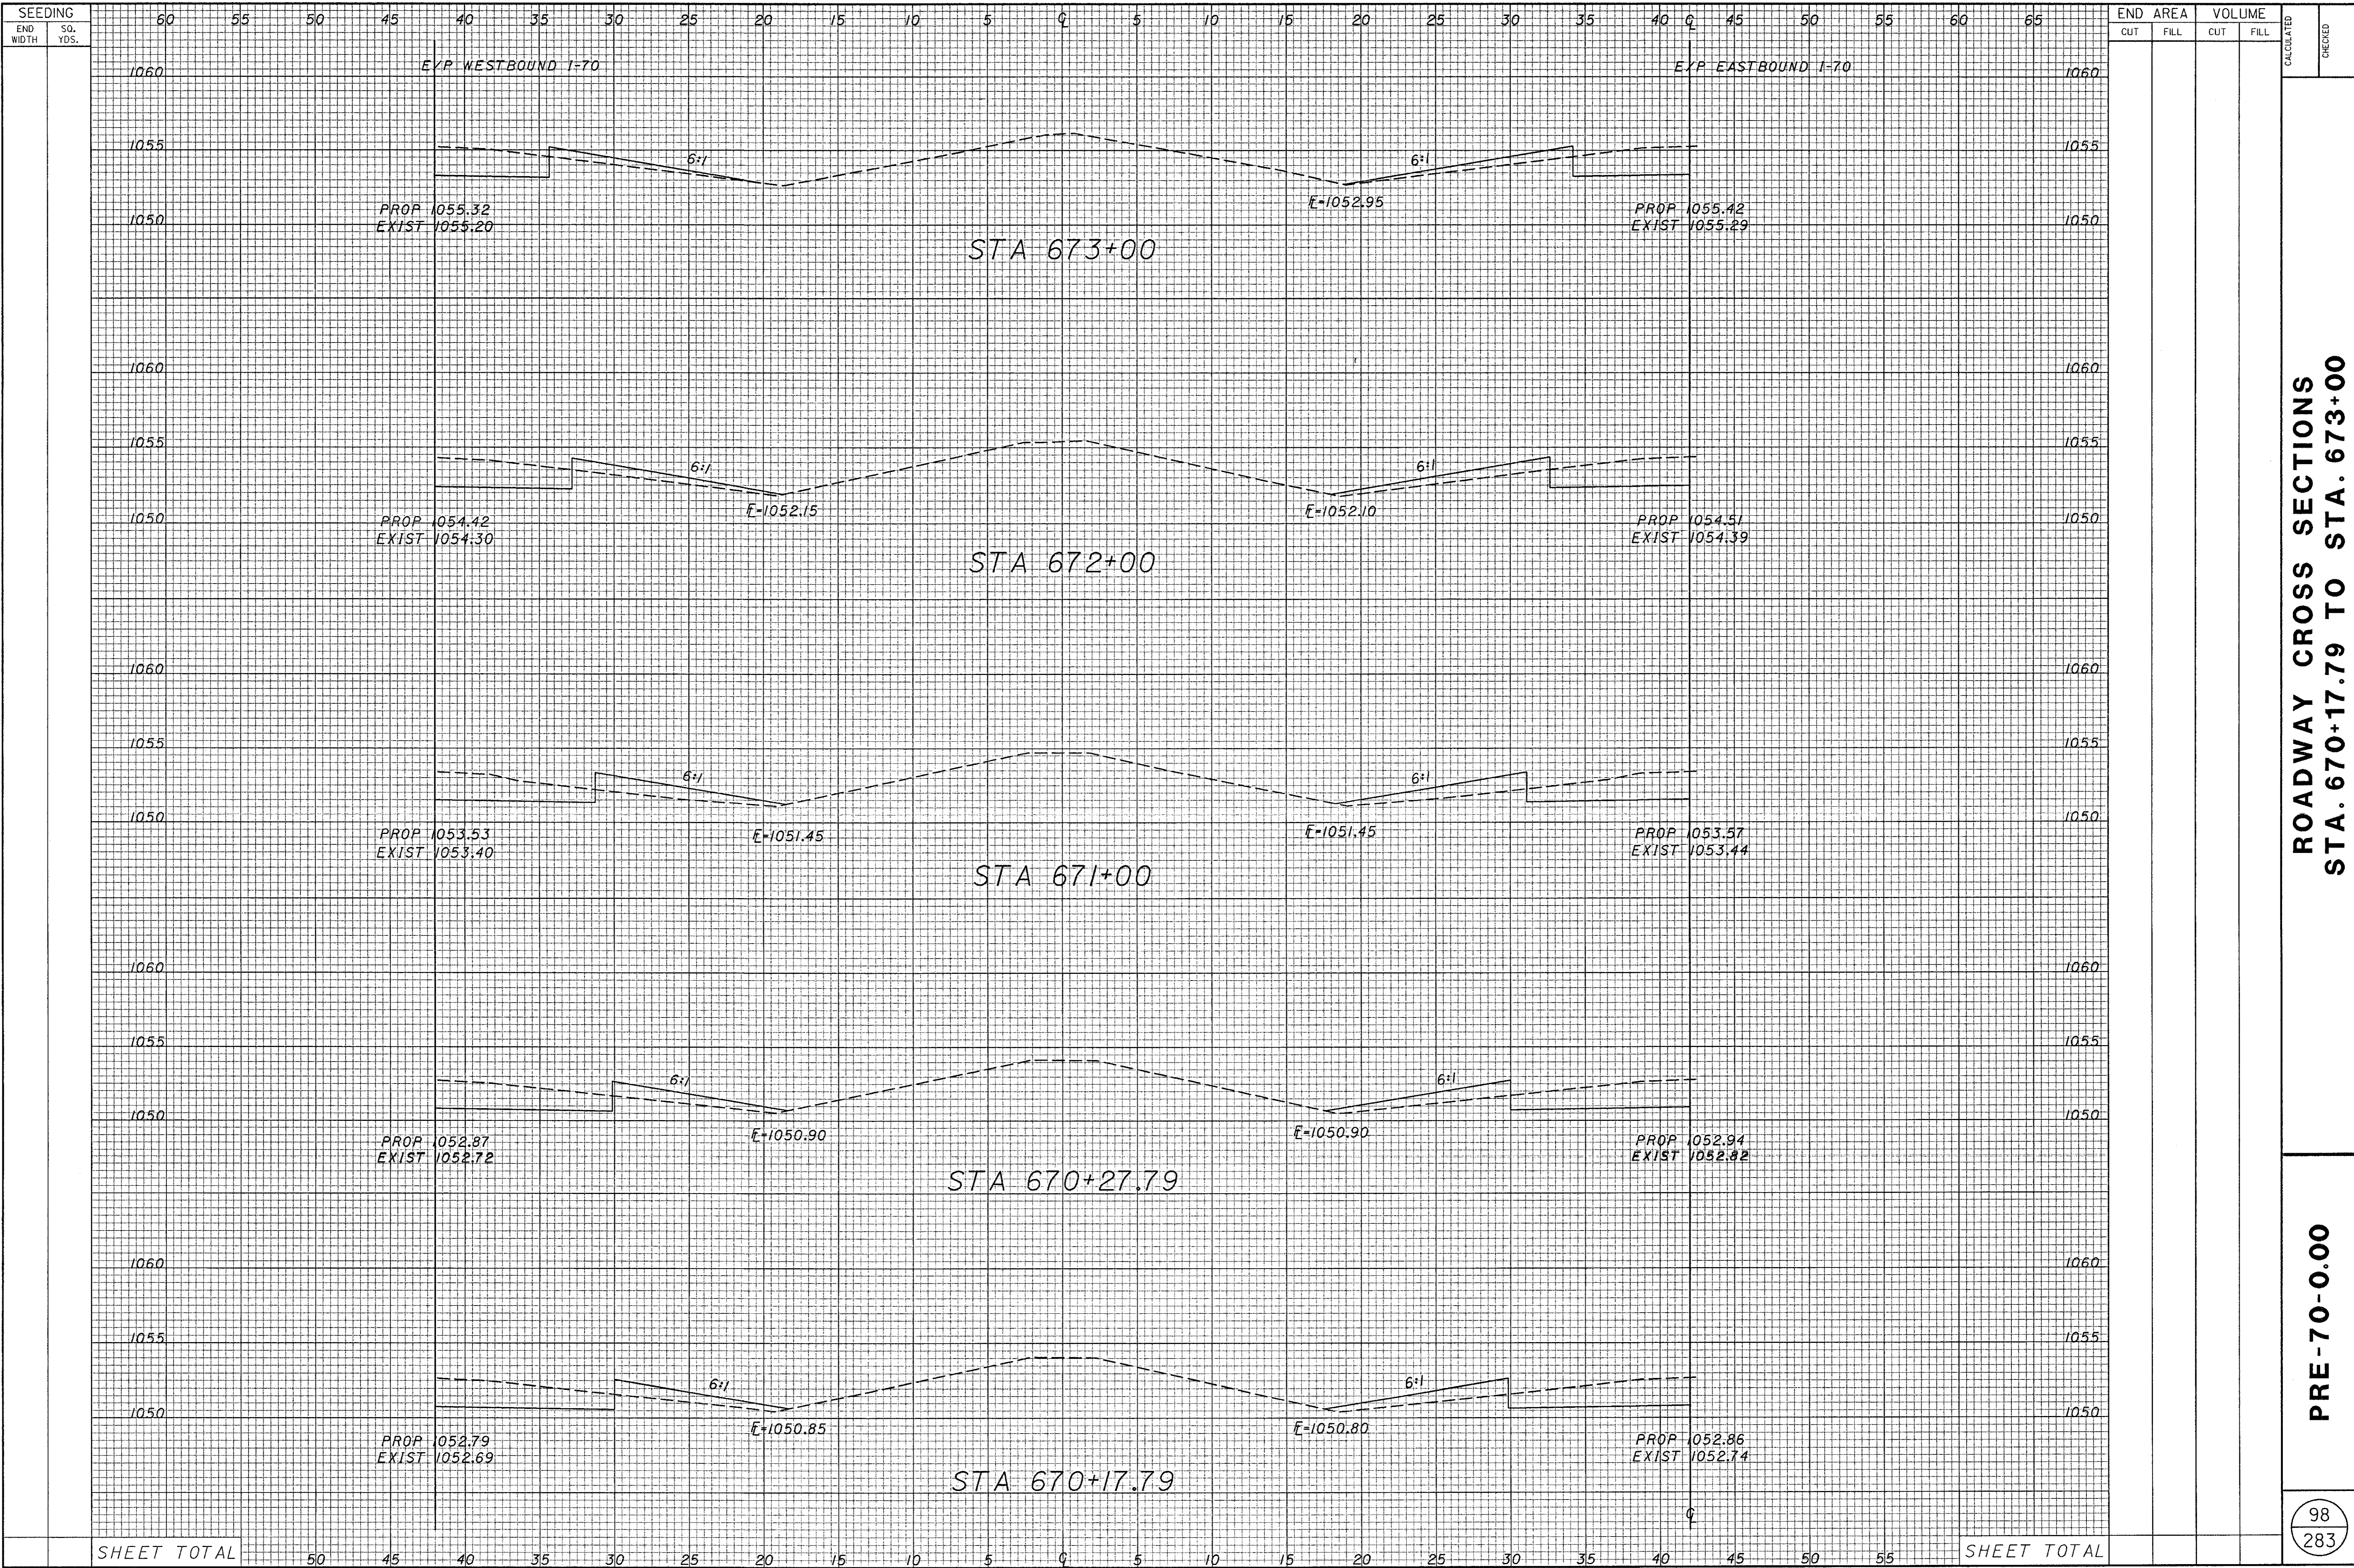

ROADWAY CROSS SECTIONS
STA. 670+17.79 TO STA. 673+00

PRE-70-0.00

98
283

SEEDING
END
WIDTH

60 55 50 45 40 35 30 25 20 15 10 5 0 5 10 15 20 25 30 35 40 45 50 55 60 65

END AREA
CUT FILL

VOLUME
CUT FILL

CALCULATED
CHECKED

EYP WESTBOUND I-70

EYP EASTBOUND I-70

1060

1060

1055

1055

1050

1050

STA 675+47.79

PROP 1057.74
EXIST 1057.51

1060

1060

1055

1055

1050

1050

STA 675+37.79

PROP 1057.56
EXIST 1057.42

PROP 1057.65
EXIST 1057.42

1060

1060

1055

1055

1050

1050

STA 675+00

PROP 1057.19
EXIST 1057.07

PROP 1057.28
EXIST 1057.15

1060

1060

1055

1055

1050

1050

STA 674+00

PROP 1056.22
EXIST 1056.10

PROP 1056.32
EXIST 1056.19

SHEET TOTAL


50 45 40 35 30 25 20 15 10 5 0 5 10 15 20 25 30 35 40 45 50 55

SHEET TOTAL

ROADWAY CROSS SECTIONS
STA. 674+00 TO STA. 675+47.79


PRE-70-0.00

99
283

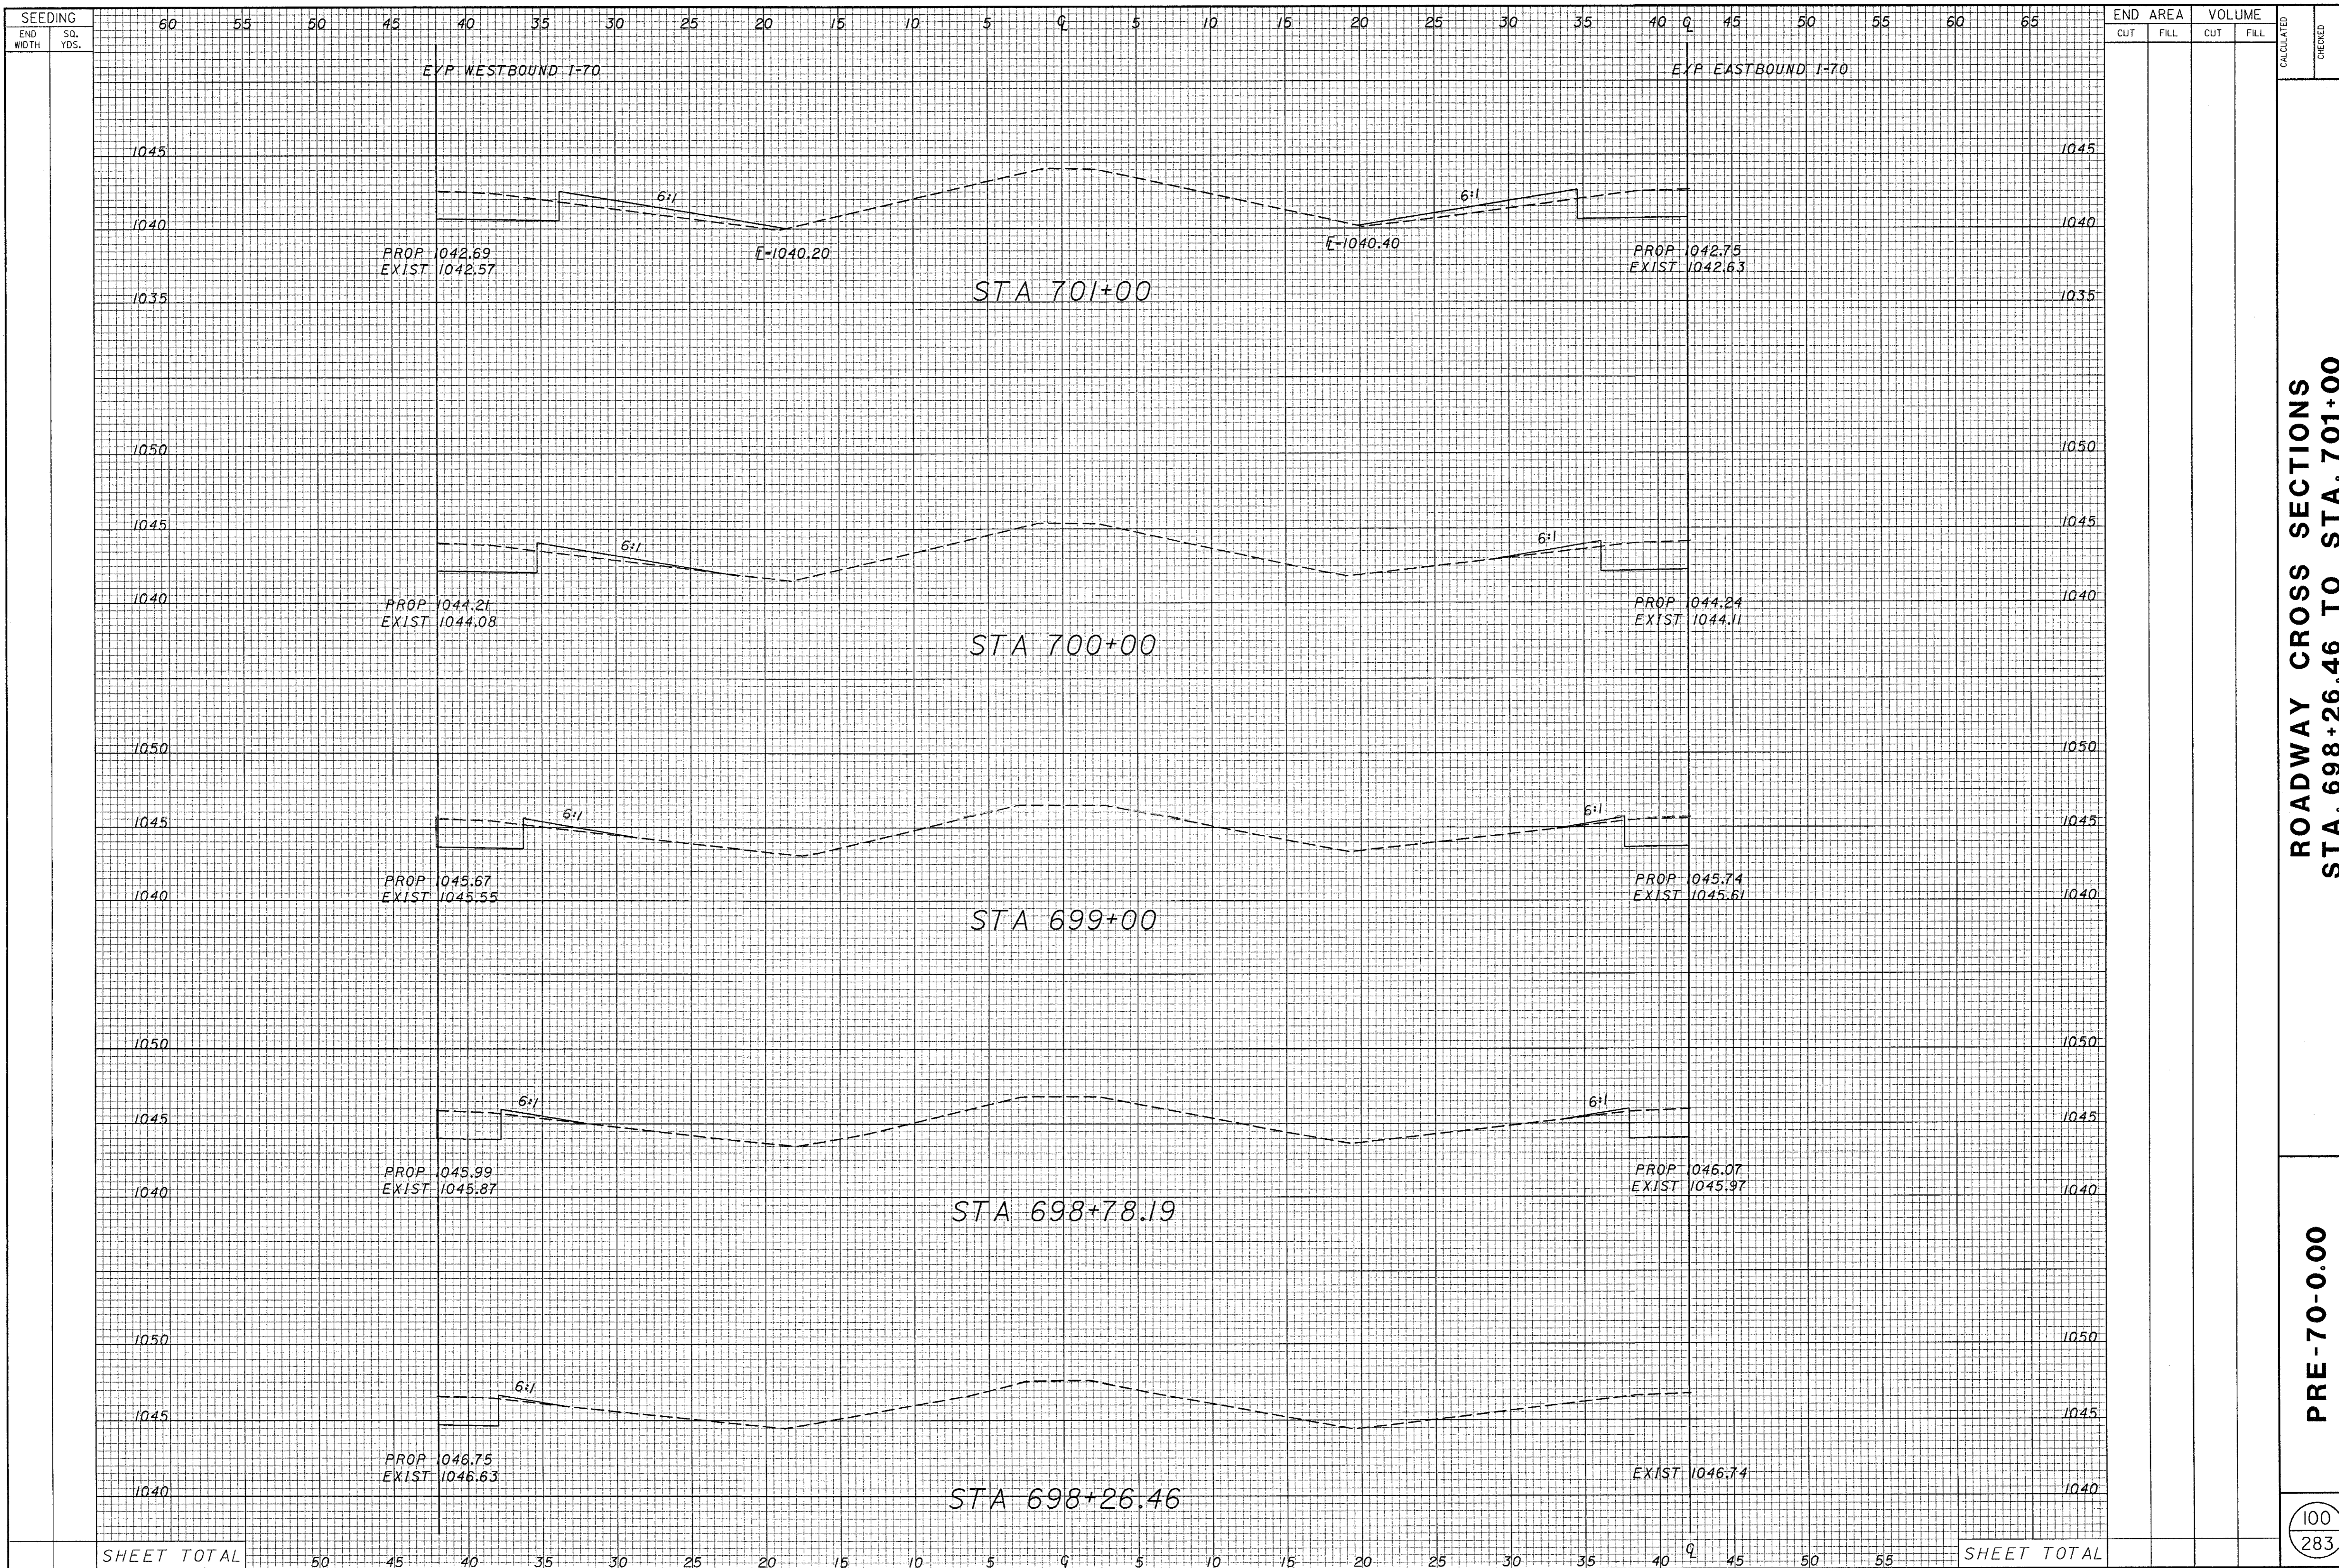

**ROADWAY CROSS SECTIONS
 STA. 698+26.46 TO STA. 701+00**

PRE-70-0.00

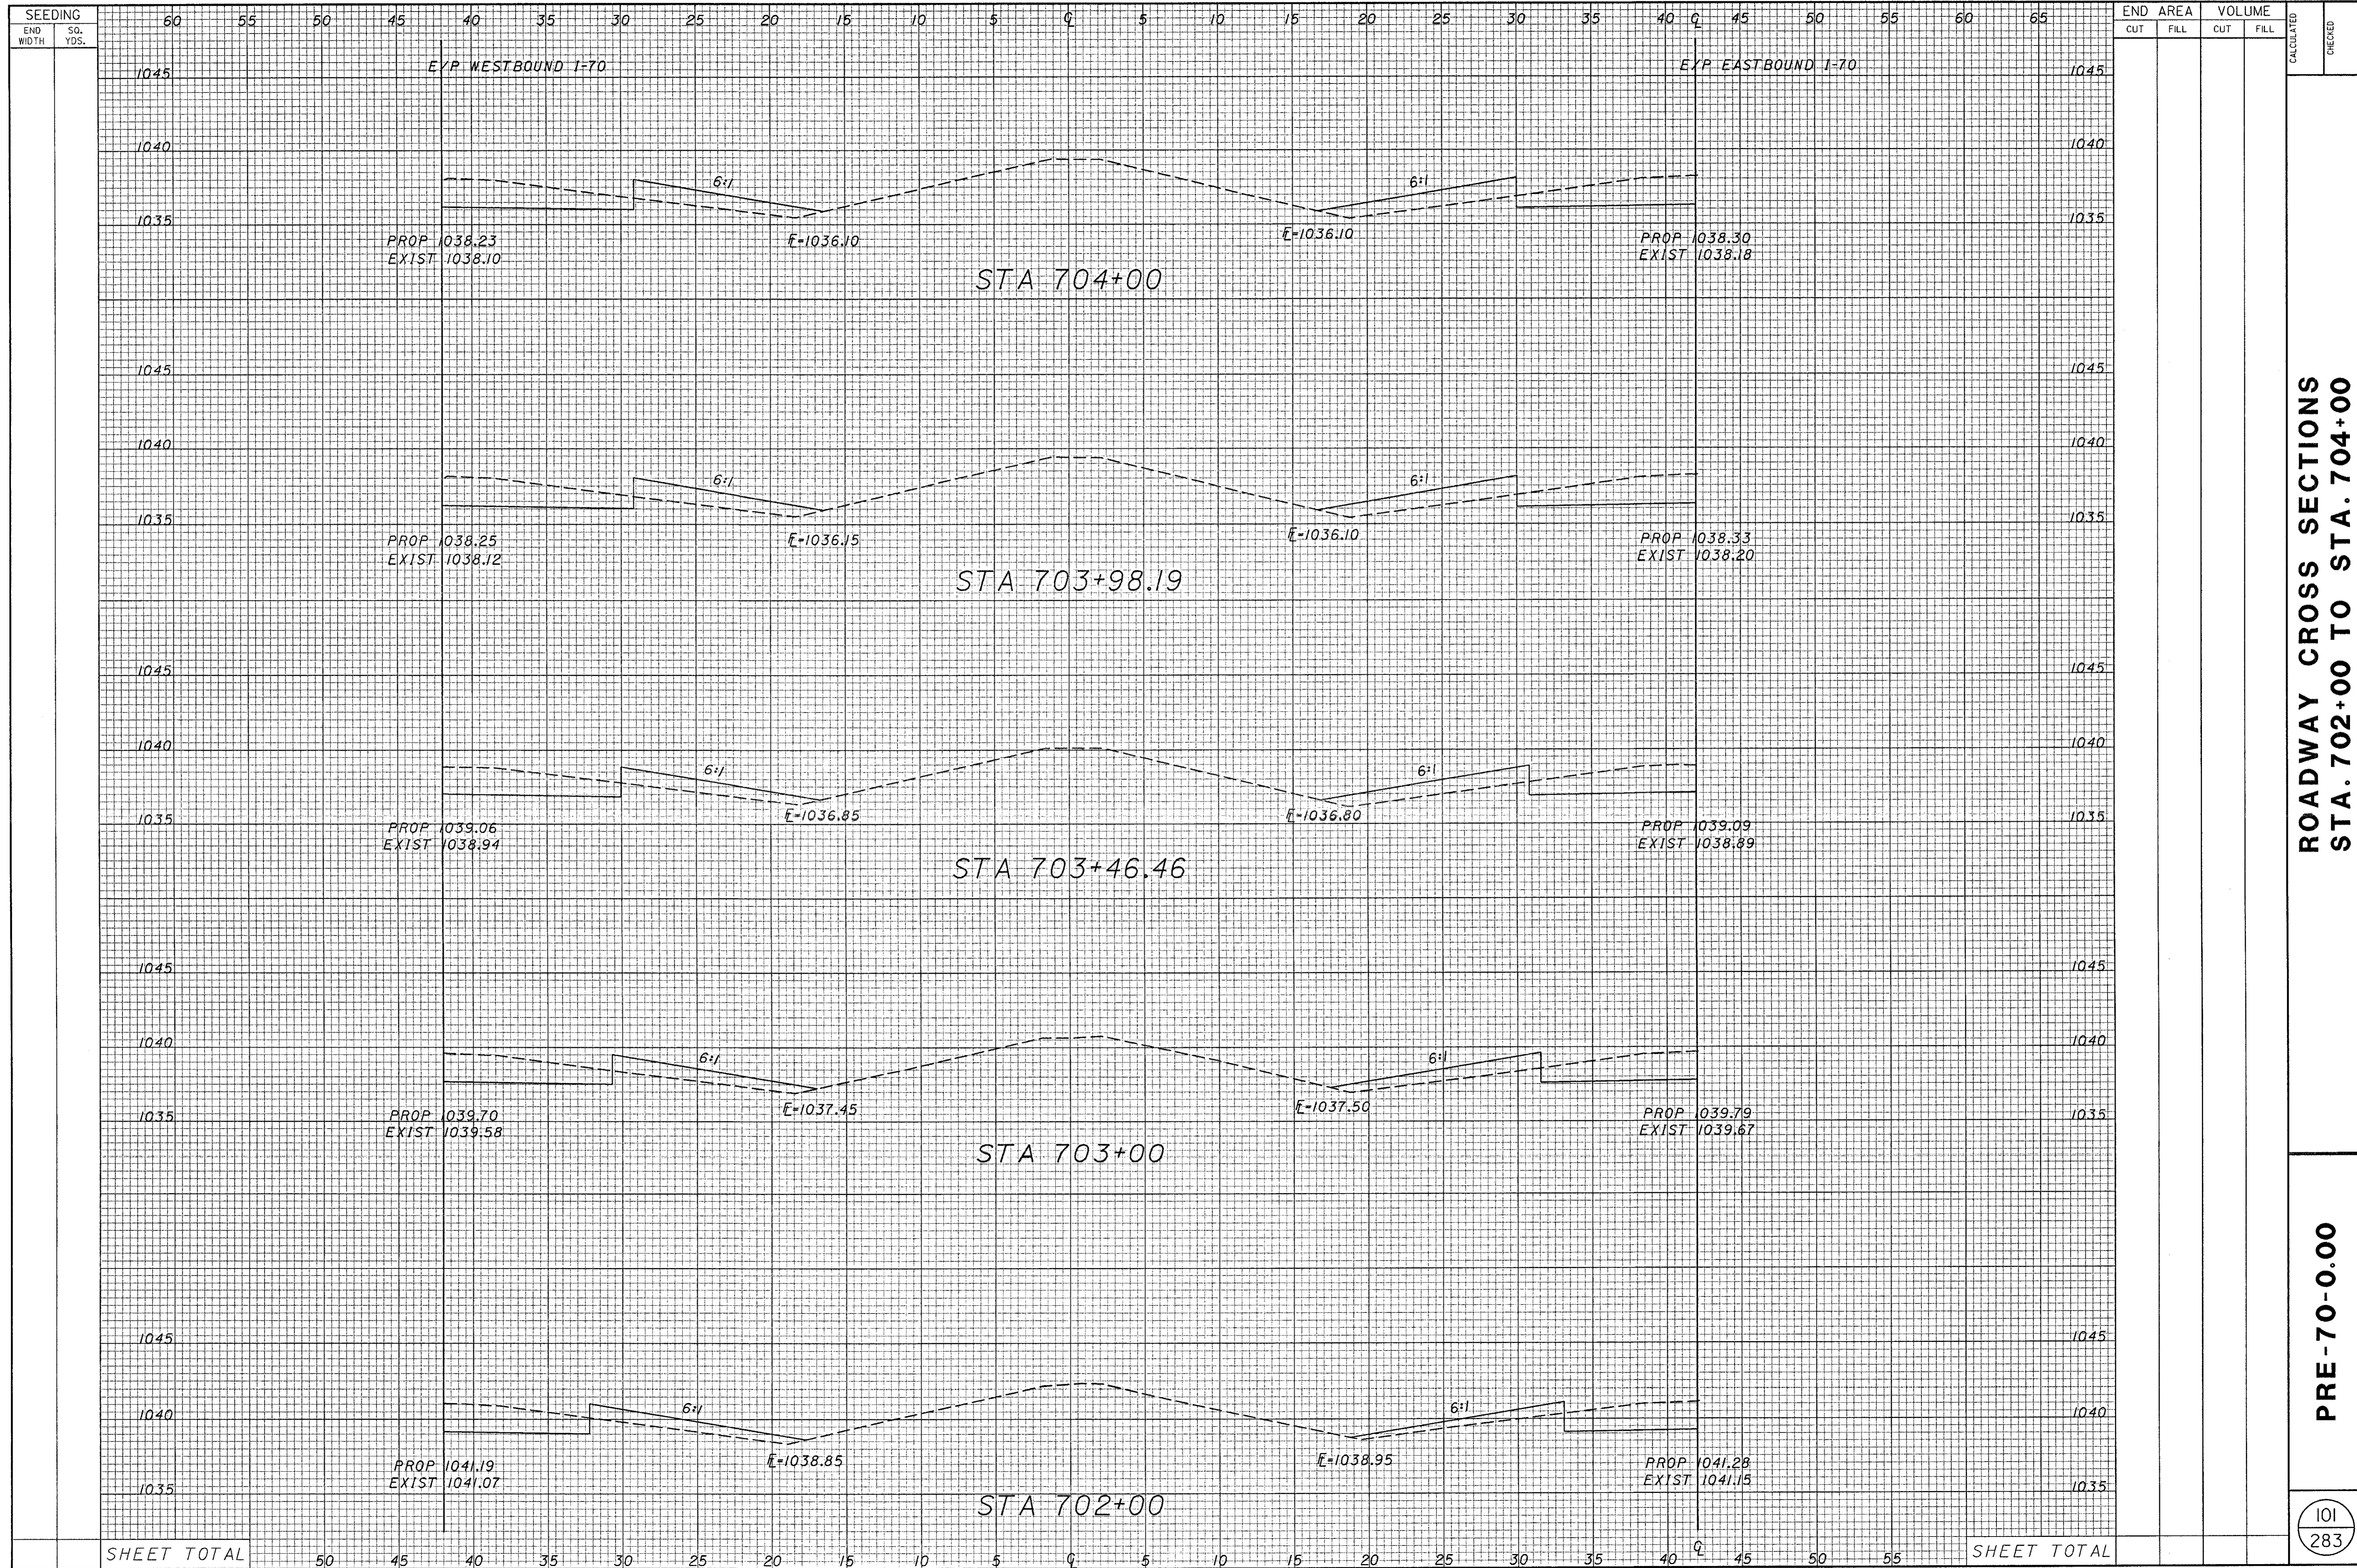


**ROADWAY CROSS SECTIONS
STA. 702+00 TO STA. 704+00**

PRE - 70 - 0.00

END CUT	AREA FILL	VOLUME		CALCULATED	CHECKED
		CUT	FILL		

SEEDING
END
WIDTH
SQ.
YDS.

END AREA
CUT FILL
VOLUME
CUT FILL
CALCULATED
CHECKED

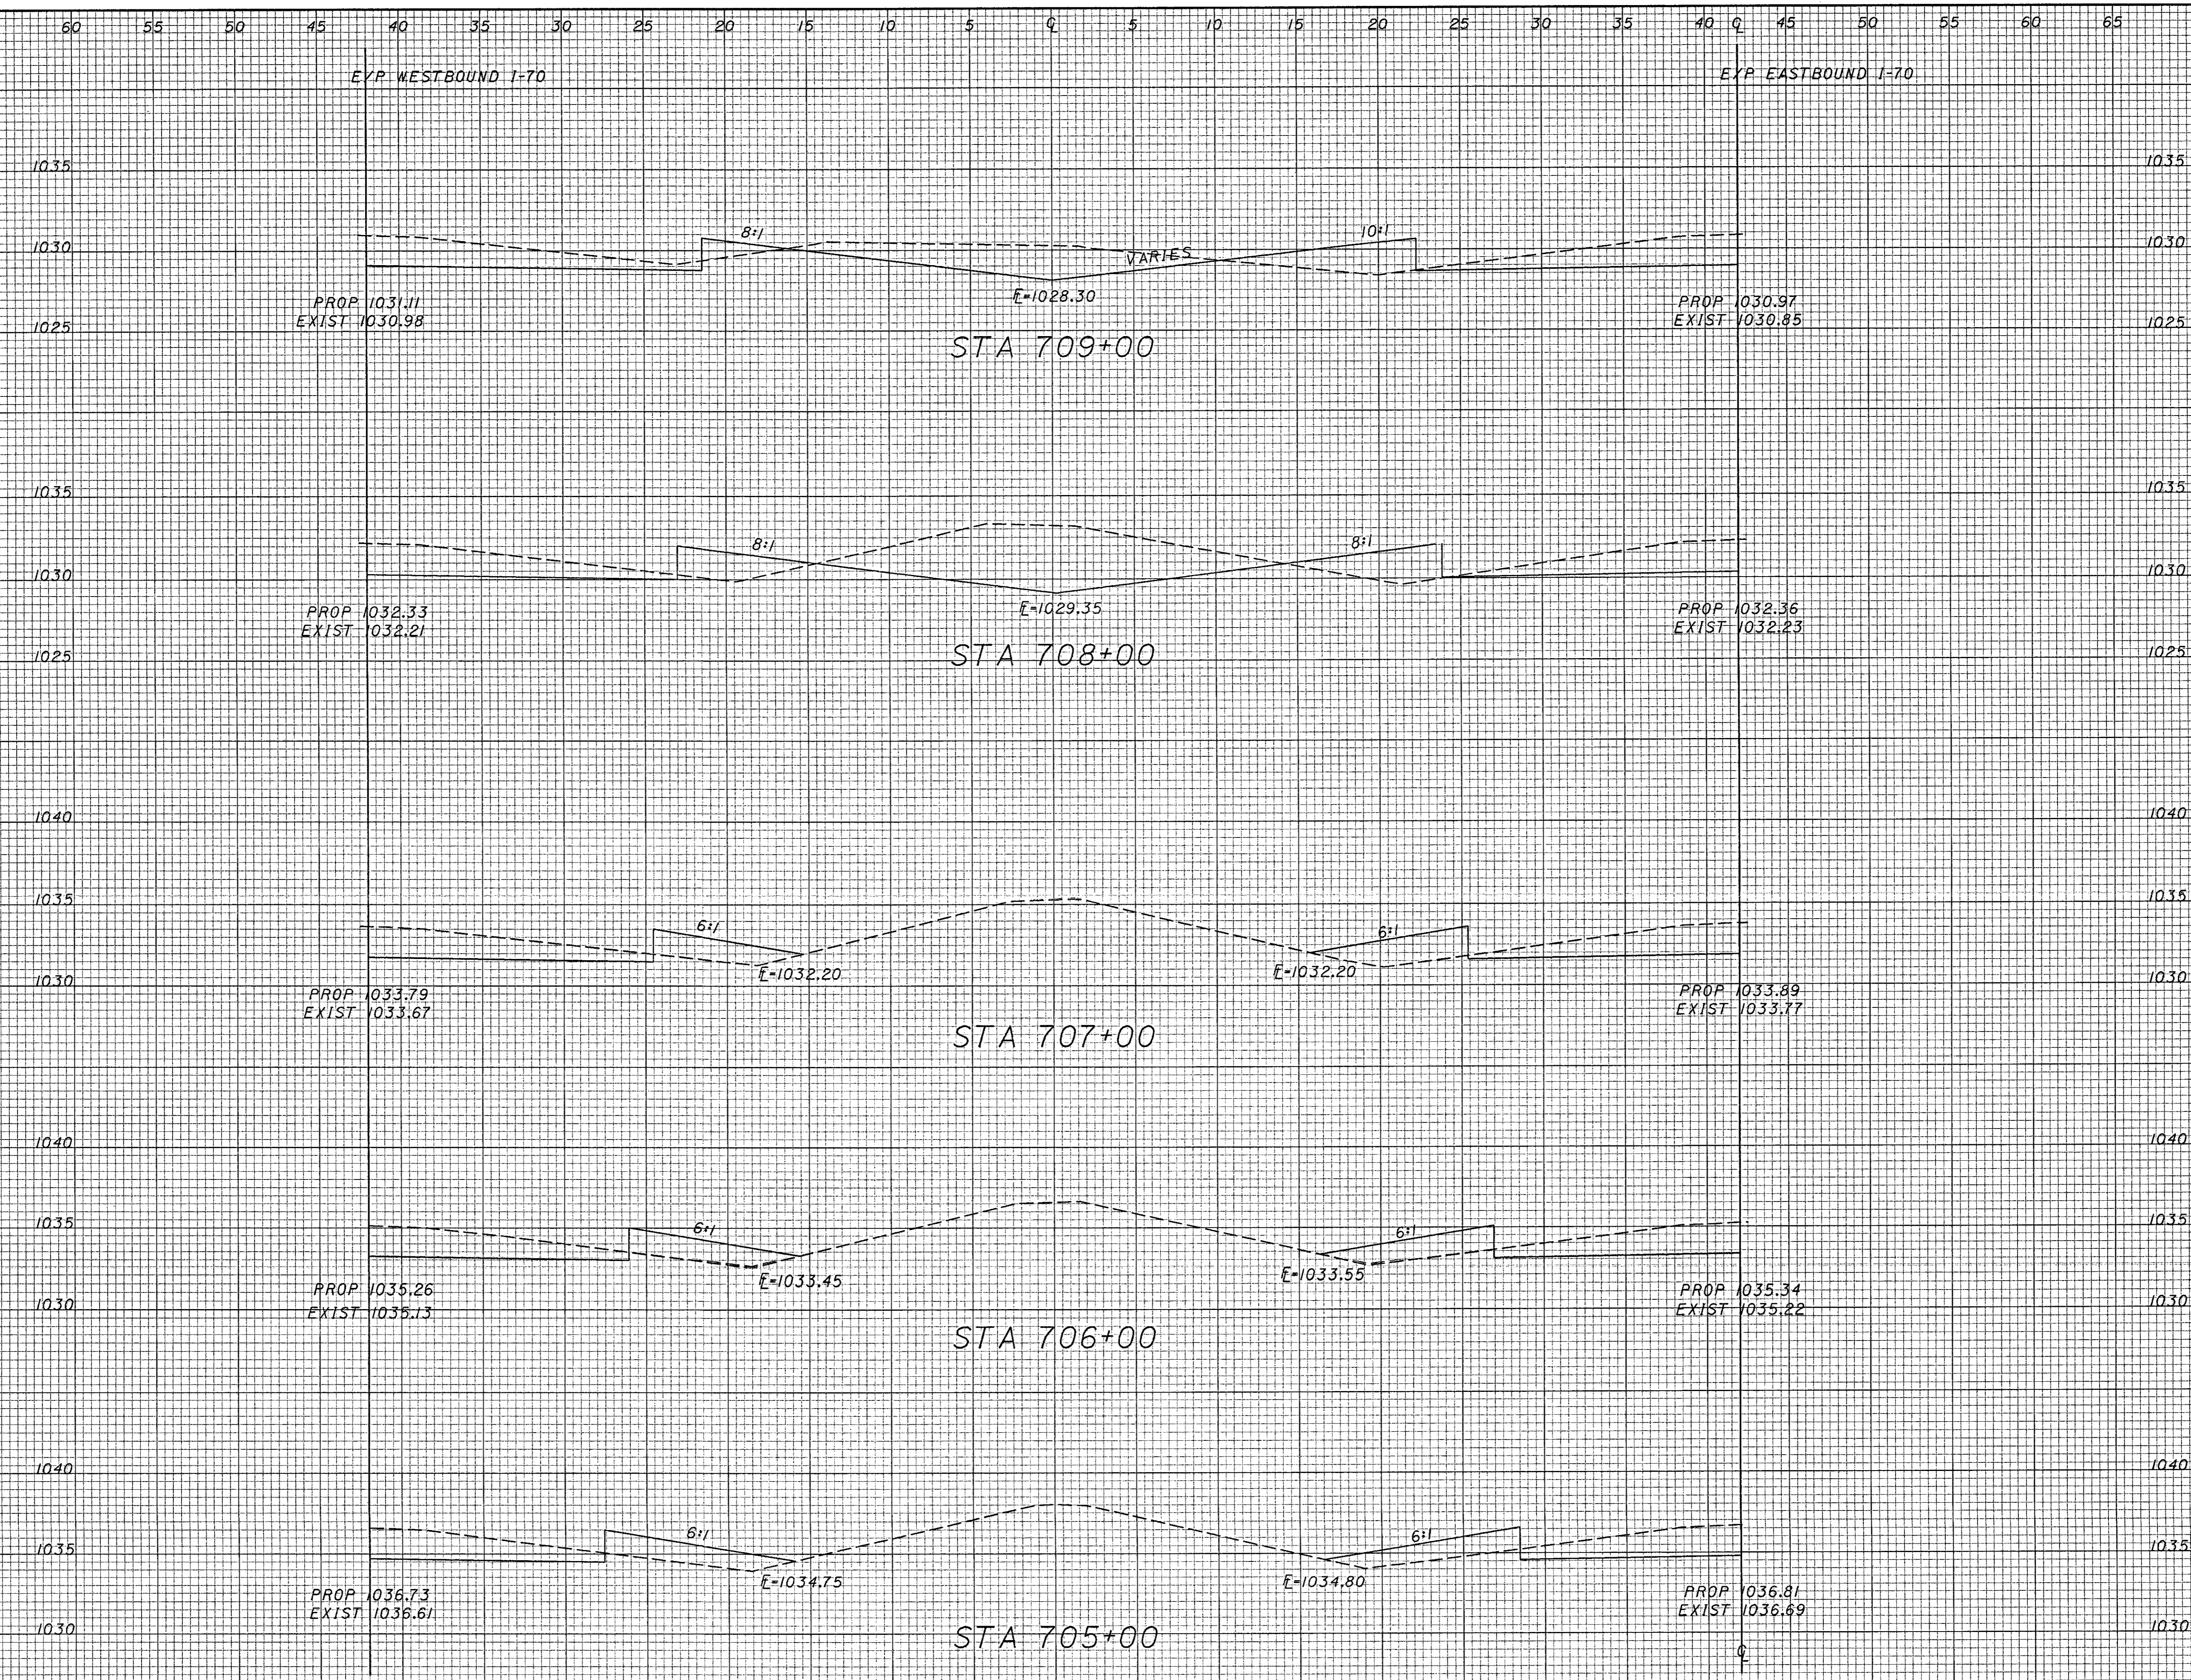


SHEET TOTAL

SHEET TOTAL

ROADWAY CROSS SECTIONS
 STA. 705+00 TO STA. 709+00

PRE-70-0.00


102
283

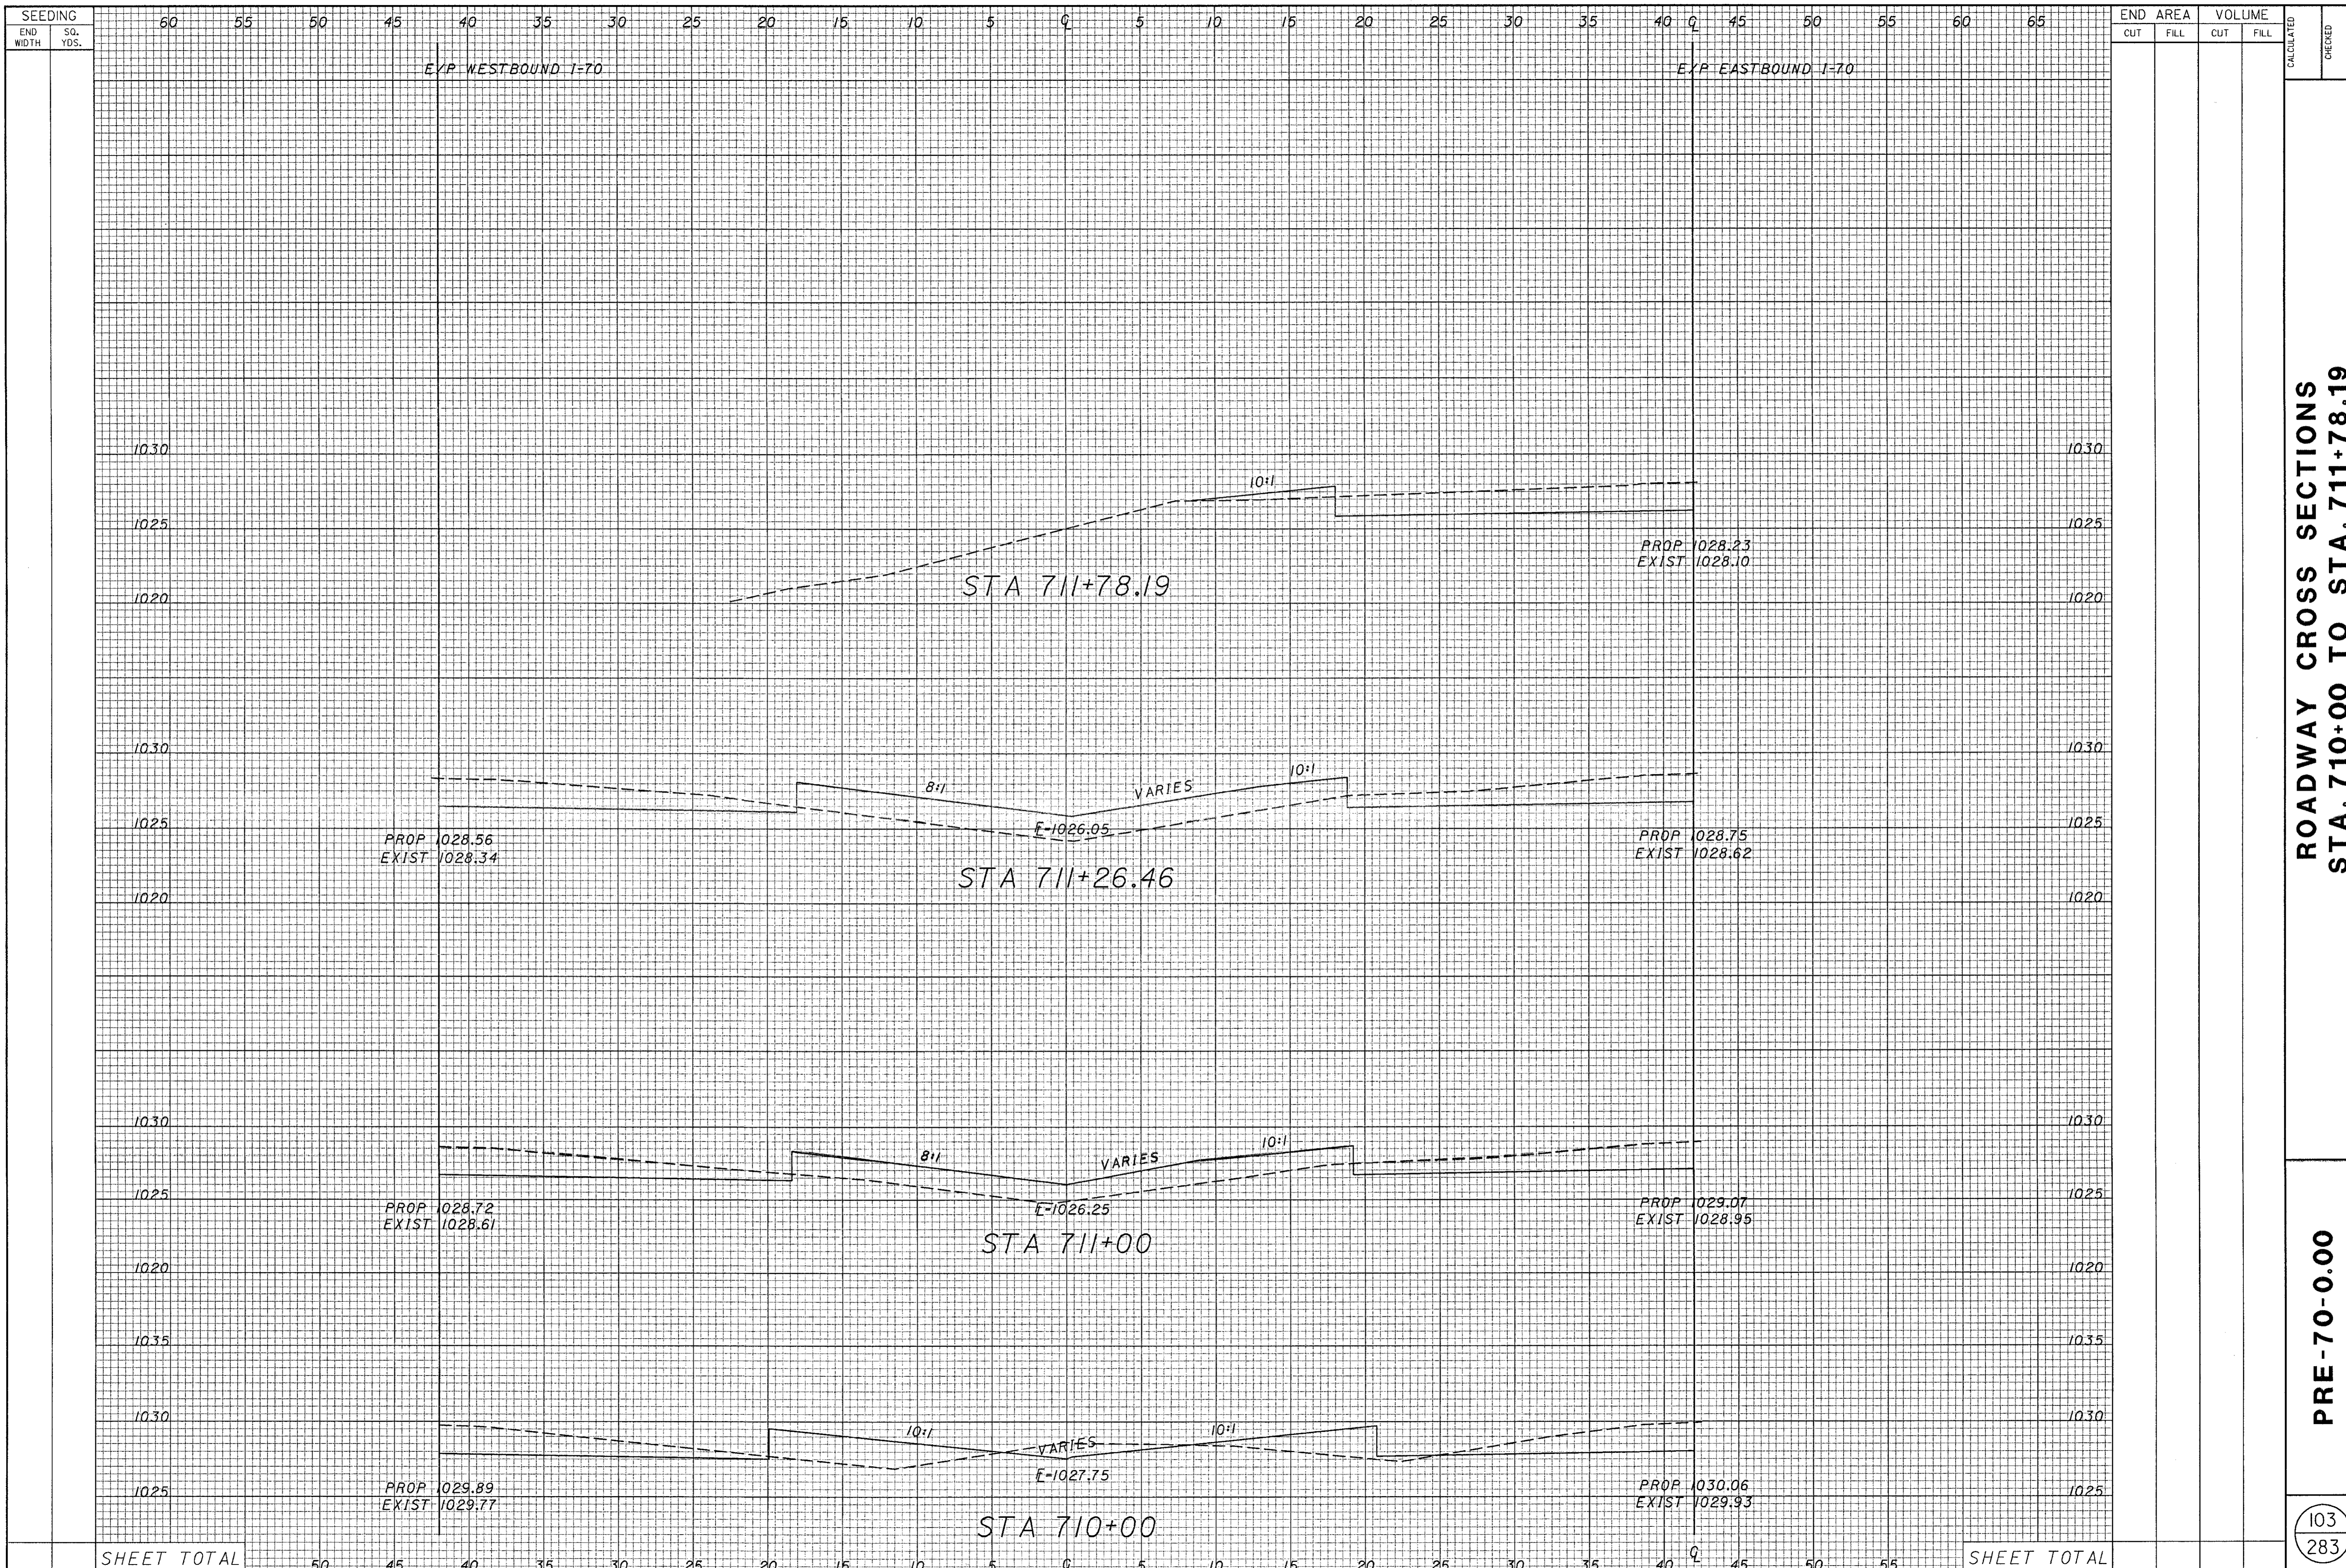


ROADWAY CROSS SECTIONS
 STA. 710+00 TO STA. 711+78.19

PRE-70-0.00

103
 283

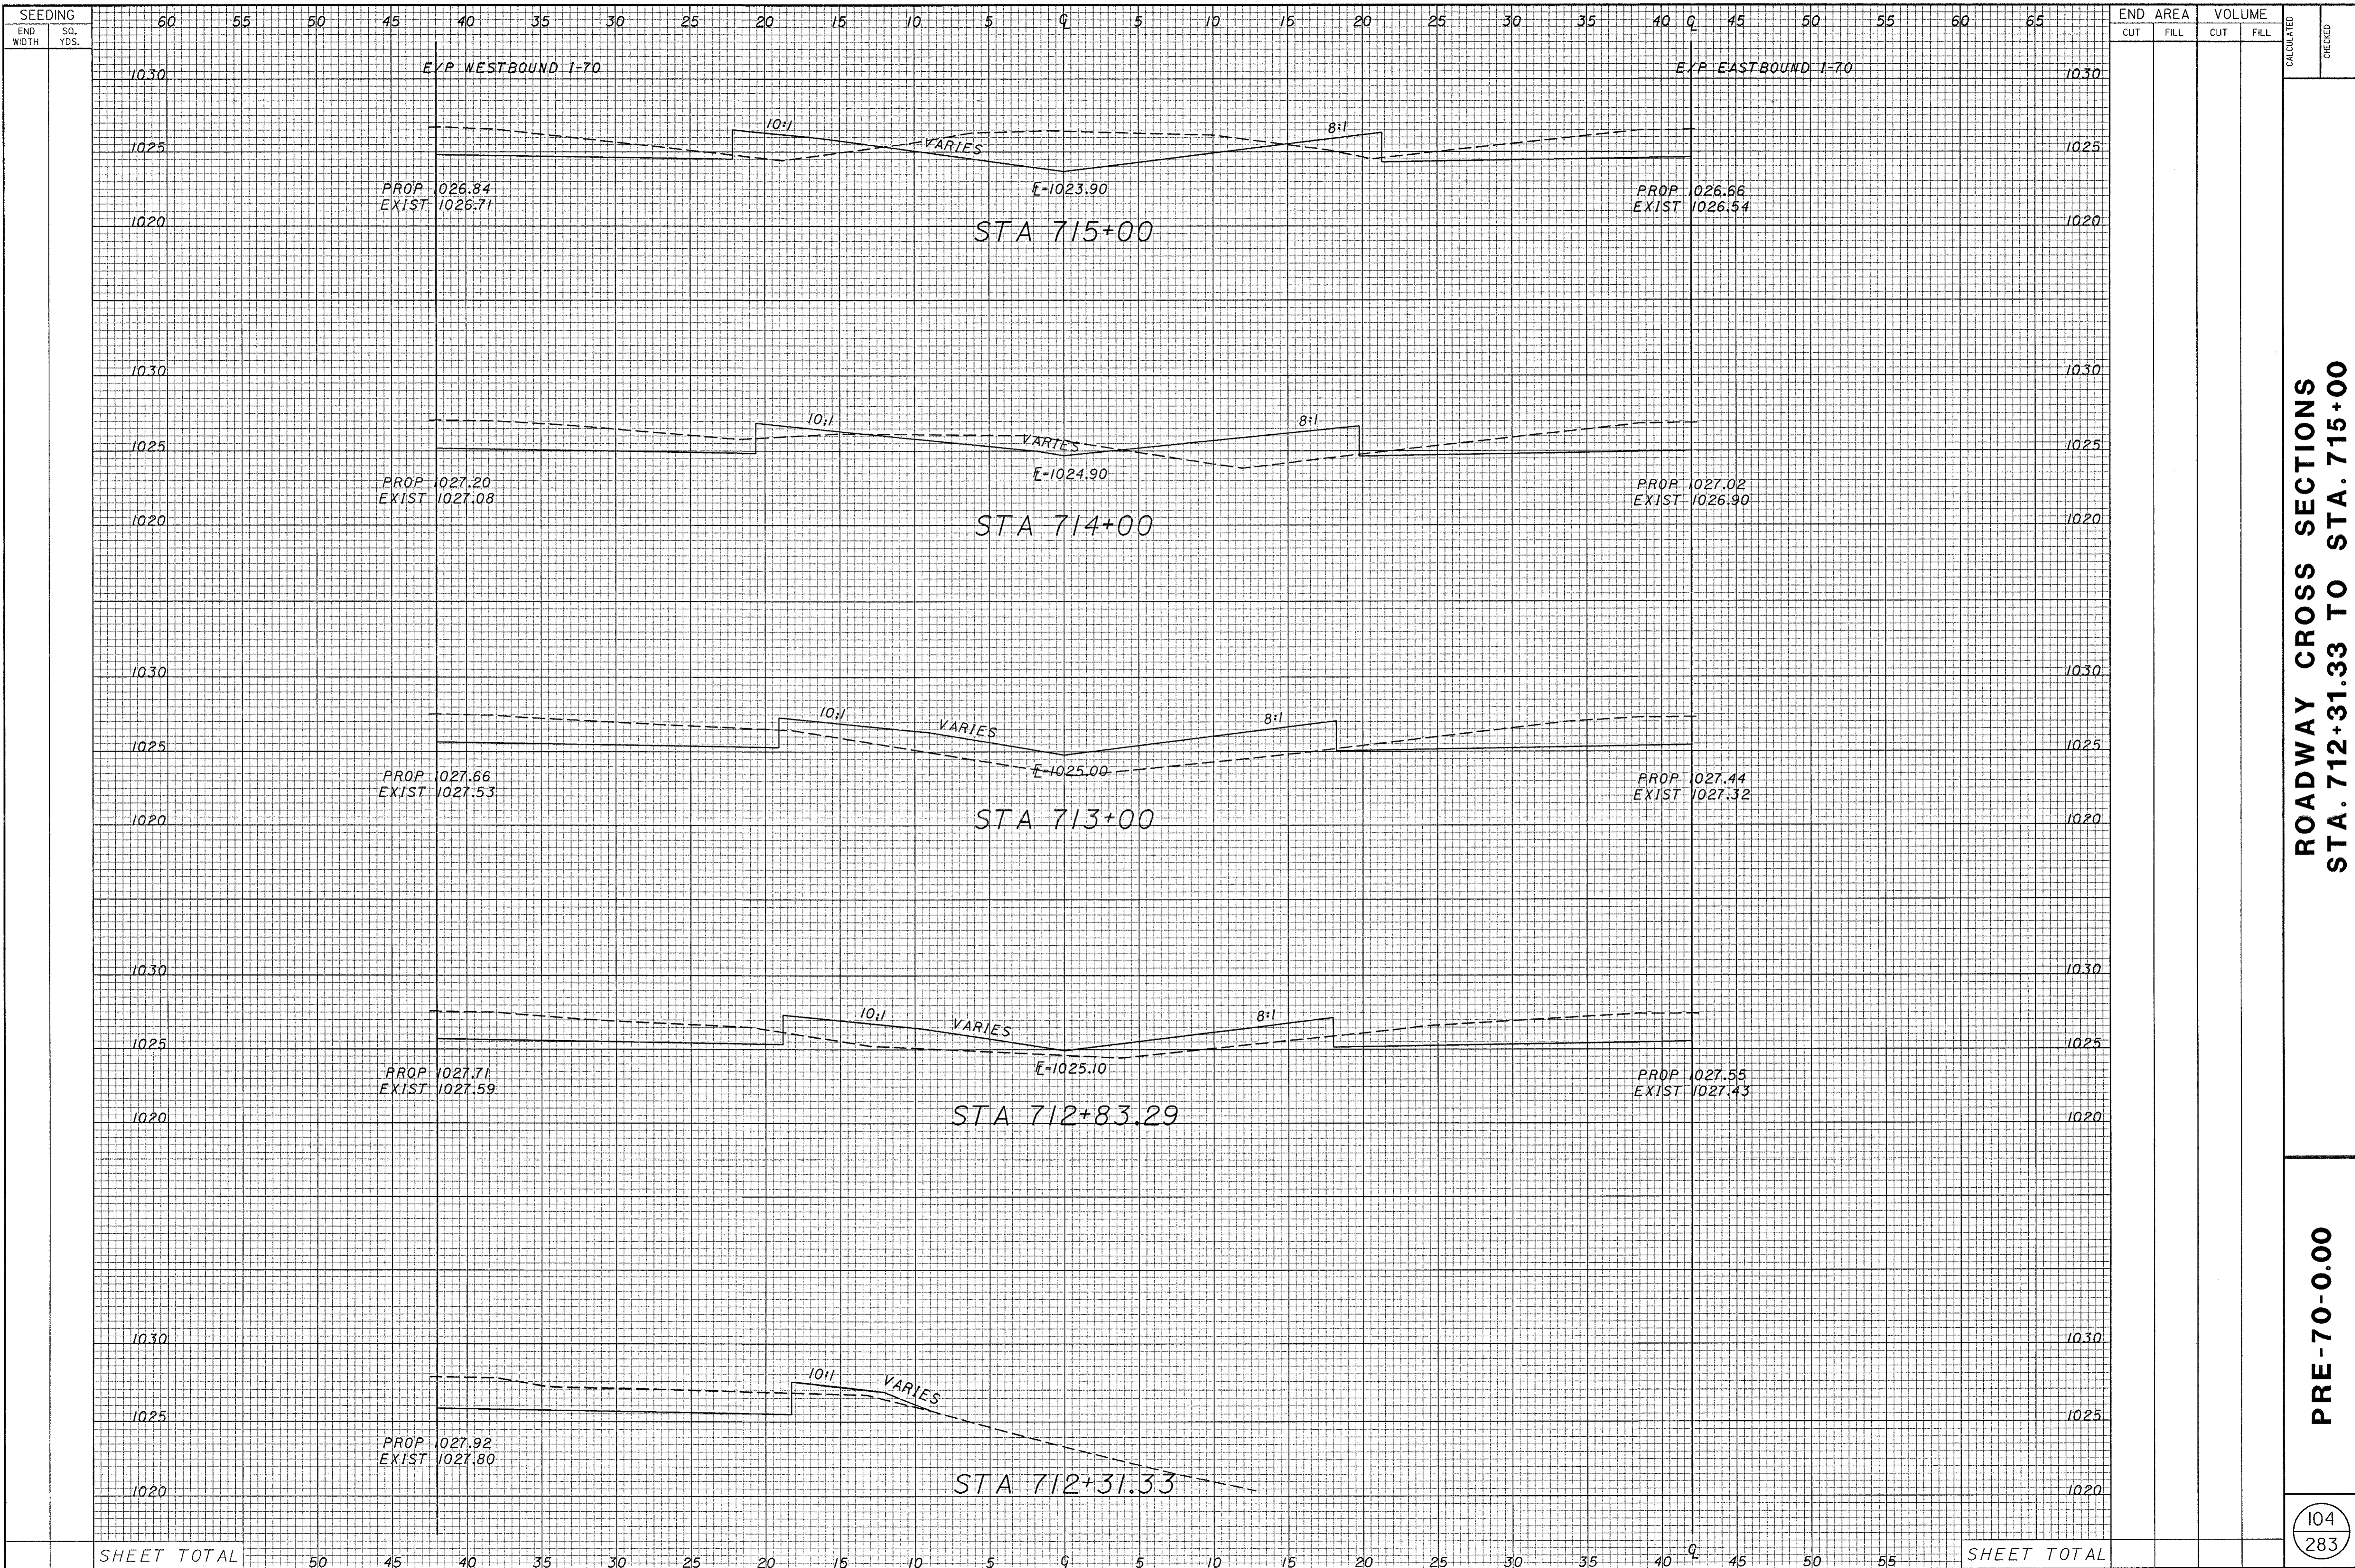


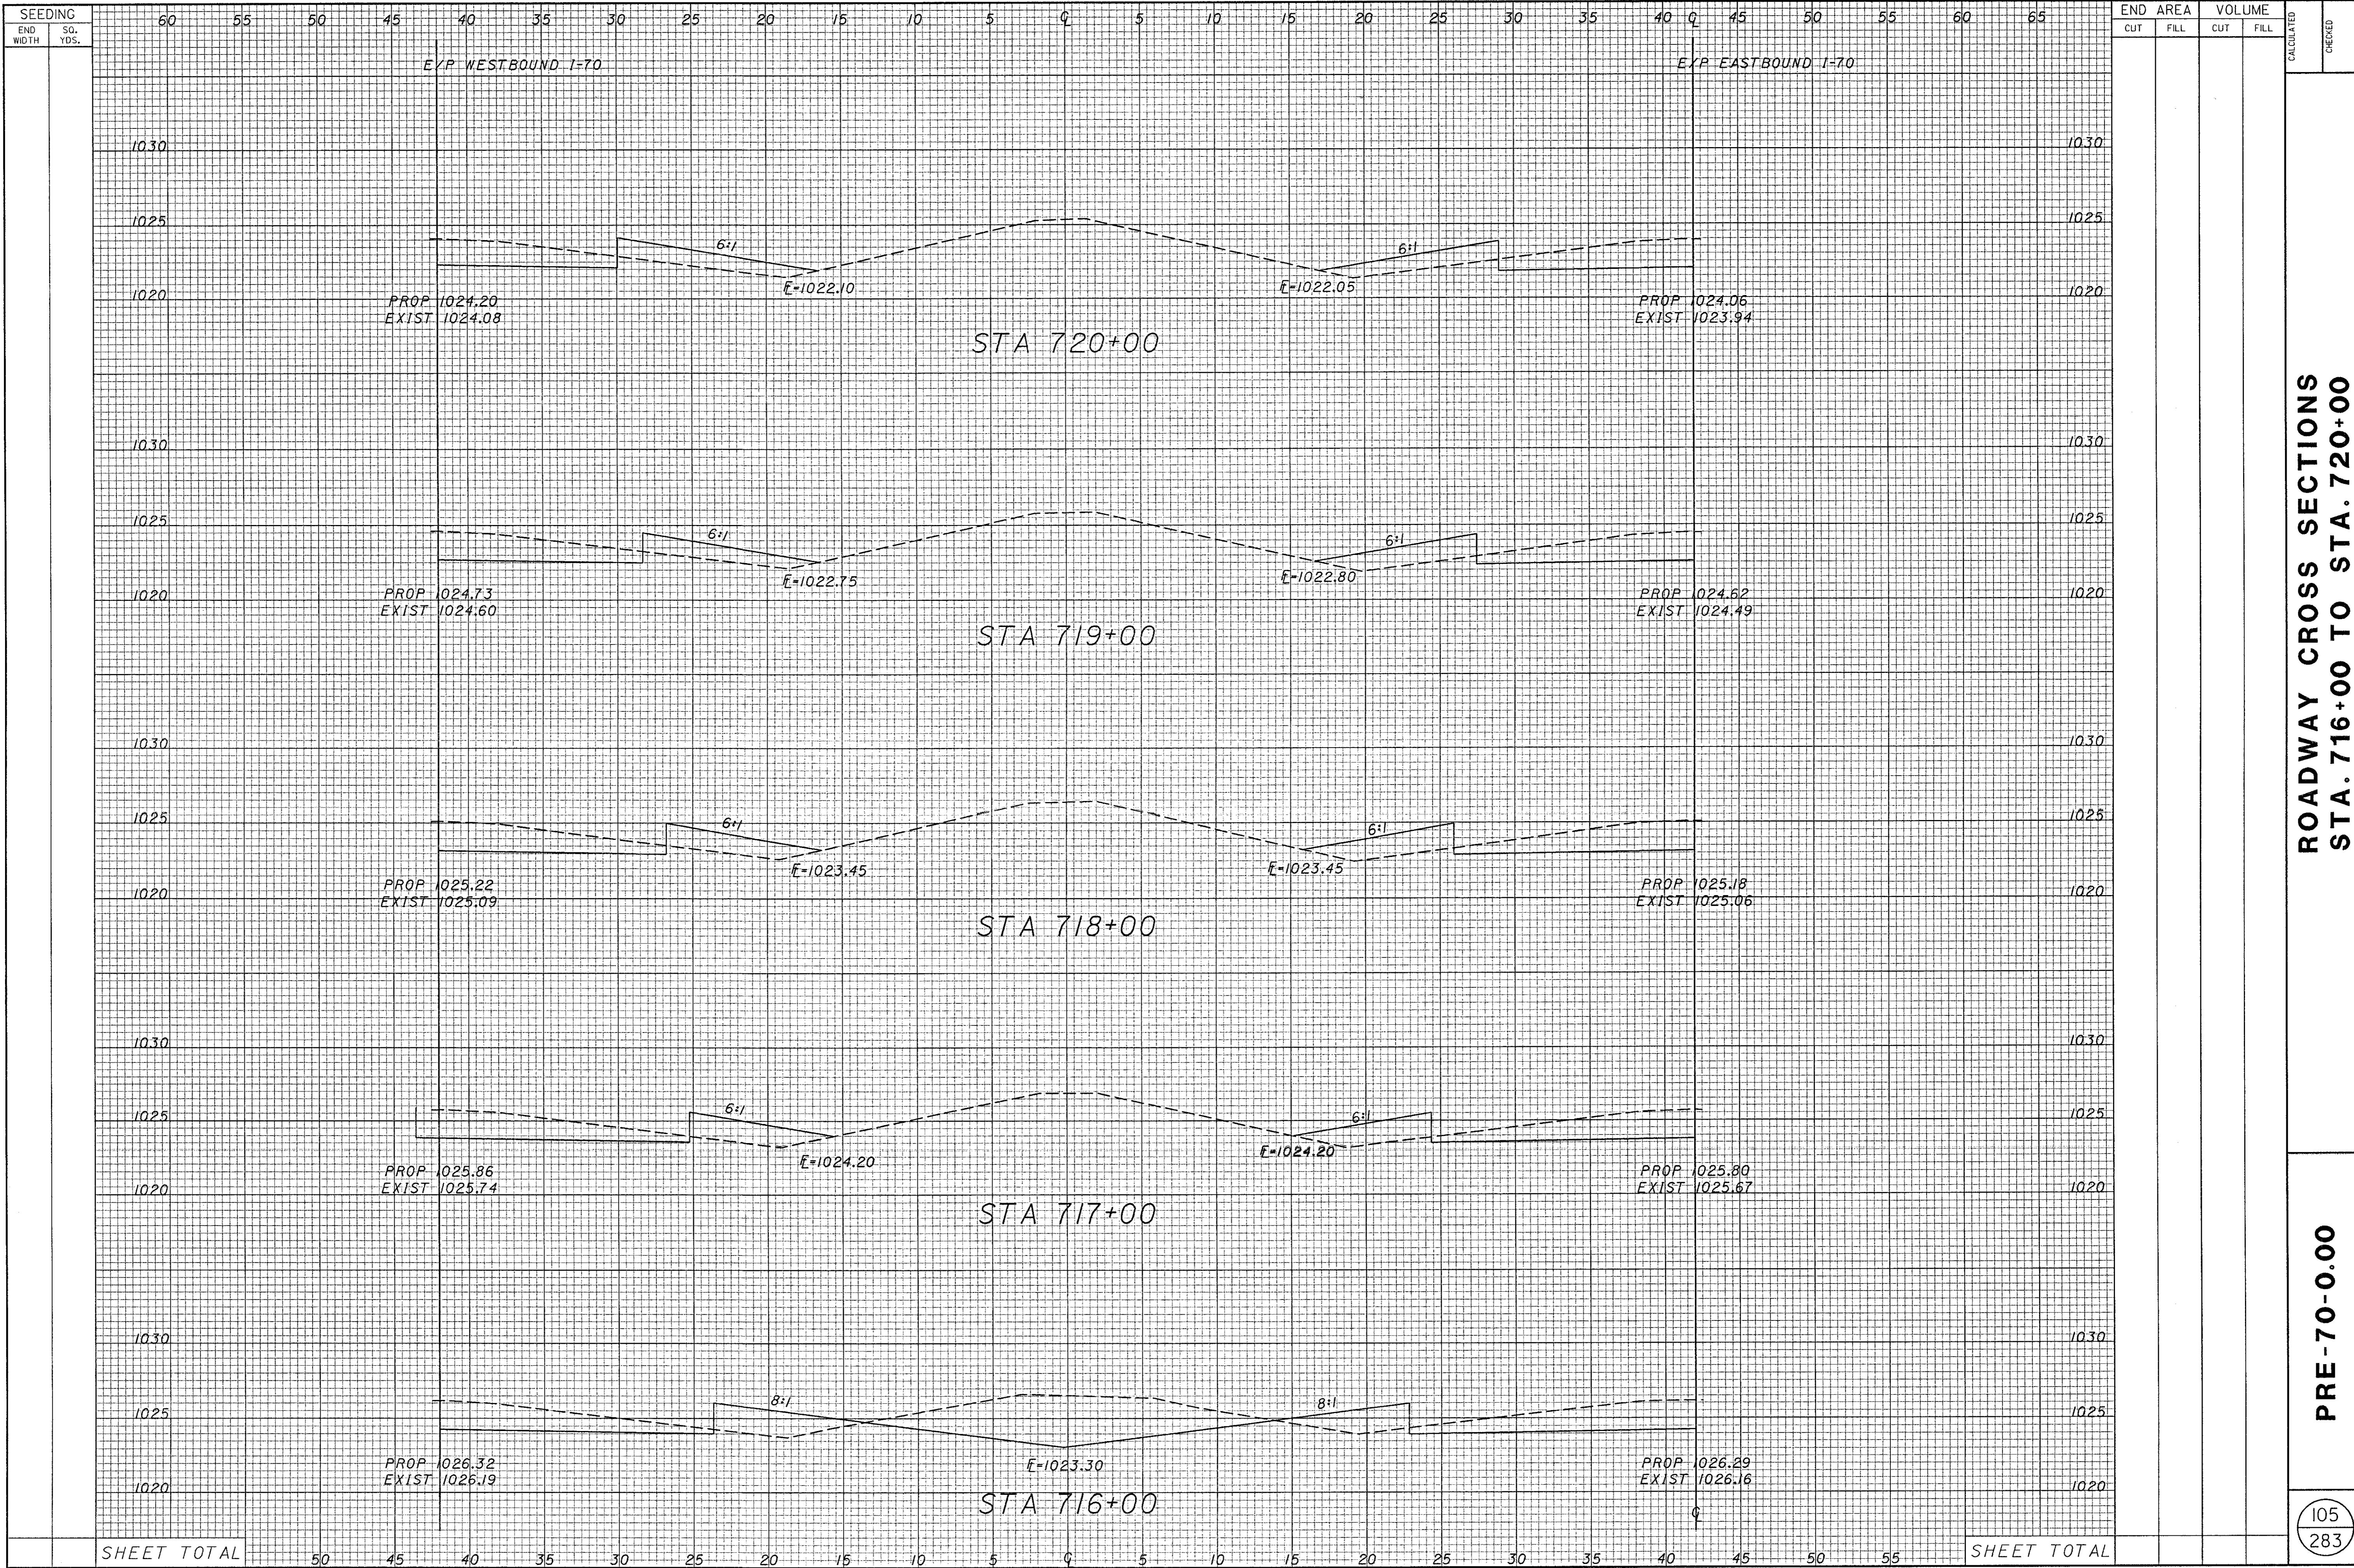

SEEDING	
END WIDTH	SQ. YDS.

END AREA		VOLUME	
CUT	FILL	CUT	FILL

CALCULATED
CHECKED

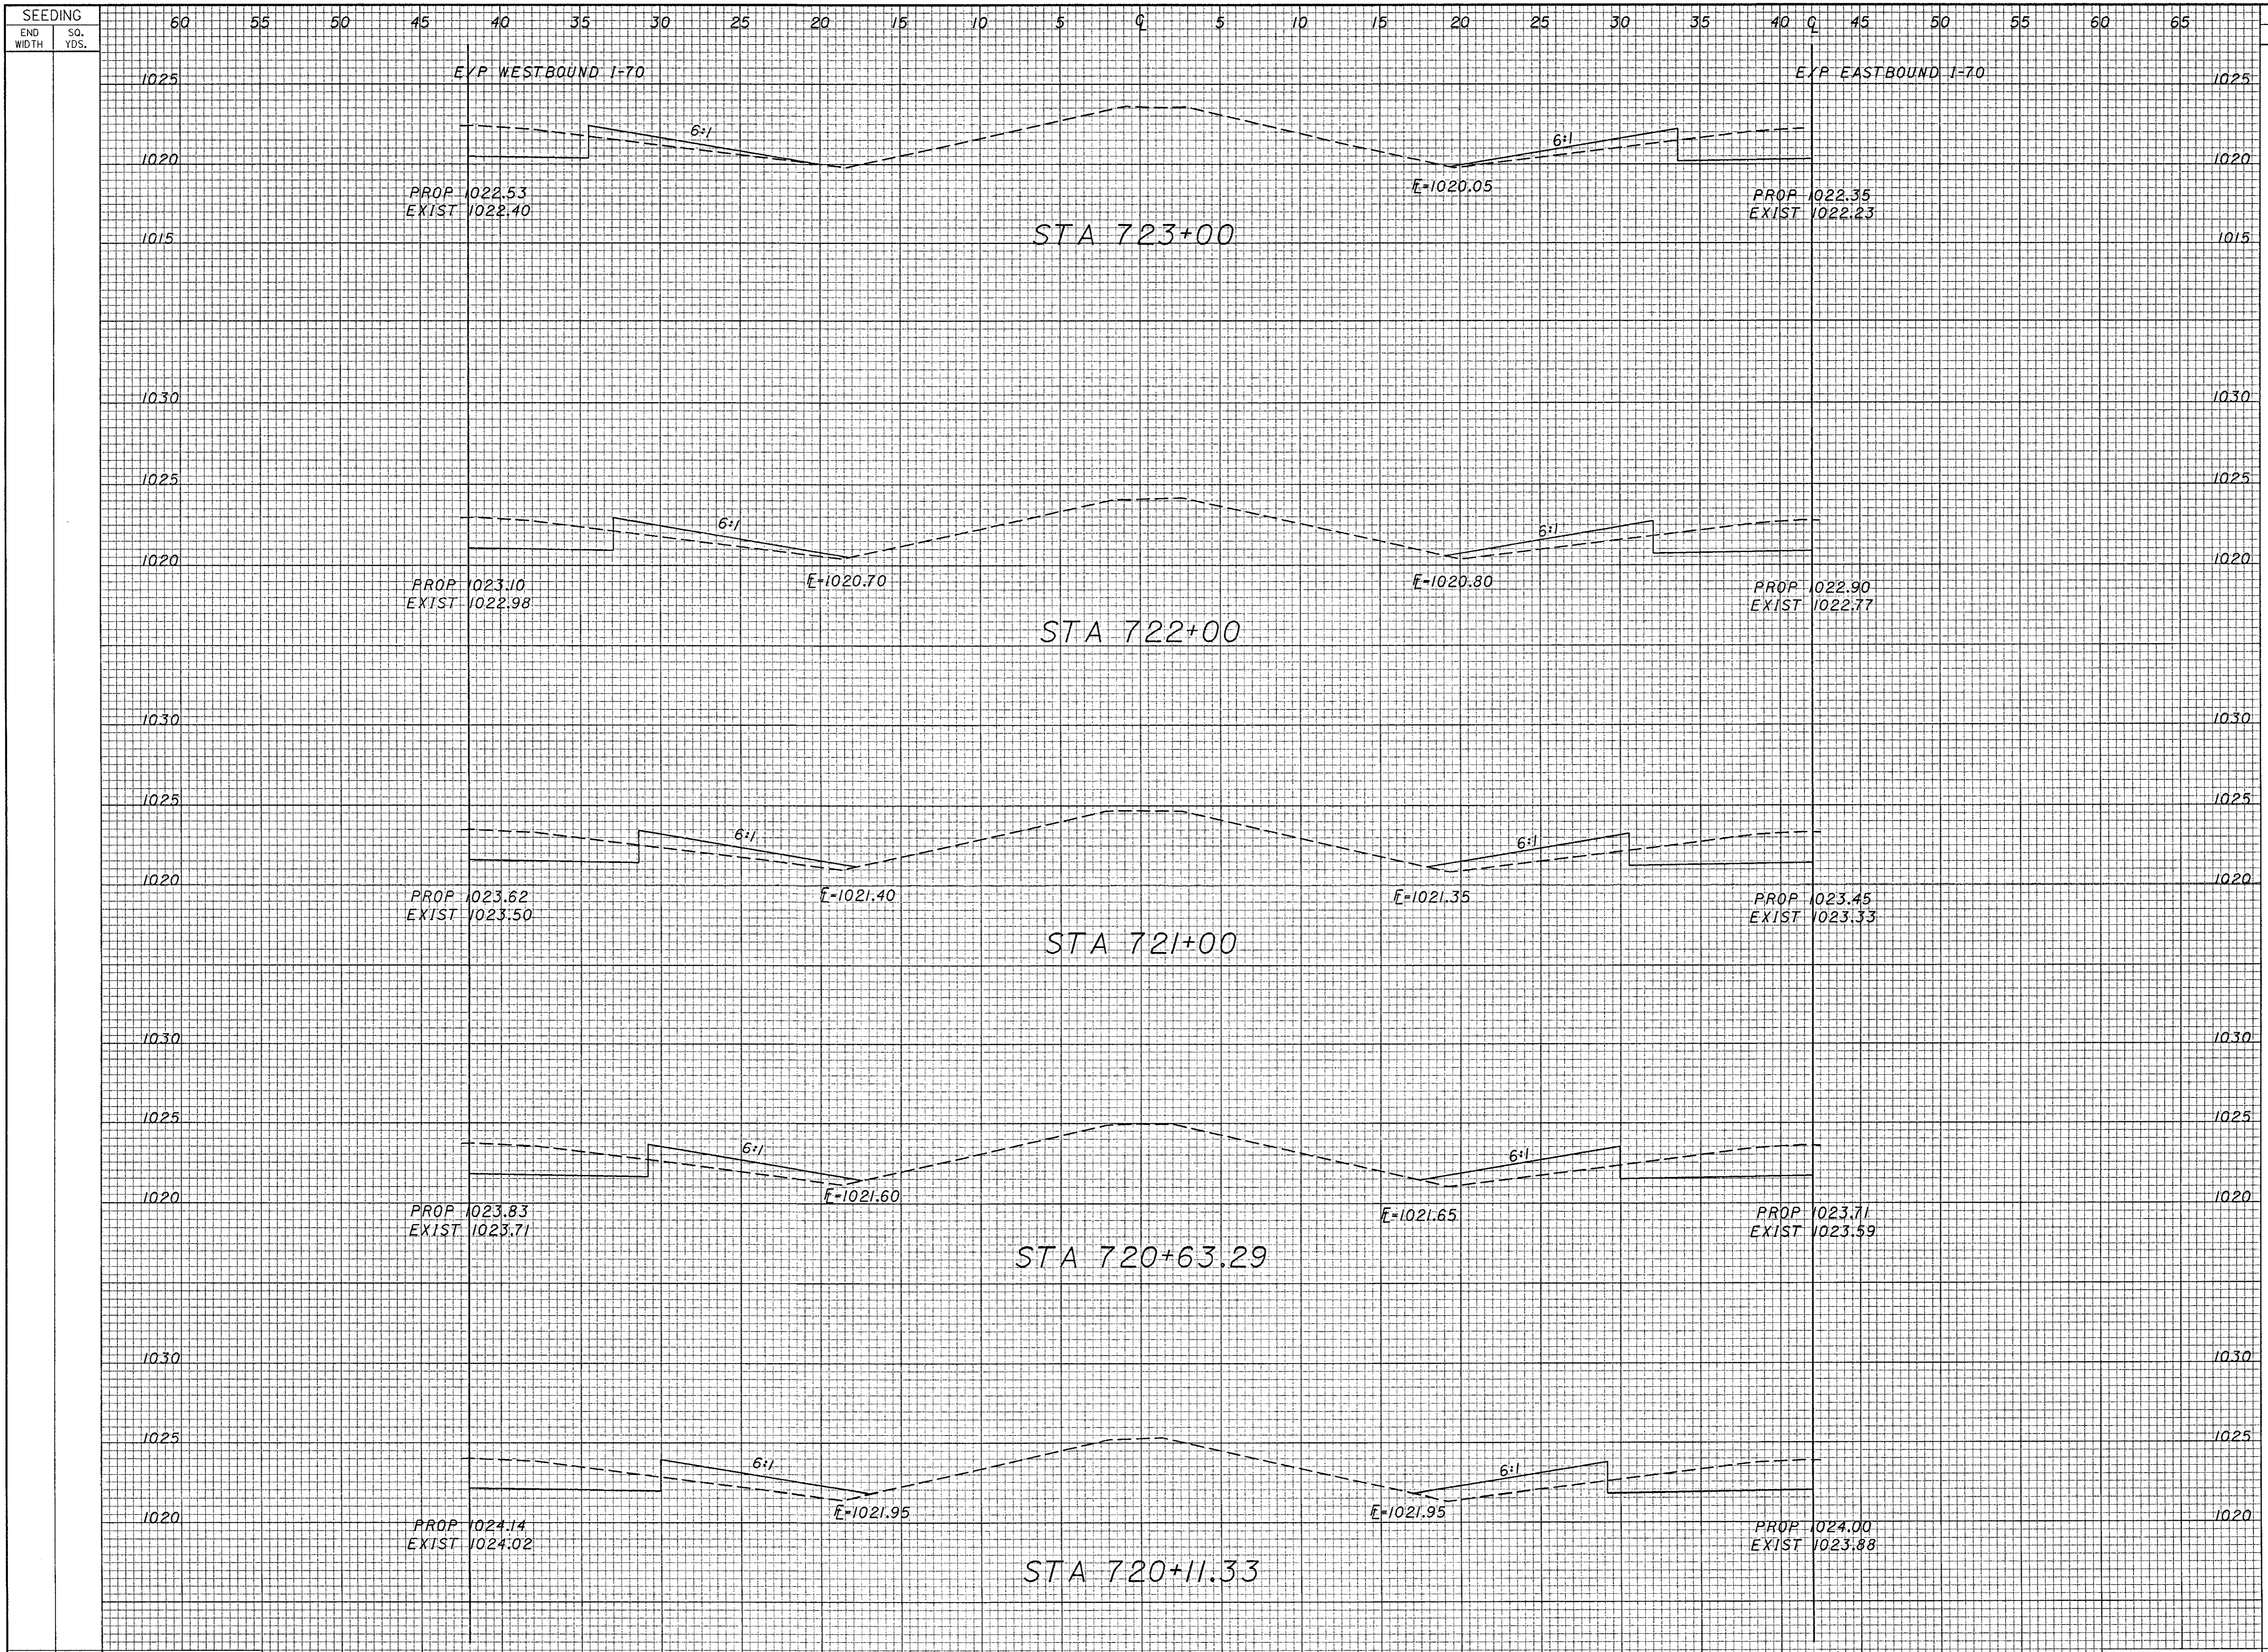

SHEET TOTAL

SHEET TOTAL

ROADWAY CROSS SECTIONS
STA. 720+11.33 TO STA. 723+00

PRE-70-0.00

106
283

SEEDING
END
WIDTH

SO.
YDS.

60 55 50 45 40 35 30 25 20 15 10 5 0 5 10 15 20 25 30 35 40 45 50 55 60 65

END
CUT

AREA
FILL

VOLUME
CUT

FILL

CALCULATED

CHECKED

E/P WESTBOUND I-70

E/P EASTBOUND I-70

1025

1025

1020

1020

1015

1015

STA 725+83.29

PROP 1020.84
EXIST 1020.72

6:1

1025

1025

1020

1020

1015

1015

STA 725+31.33

PROP 1021.15
EXIST 1021.02

PROP 1021.11
EXIST 1020.99

6:1

6:1

1025

1025

1020

1020

1015

1015

STA 725+00

PROP 1021.32
EXIST 1021.20

PROP 1021.28
EXIST 1021.16

6:1

6:1

1025

1025

1020

1020

1015

1015

STA 724+00

PROP 1021.93
EXIST 1021.80

PROP 1021.83
EXIST 1021.71

6:1

6:1

SHEET TOTAL


50 45 40 35 30 25 20 15 10 5 0 5 10 15 20 25 30 35 40 45 50 55


SHEET TOTAL

ROADWAY CROSS SECTIONS
STA. 724+00 TO STA. 725+83.29


PRE-70-0.00

107
283

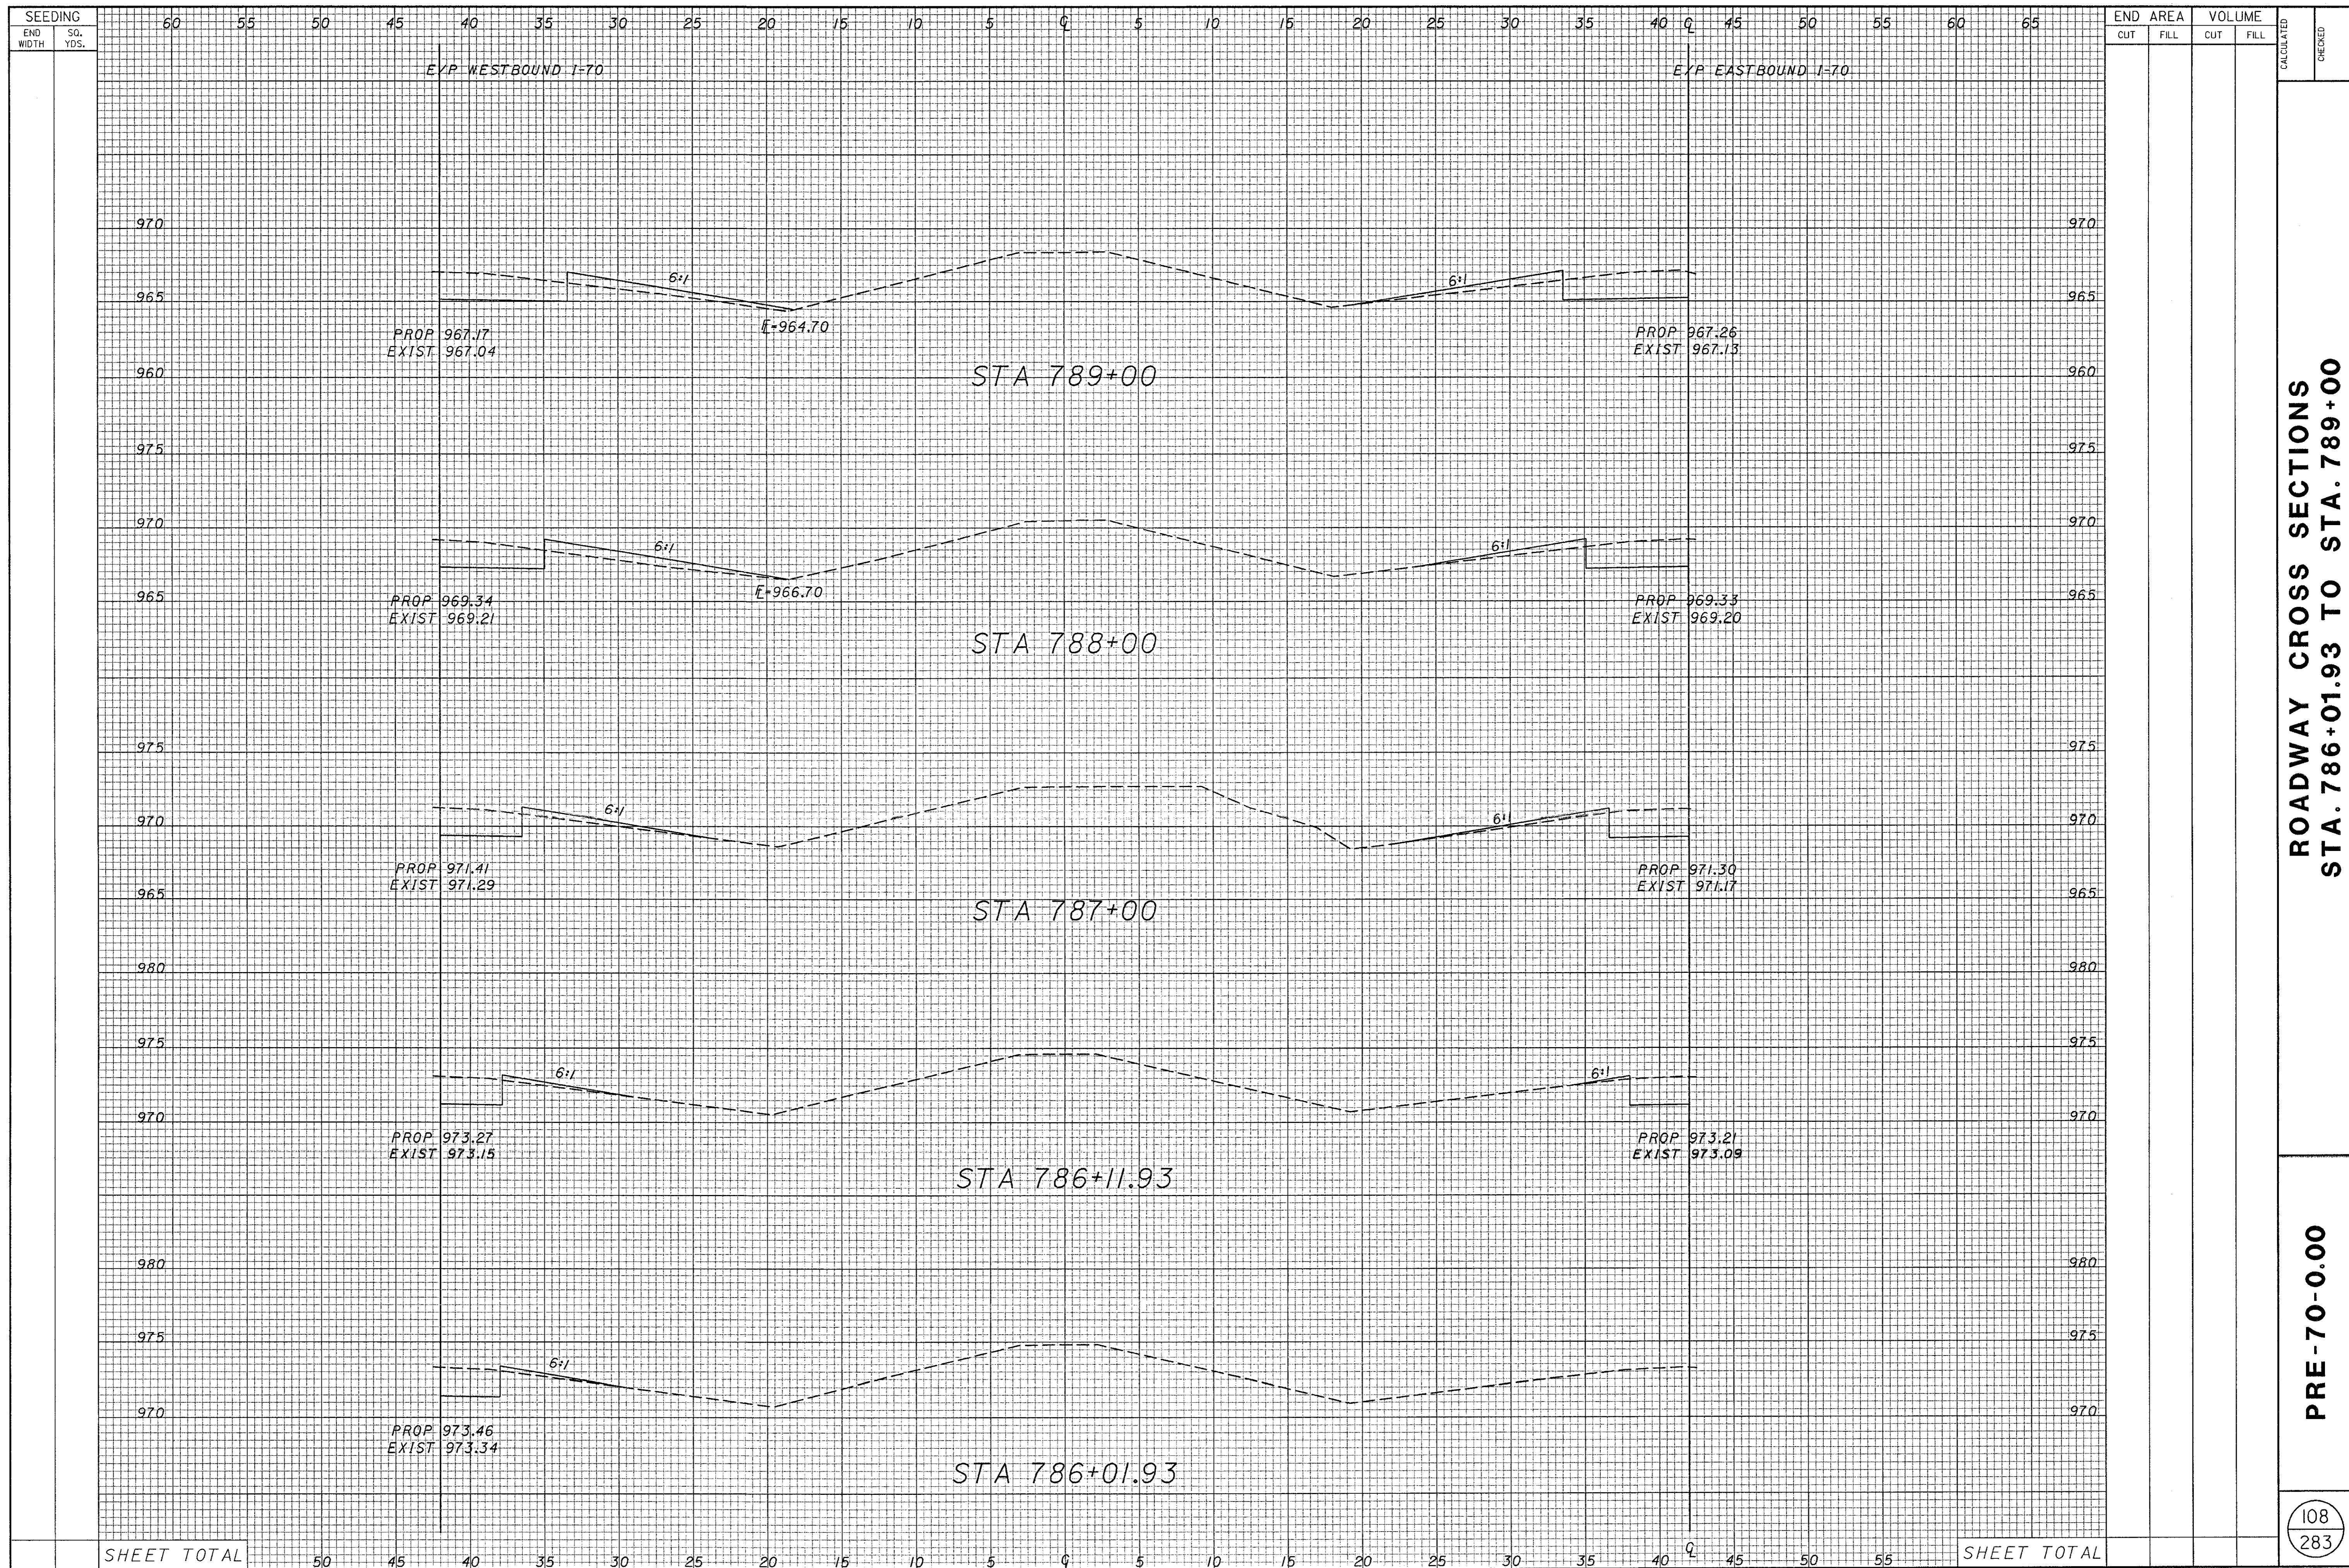

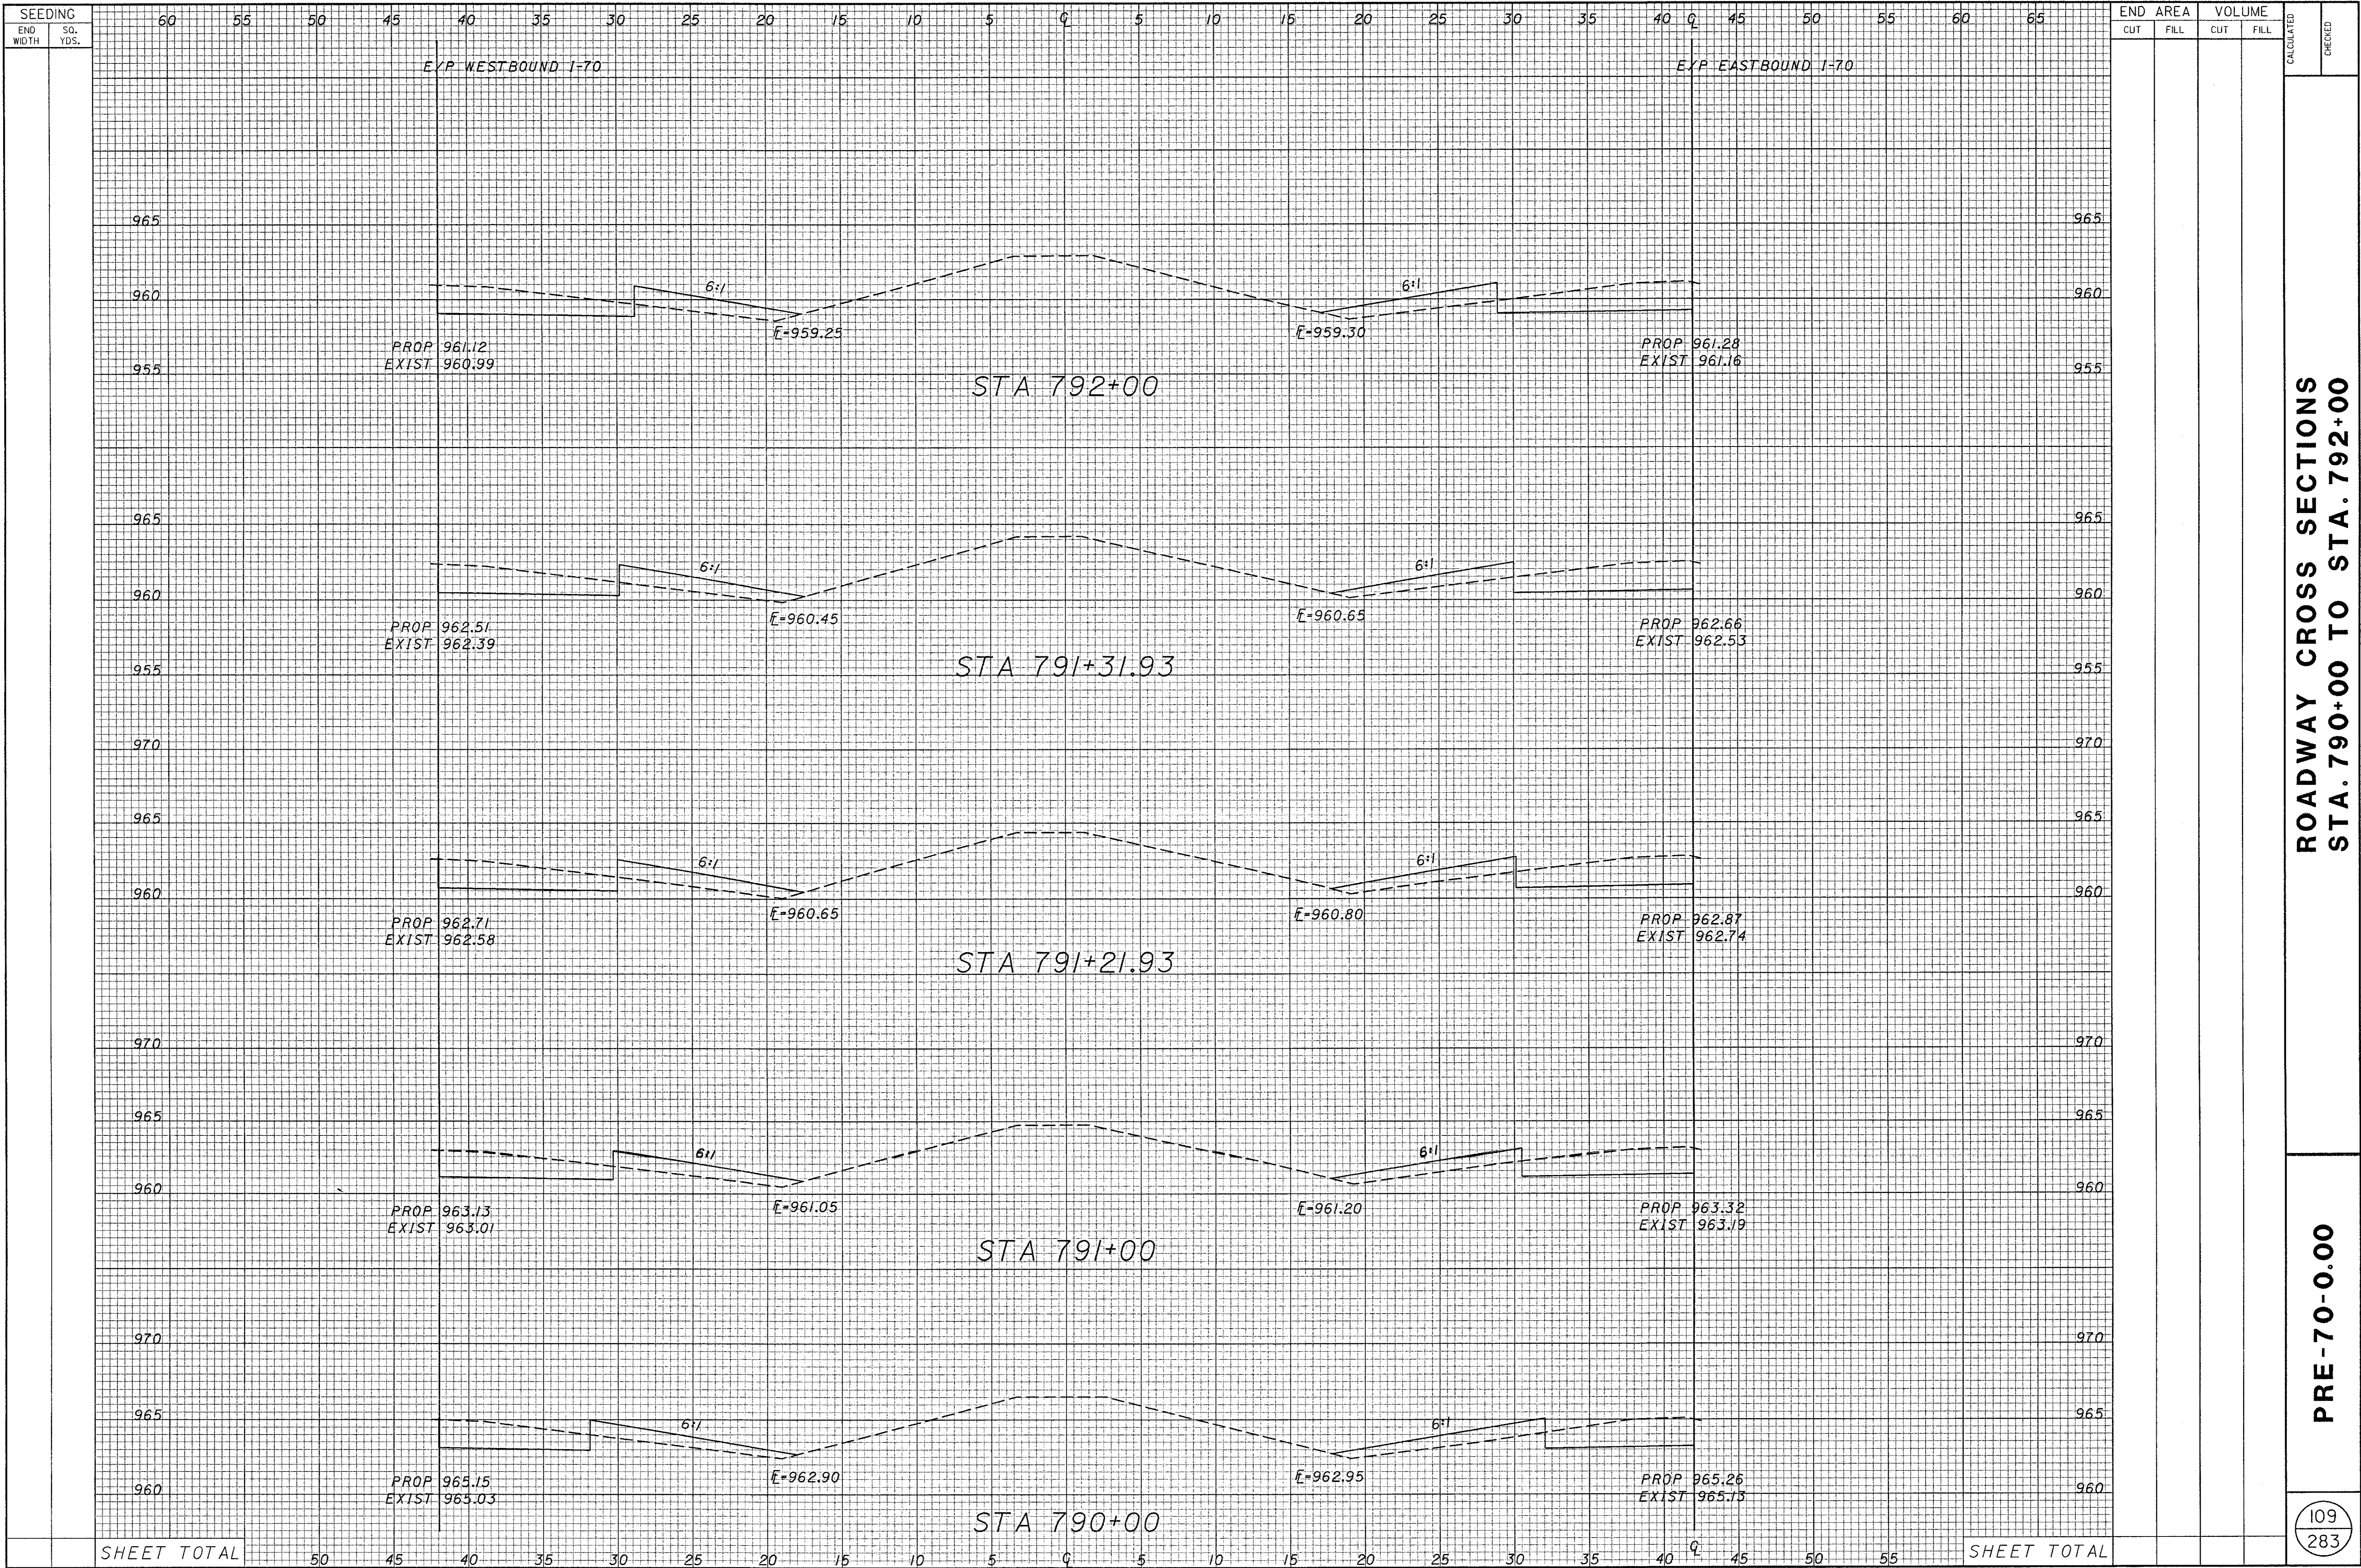

SEEDING
END WIDTH SQ. YDS.

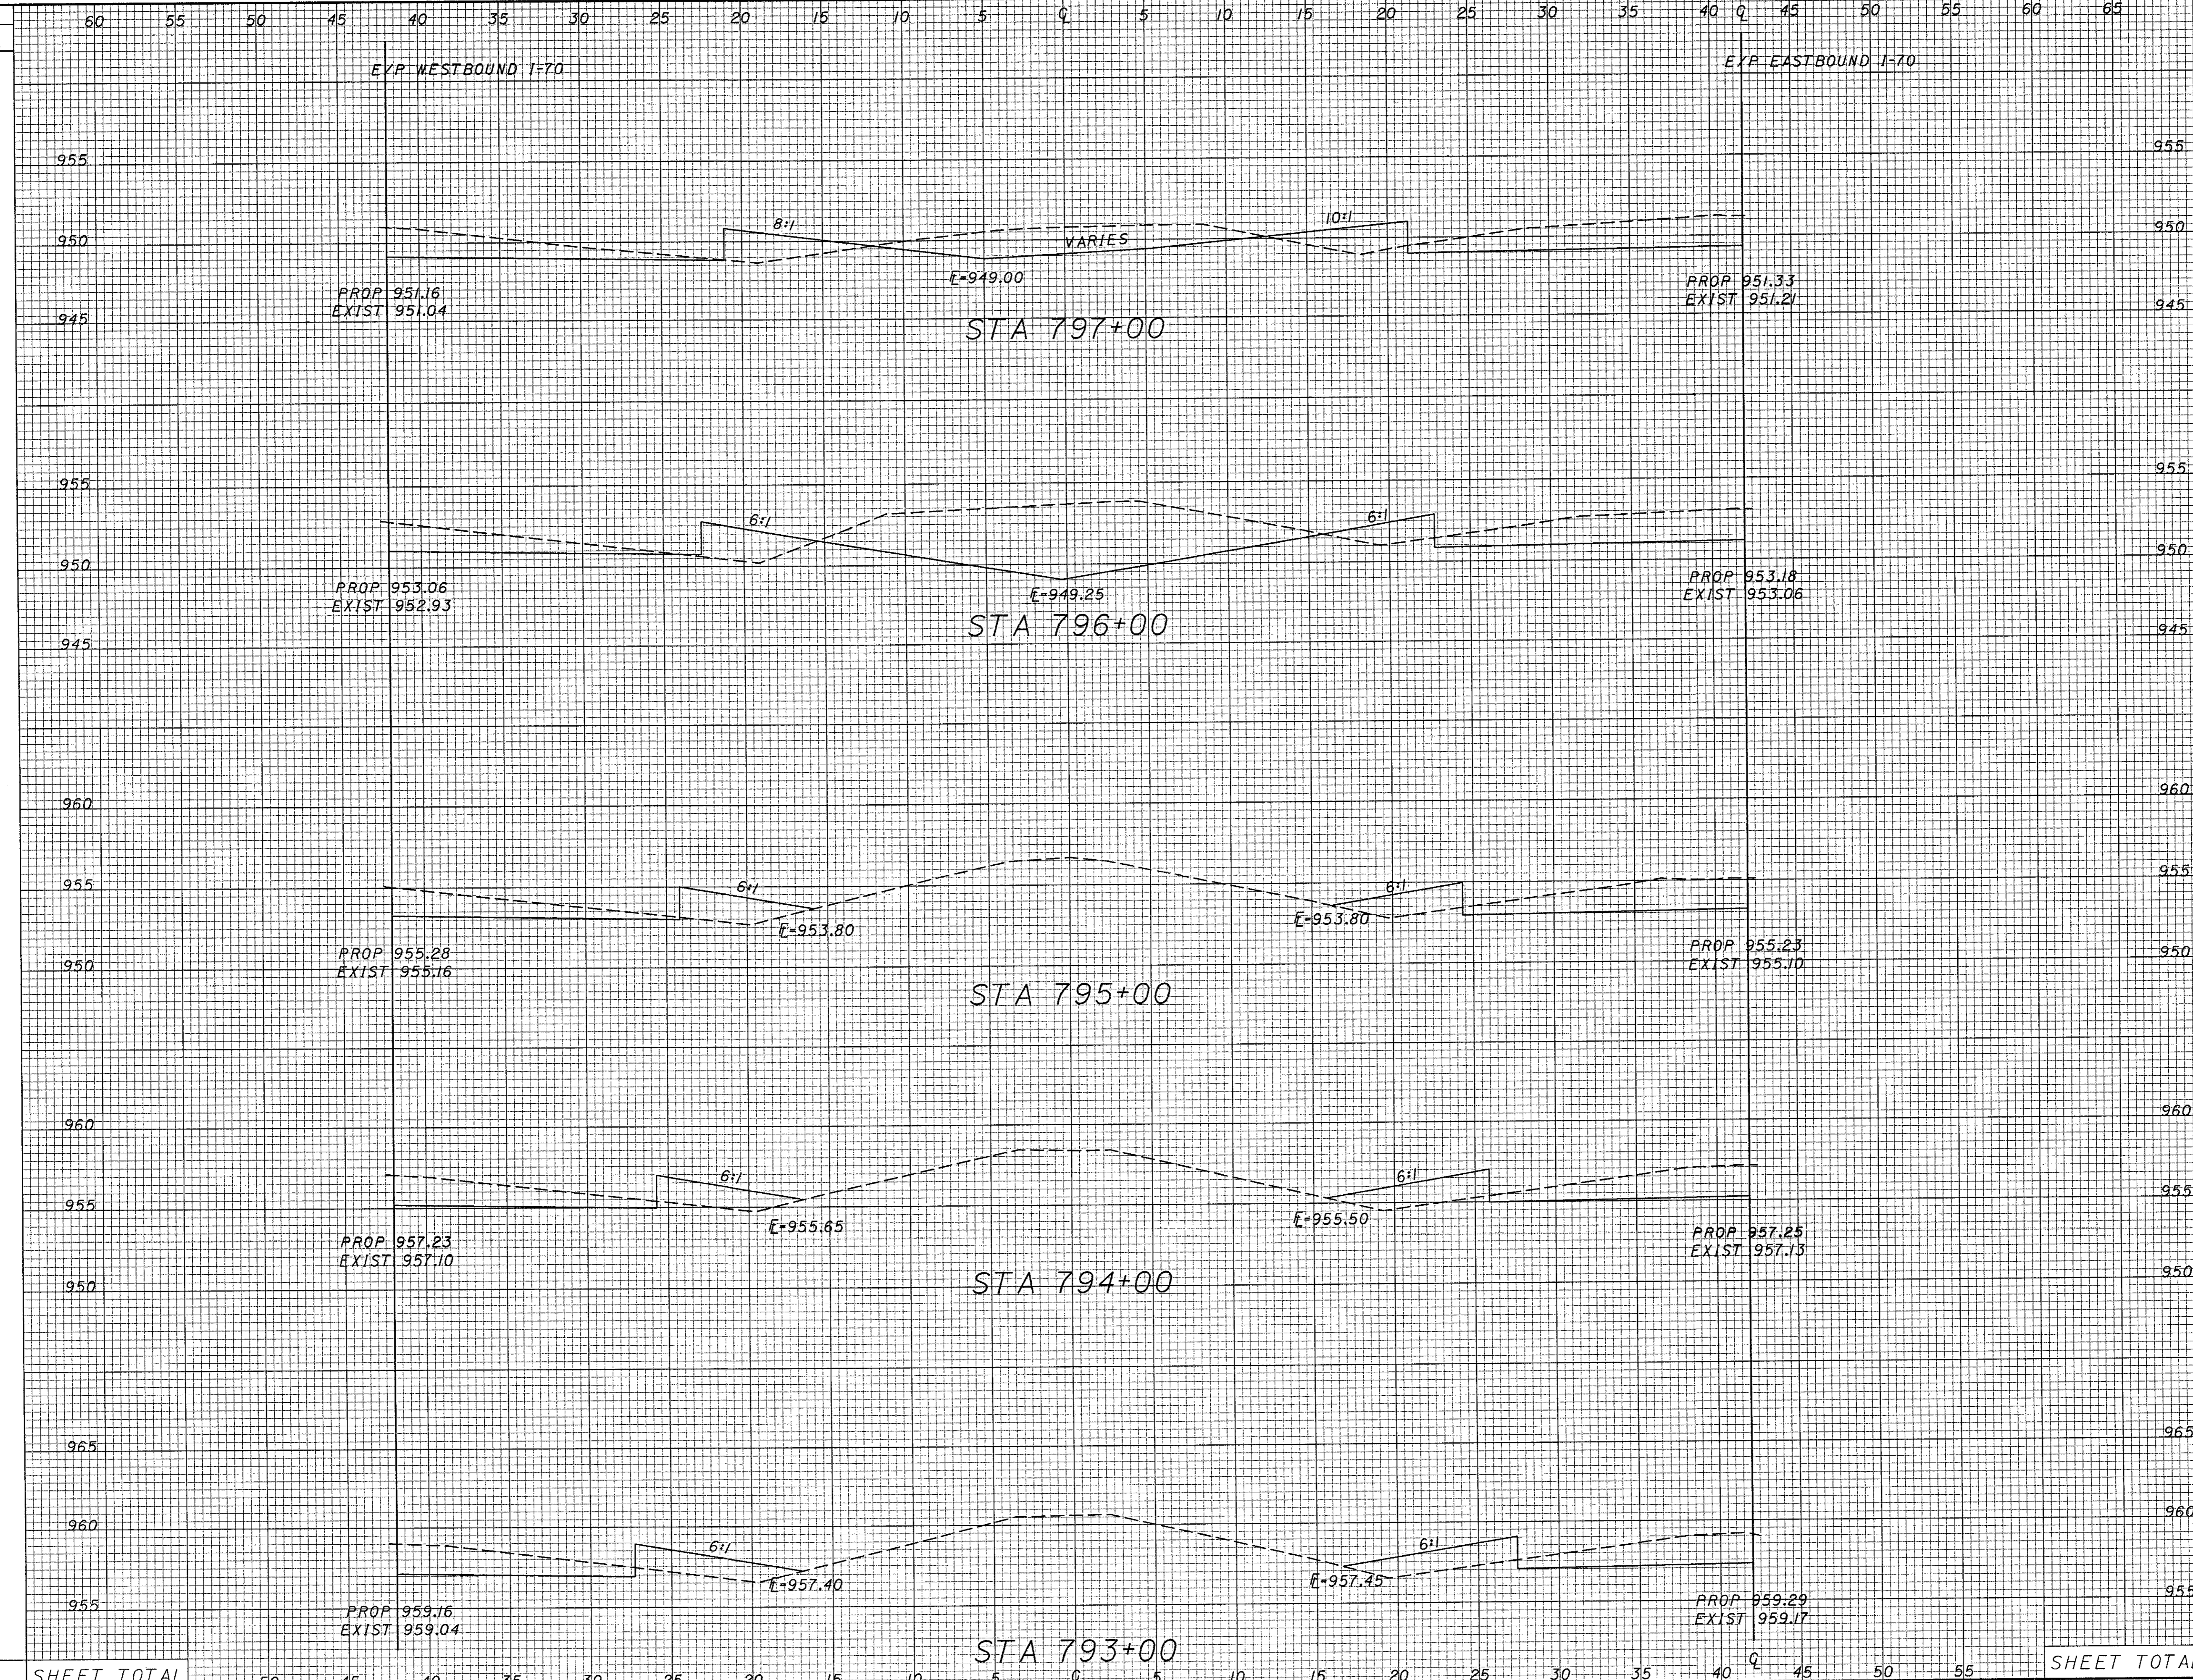

END AREA		VOLUME	
CUT	FILL	CUT	FILL

CALCULATED
CHECKED


ROADWAY CROSS SECTIONS
STA. 793+00 TO STA. 797+00

PRE-70-0.00

110
283


SHEET TOTAL

SHEET TOTAL

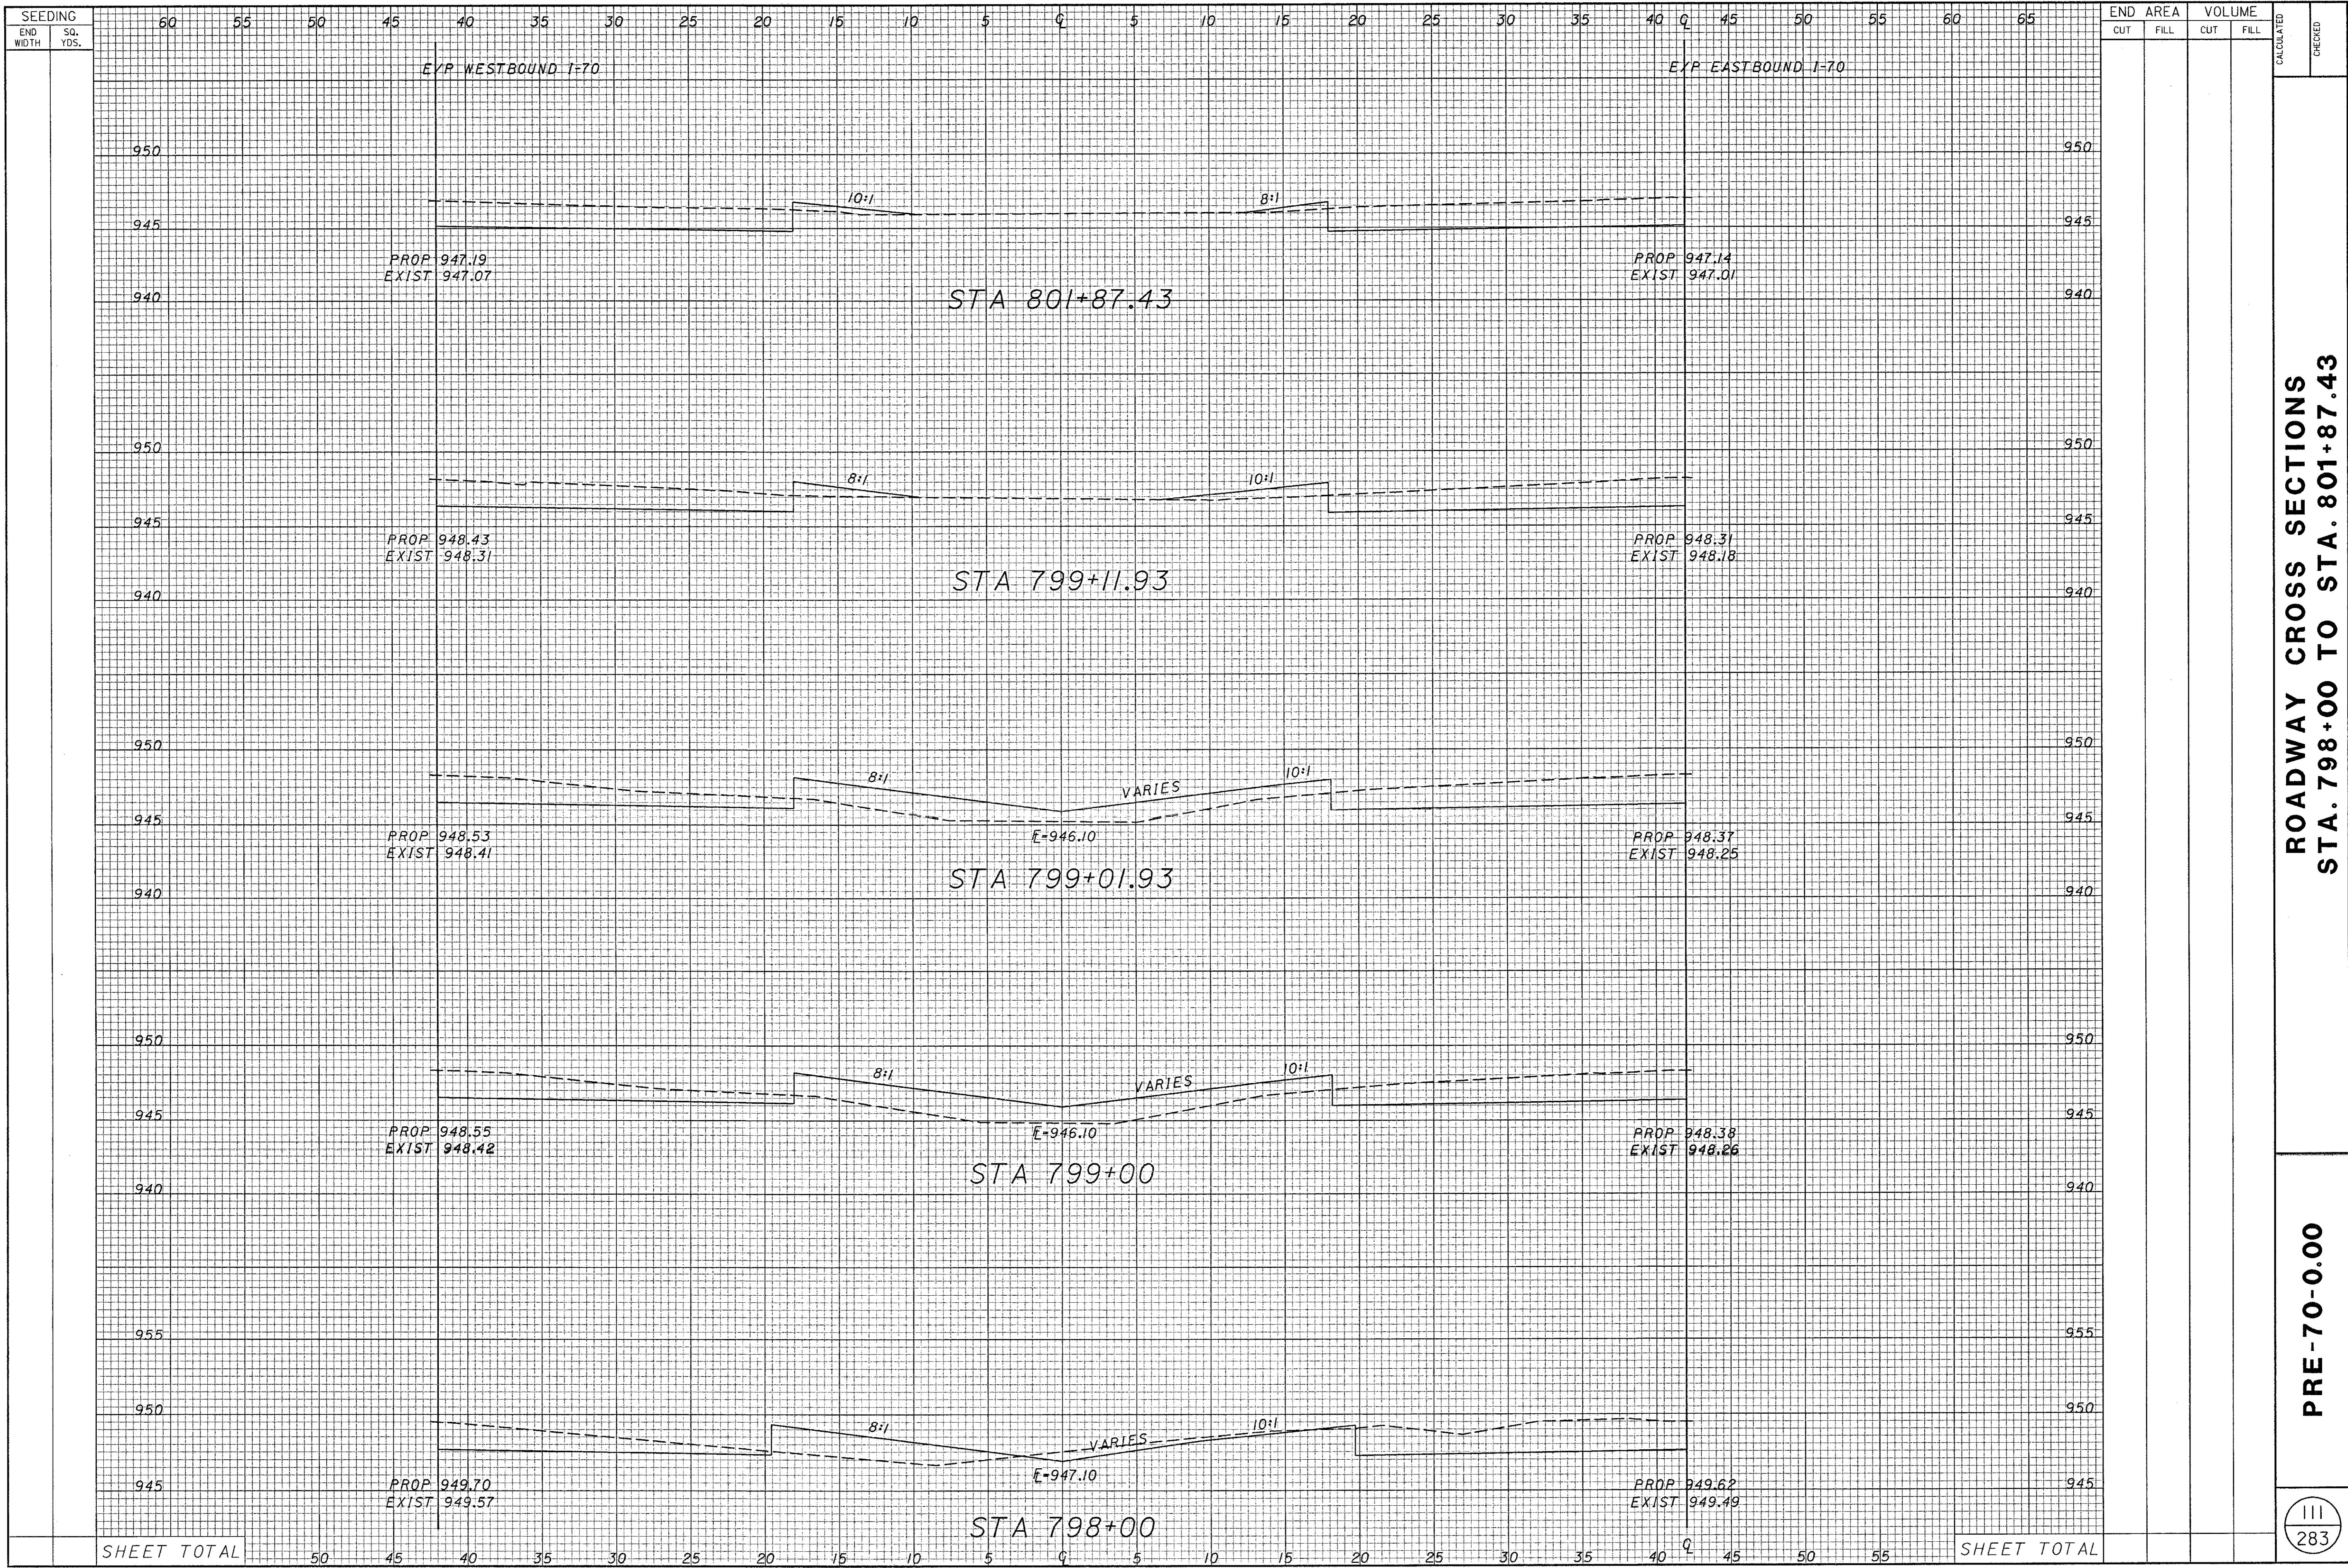


ROADWAY CROSS SECTIONS
STA. 798+00 TO STA. 801+87.43

PRE-70-0.00

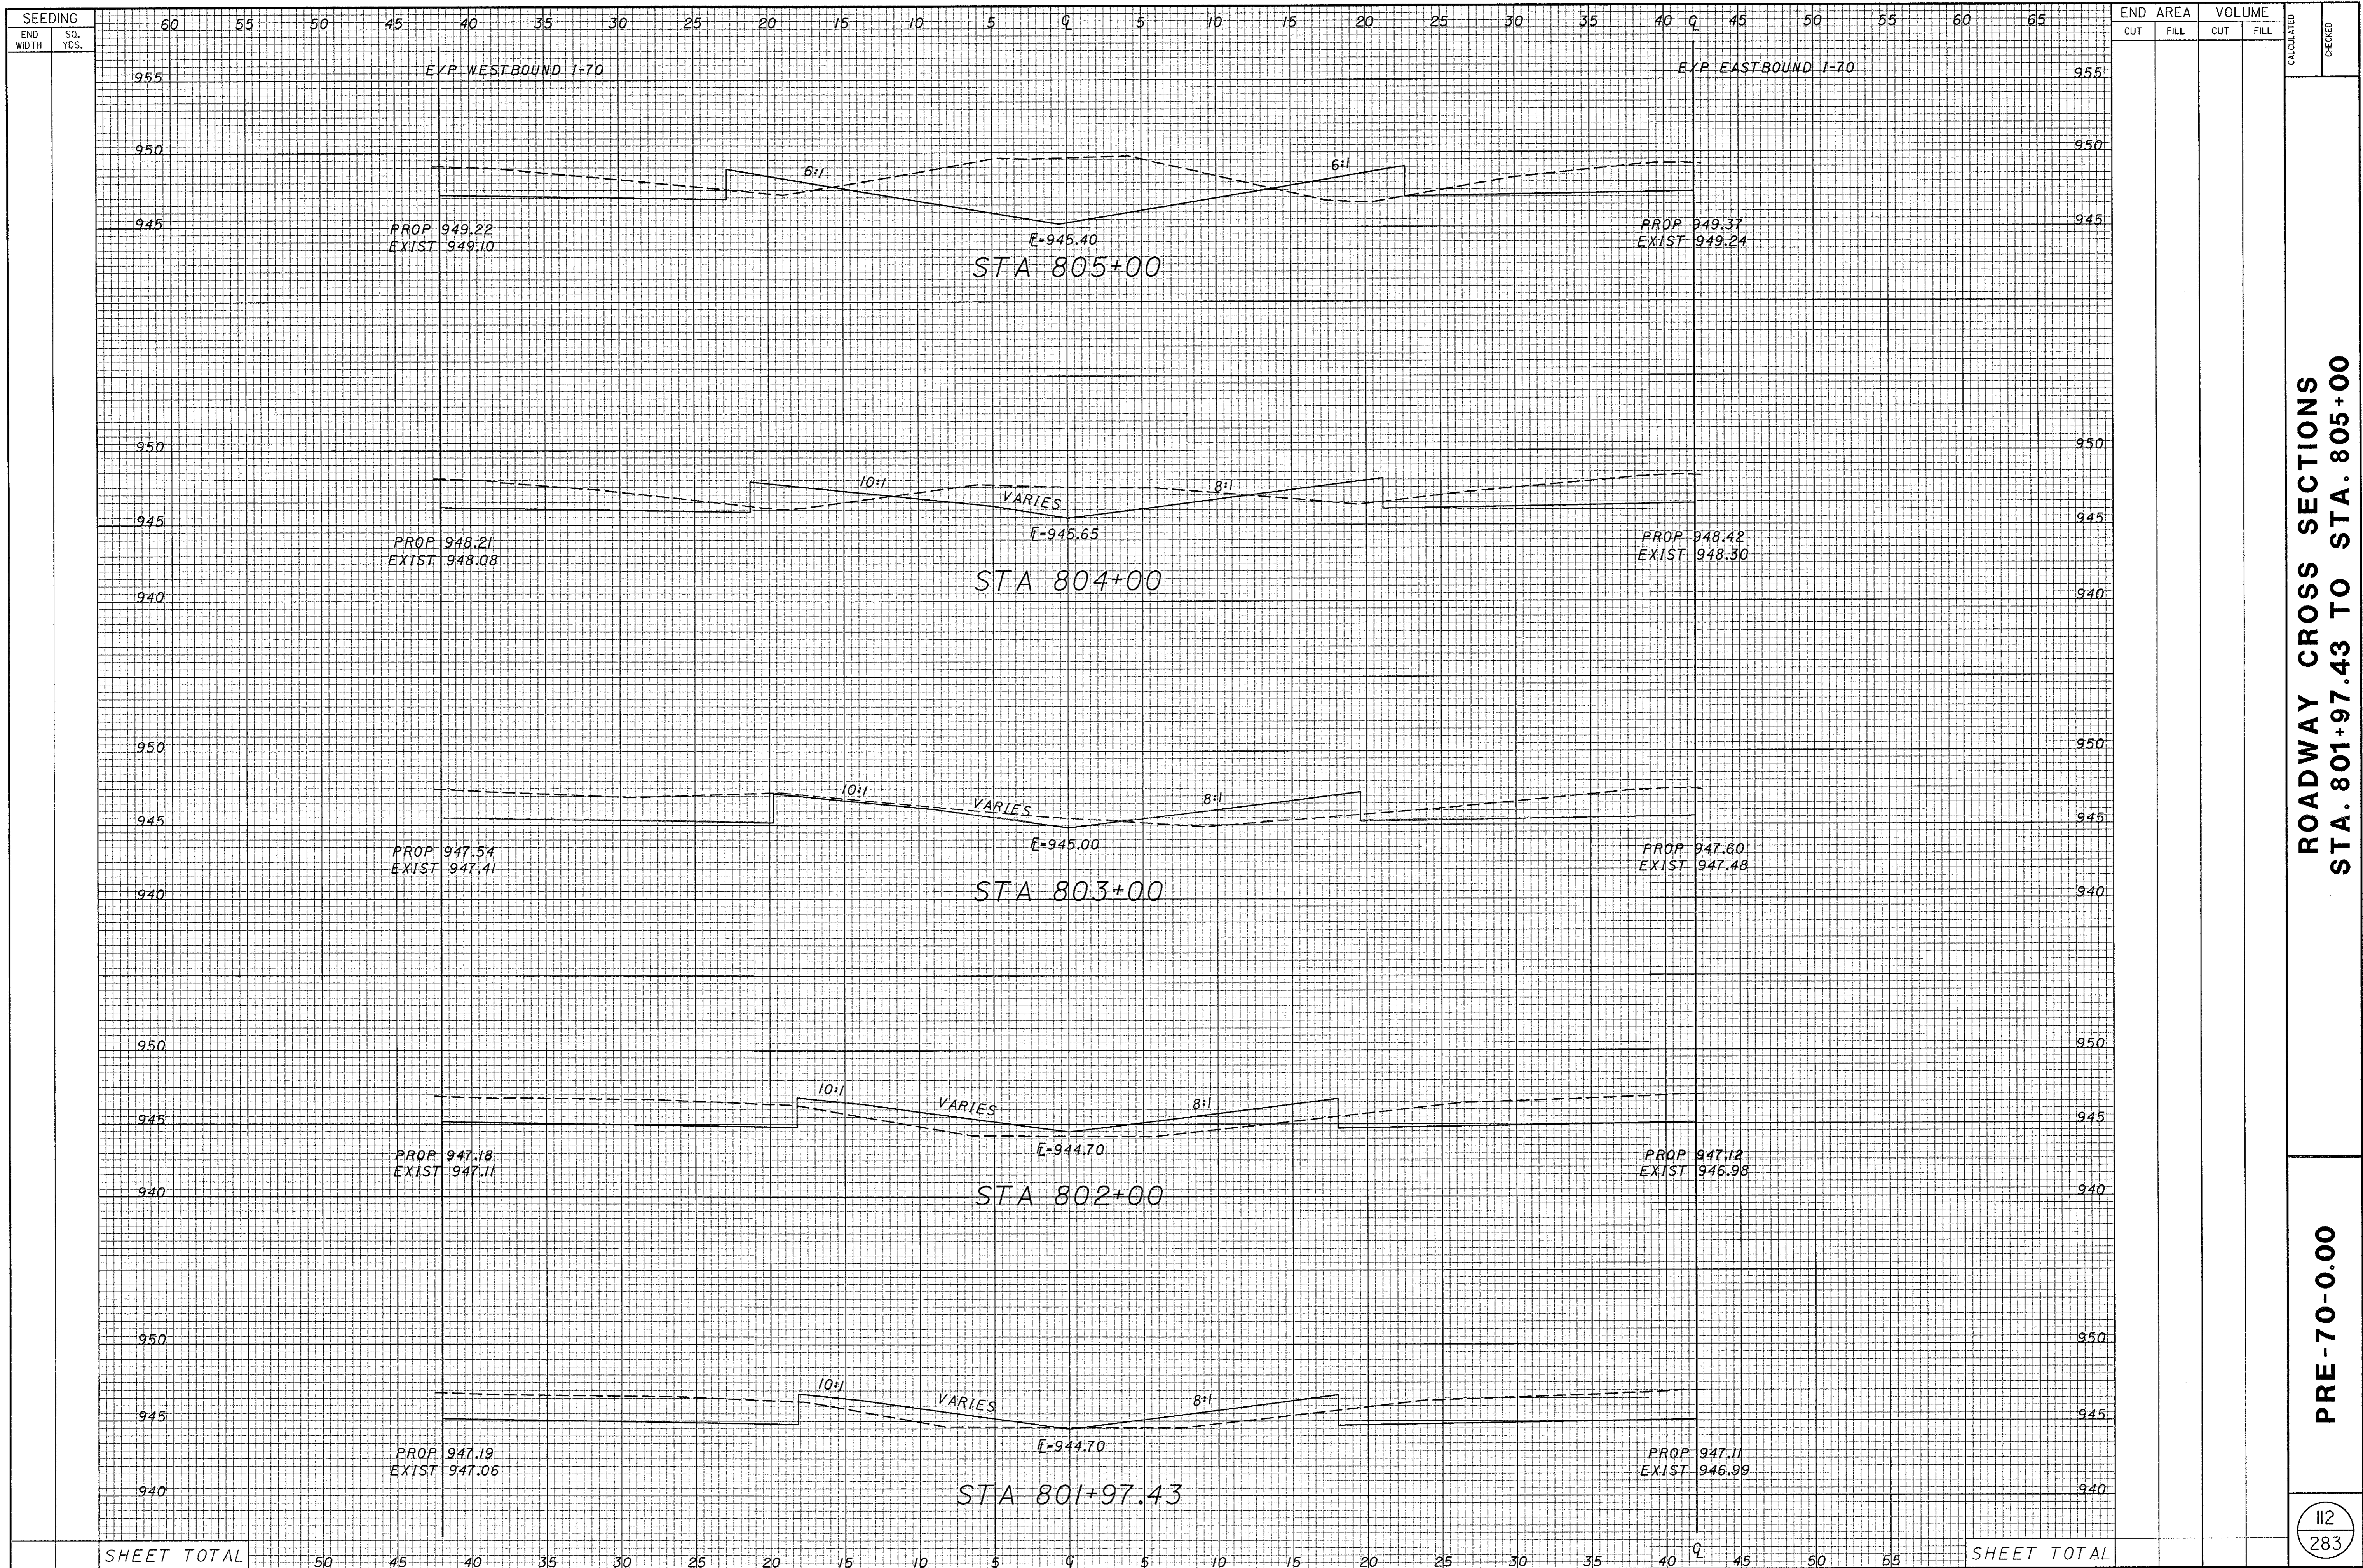

ROADWAY CROSS SECTIONS
STA. 801+97.43 TO STA. 805+00


PRE-70-0.00

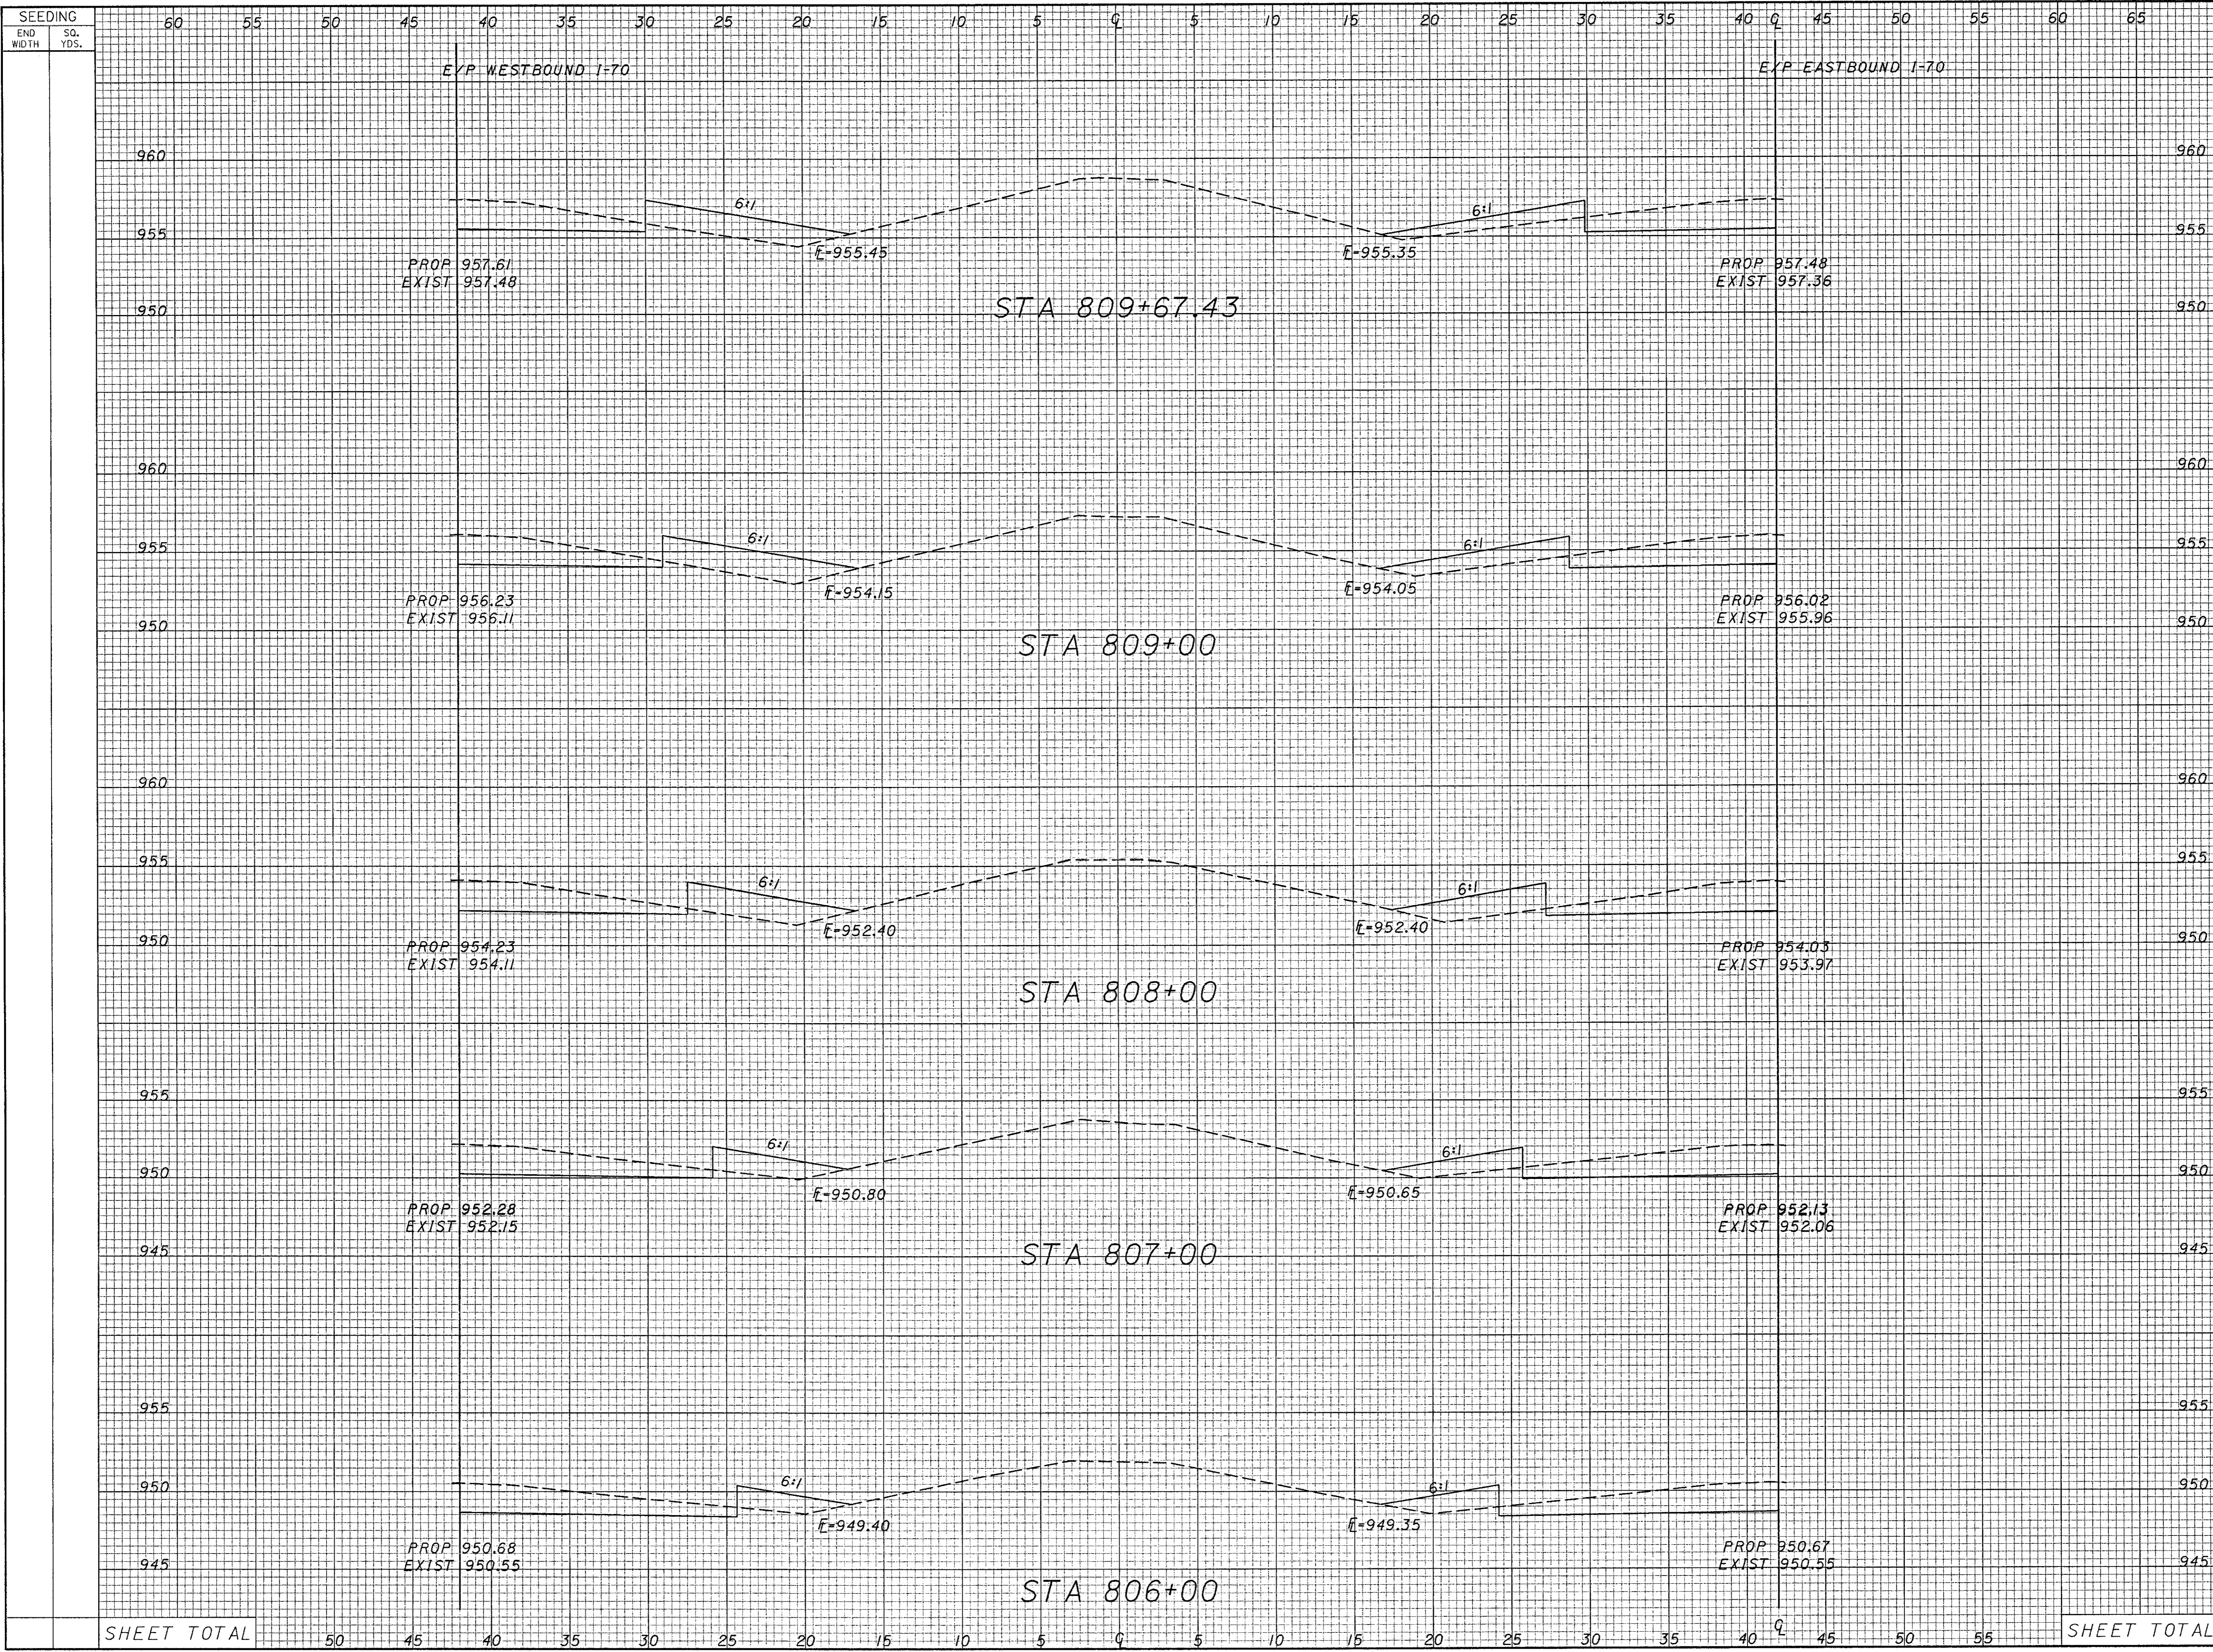

END CUT	AREA FILL	VOLUME		CALCULATED	CHECKED
		CUT	FILL		


**ROADWAY CROSS SECTIONS
STA. 806+00 TO STA. 809+67.43**


PRE-70-0.00

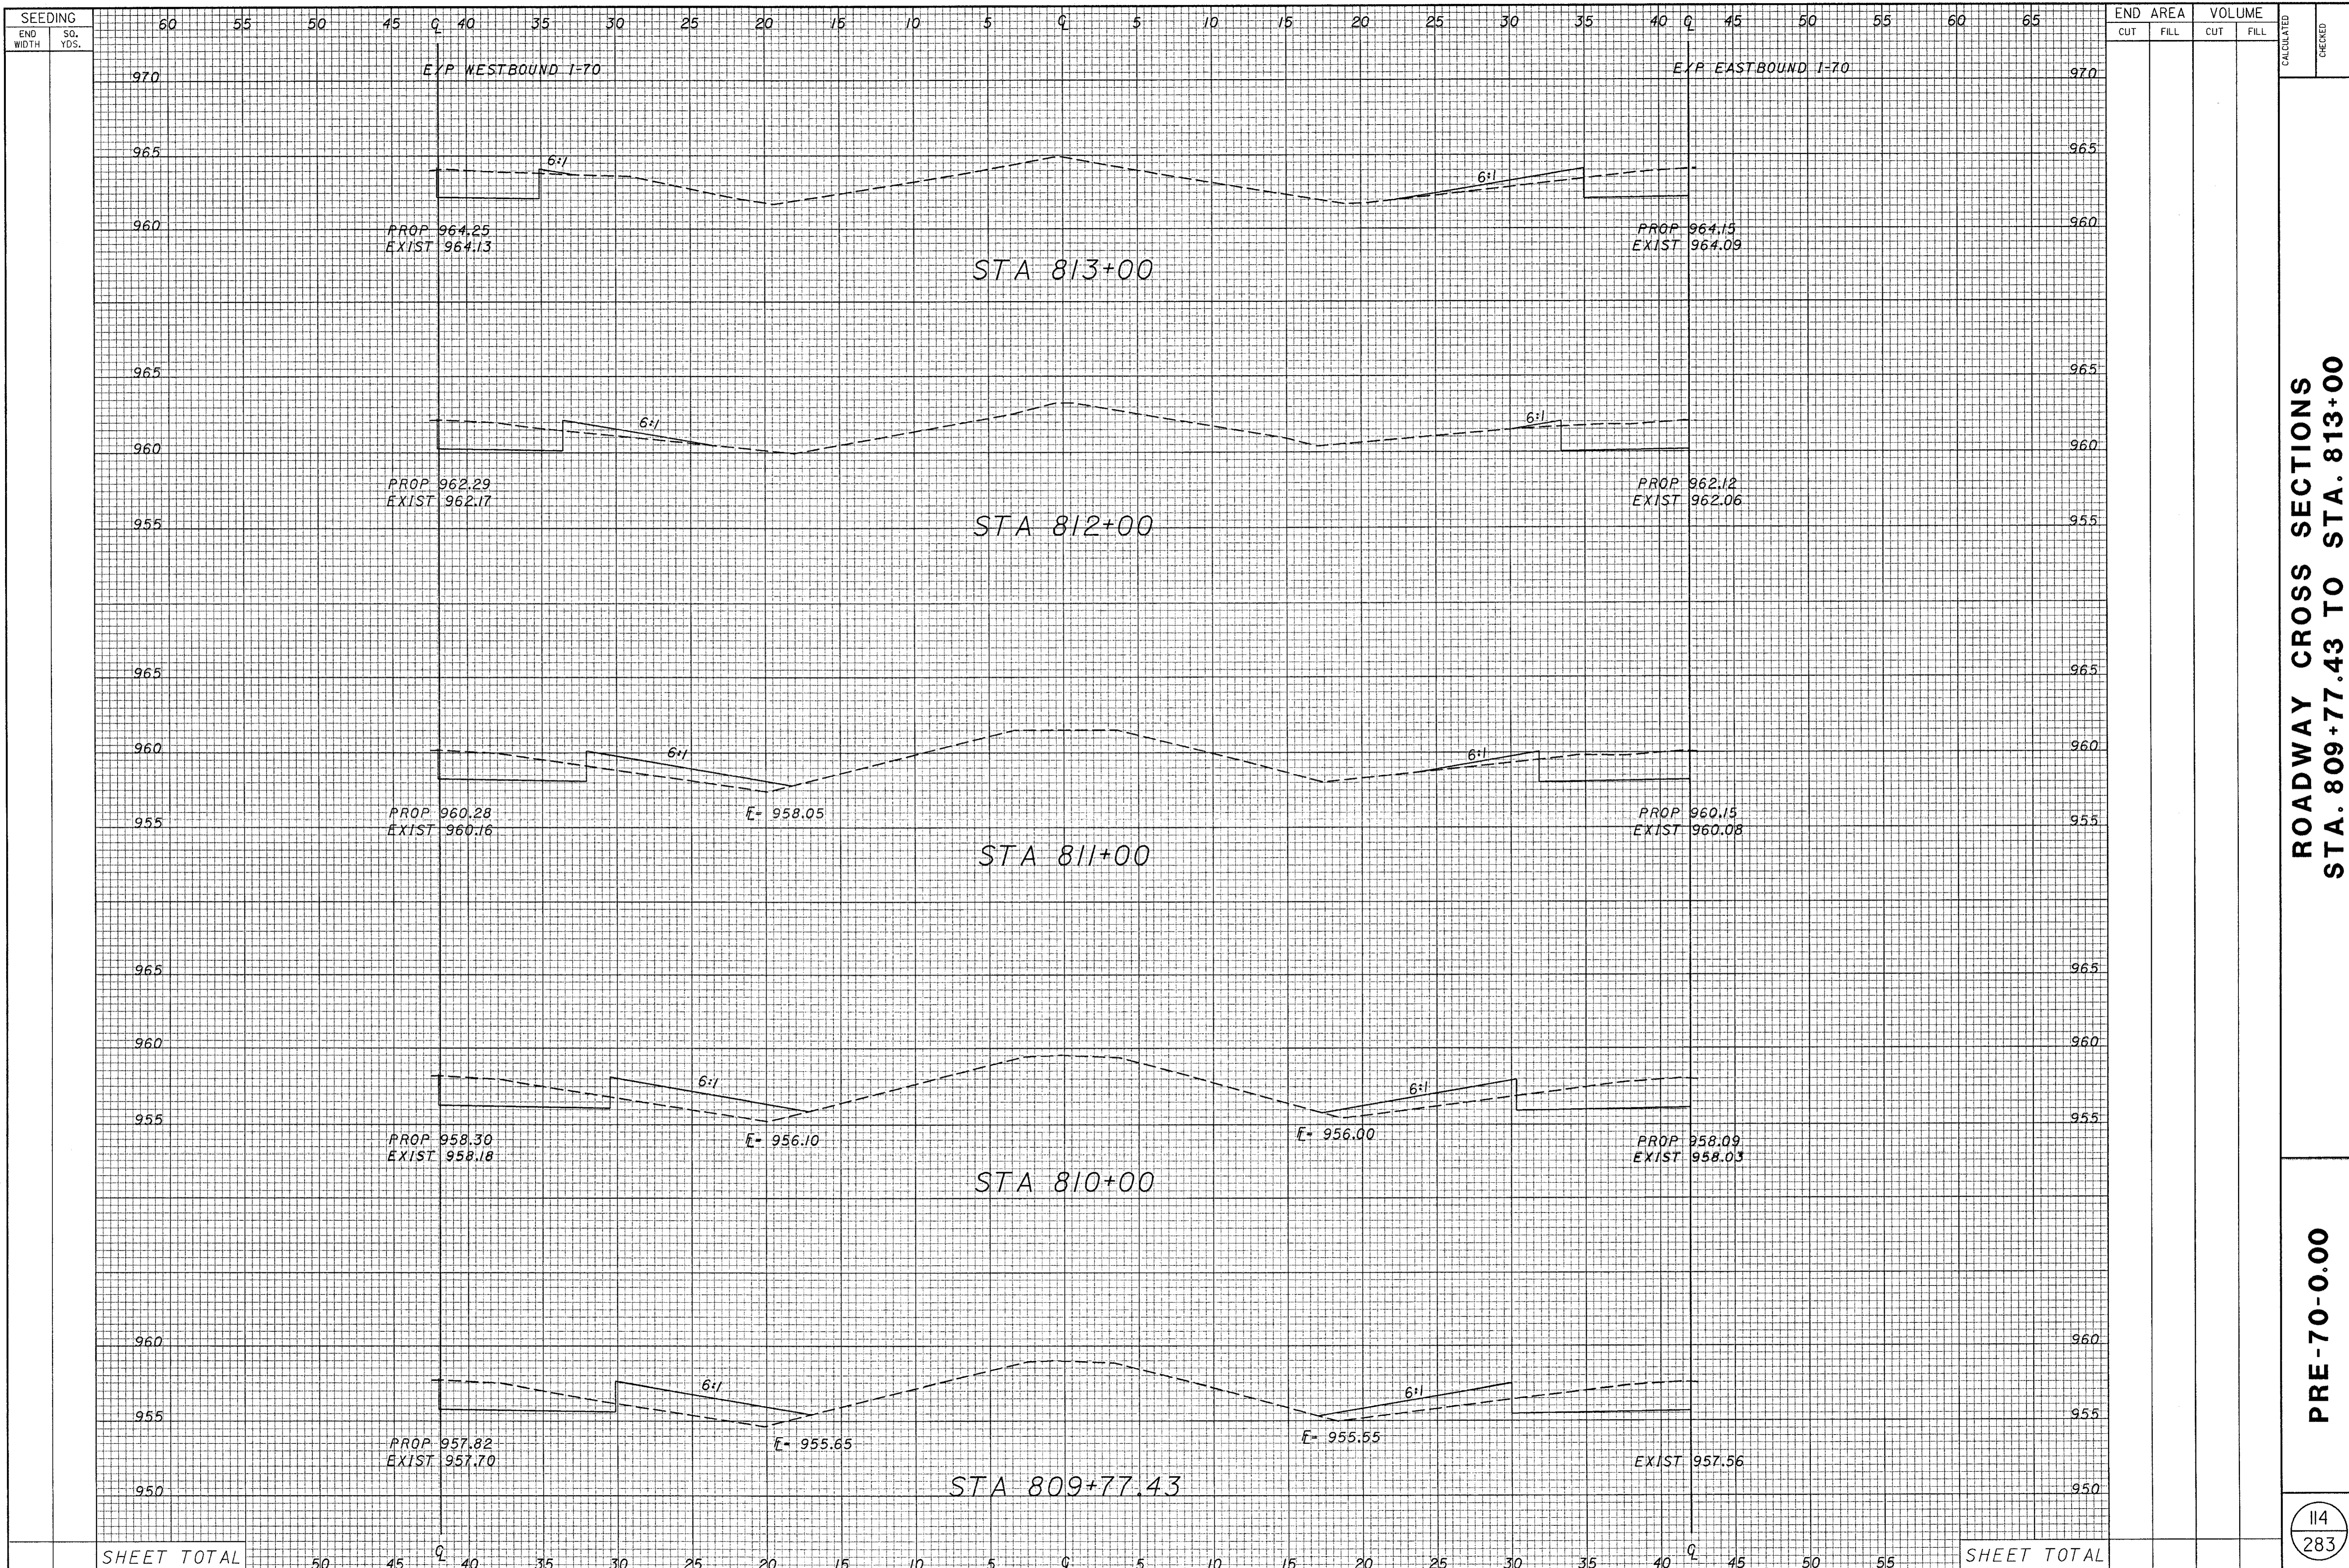





ROADWAY CROSS SECTIONS
 STA. 809+77.43 TO STA. 813+00

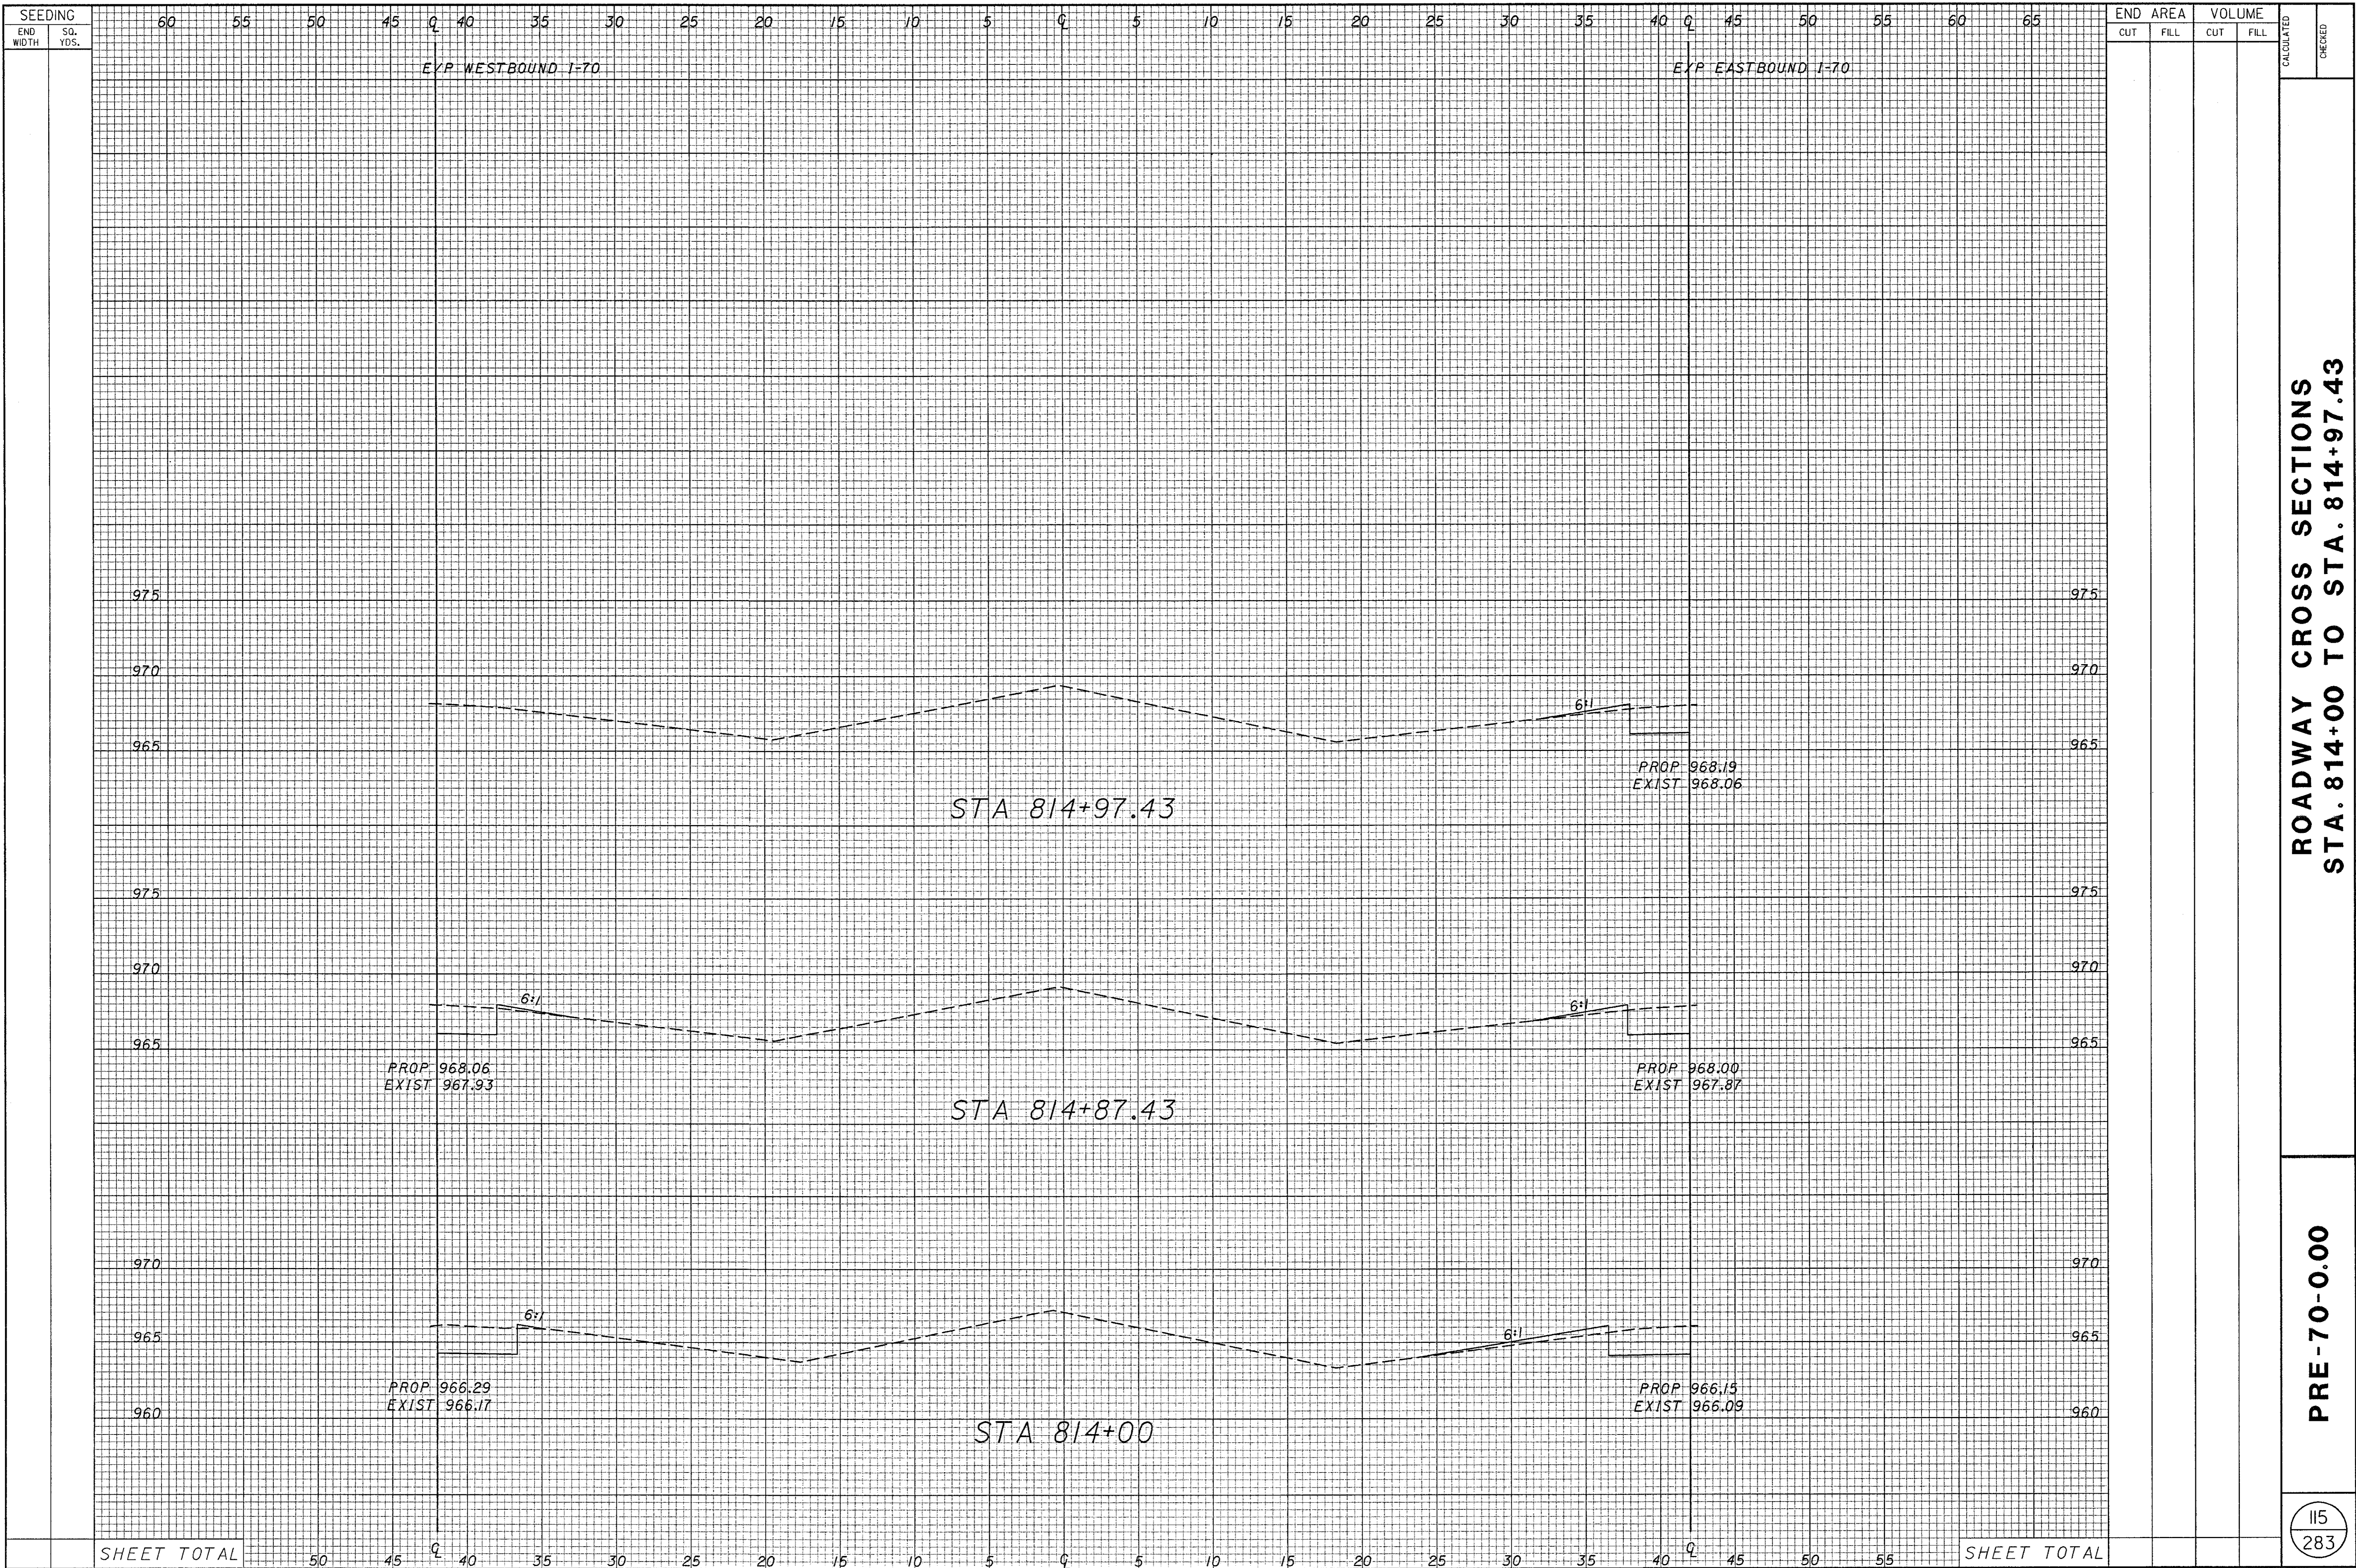
PRE-70-0.00






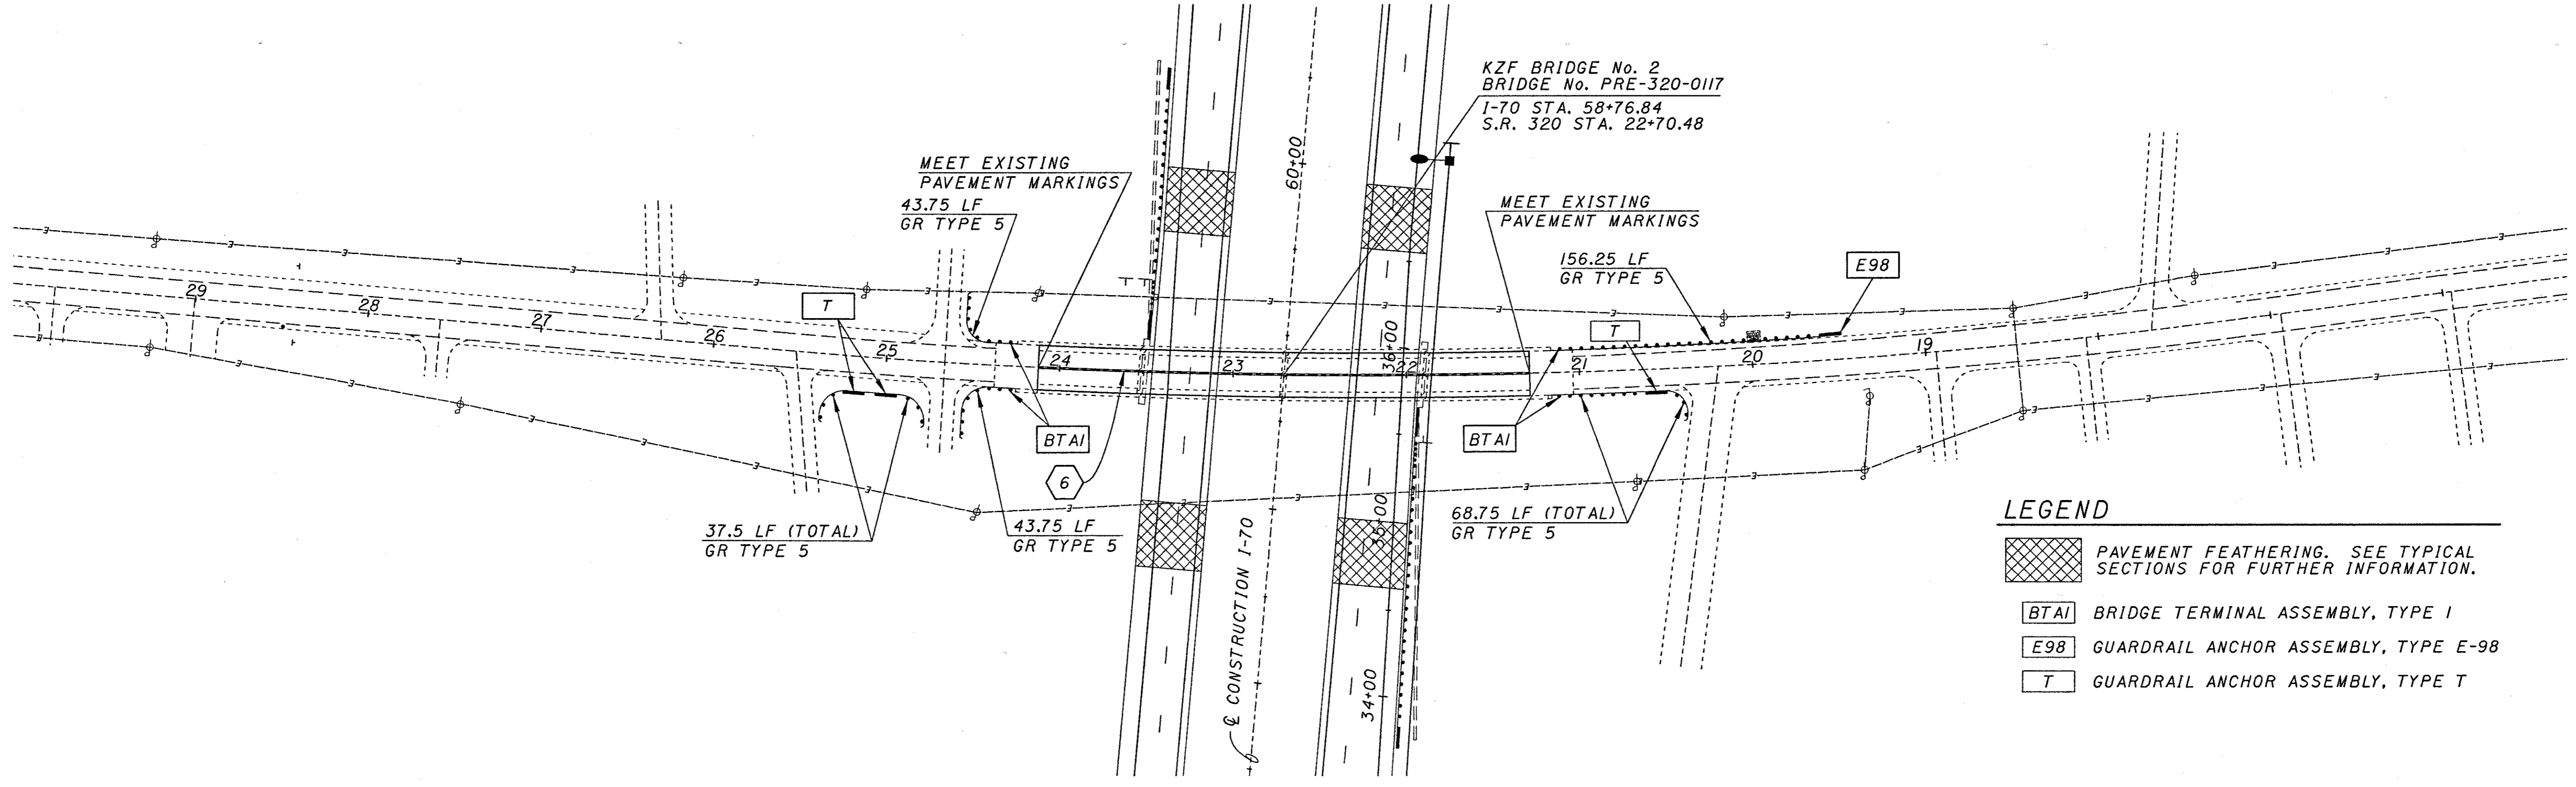


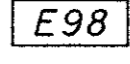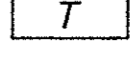

- LEGEND**
-  PAVEMENT FEATHERING. SEE TYPICAL SECTIONS FOR FURTHER INFORMATION.
 -  BRIDGE TERMINAL ASSEMBLY, TYPE I
 -  GUARDRAIL ANCHOR ASSEMBLY, TYPE E-98
 -  GUARDRAIL ANCHOR ASSEMBLY, TYPE T

S.R. 320

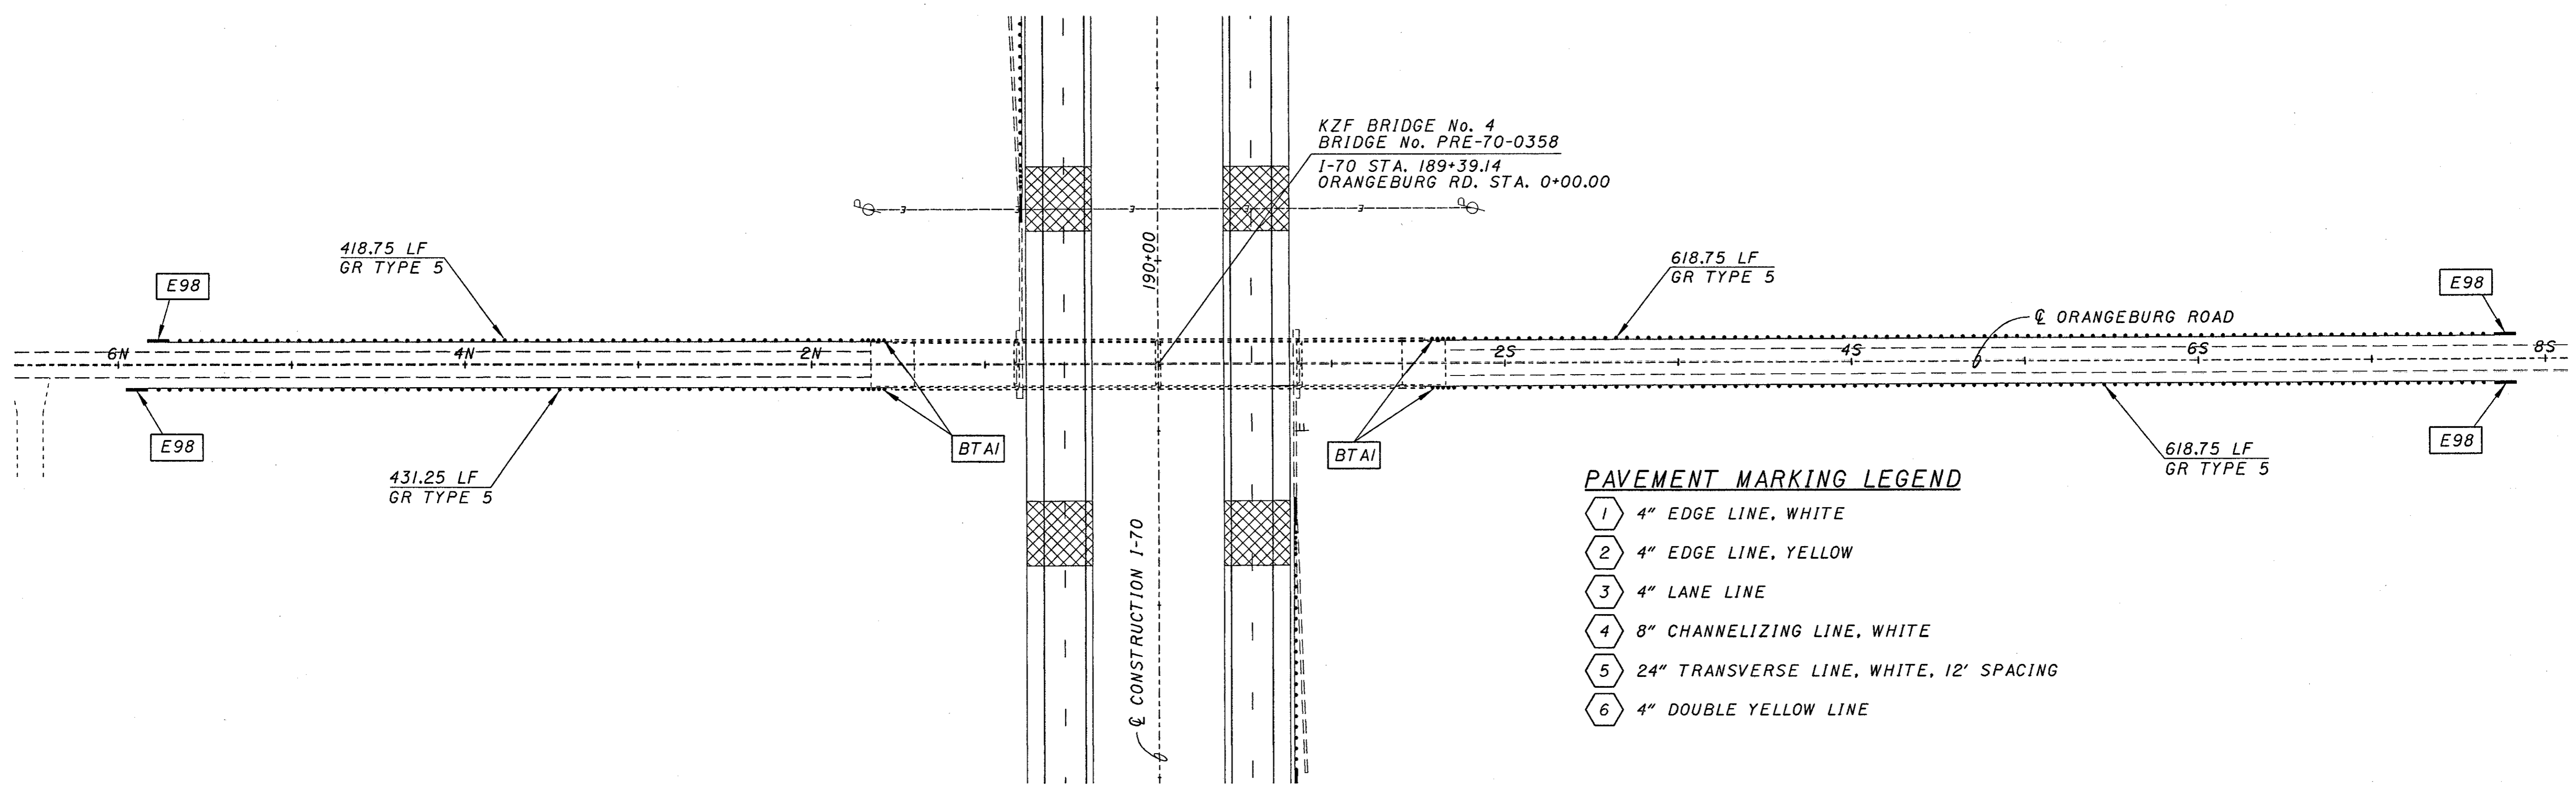

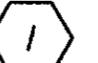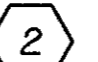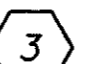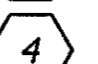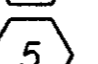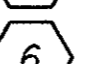
- PAVEMENT MARKING LEGEND**
-  4" EDGE LINE, WHITE
 -  4" EDGE LINE, YELLOW
 -  4" LANE LINE
 -  8" CHANNELIZING LINE, WHITE
 -  24" TRANSVERSE LINE, WHITE, 12' SPACING
 -  4" DOUBLE YELLOW LINE

ORANGEBURG ROAD

OVERHEAD BRIDGE PLAN
 S.R. 320 & ORANGEBURG RD.


PRE-70-0.00

REVISIONS
 NO. DESCRIPTION
 DATE BY
 1. 11/15/70 J. W. H. (S) (S)
 2. 11/15/70 J. W. H. (S) (S)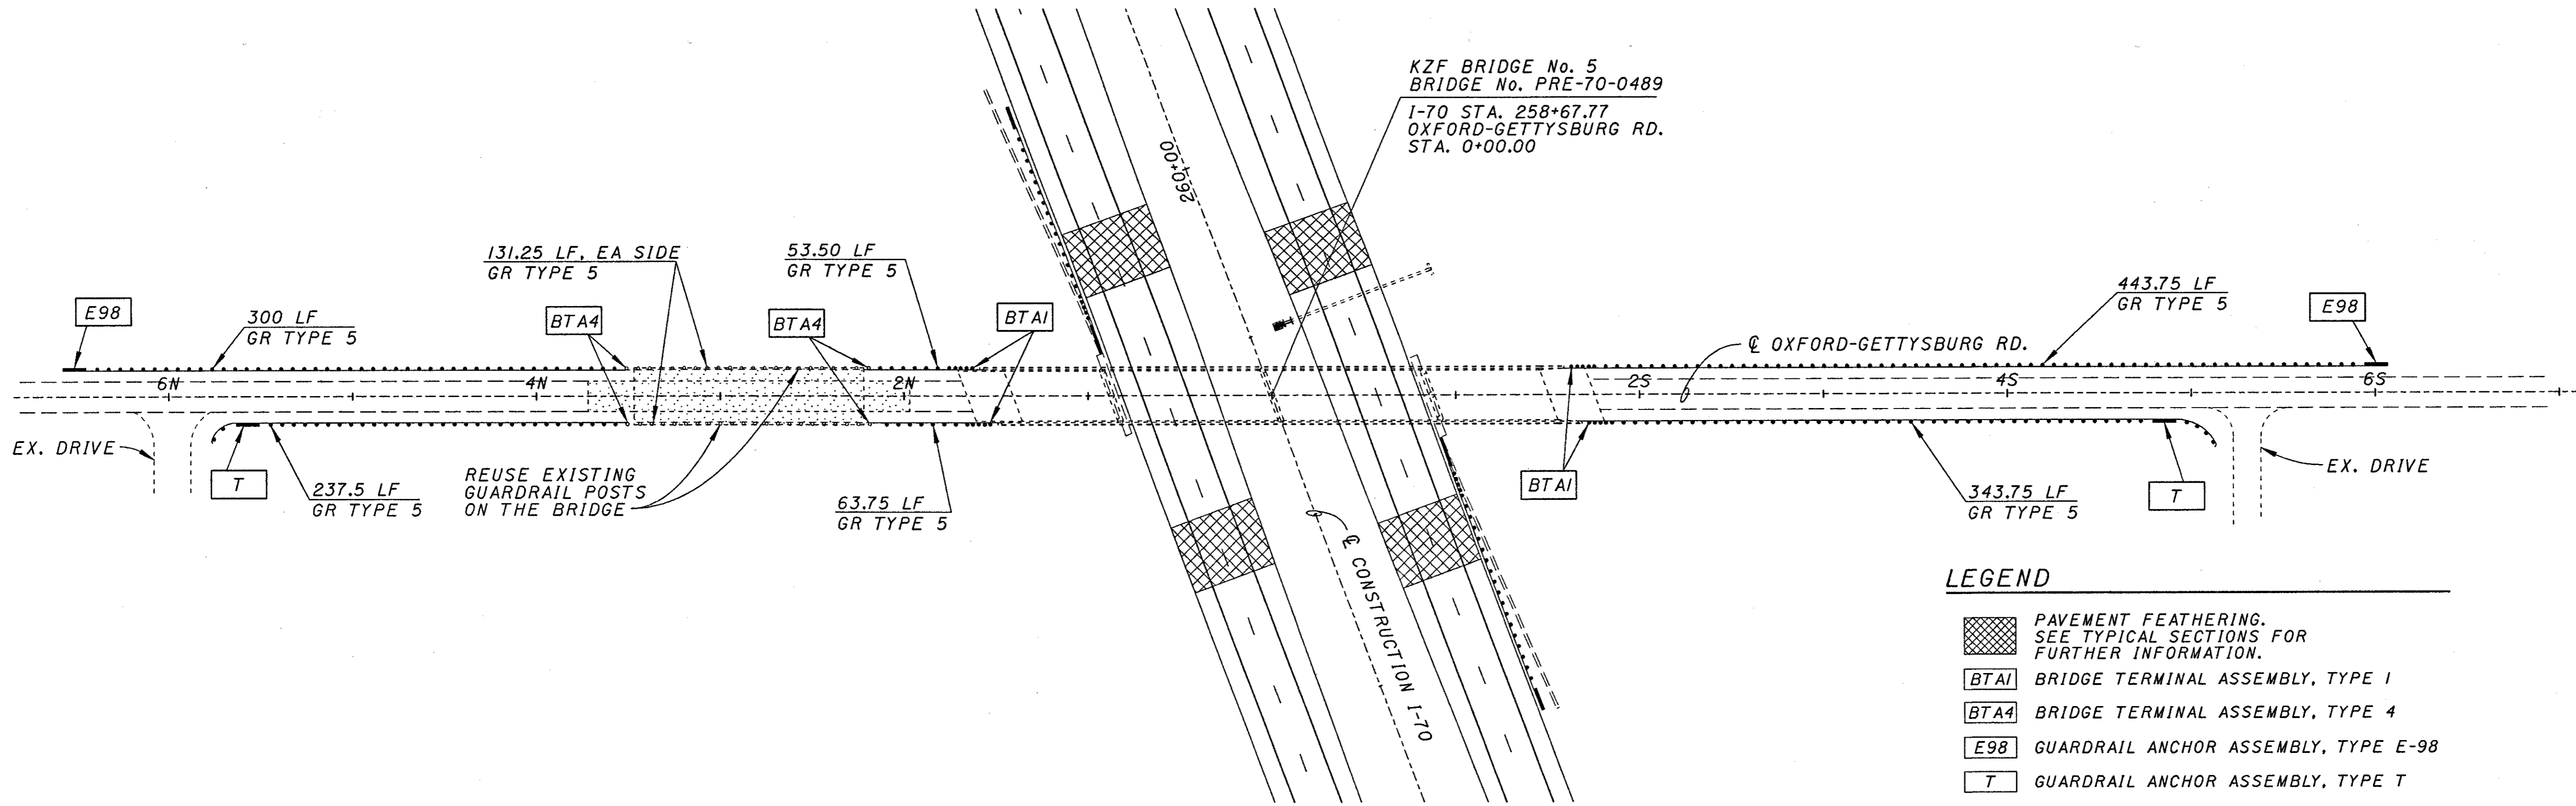
- LEGEND**
- PAVEMENT FEATHERING. SEE TYPICAL SECTIONS FOR FURTHER INFORMATION.
 - BRIDGE TERMINAL ASSEMBLY, TYPE I
 - BRIDGE TERMINAL ASSEMBLY, TYPE 4
 - GUARDRAIL ANCHOR ASSEMBLY, TYPE E-98
 - GUARDRAIL ANCHOR ASSEMBLY, TYPE T


- PAVEMENT MARKING LEGEND**
- | | |
|----------------------|---|
| 4" EDGE LINE, WHITE | 8" CHANNELIZING LINE, WHITE |
| 4" EDGE LINE, YELLOW | 24" TRANSVERSE LINE, WHITE, 12' SPACING |
| 4" LANE LINE | 4" DOUBLE YELLOW LINE |

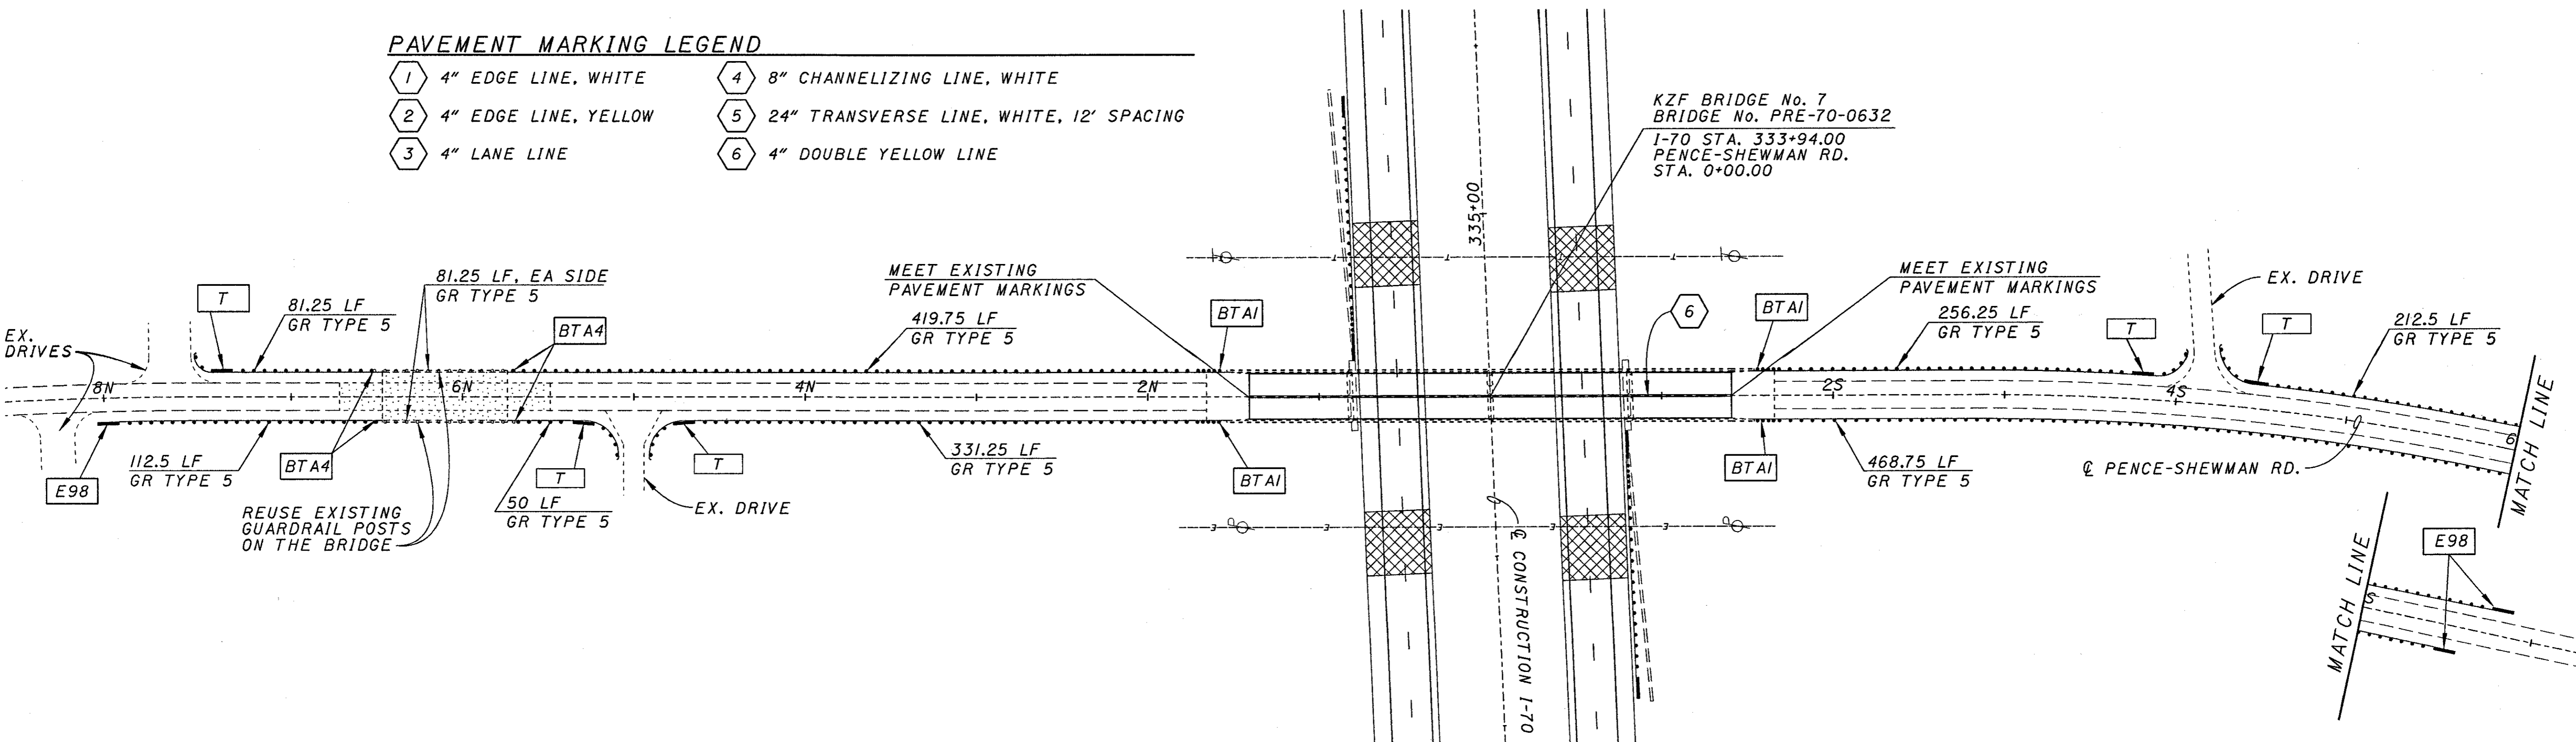

*****REVISIONS*****
 DATE: 11/15/00
 DRAWN: J. B. WILSON
 CHECKED: J. B. WILSON
 DESIGNED: J. B. WILSON
 PROJECT: PENCE-SHEWMAN RD. OVERHEAD BRIDGE PLAN
 ACTIVE LEVELS ON: 04/15/00

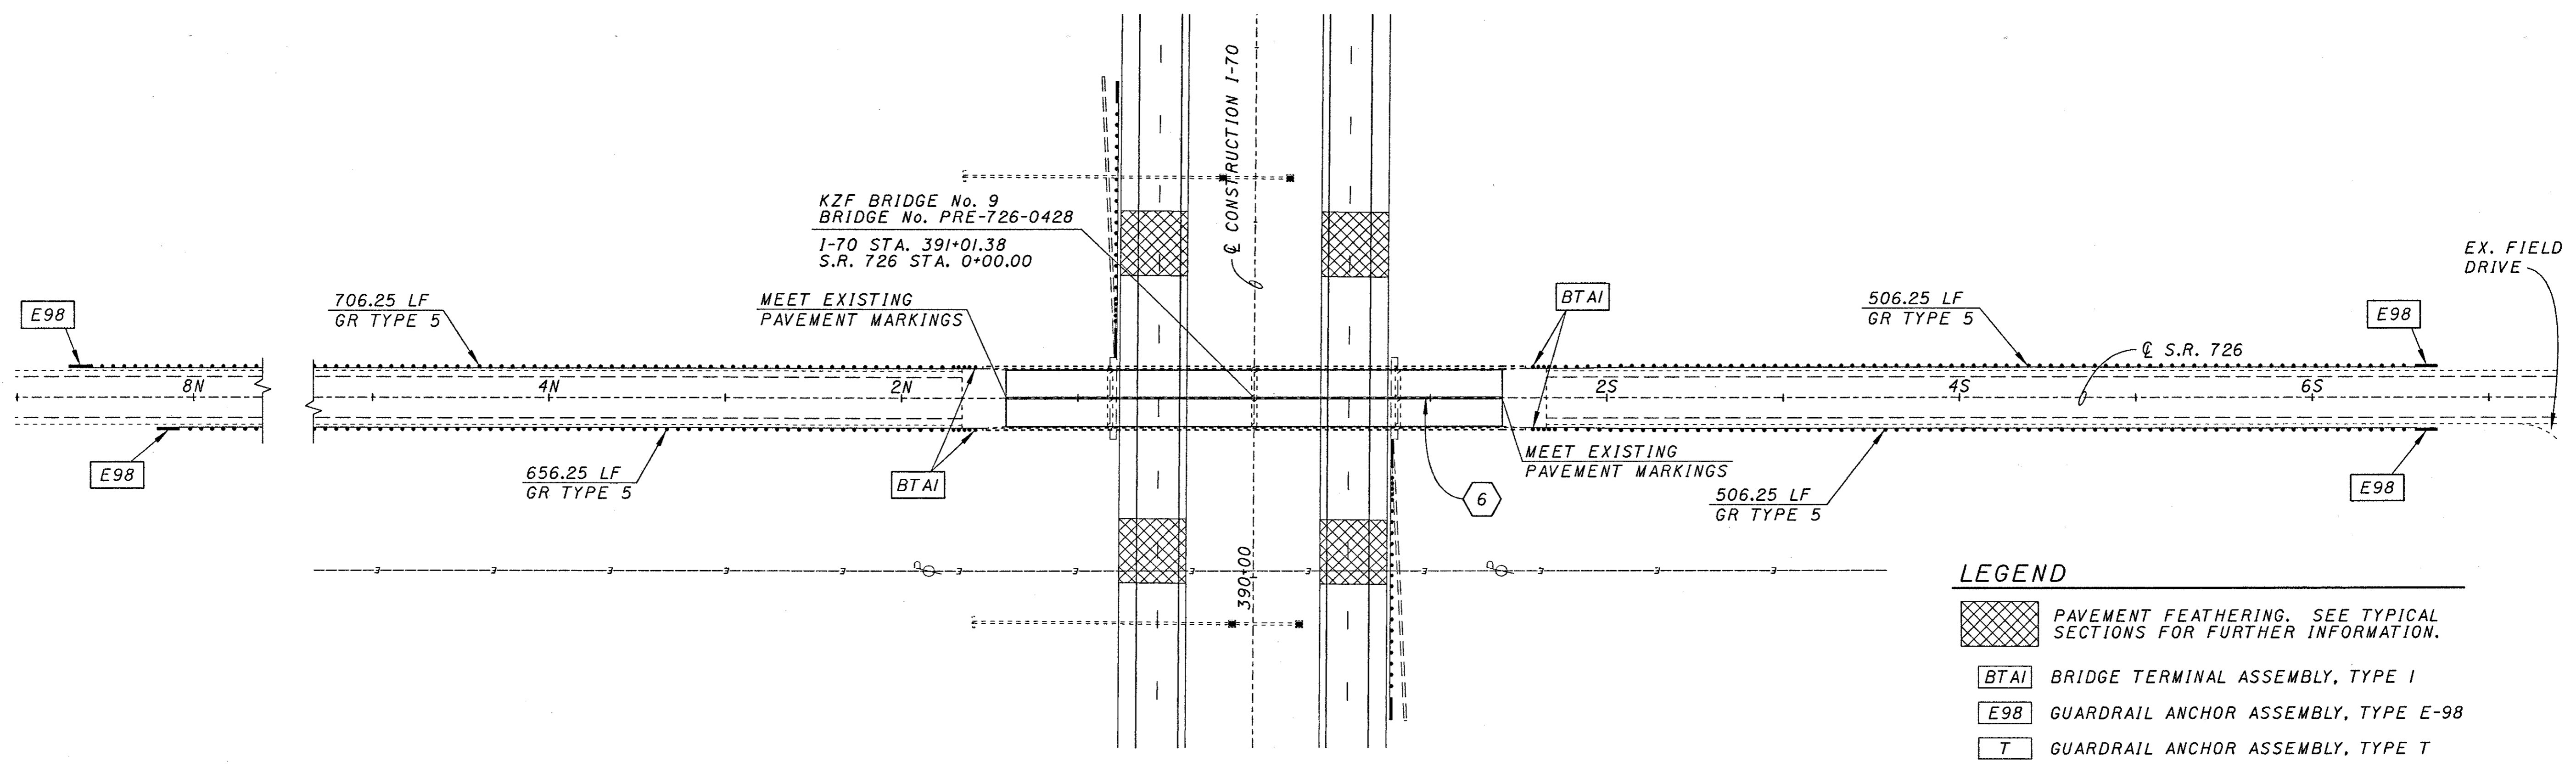


S.R. 726

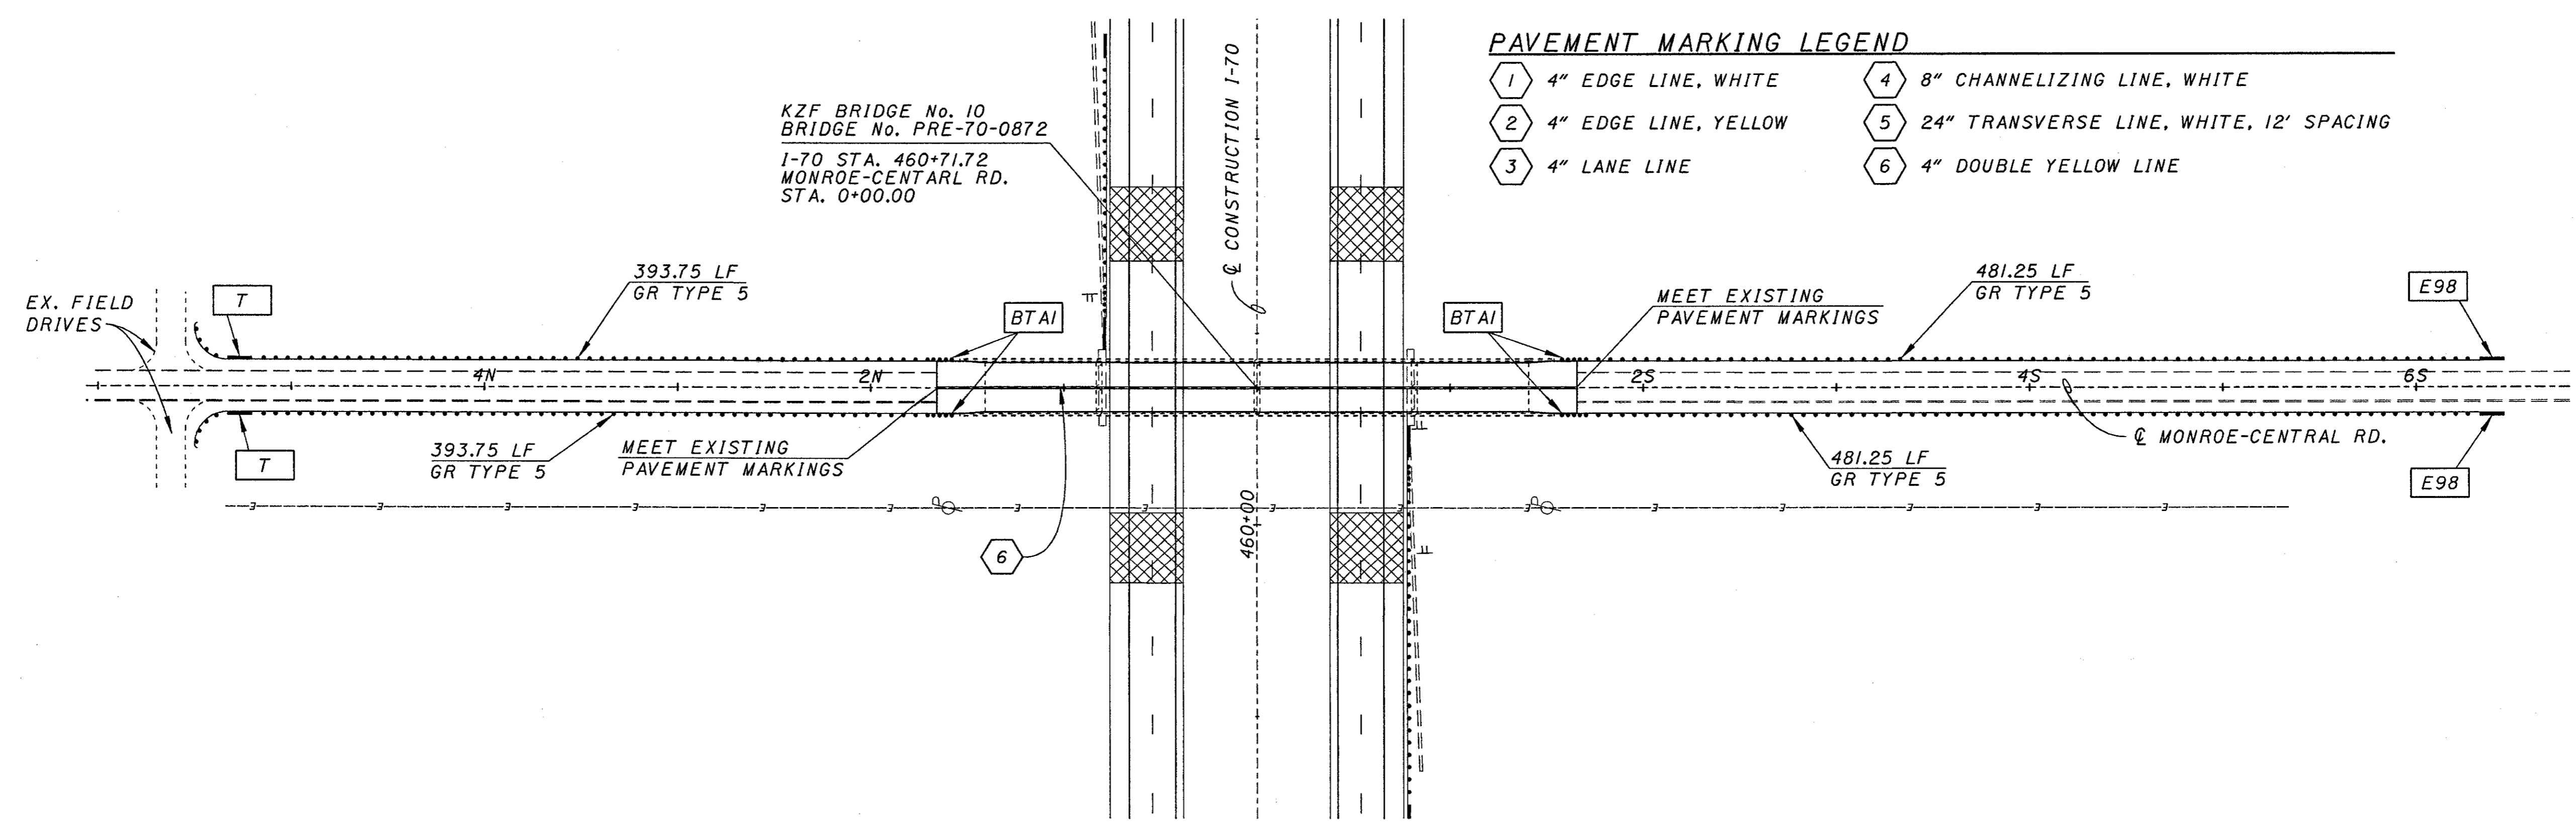

MONROE-CENTRAL ROAD


REF: PRE-70-000000
DES: PRE-70-000000
APP: PRE-70-000000
DATE: 08/11/10
ACTIVE LEVELS OR SHEETS

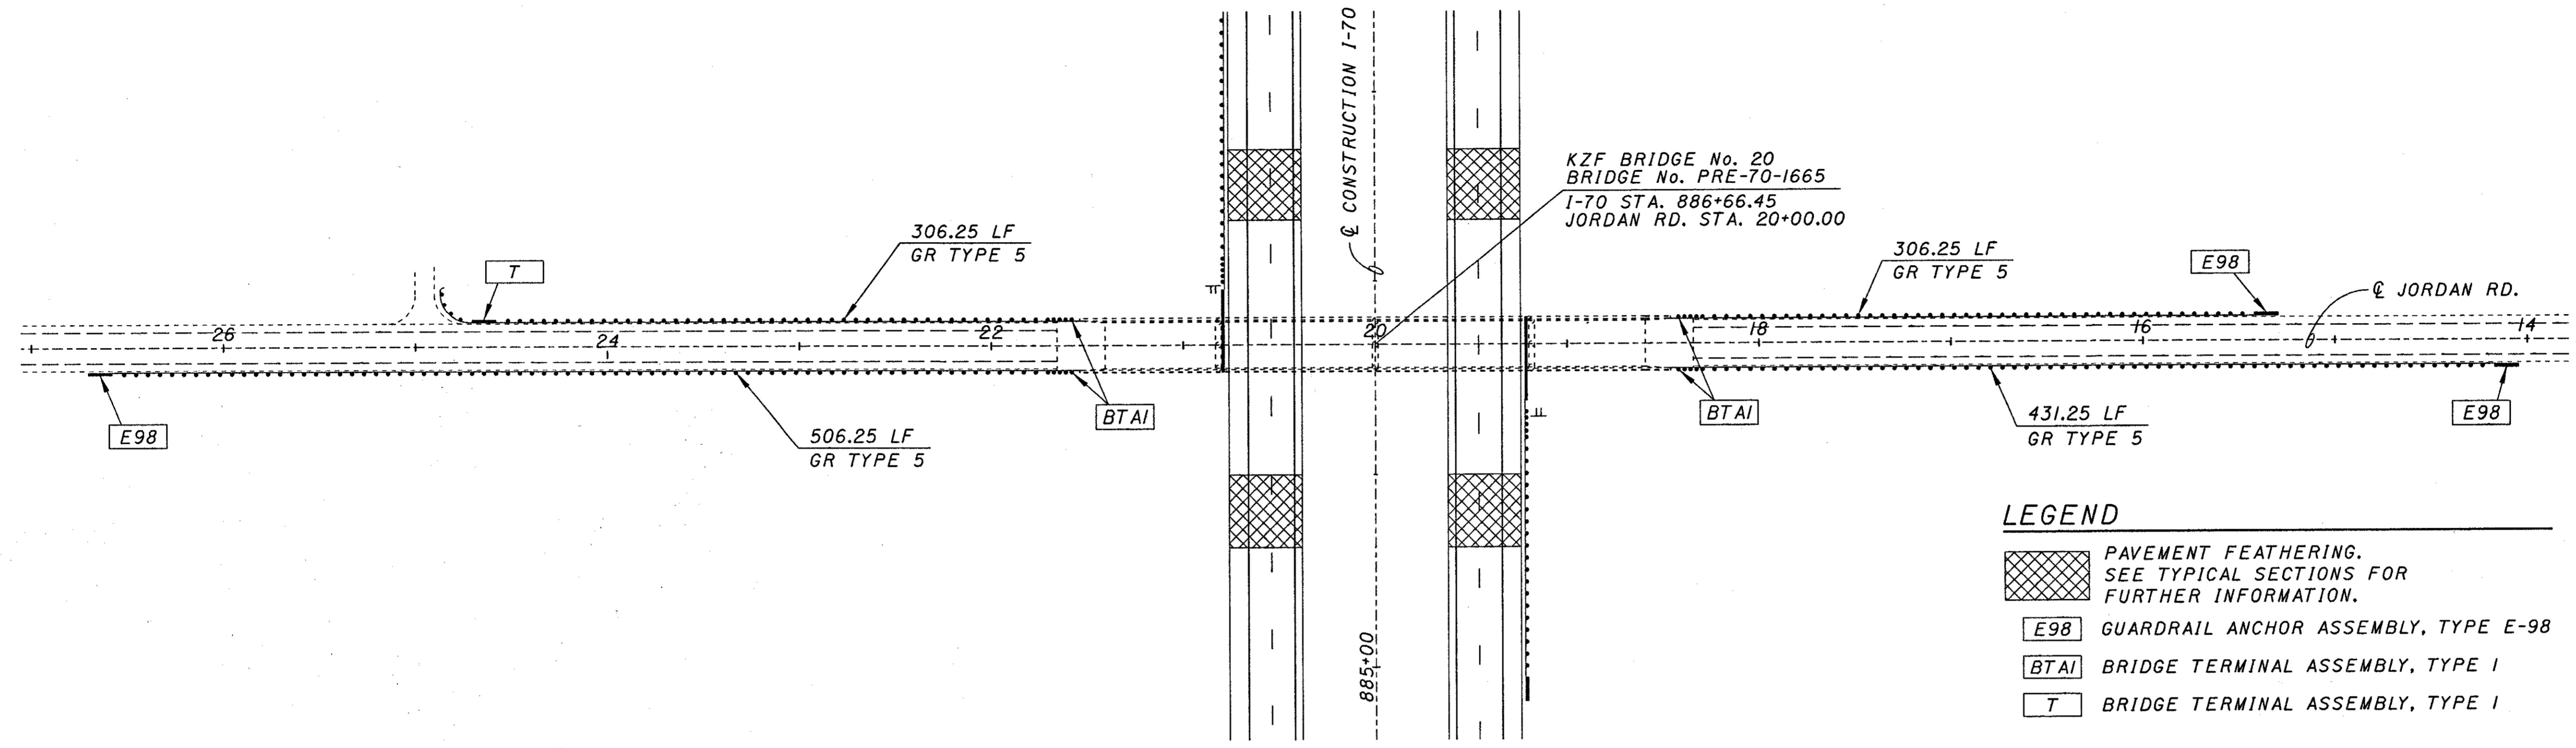

LEGEND

- PAVEMENT FEATHERING. SEE TYPICAL SECTIONS FOR FURTHER INFORMATION.
- GUARDRAIL ANCHOR ASSEMBLY, TYPE E-98
- BRIDGE TERMINAL ASSEMBLY, TYPE I
- BRIDGE TERMINAL ASSEMBLY, TYPE I

JORDON ROAD

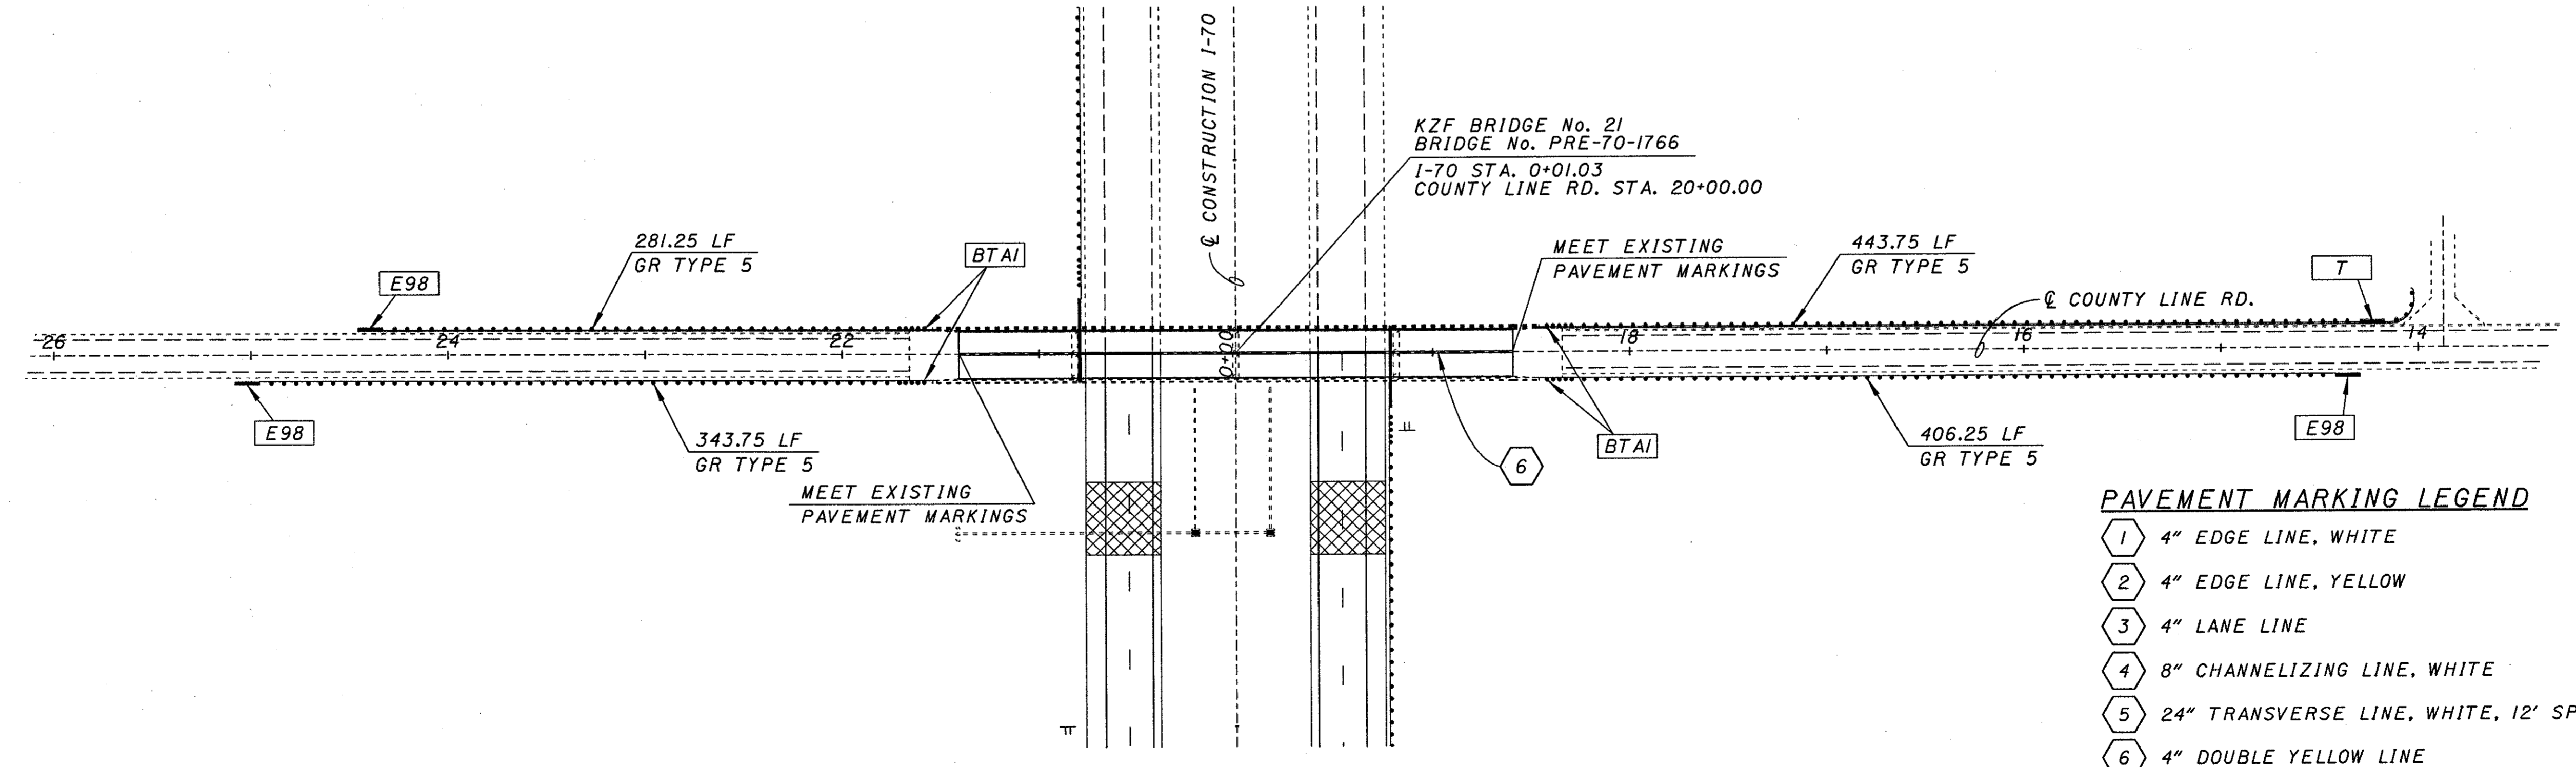


PAVEMENT MARKING LEGEND

- 4" EDGE LINE, WHITE
- 4" EDGE LINE, YELLOW
- 4" LANE LINE
- 8" CHANNELIZING LINE, WHITE
- 24" TRANSVERSE LINE, WHITE, 12' SPACING
- 4" DOUBLE YELLOW LINE

COUNTY LINE ROAD

REF: REF01** REF02** REF03** REF100**
 USER: JLS/ERMAN**
 DES: JLS/ERMAN**
 DATE: 11/11/99
 ACTIVE LEVELS ON: **LEV**

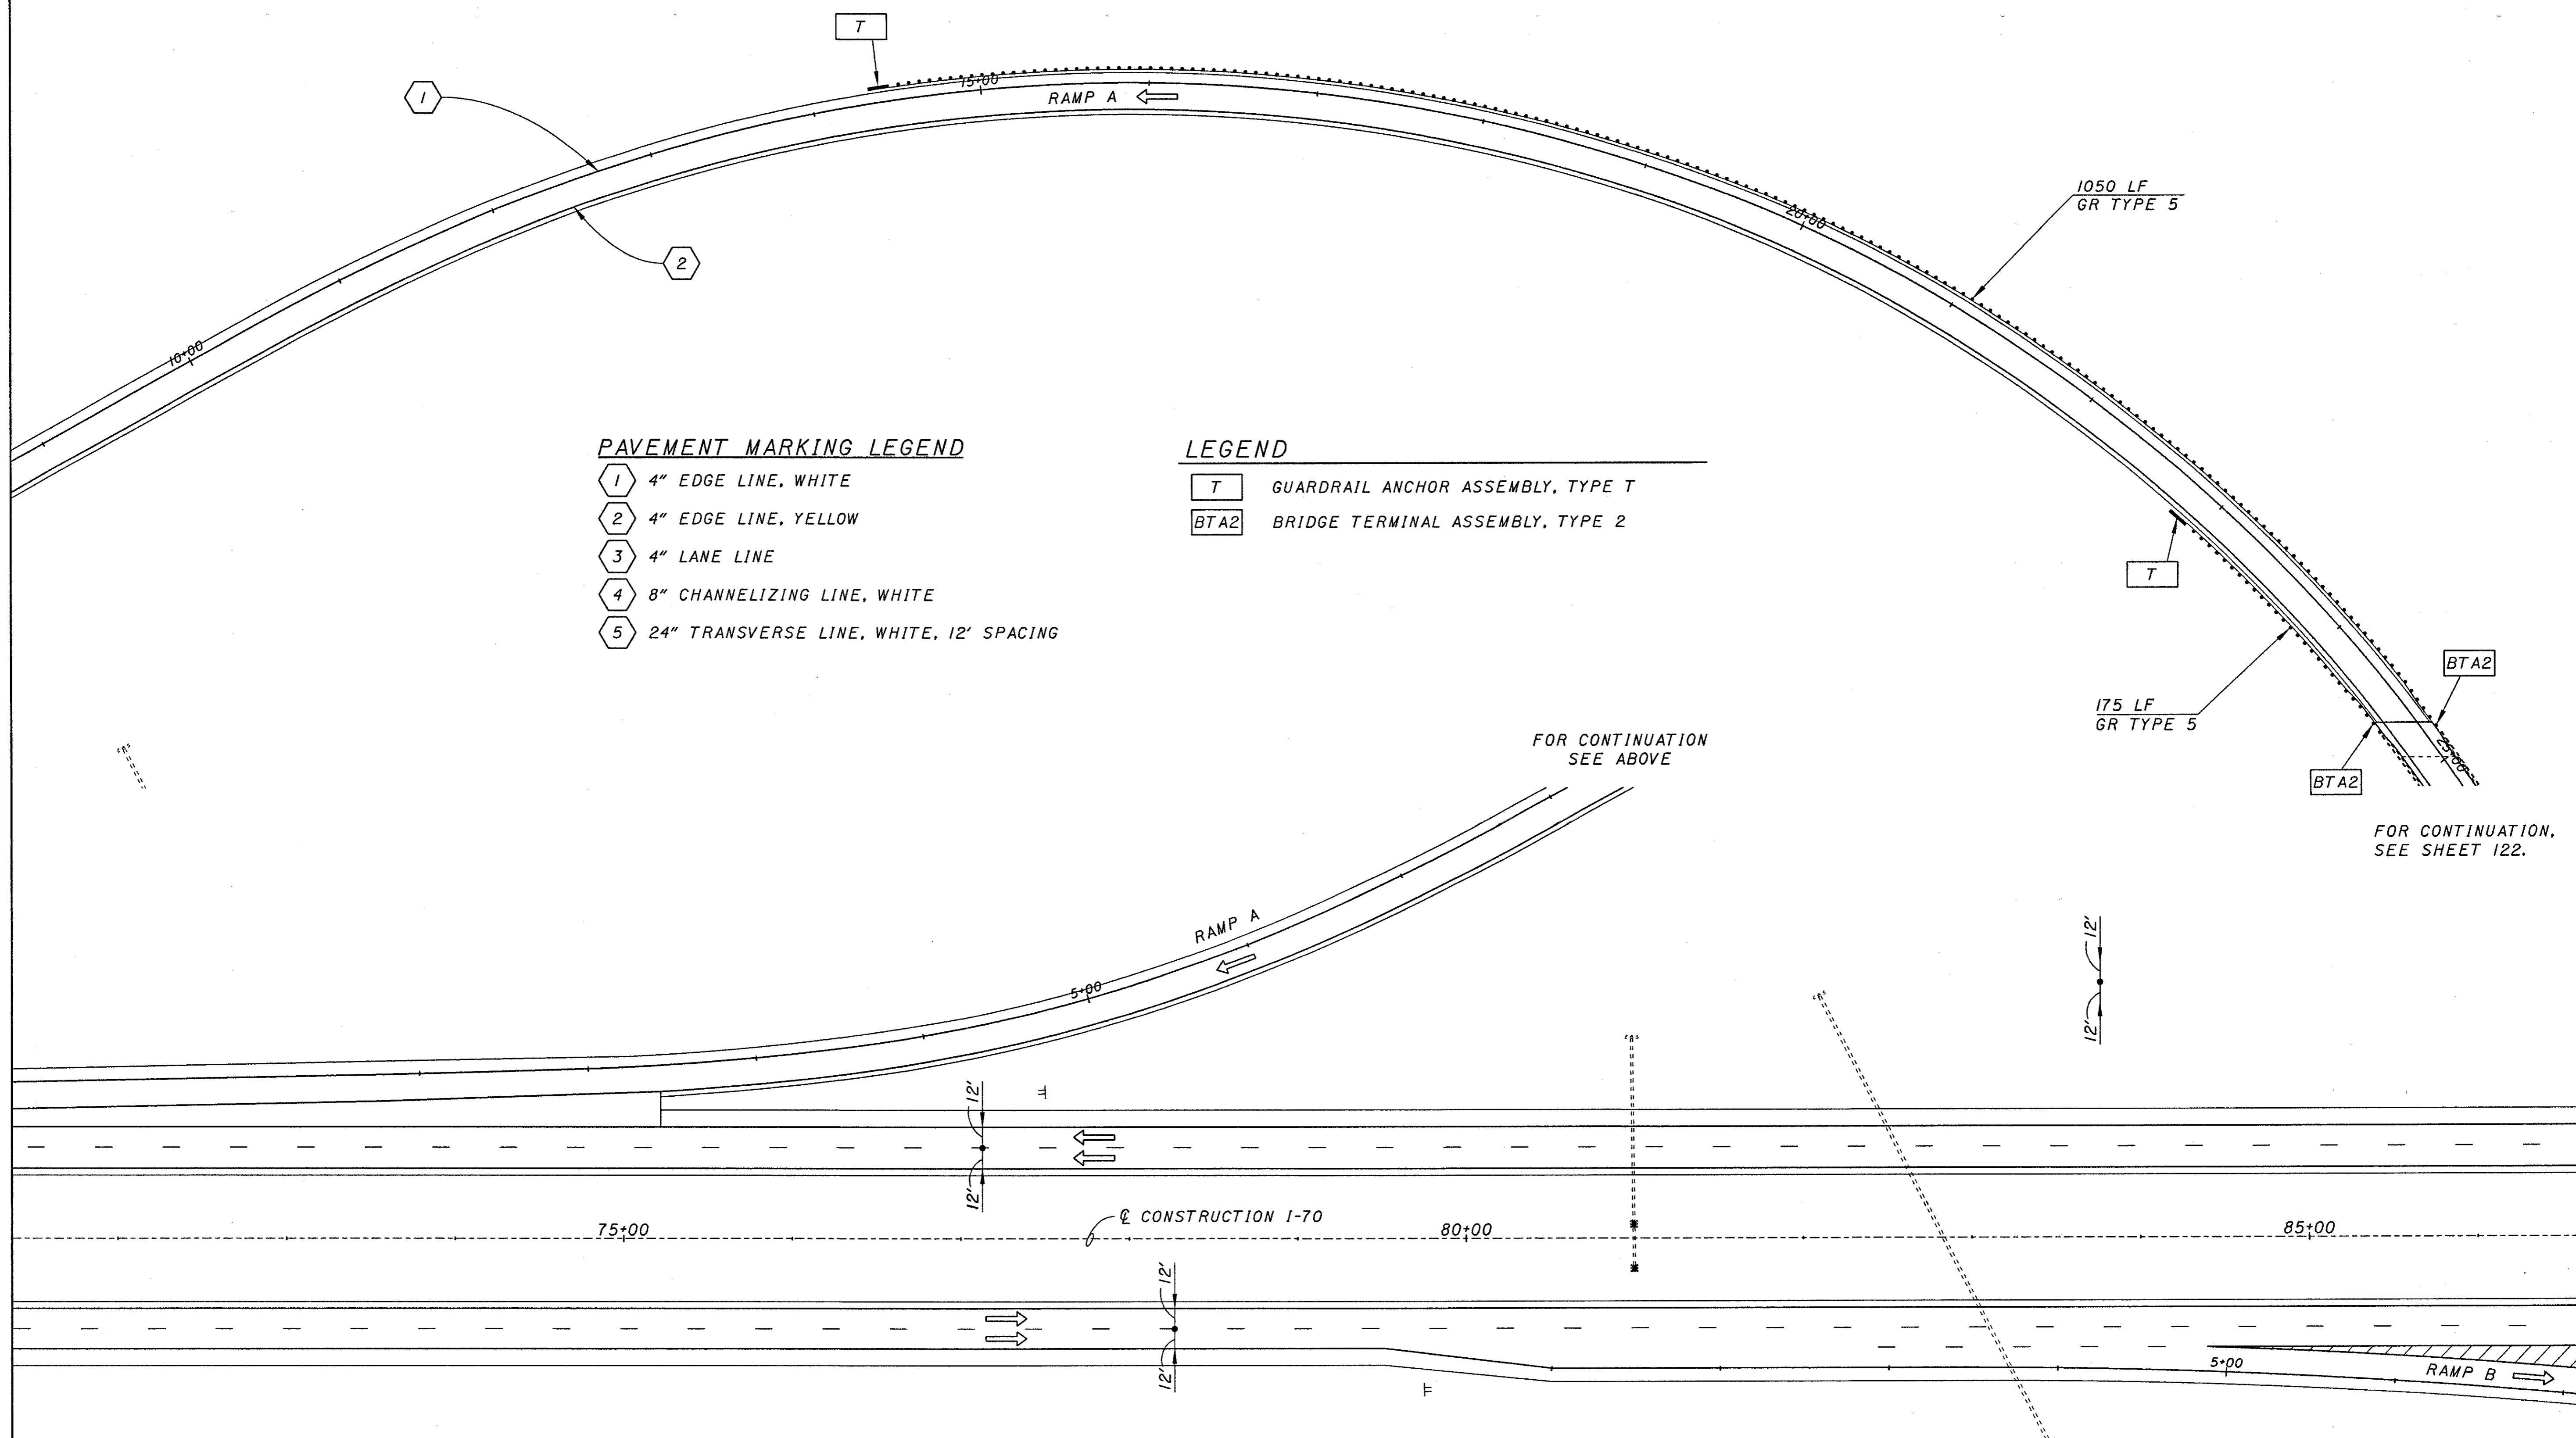

- PAVEMENT MARKING LEGEND**
- ① 4" EDGE LINE, WHITE
 - ② 4" EDGE LINE, YELLOW
 - ③ 4" LANE LINE
 - ④ 8" CHANNELIZING LINE, WHITE
 - ⑤ 24" TRANSVERSE LINE, WHITE, 12' SPACING

- LEGEND**
- T GUARDRAIL ANCHOR ASSEMBLY, TYPE T
 - BTA2 BRIDGE TERMINAL ASSEMBLY, TYPE 2

FOR CONTINUATION
SEE ABOVE


FOR CONTINUATION,
SEE SHEET 122.

NOTES
 1) FOR MAINLINE INFORMATION, SEE SHEETS 13-14.

PLAN
 STA. 82+00 TO STA. 110+00

PRE-70-0.00

 USER: ***
 PROJ: ***
 DATE: ***
 ACTIVE LEVELS ON: **LEVE**

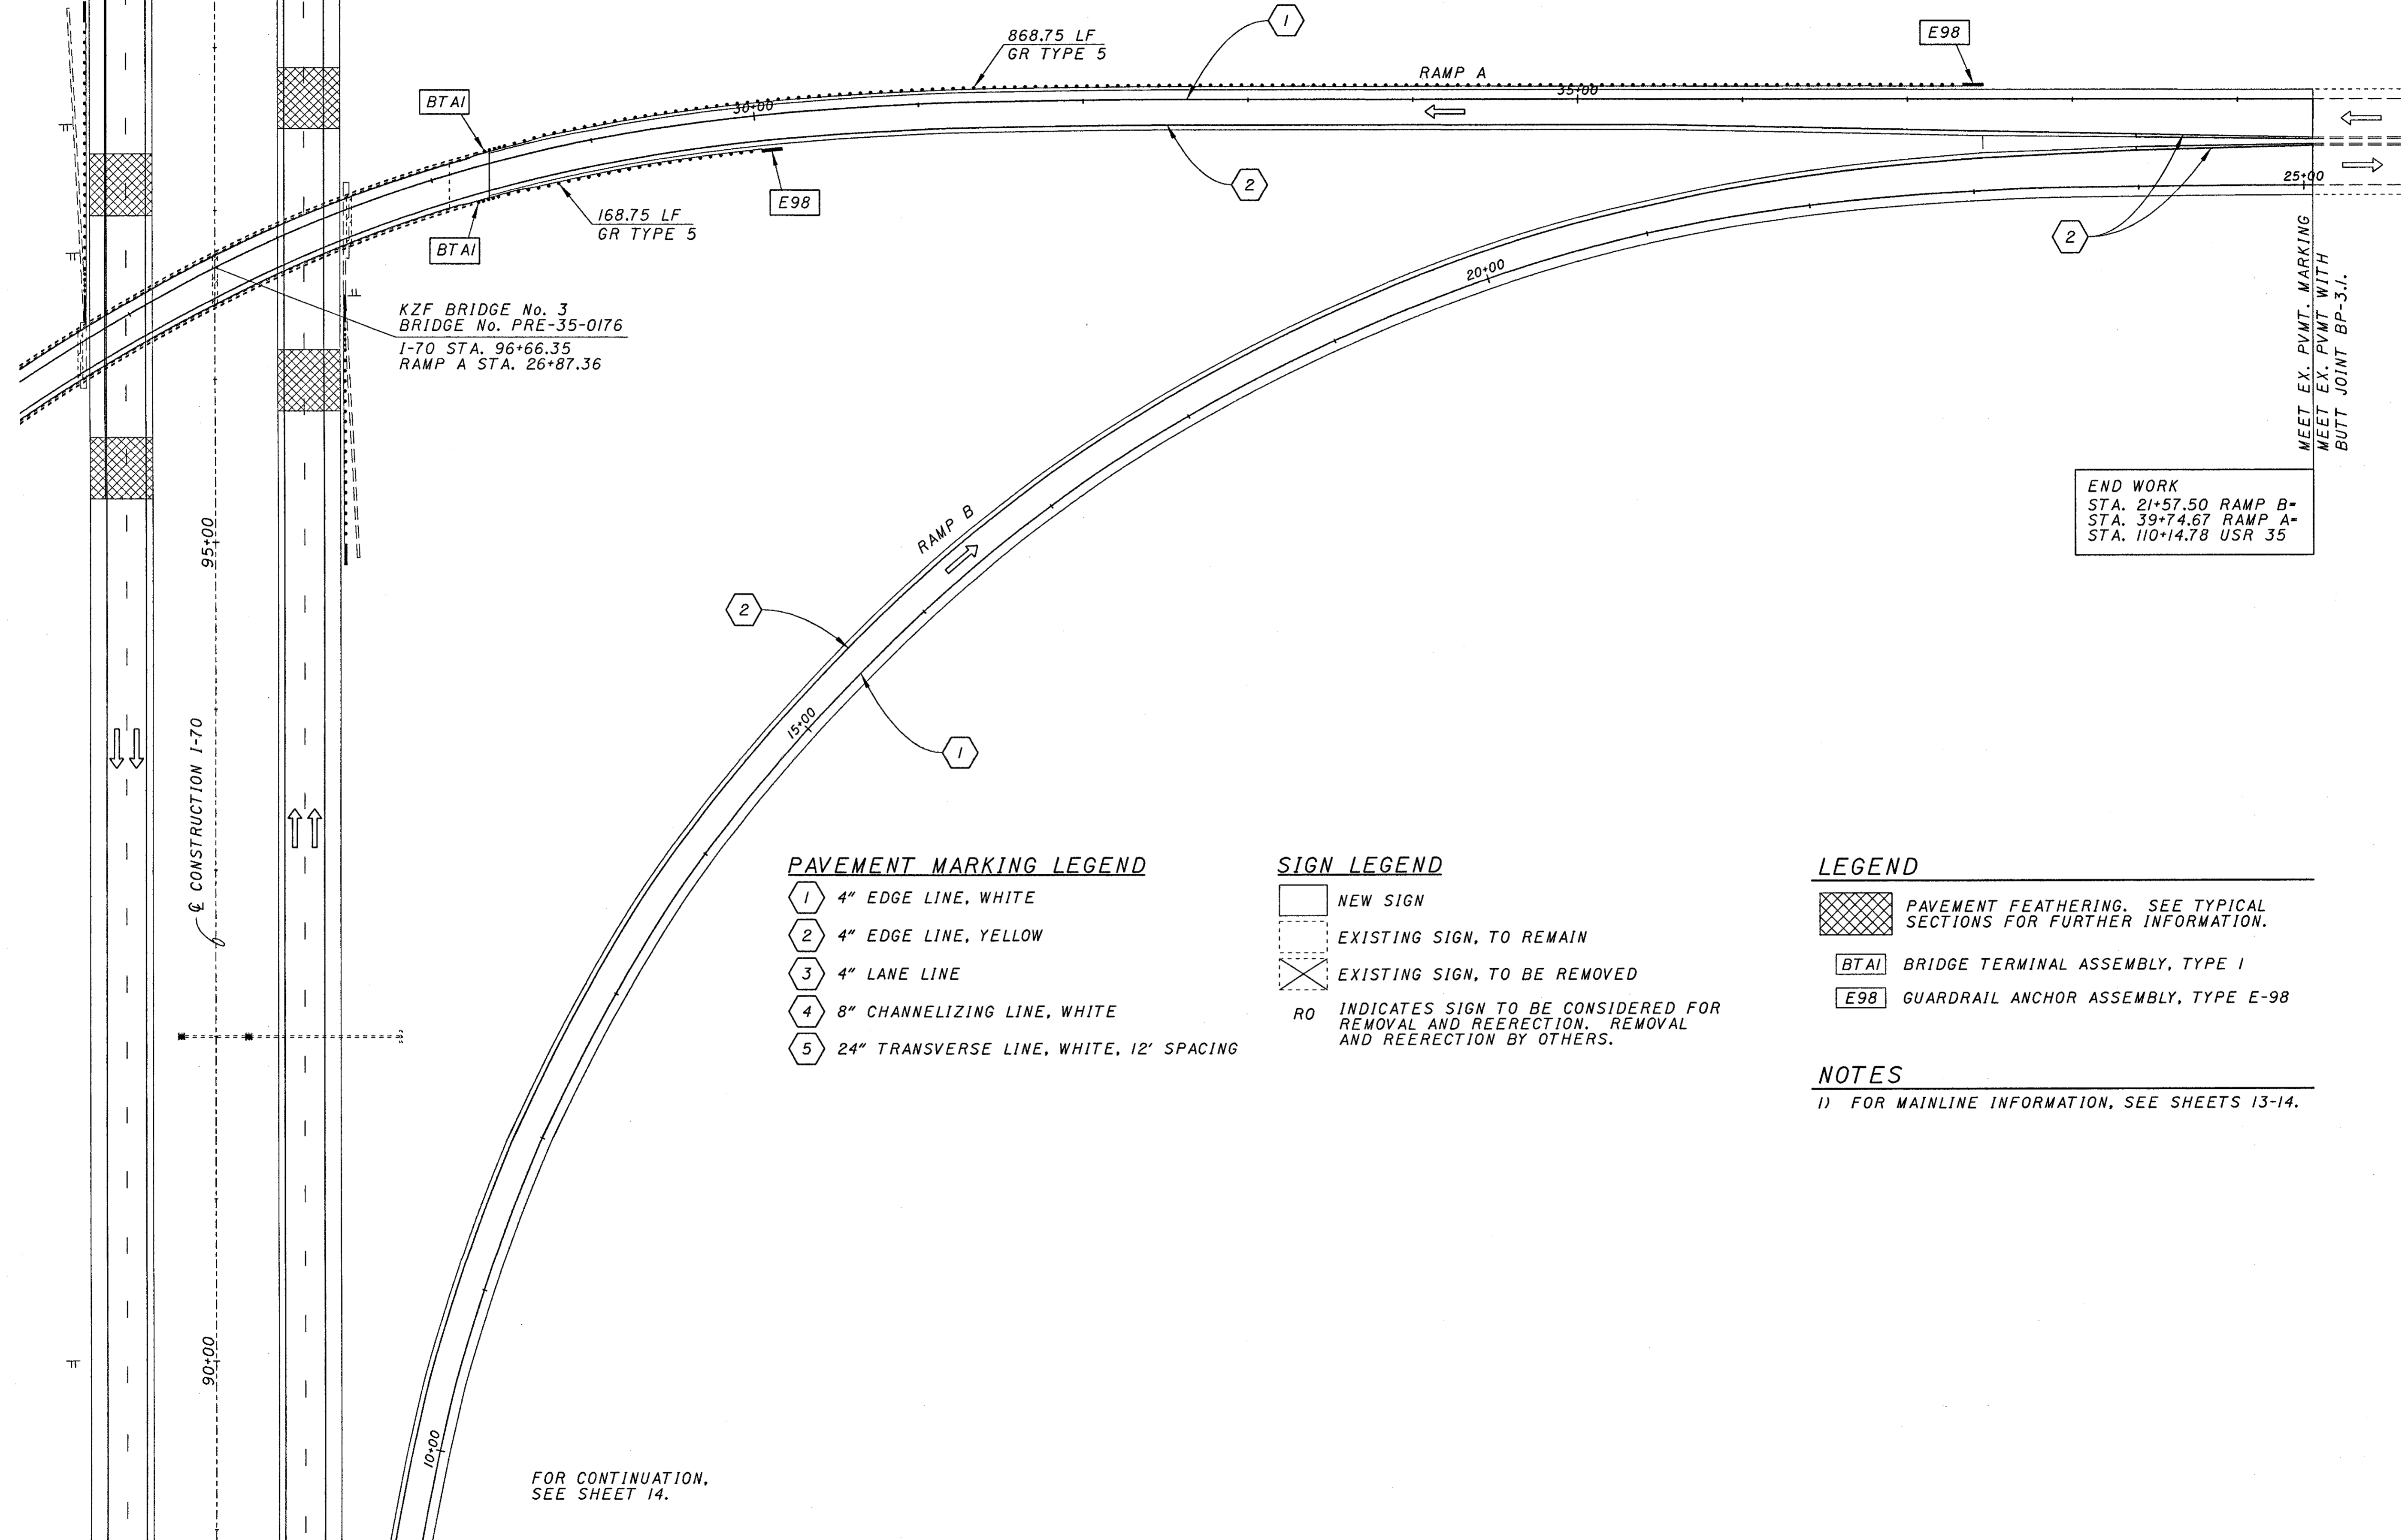

KZF BRIDGE No. 3
BRIDGE No. PRE-35-0176
I-70 STA. 96+66.35
RAMP A STA. 26+87.36

END WORK
STA. 21+57.50 RAMP B-
STA. 39+74.67 RAMP A-
STA. 110+14.78 USR 35

PAVEMENT MARKING LEGEND

- 1 4" EDGE LINE, WHITE
- 2 4" EDGE LINE, YELLOW
- 3 4" LANE LINE
- 4 8" CHANNELIZING LINE, WHITE
- 5 24" TRANSVERSE LINE, WHITE, 12' SPACING

SIGN LEGEND

- NEW SIGN
- EXISTING SIGN, TO REMAIN
- EXISTING SIGN, TO BE REMOVED
- RO INDICATES SIGN TO BE CONSIDERED FOR REMOVAL AND REERECTION. REMOVAL AND REERECTION BY OTHERS.

LEGEND

- PAVEMENT FEATHERING. SEE TYPICAL SECTIONS FOR FURTHER INFORMATION.
- BTAI BRIDGE TERMINAL ASSEMBLY, TYPE I
- E98 GUARDRAIL ANCHOR ASSEMBLY, TYPE E-98

NOTES

1) FOR MAINLINE INFORMATION, SEE SHEETS 13-14.

95+00

CONSTRUCTION I-70

90+00


FOR CONTINUATION,
SEE SHEET 14.

PLAN
STA. 82+00 TO STA. 110+00

PRE-70-0.00


DESIGNATION

ACTIVE LEVEL ON 11/15/88

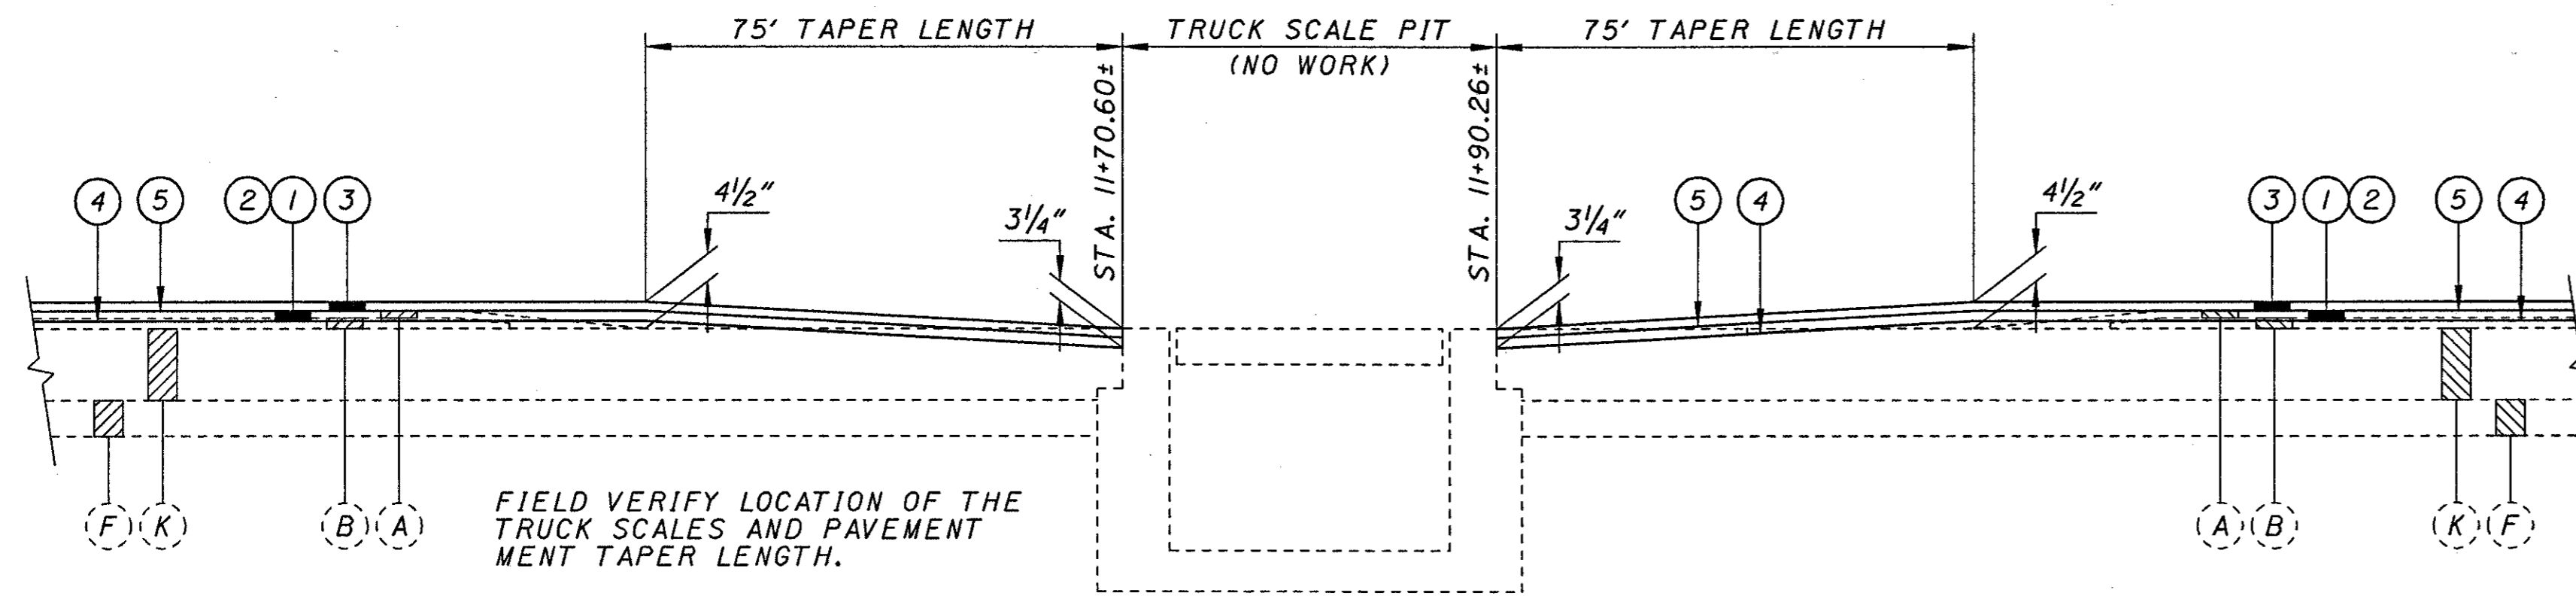

FEATHERING AT WEIGH STATION TRUCK SCALE


NOT TO SCALE

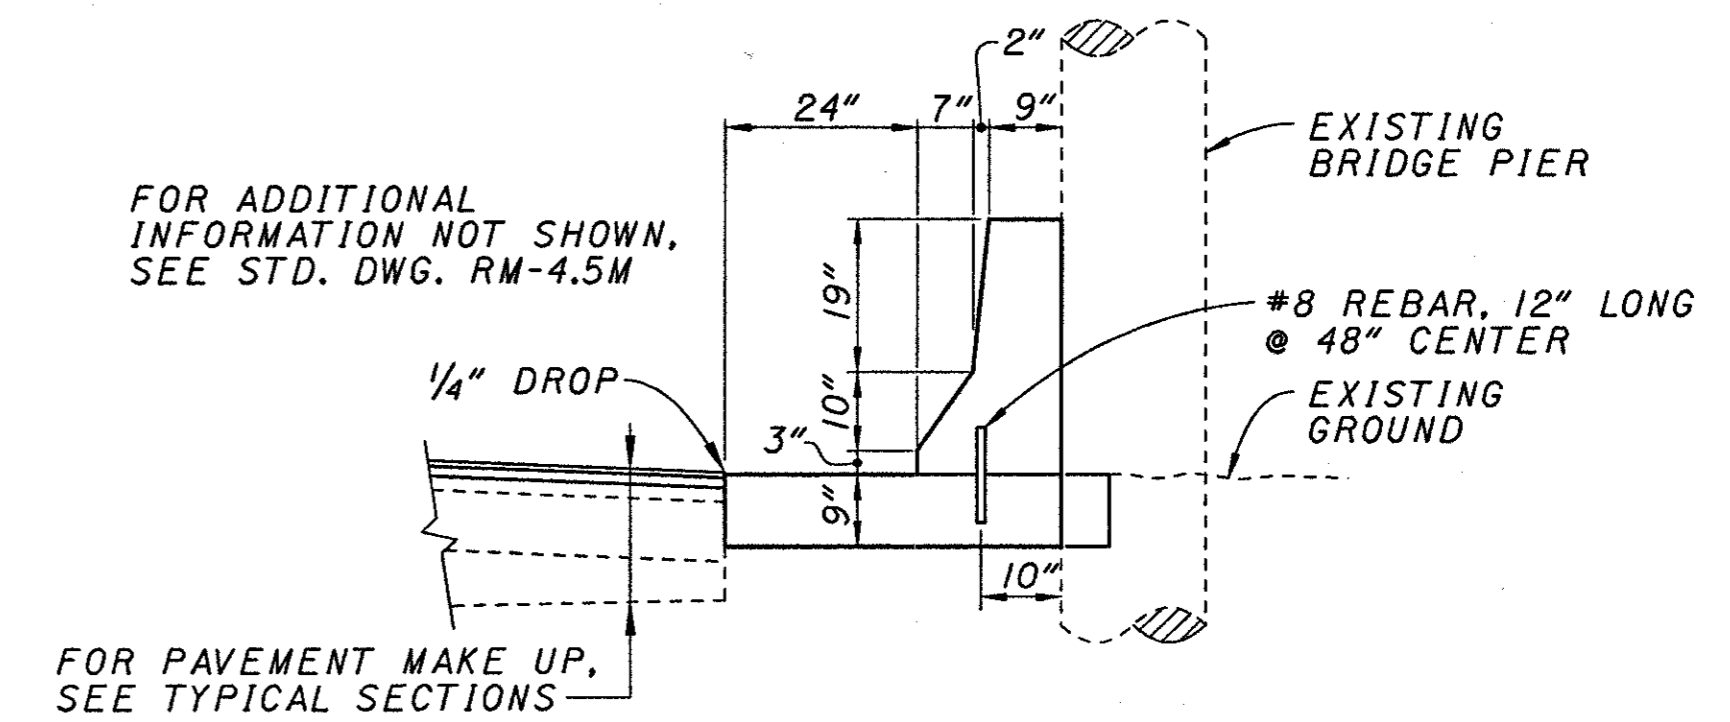

CONCRETE BARRIER TYPE D, AS PER PLAN

NOT TO SCALE
FOR BARRIER LIMITS AND LOCATIONS SEE PLAN SHEETS


FOR LOCATIONS, SEE BRIDGE SITE PLANS AND FOR FURTHER INFORMATION, SEE STANDARD DRAWING DM-4.1M.

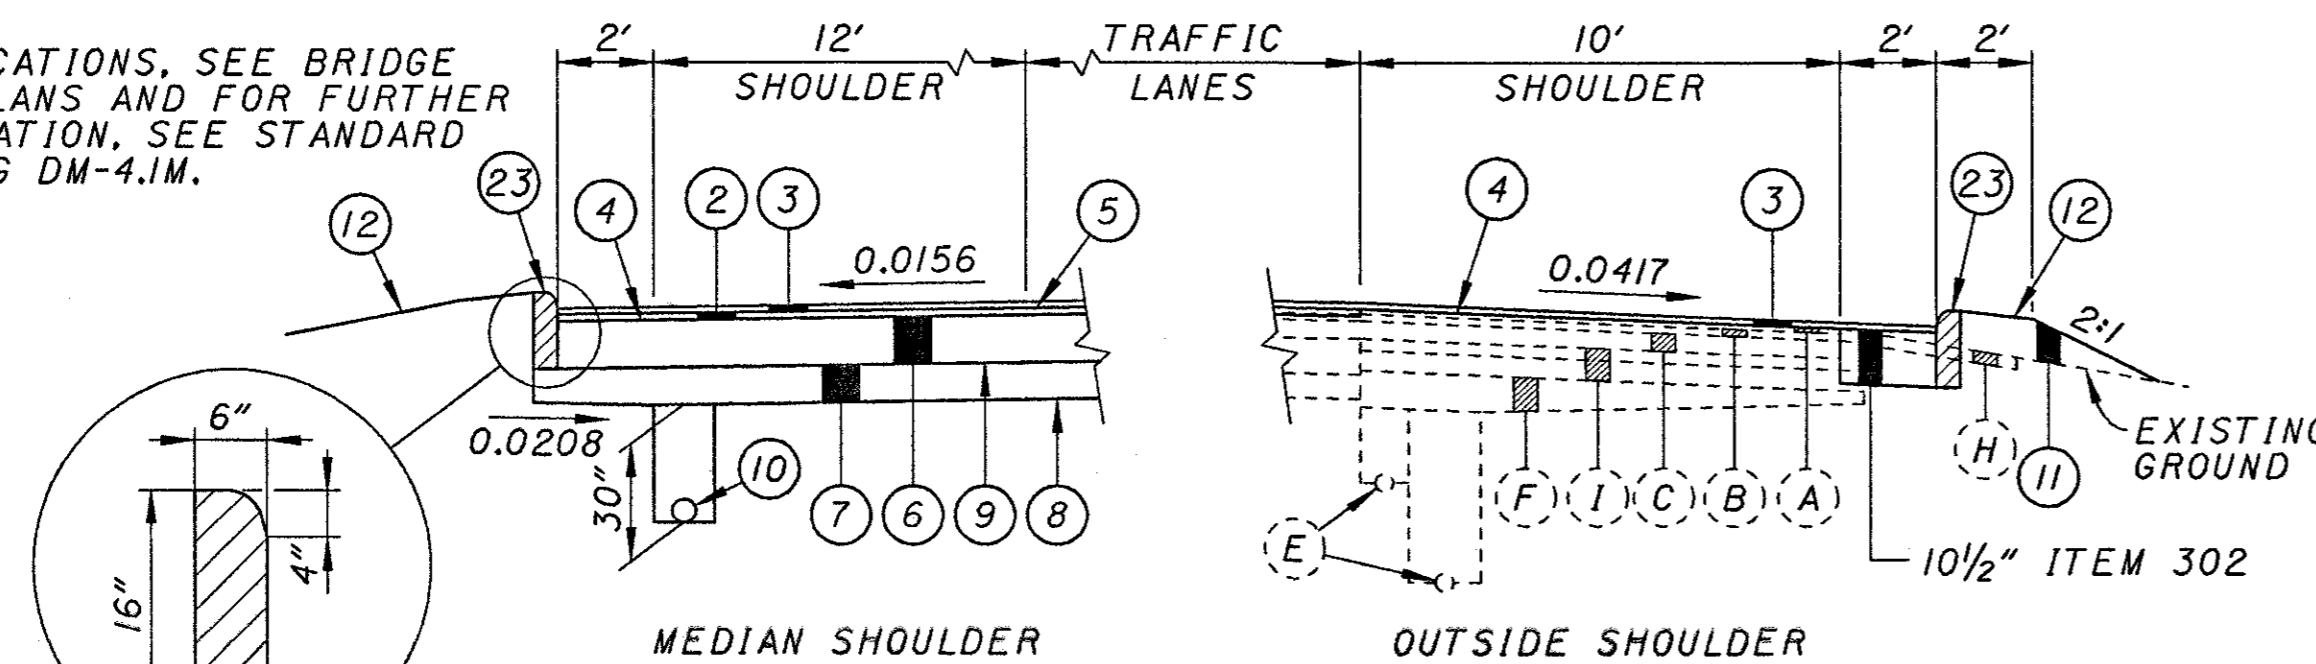

ITEM 830 - CURB, TYPE 6, AS PER PLAN


NOT TO SCALE

- BRIDGE No. PRE-70-0504 R/L (SEVEN MILE CREEK)
EAST SIDE OF EB & WB BRIDGES - 4 LOCATIONS
- BRIDGE No. PRE-70-0689 R/L (BANTAS FORK CREEK)
EAST SIDE OF EB & WB BRIDGES - 4 LOCATIONS
- BRIDGE No. PRE-70-1072 R/L (GOOSE RUN)
WEST SIDE OF EB & WB BRIDGES - 4 LOCATIONS
- BRIDGE No. PRE-70-1249 R/L (PRICE'S CREEK)
EAST SIDE OF EB & WB BRIDGES - 4 LOCATIONS
WEST SIDE OF EB & WB BRIDGES - 4 LOCATIONS
- BRIDGE No. PRE-70-1349 R/L (JIM'S RUN)
NONE REQUIRED AT THIS LOCATION
- BRIDGE No. PRE-70-1500 R/L (TWIN CREEK)
EAST SIDE OF EB & WB BRIDGES - 4 LOCATIONS

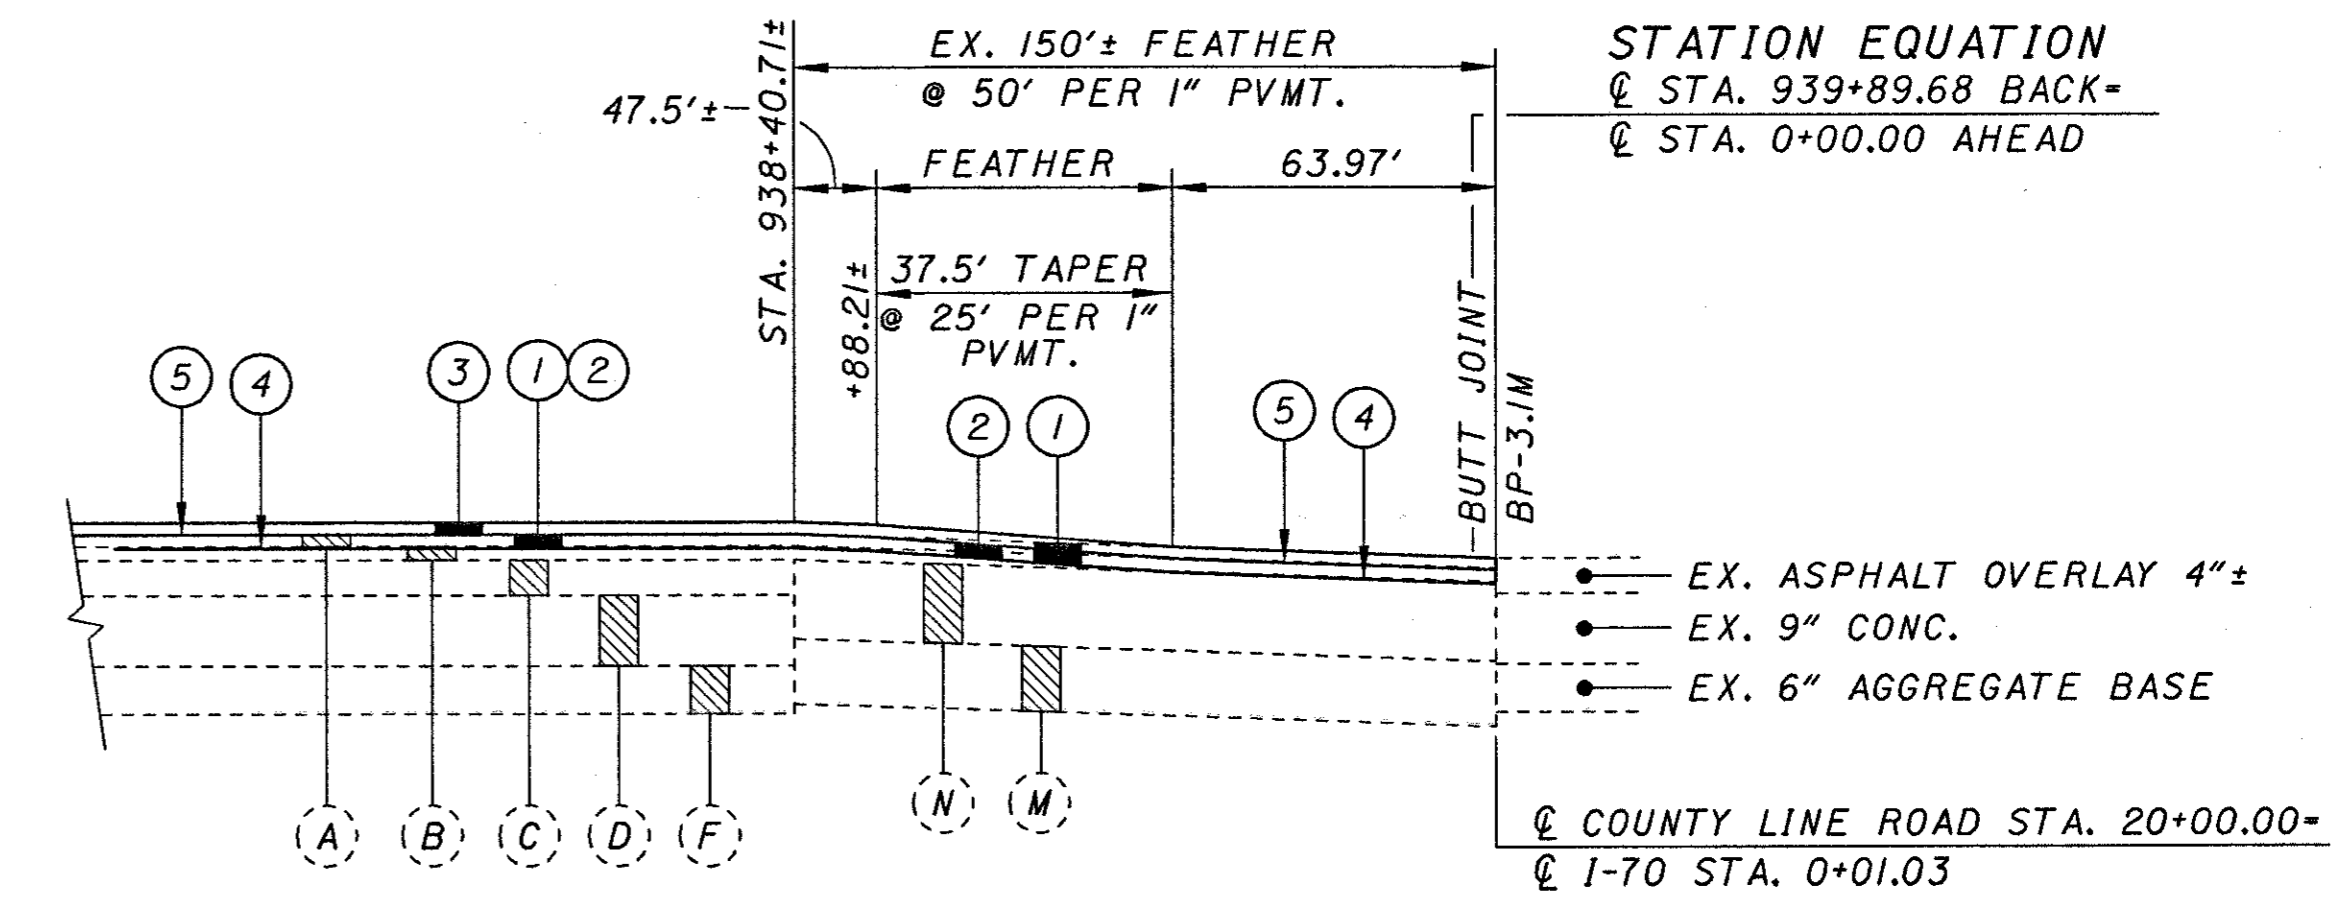

PAVEMENT FEATHERING @ END PROJECT

NOT TO SCALE
PREBLE/MONTGOMERY COUNTY LINE

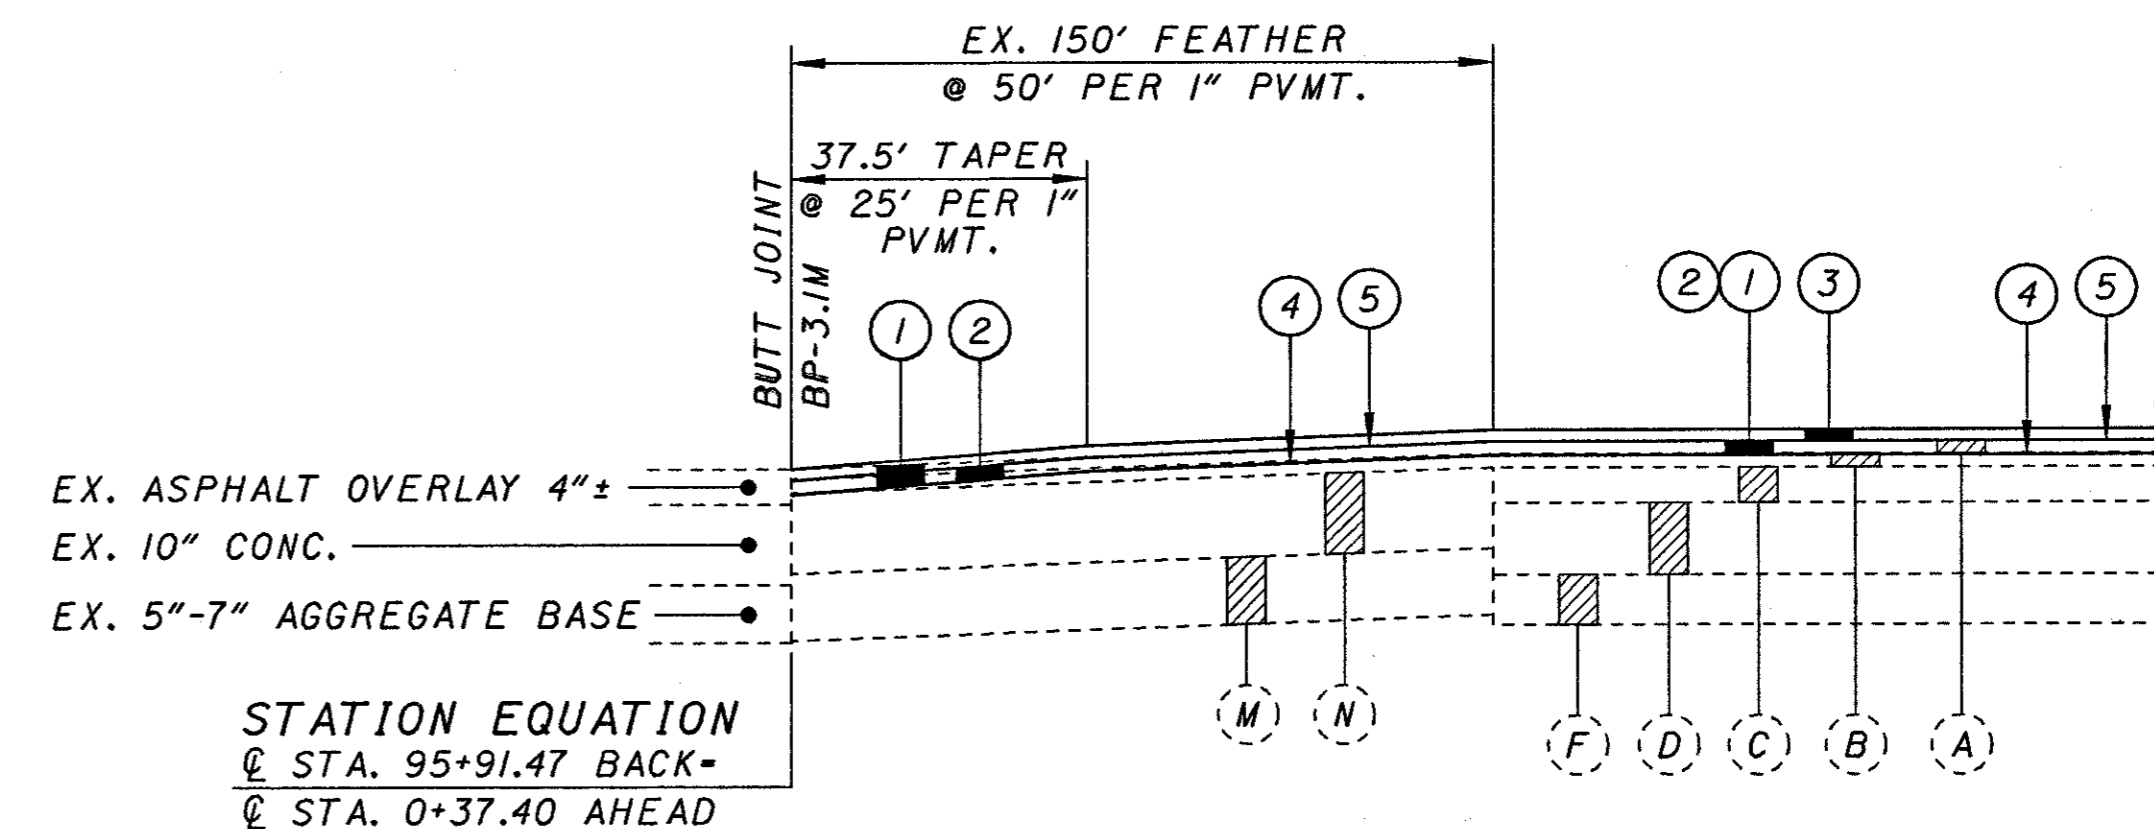

PAVEMENT FEATHERING @ BEGIN PROJECT


NOT TO SCALE
OHIO/INDIANA STATE LINE (PREBLE/WAYNE COUNTY LINE)

NOTE:

1) FOR ITEM LEGEND, SEE SHEET 5.

MISCELLANEOUS DETAILS
PAVEMENT FEATHERING/CONCRETE BARRIER DETAILS

PRE-70-0.00

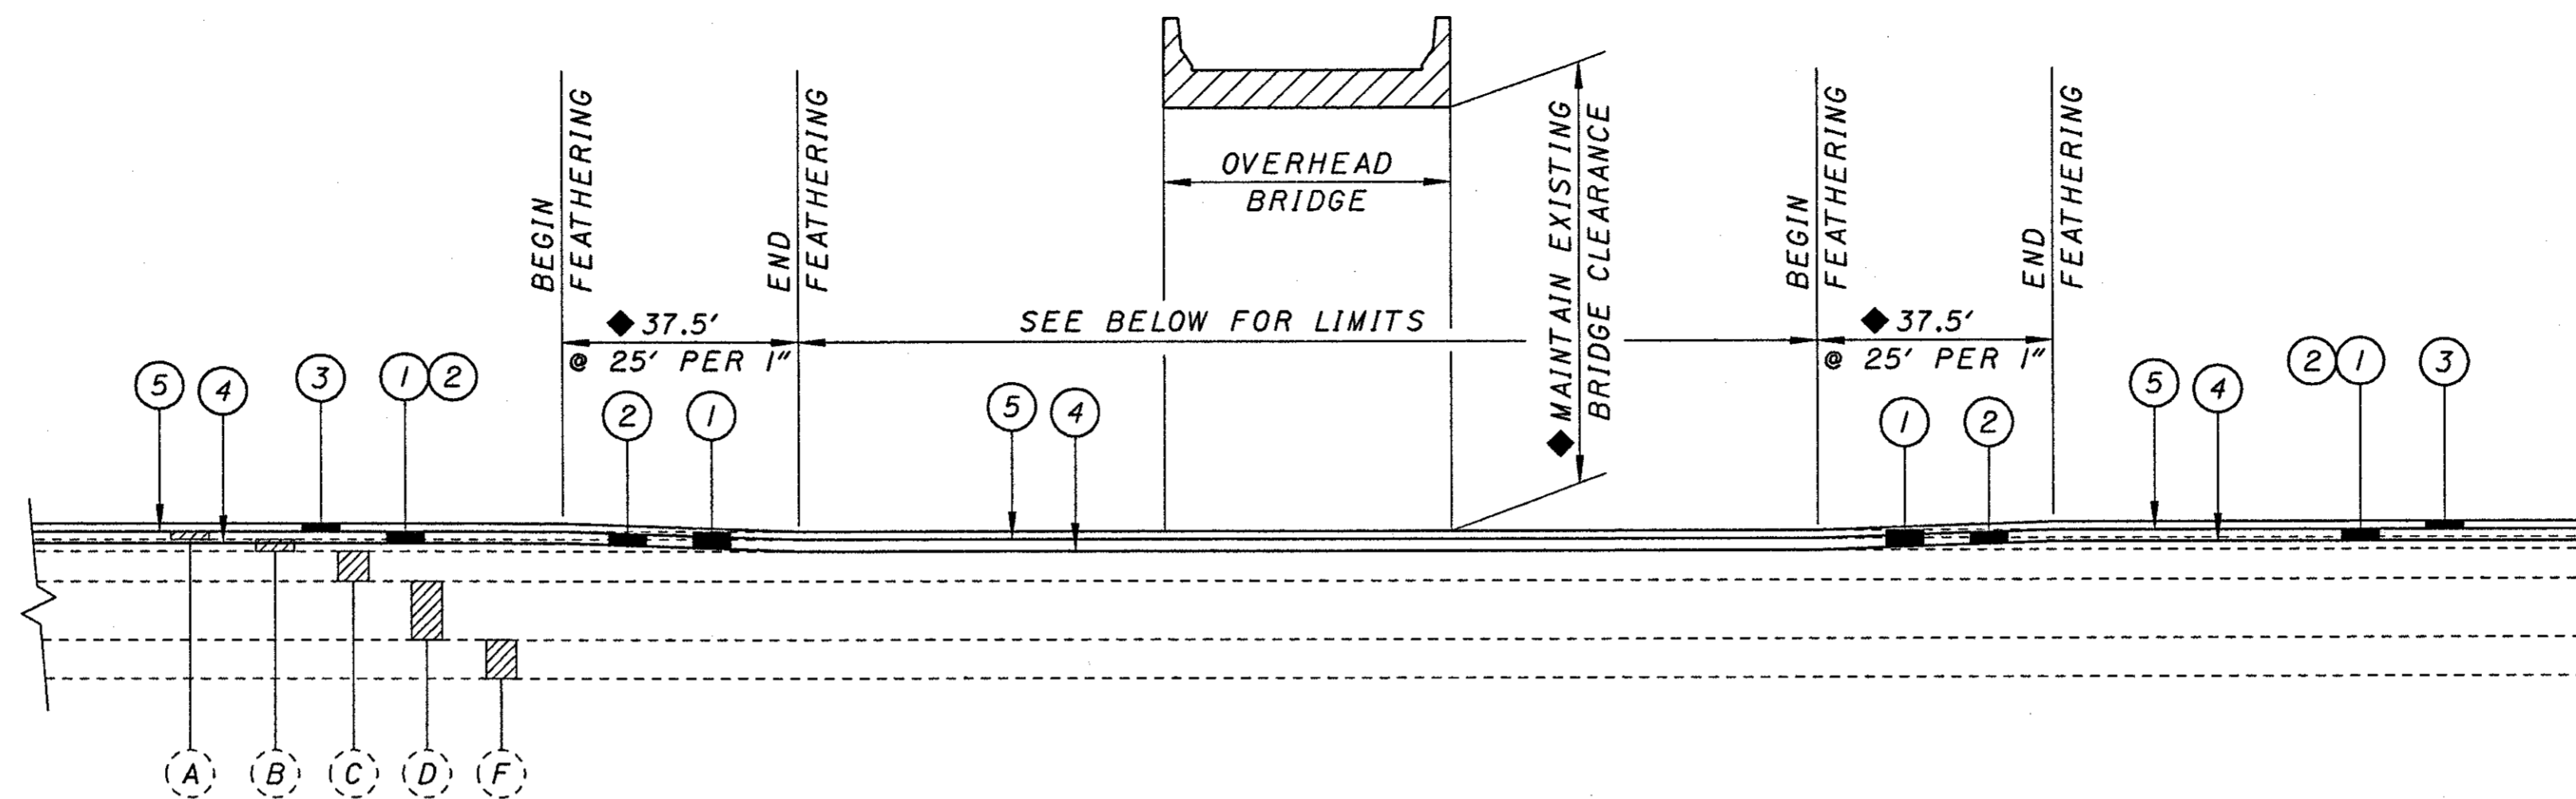


PAVEMENT FEATHERING @ OVERHEAD BRIDGES
NOT TO SCALE

◆ EXISTING BRIDGE CLEARANCE DOES NOT MEET CURRENT STANDARDS.
PRE-70-503-1955 (S.R. 503) EXISTING CLEARANCE IS 15.81', INCREASE TO 16', FEATHER LENGTH INCREASES TO 94.5'.
PRE-70-1541 (LEWISBURG-OZIAS RD.) EXISTING CLEARANCE IS 15.83', INCREASE TO 16', FEATHER LENGTH INCREASES TO 88.5'.

WESTBOUND LANES				EASTBOUND LANES				WESTBOUND LANES				EASTBOUND LANES			
BRIDGE No. PRE-320-0117 (S.R. 320)								BRIDGE No. PRE-70-0872 (MONROE-CENTRAL RD.)							
<u>BEGIN FEATHER</u>	<u>END FEATHER</u>	<u>BEGIN FEATHER</u>	<u>END FEATHER</u>	<u>BEGIN FEATHER</u>	<u>END FEATHER</u>	<u>BEGIN FEATHER</u>	<u>END FEATHER</u>	<u>BEGIN FEATHER</u>	<u>END FEATHER</u>	<u>BEGIN FEATHER</u>	<u>END FEATHER</u>	<u>BEGIN FEATHER</u>	<u>END FEATHER</u>	<u>BEGIN FEATHER</u>	<u>END FEATHER</u>
STA. 57+61.00	TO STA. 57+98.50	STA. 57+61.00	TO STA. 57+98.50	STA. 59+54.00	TO STA. 59+91.50	STA. 59+54.00	TO STA. 59+91.50	STA. 459+68.70	TO STA. 460+06.20	STA. 459+68.70	TO STA. 460+06.20	STA. 461+37.20	TO STA. 461+74.70	STA. 461+37.20	TO STA. 461+74.70
STA. 59+54.00	TO STA. 59+91.50							STA. 461+37.20	TO STA. 461+74.70	STA. 461+37.20	TO STA. 461+74.70				
BRIDGE No. PRE-35-0176 (U.S.R. 35 - RAMP A)								BRIDGE No. PRE-127-1911 (U.S.R. 127)							
<u>BEGIN FEATHER</u>	<u>END FEATHER</u>	<u>BEGIN FEATHER</u>	<u>END FEATHER</u>	<u>BEGIN FEATHER</u>	<u>END FEATHER</u>	<u>BEGIN FEATHER</u>	<u>END FEATHER</u>	<u>BEGIN FEATHER</u>	<u>END FEATHER</u>	<u>BEGIN FEATHER</u>	<u>END FEATHER</u>	<u>BEGIN FEATHER</u>	<u>END FEATHER</u>	<u>BEGIN FEATHER</u>	<u>END FEATHER</u>
STA. 95+26.50	TO STA. 95+64.00	STA. 95+80.50	TO STA. 96+18.00	STA. 96+97.00	TO STA. 97+34.50	STA. 97+50.00	TO STA. 97+87.50	STA. 522+84.00	TO STA. 523+21.50	STA. 522+80.00	TO STA. 523+17.50	STA. 524+98.50	TO STA. 525+36.00	STA. 524+94.50	TO STA. 525+32.00
STA. 95+26.50	TO STA. 95+64.00							STA. 522+84.00	TO STA. 523+21.50	STA. 522+80.00	TO STA. 523+17.50				
BRIDGE No. PRE-70-0358 (ORANGEBURG RD.)								BRIDGE No. PRE-70-1366 (SHIELDS RD.)							
<u>BEGIN FEATHER</u>	<u>END FEATHER</u>	<u>BEGIN FEATHER</u>	<u>END FEATHER</u>	<u>BEGIN FEATHER</u>	<u>END FEATHER</u>	<u>BEGIN FEATHER</u>	<u>END FEATHER</u>	<u>BEGIN FEATHER</u>	<u>END FEATHER</u>	<u>BEGIN FEATHER</u>	<u>END FEATHER</u>	<u>BEGIN FEATHER</u>	<u>END FEATHER</u>	<u>BEGIN FEATHER</u>	<u>END FEATHER</u>
STA. 188+23.00	TO STA. 188+60.50	STA. 188+23.00	TO STA. 188+60.50	STA. 190+17.50	TO STA. 190+55.00	STA. 190+17.50	TO STA. 190+55.00	STA. 720+66.50	TO STA. 721+04.00	STA. 720+60.50	TO STA. 720+98.00	STA. 722+38.00	TO STA. 722+75.50	STA. 722+32.00	TO STA. 722+69.50
STA. 188+23.00	TO STA. 188+60.50							STA. 720+66.50	TO STA. 721+04.00	STA. 720+60.50	TO STA. 720+98.00				
BRIDGE No. PRE-70-0489 (OXFORD-GETTYSBURG RD.)								BRIDGE No. PRE-70-503-1955 (S.R. 503)							
<u>BEGIN FEATHER</u>	<u>END FEATHER</u>	<u>BEGIN FEATHER</u>	<u>END FEATHER</u>	<u>BEGIN FEATHER</u>	<u>END FEATHER</u>	<u>BEGIN FEATHER</u>	<u>END FEATHER</u>	<u>BEGIN FEATHER</u>	<u>END FEATHER</u>	<u>BEGIN FEATHER</u>	<u>END FEATHER</u>	<u>BEGIN FEATHER</u>	<u>END FEATHER</u>	<u>BEGIN FEATHER</u>	<u>END FEATHER</u>
STA. 257+83.00	TO STA. 258+20.50	STA. 257+45.60	TO STA. 257+83.10	STA. 259+51.60	TO STA. 259+89.10	STA. 259+14.20	TO STA. 259+51.70	STA. 779+79.00	TO STA. 780+73.50	STA. 779+79.00	TO STA. 780+73.50	STA. 782+10.50	TO STA. 783+05.00	STA. 782+10.50	TO STA. 783+05.00
STA. 257+83.00	TO STA. 258+20.50							STA. 779+79.00	TO STA. 780+73.50	STA. 779+79.00	TO STA. 780+73.50				
BRIDGE No. PRE-70-0632 (PENCE-SHEWMAN RD.)								BRIDGE No. PRE-70-1541 (LEWISBURG-OZIAS RD.)							
<u>BEGIN FEATHER</u>	<u>END FEATHER</u>	<u>BEGIN FEATHER</u>	<u>END FEATHER</u>	<u>BEGIN FEATHER</u>	<u>END FEATHER</u>	<u>BEGIN FEATHER</u>	<u>END FEATHER</u>	<u>BEGIN FEATHER</u>	<u>END FEATHER</u>	<u>BEGIN FEATHER</u>	<u>END FEATHER</u>	<u>BEGIN FEATHER</u>	<u>END FEATHER</u>	<u>BEGIN FEATHER</u>	<u>END FEATHER</u>
STA. 332+91.50	TO STA. 333+29.00	STA. 332+84.00	TO STA. 333+21.50	STA. 334+60.00	TO STA. 334+97.50	STA. 334+52.50	TO STA. 334+90.00	STA. 819+20.20	TO STA. 820+08.70	STA. 819+33.20	TO STA. 820+21.70	STA. 821+40.70	TO STA. 822+29.20	STA. 821+53.70	TO STA. 822+42.20
STA. 332+91.50	TO STA. 333+29.00							STA. 819+20.20	TO STA. 820+08.70	STA. 819+33.20	TO STA. 820+21.70				
BRIDGE No. PRE-726-0428 (S.R. 726)								BRIDGE No. PRE-70-1665 (JORDAN RD.)							
<u>BEGIN FEATHER</u>	<u>END FEATHER</u>	<u>BEGIN FEATHER</u>	<u>END FEATHER</u>	<u>BEGIN FEATHER</u>	<u>END FEATHER</u>	<u>BEGIN FEATHER</u>	<u>END FEATHER</u>	<u>BEGIN FEATHER</u>	<u>END FEATHER</u>	<u>BEGIN FEATHER</u>	<u>END FEATHER</u>	<u>BEGIN FEATHER</u>	<u>END FEATHER</u>	<u>BEGIN FEATHER</u>	<u>END FEATHER</u>
STA. 389+96.40	TO STA. 390+33.90	STA. 389+96.40	TO STA. 390+33.90	STA. 391+68.50	TO STA. 392+06.00	STA. 391+68.50	TO STA. 392+06.00	STA. 885+62.50	TO STA. 886+00.00	STA. 885+62.50	TO STA. 886+00.00	STA. 887+32.50	TO STA. 887+70.00	STA. 887+32.50	TO STA. 887+70.00
STA. 389+96.40	TO STA. 390+33.90							STA. 885+62.50	TO STA. 886+00.00	STA. 885+62.50	TO STA. 886+00.00				
BRIDGE No. PRE-70-1776 (COUNTY LINE RD.) FOR FEATHER LIMITS SEE "PAVEMENT @ END PROJECT DETAIL" ON THE PREVIOUS SHEET.															

MISCELLANEOUS DETAILS
PAVEMENT FEATHERING AT OVERHEAD BRIDGES DETAIL
PRE-70-0.00

REF: PRE-70-0.00
DESIGN: LEWISBURG-OZIAS RD.
PREP: NAME: \$PRJNAME\$
ACTIVE LEVELS ON: \$LEVEL\$

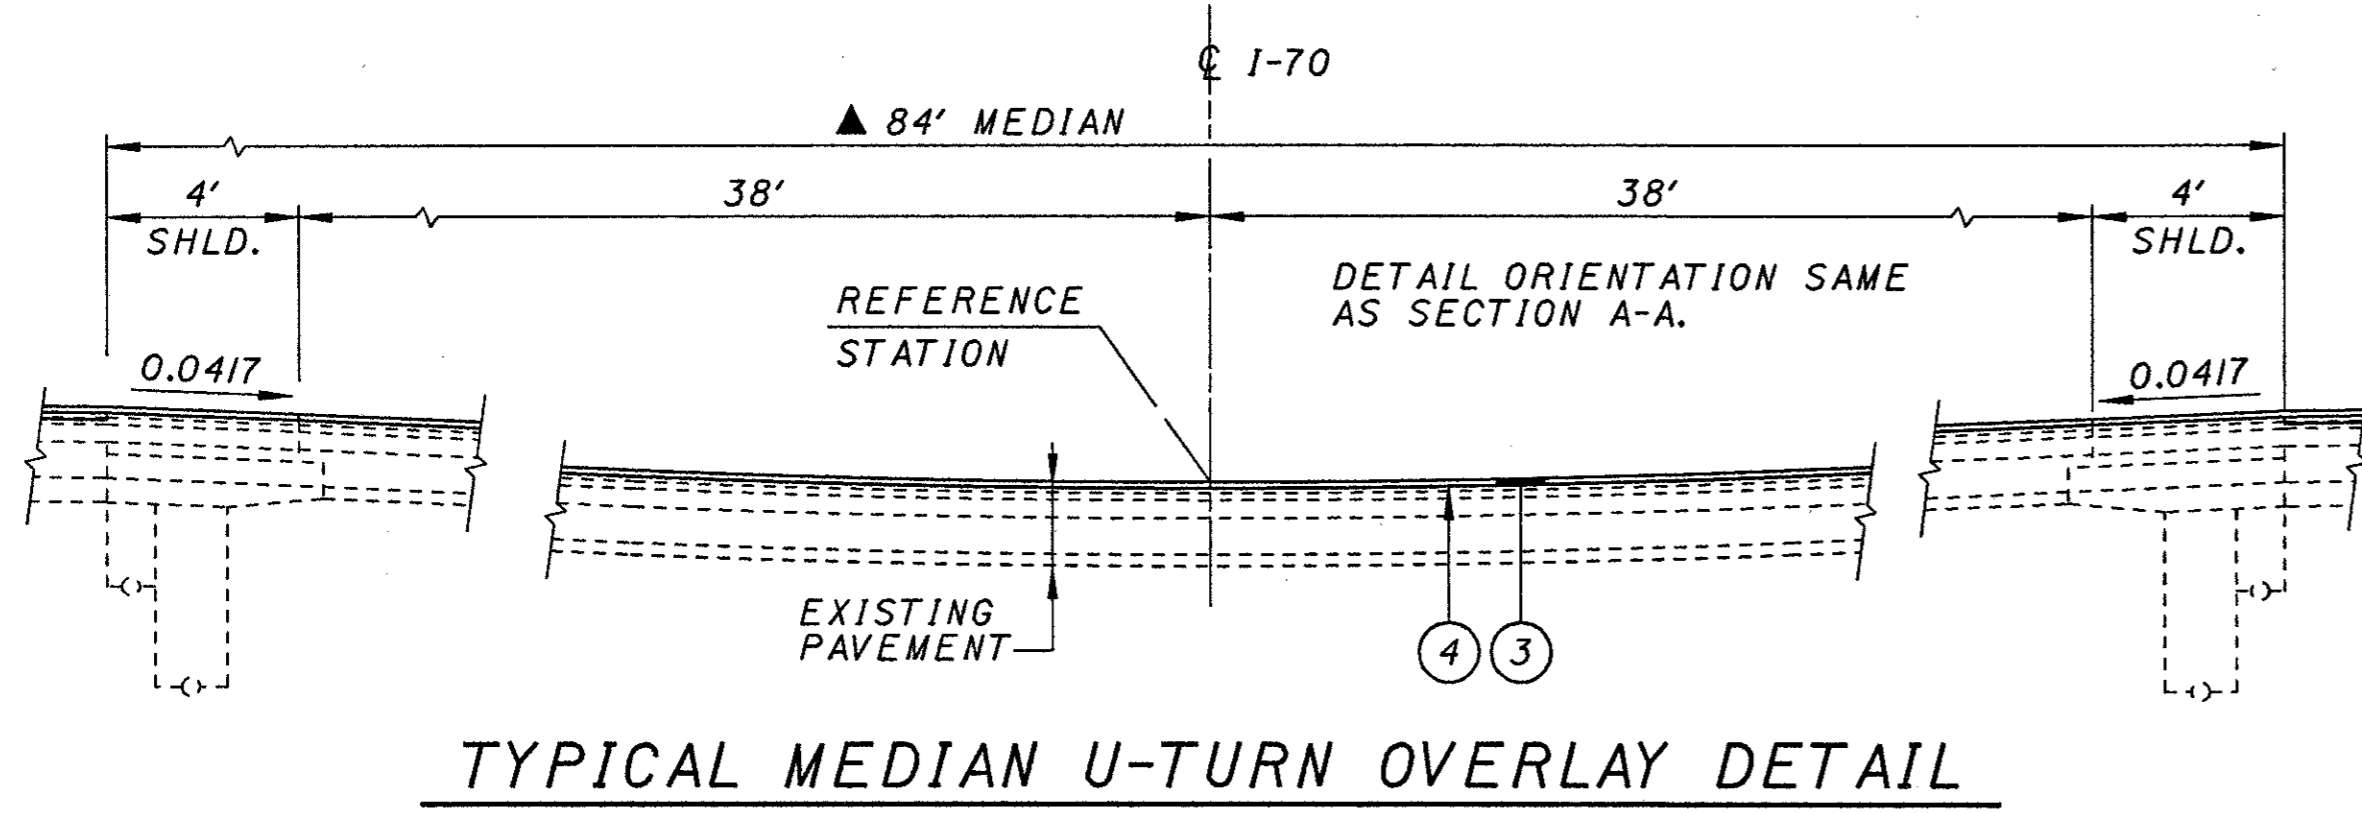


TYPICAL MEDIAN U-TURN OVERLAY DETAIL

NOT TO SCALE

▲ STA. 3+55± STA. 210+50± STA. 489+60±
 STA. 114+85± STA. 338+60± STA. 740+00±
 ▲ MEDIAN WIDTH IS 60'

FOR FURTHER MEDIAN U-TURN INFORMATION, SEE ROADWAY L&D MANUAL, FIGURE 304-2.

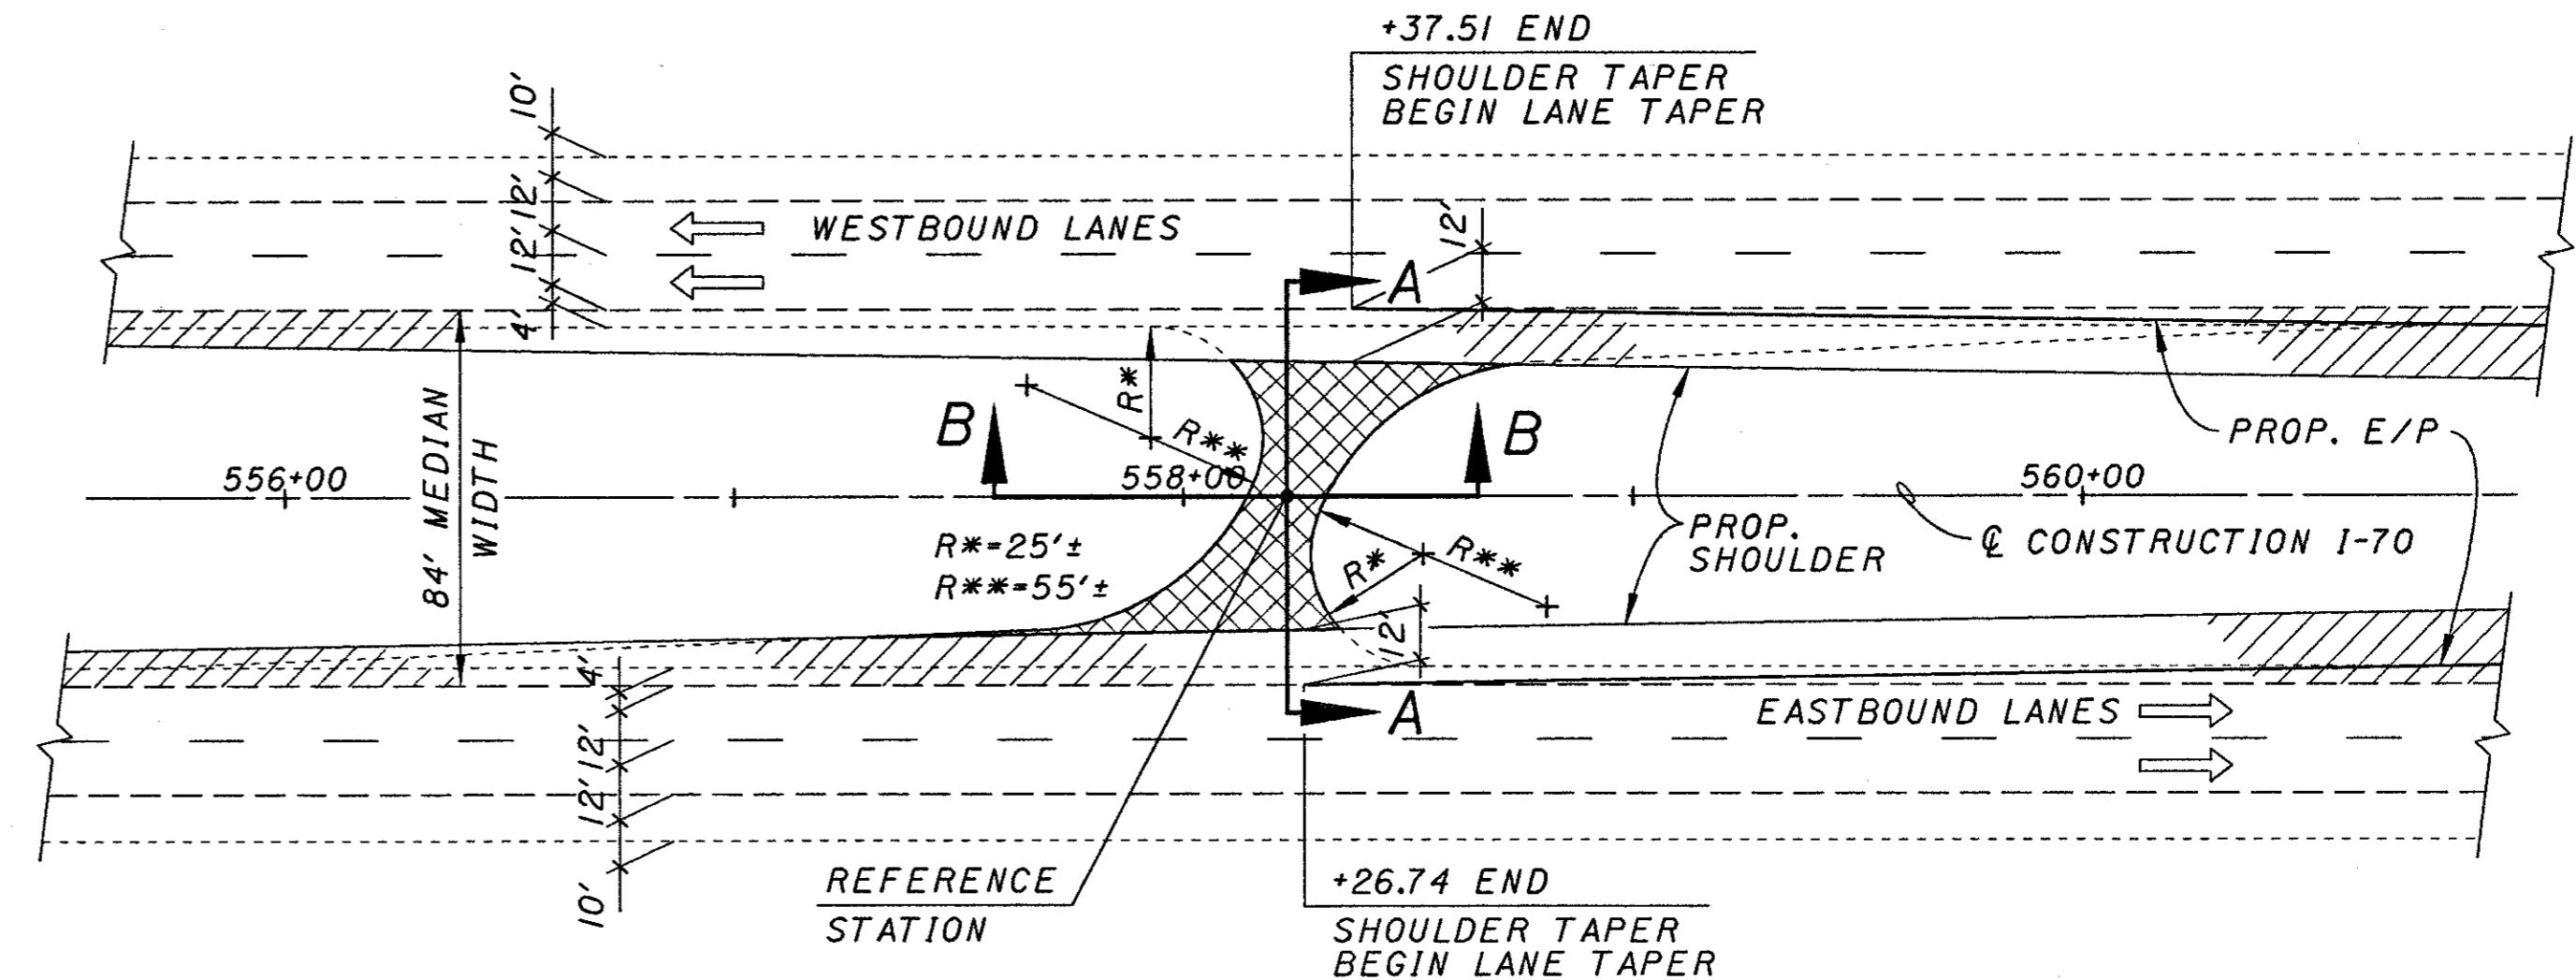


MEDIAN U-TURN @ STA. 558+23±

NOT TO SCALE

LIMITS OF MEDIAN U-TURN PAVING. (SEE NOTE 2)
 LIMITS OF MEDIAN WIDENING PAVEMENT

FOR FURTHER MEDIAN U-TURN INFORMATION, SEE ROADWAY L&D MANUAL, FIGURE 304-2.

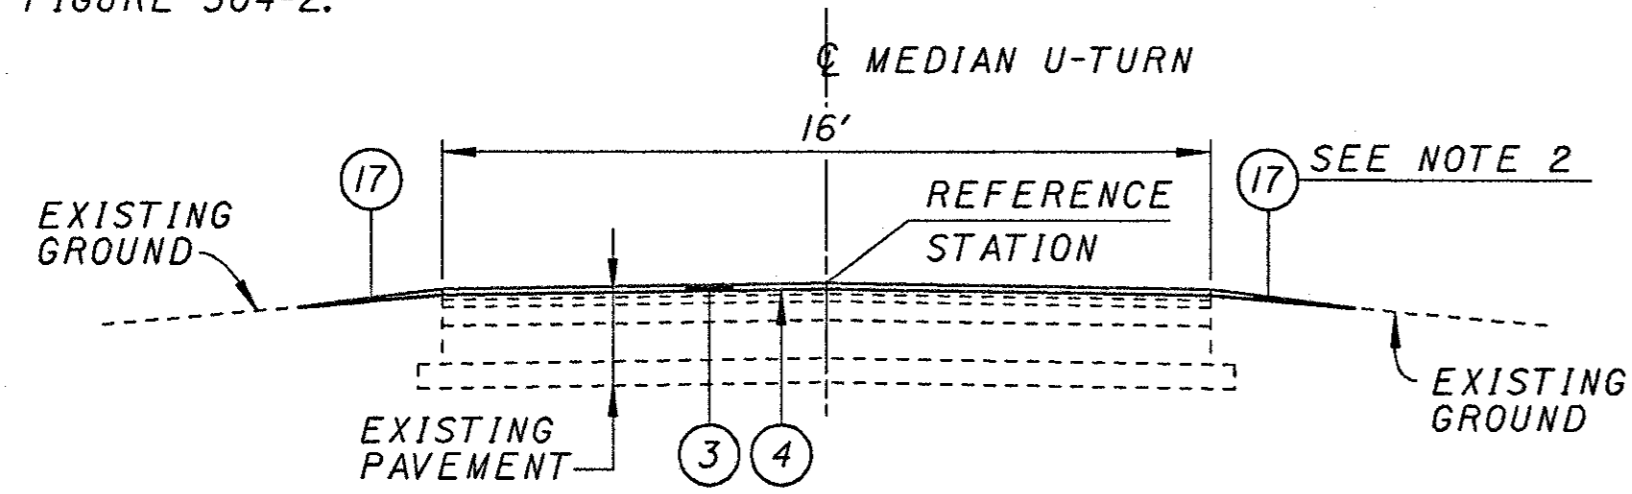


SECTION B'-B'

NOT TO SCALE


STA. 3+55± STA. 338+60±
 STA. 114+85± STA. 489+60±

SECTIONS B'-B' & B''-B'' ORIENTATION SAME AS SECTION B-B AND APPLY AT THE STATIONS LISTED ONLY.

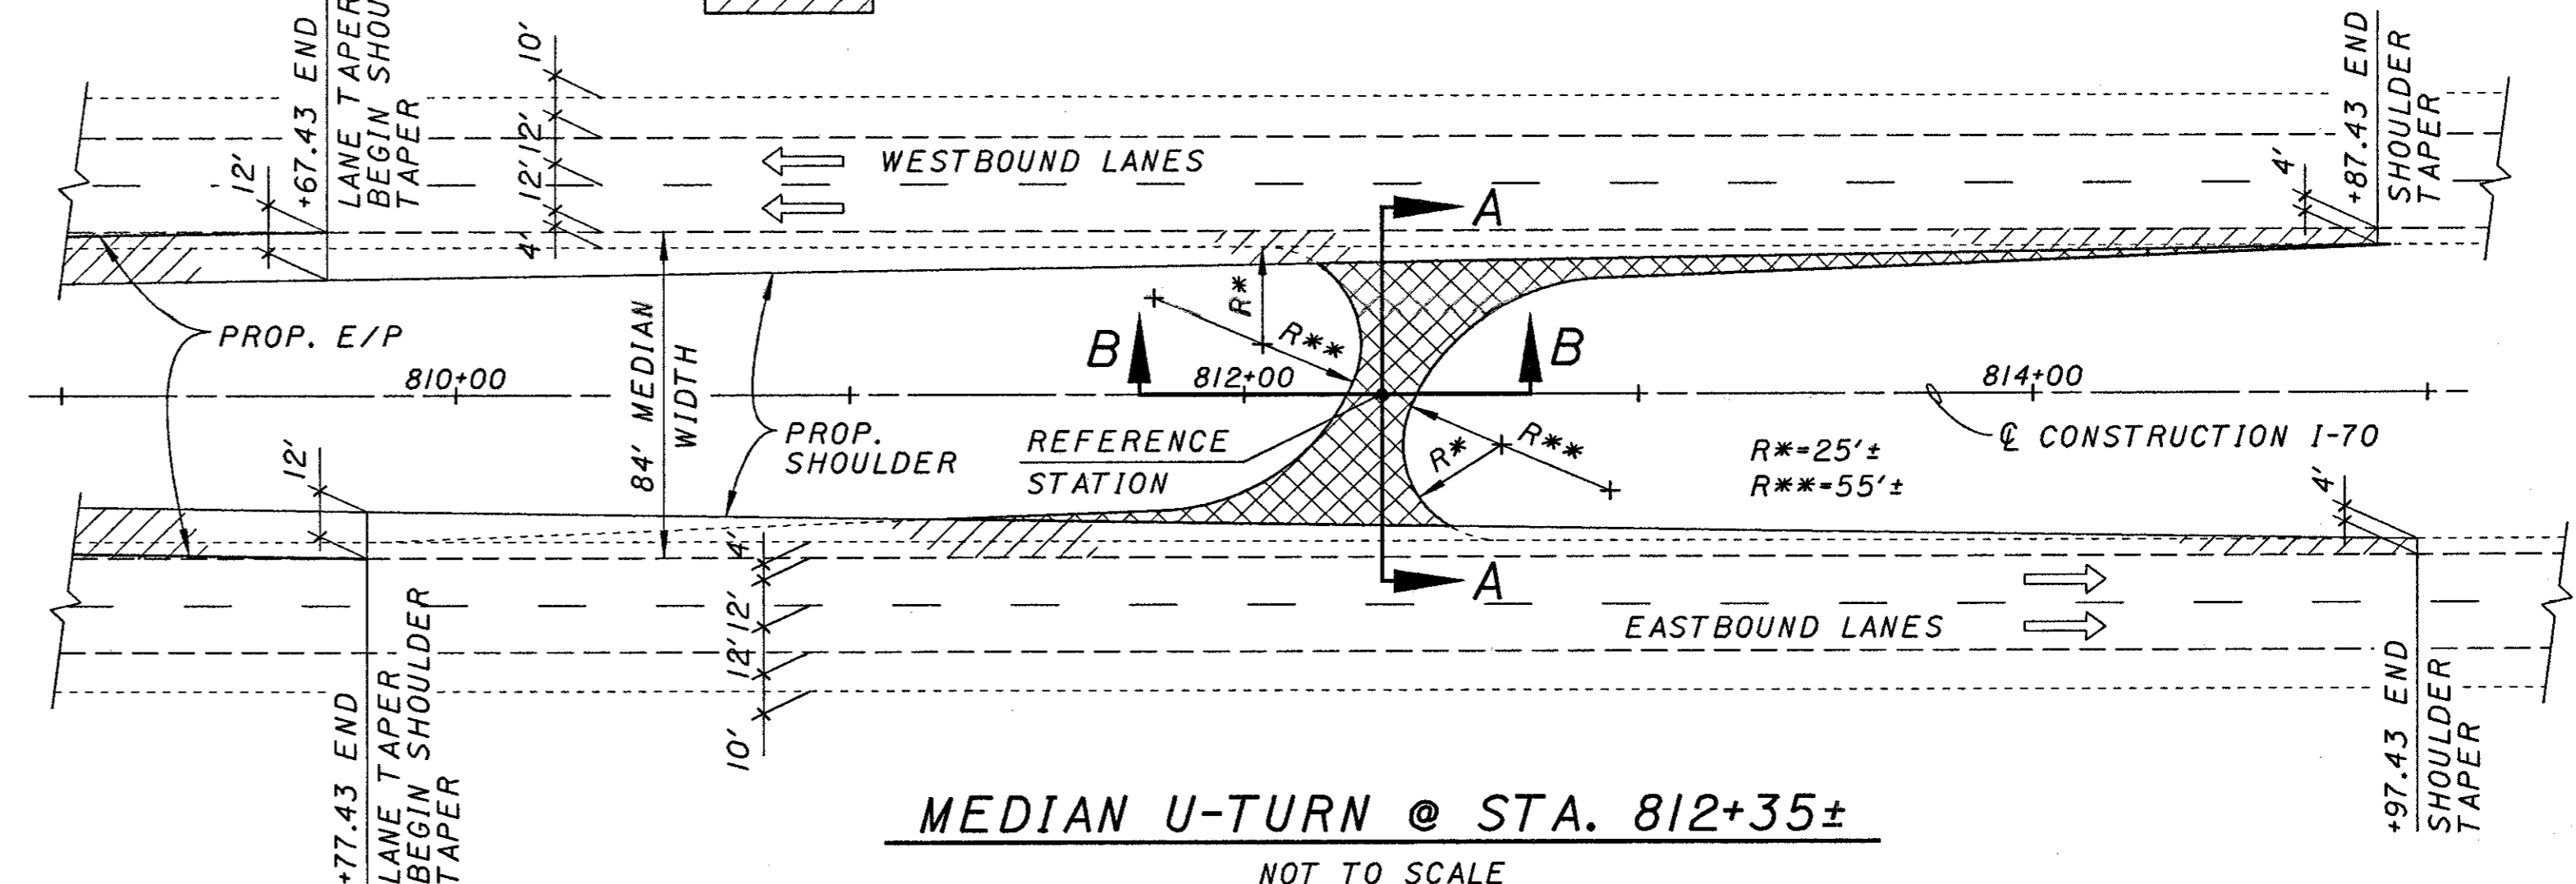

MEDIAN U-TURN @ STA. 812+35±

NOT TO SCALE

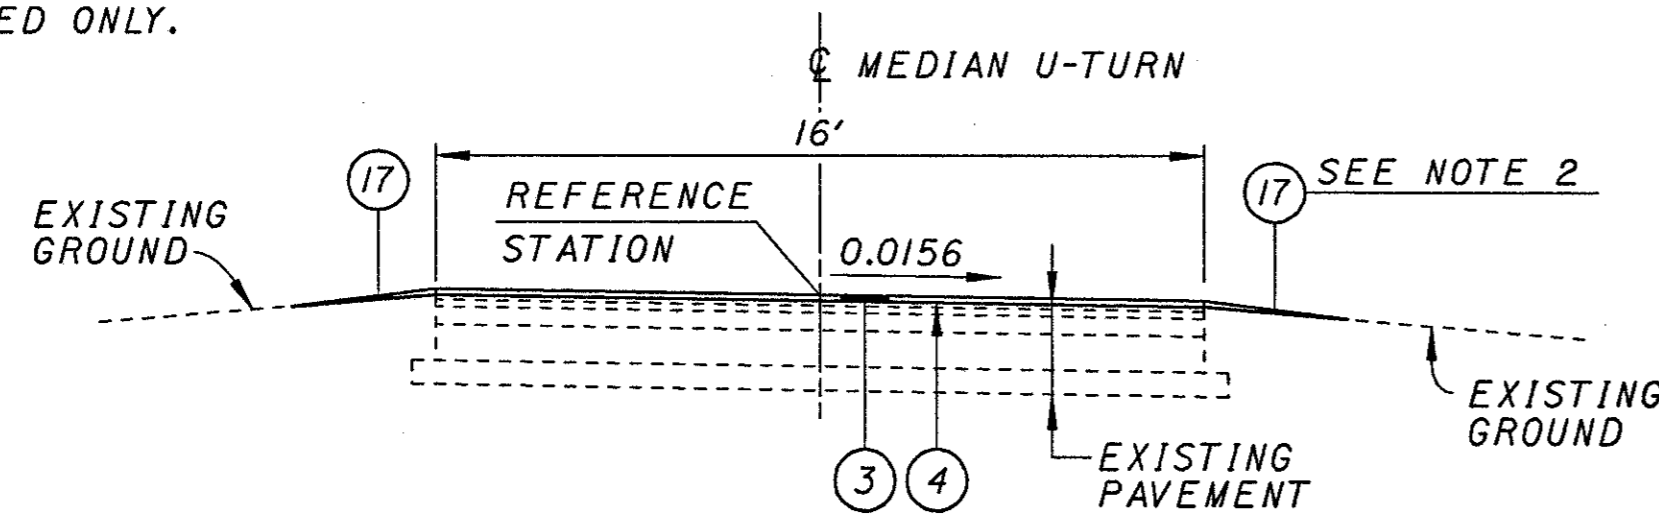


SECTION B''-B''

NOT TO SCALE

STA. 210+50± STA. 740+00±


FOR FURTHER MEDIAN U-TURN INFORMATION, SEE ROADWAY L&D MANUAL, FIGURE 304-2.

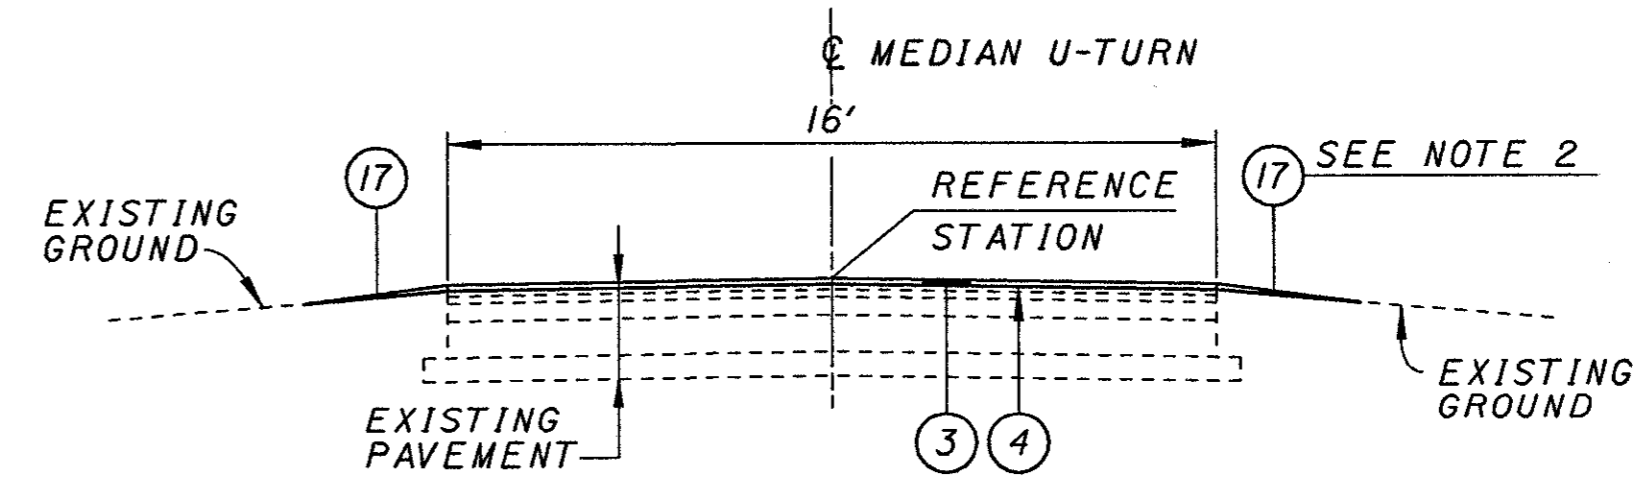

SECTION B-B

NOT TO SCALE

STA. 558+23± STA. 812+35±

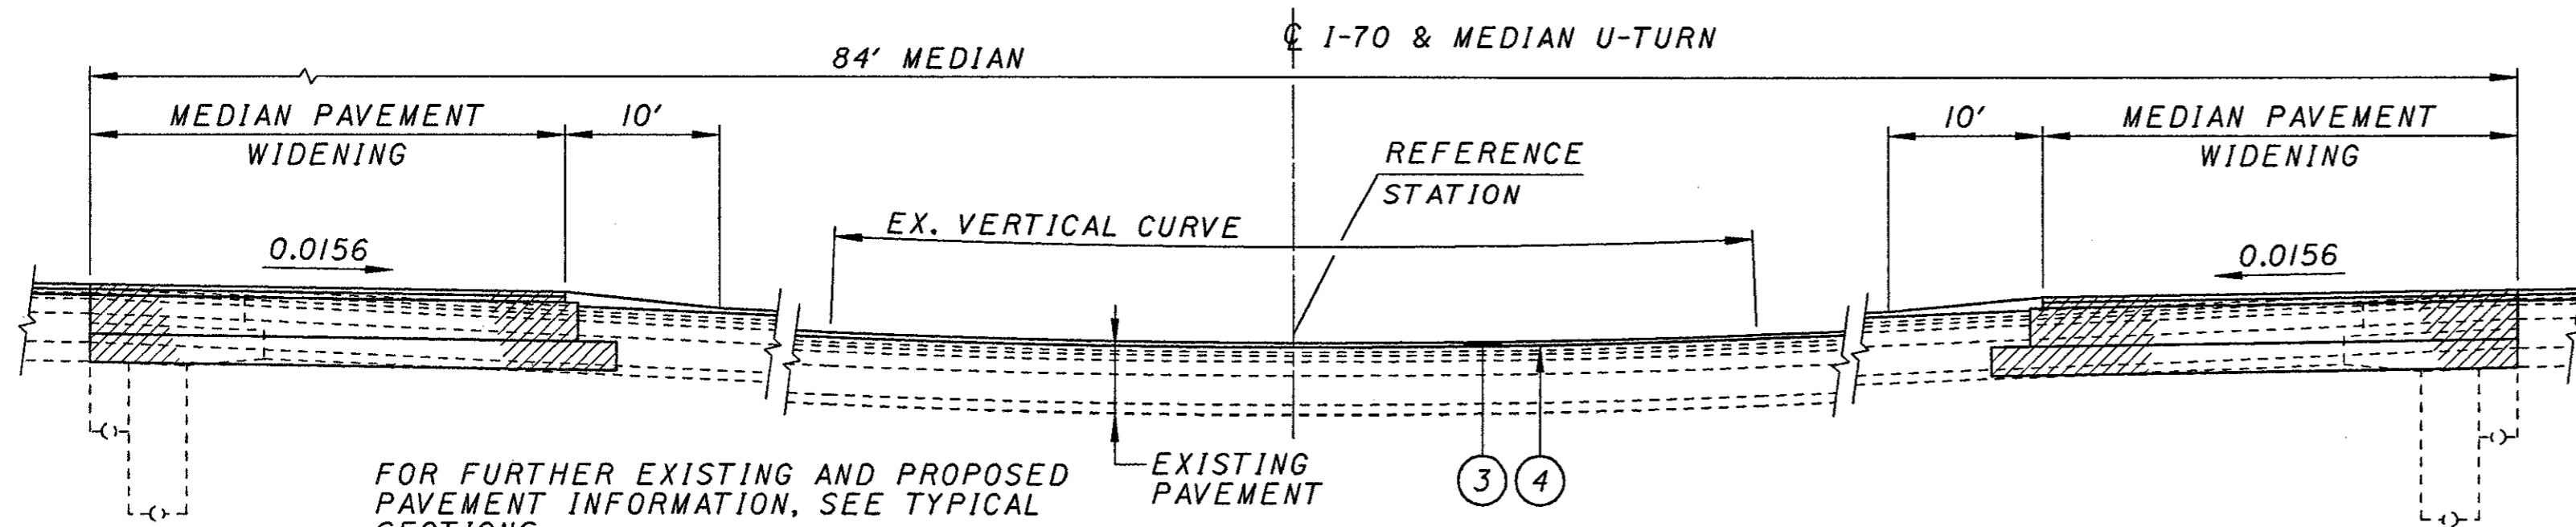

SECTION A-A

NOT TO SCALE


STA. 558+23± STA. 812+35±

FOR FURTHER EXISTING AND PROPOSED PAVEMENT INFORMATION, SEE TYPICAL SECTIONS.


NOTES

- 1) FOR ITEM LEGEND, SEE SHEET 5.
- 2) ITEM 617 - COMPACTED AGGREGATE SHALL BE PLACED IF THE DROP-OFF AT THE PAVEMENT EDGE IS 2" OR GREATER.


 REVISIONS
 NO. DATE BY
 1 10/1/79 JKL
 2 10/1/79 JKL
 3 10/1/79 JKL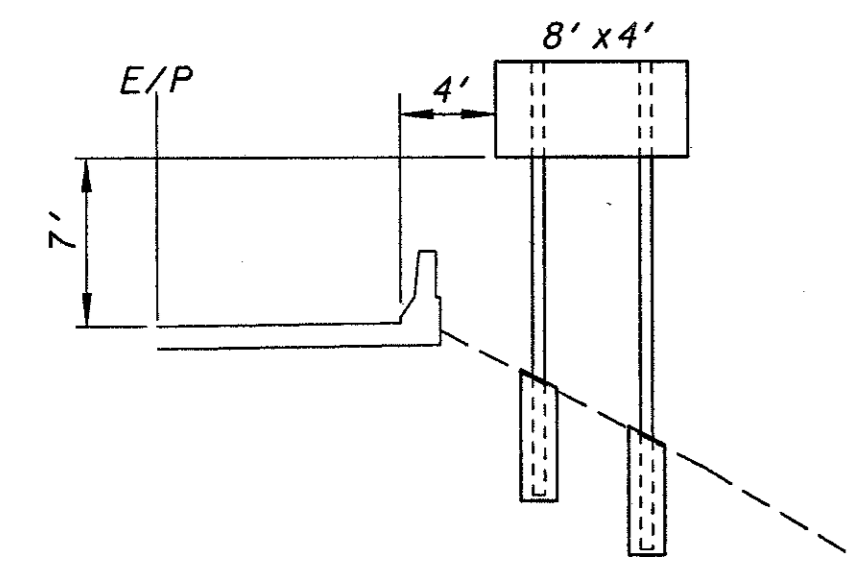

STA.0+40 I-70 E.B. RIGHT
W6x9
SUPPORTS: (2) 18' & 20.4'
SPACING: 1.76', 4.48', 1.76'
FOUNDATIONS: (2) 1.5'x5'

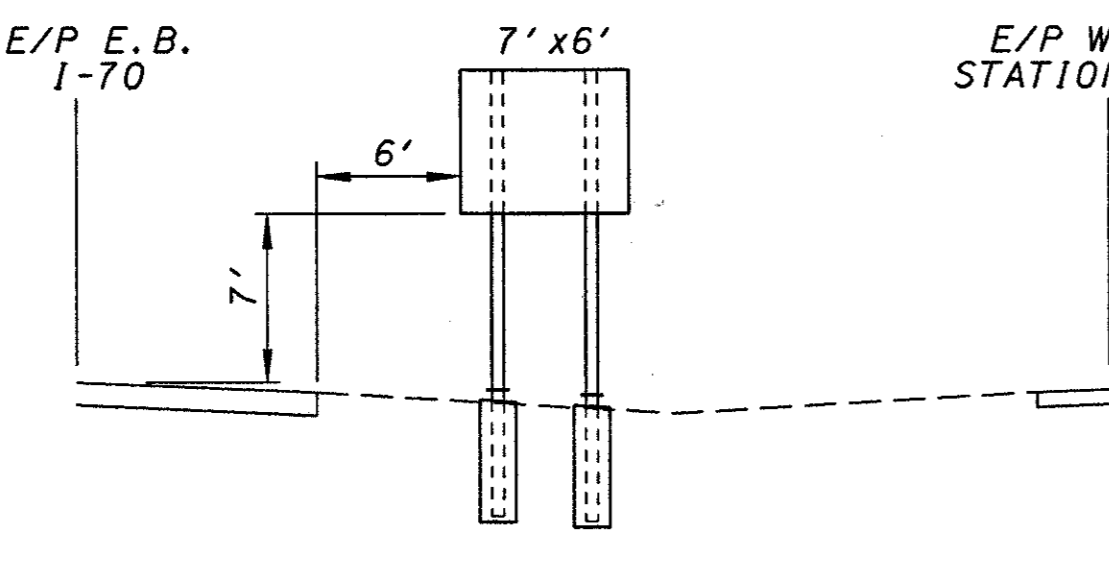


STA.28+90 I-70 E.B. RIGHT
W6x9 WITH BREAKAWAY CONNECTION
SUPPORTS: (2) 18.6' & 18.8'
SPACING: 1.54', 3.92', 1.54'
FOUNDATIONS: (2) 1.5'x5'

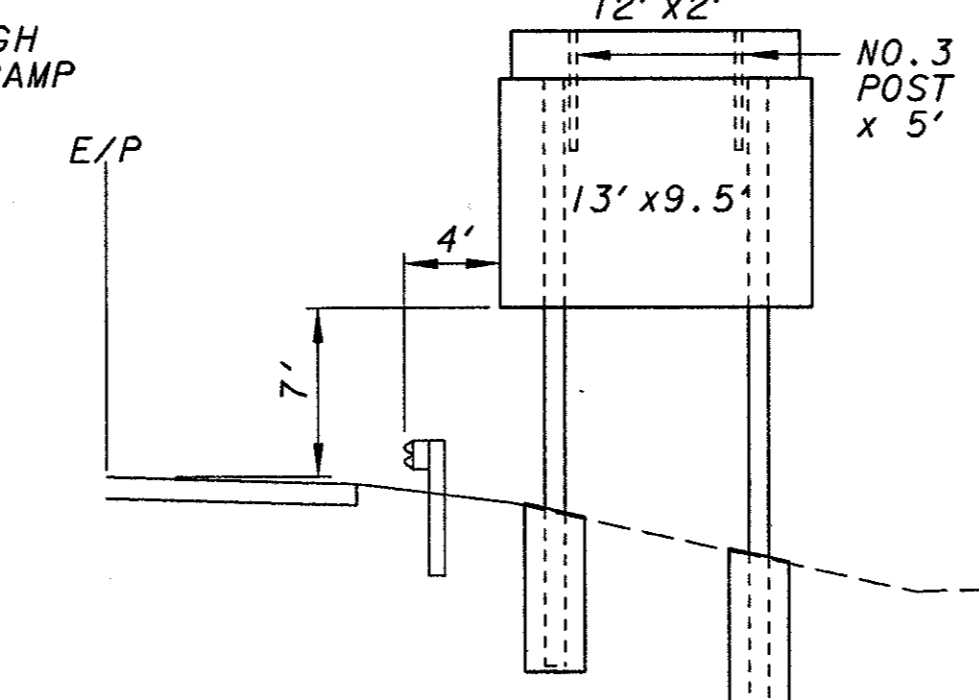


STA.97+55 I-70 W.B. LEFT
W10x22
SUPPORTS: (2) 24.6' & 26.5'
SPACING: 1.75', 8.5', 1.75'
FOUNDATIONS: (2) 2.5'x6.75'

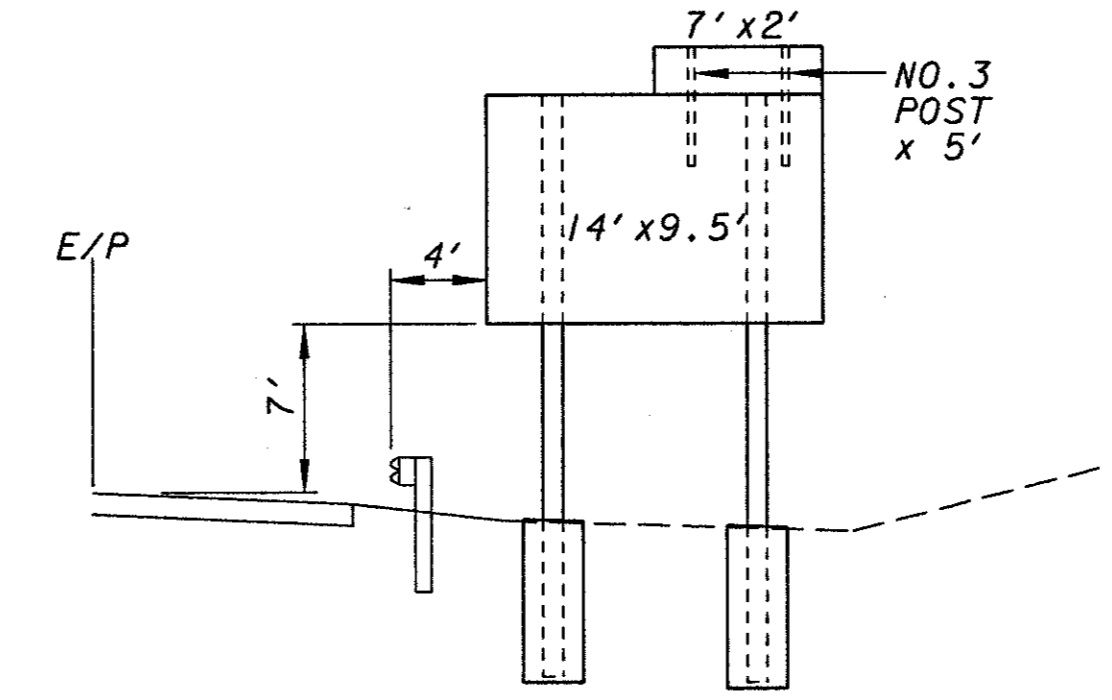


STA.459+85 I-70 E.B. RIGHT
W10x22
SUPPORTS: (2) 24.3' & 24.6'
SPACING: 1.75', 8.5', 1.75'
FOUNDATIONS: (2) 2.5'x6.75'

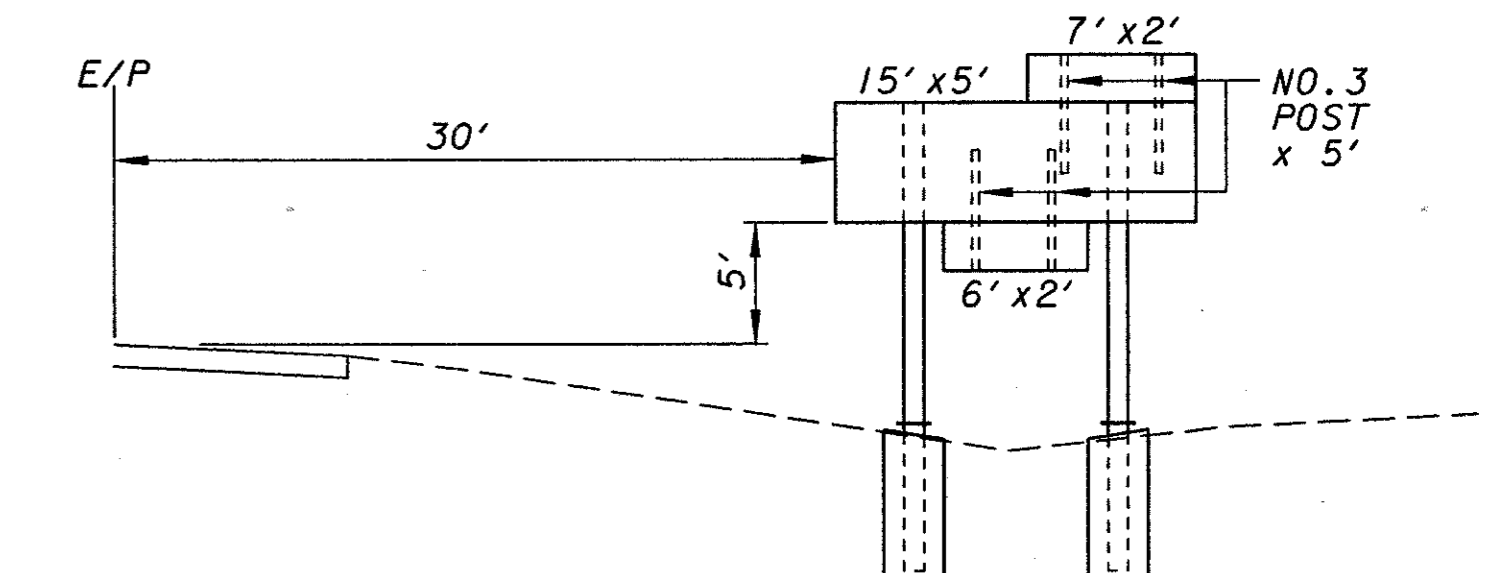


STA.481+00 I-70 E.B. RIGHT

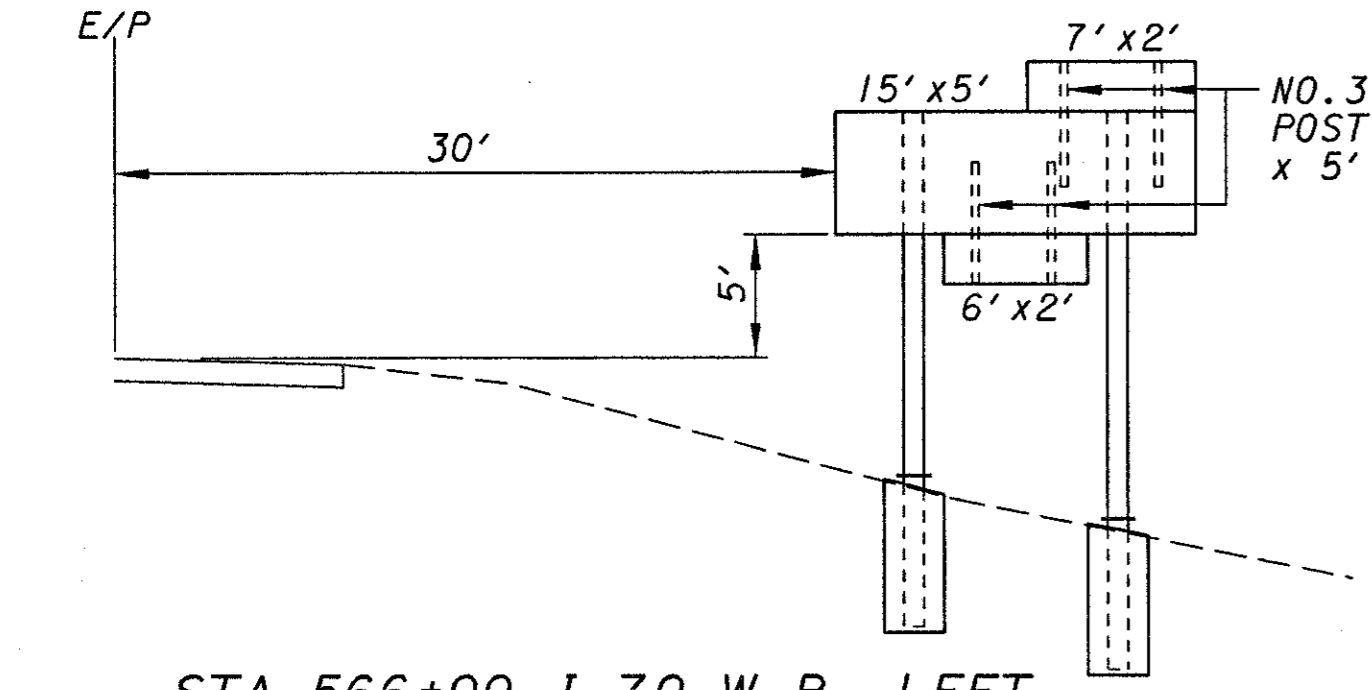


STA.566+00 I-70 W.B. LEFT
W8x18 WITH BREAKAWAY CONNECTION
SUPPORTS: (2) 21.1' & 22.9'
SPACING: 3.25', 8.5', 3.25'
FOUNDATIONS: (2) 2.5'x6'

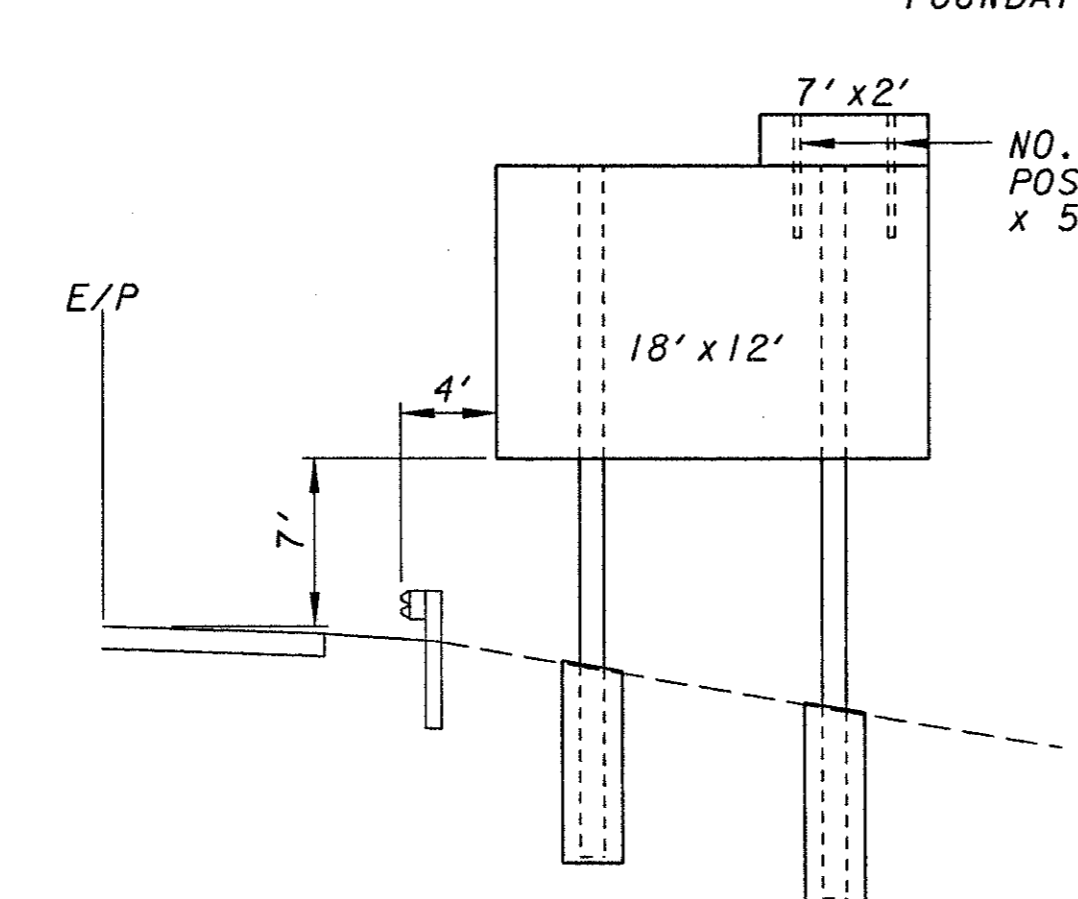


STA.711+75 I-70 E.B. RIGHT
W12x30
SUPPORTS: (2) 28.7' & 30.4'
SPACING: 3.96', 10.08', 3.96'
FOUNDATIONS: (2) 2.5'x8.25'

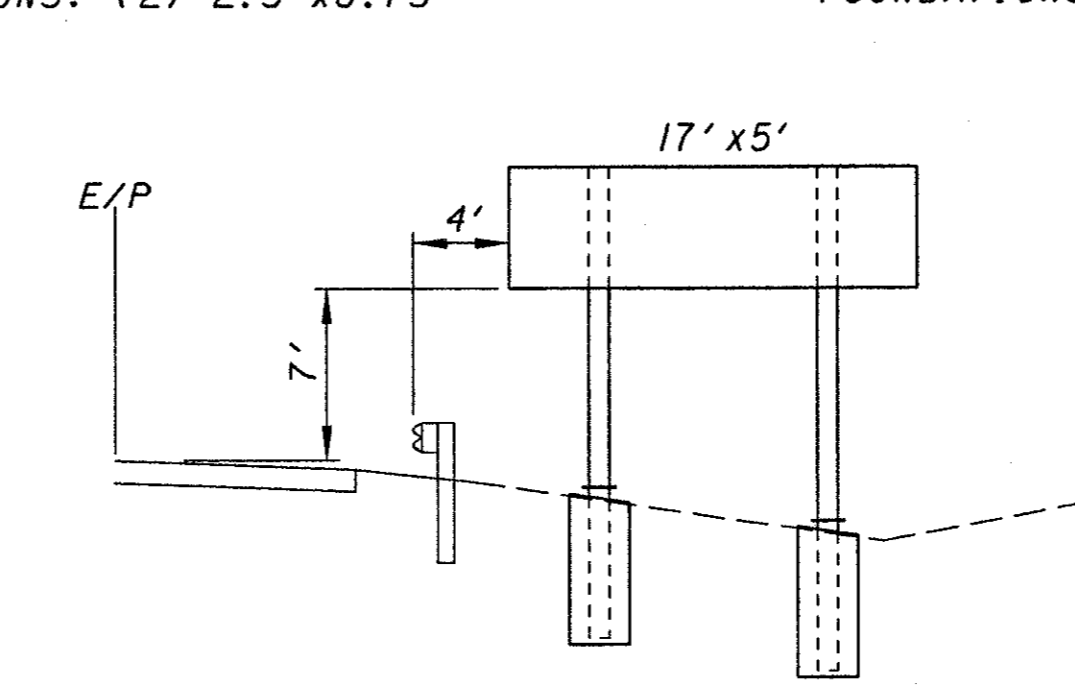


STA.723+00 I-70 W.B. LEFT
W10x12
SUPPORTS: (2) 19.4' & 20.8'
SPACING: 3.74', 9.52', 3.74'
FOUNDATIONS: (2) 2.5'x6'

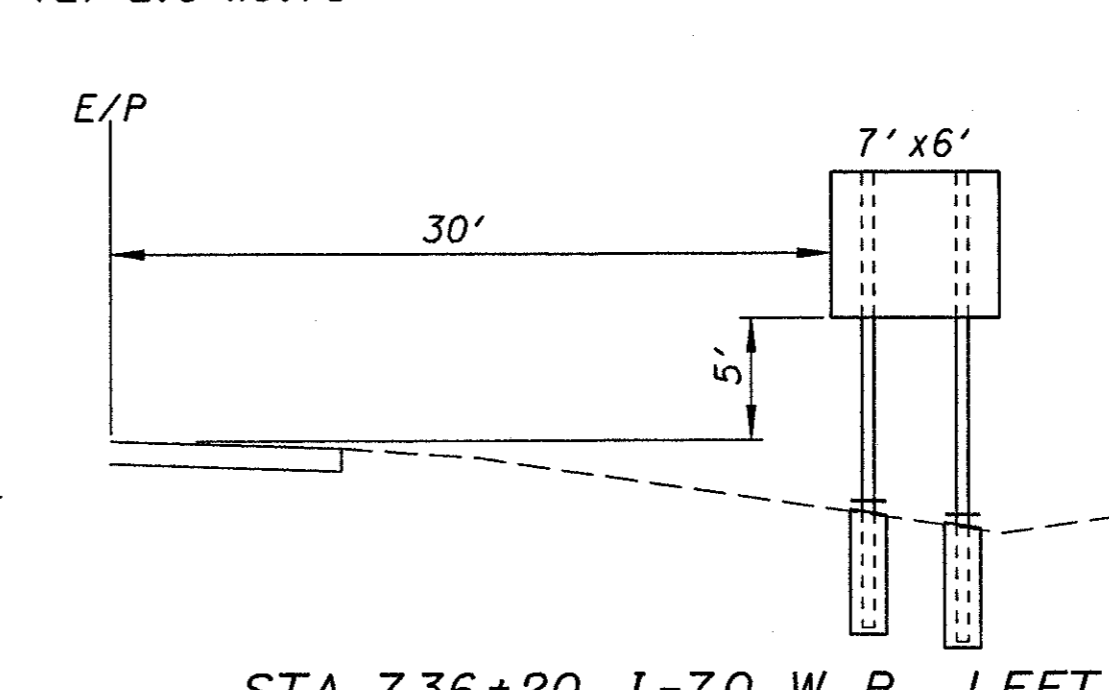


STA.736+20 I-70 W.B. LEFT
W6x9 WITH BREAKAWAY CONNECTION
SUPPORTS: (2) 18.8' & 19.4'
SPACING: 1.54', 3.92', 1.54'
FOUNDATIONS: (2) 1.5'x5'

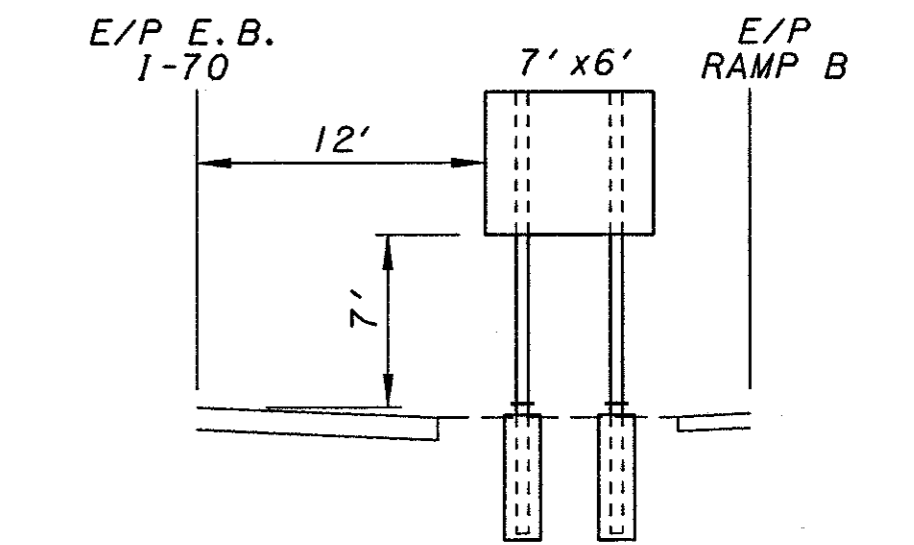


STA.772+50 I-70 E.B. RIGHT
W6x9 WITH BREAKAWAY CONNECTION
SUPPORTS: (2) @ 18.2'
SPACING: 1.54', 3.92', 1.54'
FOUNDATIONS: (2) 1.5'x5'

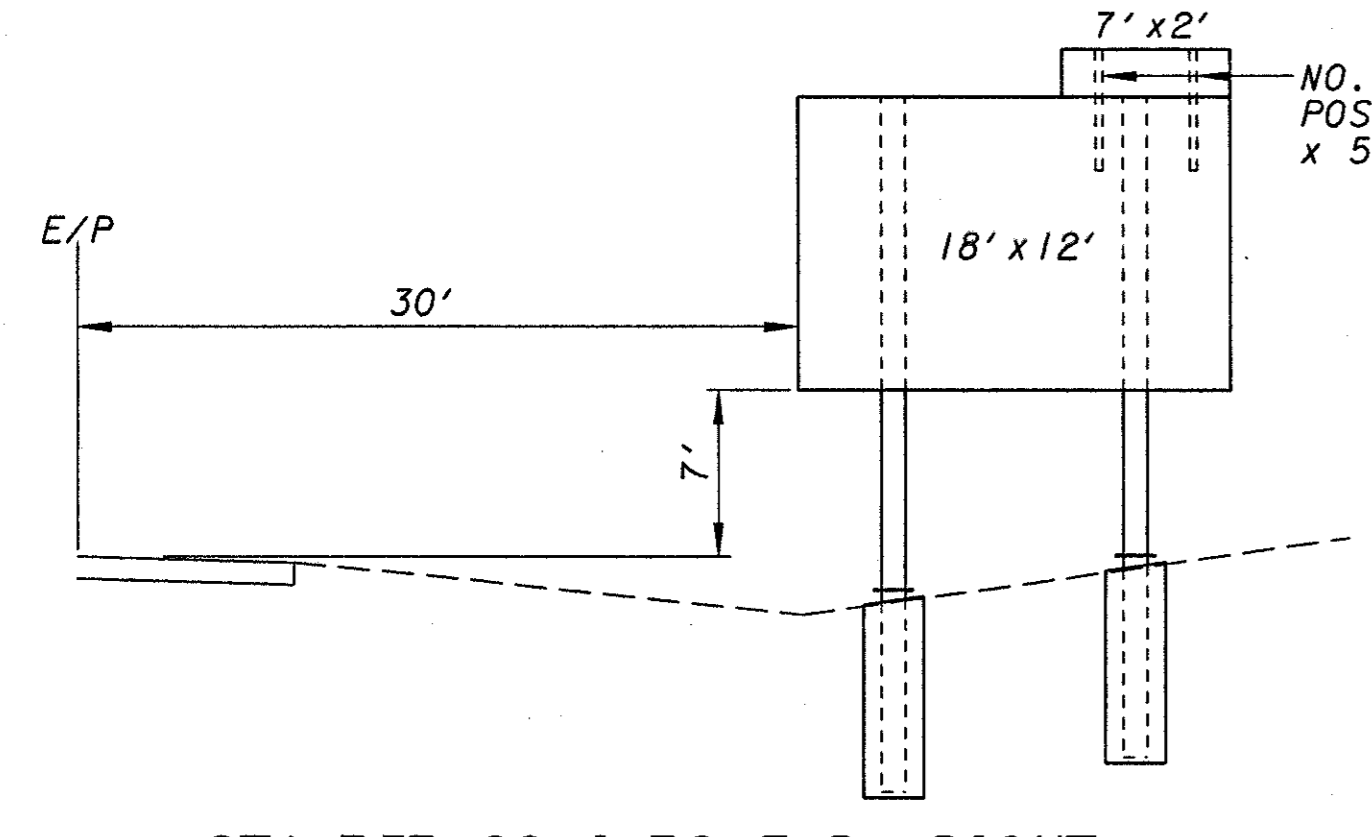


STA.737+00 I-70 E.B. RIGHT
W12x30 WITH BREAKAWAY CONNECTION
SUPPORTS: (2) 28.9' & 27.5'
SPACING: 3.96', 10.08', 3.96'
FOUNDATIONS: (2) 2.5'x8.25'

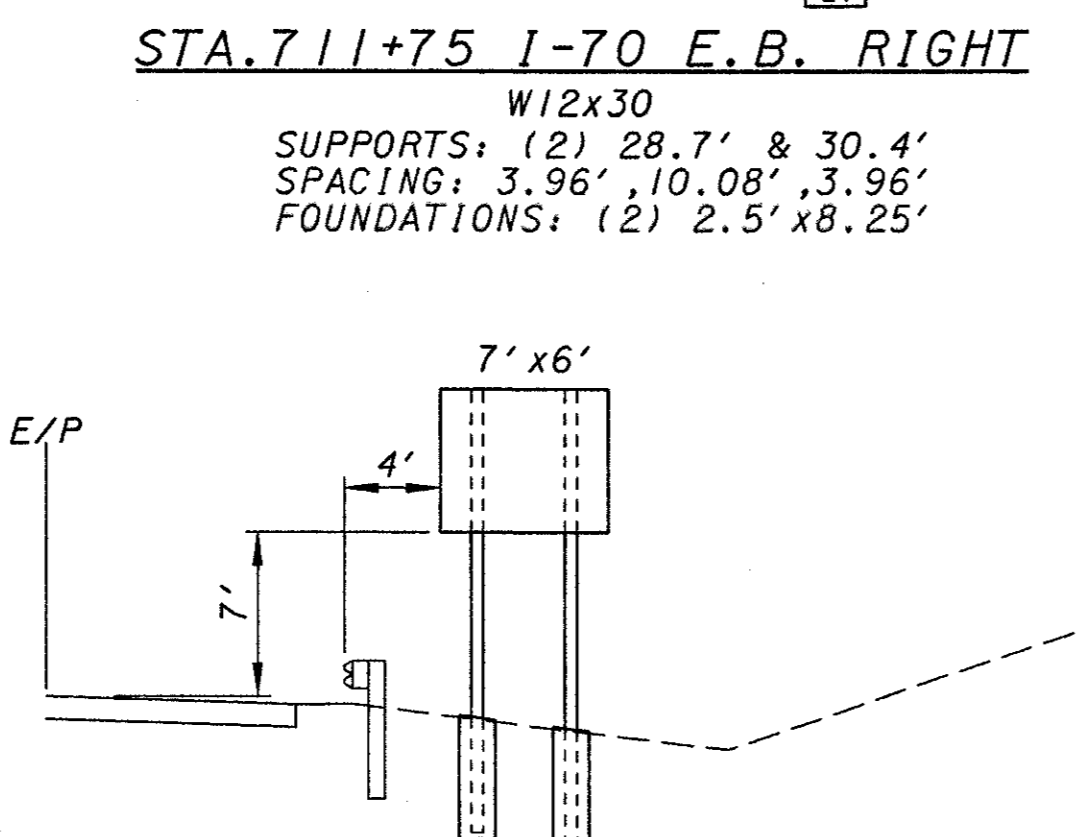


STA.820+50 I-70 E.B. RIGHT
W6x9
SUPPORTS: (2) 18.7' & 19.2'
SPACING: 1.54', 3.92', 1.54'
FOUNDATIONS: (2) 1.5'x5'

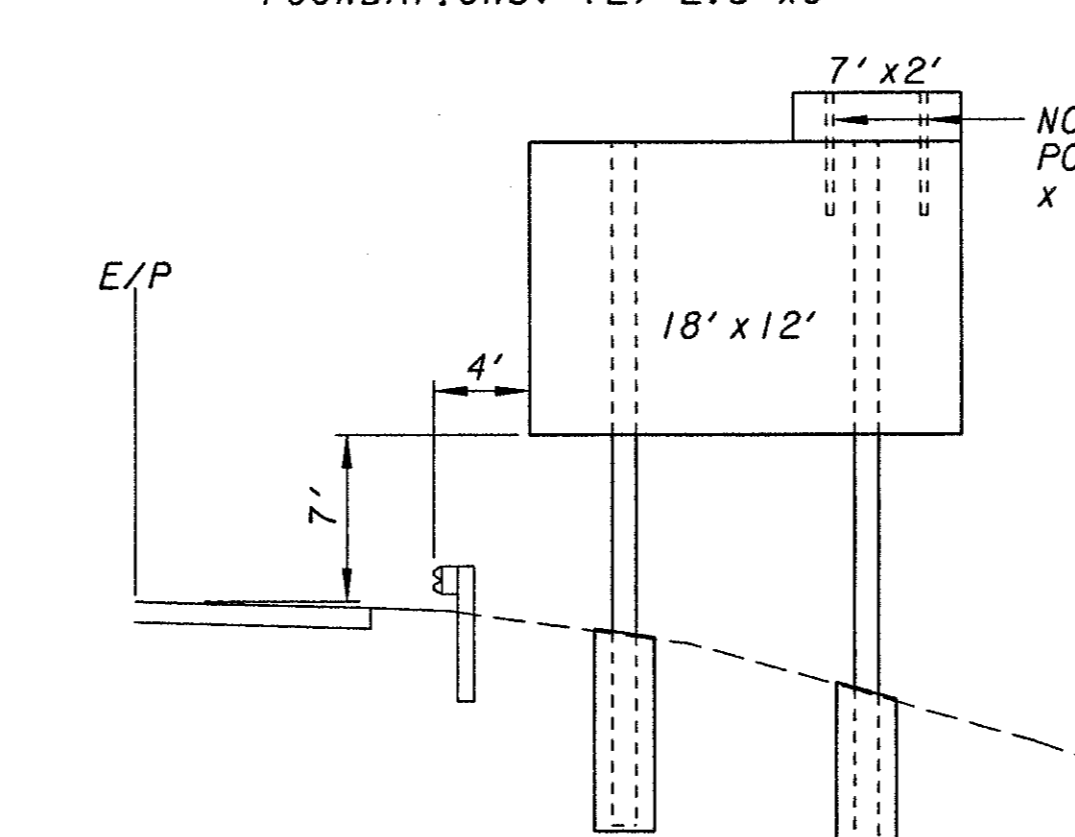


STA.802+60 I-70 W.B. LEFT
W12x30
SUPPORTS: (2) 28.5' & 30.9'
SPACING: 3.96', 10.08', 3.96'
FOUNDATIONS: (2) 2.5'x8.25'

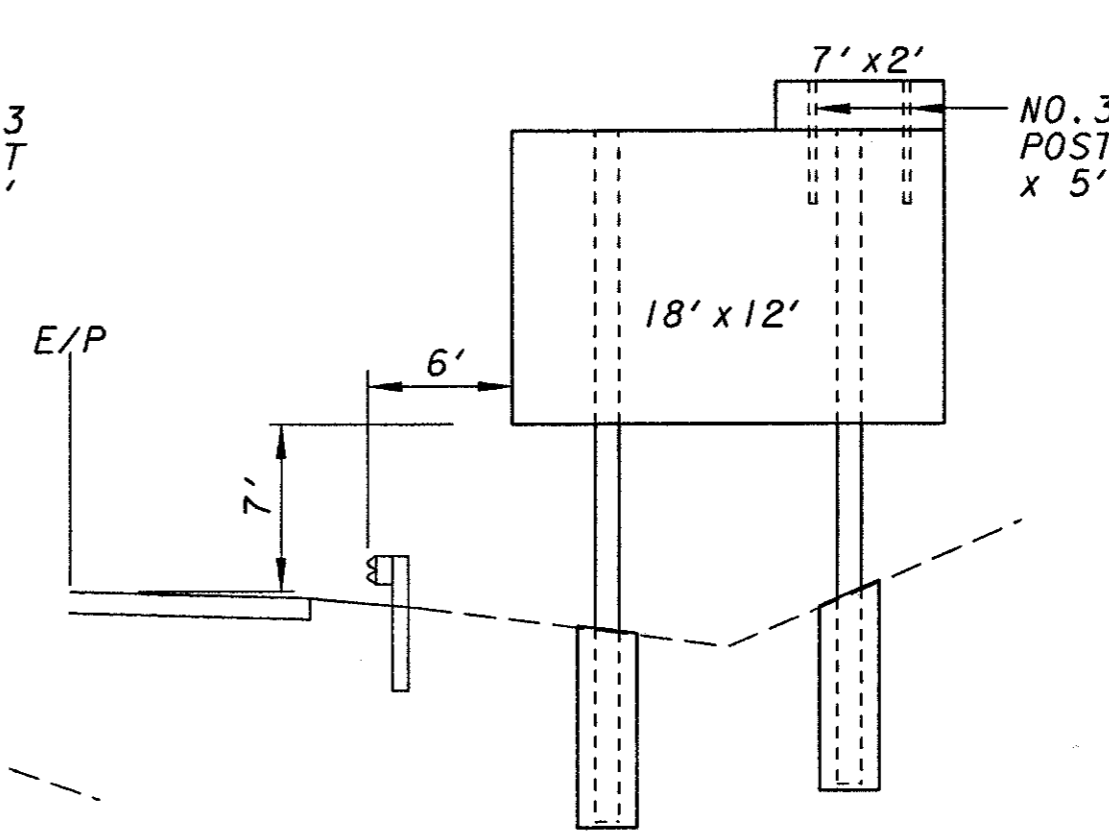


STA.821+25 I-70 W.B. LEFT
W12x30
SUPPORTS: (2) 28.8' & 27.2'
SPACING: 3.96', 10.08', 3.96'
FOUNDATIONS: (2) 2.5'x8.25'

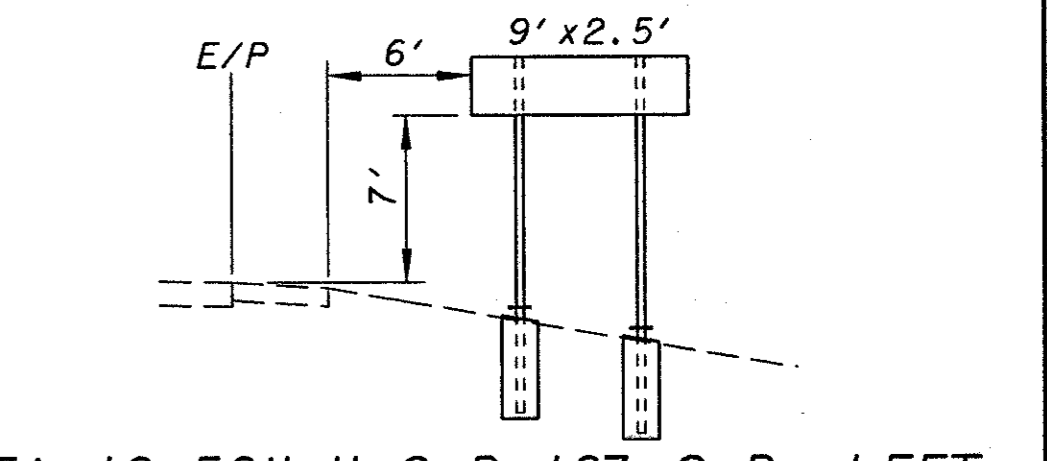


STA.12+52N U.S.R. 127 S.B. LEFT
STA.4+34S U.S.R. 127 N.B. RIGHT,
STA.11+93S U.S.R. 127 N.B. RIGHT,
AND STA.44+40 S.R.503 S.B. LEFT
SIMILAR
S4x7.7 WITH BREAKAWAY CONNECTION
SUPPORTS: (2) 14.8' & 15.7'
SPACING: 1.98', 5.04', 1.98'
FOUNDATIONS: (2) 1.5'x4'

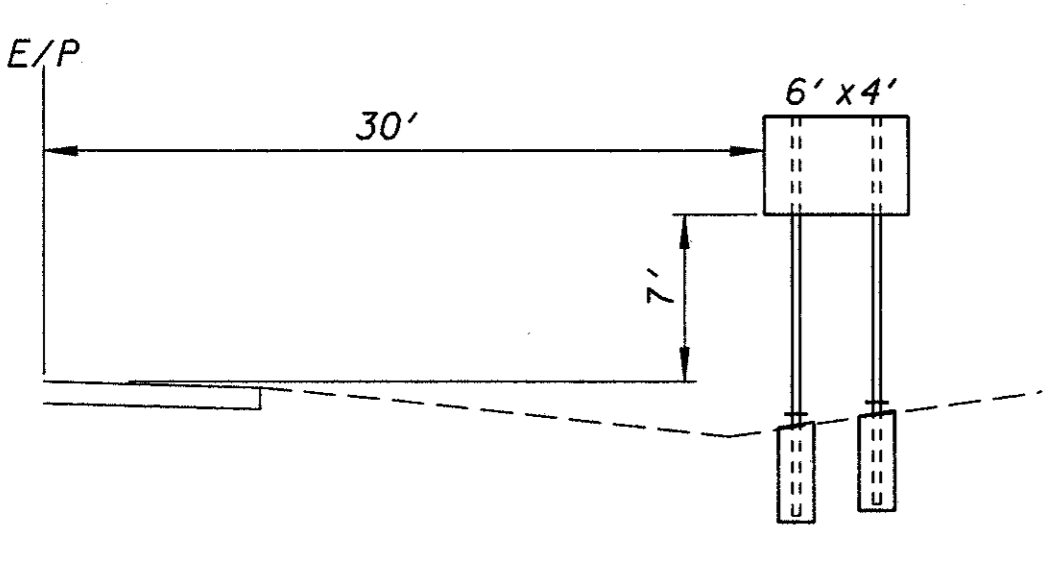


STA.880+00 I-70 W.B. LEFT
S4x7.7 WITH BREAKAWAY CONNECTION
SUPPORTS: (2) 16.6' & 16.2'
SPACING: 1.32', 3.36', 1.32'
FOUNDATIONS: (2) 1.5'x4'

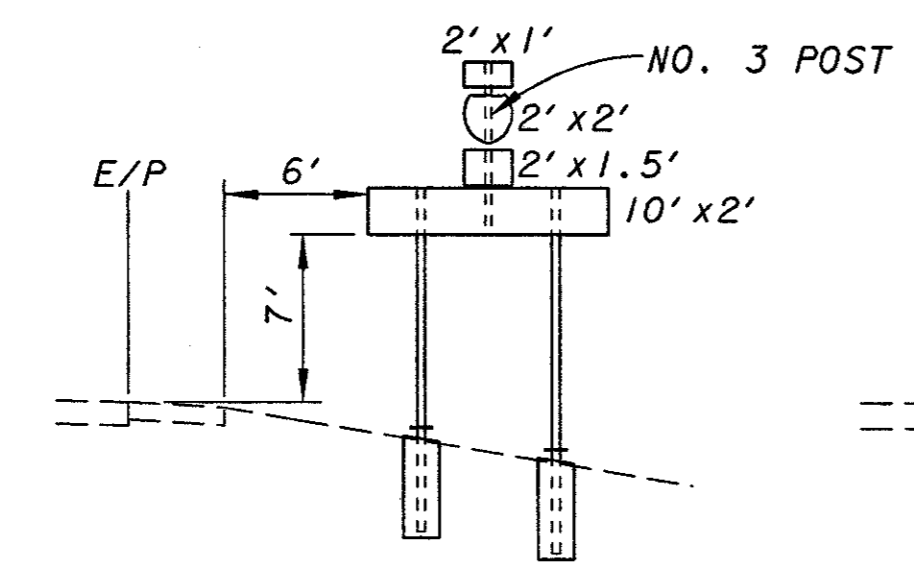


STA.45+40 S.R.503 N.B. RIGHT
STA.34+65 S.R.503 S.B. LEFT - SIMILAR
S4x7.7 WITH BREAKAWAY CONNECTION
SUPPORTS: (2) 14.4' & 15.3'
SPACING: 2.2', 5.6', 2.2'
FOUNDATIONS: (2) 1.5'x4'

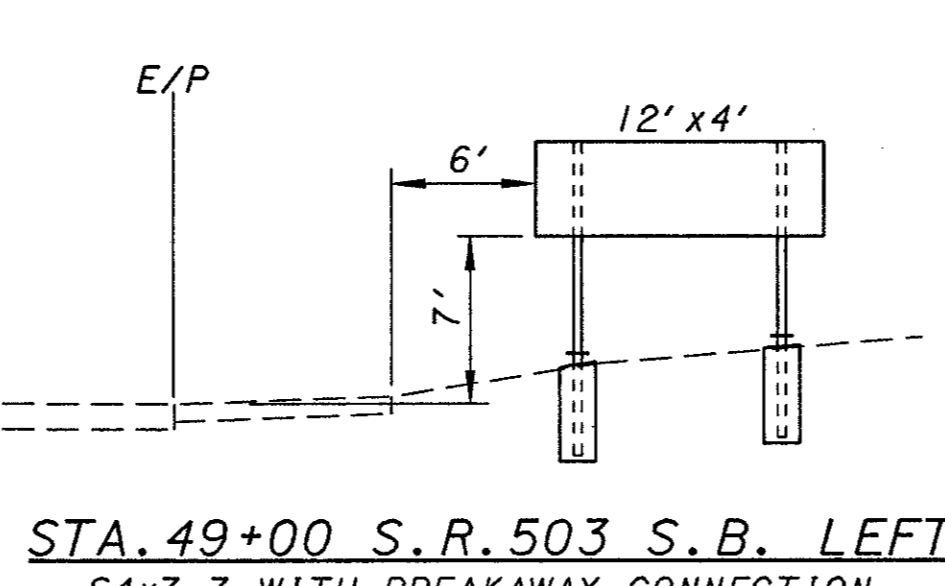

STA.49+00 S.R.503 S.B. LEFT
S4x7.7 WITH BREAKAWAY CONNECTION
SUPPORTS: (2) 13.2' & 12.4'
SPACING: 1.75', 8.5', 1.75'
FOUNDATIONS: (2) 1.5'x4'

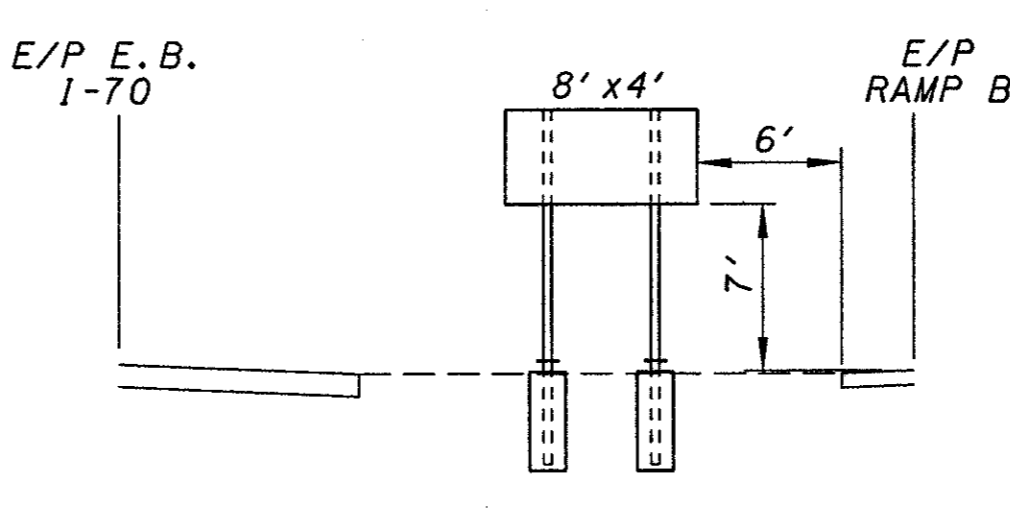


STA.13+50 RAMP B LEFT (S.R. 503)
S4x7.7 WITH BREAKAWAY CONNECTION
SUPPORTS: (2) @ 15'
SPACING: 1.76', 4.48', 1.76'
FOUNDATIONS: (2) 1.5'x4'

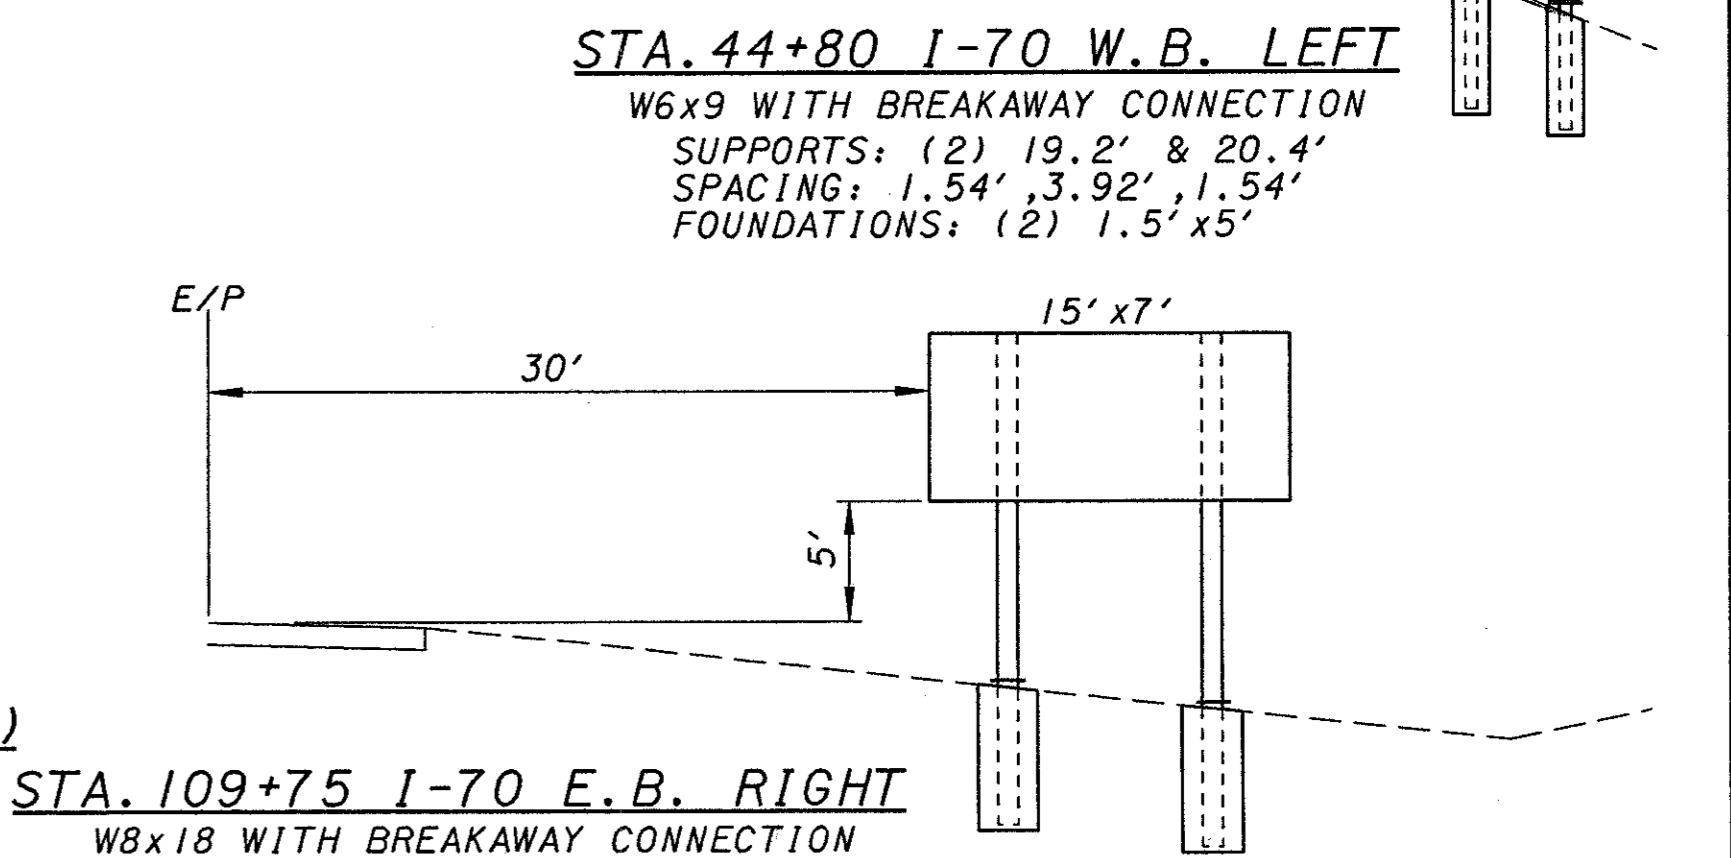


STA.109+75 I-70 E.B. RIGHT
W8x18 WITH BREAKAWAY CONNECTION
SUPPORTS: (2) 22' & 23.5'
SPACING: 3.25', 8.5', 3.25'
FOUNDATIONS: (2) 2.5'x6'

DESIGNED BY: REF. 102
CHECKED BY: REF. 102
DATE: 10/20/00
ACTIVE ELEVATIONS: 127

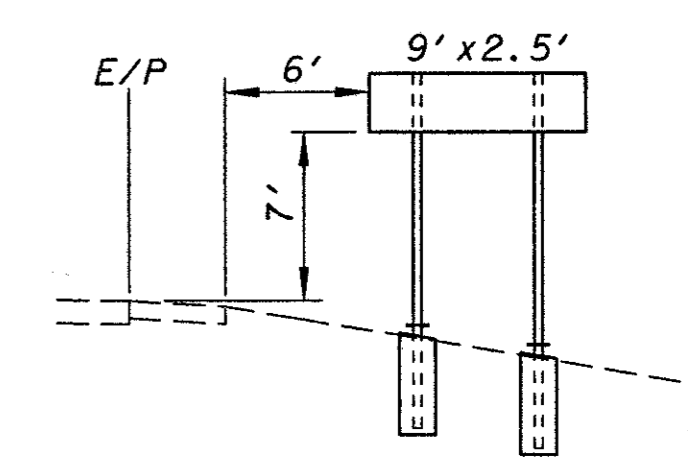

STA. 4+45N U.S.R. 127 N.B. LEFT

S4x7.7 WITH BREAKAWAY CONNECTION
 SUPPORTS: (2) 14.8' & 15.7'
 SPACING: 1.98', 5.04', 1.98'
 FOUNDATIONS: (2) 1.5'x4'


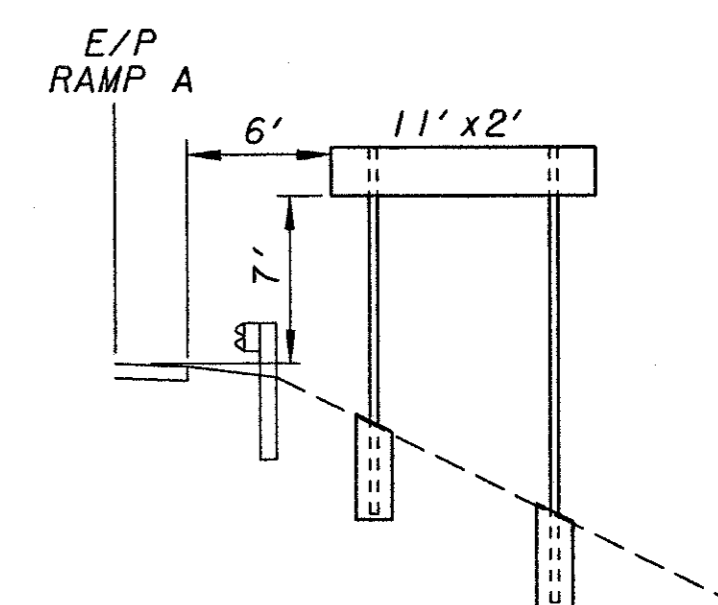


STA. 12+12 RAMP A RIGHT (U.S.R. 127)

S4x7.7
 SUPPORTS: (2) 15.3' & 19.0'
 SPACING: 1.75', 7.5', 1.75'
 FOUNDATIONS: (2) 1.5'x4'

SIGN ELEVATION

PRE-70-0.00

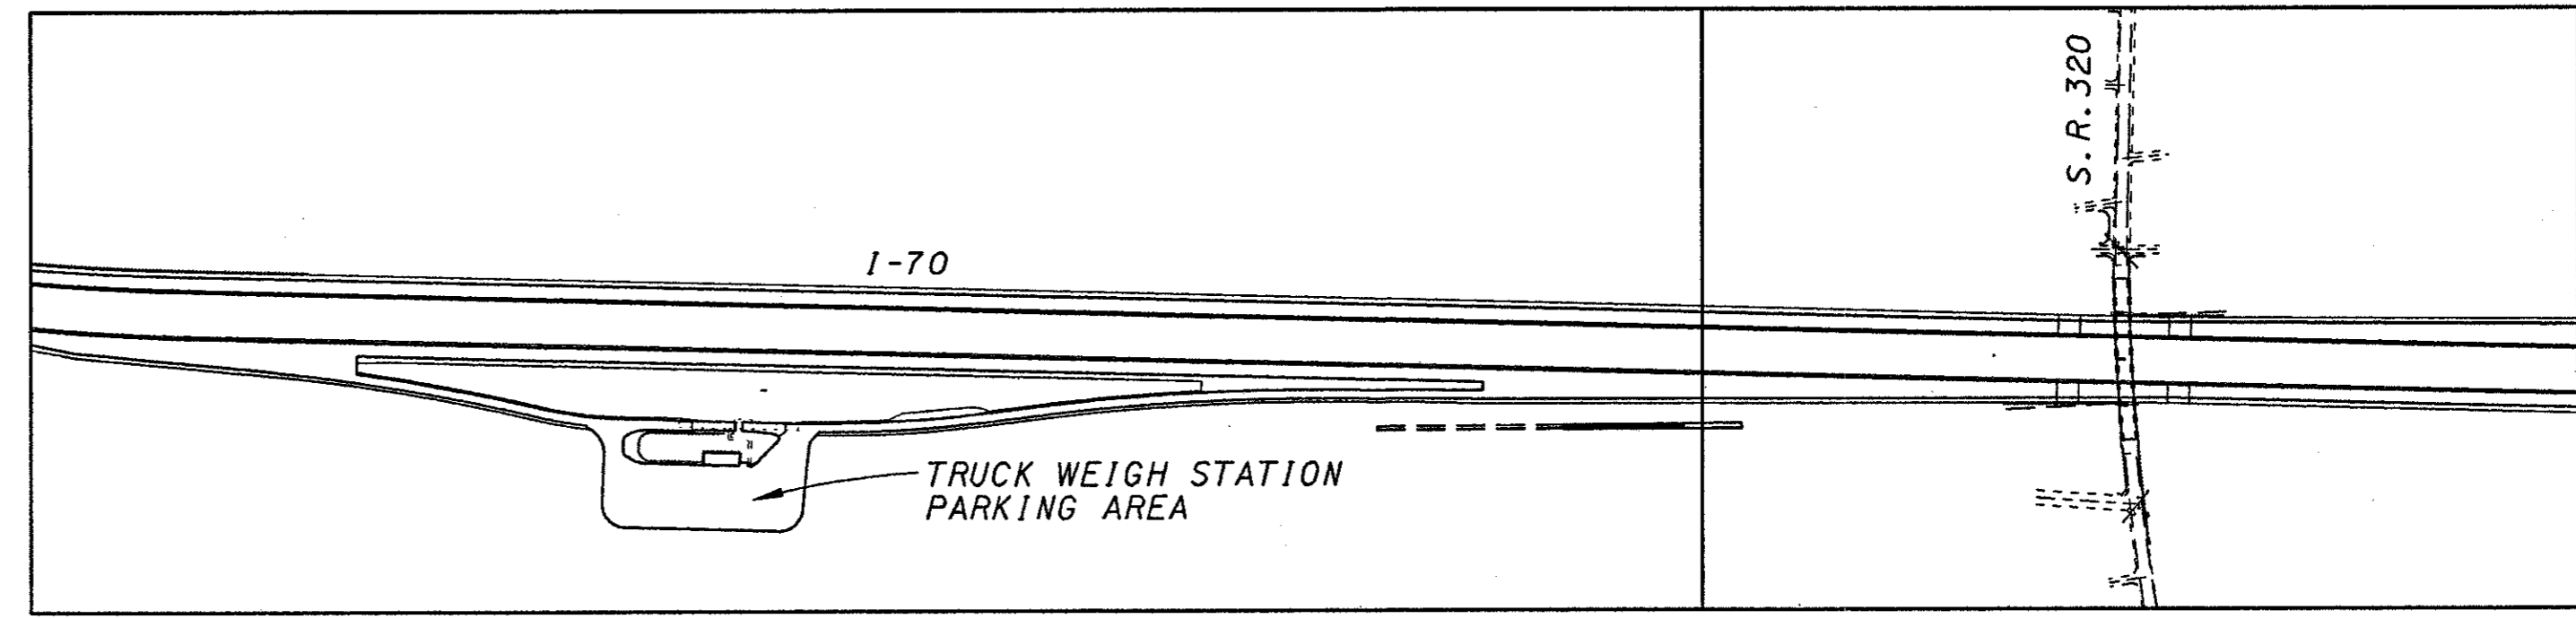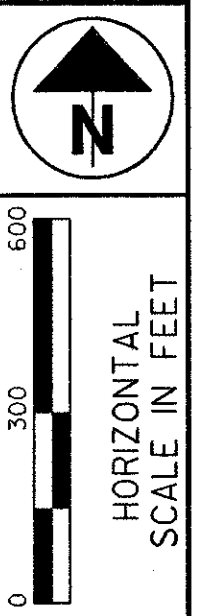

LEGEND

- LIGHT POLE, 200 WATT HPS (HIGH PRESSURE SODIUM)
41.7' MOUNTING HEIGHT, 18' ARM, STYLE B LUMINAIRE,
TYPE II.
- LIGHT POLE, 400 WATT HPS (HIGH PRESSURE SODIUM)
50' MOUNTING HEIGHT, 15' ARM, STYLE B LUMINAIRE,
TYPE III.
- LOW MAST LIGHT POLE, 51.7' MOUNTING HEIGHT WITH
(1) 400 WATT HPS SYMMETRIC LUMINAIRE, TYPE V.
- EXISTING WOOD POLE AND LUMINAIRE TO BE REMOVED.
- PROPOSED PULL BOX
- CONDUIT STUBBED AND CAPPED
- PROPOSED CIRCUIT - DUCT CABLE
- PROPOSED CIRCUIT - DUCT CABLE IN CONDUIT

INDEX OF SHEETS

LIGHTING INDEX SHEET----- 129
GENERAL NOTES----- 130
PLAN SHEETS----- 131-132
LIGHTING DETAILS----- 133

STATION	OFFSET FROM PAVEMENT EDGE	CIRCUIT - POLE NUMBER	POLE NUMBER
WATTAGE OF LUMINAIRE	MOUNTING HEIGHT	BRACKET ARM LENGTH	TYPE OF LUMINAIRE

TYPICAL POLE IDENTIFICATION

DATE: 12/15/94
DRAWN: L. JONES
CHECKED: M. JONES
ACTIVE LEVELS: 100, 101, 102, 103, 104

POWER SERVICE, AS PER PLAN

POWER SERVICE EQUIPMENT SHALL BE INSTALLED AS SPECIFIED IN THE ODOT CONSTRUCTION AND MATERIAL SPECIFICATIONS AND AS SHOWN ON SHEET 5 EXCEPT THAT THE EQUIPMENT WILL BE MOUNTED TO THE INSIDE WALL OF THE WEIGH STATION RATHER THAN A SERVICE POLE.

7.13.11 LUMINAIRES

IN ADDITION TO THE REQUIREMENTS OF THE DEPARTMENT'S CONSTRUCTION AND MATERIAL SPECIFICATIONS, LUMINAIRES SHALL BE AS FOLLOWS:

STYLE B LUMINAIRES SHALL HAVE SINGLE RATED 240 VOLT, 200 WATT OR 400 WATT, INTEGRAL REGULATOR BALLASTS FOR USE WITH HIGH PRESSURE SODIUM LAMPS AND SHALL BE GENERAL ELECTRIC M400, CROUSE-HINDS OVM, AMERICAN 25/26, OR EQUAL APPROVED BY THE ENGINEER.

LOW MAST, SYMMETRIC DISTRIBUTION, 400 WATT HIGH PRESSURE SODIUM, 240 VOLT SHALL BE COOPER HMX, GENERAL ELECTRIC HMA, HOLOPHANE HMST, OR EQUAL AS APPROVED BY THE ENGINEER.

7.13.14 LAMPS

HIGH PRESSURE SODIUM LAMPS SHALL BE GENERAL ELECTRIC "LUCALOX," WESTINGHOUSE "CERAMALUX," SYLVANIA "LUMALUX," OR EQUAL APPROVED BY THE ENGINEER.

UNDERDRAINS FOR PULL BOXES

REFERENCE IS MADE TO STANDARD DRAWING HL-30.11M FOR DETAILS OF DRAINING PULL BOXES. UNDERDRAINS FOR PULL BOXES SHALL BE USED AS DIRECTED BY THE ENGINEER AND SHALL BE PROVIDED WHERE THE LENGTH REQUIRED FOR A SATISFACTORY OUTLET DOES NOT EXCEED APPROXIMATELY 20 FEET.


ADDITIONAL ITEMS

THE FOLLOWING ITEMS, ALTHOUGH NOT SPECIFICALLY SHOWN IN THE PLANS AND DETAILS, SHALL BE PROVIDED BY THE CONTRACTOR TO SATISFY ANY AND ALL REQUIREMENTS NECESSARY FOR COMPLETE AND SATISFACTORY INSTALLATION OF THE PROJECT LIGHTING. PROVISION AND INSTALLATION SHALL BE ACCORDING TO THE STATE OF OHIO DEPARTMENT OF TRANSPORTATION CONSTRUCTION AND MATERIAL SPECIFICATION AND THE ODOT STANDARD DRAWINGS:

- HIGH VOLTAGE TEST
- LIGHT POLE FOUNDATIONS
- 24" DEEP TRENCH
- NO. 10 AWG POLE AND BRACKET CABLE
- GROUND RODS
- CONNECTOR KITS
- CABLE SPLICING KITS

REF: REF01
REF: REF02
REF: REF03
REF: REF04
REF: REF05

DATE: 11/11/11
PROJECT: I-75/ST-7
ACTIVE LEVELS ON: 283

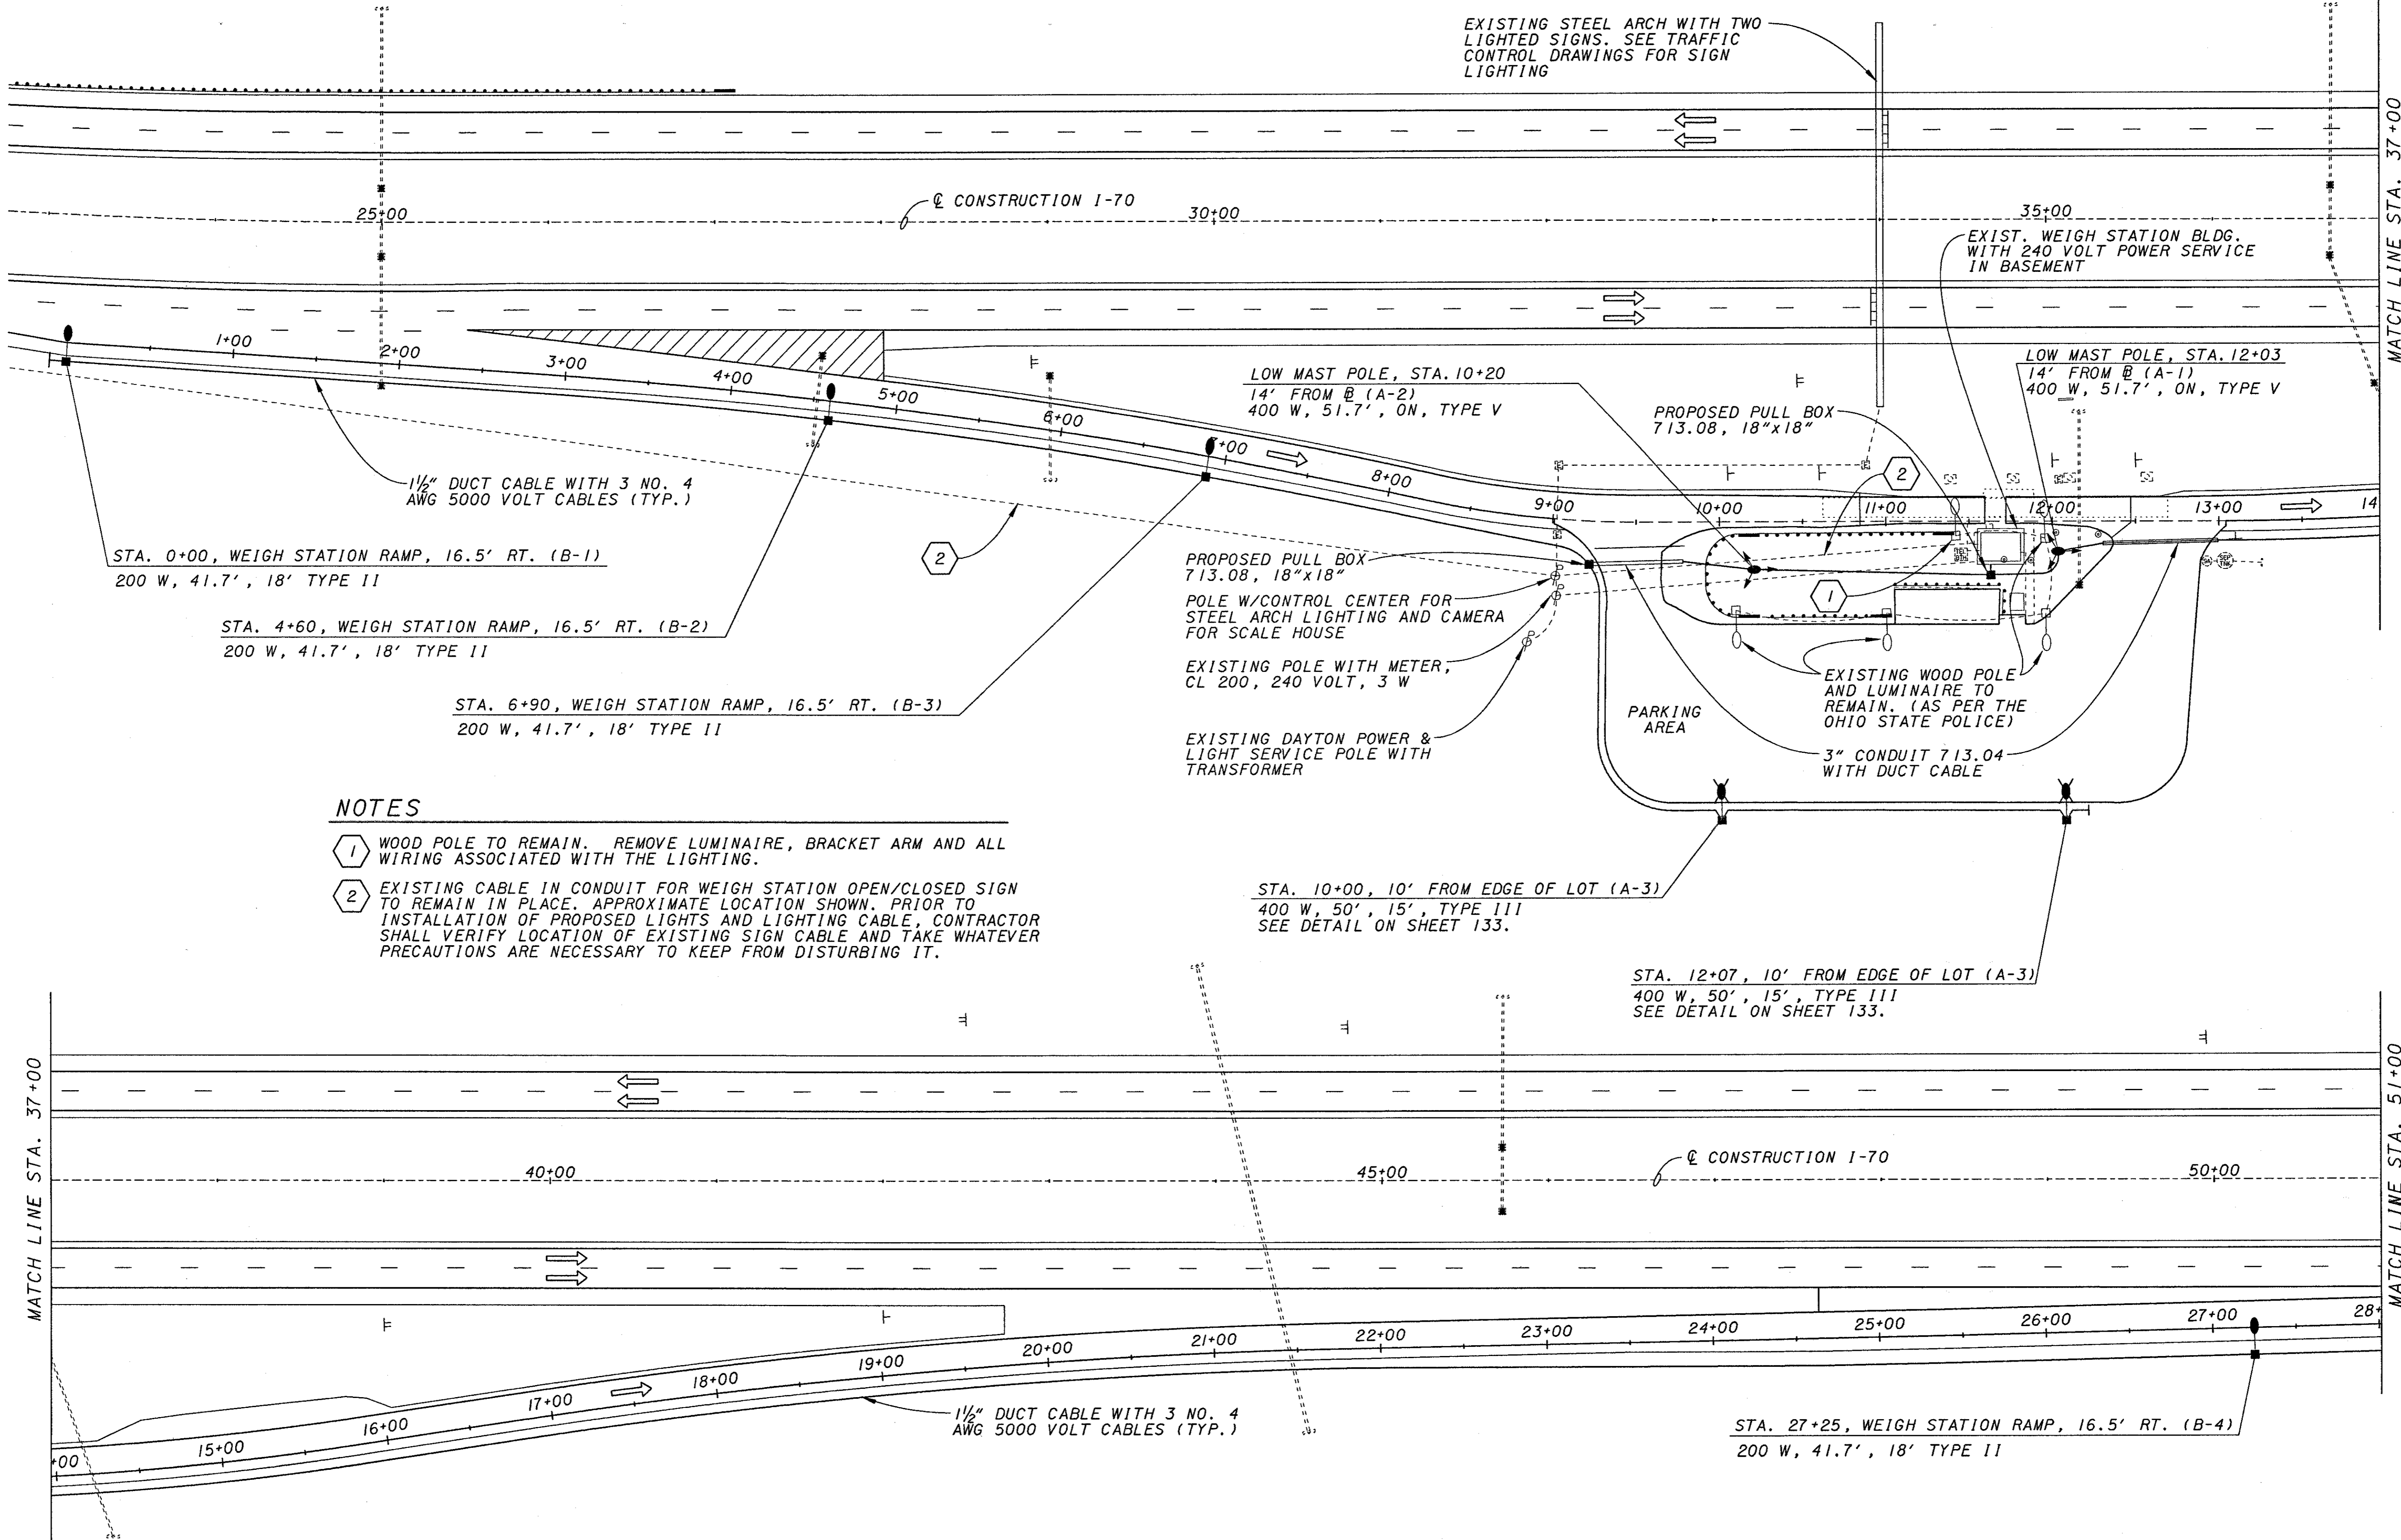

STA. 0+00, WEIGH STATION RAMP, 16.5' RT. (B-1)
200 W, 41.7', 18' TYPE II

STA. 4+60, WEIGH STATION RAMP, 16.5' RT. (B-2)
200 W, 41.7', 18' TYPE II

STA. 6+90, WEIGH STATION RAMP, 16.5' RT. (B-3)
200 W, 41.7', 18' TYPE II

STA. 27+25, WEIGH STATION RAMP, 16.5' RT. (B-4)
200 W, 41.7', 18' TYPE II

NOTES

- ① WOOD POLE TO REMAIN. REMOVE LUMINAIRE, BRACKET ARM AND ALL WIRING ASSOCIATED WITH THE LIGHTING.
- ② EXISTING CABLE IN CONDUIT FOR WEIGH STATION OPEN/CLOSED SIGN TO REMAIN IN PLACE. APPROXIMATE LOCATION SHOWN. PRIOR TO INSTALLATION OF PROPOSED LIGHTS AND LIGHTING CABLE, CONTRACTOR SHALL VERIFY LOCATION OF EXISTING SIGN CABLE AND TAKE WHATEVER PRECAUTIONS ARE NECESSARY TO KEEP FROM DISTURBING IT.

STA. 10+00, 10' FROM EDGE OF LOT (A-3)
400 W, 50', 15', TYPE III
SEE DETAIL ON SHEET 133.

STA. 12+07, 10' FROM EDGE OF LOT (A-3)
400 W, 50', 15', TYPE III
SEE DETAIL ON SHEET 133.


REF: 11-11-01
REF: 11-11-02
REF: 11-11-03
REF: 11-11-100

LIGHTING PLAN
STA. 24+00 TO STA. 51+00


PRE-70-0.00

DESIGNATION*****




REF. 1
REF. 2
REF. 3
REF. 4
REF. 5
REF. 6
REF. 7
REF. 8
REF. 9
REF. 10

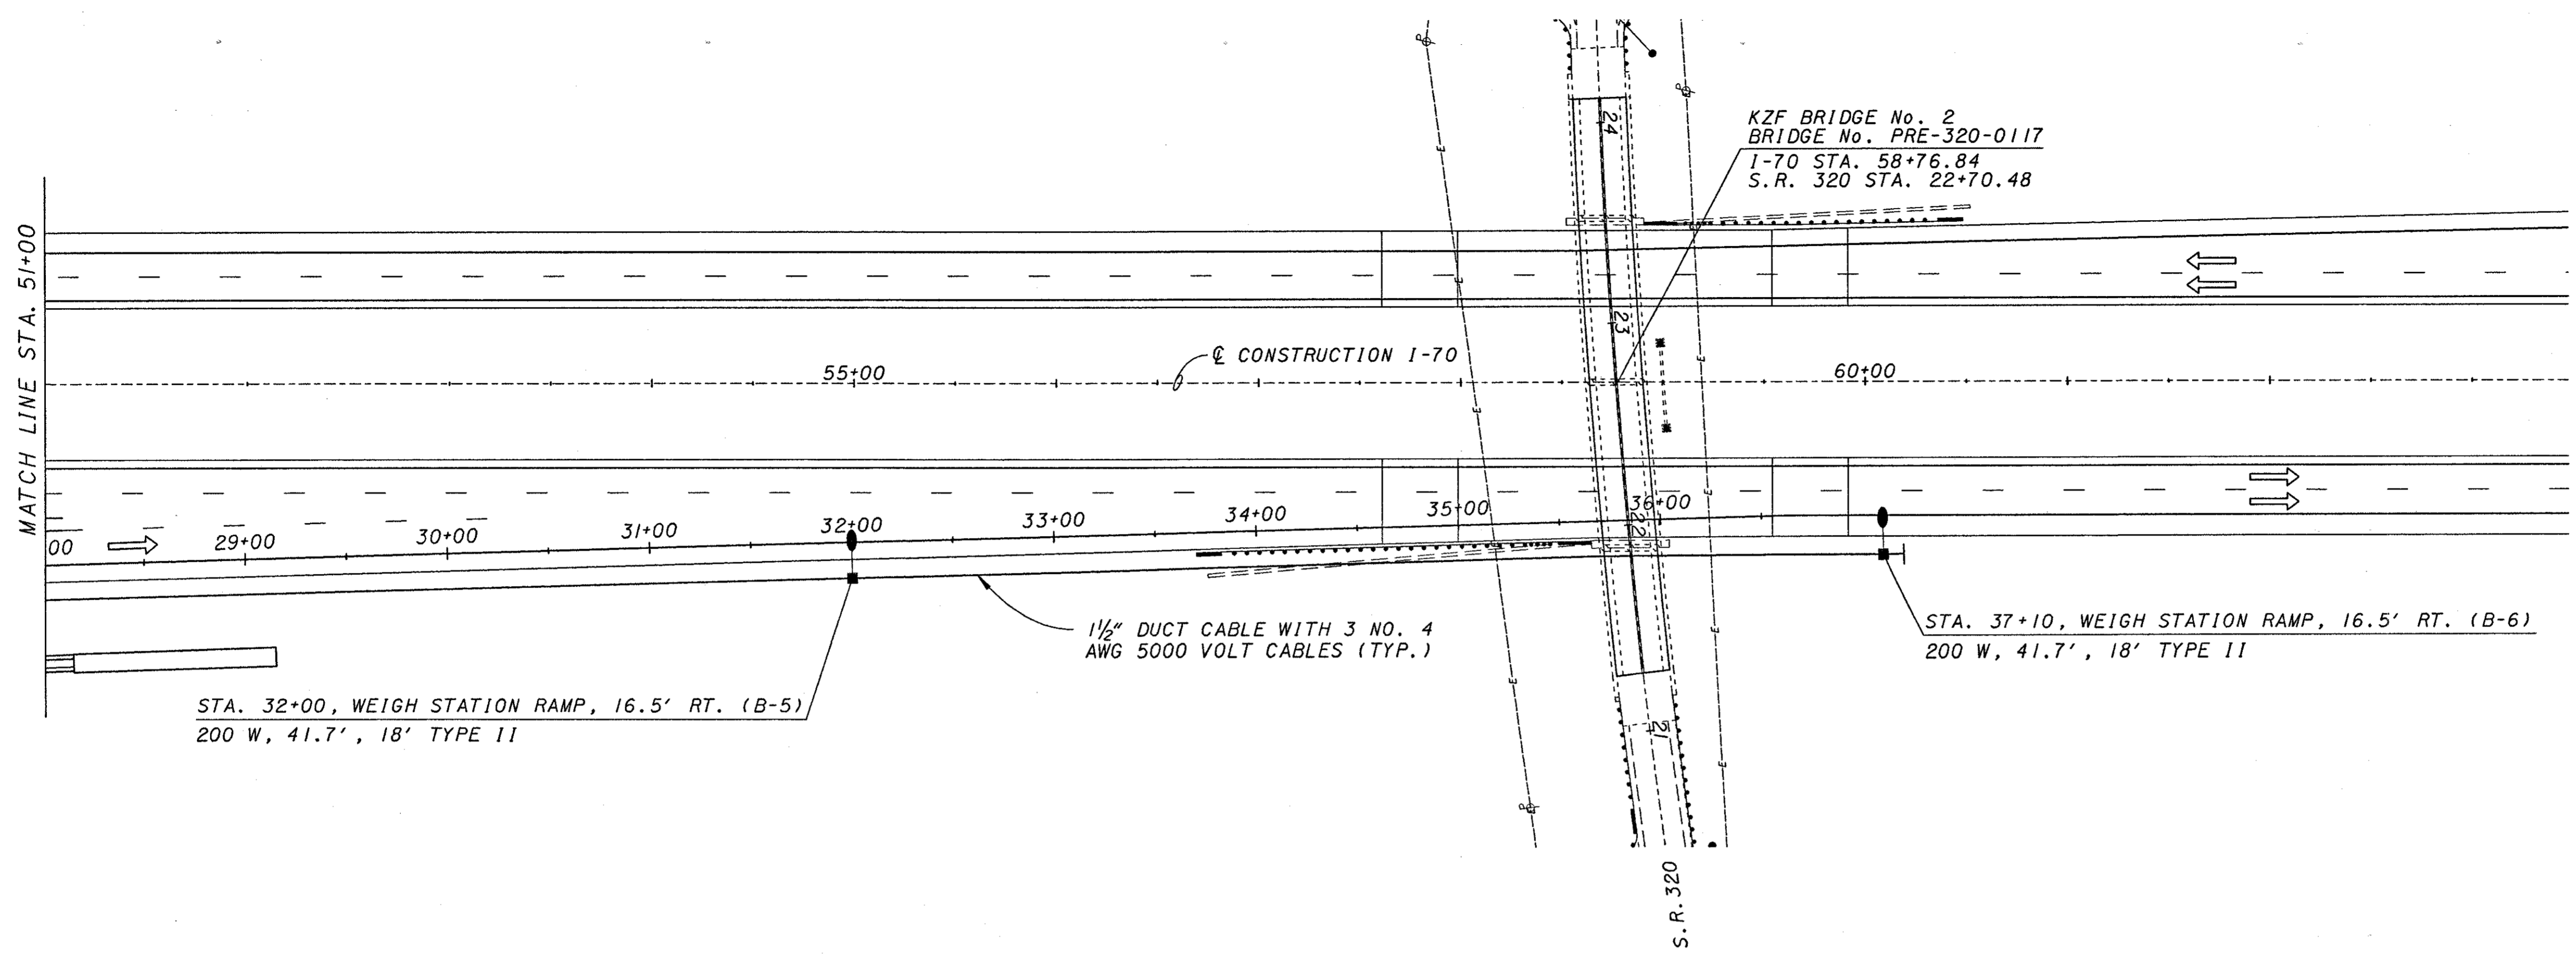


POWER SERVICE DATA									
CONTROL CENTER LOCATION	POWER SERVICE	CONNECTED LOAD (KVA)	SERVICE ENTRANCE CONDUCTOR SIZE	ENCLOSURE RATING (AMPS)	CIRCUIT NUMBER	CIRCUIT LOAD (AMPS)	CIRCUIT BREAKER SIZE	REMARKS	MAINTAINING AGENCY
WEIGH STATION BASEMENT	EXISTING 240 VOLT, 3 WIRE, GROUNDED NEUTRAL	2.8	NO. 4	CIRCUIT BREAKER ENCLOSURE	A	6.6	20A	A-1 THRU A-4	ODOT
					B	5	20A	B-1 THRU B-6	

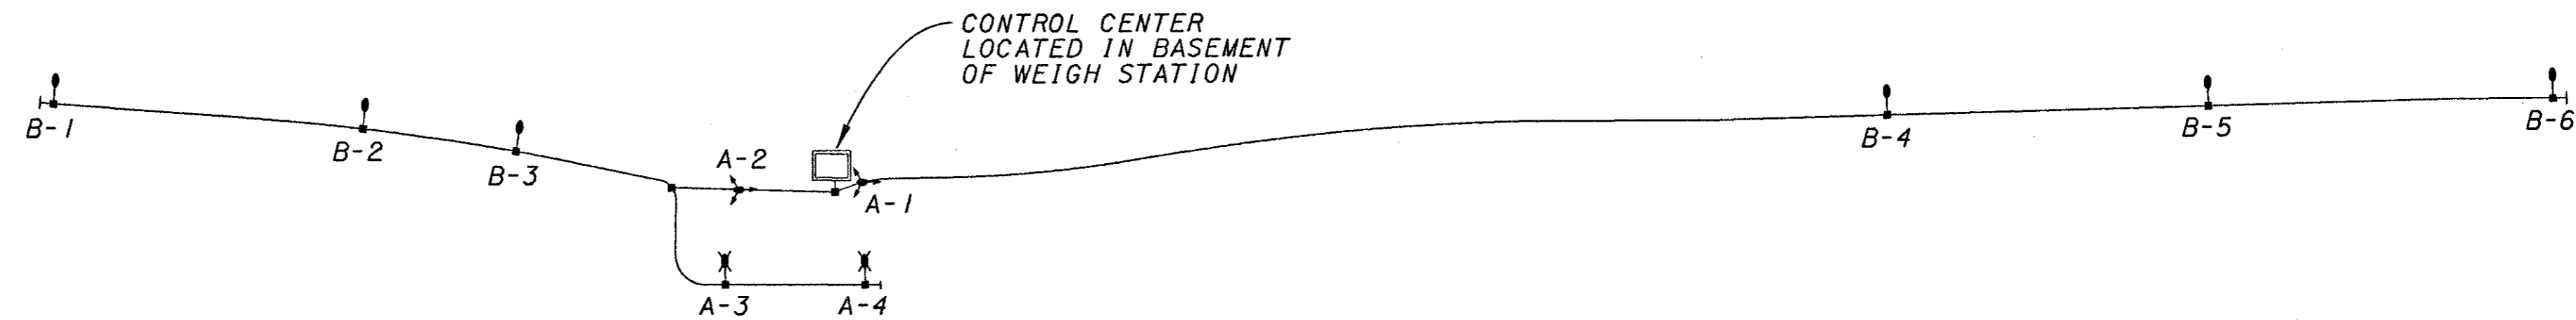




CIRCUIT DIAGRAM

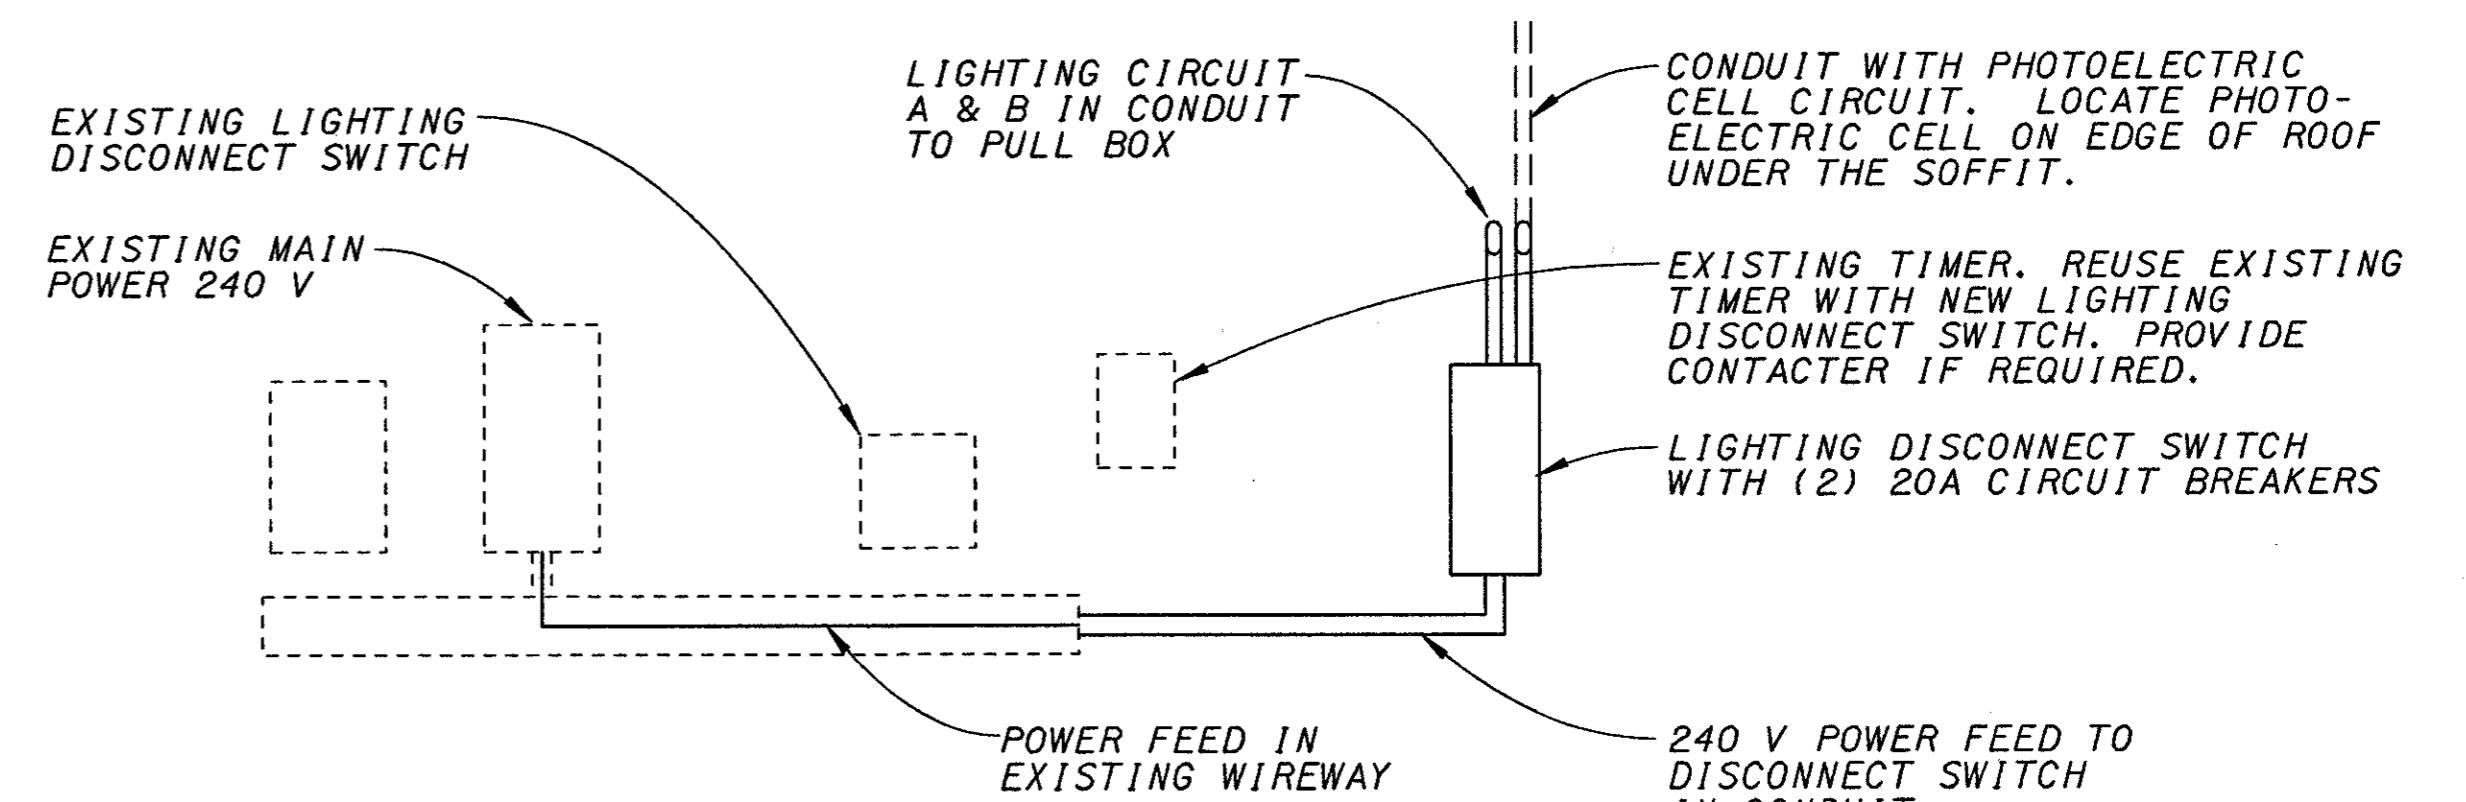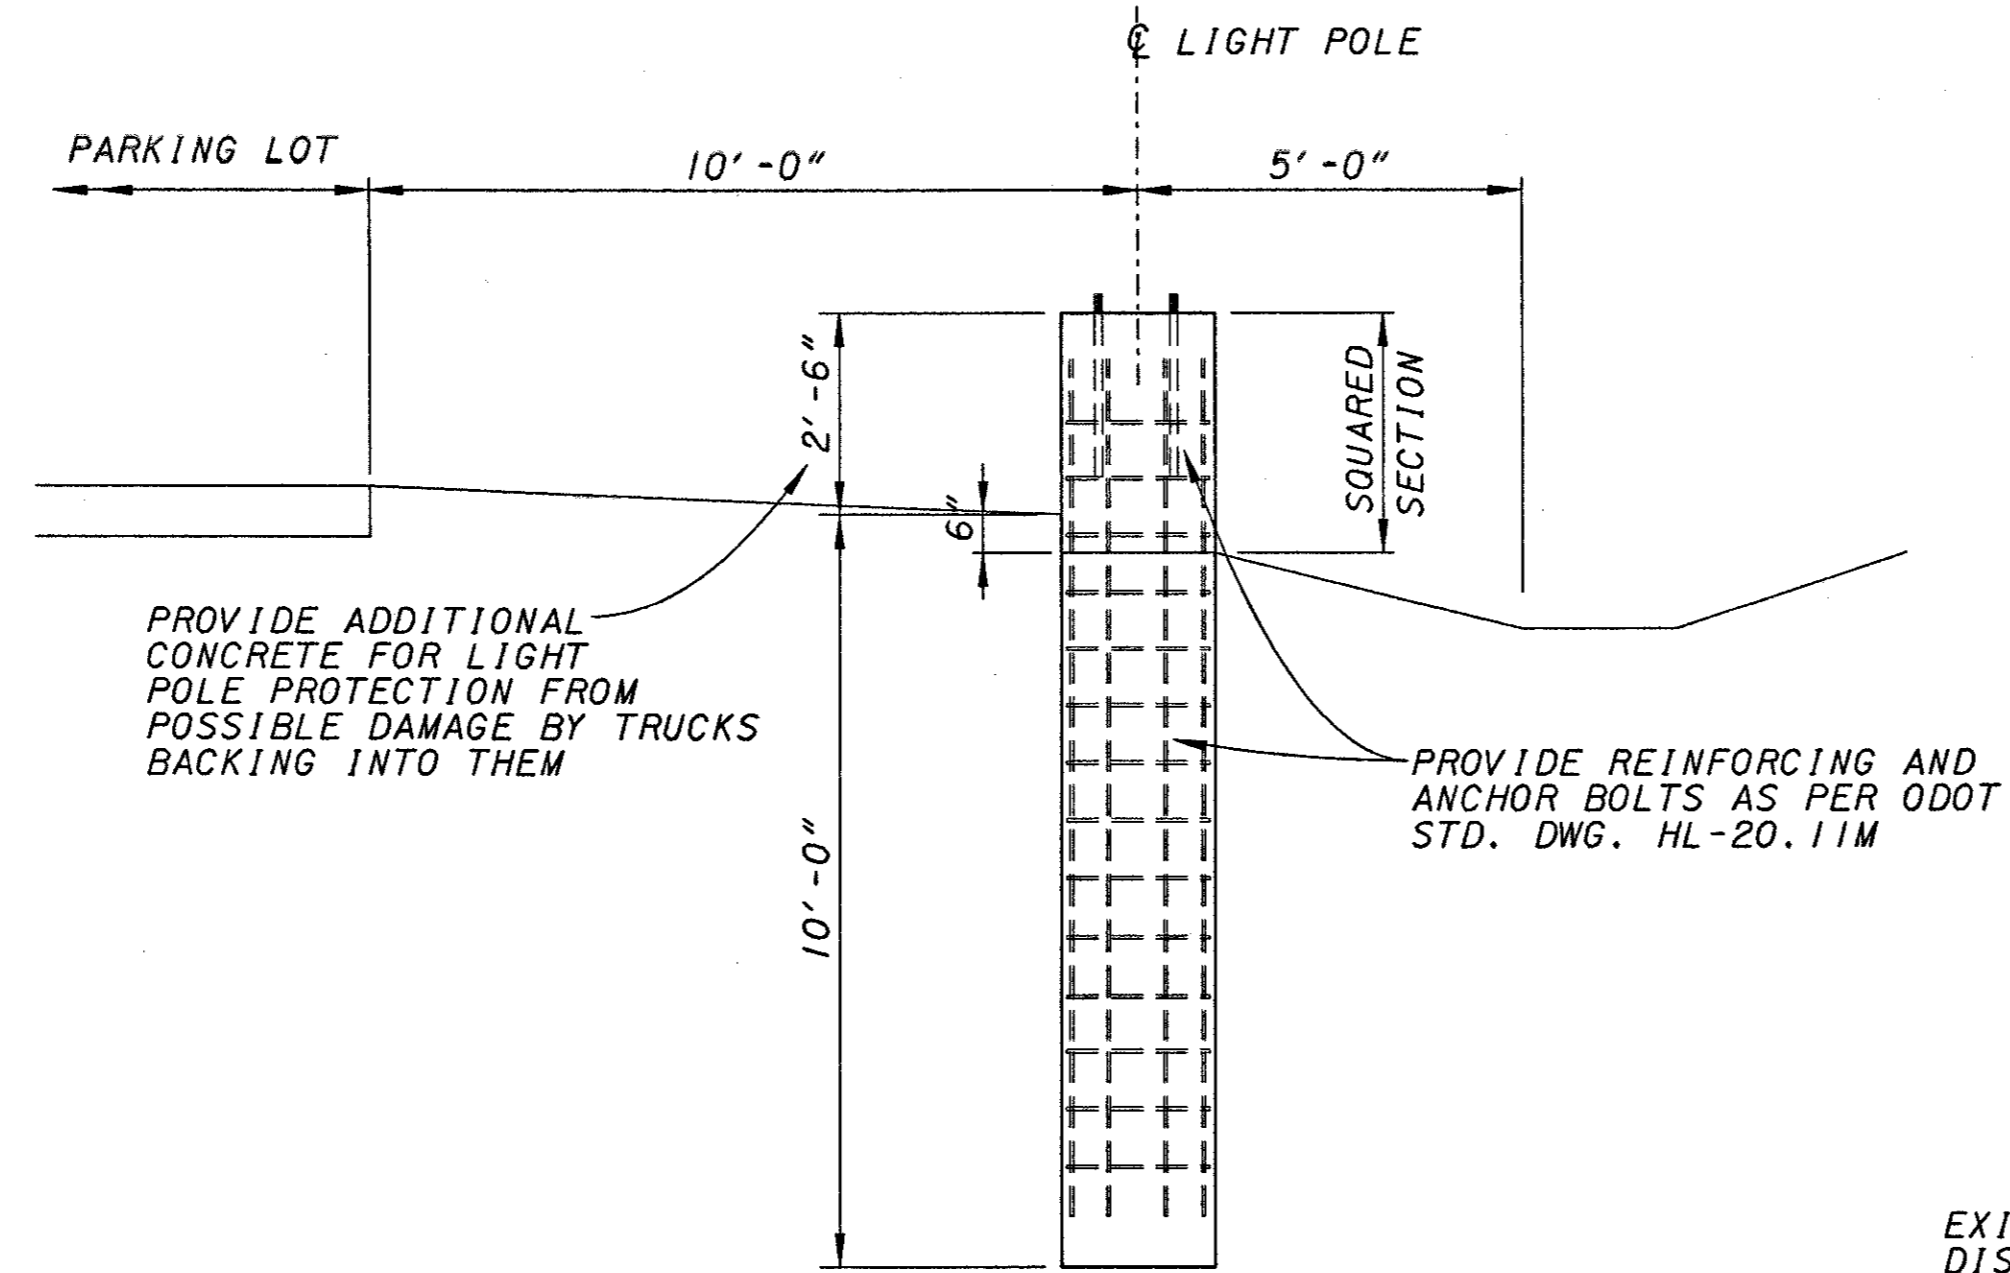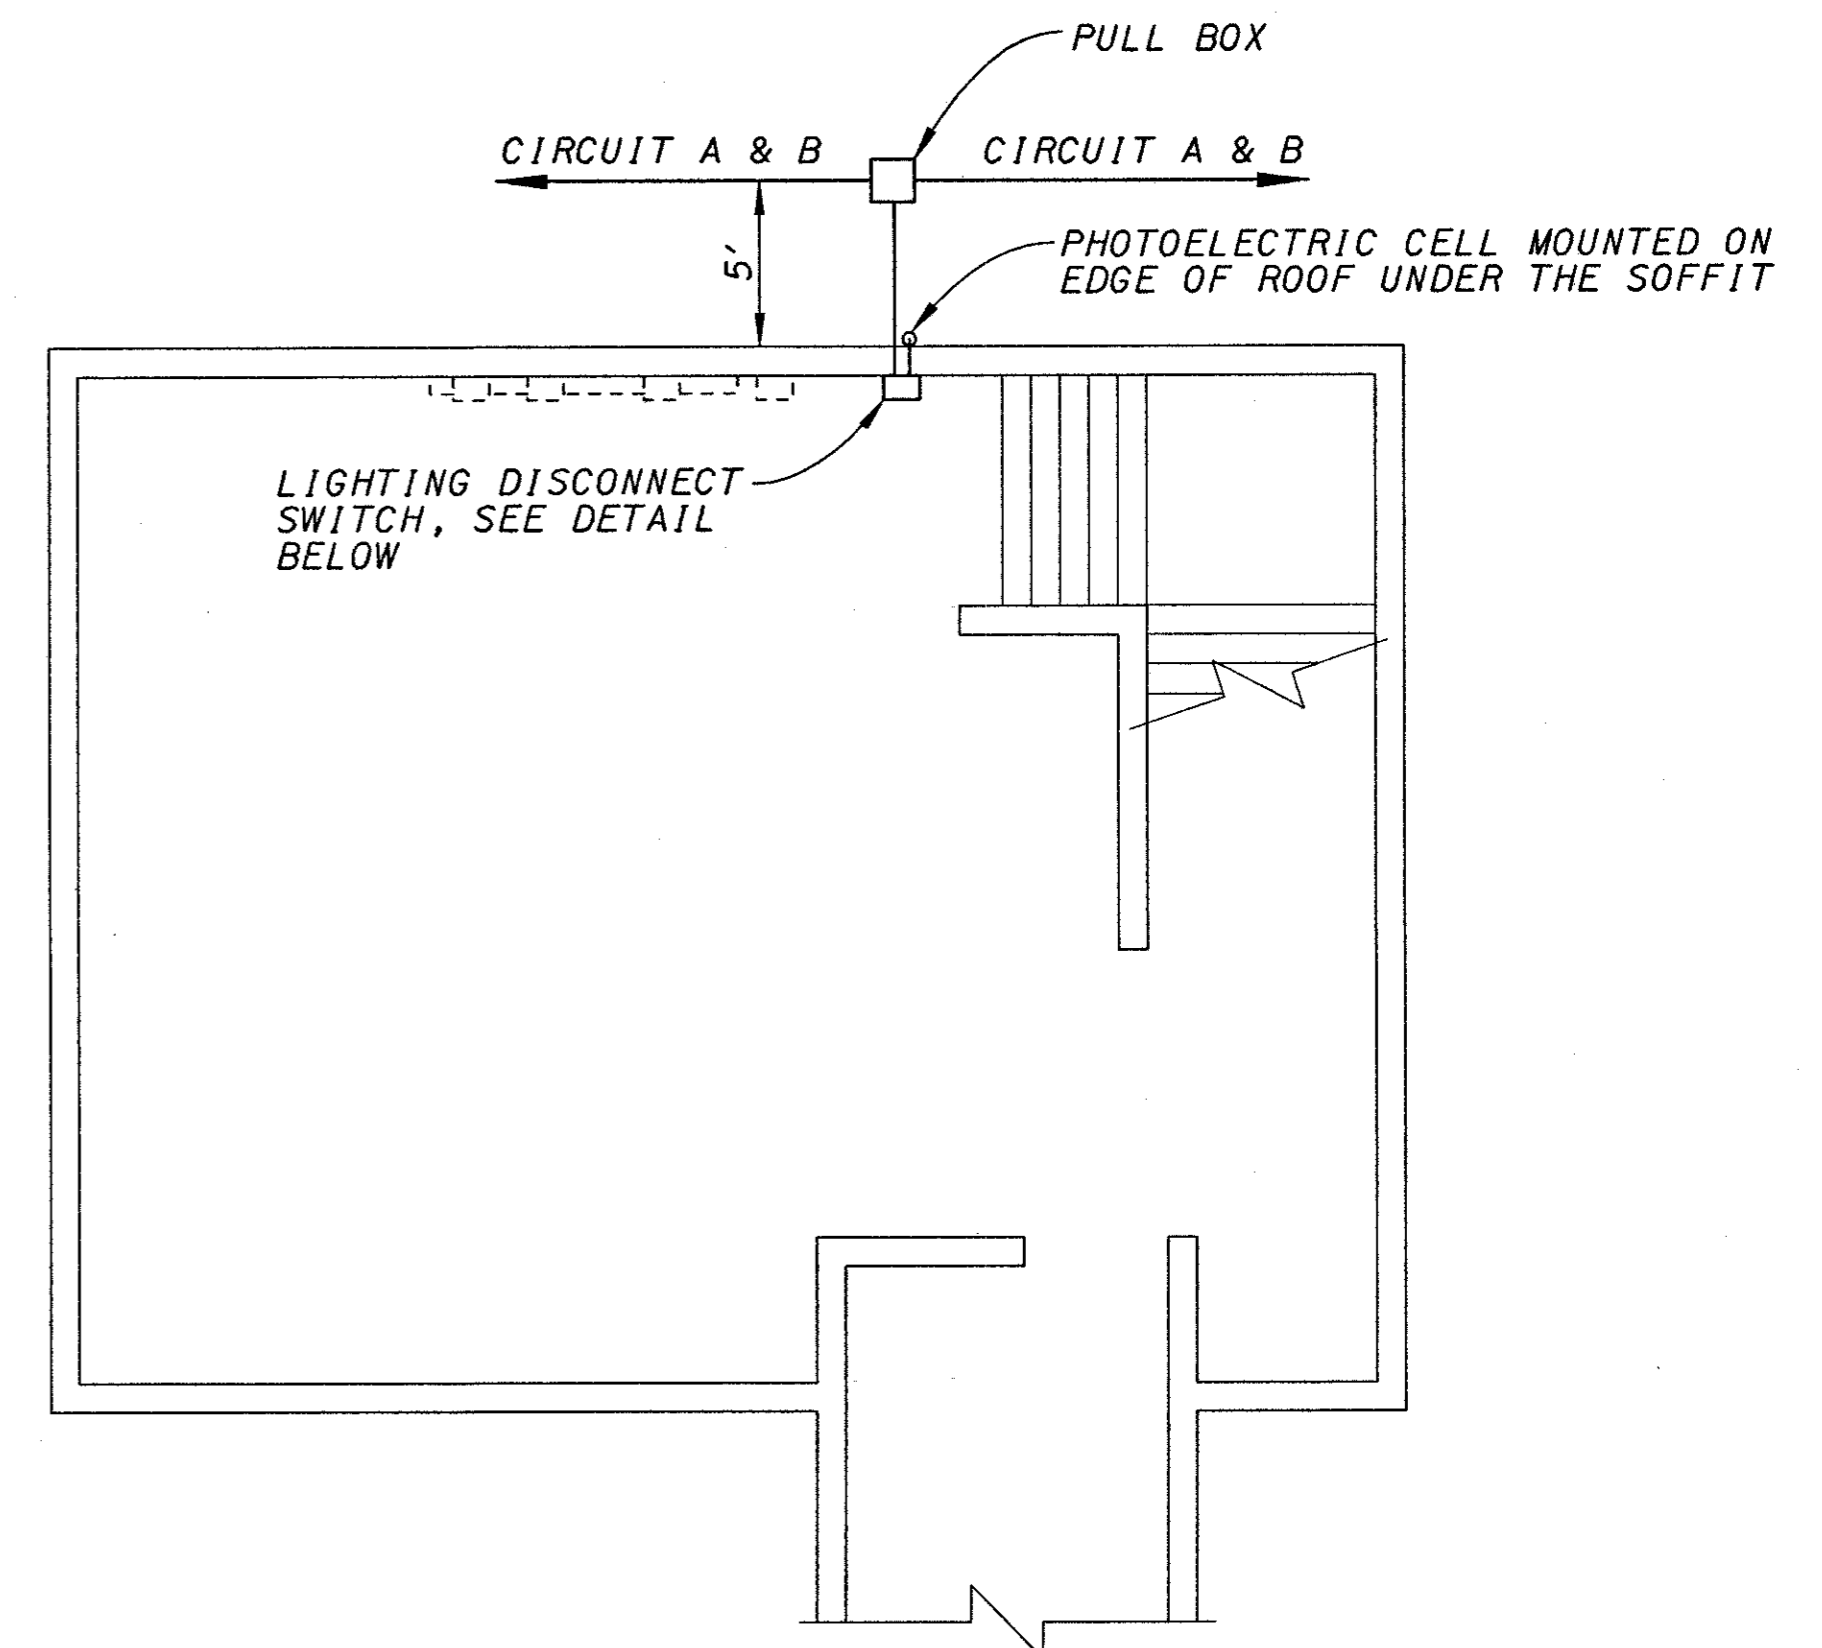

1.00
 2.00
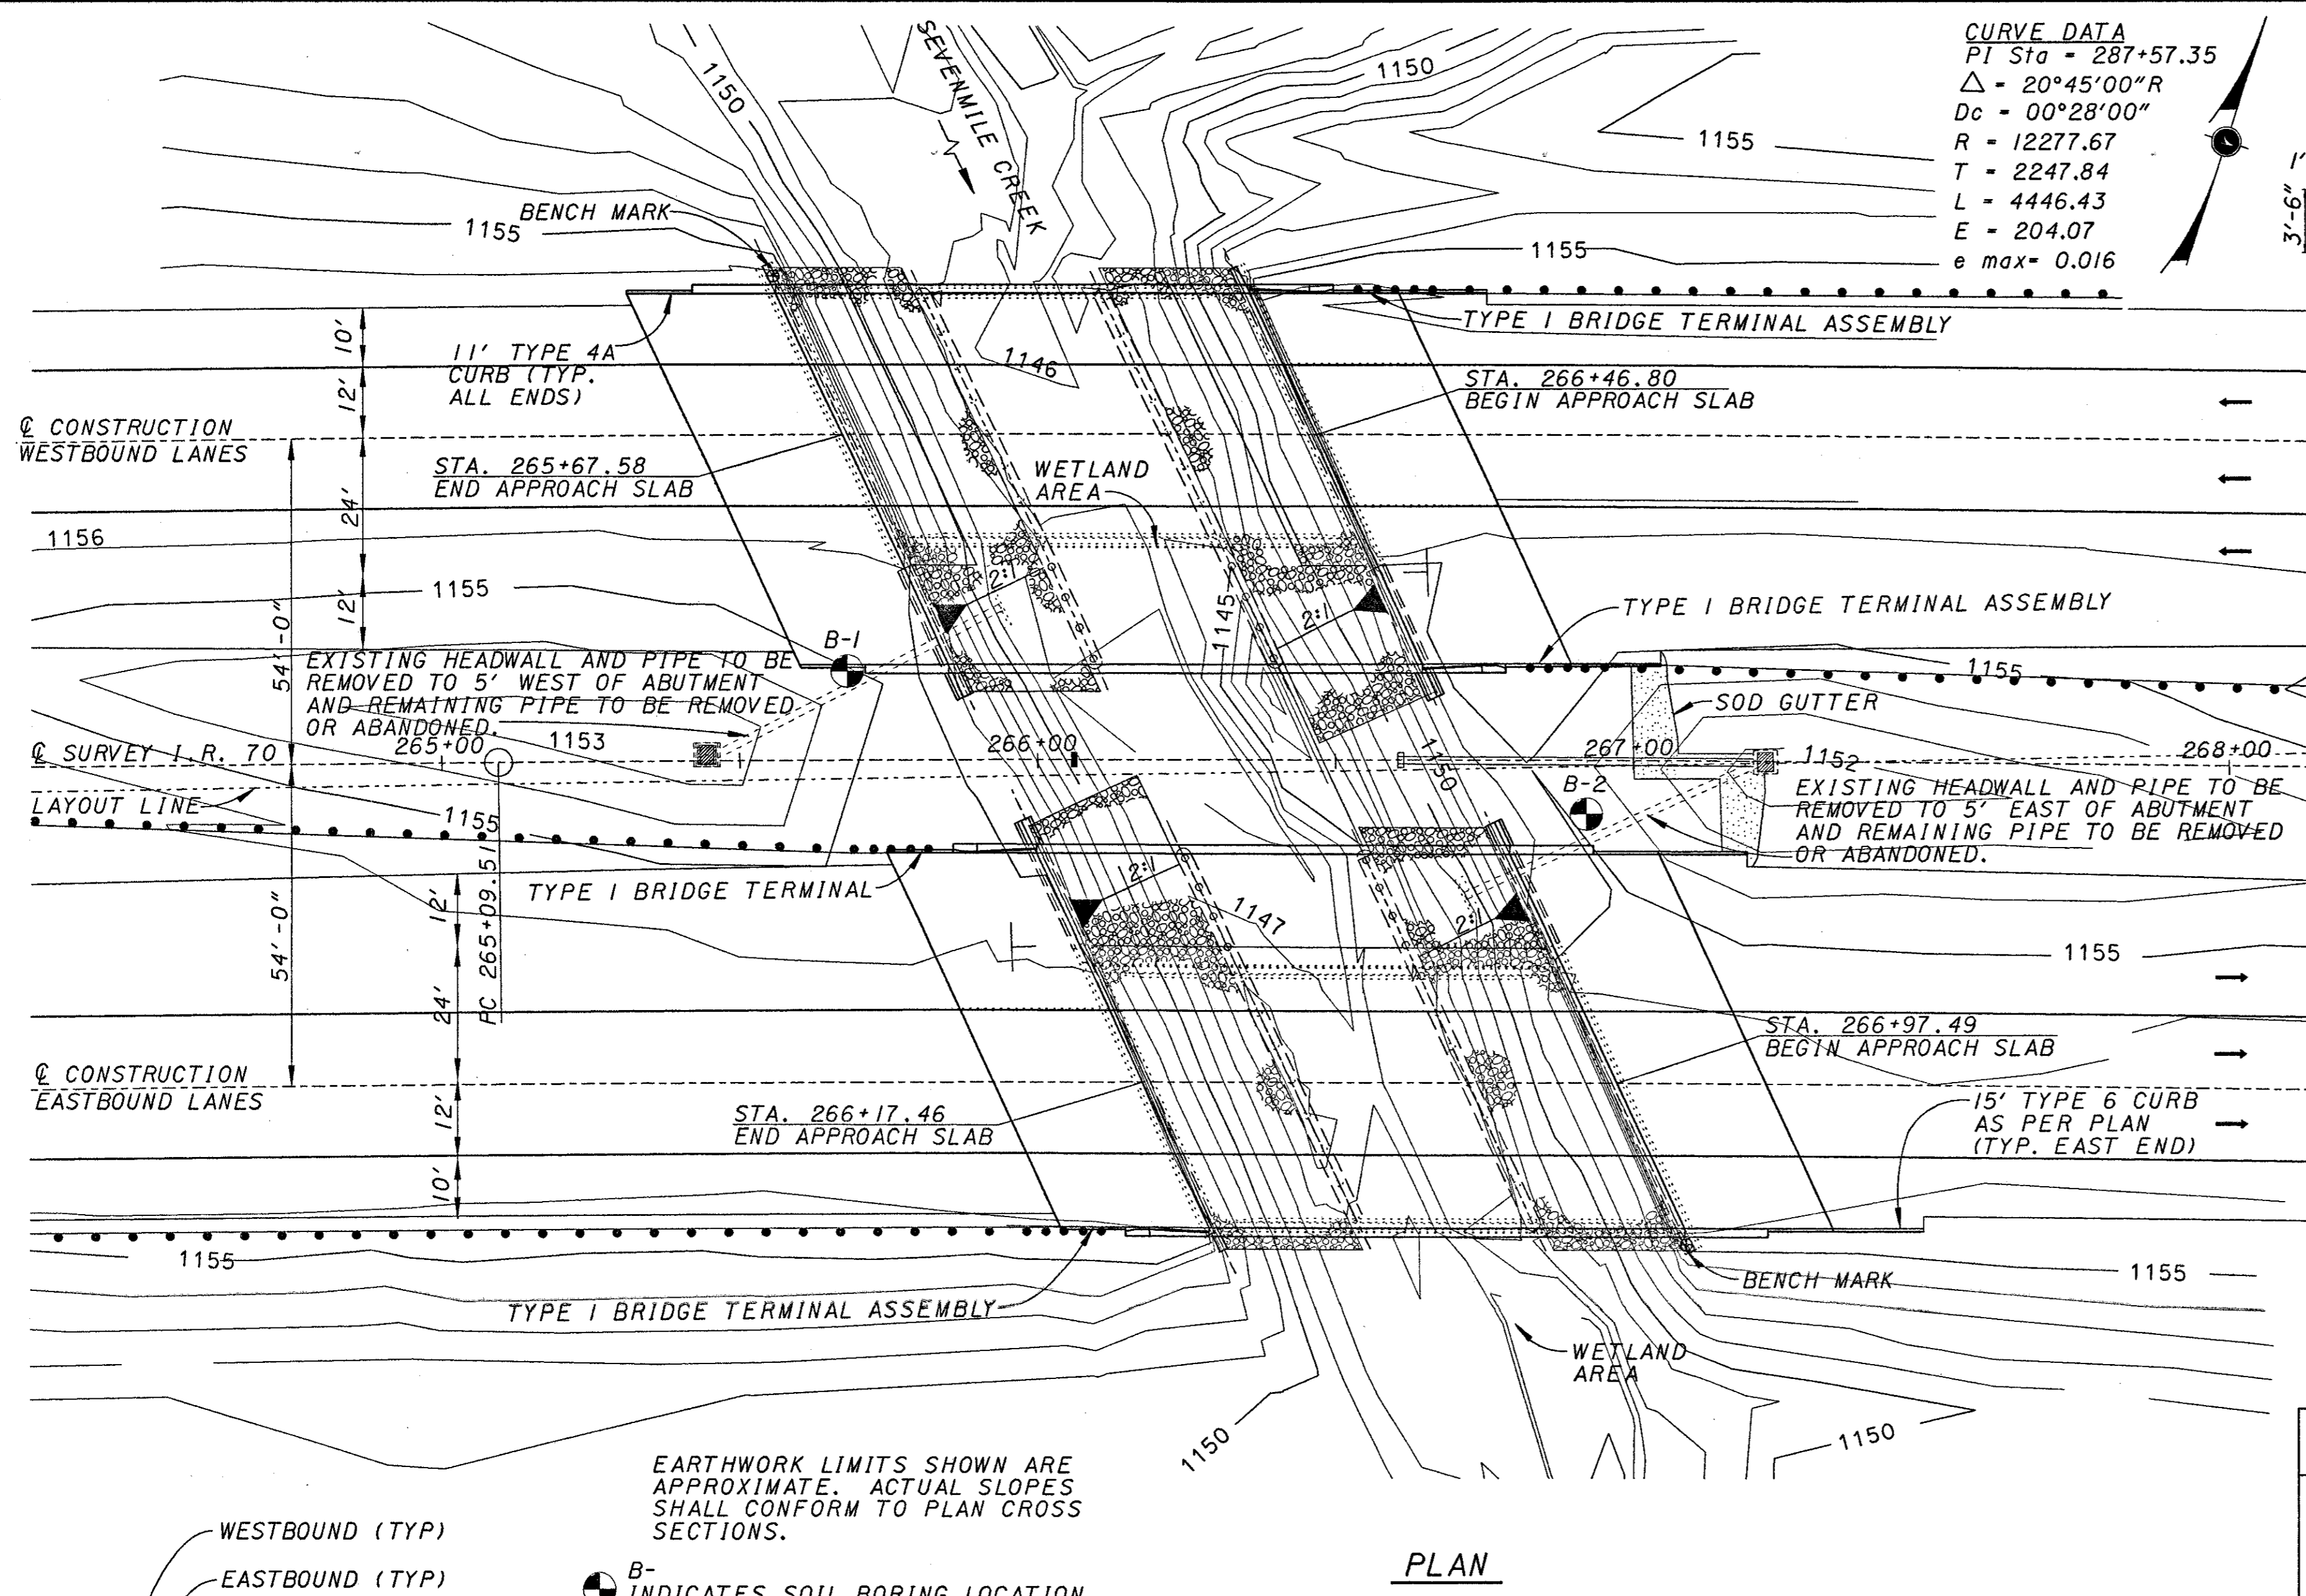

CURVE DATA
 PI Sta = 287+57.35
 $\Delta = 20^\circ 45' 00'' R$
 $D_c = 00^\circ 28' 00''$
 $R = 12277.67$
 $T = 2247.84$
 $L = 4446.43$
 $E = 204.07$
 $e_{max} = 0.016$

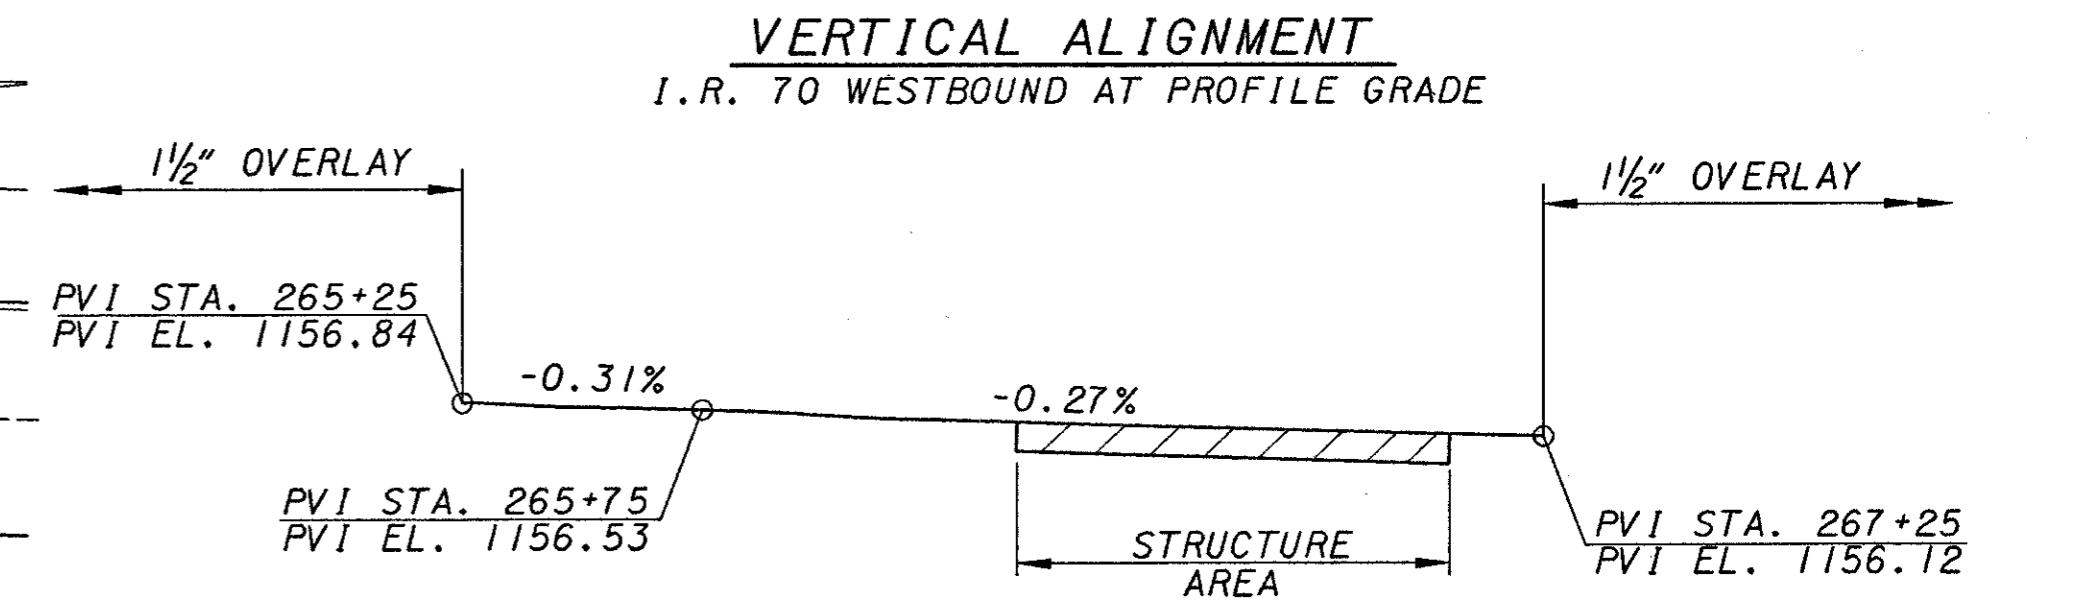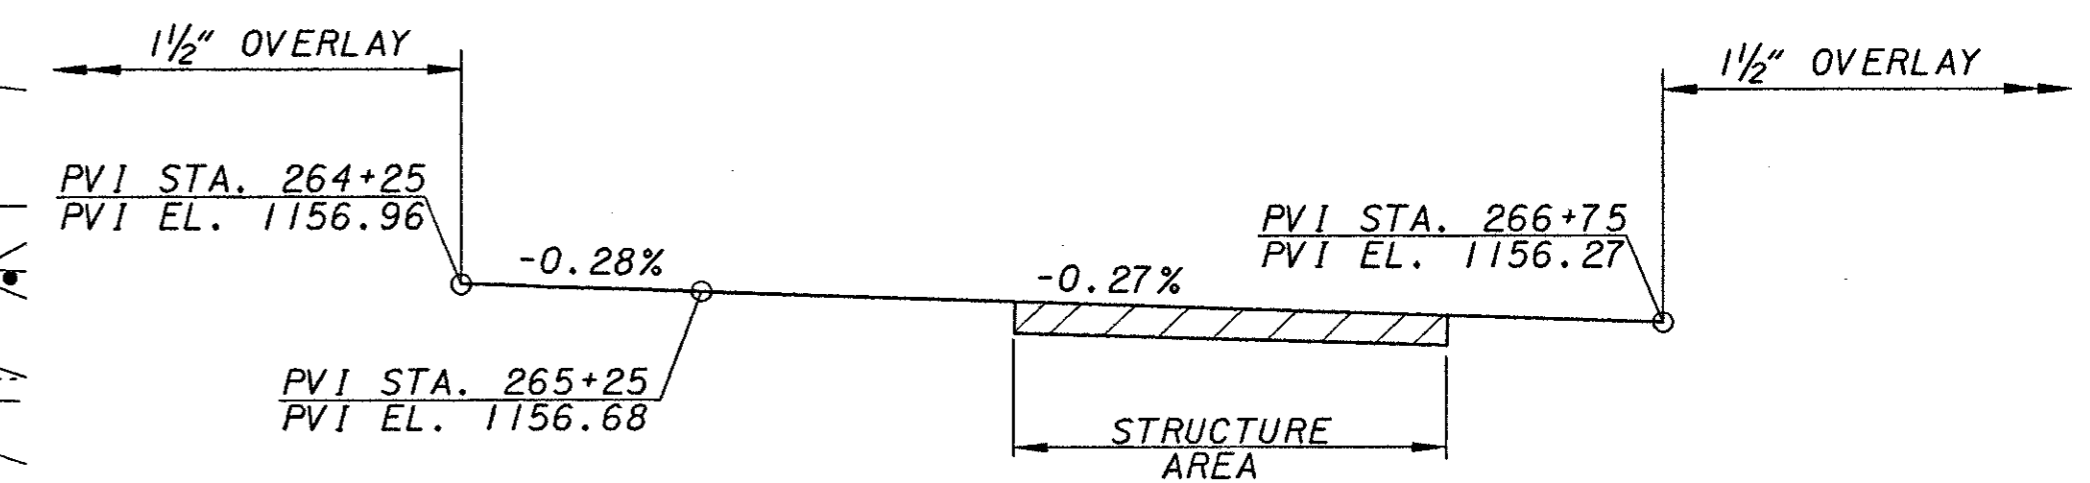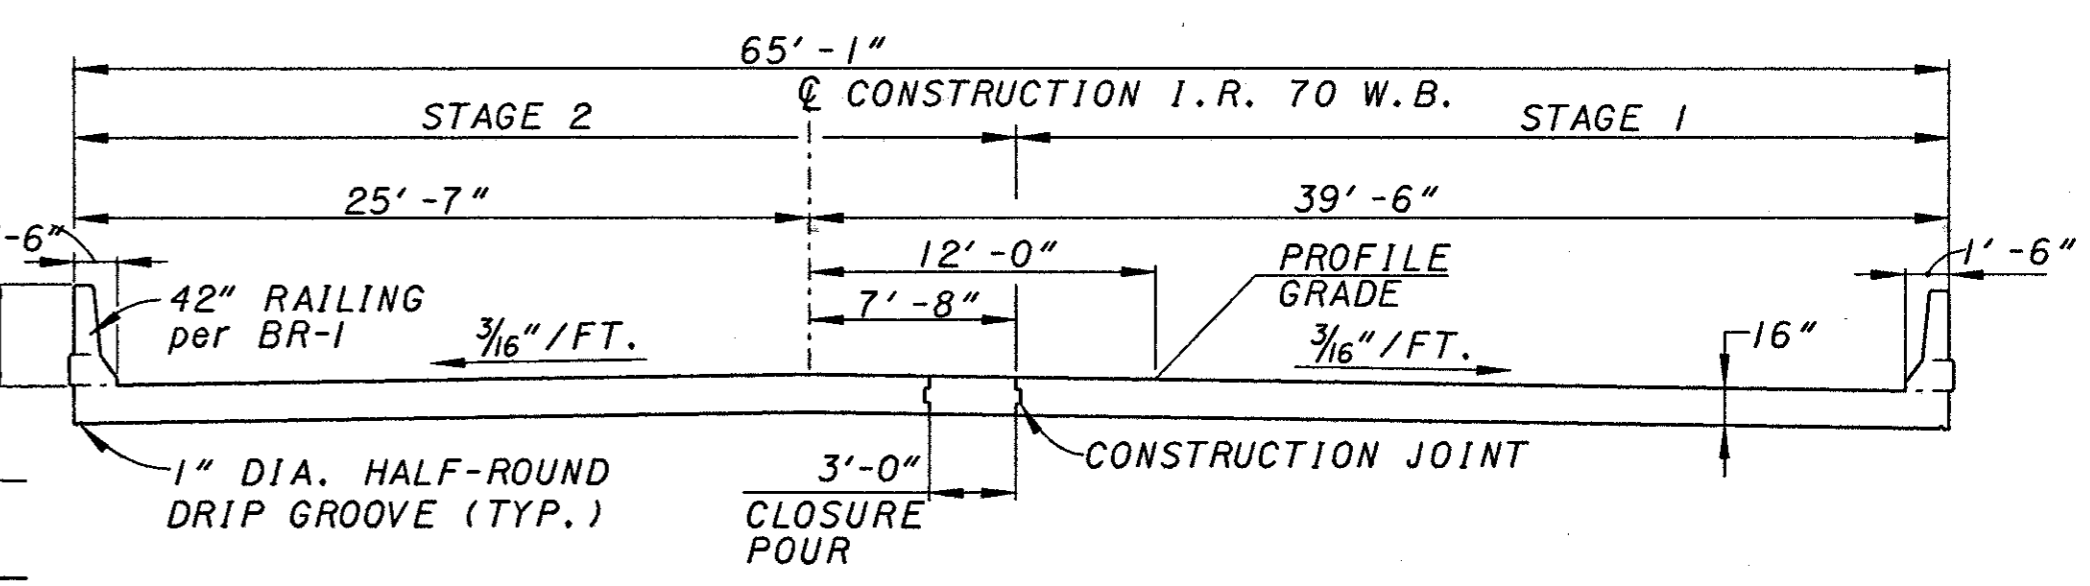

TRAFFIC DATA

ADT (2001) = 35,860
ADT (2021) = 50,800
ADTT (2021) = 19,812
SOURCE = ODOT

BENCH MARK

BOX NOTCH ON S.E. ABUTMENT EASTBOUND AT STA. 267+09.6, 80.8 RT. AT ELEVATION 1156.61
BOX NOTCH ON N.W. ABUTMENT WESTBOUND AT STA. 265+56.03, 80.0 LT. AT ELEVATION 1156.98

DRAINAGE DATA


DRAINAGE AREA: 4.79 SQ. MILES
EXISTING BRIDGE OPENING: 550 Sq. Ft.
PROPOSED BRIDGE OPENING: 550 Sq. Ft.
HW100: 1153.11
HW50: 1152.79
Q100: 1,550 C.F.S.
Q50: 1,375 C.F.S.
V100: 4.56 F.P.S.
V50: 4.30 F.P.S.
LOW CHORD ELEVATION: 1154.5
TOP OF DECK ELEVATION: 1155.8 TO 1156.5

EXISTING STRUCTURE - I.R. 70


TYPE: 3 SPAN CONTINUOUS REINFORCED CONCRETE SLAB WITH CAPPED PILE SUBSTRUCTURE.
LENGTH OF SPANS: 23'-9 7/8" ±, 30'-1 1/2" ±, 23'-11 5/8" ± W.B. 24'-3 1/8" ±, 29'-8 3/8" ±, 24'-0 3/4" ± E.B.
ROADWAY WIDTH: 39'-8" ± TOE/TOE BARRIER
DESIGN LOADING: C.F. 2000
SKEW ANGLE: 25°00'00" ± RT. FWD.
SUPERELEVATION: NONE - NORMAL CROWN
WEARING SURFACE: 1" MONOLITHIC CONCRETE
ALIGNMENT: 0°28' ± CURVE RIGHT
YEAR BUILT: 1962

PROPOSED STRUCTURE


PROPOSED WORK: NEW REINFORCED CONCRETE DECK ON WIDENED SUBSTRUCTURE.
TYPE: 3 SPAN CONTINUOUS REINFORCED CONCRETE SLAB WITH CAPPED PILE SUBSTRUCTURE.
LENGTH OF SPANS: 23'-9 7/8" ±, 30'-1 1/2" ±, 23'-11 5/8" ± W.B. 24'-3 1/8" ±, 29'-8 3/8" ±, 24'-0 3/4" ± E.B.
ROADWAY WIDTH: 62'-0" ± TOE/TOE BARRIER
DESIGN LOADING: HS-20 WITH ALTERNATE MILITARY
SKEW ANGLE: 25°00'00" ± RT. FWD.
SUPERELEVATION: NONE - NORMAL CROWN
WEARING SURFACE: 1" MONOLITHIC CONCRETE
APPROACH SLAB: AS-1-81 (25' LONG)
ALIGNMENT: 0°28' ± CURVE RIGHT (BRIDGE TANGENT)
LATITUDE: N 39°50'00"
LONGITUDE: W 84°43'03"

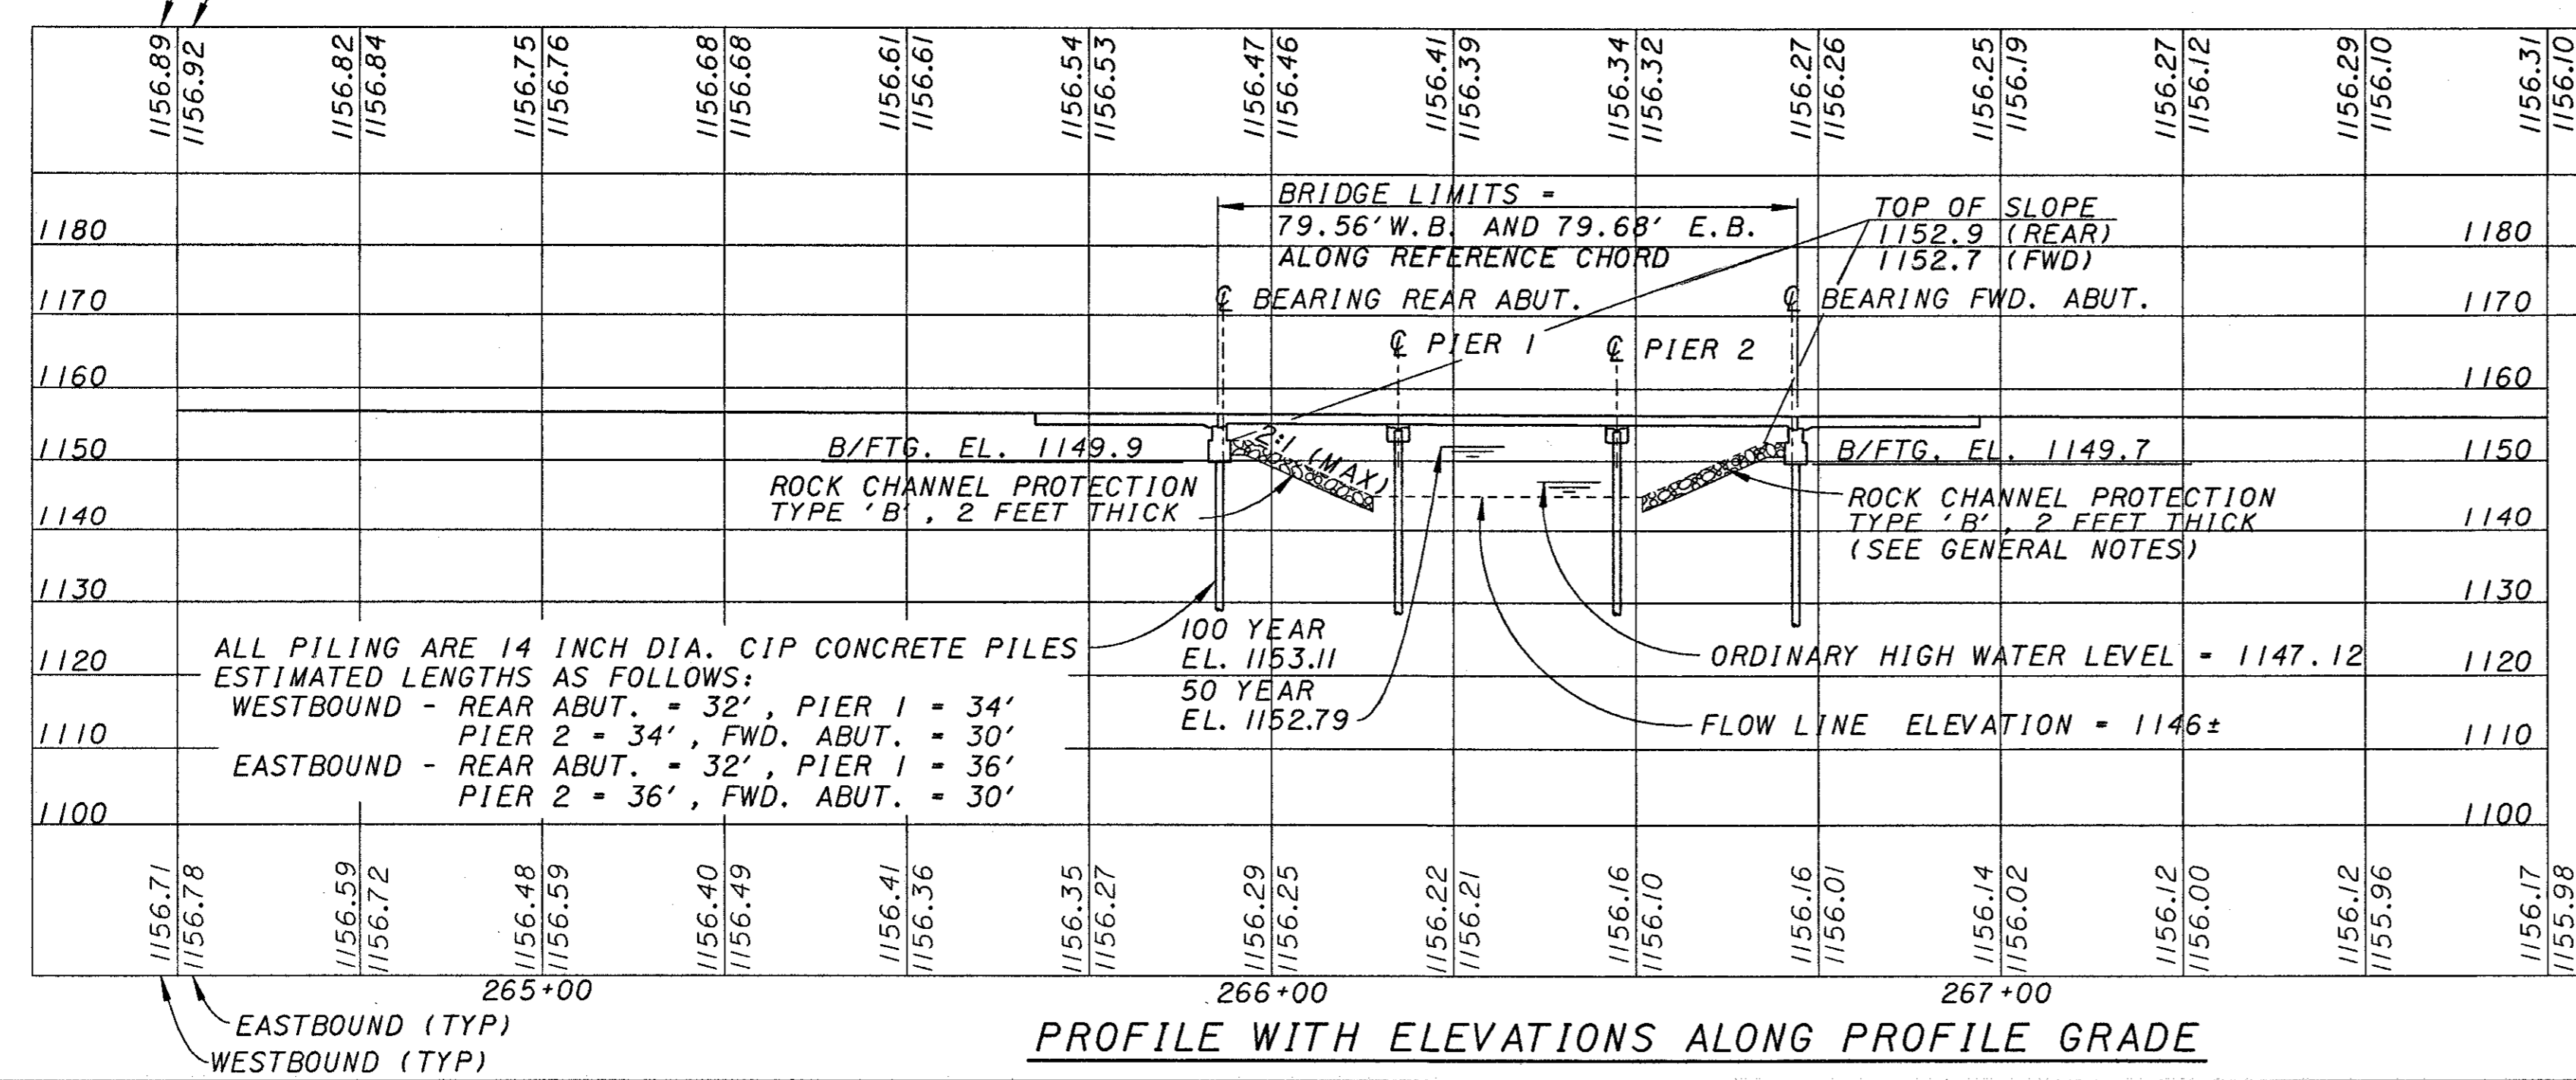

REF: **REF1**
 REF: **REF2**
 REF: **REF3**
 REF: **REF100**

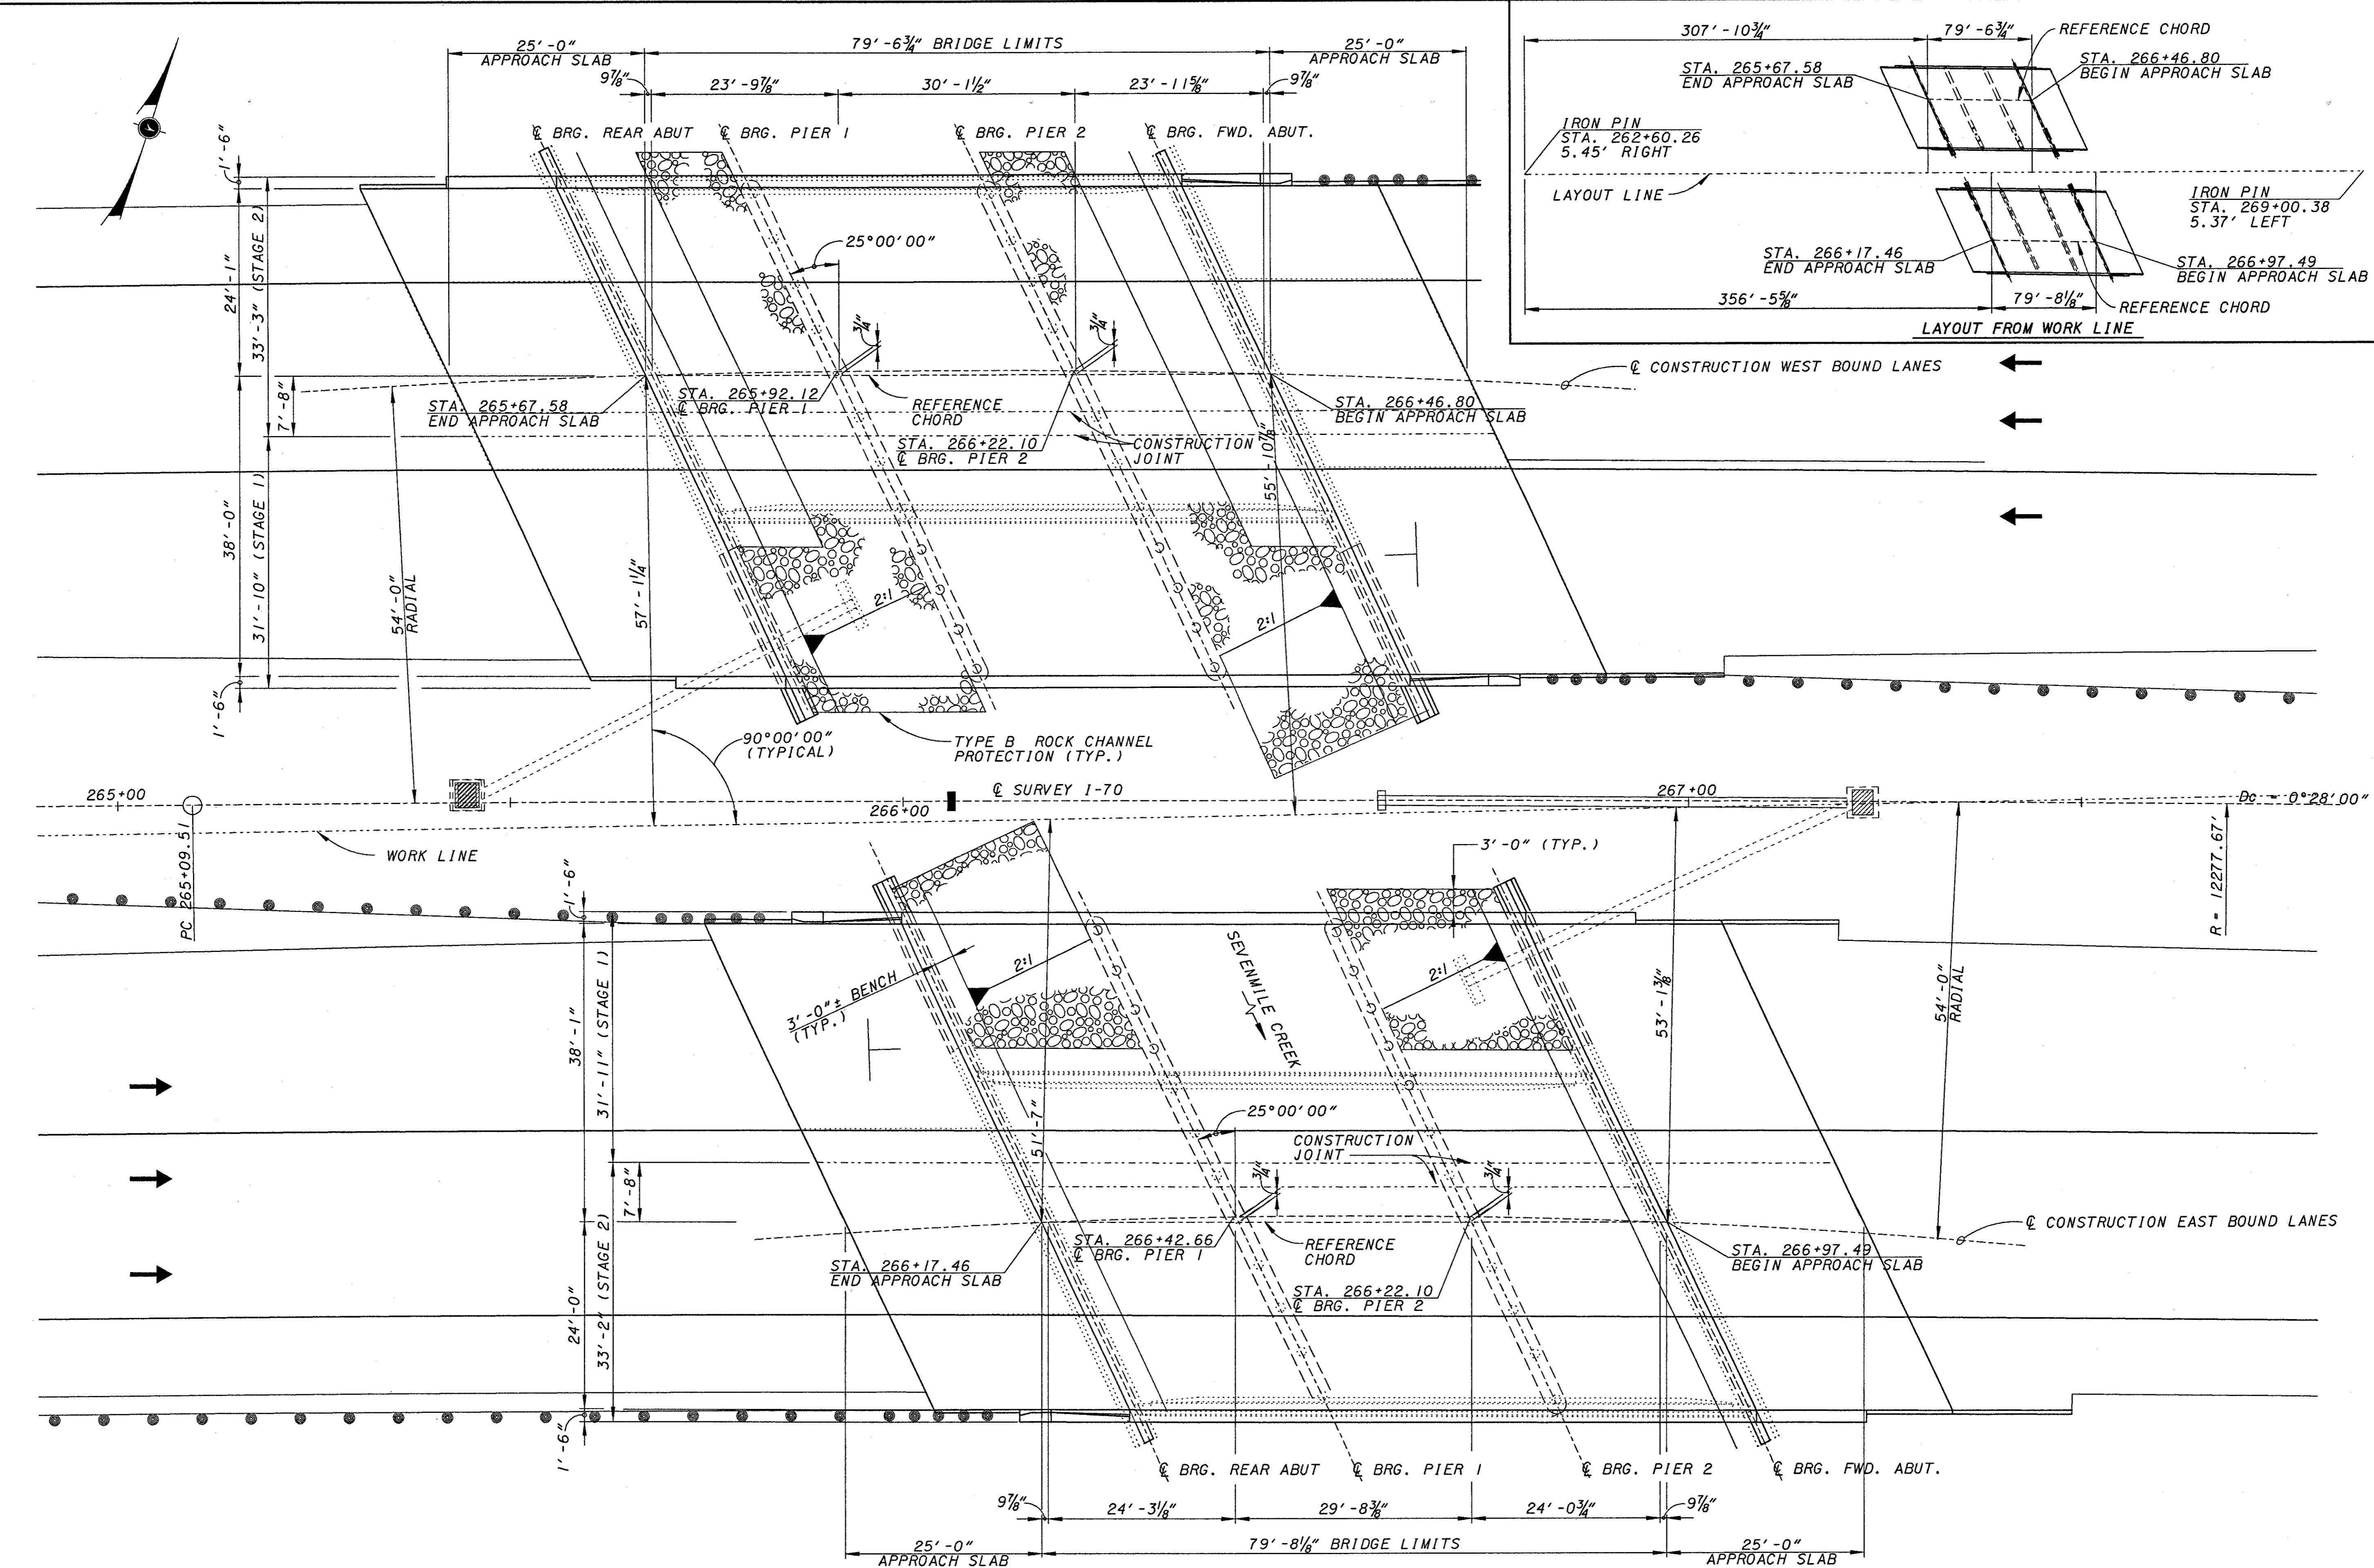

PLAN

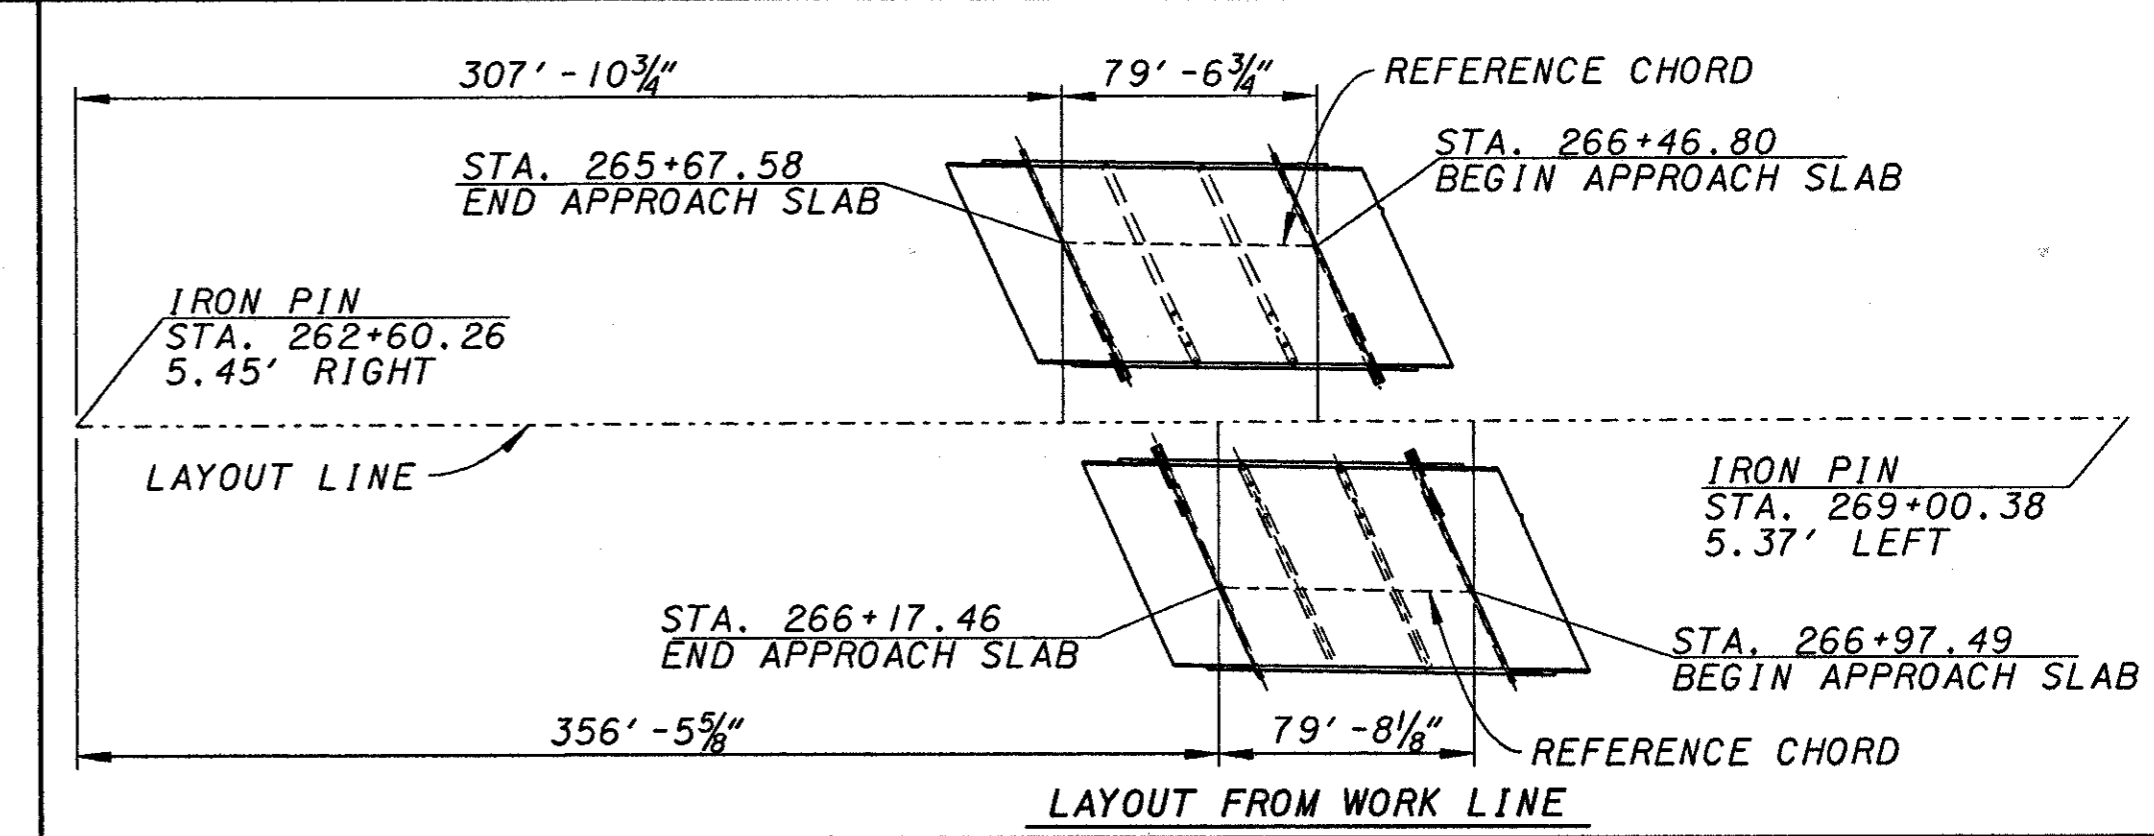

KZF DESIGN
 DESIGN AGENCY
 ARCHITECTURE | ENGINEERING | INTERIORS | PLUMBING
 13500 W. 10th Avenue, Suite 100, Golden, CO 80401
 TEL: 303.440.1000 FAX: 303.440.1001

DESIGNED	SVA	CHECKED	WBS
DRAWN	JDG	REVIEWED	
DATE	6-21-2000	STRUCTURE FILE NUMBER	6800939/6800904
REVISED	DGK		

GENERAL PLAN
 BRIDGE NO. PRE-70-0504 L/R
 I.R. TO OVER SEVEN MILE CREEK

PRE-70-0.00

2 / 17

135
 283

REF: **REFB**
REF: **REFC**
REF: **REFD**
REF: **REFE**
REF: **REFG**
REF: **REFH**
REF: **REFI**
REF: **REFJ**

REF: **REFB**
REF: **REFC**
REF: **REFD**
REF: **REFE**
REF: **REFG**
REF: **REFH**
REF: **REFI**
REF: **REFJ**

REF: **REFB**
REF: **REFC**
REF: **REFD**
REF: **REFE**
REF: **REFG**
REF: **REFH**
REF: **REFI**
REF: **REFJ**

REF: **REFB**
REF: **REFC**
REF: **REFD**
REF: **REFE**
REF: **REFG**
REF: **REFH**
REF: **REFI**
REF: **REFJ**

*****ACTIVE*****
*****INACTIVE*****
*****DELETED*****
*****REMOVED*****
*****ARCHIVED*****
*****HIDDEN*****
*****LOCKED*****
*****UNLOCKED*****
*****ACTIVE LEVELS ON*****

REFERENCE: SHALL BE MADE TO STANDARD DRAWINGS :

AS-1-81 REVISED 09-15-94 (SHEETS 1,2 & 3)
BR-1 REVISED 1-6-99
CS-1-93 DATED 5-11-93
CPP-2-94 DATED 12-19-94

AND TO SUPPLEMENTAL SPECIFICATION:

842 DATED 1/6/99
844 DATED 5/5/98
899 DATED 10/21/98
954 DATED 9/9/97
911 DATED 07/10/97

DESIGN SPECIFICATIONS: THIS STRUCTURE CONFORMS TO "STANDARD SPECIFICATIONS FOR HIGHWAY BRIDGES" ADOPTED BY THE AMERICAN ASSOCIATION OF STATE HIGHWAY AND TRANSPORTATION OFFICIALS, 1996, INCLUDING THE 1997, 1998 AND 1999 INTERIM SPECIFICATIONS AND THE ODOT BRIDGE DESIGN MANUAL.

DESIGN LOADING: HS20-44 AND THE ALTERNATE MILITARY LOADING.

DESIGN STRESSES:

CLASS S CONCRETE - COMPRESSIVE STRENGTH 4500 PSI (28-DAY) (SUPERSTRUCTURE)
CLASS C CONCRETE - COMPRESSIVE STRENGTH 4000 PSI (28-DAY) (SUBSTRUCTURE)
STRUCTURAL STEEL - ASTM A36 - YIELD STRENGTH 36,000 PSI
REINFORCING STEEL - ASTM A615, A616 OR A617. EPOXY COATED GRADE 60 - MINIMUM YIELD STRENGTH 60,000 PSI.

DECK PROTECTION METHOD: EPOXY COATED REINFORCING STEEL, SEALING OF CONCRETE SURFACES, CLASS S CONCRETE AND 2 1/2" CONCRETE COVER.

MONOLITHIC WEARING SURFACE: IS ASSUMED, FOR DESIGN PURPOSES, TO BE 1" THICK.

REINFORCING BAR SPLICES: REINFORCING BAR SPLICE LENGTHS SHALL CONFORM TO THE MINIMUM LENGTHS SPECIFIED BY 509.08 OF THE C.M.S. UNLESS OTHERWISE NOTED ON THE PLANS.

UTILITY LINES: ALL EXPENSE INVOLVED IN RELOCATION OF THE AFFECTED UTILITY LINES SHALL BE BORNE BY THE UTILITY. THE CONTRACTOR AND UTILITY ARE TO COOPERATE BY ARRANGING THEIR WORK IN SUCH A MANNER THAT INCONVENIENCE TO EITHER WILL BE HELD TO A MINIMUM.

REINFORCING CLEARANCE: UNLESS OTHERWISE NOTED, MINIMUM REINFORCING STEEL CLEARANCE TO FACE OF CONCRETE IS 2".

PROPOSED WORK

1. REMOVE EXISTING CONCRETE DECK, PARAPETS, SCUPPERS, APPROACH SLABS AND PORTIONS OF CONCRETE SUBSTRUCTURES IN A SEQUENCE CONSISTENT WITH MAINTENANCE OF TRAFFIC PLANS AND NOTES AND STAGE CONSTRUCTION.
2. DRIVE PILING AND CONSTRUCT NEW ABUTMENT AND PIER CAPS.
3. CONSTRUCT A NEW CONCRETE DECK AT ELEVATIONS TO MEET OVERLAY ON EXISTING ROADWAY APPROACHES.
4. CONSTRUCT NEW CONCRETE APPROACH SLABS.
5. CONSTRUCT NEW CONCRETE BARRIERS ON DECK AND APPROACH SLABS.
6. PATCH CONCRETE SUBSTRUCTURES AS DIRECTED.
7. CLEAN AND SEAL CONCRETE BARRIERS, ABUTMENTS AND PIERS.

ITEM 202 - PORTIONS OF STRUCTURE REMOVED, OVER 20 FOOT SPAN, AS PER PLAN

DESCRIPTION: THIS WORK SHALL CONSIST OF THE REMOVAL OF CONCRETE DECKS INCLUDING PARAPETS AND OTHER APPURTENANCES. PORTIONS OF THE PIERS AND ABUTMENTS SHALL ALSO BE REMOVED AS SHOWN ON THE PLANS. CARE SHALL BE TAKEN DURING REMOVALS TO PROTECT PORTIONS OF THE EXISTING STRUCTURE THAT ARE TO BE SALVAGED AND INCORPORATED INTO THE PROPOSED STRUCTURE. IN THIS RESPECT, THE USE OF EXPLOSIVES, HEADACHE BALLS AND/OR HOE-RAM TYPE OF EQUIPMENT IS PROHIBITED. ALL REMOVALS SHALL BE CONSISTENT WITH THE STAGE CONSTRUCTION REQUIREMENTS. ALL WORK SHALL BE TO THE SATISFACTION OF THE ENGINEER.

PROTECTION OF TRAFFIC: PRIOR TO DEMOLITION OF ANY PORTIONS OF THE EXISTING SUPERSTRUCTURE, THE CONTRACTOR SHALL SUBMIT HIS PLANS FOR THE PROTECTION OF TRAFFIC (VEHICULAR, BOAT, ETC.) ADJACENT TO AND/OR UNDER THE STRUCTURE TO THE ENGINEER FOR APPROVAL. THESE PLANS SHALL INCLUDE PROVISIONS FOR ANY DEVICES AND STRUCTURES THAT MAY BE NECESSARY TO ENSURE SUCH PROTECTION. TEMPORARY VERTICAL CLEARANCES SPECIFIED ON THE PLANS OR IN THE PROPOSAL SHALL BE MAINTAINED AT ALL TIMES EXCEPT AS OTHERWISE APPROVED BY THE ENGINEER.

REMOVAL METHODS: CONCRETE MAY BE REMOVED BY CUTTING AND BY MEANS OF HAND OPERATED PNEUMATIC HAMMERS EMPLOYING POINTED OR BLUNTED CHISEL TYPE TOOLS. FOR REMOVALS, A HAMMER HEAVIER THAN 35 POUNDS BUT NOT TO EXCEED 90 POUNDS MAY BE USED AT THE APPROVAL OF THE ENGINEER, TO ENSURE ADEQUATE DEPTH CONTROL AND TO PREVENT DAMAGE TO CONCRETE SUBSTRUCTURES.

SUBSTRUCTURE CONCRETE REMOVAL SHALL BE BY MEANS OF APPROVED PNEUMATIC HAMMERS EMPLOYING POINTED AND BLUNT CHISEL TOOLS. HYDRAULIC HOE-RAM TYPE HAMMERS WILL NOT BE PERMITTED. THE WEIGHT OF THE HAMMER SHALL NOT BE MORE THAN 35 POUNDS FOR REMOVAL WITHIN 18 INCHES OF PORTIONS TO BE PRESERVED. OUTSIDE THE 18 INCH LIMIT, A HAMMER HEAVIER THAN 35 POUNDS, BUT NOT TO EXCEED 90 POUNDS MAY BE USED AT THE APPROVAL OF THE ENGINEER. PNEUMATIC HAMMERS SHALL NOT BE PLACED IN DIRECT CONTACT WITH REINFORCING STEEL THAT IS TO BE RETAINED IN THE REBUILT STRUCTURE.

ROCK CHANNEL PROTECTION

BROKEN CONCRETE FROM THE EXISTING BRIDGE DECK MAY BE USED FOR ROCK CHANNEL PROTECTION. MATERIAL CAN BE EITHER TYPE B OR TYPE C WITH A MINIMUM OF 50% OF THE MATERIAL BEING TYPE B.

PILE DESIGN LOADS

THE ULTIMATE BEARING VALUE IS 43 TONS PER PILE FOR THE ABUTMENT PILES. THE ULTIMATE BEARING VALUE IS 70 TONS PER PILE FOR THE PIER PILES.

SEAL PIER CAPS, WINGWALLS, ABUTMENTS, PARAPETS, AND DECK EDGES WITH EPOXY-URETHANE: COLOR SHALL BE FEDERAL COLOR STANDARD 17778 (OFF-WHITE)

THIS WORK SHALL CONSIST OF FURNISHING ALL NECESSARY LABOR, MATERIALS AND EQUIPMENT TO SEAL THE DESIGNATED EXPOSED CONCRETE SURFACE AREAS IN ACCORDANCE WITH THE PROJECT PROPOSAL DOCUMENT (PAGE 30) ENTITLED, ITEM SPECIAL - SEALING OF CONCRETE SURFACES

PATCH SUBSTRUCTURE CONCRETE

PATCHING SUBSTRUCTURE CONCRETE SHALL BE PERFORMED IN ACCORDANCE WITH THE STATE OF OHIO DEPARTMENT OF TRANSPORTATION CONSTRUCTION AND MATERIAL SPECIFICATIONS ITEM 519 PATCHING CONCRETE STRUCTURES. THE LOCATION AND SURFACE AREA EXTENT OF PATCHING CONCRETE STRUCTURES SHALL BE FIELD-DETERMINED BY THE ODOT PROJECT ENGINEER. THE CONTRACTOR SHALL PROVIDE THE PROJECT ENGINEER ACCESS TO CONCRETE SURFACES FOR INSPECTION. THE CONTRACTOR SHALL PROVIDE THE ENGINEER AEROSOL PAINT FOR THE PURPOSE OF MARKING SUBSTRUCTURE CONCRETE TO BE PATCHED.

REF: **REF**
REF: **REF**
LOADING LIMITATION: NO PART OF THE STRUCTURE SHALL BE SUBJECTED TO UNIT STRESSES THAT EXCEED 136.5% OF THE ALLOWABLE UNIT STRESSES GIVEN IN THE AASHTO STANDARD SPECIFICATIONS FOR HIGHWAY BRIDGES DUE EITHER TO DEMOLITION, ERECTION OR CONSTRUCTION METHODS, OR TO THE USE OR MOVEMENT OF DEMOLITION OR ERECTION EQUIPMENT ON OR ACROSS THE STRUCTURE. STRUCTURAL ANALYSIS COMPUTATIONS, BY A REGISTERED PROFESSIONAL ENGINEER, SHOWING THE ALLOWABLE STRESSES AND THE MAXIMUM STRESSES PRODUCED BY THE CONTRACTOR'S METHODS OR EQUIPMENT SHALL BE SUBMITTED TO THE DIRECTOR FOR REVIEW AND APPROVAL AT LEAST TWO WEEKS PRIOR TO THE START OF THE WORK.

ENVIRONMENTAL COMMITMENTS AND RESOURCES TO BE AVOIDED

THE CONTRACTOR SHALL REFER TO THE STORMWATER POLLUTION PREVENTION PLAN (SWAPP) TO ADDRESS EROSION ASSOCIATED WITH SHOULDER DISTURBANCE/ RECONSTRUCTION AND BRIDGE WORK. (CMS 877.03)

ALL CONDITIONS ATTACHED WITH CORPS PERMIT (NATIONWIDE 3 & 14) SHALL BE IMPLEMENTED IN THE FIELD WITH THE ACTUAL PERMIT BEING DISPLAYED ONSITE.

EVERY EFFORT SHALL BE MADE TO KEEP DECK MATERIAL OUT OF THE STREAM CHANNELS. IF ANY MATERIAL FALLS INTO THE WATER, IT SHALL BE REMOVED IMMEDIATELY. ALL DEBRIS OR EXCESS FILL MATERIAL SHOULD BE DISPOSED AT AN APPROVED UPLAND SITE. (ABOVE THE 100 YR. FLOODPLAIN)

IN-STREAM STRUCTURES SHALL BE KEPT TO THE MINIMAL SIZE NEEDED TO FACILITATE WORK AND WILL BE REMOVED IMMEDIATELY TO ORIGINAL GRADE AFTER IN-STREAM WORK IS COMPLETED.

WHILE PAINTING, SANDBLASTING OR SEALING OF ANY PORTION OF THE BRIDGE AN APPROPRIATE APRON WILL BE UTILIZED TO PREVENT DEBRIS AND PAINT OVERSPRAY AND SEALANTS FROM ENTERING INTO THE STREAM.

PROPER SEDIMENT AND EROSION CONTROLS SHALL BE IMPLEMENTED THROUGHOUT THE COURSE OF THE PROJECT. ALL DISTURBED AREAS SHALL BE SEEDED AND MULCHED IMMEDIATELY UPON COMPLETION OF EARTHWORK (ODOT CMS ITEM 877)

IMPLEMENT ODOT CMS ITEM 616, DUST CONTROL AS NECESSARY.

COMPLY WITH ODOT CMS ITEM 107.21 CONTROLLING POLLUTION OF THE ENVIRONMENT.

VEGETATION REMOVAL WILL BE HELD TO AN ABSOLUTE MINIMUM REQUIRED TO COMPLETE THE WORK.

WETLANDS EXIST WITHIN THE PROJECT AREA. ALL WETLANDS NOT DIRECTLY INVOLVED WITH BRIDGE DECK/SUBSTRUCTURE MODIFICATIONS SHALL BE AVOIDED. THE BRIDGE SITE PLANS SHOW WETLAND AREAS TO BE AVOIDED.

REPLACEMENT OF EXISTING REINFORCING STEEL: ANY EXISTING REINFORCING BARS WHICH ARE TO BE INCORPORATED INTO THE NEW WORK AND WHICH ARE MADE UNUSABLE BY THE CONTRACTOR'S CONCRETE REMOVAL OPERATIONS SHALL BE REPLACED WITH NEW STEEL AT HIS COST. ANY EXISTING REINFORCING BARS WHICH ARE DEEMED BY THE ENGINEER TO BE UNUSABLE BECAUSE OF CORROSION SHALL BE REPLACED WITH NEW REINFORCING STEEL.

EXISTING STRUCTURE VERIFICATION: DETAILS AND DIMENSIONS SHOWN ON THESE PLANS PERTAINING TO THE EXISTING STRUCTURE HAVE BEEN OBTAINED FROM PLANS OF THE EXISTING STRUCTURE AND/OR FROM FIELD OBSERVATIONS AND MEASUREMENTS. CONSEQUENTLY, THEY ARE INDICATIVE OF THE EXISTING STRUCTURE AND THE PROPOSED WORK BUT THEY SHALL BE CONSIDERED TENTATIVE AND APPROXIMATE. THE CONTRACTOR IS REFERRED TO CMS SECTIONS 102.05 AND 105.02.

CONTRACT BID PRICES SHALL BE BASED UPON A RECOGNITION OF THE UNCERTAINTIES DESCRIBED ABOVE AND UPON A PREBID EXAMINATION OF THE EXISTING STRUCTURE BY THE CONTRACTOR. HOWEVER, ALL PROJECT WORK SHALL BE BASED UPON ACTUAL DETAILS AND DIMENSIONS WHICH HAVE BEEN VERIFIED BY THE CONTRACTOR IN THE FIELD.

EXISTING STRUCTURE PLANS:

THE ORIGINAL DESIGN PLANS MAY BE EXAMINED AT THE DEPARTMENT OF TRANSPORTATION, DISTRICT 8 OFFICE, 505 SOUTH S.R. 741 LEBANON, OHIO 45036 (800) 831-2142. THE CONTRACTOR SHALL BECOME FAMILIAR WITH THESE DRAWINGS.

ITEM 846 - TREATING CONCRETE WITH HMWM RESIN

SEAL THE CONSTRUCTION JOINT IN THE BRIDGE DECK AND APPROACH SLABS AS SHOWN IN THE PLANS. SEE SUPPLEMENTAL SPECIFICATIONS FOR SURFACE PREPARATION AND RATE OF APPLICATION.


REF: **REF**
REF: **REF**
USER: **NAME**
DATE: **DATE**
PROJECT: **PROJECT**
ACTIVE LEVELS ON: **LEVELS**

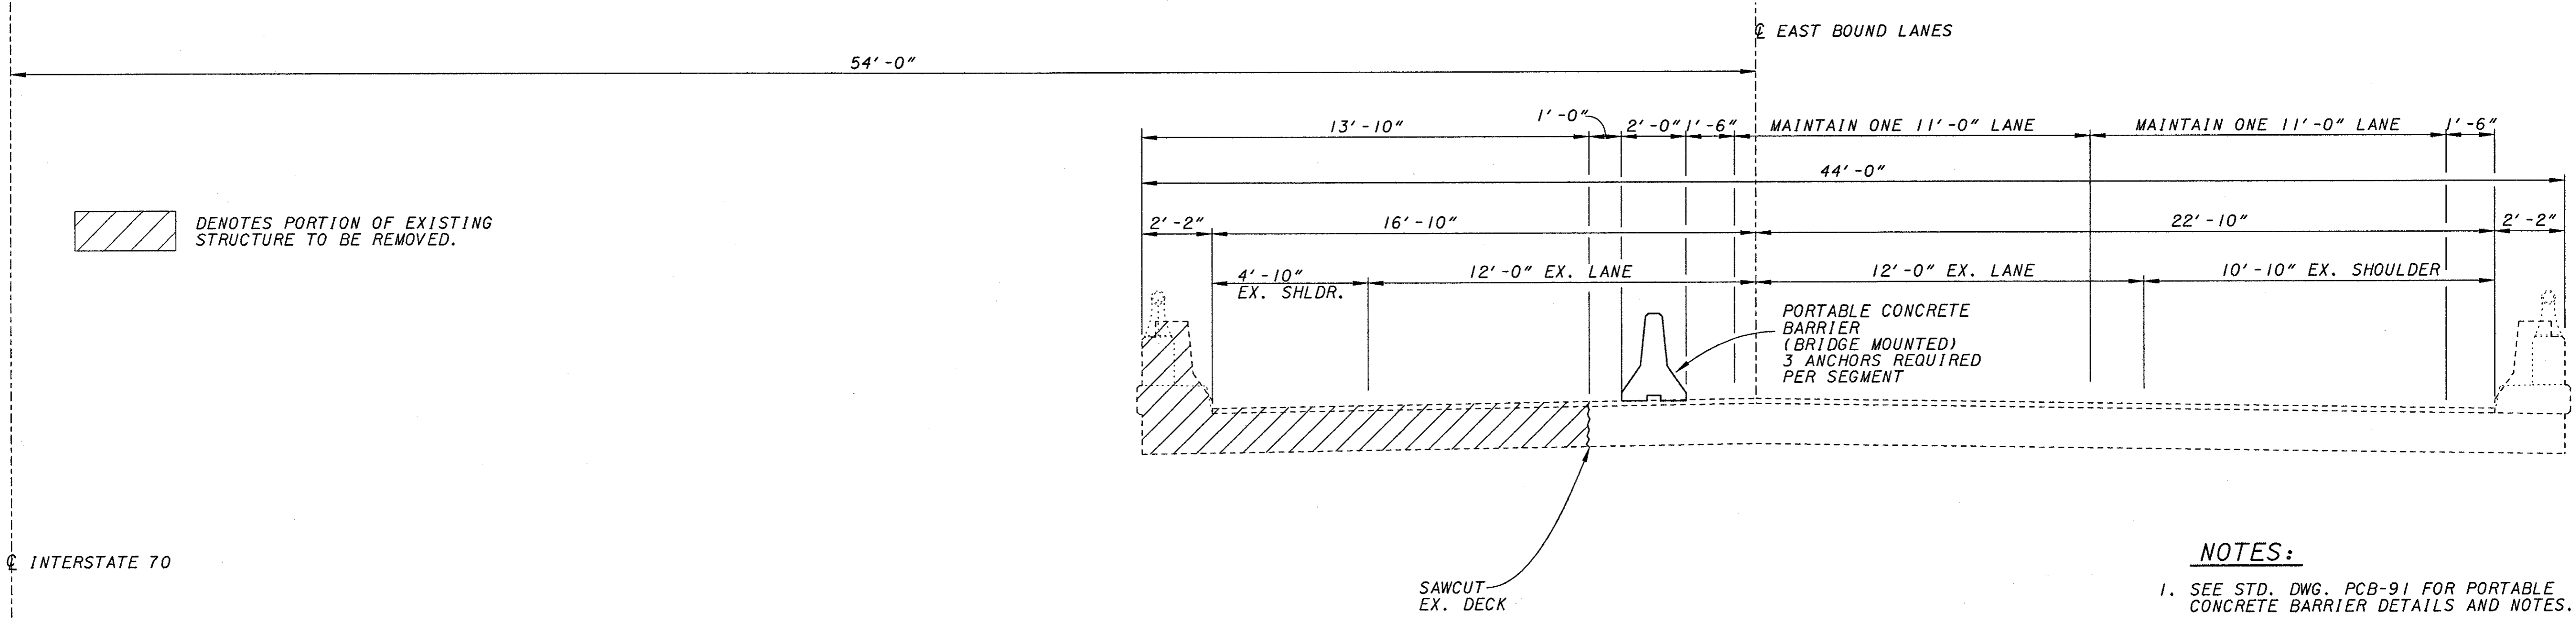

- NOTES:**
- 1. SEE STD. DWG. PCB-91 FOR PORTABLE CONCRETE BARRIER DETAILS AND NOTES.
 - 2. EASTBOUND BRIDGE SHOWN WESTBOUND BRIDGE SIMILAR.

STAGE IA

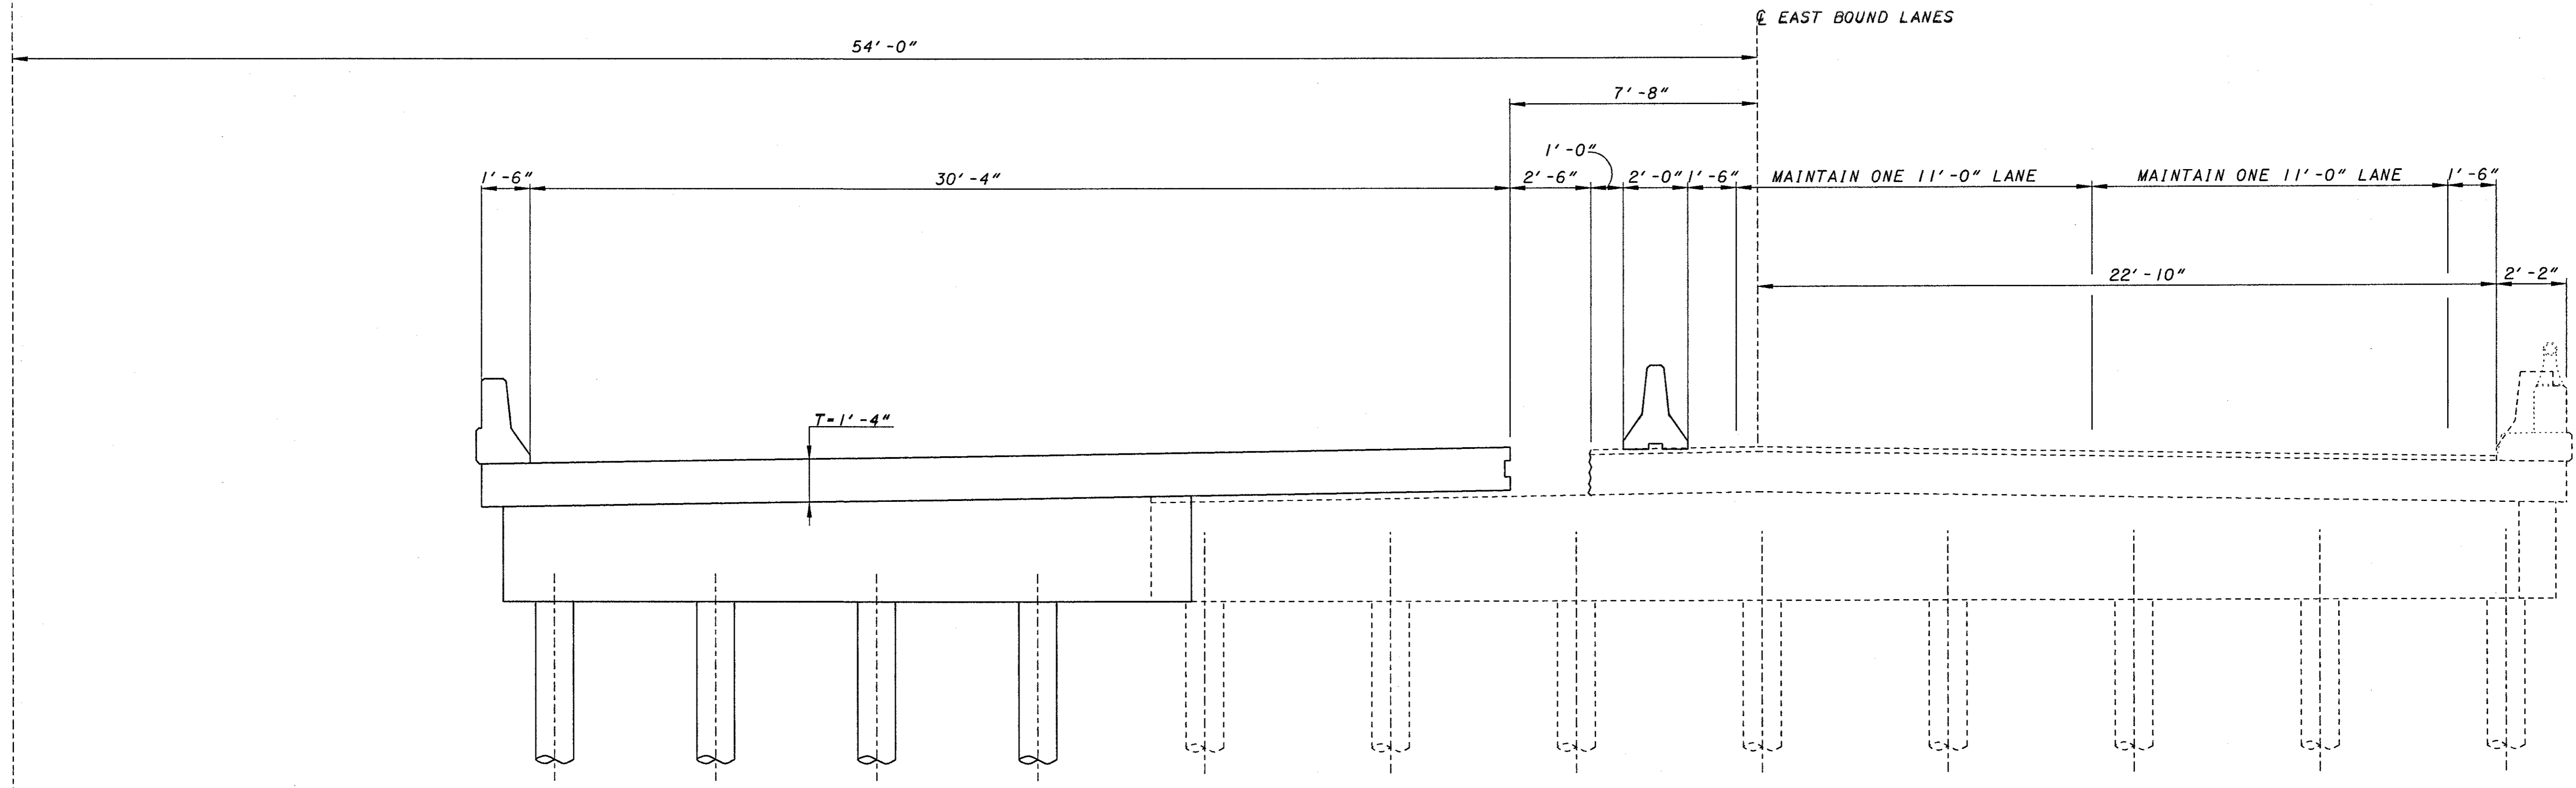

STAGE IB


REF: **REF1**
REF: **REF2**
REF: **REF3**
REF: **REF4**
REF: **REF5**
REF: **REF6**

REF: **REF1**
REF: **REF2**
REF: **REF3**
REF: **REF4**
REF: **REF5**
REF: **REF6**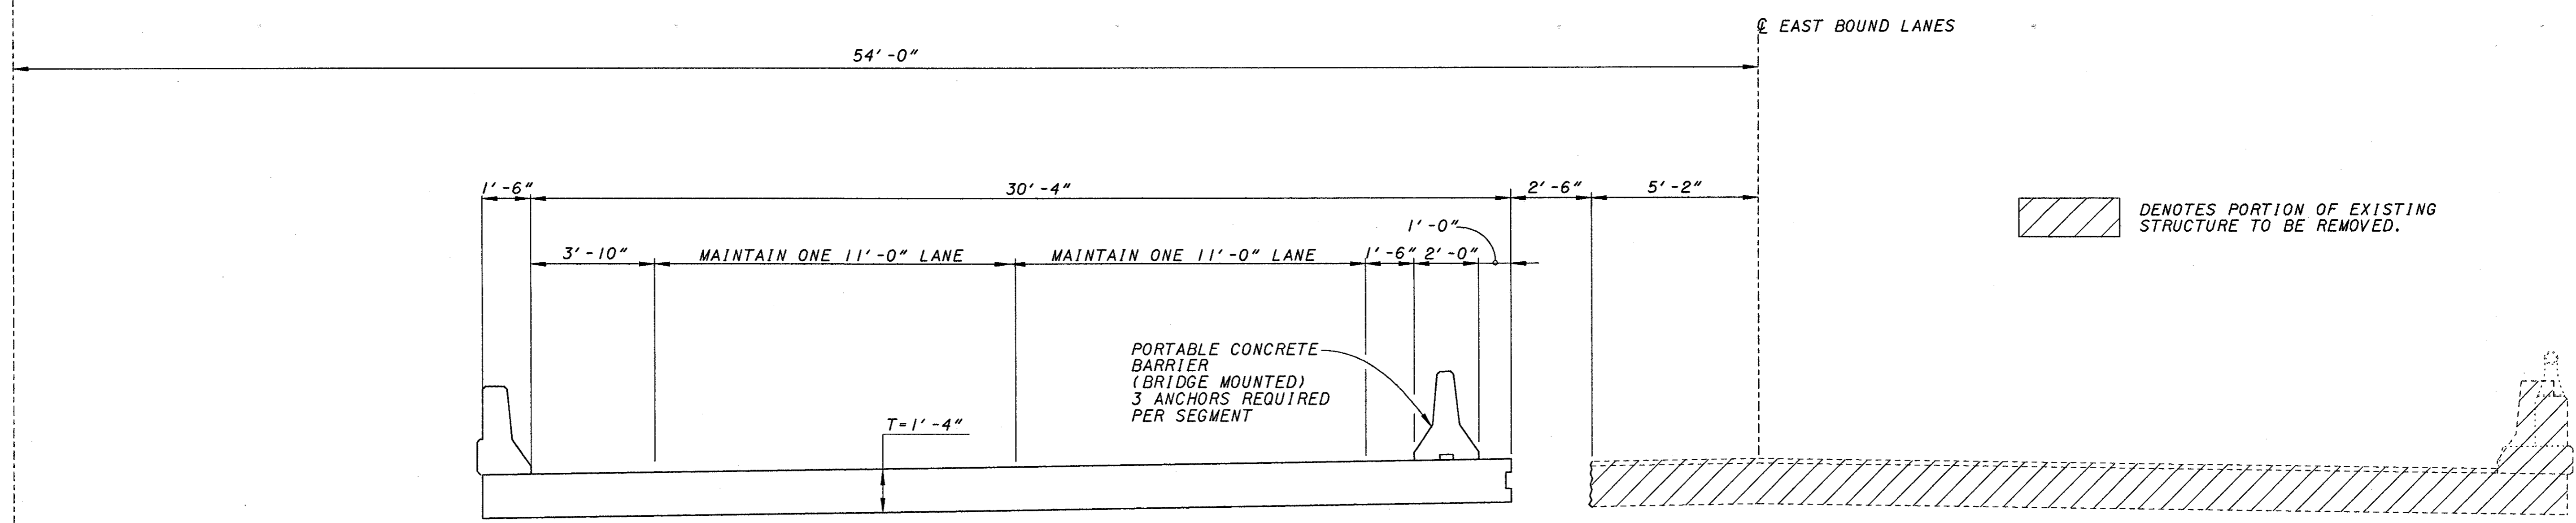

 DENOTES PORTION OF EXISTING STRUCTURE TO BE REMOVED.



INTERSTATE 70

STAGE 2A

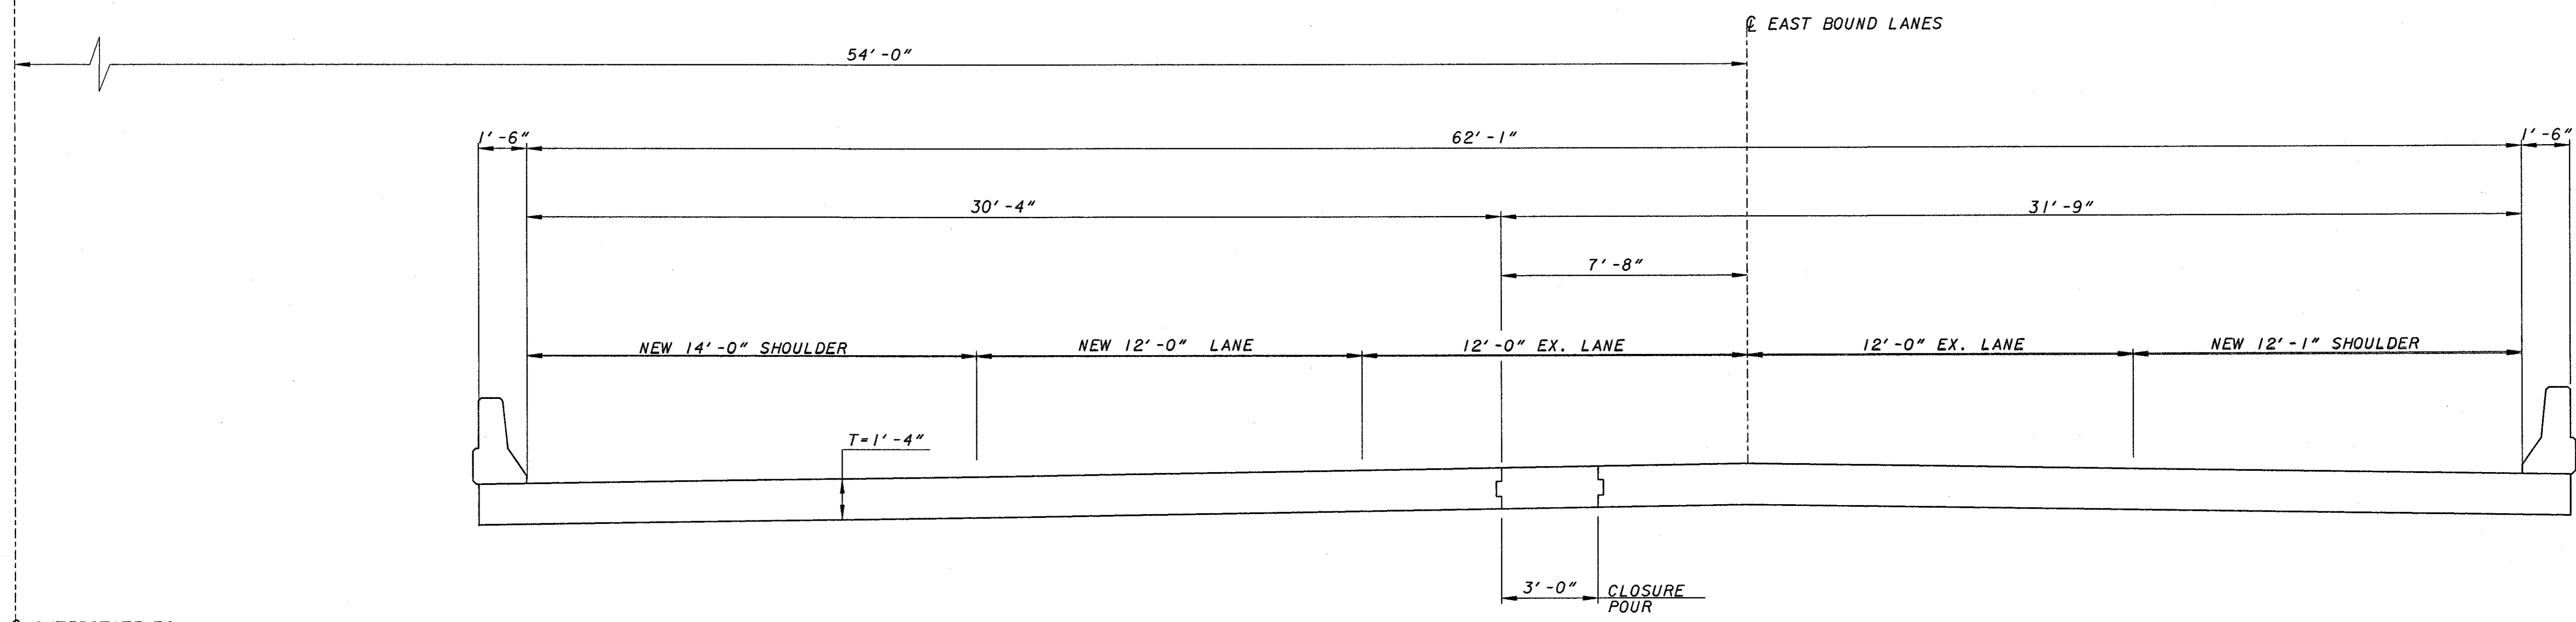


INTERSTATE 70

STAGE 2B

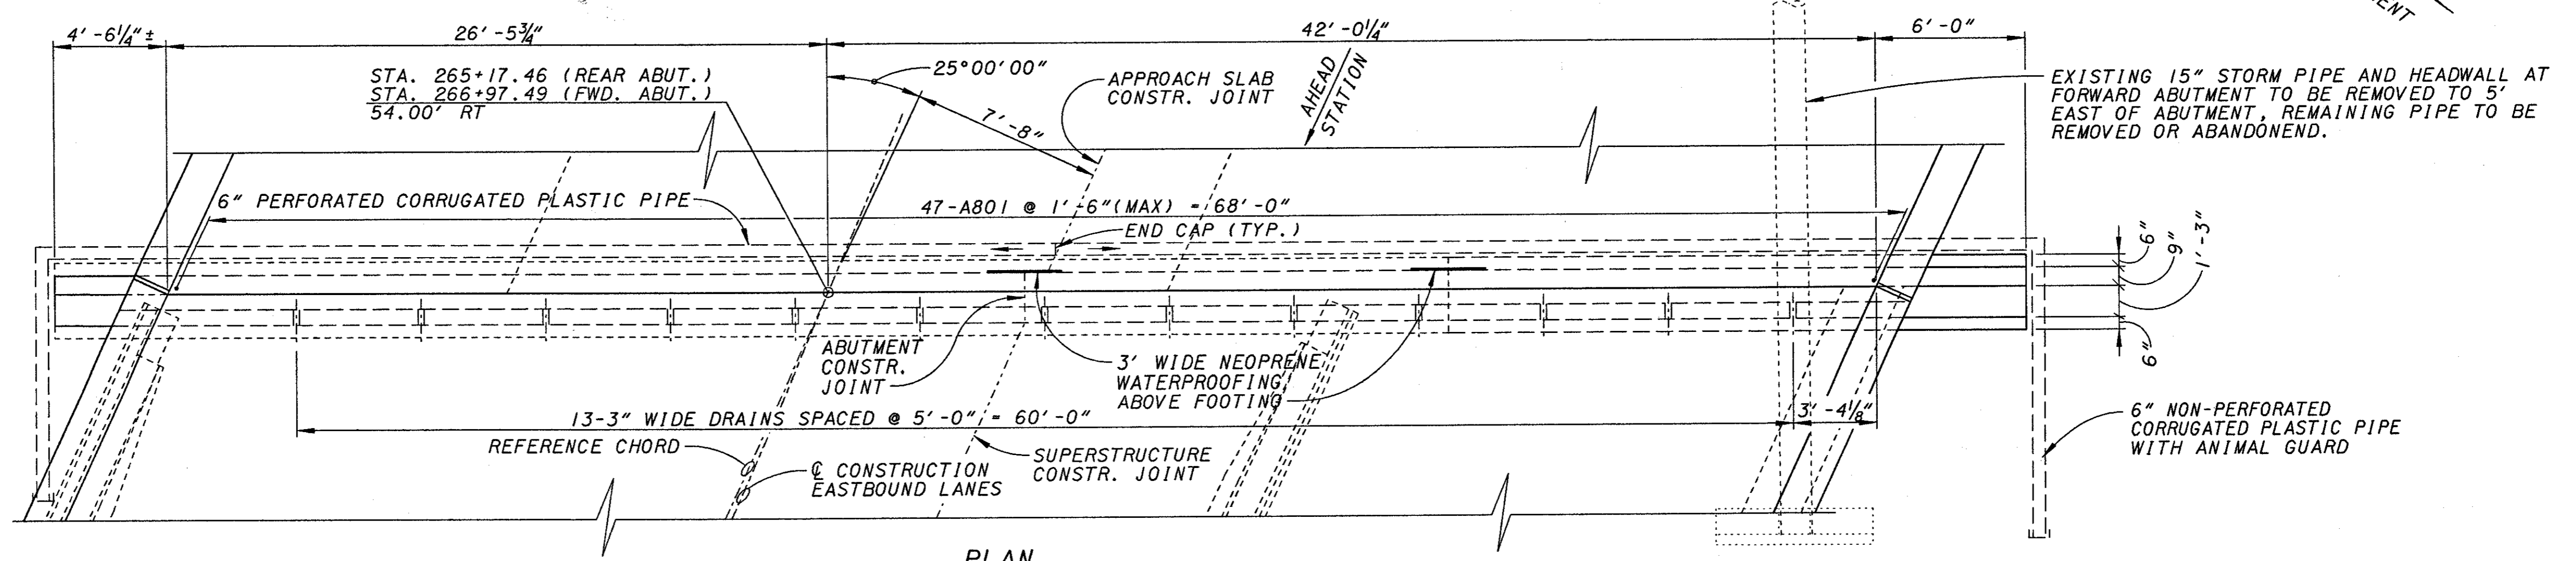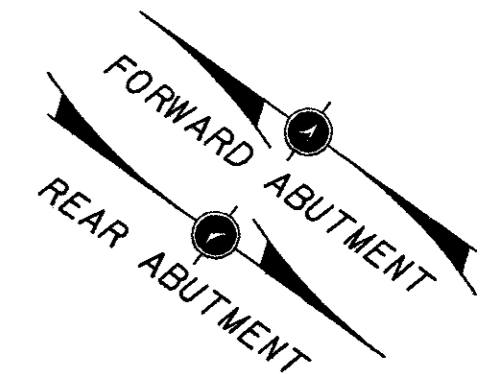

PLAN
REAR ABUTMENT SHOWN,
FORWARD ABUTMENT OPPOSITE HAND

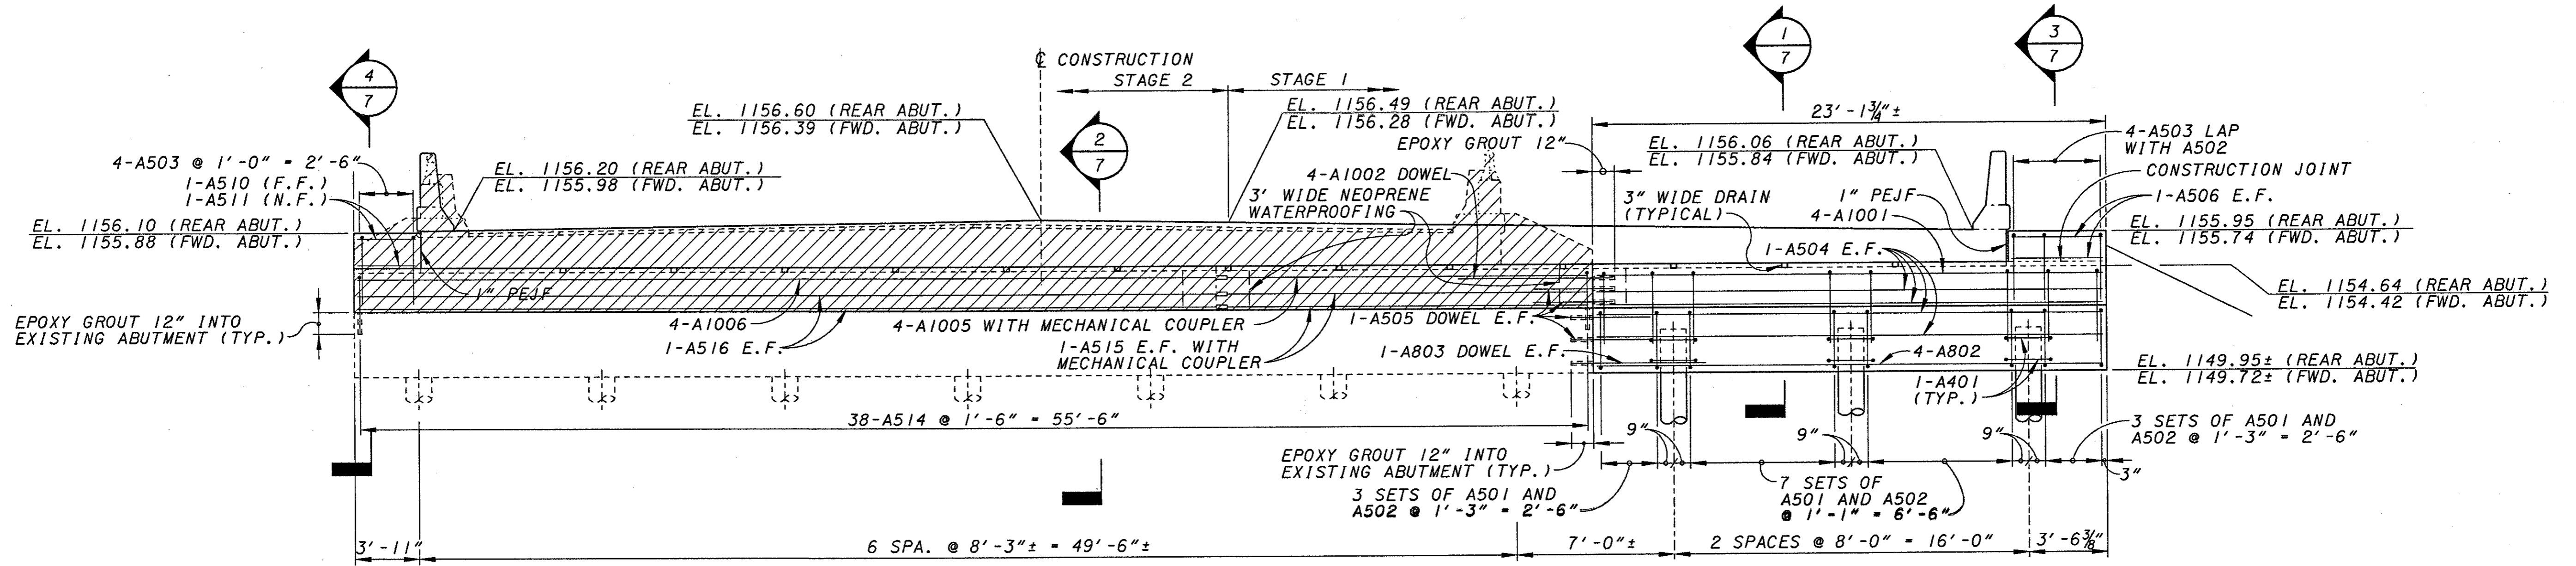

ELEVATION

DENOTES PORTION OF EXISTING STRUCTURE TO BE REMOVED

- LEGEND**
- PEJF - PREFORMED EXPANSION JOINT FILLER
 - E.F. - EACH FACE
 - N.F. - NEAR FACE
 - F.F. - FAR FACE


REF: **REF**
REF: **REF**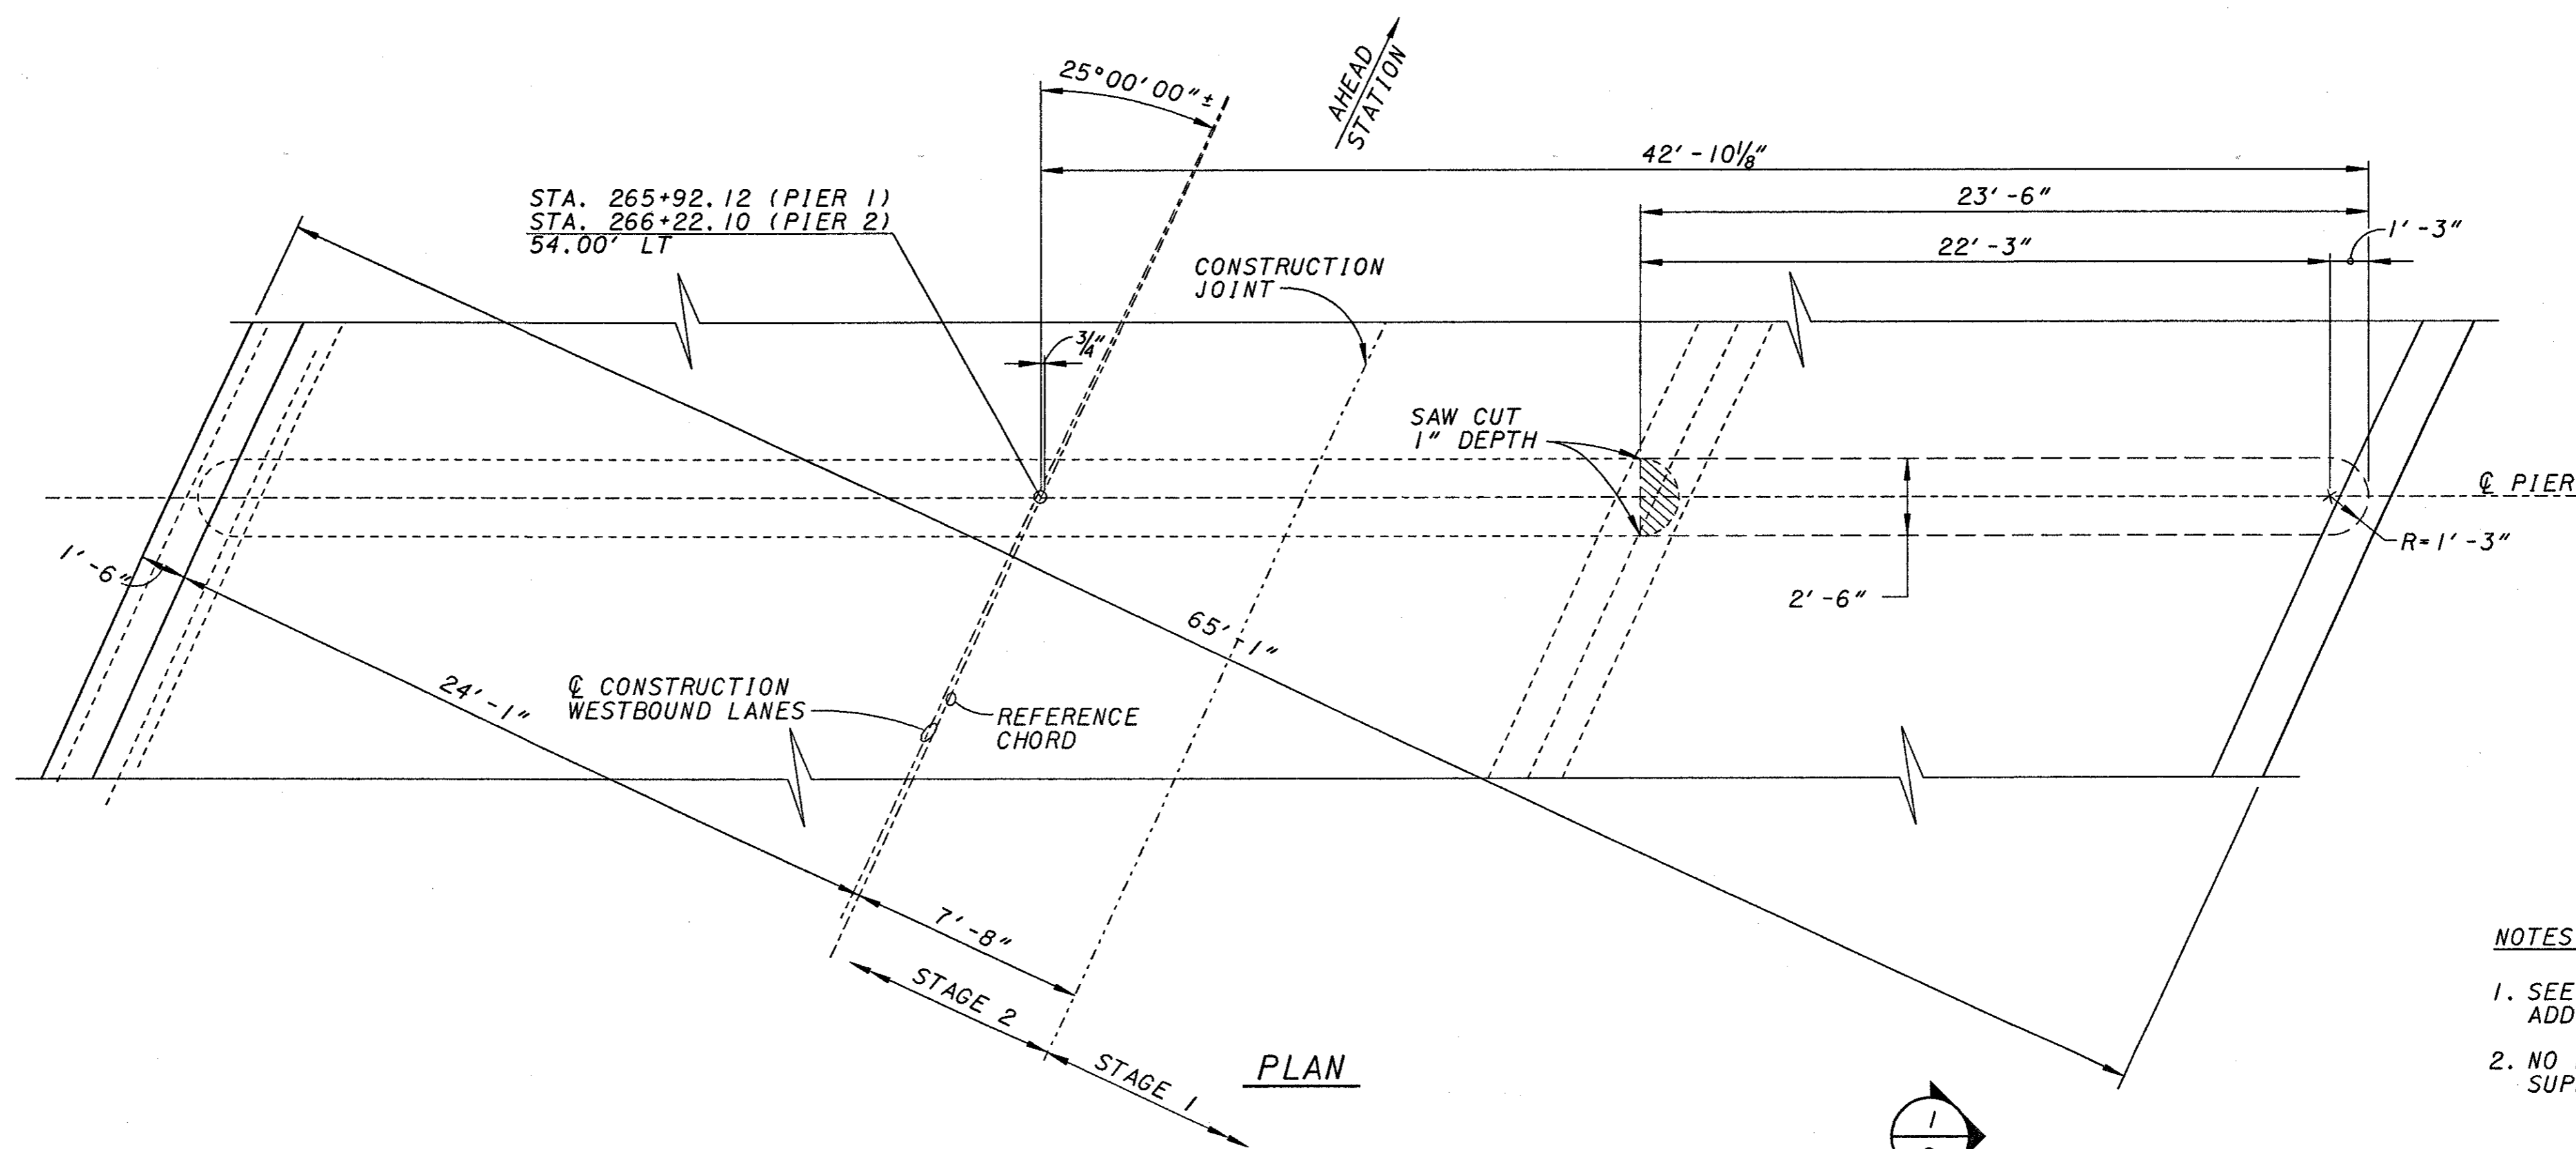
- NOTES:
1. SEE STD. DRAWING CPP-2-94 FOR ADDITIONAL NOTES AND DETAILS
 2. NO FALSEWORK SHALL BE SUPPORTED FROM THE PIER CAP.

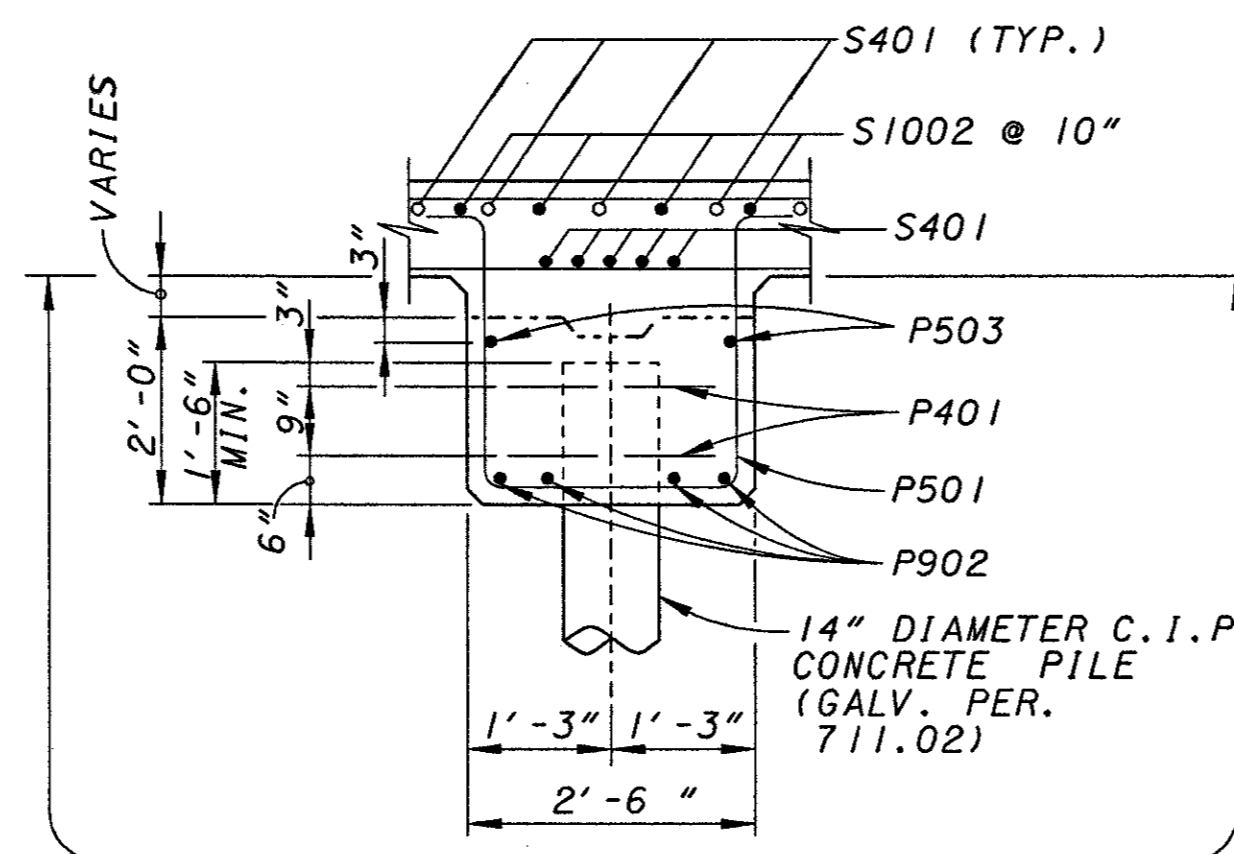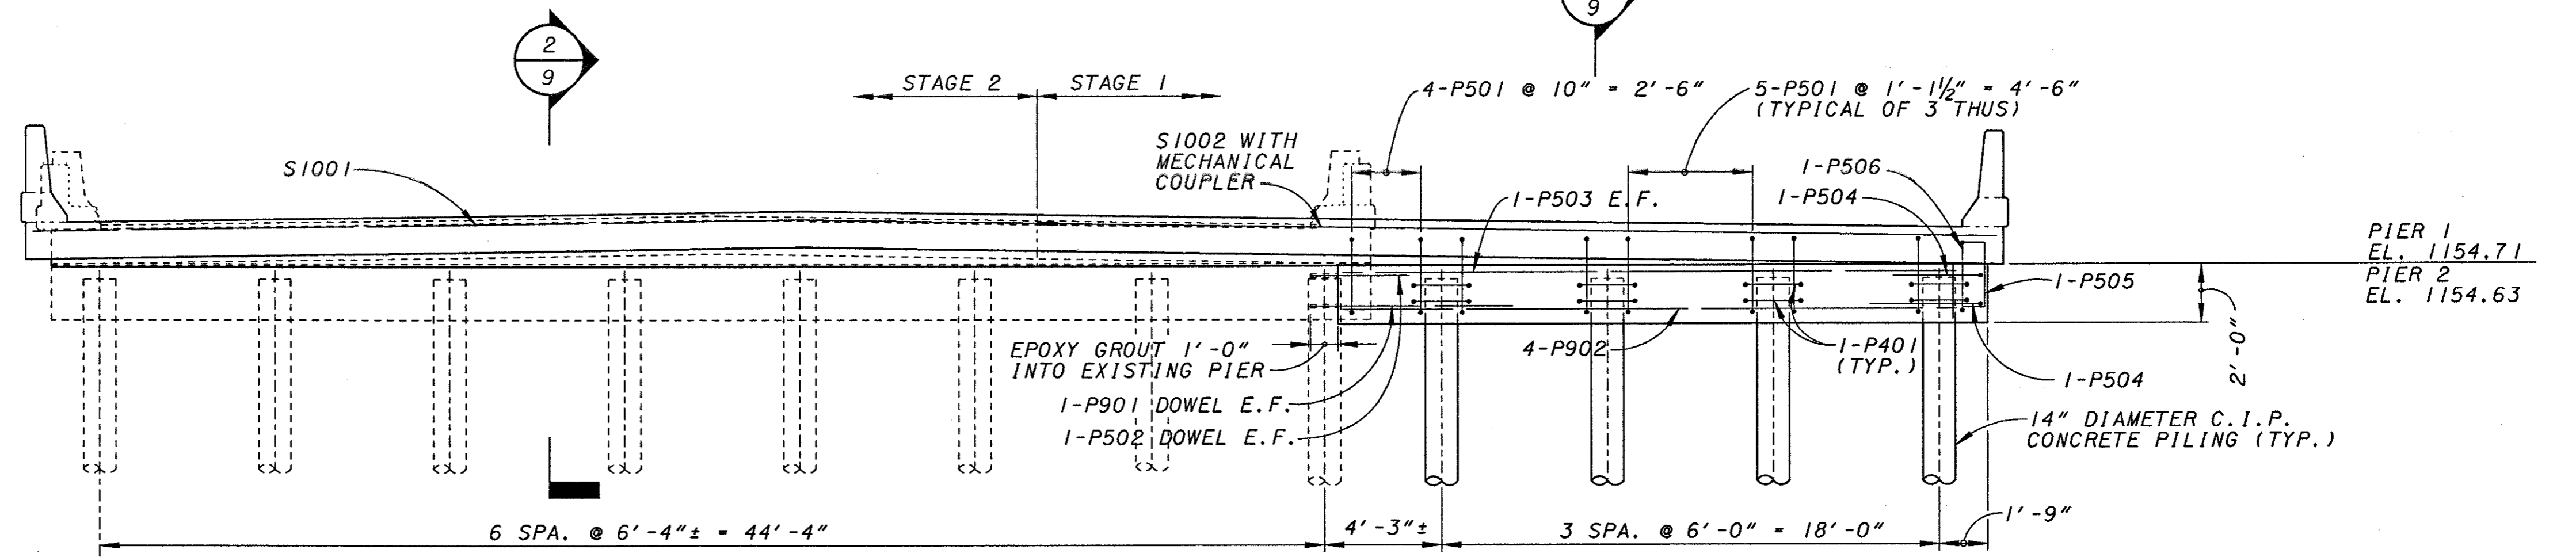


SECTION 1-1 (PROPOSED)

1 1

9 10

SEAL ALL EXPOSED CONCRETE SURFACES (EPOXY - URETHANE)

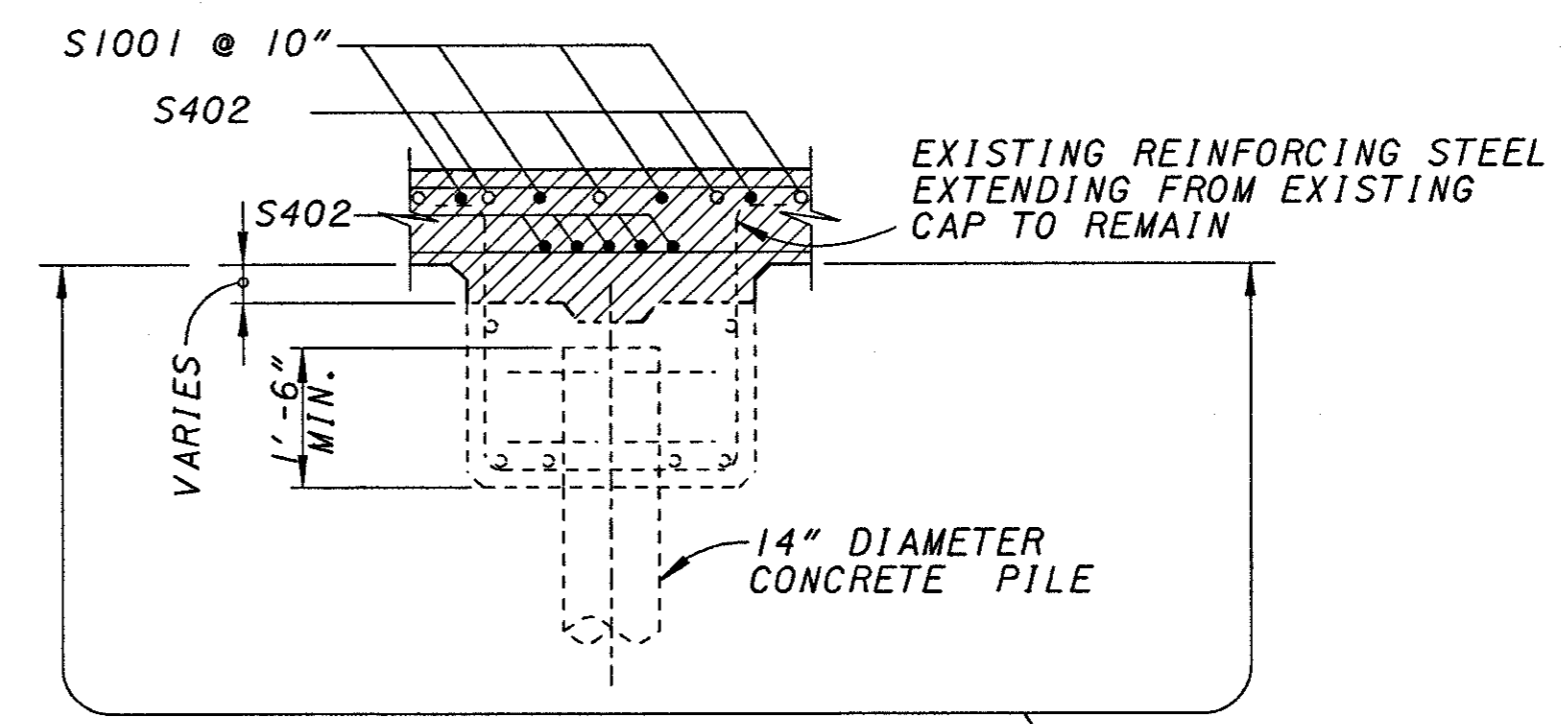

SECTION 2-2 (EXISTING)

2 2

9 10

SEAL ALL EXPOSED CONCRETE SURFACES (EPOXY - URETHANE)

▨ DENOTES REMOVAL LIMITS



REF: **REF**

REF: **REF**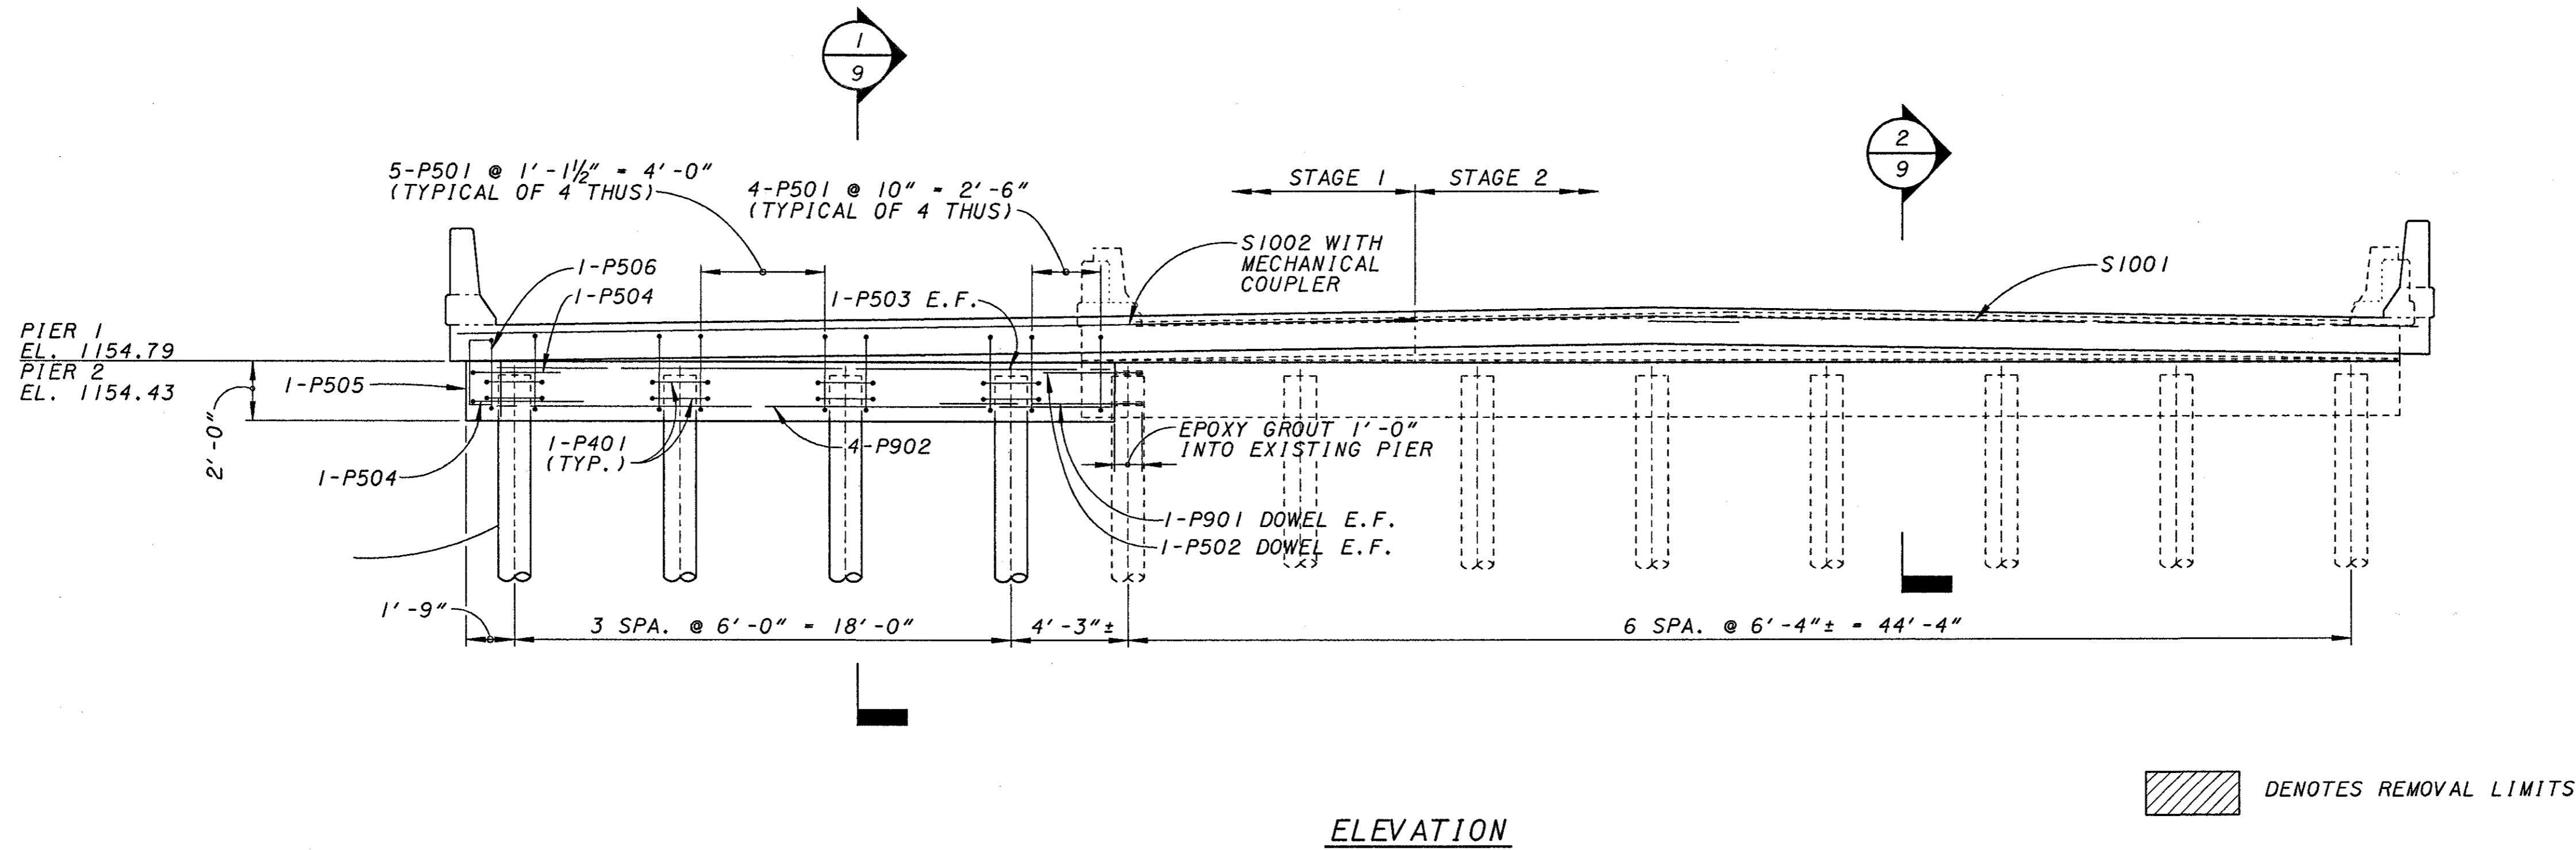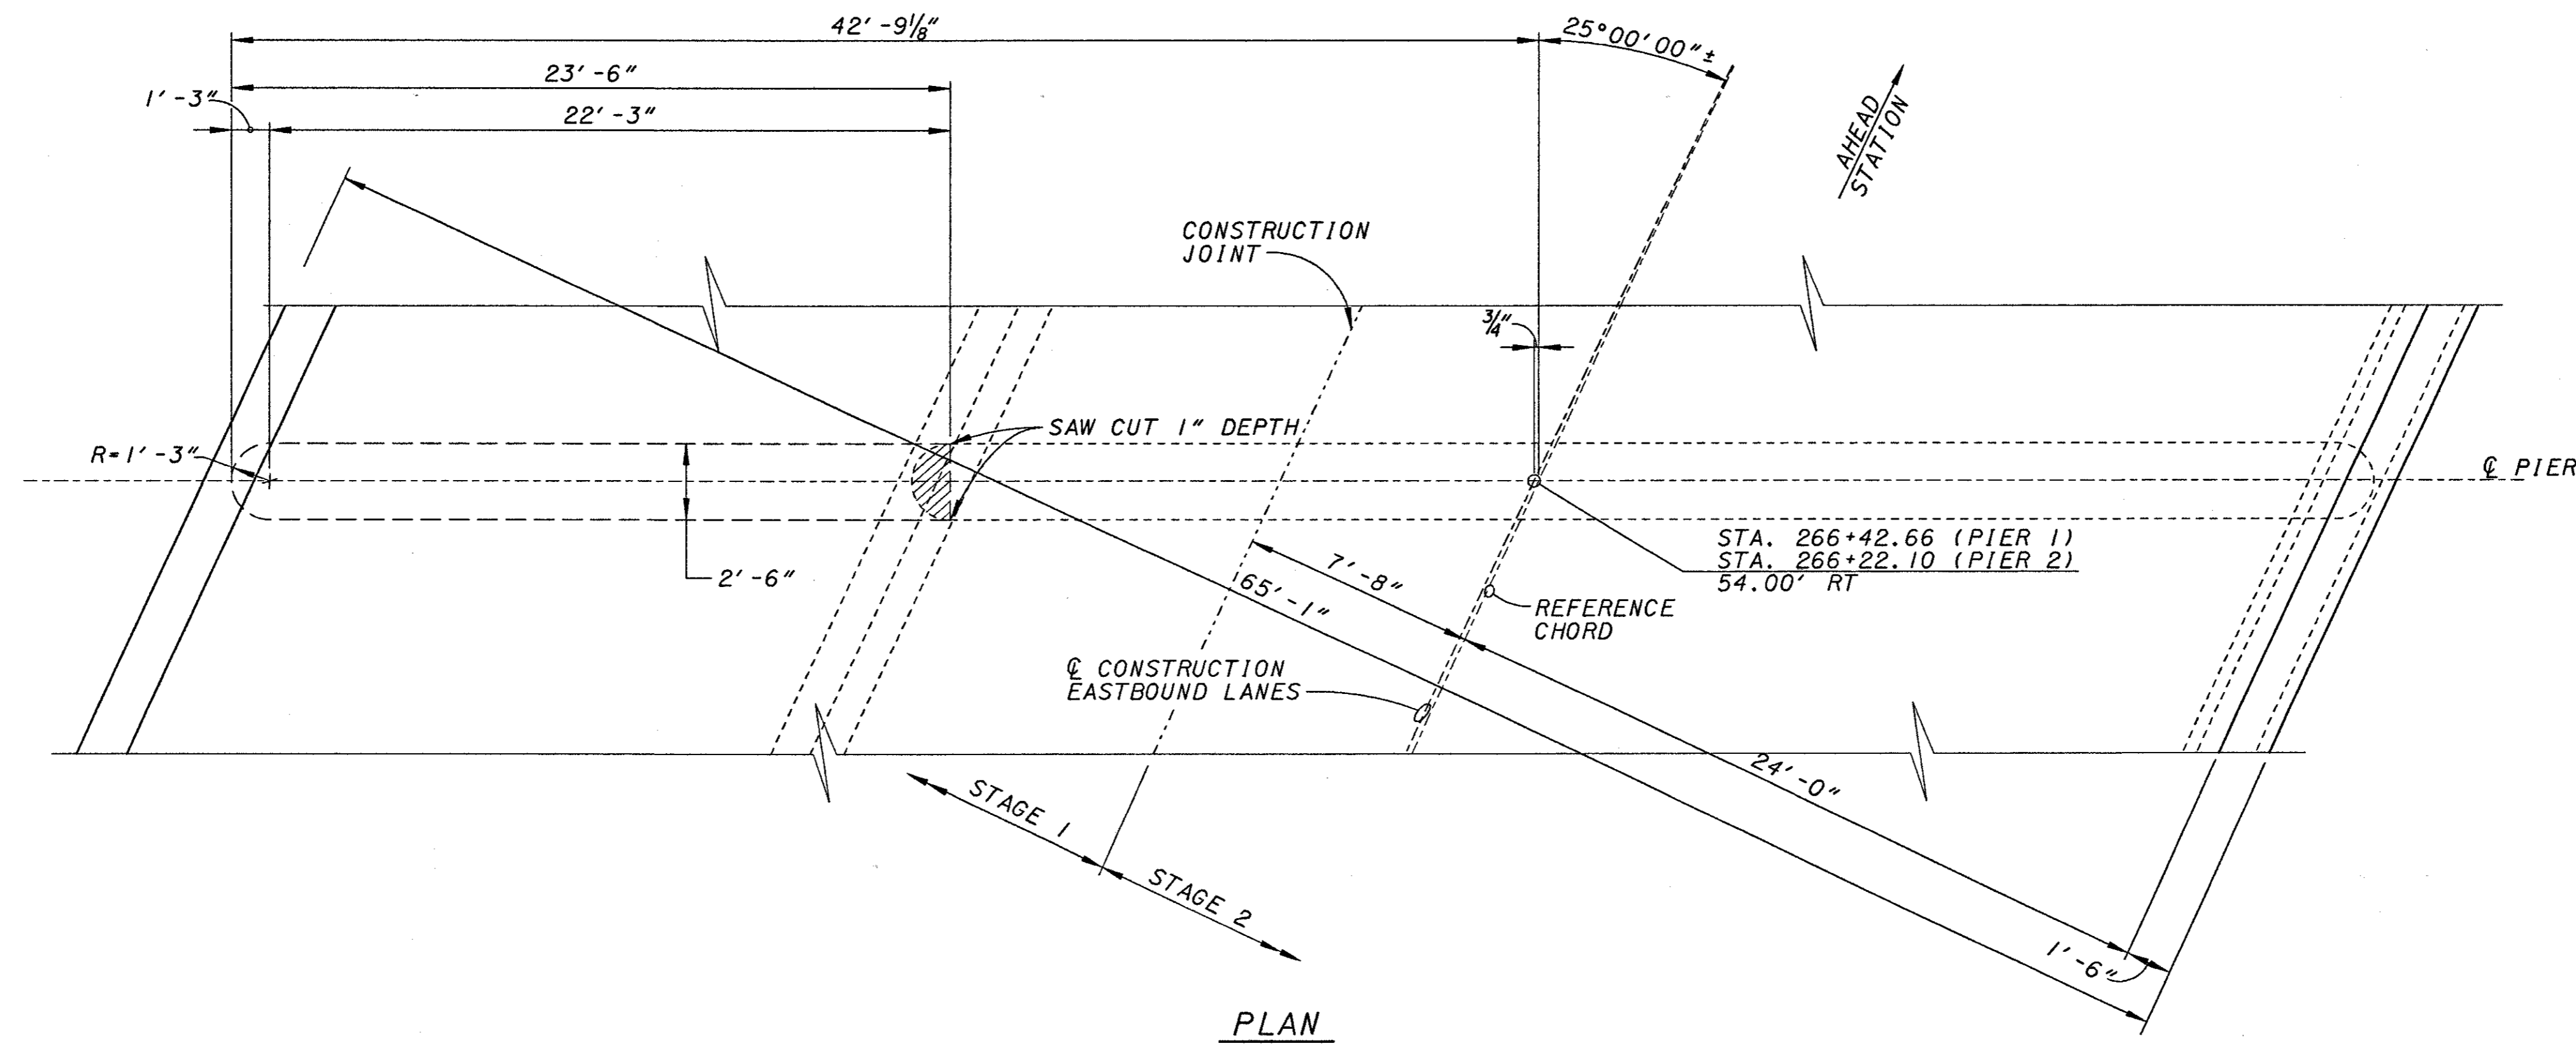

REF: **REF1**
REF: **REF2**
REF: **REF3**
REF: **REF4**
REF: **REF5**
REF: **REF6**

REF: **REF7**
REF: **REF8**
REF: **REF9**
REF: **REF10**
REF: **REF11**
REF: **REF12**

REF: **REF13**
REF: **REF14**
REF: **REF15**
REF: **REF16**
REF: **REF17**
REF: **REF18**



REF: **REF19**
REF: **REF20**
REF: **REF21**
REF: **REF22**
REF: **REF23**
REF: **REF24**

BASE: S:\PROJECTS\BRIDGE\BRIDGE PRE-70-0504\ACTIVE LEVELS ON: **LEVEL**

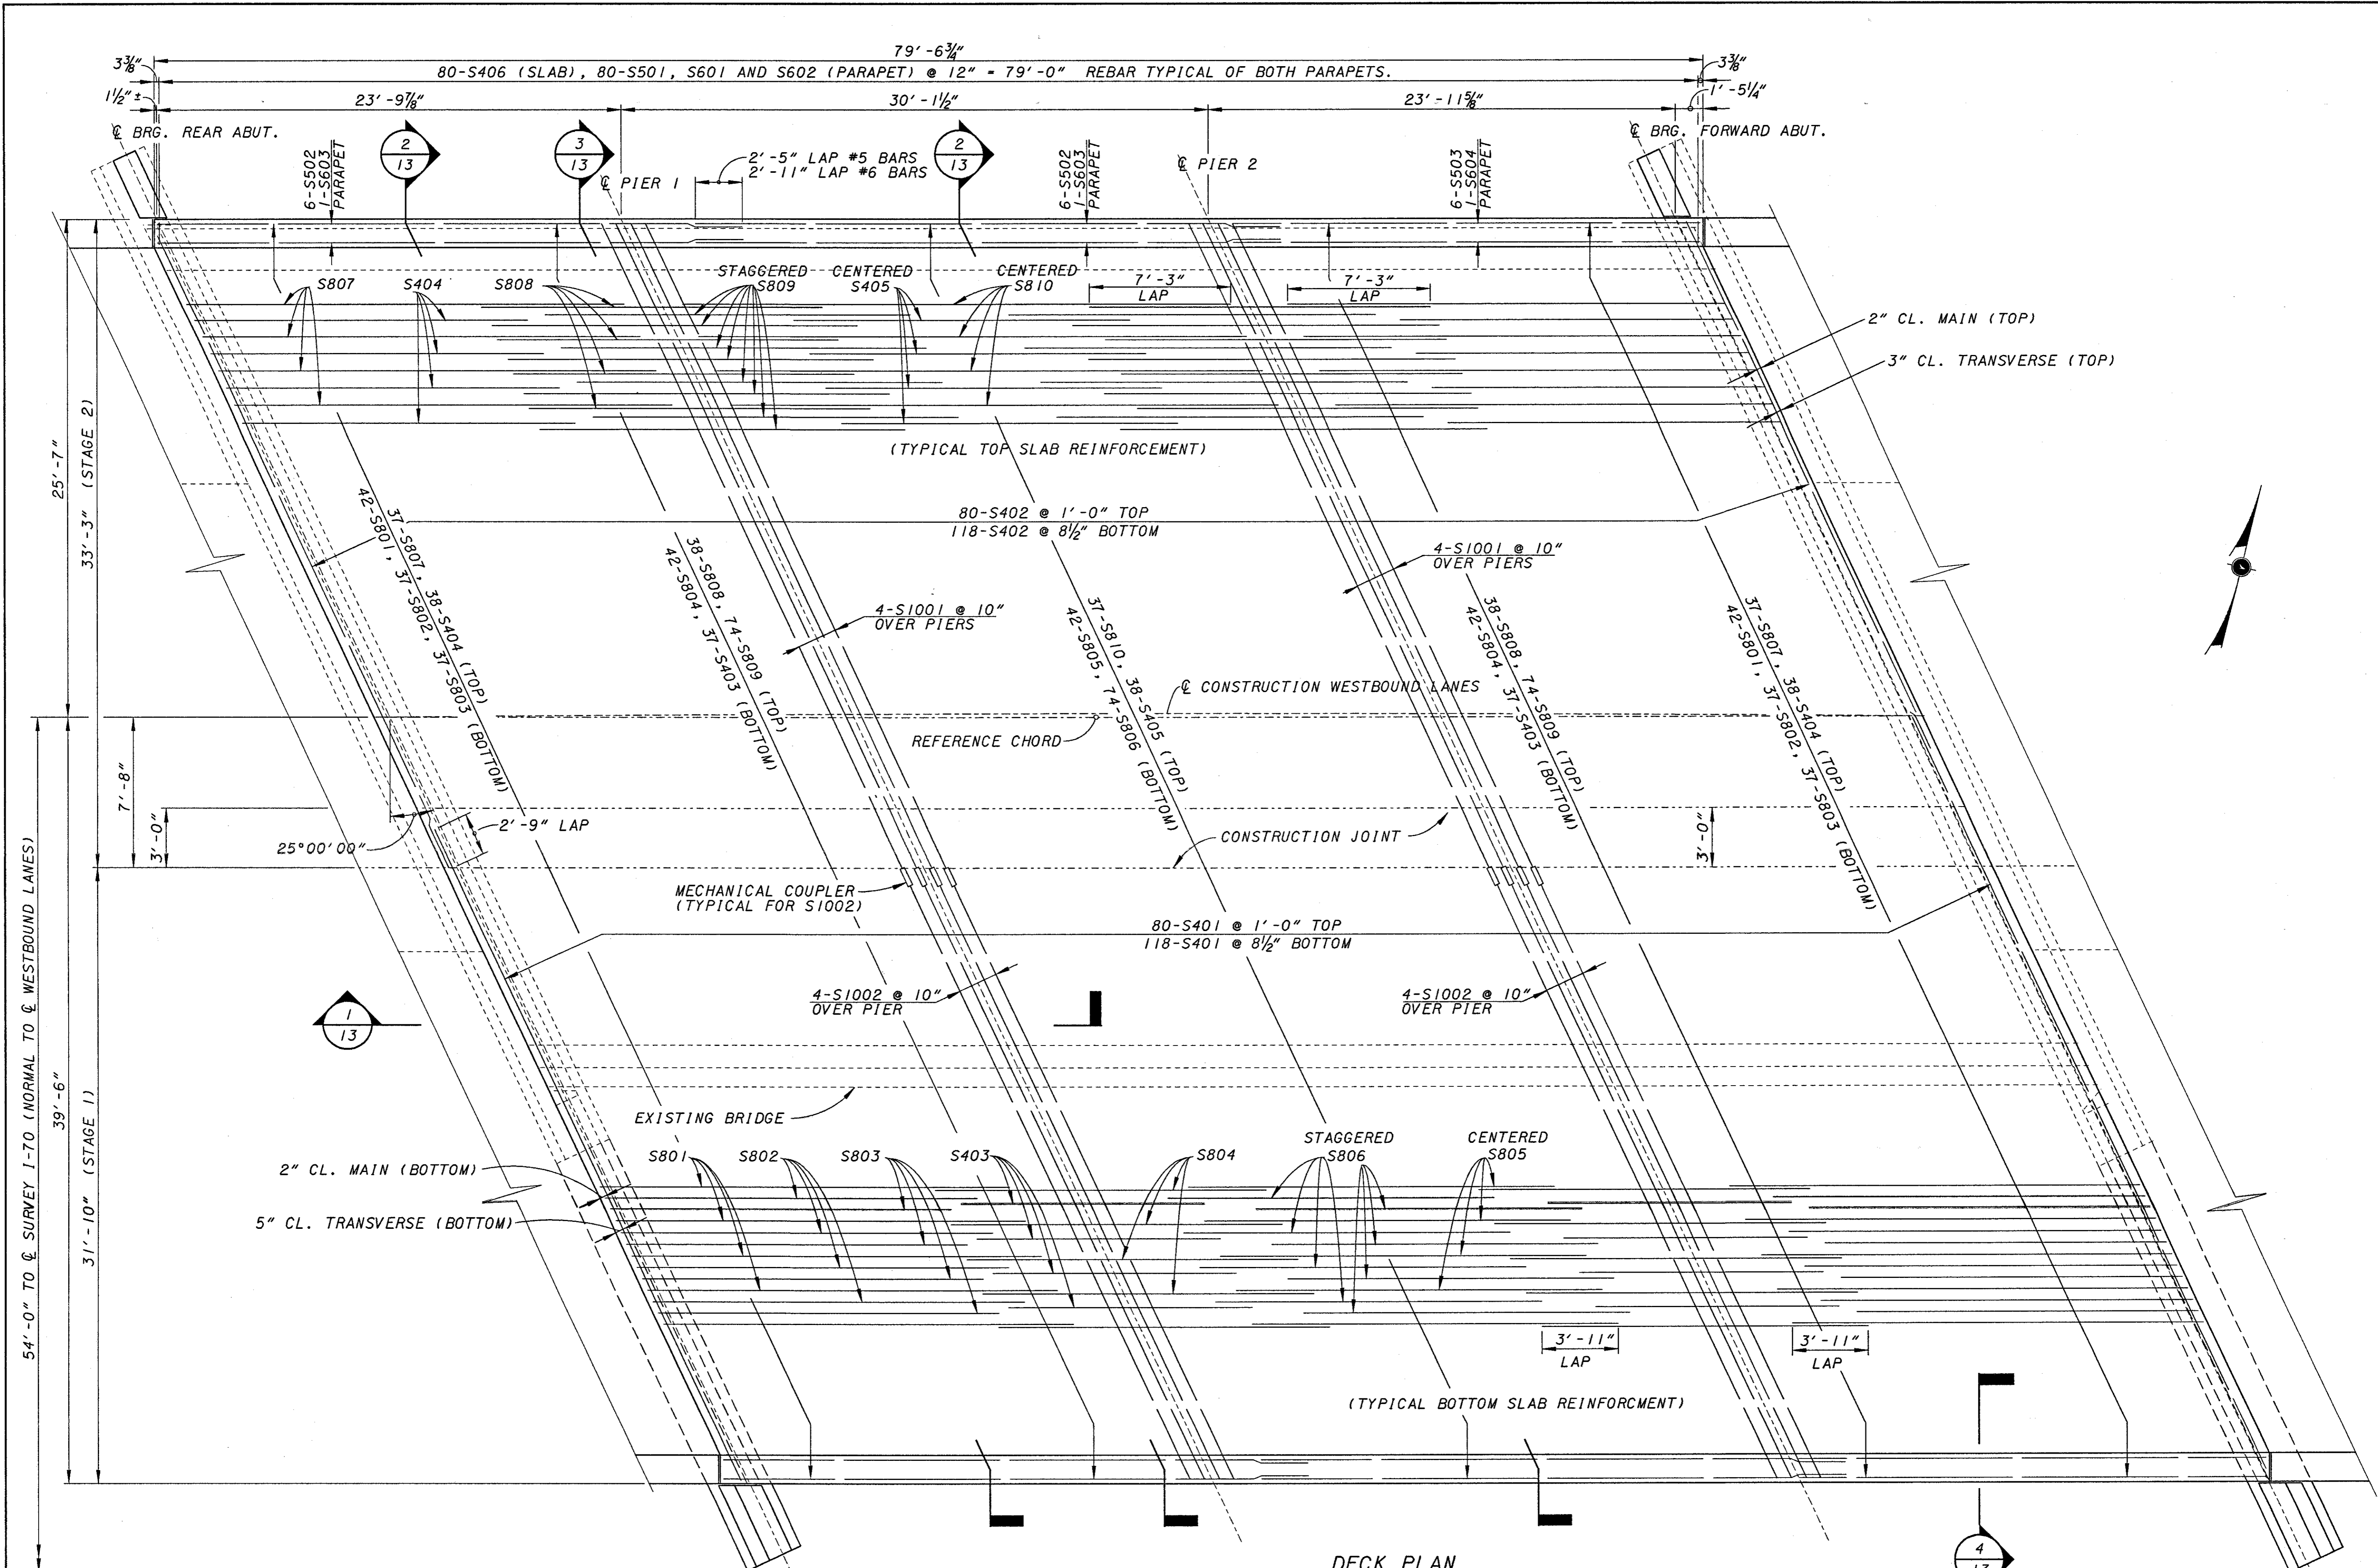


DECK PLAN


REFS: *REF01** *REF02** *REF03** *REF229** *REF230

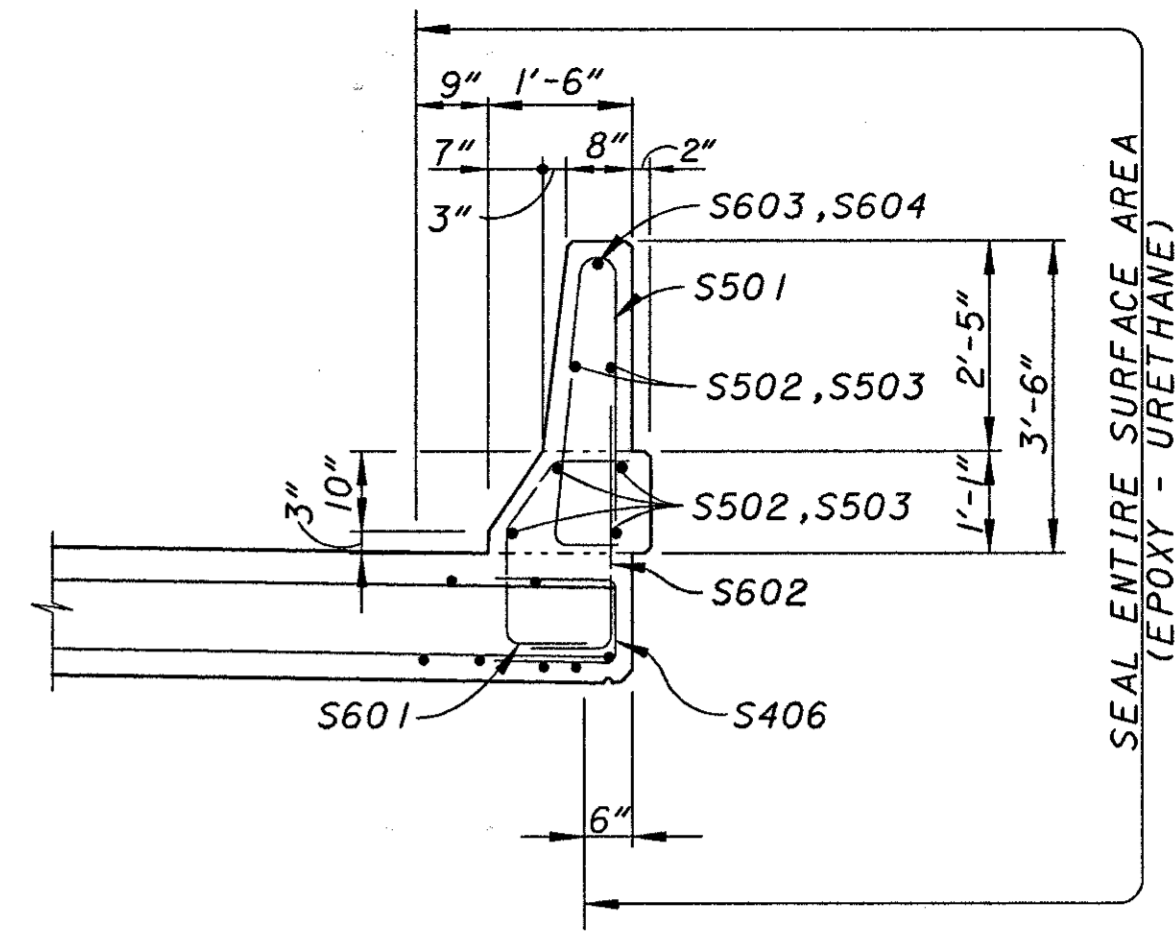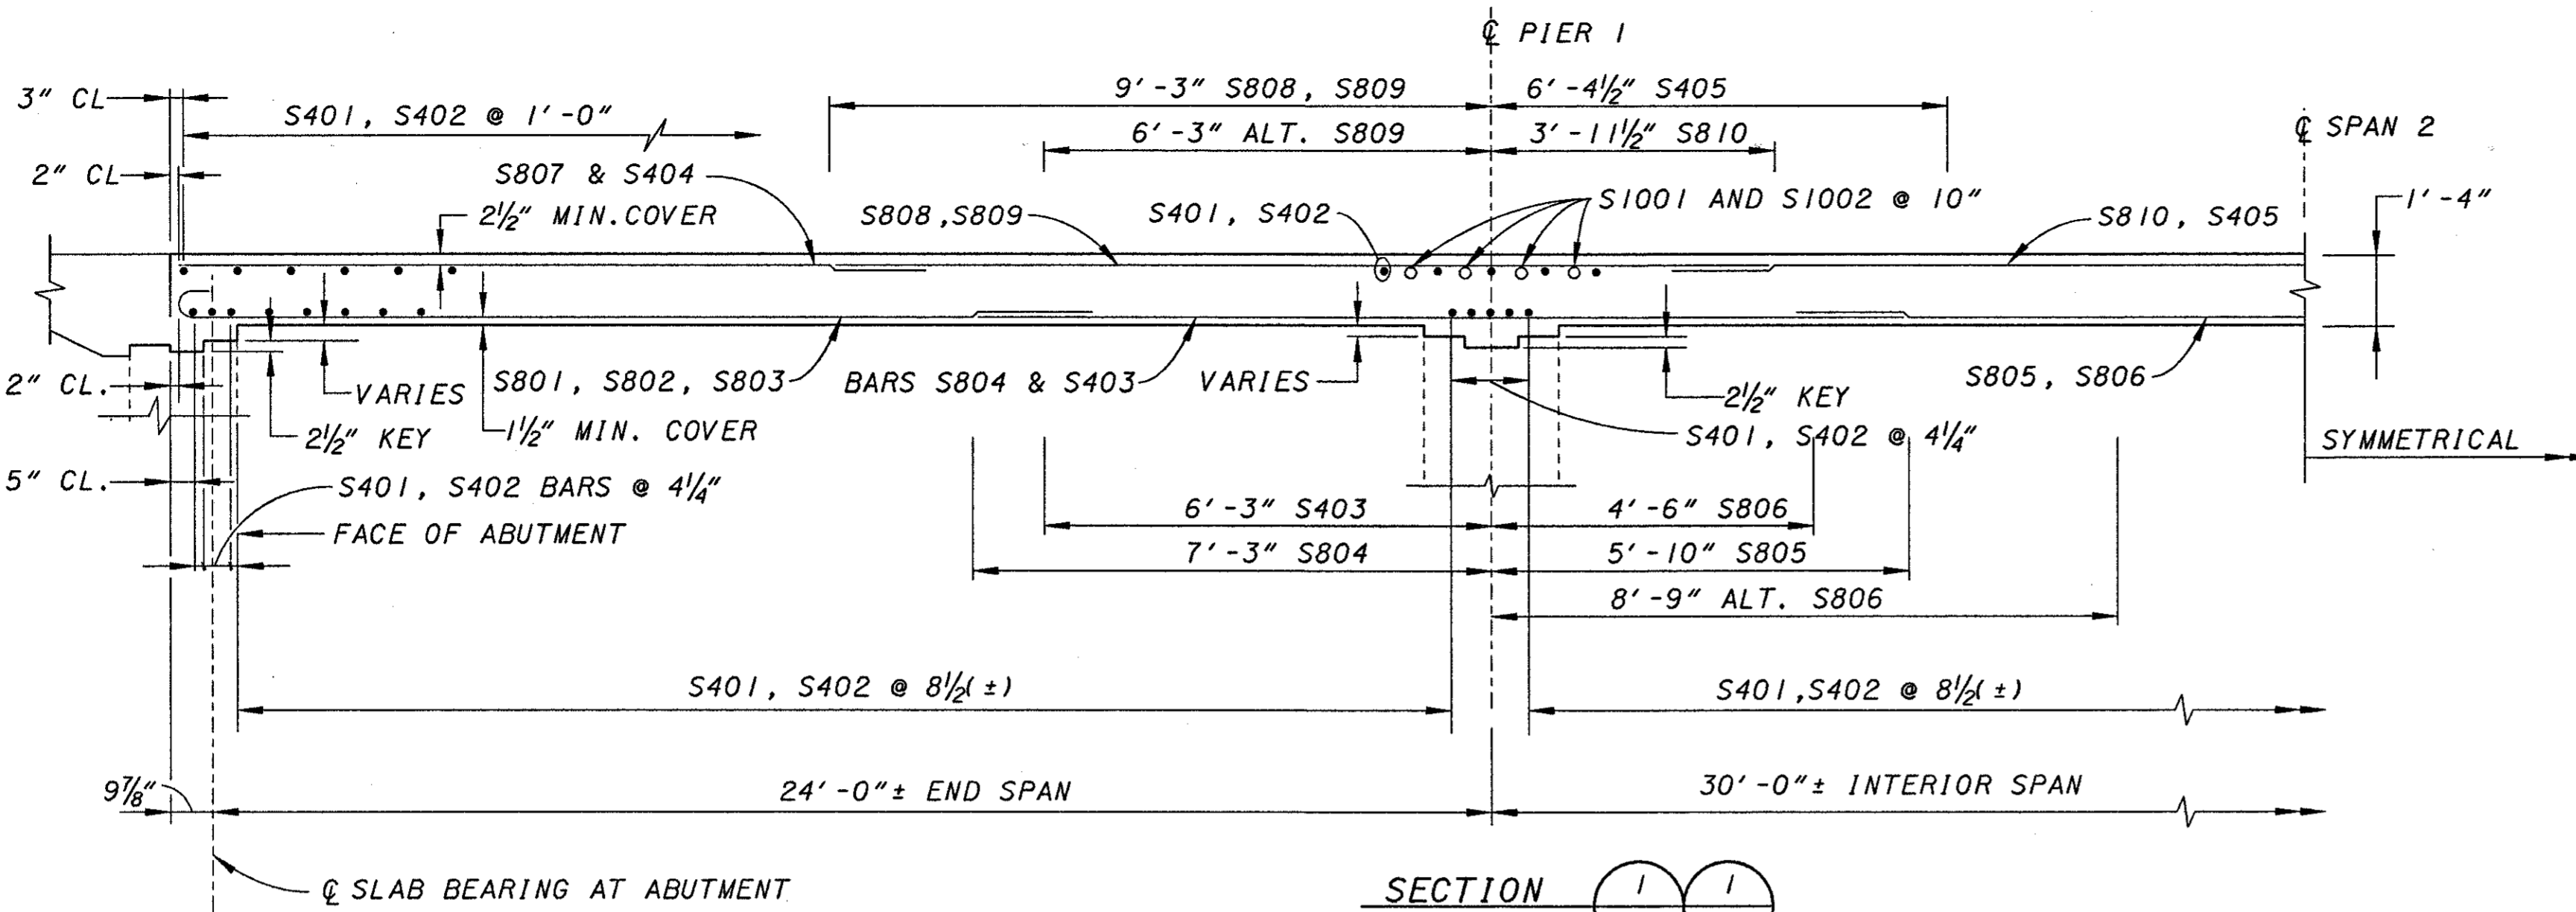

NOTE:
FALSEWORK FOR THE CONCRETE SLAB CONSTRUCTION STAGES SHALL BE INDEPENDENT OF EACH OTHER.

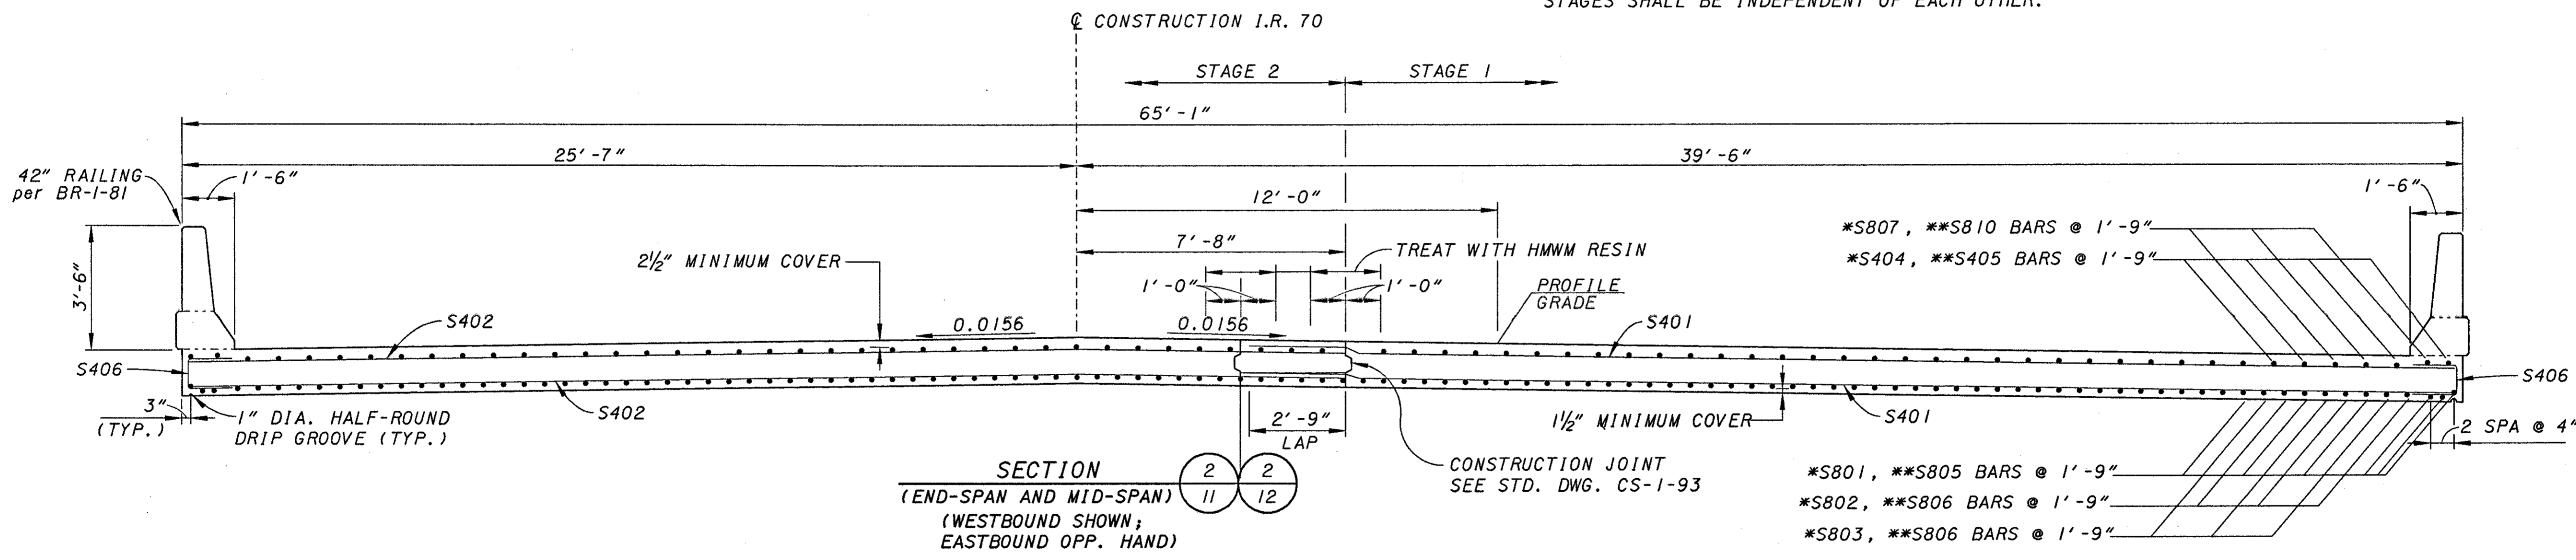

* INDICATES END SPAN
** INDICATES MID SPAN

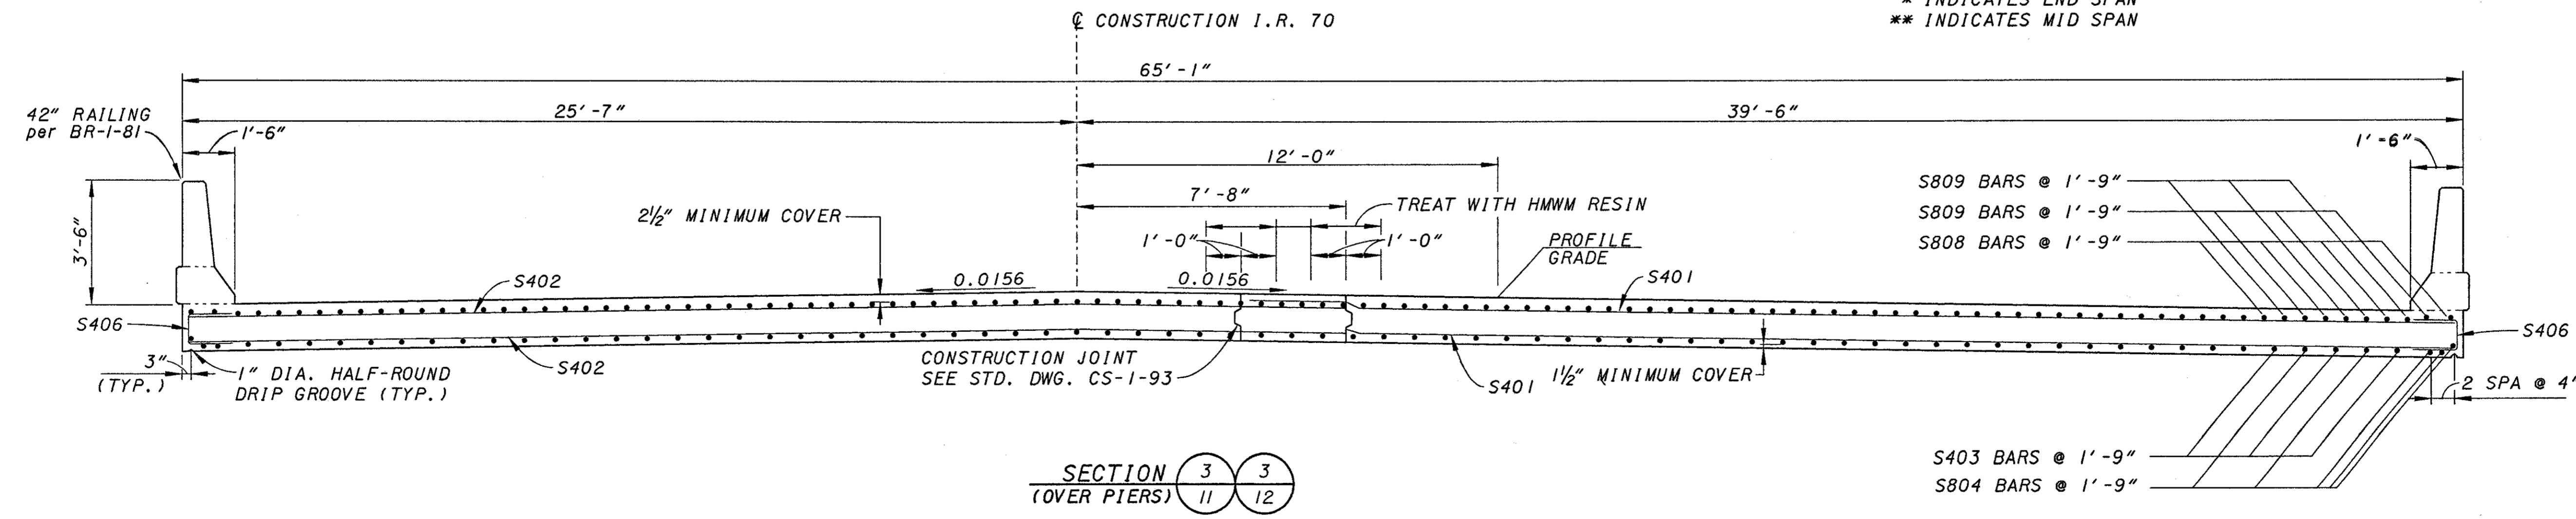

NOTE:
FALSEWORK FOR THE CONCRETE SLAB CONSTRUCTION STAGES SHALL BE INDEPENDENT OF EACH OTHER.

REVISIONS:
 1. REVISION NUMBER
 2. DATE
 3. DESCRIPTION
 4. BY
 5. CHECKED
 6. APPROVED
 7. SCALE
 8. SHEET NUMBER
 9. TOTAL SHEETS
 10. PROJECT NUMBER
 11. PROJECT NAME
 12. DRAWN BY
 13. CHECKED BY
 14. APPROVED BY
 15. DATE
 16. SCALE
 17. SHEET NUMBER
 18. TOTAL SHEETS
 19. PROJECT NUMBER
 20. PROJECT NAME

KZF DESIGN

ARCHITECTURE | ENGINEERING | INTERIORS | PLANNING
 4000 W. 10TH AVENUE, SUITE 100, DENVER, CO 80202
 TEL: 303.733.8888 FAX: 303.733.8889 WWW.KZFDESIGN.COM

DESIGNED	SJA	CHECKED	WBS
DRAWN	SJA	REVISED	
REVIEWED	DGK	DATE	6-21-2000
STRUCTURE FILE NUMBER	6800939/6800904		



KZF #6

DECK SECTION
BRIDGE NO. PRE-70-0504 L/IR
I.R. 70 OVER SEVEN MILE CREEK


PRE-70-0.00

13 / 17

146
283

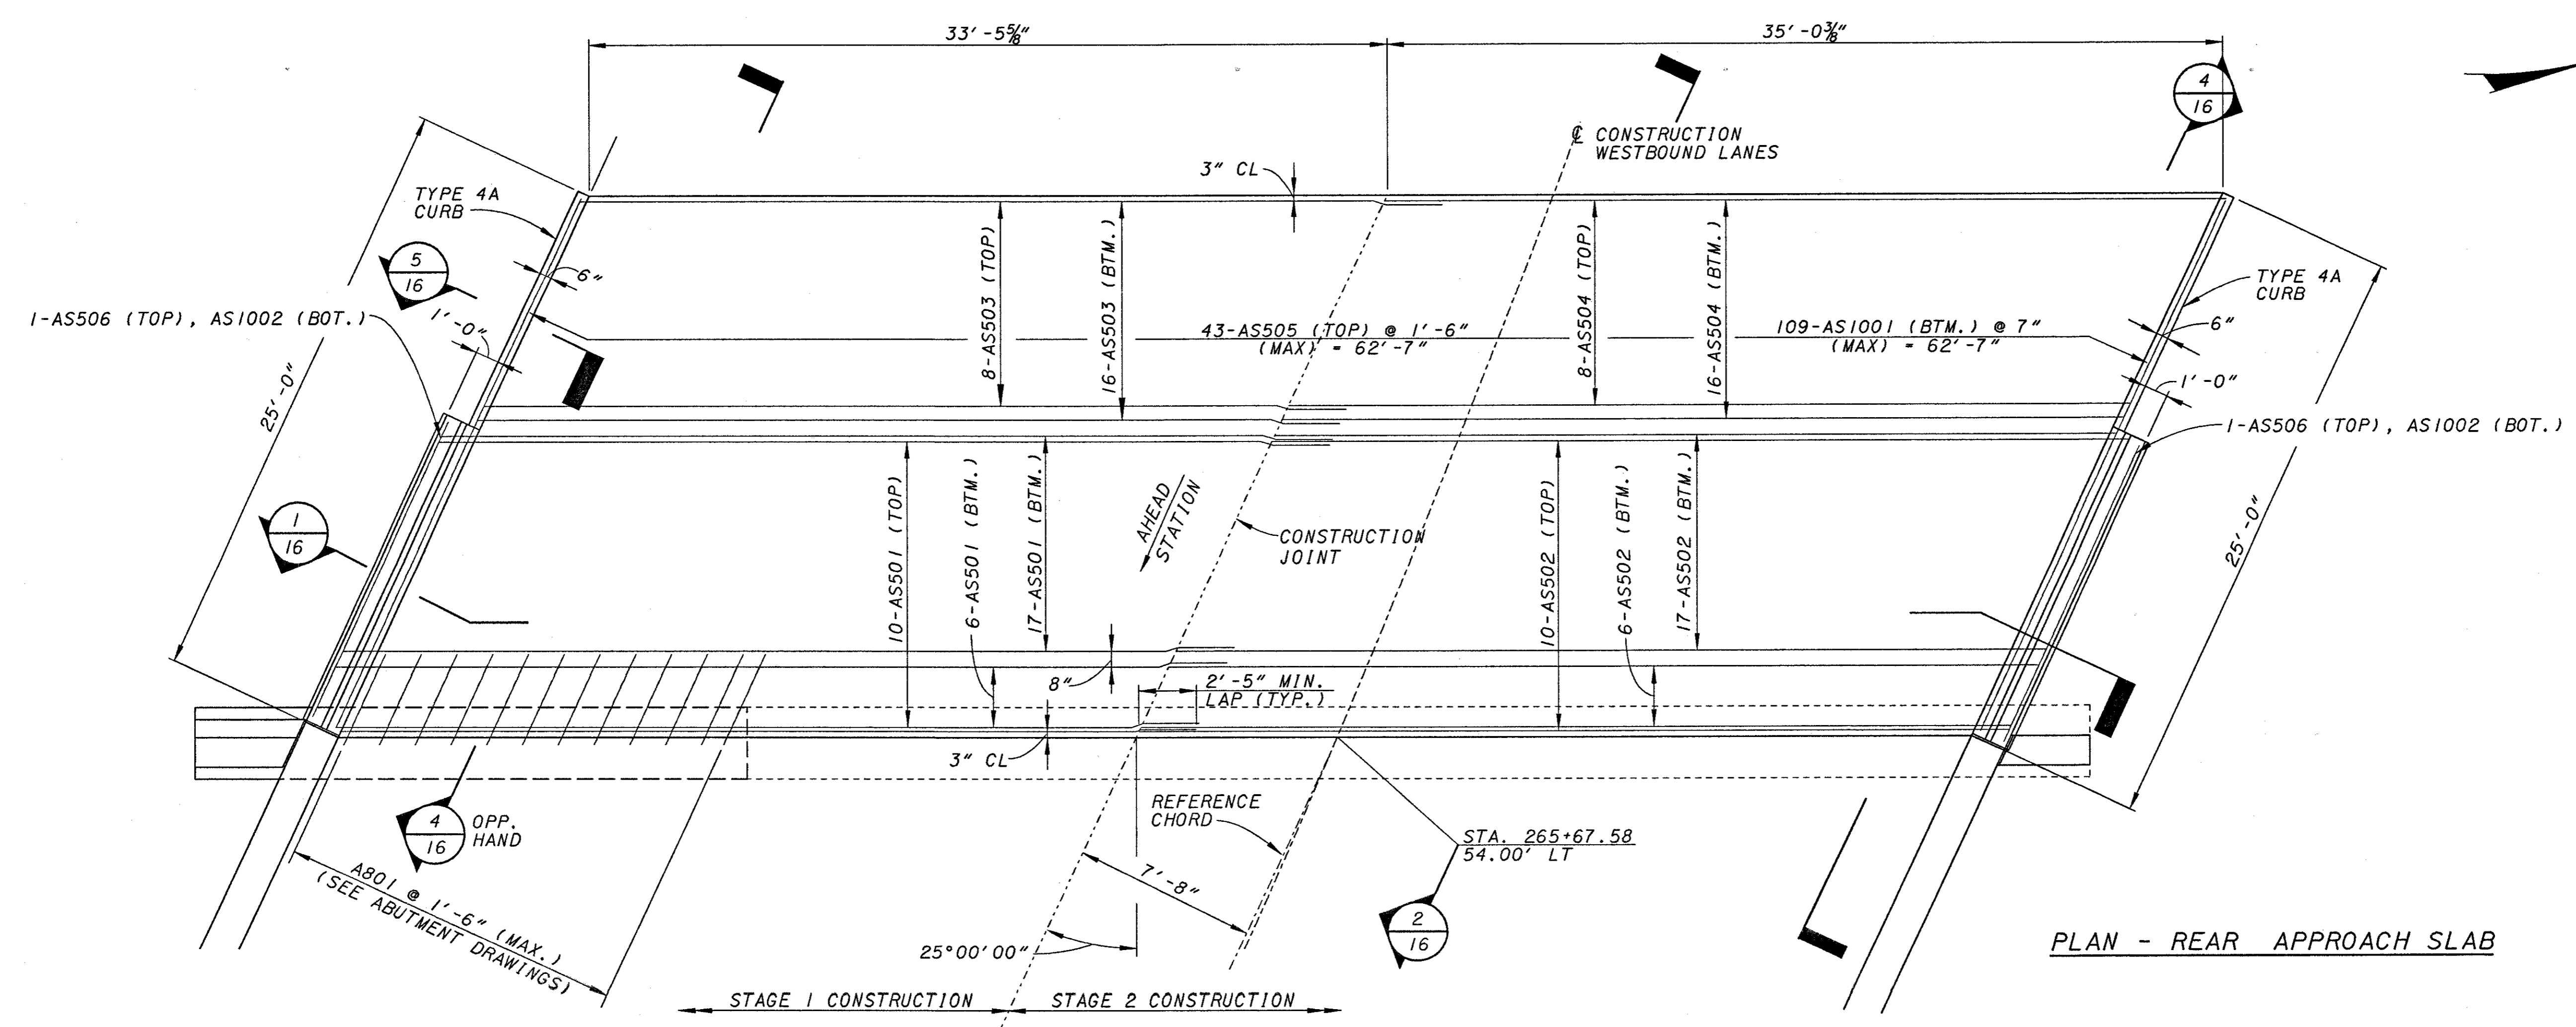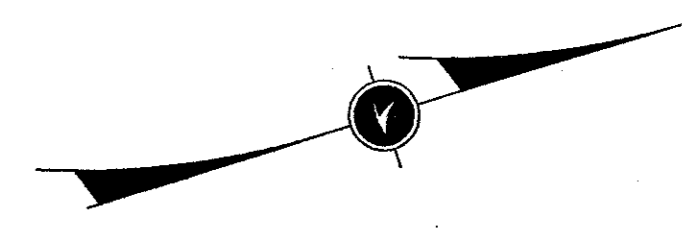


PLAN - REAR APPROACH SLAB

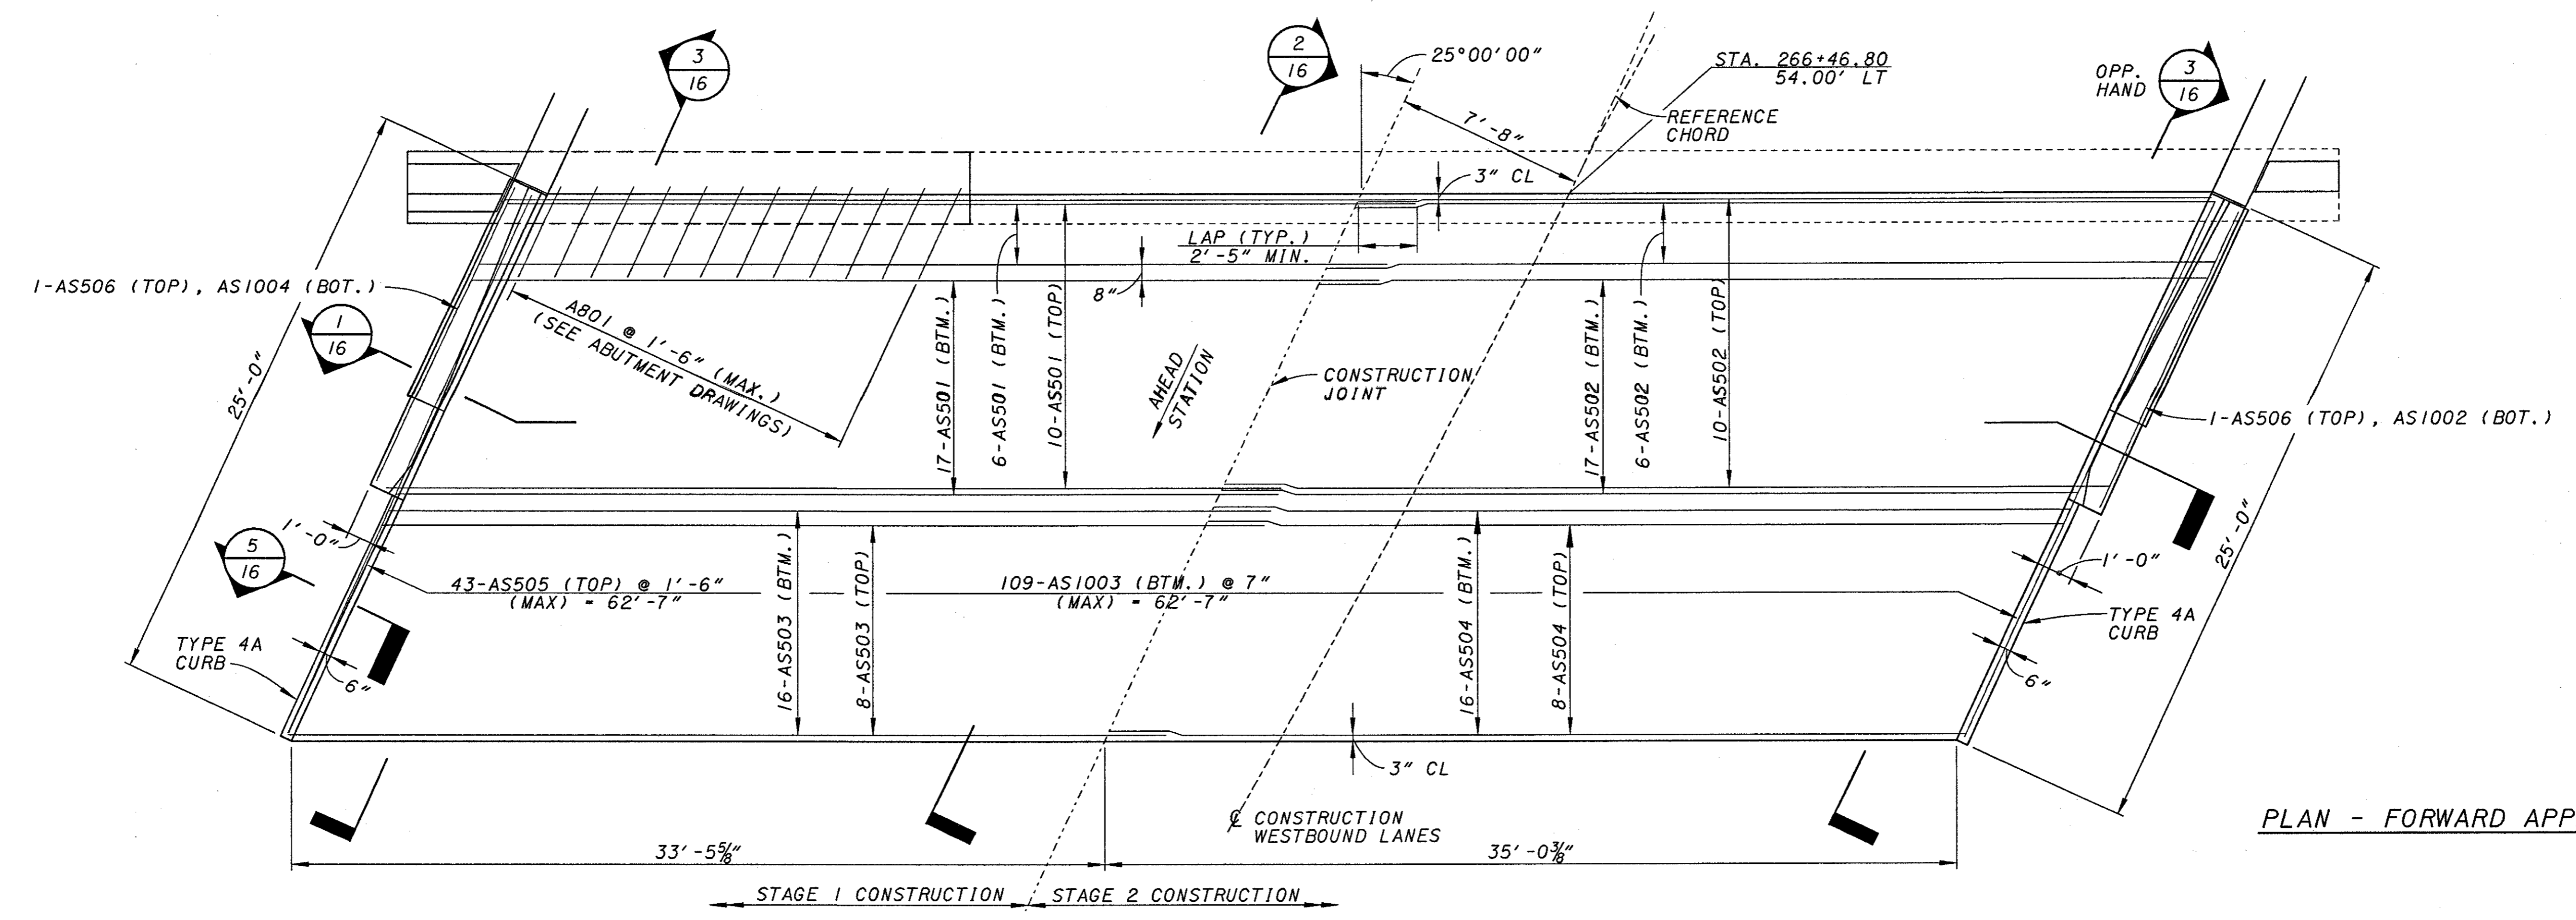


PLAN - FORWARD APPROACH SLAB


REVISIONS:
 NO. DATE BY REASON
 1 06/21/00 JDG WBS
 2 06/21/00 JDG WBS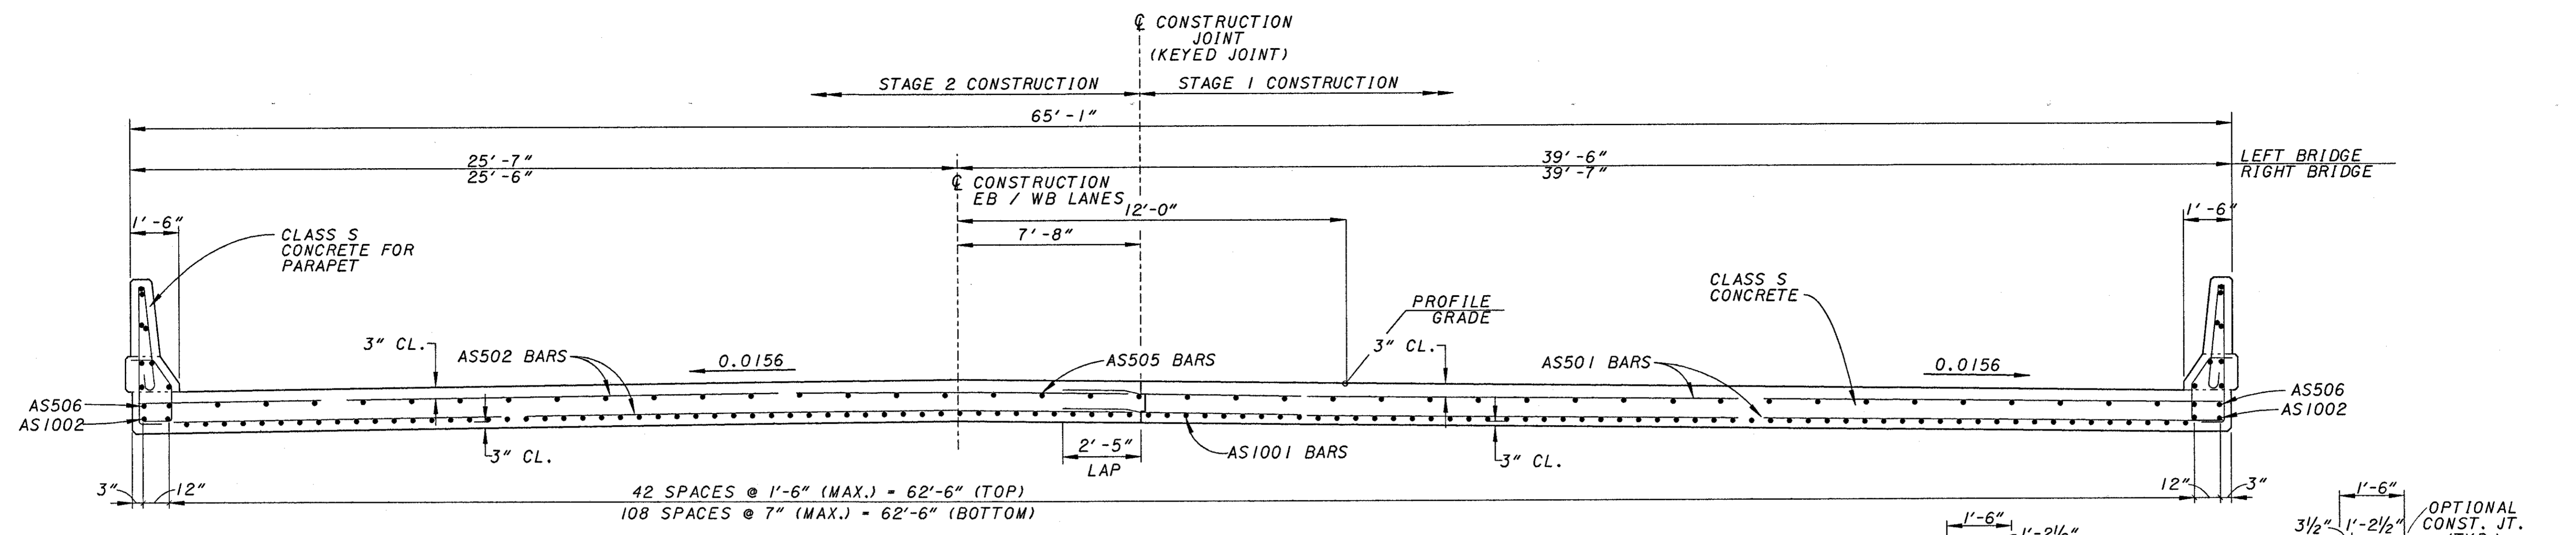
SECTION 1 1
14 15

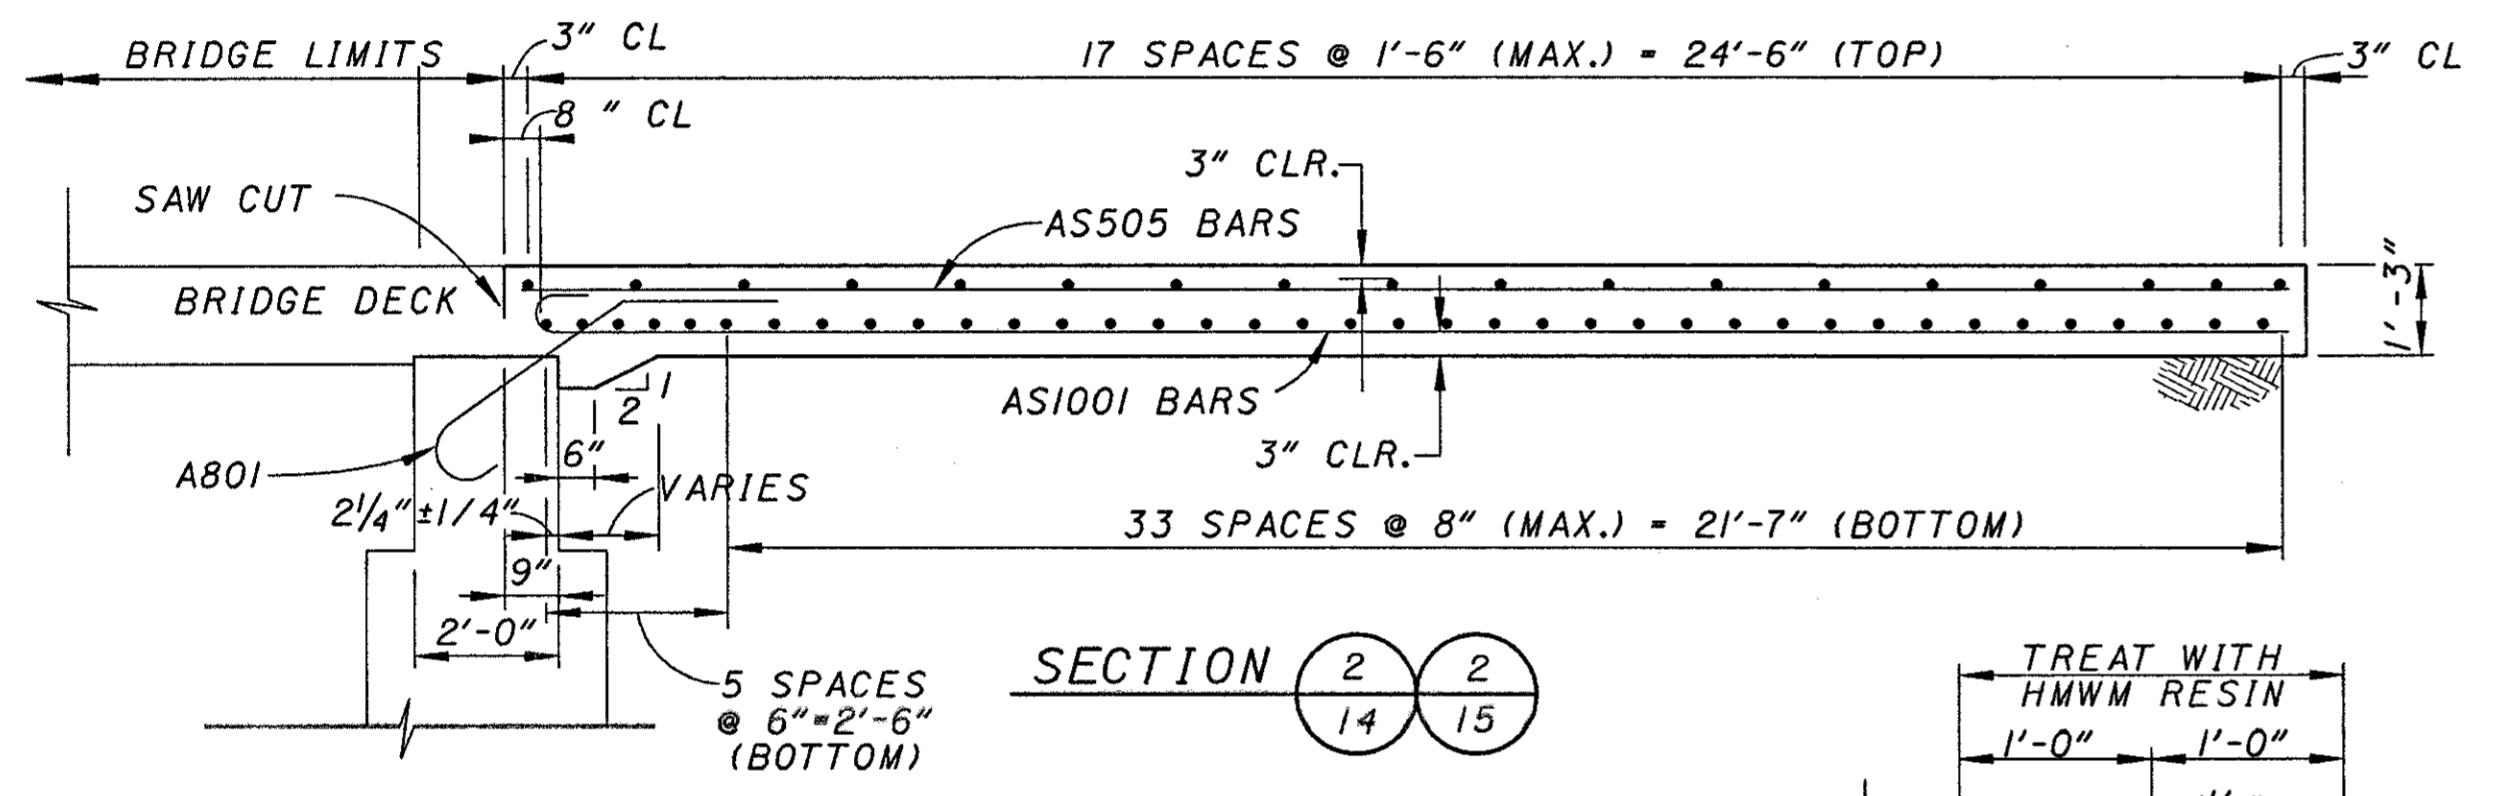

SECTION 2 2
14 15

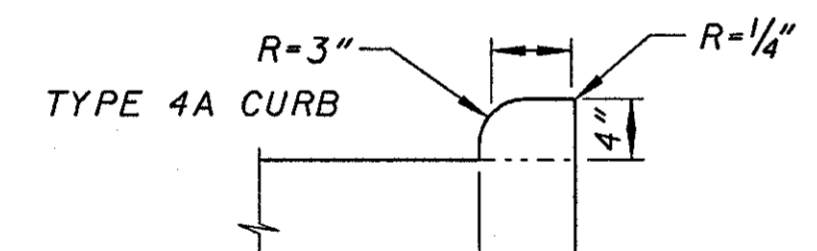


SECTION 5 5
14 15

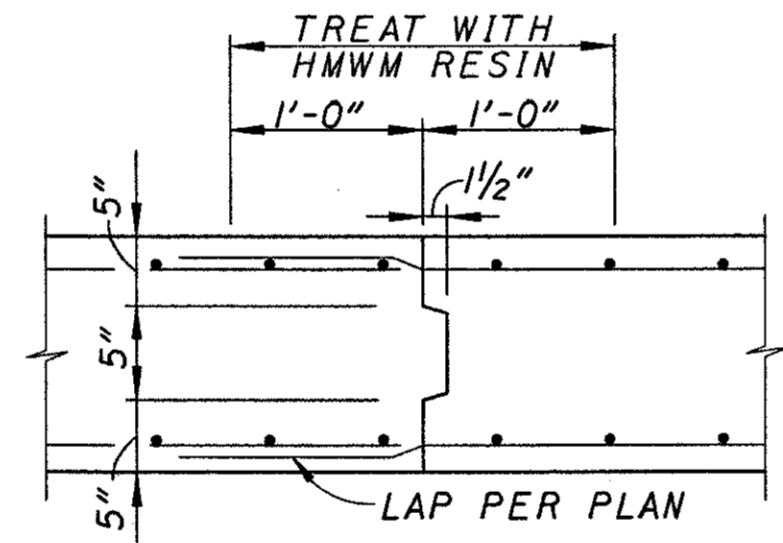


KEYED JOINT DETAIL

LEGEND:
 NF - NEAR FACE
 FF - FAR FACE
 EF - EACH FACE


ALL STEEL CLEARANCES ARE 3", EXCEPT 2" CLEAR FOR BARRIERS UNLESS OTHERWISE NOTED.

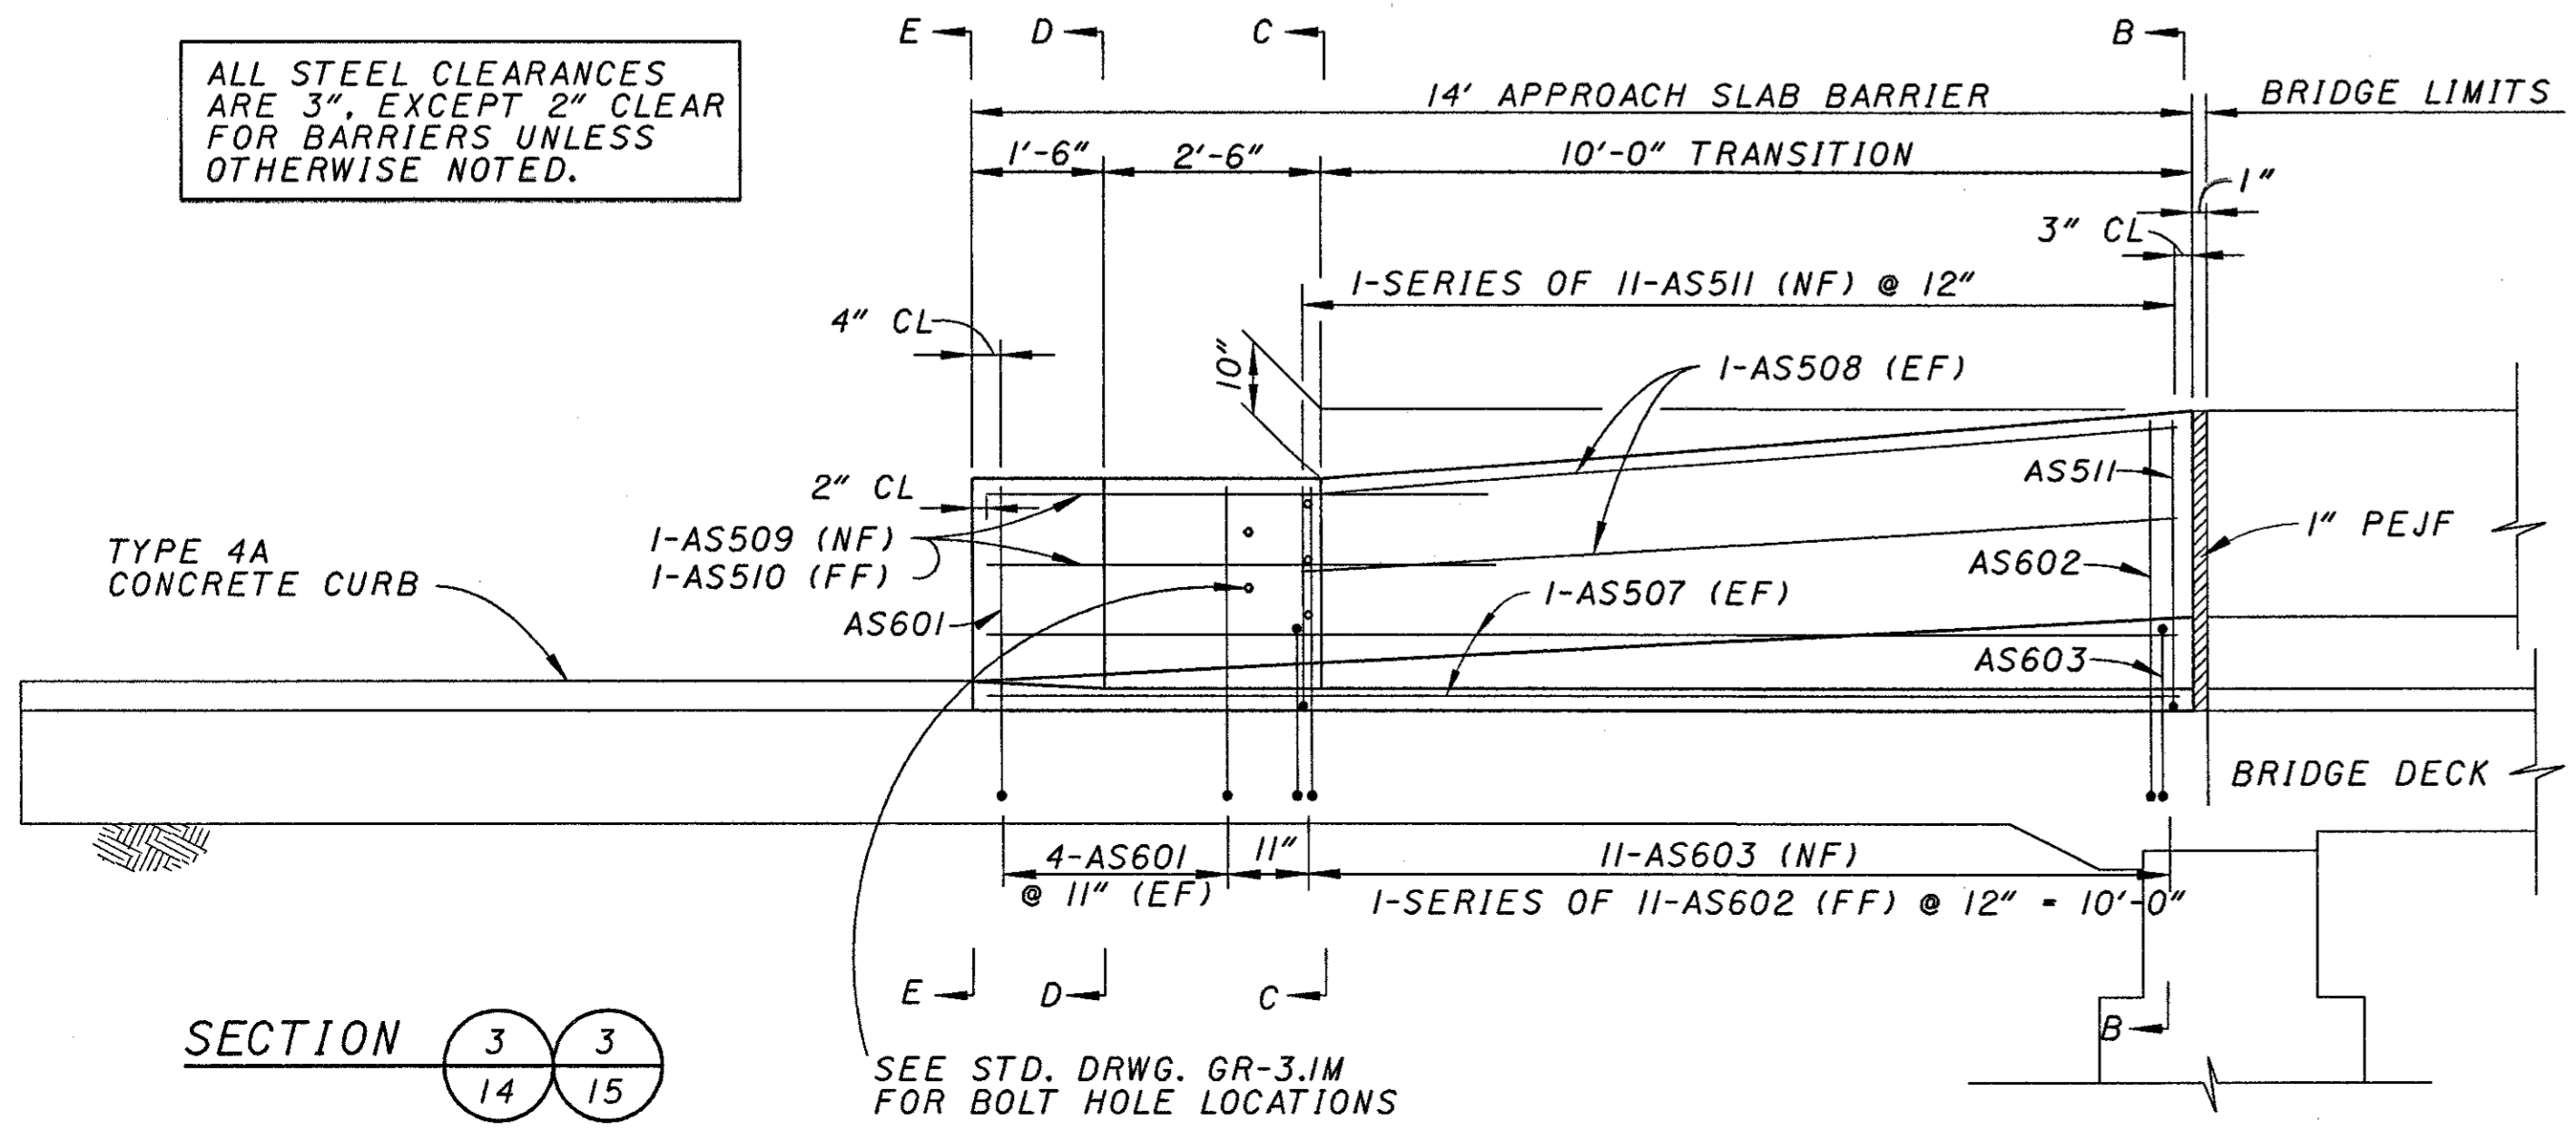


SECTION 3 3
14 15

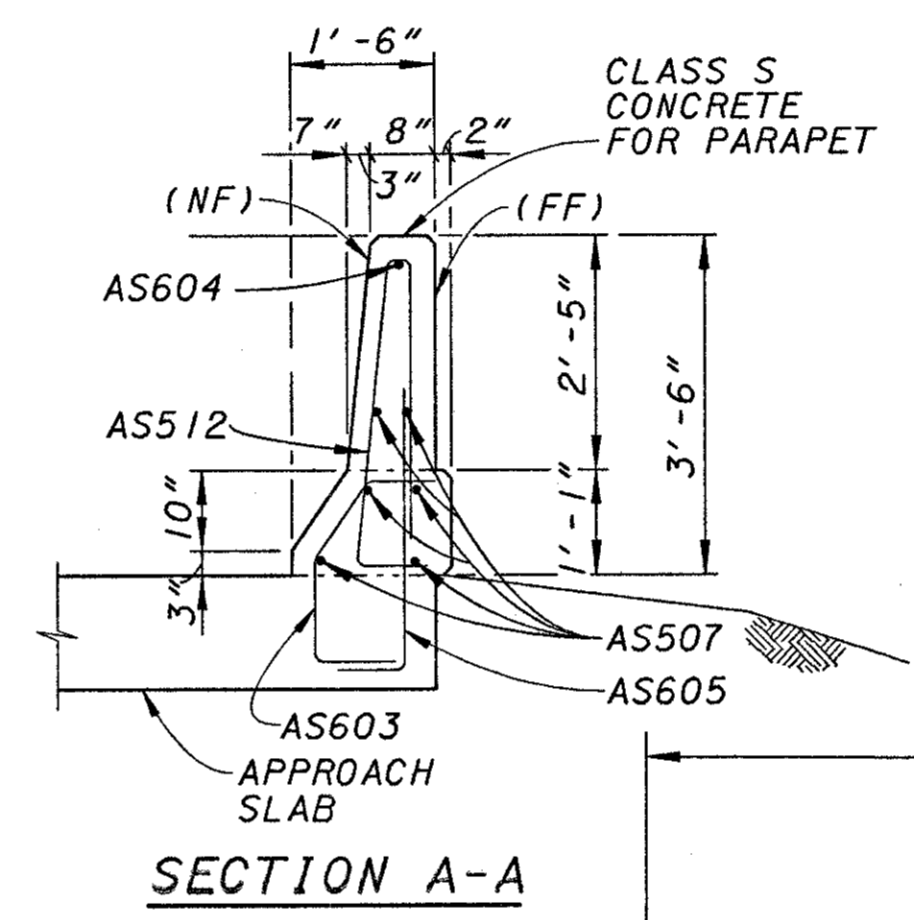


SECTION A-A

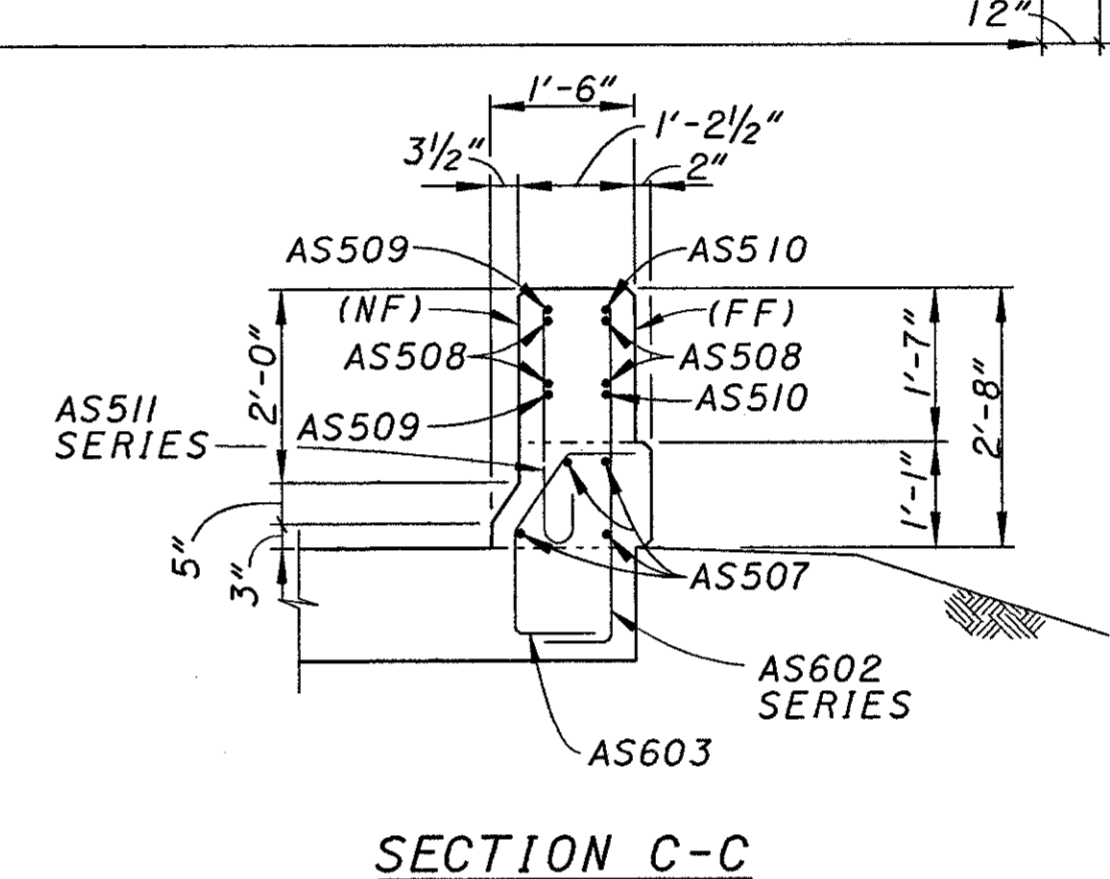


SECTION C-C

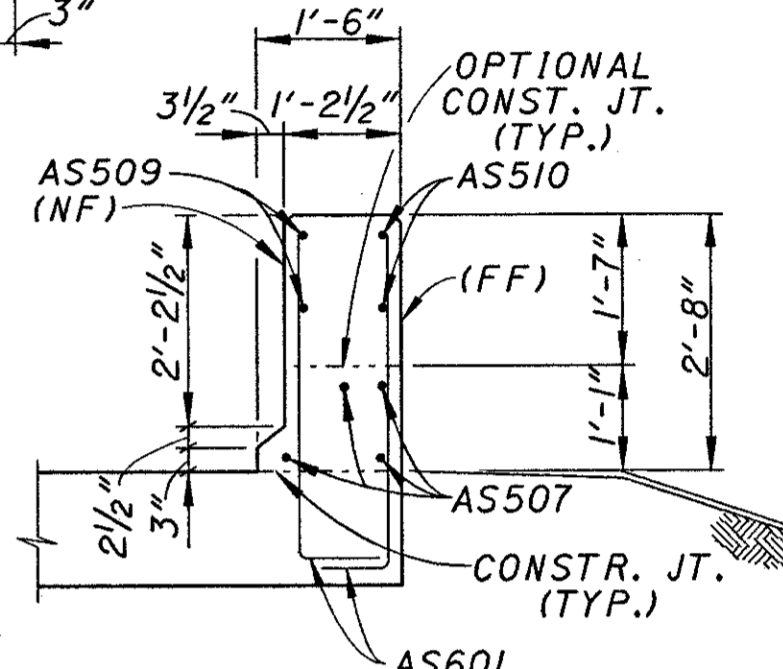


SECTION D-D

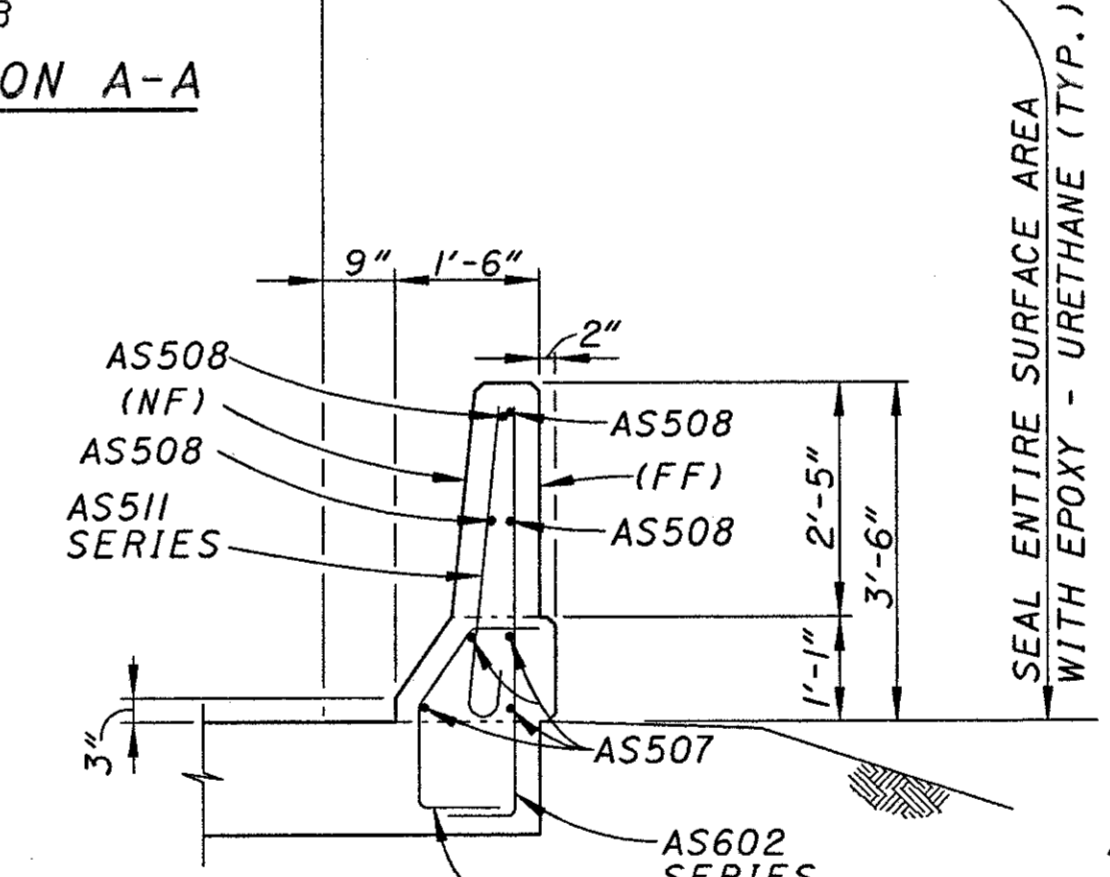





SECTION B-B

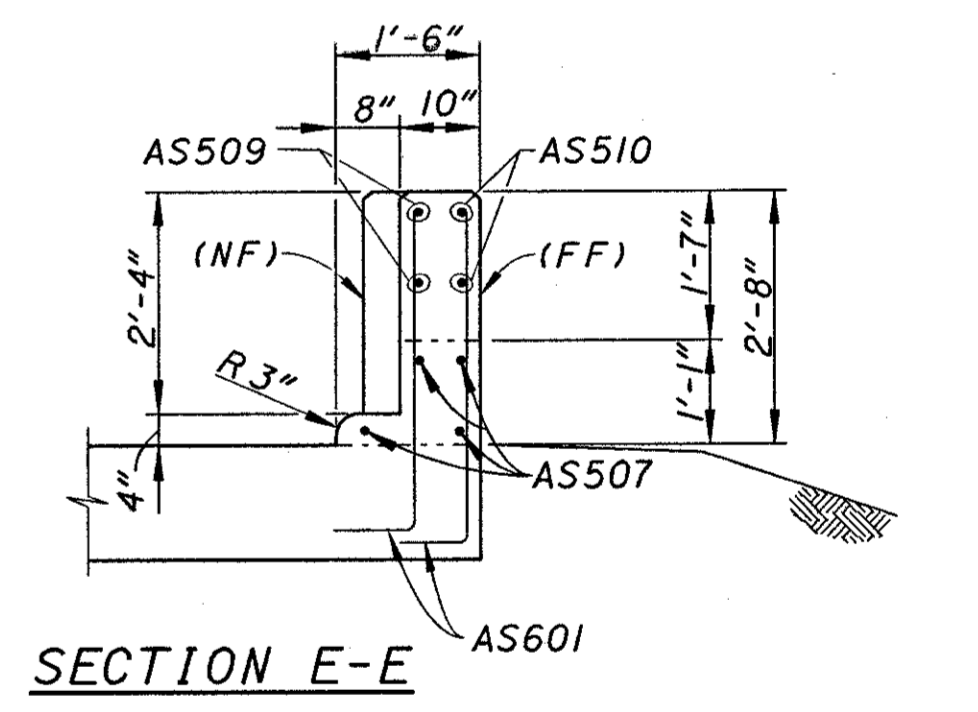

SECTION E-E

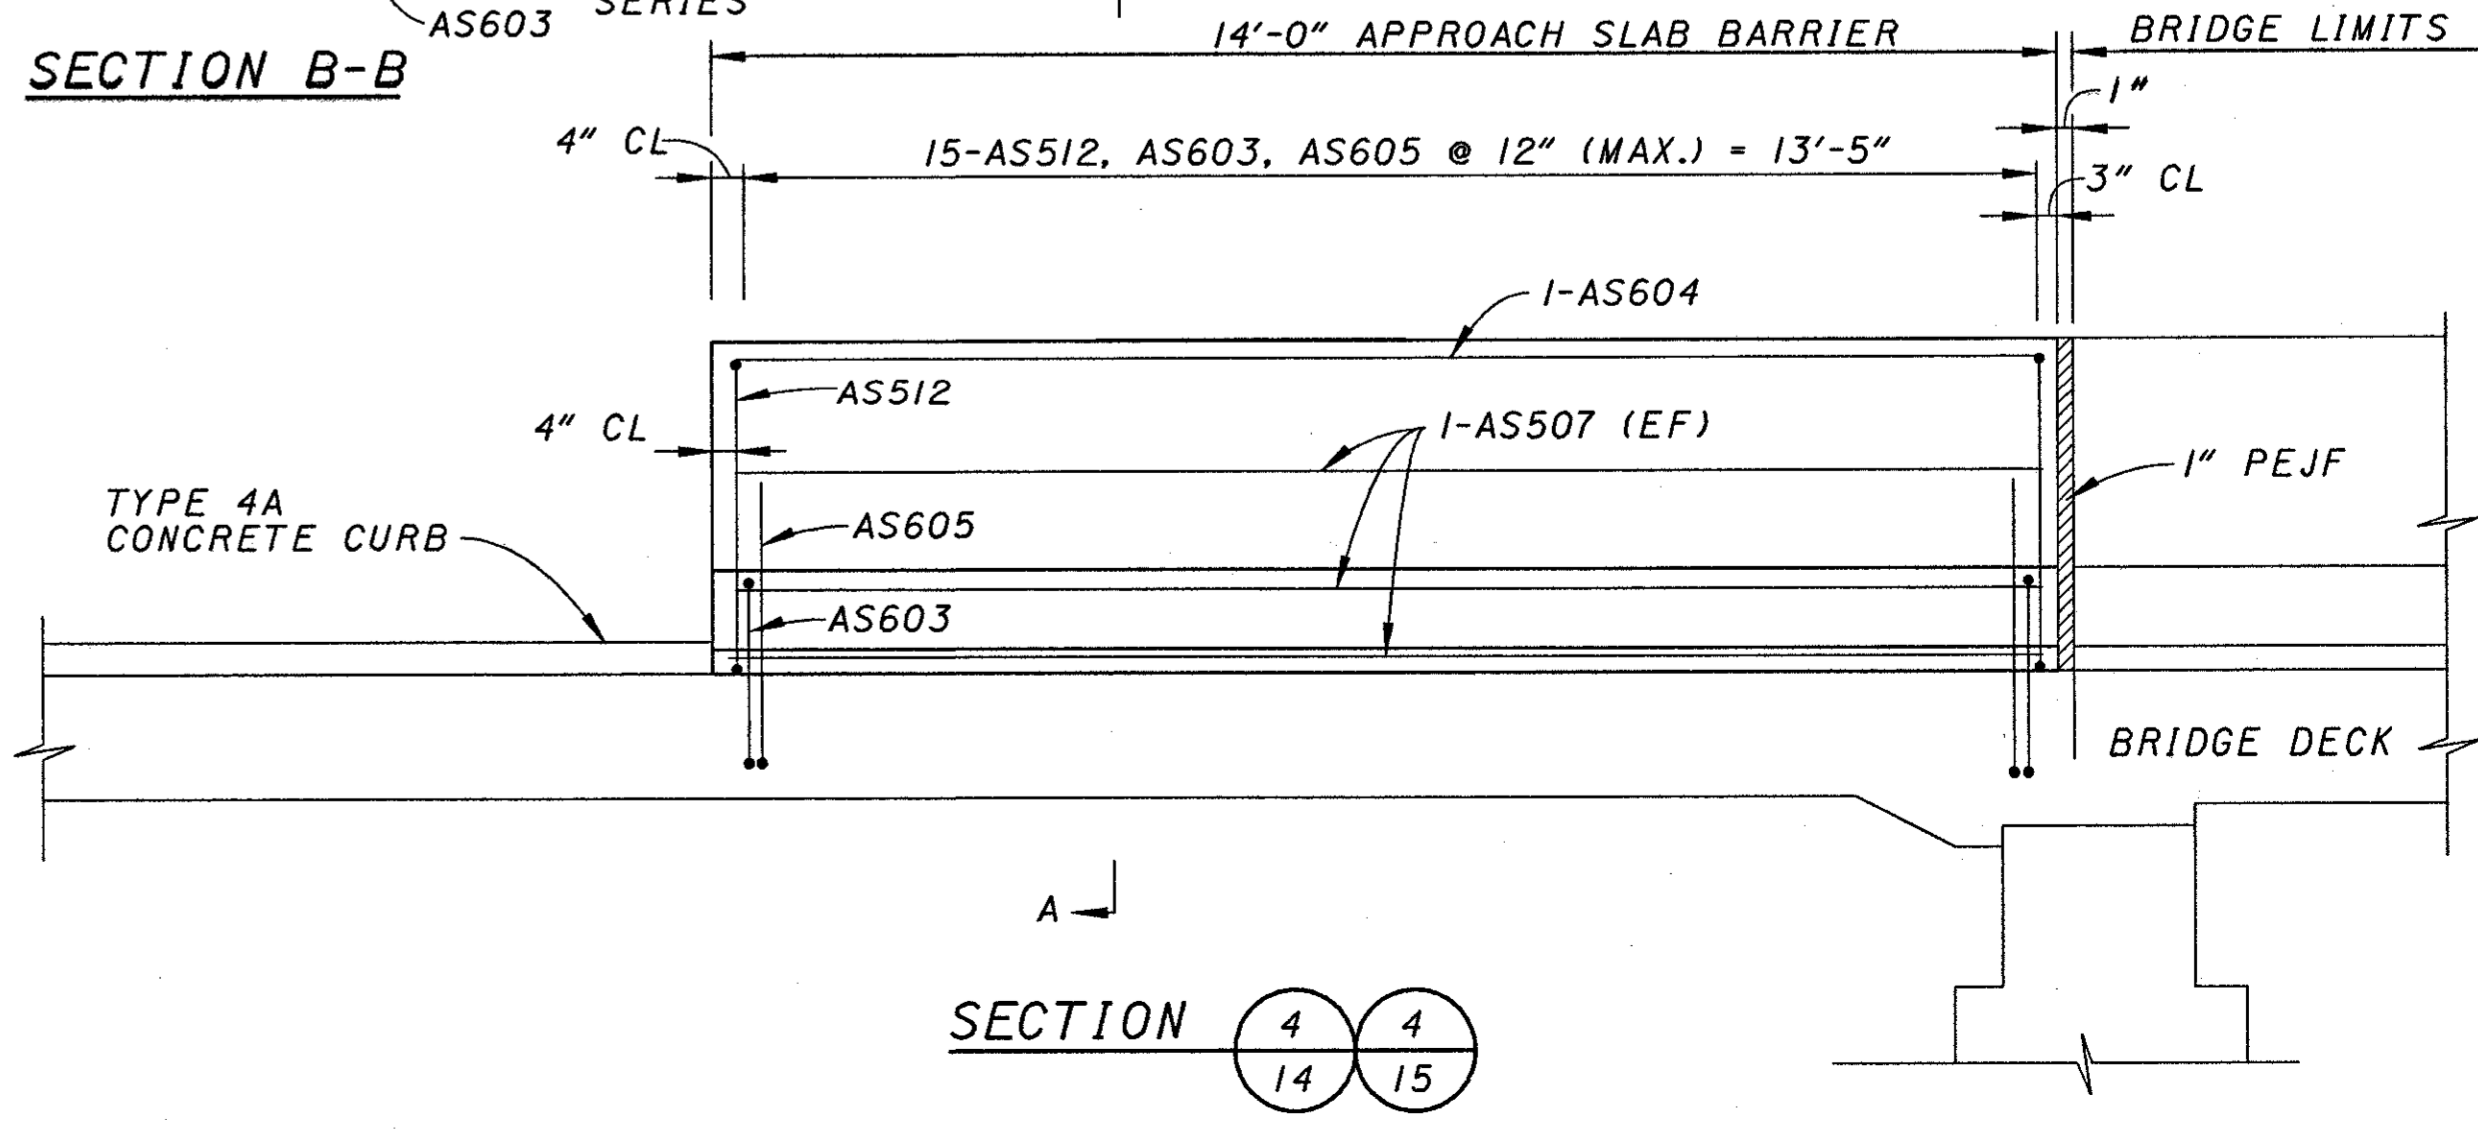

SECTION 4 4
14 15

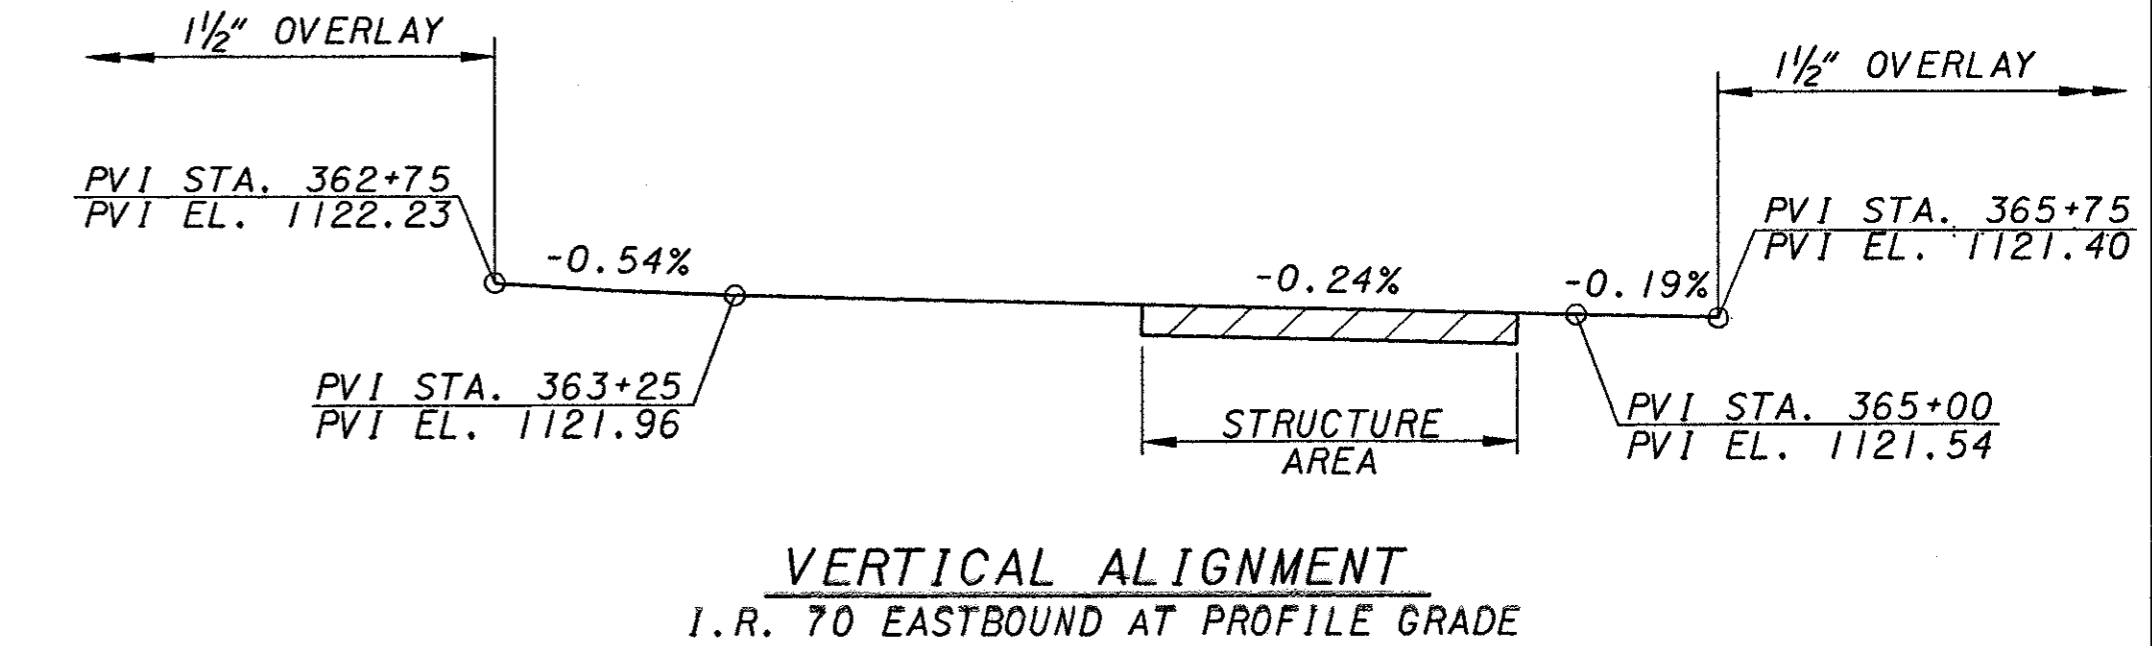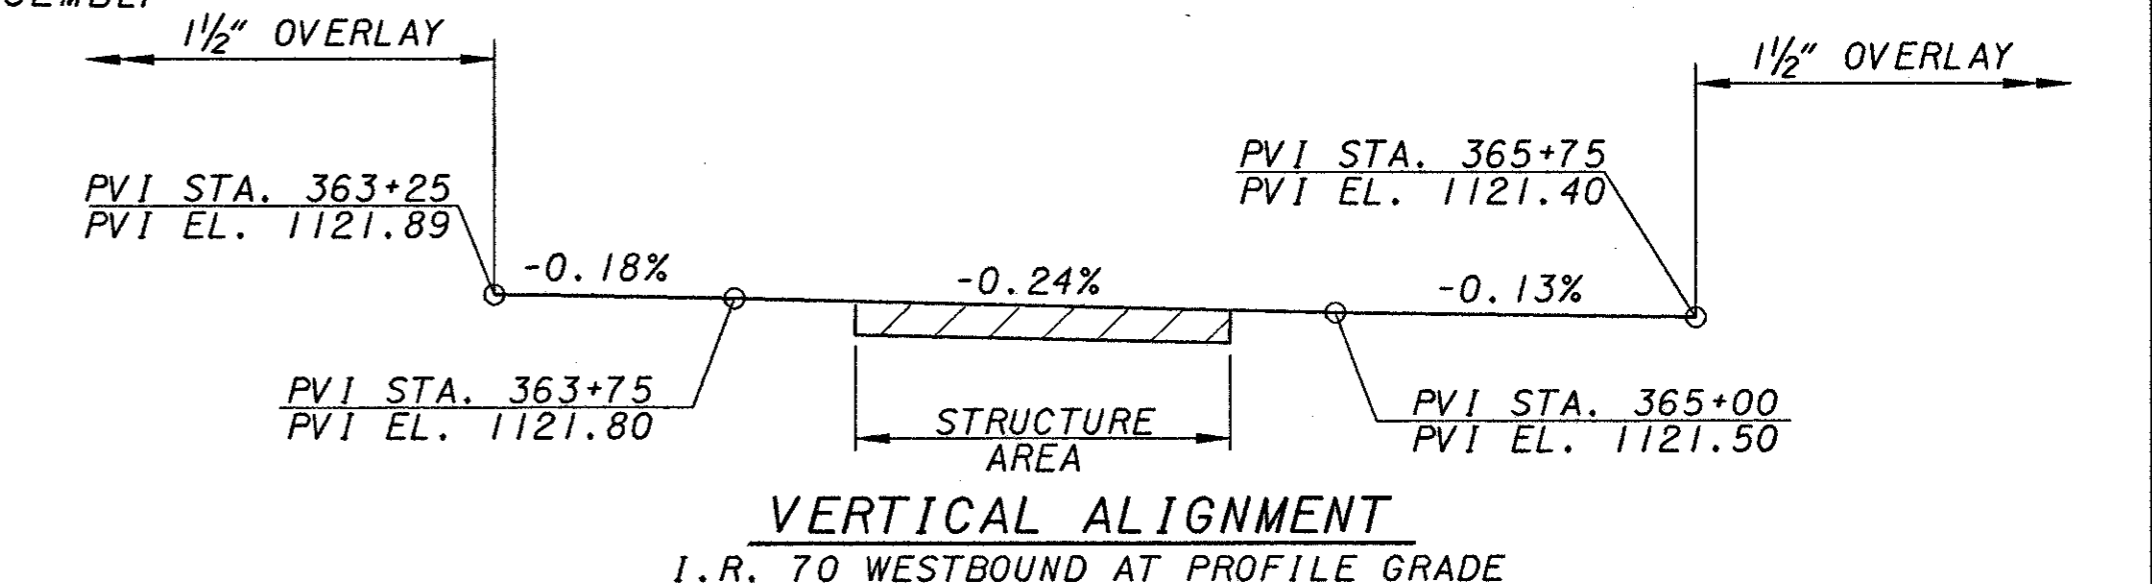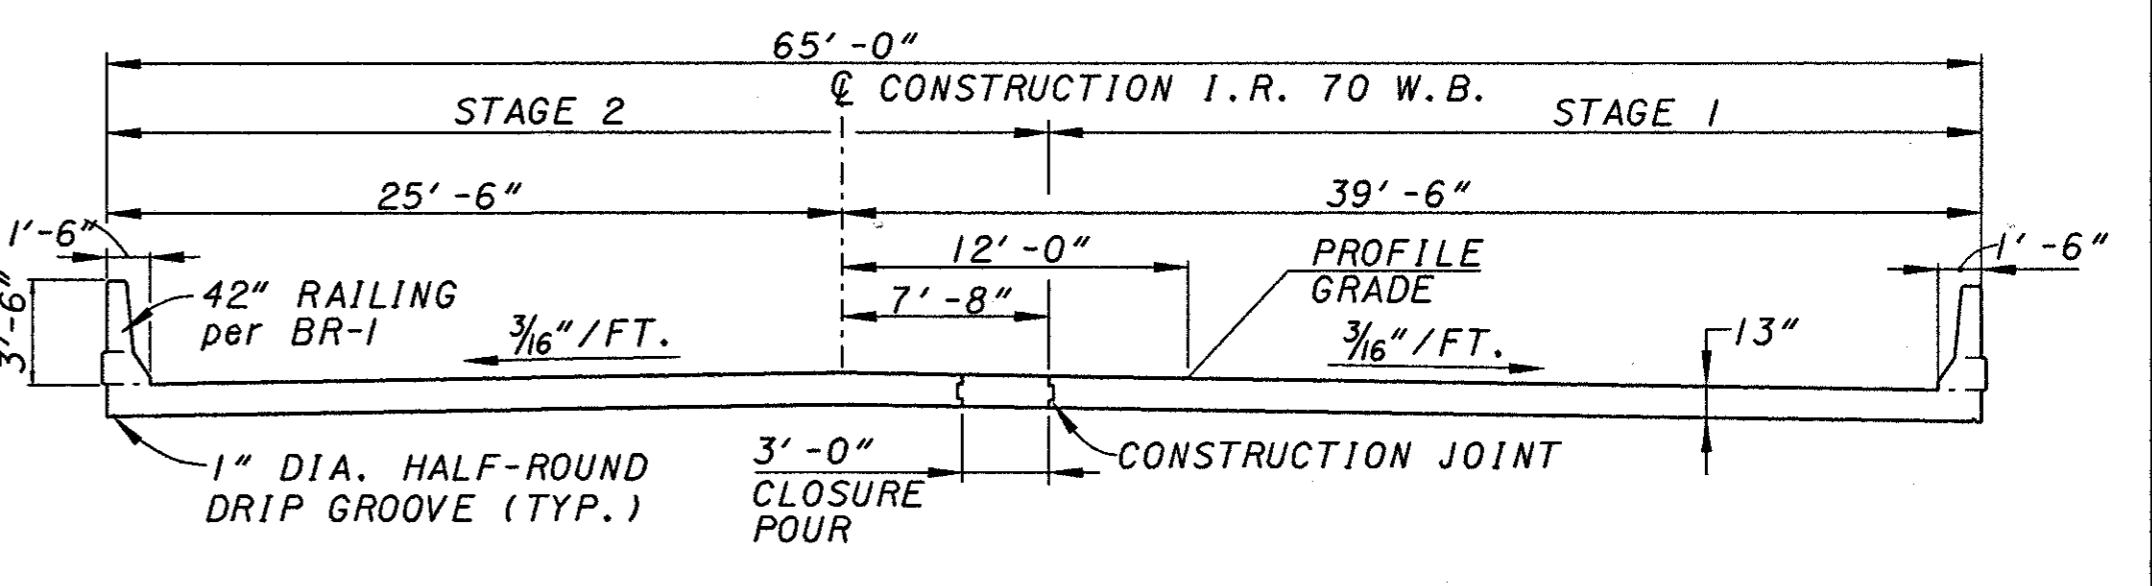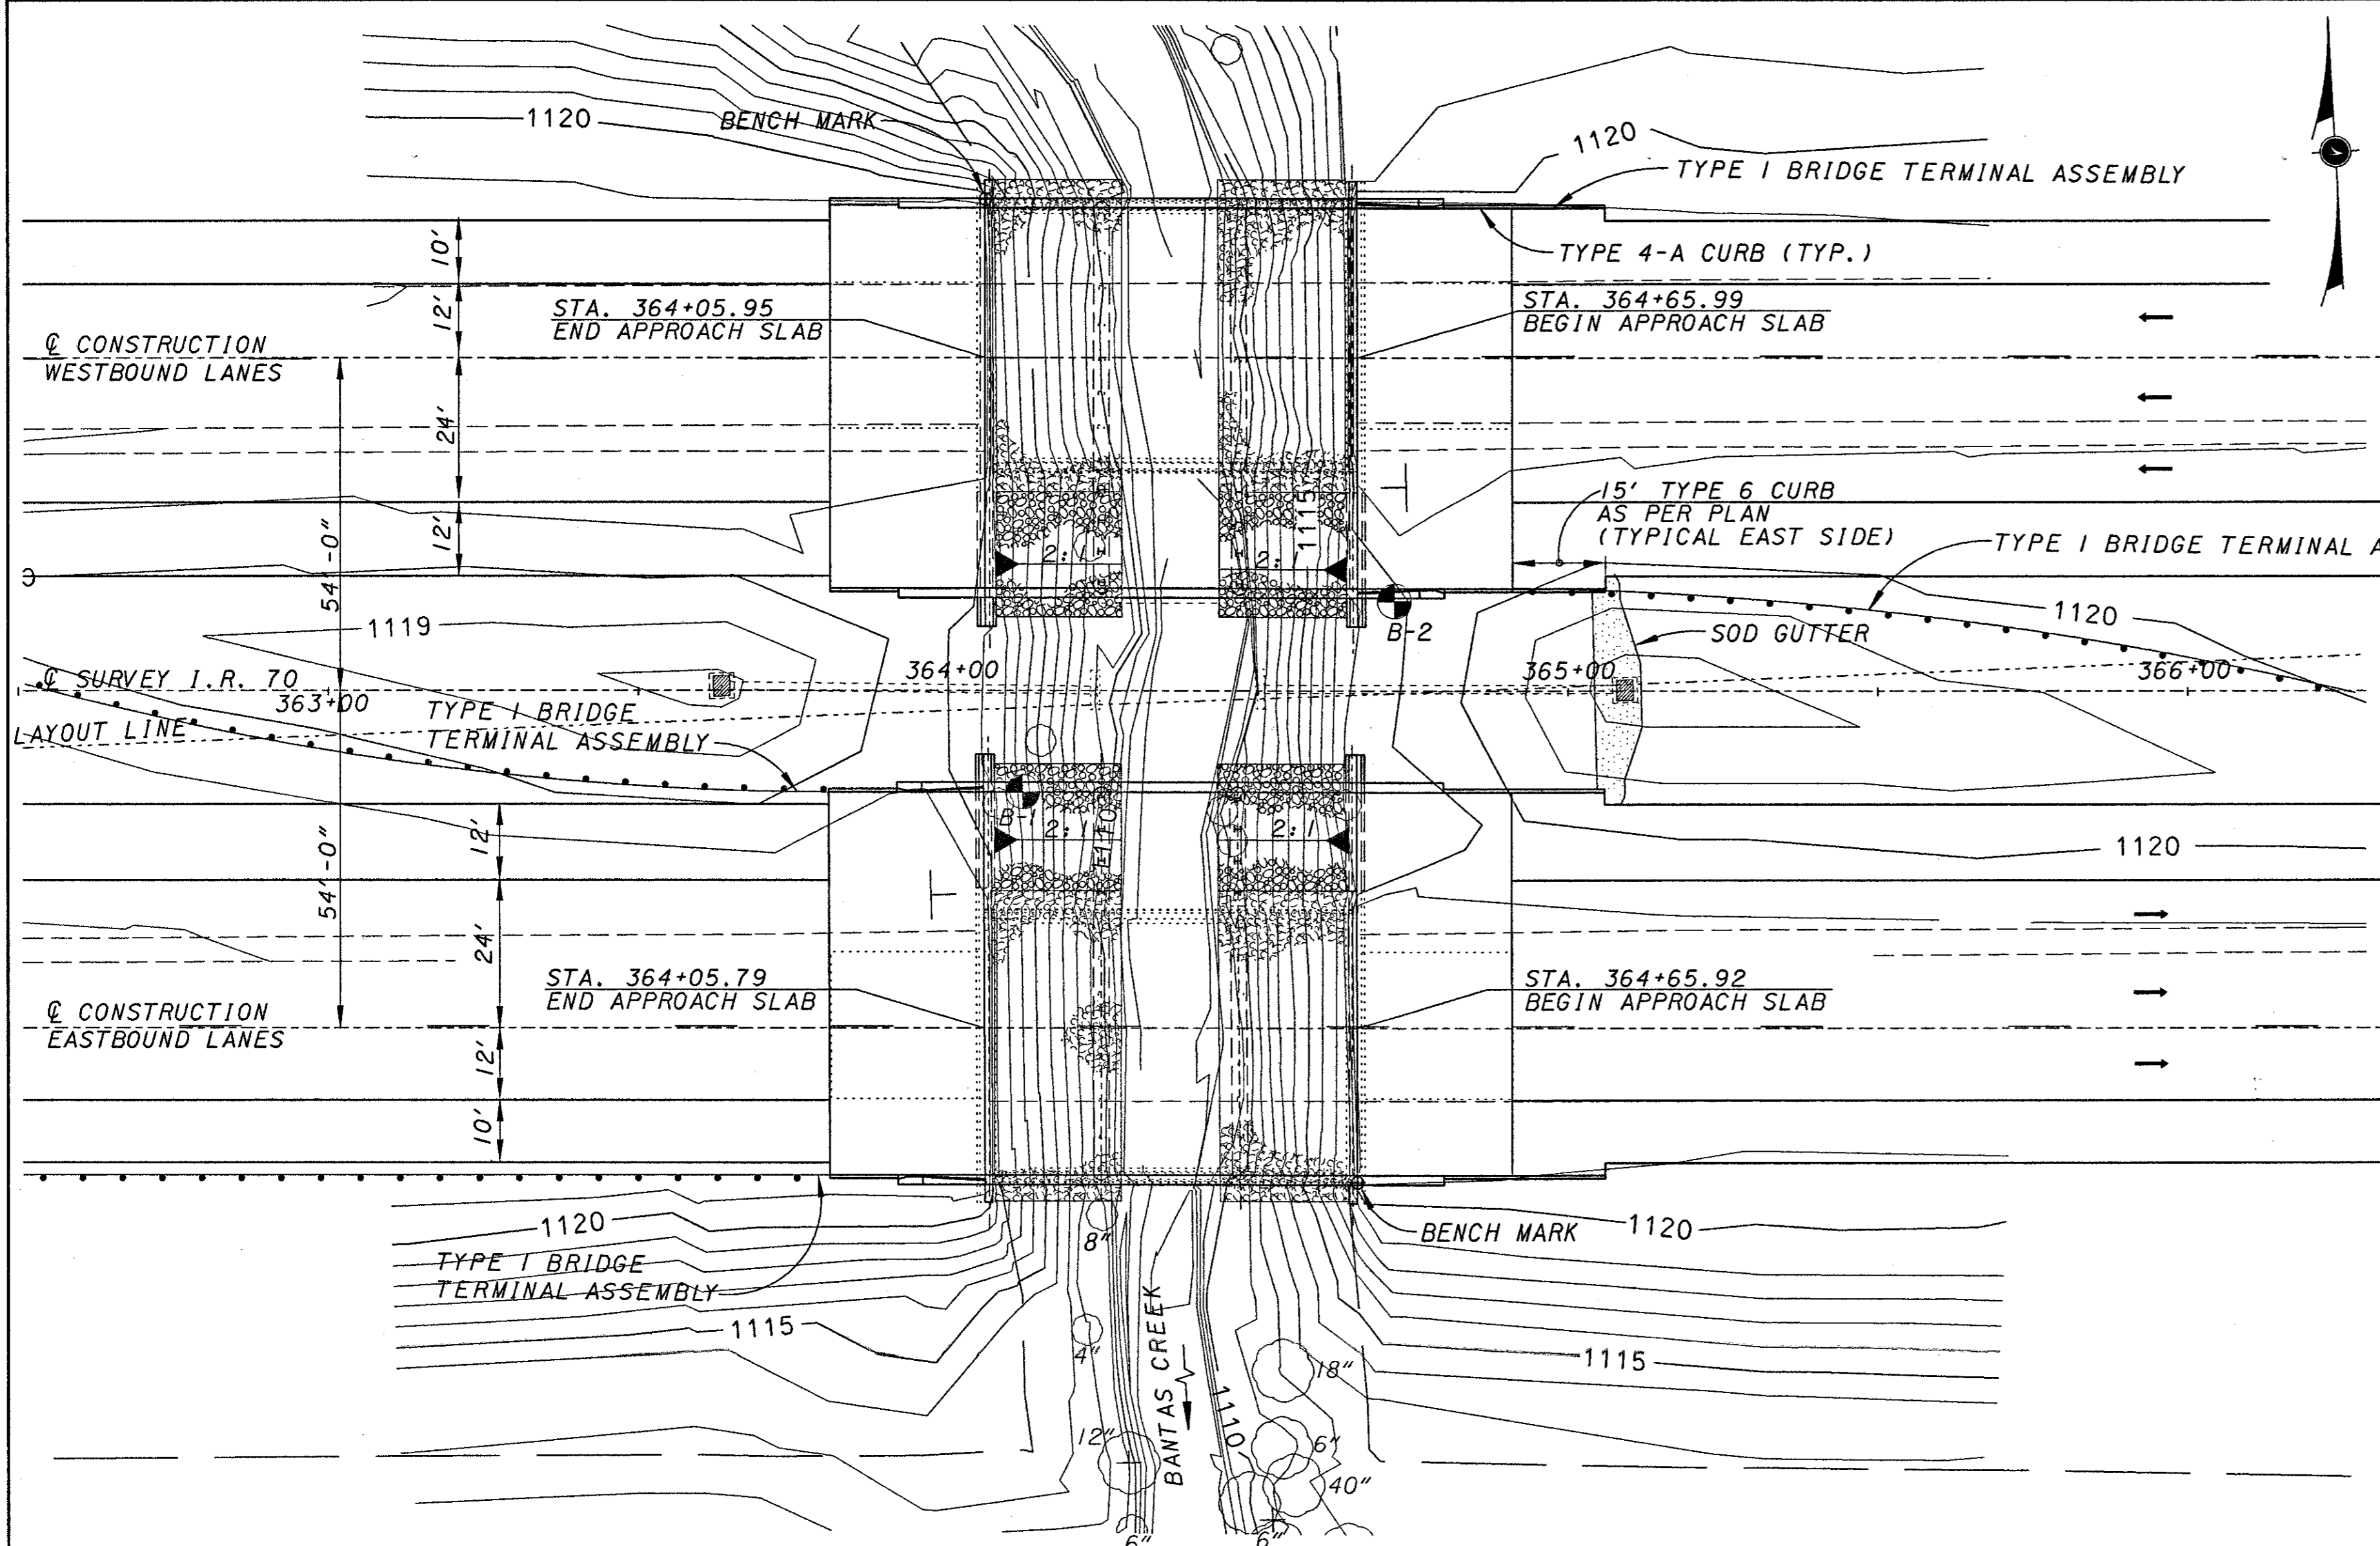

TRAFFIC DATA

ADT (2001) = 35,860
 ADT (2021) = 50,800
 ADTT (2021) = 19,812
 SOURCE = ODOT

BENCH MARK

BOX NOTCH ON S.E. ABUTMENT
 EASTBOUND AT STA. 364+65.98
 79.12 RT. AT ELEVATION 1122.04

BOX NOTCH ON N.W. ABUTMENT
 WESTBOUND AT STA. 364+06.07,
 79.34 LT. AT ELEVATION 1122.21

EXISTING STRUCTURE - I.R. 70

TYPE: 3 SPAN CONTINUOUS REINFORCED CONCRETE SLAB WITH CAPPED PILE SUBSTRUCTURE.

LENGTH OF SPANS:
 LEFT BRIDGE 18'-0 1/2" ±, 22'-1 3/8" ±, 18'-4 5/8" ±
 RIGHT BRIDGE 18'-1 1/4", 22'-2 7/8", 18'-3 1/2"

ROADWAY WIDTH: 39'-8" ± TOE/TOE BARRIER
 DESIGN LOADING: C.F. 2000
 SKEW ANGLE: NONE
 SUPERELEVATION: NONE - NORMAL CROWN
 WEARING SURFACE: 1" MONOLITHIC CONCRETE
 ALIGNMENT: TANGENT
 YEAR BUILT: 1962

DRAINAGE DATA

DRAINAGE AREA: 5.15 MILES
 EXISTING BRIDGE OPENING: 413 Sq. Ft.
 PROPOSED BRIDGE OPENING: 407 Sq. Ft.
 HW100: 1117.28'
 HW50: 1116.77'
 Q100: 1940 C.F.S.
 Q50: 1710 C.F.S.
 V100: 8.27 F.P.S.
 V50: 7.92 F.P.S.
 LOW CHORD ELEVATION: 1120.30
 TOP OF DECK ELEVATION: 1121.39 TO 1121.53


PROPOSED STRUCTURE

PROPOSED WORK: NEW REINFORCED CONCRETE DECK ON WIDENED SUBSTRUCTURE.



TYPE: 3 SPAN CONTINUOUS REINFORCED CONCRETE SLAB WITH CAPPED PILE SUBSTRUCTURE.

LENGTH OF SPANS:
 LEFT BRIDGE 18'-0 1/2" ±, 22'-1 3/8" ±, 18'-4 5/8" ±
 RIGHT BRIDGE 18'-1 1/4", 22'-2 7/8", 18'-3 1/2"

ROADWAY WIDTH: 62'-0" ± TOE/TOE BARRIER
 DESIGN LOADING: HS-20 WITH ALTERNATE MILITARY
 SKEW ANGLE: NONE
 SUPERELEVATION: NONE - NORMAL CROWN
 WEARING SURFACE: 1" MONOLITHIC CONCRETE
 APPROACH SLAB: AS-1-81 (25' LONG)
 ALIGNMENT: TANGENT
 LATITUDE: N 39°50'08"
 LONGITUDE: W 84°41'11"

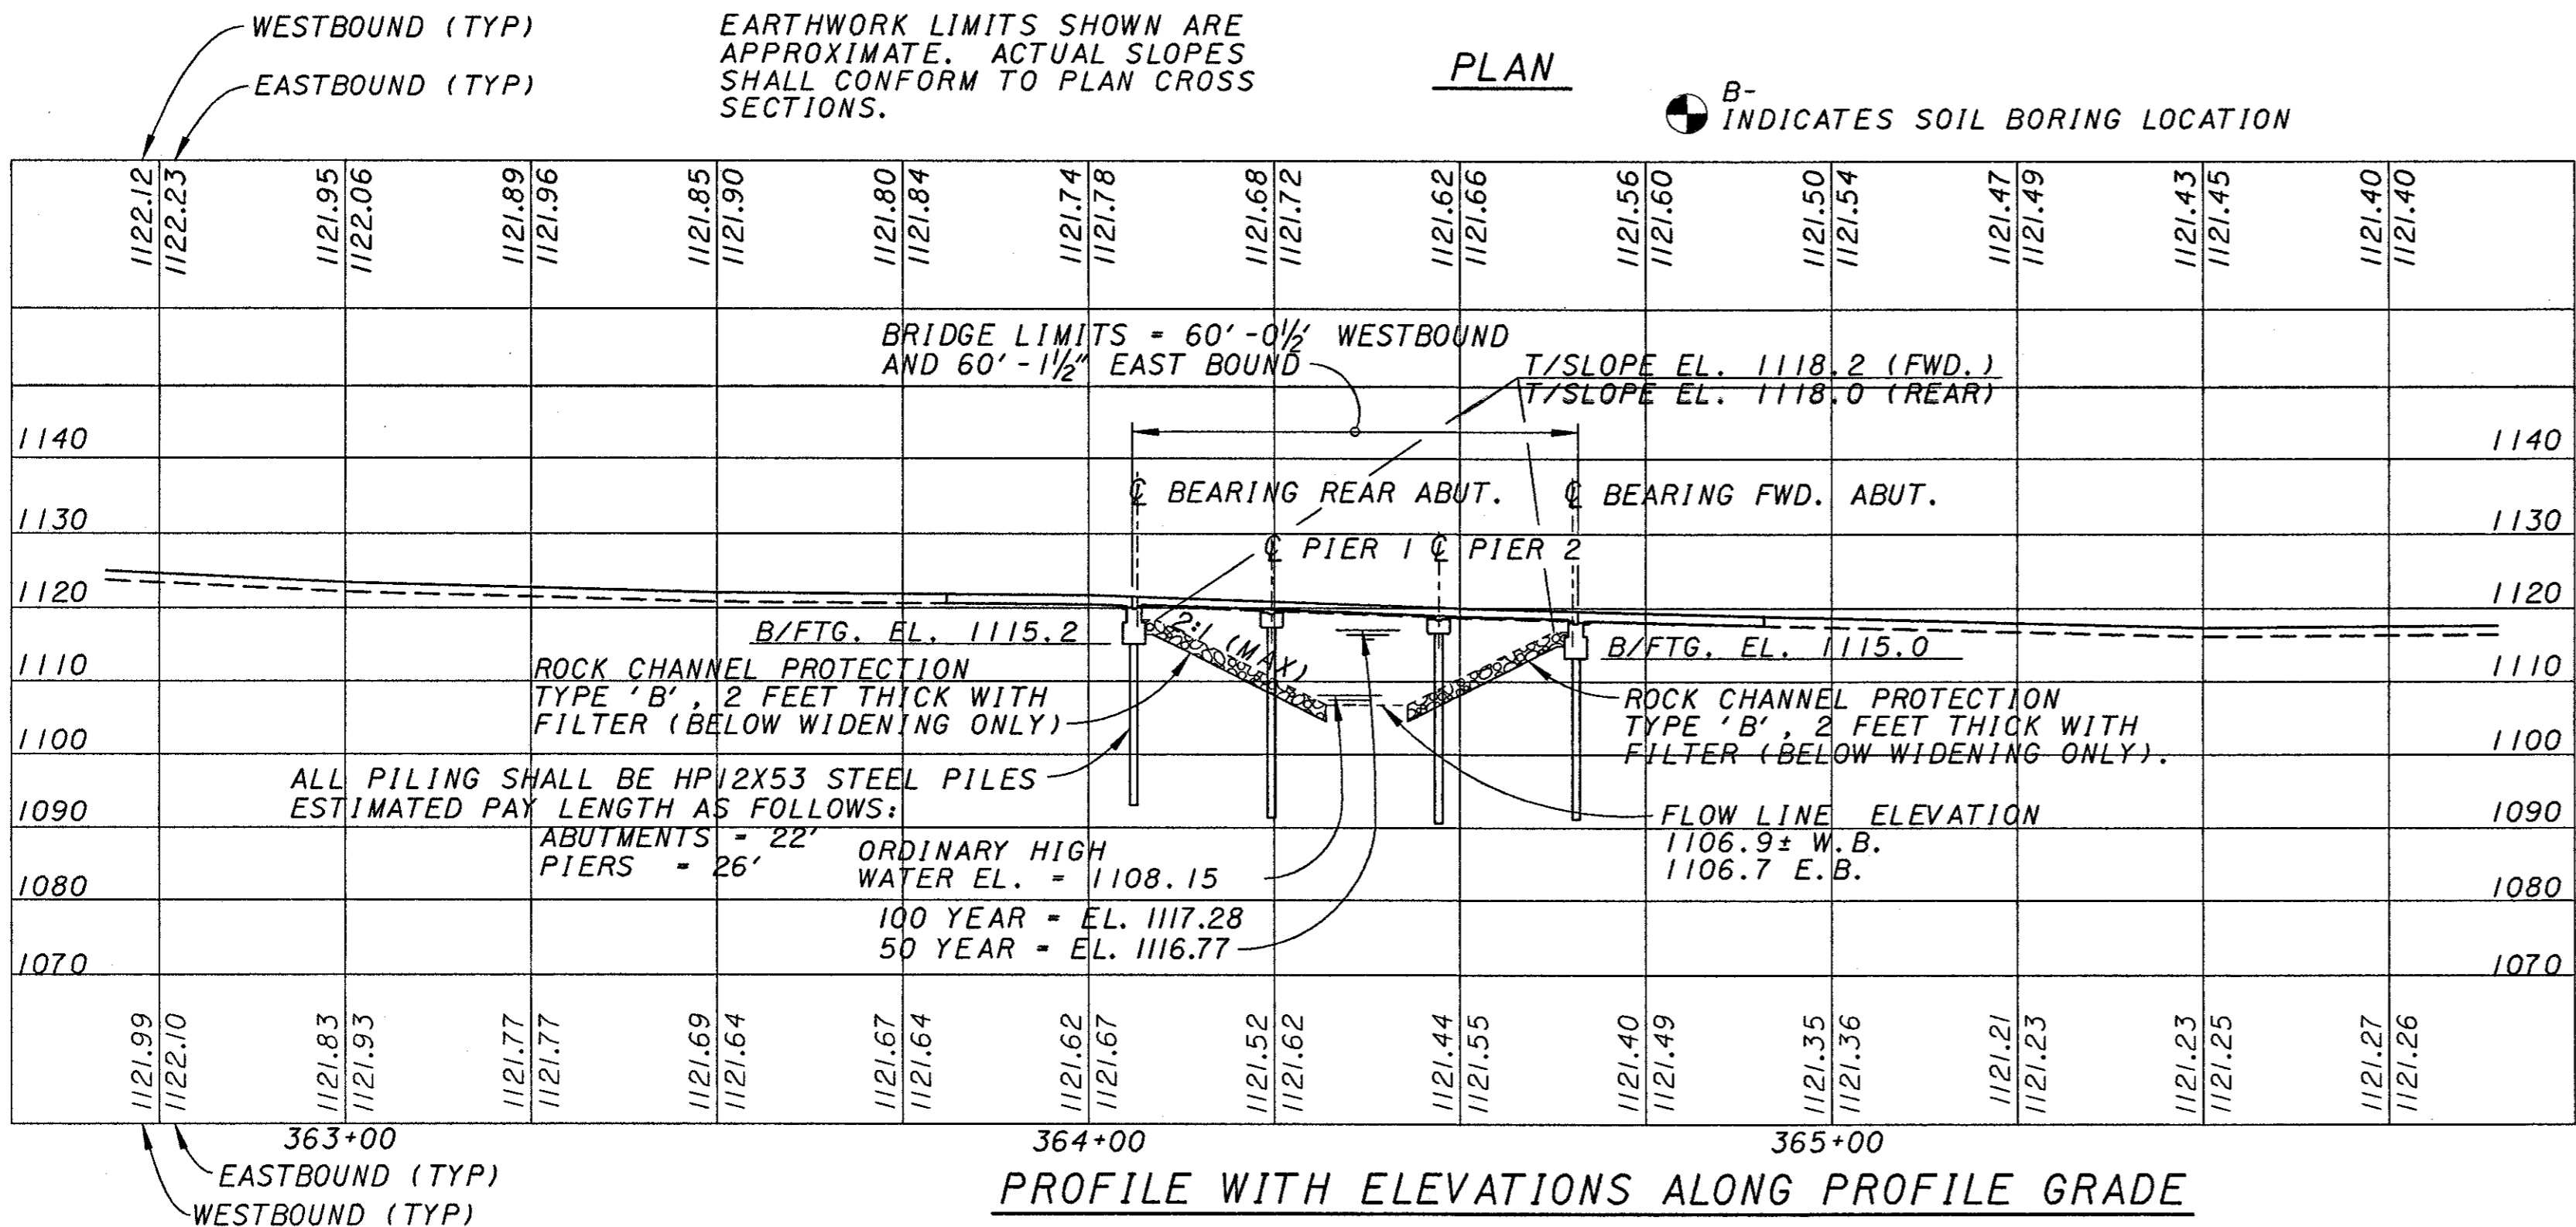

REF: **REF1**
 REF: **REF2**
 REF: **REF3**
 REF: **REF100**

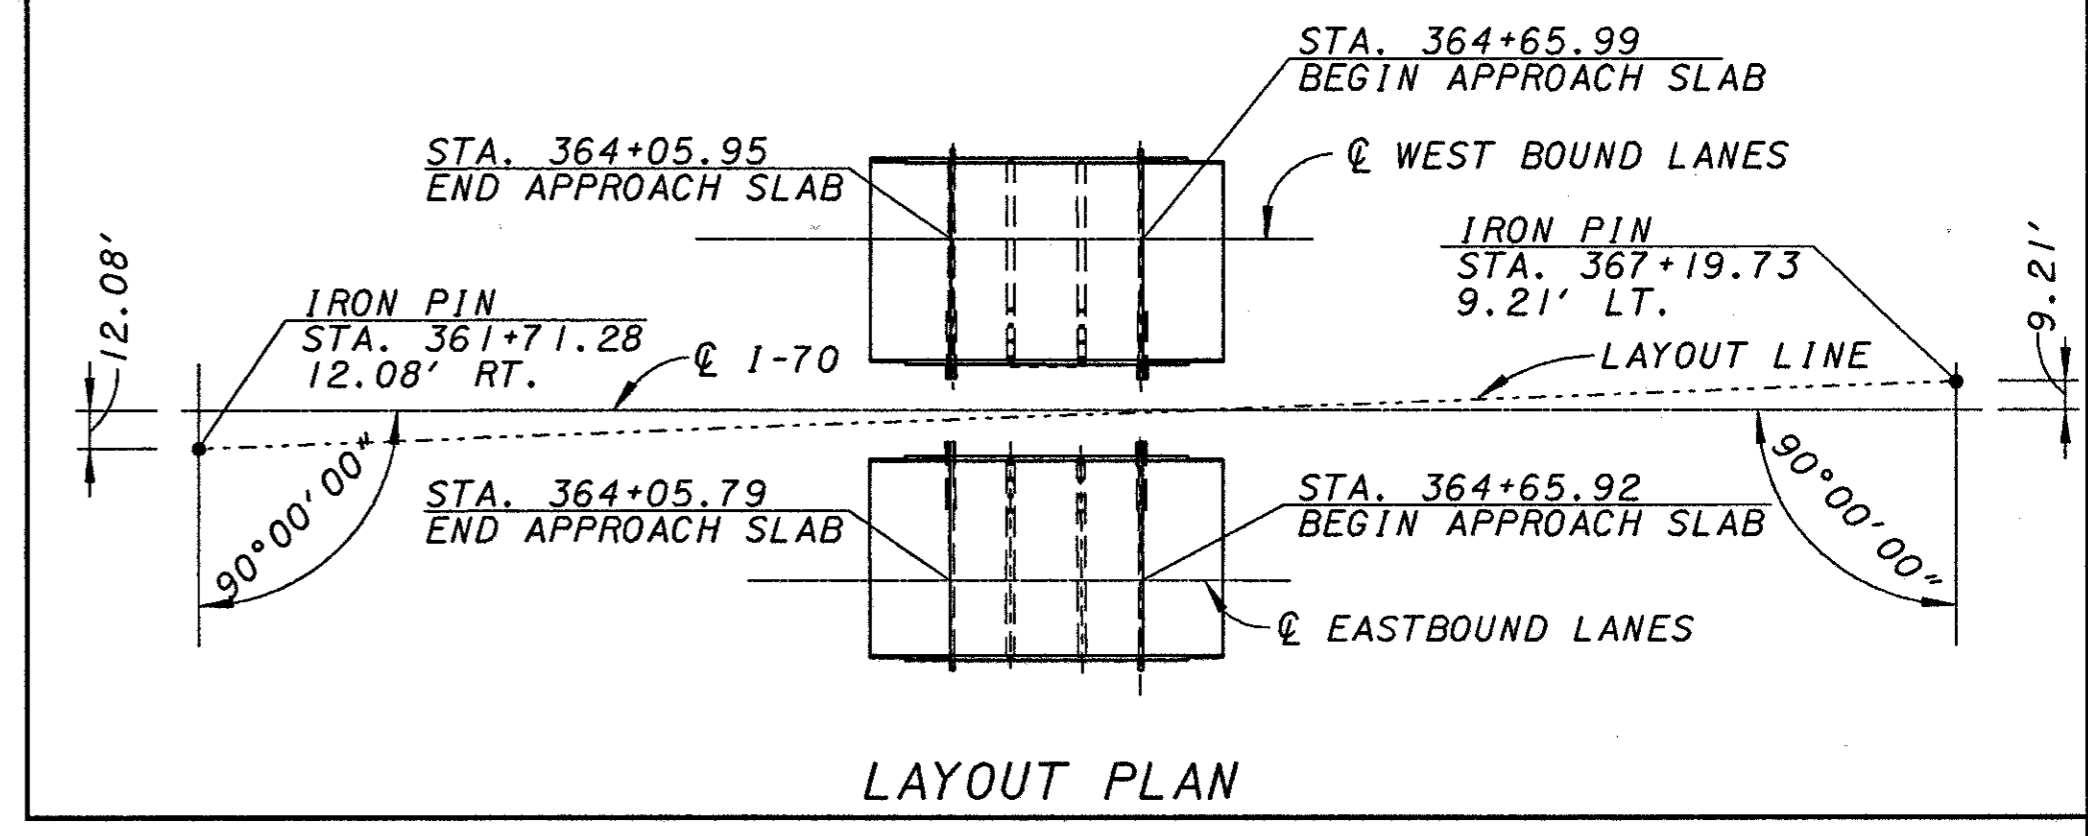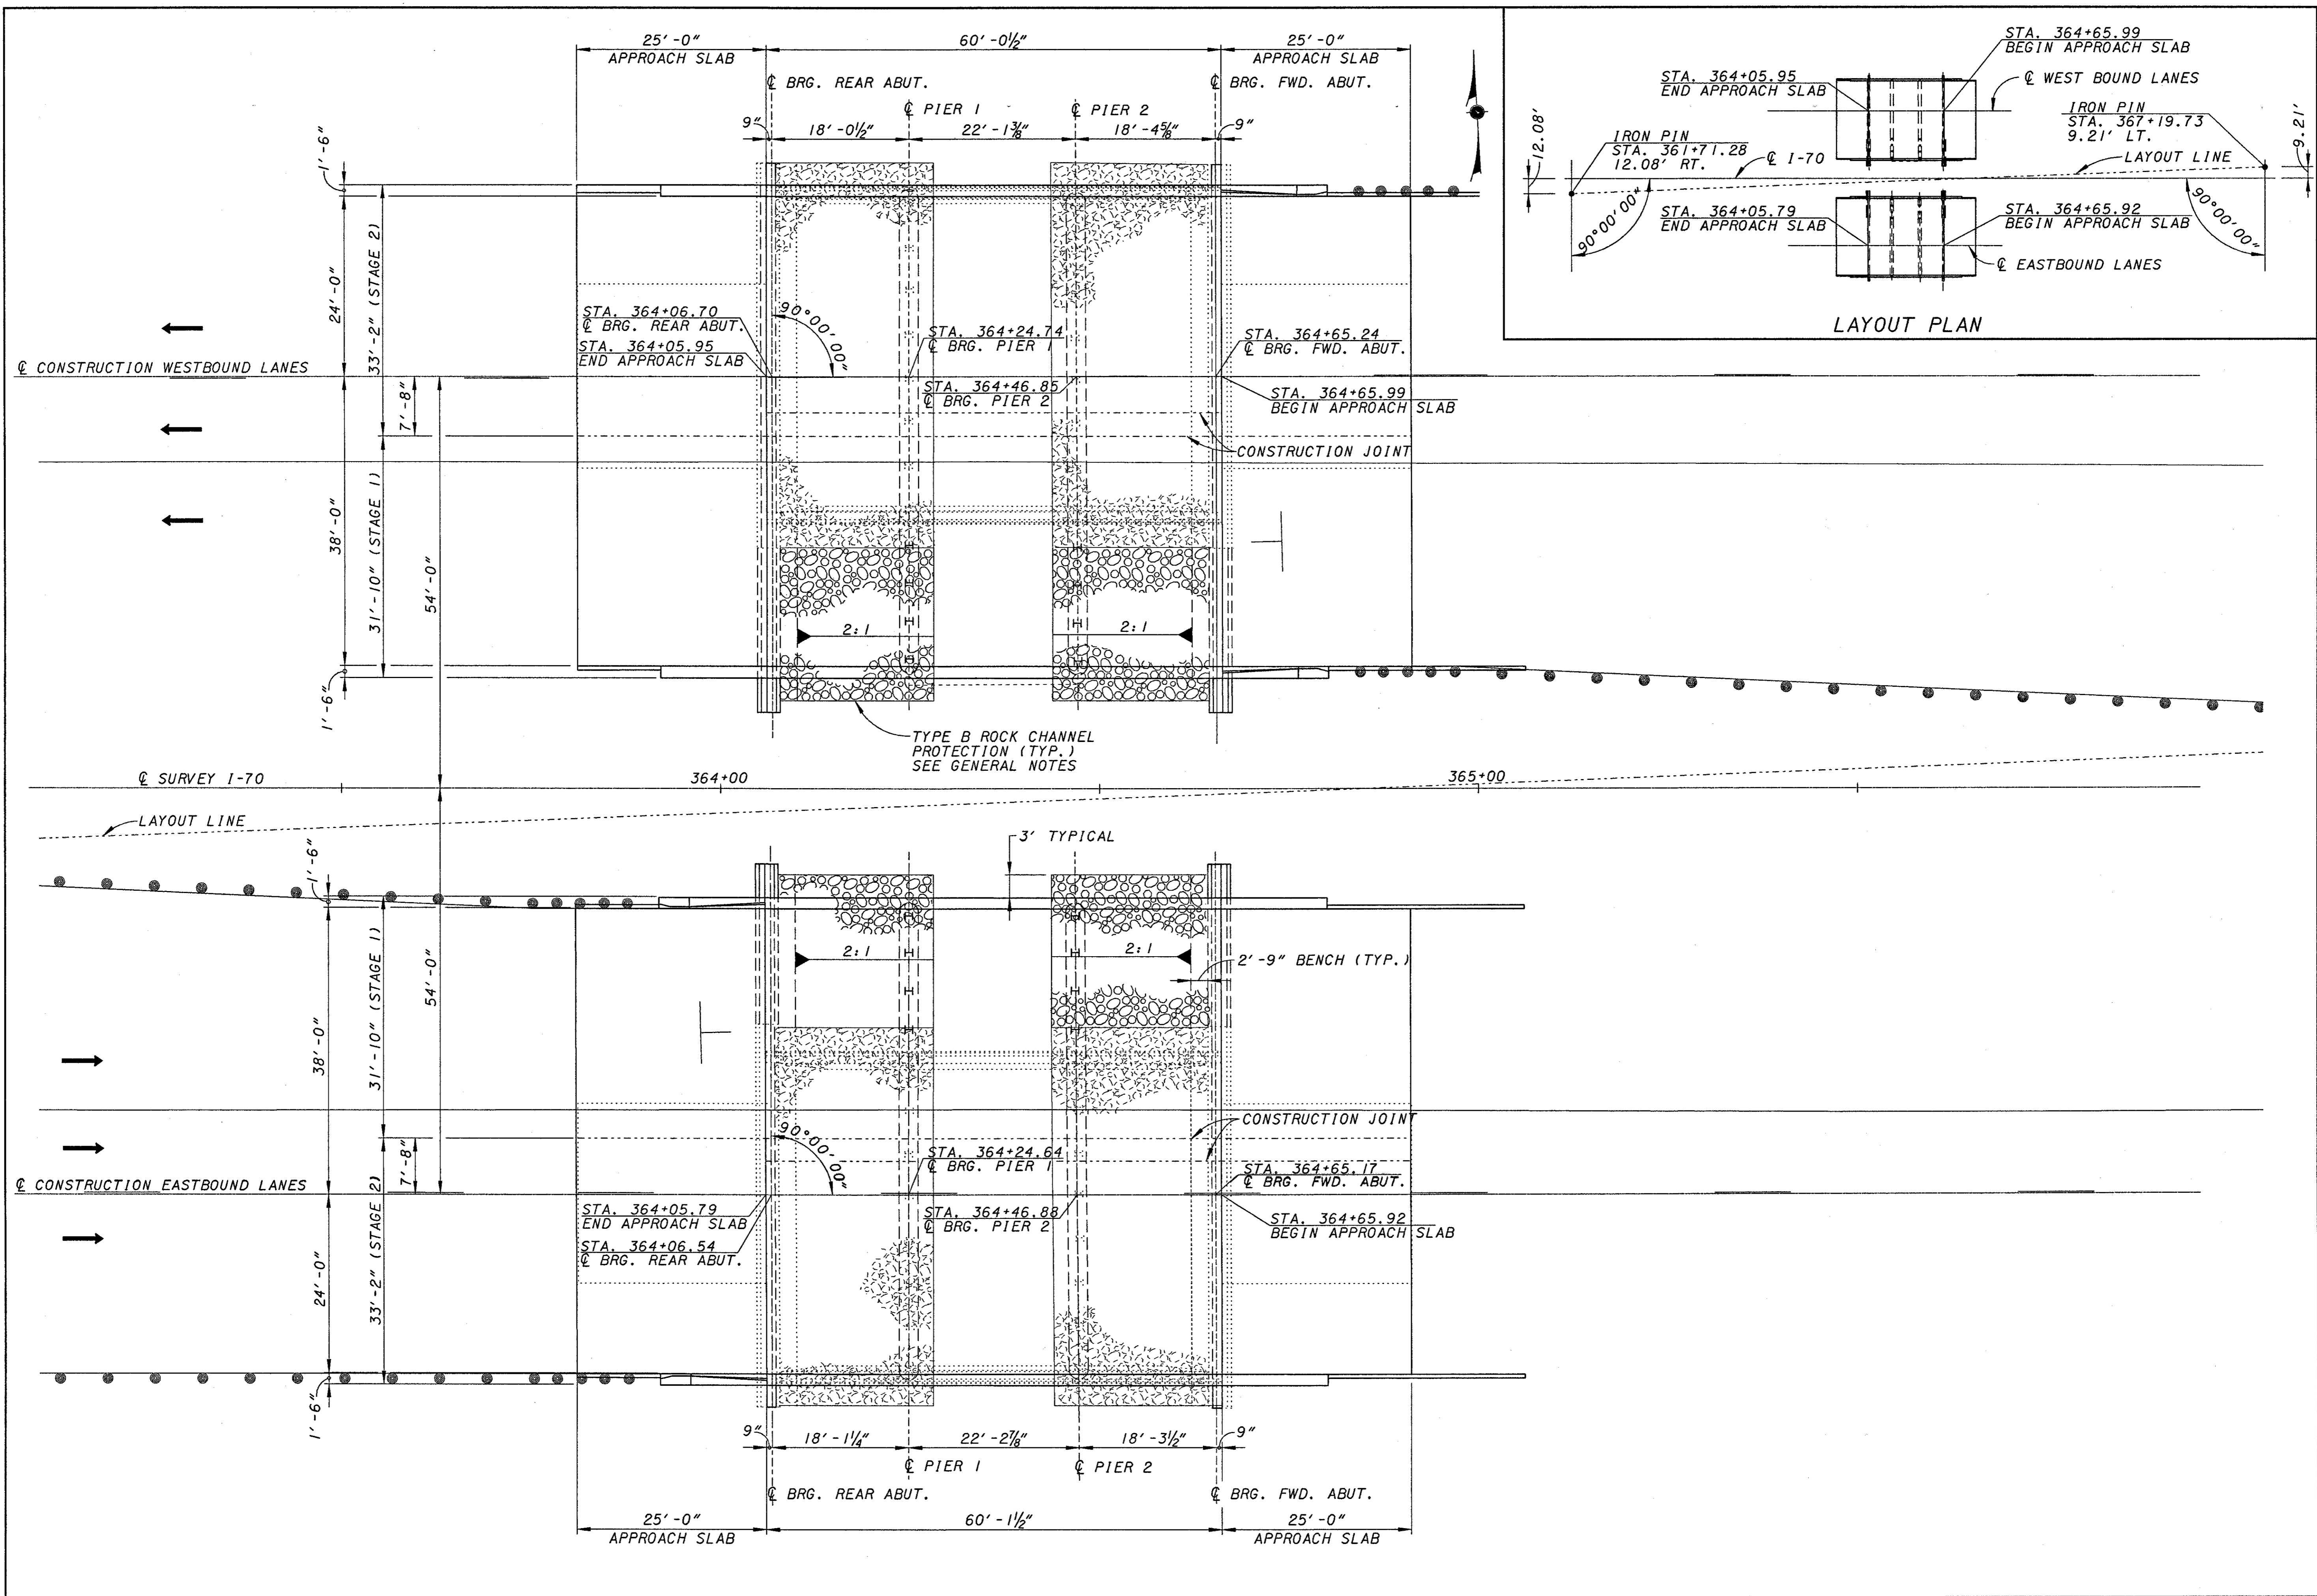

KZF DESIGN ARCHITECTURE ENGINEERING INTERIORS PLANNING 10000 W. BROADWAY, SUITE 1000, DENVER, CO 80202 TEL: 303.733.8881 FAX: 303.733.8880 WWW.KZFDESIGN.COM	DATE 7/06/00
	REVIEWED DGK
DRAWN JDC	STRUCTURE FILE NUMBER 6801021/6800998
DESIGNED SJA	CHECKED WBS
KZF #8	
GENERAL PLAN BRIDGE NO. PRE-70-0689 L/R I.R. 70 OVER BANTAS CREEK	
PRE-70-0.00	
2 / 17	
152 284	

REF: **REF**
REF: **REF**
REF: **REF**
REF: **REF**

REFERENCE: SHALL BE MADE TO STANDARD DRAWINGS :

AS-1-81 REVISED 09-15-94 (SHEETS 1,2 & 3)
BR-1 REVISED 1-6-99
CS-1-93 DATED 5-11-93
CPP-2-94 DATED 12-19-94

AND TO SUPPLEMENTAL SPECIFICATION:

842 DATED 1/6/99
844 DATED 5/5/98
899 DATED 10/21/98
954 DATED 9/9/97
911 DATED 7/10/97

DESIGN SPECIFICATIONS: THIS STRUCTURE CONFORMS TO "STANDARD SPECIFICATIONS FOR HIGHWAY BRIDGES" ADOPTED BY THE AMERICAN ASSOCIATION OF STATE HIGHWAY AND TRANSPORTATION OFFICIALS, 1996, INCLUDING THE 1997, 1998 AND 1999 INTERIM SPECIFICATIONS AND THE ODOT BRIDGE DESIGN MANUAL.

DESIGN LOADING: HS20-44 AND THE ALTERNATE MILITARY LOADING.

DESIGN STRESSES:

CLASS S CONCRETE - COMPRESSIVE STRENGTH 4500 PSI (28-DAY) (SUPERSTRUCTURE)
CLASS C CONCRETE - COMPRESSIVE STRENGTH 4000 PSI (28-DAY) (SUBSTRUCTURE)
STRUCTURAL STEEL - ASTM A36 - YIELD STRENGTH 36,000 PSI
REINFORCING STEEL - ASTM A615, A616 OR A617. EPOXY COATED GRADE 60 - MINIMUM YIELD STRENGTH 60,000 PSI.

DECK PROTECTION METHOD: EPOXY COATED REINFORCING STEEL, SEALING OF CONCRETE SURFACES, CLASS S CONCRETE AND 2 1/2" CONCRETE COVER.

MONOLITHIC WEARING SURFACE: IS ASSUMED, FOR DESIGN PURPOSES, TO BE 1" THICK.

REINFORCING BAR SPLICES: REINFORCING BAR SPLICE LENGTHS SHALL CONFORM TO THE MINIMUM LENGTHS SPECIFIED BY 509.08 OF THE C.M.S. UNLESS OTHERWISE NOTED ON THE PLANS.

UTILITY LINES: ALL EXPENSE INVOLVED IN RELOCATION OF THE AFFECTED UTILITY LINES SHALL BE BORNE BY THE UTILITY. THE CONTRACTOR AND UTILITY ARE TO COOPERATE BY ARRANGING THEIR WORK IN SUCH A MANNER THAT INCONVENIENCE TO EITHER WILL BE HELD TO A MINIMUM.

REINFORCING CLEARANCE: UNLESS OTHERWISE NOTED, MINIMUM REINFORCING STEEL CLEARANCE TO FACE OF CONCRETE IS 2".

PROPOSED WORK

1. REMOVE EXISTING CONCRETE DECK, PARAPETS, SCUPPERS, APPROACH SLABS AND PORTIONS OF CONCRETE SUBSTRUCTURES IN A SEQUENCE CONSISTENT WITH MAINTENANCE OF TRAFFIC PLANS AND NOTES AND STAGE CONSTRUCTION.
2. DRIVE PILING AND CONSTRUCT NEW ABUTMENT AND PIER CAPS.
3. CONSTRUCT A NEW CONCRETE DECK AT ELEVATIONS TO MEET OVERLAY ON EXISTING ROADWAY APPROACHES.
4. CONSTRUCT NEW CONCRETE APPROACH SLABS.
5. CONSTRUCT NEW CONCRETE BARRIERS ON DECK AND APPROACH SLABS.
6. PATCH CONCRETE SUBSTRUCTURES AS DIRECTED.
7. CLEAN AND SEAL CONCRETE BARRIERS, ABUTMENTS AND PIERS.

ITEM 202 - PORTIONS OF STRUCTURE REMOVED, AS PER PLAN

DESCRIPTION: THIS WORK SHALL CONSIST OF THE REMOVAL OF CONCRETE DECKS INCLUDING PARAPETS AND OTHER APPURTENANCES. PORTIONS OF THE PIERS AND ABUTMENTS SHALL ALSO BE REMOVED AS SHOWN ON THE PLANS. CARE SHALL BE TAKEN DURING REMOVALS TO PROTECT PORTIONS OF THE EXISTING STRUCTURE THAT ARE TO BE SALVAGED AND INCORPORATED INTO THE PROPOSED STRUCTURE. IN THIS RESPECT, THE USE OF EXPLOSIVES, HEADACHE BALLS AND/OR HOE-RAM TYPE OF EQUIPMENT IS PROHIBITED. ALL REMOVALS SHALL BE CONSISTENT WITH THE STAGE CONSTRUCTION REQUIREMENTS. EVERY EFFORT SHALL BE MADE TO KEEP DECK MATERIALS OUT OF THE STREAM CHANNEL. IF ANY MATERIAL FALLS INTO THE WATER, THE MATERIAL SHALL BE REMOVED IMMEDIATELY. ALL CONSTRUCTION DEBRIS AND OR EXCESS FILL MATERIAL SHALL BE DISPOSED AT AN ENGINEER APPROVED UPLAND SITE. (A DISPOSAL SITE LOCATED ABOVE THE 100-YEAR FLOOD PLAIN.) ALL WORK SHALL BE PERFORMED TO THE SATISFACTION OF THE ENGINEER.

PROTECTION OF TRAFFIC: PRIOR TO DEMOLITION OF ANY PORTIONS OF THE EXISTING SUPERSTRUCTURE, THE CONTRACTOR SHALL SUBMIT HIS PLANS FOR THE PROTECTION OF TRAFFIC (VEHICULAR, BOAT, ETC.) ADJACENT TO AND/OR UNDER THE STRUCTURE TO THE ENGINEER FOR APPROVAL. THESE PLANS SHALL INCLUDE PROVISIONS FOR ANY DEVICES AND STRUCTURES THAT MAY BE NECESSARY TO ENSURE SUCH PROTECTION. TEMPORARY VERTICAL CLEARANCES SPECIFIED ON THE PLANS OR IN THE PROPOSAL SHALL BE MAINTAINED AT ALL TIMES EXCEPT AS OTHERWISE APPROVED BY THE ENGINEER.

REMOVAL METHODS: CONCRETE MAY BE REMOVED BY CUTTING AND BY MEANS OF HAND OPERATED PNEUMATIC HAMMERS EMPLOYING POINTED OR BLUNTED CHISEL TYPE TOOLS. FOR REMOVALS, A HAMMER HEAVIER THAN 35 POUNDS BUT NOT TO EXCEED 90 POUNDS MAY BE USED AT THE APPROVAL OF THE ENGINEER, TO ENSURE ADEQUATE DEPTH CONTROL AND TO PREVENT DAMAGE TO CONCRETE SUBSTRUCTURES.

SUBSTRUCTURE CONCRETE REMOVAL SHALL BE BY MEANS OF APPROVED PNEUMATIC HAMMERS EMPLOYING POINTED AND BLUNT CHISEL TOOLS. HYDRAULIC HOE-RAM TYPE HAMMERS WILL NOT BE PERMITTED. THE WEIGHT OF THE HAMMER SHALL NOT BE MORE THAN 35 POUNDS FOR REMOVAL WITHIN 18 INCHES OF PORTIONS TO BE PRESERVED. OUTSIDE THE 18 INCH LIMIT, A HAMMER HEAVIER THAN 35 POUNDS, BUT NOT TO EXCEED 90 POUNDS MAY BE USED AT THE APPROVAL OF THE ENGINEER. PNEUMATIC HAMMERS SHALL NOT BE PLACED IN DIRECT CONTACT WITH REINFORCING STEEL THAT IS TO BE RETAINED IN THE REBUILT STRUCTURE.

ROCK CHANNEL PROTECTION

BROKEN CONCRETE FROM THE EXISTING BRIDGE DECK MAY BE USED FOR ROCK CHANNEL PROTECTION. MATERIAL CAN BE EITHER TYPE B OR TYPE C WITH A MINIMUM OF 50% OF THE MATERIAL BEING TYPE B.

IN-STREAM STRUCTURES

THE CONTRACTOR SHALL KEEP IN-STREAM STRUCTURES TO THE MINIMUM SIZE NEEDED TO FACILITATE PROJECT WORK. THE CONTRACTOR SHALL REMOVE IN-STREAM STRUCTURES AND RESTORE THE CHANNEL TO ORIGINAL GRADE IMMEDIATELY FOLLOWING COMPLETION OF IN-STREAM WORK.

PILE DESIGN LOADS

THE ULTIMATE BEARING VALUE IS 37 TONS PER PILE FOR THE ABUTMENT PILES. THE ULTIMATE BEARING VALUE IS 44 TONS PER PILE FOR THE PIER PILES.

LOADING LIMITATION: NO PART OF THE STRUCTURE SHALL BE SUBJECTED TO UNIT STRESSES THAT EXCEED 136.5% OF THE ALLOWABLE UNIT STRESSES GIVEN IN THE AASHTO STANDARD SPECIFICATIONS FOR HIGHWAY BRIDGES DUE EITHER TO DEMOLITION, ERECTION OR CONSTRUCTION METHODS, OR TO THE USE OR MOVEMENT OF DEMOLITION OR ERECTION EQUIPMENT ON OR ACROSS THE STRUCTURE. STRUCTURAL ANALYSIS COMPUTATIONS, BY A REGISTERED PROFESSIONAL ENGINEER, SHOWING THE ALLOWABLE STRESSES AND THE MAXIMUM STRESSES PRODUCED BY THE CONTRACTOR'S METHODS OR EQUIPMENT SHALL BE SUBMITTED TO THE DIRECTOR FOR REVIEW AND APPROVAL AT LEAST TWO WEEKS PRIOR TO THE START OF THE WORK.

REF: **REF**
REF: **REF**
DATE	7/06/00
REVIEWED	DGK
STRUCTURE FILE NUMBER	6801021/6800998
DRAWN	JDC
REVISION	
DESIGNED	SJA
CHECKED	WBS

KZF #8

GENERAL NOTES
BRIDGE NO. PRE-70-0689 L/R
I.R. TO OVER BANTAS CREEK

PRE-70-0.00

3 / 17

153
284

REF: **REF1**
REF: **REF2**
REF: **REF3**
REF: **REF4**
REF: **REF5**

REF: **REF1**
REF: **REF2**
REF: **REF3**
REF: **REF4**
REF: **REF5**

REF: **REF1**
REF: **REF2**
REF: **REF3**
REF: **REF4**
REF: **REF5**

REF: **REF1**
REF: **REF2**
REF: **REF3**
REF: **REF4**
REF: **REF5**

USER: **USER**
DATE: **DATE**
TIME: **TIME**
ACTIVE LEVELS ON: **LEVELS**

PILE ENCASEMENT

ALL PILES FOR THE CAPPED PILE PIERS SHALL BE ENCASED IN CLASS S OR CLASS C CONCRETE (SS 899.03) AND SHALL BE IN ACCORDANCE WITH SS 842, EXCEPT AS MODIFIED HEREIN. THE REQUIRED SLUMP IS 6 INCHES, PLUS OR MINUS 2 INCHES. THE MAXIMUM WATER CEMENT RATIO SHALL BE 0.50. IF CONCRETE IS PLACED UNDER WATER, THE REQUIREMENTS OF ADDING 10 PERCENT MORE CEMENT TO THE CONCRETE SHALL BE WAIVED. THE CONCRETE SHALL BE PLACED WITHIN A FORM THAT CONSISTS OF POLYETHYLENE PIPE (707.33), OR PVC PIPE (707.42). THE ENCASEMENT SHALL EXTEND FROM 3 FEET BELOW THE FINISHED GROUND SURFACE UP TO THE CONCRETE PIER CAP AND SHALL BE POSITIONED SO THAT AT LEAST 3 INCHES OF CONCRETE COVER IS PROVIDED AROUND THE EXTERIOR OF THE PILE.

IN LIEU OF ENCASING THE PILE IN CONCRETE, AT THE OPTION OF THE CONTRACTOR, THE PILE MAY BE GALVANIZED AS PER 711.02. THE GALVANIZING SHALL BE CONTINUOUS FROM A MINIMUM OF 3 FEET BELOW THE FINISH GROUND SURFACE UP TO THE CONCRETE PIER CAP. THE GALVANIZED COATING THICKNESS SHALL BE A MINIMUM OF 4 MILS. ALL GOUGES, SCRAPES, SCRATCHES OR OTHER SURFACE IMPERFECTIONS CAUSED BY THE HANDLING OR THE DRIVING OF THE PILE SHALL BE REPAIRED TO THE SATISFACTION OF THE ENGINEER.

REPLACEMENT OF EXISTING REINFORCING STEEL: ANY EXISTING REINFORCING BARS WHICH ARE TO BE INCORPORATED INTO THE NEW WORK AND WHICH ARE MADE UNUSABLE BY THE CONTRACTOR'S CONCRETE REMOVAL OPERATIONS SHALL BE REPLACED WITH NEW STEEL AT HIS COST. ANY EXISTING REINFORCING BARS WHICH ARE DEEMED BY THE ENGINEER TO BE UNUSABLE BECAUSE OF CORROSION SHALL BE REPLACED WITH NEW REINFORCING STEEL.

EXISTING STRUCTURE VERIFICATION: DETAILS AND DIMENSIONS SHOWN ON THESE PLANS PERTAINING TO THE EXISTING STRUCTURE HAVE BEEN OBTAINED FROM PLANS OF THE EXISTING STRUCTURE AND/OR FROM FIELD OBSERVATIONS AND MEASUREMENTS. CONSEQUENTLY, THEY ARE INDICATIVE OF THE EXISTING STRUCTURE AND THE PROPOSED WORK BUT THEY SHALL BE CONSIDERED TENTATIVE AND APPROXIMATE. THE CONTRACTOR IS REFERRED TO CMS SECTIONS 102.05 AND 105.02.

CONTRACT BID PRICES SHALL BE BASED UPON A RECOGNITION OF THE UNCERTAINTIES DESCRIBED ABOVE AND UPON A PREBID EXAMINATION OF THE EXISTING STRUCTURE BY THE CONTRACTOR. HOWEVER, ALL PROJECT WORK SHALL BE BASED UPON ACTUAL DETAILS AND DIMENSIONS WHICH HAVE BEEN VERIFIED BY THE CONTRACTOR IN THE FIELD.

EXISTING STRUCTURE PLANS:

THE ORIGINAL DESIGN PLANS MAY BE EXAMINED AT THE DEPARTMENT OF TRANSPORTATION, DISTRICT 8 OFFICE, 505 SOUTH S.R. 741 LEBANON, OHIO 45036 (800) 831-2142. THE CONTRACTOR SHALL BECOME FAMILIAR WITH THESE DRAWINGS.

ITEM 846 - TREATING CONCRETE WITH HMWM RESIN

SEAL THE CONSTRUCTION JOINT IN THE BRIDGE DECK AND APPROACH SLABS AS SHOWN IN THE PLANS. SEE SUPPLEMENTAL SPECIFICATIONS FOR SURFACE PREPARATION AND RATE OF APPLICATION.

SEAL PIER CAPS, WINGWALLS, ABUTMENTS, PARAPETS, AND DECK EDGES WITH EPOXY-URETHANE: COLOR SHALL BE FEDERAL COLOR STANDARD 17778 (OFF-WHITE)

THIS WORK SHALL CONSIST OF FURNISHING ALL NECESSARY LABOR, MATERIALS AND EQUIPMENT TO SEAL THE DESIGNATED EXPOSED CONCRETE SURFACE AREAS IN ACCORDANCE WITH THE PROJECT PROPOSAL DOCUMENT (PAGE 30) ENTITLED, ITEM SPECIAL - SEALING OF CONCRETE SURFACES

PATCH SUBSTRUCTURE CONCRETE

PATCHING SUBSTRUCTURE CONCRETE SHALL BE PERFORMED IN ACCORDANCE WITH THE STATE OF OHIO DEPARTMENT OF TRANSPORTATION CONSTRUCTION AND MATERIAL SPECIFICATIONS ITEM 519 PATCHING CONCRETE STRUCTURES. THE LOCATION AND SURFACE AREA EXTENT OF PATCHING CONCRETE STRUCTURES SHALL BE FIELD-DETERMINED BY THE ODOT PROJECT ENGINEER. THE CONTRACTOR SHALL PROVIDE THE PROJECT ENGINEER ACCESS TO CONCRETE SURFACES FOR INSPECTION. THE CONTRACTOR SHALL PROVIDE THE ENGINEER AEROSOL PAINT FOR THE PURPOSE OF MARKING SUBSTRUCTURE CONCRETE TO BE PATCHED.

ENVIRONMENTAL COOMMITMENTS & RESOURCES TO BE AVOIDED

THE CONTRACTOR SHALL REFER TO THE STORMWATER POLLUTION PREVENTION PLAN (SWAPP) TO ADDRESS EROSION ASSOCIATED WITH SHOULDER DISTURBANCE/ RECONSTRUCTION AND BRIDGE WORK. (CMS 877.03)
ALL CONDITIONS ATTACHED WITH CORPS PERMIT (NATIONWIDE 3 & 14) SHALL BE IMPLEMENTED IN THE FIELD WITH THE ACTUAL PERMIT BEING DISPLAYED ONSITE. EVERY EFFORT SHALL BE MADE TO KEEP DECK MATERIAL OUT OF THE STREAM CHANNELS. IF ANY MATERIAL FALLS INTO THE WATER, IT SHALL BE REMOVED IMMEDIATELY. ALL DEBRIS OR EXCESS FILL MATERIAL SHOULD BE DISPOSED AT AN APPROVED UPLAND SITE. (ABOVE THE 100 YR. FLOODPLAIN)
IN-STREAM STRUCTURES SHALL BE KEPT TO THE MINIMAL SIZE NEEDED TO FACILITATE WORK AND WILL BE REMOVED IMMEDIATELY TO ORIGINAL GRADE AFTER IN-STREAM WORK IS COMPLETED.
WHILE PAINTING, SANDBLASTING OR SEALING OF ANY PORTION OF THE BRIDGE AN APPROPRIATE APRON WILL BE UTILIZED TO PREVENT DEBRIS AND PAINT OVERSPRAY AND SEALANTS FROM ENTERING INTO THE STREAM.
PROPER SEDIMENT AND EROSION CONTROLS SHALL BE IMPLEMENTED THROUGHOUT THE COURSE OF THE PROJECT. ALL DISTURBED AREAS SHALL BE SEEDED AND MULCHED IMMEDIATELY UPON COMPLETION OF EARTHWORK (ODOT CMS ITEM 877) IMPLEMENT ODOT CMS ITEM 616, DUST CONTROL AS NECESSARY.
COMPLY WITH ODOT CMS ITEM 107.21 CONTROLLING POLLUTION OF THE ENVIRONMENT.
VEGETATION REMOVAL WILL BE HELD TO AN ABSOLUTE MINIMUM REQUIRED TO COMPLETE THE WORK.

REF: **REF**
REF: **REF**

REF: **REF**
REF: **REF**
REF: **REF**
REF: **REF**

BASELINE CASES
CASES WITH WARRING
PERMITS FOR CONSTRUCTION
ACTIVE LEVELS ON **ELEV**

 DENOTES PORTION OF EXISTING STRUCTURE TO BE REMOVED.

CL SURVEY 1-70

CL EAST BOUND LANES

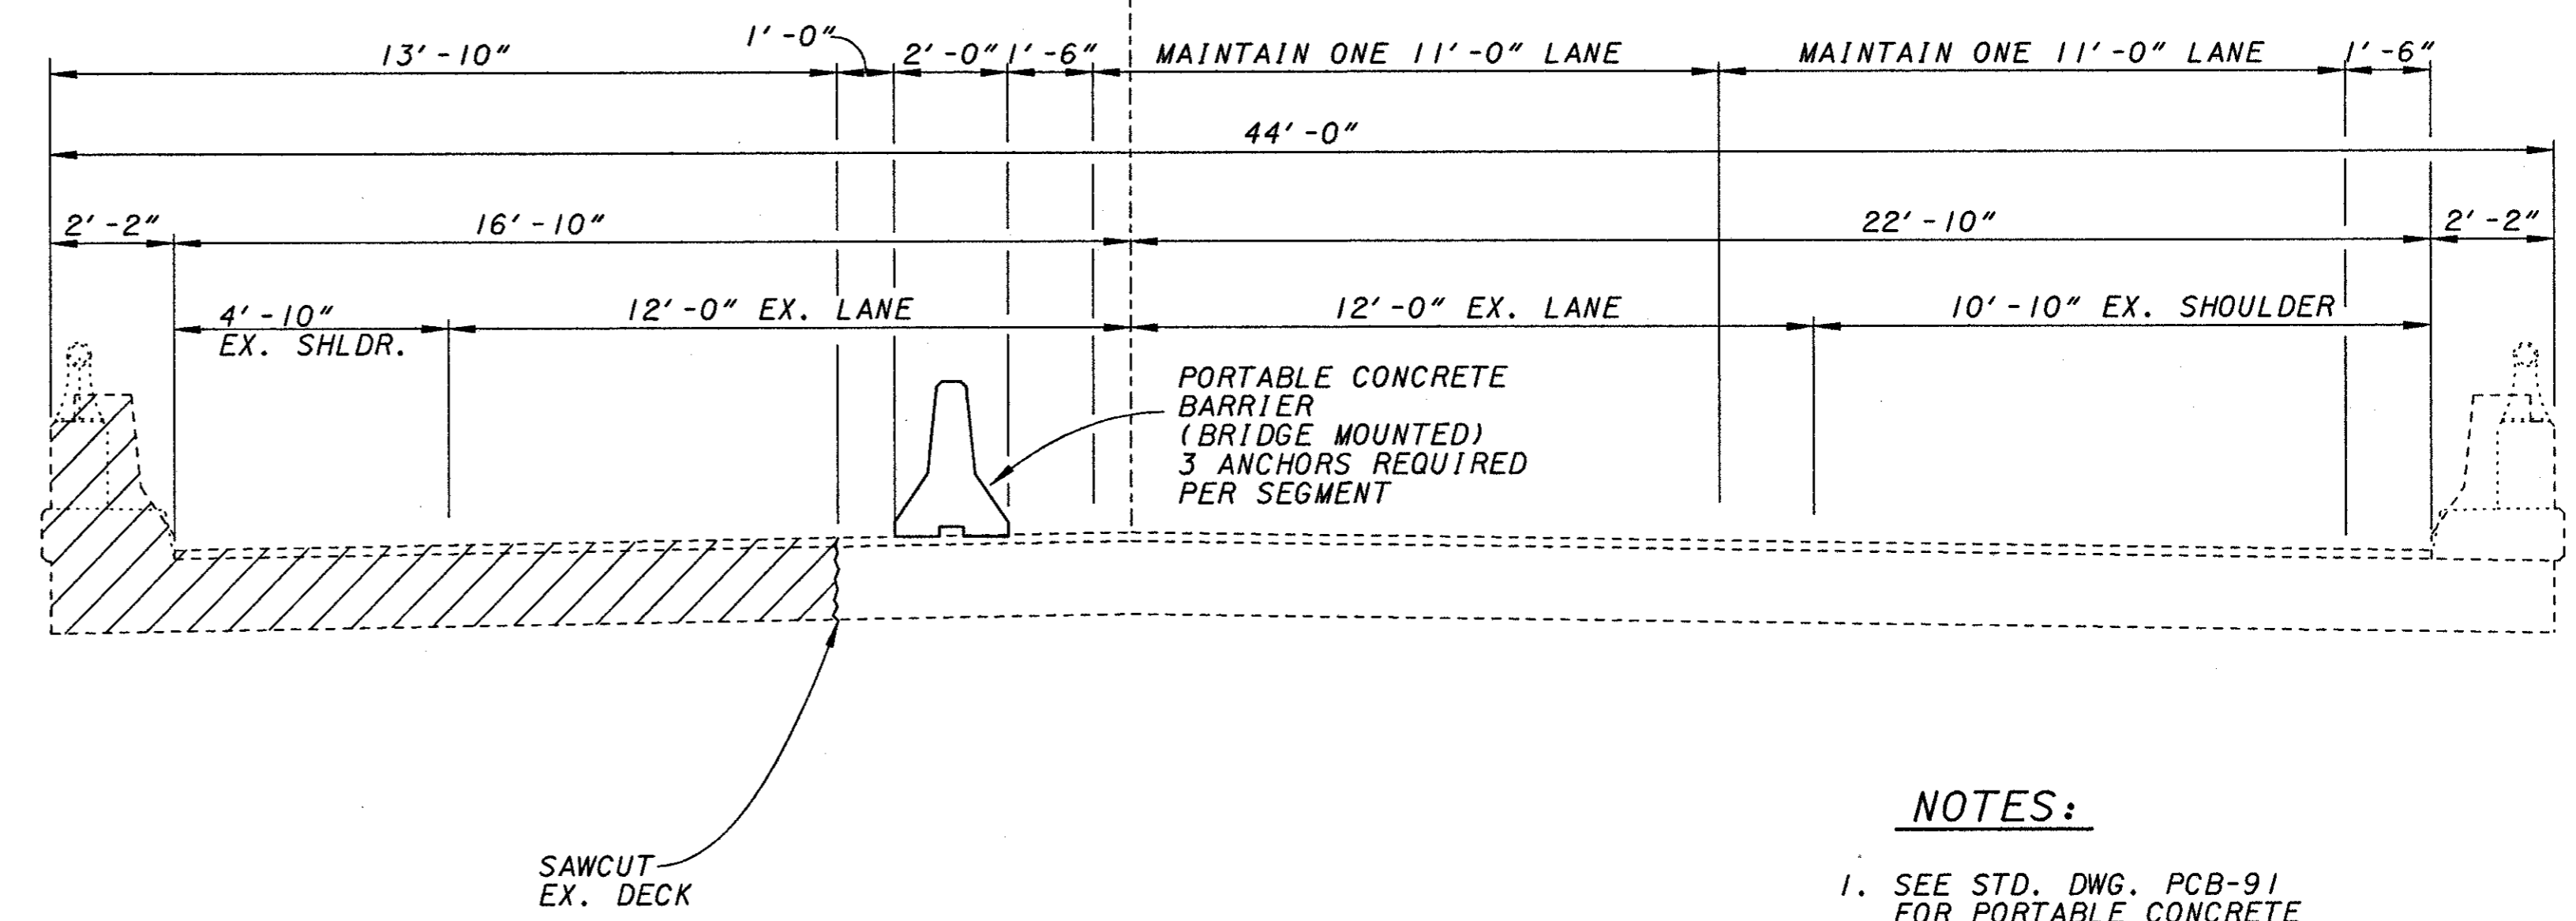


STAGE IA

NOTES:

- 1. SEE STD. DWG. PCB-91 FOR PORTABLE CONCRETE BARRIER DETAILS AND NOTES.
- 2. EASTBOUND BRIDGE SHOWN WESTBOUND BRIDGE SIMILAR.

54'-0"

CL EAST BOUND LANES

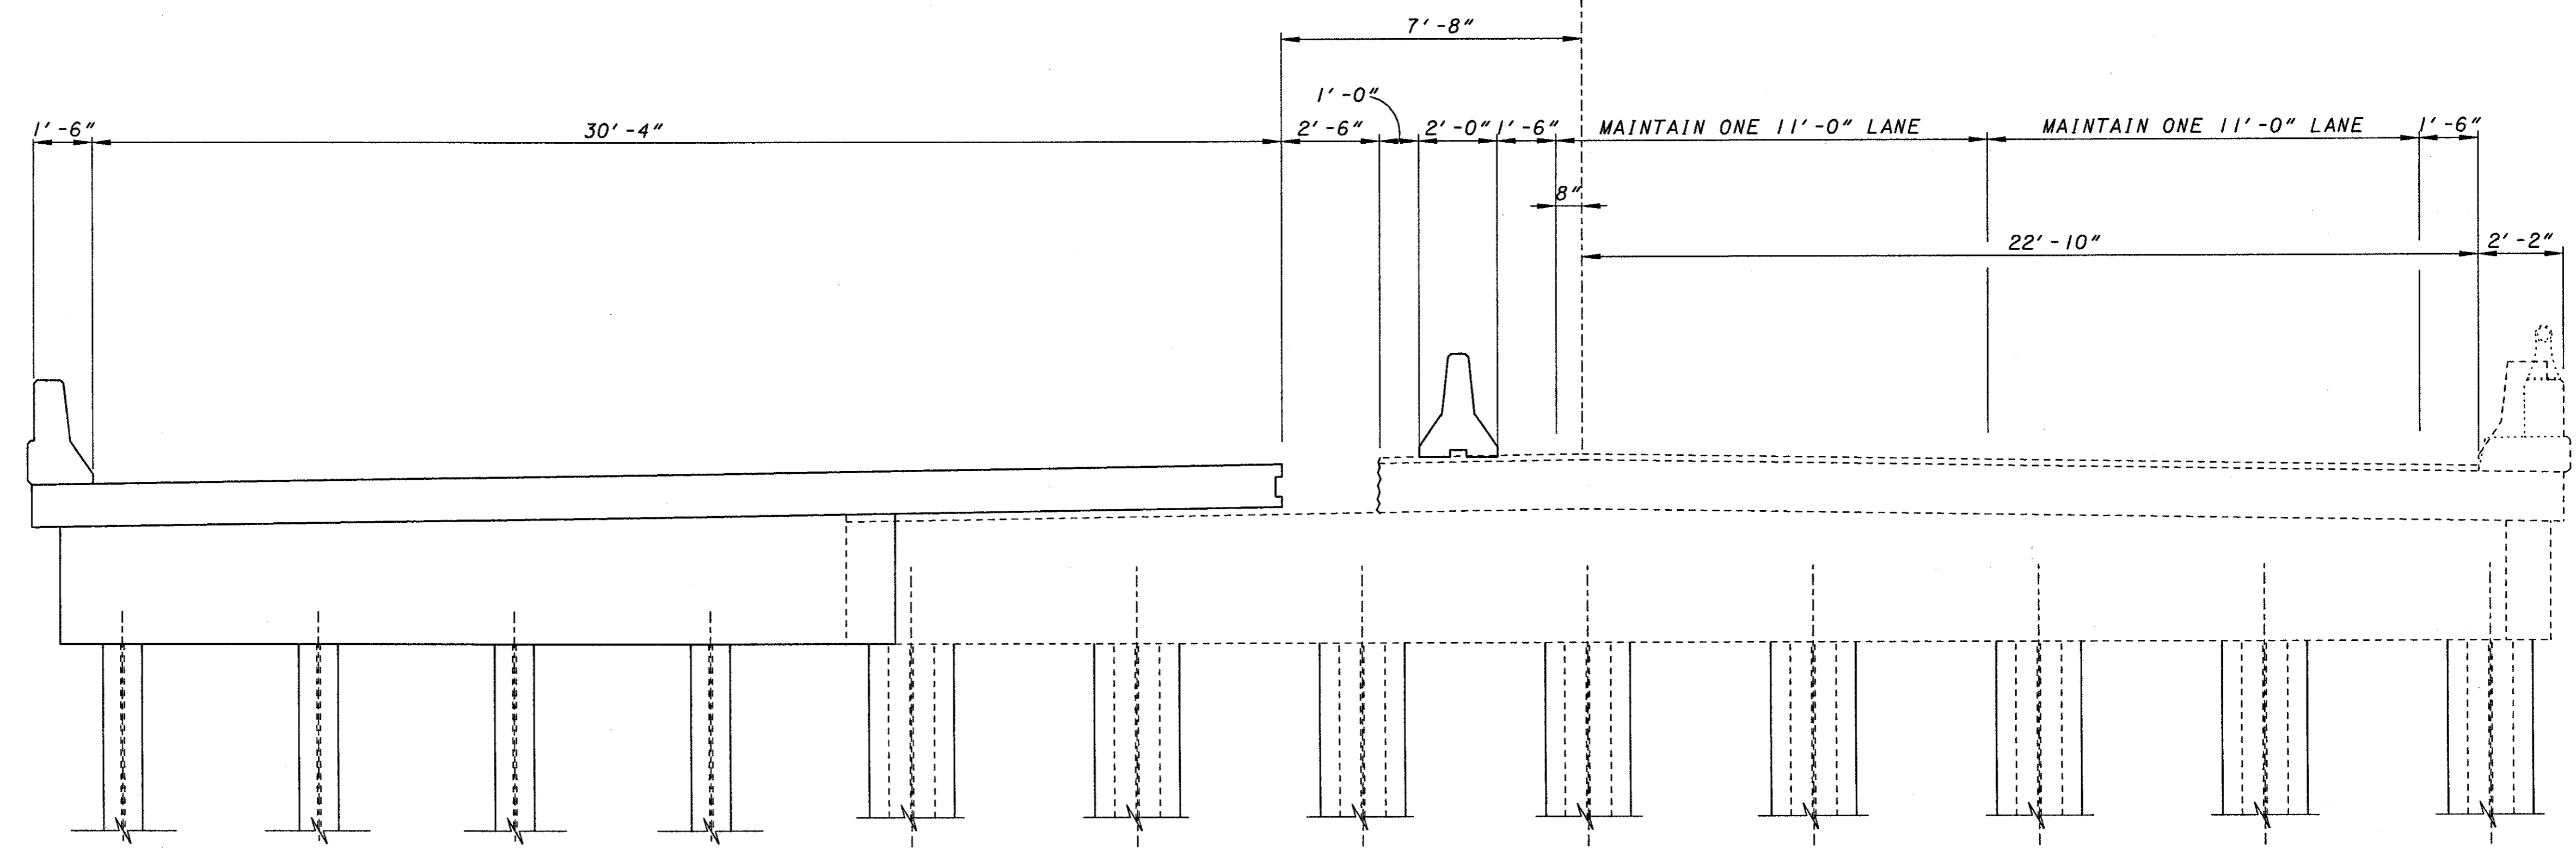

STAGE IB

DATE	7/06/00
REVIEWED	DGK
STRUCTURE FILE NUMBER	68010216800998
DRAWN	SJA
REVIS	
DESIGNED	SJA
CHECKED	WBS

EASTBOUND BRIDGE STAGE I CONSTRUCTION #8
BRIDGE NO. PRE-70-0689 L/R
I.R. 70 OVER BANTAS CREEK

PRE-70-0.00


REF: **REF**
REF: **REF**
DATE: 7/20/00
USER: SJA
PROJECT: BRIDGE STAGE 2 CONSTRUCTION
DRAWING: PRE-70-0689 L/R
ACTIVE LEVELS ON: #8LEV**

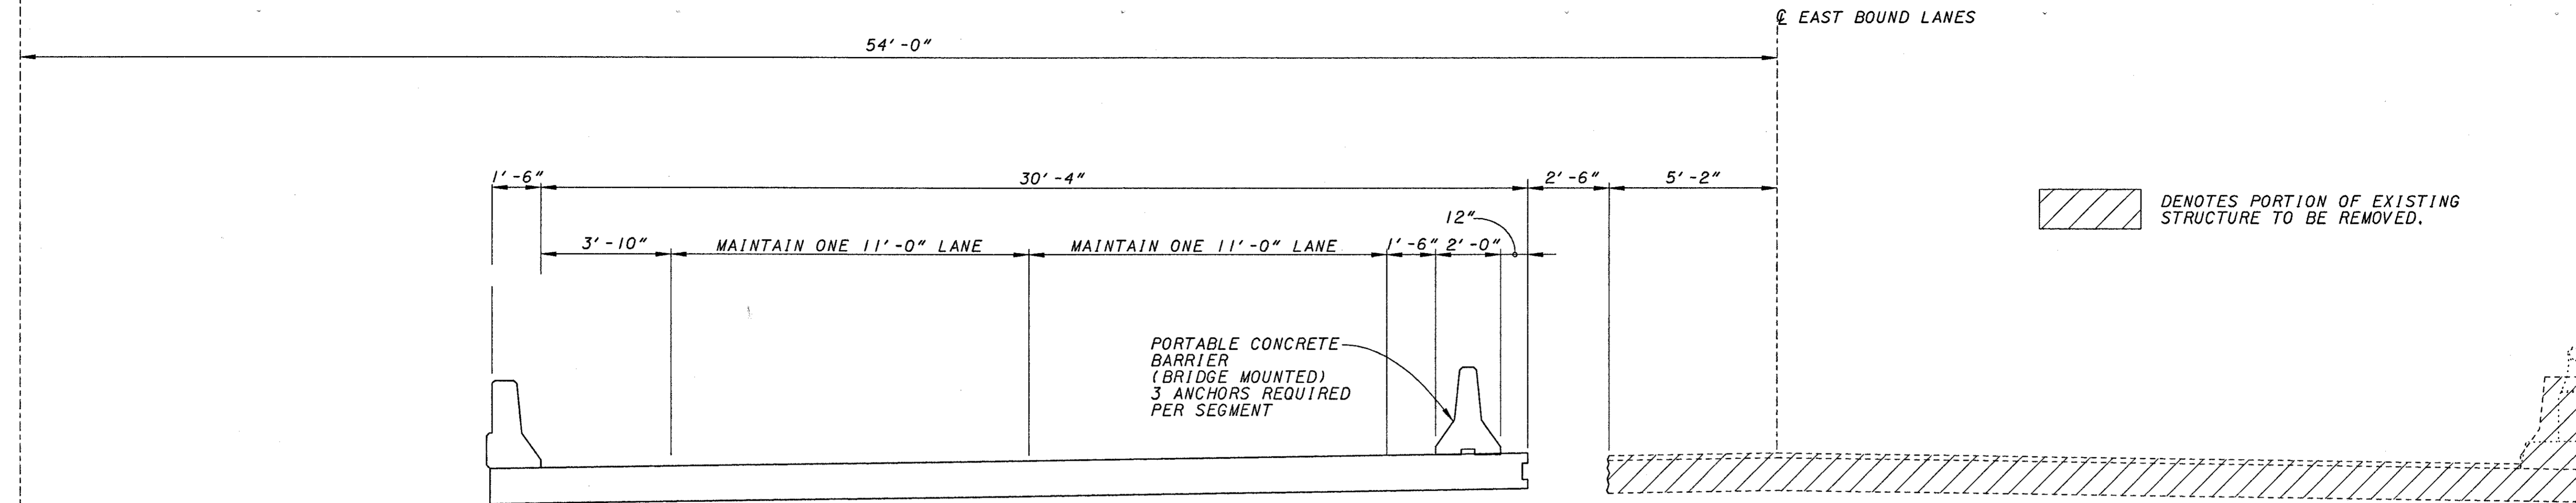

 DENOTES PORTION OF EXISTING STRUCTURE TO BE REMOVED.

☉ SURVEY 1-70

STAGE 2A

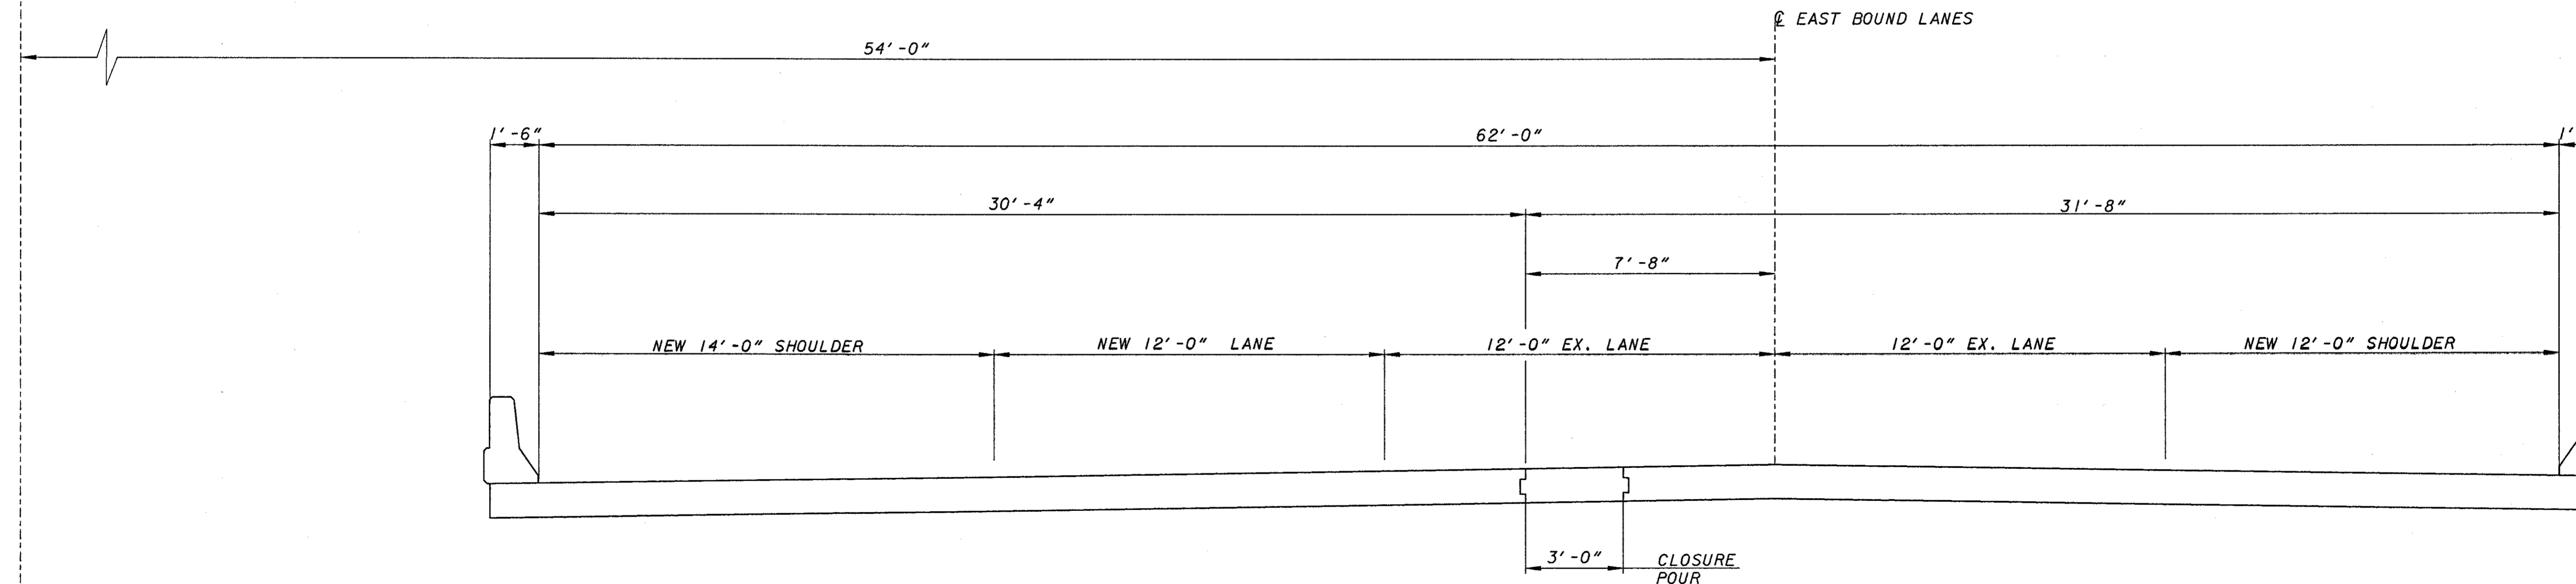

☉ SURVEY 1-70

STAGE 2B

DATE	7/20/00
REVIEWED	DGK
STRUCTURE FILE NUMBER	6801021/6800998
DRAWN	SJA
REVISED	
DESIGNED	SJA
CHECKED	WBS

KZF #8

BRIDGE STAGE 2 CONSTRUCTION
BRIDGE NO. PRE-70-0689 L/R
I.R. 70 OVER BANTAS CREEK

PRE-70-0.00

REF: *****
 REF: *****

REF: *****
 REF: *****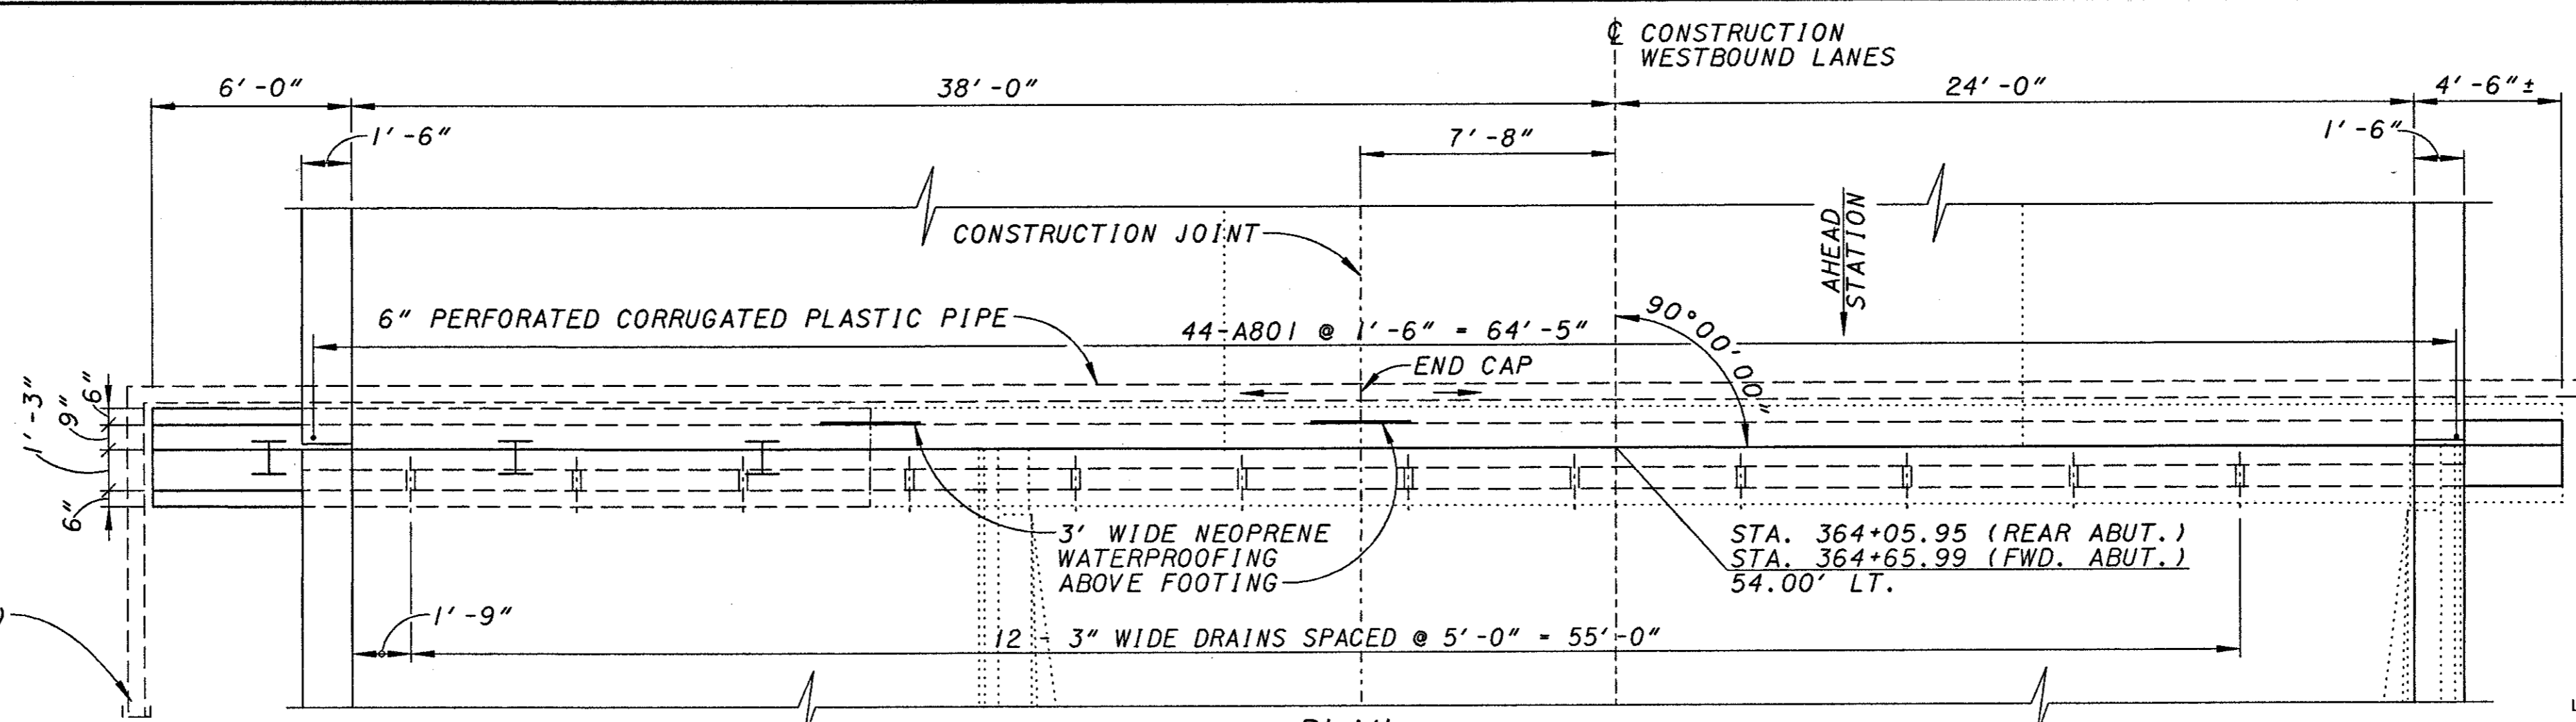
PLAN
 REAR ABUTMENT SHOWN,
 FORWARD ABUTMENT OPPOSITE HAND

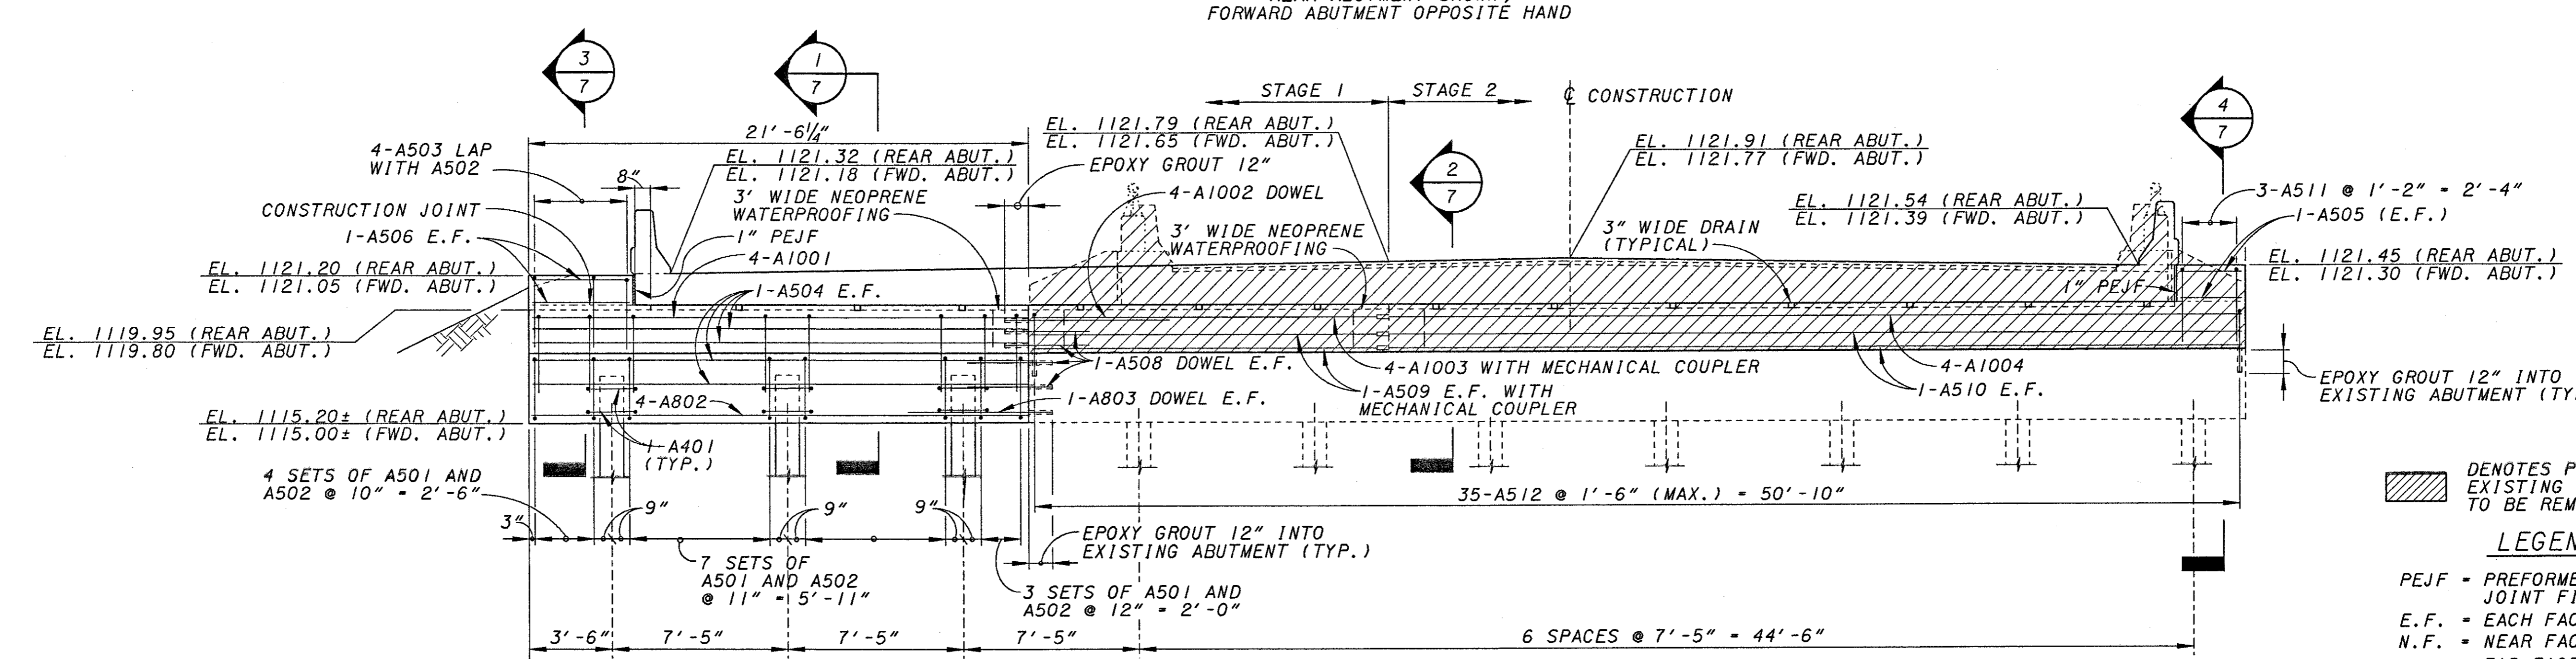


ELEVATION


DENOTES PORTION OF
 EXISTING STRUCTURE
 TO BE REMOVED

LEGEND


- PEJF - PREFORMED EXPANSION JOINT FILLER
- E.F. - EACH FACE
- N.F. - NEAR FACE
- F.F. - FAR FACE

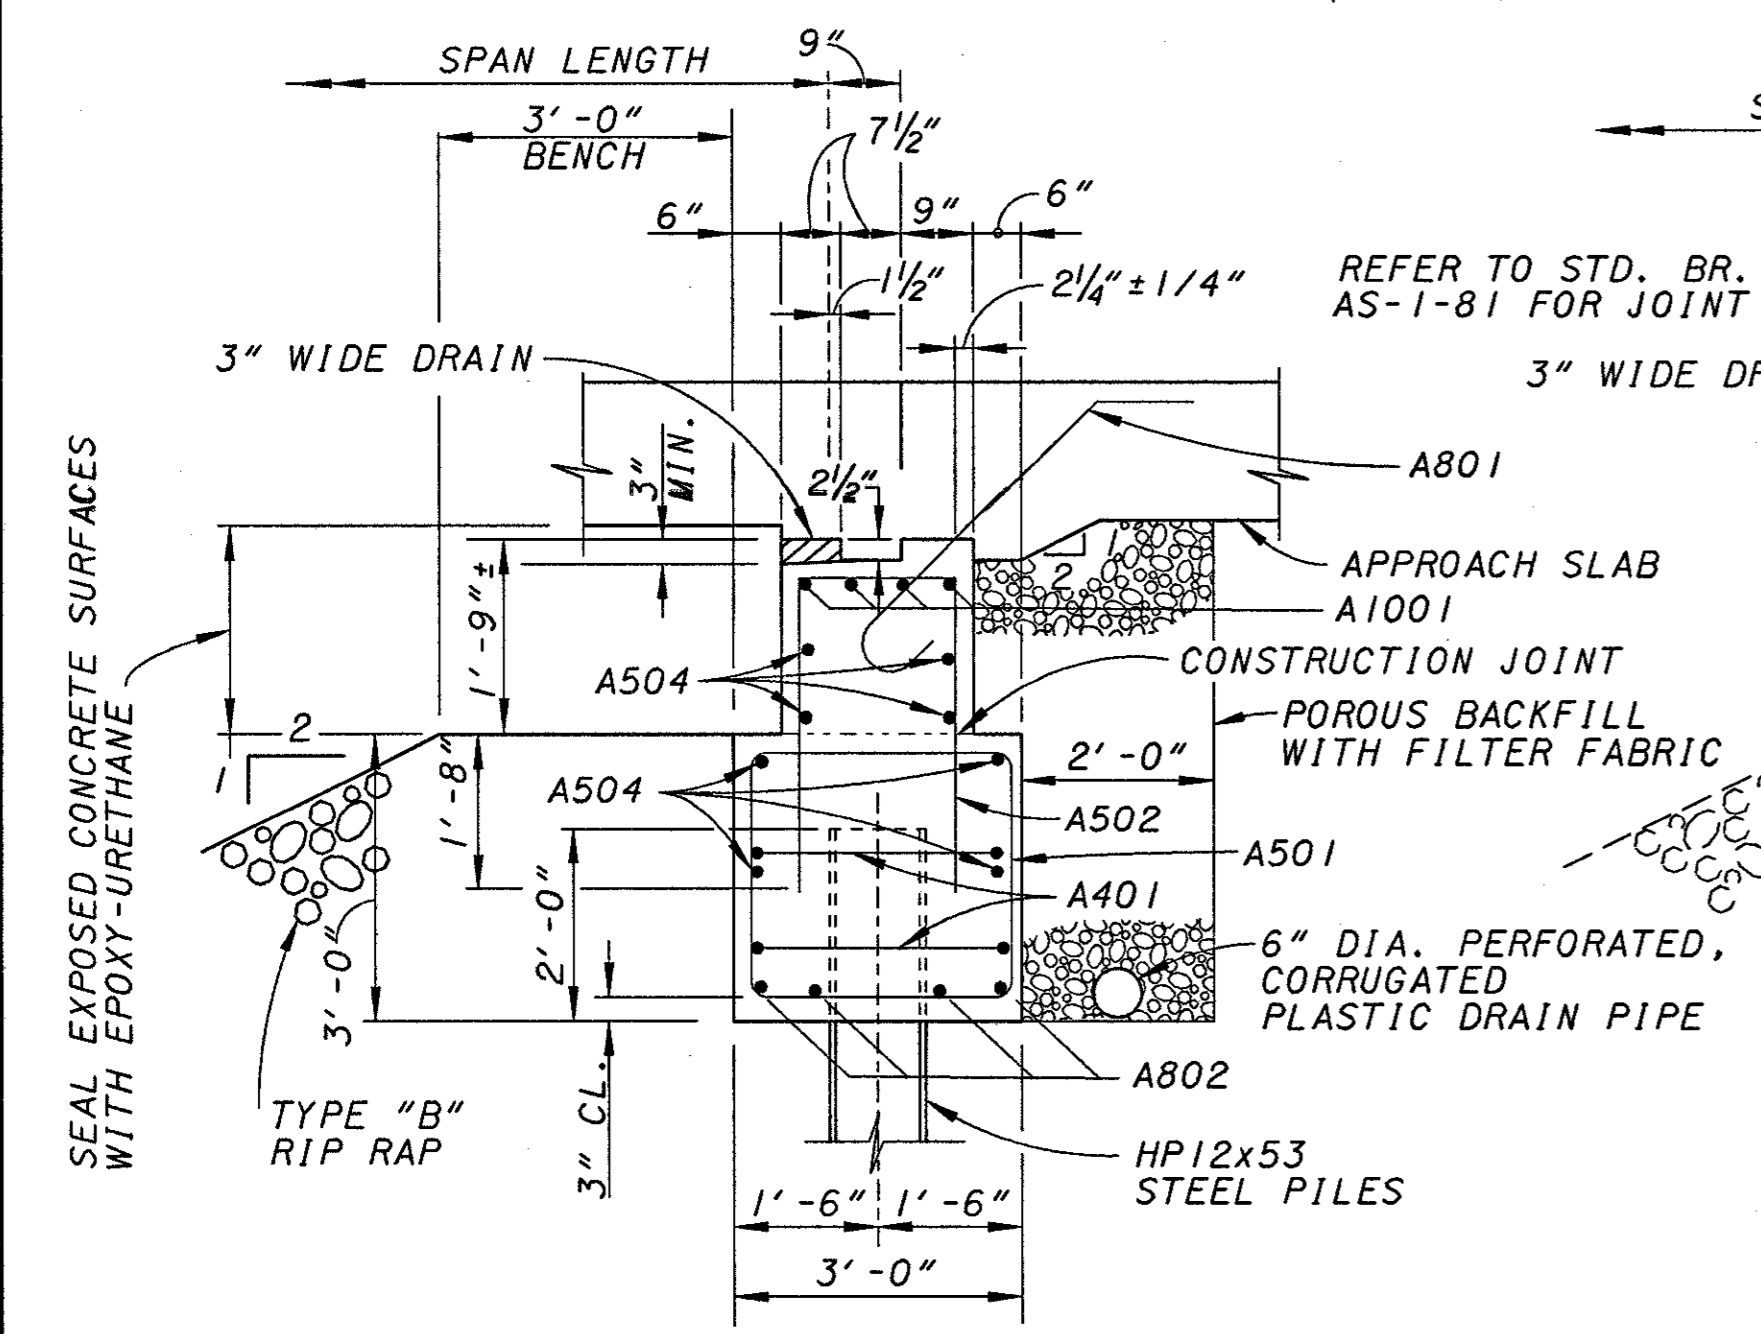


SECTION 1 1
 7 8

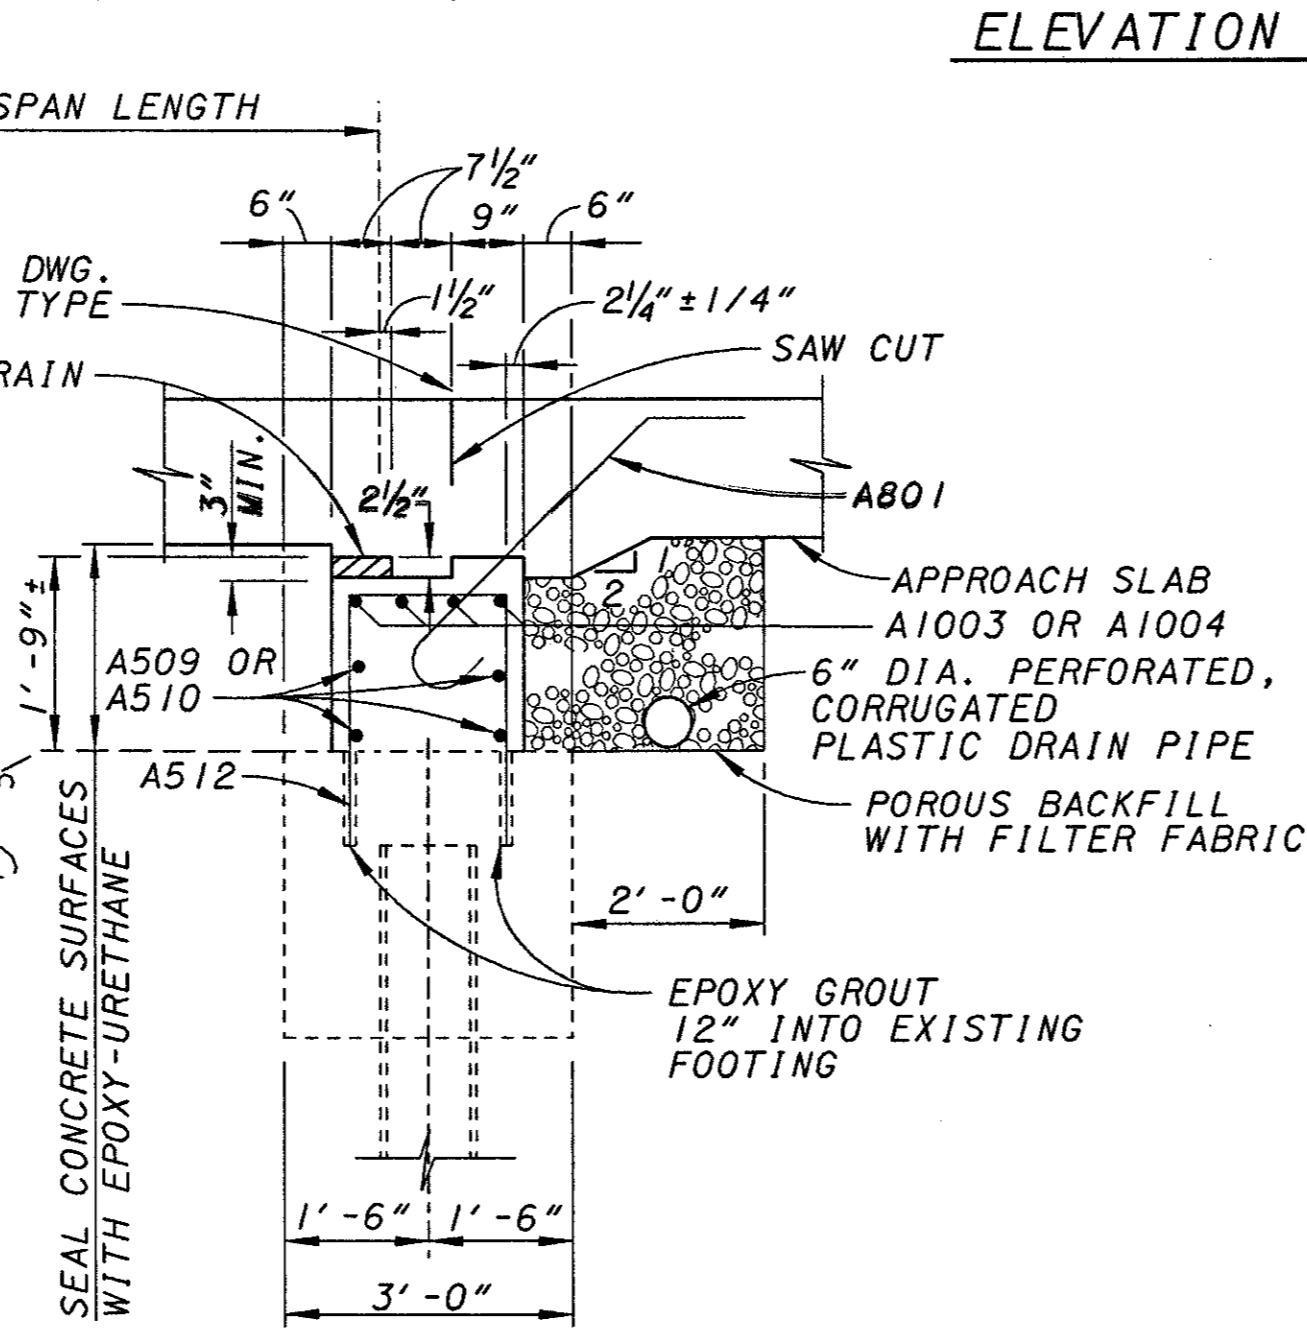


SECTION 2 2
 7 8

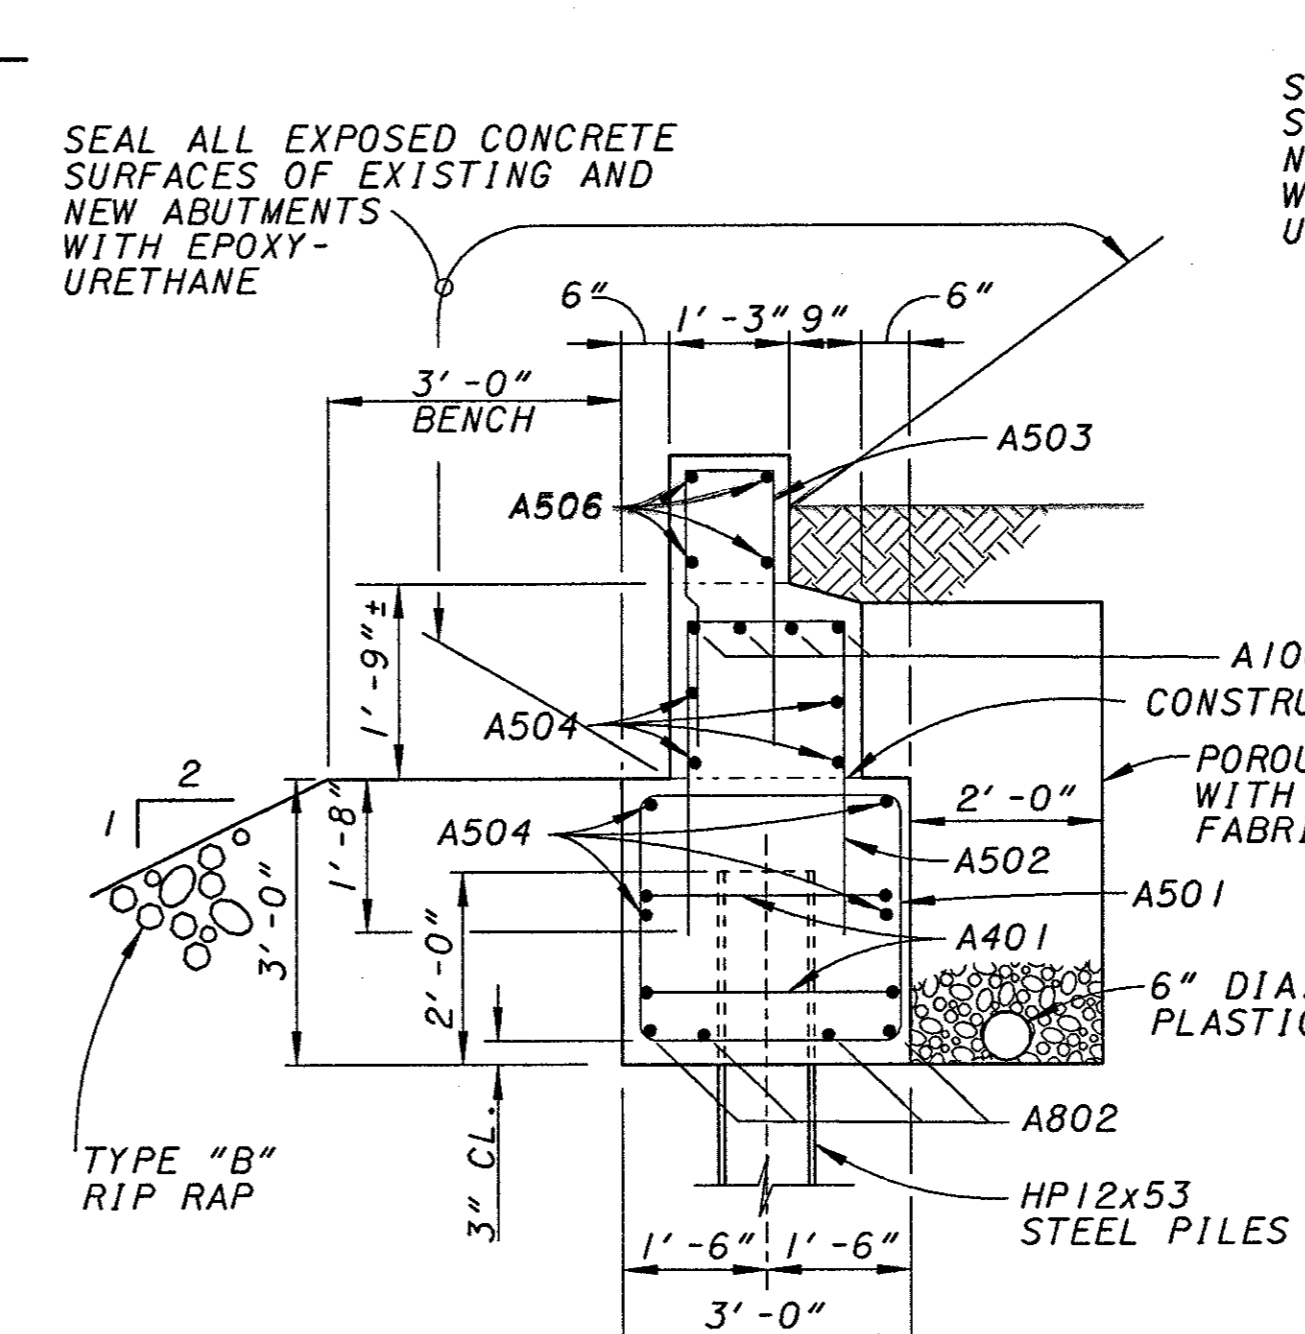

SECTION 3 3
 7 8

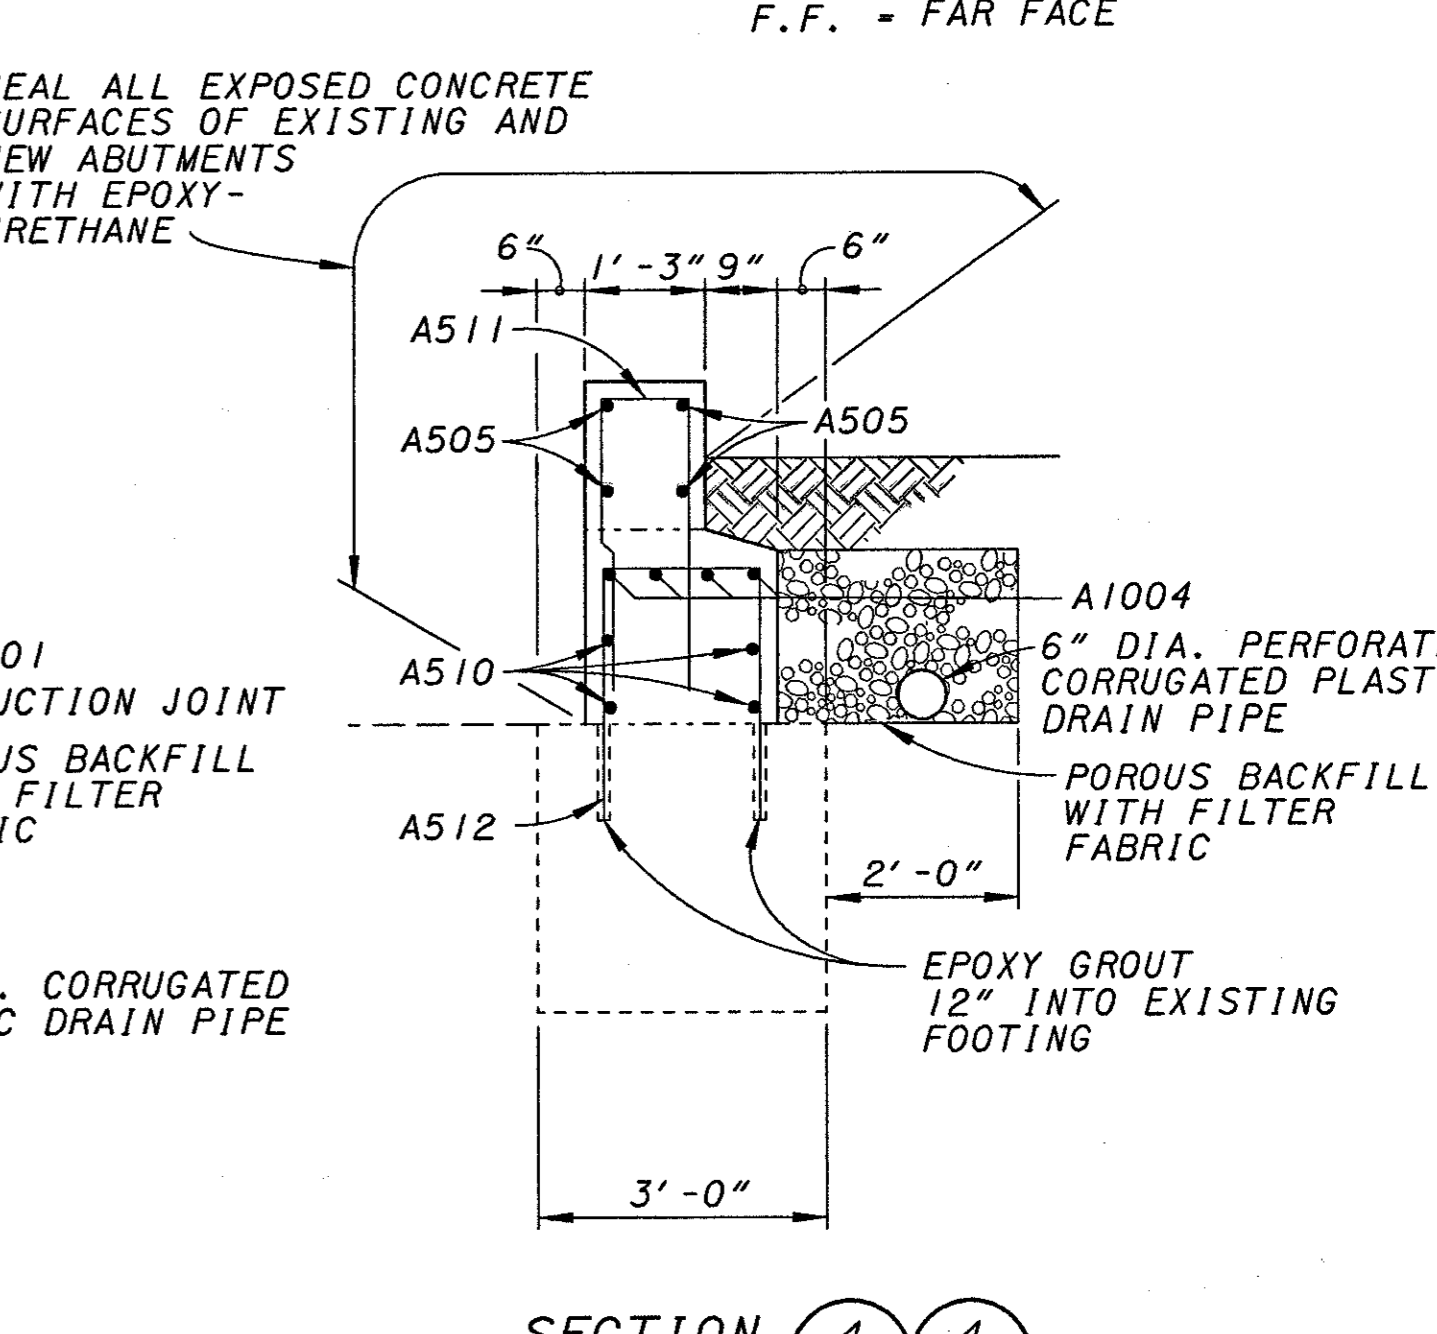

SECTION 4 4
 7 8

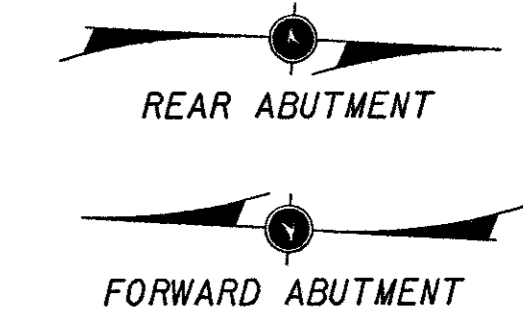


REF: **REF**
 REF: **REF**
REF: **REF**
 REF: **REF**
 REF: **REF**
 REF: **REF**

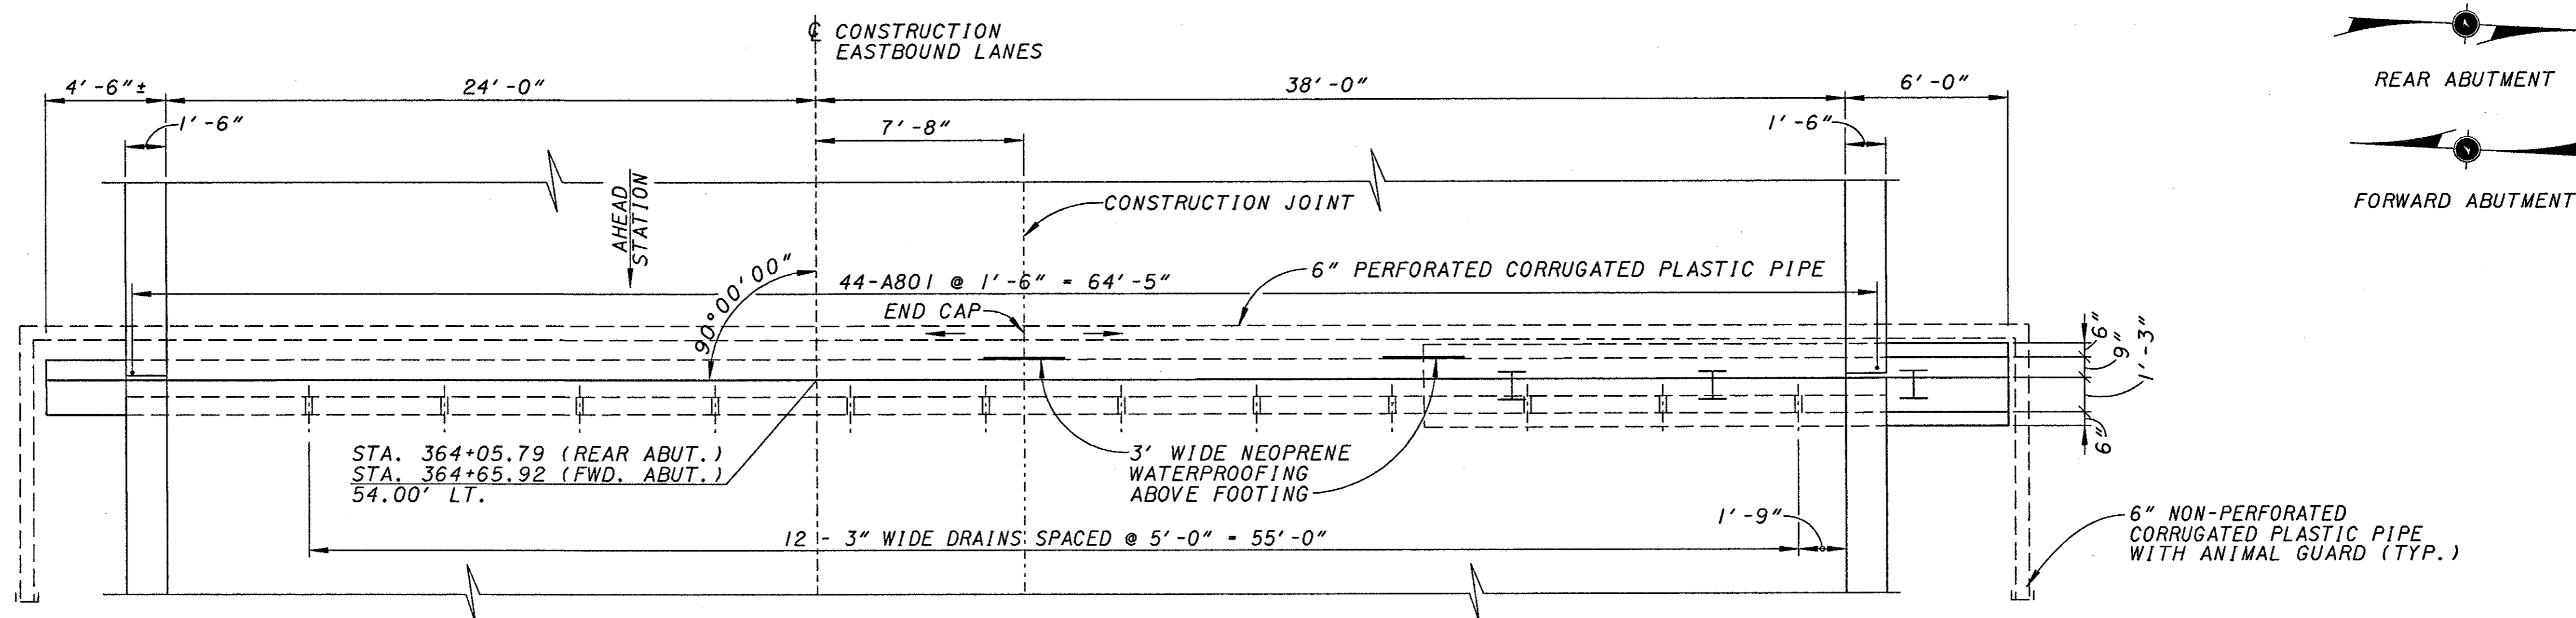

PLAN
 REAR ABUTMENT SHOWN,
 FORWARD ABUTMENT OPPOSITE HAND

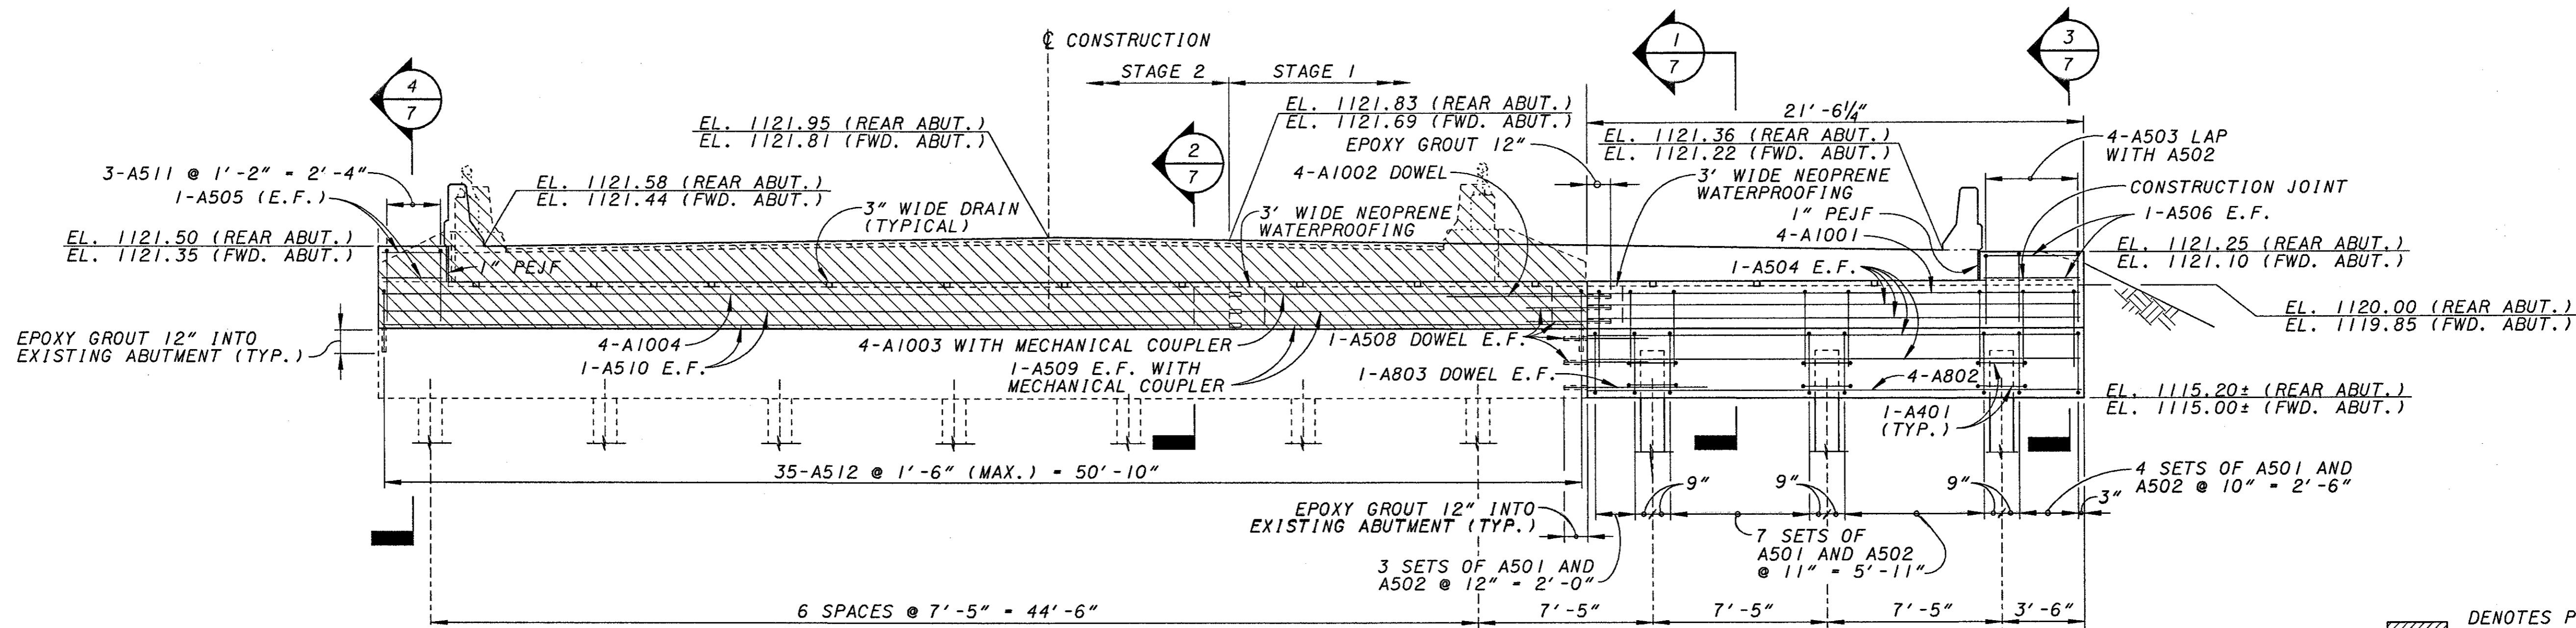


ELEVATION


/// DENOTES PORTION OF
 EXISTING STRUCTURE
 TO BE REMOVED

LEGEND


- PEJF - PREFORMED EXPANSION JOINT FILLER
- E.F. - EACH FACE
- N.F. - NEAR FACE
- F.F. - FAR FACE

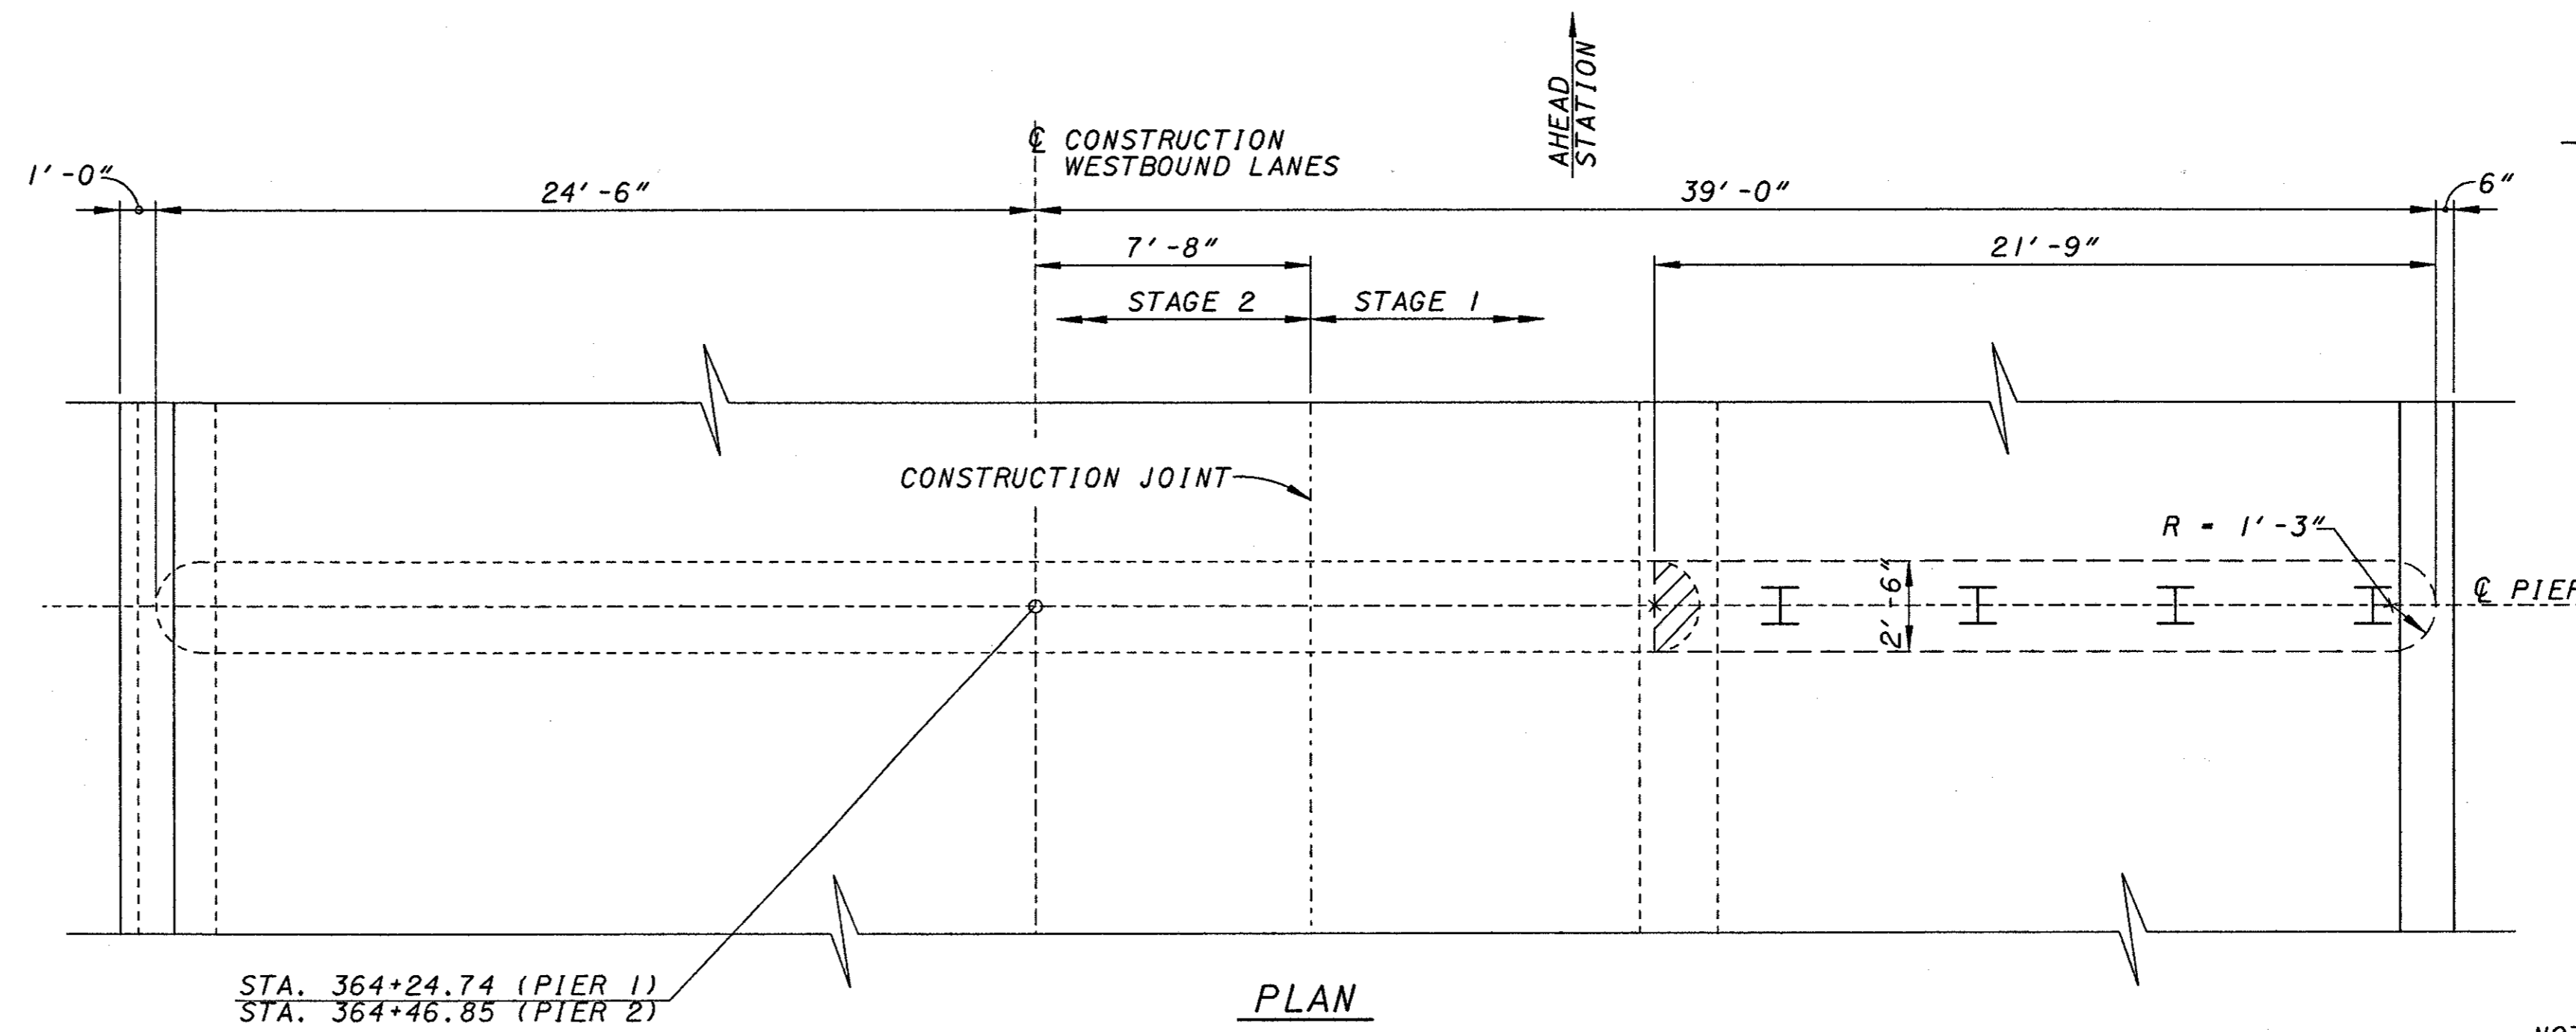

PLAN

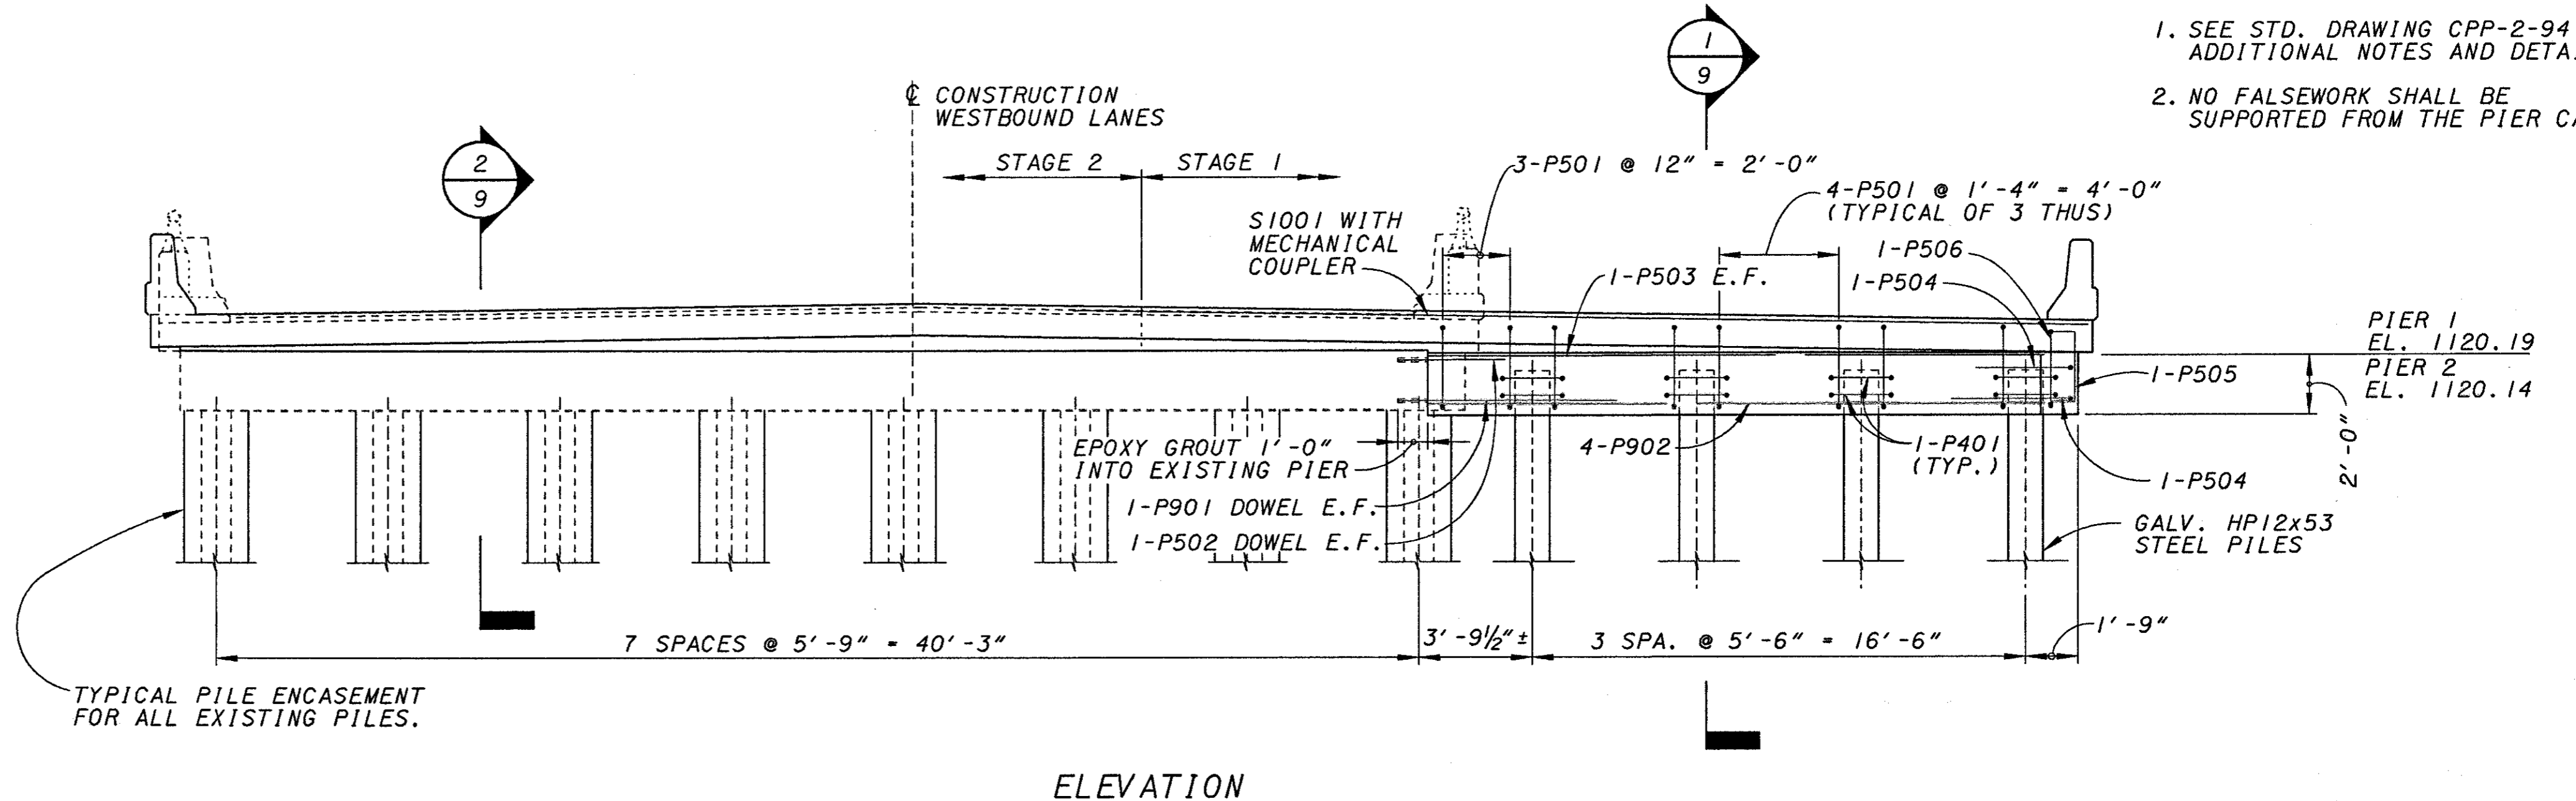


ELEVATION

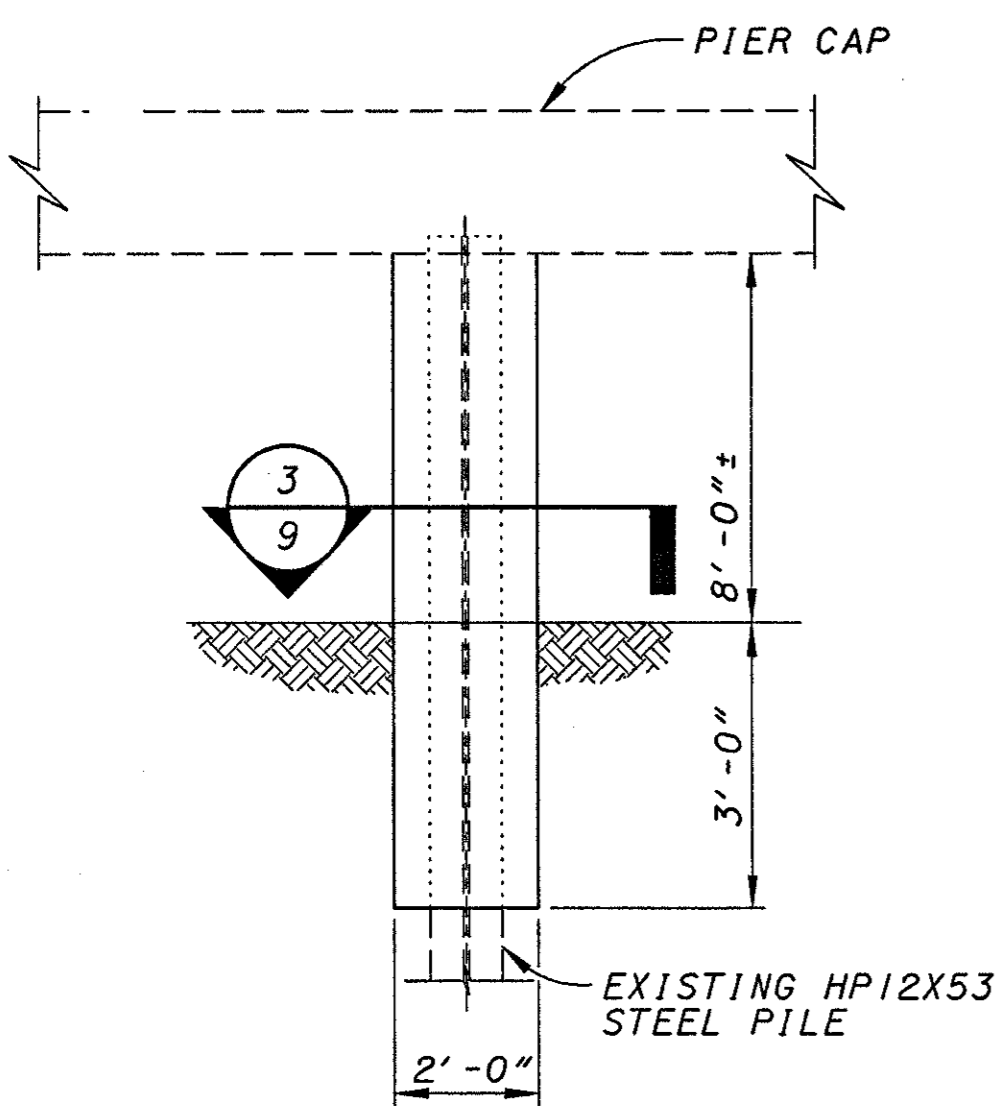


SECTION 3/9

TYPICAL EXISTING PILE ENCASEMENT DETAIL

TYPICAL PILE ENCASEMENT FOR ALL EXISTING PILES.

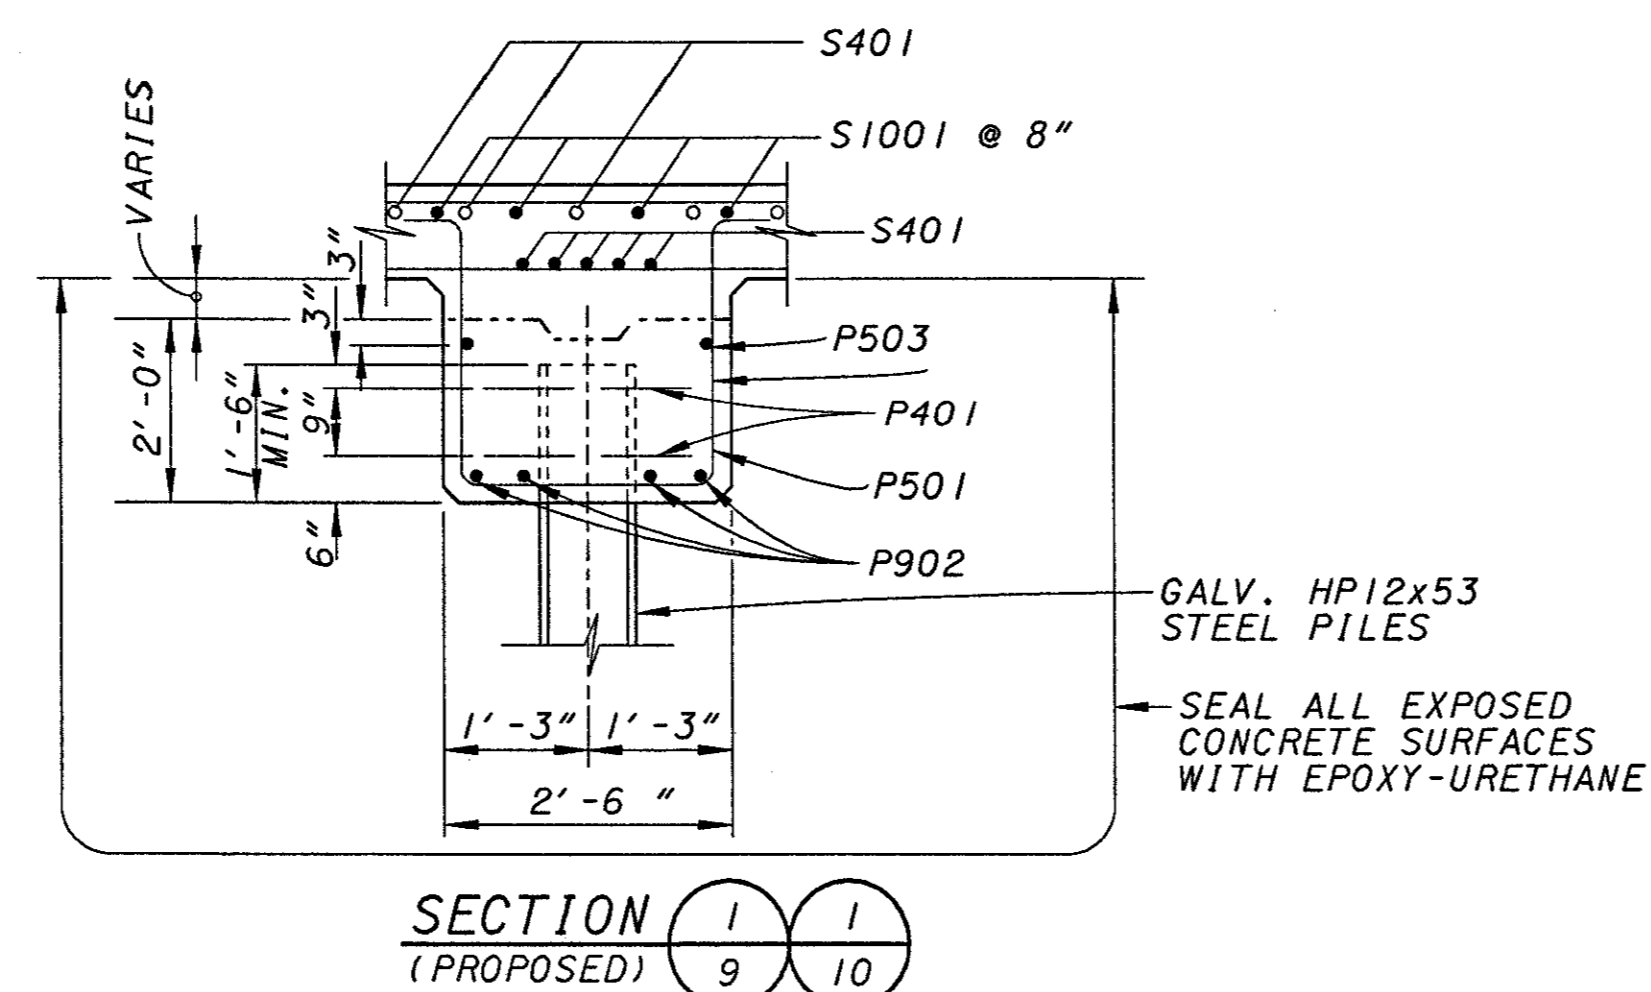

SECTION 1/1 (PROPOSED)

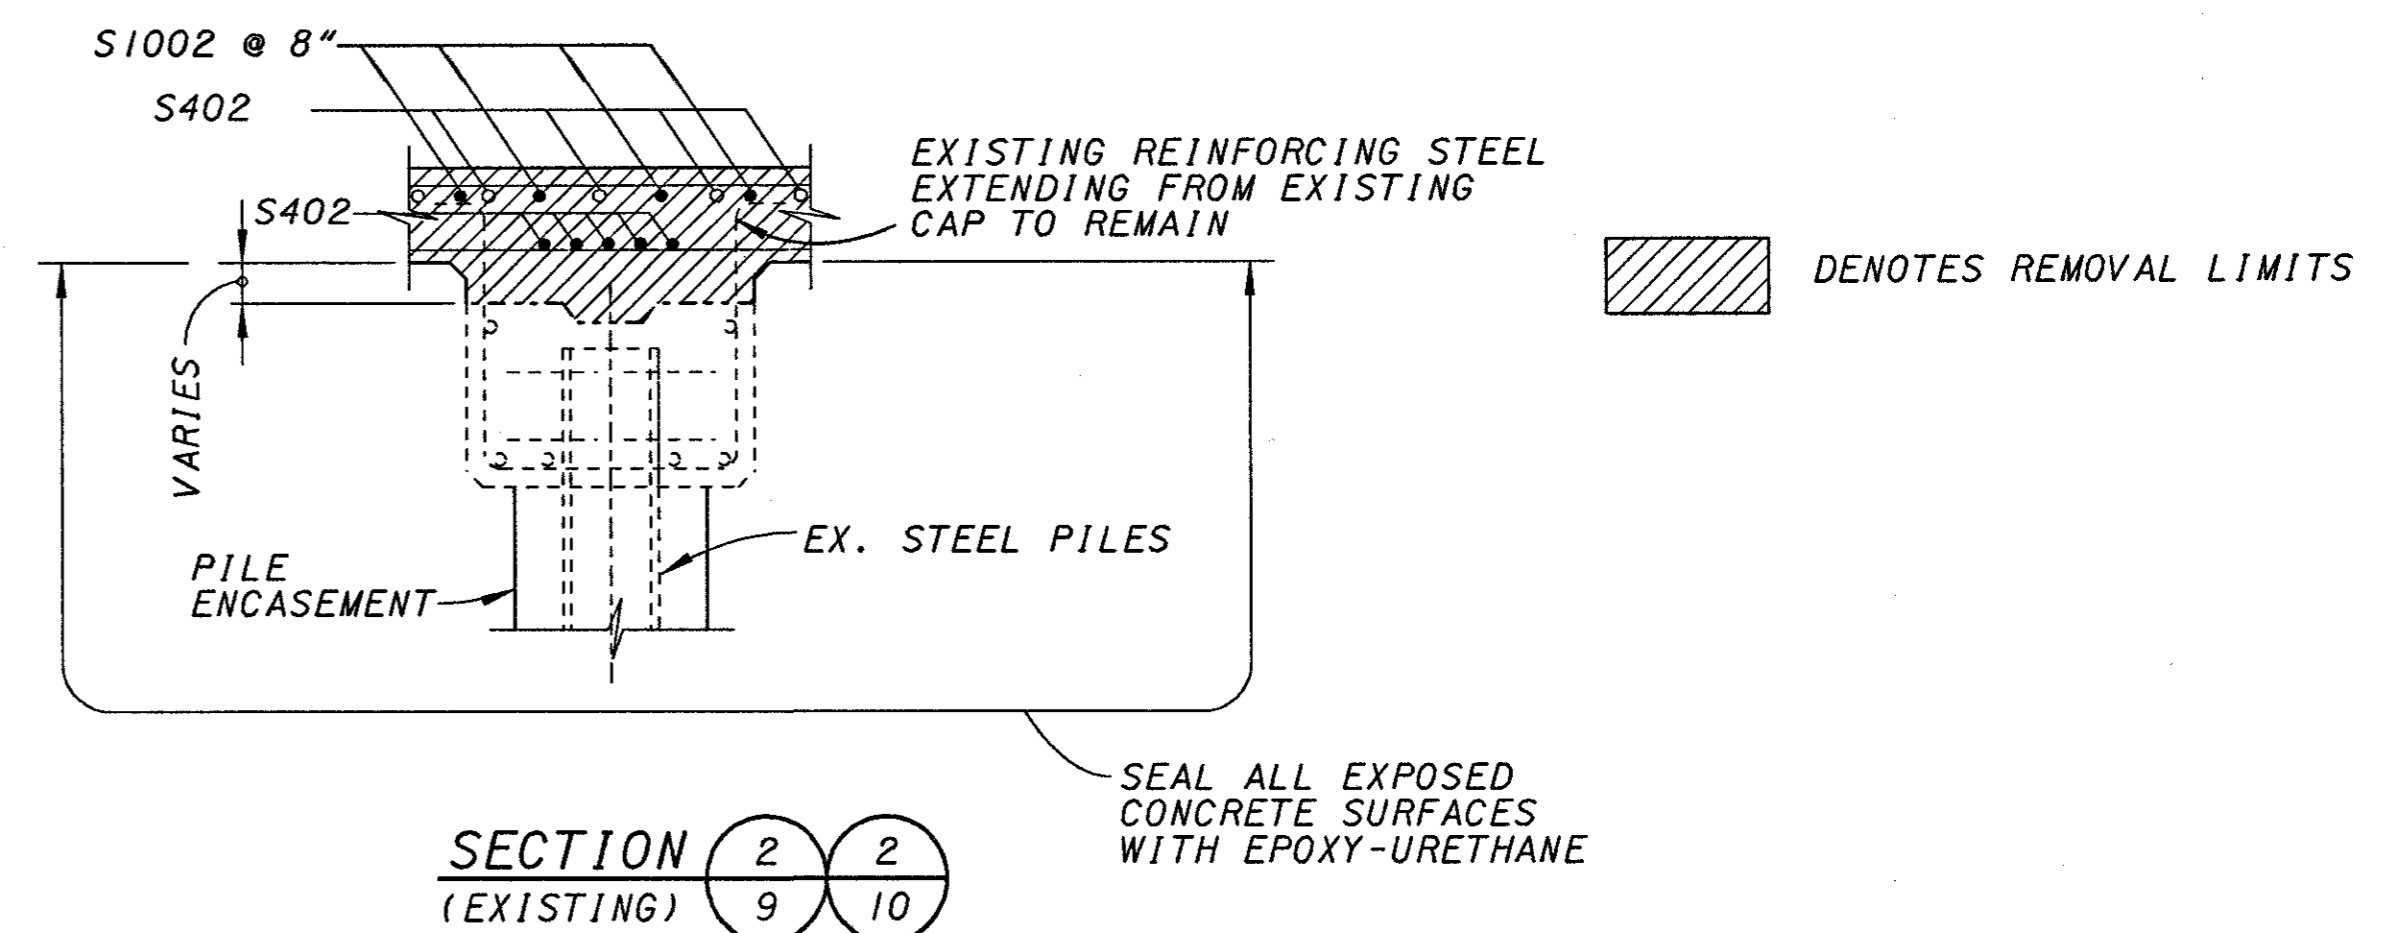

SECTION 2/2 (EXISTING)

DENOTES REMOVAL LIMITS

- NOTES:**
1. SEE STD. DRAWING CPP-2-94 FOR ADDITIONAL NOTES AND DETAILS
 2. NO FALSEWORK SHALL BE SUPPORTED FROM THE PIER CAP.

REF: **REF**

REF: **REF**

REF: **REF**

REF: **REF**

 USER: *****
 PROJECT: *****
 SHEET: *****
 ACTIVE LEVELS ON: *****


REF: **REF:***
 REF: **REF:***
 USER: *****
 PROJECT: *****
 SHEET: *****
 ACTIVE LEVELS ON: **LEVS

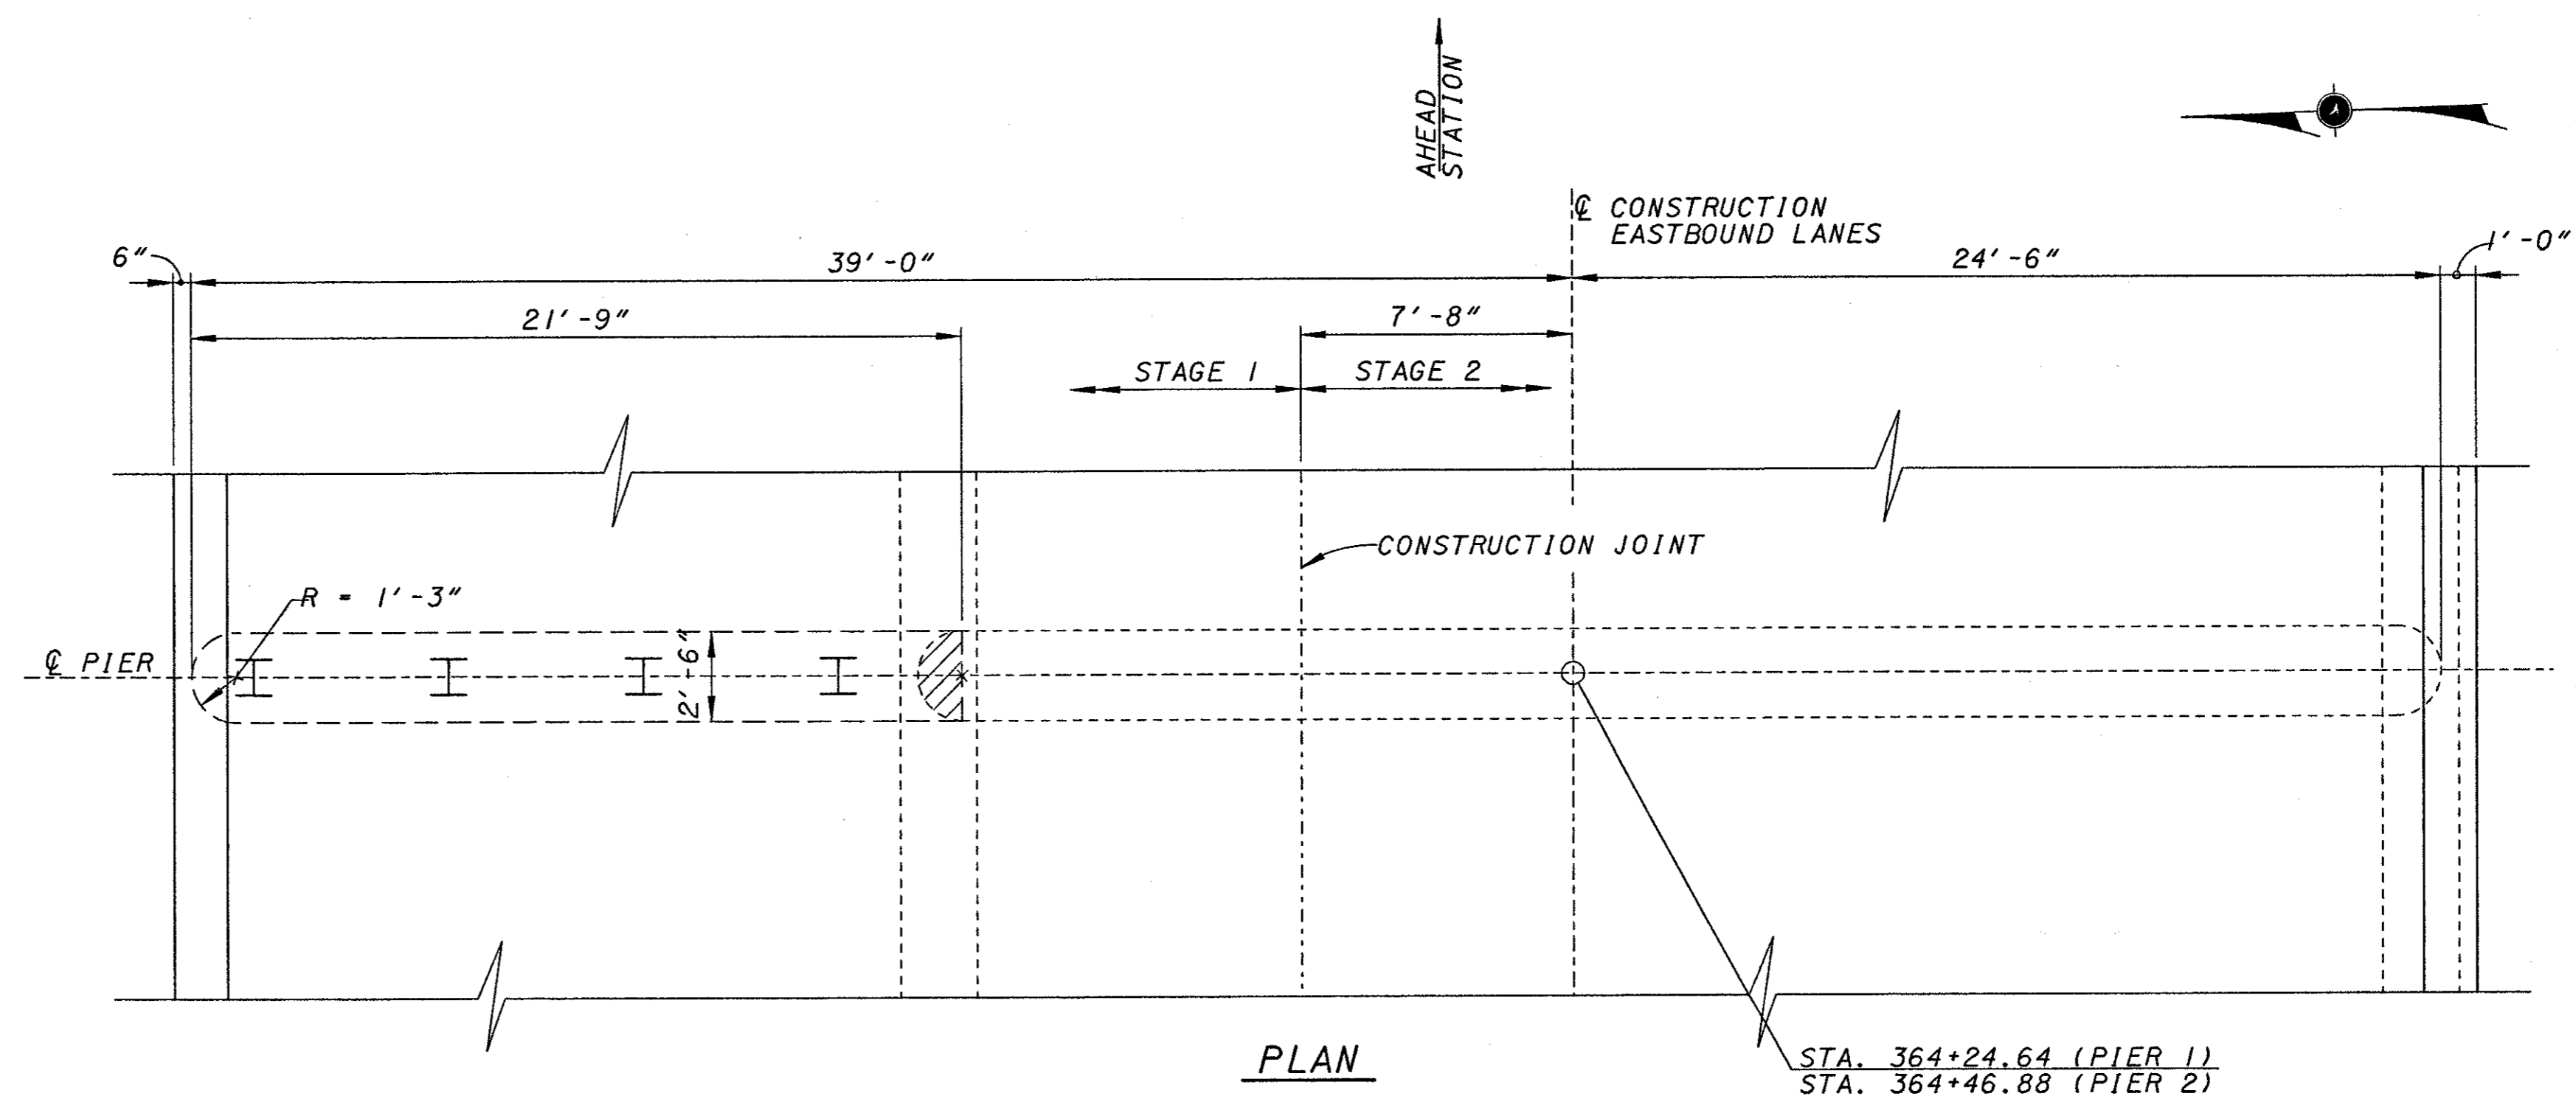

PLAN

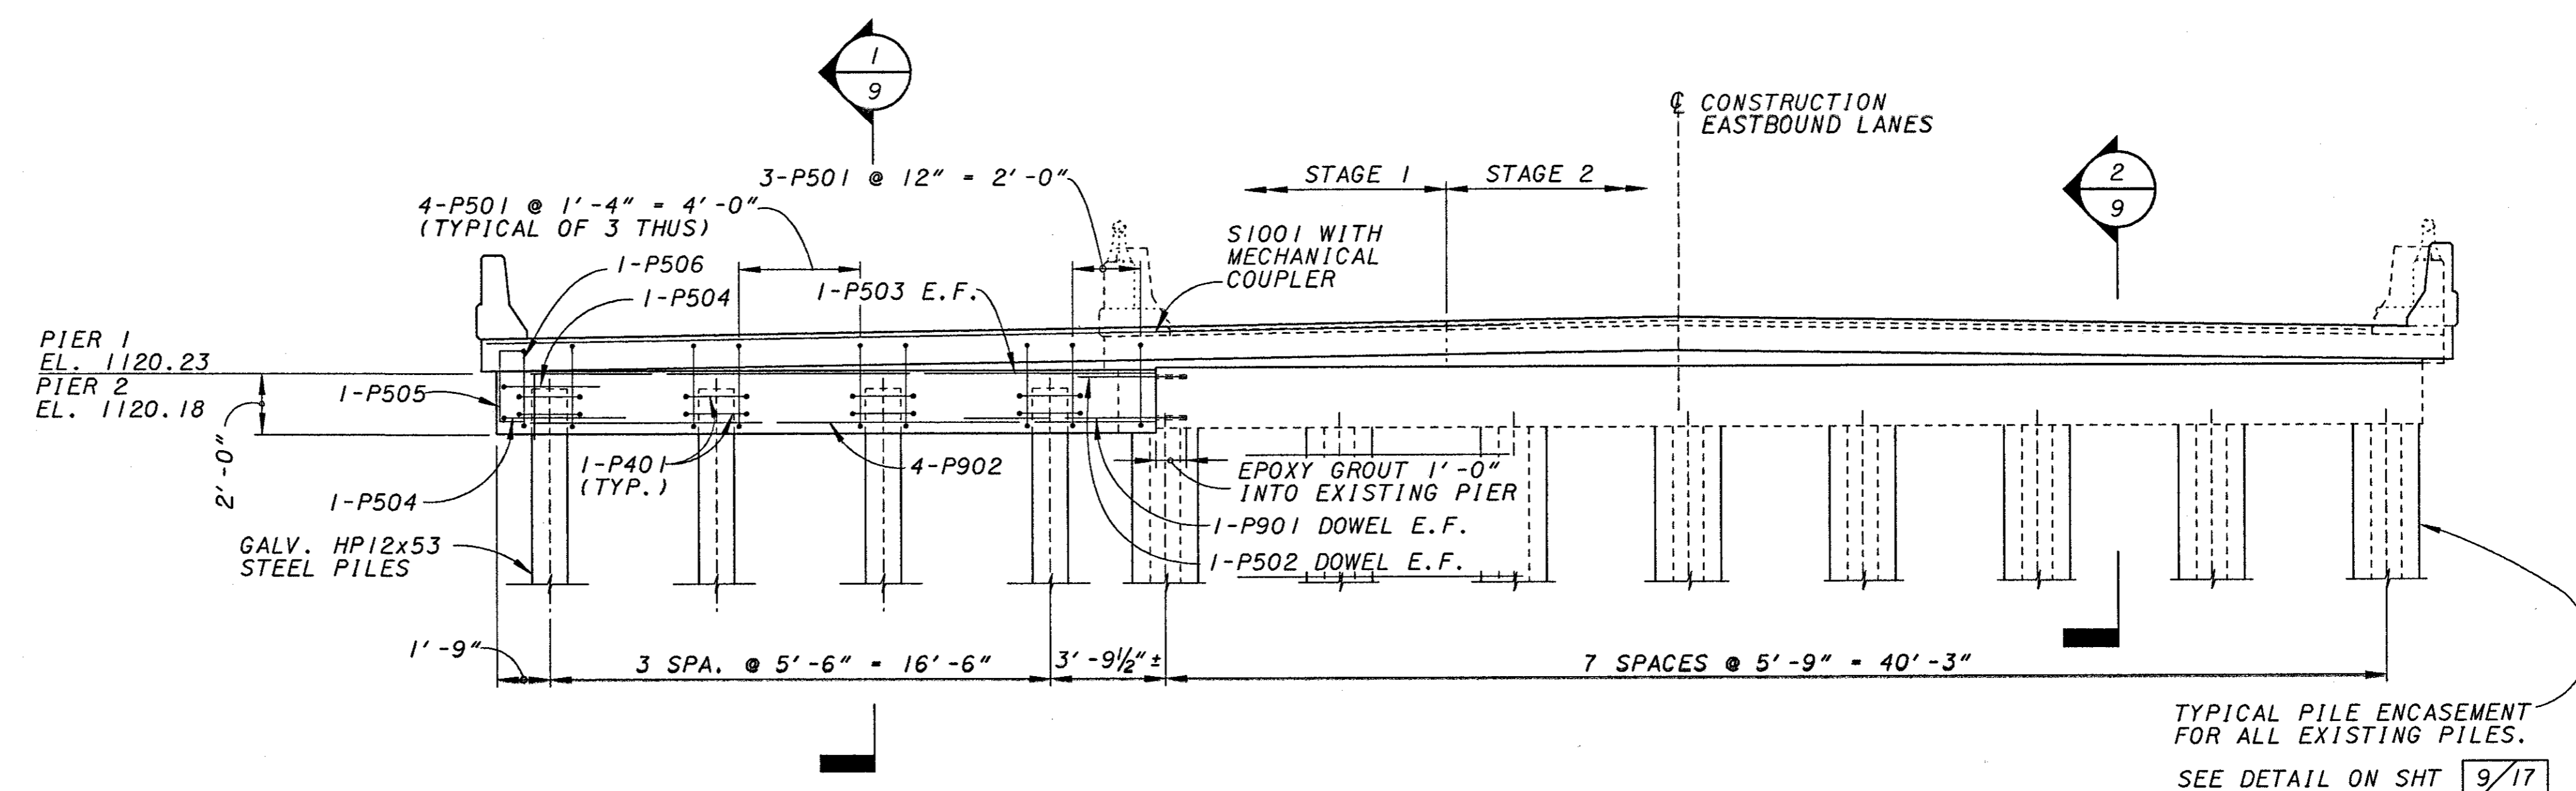

ELEVATION

- NOTES:
1. SEE STD. DRAWING CPP-2-94 FOR ADDITIONAL NOTES AND DETAILS
 2. NO FALSEWORK SHALL BE SUPPORTED FROM THE PIER CAP.


REF: **REF**
 REF: **REF**
 USER *****
 DATE: 11/11/00
 PROJECT: BANTAS CREEK BRIDGE
 DRAWING: PRE-70-0.00
 SHEET: 161/284

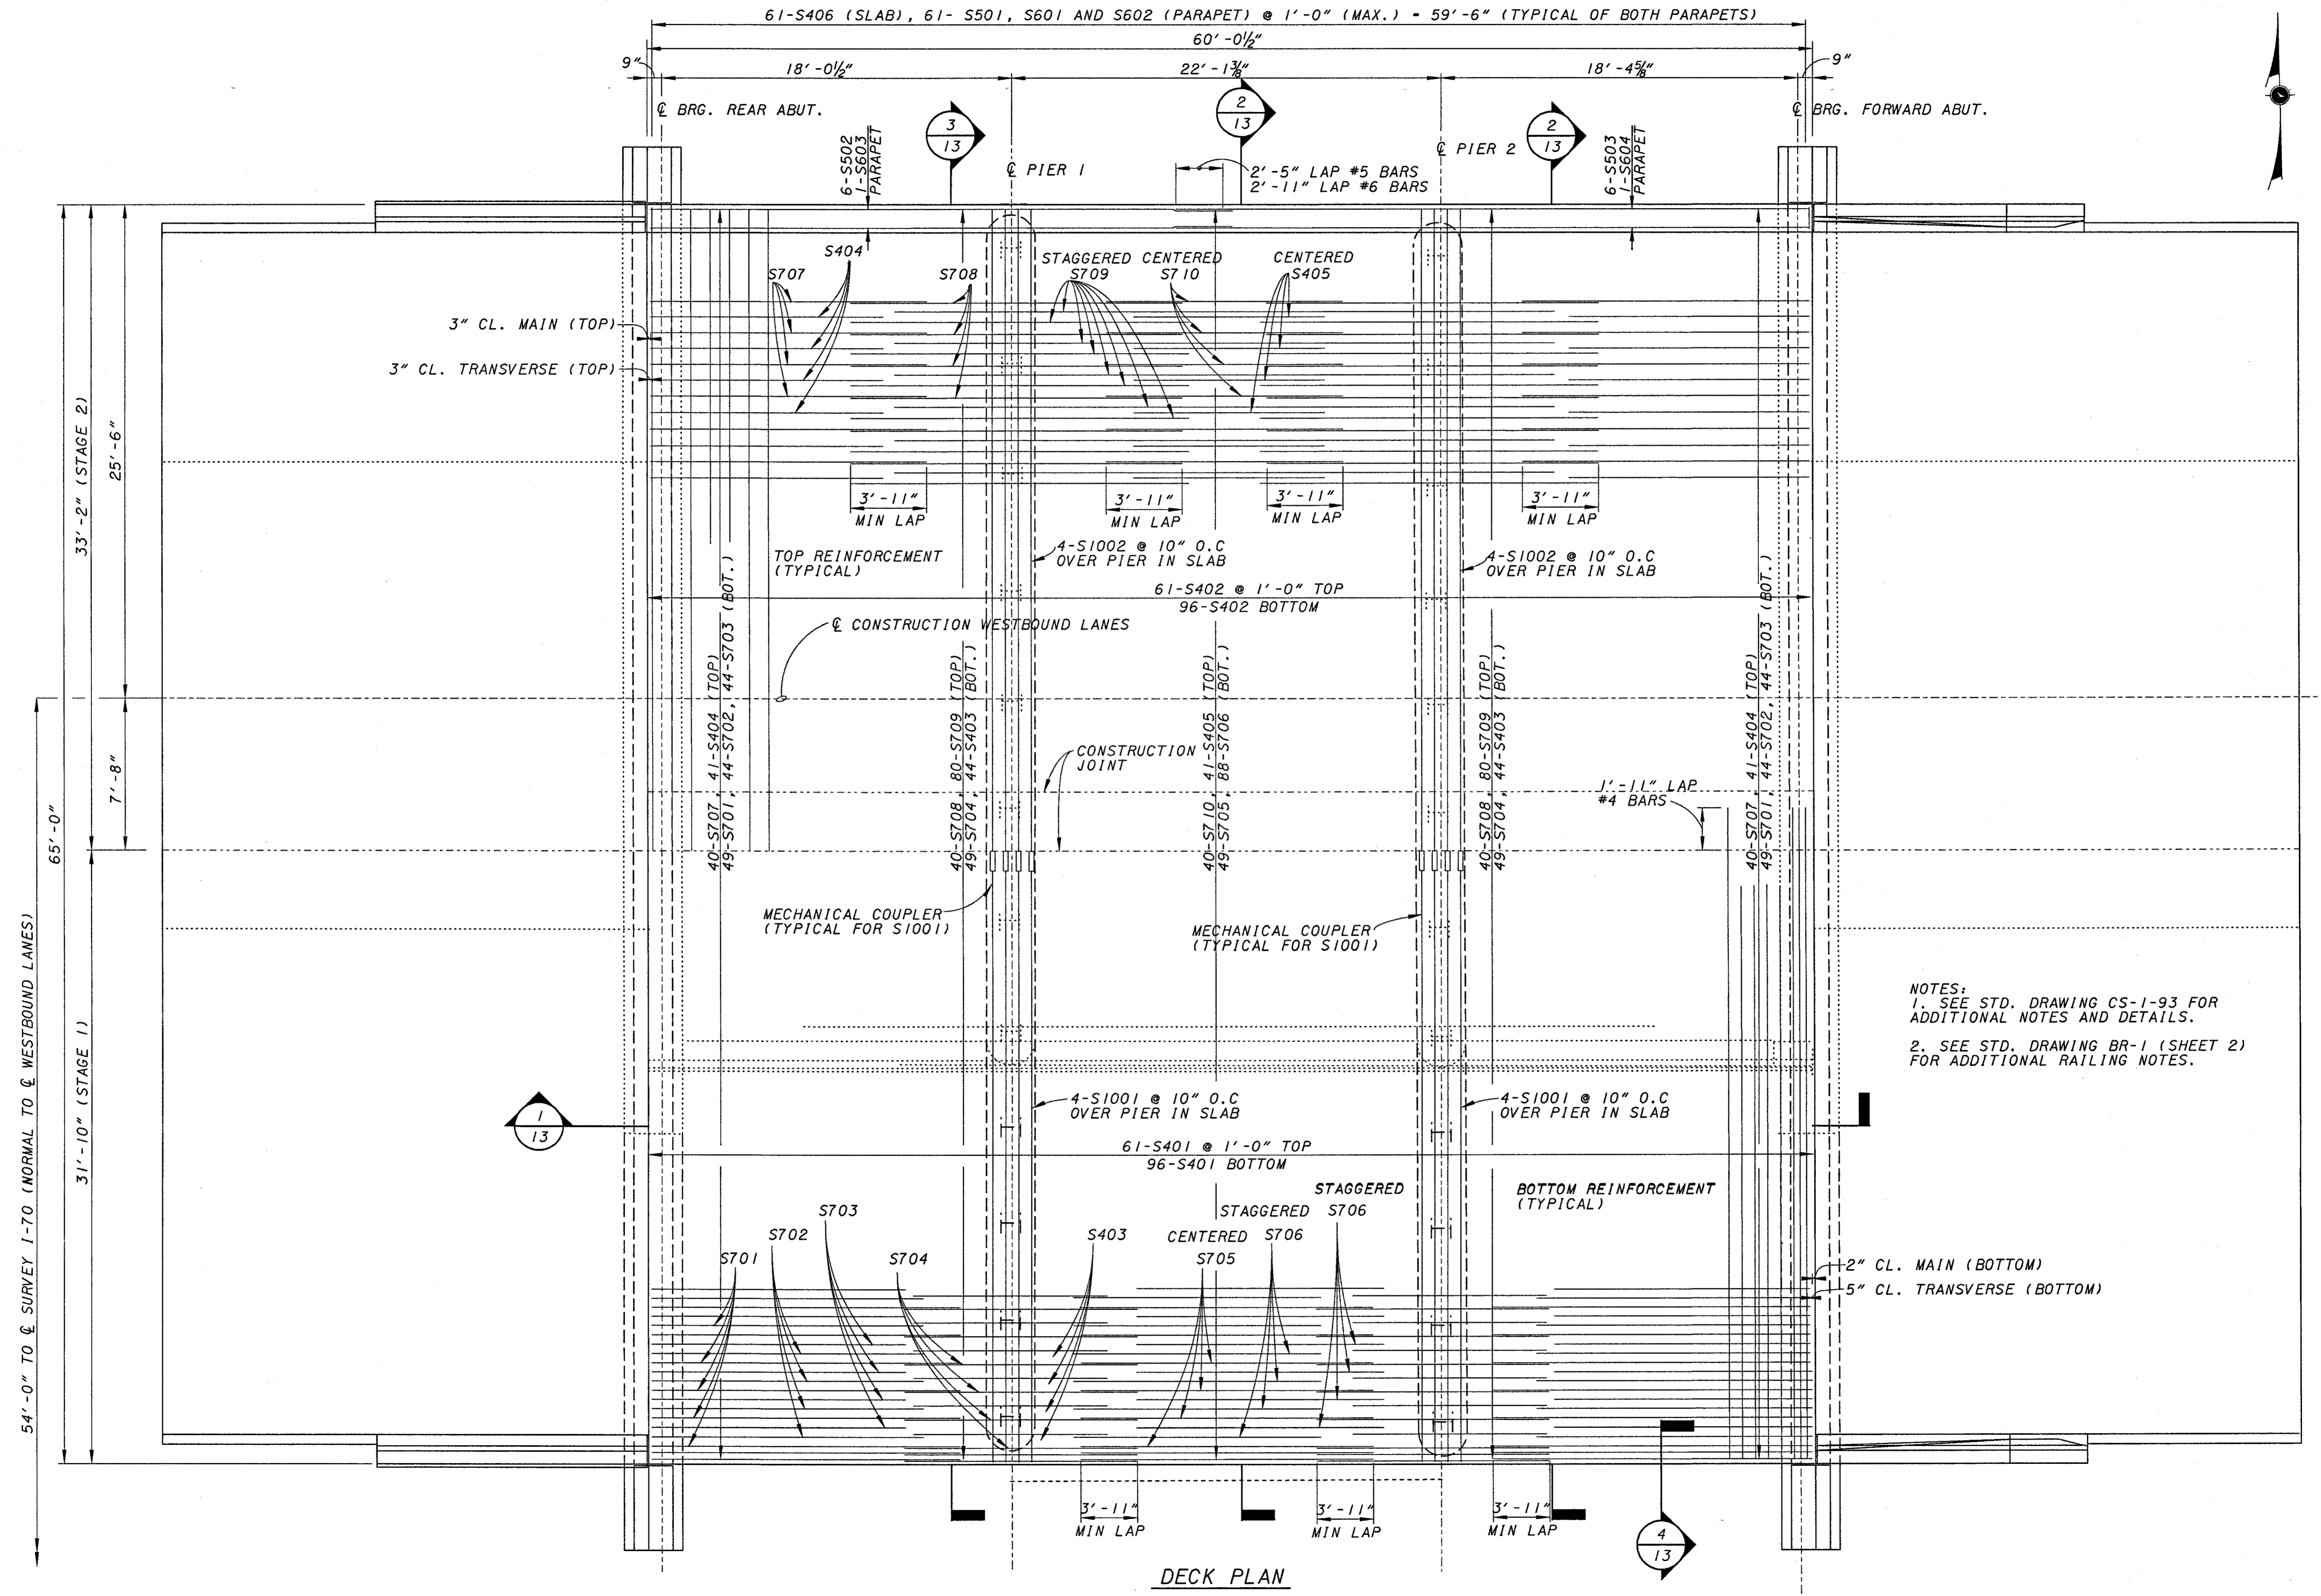


NOTES:
 1. SEE STD. DRAWING CS-1-93 FOR ADDITIONAL NOTES AND DETAILS.
 2. SEE STD. DRAWING BR-1 (SHEET 2) FOR ADDITIONAL RAILING NOTES.

DECK PLAN

KZF DESIGN Architecture Engineering Interiors Planning TEL: 680.102.1768 FAX: 680.102.1769	DESIGNED SJA	DRAWN DGK	REVIEWED DGK	DATE 7/06/00
	CHECKED WBS	REVISED	STRUCTURE FILE NUMBER 680102176800998	PROJECT FILE NUMBER 680102176800998
DECK PLAN - LEFT BRIDGE BRIDGE NO. PRE-70-0689 L/R I.R. TO OVER BANTAS CREEK				
PRE-70-0.00				
161 / 284				

REVISIONS:
 1. REVISIONS TO BE MADE BY THE DESIGNER.
 2. REVISIONS TO BE MADE BY THE DESIGNER.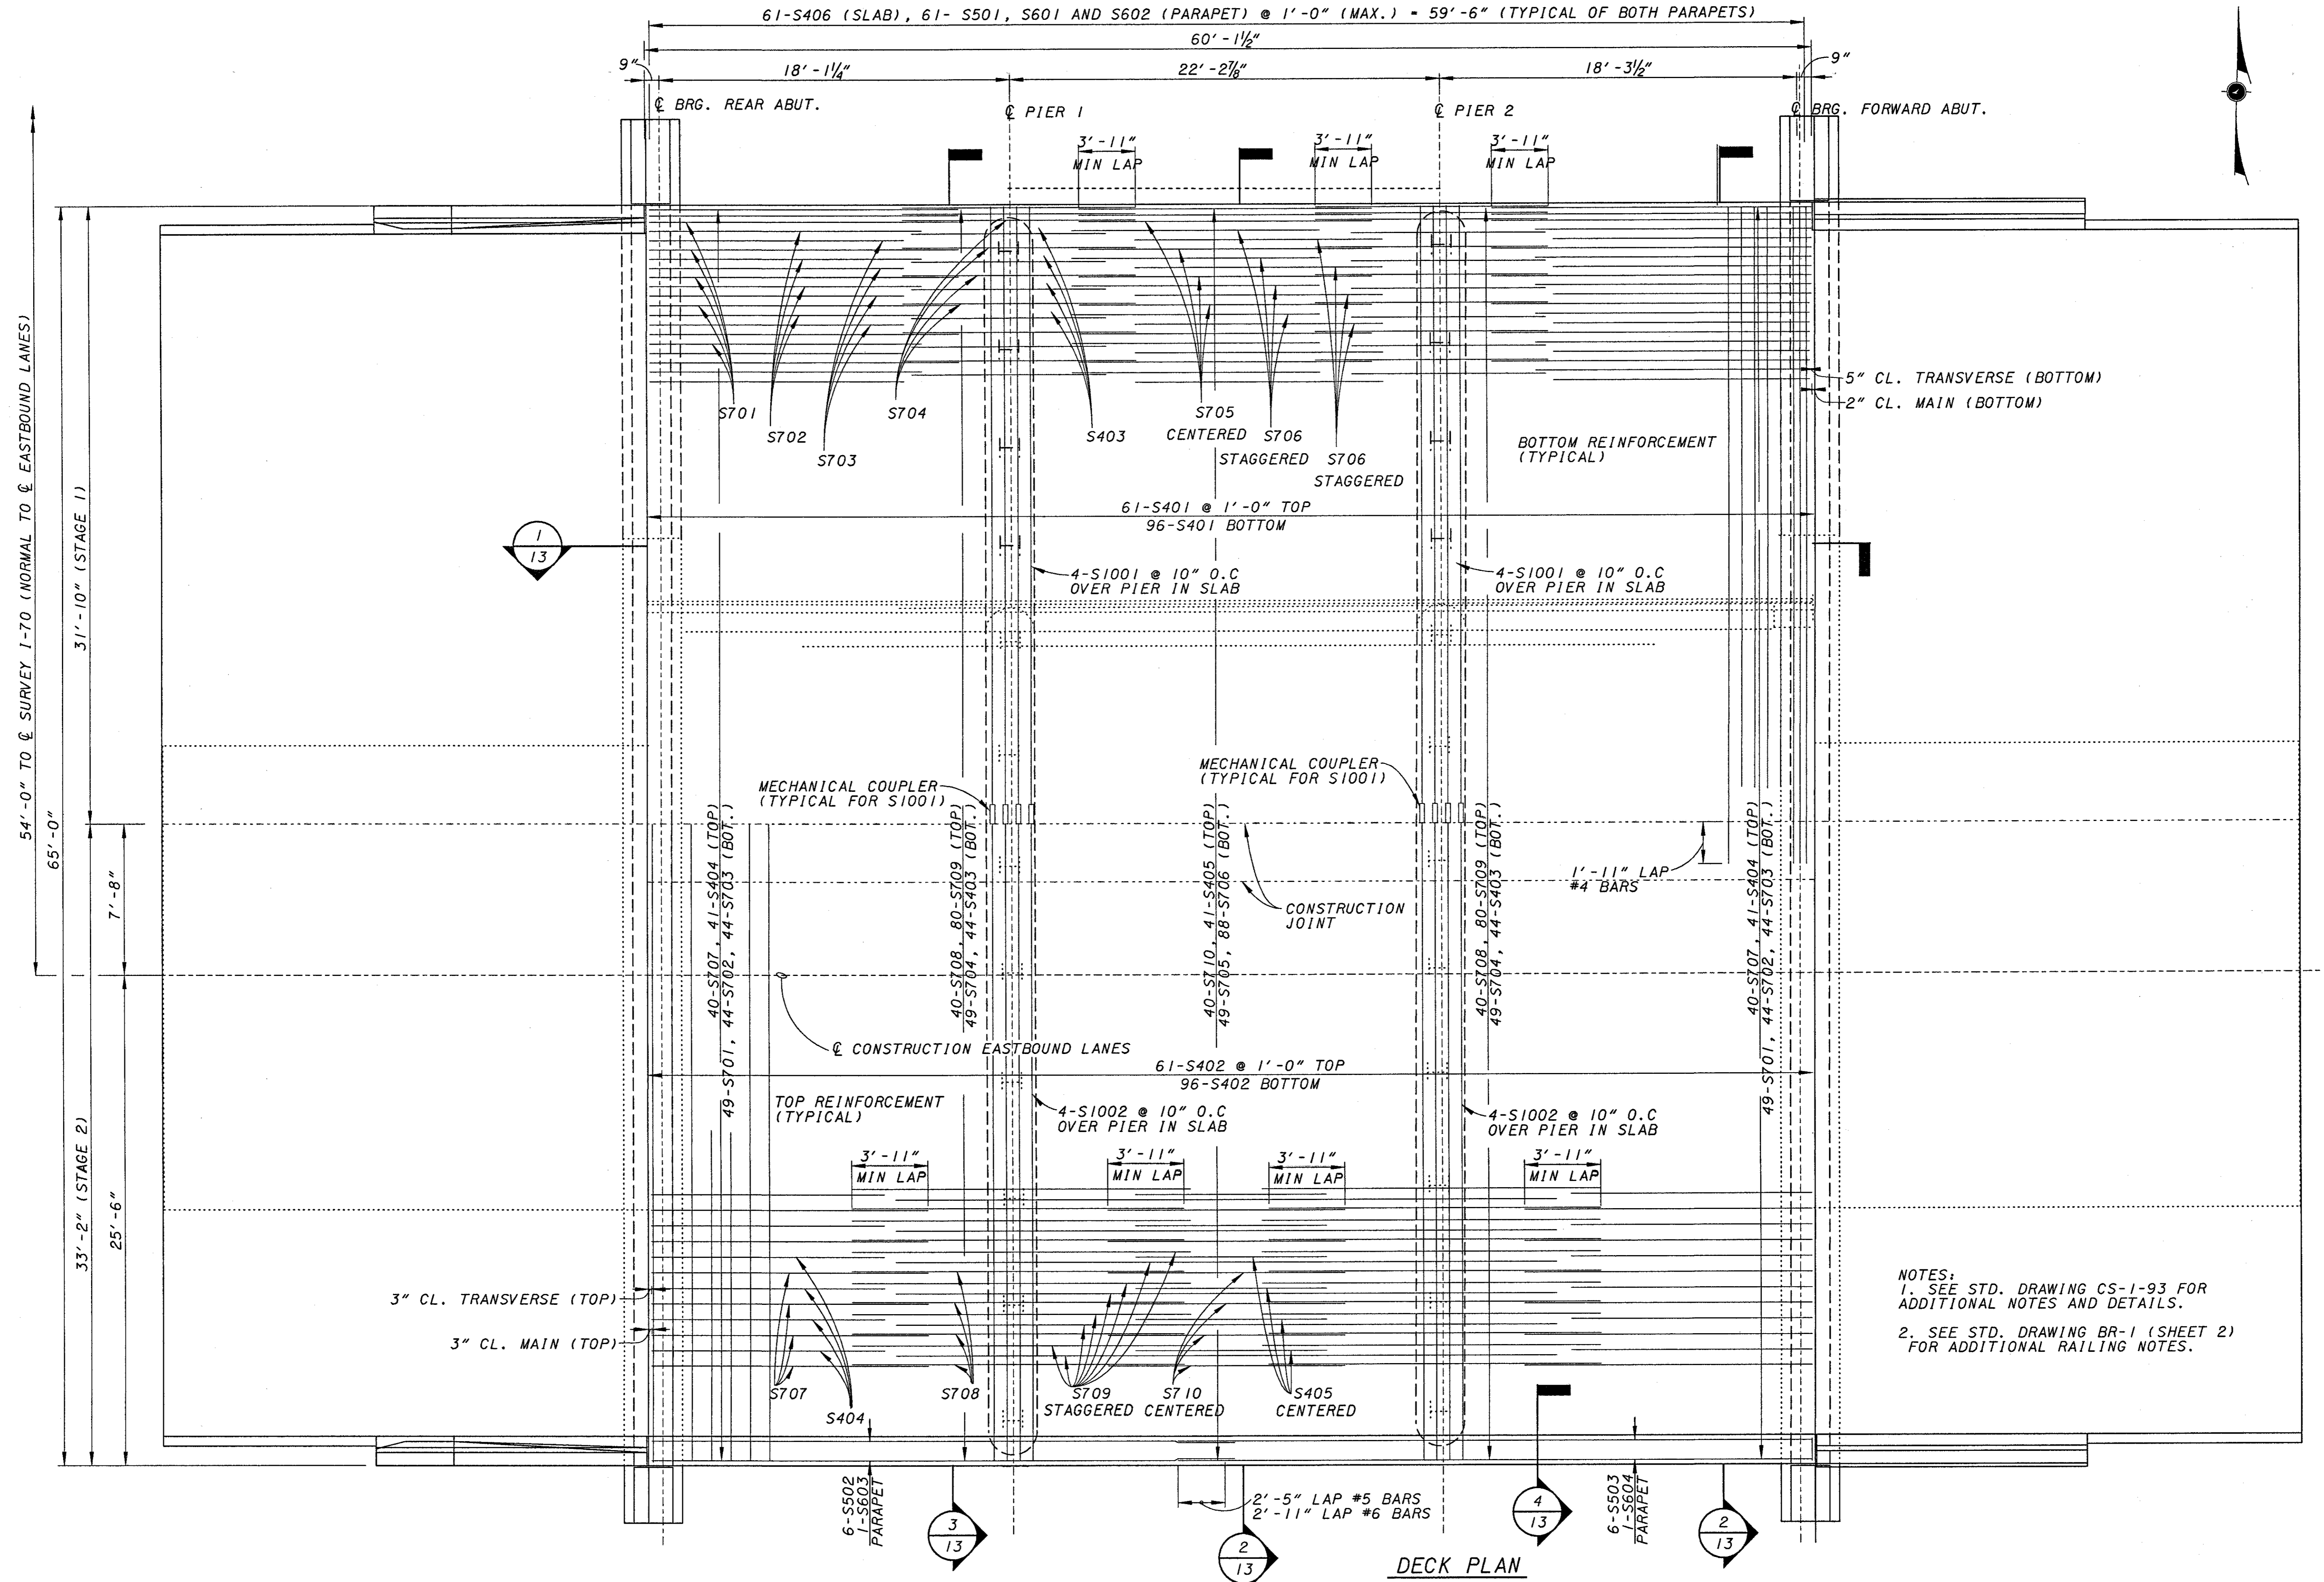
NOTES:
 1. SEE STD. DRAWING CS-1-93 FOR ADDITIONAL NOTES AND DETAILS.
 2. SEE STD. DRAWING BR-1 (SHEET 2) FOR ADDITIONAL RAILING NOTES.

DECK PLAN

DESIGN AGENCY: **KZF DESIGN**
 DATE: 7/06/00
 REVIEWED: DCK
 DRAWN: DCK
 DESIGNED: SJA
 CHECKED: WBS
 STRUCTURE FILE NUMBER: 6801021/6800998
 BRIDGE NO. PRE-70-0689 L/R
 I.R. 70 OVER BANTAS CREEK
 PRE-70-0.00
 12 / 17
 162 / 284


REF: **REF**
 REF: **REF**
 DATE: 7/06/00
 TIME: 10:00
 USER: JG
 PROJECT: PRE-70-0689 L/R
 DRAWING: PRE-70-0.00
 SHEET: 15 OF 17
 ACTIVE LEVELS ON: 165.284

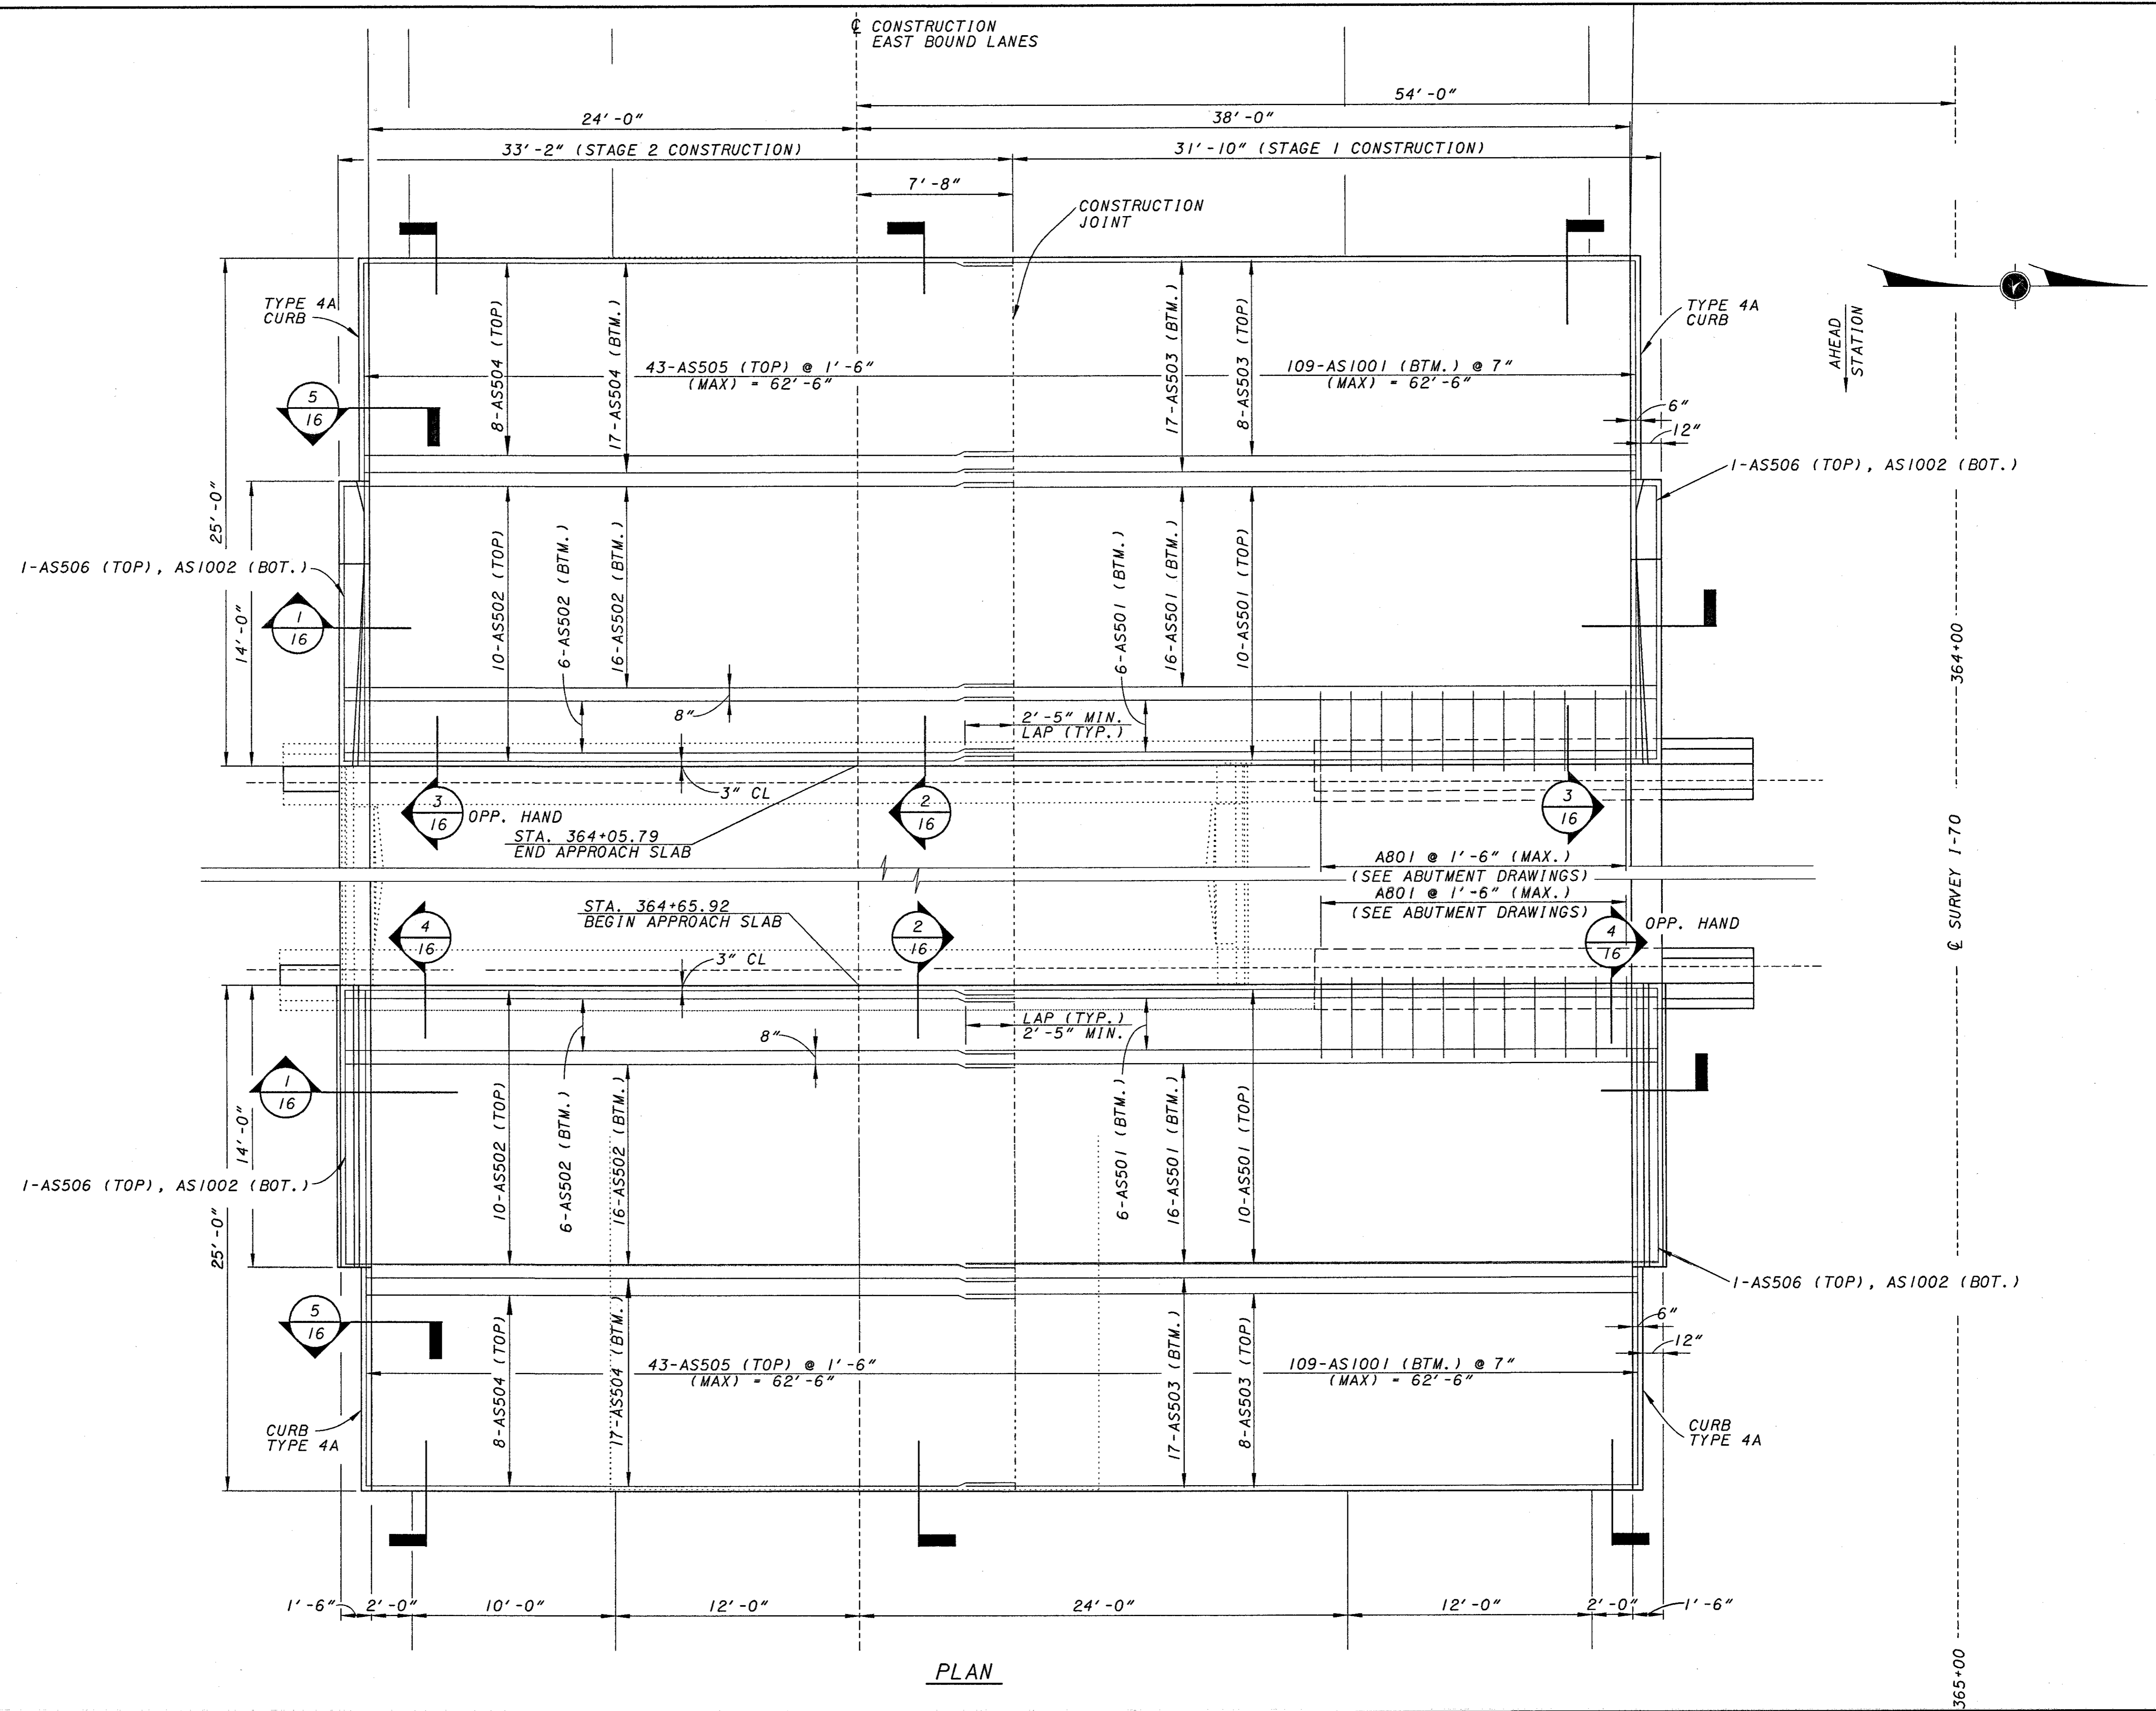


PLAN

365+00

364+00

AHEAD
STATION

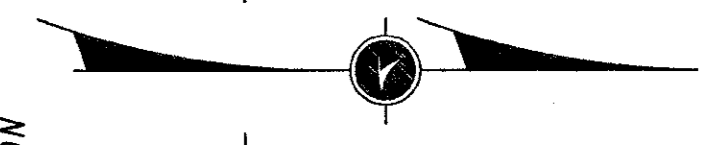

DESIGNED	DATE
SJA	7/06/00
CHECKED	REVIEWED
WBS	DGK
DESIGNED	STRUCTURE FILE NUMBER
JDG	680102176800998
REVISION	


KZF #8

APPROACH SLABS - RIGHT BRIDGE
 BRIDGE NO. PRE-70-0689 L/R
 I.R. 70 OVER BANTAS CREEK

PRE-70-0.00

15 / 17

165
284

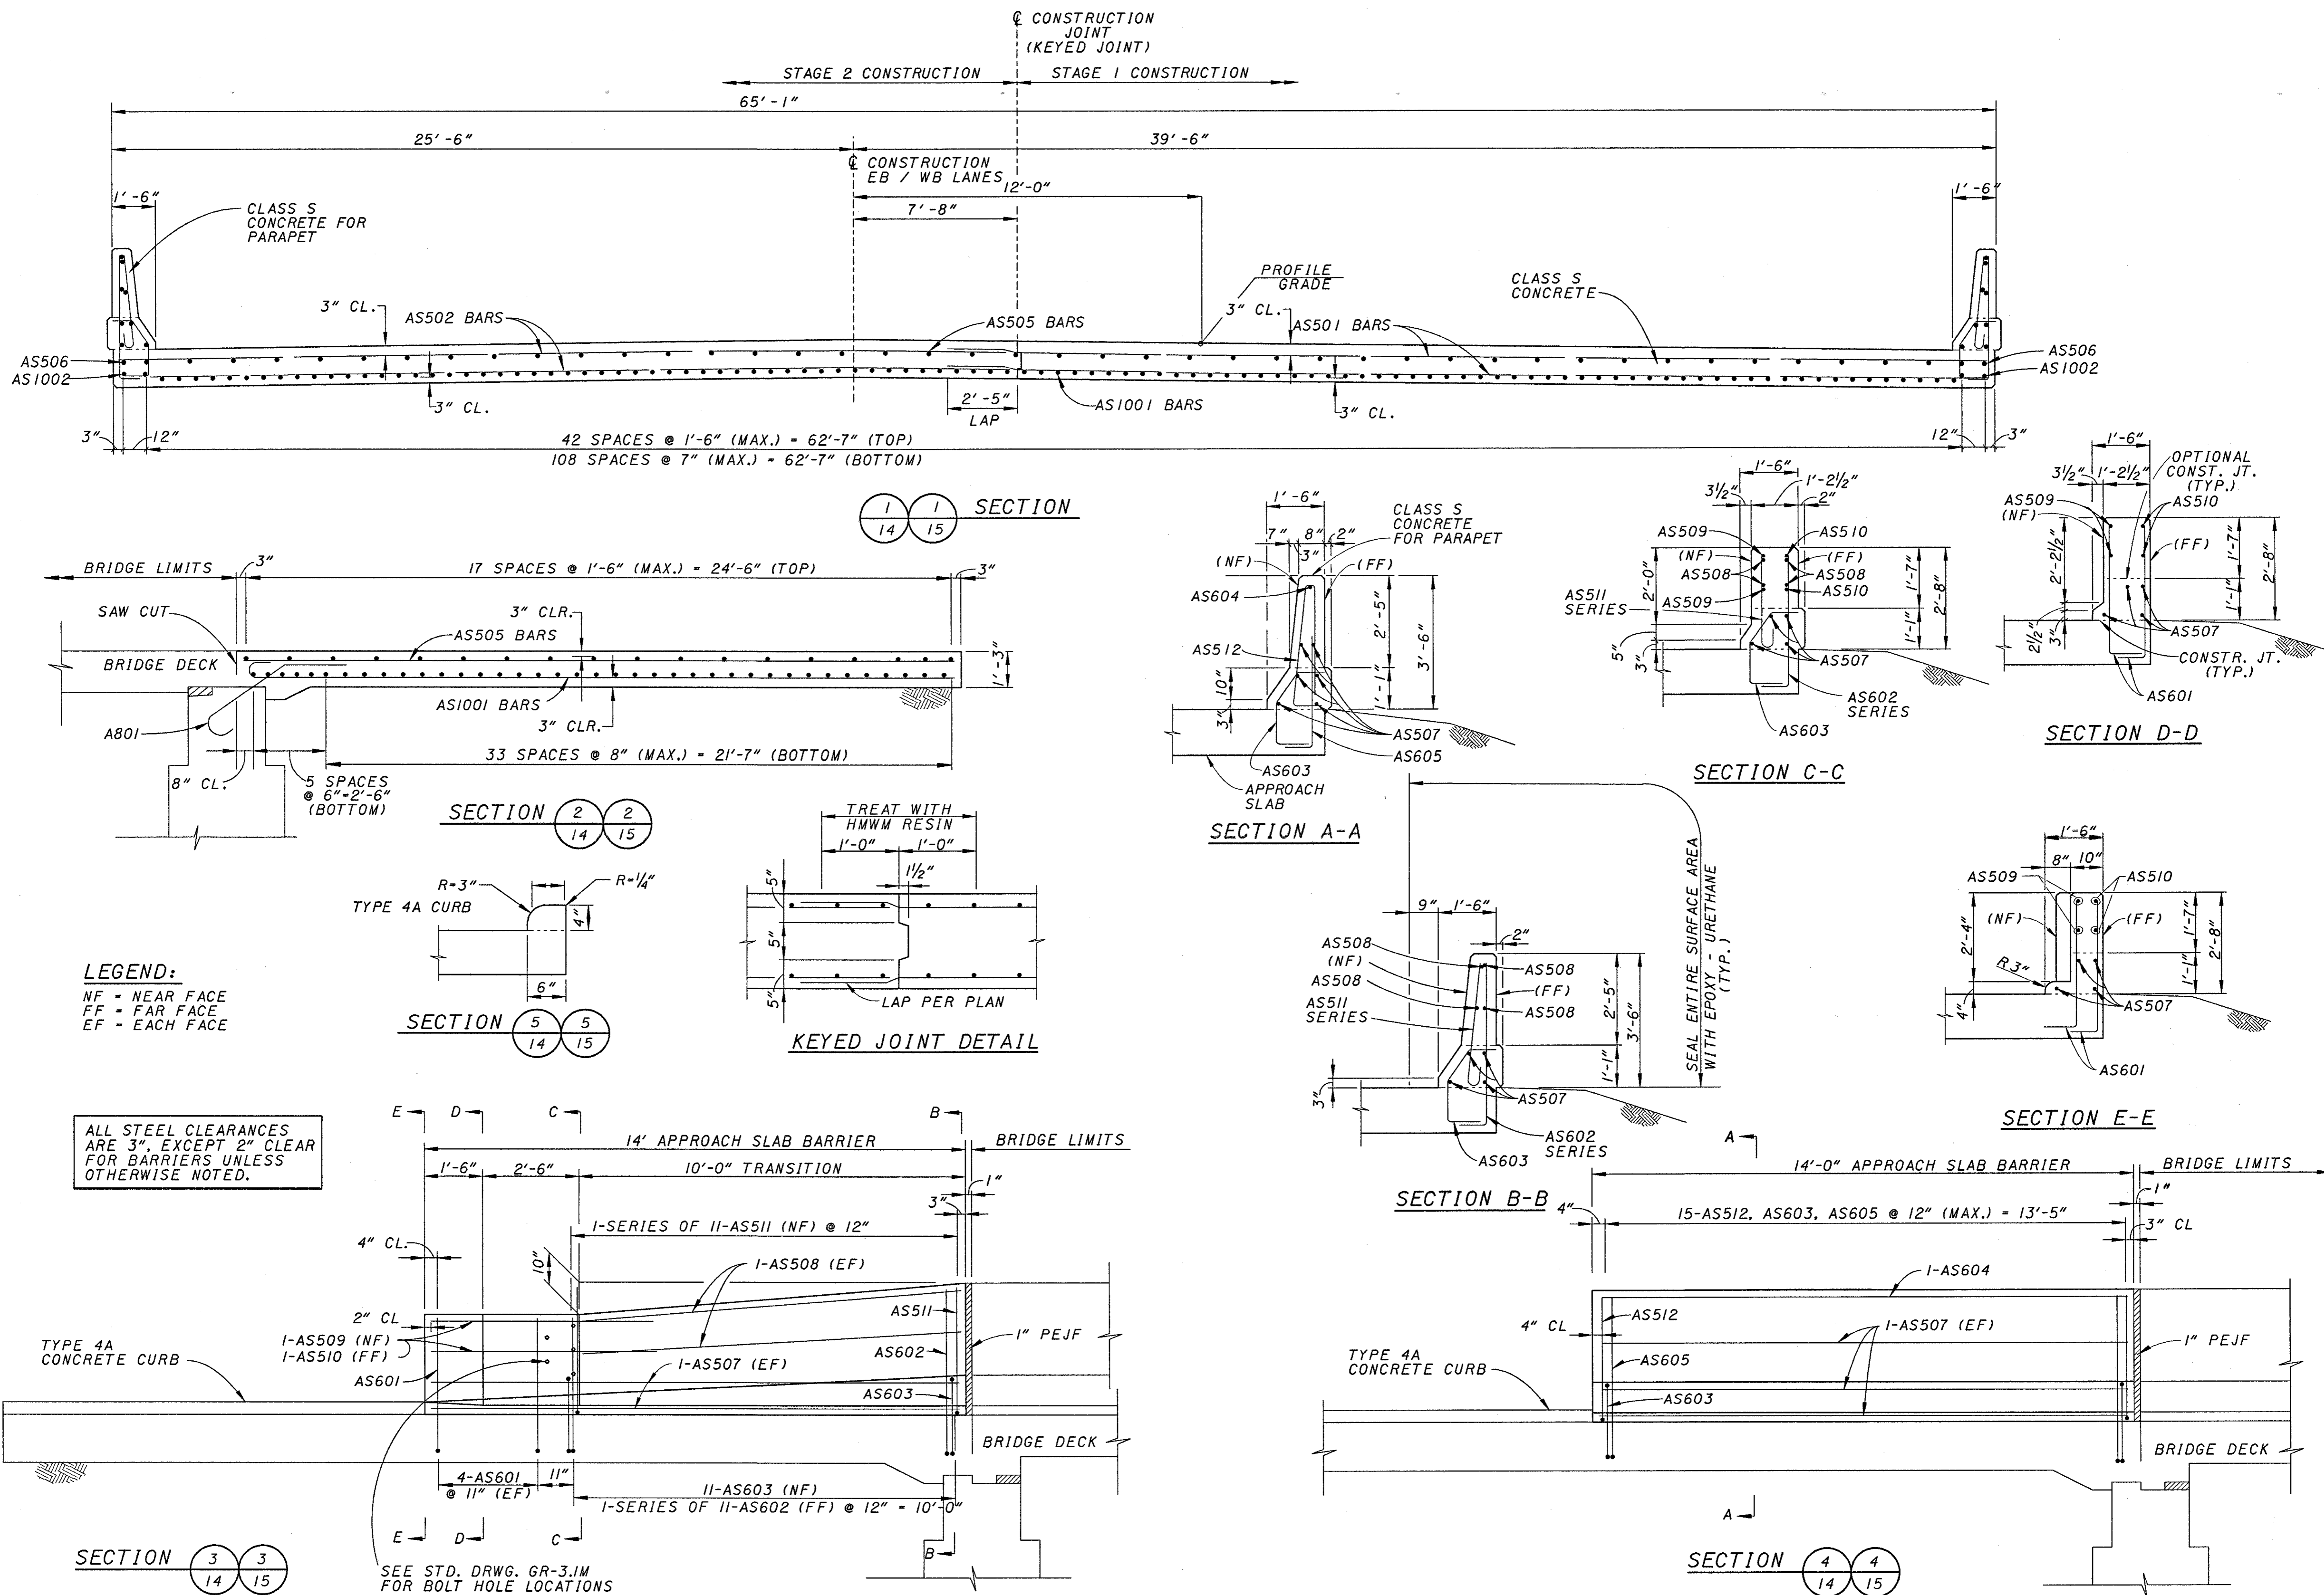

REF: ARES
 REF: ARES





REF: ARES
 REF: ARES
ALL STEEL CLEARANCES ARE 3", EXCEPT 2" CLEAR FOR BARRIERS UNLESS OTHERWISE NOTED.

SEE STD. DRWG. GR-3.1M FOR BOLT HOLE LOCATIONS

REVISIONS: (DATE) (BY) (REASON)
 1. (08/01/2024) (KZE) (REVISED PER COMMENTS)
 2. (08/01/2024) (KZE) (REVISED PER COMMENTS)
 3. (08/01/2024) (KZE) (REVISED PER COMMENTS)
 4. (08/01/2024) (KZE) (REVISED PER COMMENTS)
 5. (08/01/2024) (KZE) (REVISED PER COMMENTS)
 6. (08/01/2024) (KZE) (REVISED PER COMMENTS)
 7. (08/01/2024) (KZE) (REVISED PER COMMENTS)
 8. (08/01/2024) (KZE) (REVISED PER COMMENTS)
 9. (08/01/2024) (KZE) (REVISED PER COMMENTS)
 10. (08/01/2024) (KZE) (REVISED PER COMMENTS)

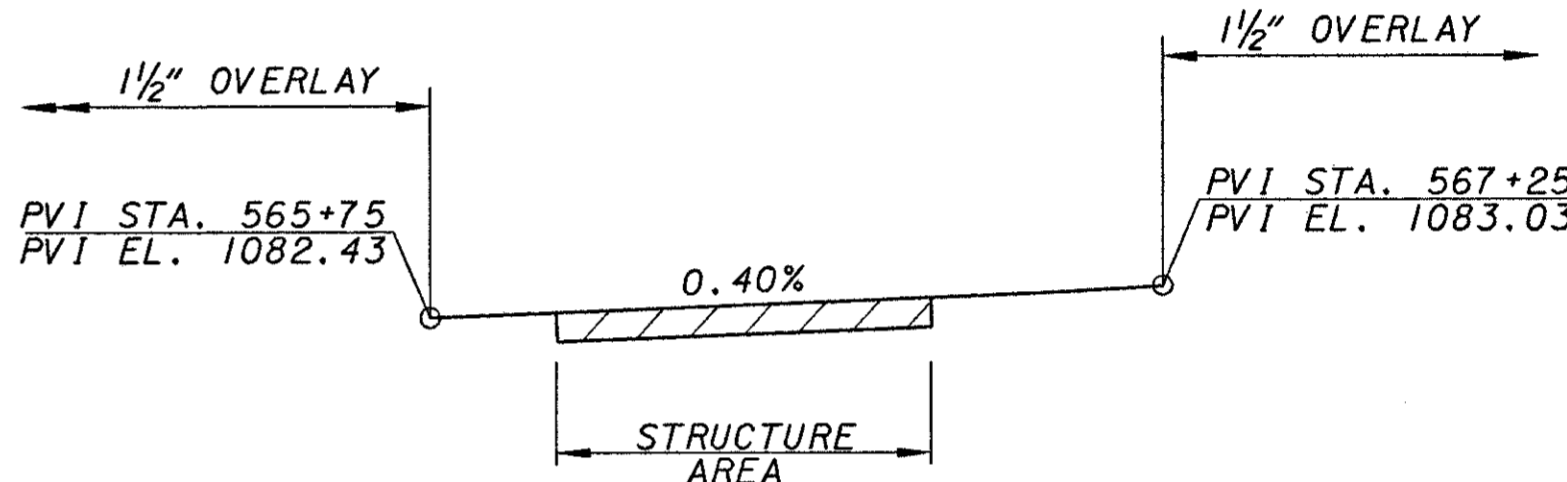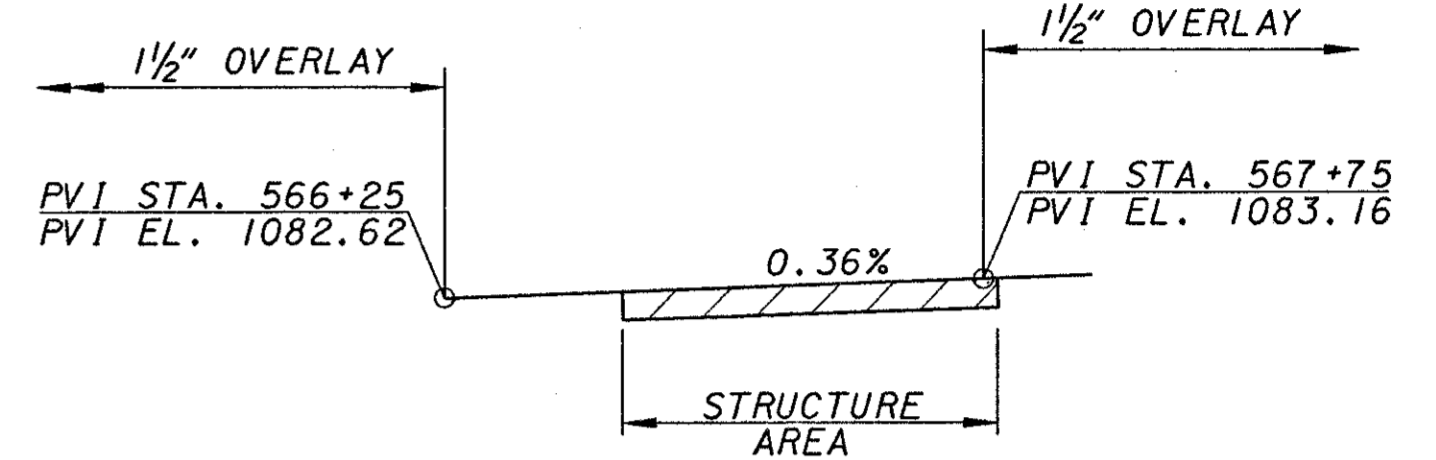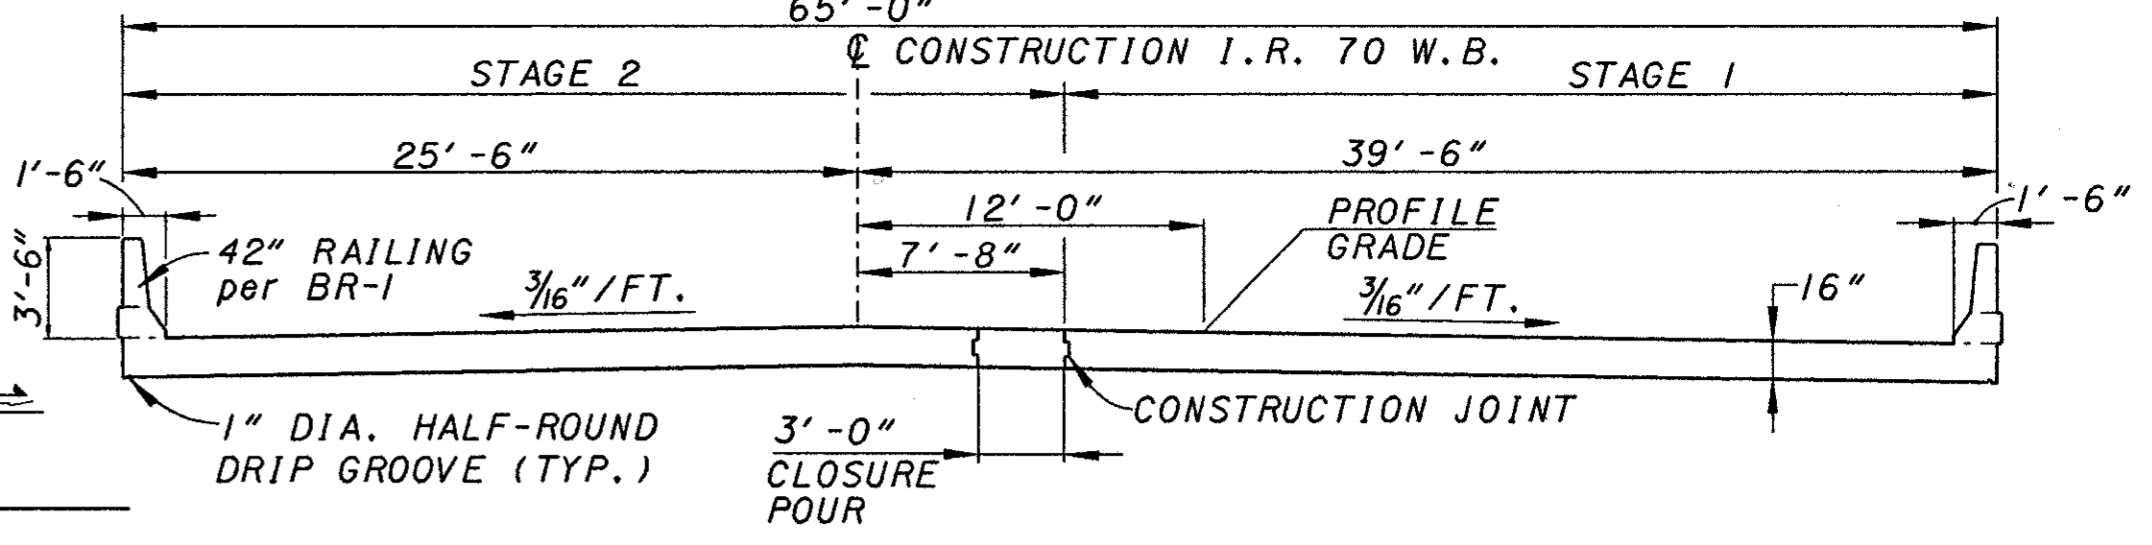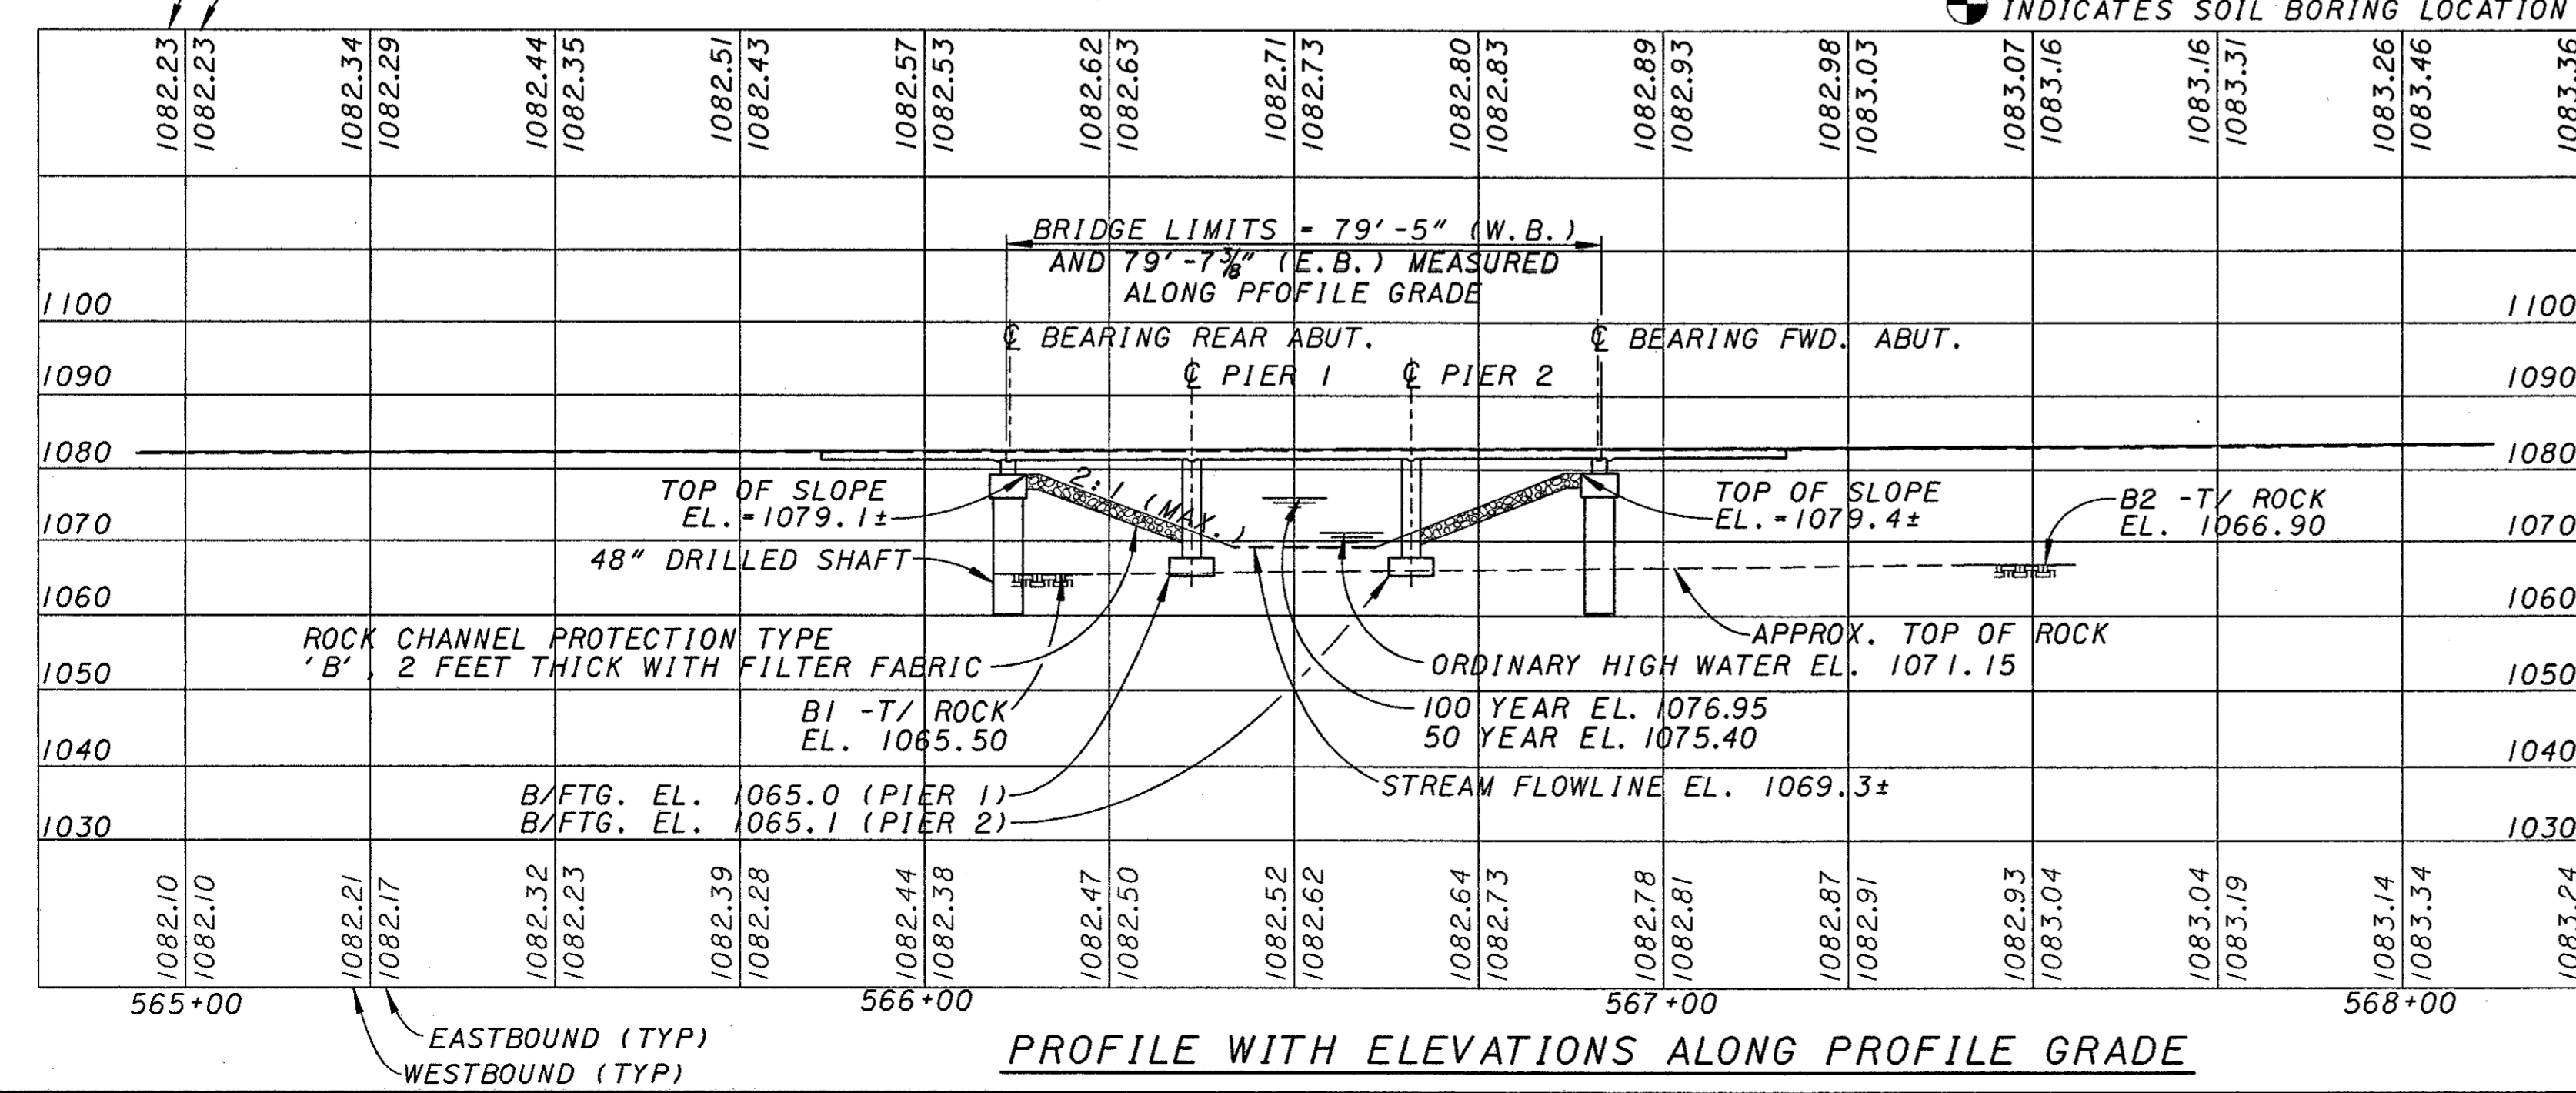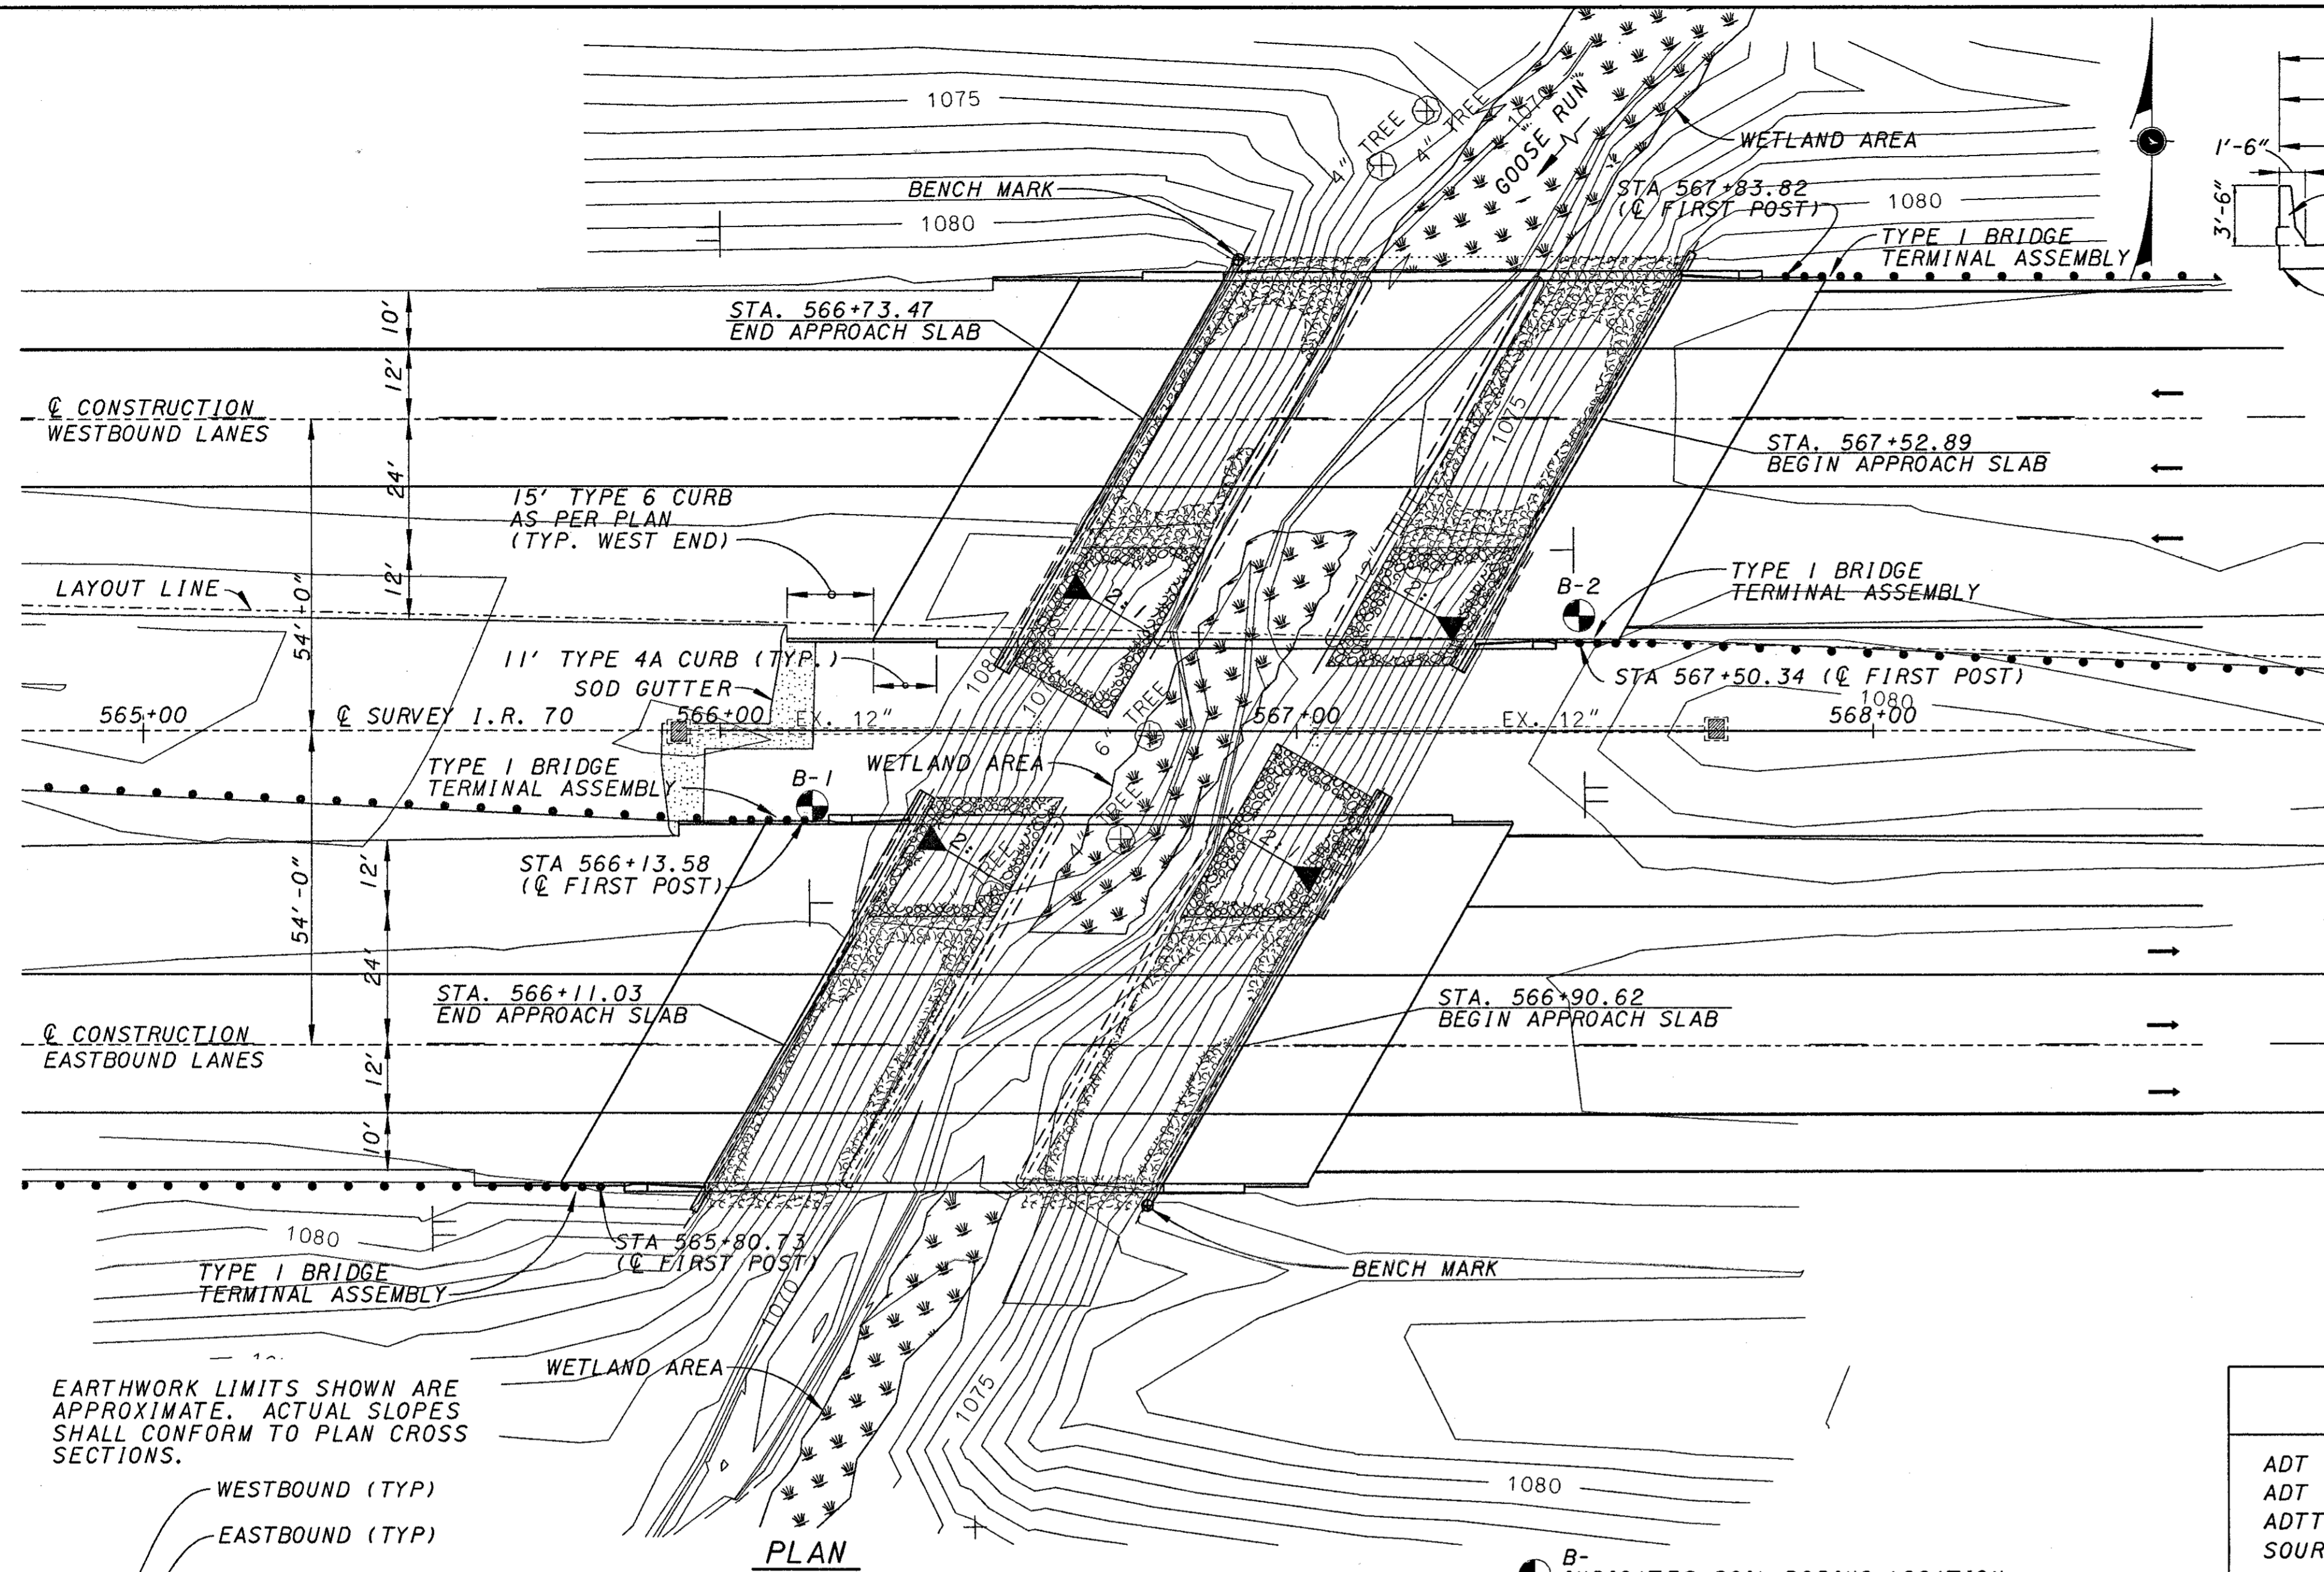

TRAFFIC DATA

ADT (2001) = 35,860
 ADT (2021) = 50,800
 ADTT (2021) = 19,812
 SOURCE = ODOT

BENCH MARK

BOX NOTCH ON S.E. ABUTMENT
 EASTBOUND AT STA. 566+74.54
 79.69 RT. AT ELEVATION 1083.27
 BOX NOTCH ON N.W. ABUTMENT
 WESTBOUND AT STA. 566+89.16,
 79.07 LT. AT ELEVATION 1083.34

DRAINAGE DATA

DRAINAGE AREA: 4.08 SQ. MILES
 EXISTING BRIDGE OPENING: 581 Sq. Ft.
 PROPOSED BRIDGE OPENING: 581 Sq. Ft.
 HW100: 1076.95
 HW50: 1075.40
 Q100: 959 C.F.S.
 Q50: 851 C.F.S.
 V100: 4.13 F.P.S.
 V50: 3.56 F.P.S.
 LOW CHORD ELEVATION: 1080.98
 TOP OF DECK ELEVATION: 1082.31 TO 1082.98

EXISTING STRUCTURE - I.R. 70




TYPE: 3 SPAN CONTINUOUS REINFORCED CONCRETE SLAB WITH CAPPED PILE SUBSTRUCTURE.
 LENGTH OF SPANS:
 23'-11 1/8" ±, 29'-10" ±, 23'-10 1/2" ± W.B.
 24'-1 1/8" ±, 29'-9 5/8" ±, 23'-10 1/8" ± E.B.
 ROADWAY WIDTH: 39'-8" ± TOE/TOE BARRIER
 DESIGN LOADING: C.F. 2000
 SKEW ANGLE: 30°00'00" ± LT. FWD.
 SUPERELEVATION: NONE - NORMAL CROWN
 WEARING SURFACE: 1" MONOLITHIC CONCRETE
 ALIGNMENT: TANGENT
 YEAR BUILT: 1962

PROPOSED STRUCTURE

PROPOSED WORK: NEW REINFORCED CONCRETE DECK ON WIDENED SUBSTRUCTURE.
 TYPE: 3 SPAN CONTINUOUS REINFORCED CONCRETE SLAB WITH CAPPED PILE SUBSTRUCTURE.
 LENGTH OF SPANS:
 23'-11 1/8" ±, 29'-10" ±, 23'-10 1/2" ± W.B.
 24'-1 1/8" ±, 29'-9 5/8" ±, 23'-10 1/8" ± E.B.
 ROADWAY WIDTH: 62'-0" ± TOE/TOE BARRIER
 DESIGN LOADING: HS-20 WITH ALTERNATE MILITARY
 SKEW ANGLE: 30°00'00" ± LT. FWD.
 SUPERELEVATION: NONE - NORMAL CROWN
 WEARING SURFACE: 1" MONOLITHIC CONCRETE
 APPROACH SLAB: AS-1-B1 (25' LONG)
 ALIGNMENT: TANGENT
 LATITUDE: N 39°50'13"
 LONGITUDE: W 84°36'52"

KZF DESIGN
 DESIGN AGENCY
 Architecture | Engineering | Interiors | Planning
 6801 I-45/680 | 234
 TEL: 613.621.8211 FAX: 613.621.8200 WEB: www.kzf.com

DATE: 08-02-00
 REVIEWED: DKG
 DRAWN: JDG
 DESIGNED: SJA
 CHECKED: WBS
 PROJECT: PREBLE COUNTY STA 566+42.25 STA 567+21.76
 SHEET: KZF #12
 TITLE: SITE PLAN
 BRIDGE NO. PRE-70-1072 L/R
 I.R. 70 OVER GOOSE RUN
 PRE-70-0.00
 1/17
 168
 283

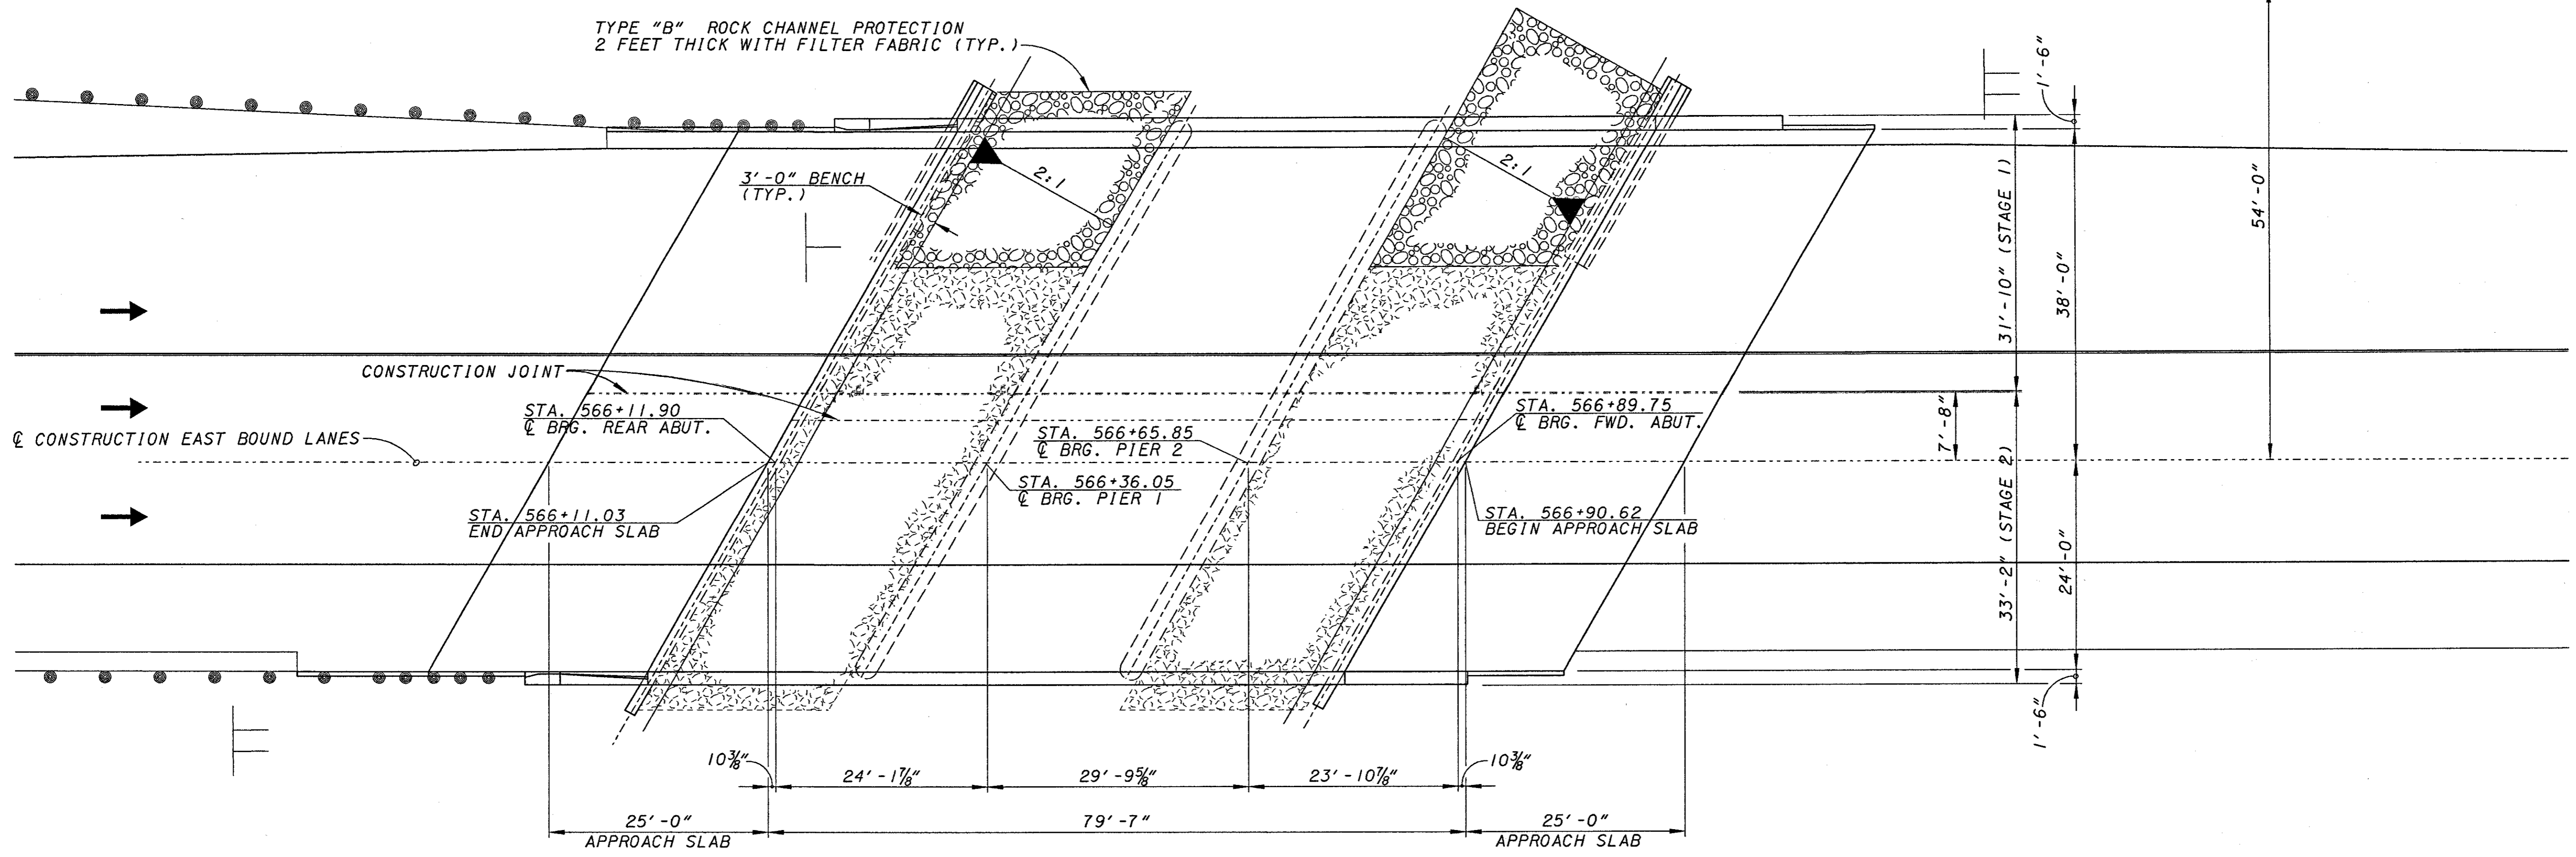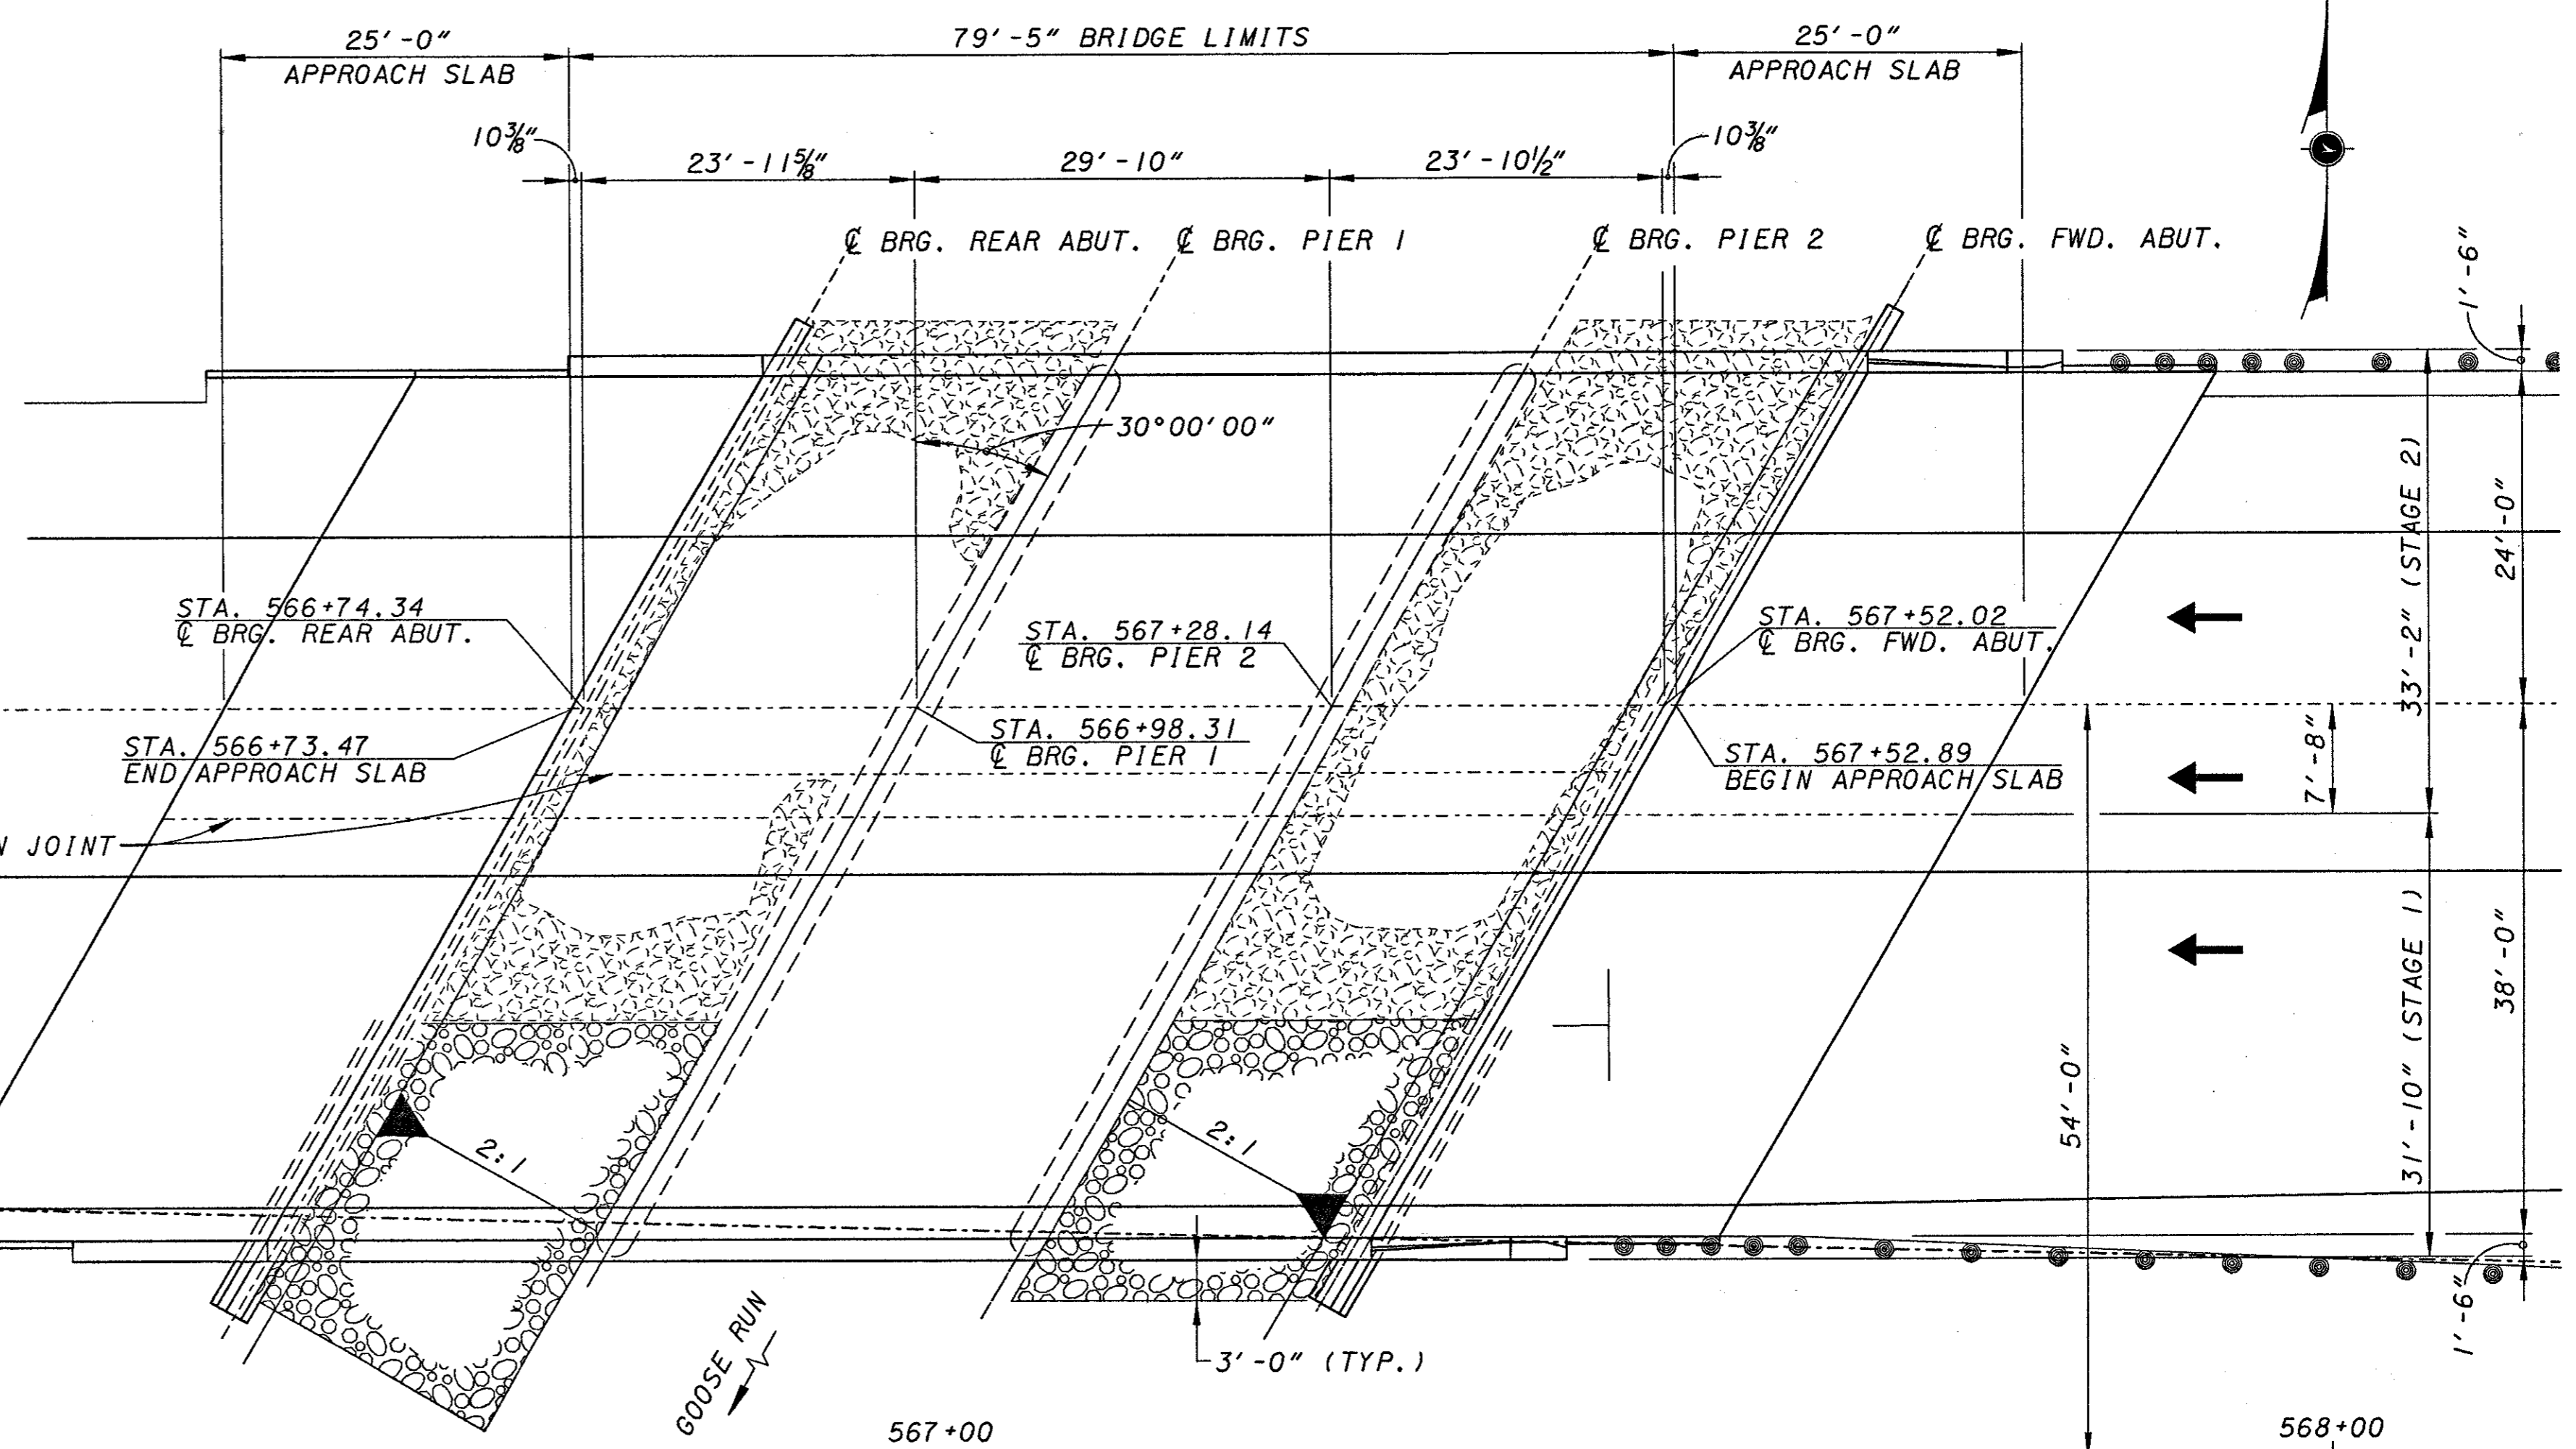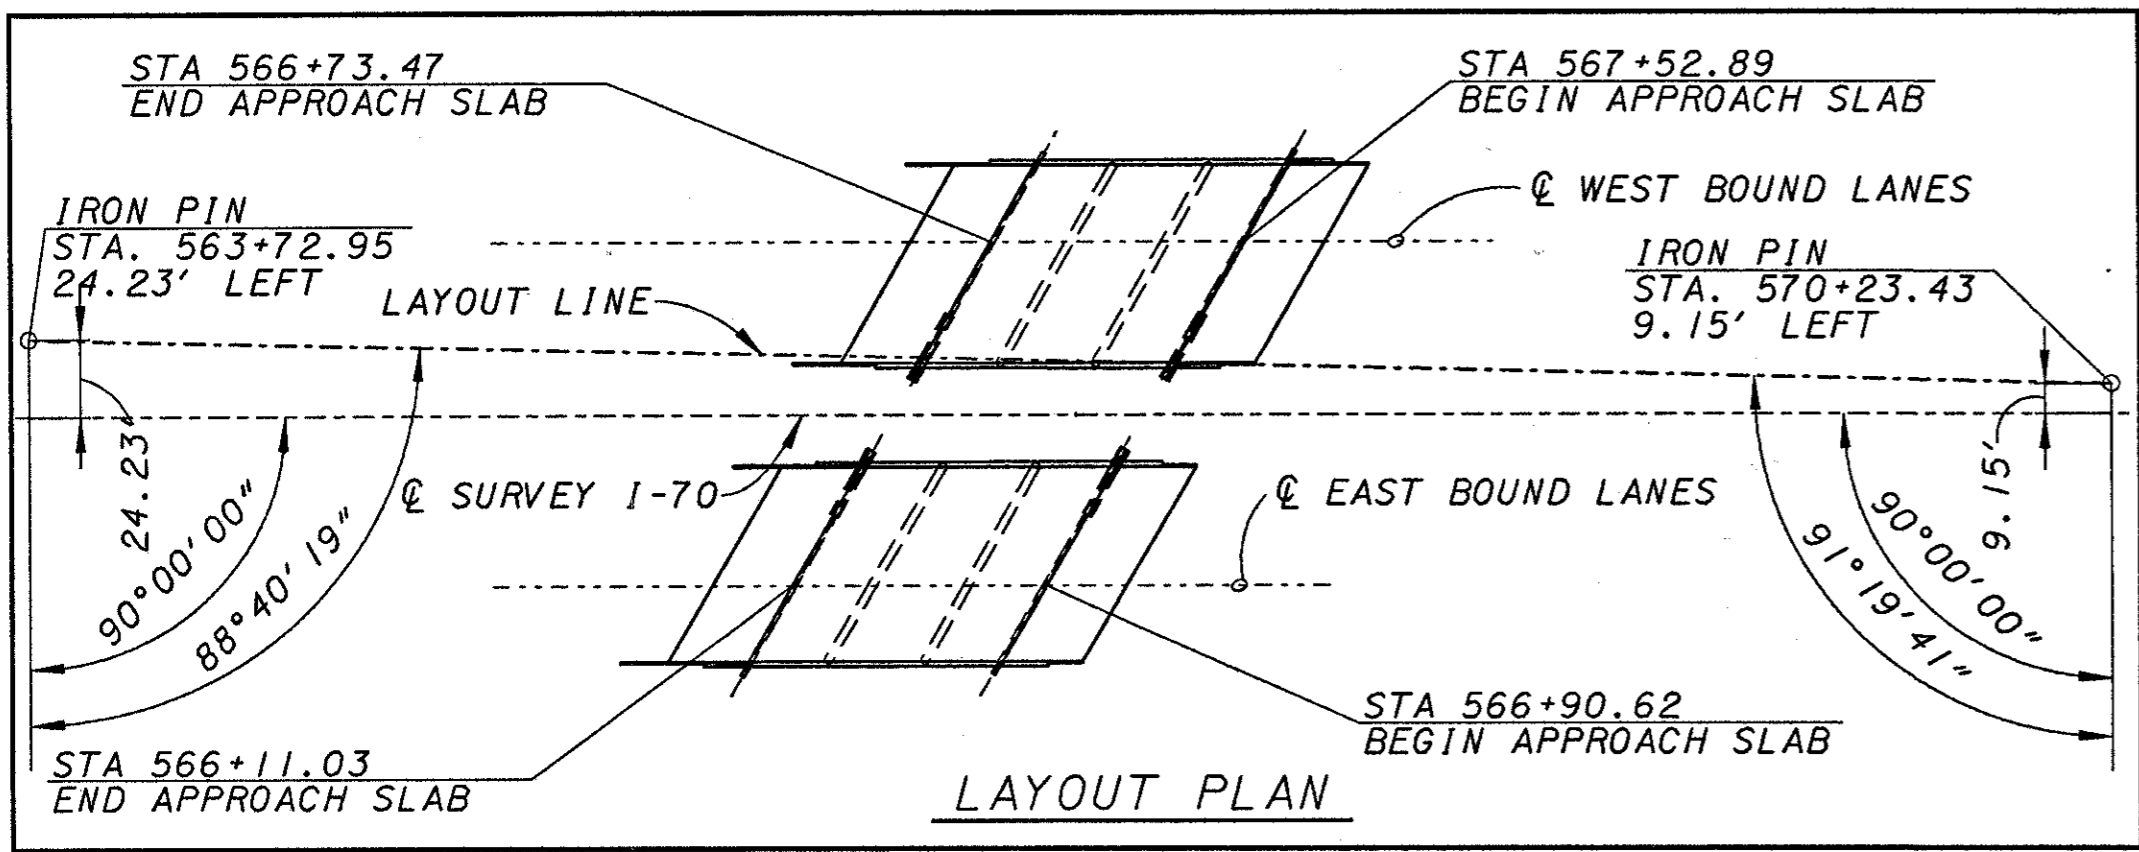

REF: **REF1**
REF: **REF2**
REF: **REF3**
REF: **REF4**
REF: **REF5**
REF: **REF6**

REF: **REF7**
REF: **REF8**
REF: **REF9**
REF: **REF10**
REF: **REF11**
REF: **REF12**

REF: **REF13**
REF: **REF14**
REF: **REF15**
REF: **REF16**
REF: **REF17**
REF: **REF18**

REF: **REF19**
REF: **REF20**
REF: **REF21**
REF: **REF22**
REF: **REF23**
REF: **REF24**

1. ALL DIMENSIONS ARE IN FEET AND INCHES UNLESS OTHERWISE SPECIFIED.
2. ALL DIMENSIONS ARE TO CENTERLINE UNLESS OTHERWISE SPECIFIED.
3. ALL DIMENSIONS ARE TO FACE UNLESS OTHERWISE SPECIFIED.
4. ALL DIMENSIONS ARE TO CENTERLINE UNLESS OTHERWISE SPECIFIED.
5. ALL DIMENSIONS ARE TO FACE UNLESS OTHERWISE SPECIFIED.
6. ALL DIMENSIONS ARE TO CENTERLINE UNLESS OTHERWISE SPECIFIED.
7. ALL DIMENSIONS ARE TO FACE UNLESS OTHERWISE SPECIFIED.
8. ALL DIMENSIONS ARE TO CENTERLINE UNLESS OTHERWISE SPECIFIED.
9. ALL DIMENSIONS ARE TO FACE UNLESS OTHERWISE SPECIFIED.
10. ALL DIMENSIONS ARE TO CENTERLINE UNLESS OTHERWISE SPECIFIED.

REF: **REF**
REF: **REF**
USER: *****
DATE: *****
TIME: *****

REFERENCE: SHALL BE MADE TO STANDARD DRAWINGS :

AS-1-81 REVISED 09-15-94 (SHEETS 1,2 & 3)
BR-1 REVISED 1-6-99
CS-1-93 DATED 5-11-93

AND TO SUPPLEMENTAL SPECIFICATION:

842 DATED 1/6/99
844 DATED 1/6/99
899 DATED 10/21/98
954 DATED 9/9/97
911 DATED 7/10/97

DESIGN SPECIFICATIONS: THIS STRUCTURE CONFORMS TO "STANDARD SPECIFICATIONS FOR HIGHWAY BRIDGES" ADOPTED BY THE AMERICAN ASSOCIATION OF STATE HIGHWAY AND TRANSPORTATION OFFICIALS, 1996, INCLUDING THE 1997, 1998 AND 1999 INTERIM SPECIFICATIONS AND THE ODOT BRIDGE DESIGN MANUAL.

DESIGN LOADING: HS20-44 AND THE ALTERNATE MILITARY LOADING.

DESIGN STRESSES:

CLASS S CONCRETE - COMPRESSIVE STRENGTH 4500 PSI (28-DAY) (SUPERSTRUCTURE)
CLASS C CONCRETE - COMPRESSIVE STRENGTH 4000 PSI (28-DAY) (SUBSTRUCTURE)
STRUCTURAL STEEL - ASTM A36 - YIELD STRENGTH 36,000 PSI
REINFORCING STEEL - ASTM A615, A616 OR A617. EPOXY COATED GRADE 60 - MINIMUM YIELD STRENGTH 60,000 PSI.
SPIRAL REINFORCEMENT MAY BE PLAIN BARS, ASTM A82 OR A615.

DECK PROTECTION METHOD: EPOXY COATED REINFORCING STEEL, SEALING OF CONCRETE SURFACES, CLASS S CONCRETE AND 2 1/2" CONCRETE COVER.

MONOLITHIC WEARING SURFACE: IS ASSUMED, FOR DESIGN PURPOSES, TO BE 1" THICK.

REINFORCING BAR SPLICES: REINFORCING BAR SPLICE LENGTHS SHALL CONFORM TO THE MINIMUM LENGTHS SPECIFIED BY 509.08 OF THE C.M.S. UNLESS OTHERWISE NOTED ON THE PLANS.

UTILITY LINES: ALL EXPENSE INVOLVED IN RELOCATION OF THE AFFECTED UTILITY LINES SHALL BE BORNE BY THE UTILITY. THE CONTRACTOR AND UTILITY ARE TO COOPERATE BY ARRANGING THEIR WORK IN SUCH A MANNER THAT INCONVENIENCE TO EITHER WILL BE HELD TO A MINIMUM.

REINFORCING CLEARANCE: UNLESS OTHERWISE NOTED, MINIMUM REINFORCING STEEL CLEARANCE TO FACE OF CONCRETE IS 2".

PROPOSED WORK

1. REMOVE EXISTING CONCRETE DECK, PARAPETS, SCUPPERS, APPROACH SLABS AND PORTIONS OF CONCRETE SUBSTRUCTURES IN A SEQUENCE CONSISTENT WITH MAINTENANCE OF TRAFFIC PLANS AND NOTES AND STAGE CONSTRUCTION.
2. INSTALL DRILL SHAFTS AND CONSTRUCT NEW ABUTMENT AND PIER CAPS.
3. CONSTRUCT A NEW CONCRETE DECK AT ELEVATIONS TO MEET OVERLAY ON EXISTING ROADWAY APPROACHES.
4. CONSTRUCT NEW CONCRETE APPROACH SLABS.
5. CONSTRUCT NEW CONCRETE BARRIERS ON DECK AND APPROACH SLABS.
6. PATCH CONCRETE SUBSTRUCTURES AS DIRECTED.
7. CLEAN AND SEAL CONCRETE BARRIERS, ABUTMENTS AND PIERS.

FOUNDATION BEARING PRESSURE

ABUTMENT FOOTINGS, AS DESIGNED, PRODUCE A MAXIMUM BEARING PRESSURE OF 3.2 TONS PER SQUARE FOOT. THE ALLOWABLE BEARING PRESSURE IS 3.2 TONS PER SQUARE FOOT.

PIER FOOTINGS, AS DESIGNED, PRODUCE A MAXIMUM BEARING PRESSURE OF 2.0 TONS PER SQUARE FOOT. THE ALLOWABLE BEARING PRESSURE IS 2.1 TONS PER SQUARE FOOT.

ITEM 202 - PORTIONS OF STRUCTURE REMOVED, AS PER PLAN

DESCRIPTION: THIS WORK SHALL CONSIST OF THE REMOVAL OF CONCRETE DECKS INCLUDING PARAPETS AND OTHER APPURTENANCES. PORTIONS OF THE PIERS AND ABUTMENTS SHALL ALSO BE REMOVED AS SHOWN ON THE PLANS. CARE SHALL BE TAKEN DURING REMOVALS TO PROTECT PORTIONS OF THE EXISTING STRUCTURE THAT ARE TO BE SALVAGED AND INCORPORATED INTO THE PROPOSED STRUCTURE. IN THIS RESPECT, THE USE OF EXPLOSIVES, HEADACHE BALLS AND/OR HOE-RAM TYPE OF EQUIPMENT IS PROHIBITED. ALL REMOVALS SHALL BE CONSISTENT WITH THE STAGE CONSTRUCTION REQUIREMENTS. EVERY EFFORT SHALL BE MADE TO KEEP DECK MATERIALS OUT OF THE STREAM CHANNEL. IF ANY MATERIAL FALLS INTO THE WATER, THE MATERIAL SHALL BE REMOVED IMMEDIATELY. ALL CONSTRUCTION DEBRIS AND OR EXCESS FILL MATERIAL SHALL BE DISPOSED AT AN ENGINEER APPROVED UPLAND SITE. (A DISPOSAL SITE LOCATED ABOVE THE 100-YEAR FLOOD PLAIN.) ALL WORK SHALL BE PERFORMED TO THE SATISFACTION OF THE ENGINEER.

PROTECTION OF TRAFFIC: PRIOR TO DEMOLITION OF ANY PORTIONS OF THE EXISTING SUPERSTRUCTURE, THE CONTRACTOR SHALL SUBMIT HIS PLANS FOR THE PROTECTION OF TRAFFIC (VEHICULAR, BOAT, ETC.) ADJACENT TO AND/OR UNDER THE STRUCTURE TO THE ENGINEER FOR APPROVAL. THESE PLANS SHALL INCLUDE PROVISIONS FOR ANY DEVICES AND STRUCTURES THAT MAY BE NECESSARY TO ENSURE SUCH PROTECTION. TEMPORARY VERTICAL CLEARANCES SPECIFIED ON THE PLANS OR IN THE PROPOSAL SHALL BE MAINTAINED AT ALL TIMES EXCEPT AS OTHERWISE APPROVED BY THE ENGINEER.

REMOVAL METHODS: CONCRETE MAY BE REMOVED BY CUTTING AND BY MEANS OF HAND OPERATED PNEUMATIC HAMMERS EMPLOYING POINTED OR BLUNTED CHISEL TYPE TOOLS. FOR REMOVALS, A HAMMER HEAVIER THAN 35 POUNDS BUT NOT TO EXCEED 90 POUNDS MAY BE USED AT THE APPROVAL OF THE ENGINEER, TO ENSURE ADEQUATE DEPTH CONTROL AND TO PREVENT DAMAGE TO CONCRETE SUBSTRUCTURES.

SUBSTRUCTURE CONCRETE REMOVAL SHALL BE BY MEANS OF APPROVED PNEUMATIC HAMMERS EMPLOYING POINTED AND BLUNT CHISEL TOOLS. HYDRAULIC HOE-RAM TYPE HAMMERS WILL NOT BE PERMITTED. THE WEIGHT OF THE HAMMER SHALL NOT BE MORE THAN 35 POUNDS FOR REMOVAL WITHIN 18 INCHES OF PORTIONS TO BE PRESERVED. OUTSIDE THE 18 INCH LIMIT, A HAMMER HEAVIER THAN 35 POUNDS, BUT NOT TO EXCEED 90 POUNDS MAY BE USED AT THE APPROVAL OF THE ENGINEER. PNEUMATIC HAMMERS SHALL NOT BE PLACED IN DIRECT CONTACT WITH REINFORCING STEEL THAT IS TO BE RETAINED IN THE REBUILT STRUCTURE.

ROCK CHANNEL PROTECTION

BROKEN CONCRETE FROM THE EXISTING BRIDGE DECK MAY BE USED FOR ROCK CHANNEL PROTECTION. MATERIAL CAN BE EITHER TYPE B OR TYPE C WITH A MINIMUM OF 50% OF THE MATERIAL BEING TYPE B.

SEAL PIER CAPS, WINGWALLS, ABUTMENTS, PARAPETS, AND DECK EDGES WITH EPOXY-URETHANE: COLOR SHALL BE FEDERAL COLOR STANDARD 17778 (OFF-WHITE)

THIS WORK SHALL CONSIST OF FURNISHING ALL NECESSARY LABOR, MATERIALS AND EQUIPMENT TO SEAL THE DESIGNATED EXPOSED CONCRETE SURFACE AREAS IN ACCORDANCE WITH THE PROJECT PROPOSAL DOCUMENT (PAGE 30) ENTITLED, ITEM SPECIAL - SEALING OF CONCRETE SURFACES

PATCH SUBSTRUCTURE CONCRETE

PATCHING SUBSTRUCTURE CONCRETE SHALL BE PERFORMED IN ACCORDANCE WITH THE STATE OF OHIO DEPARTMENT OF TRANSPORTATION CONSTRUCTION AND MATERIAL SPECIFICATIONS ITEM 519 PATCHING CONCRETE STRUCTURES. THE LOCATION AND SURFACE AREA EXTENT OF PATCHING CONCRETE STRUCTURES SHALL BE FIELD-DETERMINED BY THE ODOT PROJECT ENGINEER. THE CONTRACTOR SHALL PROVIDE THE PROJECT ENGINEER ACCESS TO CONCRETE SURFACES FOR INSPECTION. THE CONTRACTOR SHALL PROVIDE THE ENGINEER AEROSOL PAINT FOR THE PURPOSE OF MARKING SUBSTRUCTURE CONCRETE TO BE PATCHED.

LOADING LIMITATION: NO PART OF THE STRUCTURE SHALL BE SUBJECTED TO UNIT STRESSES THAT EXCEED 136.5% OF THE ALLOWABLE UNIT STRESSES GIVEN IN THE AASHTO STANDARD SPECIFICATIONS FOR HIGHWAY BRIDGES DUE EITHER TO DEMOLITION, ERECTION OR CONSTRUCTION METHODS, OR TO THE USE OR MOVEMENT OF DEMOLITION OR ERECTION EQUIPMENT ON OR ACROSS THE STRUCTURE. STRUCTURAL ANALYSIS COMPUTATIONS, BY A REGISTERED PROFESSIONAL ENGINEER, SHOWING THE ALLOWABLE STRESSES AND THE MAXIMUM STRESSES PRODUCED BY THE CONTRACTOR'S METHODS OR EQUIPMENT SHALL BE SUBMITTED TO THE DIRECTOR FOR REVIEW AND APPROVAL AT LEAST TWO WEEKS PRIOR TO THE START OF THE WORK.

REF: **REF**
REF: **REF**
ACTIVE LEVELS ON **EIV**

ENVIRONMENTAL COMMITMENTS AND RESOURCES TO BE AVOIDED

THE CONTRACTOR SHALL REFER TO THE STORMWATER POLLUTION PREVENTION PLAN (SWAPP) TO ADDRESS EROSION ASSOCIATED WITH SHOULDER DISTURBANCE/ RECONSTRUCTION AND BRIDGE WORK. (CMS 877.03)

ALL CONDITIONS ATTACHED WITH CORPS PERMIT (NATIONWIDE 3 & 14) SHALL BE IMPLEMENTED IN THE FIELD WITH THE ACTUAL PERMIT BEING DISPLAYED ONSITE.

EVERY EFFORT SHALL BE MADE TO KEEP DECK MATERIAL OUT OF THE STREAM CHANNELS. IF ANY MATERIAL FALLS INTO THE WATER, IT SHALL BE REMOVED IMMEDIATELY. ALL DEBRIS OR EXCESS FILL MATERIAL SHOULD BE DISPOSED AT AN APPROVED UPLAND SITE. (ABOVE THE 100 YR. FLOODPLAIN)

IN-STREAM STRUCTURES SHALL BE KEPT TO THE MINIMAL SIZE NEEDED TO FACILITATE WORK AND WILL BE REMOVED IMMEDIATELY TO ORIGINAL GRADE AFTER IN-STREAM WORK IS COMPLETED.

WHILE PAINTING, SANDBLASTING OR SEALING OF ANY PORTION OF THE BRIDGE AN APPROPRIATE APRON WILL BE UTILIZED TO PREVENT DEBRIS AND PAINT OVERSPRAY AND SEALANTS FROM ENTERING INTO THE STREAM.

PROPER SEDIMENT AND EROSION CONTROLS SHALL BE IMPLEMENTED THROUGHOUT THE COURSE OF THE PROJECT. ALL DISTURBED AREAS SHALL BE SEEDED AND MULCHED IMMEDIATELY UPON COMPLETION OF EARTHWORK (ODOT CMS ITEM 877)

IMPLEMENT ODOT CMS ITEM 616, DUST CONTROL AS NECESSARY.

COMPLY WITH ODOT CMS ITEM 107.21 CONTROLLING POLLUTION OF THE ENVIRONMENT.

VEGETATION REMOVAL WILL BE HELD TO AN ABSOLUTE MINIMUM REQUIRED TO COMPLETE THE WORK.

WETLANDS EXIST WITHIN THE PROJECT AREA. ALL WETLANDS NOT DIRECTLY INVOLVED WITH BRIDGE DECK/SUBSTRUCTURE MODIFICATIONS SHALL BE AVOIDED. THE BRIDGE SITE PLANS SHOW WETLAND AREAS TO BE AVOIDED.

REPLACEMENT OF EXISTING REINFORCING STEEL: ANY EXISTING REINFORCING BARS WHICH ARE TO BE INCORPORATED INTO THE NEW WORK AND WHICH ARE MADE UNUSABLE BY THE CONTRACTOR'S CONCRETE REMOVAL OPERATIONS SHALL BE REPLACED WITH NEW STEEL AT HIS COST. ANY EXISTING REINFORCING BARS WHICH ARE DEEMED BY THE ENGINEER TO BE UNUSABLE BECAUSE OF CORROSION SHALL BE REPLACED WITH NEW REINFORCING STEEL.

EXISTING STRUCTURE VERIFICATION: DETAILS AND DIMENSIONS SHOWN ON THESE PLANS PERTAINING TO THE EXISTING STRUCTURE HAVE BEEN OBTAINED FROM PLANS OF THE EXISTING STRUCTURE AND/OR FROM FIELD OBSERVATIONS AND MEASUREMENTS. CONSEQUENTLY, THEY ARE INDICATIVE OF THE EXISTING STRUCTURE AND THE PROPOSED WORK BUT THEY SHALL BE CONSIDERED TENTATIVE AND APPROXIMATE. THE CONTRACTOR IS REFERED TO CMS SECTIONS 102.05 AND 105.02.

CONTRACT BID PRICES SHALL BE BASED UPON A RECOGNITION OF THE UNCERTAINTIES DESCRIBED ABOVE AND UPON A PREBID EXAMINATION OF THE EXISTING STRUCTURE BY THE CONTRACTOR. HOWEVER, ALL PROJECT WORK SHALL BE BASED UPON ACTUAL DETAILS AND DIMENSIONS WHICH HAVE BEEN VERIFIED BY THE CONTRACTOR IN THE FIELD.

EXISTING STRUCTURE PLANS:

THE ORIGINAL DESIGN PLANS MAY BE EXAMINED AT THE DEPARTMENT OF TRANSPORTATION, DISTRICT 8 OFFICE, 505 SOUTH S.R. 741 LEBANON, OHIO 45036 (800) 831-2142. THE CONTRACTOR SHALL BECOME FAMILIAR WITH THESE DRAWINGS.

ITEM 846 - TREATING CONCRETE WITH HMWM RESIN

SEAL THE CONSTRUCTION JOINT IN THE BRIDGE DECK AND APPROACH SLABS AS SHOWN IN THE PLANS. SEE SUPPLEMENTAL SPECIFICATIONS FOR SURFACE PREPARATION AND RATE OF APPLICATION.

REF: **REF**
REF: **REF**
REF: **REF**
REF: **REF**


REF: **REF**
REF: **REF**
DATE: 08-02-00
PROJECT: I-70 OVER GOOSE RUN
DRAWN BY: JDC
CHECKED BY: WBS
DATE: 08-02-00


 DENOTES PORTION OF EXISTING STRUCTURE TO BE REMOVED.

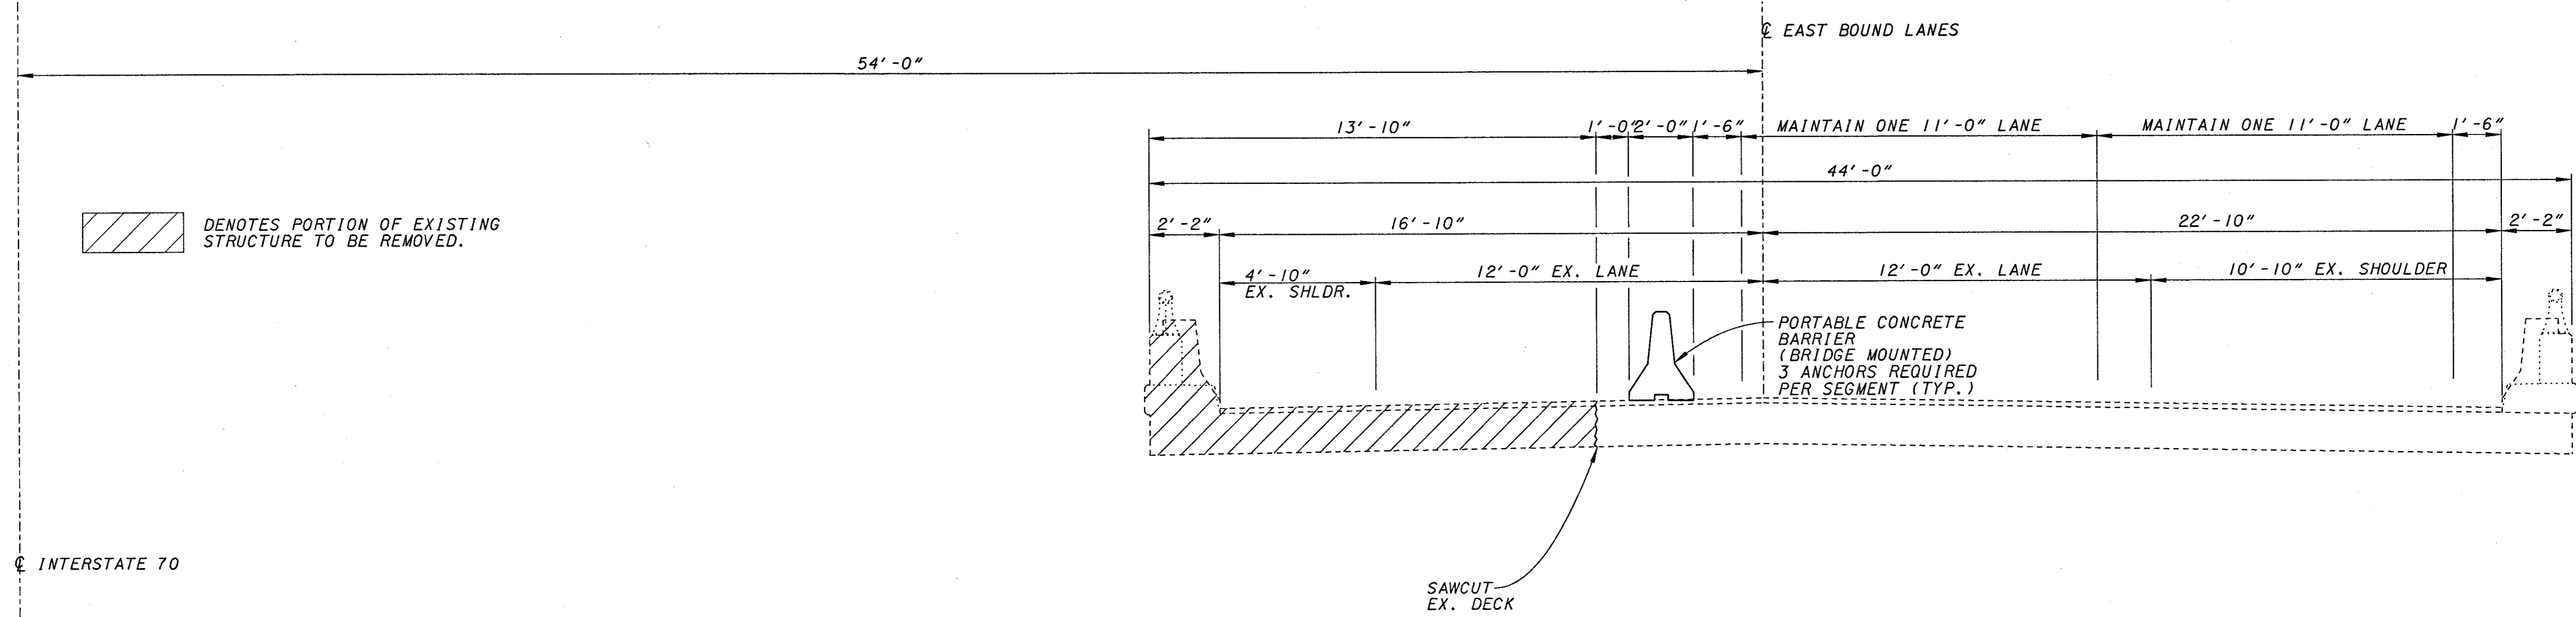

STAGE 1A

NOTES:

- 1. SEE STD. DWG. PCB-91 FOR PORTABLE CONCRETE BARRIER DETAILS AND NOTES.
- 2. EASTBOUND BRIDGE SHOWN, WESTBOUND BRIDGE SIMILAR

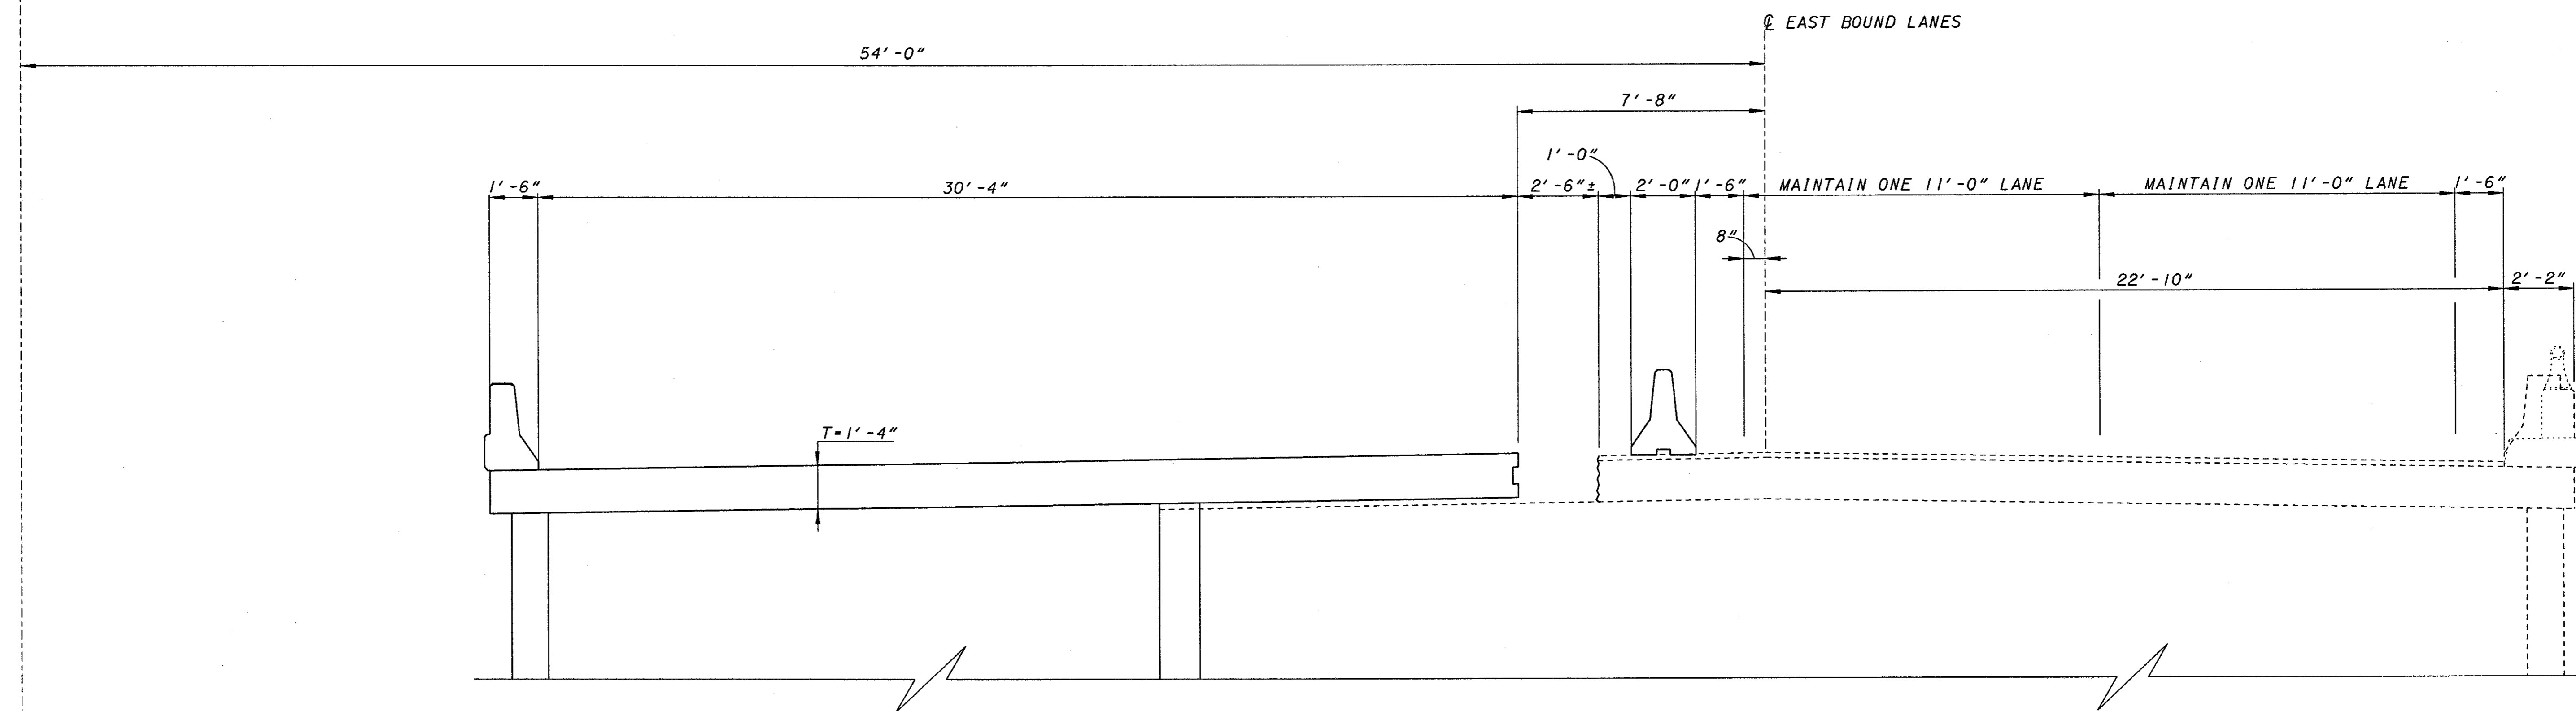

STAGE 1B

DATE	08-02-00
REVISED	DGK
STRUCTURE FILE NUMBER	6801145/6801234
DESIGNED	SJA
CHECKED	WBS
DRAWN	JDC
REVISED	

KZF #12

BRIDGE STAGE 1 CONSTRUCTION
BRIDGE NO. PRE-70-1072 L/R
I.R. 70 OVER GOOSE RUN

PRE-70-0.00


REF: **REF**
REF: **REF**
DESIGNATION*****
PRJ: NAME: **PRJNAME**
ACTIVE LEVELS ON: **LEVEL**

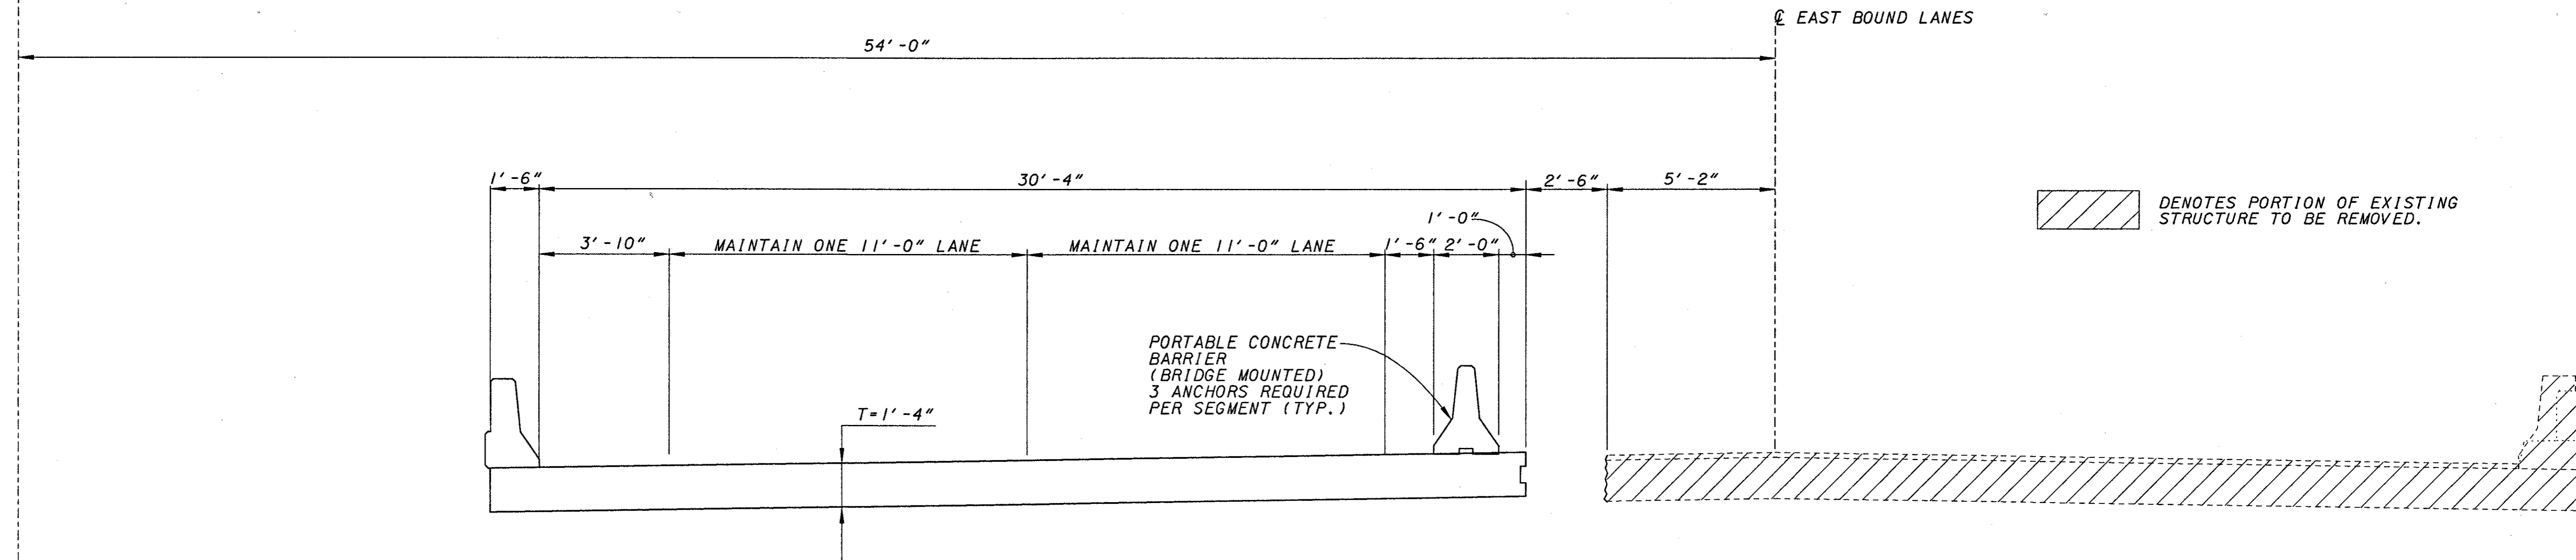

 DENOTES PORTION OF EXISTING STRUCTURE TO BE REMOVED.

INTERSTATE 70

STAGE 2A

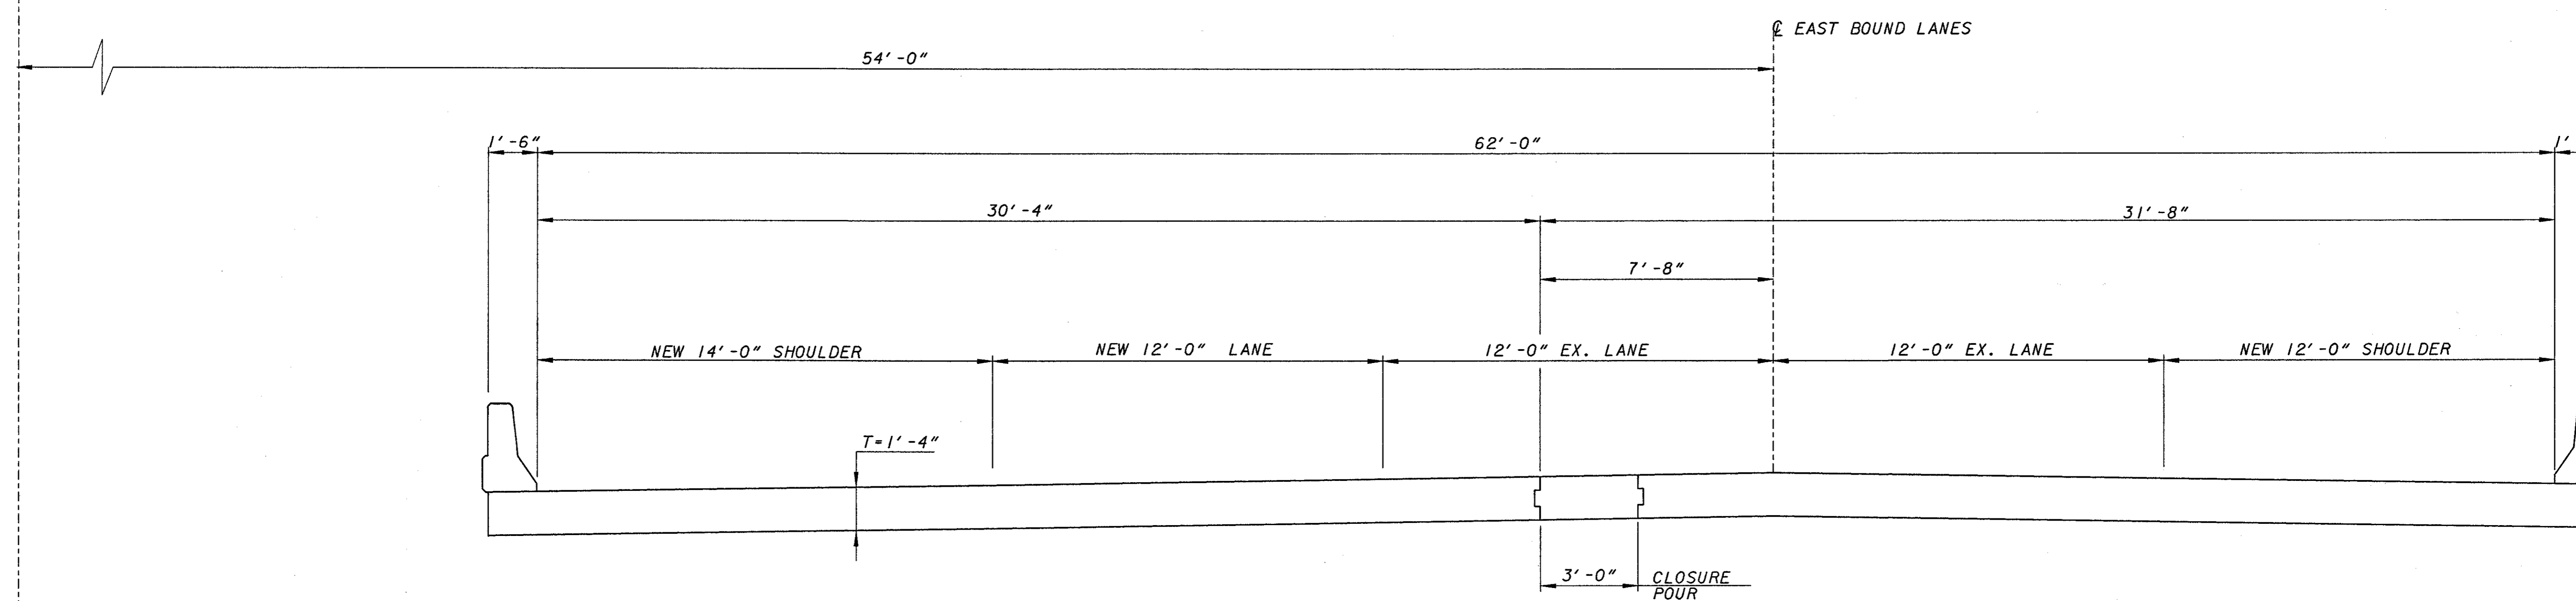



STAGE 2B

DESIGNED	SJA	CHECKED	WBS
DRAWN	JDG	REVISED	
REVIEWED	DGK	STRUCTURE FILE NUMBER	680114576801234
DATE	08-02-00		

KZF #12

BRIDGE STAGE 2 CONSTRUCTION
BRIDGE NO. PRE-70-1072 L/R
I.R. 70 OVER GOOSE RUN

PRE-70-0.00

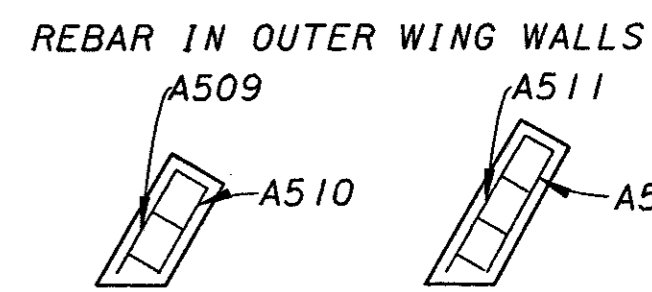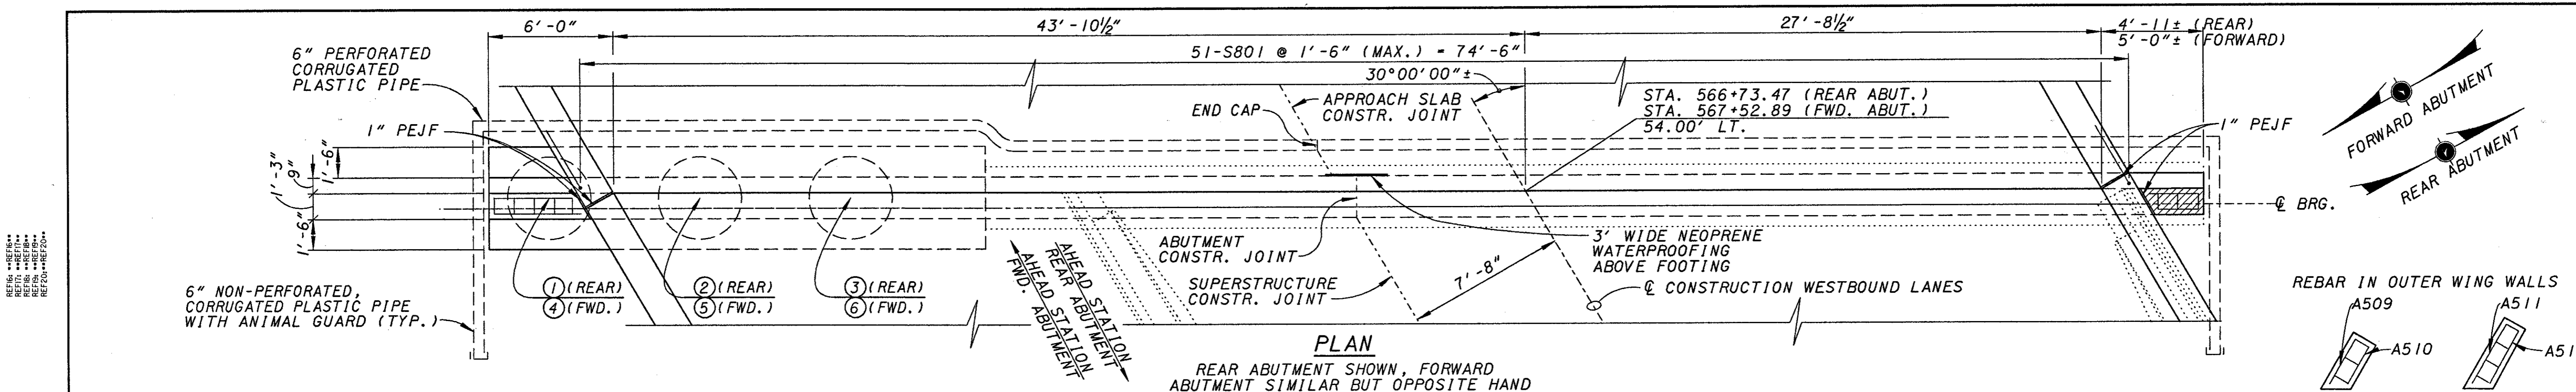

	REAR ABUT.	FORWARD ABUT.
A509	2'-6"	A511 3'-4"
A510	2'-0"	A512 2'-10"





LEGEND

EF = EACH FACE
NF = NEAR FACE
FF = FAR FACE
PEJF = PREFORMED EXPANSION JOINT FILLER

(X) DENOTES DRILLED SHAFT NUMBER


▨ DENOTES PORTION OF EXISTING STRUCTURE TO BE REMOVED

ALL STEEL CLEARANCES ARE 3" UNLESS NOTED OTHERWISE.

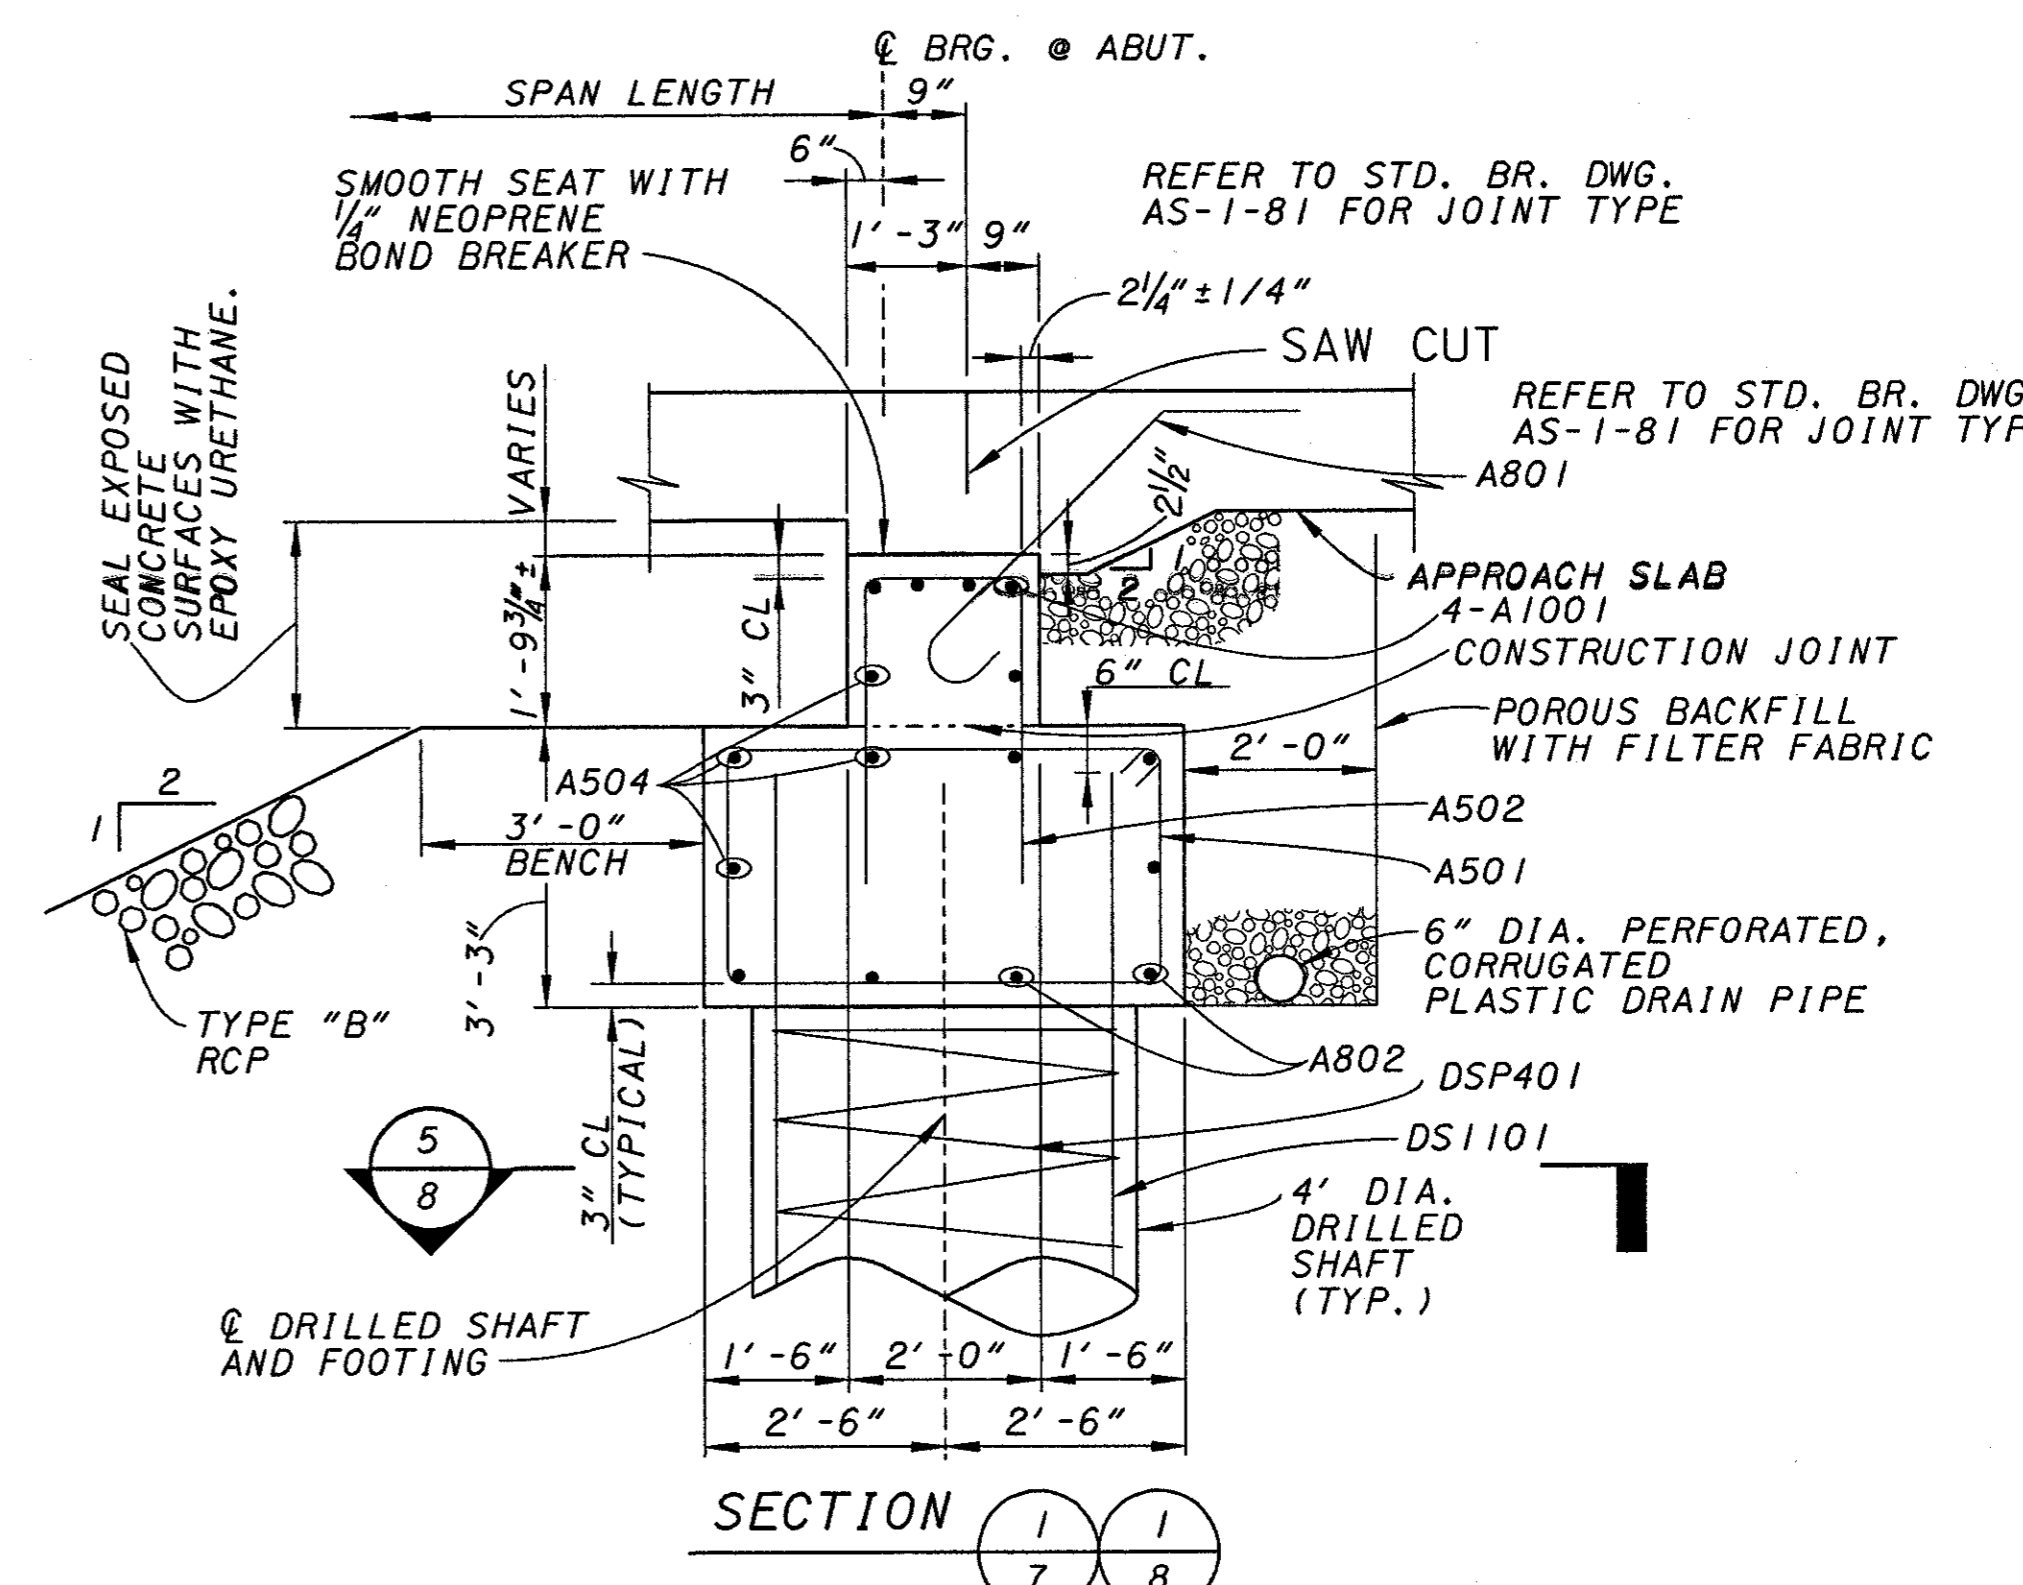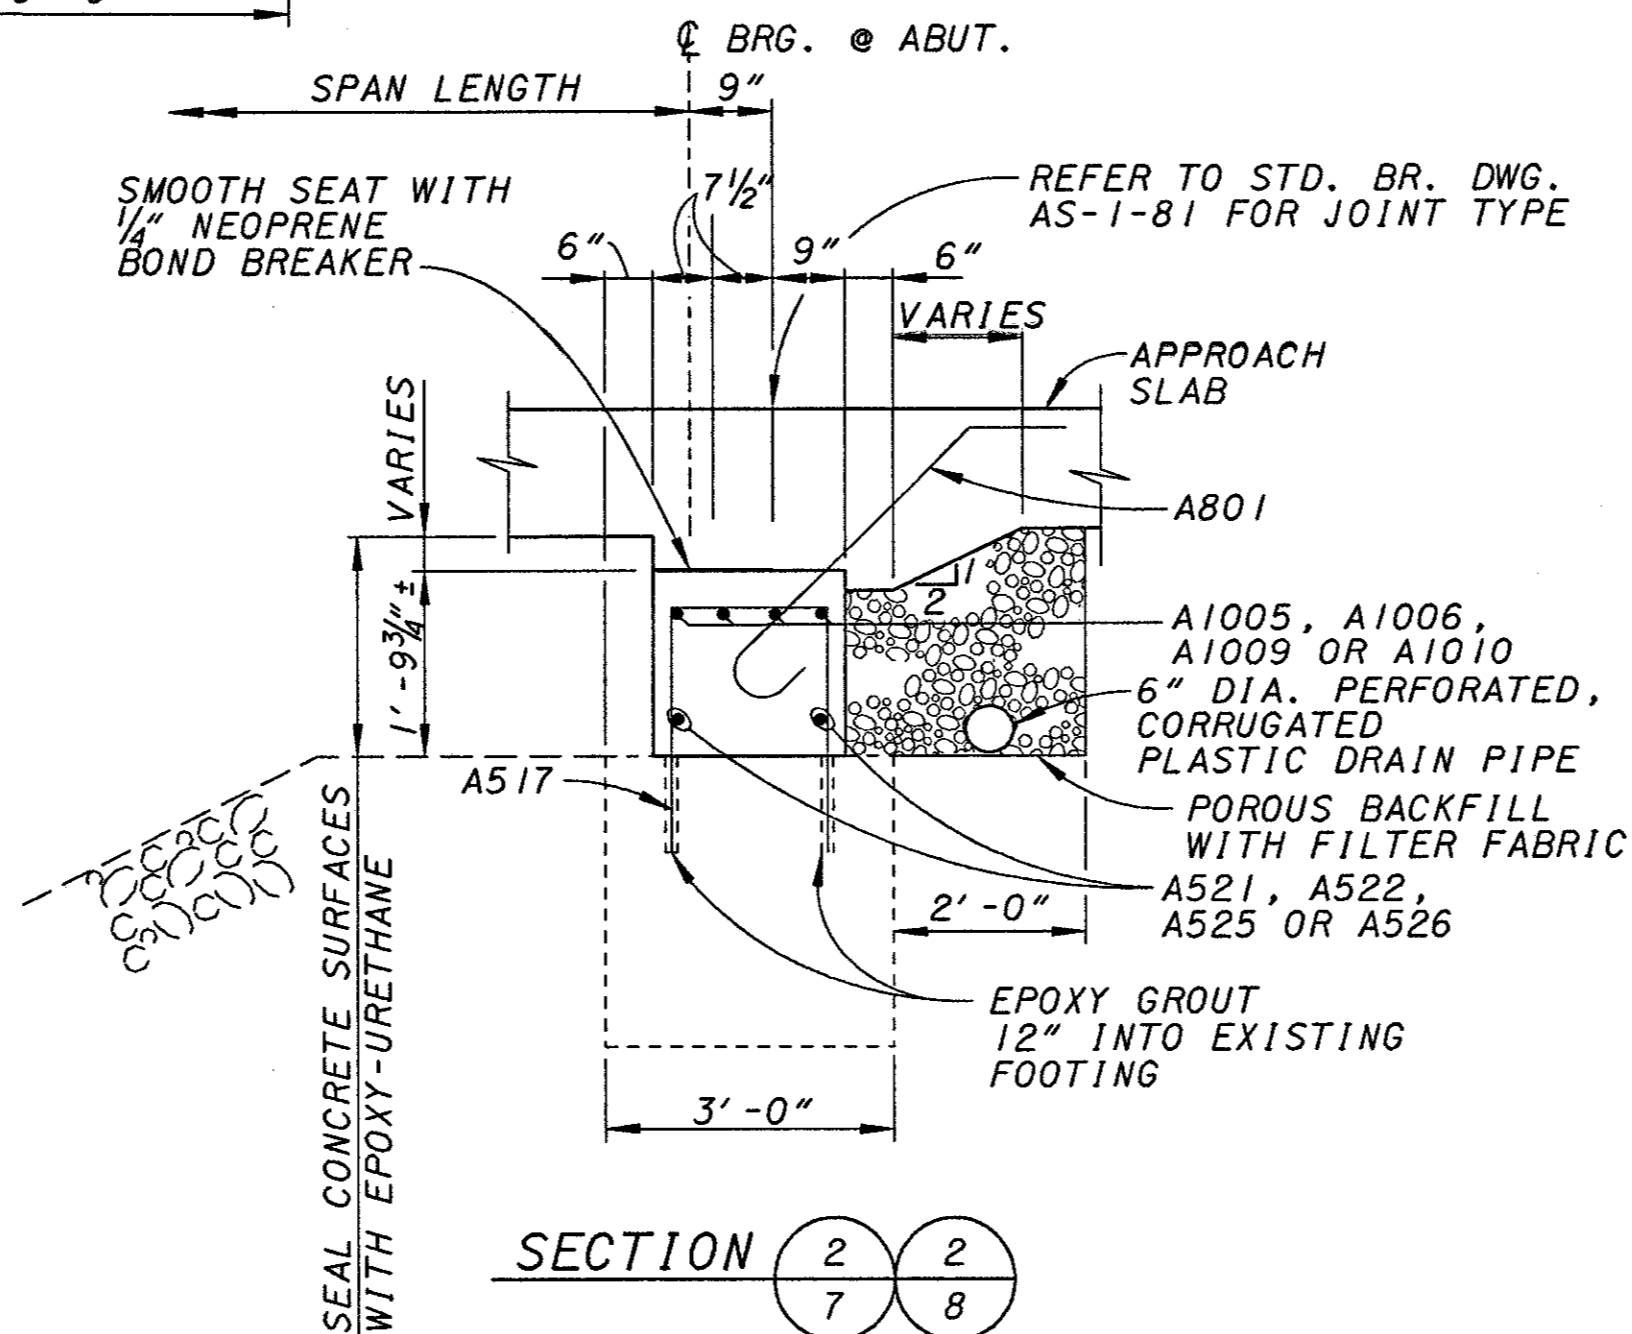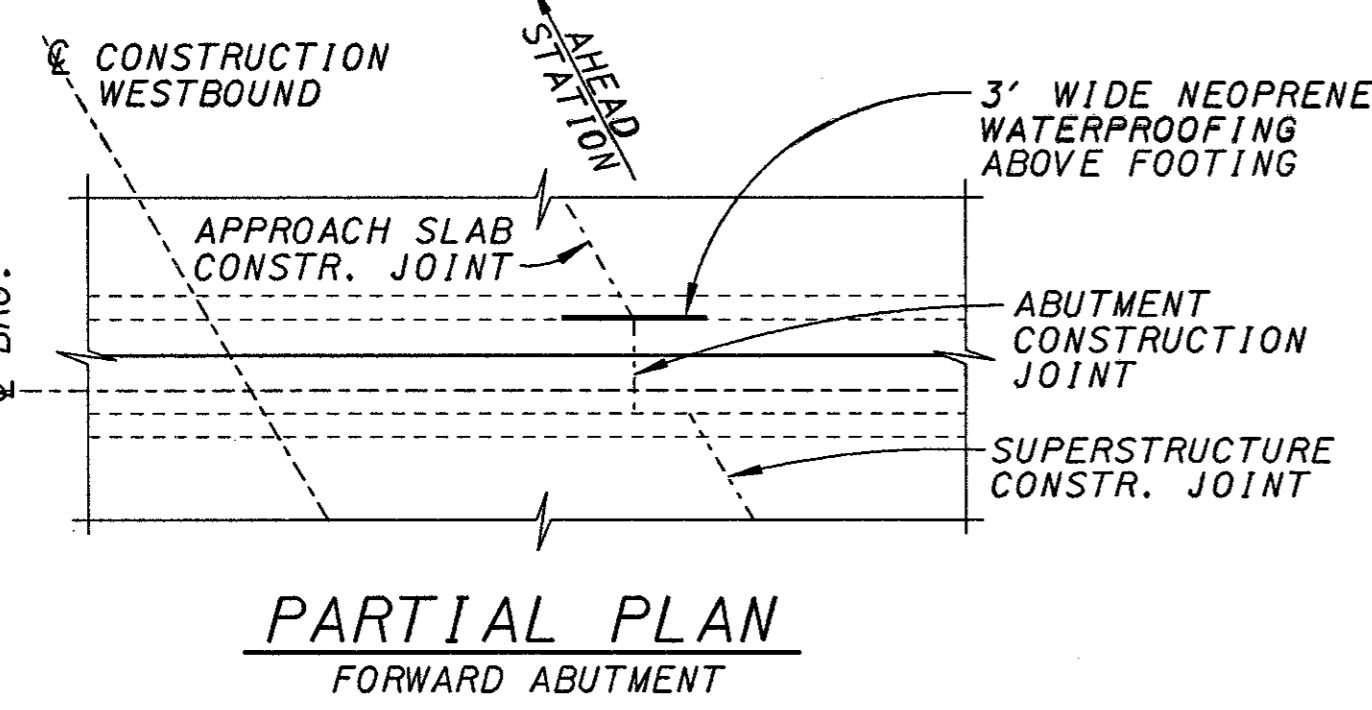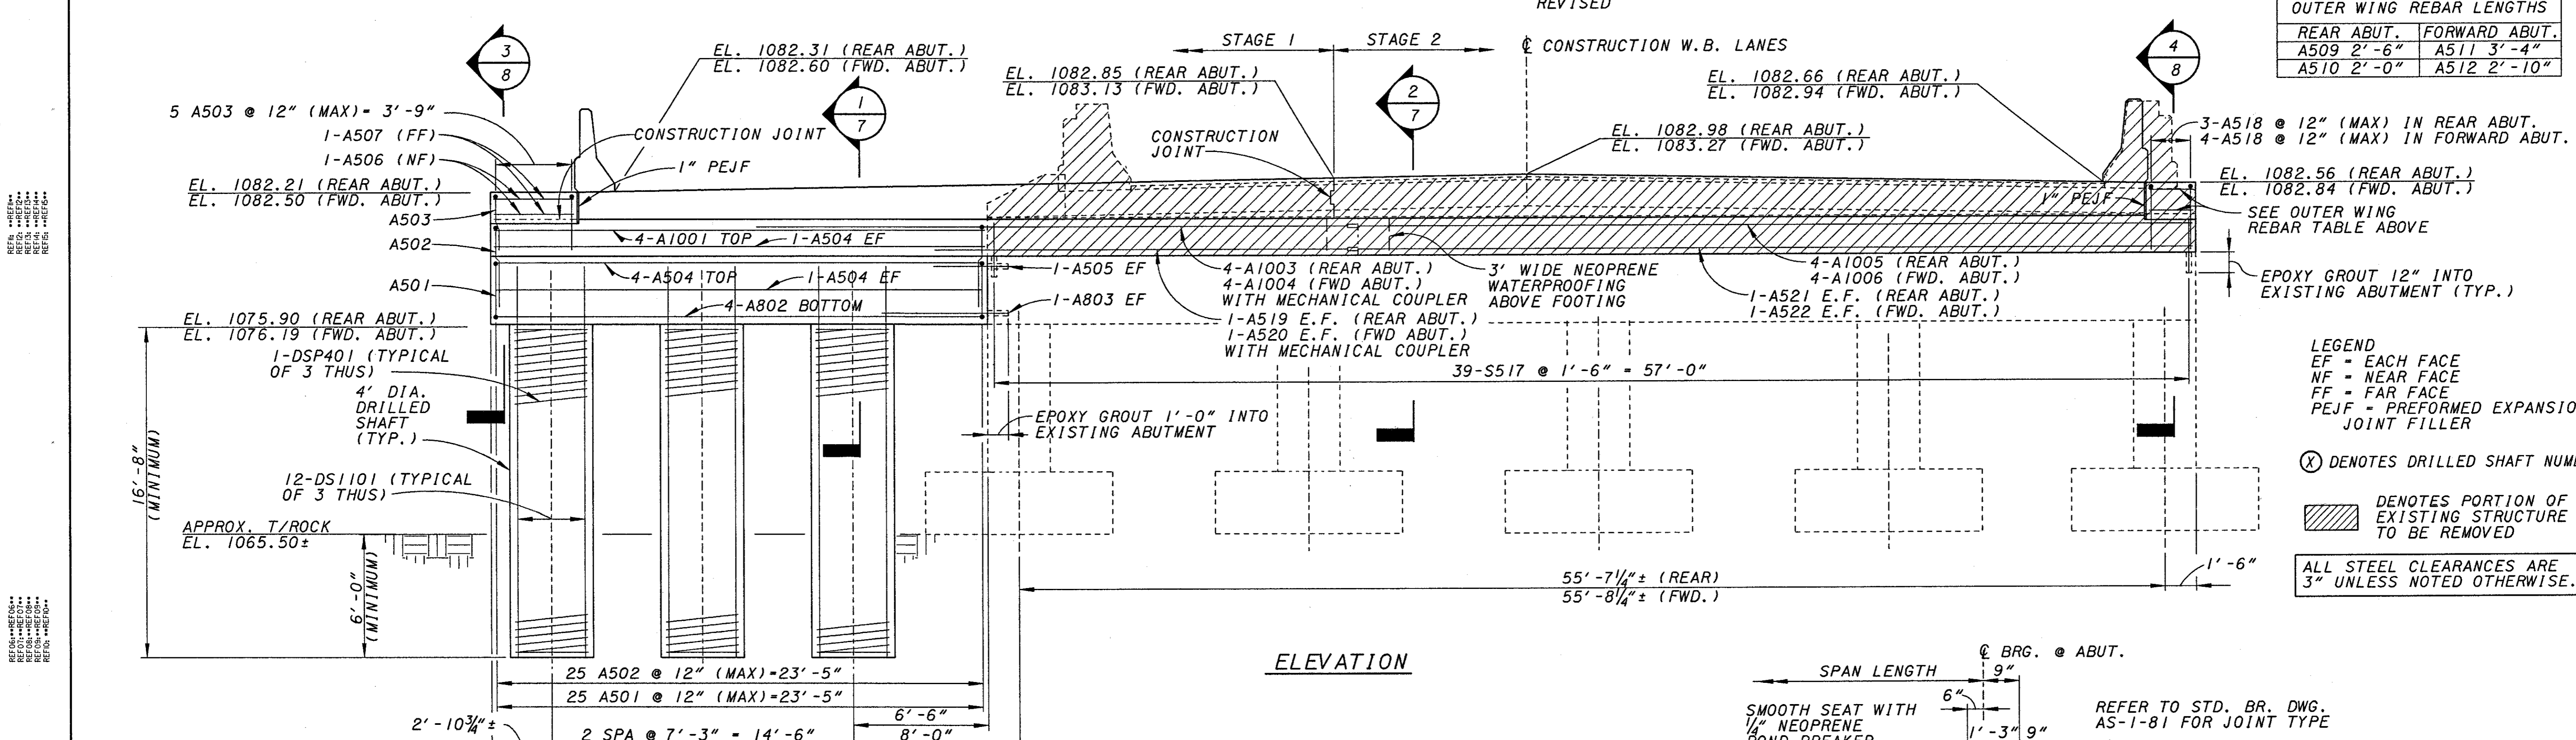


REF: A501-A509
REF: A510-A512
REF: A801-A802
REF: A803-A804
REF: A805-A806
REF: A807-A808
REF: A809-A810
REF: A811-A812
REF: A813-A814
REF: A815-A816
REF: A817-A818
REF: A819-A820
REF: A821-A822
REF: A823-A824
REF: A825-A826
REF: A827-A828
REF: A829-A830

REF: DS1101
REF: DS1102
REF: DS1103
REF: DS1104
REF: DS1105
REF: DS1106
REF: DS1107
REF: DS1108
REF: DS1109
REF: DS1110
REF: DS1111
REF: DS1112
REF: DS1113
REF: DS1114
REF: DS1115
REF: DS1116
REF: DS1117
REF: DS1118
REF: DS1119
REF: DS1120



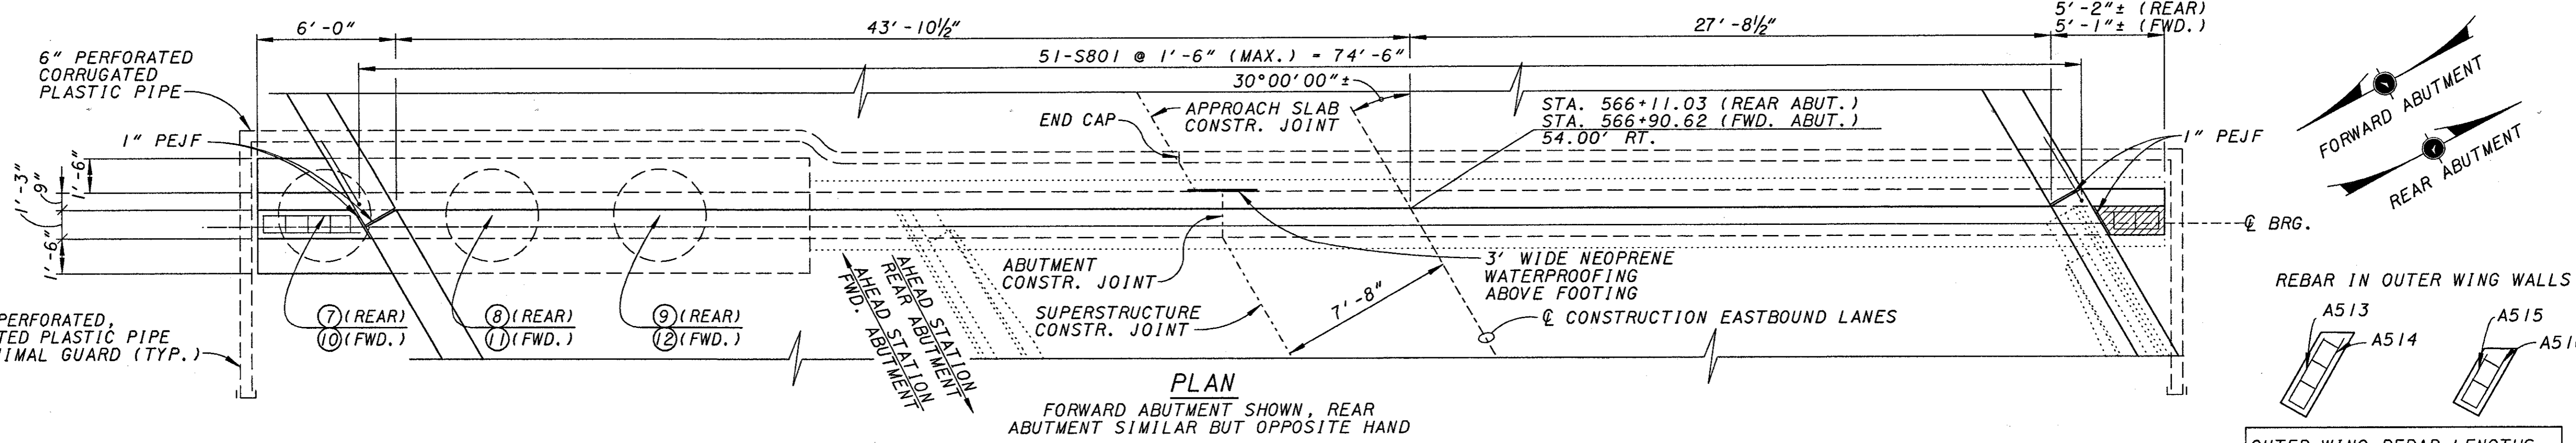


OUTER WING REBAR LENGTHS

REAR ABUT.	FORWARD ABUT.
A513 3'-1"	A515 2'-3"
A514 3'-6"	A516 2'-8"

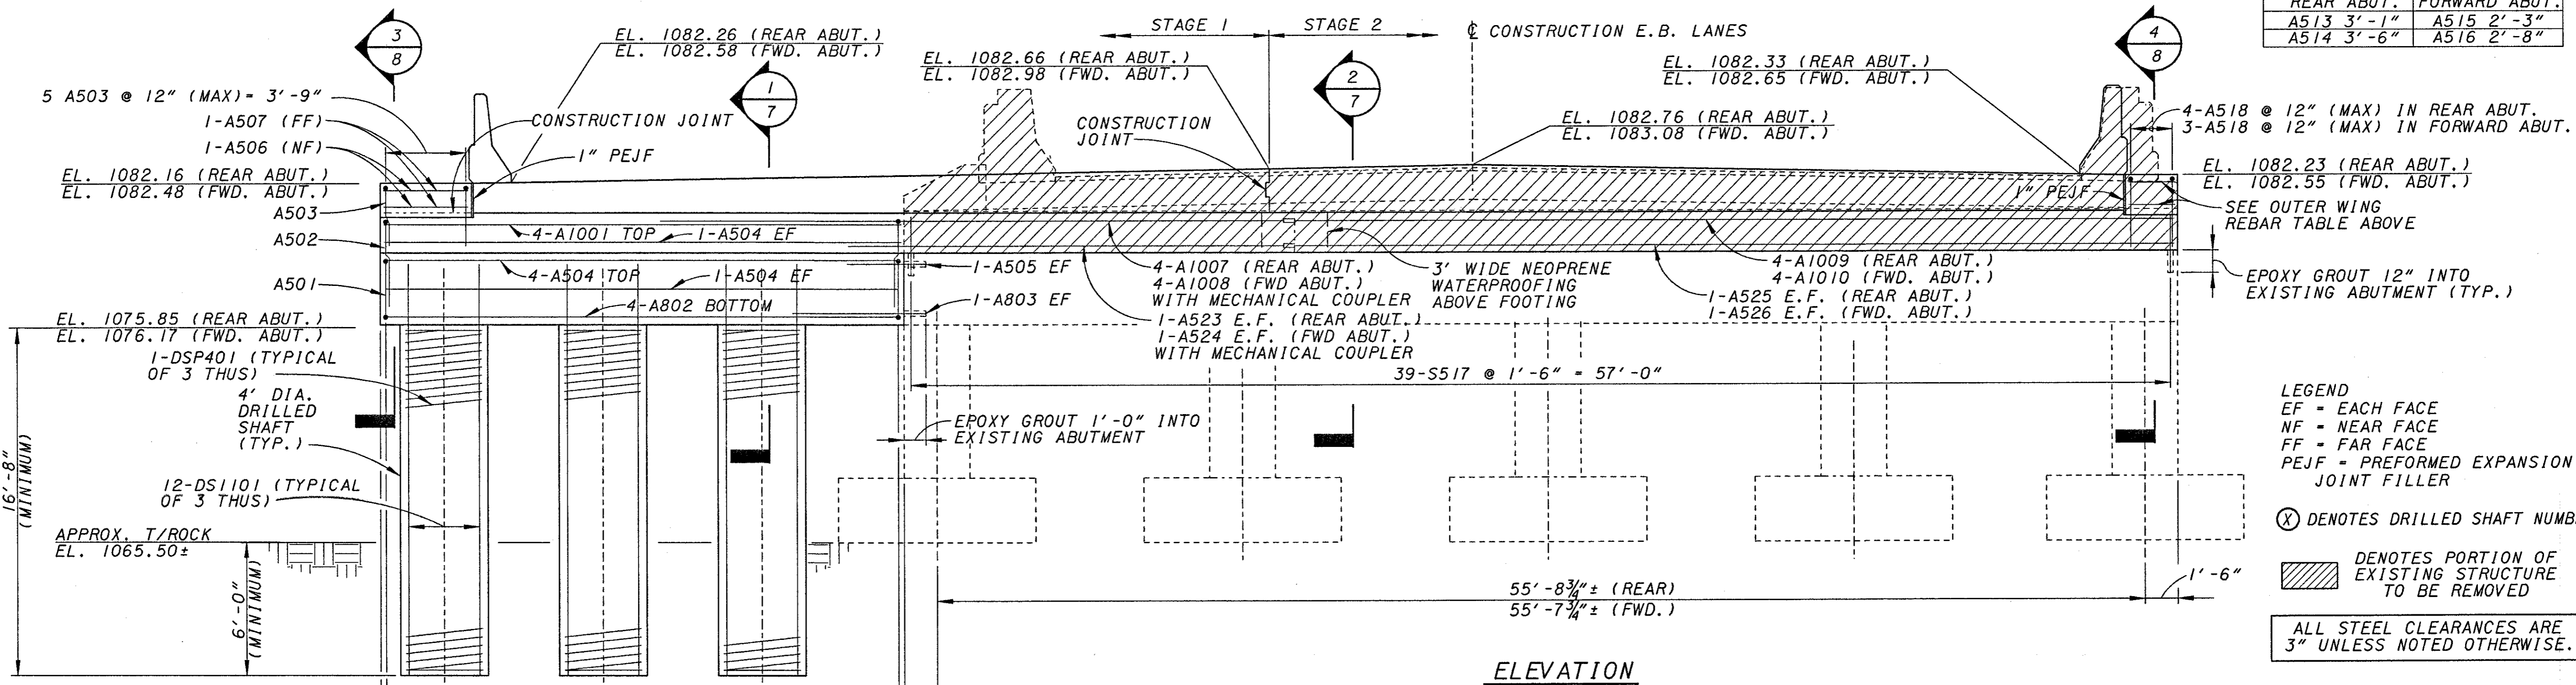

LEGEND
 EF = EACH FACE
 NF = NEAR FACE
 FF = FAR FACE
 PEJF = PREFORMED EXPANSION JOINT FILLER
 (X) DENOTES DRILLED SHAFT NUMBER
 [Hatched Area] DENOTES PORTION OF EXISTING STRUCTURE TO BE REMOVED
 ALL STEEL CLEARANCES ARE 3" UNLESS NOTED OTHERWISE.

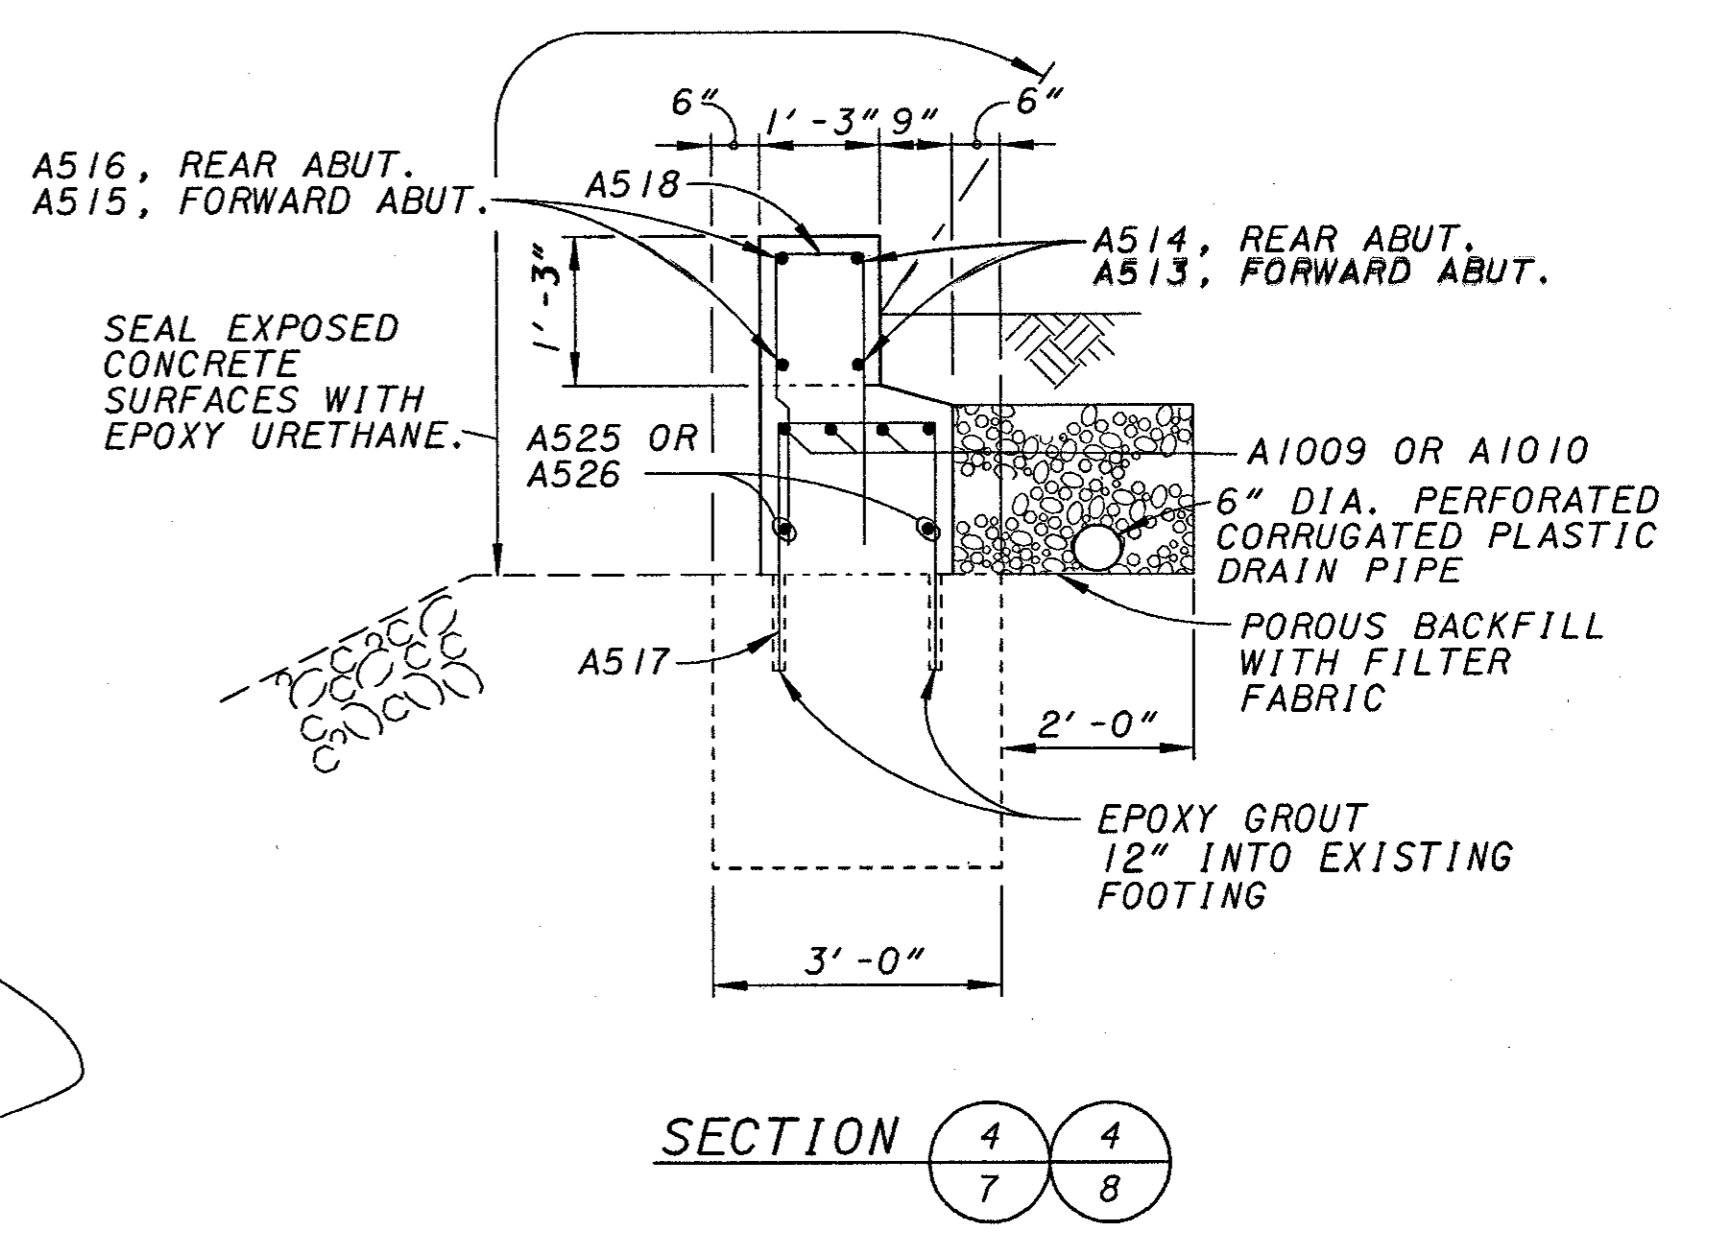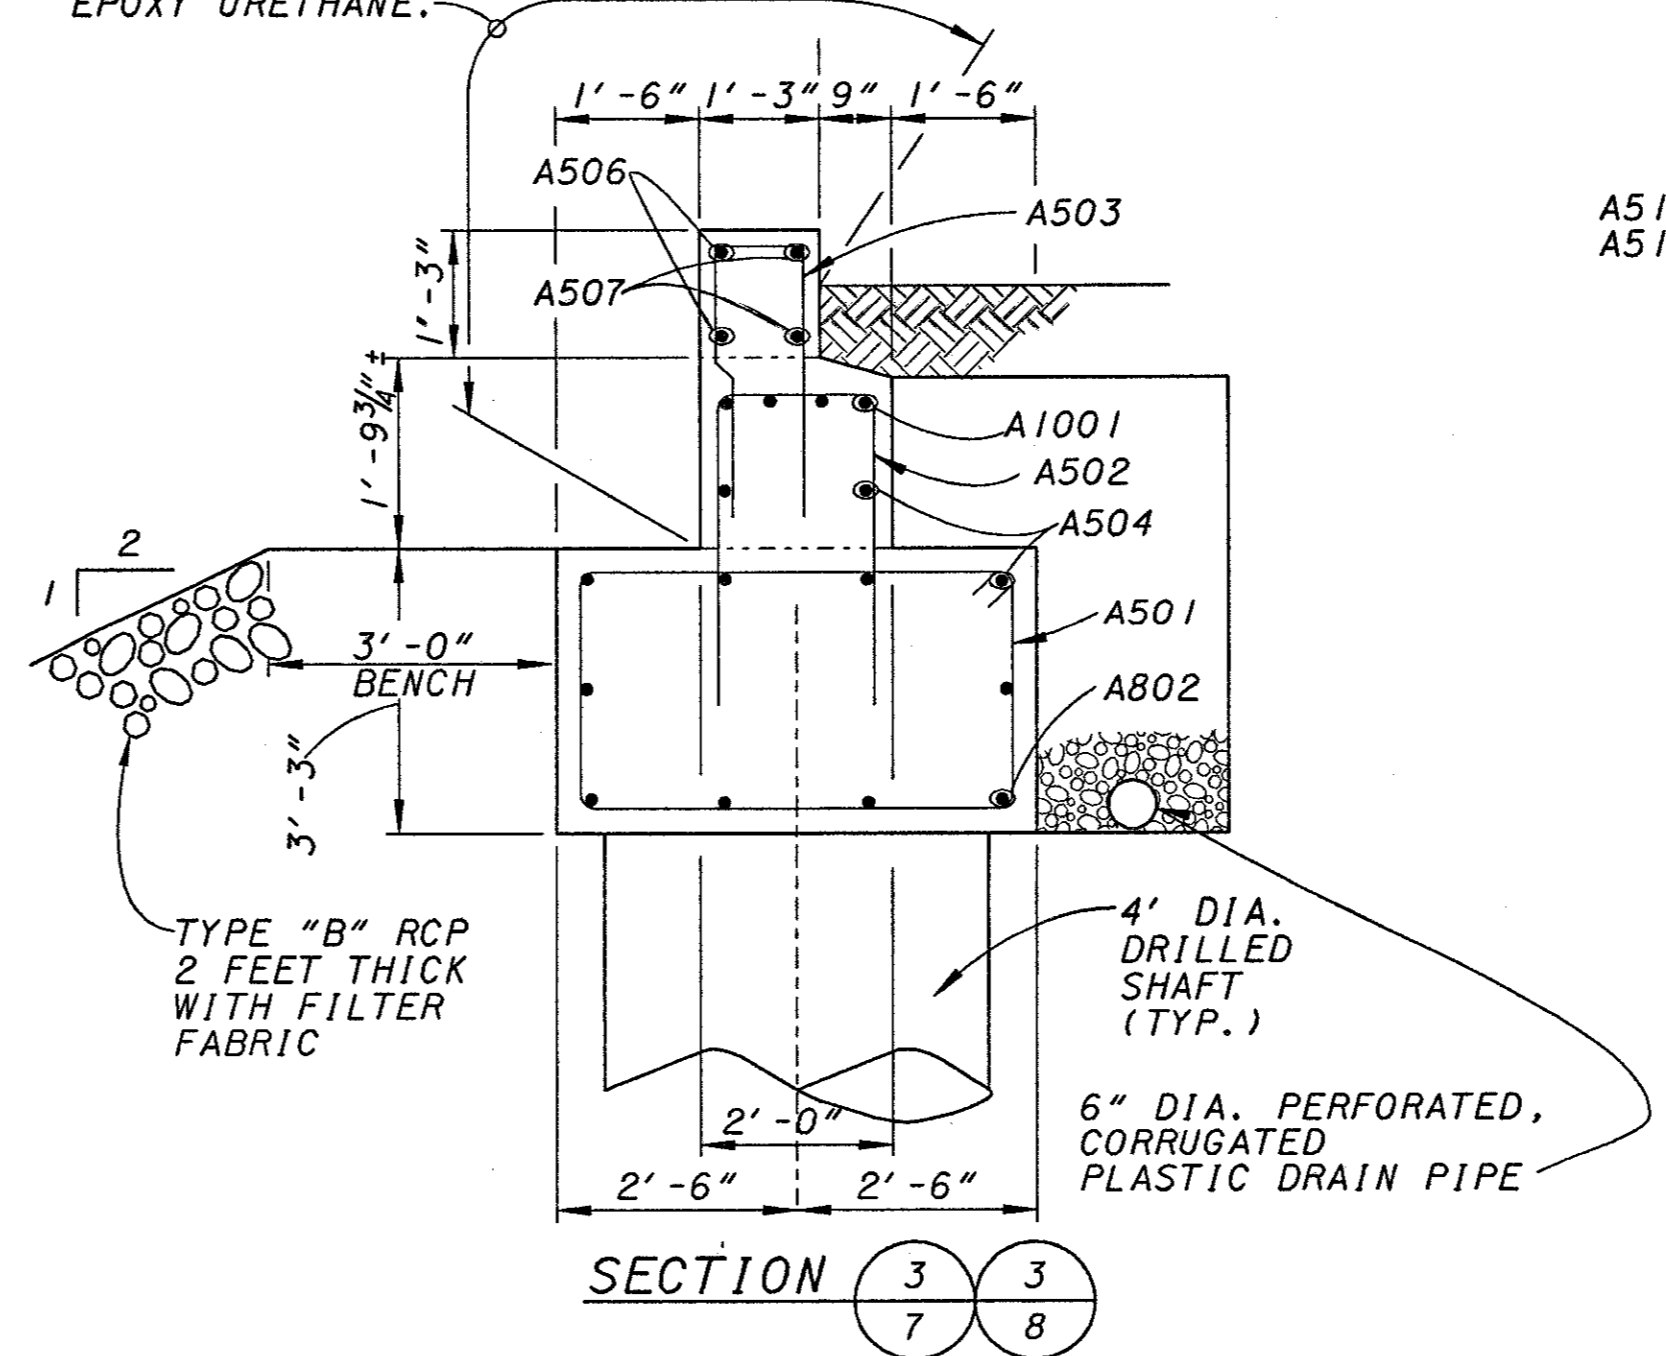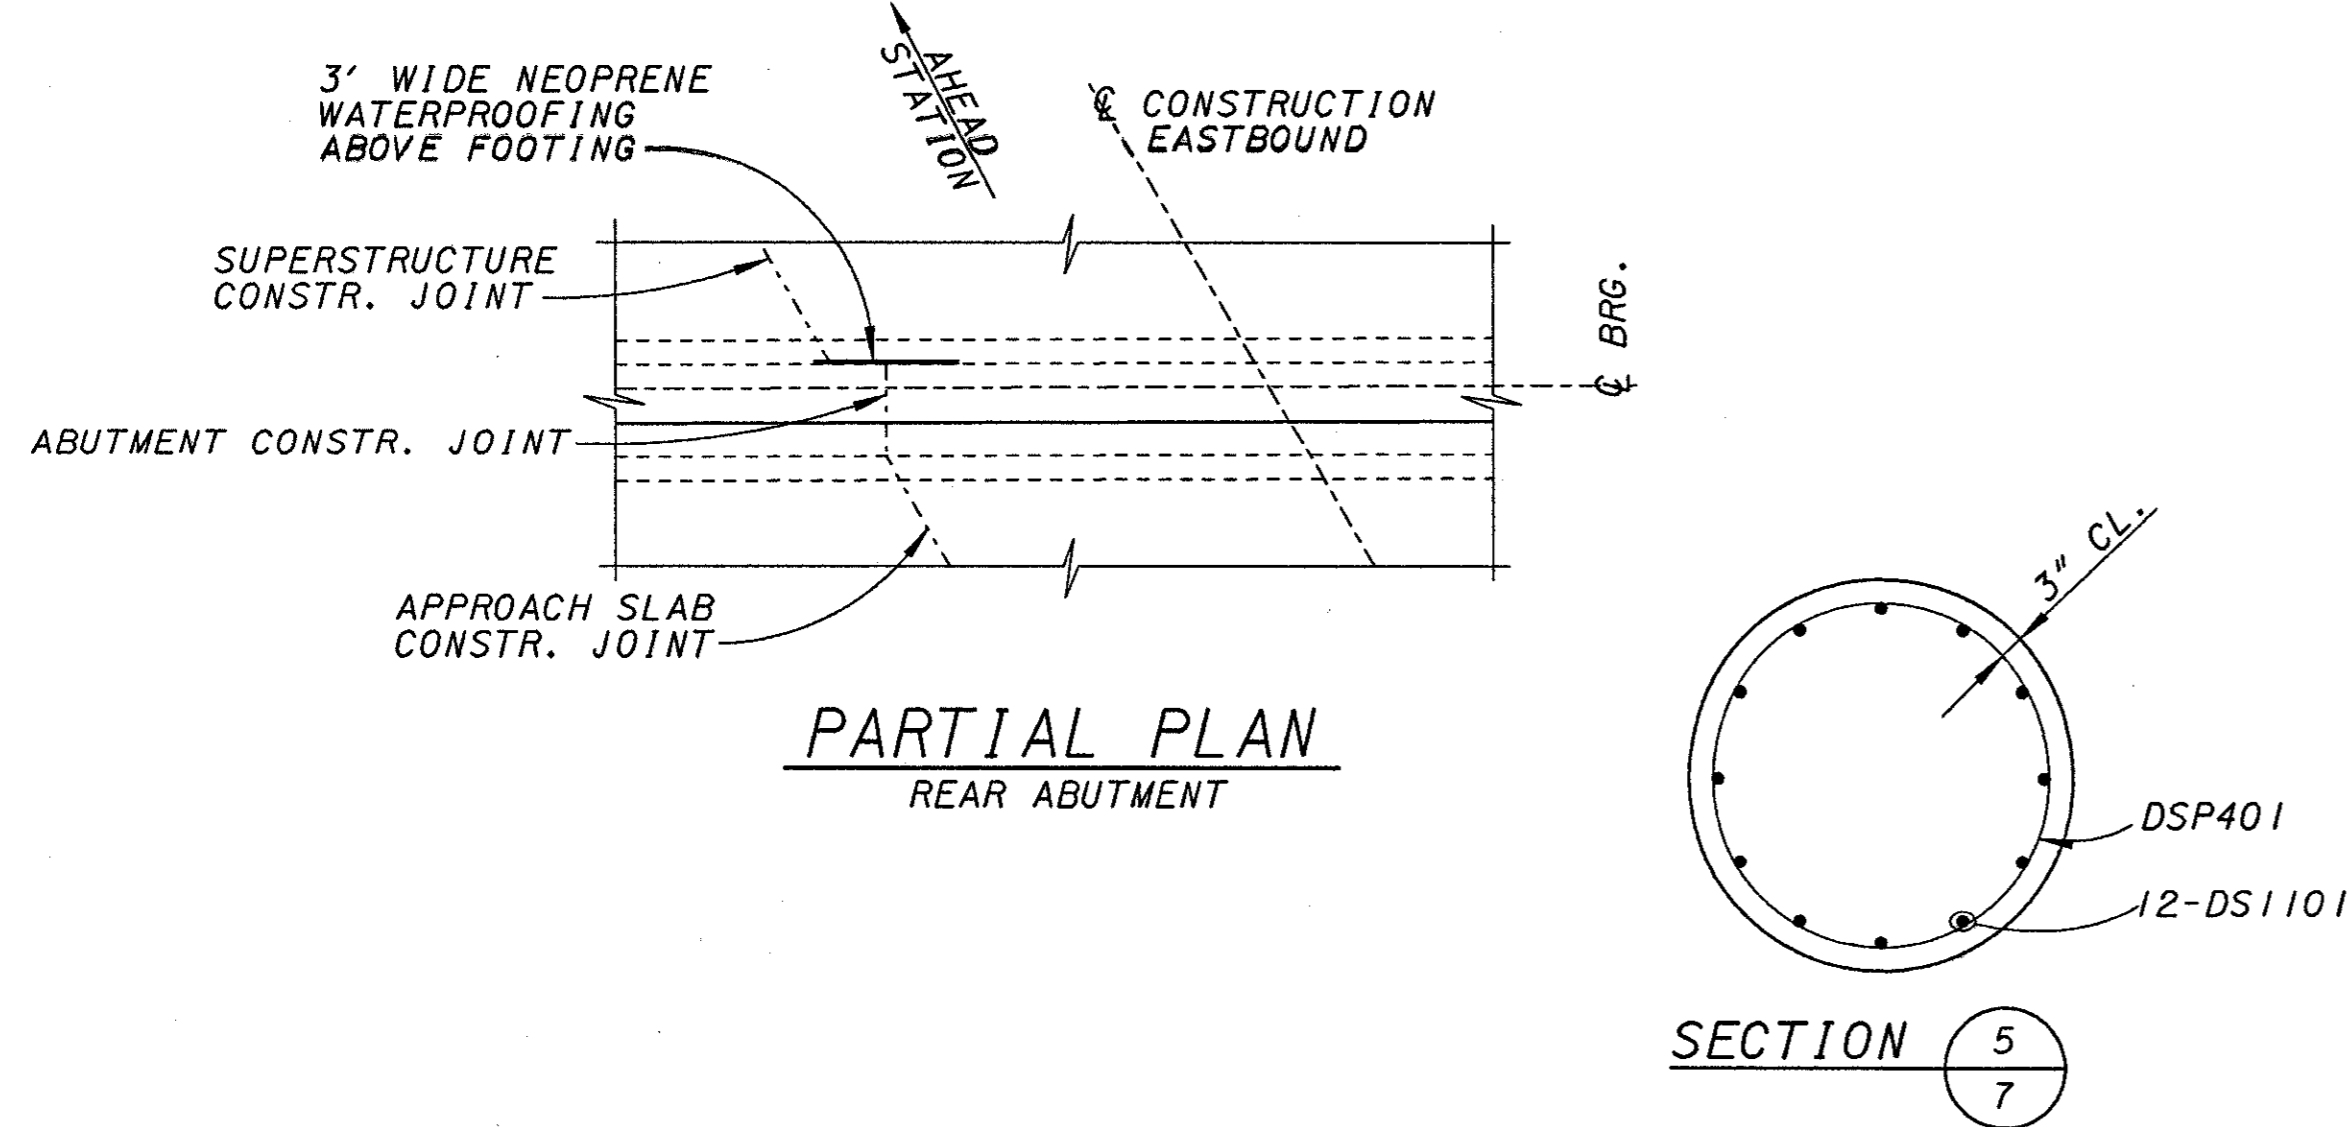




REF: **REF**
 REF: **REF**
REF: **REF**
 REF: **REF**
 REF: **REF**
 REF: **REF**

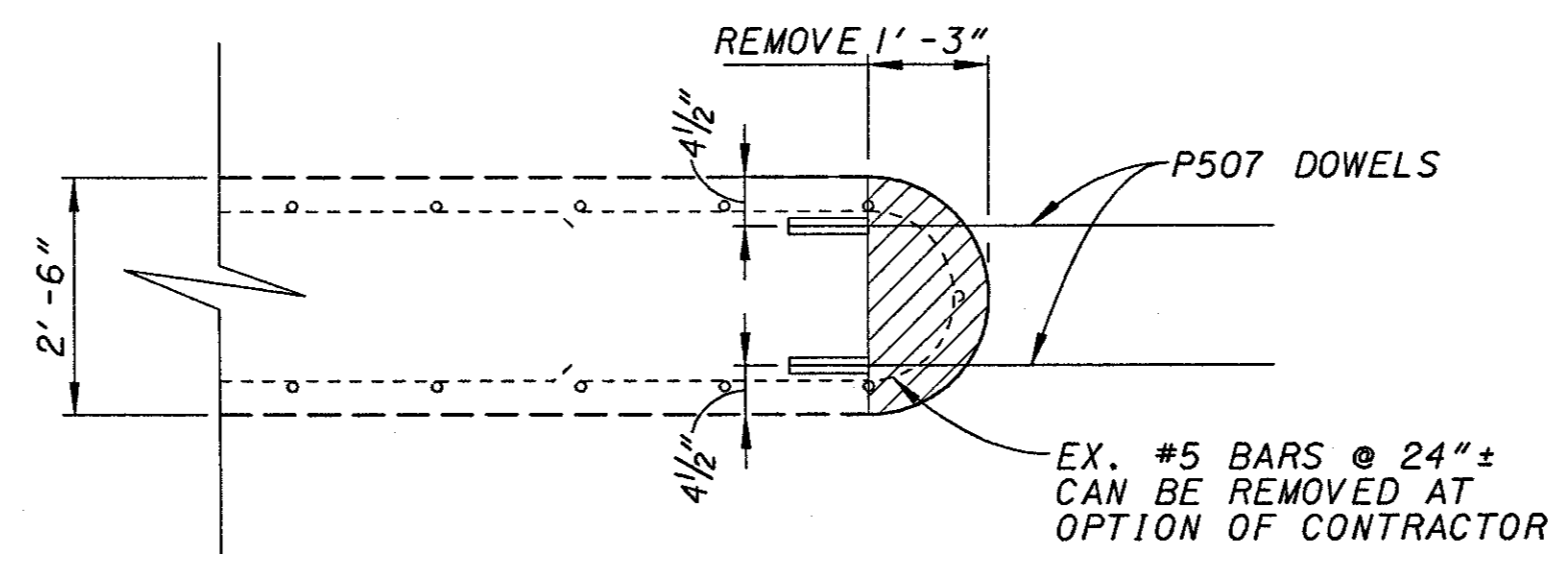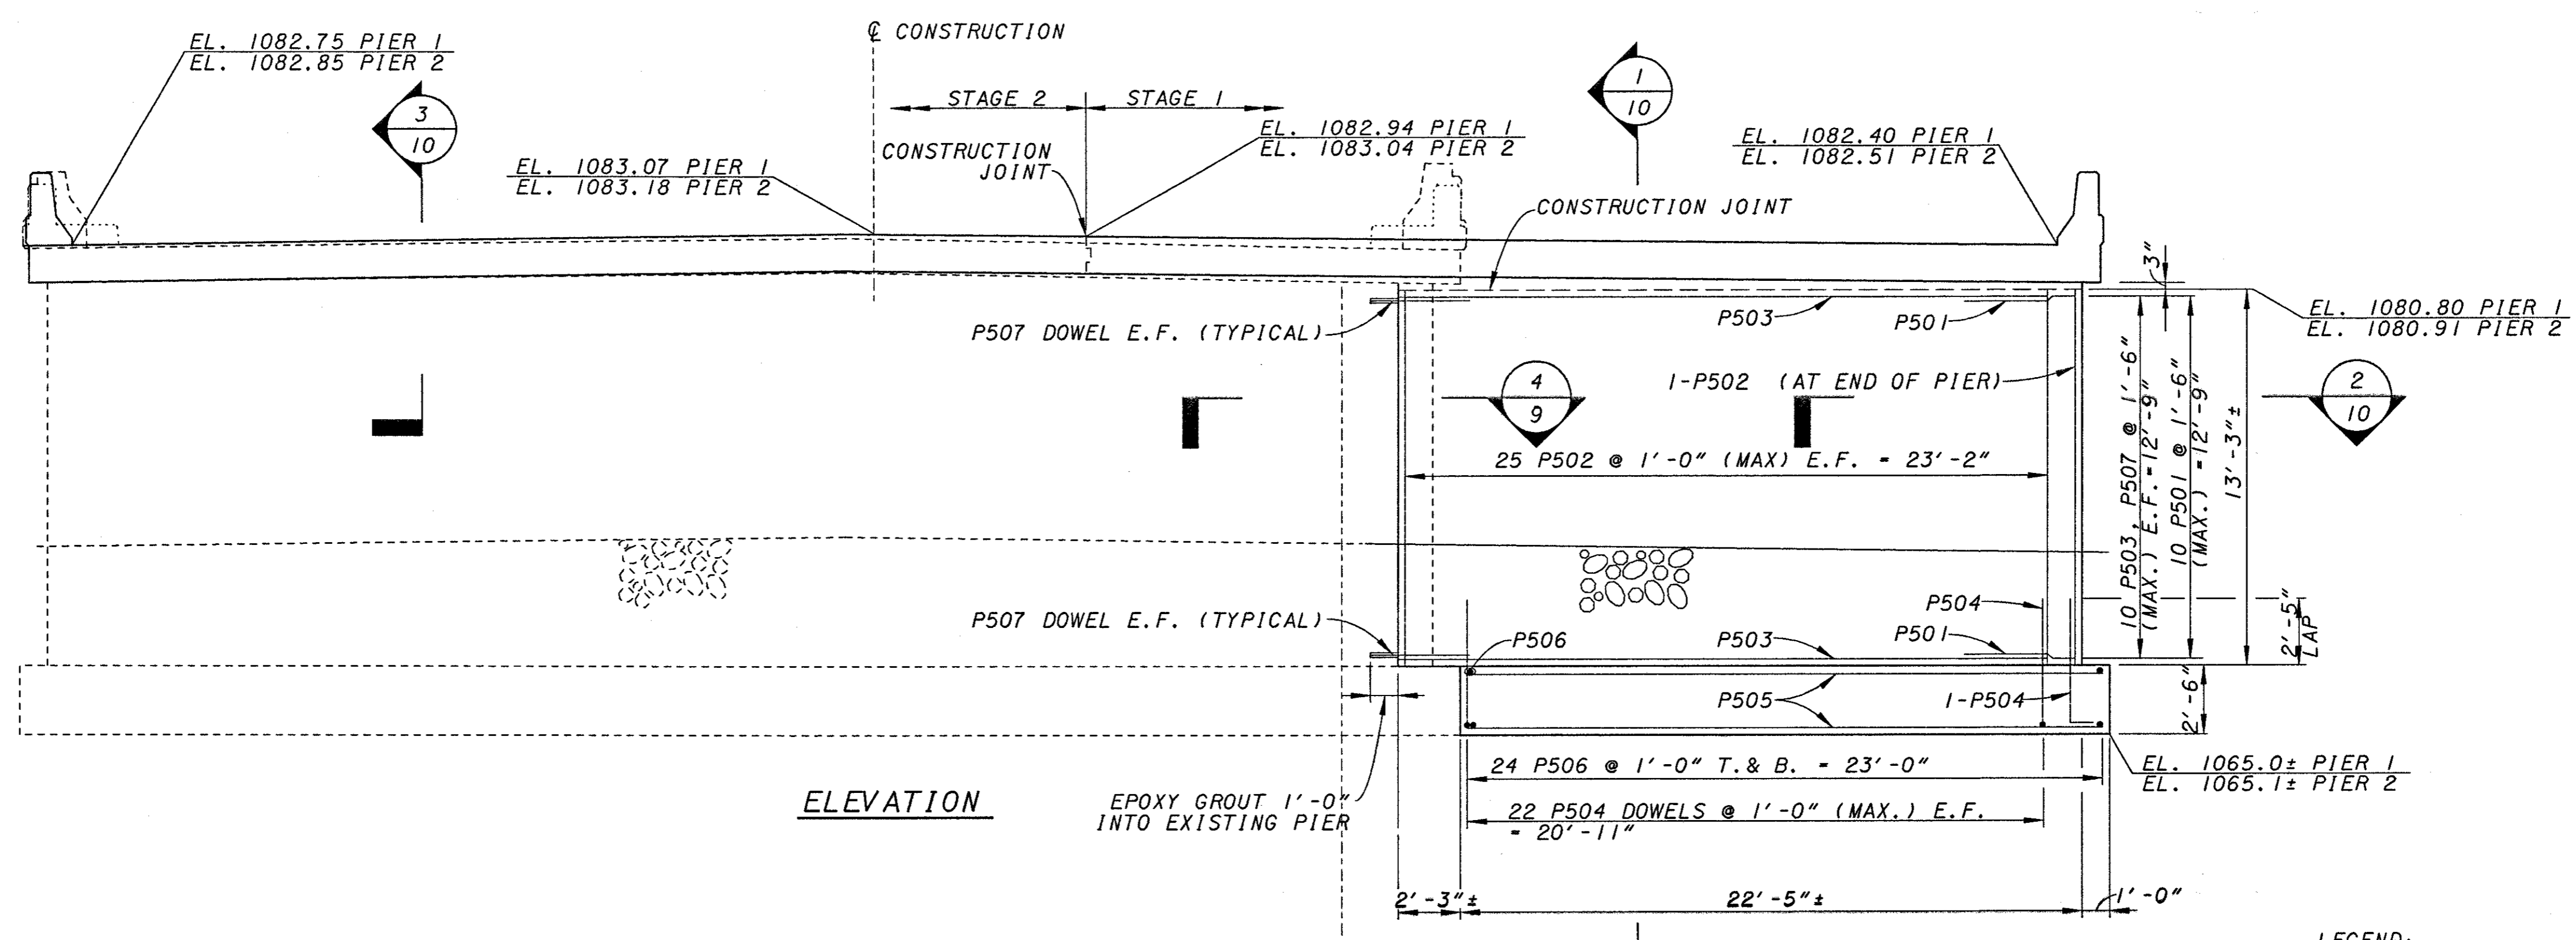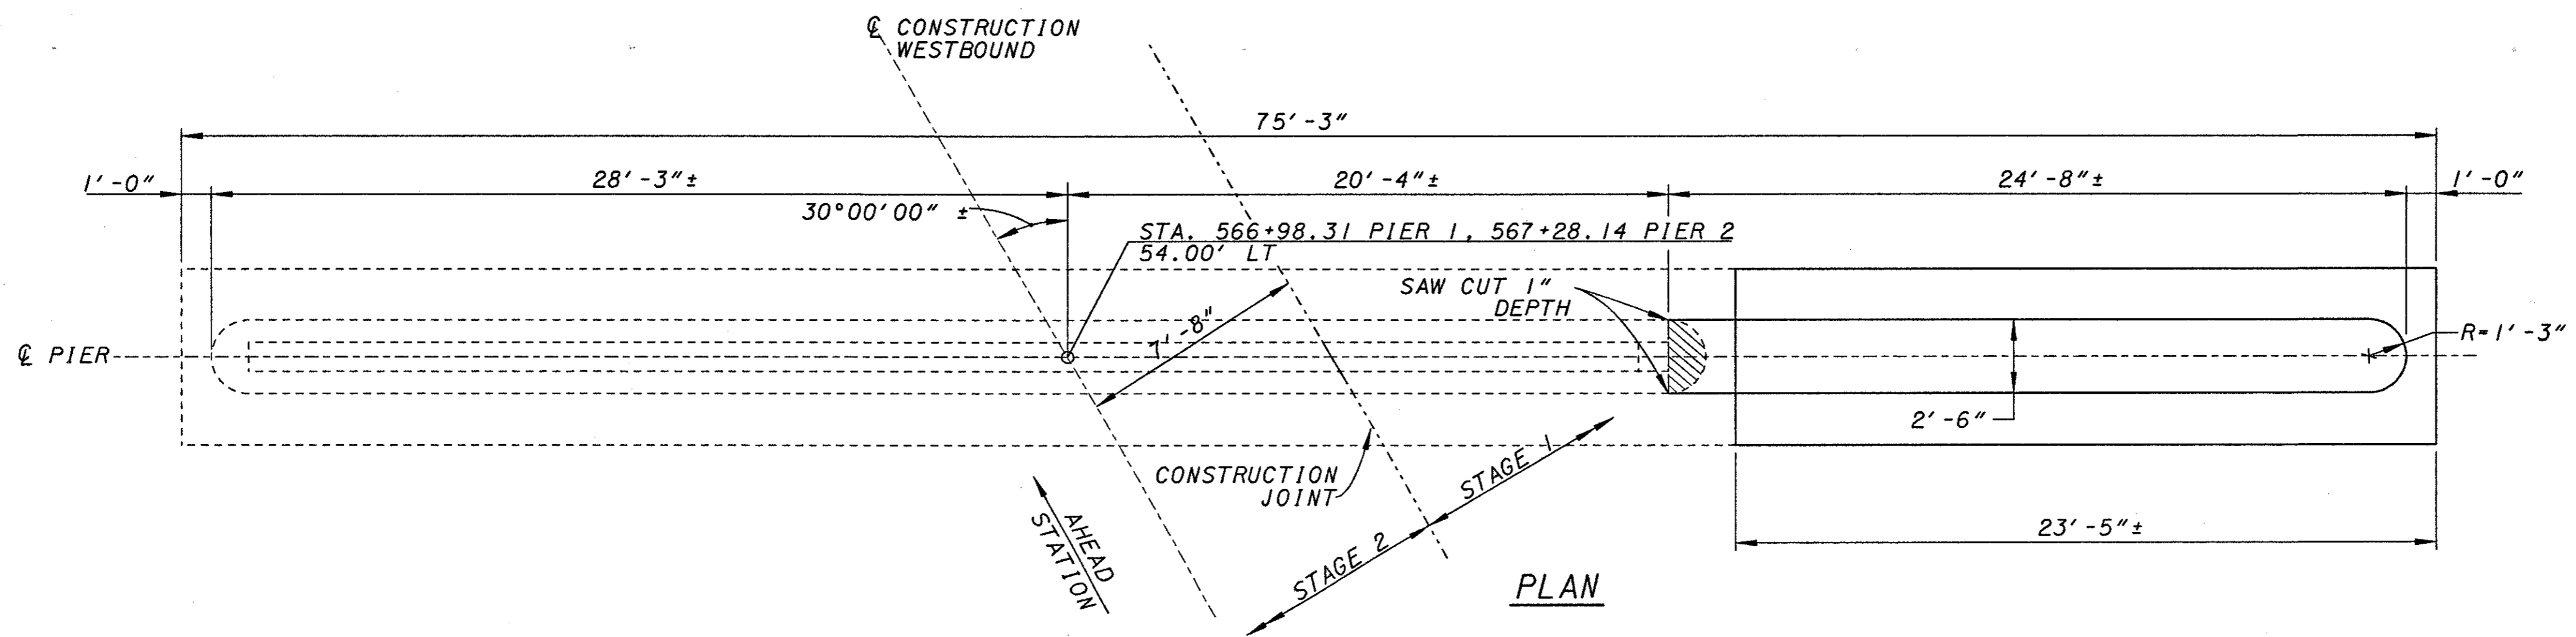

SECTION (PROPOSED) 4/9 4/10

LEGEND:
 E.F. = EACH FACE
 T. & B. = TOP AND BOTTOM

DENOTES REMOVAL LIMITS

ALL STEEL CLEARANCES ARE 3" UNLESS NOTED OTHERWISE

NOTE: FOOTINGS SHALL EXTEND A MINIMUM OF 3" INTO THE BOULDERY ZONE OR INTO THE UNDISTURBED ROCK OR TO THE ELEVATION SHOWN, WHICHEVER IS LOWER.






REF: AREF:***
 REF: AREF:***
 DESIGNED BY: J. J. GIBSON
 DRAWN BY: J. J. GIBSON
 CHECKED BY: J. J. GIBSON
 DATE: 08-02-00

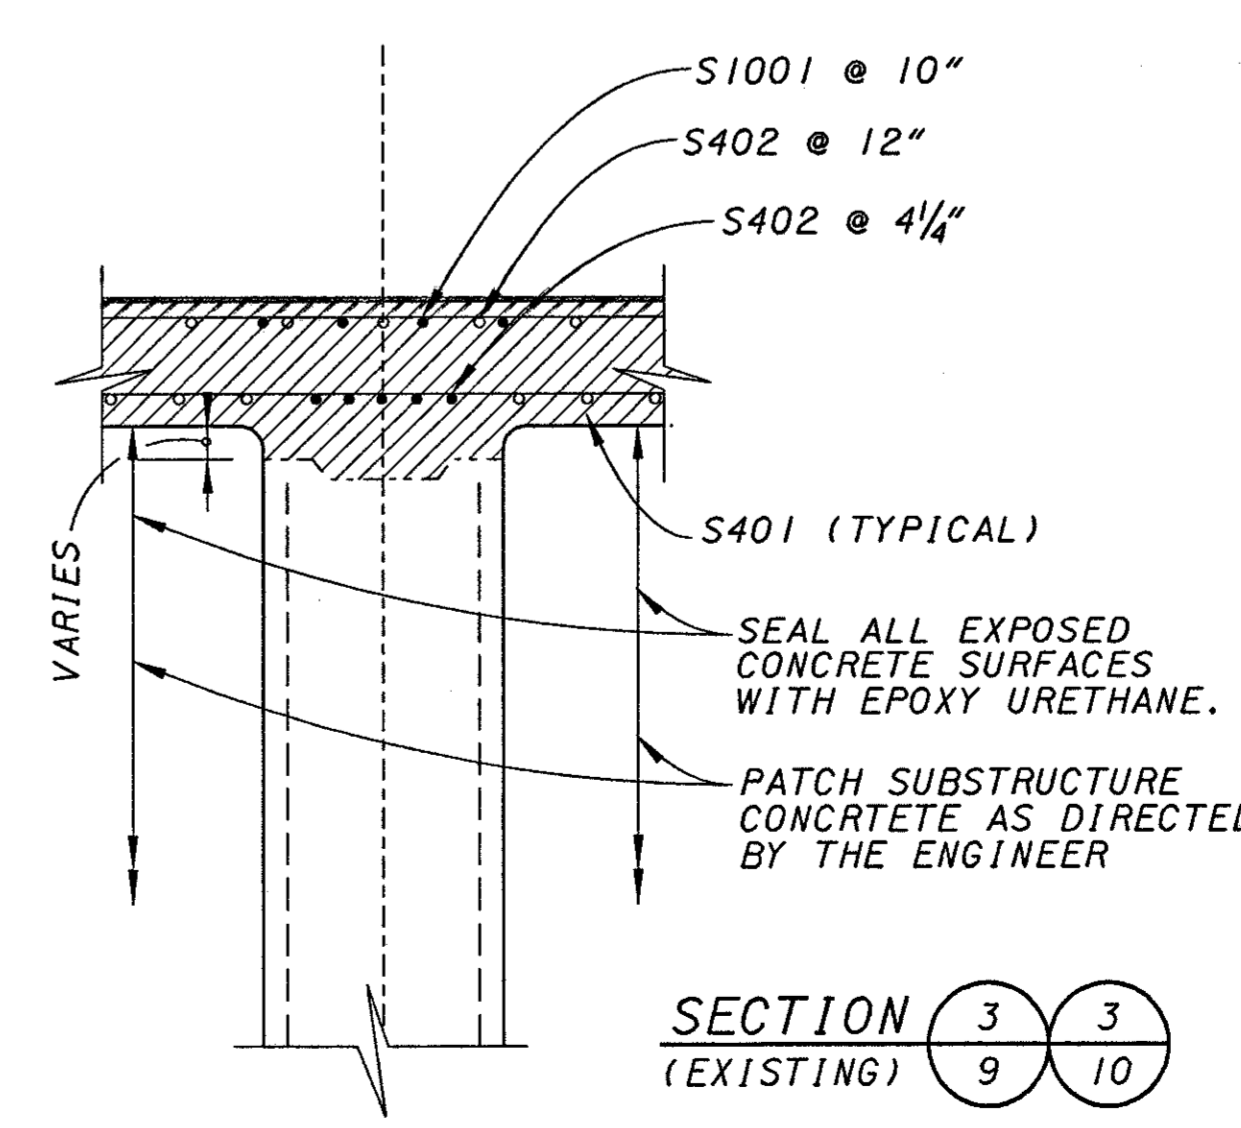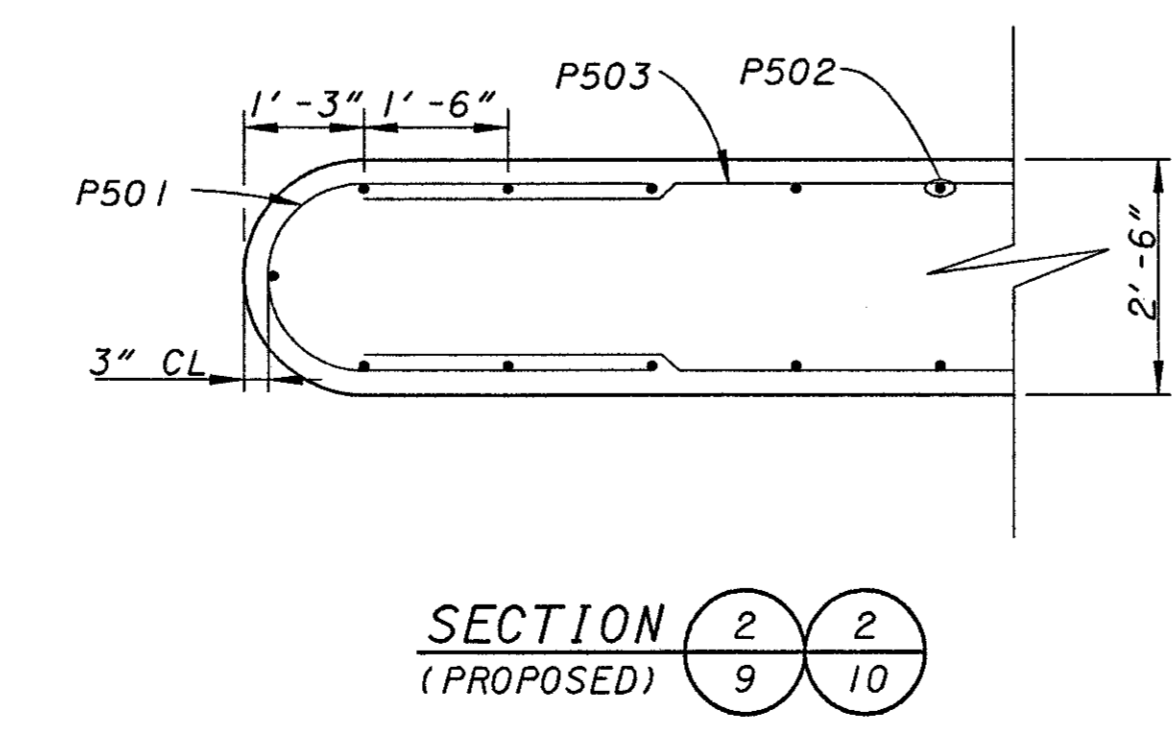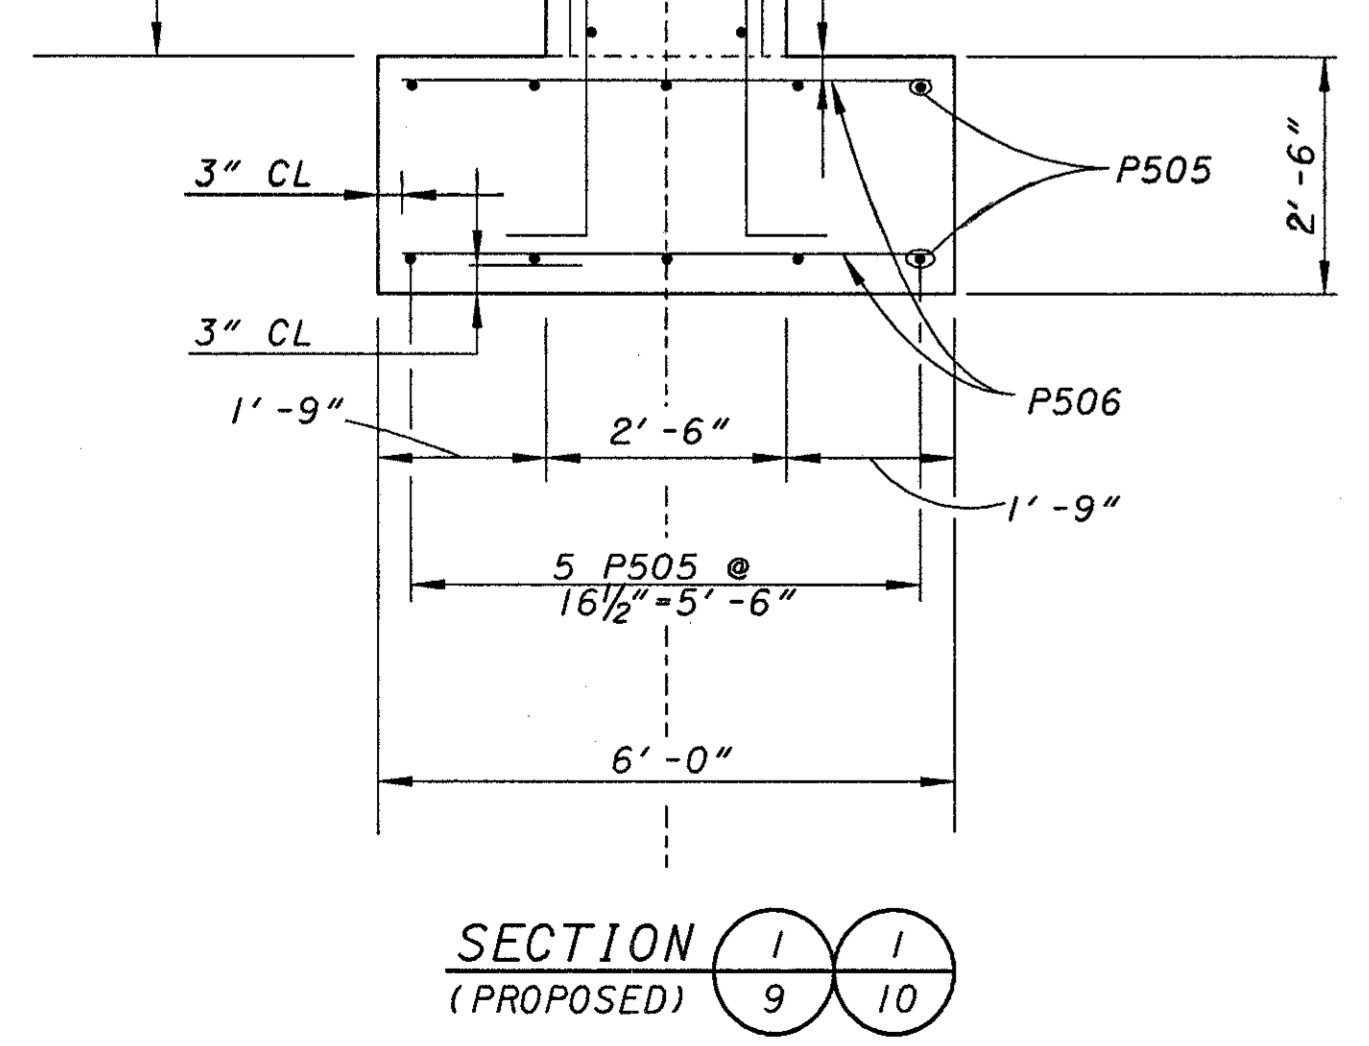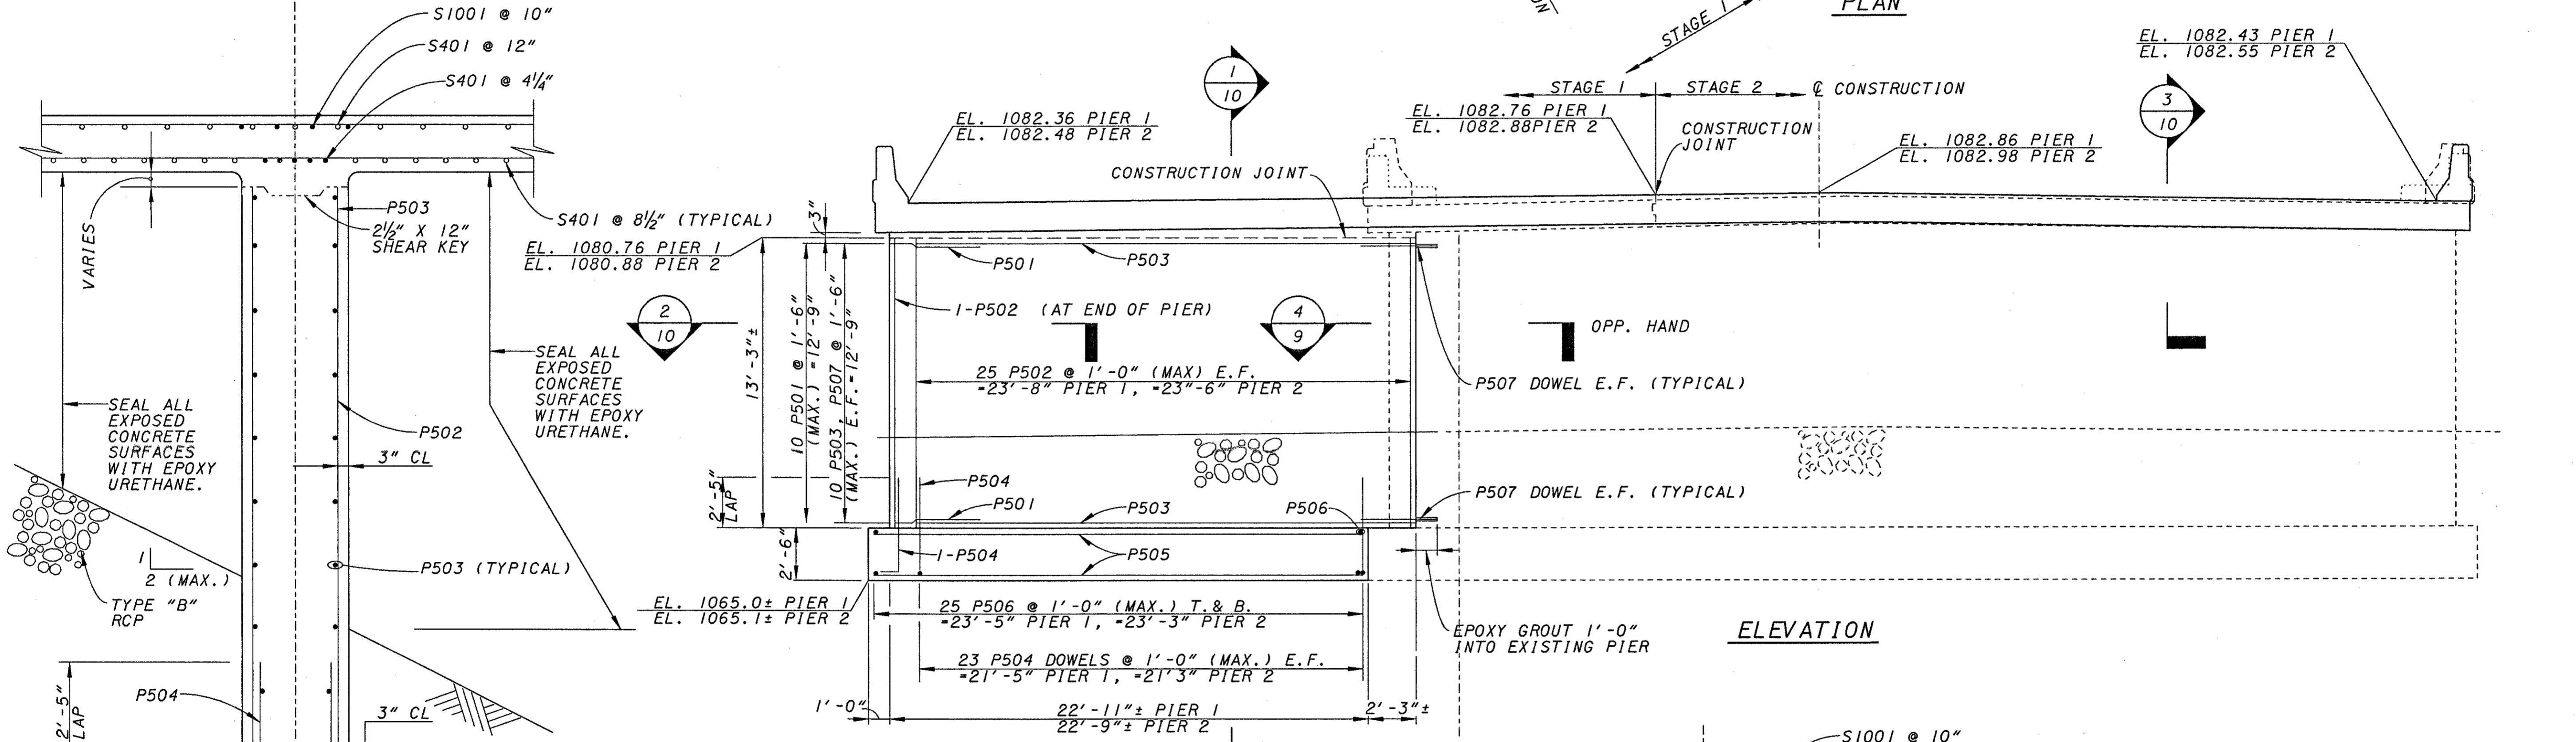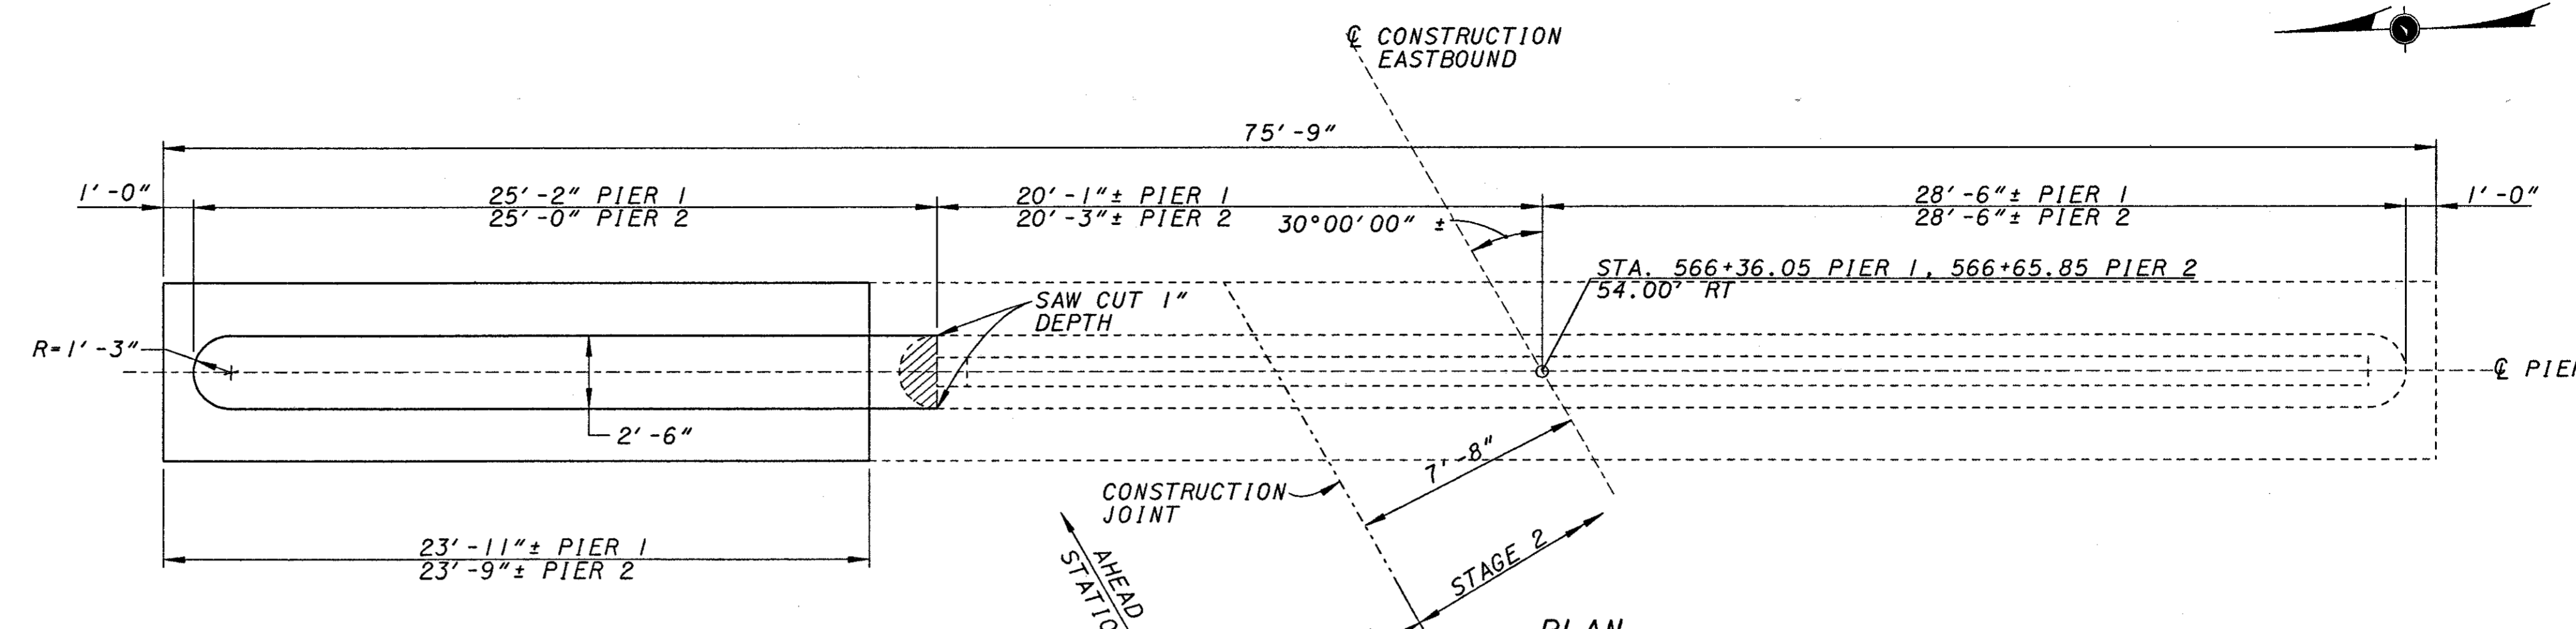

LEGEND:
 E.F. = EACH FACE
 T. & B. = TOP AND BOTTOM

DENOTES REMOVAL LIMITS

ALL STEEL CLEARANCES ARE 3" UNLESS NOTED OTHERWISE

NOTE: FOOTINGS SHALL EXTEND A MINIMUM OF 3" INTO THE BOULDERY ZONE OR INTO THE UNDISTURBED ROCK OR TO THE ELEVATION SHOWN, WHICHEVER IS LOWER.

DESIGN AGENCY
KZF DESIGN
 Engineering & Construction
 6801 145th Ave, Suite 100
 Edina, MN 55425
 TEL: 612-818-1111 FAX: 612-818-2888 WEB: www.kzf.com

DESIGNED	SJA	CHECKED	WBS
DRAWN	JDG	REVISED	
REVIEWED	DGK	STRUCTURE FILE NUMBER	6801145/6801234
DATE	08-02-00		

KZF #12

PIER DETAILS - RIGHT BRIDGE
 BRIDGE NO. PRE-70-1072 L/R
 I.R. TO OVER GOOSE RUN

PRE-70-0.00

10/17

177
283


REF: **REF1**
REF: **REF2**
REF: **REF3**
REF: **REF4**
REF: **REF5**

REF: **REF6**
REF: **REF7**
REF: **REF8**
REF: **REF9**
REF: **REF10**

REF: **REF11**
REF: **REF12**
REF: **REF13**
REF: **REF14**
REF: **REF15**


REF: **REF16**
REF: **REF17**
REF: **REF18**
REF: **REF19**
REF: **REF20**

DATE: **DATE**
USER: **USER**
PROJECT: **PROJECT**
DRAWING: **DRAWING**
ACTIVE LEVELS: **ACTIVE LEVELS**

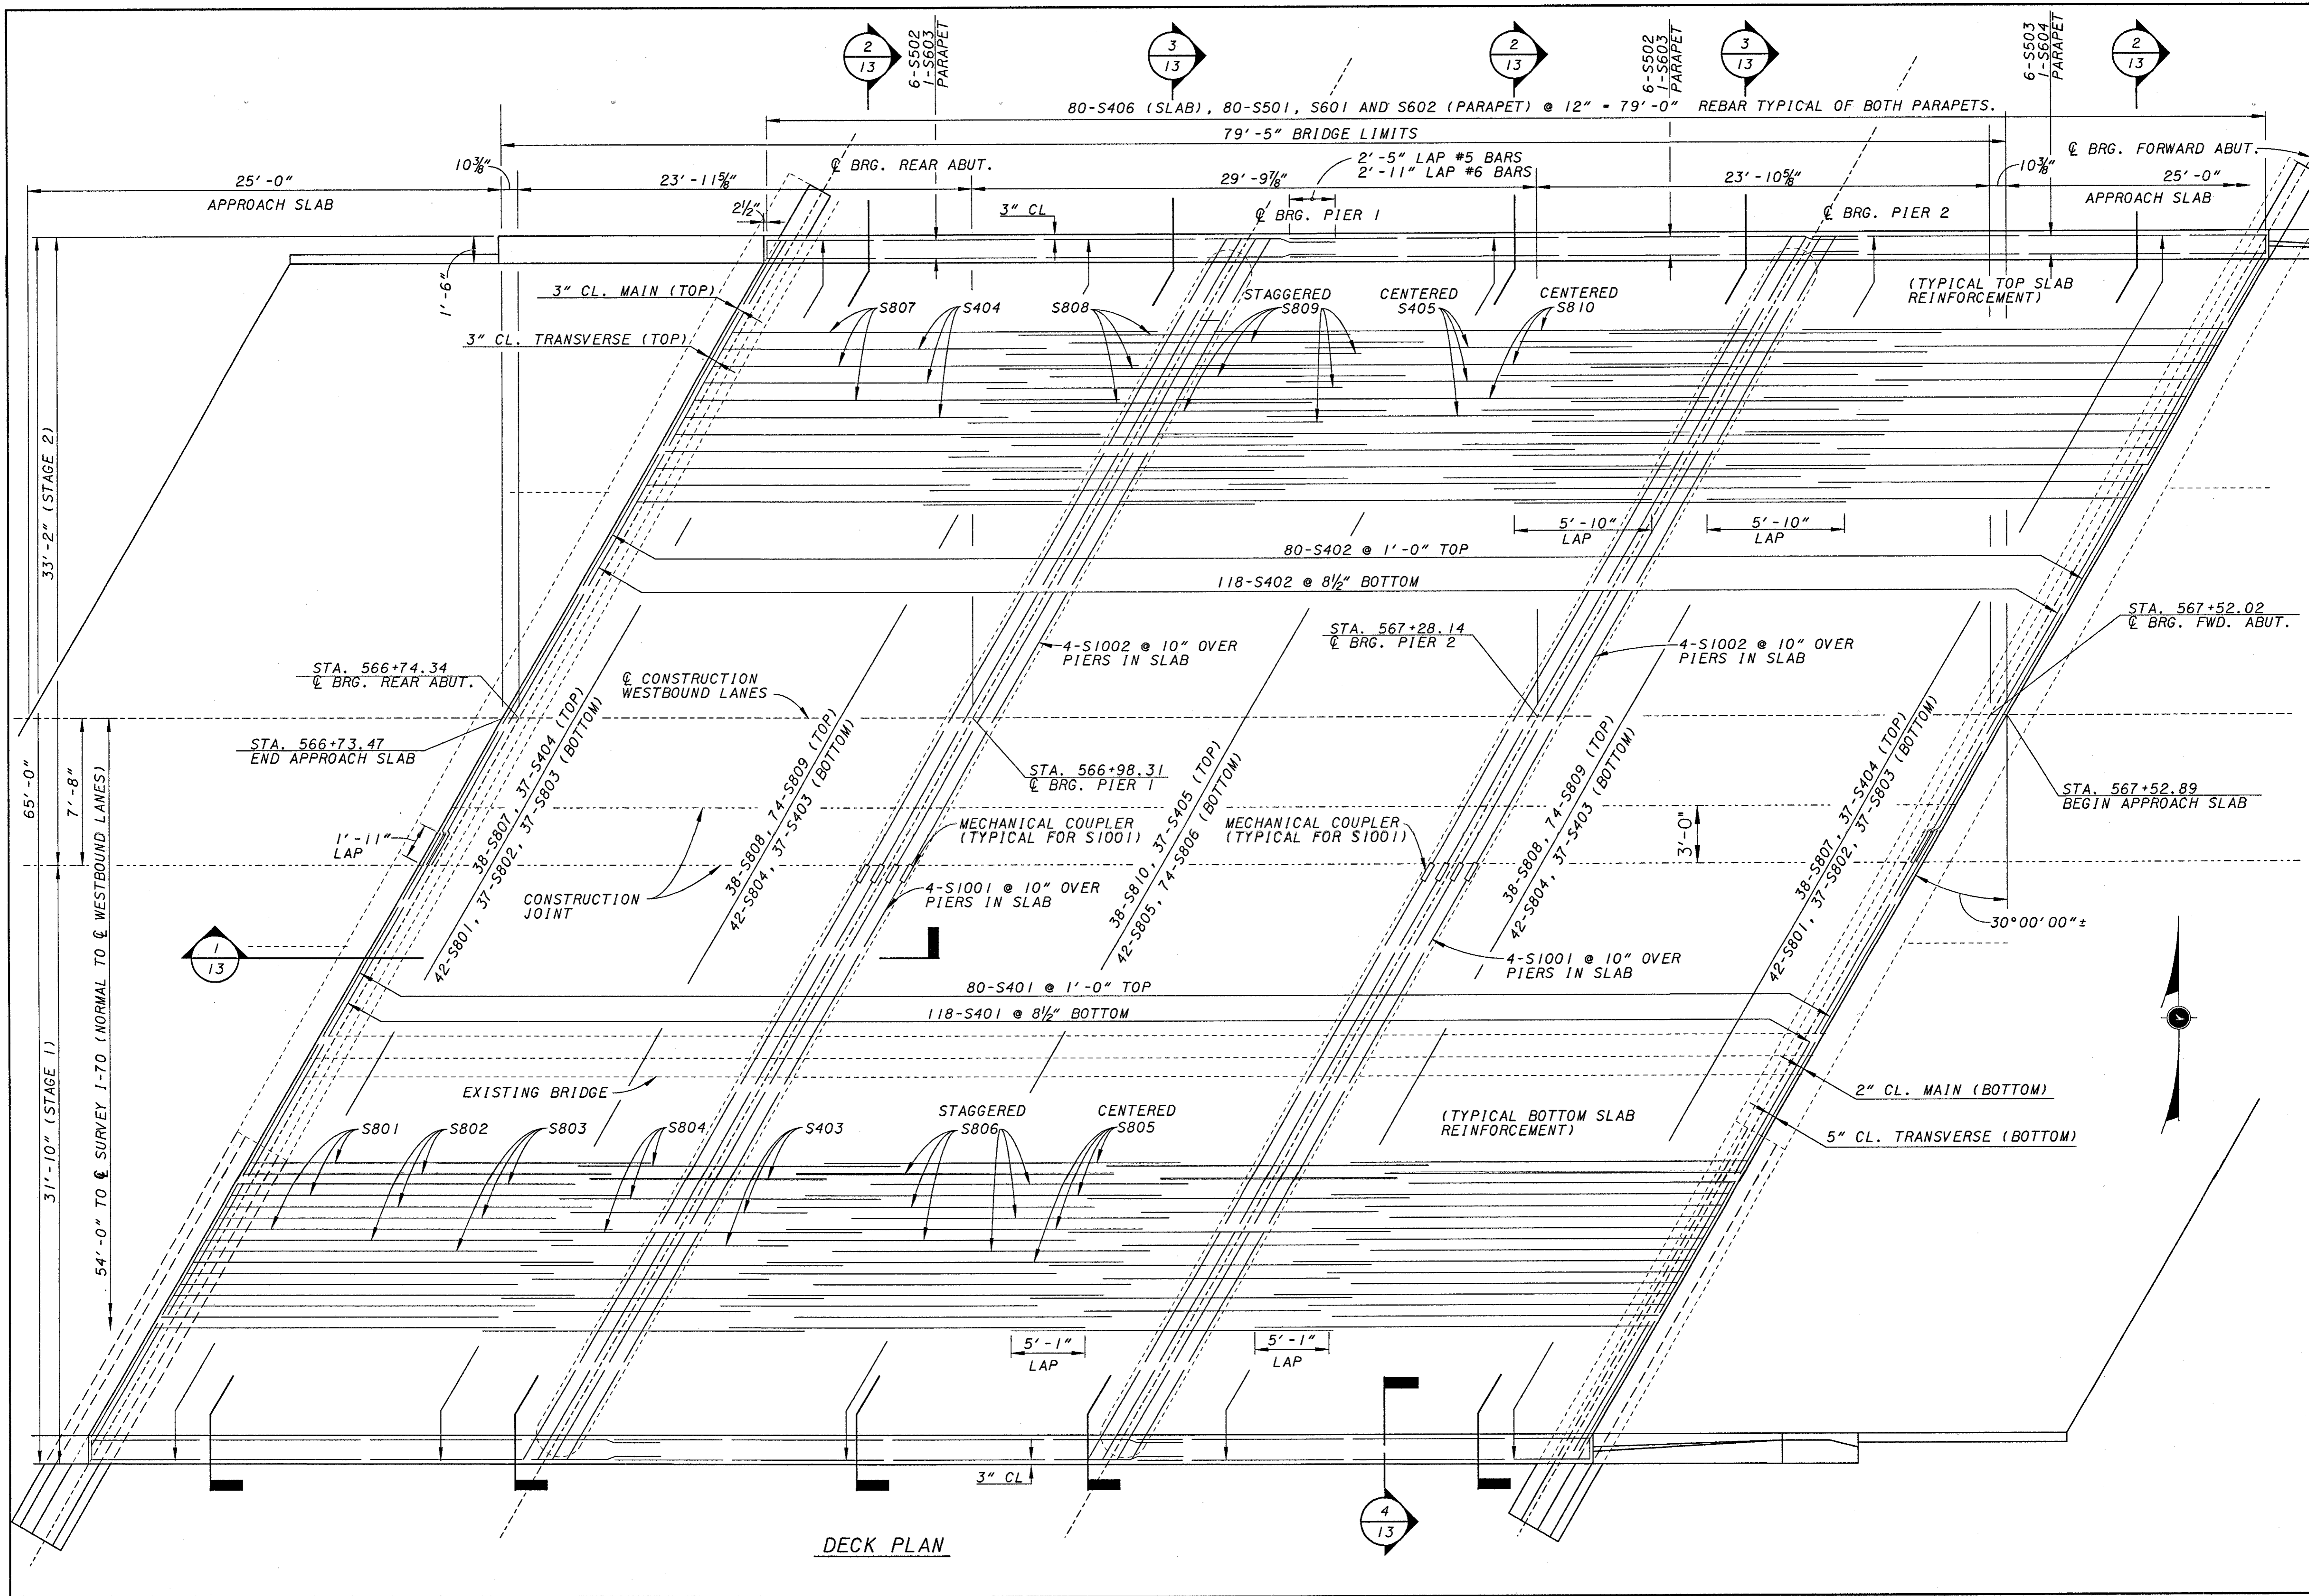

DECK PLAN

REVISIONS:
 NO. DATE BY
 1 08-02-00 JVG
 2 08-02-00 JVG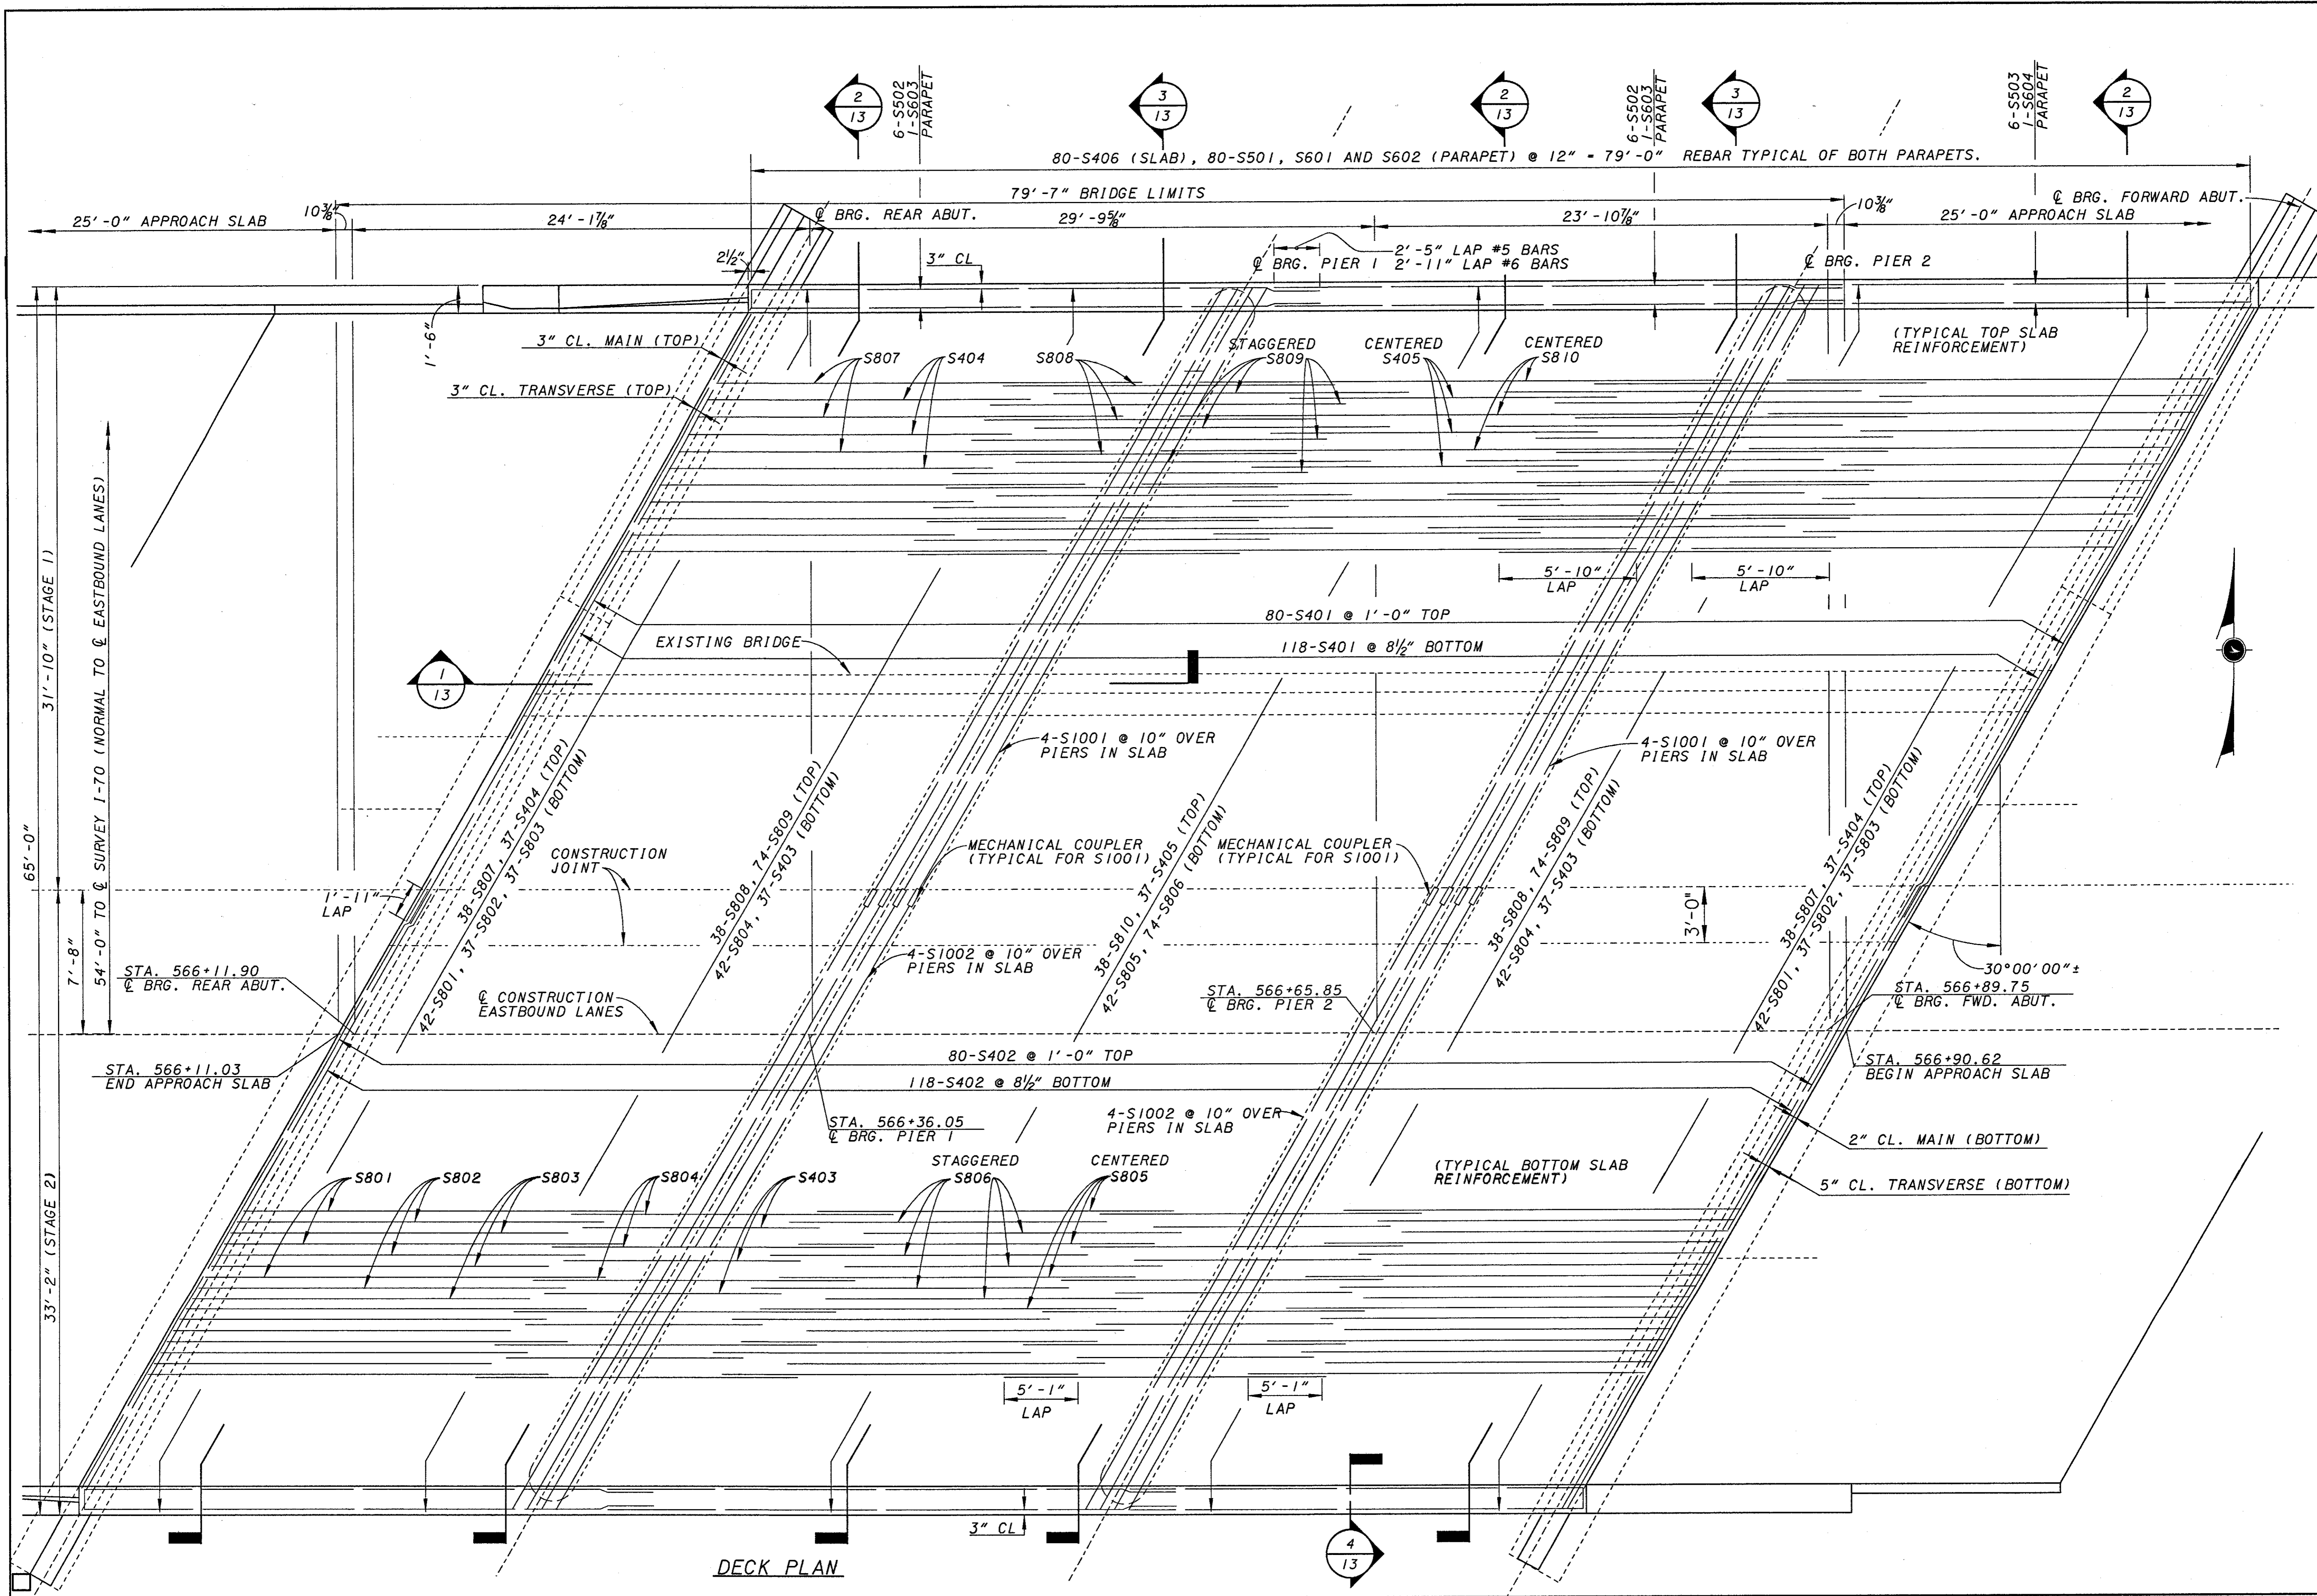
DECK PLAN

KZF DESIGN
 DESIGN AGENCY
 1500 EAST 17TH AVENUE, SUITE 100
 DENVER, COLORADO 80202
 TEL: 303.733.1311 FAX: 303.733.1311 WEB: www.kzf.com

DATE	08-02-00
REVISION	DGK
STRUCTURE FILE NUMBER	6801145/6801234
DESIGNED	SVA
CHECKED	WBS
DRAWN	JVG
REVISION	

DECK PLAN - RIGHT BRIDGE
 BRIDGE NO. PRE-70-1072 L/R
 I.R. TO OVER GOOSE RUN

PRE-70-0.00

12 / 17

179
 283



REF: **REF**
 REF: **REF**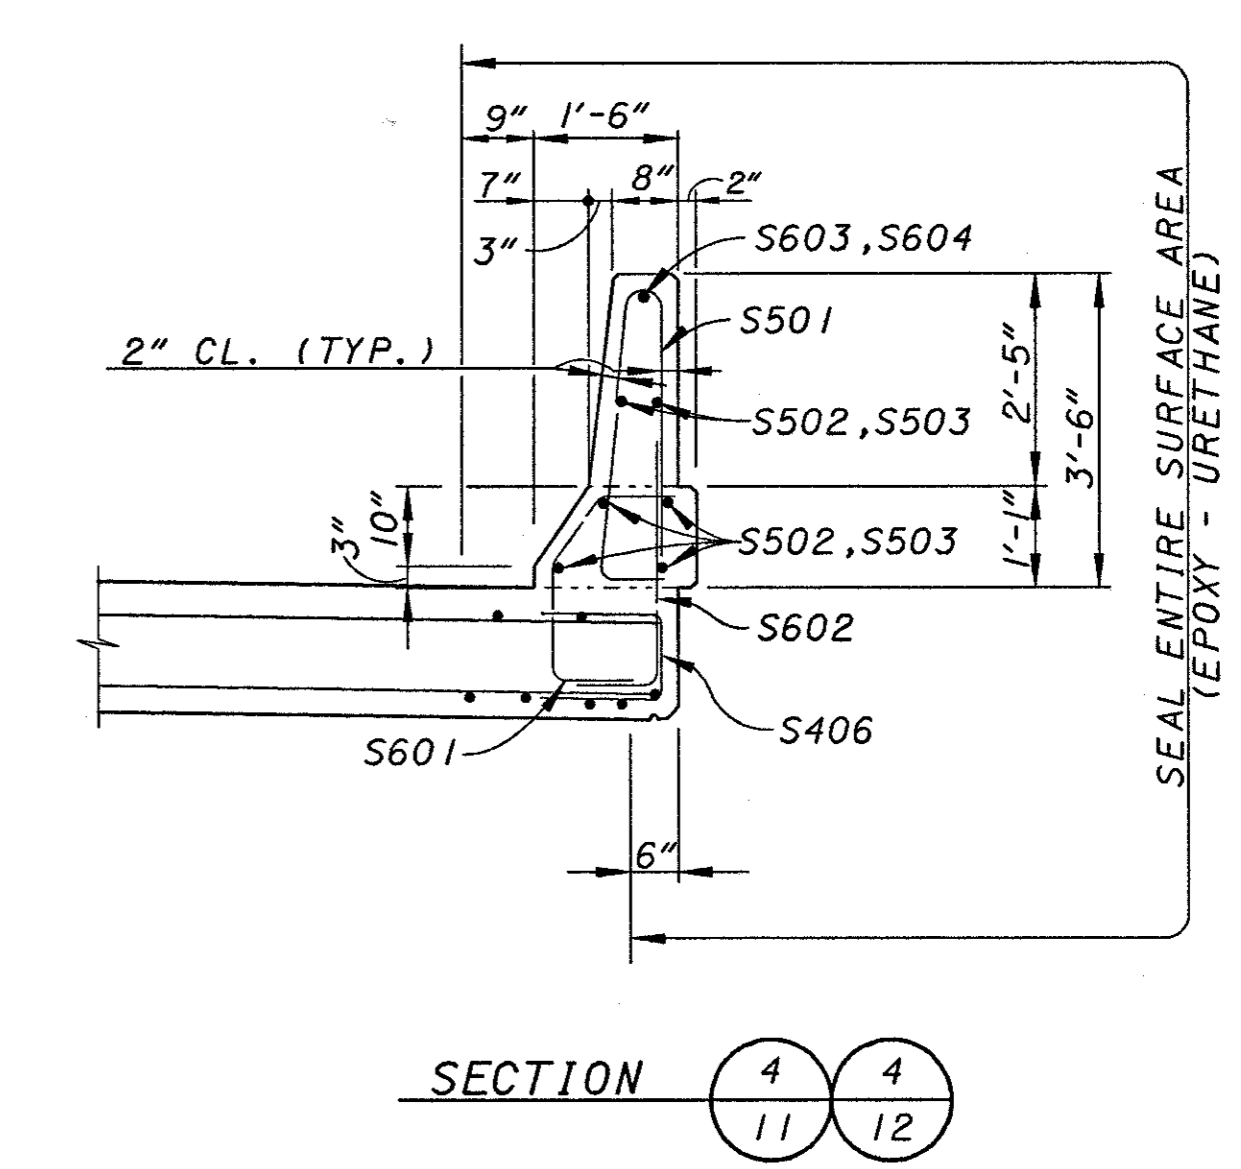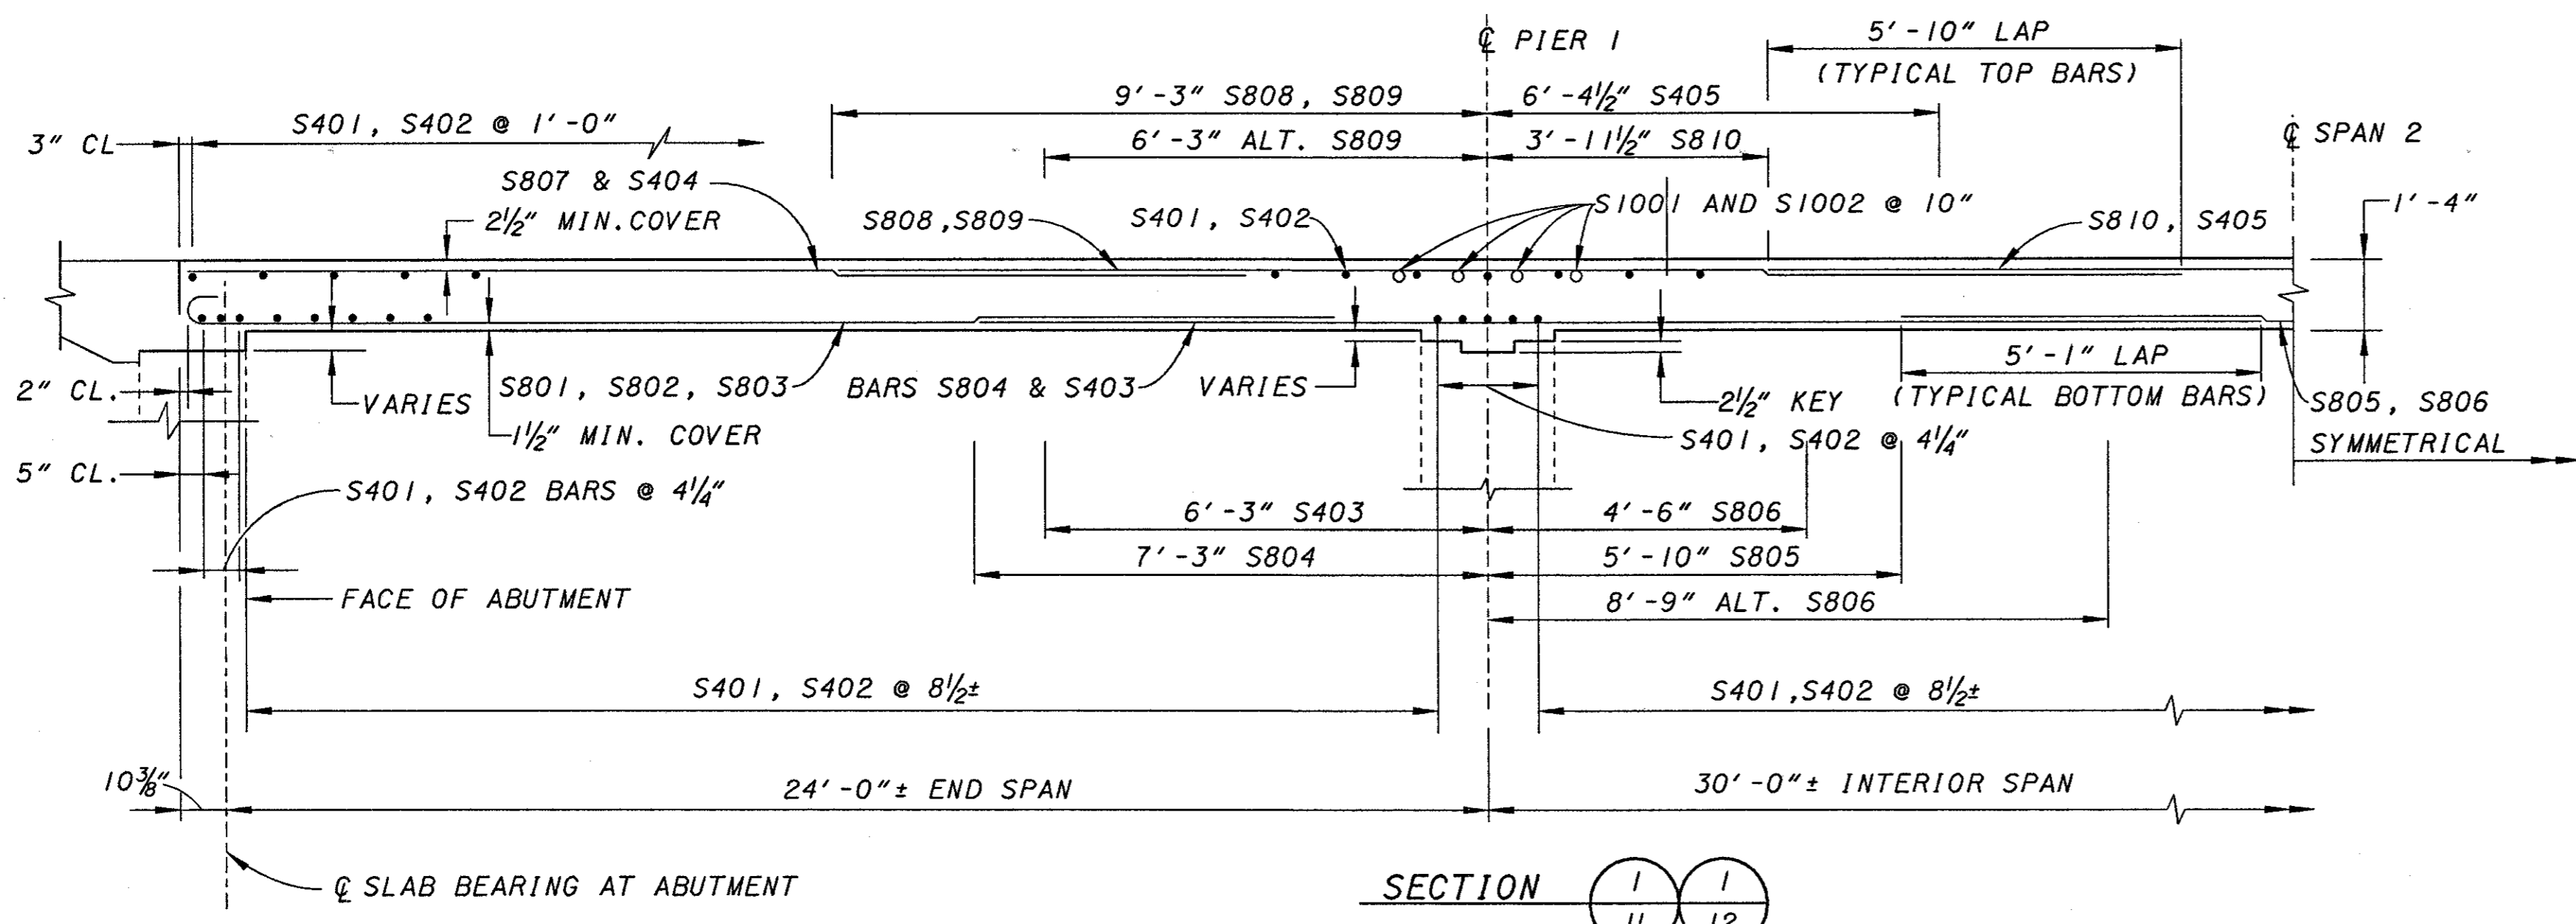
NOTE:
 FALSEWORK FOR THE CONCRETE SLAB CONSTRUCTION STAGES SHALL BE INDEPENDENT OF EACH OTHER.

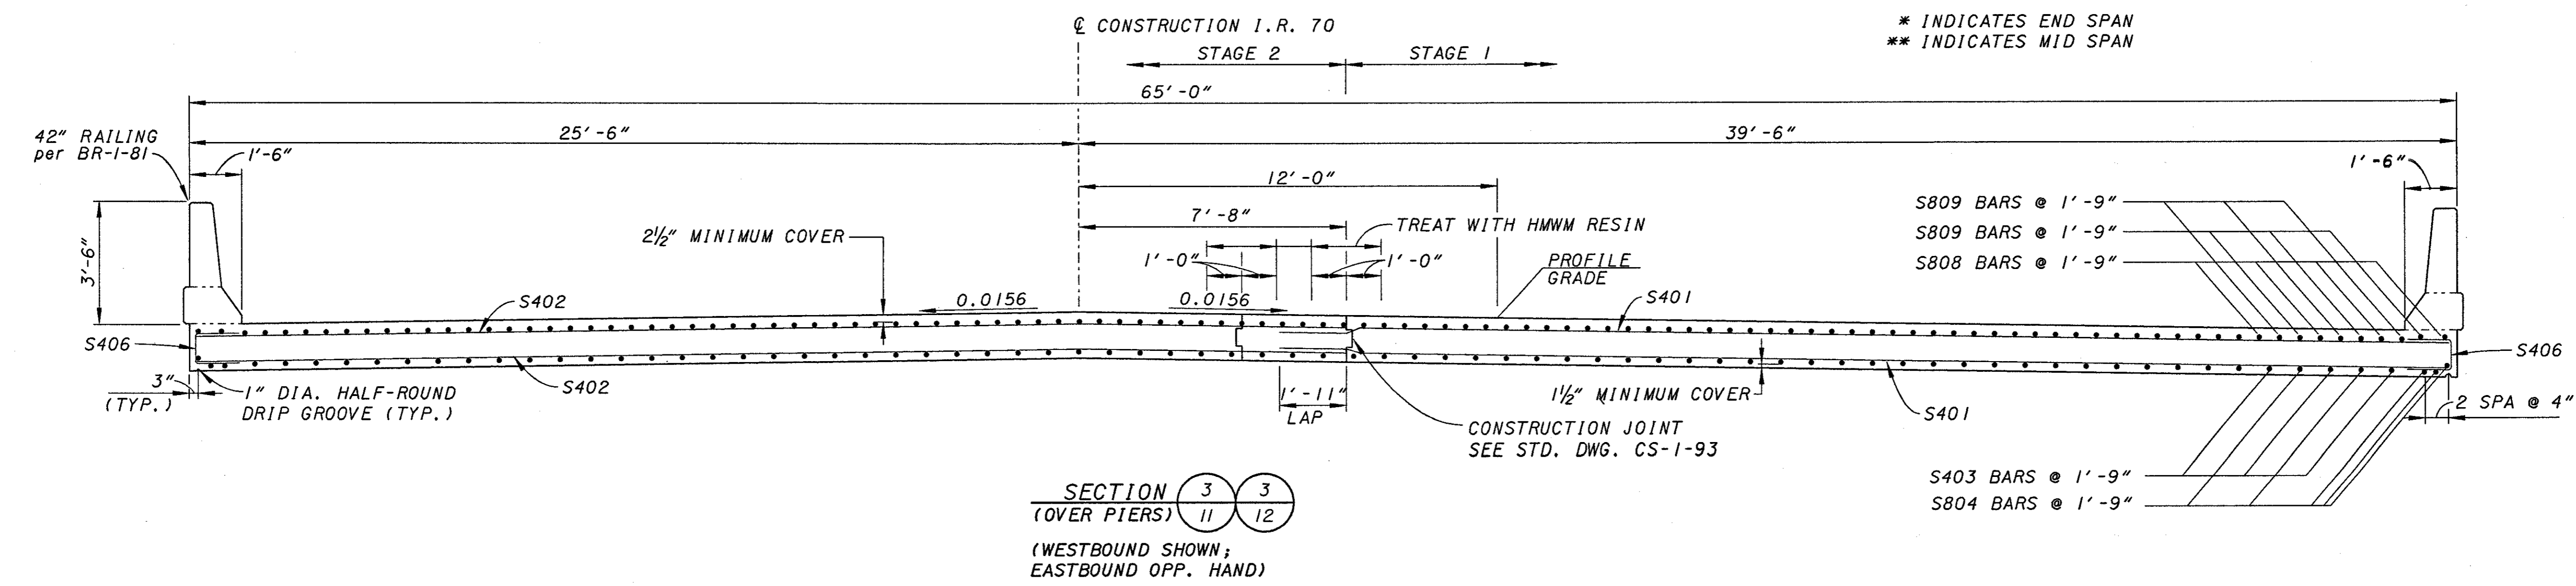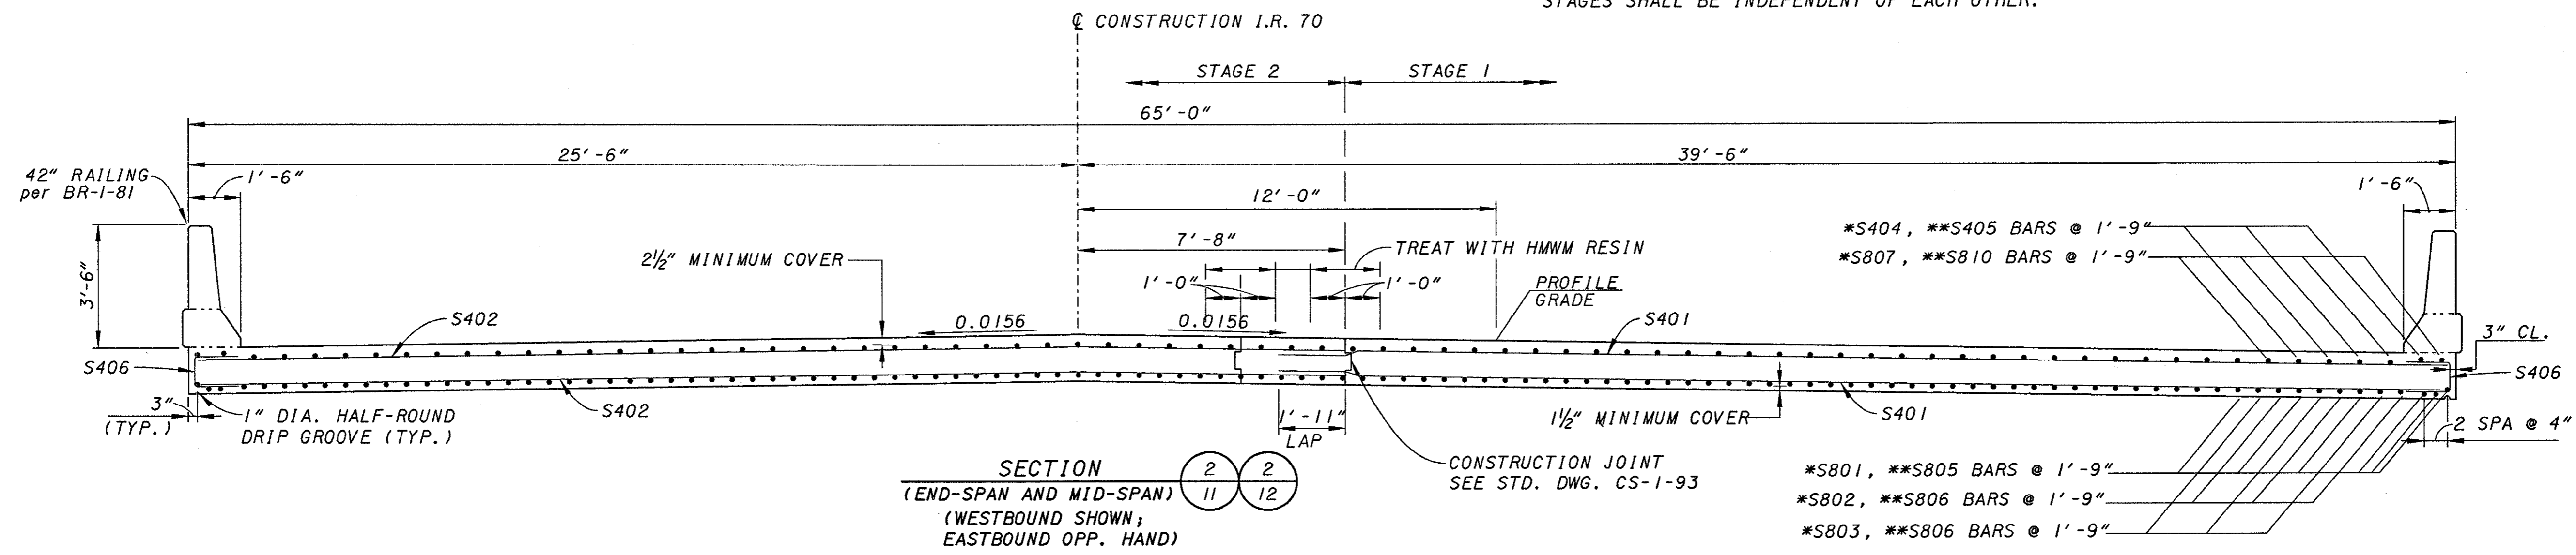


REF: 000000
 REF: 000000

DATE: 08/20/00
 TIME: 10:00 AM
 PROJECT: I-70 OVER GOOSE RUN
 SHEET: 181 OF 283

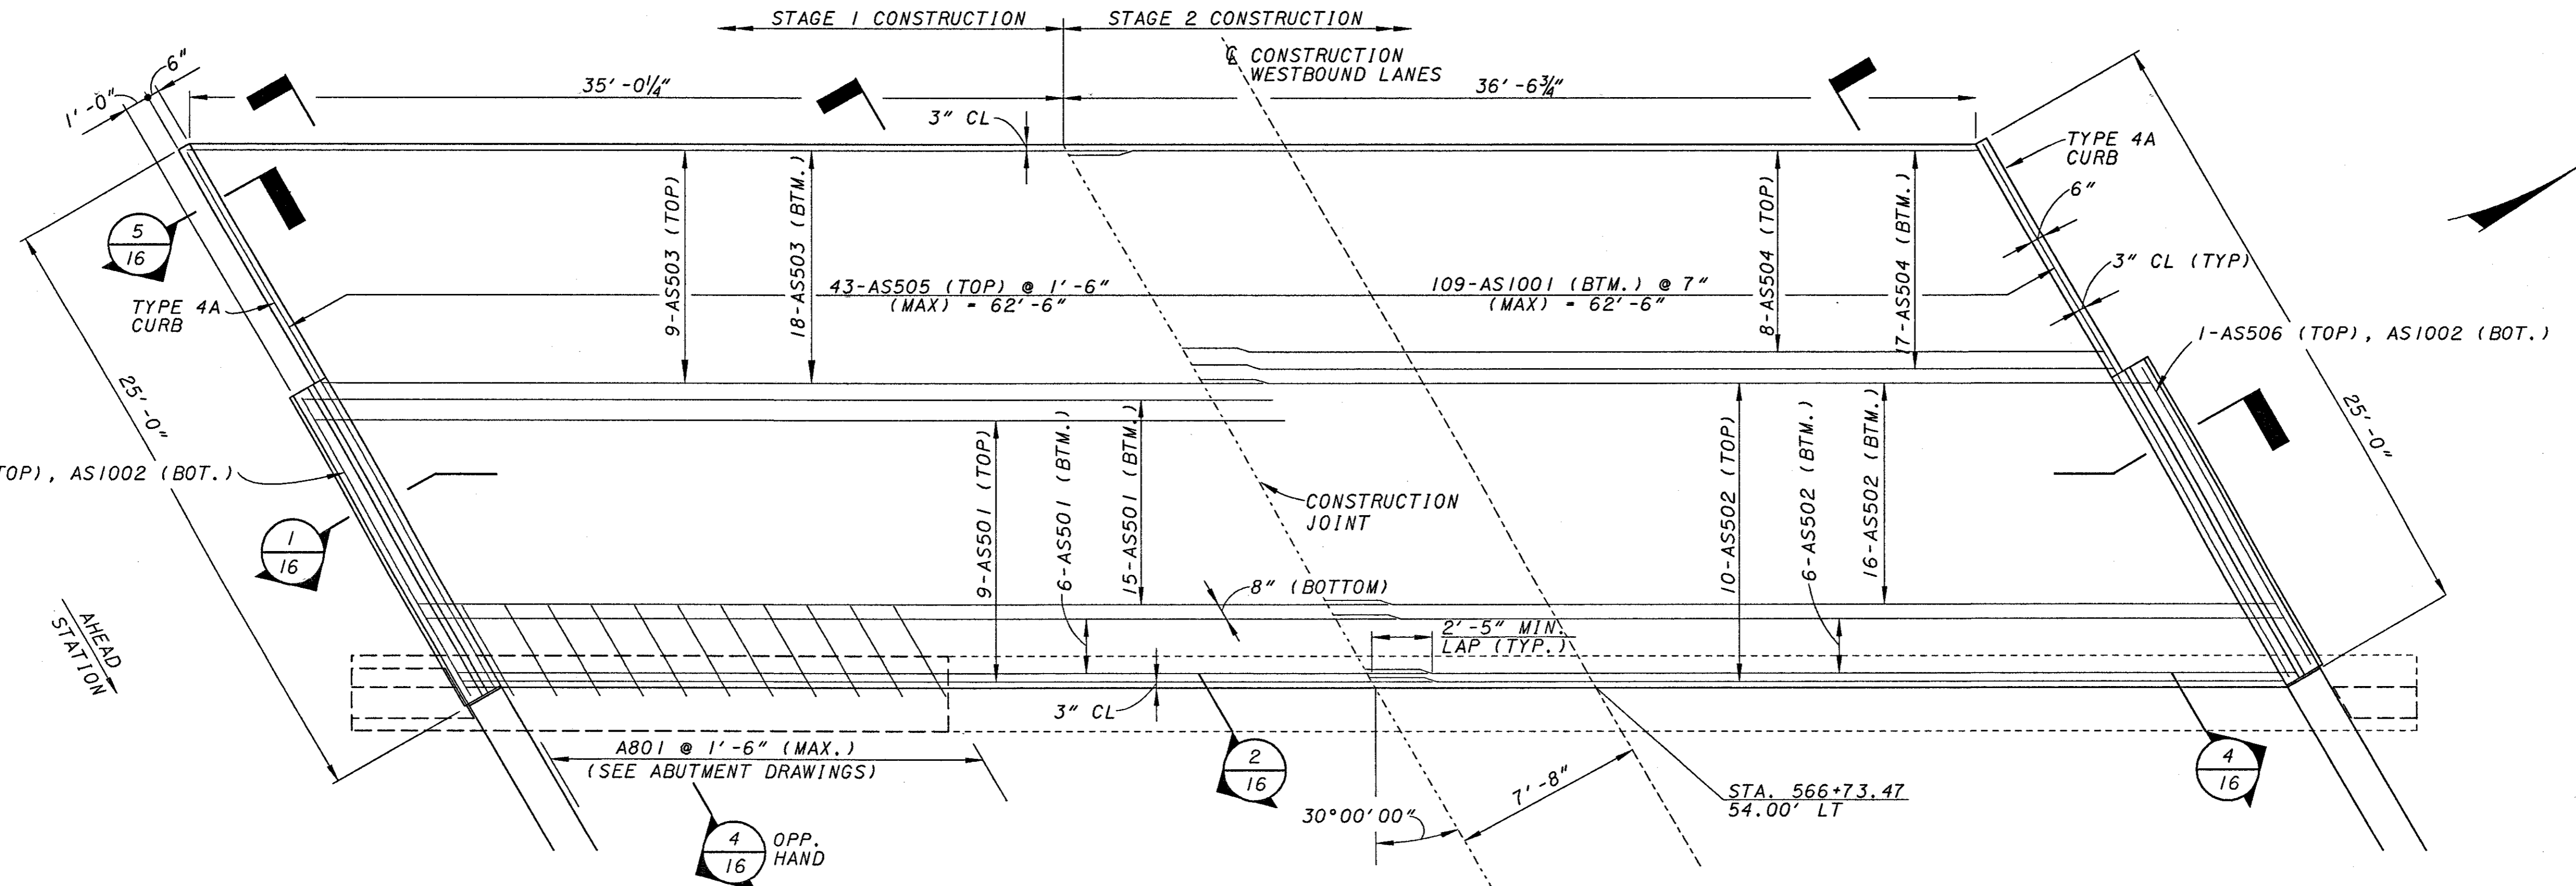

PLAN - REAR APPROACH SLAB

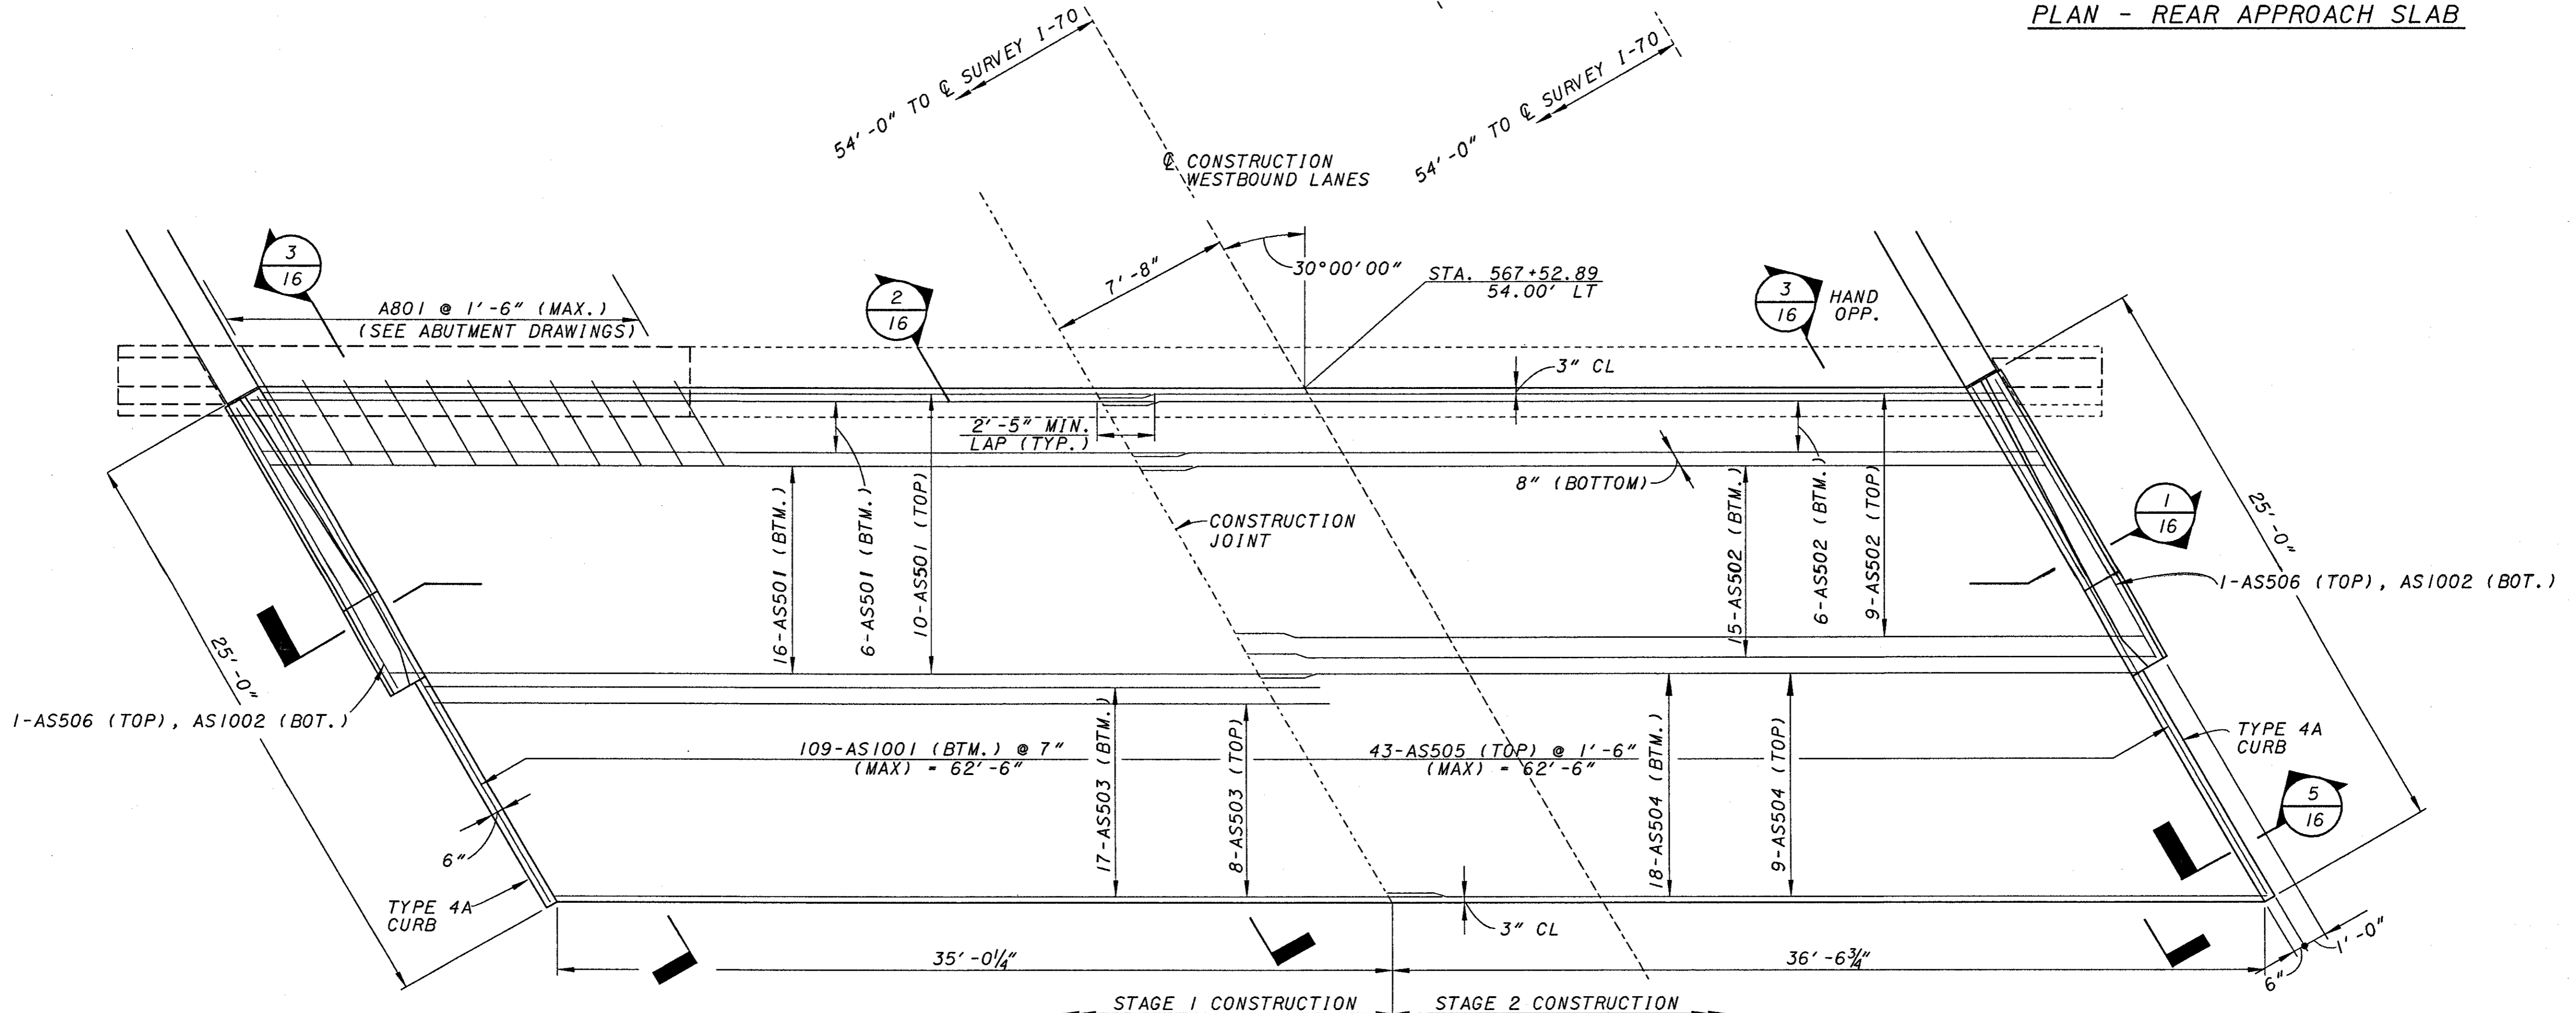

PLAN - FORWARD APPROACH SLAB

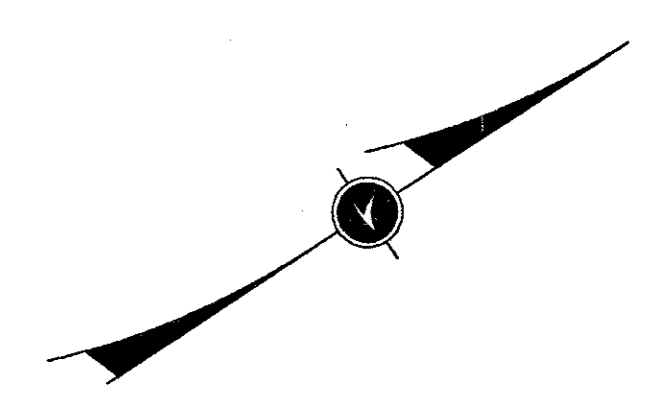

DESIGNED	DATE
SJA	08-02-00
CHECKED	STRUCTURE FILE NUMBER
WBS	680114576801234
DRAWN	REVIEWED
JDG	DGK
DATE	FILE NUMBER
	680114576801234

KZF #12


APPROACH SLABS - LEFT BRIDGE
 BRIDGE NO. PRE-70-1072 L/R
 I.R. 70 OVER GOOSE RUN

PRE-70-0.00


14 / 17

181
 283








REVISIONS
 NO. DATE BY
 1 08/02/00 JVG
 2 08/02/00 JVG
 3 08/02/00 JVG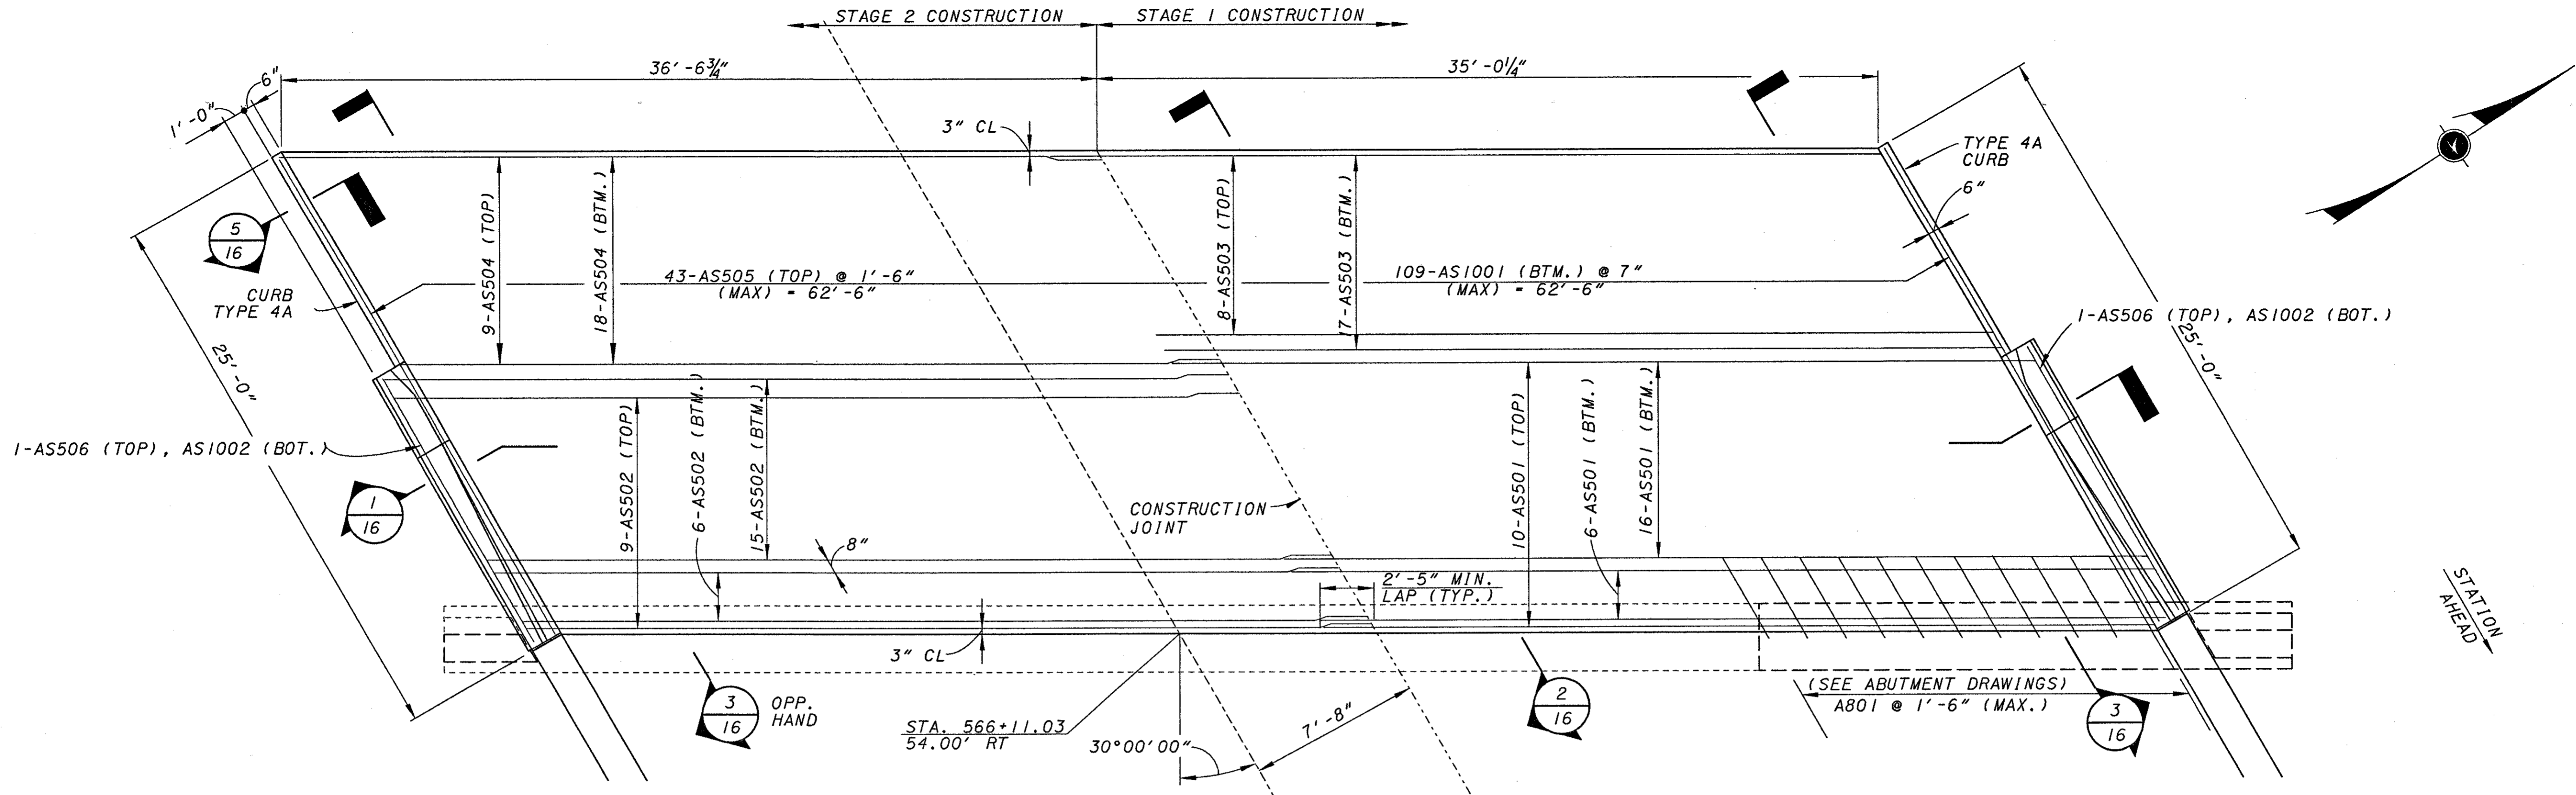
PLAN - REAR APPROACH SLAB




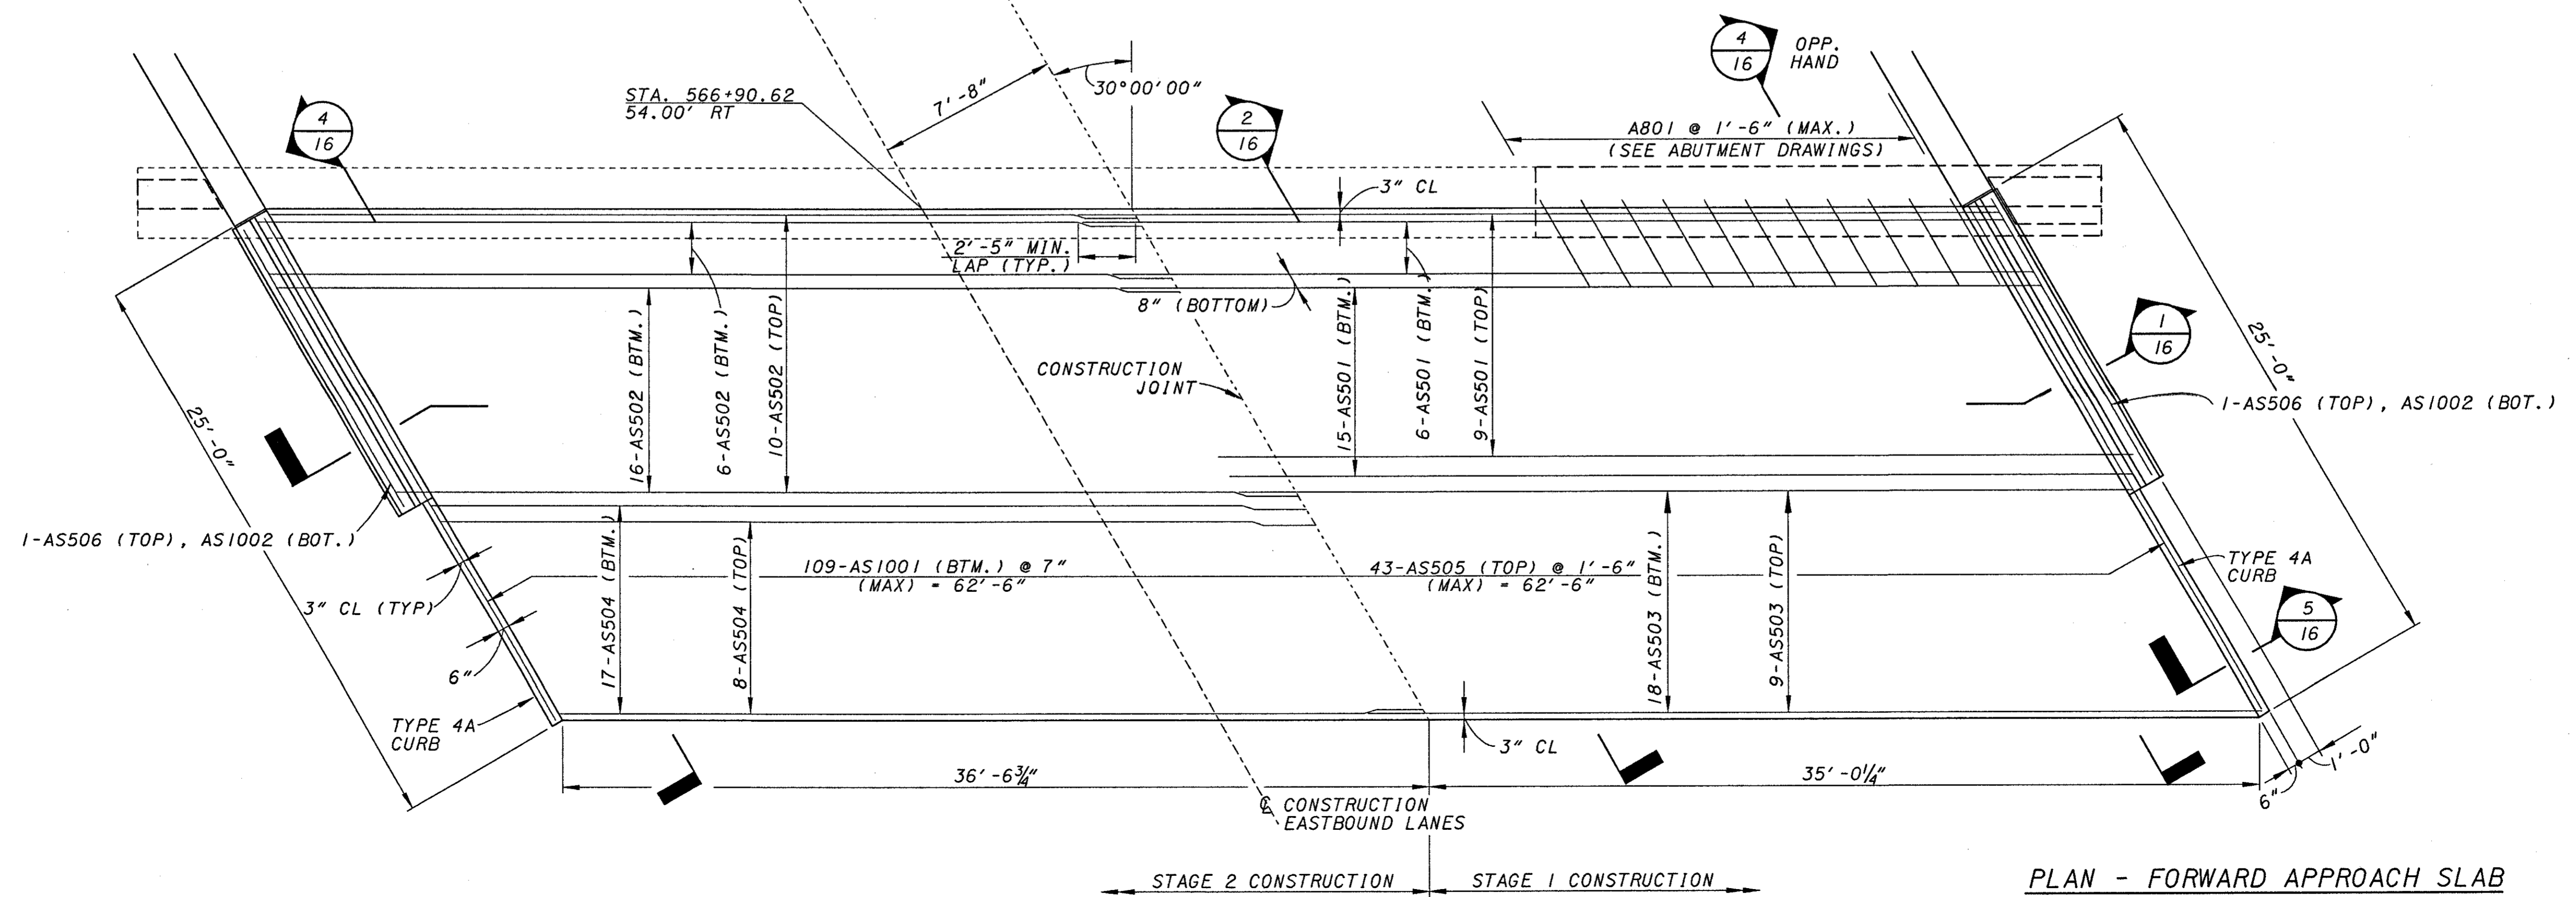



PLAN - FORWARD APPROACH SLAB

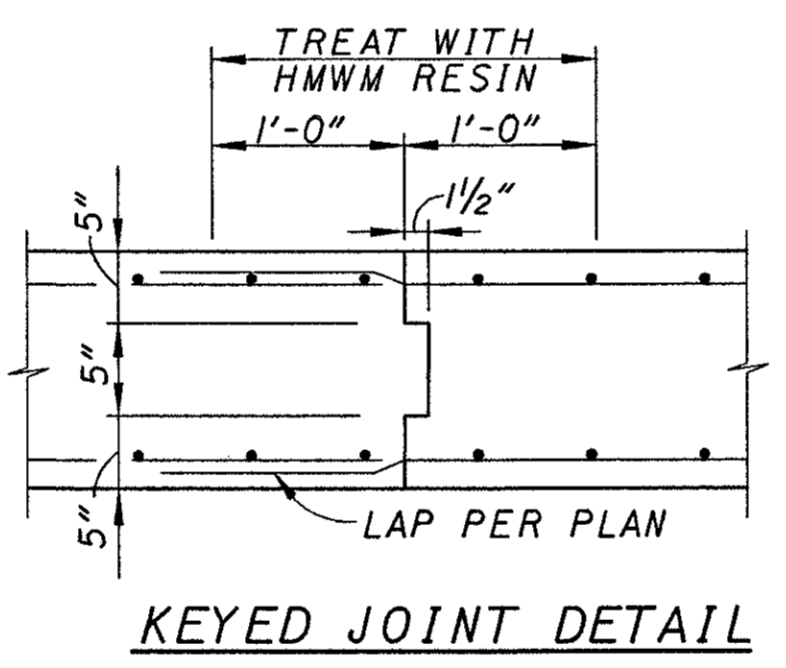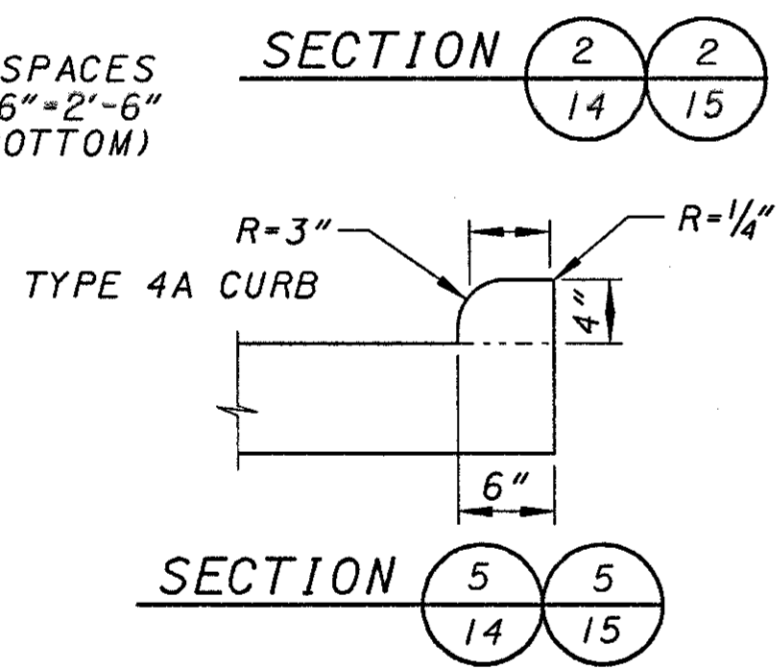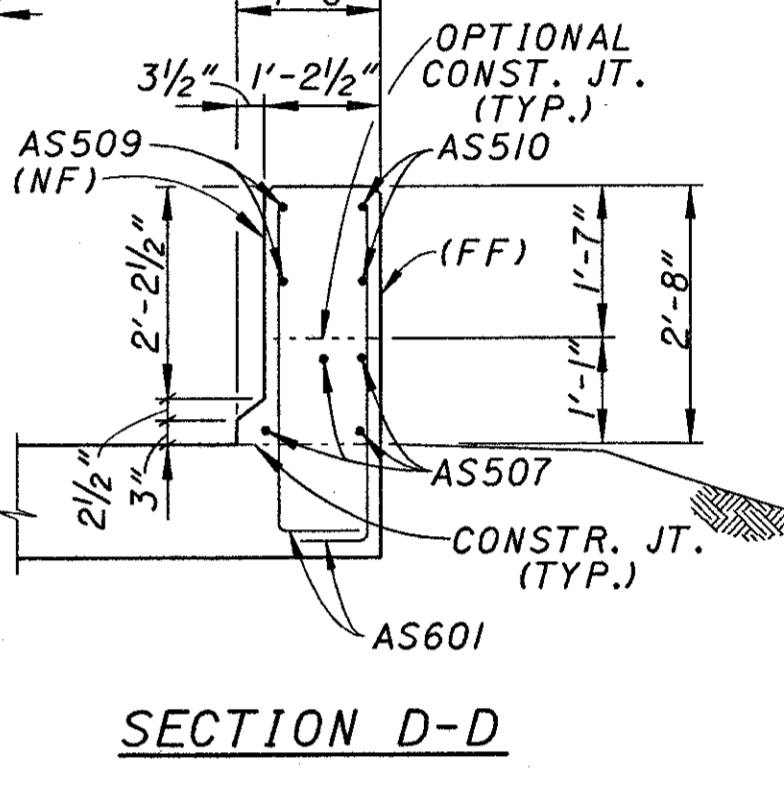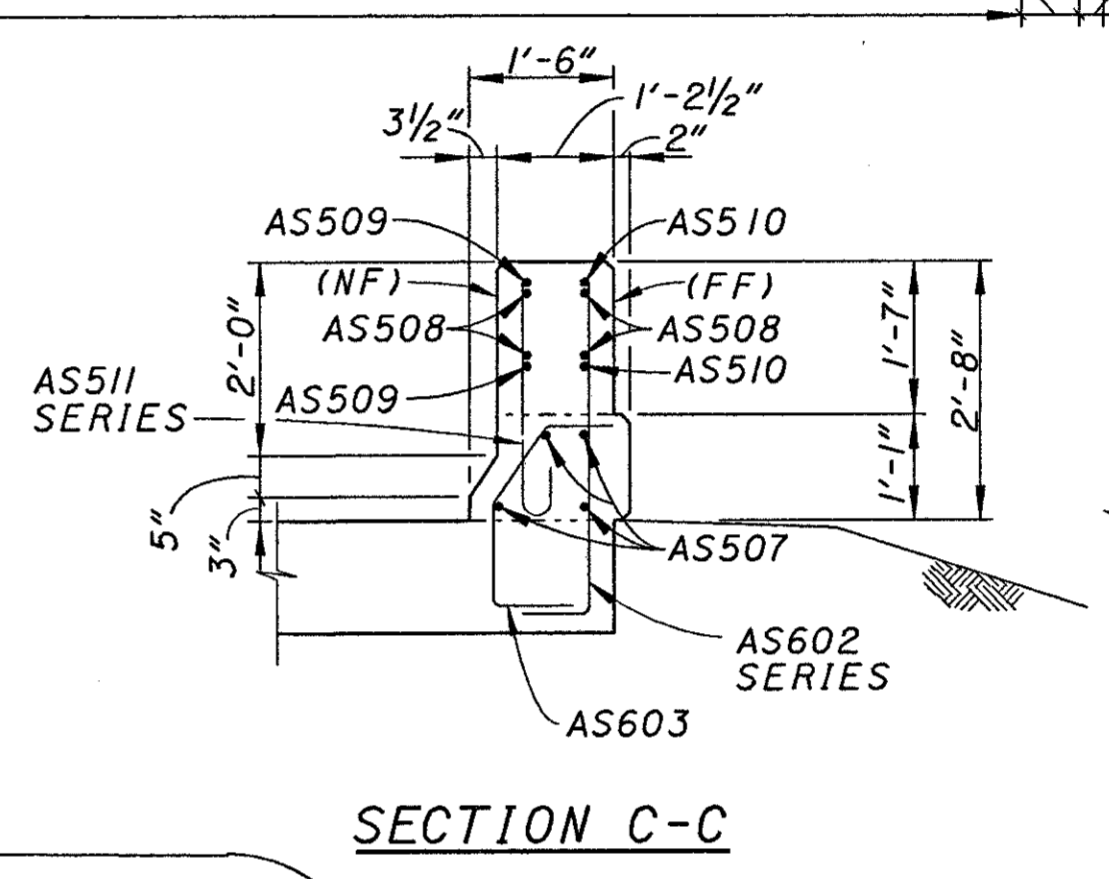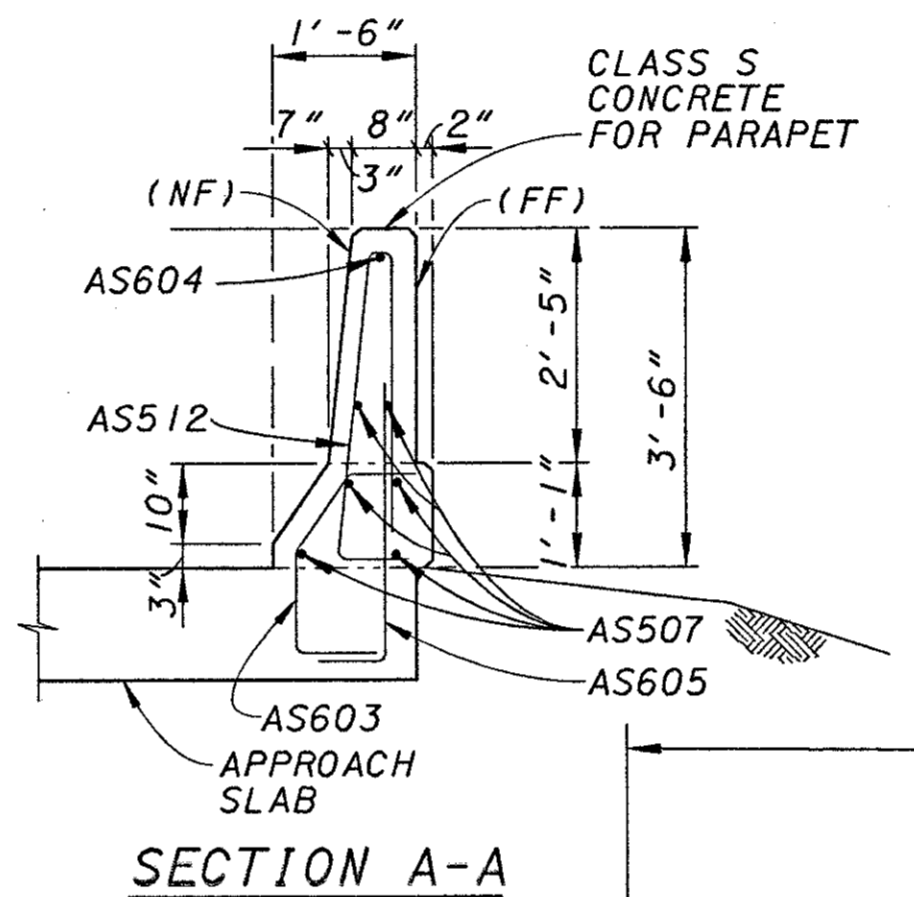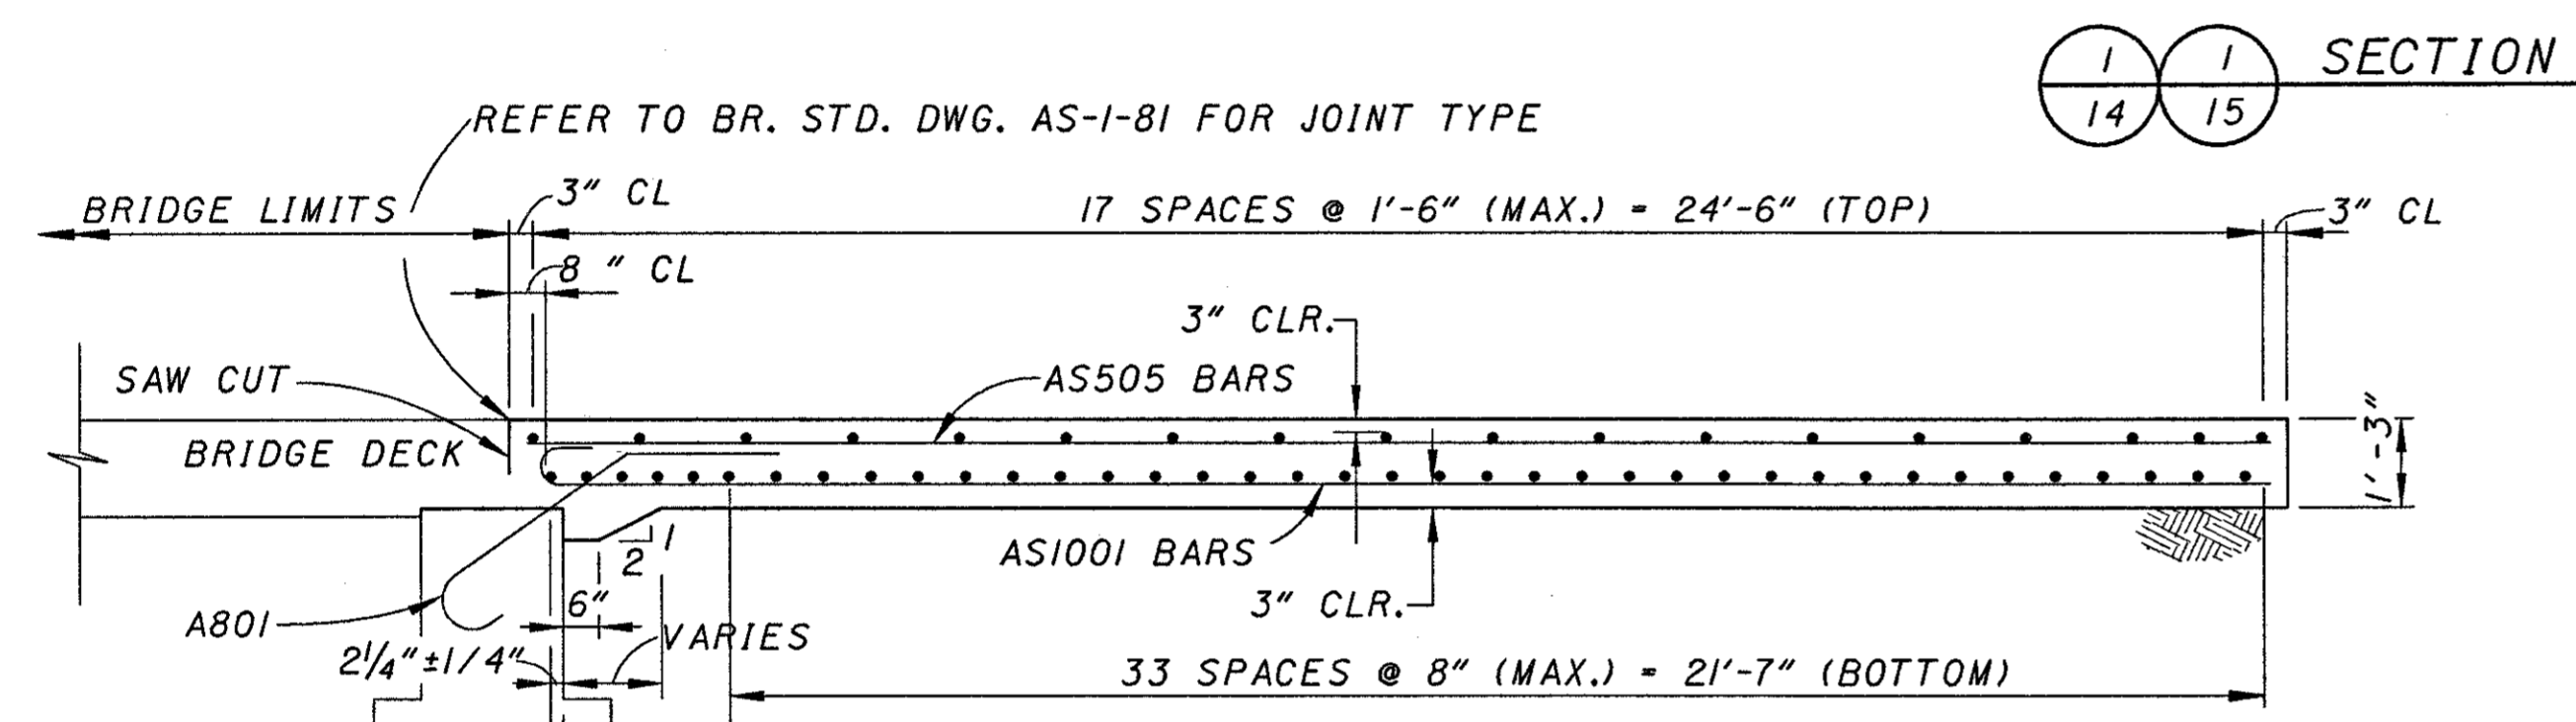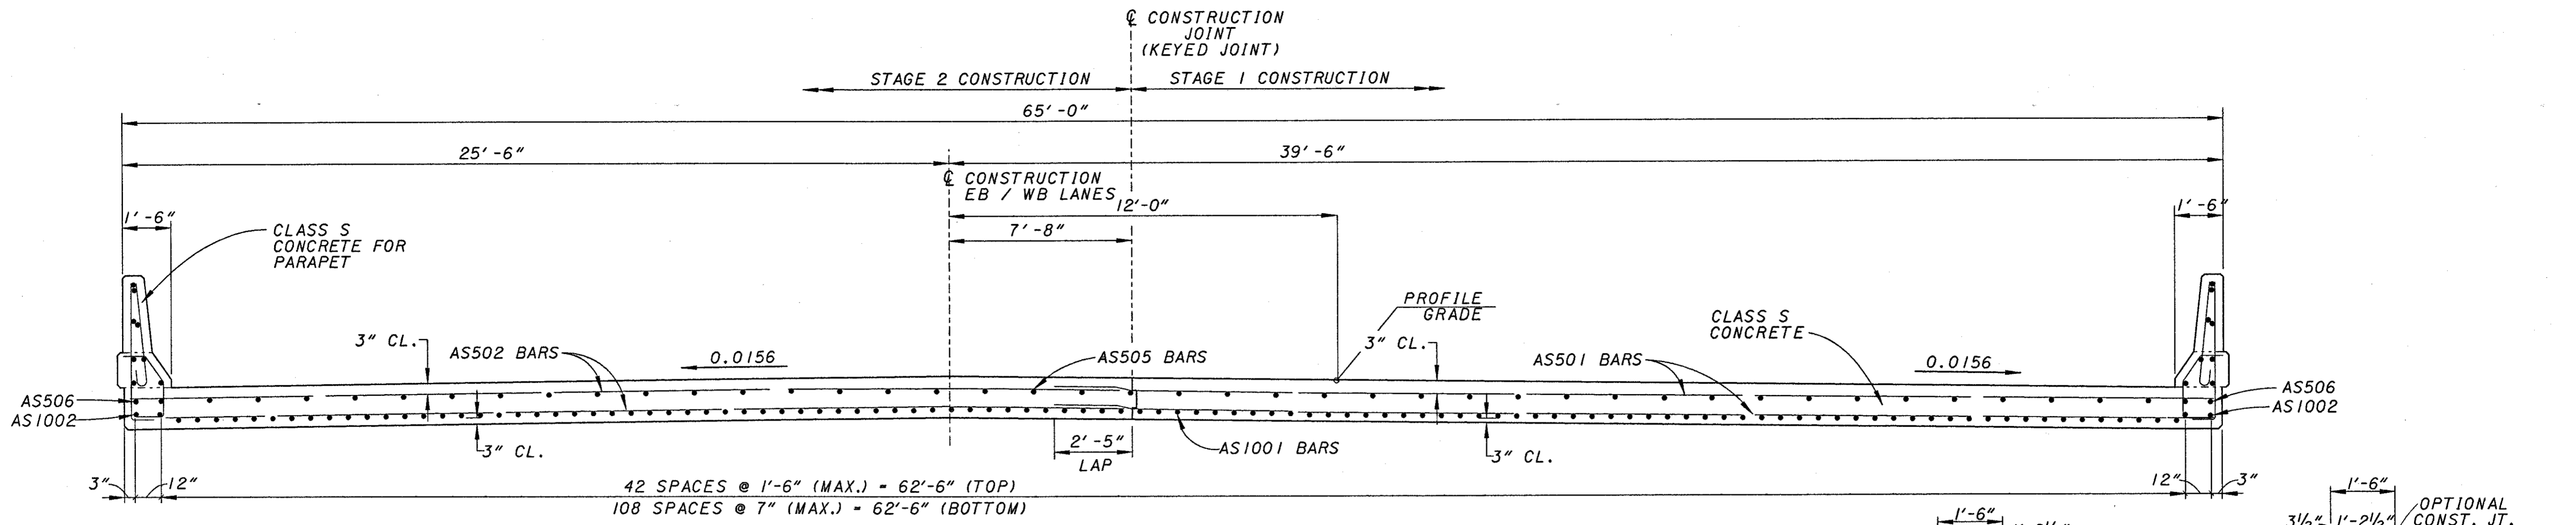


LEGEND:
 NF - NEAR FACE
 FF - FAR FACE
 EF - EACH FACE

ALL STEEL CLEARANCES ARE 3", EXCEPT 2" CLEAR FOR BARRIERS UNLESS OTHERWISE NOTED.

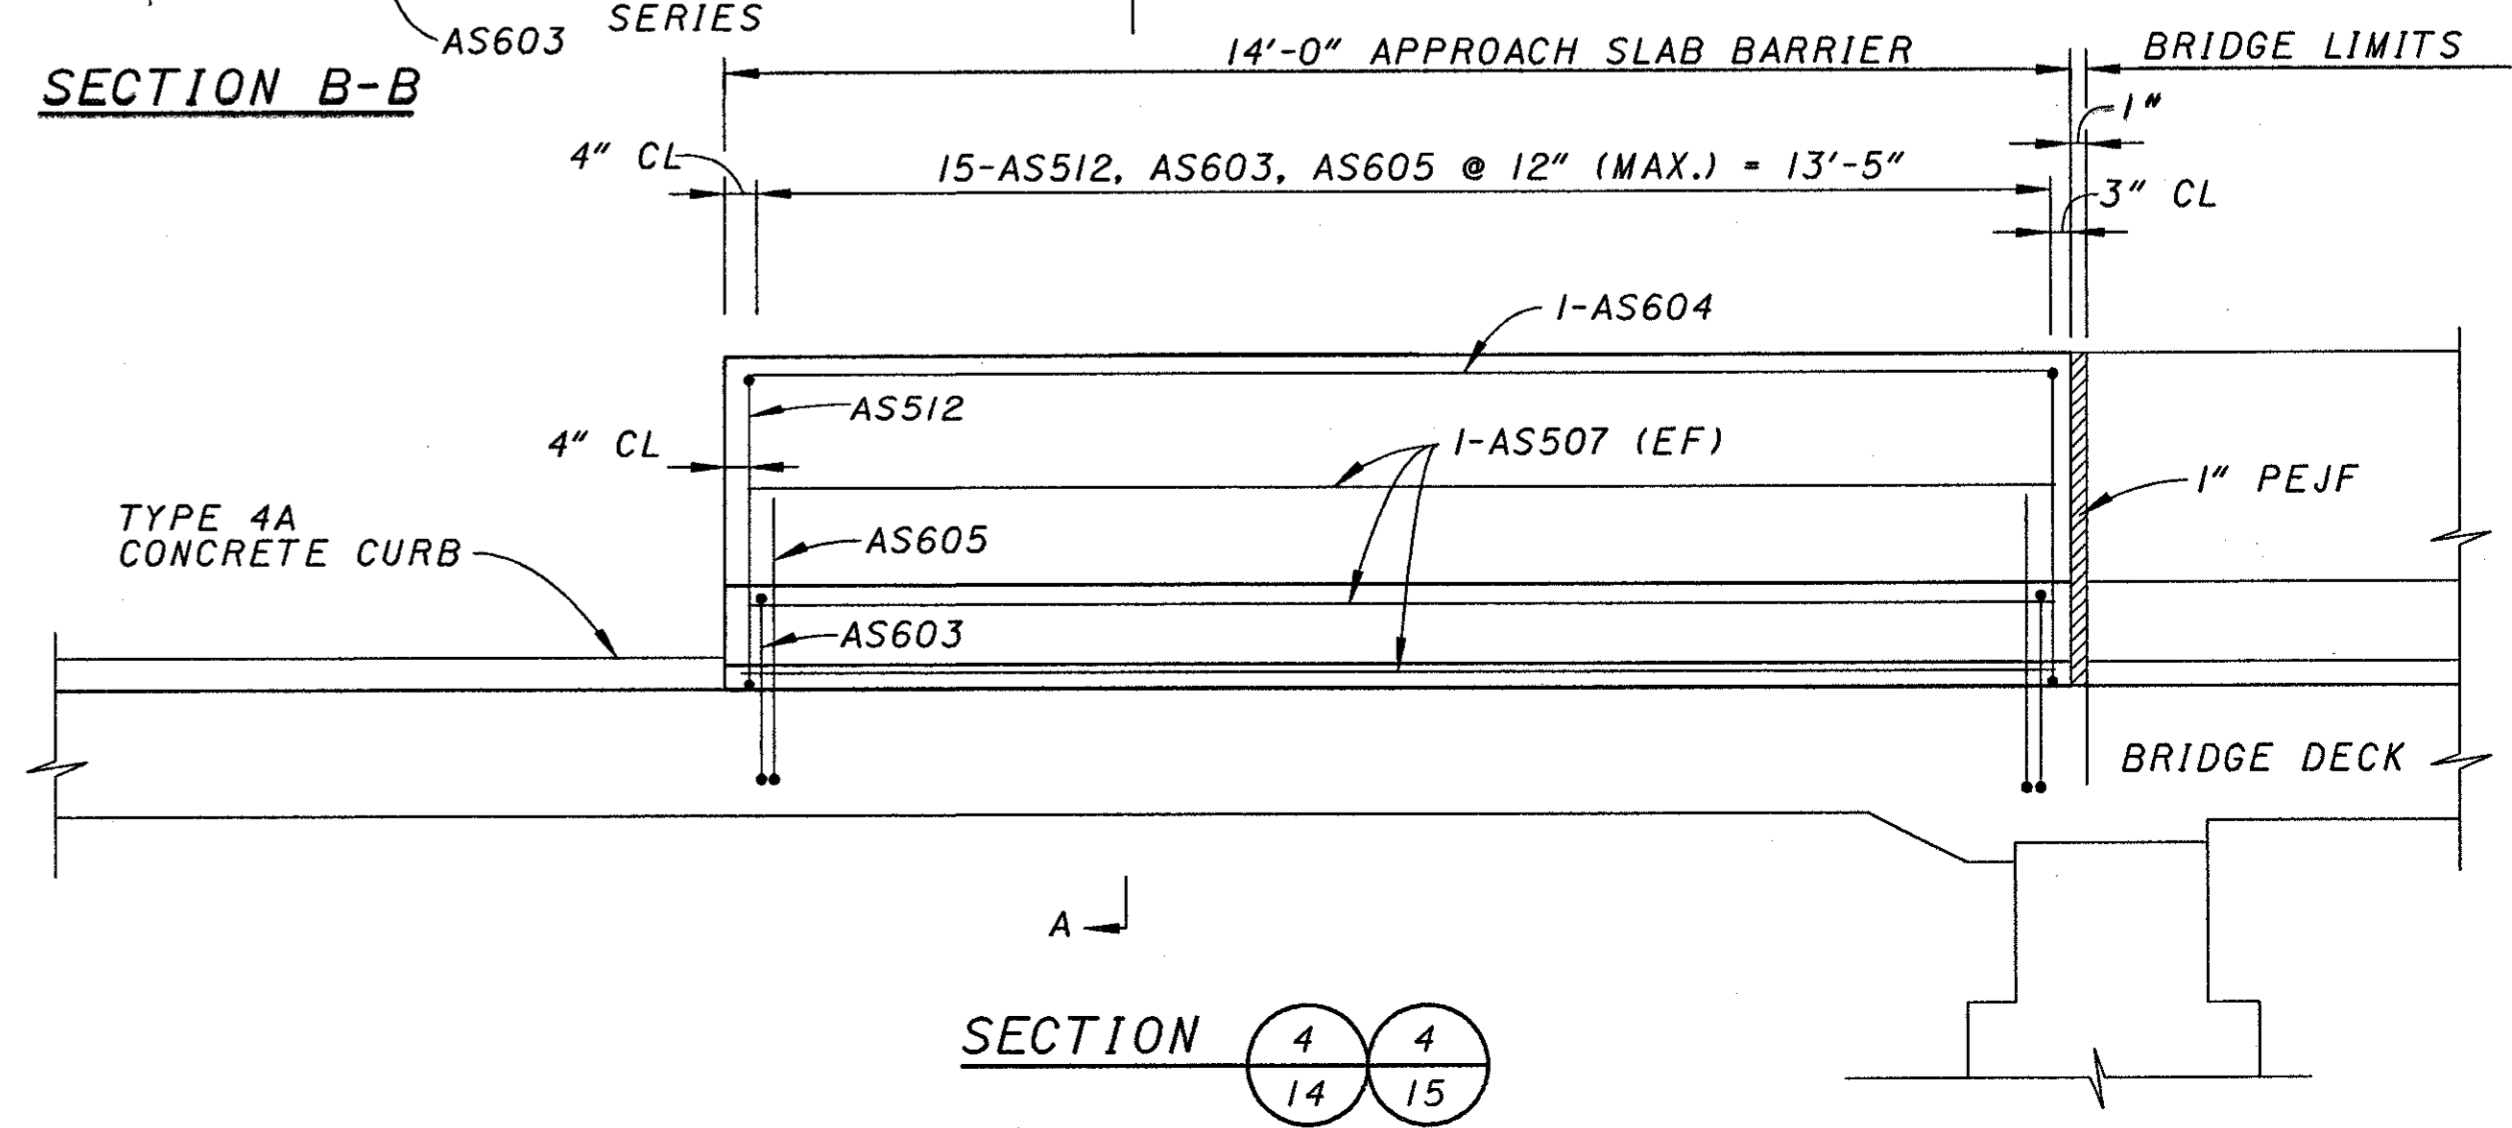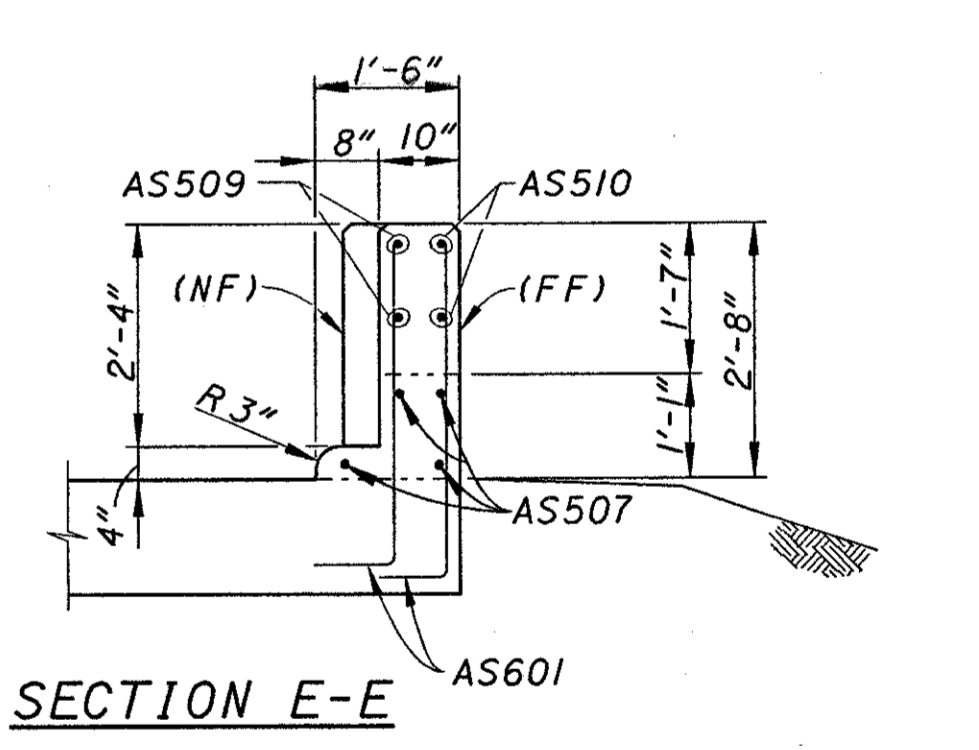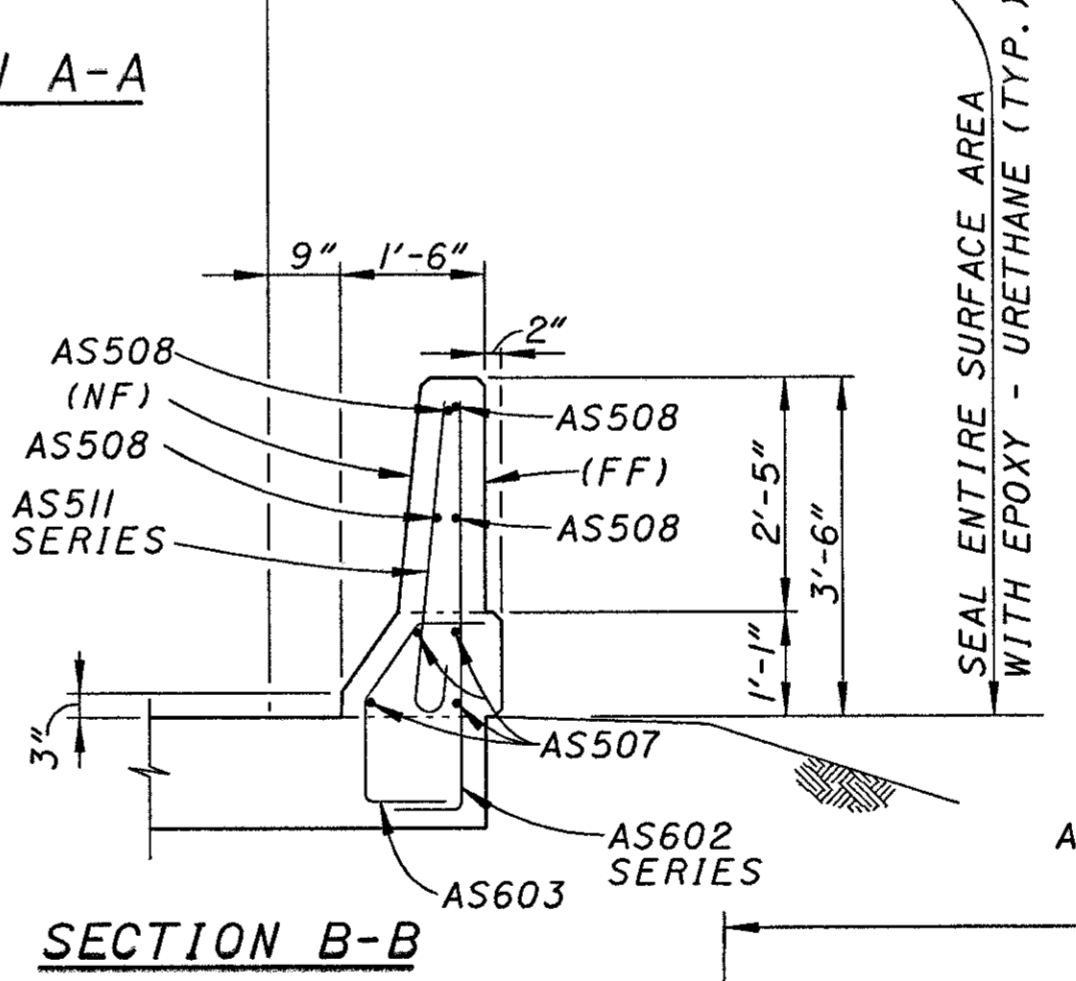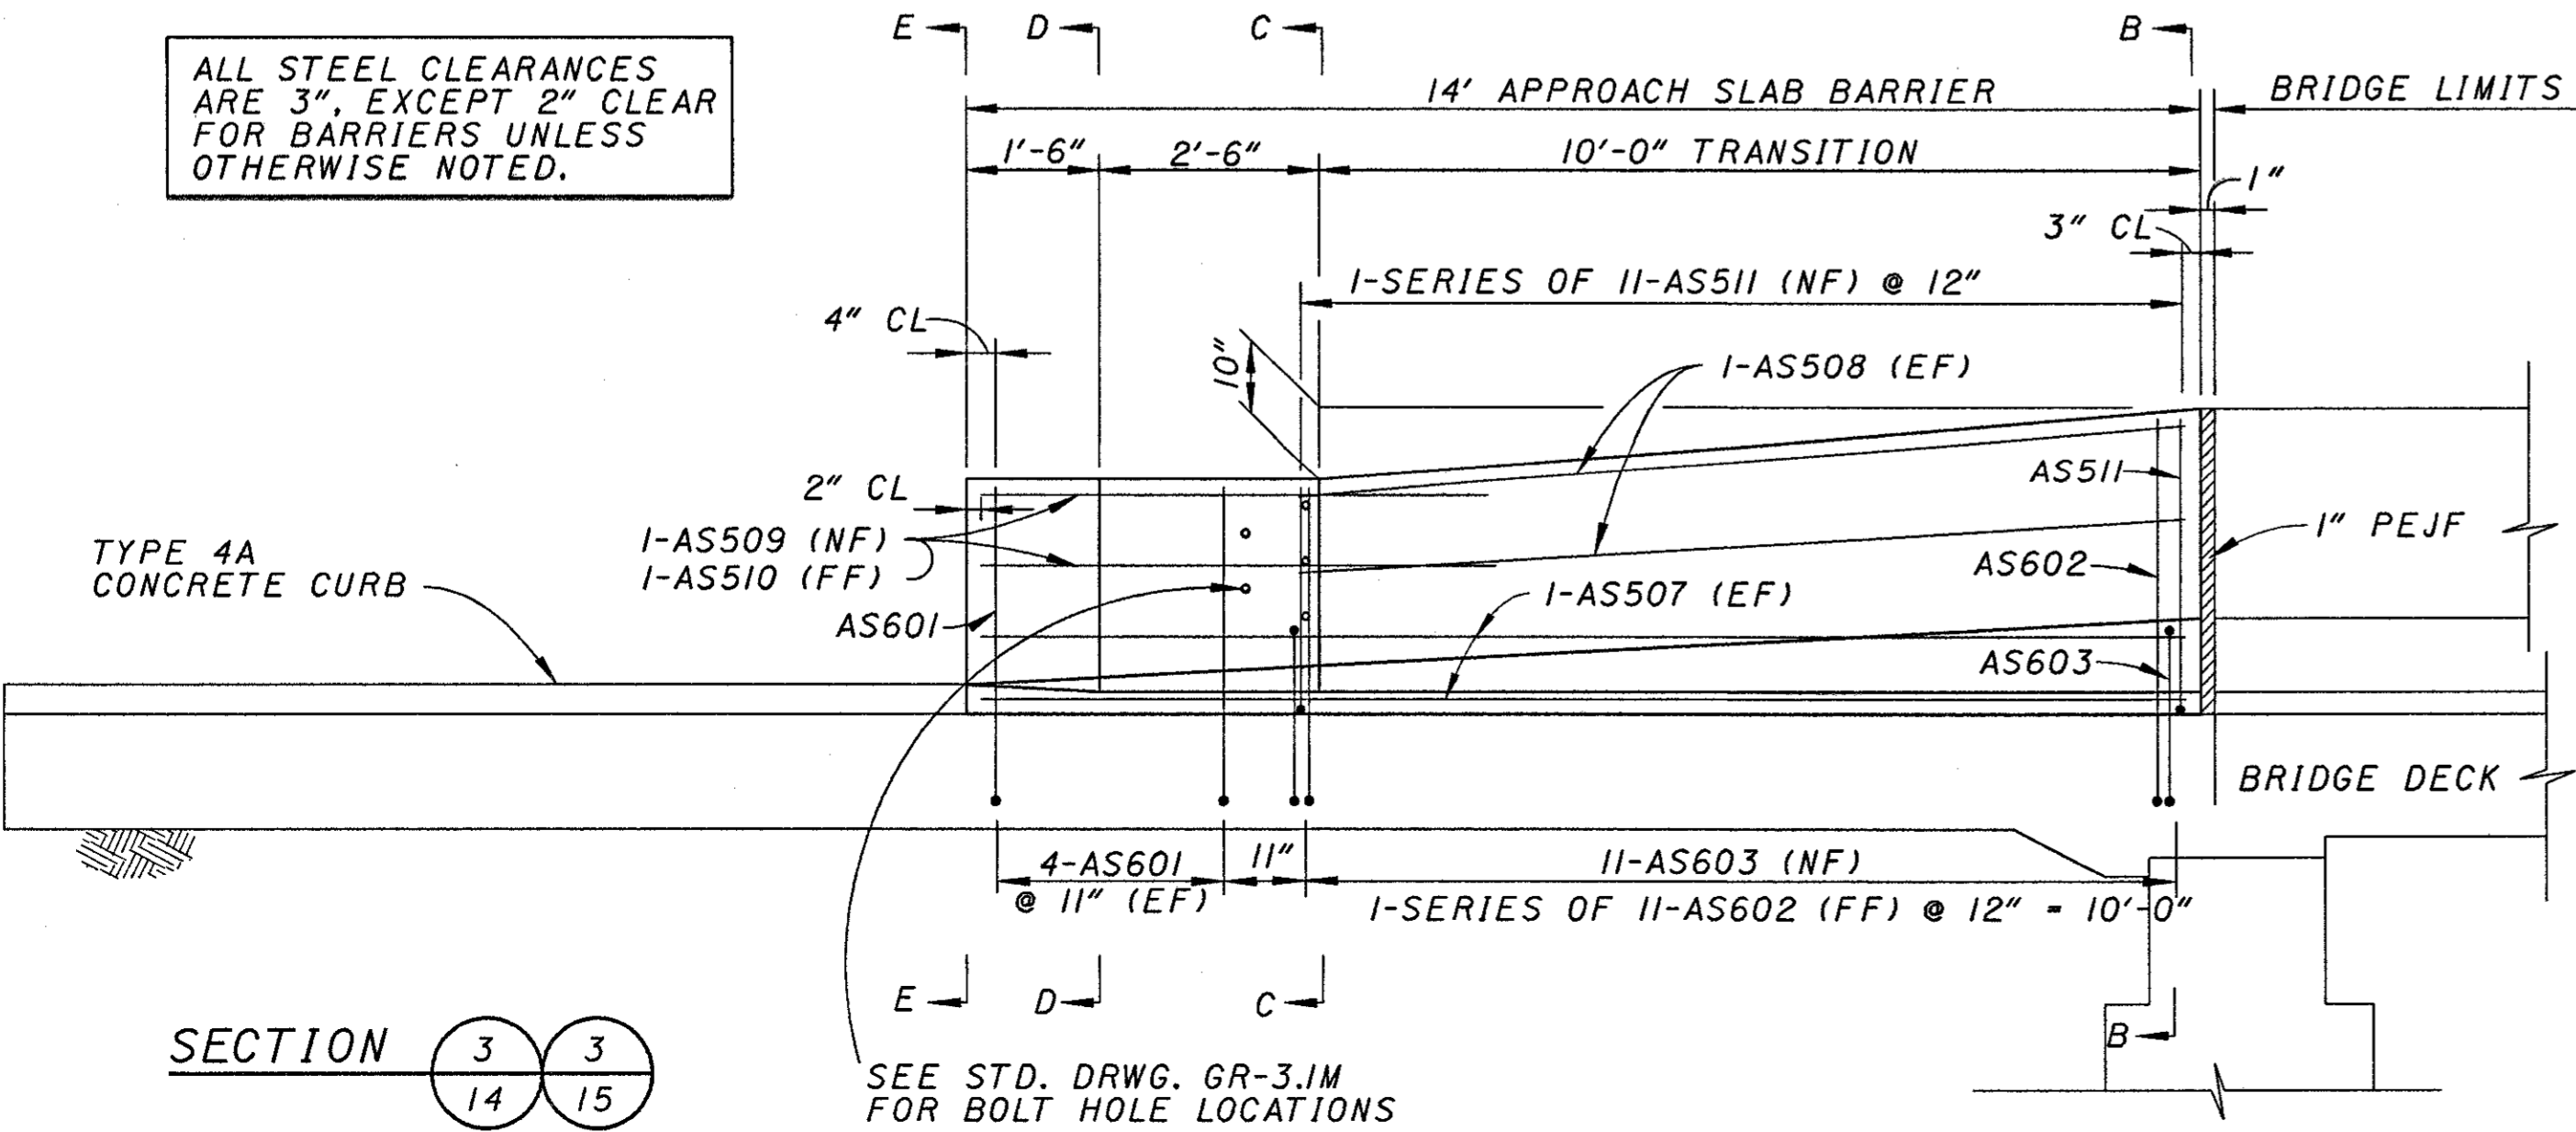


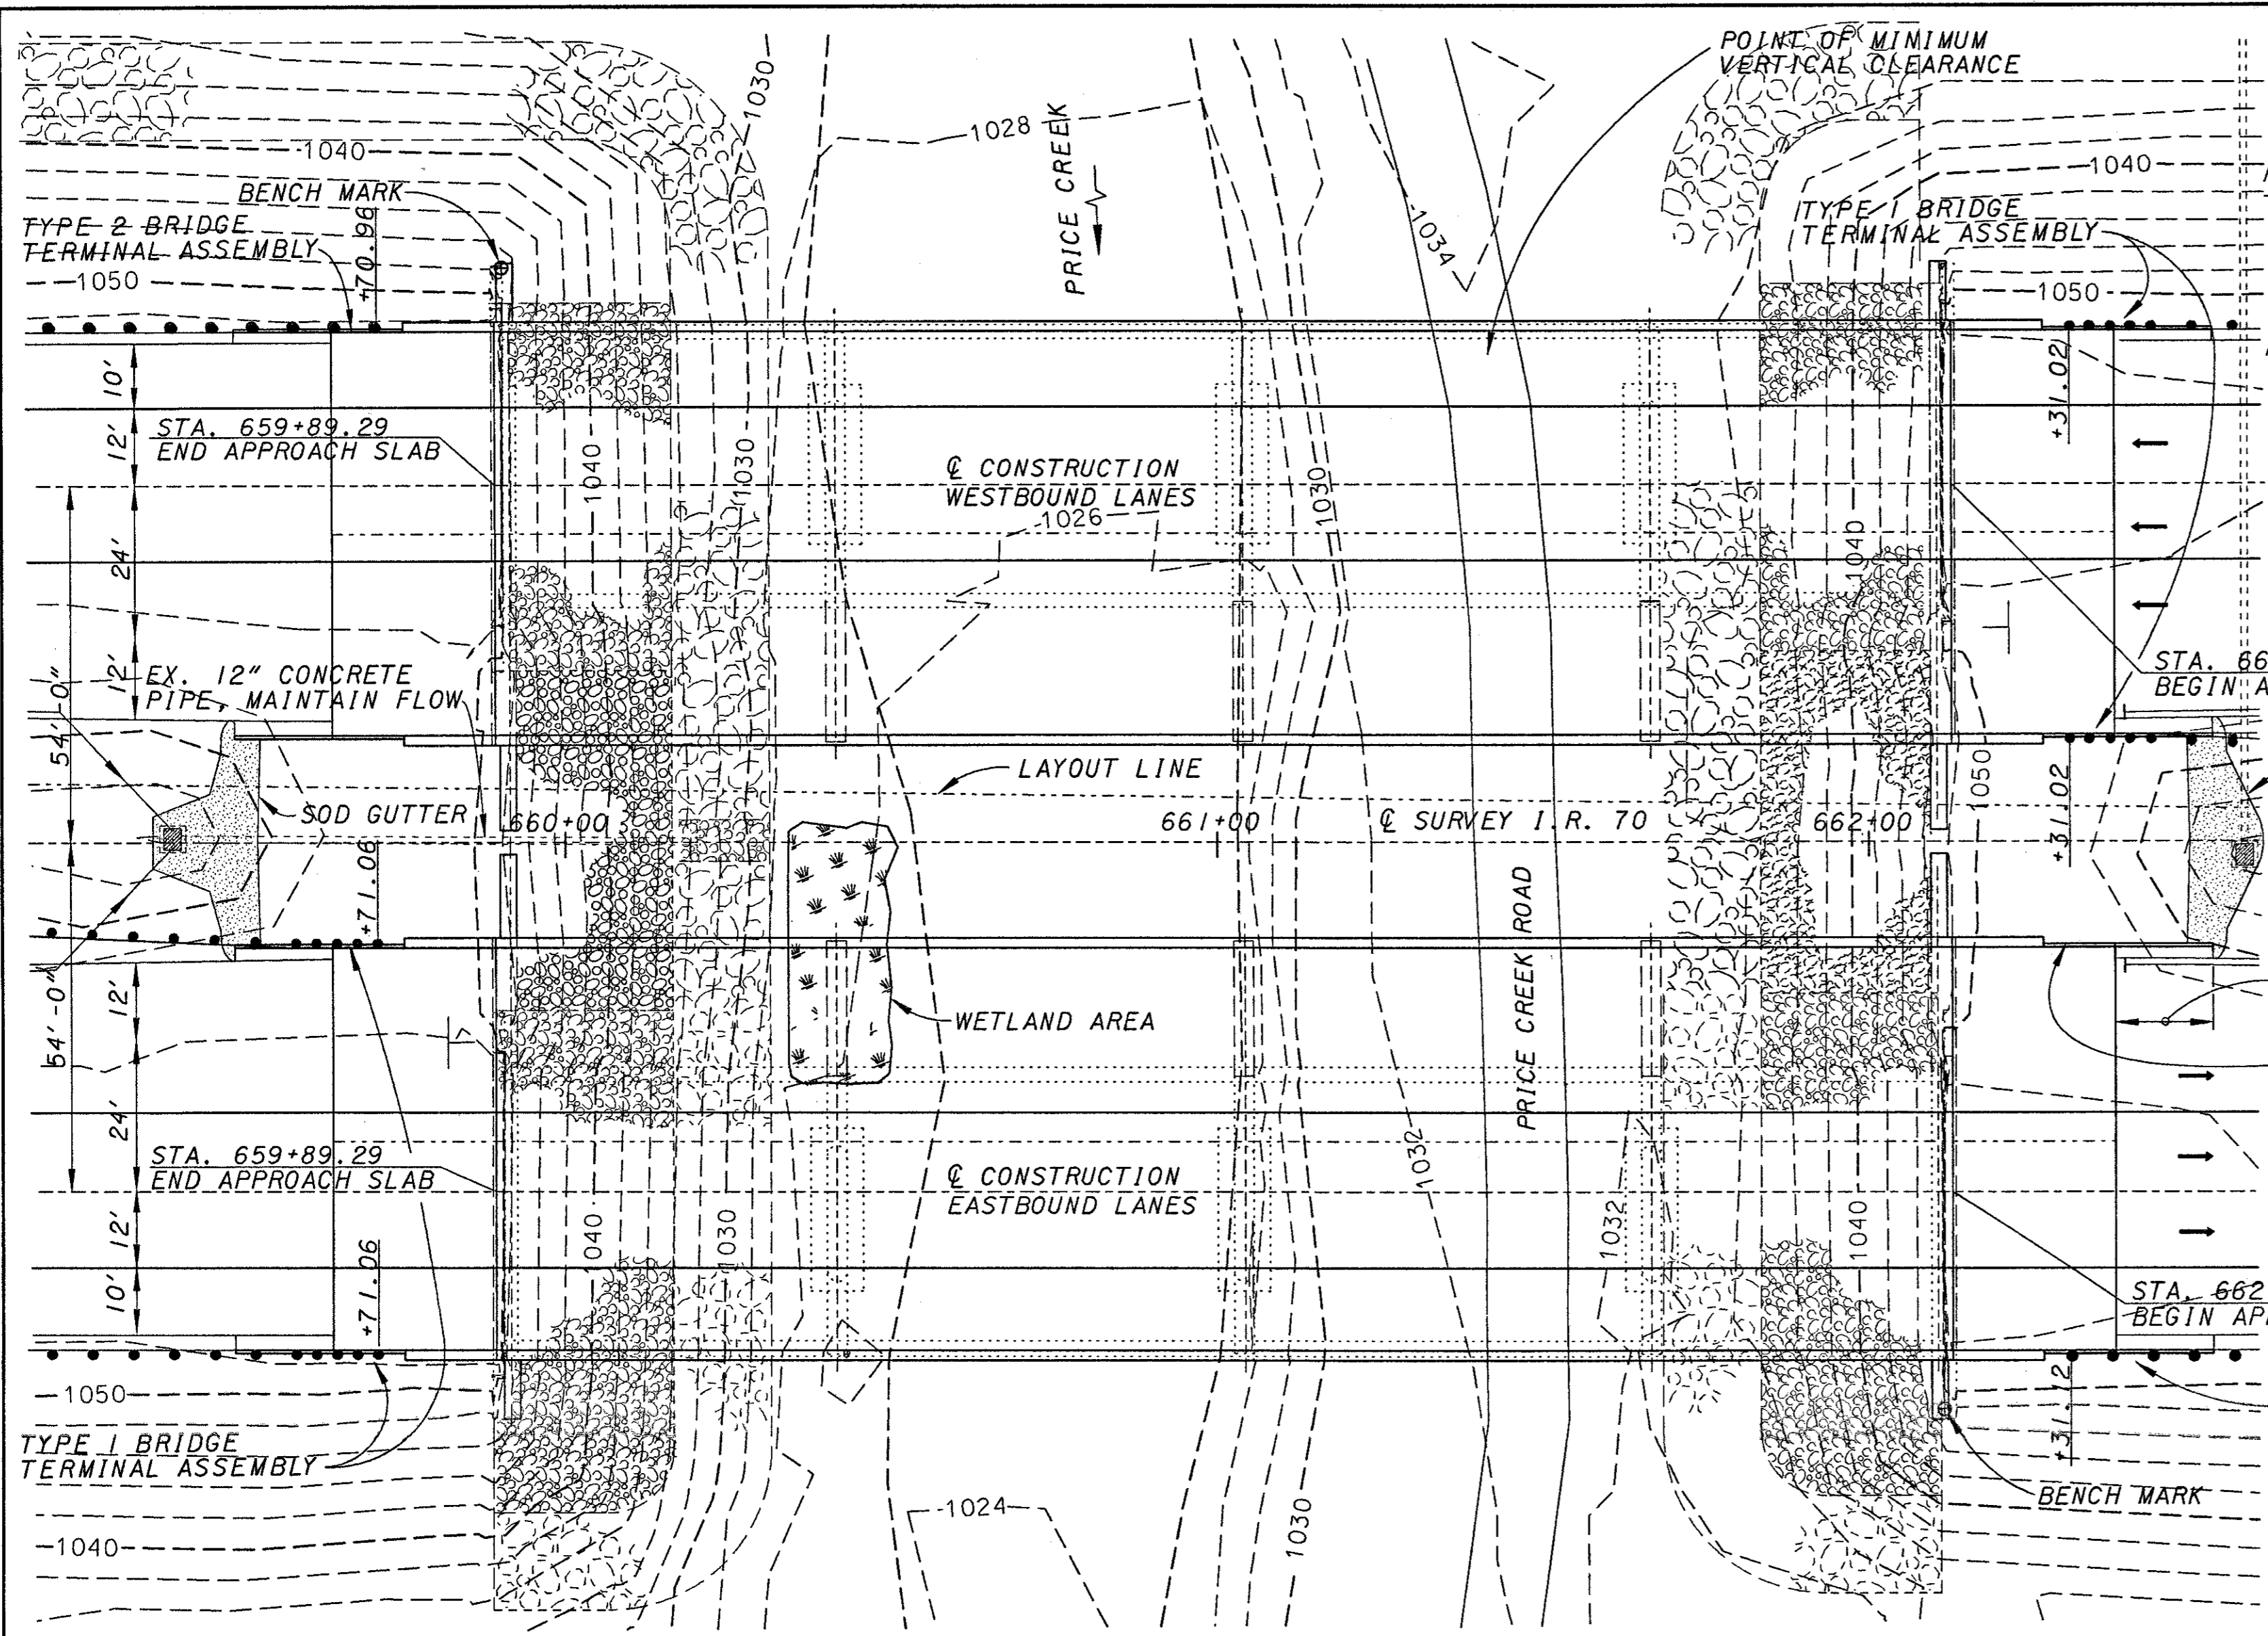


PLAN EARTHWORK LIMITS SHOWN ARE APPROXIMATE. ACTUAL SLOPES SHALL CONFORM TO PLAN CROSS SECTIONS.

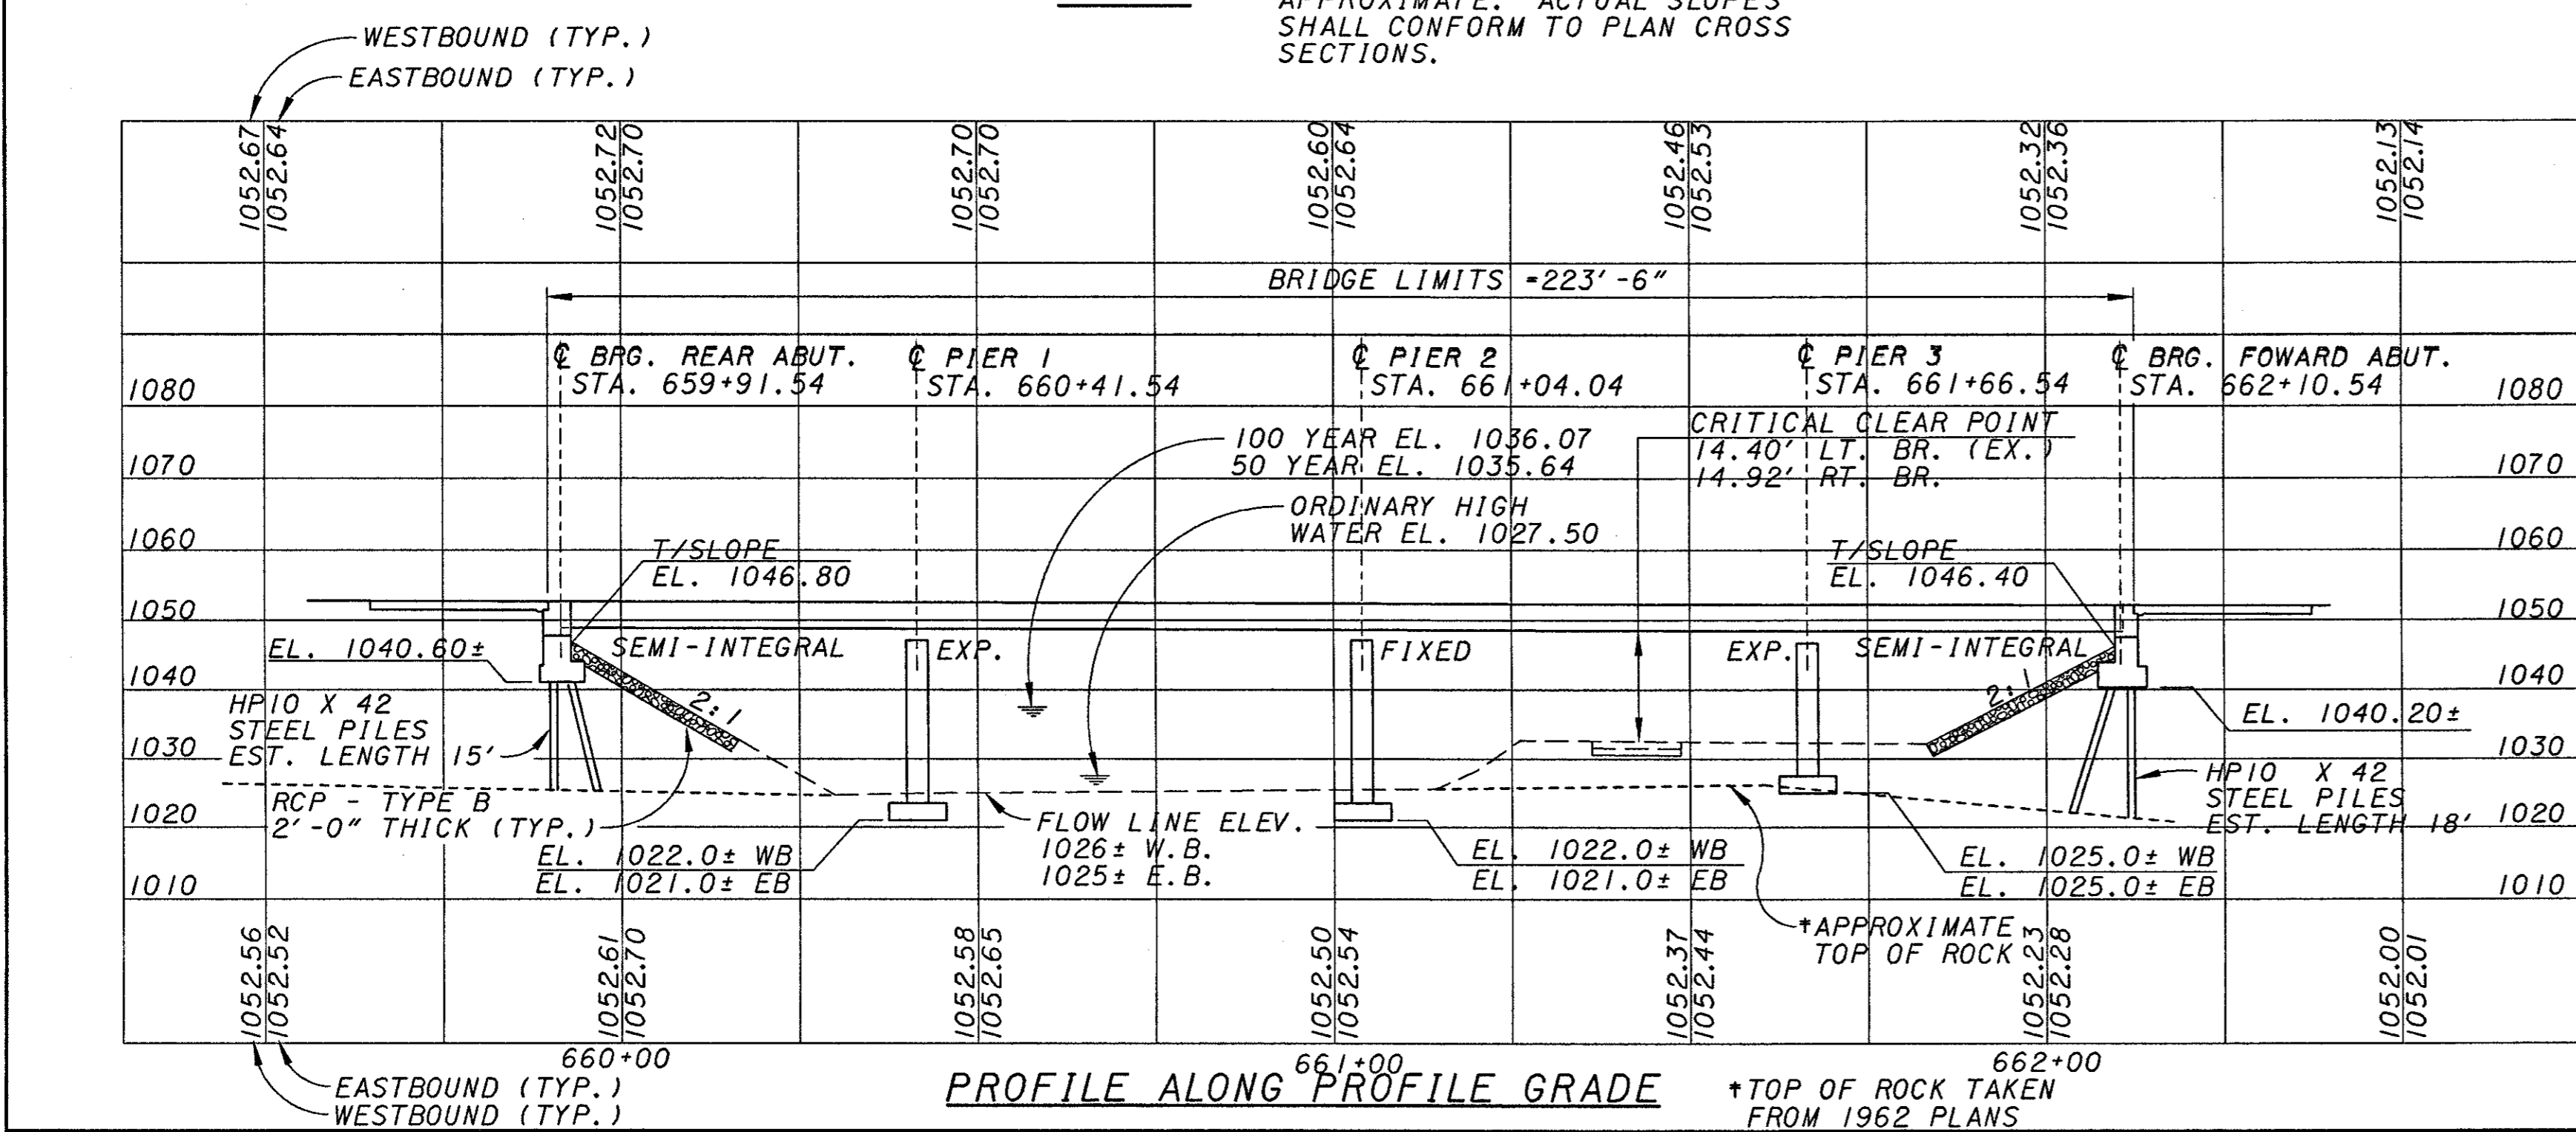

PROFILE ALONG PROFILE GRADE *TOP OF ROCK TAKEN FROM 1962 PLANS

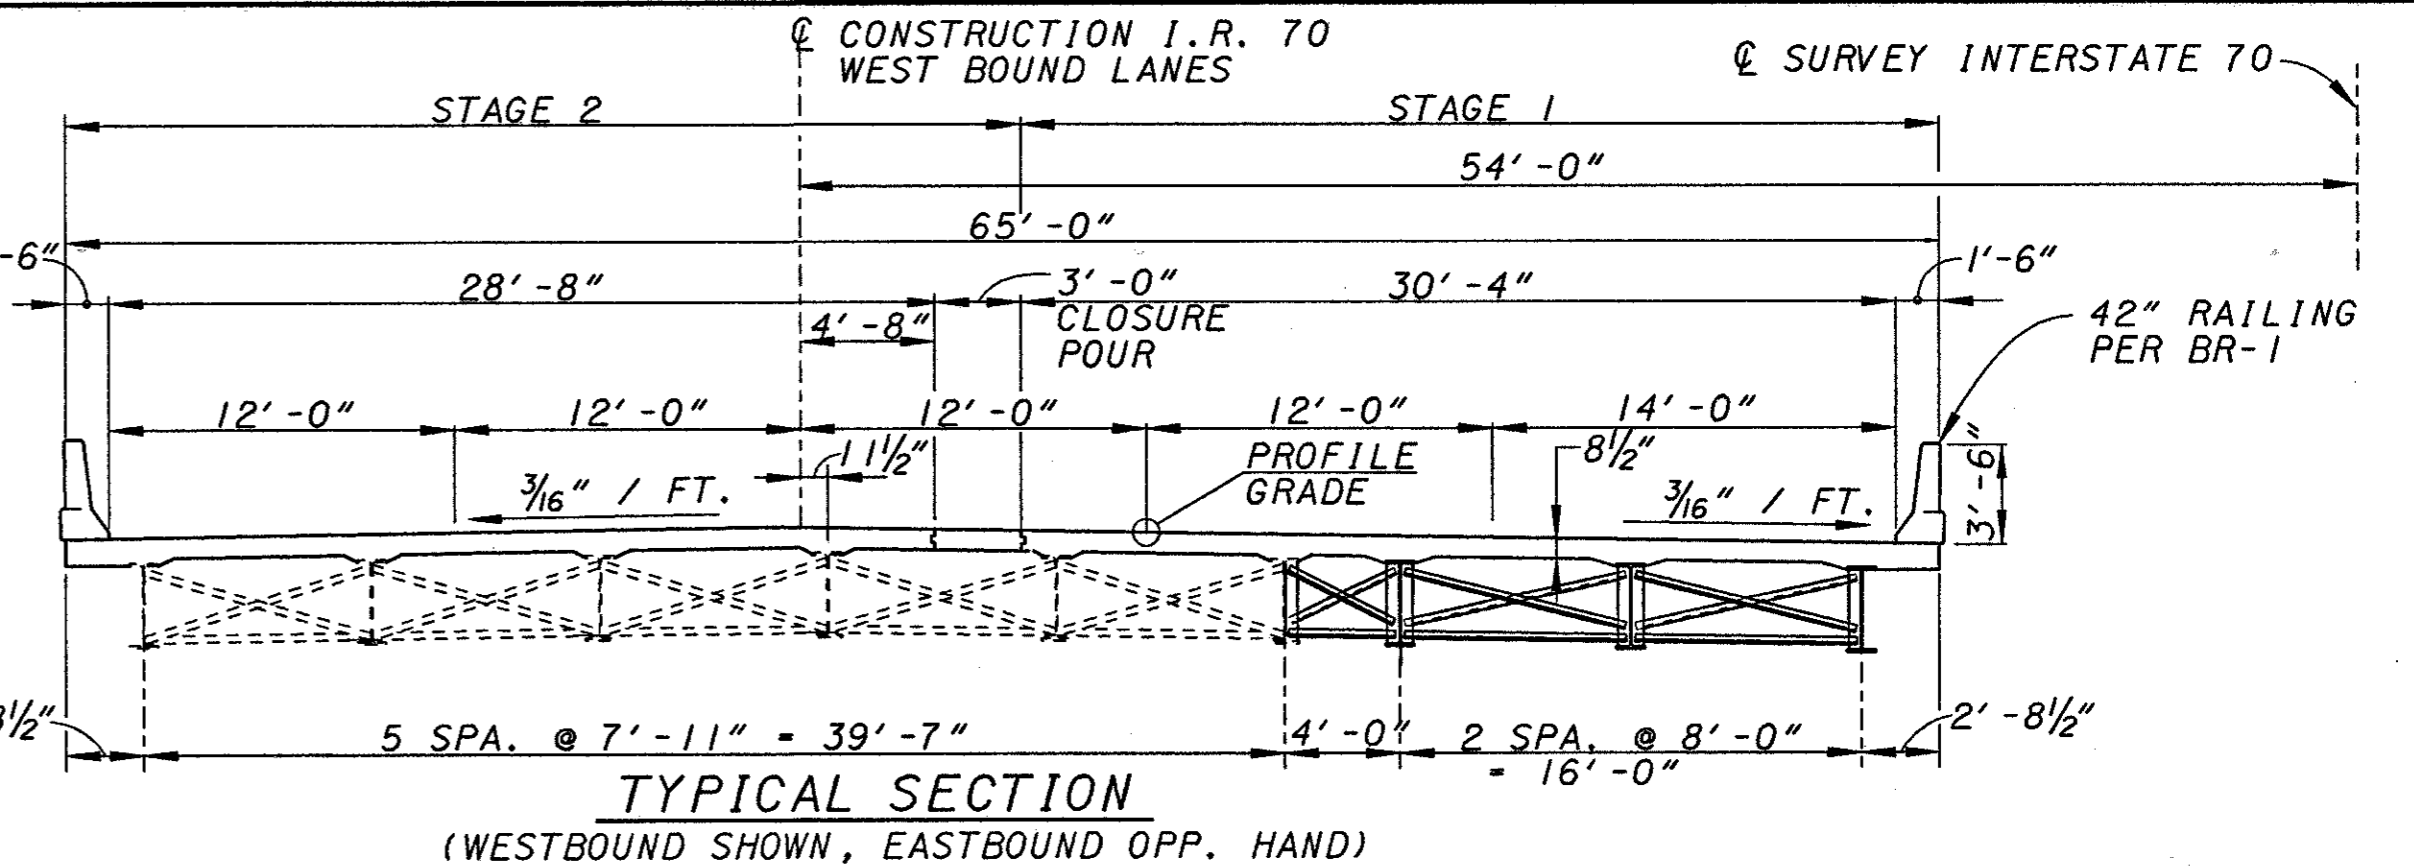

TYPICAL SECTION
(WESTBOUND SHOWN, EASTBOUND OPP. HAND)

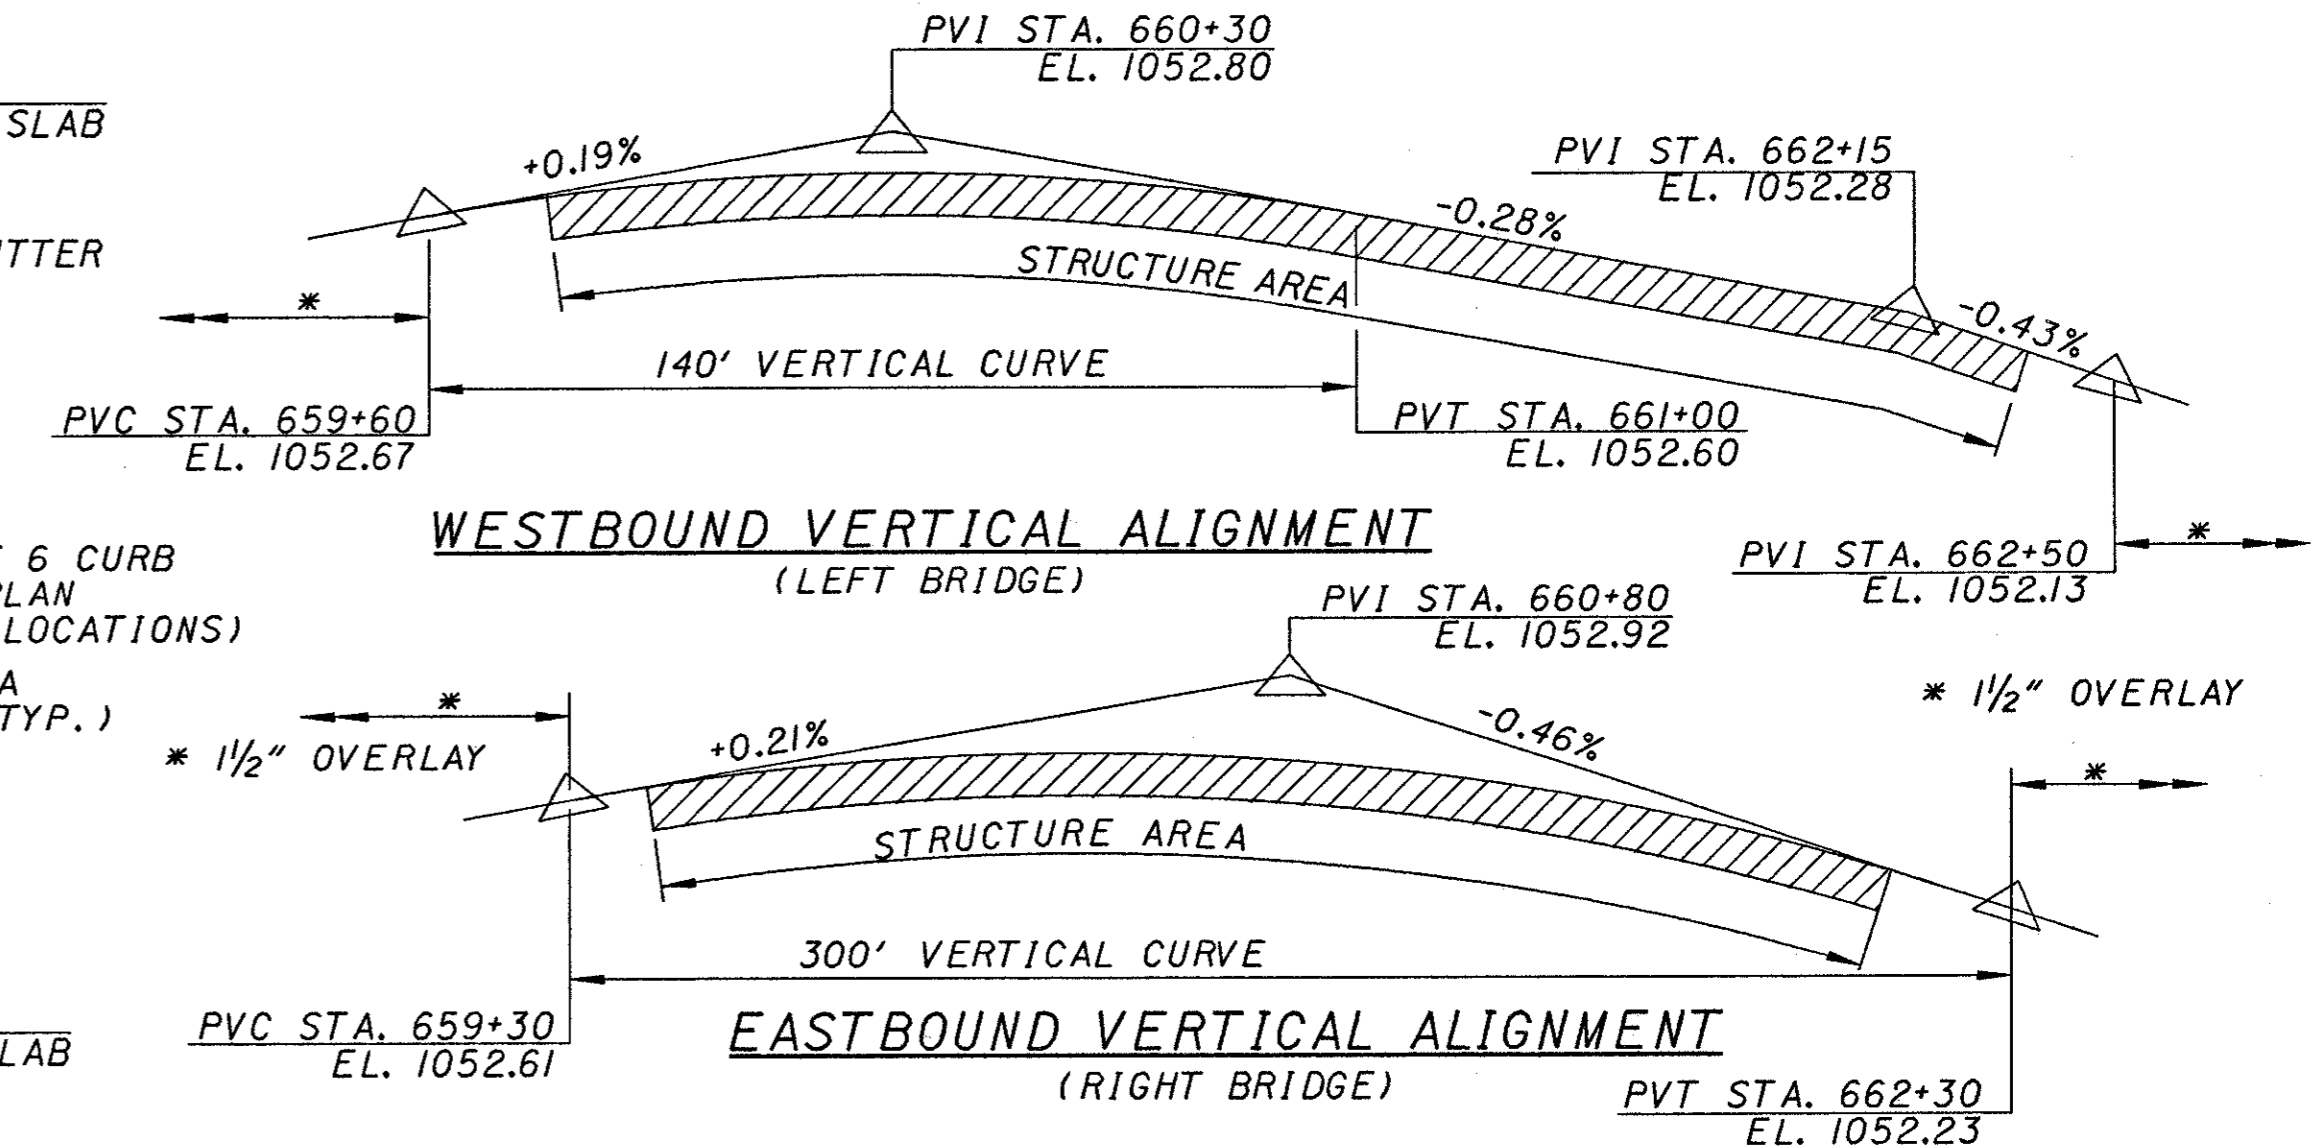

WESTBOUND VERTICAL ALIGNMENT
(LEFT BRIDGE)

EASTBOUND VERTICAL ALIGNMENT
(RIGHT BRIDGE)

TRAFFIC DATA	
ADT (2001) = 35,860	ADTT (2021) = 19,812
ADT (2021) = 50,800	SOURCE = ODOT

BENCH MARK	
BOX NOTCH ON S.E. ABUTMENT EASTBOUND AT STA. 662+12±, 85' RT. AT ELEVATION 1051.95	
BOX NOTCH ON N.W. ABUTMENT WESTBOUND AT STA. 659+90±, 85' LT. AT ELEVATION 1052.36	

DRAINAGE DATA	
DRAINAGE AREA: 18.6 SQ. MILES	LOW CHORD ELEVATION: 1048.30
EXISTING BRIDGE OPENING: 3470 Sq. Ft.	TOP OF DECK ELEVATION: 1052.3 TO 1052.7
PROPOSED BRIDGE OPENING: 3470 Sq. Ft.	
HW100: 1036.07	
HW50: 1035.64	
Q100: 4050 C.F.S.	
Q50: 3610 C.F.S.	
V100: 11.61 F.P.S.	
V50: 11.55 F.P.S.	

EXISTING STRUCTURE - I.R. 70

TYPE: CONTINUOUS STEEL BEAM "PAINTED" WITH REINFORCED CONCRETE DECK, REINFORCED CONCRETE PIERS AND ABUTMENTS.

LENGTH OF SPANS: 50'-0"±, 62'-6"±, 62'-6"±, 44'-0"±

ROADWAY WIDTH: 39'-8"± TOE/TOE BARRIER

DESIGN LOADING: C.F. 2000

SKEW ANGLE: NONE

SUPERELEVATION: NONE - NORMAL CROWN

WEARING SURFACE: 1" MONOLITHIC CONCRETE

ALIGNMENT: TANGENT

YEAR BUILT: 1962

PROPOSED STRUCTURE

PROPOSED WORK: NEW COMPOSITE REINFORCED CONCRETE DECK WITH ADDITIONAL BEAMS ON WIDENED SUBSTRUCTURE

TYPE: CONTINUOUS STEEL BEAM "A709-50 PAINTED" WITH COMPOSITE REINFORCED CONCRETE DECK, SEMI-INTEGRAL REINFORCED CONCRETE ABUTMENTS AND REINFORCED CONCRETE "T" TYPE PIERS.

LENGTH OF SPANS: 50'-0"±, 62'-6"±, 62'-6"±, 44'-0"±

ROADWAY WIDTH: 62'-0"± TOE/TOE BARRIER

DESIGN LOADING: HS-20 WITH ALTERNATE MILITARY LOADING, CASE 1

SKEW ANGLE: NONE

SUPERELEVATION: NONE - NORMAL CROWN

WEARING SURFACE: 1" MONOLITHIC CONCRETE

APPROACH SLAB: AS-1-81 (25' LONG)

ALIGNMENT: TANGENT

LATITUDE: N 39°50'10"

LONGITUDE: W 84°34'51"

KZF DESIGN
DESIGN AGENCY
10000 W. 100th St., Suite 100, Overland Park, KS 66204
TEL: 913.881.8811 FAX: 913.881.8800 WEB: www.kzf.com

DATE: 09/20/00
REVIEWED: DCK
DRAWN: JDG
DESIGNED: SJA
CHECKED: WBS

PREBLE COUNTY
STA 659+89.74
STA 662+13.24

KZF #13



S I T E P L A N
BRIDGE NO. PRE-70-1249
I.R. 70 OVER PRICE CREEK

PRE-70-0.00

1/27

185
283

REVISIONS:
 NO. DATE BY
 1 09/20/00 JWG
 2 09/20/00 JWG
 3 09/20/00 JWG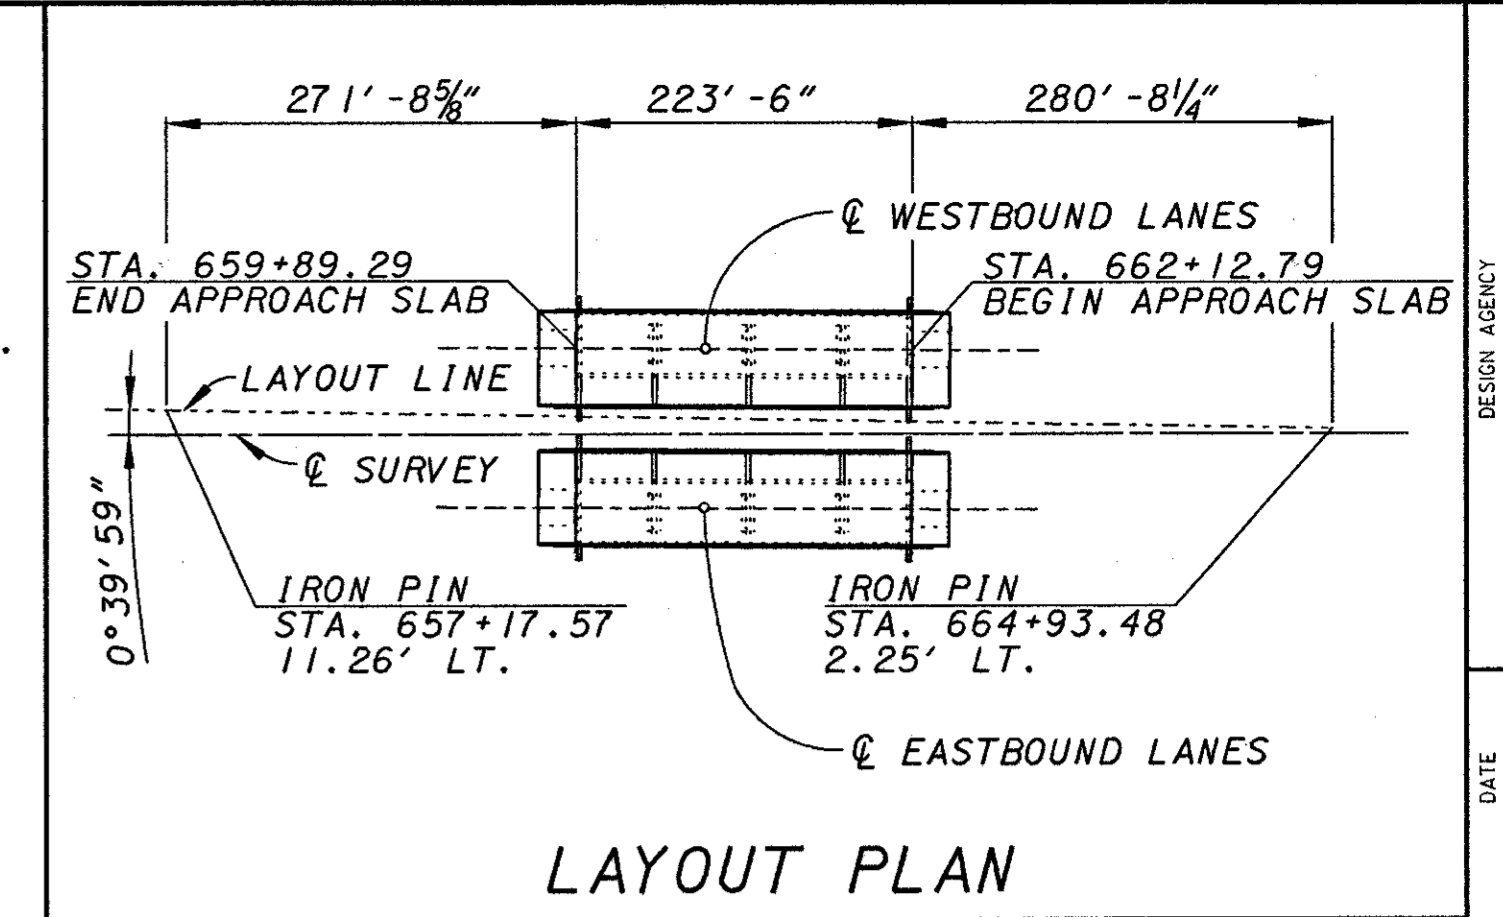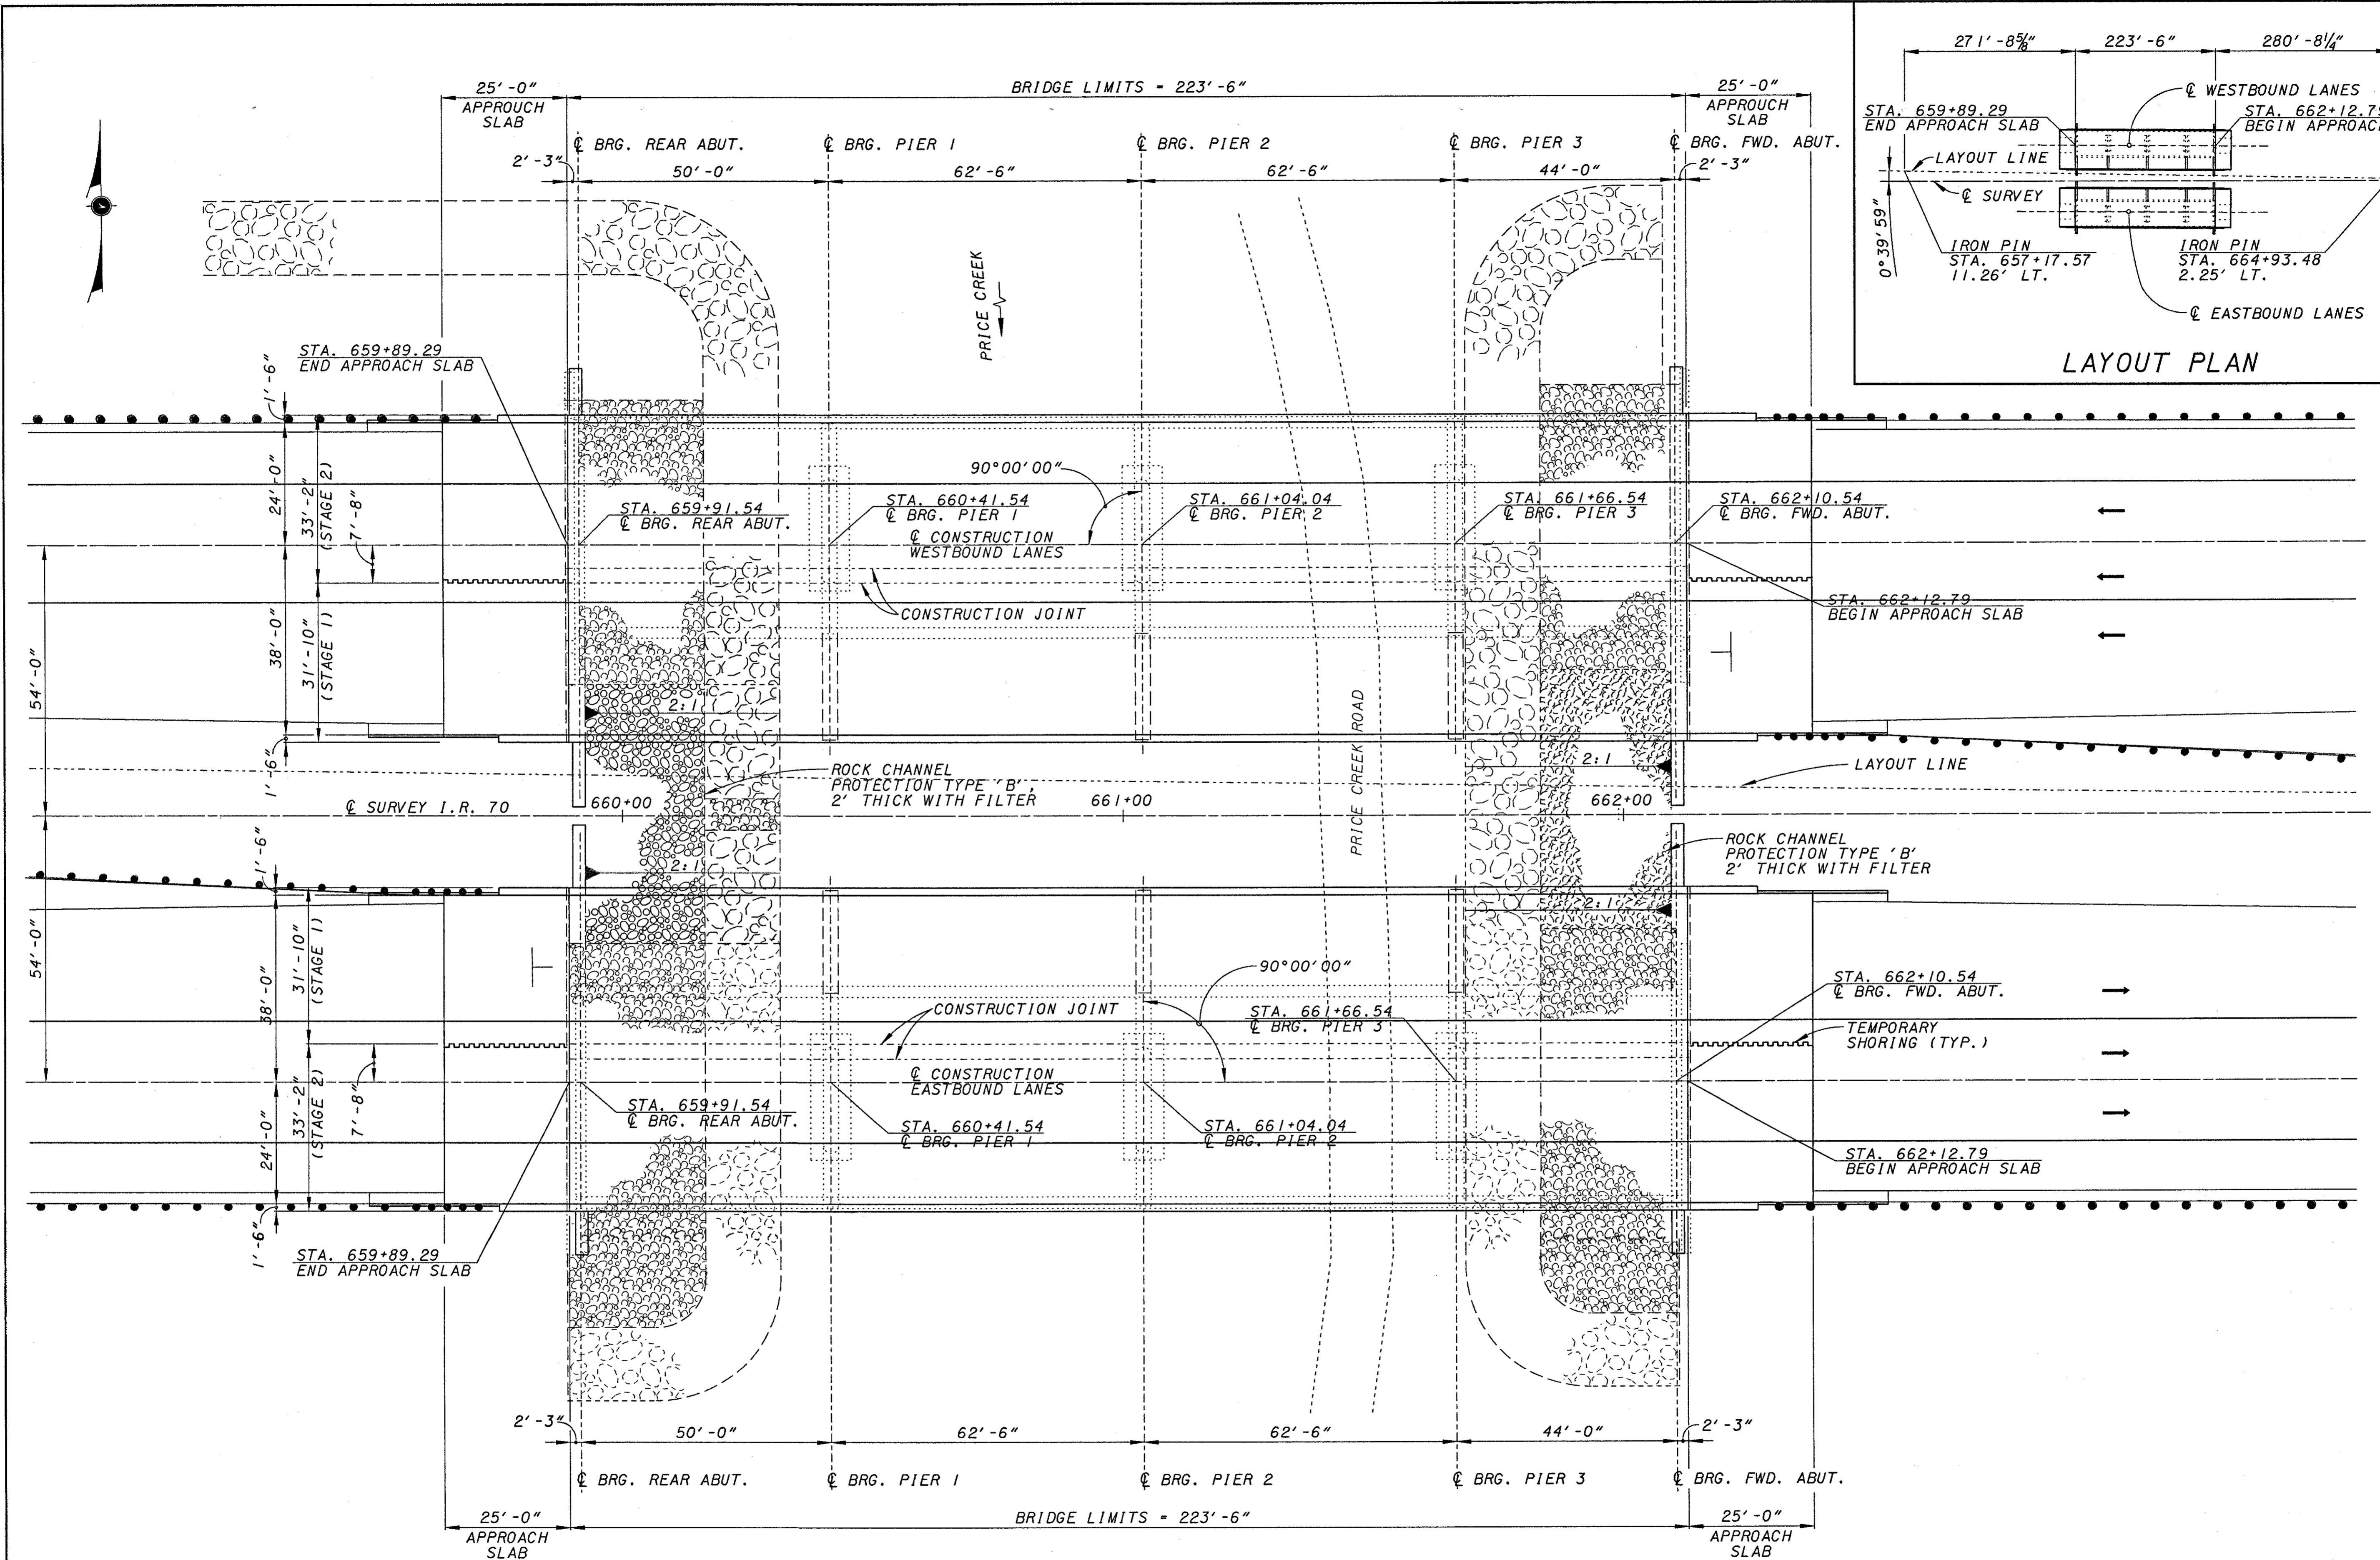
PLAN

DESIGN AGENCY: **KZF DESIGN**
 ARCHITECTURE | ENGINEERING | PLANNING
 KZF DESIGN INC. 800 East Olive Avenue, Suite 200
 Fort Worth, TX 76102-1000
 TEL: 817.335.1000 FAX: 817.335.1000

DESIGNED	SJA	CHECKED	WBS
DRAWN	JDG	REVIEWED	
DATE	09/20/00	STRUCTURE FILE NUMBER	6801269/6801293
REVIEWED	DGK		

GENERAL PLAN
 BRIDGE NO. PRE-70-1249 L/R
 I.R. 70 OVER PRICE CREEK

PRE-70-0.00

2 / 27

186
 283

REFERENCE: SHALL BE MADE TO STANDARD DRAWINGS :

AS-1-81 REVISED 09-15-94 (SHEETS 1,2 & 3)
BR-1 REVISED 1-6-99
BS-1-93 DATED 12-19-94
GSD-1-96M DATED 2-12-97
RB-1-55 REVISED 2-2-59
SICD-1-96M DATED 2-12-97

AND TO SUPPLEMENTAL SPECIFICATION:

815 DATED 5/30/96
816 DATED 4/21/97
842 DATED 1/6/99
844 DATED 1/6/99
846 DATED 9/9/97
899 DATED 10/21/98
910 DATED 7/28/98
911 DATED 7/10/97
954 DATED 9/9/97

DESIGN SPECIFICATIONS: THIS STRUCTURE CONFORMS TO "STANDARD SPECIFICATIONS FOR HIGHWAY BRIDGES" ADOPTED BY THE AMERICAN ASSOCIATION OF STATE HIGHWAY AND TRANSPORTATION OFFICIALS, 1996, INCLUDING THE 1997, 1998 AND 1999 INTERIM SPECIFICATIONS AND THE ODOT BRIDGE DESIGN MANUAL.

DESIGN LOADING: HS20-44, CASE 1 AND THE ALTERNATE MILITARY LOADING.

DESIGN STRESSES:

CLASS S CONCRETE - COMPRESSIVE STRENGTH 4500 PSI (28-DAY) (SUPERSTRUCTURE)
CLASS C CONCRETE - COMPRESSIVE STRENGTH 4000 PSI (28-DAY) (SUBSTRUCTURE)
STRUCTURAL STEEL - ASTM A572/A709 GRADE 50 - YIELD STRENGTH 50,000 PSI
REINFORCING STEEL - ASTM A615, A616 OR A617. EPOXY COATED GRADE 60 - MINIMUM YIELD STRENGTH 60,000 PSI.

DECK PROTECTION METHOD: EPOXY COATED REINFORCING STEEL, SEALING OF CONCRETE SURFACES, CLASS S CONCRETE AND 2 1/2" CONCRETE COVER.

MONOLITHIC WEARING SURFACE: IS ASSUMED, FOR DESIGN PURPOSES, TO BE 1" THICK.

REINFORCING BAR SPLICES: REINFORCING BAR SPLICE LENGTHS SHALL CONFORM TO THE MINIMUM LENGTHS SPECIFIED BY 509.08 OF THE C.M.S. UNLESS OTHERWISE NOTED ON THE PLANS.

UTILITY LINES: ALL EXPENSE INVOLVED IN RELOCATION OF THE AFFECTED UTILITY LINES SHALL BE BORNE BY THE UTILITY. THE CONTRACTOR AND UTILITY ARE TO COOPERATE BY ARRANGING THEIR WORK IN SUCH A MANNER THAT INCONVENIENCE TO EITHER WILL BE HELD TO A MINIMUM.

PROPOSED WORK

- 1. REMOVE EXISTING CONCRETE DECK, PARAPETS, SCUPPERS, APPROACH SLABS AND PORTIONS OF CONCRETE SUBSTRUCTURES IN A SEQUENCE CONSISTENT WITH MAINTENANCE OF TRAFFIC PLANS AND NOTES AND STAGE CONSTRUCTION.
2. INSTALL PILING AND CONSTRUCT ABUTMENT AND PIER WIDENING.
3. INSTALL NEW BEAMS AND CONSTRUCT A NEW CONCRETE DECK AT ELEVATIONS TO MEET PROPOSED OVERLAY ON EXISTING ROADWAY APPROACHES.
4. CONSTRUCT NEW CONCRETE APPROACH SLABS.
5. CONSTRUCT NEW CONCRETE BARRIERS ON DECK AND APPROACH SLABS.
6. PATCH CONCRETE SUBSTRUCTURES AS DIRECTED.
7. CLEAN AND SEAL CONCRETE BARRIERS, ABUTMENTS AND PIERS.
8. PAINT EXISTING STRUCTURAL STEEL WITH SYSTEM OZEU.
9. PAINT NEW STRUCTURAL STEEL WITH SYSTEM IZEU.

PILES DRIVEN TO BEDROCK: PILES FOR THE ABUTMENTS DRIVEN TO REFUSAL ON BEDROCK. REFUSAL SHALL BE CONSIDERED AS OBTAINED BY PENETRATING SOFT BEDROCK FOR SEVERAL INCHES WITH A MINIMUM RESISTANCE OF 20 BLOWS PER INCH OR REFUSAL SHALL BE CONSIDERED AS OBTAINED AFTER THE PILE HAS CONTACTED HARD BEDROCK AND THE PILE HAS THEN RECEIVED AT LEAST 20 BLOWS.

FOUNDATION BEARING PRESSURE

PIER FOOTINGS, AS DESIGNED, PRODUCE A MAXIMUM BEARING PRESSURE OF 3.8 TONS PER SQUARE FOOT. THE ALLOWABLE BEARING PRESSURE IS 5 TONS PER SQUARE FOOT.

PILE DESIGN LOADS

THE ULTIMATE BEARING VALUE IS 88 TONS PER PILE FOR THE ABUTMENT PILES.

ITEM 202 - PORTIONS OF STRUCTURE REMOVED, AS PER PLAN

DESCRIPTION: THIS WORK SHALL CONSIST OF THE REMOVAL OF CONCRETE DECKS INCLUDING PARAPETS AND OTHER APPURTENANCES. PORTIONS OF THE ABUTMENTS SHALL ALSO BE REMOVED AS SHOWN ON THE PLANS. CARE SHALL BE TAKEN DURING REMOVALS TO PROTECT PORTIONS OF THE EXISTING STRUCTURE THAT ARE TO BE SALVAGED AND INCORPORATED INTO THE PROPOSED STRUCTURE. IN THIS RESPECT, THE USE OF EXPLOSIVES, HEADACHE BALLS AND/OR HOE-RAM TYPE OF EQUIPMENT IS PROHIBITED. ALL REMOVALS SHALL BE CONSISTENT WITH THE STAGE CONSTRUCTION REQUIREMENTS. EVERY EFFORT SHALL BE MADE TO KEEP DECK MATERIALS OUT OF THE STREAM CHANNEL. IF ANY MATERIAL FALLS INTO THE WATER, THE MATERIAL SHALL BE REMOVED IMMEDIATELY. ALL CONSTRUCTION DEBRIS AND OR EXCESS FILL MATERIAL SHALL BE DISPOSED AT AN ENGINEER APPROVED UPLAND SITE. (A DISPOSAL SITE LOCATED ABOVE THE 100-YEAR FLOOD PLAIN.) ALL WORK SHALL BE PERFORMED TO THE SATISFACTION OF THE ENGINEER.

PROTECTION OF TRAFFIC: PRIOR TO DEMOLITION OF ANY PORTIONS OF THE EXISTING SUPERSTRUCTURE, THE CONTRACTOR SHALL SUBMIT HIS PLANS FOR THE PROTECTION OF TRAFFIC (VEHICULAR, BOAT, ETC.) ADJACENT TO AND/OR UNDER THE STRUCTURE TO THE DIRECTOR FOR APPROVAL. THESE PLANS SHALL INCLUDE PROVISIONS FOR ANY DEVICES AND STRUCTURES THAT MAY BE NECESSARY TO ENSURE SUCH PROTECTION. TEMPORARY VERTICAL CLEARANCES SPECIFIED ON THE PLANS OR IN THE PROPOSAL SHALL BE MAINTAINED AT ALL TIMES EXCEPT AS OTHERWISE APPROVED BY THE DIRECTOR.

PROTECTION OF STEEL SUPPORT SYSTEMS: BEFORE DECK SLAB CUTTING IS PERMITTED, THE OUTLINE OF PRIMARY STEEL MEMBERS IN CONTACT WITH THE BOTTOM OF THE DECK SHALL BE DRAWN ON THE SURFACE OF DECK. SMALL DIAMETER PILOT HOLES SHALL BE DRILLED 2 INCHES OUTSIDE THESE LINES TO CONFIRM THE LOCATION OF FLANGE EDGES. DECK CUTS OVER OR WITHIN 2 INCHES OF FLANGE EDGES SHALL NOT EXTEND LOWER THAN THE BOTTOM LAYER OF DECK SLAB REINFORCING STEEL. CUTS MADE OUTSIDE 2 INCHES OF FLANGE EDGES MAY EXTEND THE FULL DEPTH OF THE DECK. DURING CUTTING OF THE DECK SLAB, CARE SHALL BE TAKEN NOT TO DAMAGE STEEL MEMBERS THAT ARE TO BE INCORPORATED INTO THE PROPOSED STRUCTURE.

REMOVAL METHODS: CONCRETE MAY BE REMOVED BY CUTTING AND BY MEANS OF HAND OPERATED PNEUMATIC HAMMERS EMPLOYING POINTED OR BLUNTED CHISEL TYPE TOOLS. FOR REMOVALS, A HAMMER HEAVIER THAN 35 POUNDS BUT NOT TO EXCEED 90 POUNDS MAY BE USED AT THE APPROVAL OF THE ENGINEER, TO ENSURE ADEQUATE DEPTH CONTROL AND TO PREVENT DAMAGE TO CONCRETE SUBSTRUCTURES.

SUBSTRUCTURE CONCRETE REMOVAL SHALL BE BY MEANS OF APPROVED PNEUMATIC HAMMERS EMPLOYING POINTED AND BLUNT CHISEL TOOLS. HYDRAULIC HOE-RAM TYPE HAMMERS WILL NOT BE PERMITTED. THE WEIGHT OF THE HAMMER SHALL NOT BE MORE THAN 35 POUNDS FOR REMOVAL WITHIN 18 INCHES OF PORTIONS TO BE PRESERVED. OUTSIDE THE 18 INCH LIMIT, A HAMMER HEAVIER THAN 35 POUNDS, BUT NOT TO EXCEED 90 POUNDS MAY BE USED AT THE APPROVAL OF THE ENGINEER. PNEUMATIC HAMMERS SHALL NOT BE PLACED IN DIRECT CONTACT WITH REINFORCING STEEL THAT IS TO BE RETAINED IN THE REBUILT STRUCTURE.

REPLACEMENT OF EXISTING REINFORCING STEEL: ANY EXISTING REINFORCING BARS WHICH ARE TO BE INCORPORATED INTO THE NEW WORK AND WHICH ARE MADE UNUSABLE BY THE CONTRACTOR'S CONCRETE REMOVAL OPERATIONS SHALL BE REPLACED WITH NEW STEEL AT HIS COST. ANY EXISTING REINFORCING BARS WHICH ARE DEEMED BY THE ENGINEER TO BE UNUSABLE BECAUSE OF CORROSION SHALL BE REPLACED WITH NEW REINFORCING STEEL.

EXISTING STRUCTURE VERIFICATION: DETAILS AND DIMENSIONS SHOWN ON THESE PLANS PERTAINING TO THE EXISTING STRUCTURE HAVE BEEN OBTAINED FROM PLANS OF THE EXISTING STRUCTURE AND/OR FROM FIELD OBSERVATIONS AND MEASUREMENTS. CONSEQUENTLY, THEY ARE INDICATIVE OF THE EXISTING STRUCTURE AND THE PROPOSED WORK BUT THEY SHALL BE CONSIDERED TENTATIVE AND APPROXIMATE. THE CONTRACTOR IS REFERRED TO CMS SECTIONS 105.02 AND 513.02.

EXISTING STRUCTURE PLANS:

THE ORIGINAL DESIGN PLANS MAY BE EXAMINED AT THE DEPARTMENT OF TRANSPORTATION, DISTRICT 8 OFFICE, 505 SOUTH S.R. 741 LEBANON, OHIO 45036 (800) 831-2142. THE CONTRACTOR SHALL BECOME FAMILIAR WITH THESE DRAWINGS.

INSPECTION OF STRUCTURAL STEEL:

THE ENGINEER SHALL VISUALLY INSPECT ALL EXISTING BUTT-WELDED SPLICES AND/OR TOP FLANGE COVER PLATE FILLET WELDS TO ENSURE THAT THEY ARE FREE OF DEFECTS. THE DECK SLAB HAUNCH FORMS IMMEDIATELY ADJACENT TO SUCH WELDS SHALL NOT BE ERECTED UNTIL THE ENGINEER HAS COMPLETED THIS INSPECTION. THIS INSPECTION SHALL NOT TAKE PLACE UNTIL AFTER THE TOP FLANGES ARE CLEANED AS SPECIFIED IN 511.08, BUT SHALL BE DONE BEFORE THE DECK SLAB REINFORCEMENT IS INSTALLED.

CUT LINE CONSTRUCTION JOINT PREPARATION: SAW CUT BOUNDARIES OF PROPOSED CONCRETE REMOVALS 1 INCH DEEP. REMOVE CONCRETE TO A ROUGH SURFACE. WHERE PRACTICABLE, THE EXISTING REINFORCING STEEL WHERE REQUIRED IN THE PLANS SHALL BE LEFT IN PLACE. INSTALL DOWEL BARS IF SPECIFIED. PRIOR TO CONCRETE PLACEMENT ABRASIVELY CLEAN JOINT SURFACE AND EXPOSED REINFORCEMENT TO REMOVE LOOSE AND DISINTEGRATED CONCRETE AND LOOSE RUST. THE JOINT SURFACE AND EXPOSED REINFORCEMENT SHALL BE THOROUGHLY CLEANED OF ALL DIRT, DUST, OR OTHER FOREIGN MATERIAL BY THE USE OF WATER, AIR UNDER PRESSURE, OR OTHER METHODS THAT PRODUCE SATISFACTORY RESULTS. CONCRETE BONDING SURFACES SHALL BE WET WITHOUT FREE WATER AS CONCRETE IS PLACED.

EXTRANEIOUS MEMBERS: EXISTING EXTRANEIOUS MEMBERS (I.E., FINISHING MACHINE AND FORM SUPPORTS, ETC.), AND THE SUPPORT FOR SCUPPERS AND BULB ANGLES WHICH ARE TO BE REMOVED) ATTACHED BY WELDED CONNECTIONS TO PORTIONS OF THE TOP FLANGES DESIGNATED "TENSION" SHALL BE REMOVED AND THE FLANGE SURFACES GROUND SMOOTH. GRINDING SHALL BE CAREFULLY DONE AND PARALLEL TO THE FLANGES.

DECK REMOVALS: DUE TO THE POSSIBLE PRESENCE OF WELDED ATTACHMENTS TO EXISTING STRUCTURAL STEEL (FINISHING MACHINE, SCUPPER AND FORM SUPPORTS, ETC.), CARE SHALL BE TAKEN DURING DECK REMOVAL TO AVOID DAMAGING STRINGERS WHICH ARE TO REMAIN. STRINGERS DAMAGED BY THE CONTRACTOR'S REMOVAL OPERATIONS SHALL, AT NO COST TO THE PROJECT, BE REPLACED OR REPAIRED. PROPOSED REPAIRS, DEVELOPED BY A REGISTERED PROFESSIONAL ENGINEER, SHALL BE SUBMITTED IN WRITING FOR REVIEW AND APPROVAL BY THE DIRECTOR.

REF: *REF*

REF: *REF*

DATE 09/20/00
REVIEWED DCK
STRUCTURE FILE NUMBER 6801269/6801293

DRAWN JDG
DESIGNED SJA
CHECKED WBS

KZF #13

GENERAL NOTES
BRIDGE NO. PRE-70-1249 L/R
I.R. 70 OVER PRICE CREEK

PRE-70-0.00

3/27

187
283

ROCK CHANNEL PROTECTION

BROKEN CONCRETE FROM THE EXISTING BRIDGE DECK MAY BE USED FOR ROCK CHANNEL PROTECTION. MATERIAL CAN BE EITHER TYPE B OR TYPE C WITH A MINIMUM OF 50% OF THE MATERIAL BEING TYPE B.

SEAL PIER CAPS, WINGWALLS, ABUTMENTS, PARAPETS, AND DECK EDGES WITH EPOXY-URETHANE; COLOR SHALL BE FEDERAL COLOR STANDARD 17778 (OFF-WHITE)

THIS WORK SHALL CONSIST OF FURNISHING ALL NECESSARY LABOR, MATERIALS AND EQUIPMENT TO SEAL THE DESIGNATED EXPOSED CONCRETE SURFACE AREAS IN ACCORDANCE WITH THE PROJECT PROPOSAL DOCUMENT (PAGE 30) ENTITLED, ITEM SPECIAL - SEALING OF CONCRETE SURFACES

PATCH SUBSTRUCTURE CONCRETE

PATCHING SUBSTRUCTURE CONCRETE SHALL BE PERFORMED IN ACCORDANCE WITH THE STATE OF OHIO DEPARTMENT OF TRANSPORTATION CONSTRUCTION AND MATERIAL SPECIFICATIONS ITEM 519 PATCHING CONCRETE STRUCTURES. THE LOCATION AND SURFACE AREA EXTENT OF PATCHING CONCRETE STRUCTURES SHALL BE FIELD-DETERMINED BY THE ODOT PROJECT ENGINEER. THE CONTRACTOR SHALL PROVIDE THE PROJECT ENGINEER ACCESS TO CONCRETE SURFACES FOR INSPECTION. THE CONTRACTOR SHALL PROVIDE THE ENGINEER AEROSOL PAINT FOR THE PURPOSE OF MARKING SUBSTRUCTURE CONCRETE TO BE PATCHED.

ITEM 846 - TREATING CONCRETE WITH HMW RESIN

SEAL THE CONSTRUCTION JOINTS IN THE BRIDGE DECK AND APPROACH SLABS AS SHOWN IN THE PLANS. SEE SUPPLEMENTAL SPECIFICATIONS FOR SURFACE PREPARATION AND RATE OF APPLICATION.

REINFORCING CLEARANCE: UNLESS OTHERWISE NOTED, MINIMUM REINFORCING STEEL CLEARANCE TO FACE OF CONCRETE IS 2".

LOADING LIMITATION: NO PART OF THE STRUCTURE SHALL BE SUBJECTED TO UNIT STRESSES THAT EXCEED 136.5% OF THE ALLOWABLE UNIT STRESSES GIVEN IN THE AASHTO STANDARD SPECIFICATIONS FOR HIGHWAY BRIDGES DUE EITHER TO DEMOLITION, ERECTION OR CONSTRUCTION METHODS, OR TO THE USE OR MOVEMENT OF DEMOLITION OR ERECTION EQUIPMENT ON OR ACROSS THE STRUCTURE. STRUCTURAL ANALYSIS COMPUTATIONS, BY A REGISTERED PROFESSIONAL ENGINEER, SHOWING THE ALLOWABLE STRESSES AND THE MAXIMUM STRESSES PRODUCED BY THE CONTRACTOR'S METHODS OR EQUIPMENT SHALL BE SUBMITTED TO THE DIRECTOR FOR REVIEW AND APPROVAL AT LEAST TWO WEEKS PRIOR TO THE START OF THE WORK.

ENVIRONMENTAL COMMITMENTS & RESOURCES TO BE AVOIDED

THE CONTRACTOR SHALL REFER TO THE STORMWATER POLLUTION PREVENTION PLAN (SWAPP) TO ADDRESS EROSION ASSOCIATED WITH SHOULDER DISTURBANCE/ RECONSTRUCTION AND BRIDGE WORK. (CMS 877.03)

ALL CONDITIONS ATTACHED WITH C.O.E. PERMIT (NATIONWIDE 3 & 14) SHALL BE IMPLEMENTED IN THE FIELD WITH THE ACTUAL PERMIT BEING DISPLAYED ONSITE.

EVERY EFFORT SHALL BE MADE TO KEEP DEMOLITION MATERIAL OUT OF THE STREAM CHANNELS. IF ANY MATERIAL FALLS INTO THE WATER, IT SHALL BE REMOVED IMMEDIATELY. ALL DEBRIS OR EXCESS FILL MATERIAL SHOULD BE DISPOSED AT AN APPROVED UPLAND SITE. (ABOVE THE 100 YR. FLOODPLAIN)

IN-STREAM STRUCTURES SHALL BE KEPT TO THE MINIMAL SIZE NEEDED TO FACILITATE WORK AND WILL BE REMOVED IMMEDIATELY TO ORIGINAL GRADE AFTER IN-STREAM WORK IS COMPLETED.

WHILE PAINTING, SANDBLASTING OR SEALING OF ANY PORTION OF THE BRIDGE AN APPROPRIATE APRON WILL BE UTILIZED TO PREVENT DEBRIS AND PAINT OVERSPRAY AND SEALANTS FROM ENTERING INTO THE STREAM.

PROPER SEDIMENT AND EROSION CONTROLS SHALL BE IMPLEMENTED THROUGHOUT THE COURSE OF THE PROJECT. ALL DISTURBED AREAS SHALL BE SEEDED AND MULCHED IMMEDIATELY UPON COMPLETION OF EARTHWORK (ODOT CMS ITEM 877)

IMPLEMENT ODOT CMS ITEM 616, DUST CONTROL AS NECESSARY.

COMPLY WITH ODOT CMS ITEM 107.21 CONTROLLING POLLUTION OF THE ENVIRONMENT.

VEGETATION REMOVAL WILL BE HELD TO AN ABSOLUTE MINIMUM REQUIRED TO COMPLETE THE WORK.

WETLANDS EXIST WITHIN THE PROJECT AREA. ALL WETLANDS NOT DIRECTLY INVOLVED WITH BRIDGE DECK/SUBSTRUCTURE MODIFICATIONS SHALL BE AVOIDED. THE BRIDGE SITE PLANS SHOW WETLAND AREAS TO BE AVOIDED.

CLASS C CONCRETE, ABUTMENT:

GENERAL PURPOSE HEAVY DUTY NEOPRENE SHEET WITH NYLON FABRIC REINFORCEMENT AT ABUTMENTS SHALL BE INSTALLED IN ACCORDANCE WITH STANDARD DRAWING SICD-9-96M

ITEM 516 - JACKING AND TEMPORARY SUPPORT OF SUPERSTRUCTURE, AS PER PLAN

THIS ITEM SHALL CONSIST OF FURNISHING ALL NECESSARY LABOR, MATERIALS AND ALL EQUIPMENT TO RAISE OR REPOSITION ANY EXISTING STRUCTURES TO THE DIMENSIONS AND REQUIREMENTS DEFINED IN THE PROJECT PLANS

THE CONTRACTOR SHALL BE RESPONSIBLE FOR THE DESIGN, INSTALLATION AND OPERATION OF AN ADEQUATE JACKING SYSTEM, INCLUDING ANY TEMPORARY OR PERMANENT SUPPORTS NECESSARY TO PERFORM THE WORK DESCRIBED IN THE PROJECT PLANS. THREE (3) SETS OF JACKING PLANS, WHICH INCLUDE THE INFORMATION DESCRIBED IN THIS NOTE, SHALL BE SUBMITTED TO THE DIRECTOR FOR APPROVAL AT LEAST THIRTY (30) DAYS BEFORE ACTUAL WORK IS TO BEGIN. THE PLANS SHALL BE PREPARED AND STAMPED BY A REGISTERED PROFESSIONAL ENGINEER.

JACKING SUBMITTALS SHALL INCLUDE AT LEAST THE FOLLOWING:

- 1. THE SIGNATURE AND NUMBER, OR PROFESSIONAL SEAL, OF THE PROFESSIONAL ENGINEER WHO PREPARED THE SUBMITTAL.
2. CALCULATIONS AND ANALYSIS OF THE STRUCTURE TO DETERMINE AND DEFINE THE ACTUAL LOADING APPLIED AT THE CONTRACTOR'S SELECTION JACKING POINTS.
3. A DRAWING SHOWING THE PHYSICAL AND DIMENSIONAL POSITION OF THE JACKS WITH RESPECT TO THE STRUCTURE INCLUDING CLEARANCES AND CENTER OF LIFT.
4. A SCHEMATIC LAYOUT OF JACKS, CHECK VALVES, PUMPS WITH 3 WAY REACTOR VALVE, PRESSURE GAGES, FLOW CONTROL VALVES, ETC. IN ACCORDANCE WITH MANUFACTURER'S RECOMMENDATIONS. ALL JACKS FOR EACH ABUTMENT OR PIER SHALL BE CONNECTED TOGETHER. ALL JACKS AT EACH ABUTMENT OR PIER SHALL BE THE SAME SIZE.
5. ANALYSIS AND CALCULATIONS OF THE STRESSES INDUCED OR CREATED IN THE STRUCTURE AND ANY TEMPORARY OR PERMANENT SUPPORTS. DESIGN CALCULATIONS FOR ANY TEMPORARY OR PERMANENT SUPPORTS.
6. PHYSICAL DIMENSIONS, MATERIALS, AND FABRICATION DETAILS OF ANY TEMPORARY OR PERMANENT SUPPORTS. HORIZONTAL AND VERTICAL MOVEMENT RESTRAINT SHALL BE PROVIDED.
7. A STEP BY STEP PROCEDURE DETAILING ALL STEPS IN THE JACKING OPERATION.
8. METHOD OF ATTACHMENT TO STRUCTURAL MEMBERS. WELDING TO TENSION AREAS WILL NOT BE PERMITTED.

THE ENTIRE SYSTEM INCLUDING JACKS SHALL HAVE 20% MORE CAPACITY THAN REQUIRED BASED ON CALCULATED LOADS. FOR LIFTS GREATER THAN 1 INCH, JACKS SHALL HAVE LOCKING NUTS TO POSITIVELY LOCK AND SUPPORT THE STRUCTURE DURING THE LIFT.

JACKS SHALL HAVE A SWIVEL LOAD CAP, A DOMED PISTON HEAD OR SOME OTHER DEVICE TO PROTECT AGAINST THE EFFECTS OF SIDE LOAD ON THE JACK.

JACKS ALONE SHALL NOT BE USED TO SUPPORT LOADS EXCEPT DURING THE ACTUAL JACKING OPERATION. TEMPORARY SUPPORTS, BLOCKING OR OTHER METHODS APPROVED BY THE DIRECTOR SHALL BE USED.

SINGLE ACTING RAMS WITH NO OVER-TRAVEL PROTECTION SYSTEM SHALL NOT BE USED.

SPARE EQUIPMENT SHALL BE AVAILABLE ON SITE FOR THE REQUIRED STRUCTURE RAISING TO PROCEED IN THE EVENT OF A BREAKDOWN. A LIST OF SPARE EQUIPMENT SHALL BE PROVIDED TO THE ENGINEER.

AT A MINIMUM, A JACKING OPERATION SHALL LIFT ALL BEAMS AT ANY ONE ABUTMENT OR PIER SIMULTANEOUSLY. THE ONLY EXCEPTION IS THE SITUATION WHERE THE WORK INVOLVES REPLACING OR REHABILITATING INDIVIDUAL BEARINGS, NO PERMANENT SHIMMING IS REQUIRED AND THE HEIGHT OF THE LIFT SHALL NOT EXCEED 1/4 INCH.

MAXIMUM DIFFERENTIAL JACKING HEIGHT BETWEEN ANY ADJACENT ABUTMENTS OR PIERS SHALL BE 1 INCH OR LESS.

IF, DURING THE JACKING OPERATIONS, CRACKING OF THE CONCRETE SUPERSTRUCTURE, SEPARATION OF THE CONCRETE DECK FROM THE STEEL STRINGERS, OR OTHER DAMAGE TO THE STRUCTURE IS OBSERVED, THE JACKING OPERATION SHALL IMMEDIATELY CEASE AND APPROVED SUPPORTS SHALL BE INSTALLED. THE CONTRACTOR SHALL ANALYZE THE DAMAGE AND SUBMIT A METHOD OF CORRECTION TO THE ENGINEER FOR APPROVAL. ANY BEAMS THAT SEPARATE FROM THE DECK SHALL BE EPOXY INJECTED FOR THE DISTANCE OF THE SEPARATION IN ACCORDANCE WITH THE PROPOSAL NOTE "CONCRETE REPAIR BY EPOXY INJECTION." COST OF THIS EPOXY INJECTION OR OTHER REQUIRED REPAIRS SHALL BE BORNE BY THE CONTRACTOR.

THE CONTRACTOR SHALL DEMONSTRATE TO THE ENGINEER THAT THE BRIDGE BEARINGS ARE FULLY SEATED BETWEEN ALL CONTACT AREAS. IF FULL SEATING IS NOT ATTAINED, SUITABLE MEANS OF REPAIR, SUBJECT TO THE APPROVAL OF THE ENGINEER, WILL BE REQUIRED AT THE CONTRACTOR'S EXPENSE

THE JACKING OPERATION SHALL BE DIRECTED BY A PROFESSIONAL ENGINEER EMPLOYED BY THE CONTRACTOR. FAILURE TO HAVE A PROFESSIONAL ENGINEER PRESENT SHALL BE CAUSE FOR CEASING JACKING OPERATIONS.

CONCRETE PARAPETS:

AS SOON AS A CONCRETE SAW CAN BE OPERATED WITHOUT DAMAGING THE FRESHLY PLACED CONCRETE, 1/4" DEEP CONTROL JOINTS SHALL BE SAWS INTO THE PERIMETER OF THE CONCRETE PARAPET. THE SAW CUT SHALL BE MADE IN THE COMPLETE CIRCUMFERENCE OF THE PARAPET, STARTING AND ENDING AT THE ELEVATION OF THE CONCRETE DECK. THE SAWCUTS SHALL BE PLACED AT A MINIMUM OF 6 FEET AND A MAXIMUM OF 10 FEET CENTERS. THE USE OF AN EDGE GUIDE, FENCE, OR JIG IS REQUIRED TO INSURE THAT THE CUT JOINT IS STRAIGHT, TRUE, AND ALIGNED ON ALL SURFACES OF THE PARAPET. THE JOINT WIDTH SHALL BE THE WIDTH OF THE SAW BLADE, A NOMINAL WIDTH OF 1/4 INCH. THE PERIMETER OF THE DEFLECTION CONTROL JOINT SHALL BE SEALED TO A MINIMUM DEPTH OF 1" WITH A POLYURETHANE OR POLYMERIC CAULKING MATERIAL CONFORMING TO FEDERAL SPECIFICATION, TT-S-00227E. THE BOTTOM 1/2 INCH OF THE INSIDE AND OUTSIDE FACE SHOULD BE LEFT UNSEALED TO ALLOW WATER TO ESCAPE.

ASBESTOS ABATEMENT

THE CONTRACTOR SHALL CONDUCT ASBESTOS INSPECTIONS OF ALL BRIDGES SUBJECT TO RENOVATION OR DEMOLITION AS PER CHAPTER 3745-20 OF THE OHIO ADMINISTRATIVE CODE (OAC) "ASBESTOS EMISSIONS CONTROL FROM RENOVATION/DEMOLITION AND WASTE DISPOSAL OPERATION" MAY 29, 1990 UTILIZING A CERTIFIED OHIO ASBESTOS HAZARD EVALUATION SPECIALIST. SHOULD SUSPECT ASBESTOS CONTAINING MATERIAL (ACM) BE ENCOUNTERED; PERFORM BULK SAMPLING AND ANALYSIS. PREPARE A LETTER REPORT (1-2 PAGES) INCLUDING A BRIEF DISCUSSION OF THE INSPECTION AND SAMPLING METHODOLOGY, MAPPING INDICATING THE BRIDGE LOCATION AND SAMPLING LOCATIONS, AND ANALYTICAL TEST RESULTS.

THE CONTRACTOR SHALL COMPLETE AN OEPA NOTIFICATION OF DEMOLITION AND RENOVATION FORM AND SUBMIT THIS TO THE OHIO EPA AT LEAST 10 WORKING DAYS BEFORE OPERATIONS BEGIN.

AS THESE INSPECTION REPORTS AND NOTIFICATION FORMS ARE COMPLETED, COPIES SHALL BE FORWARDED TO ODOT'S ON SITE PROJECT ENGINEER.

PAYMENT OF THE ABOVE WORK SHALL BE INCLUDED IN THE LUMP SUM BID FOR EACH BRIDGE.

SHOULD ASBESTOS CONTAINING MATERIAL BE ENCOUNTERED, ALL SUSPECT MATERIALS SHALL BE REMOVED AND PROPERLY DESPOSED OF BY A CERTIFIED ASBESTOS REMOVAL CONTRACTOR IN ACCORDANCE WITH OAC 3745-20. AN INDIVIDUAL TRAINED IN THE PROVISIONS OF NESHAPS (30 CFR PART 61, SUBPART M) WILL BE ON SITE DURING THE DEMOLITION OR RENOVATION OF ANY STRUCTURE WITH ACM AND EVIDENCE THAT THE REQUIRED TRAINING HAS BEEN ACCOMPLISHED BY THIS PERSON WILL BE AVAILABLE DURING NORMAL BUSINESS HOURS.

ALL ASSOCIATED COSTS OF ASBESTOS MATERIALS TO BE REMOVED AND PROPERLY DISPOSED OF, WILL BE PAYED UNDER 'THIRD PARTY BILLING' PROVISIONS OF ODOT CHANGE ORDER POLICY 512-004(P) APPENDIX D.

REF: **REF**

REF: **REF**

DESIGN AGENCY: KZF DESIGN INC.
GENERAL NOTES: BRIDGE NO. PRE-70-1249 L/R I.R. 70 OVER PRICE CREEK
PRE-70-0.00
3A/27
188
283


REF: **REVISION**
REF: **REVISION**
DATE: 09/20/00
USER: JLD
PROJECT: BRIDGE CONSTRUCTION
DRAWING: PRE-70-0.00
ACTIVE LEVELS: 0.00, 1.00, 2.00, 99.00, 100.00

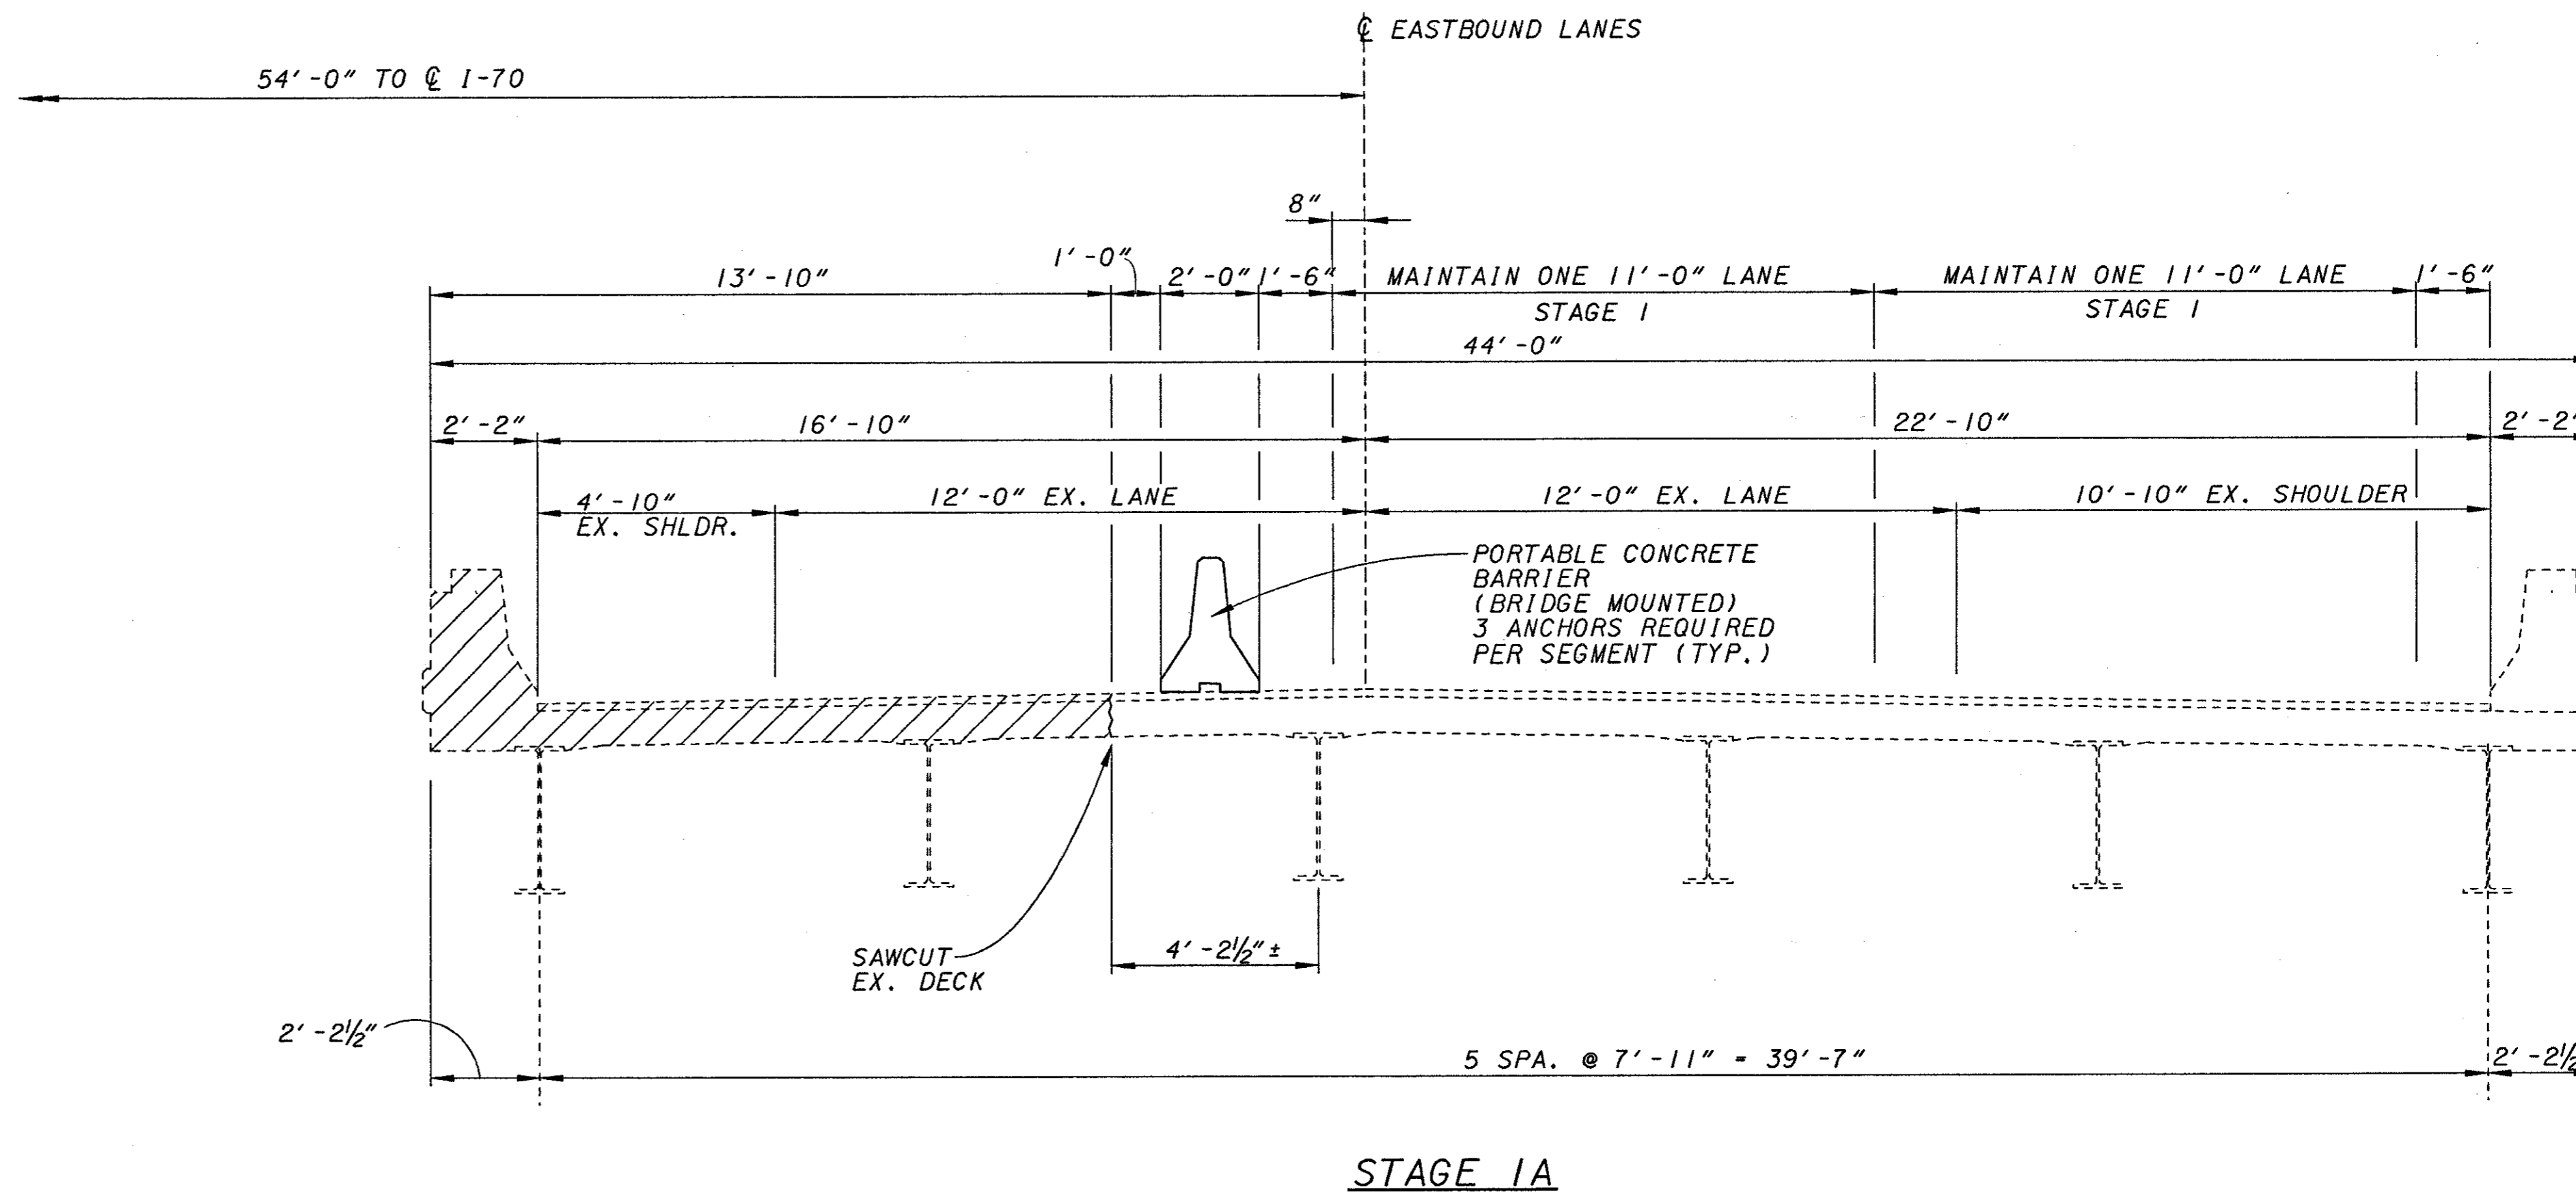

 DENOTES PORTION OF EXISTING STRUCTURE TO BE REMOVED.

NOTE:
BRIDGE FOR EASTBOUND TRAFFIC SHOWN
BRIDGE FOR WESTBOUND TRAFFIC (OPP. HAND) SIMILAR.

NOTES:
1. SEE STD. DWG. PCB-91 FOR PORTABLE CONCRETE BARRIER DETAILS AND NOTES.


REF: **REF1**
REF: **REF2**
REF: **REF3**
REF: **REF4**
REF: **REF5**
REF: **REF6**
REF: **REF7**
REF: **REF8**
REF: **REF9**
REF: **REF10**

REF: **REF1**
REF: **REF2**
REF: **REF3**
REF: **REF4**
REF: **REF5**
REF: **REF6**
REF: **REF7**
REF: **REF8**
REF: **REF9**
REF: **REF10**

REF: **REF1**
REF: **REF2**
REF: **REF3**
REF: **REF4**
REF: **REF5**
REF: **REF6**
REF: **REF7**
REF: **REF8**
REF: **REF9**
REF: **REF10**

REF: **REF1**
REF: **REF2**
REF: **REF3**
REF: **REF4**
REF: **REF5**
REF: **REF6**
REF: **REF7**
REF: **REF8**
REF: **REF9**
REF: **REF10**

DESIGNER: J. S. JONES
CHECKER: J. S. JONES
DATE: 09/20/00
PROJECT: BRIDGE STAGE IB CONSTRUCTION
BRIDGE NO. PRE-70-1249 L/R
I.R. 70 OVER PRICE CREEK

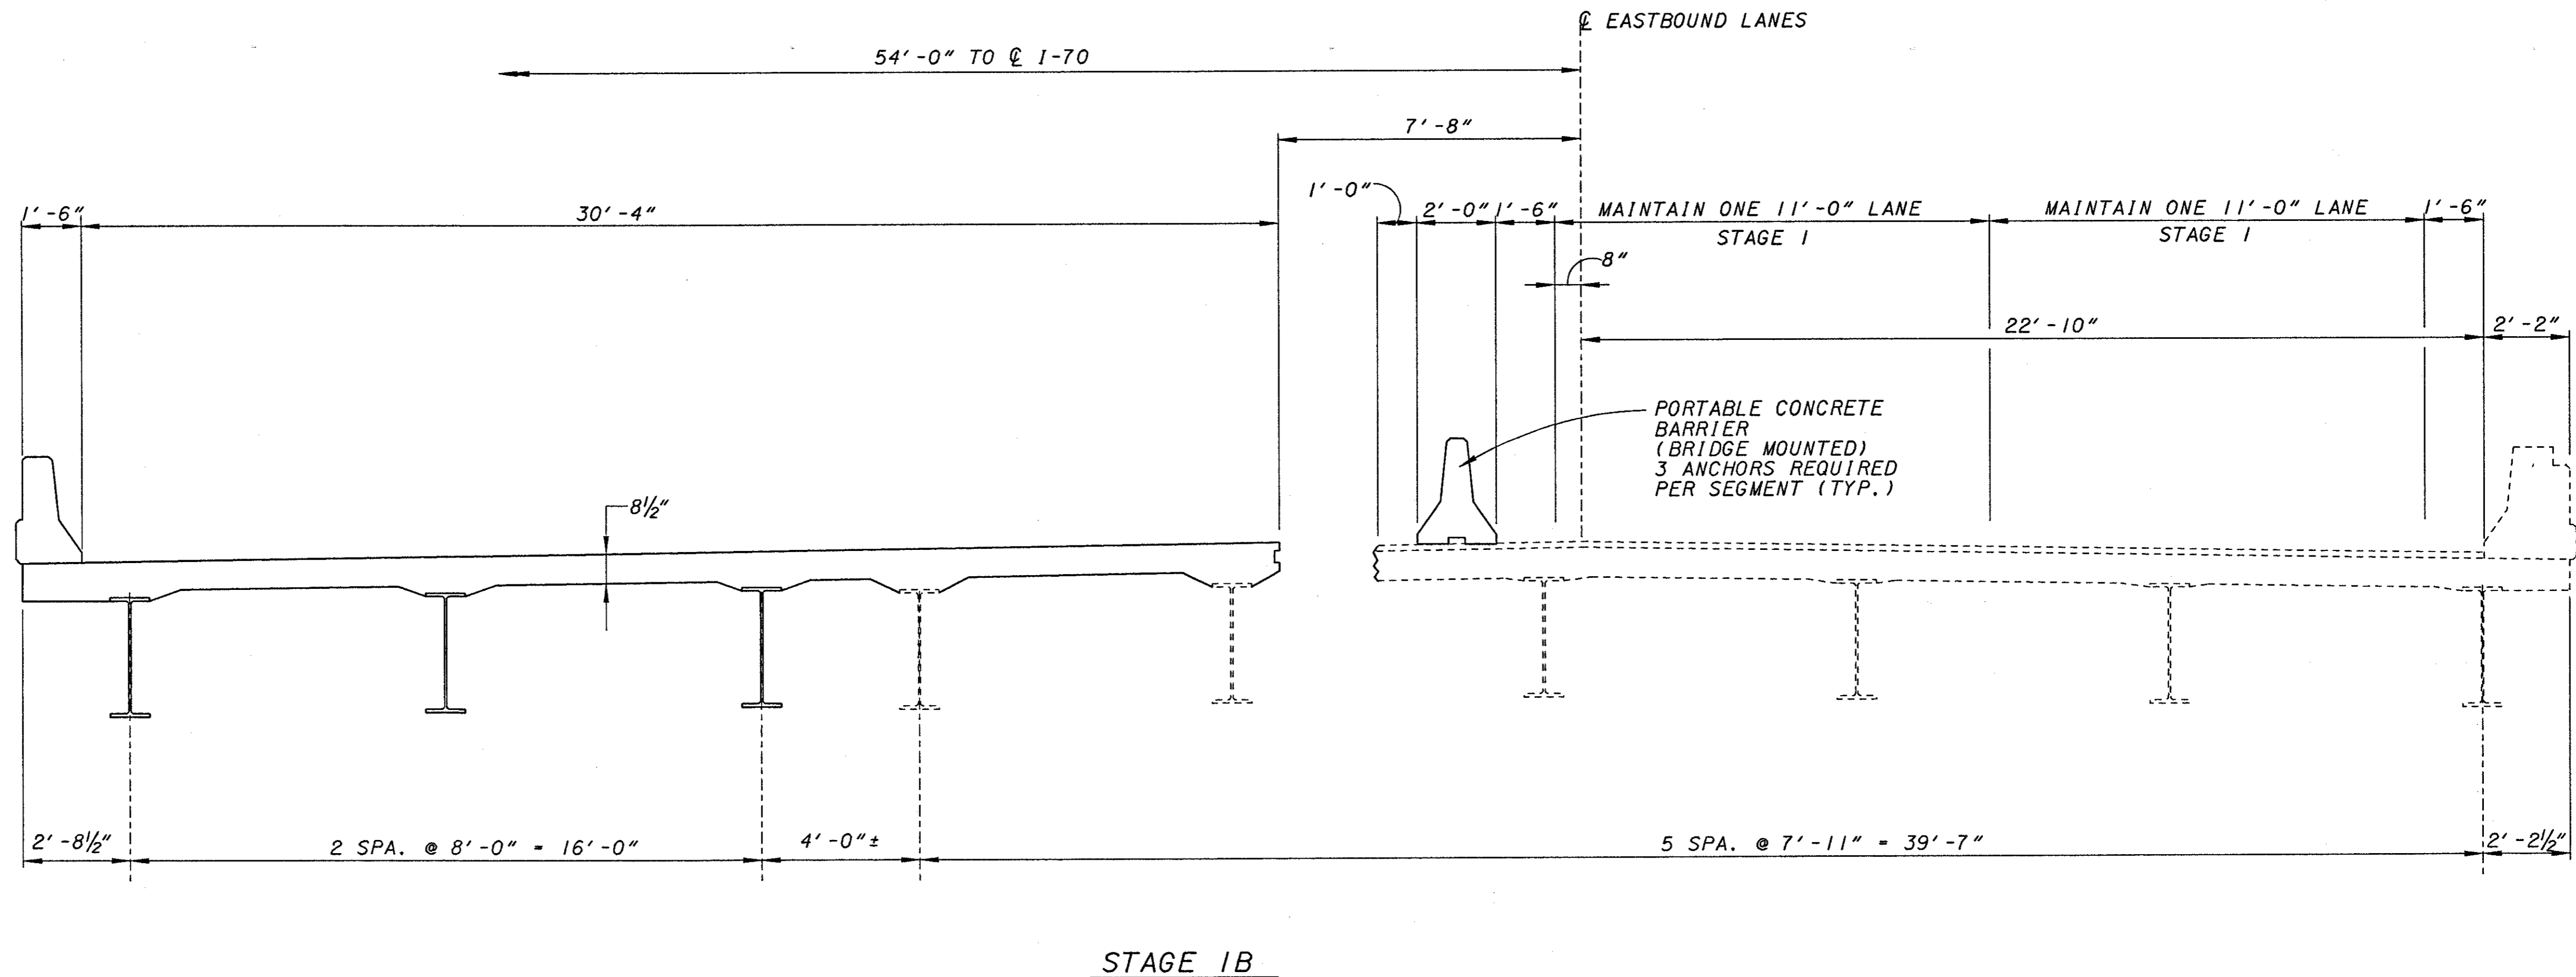

DESIGN AGENCY
KZF DESIGN
KZF DESIGN, INC.
12500 W. 12TH AVE., SUITE 100
DENVER, CO 80202-4000
TEL: 303.501.8111 FAX: 303.501.3030 WEB: www.kzf.com

REVIEWED	DATE
DGK	09/20/00

DESIGNED	CHECKED
SJA	WBS

DRAWN	REVISED
JDG	

STRUCTURE FILE NUMBER	680/1269/680/1293
-----------------------	-------------------

KZF #13

BRIDGE STAGE IB CONSTRUCTION
BRIDGE NO. PRE-70-1249 L/R
I.R. 70 OVER PRICE CREEK

PRE-70-0.00

5/27

190
283

REF: **REF**
 REF: **REF**

REF: **REF**
 REF: **REF**
 USER: *****
 PROJECT: *****
 DATE: *****
 ACTIVE LEVELS ON: *****


NOTES:

1. SEE STD. DWG. PCB-91 FOR PORTABLE CONCRETE BARRIER DETAILS AND NOTES.
2. SEE DETAILS ON SHEET [14/27] FOR CUTTING AND RECONNECTING CROSSFRAMES IN THIS BAY.
3. FALSEWORK FOR STAGES 1 AND 2 MUST BE INDEPENDENT OF EACH OTHER.

 DENOTES PORTION OF EXISTING STRUCTURE TO BE REMOVED.

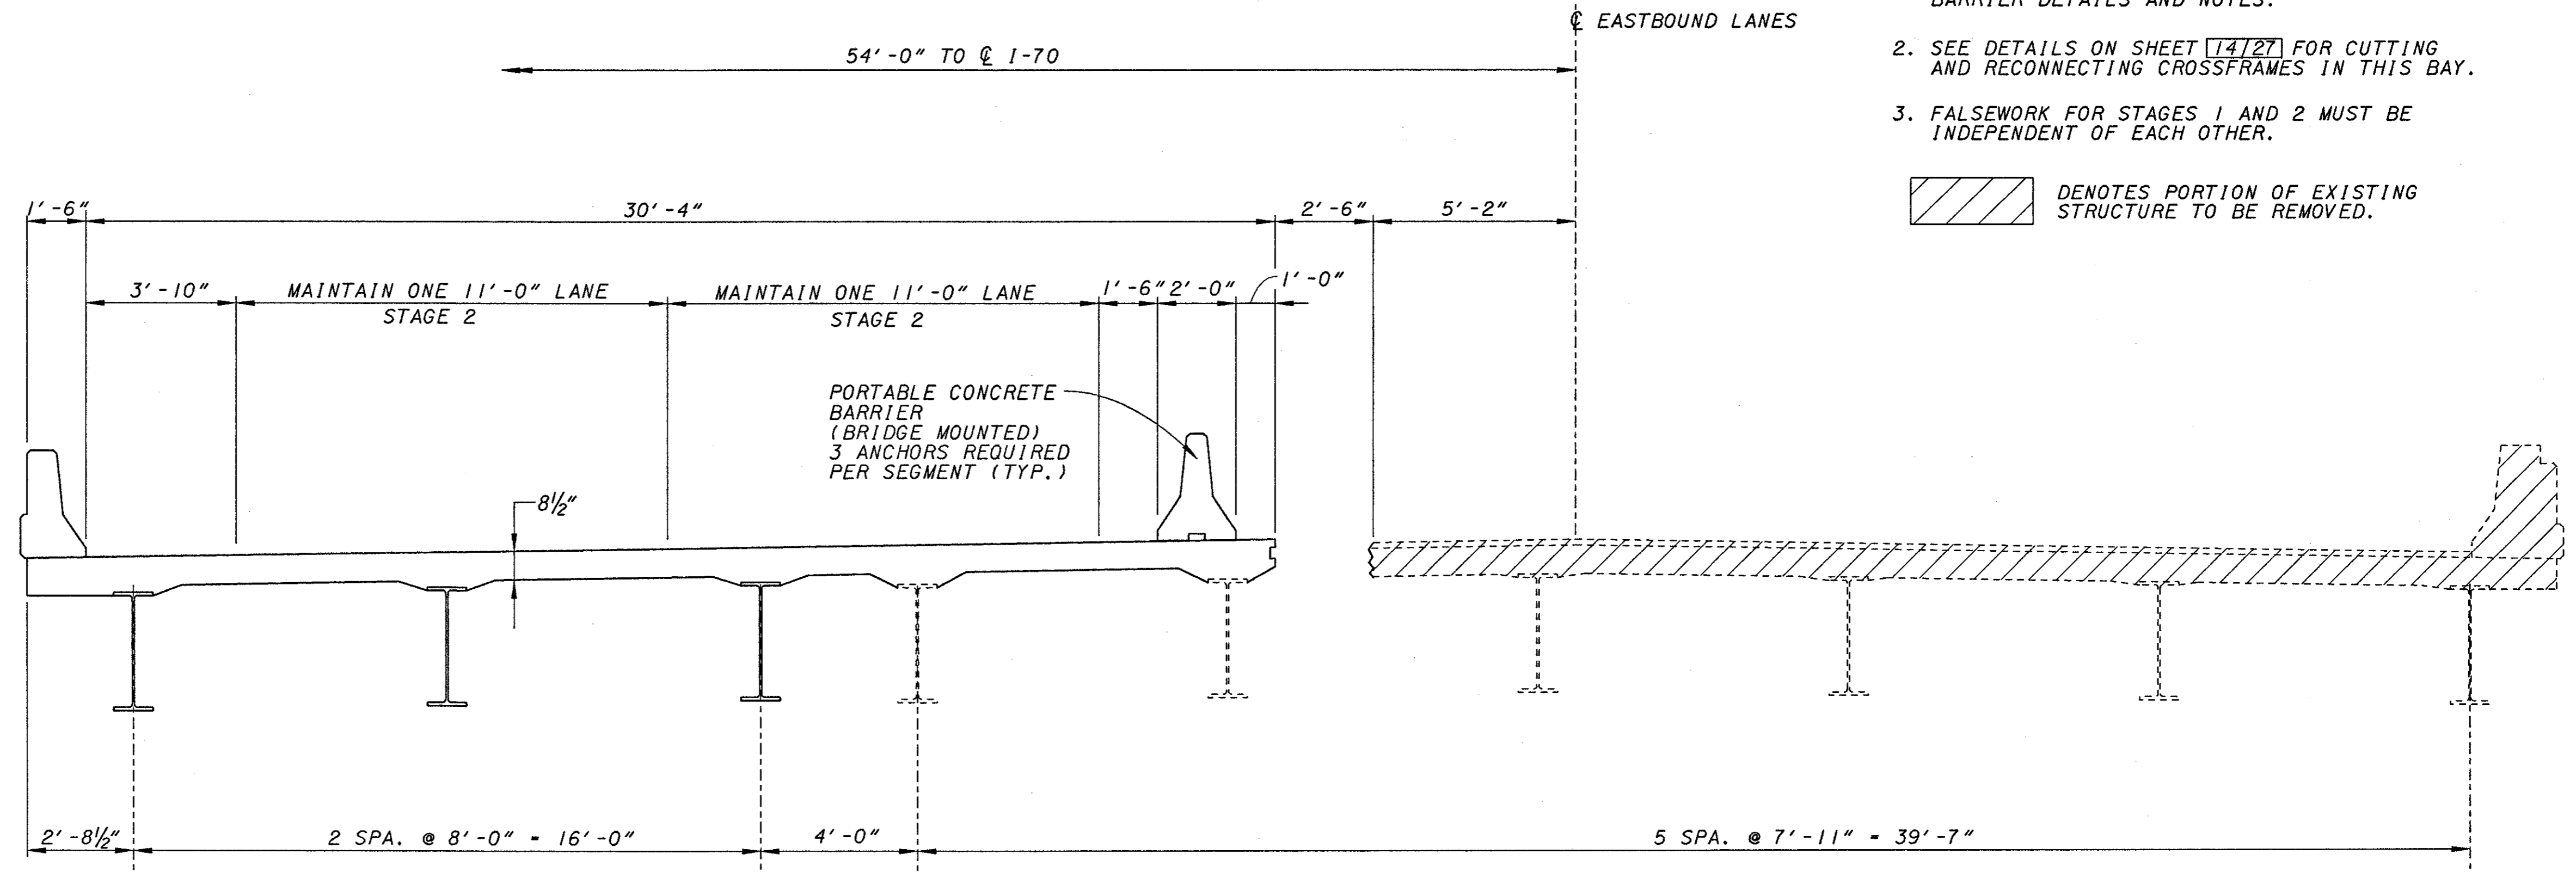

STAGE 2A

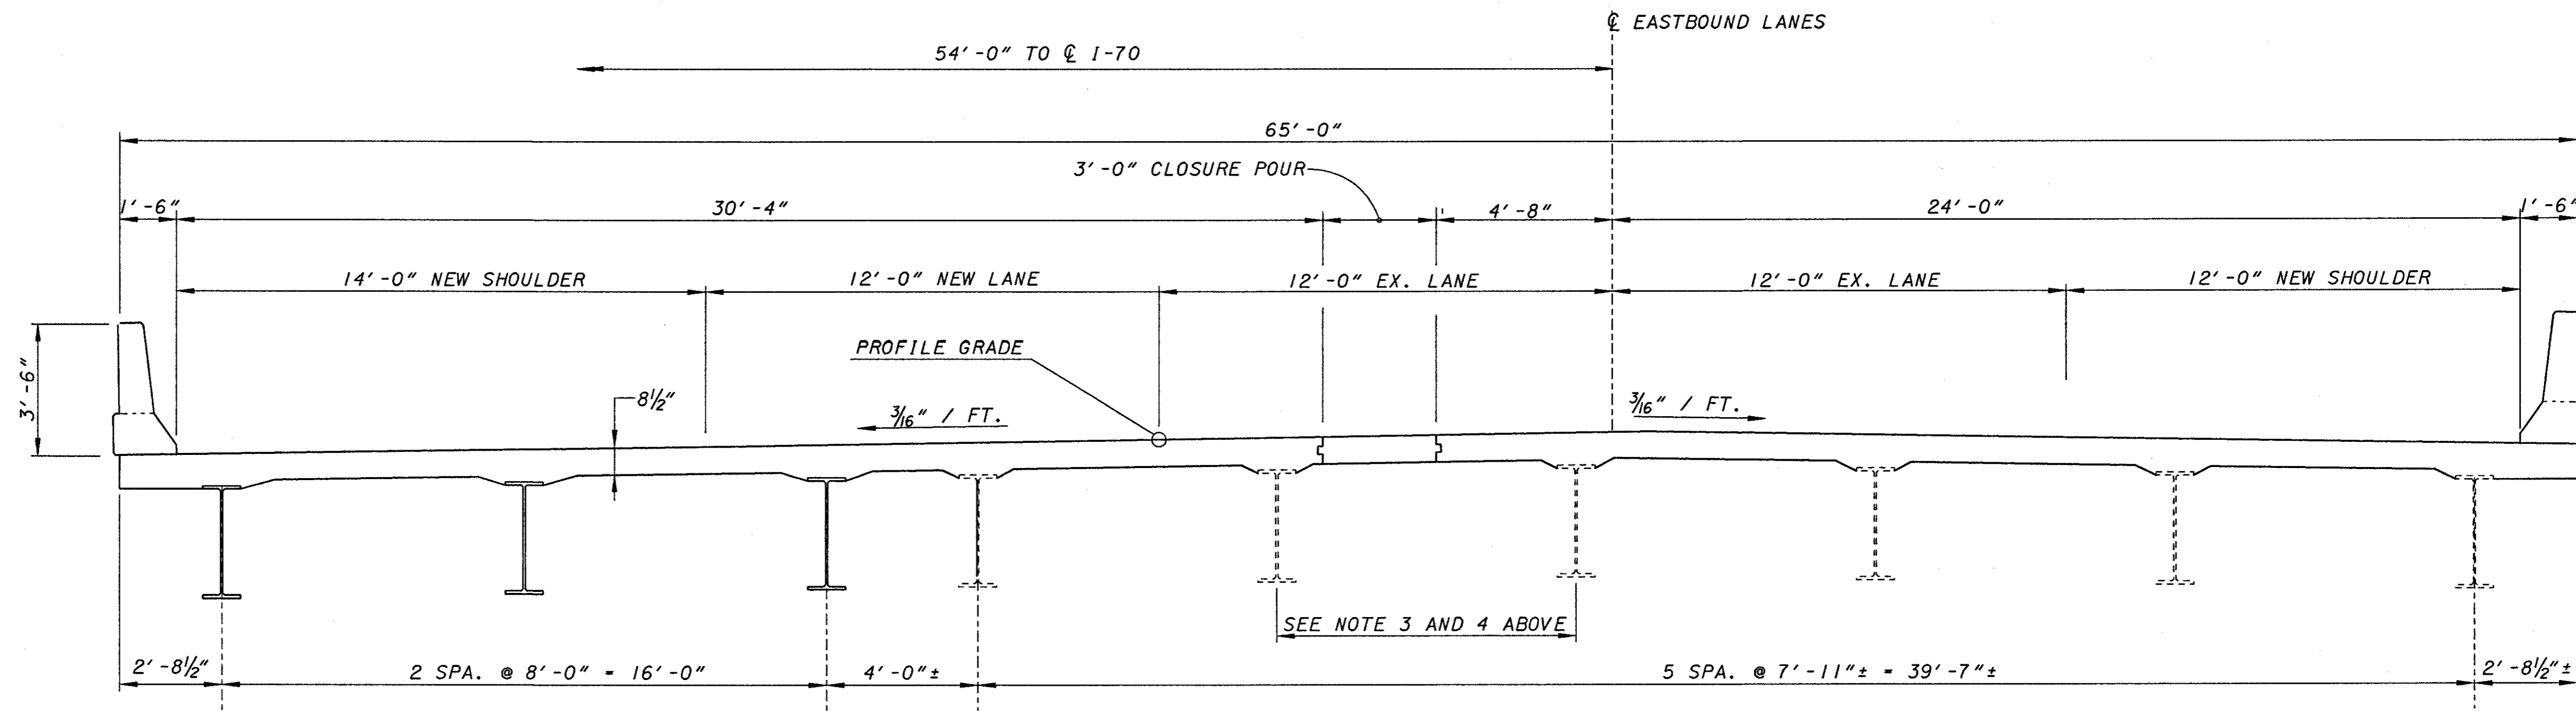

STAGE 2B


REF: ARES
 REF: ARES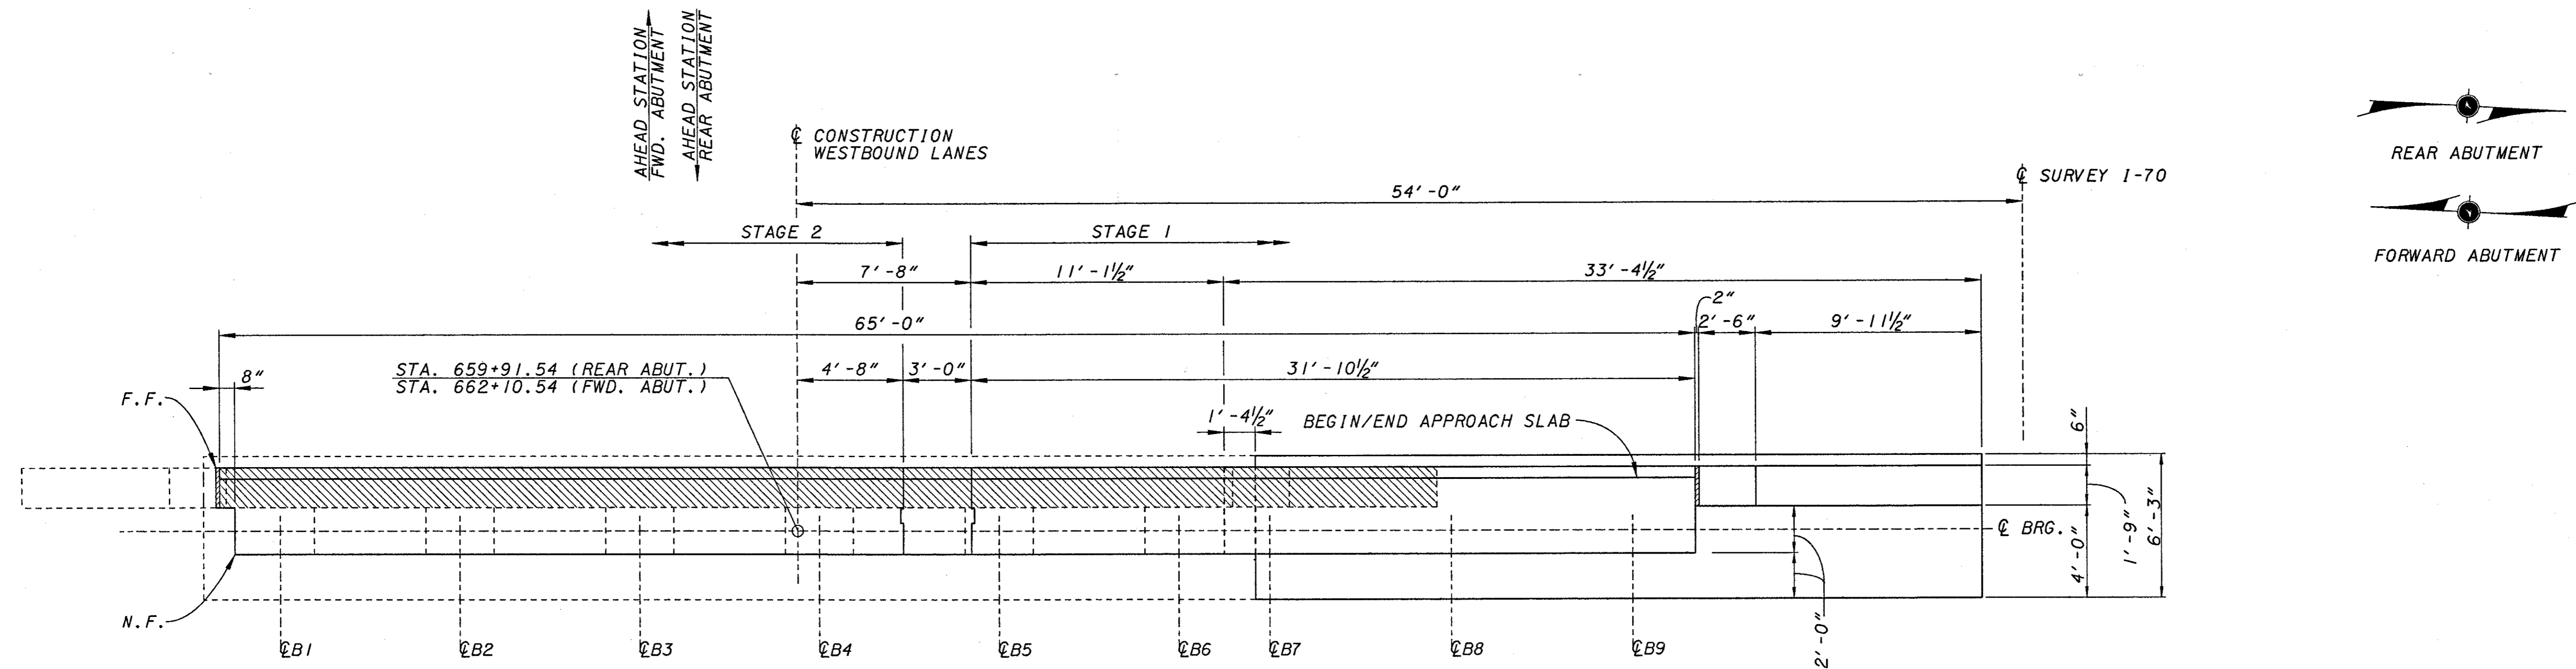
PLAN
 FORWARD ABUTMENT SHOWN,
 REAR ABUTMENT SIMILAR

		(A)	(B)	(C)	(D)
WESTBOUND LANES	REAR	1052.30	1052.78	1052.90	1052.52
	FORWARD	1051.88	1052.36	1052.48	1052.10

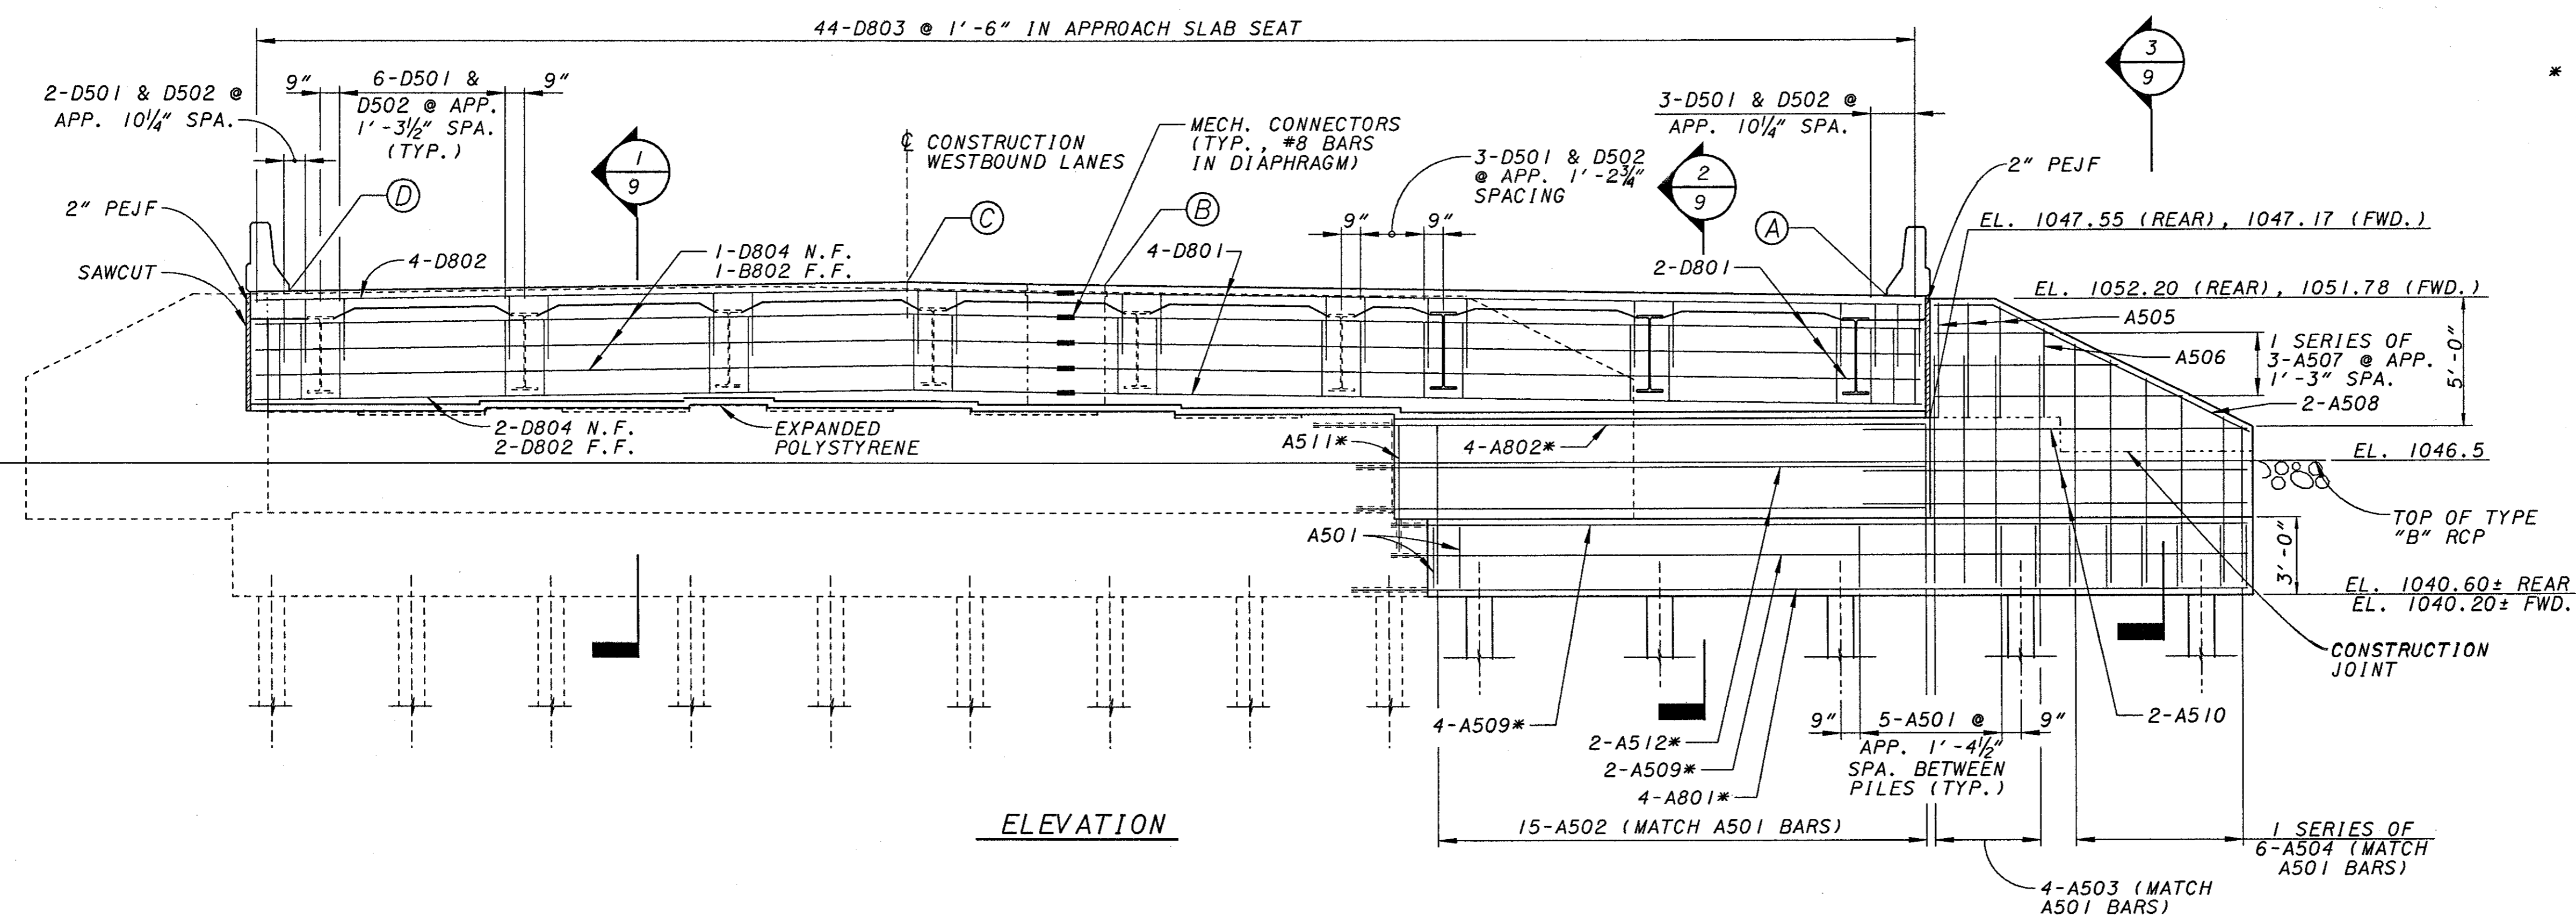

ELEVATION

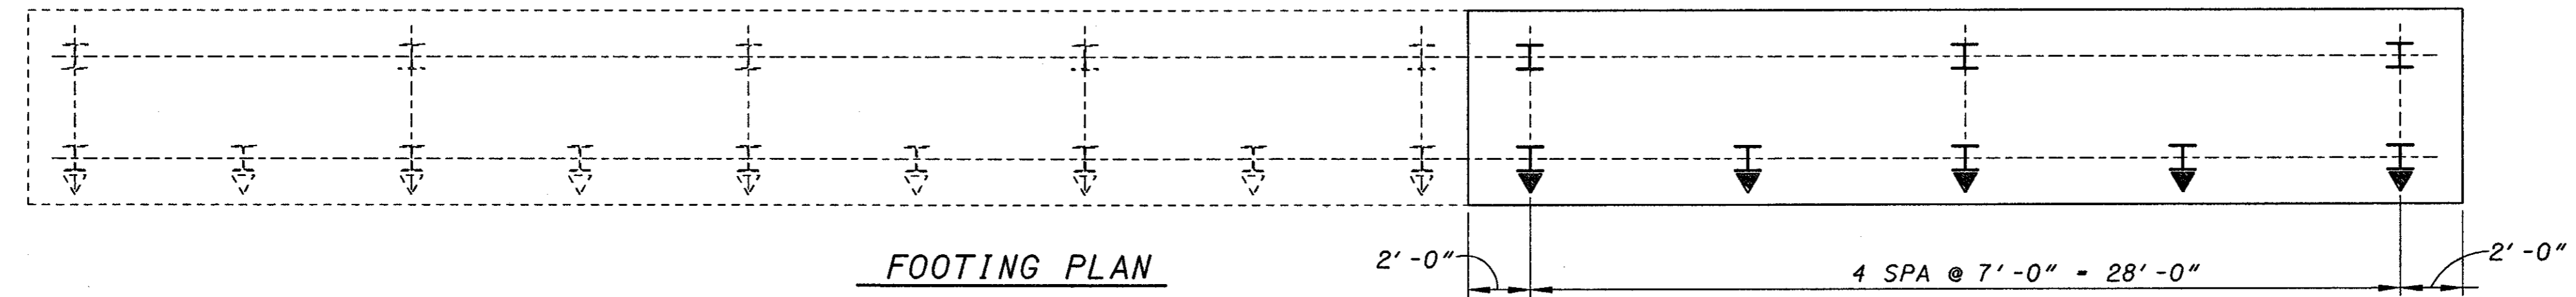

FOOTING PLAN


▨ DENOTES PORTION OF EXISTING STRUCTURE TO BE REMOVED

* DOWEL #5 BARS 1'-5" (MIN.) AND #8 BARS 2'-10" (MIN.) INTO EXISTING ABUTMENT FOOTING AND BREASTWALL.

LEGEND

- PEJF - PREFORMED EXPANSION JOINT FILLER
- E.F. - EACH FACE
- N.F. - NEAR FACE
- F.F. - FAR FACE
- APP. - APPROXIMATELY
- ⬇ DENOTES PROPOSED HP10x42 PILE BATTERED AT 1:4
- I DENOTES VERTICAL HP10x42 PILE

ALL REINFORCING STEEL CLEARANCES ARE 2" UNLESS NOTED OTHERWISE

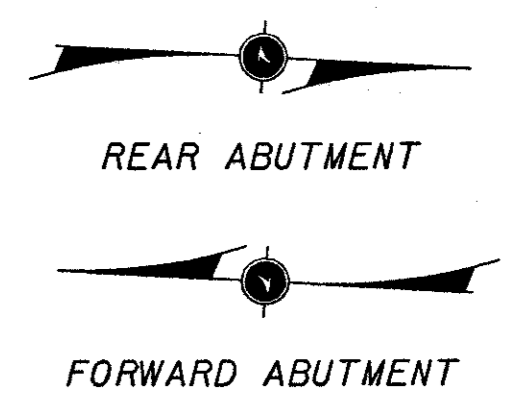



REF: AREF:***
 REF: AREF:***
 USER: *****
 PROJ: *****
 DATE: *****
 ACTIVE LEVELS ON: *****

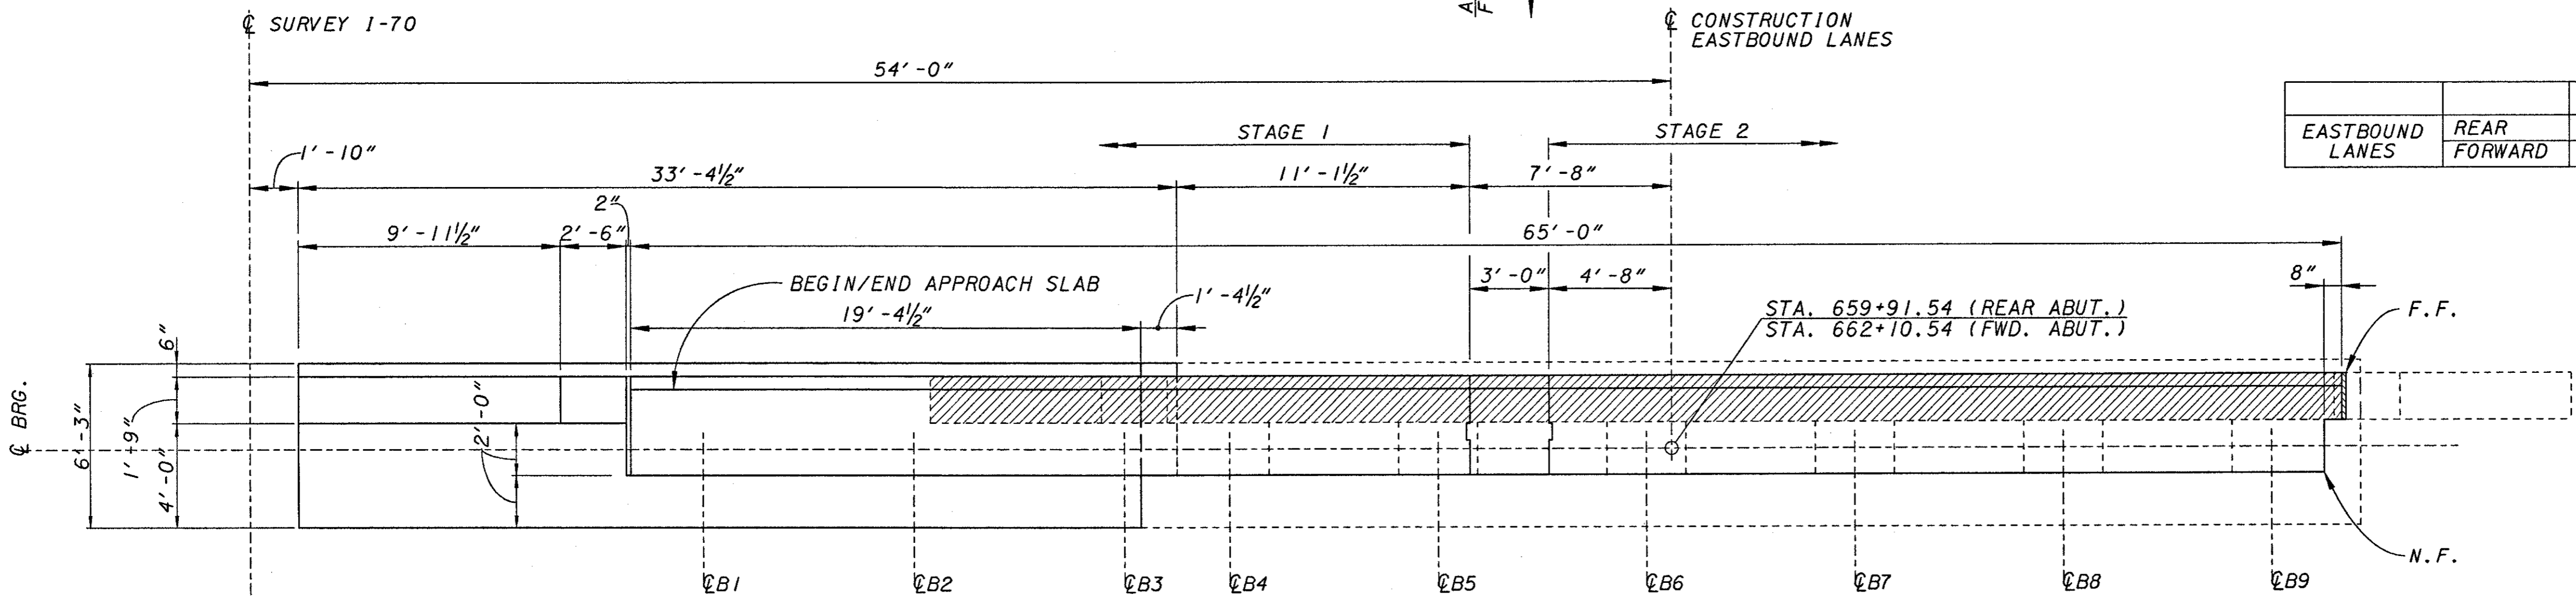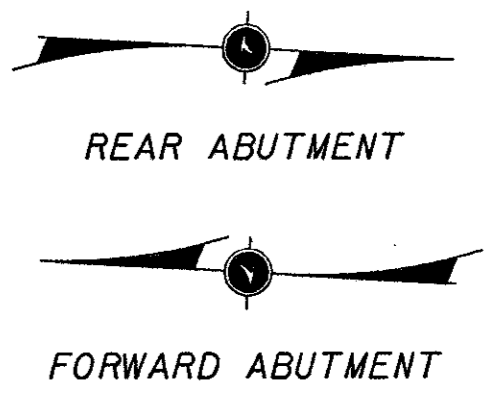

EASTBOUND LANES		(A)	(B)	(C)	(D)
REAR		1052.29	1052.76	1052.88	1052.50
FORWARD		1051.90	1052.37	1052.49	1052.12

PLAN


FORWARD ABUTMENT SHOWN,
 REAR ABUTMENT SIMILAR

▨ DENOTES PORTION OF
 EXISTING STRUCTURE
 TO BE REMOVED

* DOWEL #5 BARS 1'-5" (MIN.) AND
 #8 BARS 2'-10" (MIN.) INTO EXISTING
 ABUTMENT FOOTING AND BREASTWALL.


LEGEND

- PEJF - PREFORMED EXPANSION JOINT FILLER
- E.F. - EACH FACE
- N.F. - NEAR FACE
- F.F. - FAR FACE
- APP. - APPROXIMATELY
- ⊥ DENOTES PROPOSED HP10x42 PILE BATTERED AT 1:4
- I DENOTES VERTICAL HP10x42 PILE

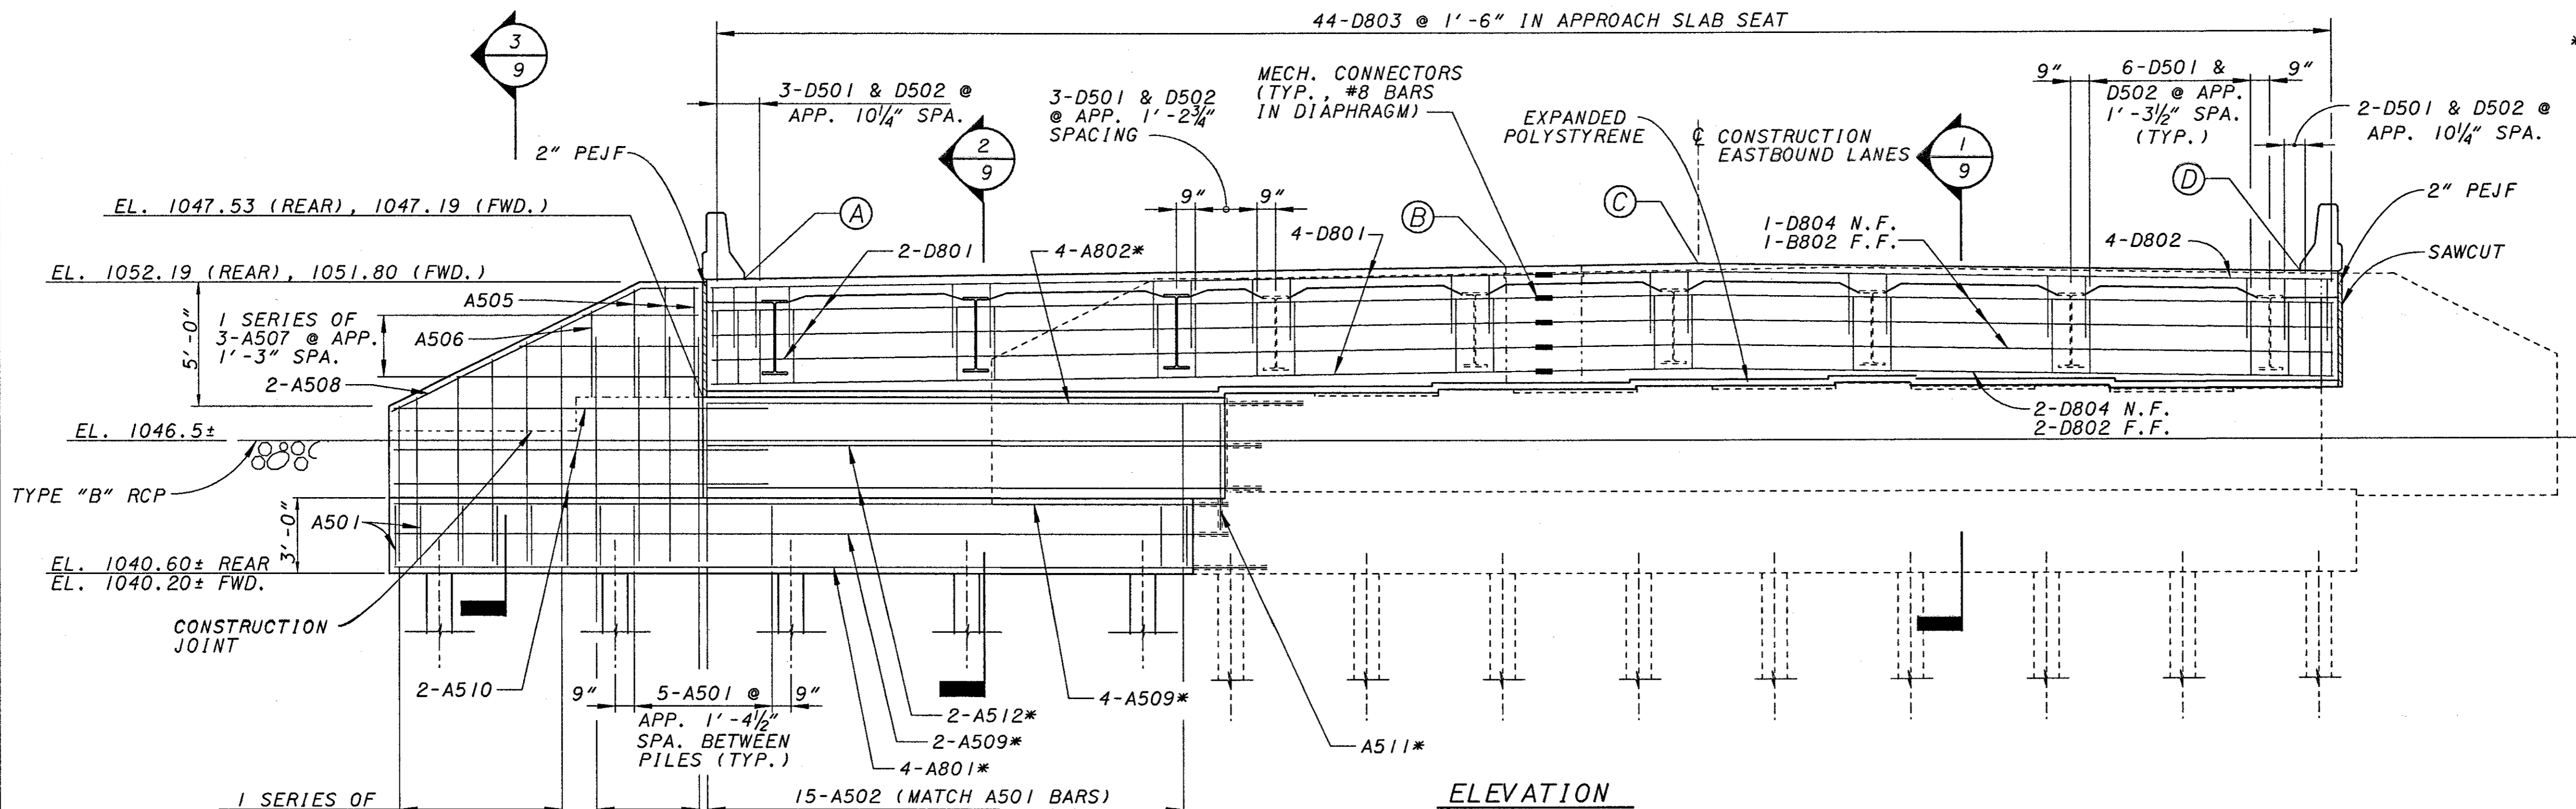

ELEVATION

ALL REINFORCING STEEL
 CLEARANCES ARE 2" UNLESS
 NOTED OTHERWISE

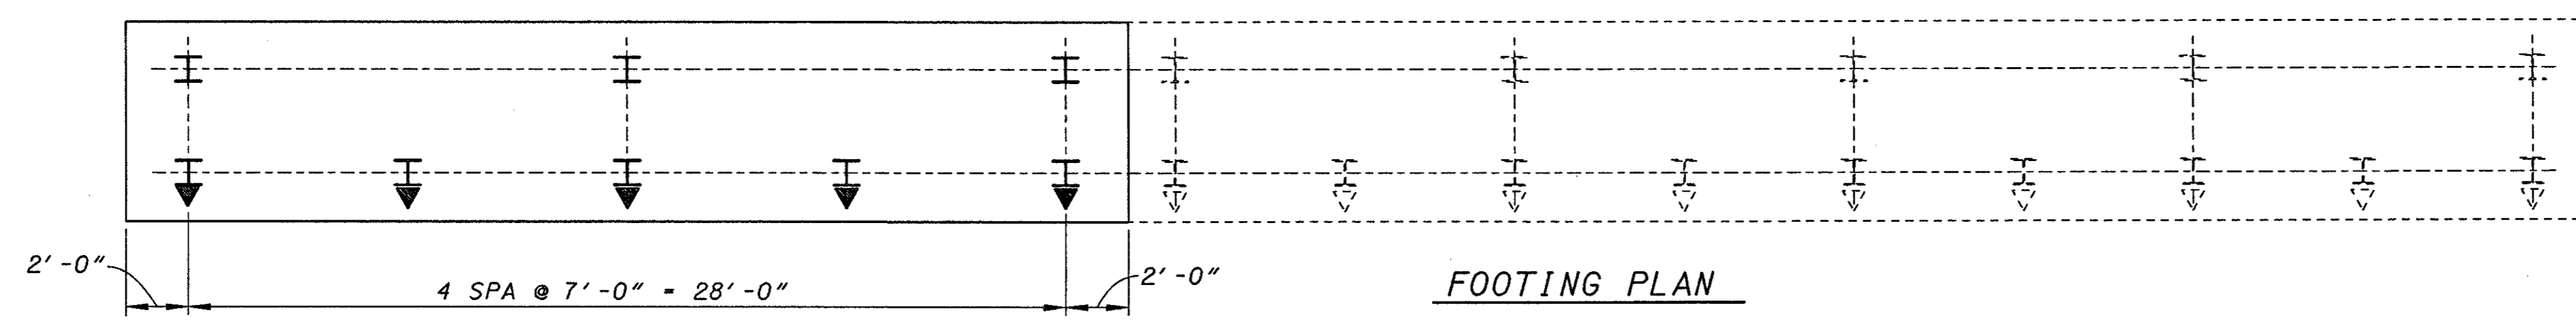

FOOTING PLAN


REF: **REF**
 REF: **REF**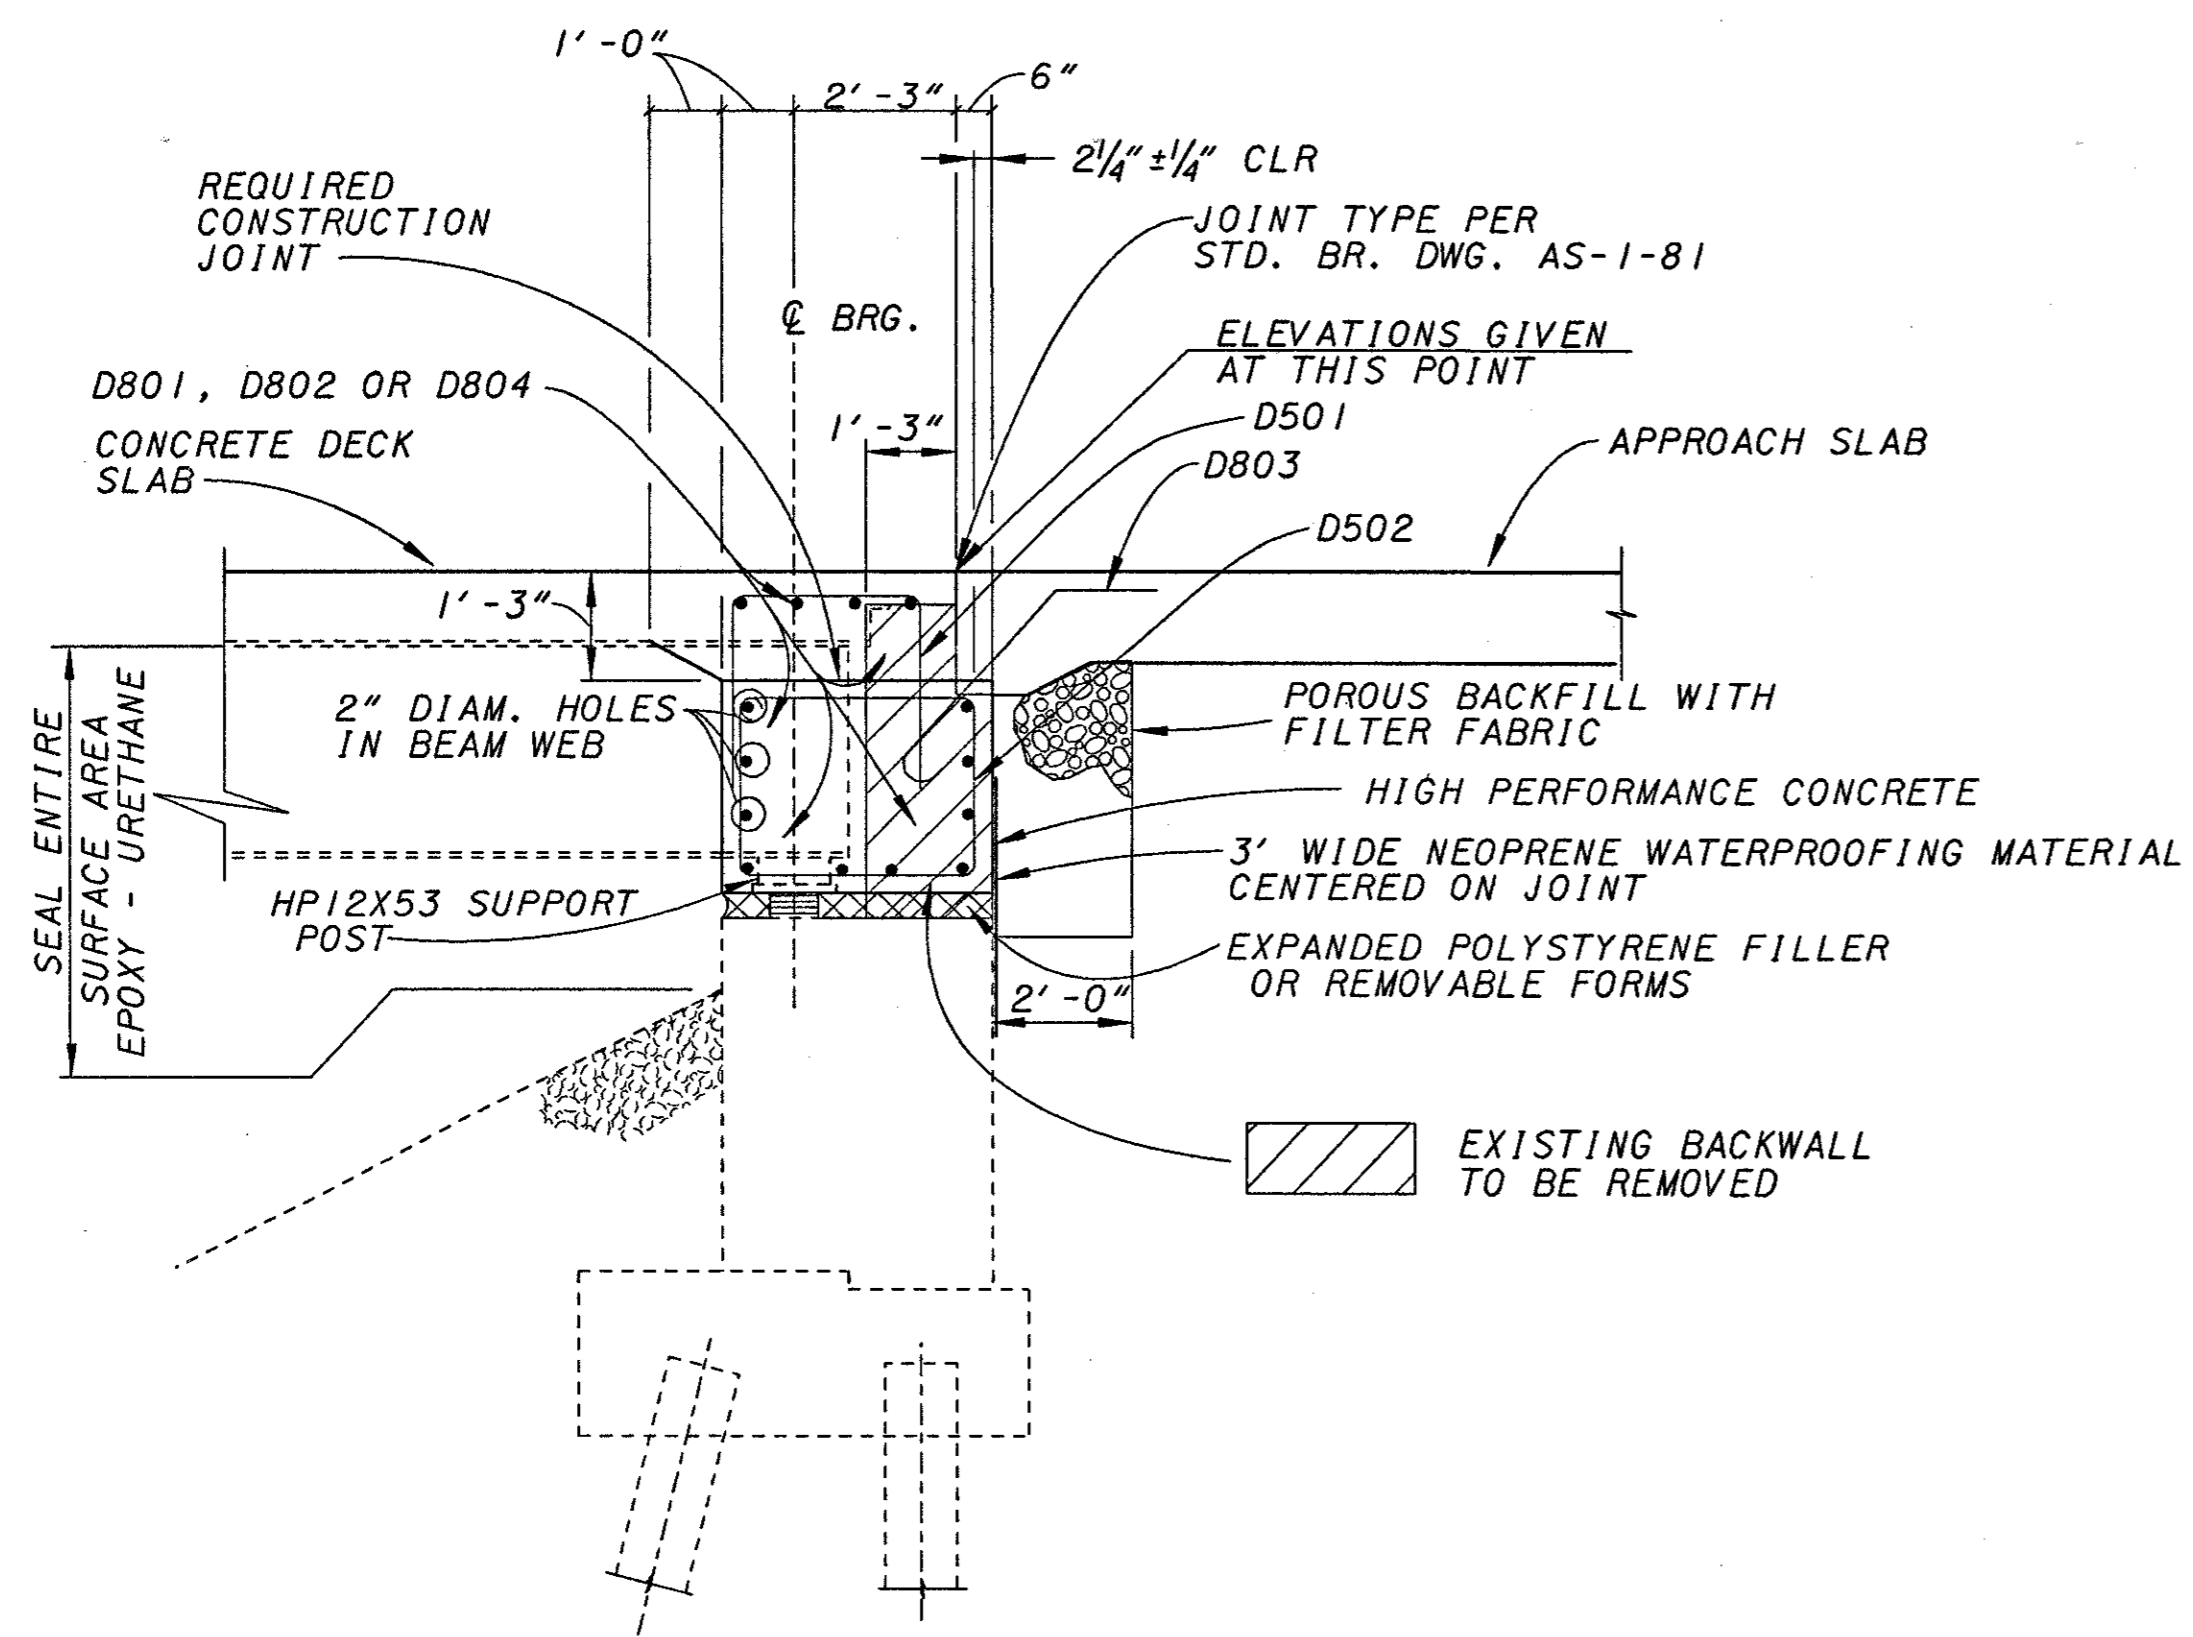
SECTION 1-1
 7 8

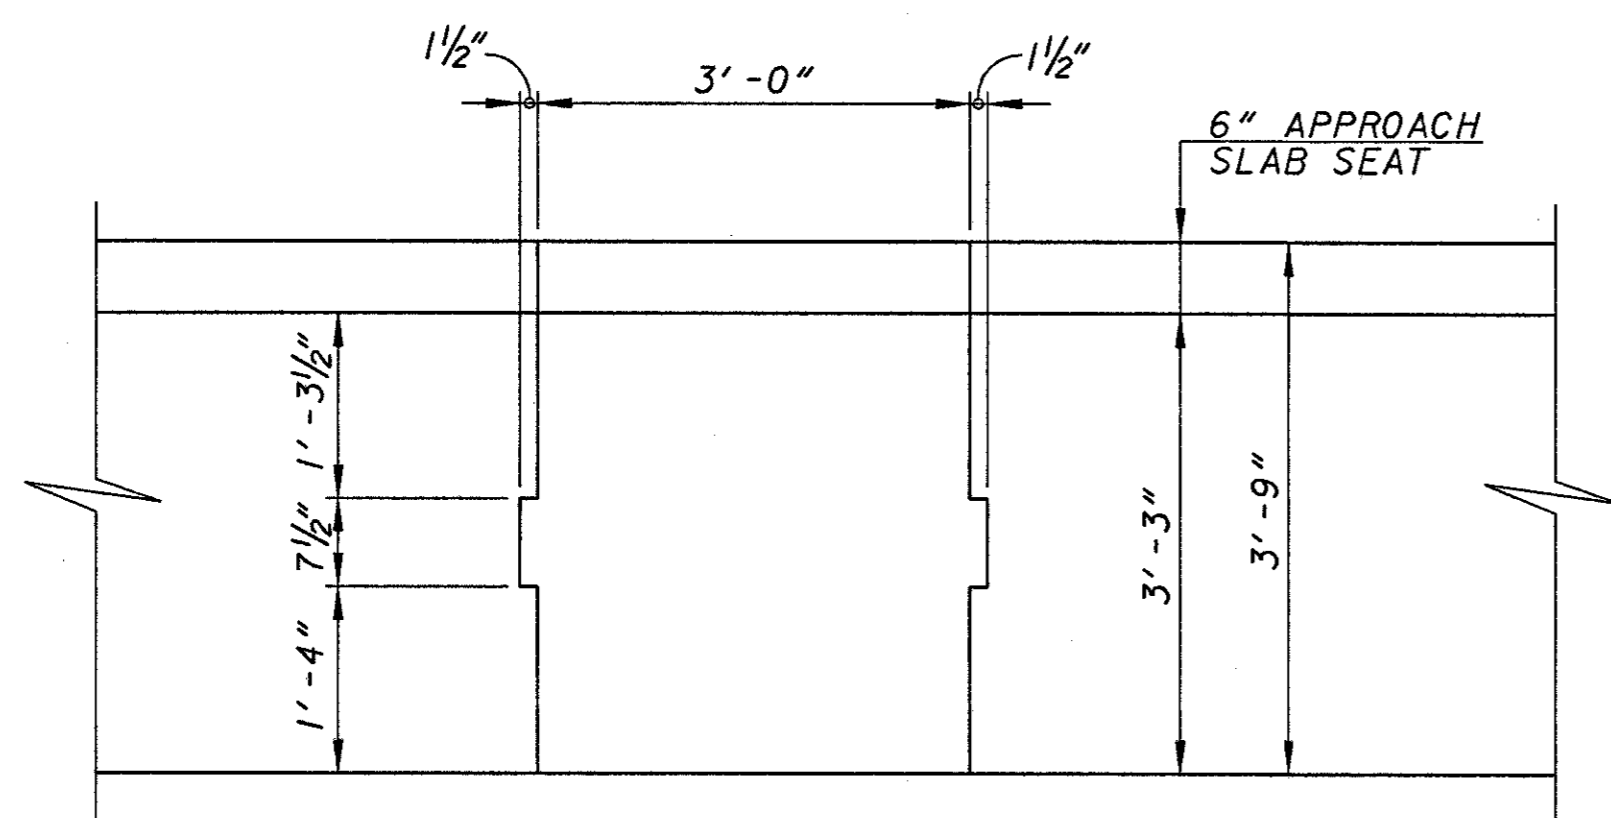

CLOSURE POUR DETAIL
 (DIAPHRAGM PLAN VIEW)

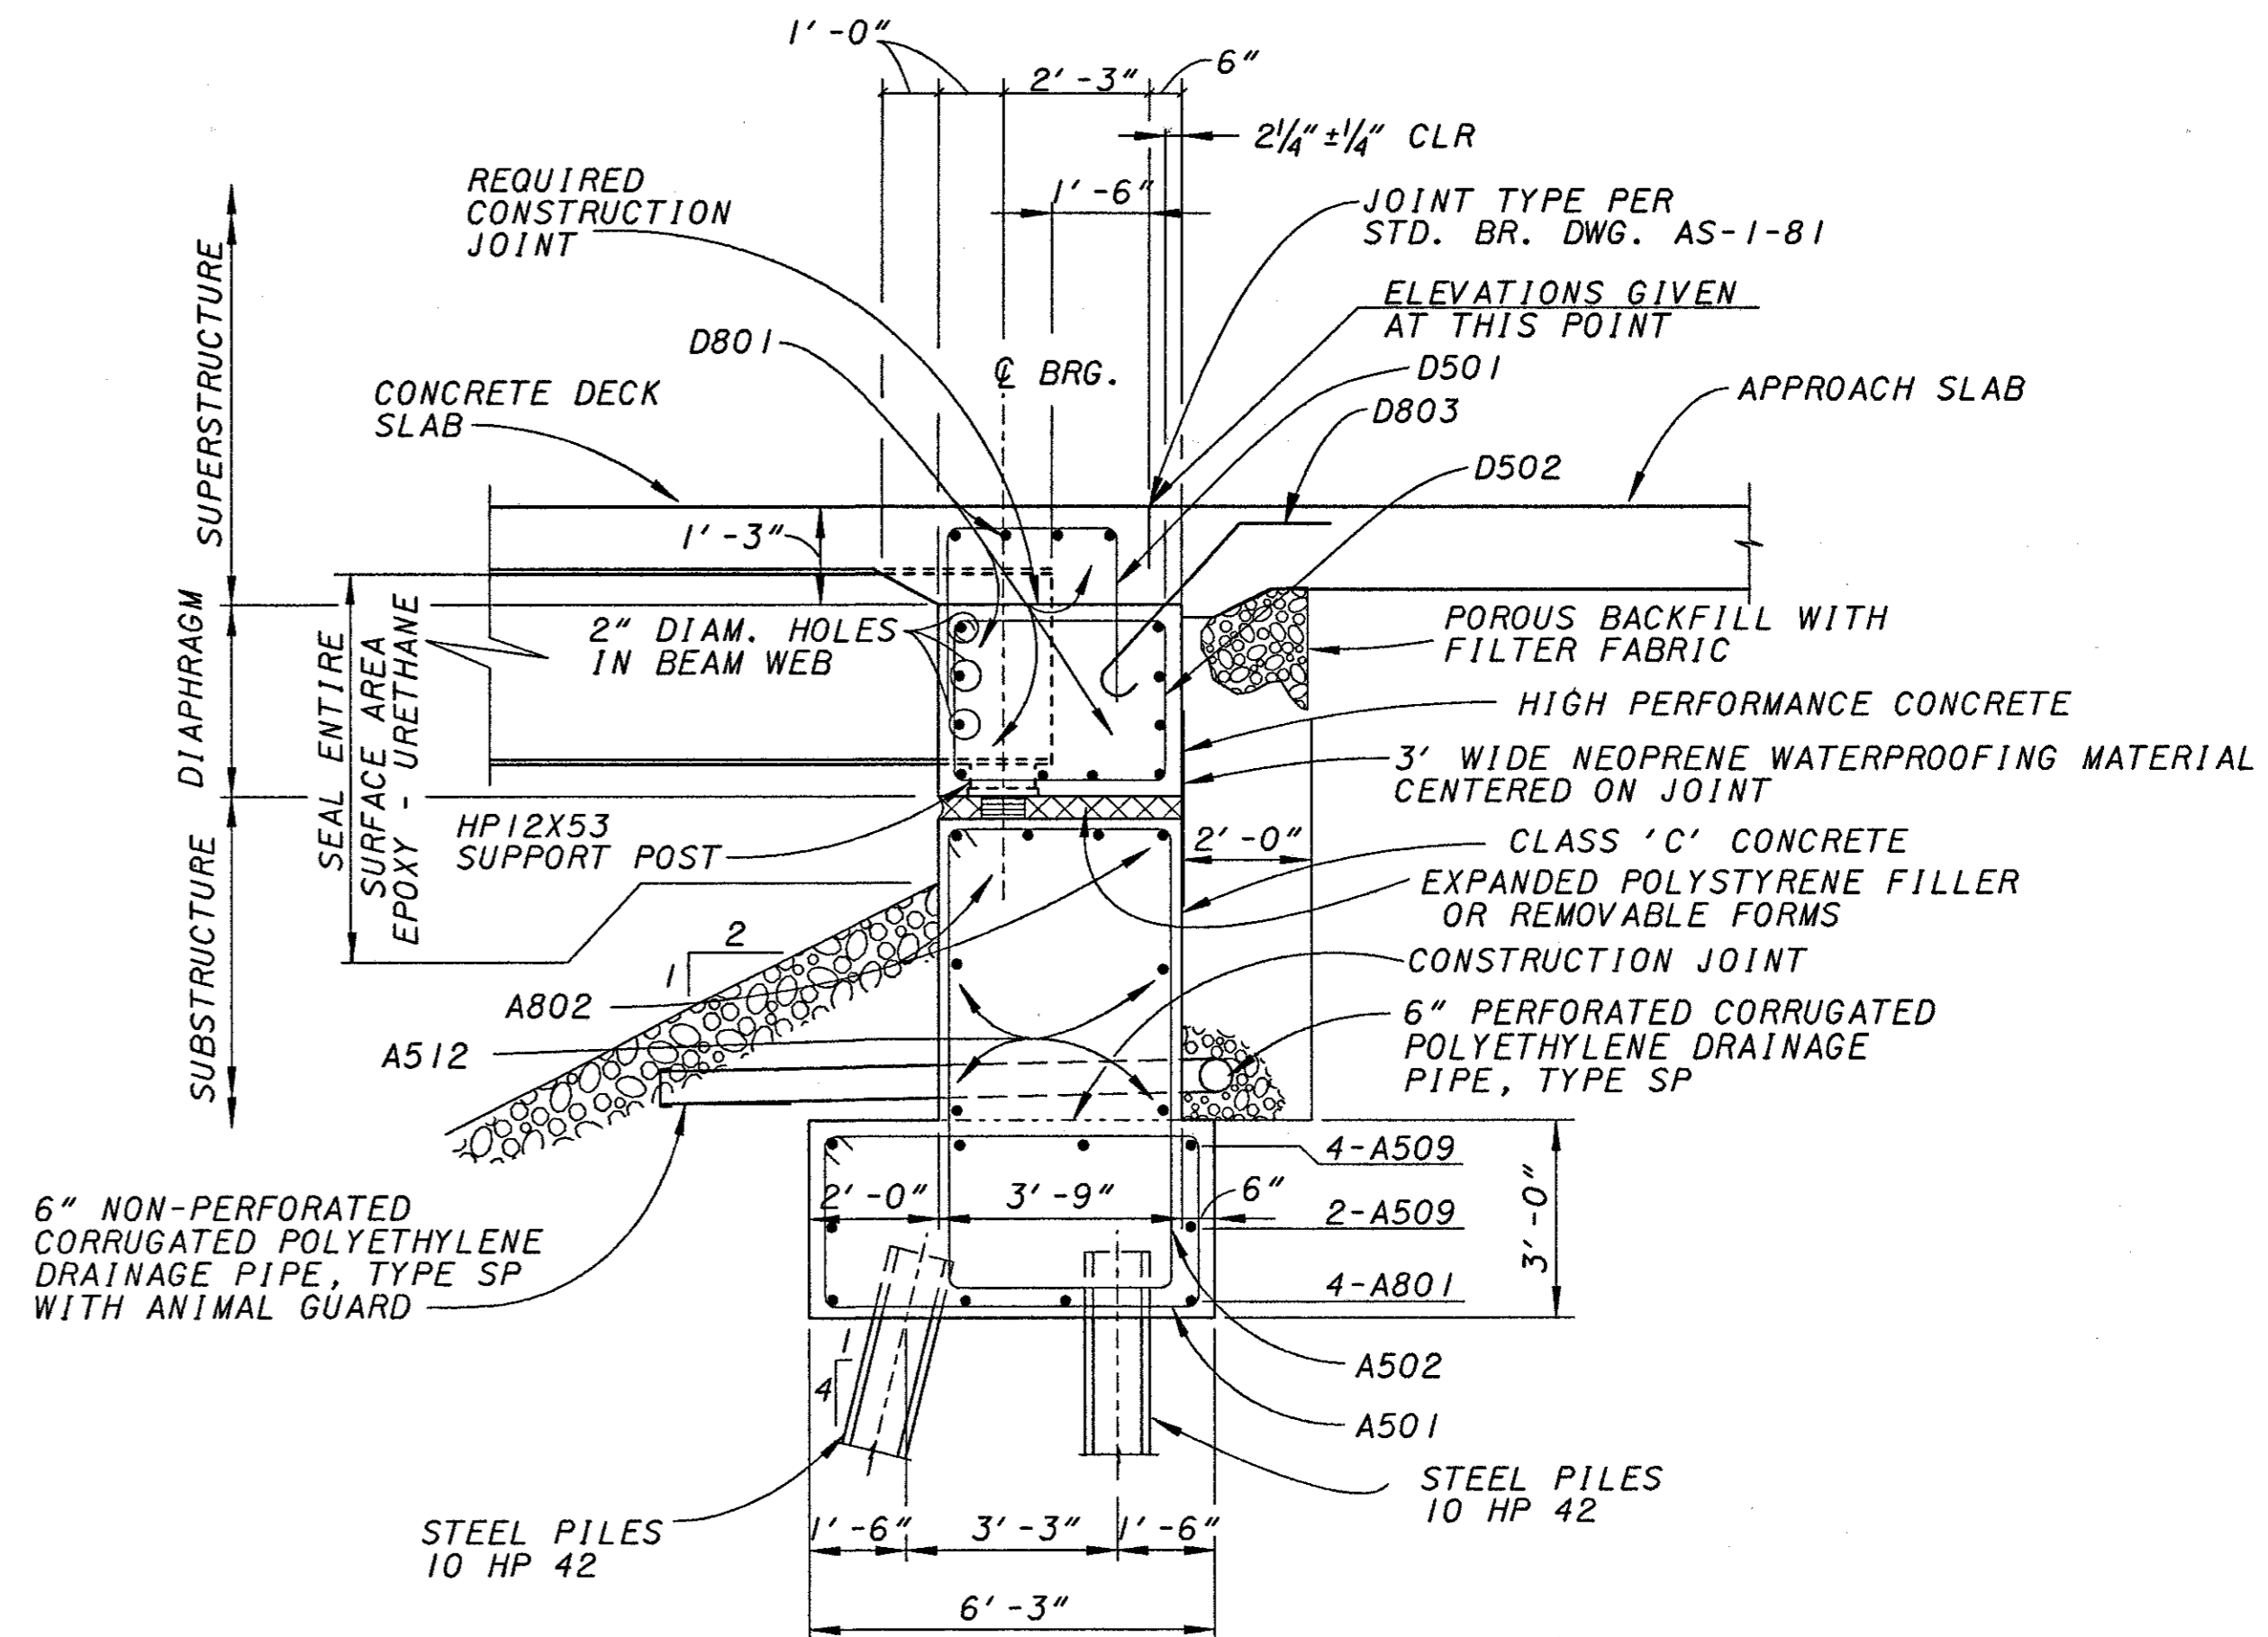


SECTION 2-2
 7 8

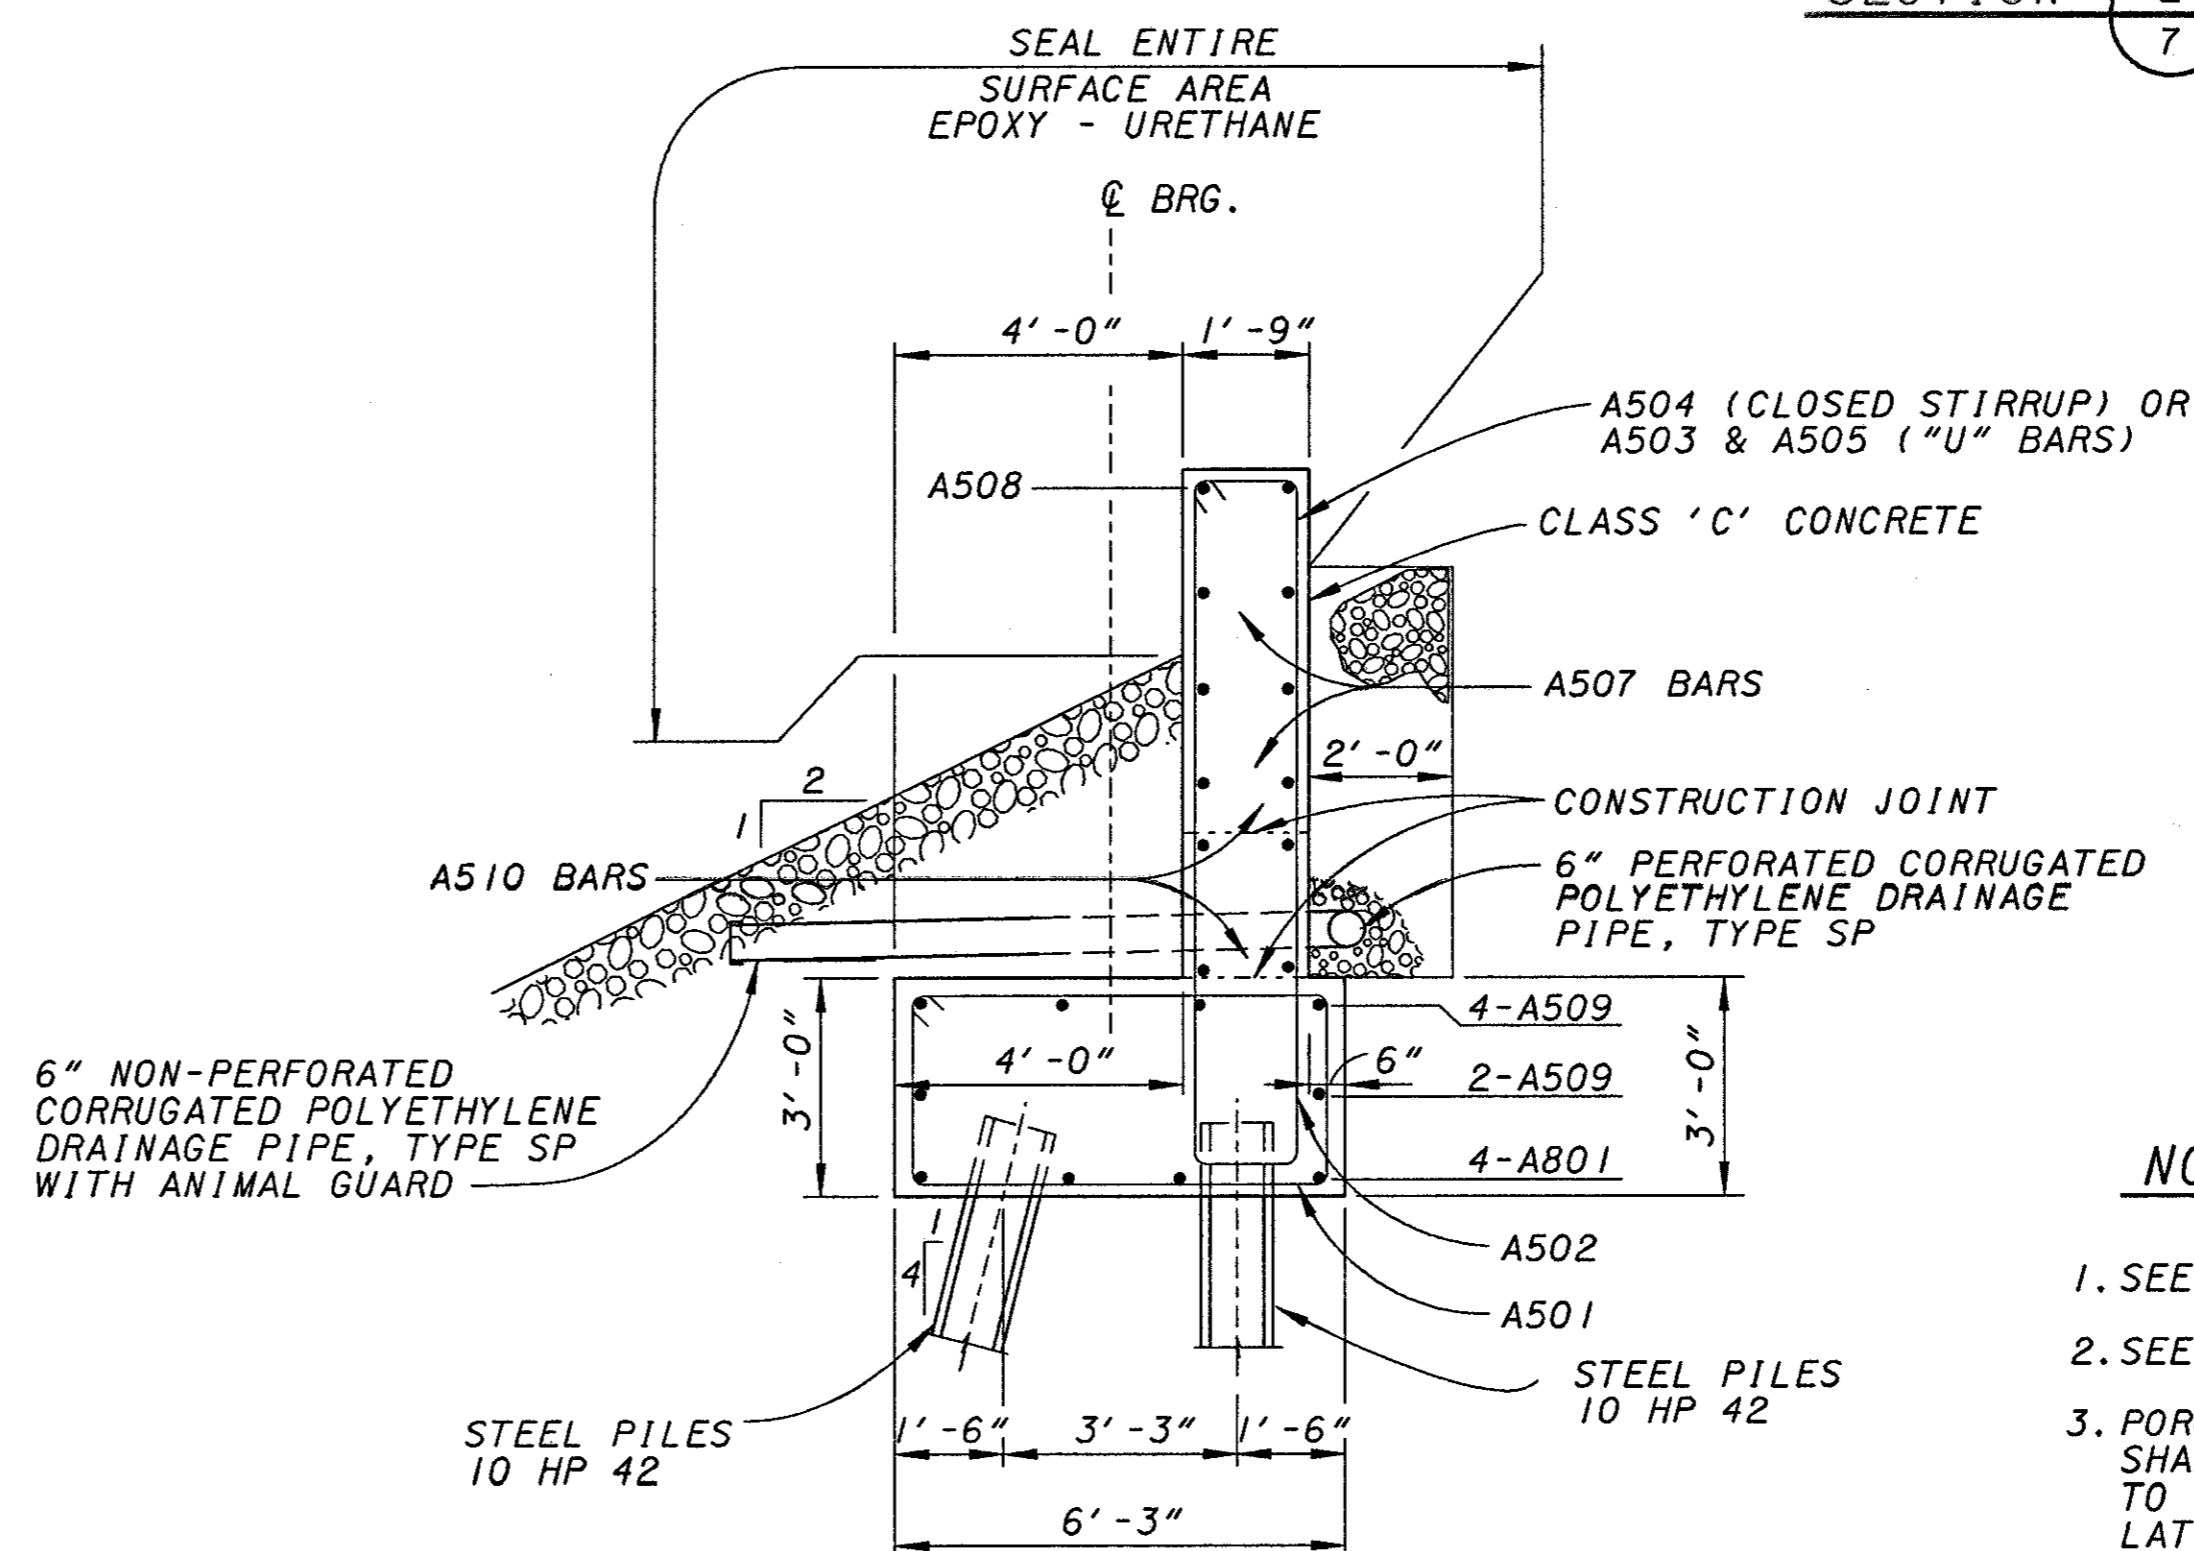

SECTION 3-3
 7 8

NOTES:

1. SEE STD. DWG. SICD-1-96M FOR ADDITIONAL DETAILS.
2. SEE SHEET 16/27 FOR BEARING DETAILS.
3. POROUS BACKFILL WITH FILTER FABRIC, 2'-0" THICK SHALL EXTEND UP TO THE PLANE OF THE SUBGRADE, TO 1'-0" BELOW THE EMBANKMENT SURFACE AND LATERALLY TO THE ENDS OF THE WINGWALLS. GEOTEXTILE FABRIC SHALL CONFORM WITH 712.09, TYPE A. TURN GEOTEXTILE FABRIC UP 6" ALONG BACK OF WALL.

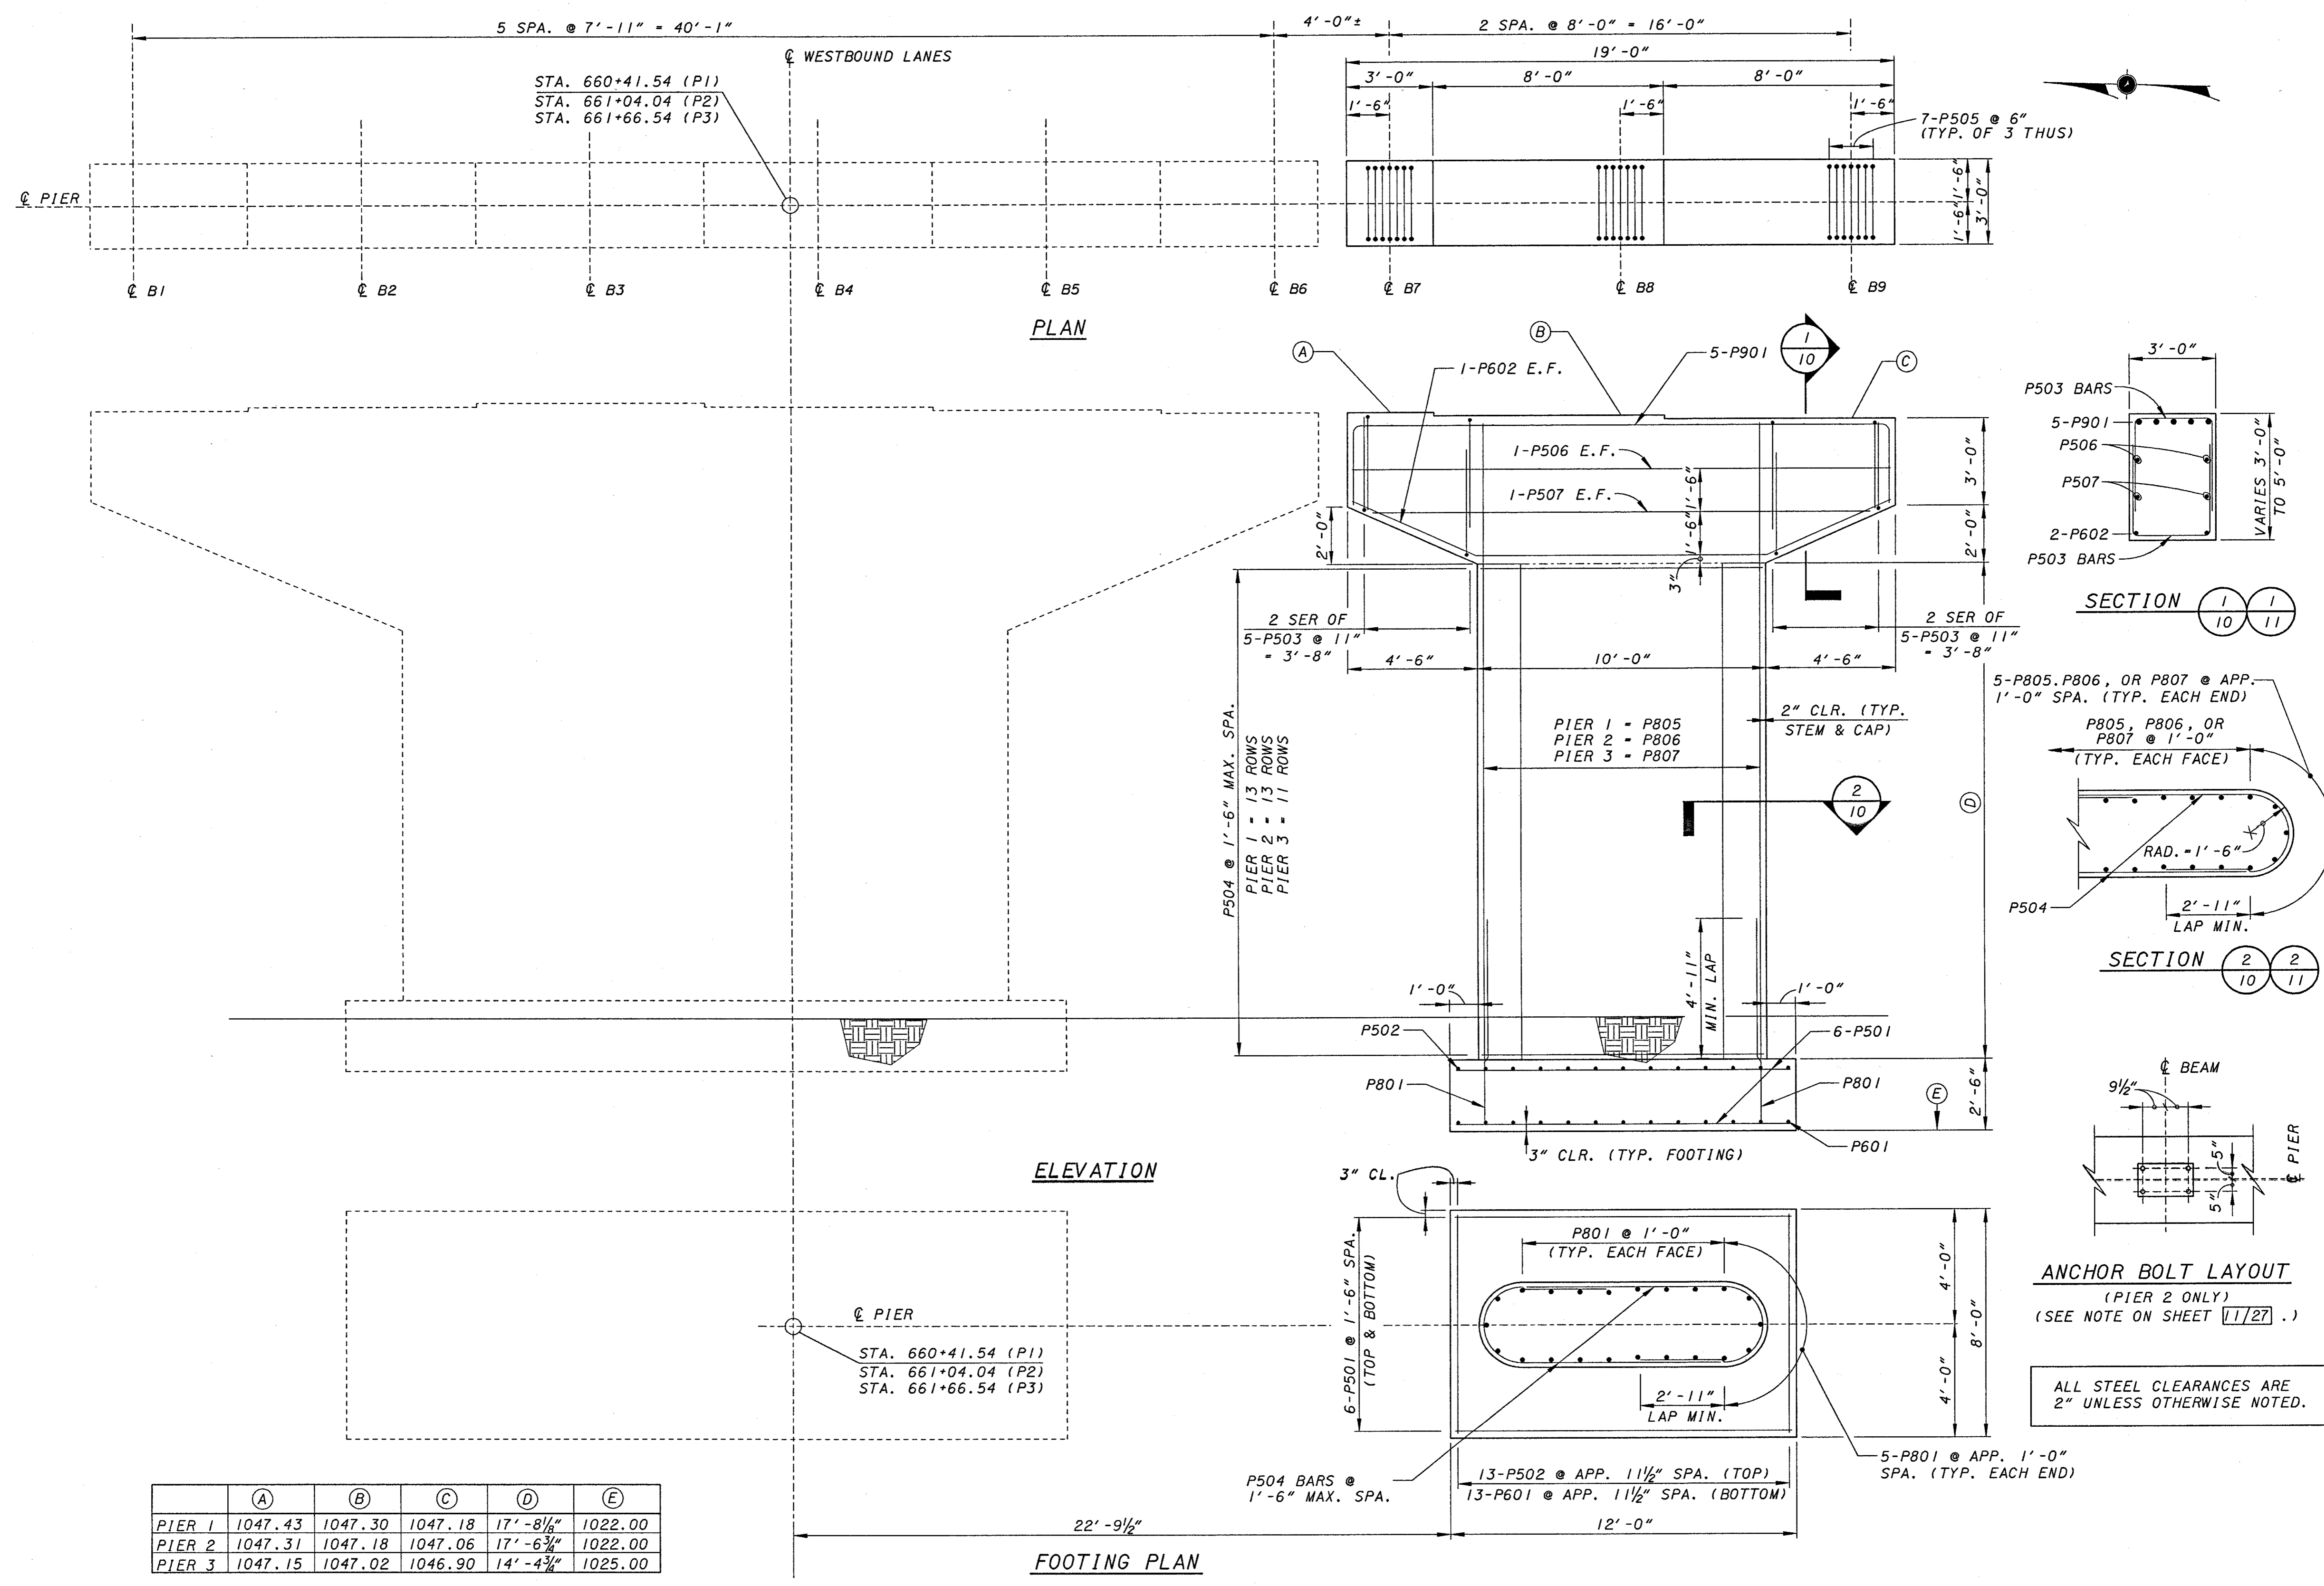






STA. 660+41.54 (P1)
 STA. 661+04.04 (P2)
 STA. 661+66.54 (P3)

7-P505 @ 6"
 (TYP. OF 3 THUS)

PLAN

ELEVATION

FOOTING PLAN

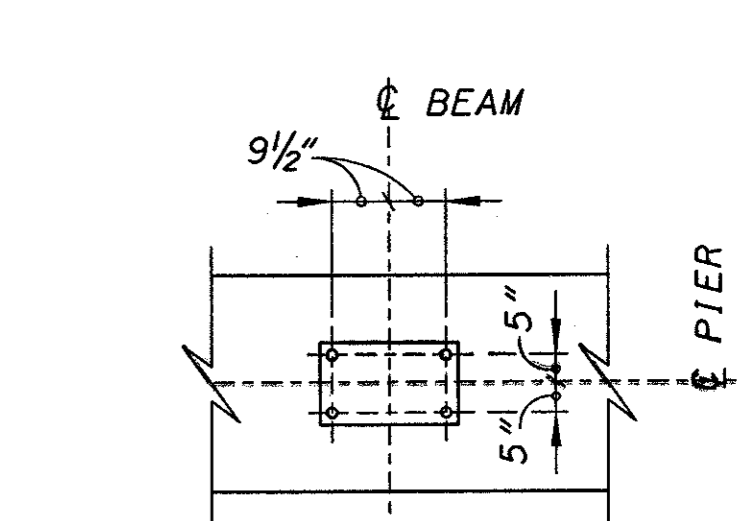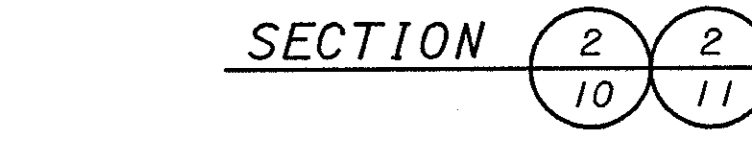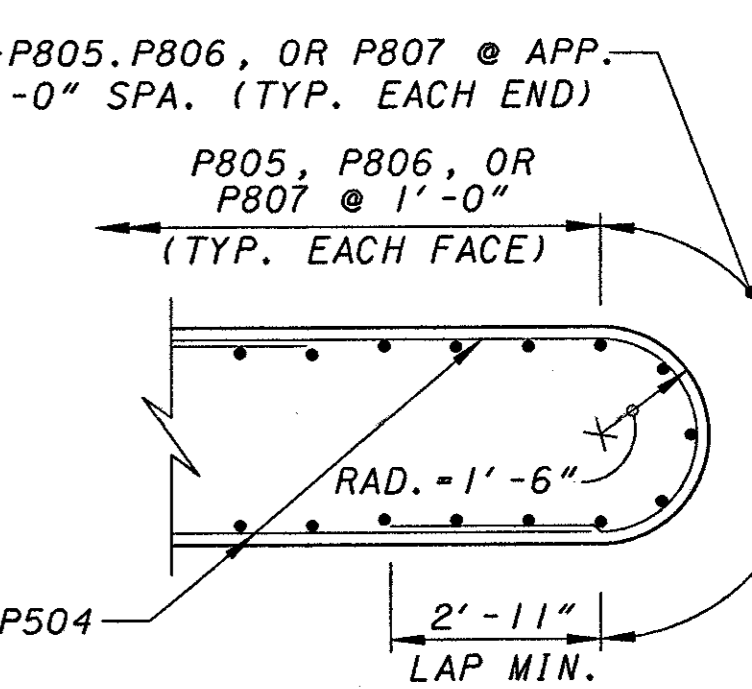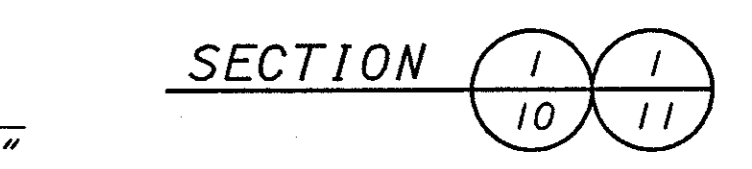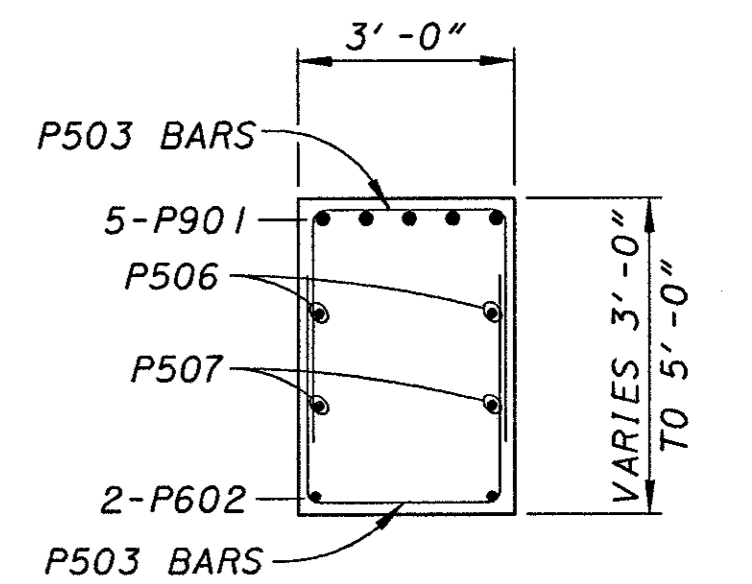

ANCHOR BOLT LAYOUT
 (PIER 2 ONLY)
 (SEE NOTE ON SHEET 1/27)

ALL STEEL CLEARANCES ARE 2" UNLESS OTHERWISE NOTED.

	(A)	(B)	(C)	(D)	(E)
PIER 1	1047.43	1047.30	1047.18	17'-8 1/8"	1022.00
PIER 2	1047.31	1047.18	1047.06	17'-6 3/4"	1022.00
PIER 3	1047.15	1047.02	1046.90	14'-4 3/4"	1025.00




REF: 1047.43
 REF: 1047.30
 REF: 1047.18
 REF: 1047.06
 REF: 1046.90

REF: 1047.43
 REF: 1047.30
 REF: 1047.18
 REF: 1047.06
 REF: 1046.90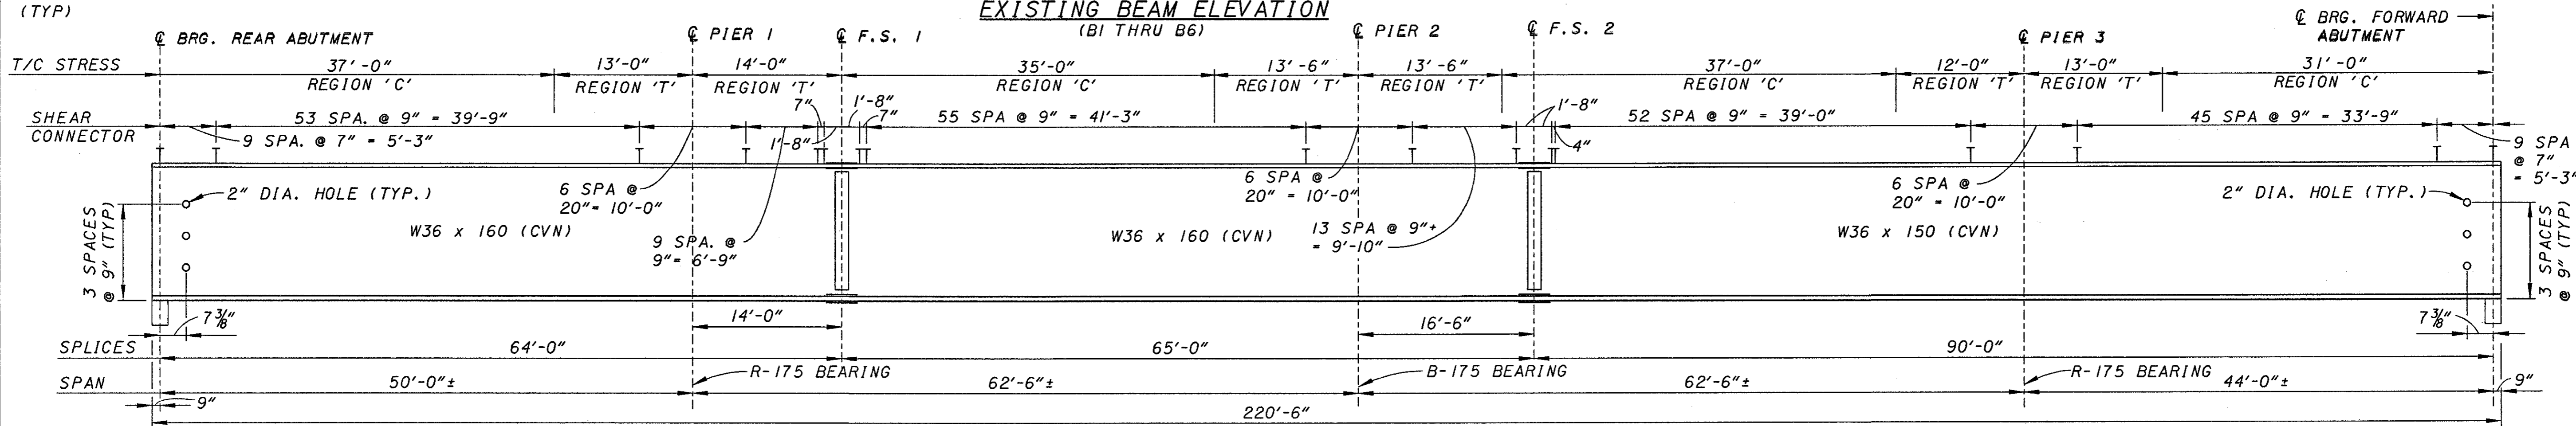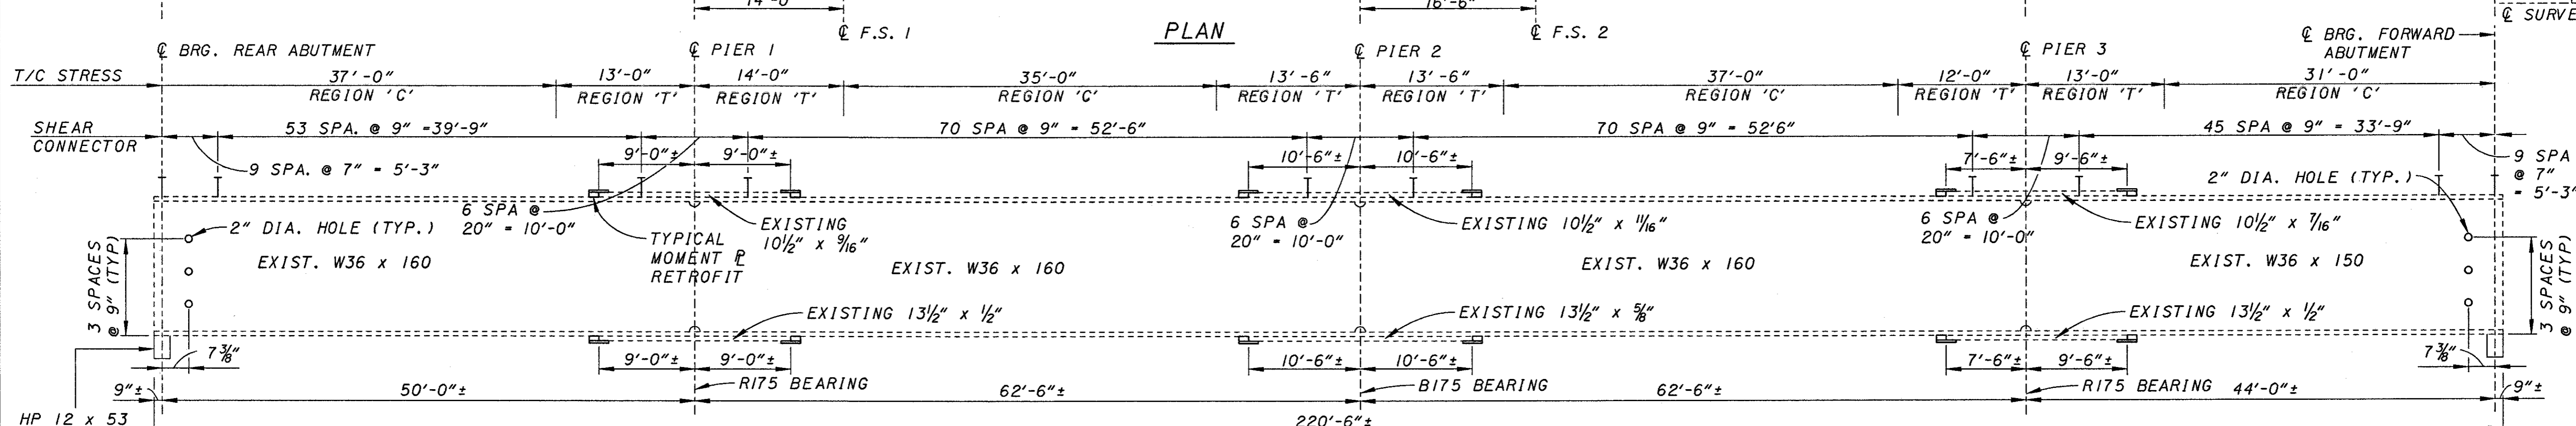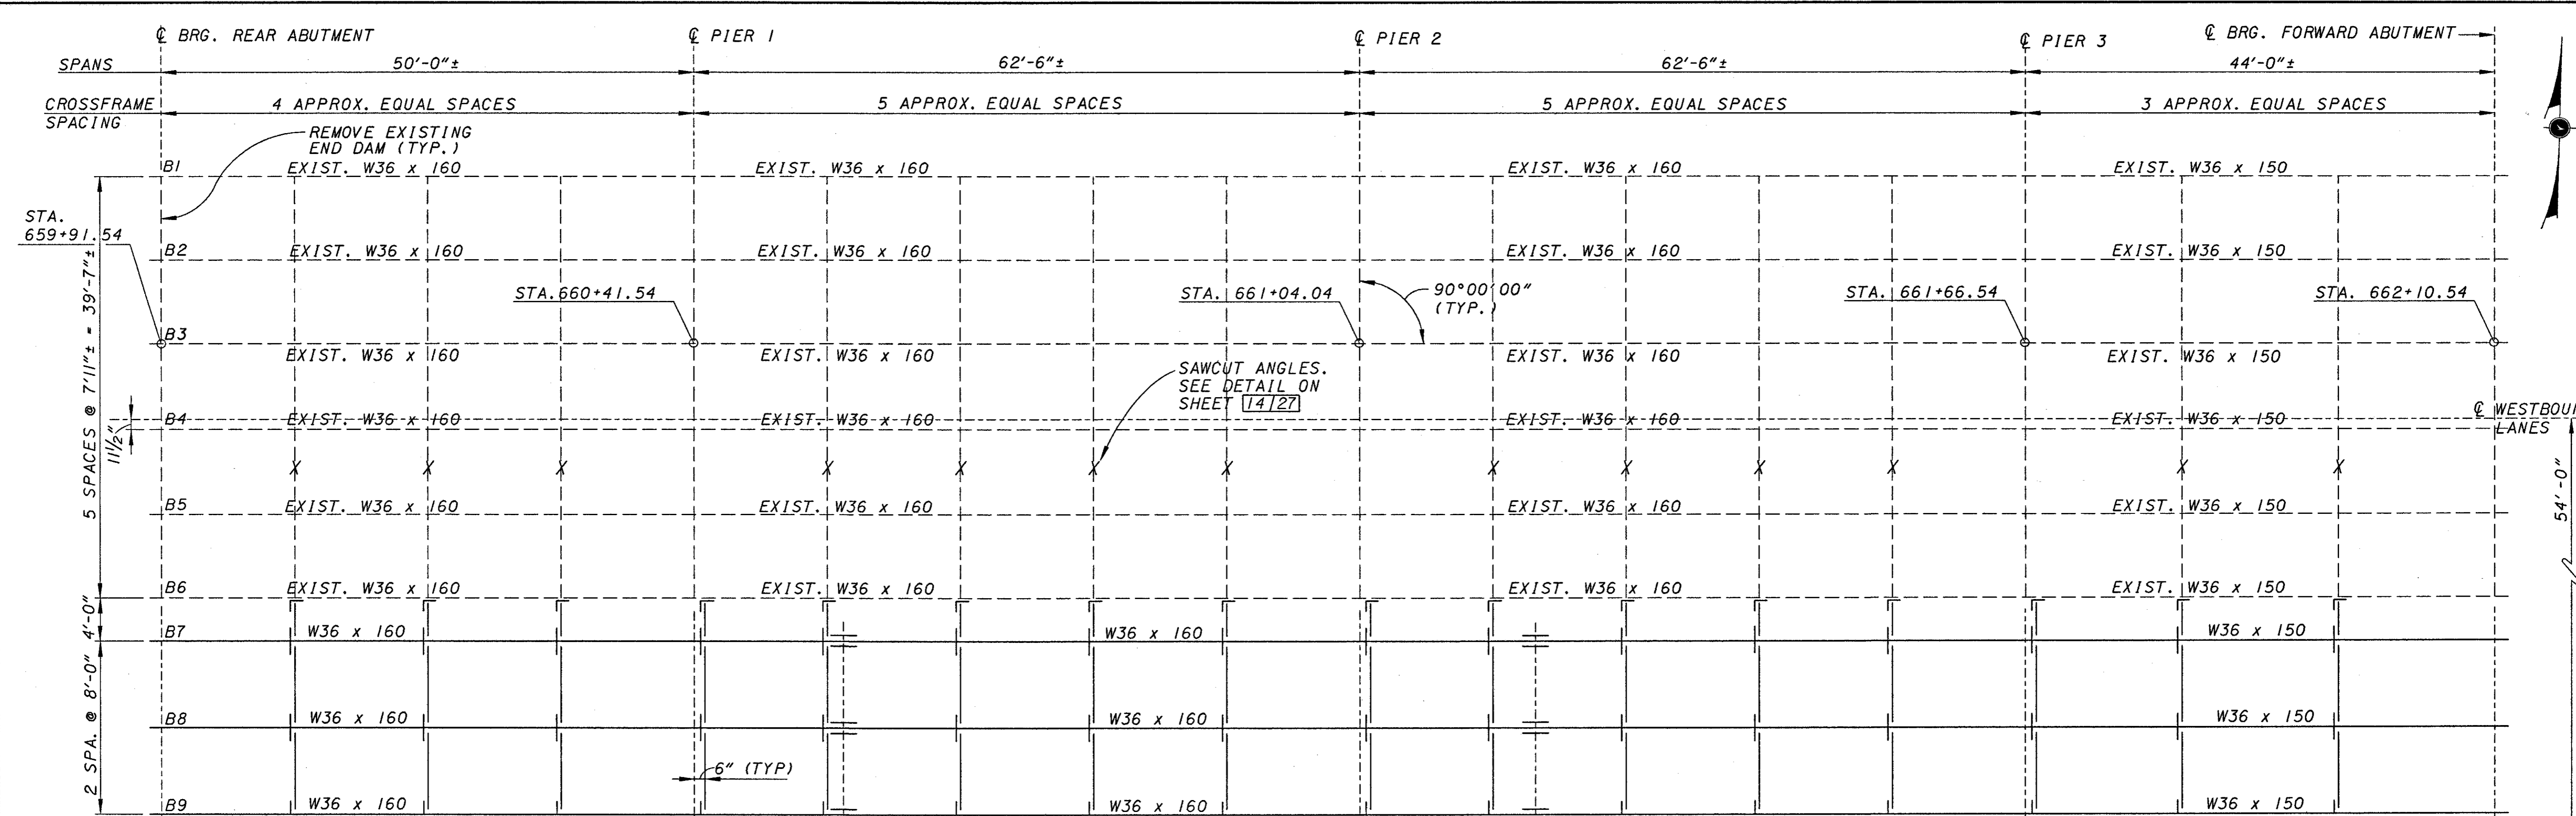

NEW BEAM ELEVATION
(B7 THRU B9)

NOTES

1. ALL NEW BEAMS TO BE GRADE 50 STEEL.

REF: **REF**
 REF: **REF**



REF: **REF**
 REF: **REF**
REF. #1: W36 x 160
 REF. #2: W36 x 150
 REF. #3: W36 x 160
 REF. #4: W36 x 160
 REF. #5: W36 x 160
 REF. #100: W36 x 160

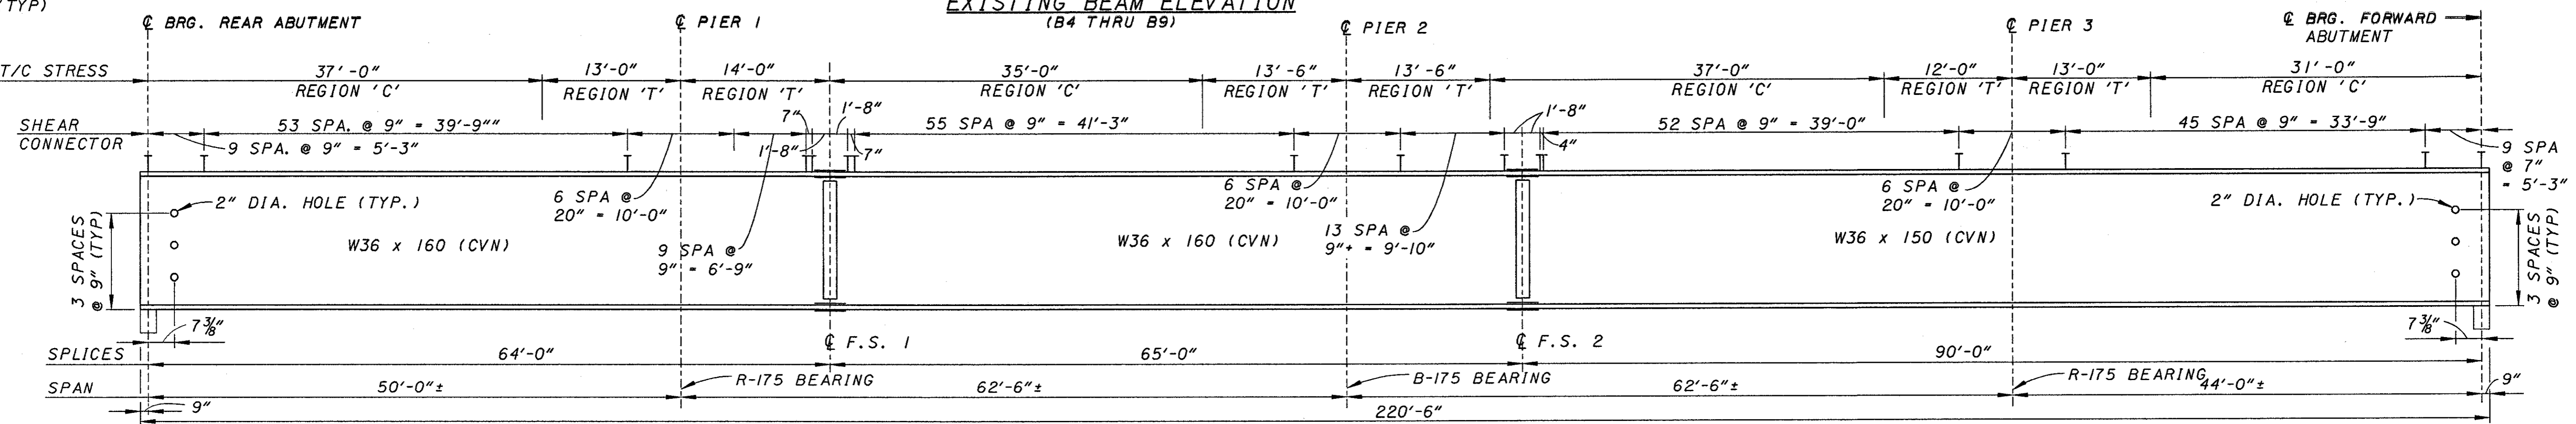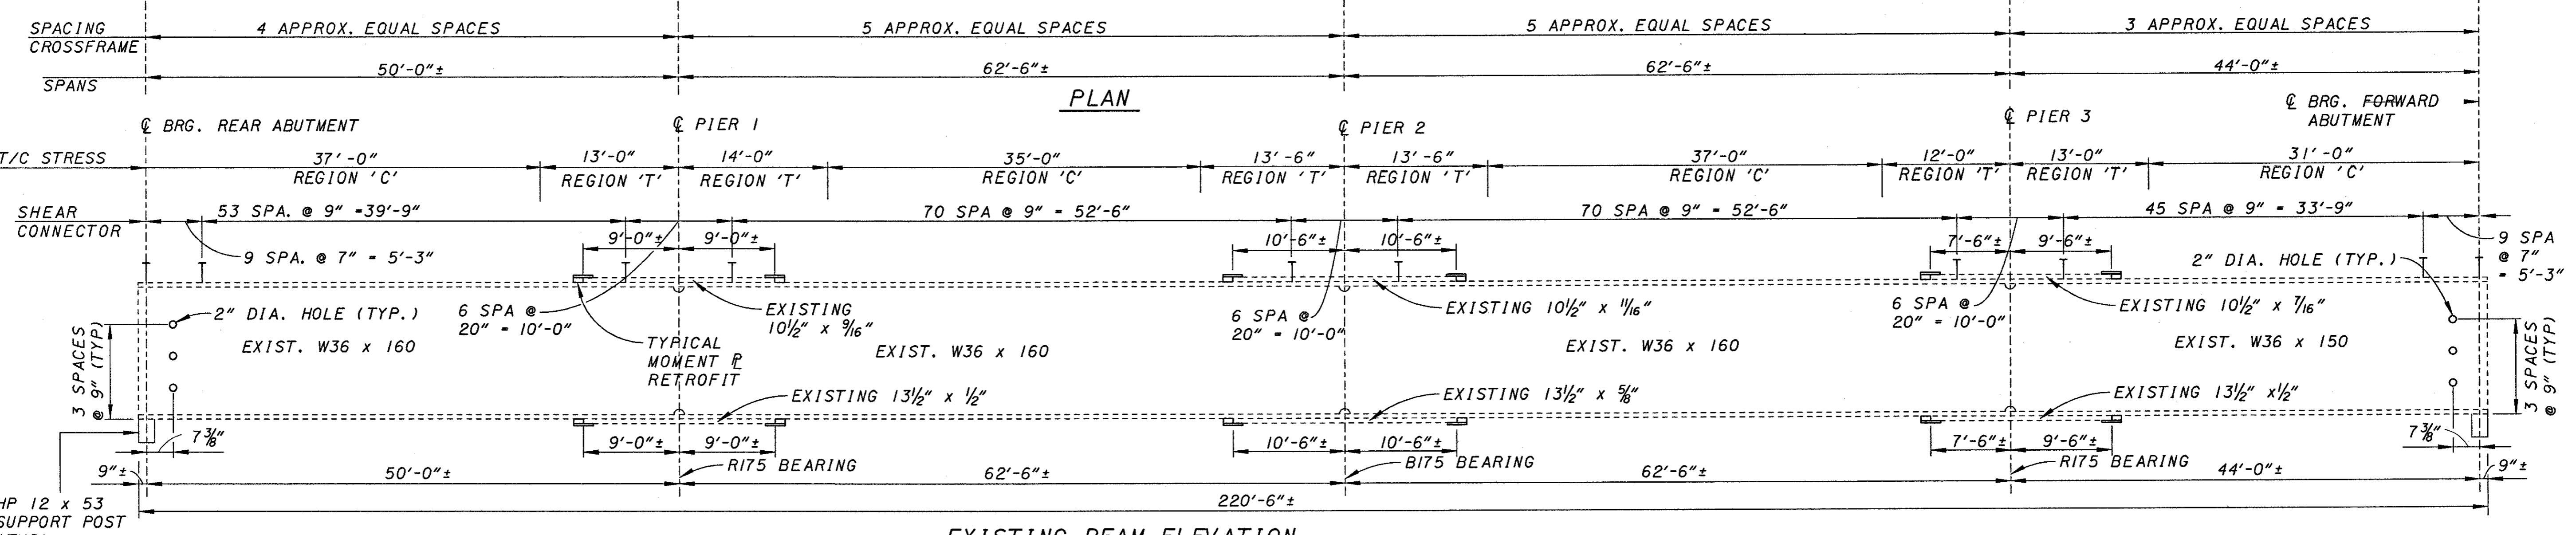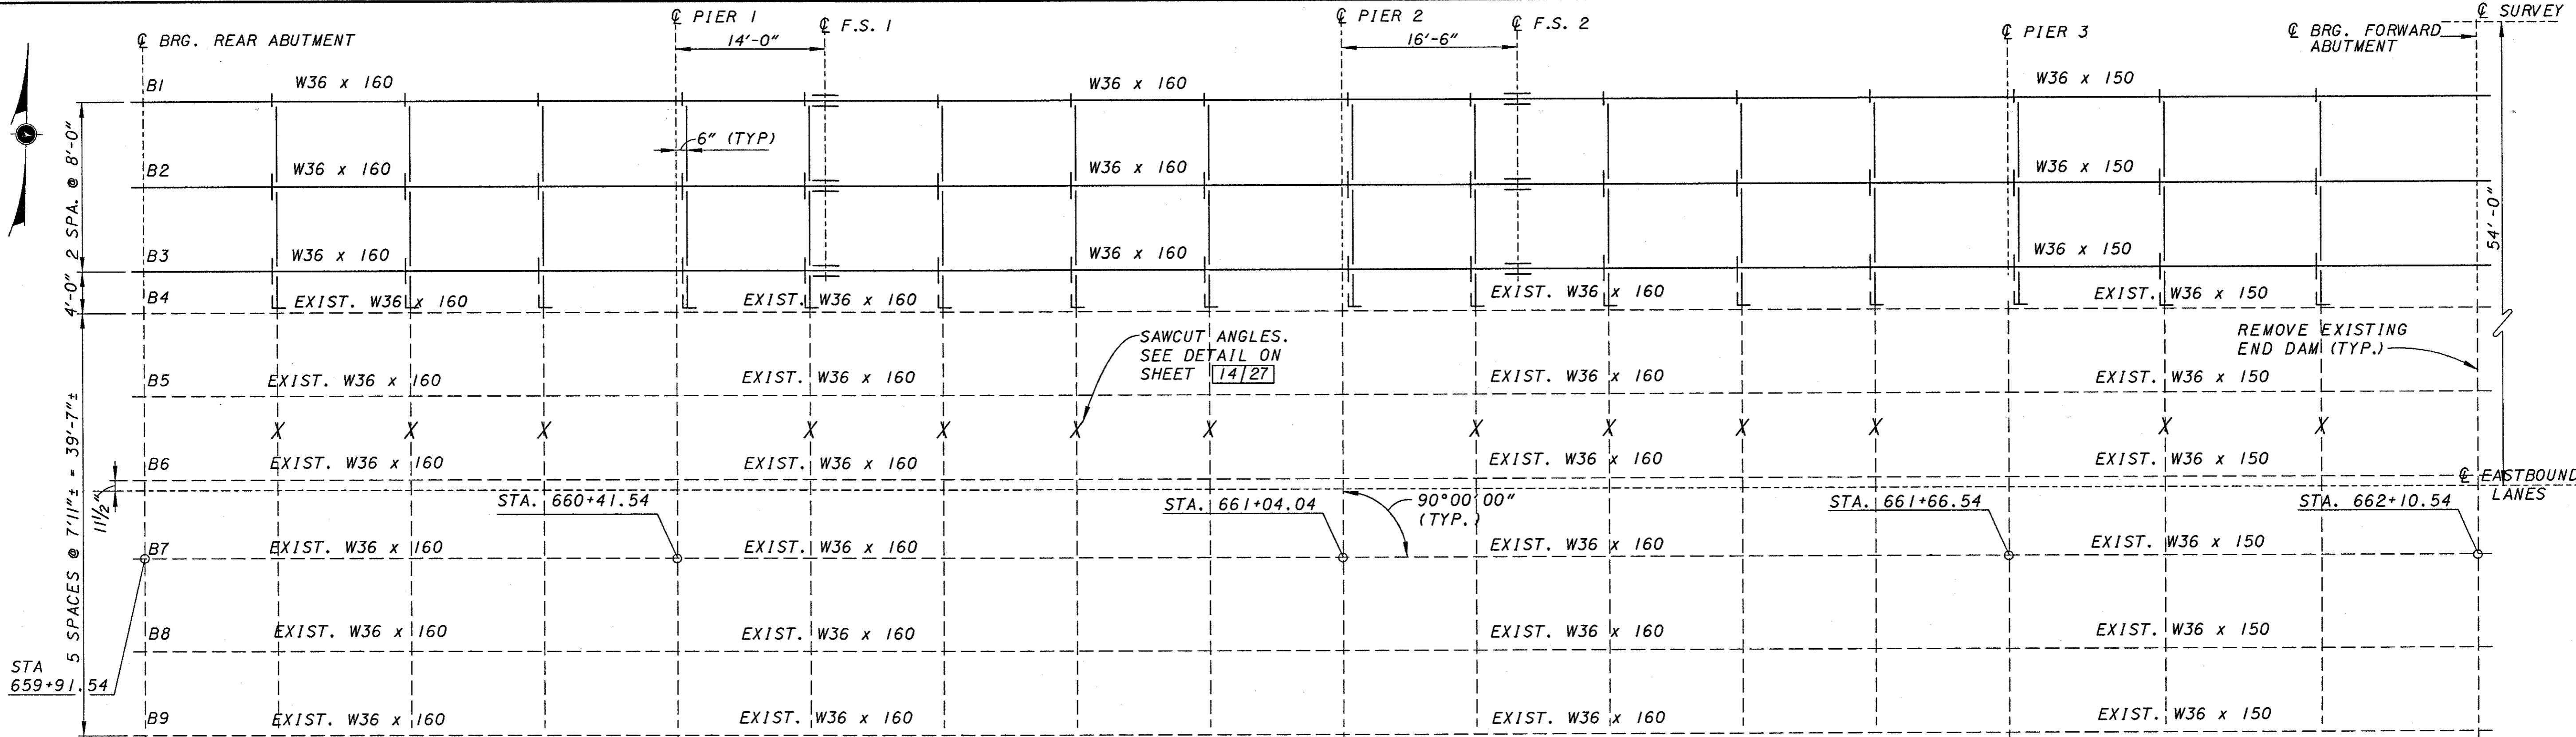

NOTES
 1. ALL NEW BEAMS TO BE GRADE 50 STEEL.

KZ DESIGN
 DESIGN AGENCY
 427 E. BROADWAY, SUITE 1200, NEW YORK, NY 10008
 TEL: 212 279 1111 FAX: 212 279 1112

DATE: 09/20/00
 DCK: 09/20/00
 STRUCTURE FILE NUMBER: 6801269/6801293
 REVISION: 10/03/00

DESIGNED: SJA
 CHECKED: WBS

FRAMING PLAN - RIGHT BRIDGE
 BRIDGE NO. PRE-70-1249 LRR
 I.R. 70 OVER PRICE CREEK

PRE-70-0.00

13 / 27

198
 283


DESIGNED	SJA	CHECKED	WBS
DRAWN	MWL	REVISED	10/03/00
REVIEWED	DGK	STRUCTURE FILE NUMBER	6801269/6801293
DATE	09/20/00		

KZF #13
FRAMING DETAILS
 BRIDGE NO. PRE-70-1249 L/R
 I.R. TO OVER PRICE CREEK

PRE-70-0.00


14 / 27

199
283

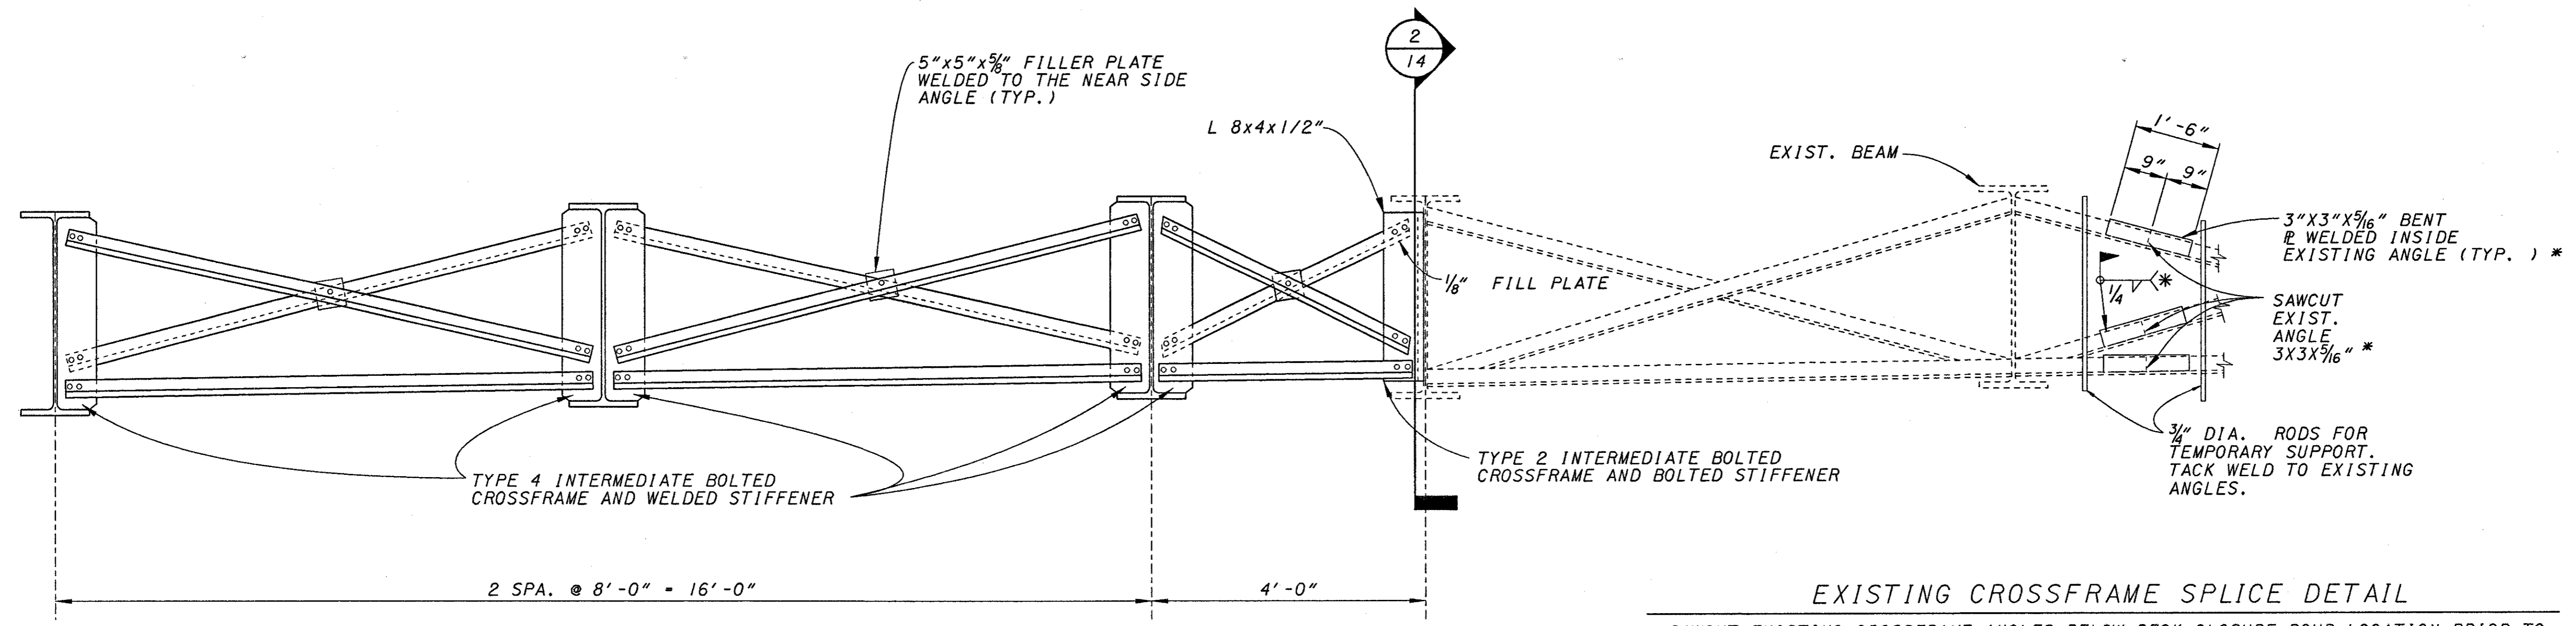


EXISTING CROSSFRAME SPLICE DETAIL


* SAWCUT EXISTING CROSSFRAME ANGLES BELOW DECK CLOSURE POUR LOCATION PRIOR TO DECK REMOVAL IN STAGE 1. SPLICE CROSSFRAME ANGLES BACK TOGETHER USING 3"X3" BENT PLATES AFTER STAGE 2 CONCRETE DECK HAS CURED PER CMS SPECIFICATIONS. AFTER SPLICING CROSSFRAME ANGLES PLACE CLOSURE DECK POUR.

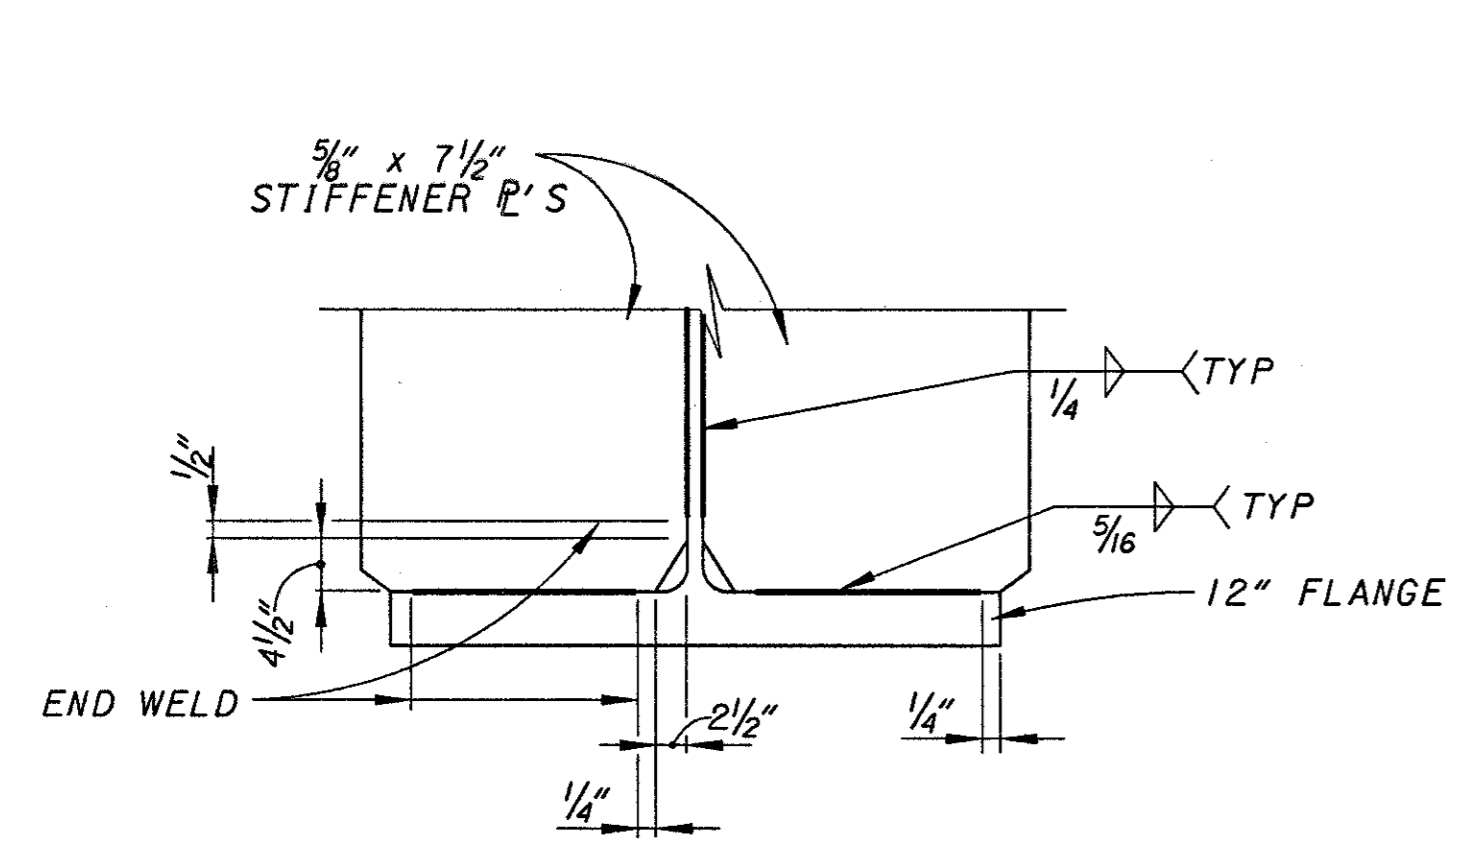

STIFFENER WELD DETAIL
(TYPICAL)

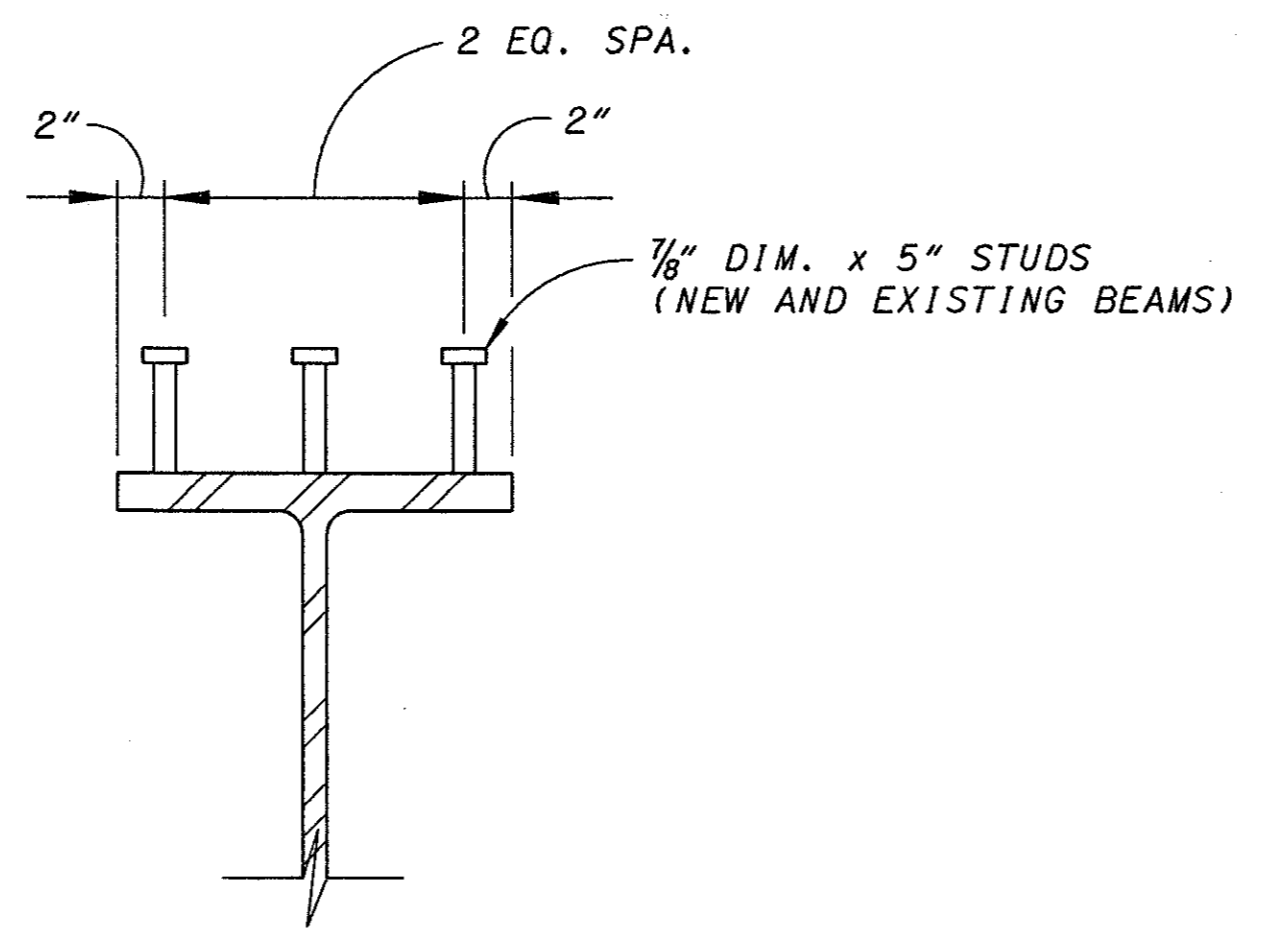


SHEAR CONNECTOR DETAIL

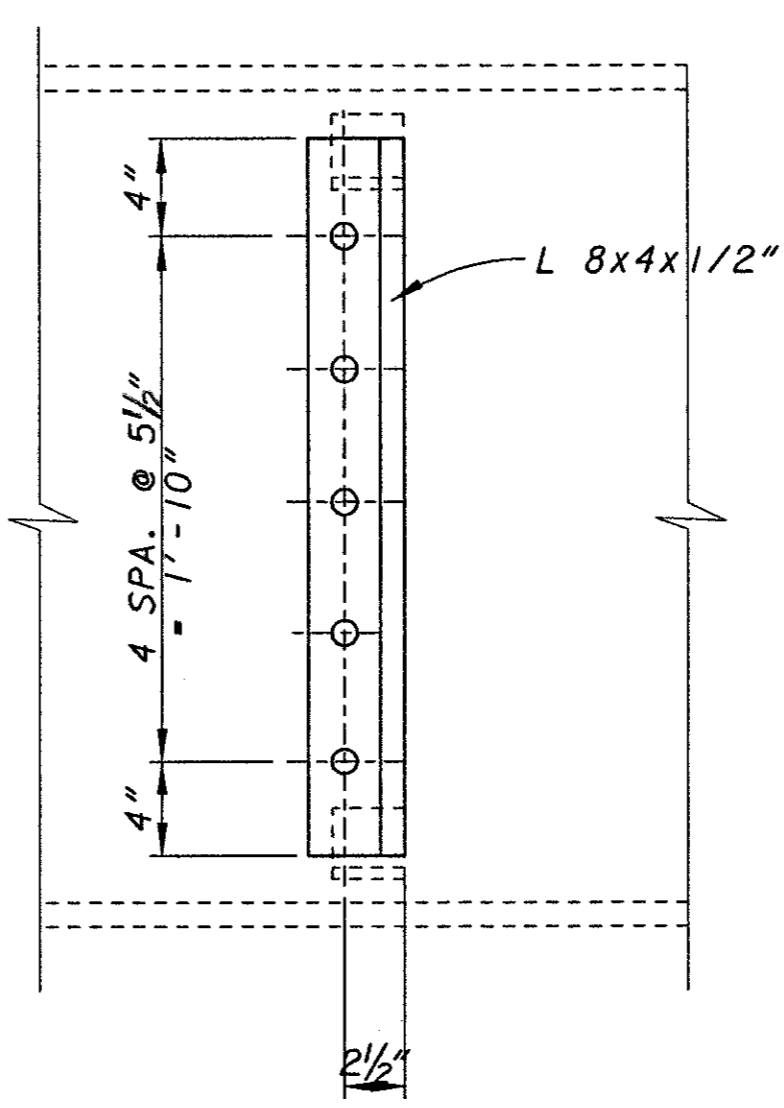


SECTION 2 / 14

- NOTES**
1. ALL NEW MATERIAL TO BE ASTM-A572/A709 GRADE 50 PAINTED UNLESS INDICATED OTHERWISE. ALL NEW AND EXISTING STEEL SHALL BE PAINTED OZEU (EXISTING) AND IZEU (NEW) WITH FEDERAL STANDARD COLOR 10324 (DARK NEUTRAL). STEEL SHALL BE FABRICATED IN ACCORDANCE WITH ODOT SUPPLEMENTAL SPECIFICATION 863.
 2. SEE SHEET **20/27** FOR WELDED ATTACHMENT NOTE.
 3. REGION "T" DENOTES TOP FLANGE IN TENSION AND BOTTOM FLANGE IN COMPRESSION (NEGATIVE MOMENT REGION).
 4. REGION "C" DENOTES TOP FLANGE IN COMPRESSION AND BOTTOM FLANGE IN TENSION (POSITIVE MOMENT REGION).
 5. SEE SHEET **17/27** FOR DEFLECTION AND CAMBER DETAILS.
 6. SEE STANDARD DRAWING RB-1-55 FOR R-175 AND B-175 BEARINGS.
 7. WHERE A SHAPE OR PLATE IS DESIGNATED (CVN) THE MATERIAL SHALL MEET MINIMUM NOTCH TOUGHNESS REQUIREMENTS AS SPECIFIED IN 711.01 OF CMS.
 8. ALL BOLTS TO BE HIGH STRENGTH 1 1/8" DIA. A325, UNLESS OTHERWISE NOTED.
 9. SEE STANDARD DRAWING GSD-1-96 FOR ADDITIONAL CROSSFRAME DETAILS.
 10. STIFFENERS TO BE NORMAL TO BEAMS.
 11. CONCRETE END DIAPHRAGMS AT ABUTMENTS SHALL BE PLACED AT LEAST 48 HOURS BEFORE ANY DECK CONCRETE IS PLACED.
 12. END DIAPHRAGM CONCRETE SHALL BE HIGH PERFORMANCE.

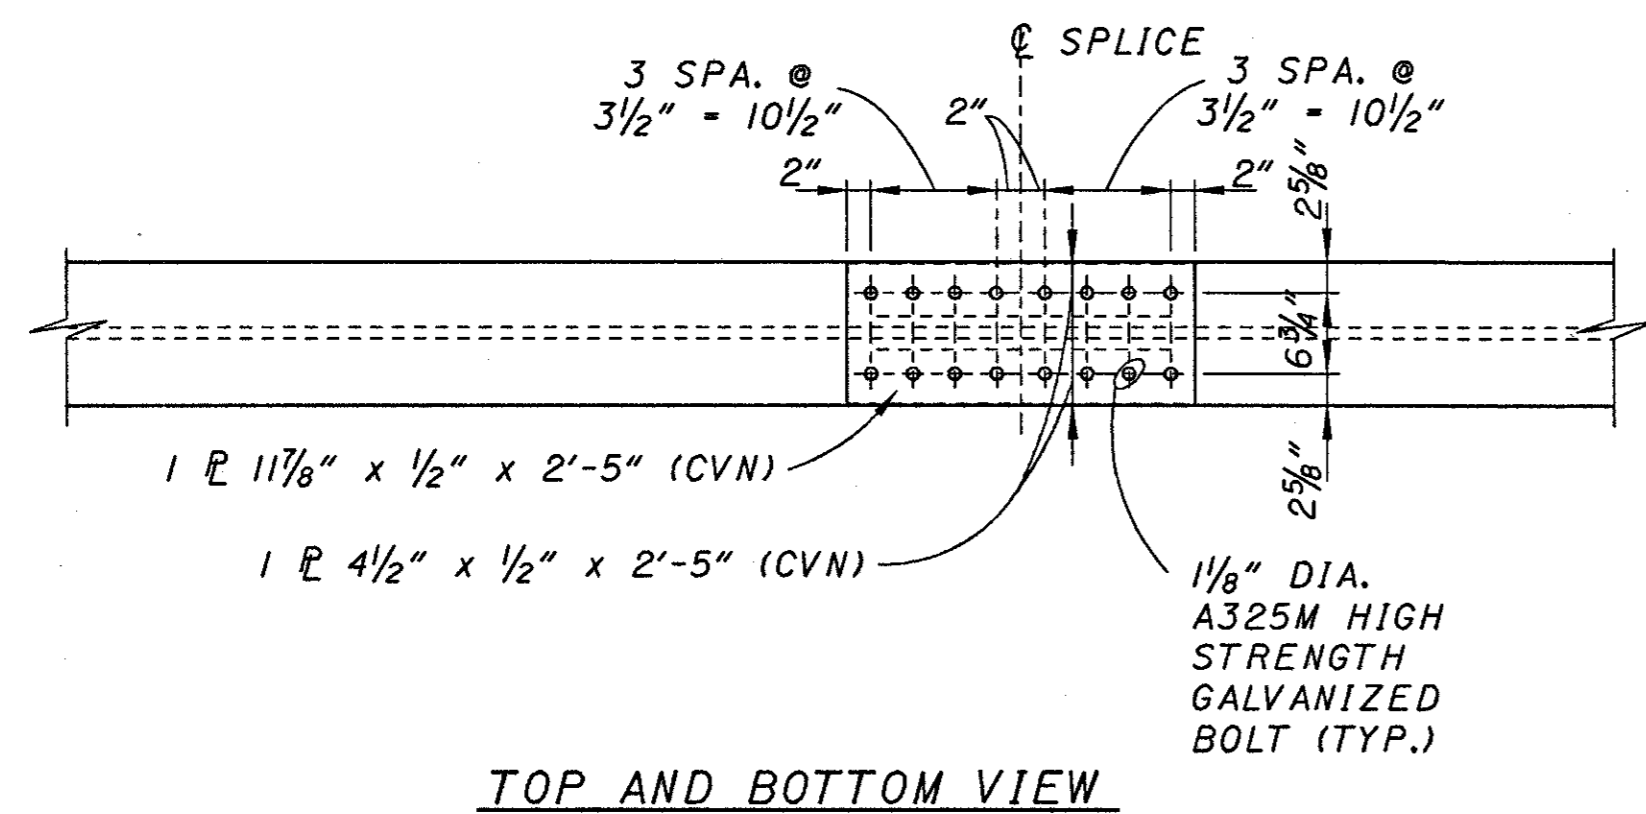


TOP AND BOTTOM VIEW

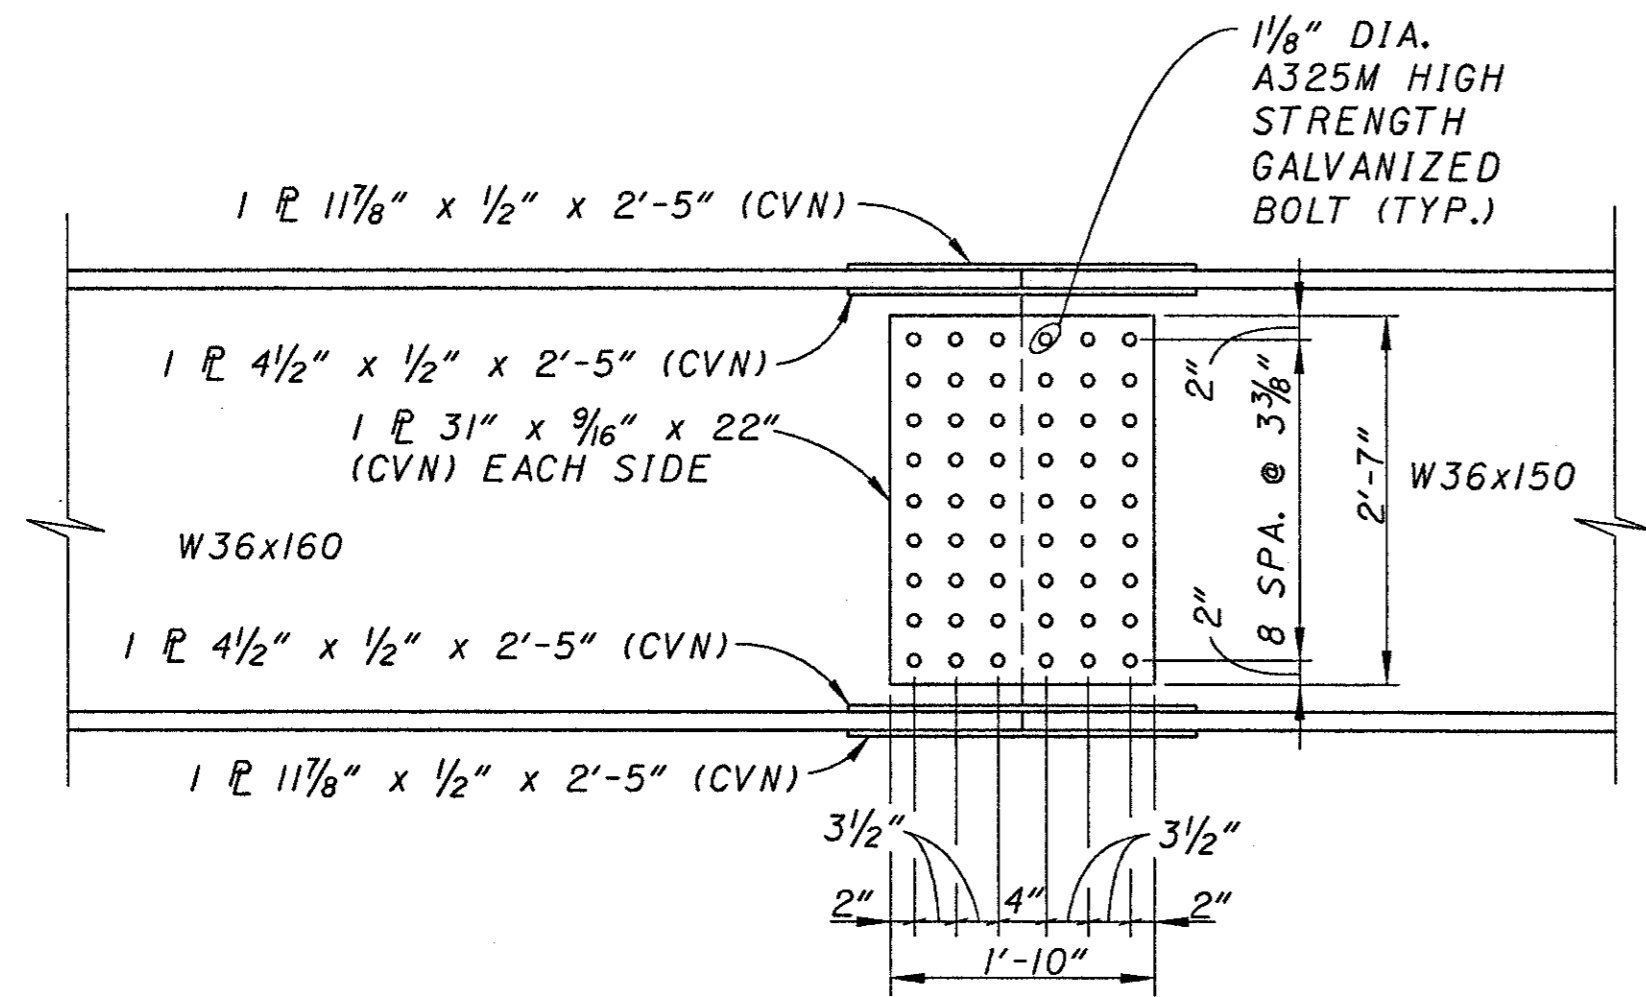


W36 X 150 BEAM SPLICE DETAIL


* PLACE BOLT HEADS ON EXPOSED SIDE OF FASCIA BEAMS AND BOTTOM SURFACE OF LOWER FLANGE

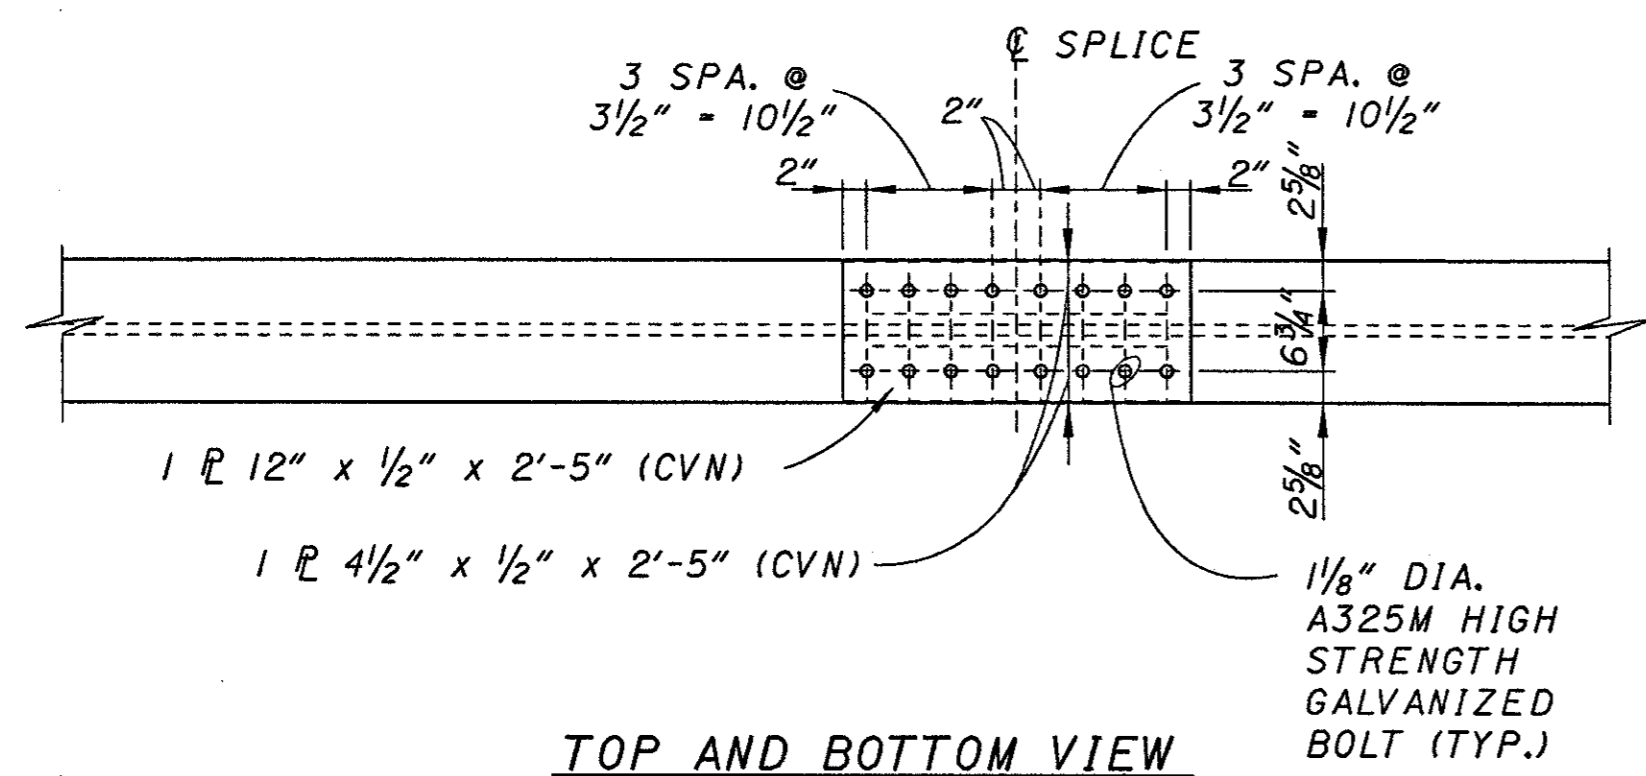


TOP AND BOTTOM VIEW

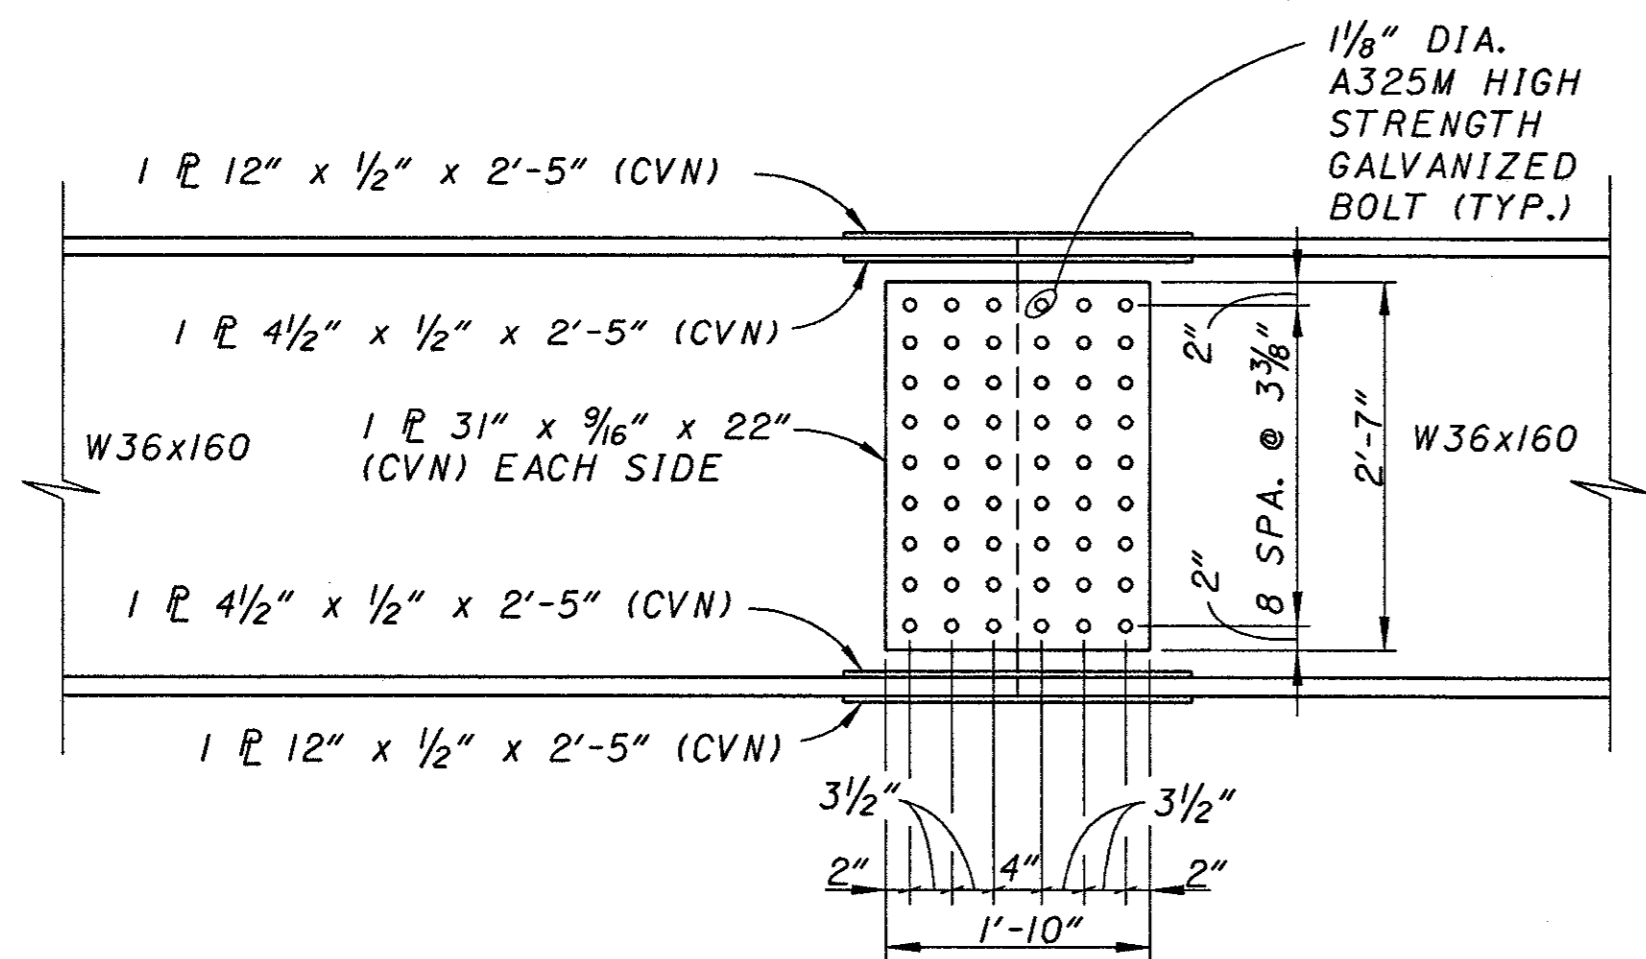

W36 X 160 BEAM SPLICE DETAIL

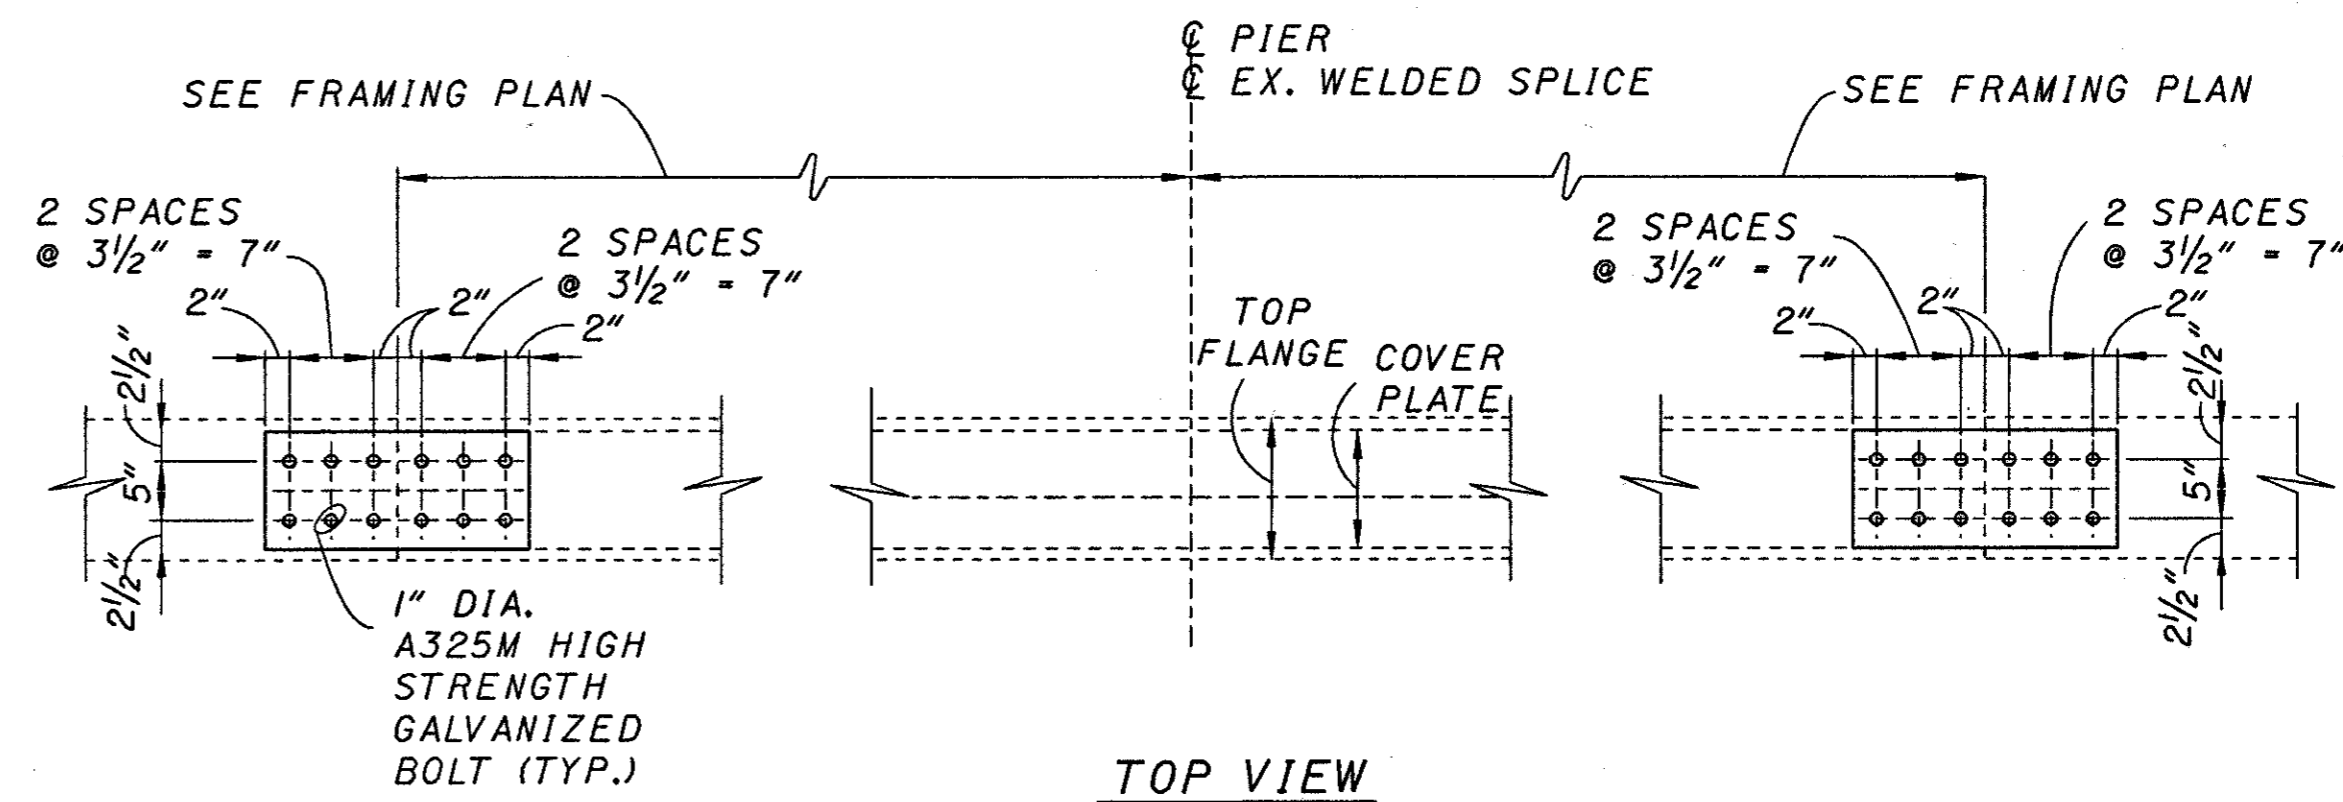


TOP VIEW

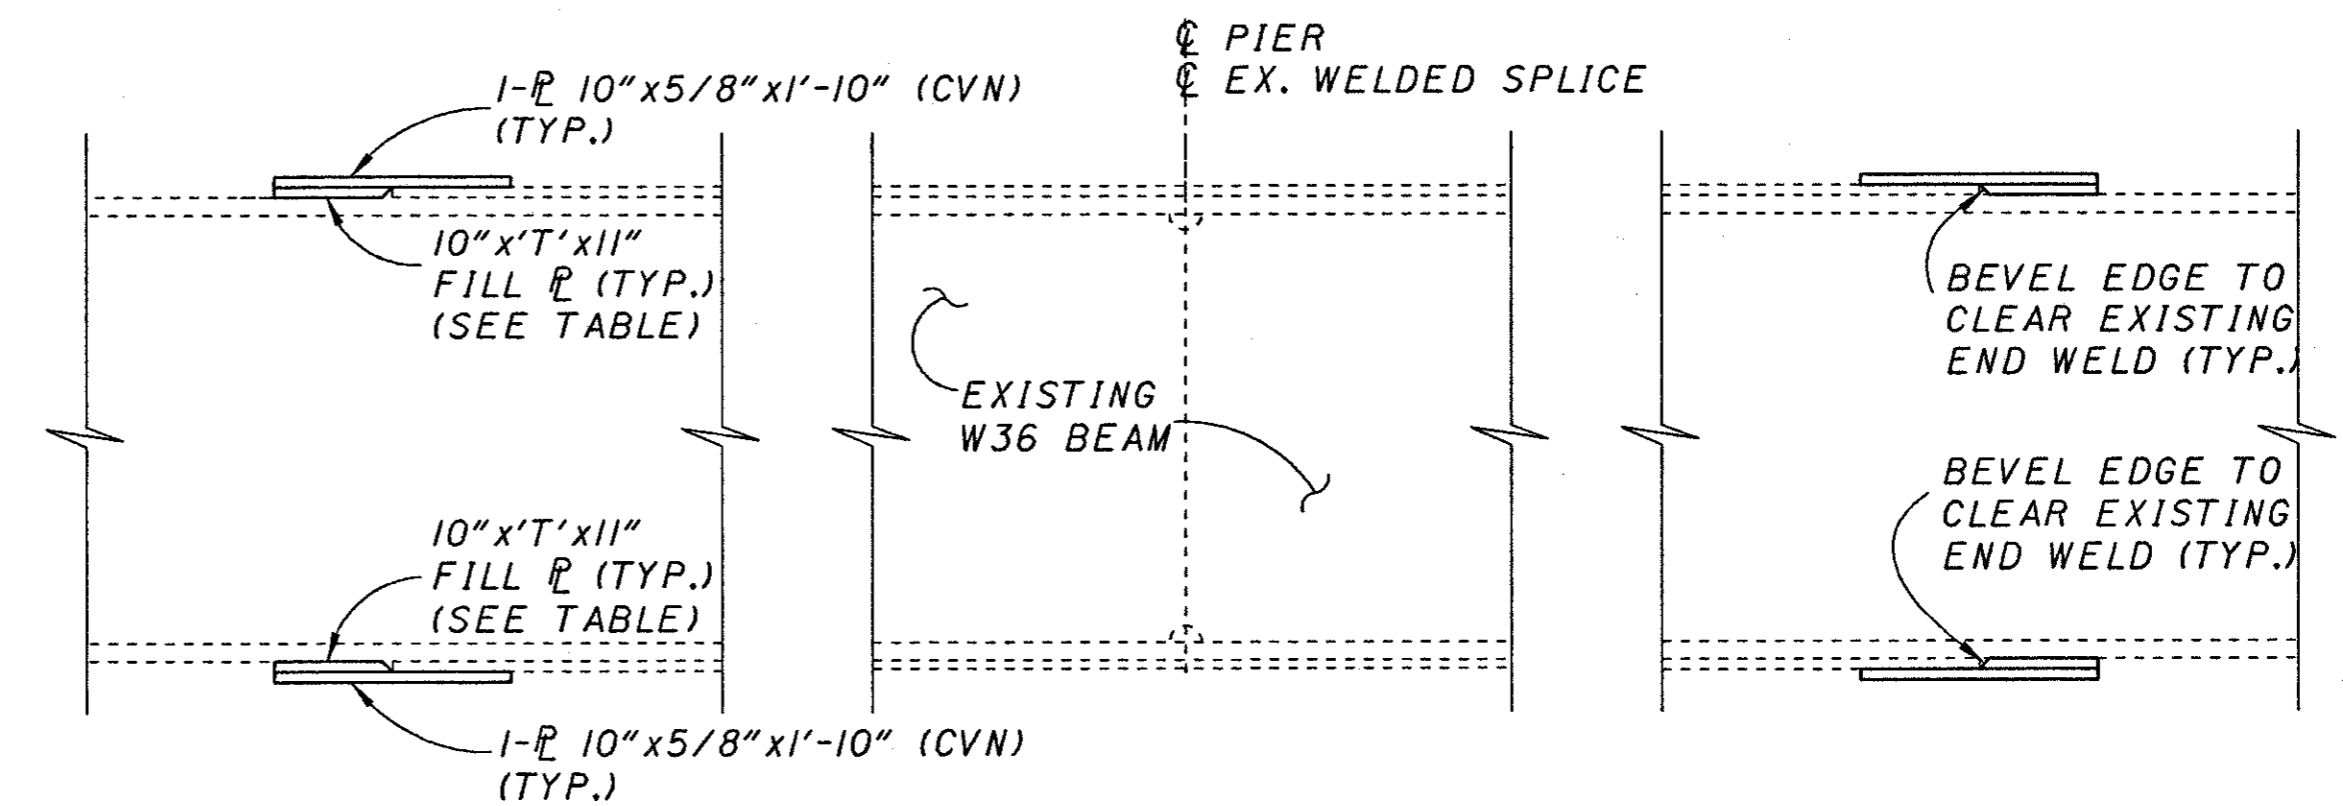

EXIST. W36 MOMENT PLATE RETROFIT DETAIL

(THIS DETAIL CONSTITUTES ONE MOMENT PLATE RETROFIT)

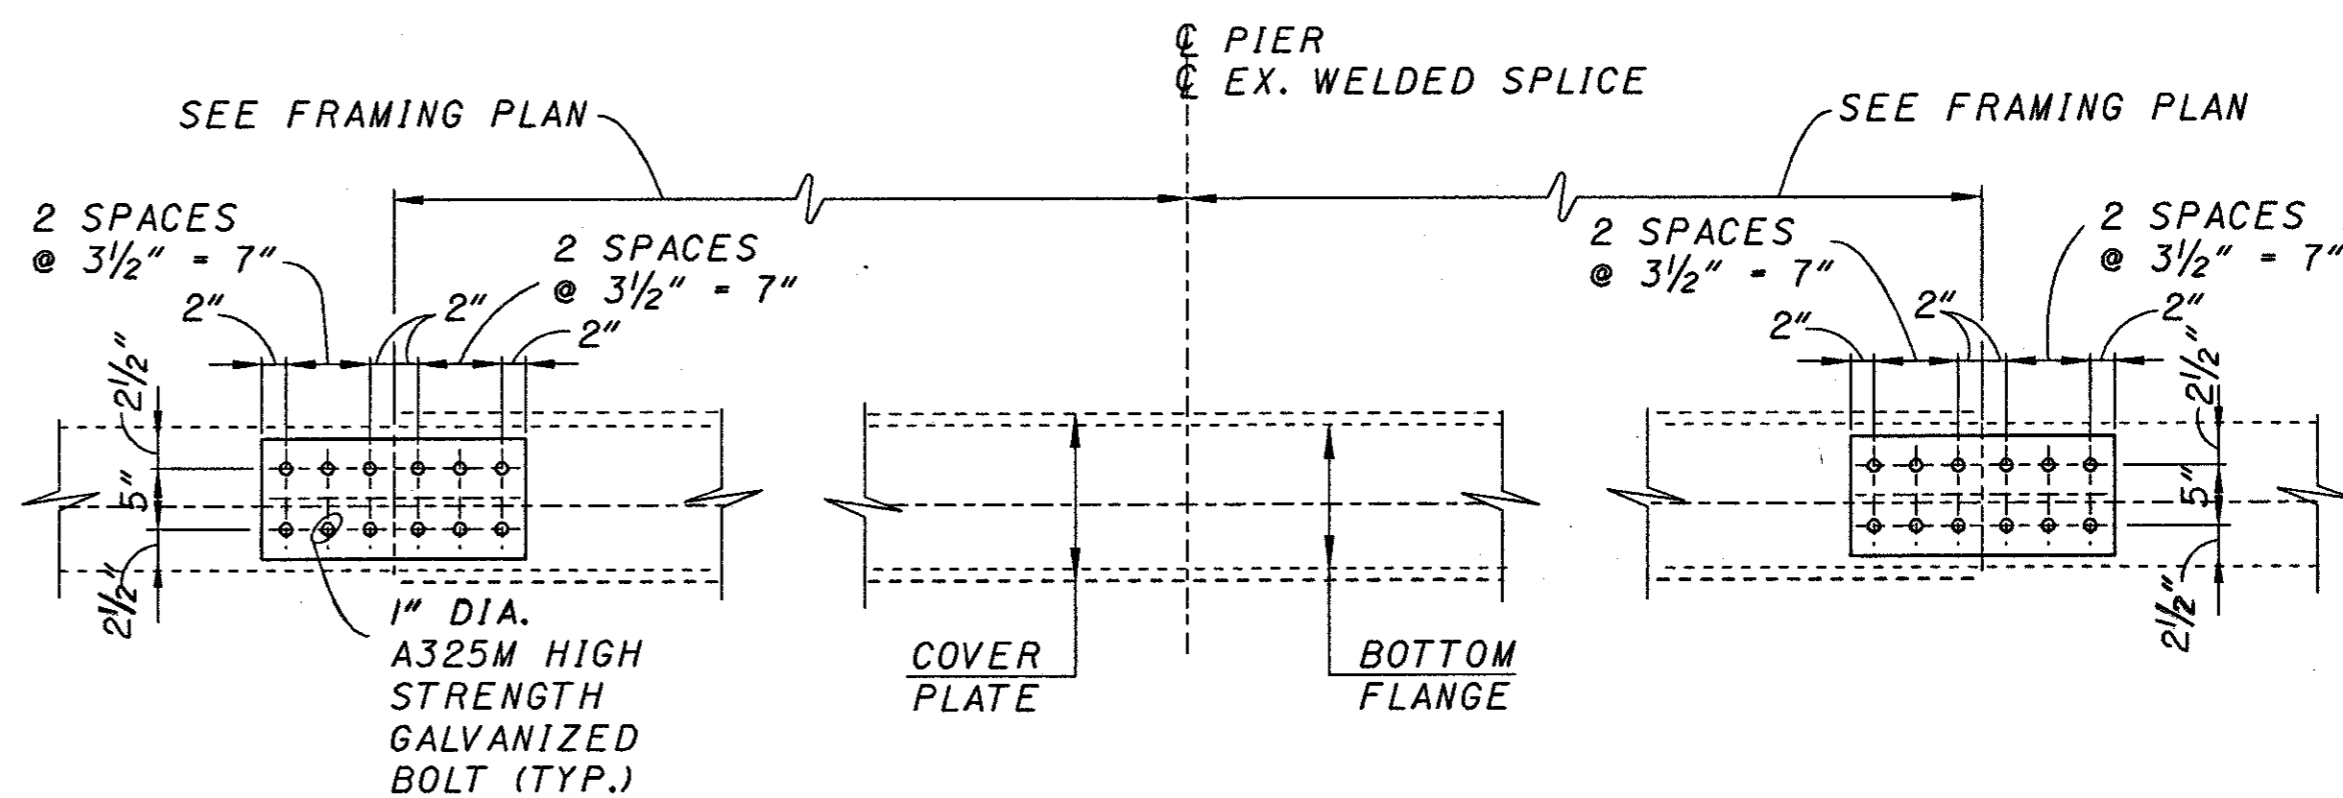

BOTTOM VIEW

FILL PLATE THICKNESS 'T'		
	TOP FLANGE	BOTTOM FLANGE
PIER 1	9/16"	1/2"
PIER 2	11/16"	5/8"
PIER 3	7/16"	1/2"

NOTES:

1. ALL MOMENT PLATE RETROFIT STEEL SHALL BE A709-36.
2. MOMENT PLATE RETROFIT WORK TO BE DONE ON A TIME AND MATERIAL BASIS.
3. SEE STANDARD DRAWING GSD-I-96 FOR ADDITIONAL CROSSFRAME DETAILS.
4. SEE STANDARD DRAWING BS-I-93 FOR ADDITIONAL SPLICE DETAILS.


REF: **REF1**
REF: **REF2**
REF: **REF3**
REF: **REF4**
REF: **REF5**
REF: **REF6**
REF: **REF7**
REF: **REF8**
REF: **REF9**
REF: **REF10**

REF: **REF1**
REF: **REF2**
REF: **REF3**
REF: **REF4**
REF: **REF5**
REF: **REF6**
REF: **REF7**
REF: **REF8**
REF: **REF9**
REF: **REF10**

REF: **REF1**
REF: **REF2**
REF: **REF3**
REF: **REF4**
REF: **REF5**
REF: **REF6**
REF: **REF7**
REF: **REF8**
REF: **REF9**
REF: **REF10**


REF: **REF1**
REF: **REF2**
REF: **REF3**
REF: **REF4**
REF: **REF5**
REF: **REF6**
REF: **REF7**
REF: **REF8**
REF: **REF9**
REF: **REF10**

DESIGNER: *****
CHECKED: *****
DATE: *****
ACTIVE LEVELS: ON *BELIEVES

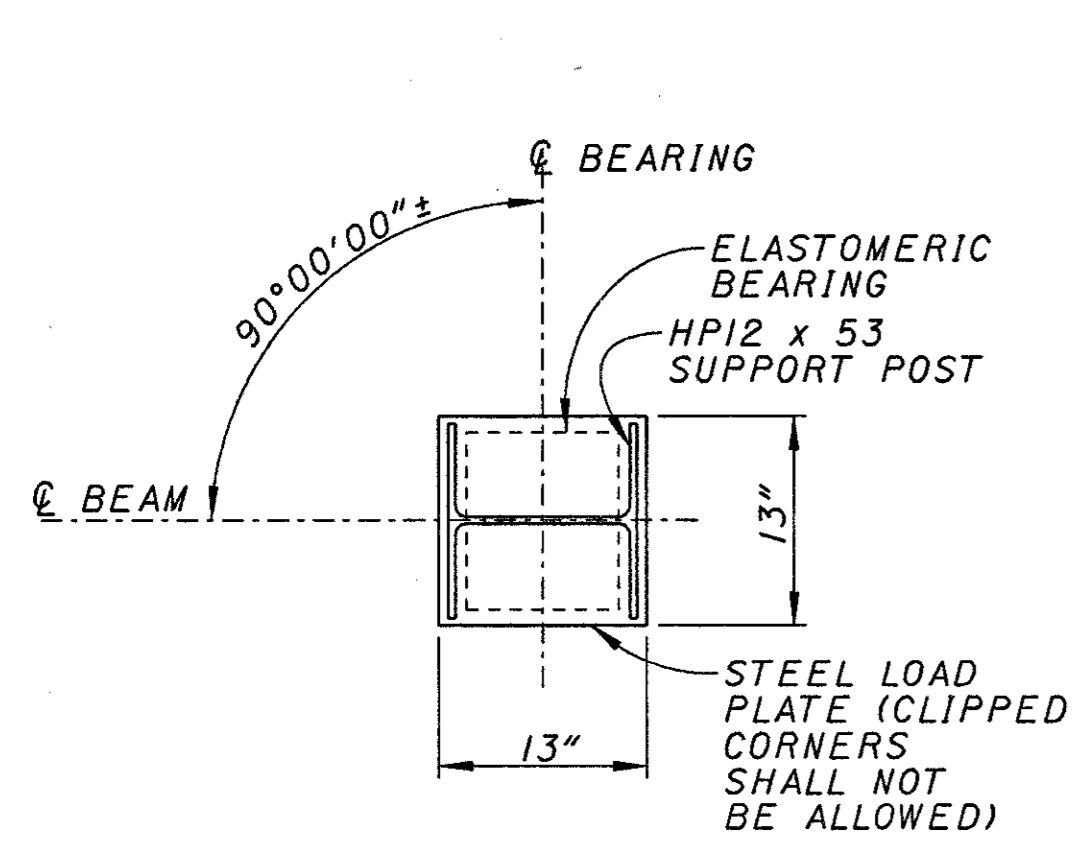

PLAN

REAR ABUTMENT	
(MAX.) DEAD LOAD REACTION	= 50.1 KIPS
(MAX.) LIVE LOAD REACTION	= 45.4 KIPS
MAX DESIGN LOAD	= 95.5 KIPS

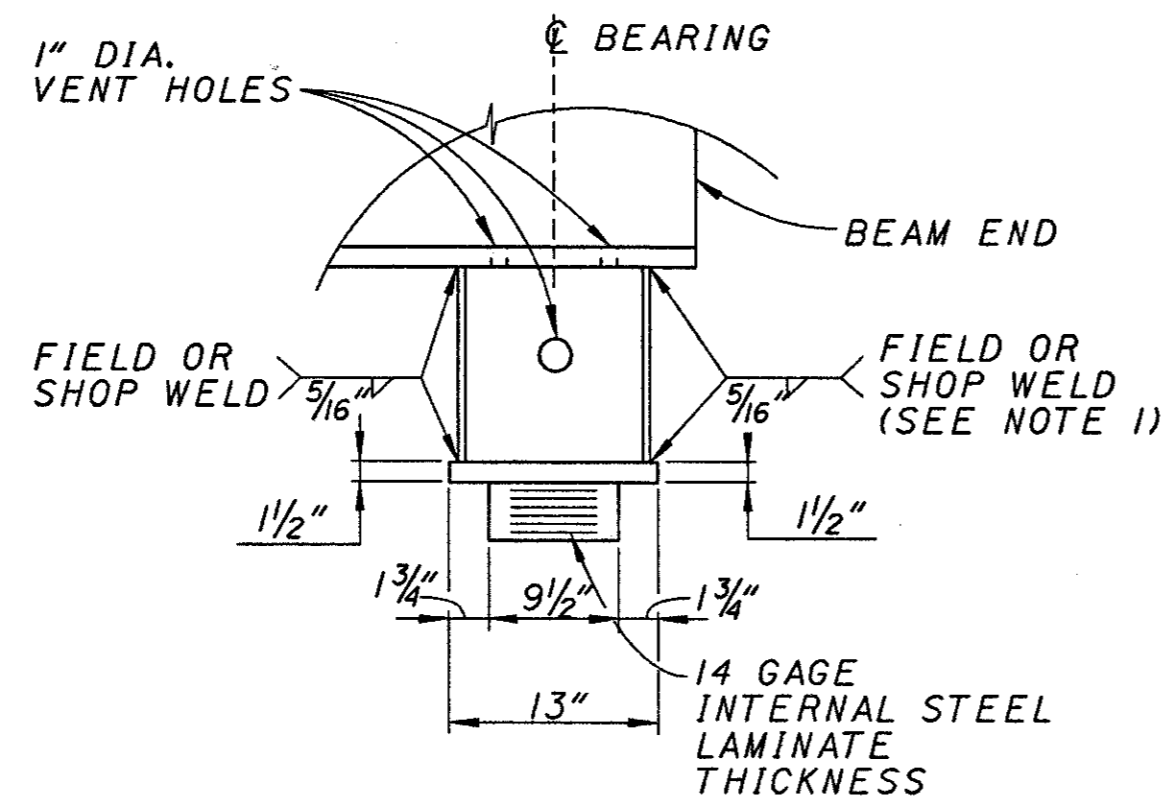


SIDE ELEVATION

NEW BEAM SHOWN
(EX. BEAM SIMILAR)

EXTERIOR ELASTOMERIC LAYERS	2 X 0.19 In = 0.387 In
INTERIOR ELASTOMERIC LAYERS	6 X 0.28 In = 1.68 In
STEEL PLATES	7 X 0.075 In = 0.525 In
TOTAL	'T' = 2.59 In


LAMINATED ELASTOMERIC EXPANSION
BEARING AT ABUTMENTS (18 REQ'D)
50 DUROMETER ELASTOMER, GRADE 3

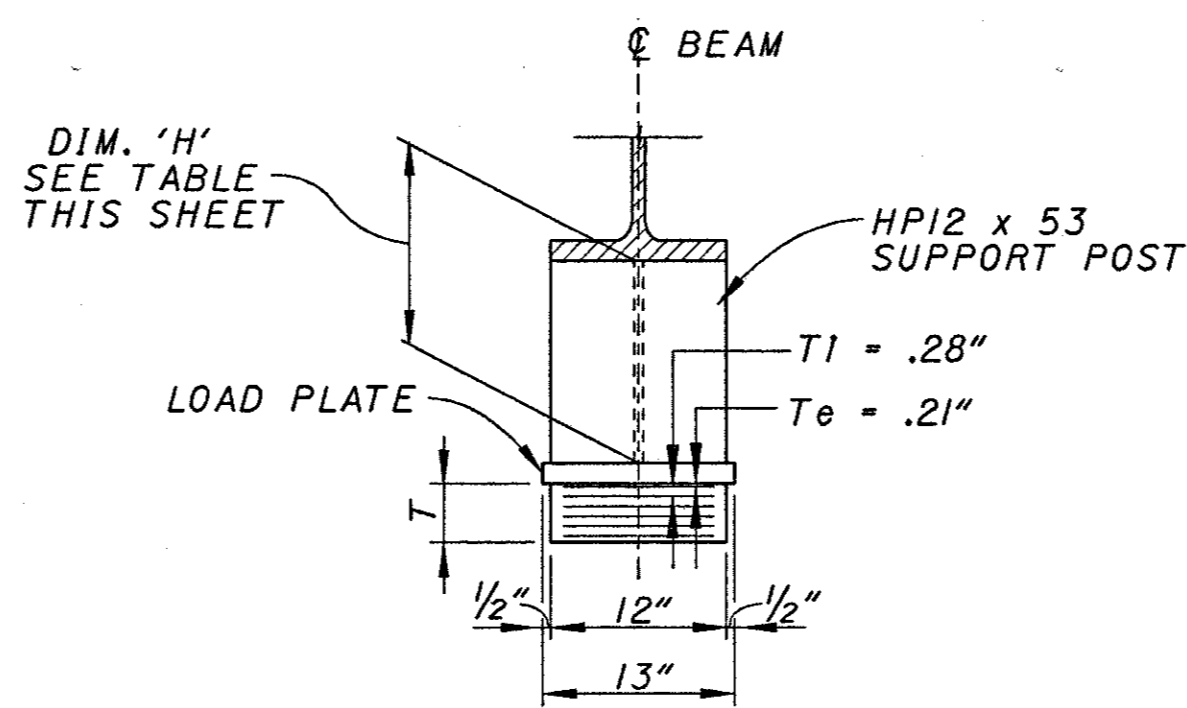

END ELEVATION


SUPPORT POST HEIGHT TABLE			
LEFT BRIDGE			
REAR ABUTMENT BEAM	"H"	FORWARD ABUTMENT BEAM	"H"
B1	6 5/8"	B1	6 5/8"
B2	6 5/8"	B2	6 5/8"
B3	6 5/8"	B3	6 5/8"
B4	6 5/8"	B4	6 5/8"
B5	6 5/8"	B5	6 5/8"
B6	6 5/8"	B6	6 5/8"
B7	9 5/8"	B7	9 3/8"
B8	8 1/8"	B8	7 1/8"
B9	6 5/8"	B9	6 5/8"

SUPPORT POST HEIGHT TABLE			
RIGHT BRIDGE			
REAR ABUTMENT BEAM	"H"	FORWARD ABUTMENT BEAM	"H"
B1	6 5/8"	B1	6 5/8"
B2	8 1/8"	B2	7 7/8"
B3	9 5/8"	B3	9 3/8"
B4	6 5/8"	B4	6 5/8"
B5	6 5/8"	B5	6 5/8"
B6	6 5/8"	B6	6 5/8"
B7	6 5/8"	B7	6 5/8"
B8	6 5/8"	B8	6 5/8"
B9	6 5/8"	B9	6 5/8"

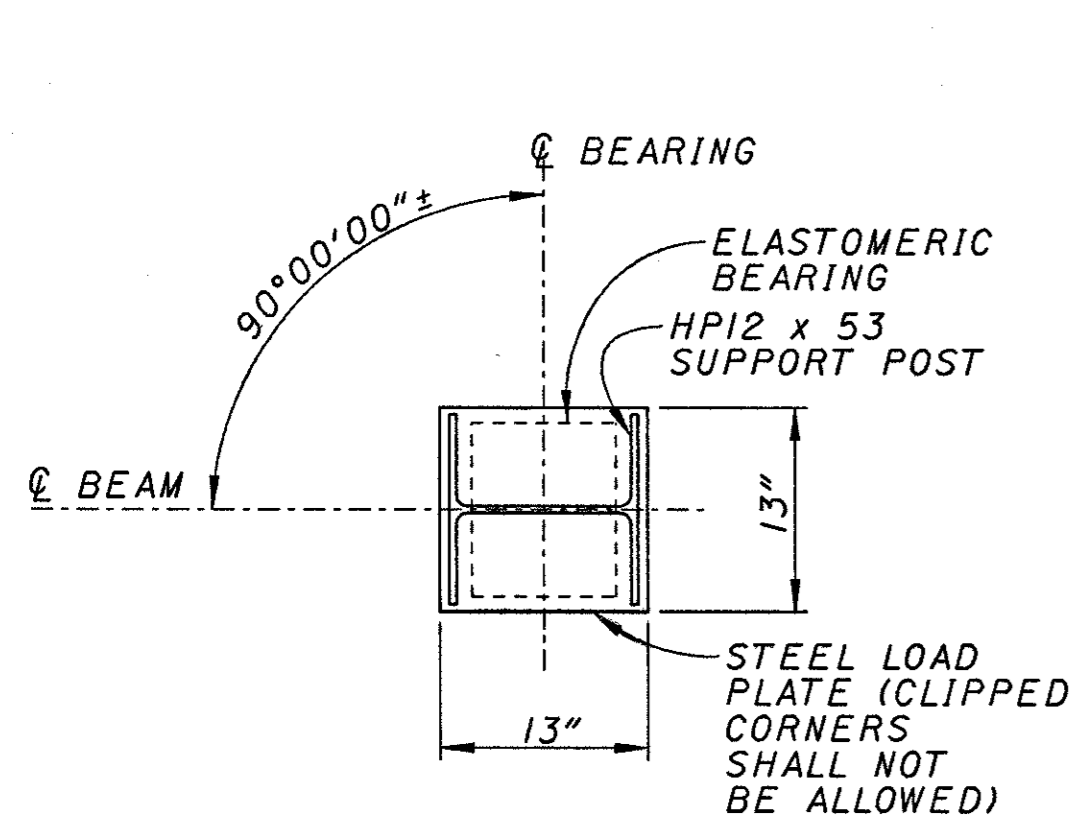

PLAN

FORWARD ABUTMENT	
(MAX.) DEAD LOAD REACTION	= 44.6 KIPS
(MAX.) LIVE LOAD REACTION	= 44.1 KIPS
MAX DESIGN LOAD	= 88.7 KIPS

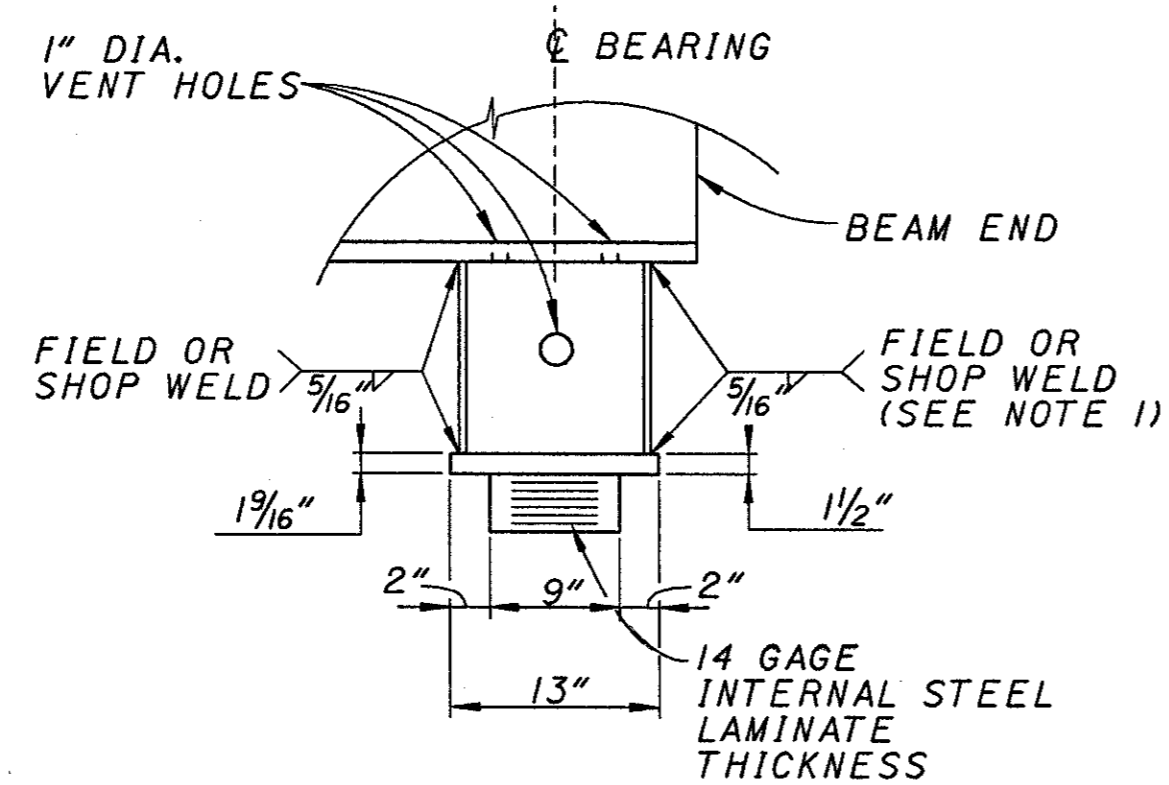


SIDE ELEVATION

NEW BEAM SHOWN
(EX. BEAM SIMILAR)

EXTERIOR ELASTOMERIC LAYERS	2 X 0.19 In = 0.38 In
INTERIOR ELASTOMERIC LAYERS	6 X 0.28 In = 1.68 In
STEEL PLATES	7 X 0.075 In = 0.525 In
TOTAL	'T' = 2.59 In

LAMINATED ELASTOMERIC EXPANSION
BEARING AT ABUTMENTS (18 REQ'D)
50 DUROMETER ELASTOMER, GRADE 3

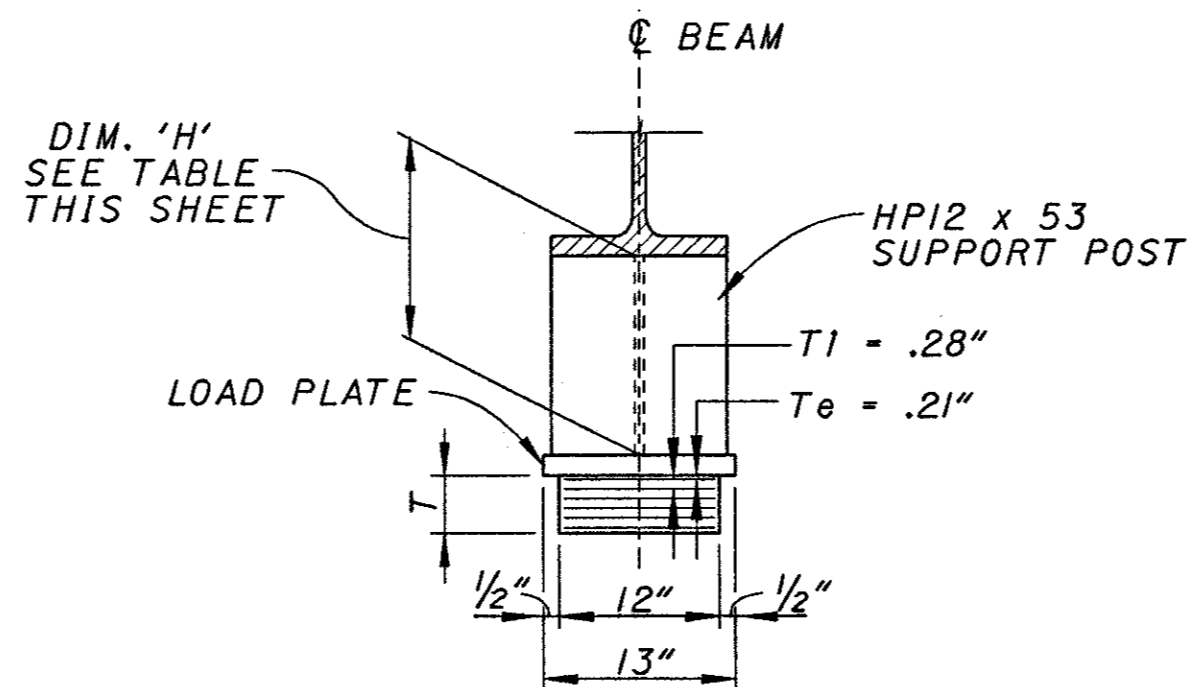

END ELEVATION

BEARING NOTES:

1. WELDING OF THE LOAD PLATE TO THE HP12 x 53 SUPPORT POST OR GIRDER FLANGE SHALL BE CONTROLLED SO THAT THE PLATE TEMPERATURE AT THE ELASTOMERIC BONDED SURFACE DOES NOT EXCEED 300°F AS DETERMINED BY USE OF PYROMETRIC STICKS OR OTHER TEMPERATURE MONITORING DEVICES.

STEEL FOR BEARING LOAD PLATES TO BE A709-36.

HP12 x 53 SUPPORT POSTS TO BE A709-36

THE STEEL LOAD PLATE SHALL BE BONDED BY VULCANIZATION TO THE ELASTOMER DURING THE MOLDING PROCESS.

IF THE STEEL IS ERECTED AT AN AMBIENT TEMPERATURE HIGHER THAN 80°F OR LOWER THAN 40°F, AND THE BEARING SHEAR DEFLECTION EXCEEDS ONE SIXTH OF THE BEARING HEIGHT AT 60°F ±9°F, THE BEAM SHALL BE RAISED TO ALLOW THE BEARINGS TO RETURN TO THEIR UNDEFORMED SHAPE AT 60°F.

2. SEE STD. DWG. SICD-1-96M FOR ADDITIONAL DETAILS.

3. ELASTOMERIC BEARINGS SHALL COMPLY WITH ITEM 516 AND AASHTO STANDARD SPECIFICATION FOR HIGHWAY BRIDGES, SECTION 18, BEARING DEVICES, DIVISION II, CONSTRUCTION, ARTICLES 18.4.5.1 AND 18.5.6.2. BEARINGS SHALL BE GRADE 3, 50 DUROMETER ELASTOMER, AND SHALL BE SUBJECT TO THE LOAD TESTING REQUIREMENTS DEFINED IN ARTICLE 18.7.4.5 OF THE AASHTO DOCUMENT LISTED ABOVE. BEARINGS WERE DESIGNED UNDER SECTION 14.6.6 OF SECTION 14, BEARINGS, DIVISION I, DESIGN (METHOD A).

REF: AREF1
REF: AREF2
REF: AREF3
REF: AREF4
REF: AREF5


REF: AREF1
REF: AREF2
REF: AREF3
REF: AREF4
REF: AREF5

REF: AREF1
REF: AREF2
REF: AREF3
REF: AREF4
REF: AREF5

REF: AREF1
REF: AREF2
REF: AREF3
REF: AREF4
REF: AREF5

BASES SHALL BE MAINTAINED
AS FILED ON INSPECTION
ACTIVE LEVELS ONLY

CAMBER DIAGRAM DIMENSION (INCH)			
LOCATION	A	B	C
LEFT BRIDGE	1 1/8"	1 1/8"	1/2"
RIGHT BRIDGE	1 1/8"	1 5/8"	1"

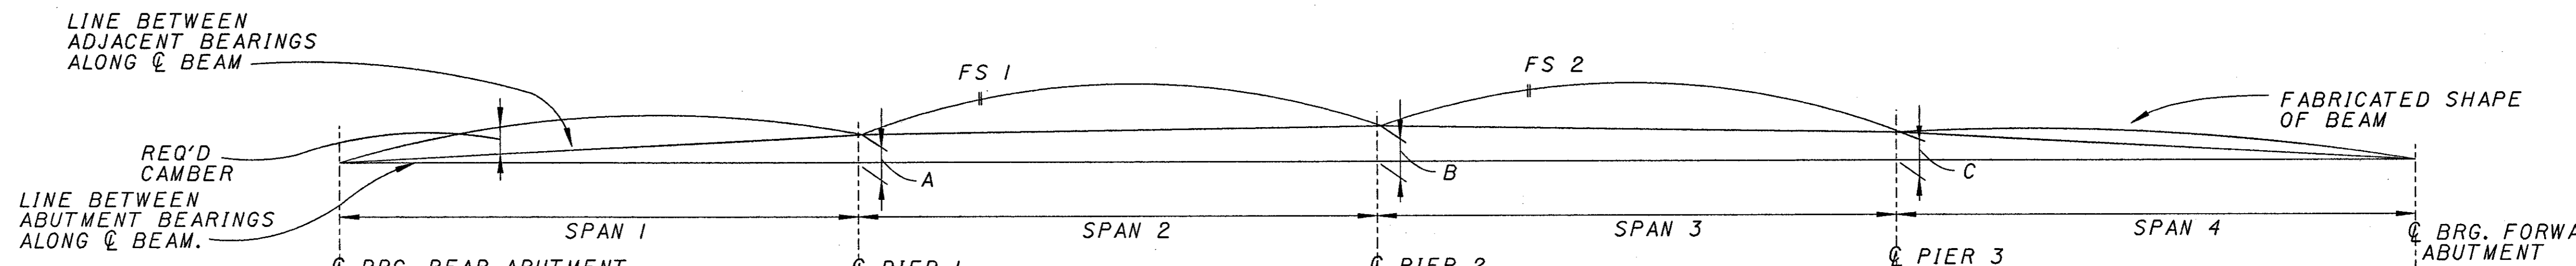

BEAMS	LOCATION	C BRG. REAR ABUTMENT									C PIER 1									C PIER 2									C PIER 3									C BRG. FORWARD ABUTMENT		
		1/10	2/10	3/10	4/10	5/10	6/10	7/10	8/10	9/10	1/10	2/10	3/10	4/10	5/10	6/10	7/10	8/10	9/10	1/10	2/10	3/10	4/10	5/10	6/10	7/10	8/10	9/10	1/10	2/10	3/10	4/10	5/10	6/10	7/10	8/10	9/10	FS1	FS2	
LEFT BRIDGE	DEFLECTION DUE TO WEIGHT OF STEEL	0	0	1/16	1/16	1/16	0	0	0	0	0	0	1/16	1/16	1/16	1/16	1/16	0	0	0	1/16	1/16	1/16	1/16	1/16	0	0	0	1/16	1/16	1/16	1/16	1/16	0	0	0	0	0	0	
	DEFLECTION DUE TO REMAINING DEAD LOAD	1/16	1/8	3/16	1/4	3/16	3/16	1/8	1/16	0	0	1/8	3/16	3/16	1/4	3/16	3/16	1/16	0	1/16	1/8	3/16	1/4	5/16	1/4	1/8	1/16	0	0	1/16	1/16	1/16	1/16	1/16	1/16	1/8	1/16	1/16	1/8	3/16
	VERTICAL CURVE CORRECTION	1/16	1/16	1/8	1/8	1/8	1/8	1/8	1/16	1/16	1/16	1/8	3/16	3/16	3/16	3/16	3/16	1/8	1/16	0	0	0	0	0	0	0	0	0	0	0	0	0	0	0	0	0	0	0	1/8	0
	REQUIRED SHOP CAMBER (INCHES)	1/8	3/16	3/8	7/16	5/8	5/16	1/4	1/8	1/16	1/16	1/4	7/16	7/16	1/2	7/16	7/16	3/16	1/16	1/16	1/8	1/4	5/16	3/8	5/16	5/16	1/8	1/16	0	0	1/16	1/16	1/16	1/8	1/16	1/16	1/16	1/4	3/16	
RIGHT BRIDGE	DEFLECTION DUE TO WEIGHT OF STEEL	0	0	1/16	1/16	1/16	0	0	0	0	0	1/16	1/16	1/16	1/16	1/16	0	0	0	0	1/16	1/16	1/16	1/16	1/16	0	0	0	0	0	0	0	0	0	0	0	0	0		
	DEFLECTION DUE TO REMAINING DEAD LOAD	1/16	1/8	3/16	1/4	3/16	3/16	1/8	1/16	0	0	1/8	3/16	3/16	1/4	3/16	3/16	1/16	0	1/16	1/8	3/16	1/4	5/16	1/4	1/4	1/8	1/16	0	0	1/16	1/16	1/16	1/8	1/16	1/16	1/8	3/16		
	VERTICAL CURVE CORRECTION	0	1/16	1/16	1/16	1/16	1/16	1/16	1/16	0	1/16	1/16	1/8	1/8	1/8	1/8	1/16	1/16	1/16	1/16	1/16	1/8	1/8	1/8	1/8	1/16	1/16	0	1/16	1/16	1/16	1/16	1/16	1/16	1/16	0	1/16	1/16		
	REQUIRED SHOP CAMBER (INCHES)	1/16	3/16	5/16	3/8	5/16	1/4	3/16	1/8	0	1/16	3/16	3/8	3/8	7/16	3/8	3/8	1/8	1/16	1/8	3/16	5/16	7/16	1/2	7/16	7/16	3/16	1/8	0	1/16	1/8	1/8	1/8	3/16	1/8	1/16	3/16	1/4		

CAMBER NOTES:
 1. POSITIVE CAMBER IS UPWARD

NOTES:
 1. SEE SHEETS 12/27 AND 13/27 FOR BEAM ELEVATIONS.

REF: **REF1**
 REF: **REF2**
 REF: **REF3**
 REF: **REF4**
 REF: **REF5**
 REF: **REF6**
 REF: **REF7**
 REF: **REF8**
 REF: **REF9**
 REF: **REF10**
 REF: **REF11**
 REF: **REF12**
 REF: **REF13**
 REF: **REF14**
 REF: **REF15**
 REF: **REF16**
 REF: **REF17**
 REF: **REF18**
 REF: **REF19**
 REF: **REF20**
 REF: **REF21**
 REF: **REF22**
 REF: **REF23**
 REF: **REF24**
 REF: **REF25**
 REF: **REF26**
 REF: **REF27**
 REF: **REF28**
 REF: **REF29**
 REF: **REF30**

DESIGN AGENCY
KZF DESIGN

Architectural | Engineering | Interiors | Planning
FOR REASON INC. 10000 Riverchase Circle, Suite 200, Atlanta, GA 30328
TEL: 404.261.1111 FAX: 404.261.1112 WWW: KZFDESIGN.COM

DATE
09/20/00

REVIEWED
DCK

STRUCTURE FILE NUMBER
6801269/6601293

DRAWN
SPG

DESIGNED
SJA

CHECKED
WBS

DESIGNED
KZF

#
#13

CAMBER DETAILS

BRIDGE NO. PRE-70-1249 L/R

I.R. 70 OVER PRICE CREEK


PRE-70-0.00

17/27

202

283

REF: **REF**
 REF: **REF**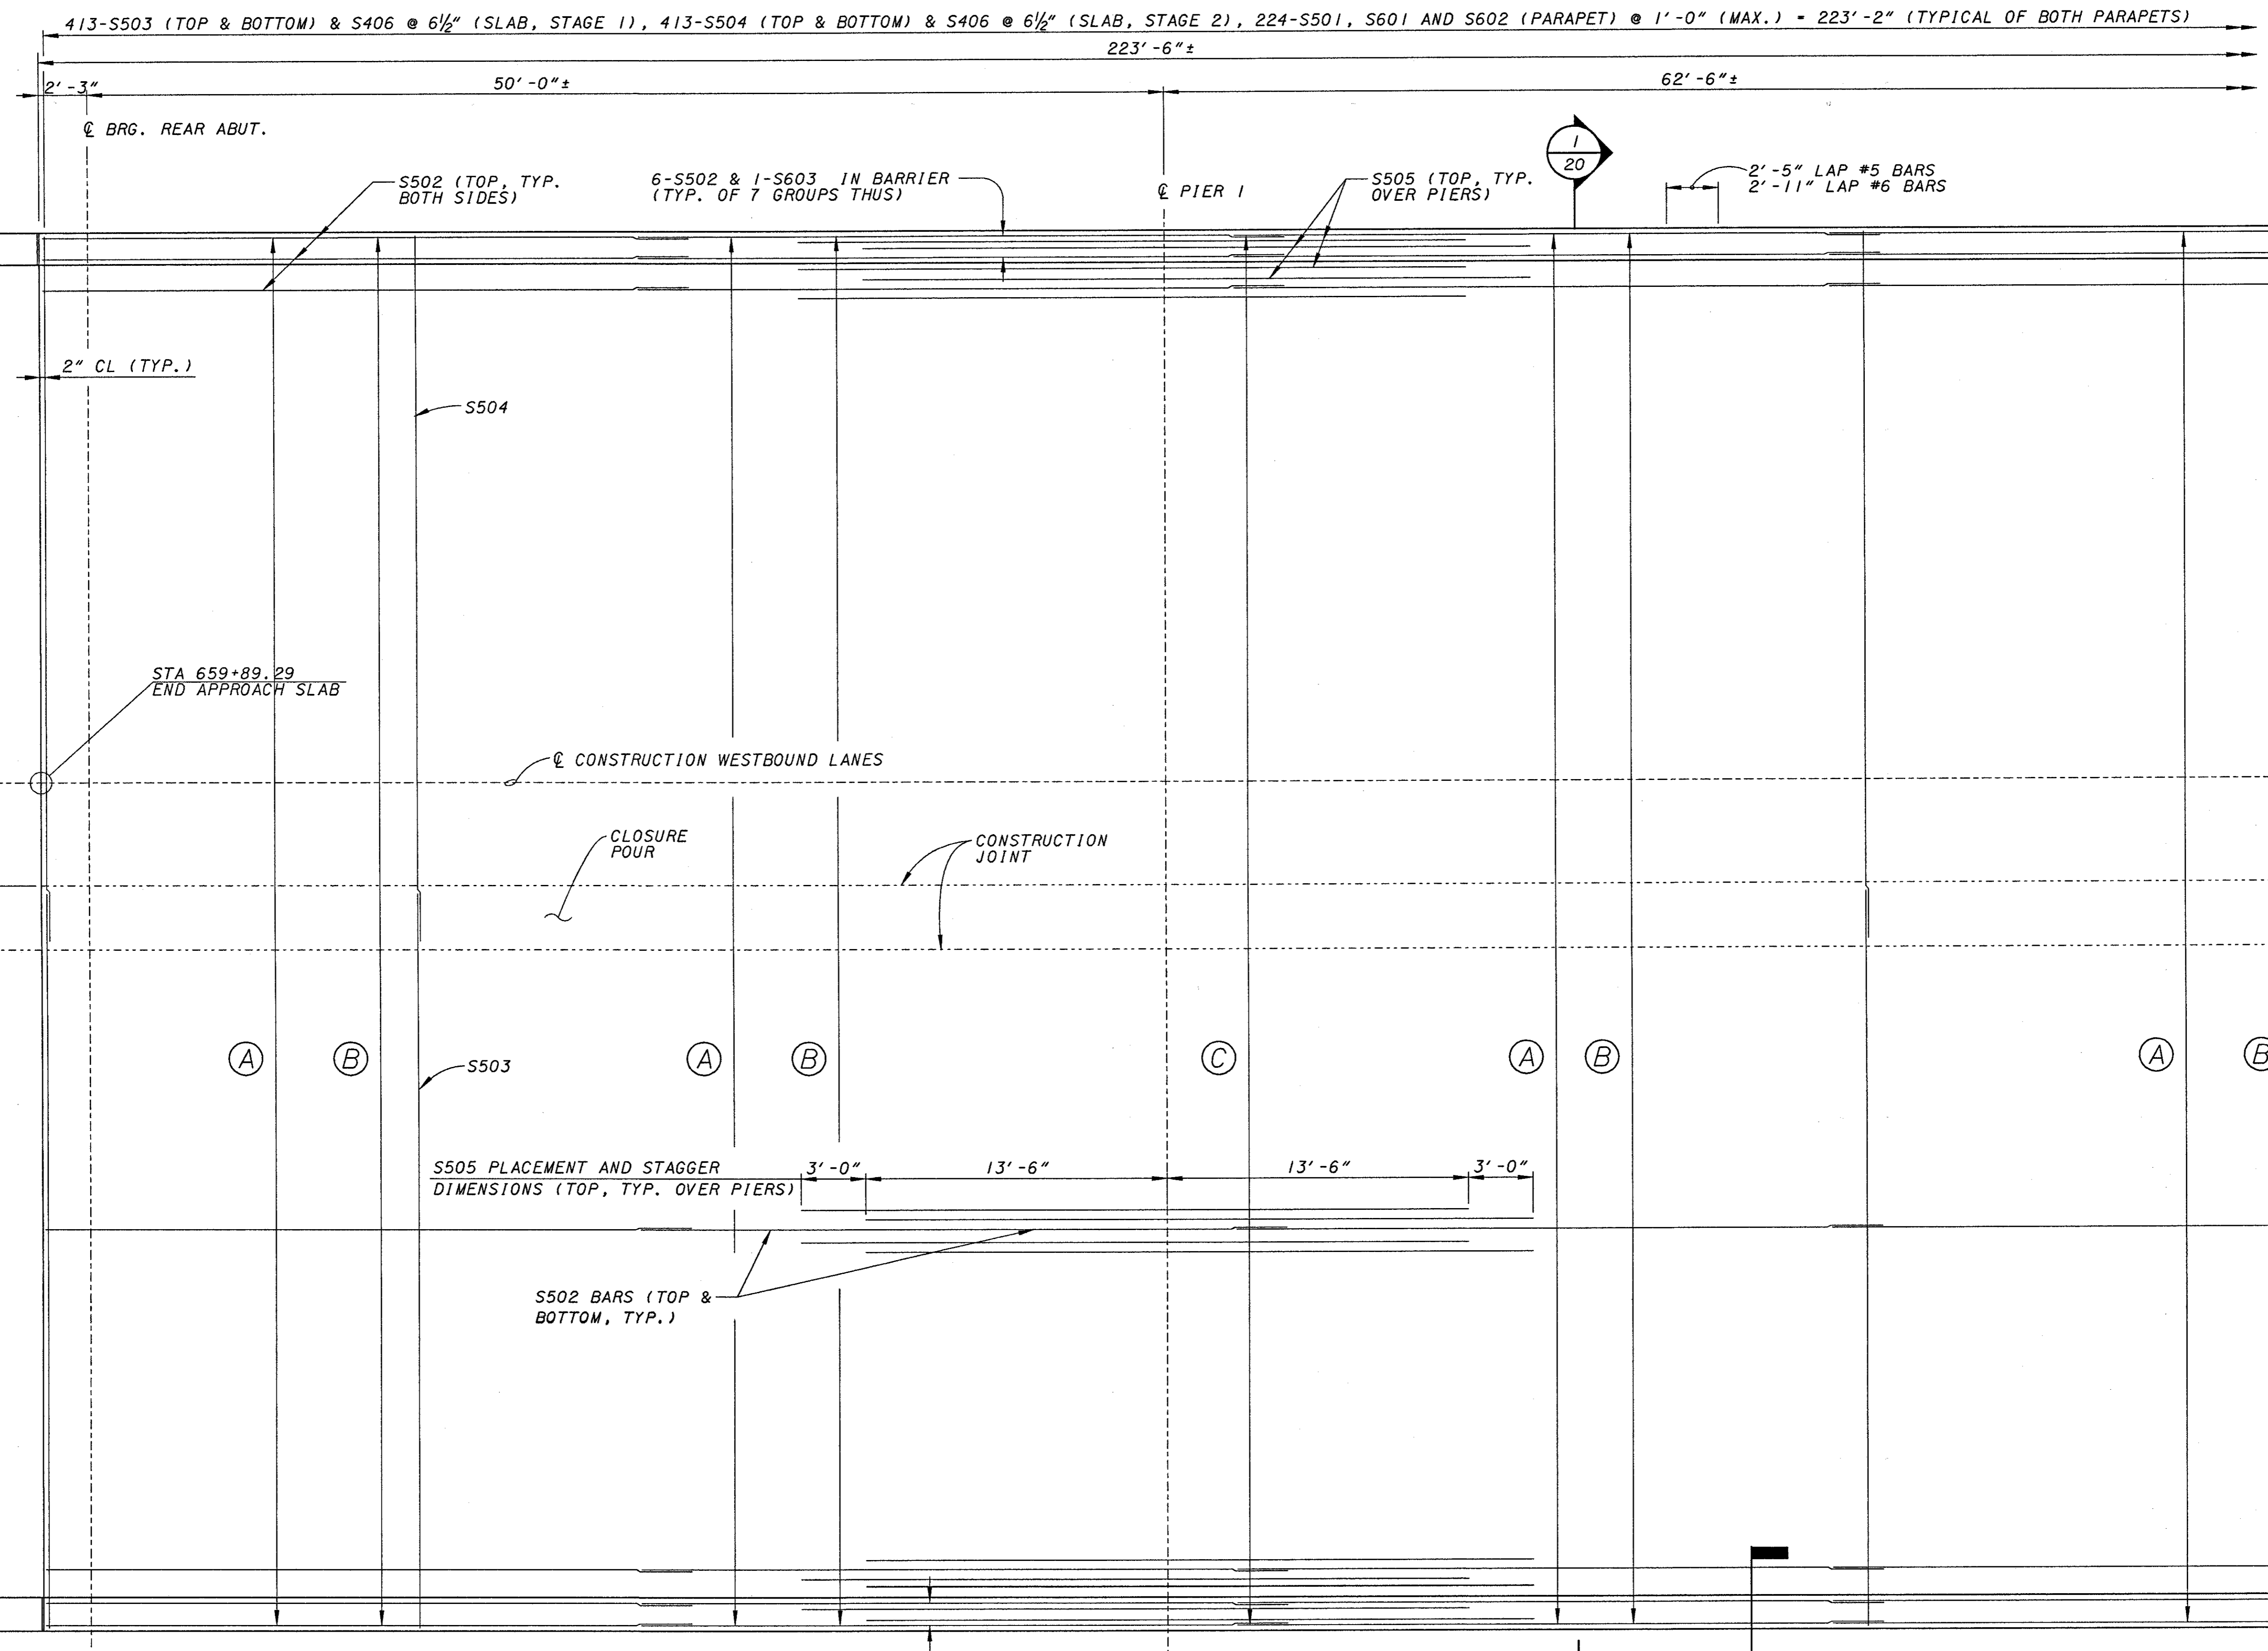
- (A) 7 SETS OF 7 & 1 SET OF 4 (BETWEEN BEAMS) AND 2 SETS OF 2 (EDGE OF SLAB) S502 BARS (TOP)
 - (B) 7 SETS OF 9 & 1 SET OF 4 (BETWEEN BEAMS) & 2 SETS OF 3 (EDGE OF SLAB) S502 BARS (BOTTOM)
 - (C) 7 SETS OF 12 & 1 SET OF 6 (BETWEEN BEAMS) AND 2 SETS OF 4 (EDGE OF SLAB) S505 BARS (TOP, TYP. OVER PIERS)
- 6-S502 & 1-S603 IN BARRIER (TYP. OF 7 GROUPS THUS)

DECK PLAN
 LEFT BRIDGE SHOWN
 RIGHT BRIDGE OPPOSITE HAND

2
 20

NOTES:
 1. SEE STD. DRAWING BR-1 (SHEET 2) FOR ADDITIONAL RAILING NOTES.


KZF DESIGN ARCHITECTURE ENGINEERING INTERIORS PLANNING	
DESIGNED SJA	DRAWN SJA
CHECKED WBS	REVIEWED DCK
DATE 09/20/00	
STRUCTURE FILE NUMBER 6801269/6801293	
DECK PLAN 1	
BRIDGE NO. PRE-70-1249 L/R	
I.R. 70 OVER PRICE CREEK	
PRE-70-0.00	
18 / 27	
(203) 283	

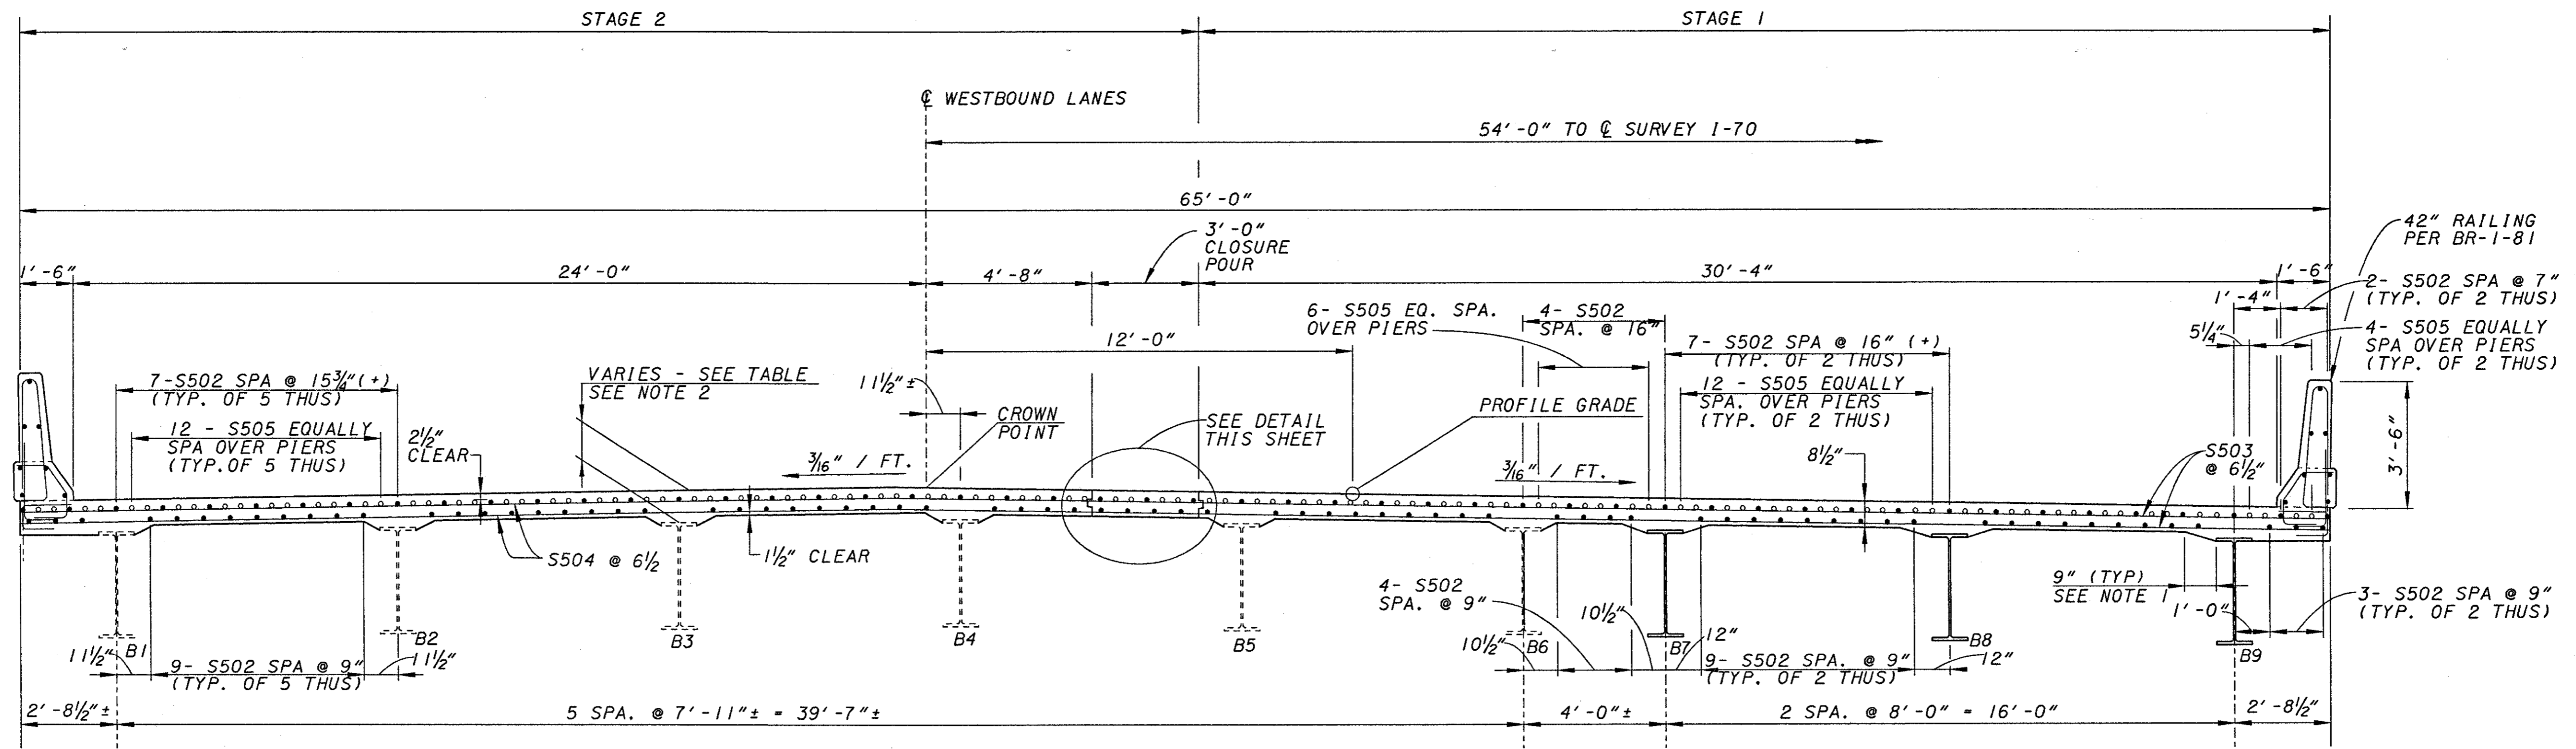


SECTION 1/18 1/19

ALL STEEL CLEARANCES ARE 2" UNLESS OTHERWISE NOTED.


CONCRETE DECK HAUNCH DEPTH (INCHES)					
BEAM	REAR ABUT.	PIER-1	PIER-2	PIER-3	FWD. ABUT.
B1	10 1/2"	11 3/8"	11 1/4"	10 3/8"	10 1/8"
B2	10 1/4"	11 3/8"	11 1/4"	10 3/8"	10 1/4"
B3	10 1/2"	11 1/8"	11 1/8"	10 1/2"	10 3/8"
B4	10 1/4"	11 1/4"	11 1/8"	10 1/4"	10 1/4"
B5	10 3/8"	11 3/8"	11 1/8"	10 1/8"	10 1/8"
B6	10 1/4"	11 3/8"	11 3/8"	10 1/4"	10 1/8"
B7-B9	10 1/2"	10 1/2"	10 1/2"	10 1/2"	10 1/2"

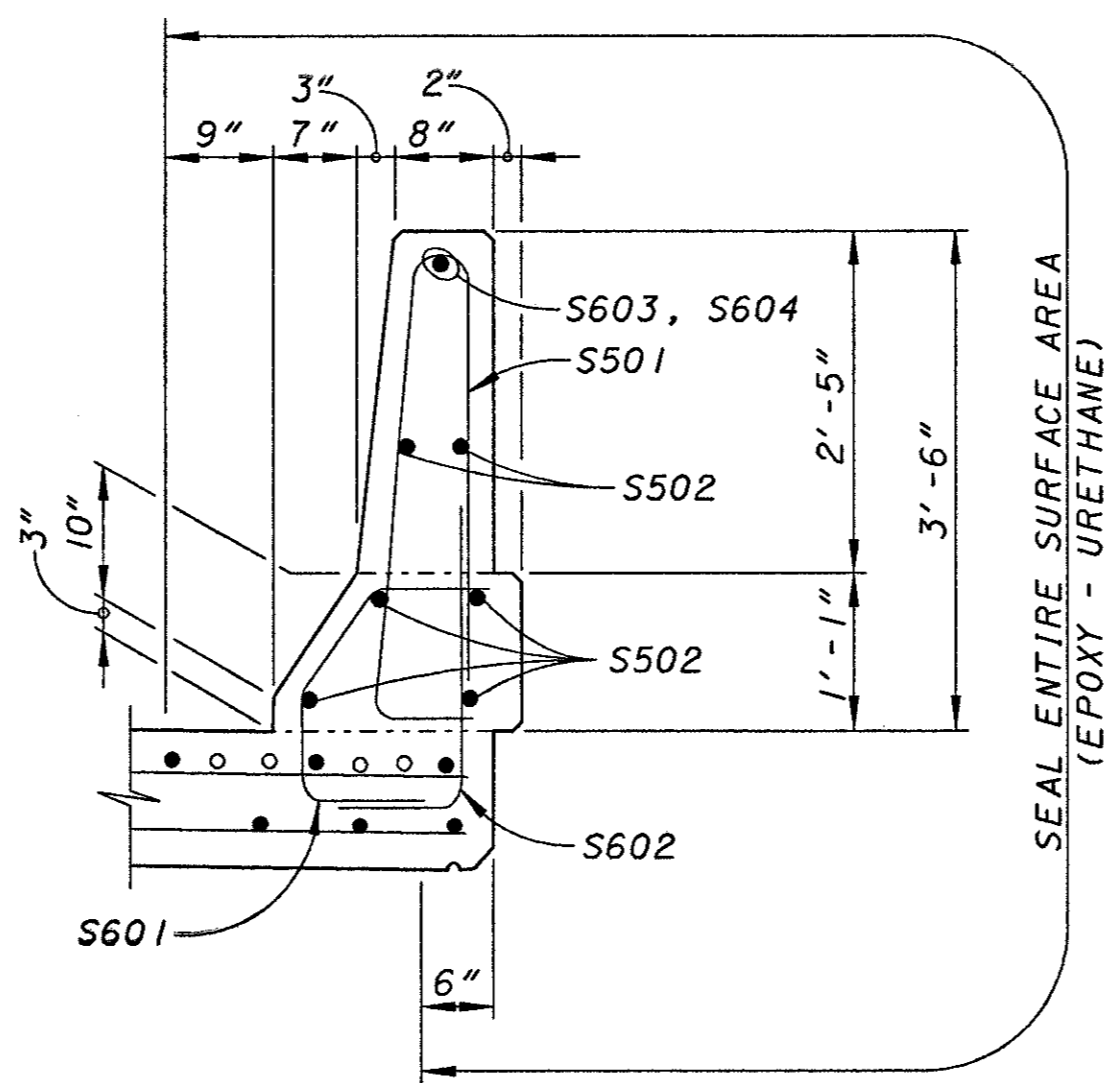

SECTION 2/18 2/19

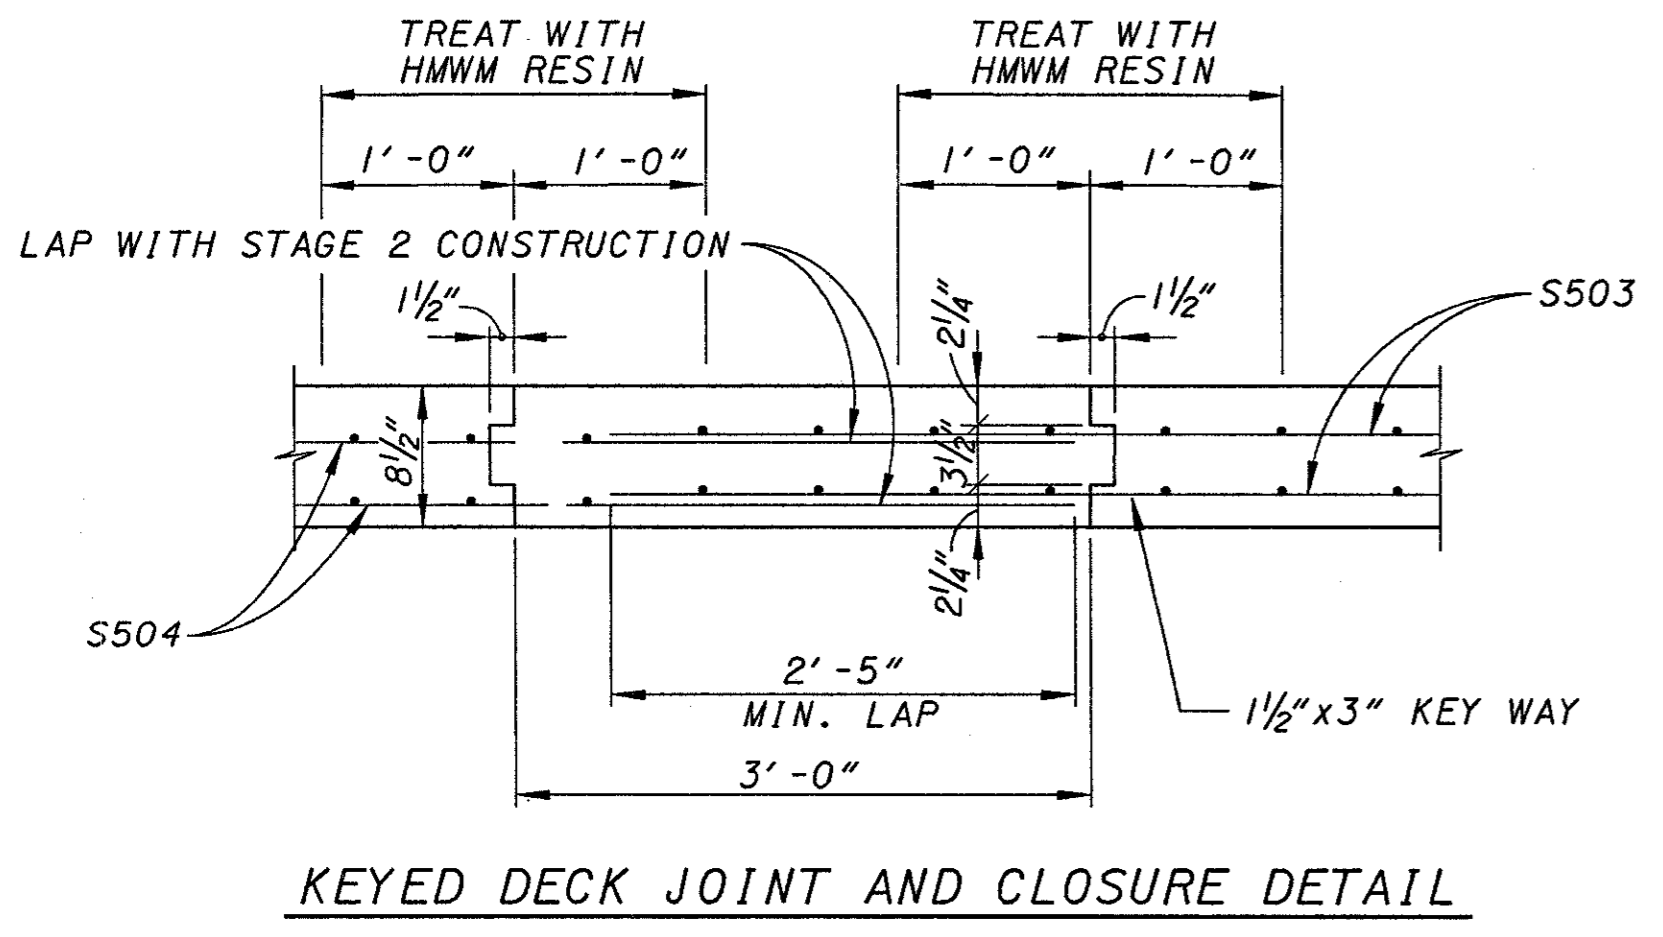


- NOTES:**
1. A HAUNCH WIDTH OF 9" SHALL BE USED FOR COMPUTING QUANTITY OF CONCRETE (OVER NEW BEAMS). HOWEVER, THE HAUNCH WIDTH MAY VARY BETWEEN 6" AND 12".
 2. THE DISTANCE FROM TOP OF DECK SLAB TO TOP OF STEEL BEAM IS THE THEORETICAL DESIGN DIMENSION INCLUDING THE DESIGN HAUNCH THICKNESS OF 2". THE QUANTITY OF DECK CONCRETE SHALL BE BASED ON THIS DIMENSION MINUS THE DESIGN HAUNCH THICKNESS, EVEN THOUGH DEVIATION FROM IT MAY BE NECESSARY BECAUSE THE TOP FLANGE OF THE BEAM MAY NOT HAVE THE EXACT CAMBER OR CONFORMATION REQUIRED TO PLACE IT PARALLEL TO THE FINISHED GRADE.
 3. SEE SHEET 3/27 AND 3A/27 FOR GENERAL NOTES.
 4. SEE SHEET 27/27 FOR REINFORCING STEEL SCHEDULE.

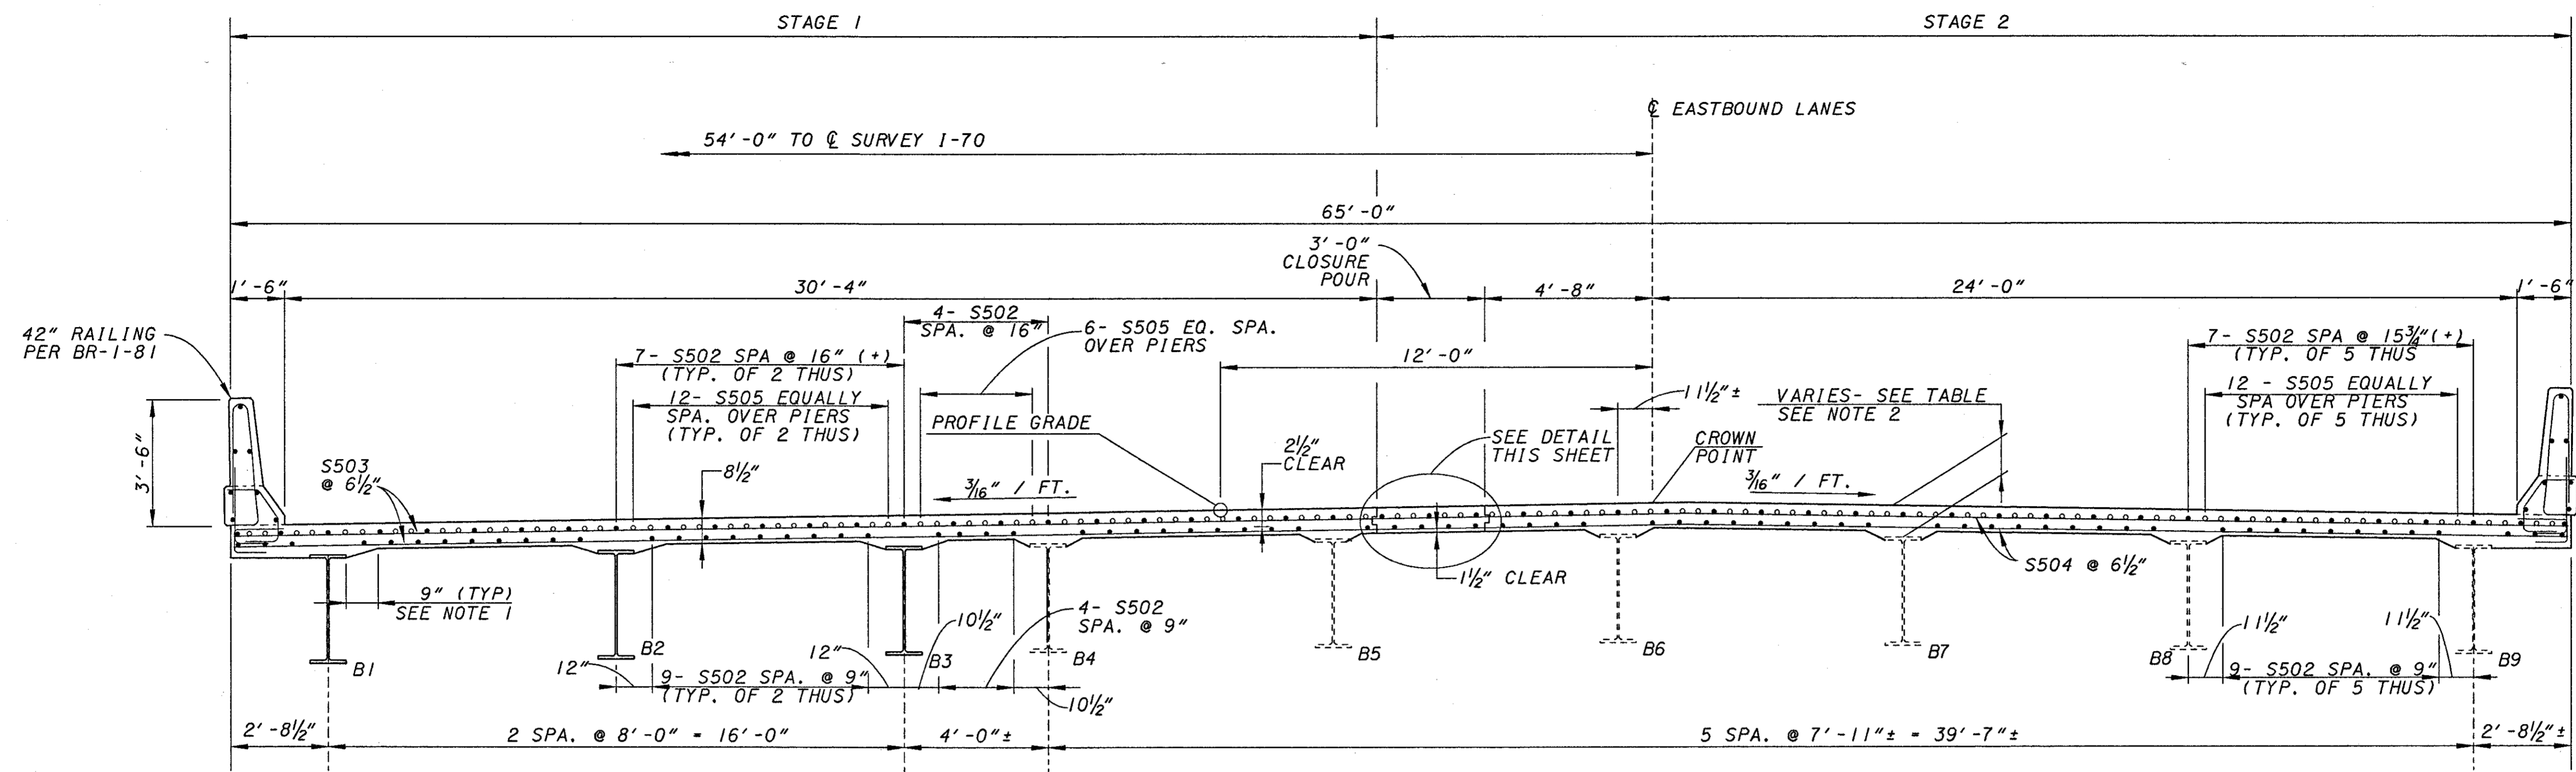

DECK SECTION

CONCRETE DECK HAUNCH DEPTH (INCHES)					
BEAM	REAR ABUT.	PIER-1	PIER-2	PIER-3	FWD. ABUT.
B1-B3	10 1/2"	10 1/2"	10 1/2"	10 1/2"	10 1/2"
B4	10 1/8"	11 3/8"	11 3/4"	10 7/8"	10 5/8"
B5	10 1/4"	11"	11 5/8"	11"	10 1/2"
B6	10 3/8"	11"	11 3/4"	12 3/8"	10 5/8"
B7	10 1/2"	11"	11 3/4"	11 1/4"	10 5/8"
B8	10 1/2"	11 1/4"	11 1/2"	11 1/8"	10 1/4"
B9	10 1/2"	11 1/8"	11 7/8"	11"	10 1/2"

ALL STEEL CLEARANCES ARE 2" UNLESS OTHERWISE NOTED

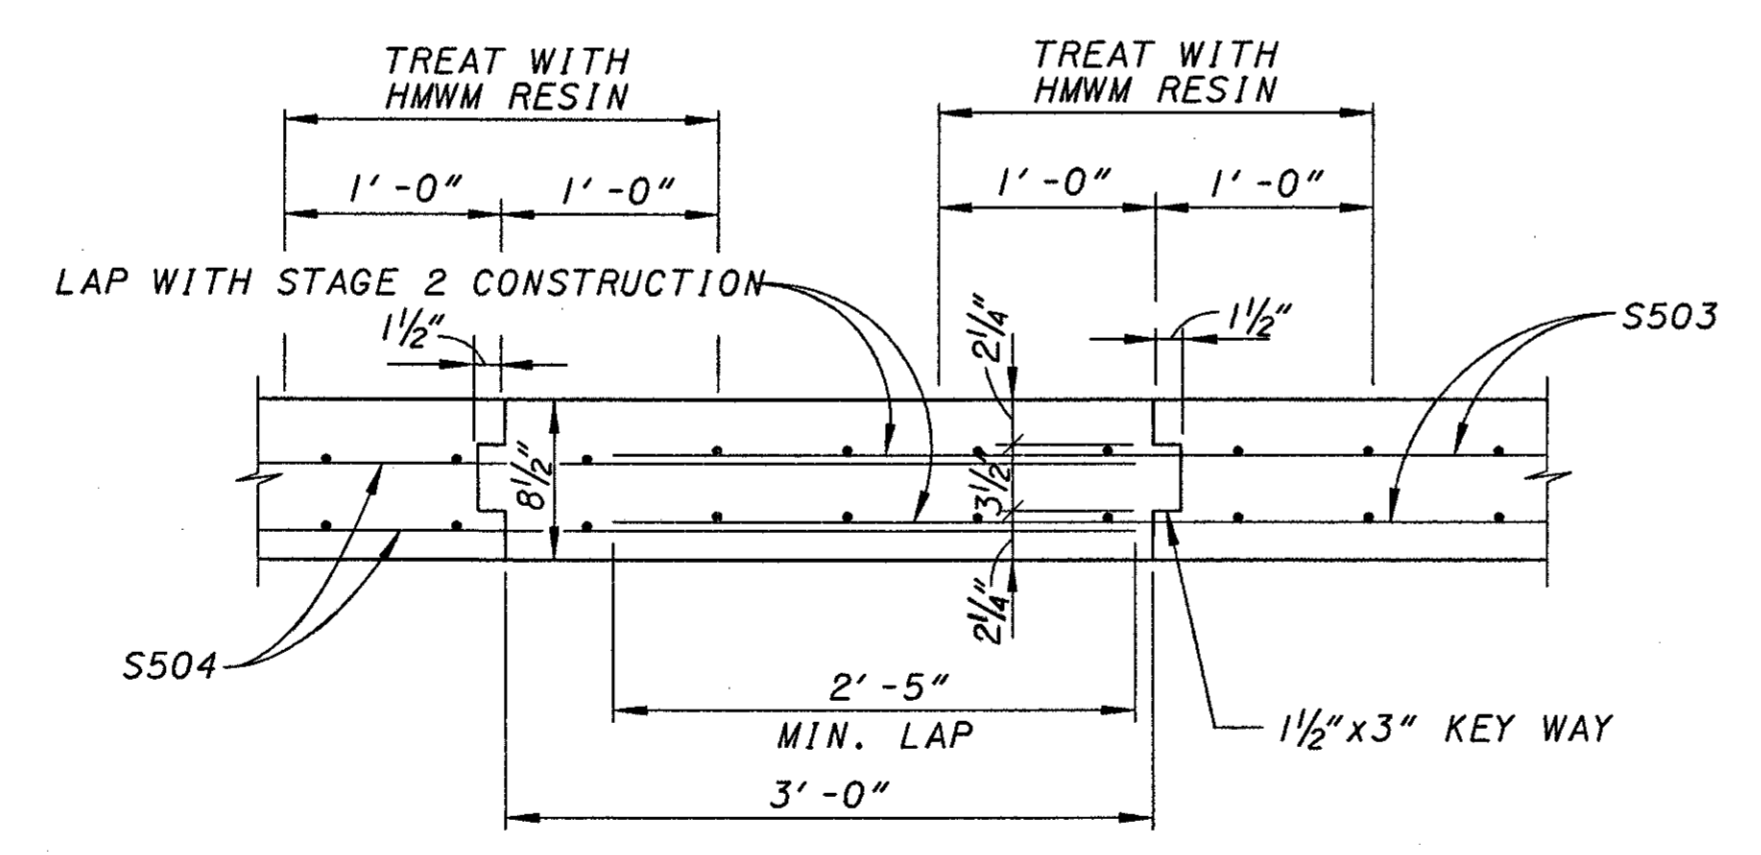

KEYED DECK JOINT AND CLOSURE DETAIL

- NOTES:**
1. A HAUNCH WIDTH OF 9" SHALL BE USED FOR COMPUTING QUANTITY OF CONCRETE (OVER NEW BEAMS). HOWEVER, THE HAUNCH WIDTH MAY VARY BETWEEN 6" AND 12".
 2. THE DISTANCE FROM TOP OF DECK SLAB TO TOP OF STEEL BEAM IS THE THEORETICAL DESIGN DIMENSION INCLUDING THE DESIGN HAUNCH THICKNESS OF 2". THE QUANTITY OF DECK CONCRETE TO BE PAID FOR SHALL BE BASED ON THIS DIMENSION MINUS THE DESIGN HAUNCH THICKNESS, EVEN THOUGH DEVIATION FROM IT MAY BE NECESSARY BECAUSE THE TOP FLANGE OF THE BEAM MAY NOT HAVE THE EXACT CAMBER OR CONFORMATION REQUIRED TO PLACE IT PARALLEL TO THE FINISHED GRADE.
 3. SEE SHEET 3/27 AND 3A/27 FOR GENERAL NOTES.
 4. SEE SHEET 27/27 FOR REINFORCING STEEL SCHEDULE.

REF: **REF1**
 REF: **REF2**
 REF: **REF3**
 REF: **REF4**

REF: **REF1**
 REF: **REF2**
 REF: **REF3**
 REF: **REF4**

REF: **REF1**
 REF: **REF2**
 REF: **REF3**
 REF: **REF4**

REF: **REF1**
 REF: **REF2**
 REF: **REF3**
 REF: **REF4**

 DESIGNATION*****
 DESIGNED BY: *****
 CHECKED BY: *****
 ACTIVE LEVELS ONLY *****

CONSTRUCTION ELEVATIONS (SCREEDS) FOR BRIDGE DECK PLACEMENT


	☉ BEARING REAR ABUT.	0.2 L	0.4 L	0.6 L	0.8 L	PIER 1	0.2 L	0.4 L	0.6 L	0.8 L	PIER 2
LEFT GUTTER	1052.52	1052.54	1052.55	1052.55	1052.54	1052.52	1052.52	1052.51	1052.49	1052.45	1052.41
BEAM B1	1052.54	1052.56	1052.57	1052.57	1052.56	1052.54	1052.54	1052.53	1052.50	1052.47	1052.42
BEAM B2	1052.67	1052.68	1052.69	1052.69	1052.68	1052.67	1052.66	1052.65	1052.63	1052.59	1052.55
BEAM B3	1052.79	1052.81	1052.82	1052.81	1052.81	1052.79	1052.78	1052.78	1052.75	1052.71	1052.67
☉ CONSTRUCTION & CROWN	1052.90	1052.92	1052.92	1052.92	1052.91	1052.90	1052.89	1052.88	1052.86	1052.82	1052.78
BEAM B4	1052.88	1052.90	1052.91	1052.91	1052.90	1052.88	1052.88	1052.87	1052.84	1052.81	1052.76
LEFT CONSTRUCTION JOINT	1052.82	1052.84	1052.85	1052.85	1052.84	1052.82	1052.82	1052.81	1052.79	1052.75	1052.71
RIGHT CONSTRUCTION JOINT	1052.78	1052.80	1052.80	1052.80	1052.79	1052.78	1052.77	1052.76	1052.74	1052.70	1052.66
BEAM B5	1052.76	1052.78	1052.79	1052.79	1052.78	1052.76	1052.75	1052.75	1052.72	1052.68	1052.64
BEAM B6	1052.64	1052.65	1052.66	1052.66	1052.65	1052.64	1052.63	1052.62	1052.60	1052.56	1052.52
BEAM B7	1052.57	1052.59	1052.60	1052.60	1052.59	1052.57	1052.57	1052.56	1052.54	1052.50	1052.46
BEAM B8	1052.45	1052.47	1052.48	1052.47	1052.47	1052.45	1052.44	1052.43	1052.41	1052.37	1052.33
BEAM B9	1052.32	1052.34	1052.35	1052.35	1052.34	1052.32	1052.32	1052.31	1052.29	1052.25	1052.21
RIGHT GUTTER	1052.30	1052.32	1052.33	1052.33	1052.32	1052.30	1052.30	1052.29	1052.27	1052.23	1052.19

CONSTRUCTION ELEVATIONS (SCREEDS) FOR BRIDGE DECK PLACEMENT

	PIER 2	0.2 L	0.4 L	0.6 L	0.8 L	PIER 3	0.2 L	0.4 L	0.6 L	0.8 L	☉ BEARING FORWARD ABUT.
LEFT GUTTER	1052.41	1052.38	1052.36	1052.32	1052.28	1052.23	1052.21	1052.19	1052.16	1052.14	1052.11
BEAM B1	1052.42	1052.40	1052.38	1052.34	1052.30	1052.25	1052.23	1052.21	1052.18	1052.16	1052.13
BEAM B2	1052.55	1052.52	1052.50	1052.47	1052.42	1052.37	1052.35	1052.33	1052.31	1052.28	1052.25
BEAM B3	1052.67	1052.65	1052.62	1052.59	1052.54	1052.50	1052.47	1052.45	1052.43	1052.40	1052.37
☉ CONSTRUCTION & CROWN	1052.78	1052.75	1052.73	1052.70	1052.65	1052.60	1052.58	1052.56	1052.54	1052.51	1052.48
BEAM B4	1052.76	1052.74	1052.72	1052.68	1052.64	1052.59	1052.57	1052.55	1052.52	1052.50	1052.47
LEFT CONSTRUCTION JOINT	1052.71	1052.68	1052.66	1052.63	1052.58	1052.53	1052.51	1052.49	1052.47	1052.44	1052.41
RIGHT CONSTRUCTION JOINT	1052.66	1052.64	1052.61	1052.58	1052.53	1052.49	1052.46	1052.44	1052.42	1052.39	1052.36
BEAM B5	1052.64	1052.62	1052.59	1052.56	1052.51	1052.47	1052.44	1052.42	1052.40	1052.37	1052.34
BEAM B6	1052.52	1052.49	1052.47	1052.44	1052.39	1052.34	1052.32	1052.30	1052.28	1052.25	1052.22
BEAM B7	1052.46	1052.43	1052.41	1052.37	1052.33	1052.28	1052.26	1052.24	1052.21	1052.19	1052.16
BEAM B8	1052.33	1052.31	1052.28	1052.25	1052.20	1052.16	1052.13	1052.11	1052.09	1052.06	1052.03
BEAM B9	1052.21	1052.18	1052.16	1052.12	1052.08	1052.03	1052.01	1051.99	1051.97	1051.94	1051.91
RIGHT GUTTER	1052.19	1052.16	1052.14	1052.11	1052.06	1052.01	1051.99	1051.97	1051.95	1051.92	1051.89

NOTES:

1. FOR DEFLECTIONS & CHAMBER TABLES SEE SHEET **17 / 27**.
2. SCREED ELEVATIONS ARE GIVEN FOR THE TOP SURFACE OF THE CONCRETE DECK PRIOR TO CONCRETE PLACEMENT. ALLOWANCE HAS BEEN MADE FOR ANTICIPATED CALCULATED DEAD LOAD DEFLECTIONS.
3. L DENOTES LENGTH OF SPAN

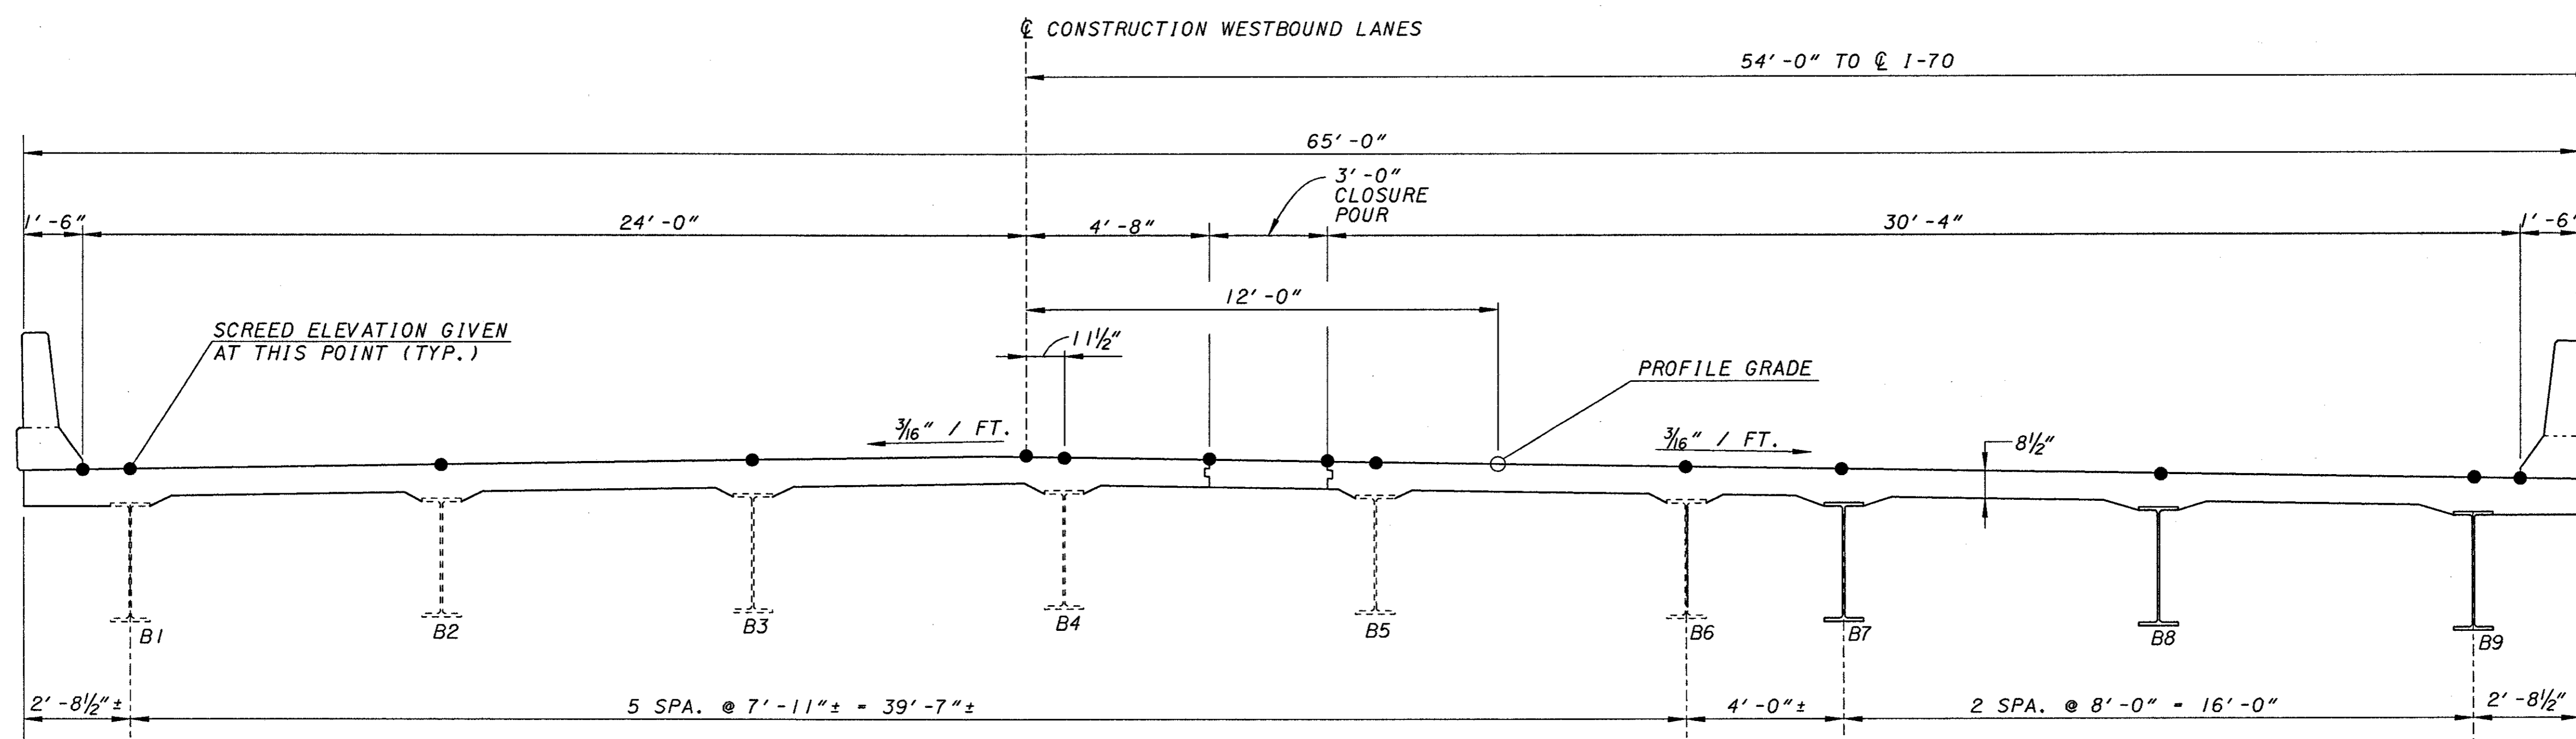

FINAL DECK ELEVATIONS

REF: **REF**
 REF: **REF**
BASED ON THE LATEST
 DESIGN INFORMATION
 FOR THIS PROJECT
 ALL LEVELS ON THIS SHEET

CONSTRUCTION ELEVATIONS (SCREEDS) FOR BRIDGE DECK PLACEMENT


	Q BEARING REAR ABUT.	0.2 L	0.4 L	0.6 L	0.8 L	PIER 1	0.2 L	0.4 L	0.6 L	0.8 L	PIER 2
LEFT GUTTER	1052.29	1052.30	1052.31	1052.31	1052.31	1052.29	1052.30	1052.30	1052.28	1052.25	1052.23
BEAM B1	1052.31	1052.32	1052.33	1052.33	1052.33	1052.31	1052.32	1052.32	1052.30	1052.27	1052.25
BEAM B2	1052.43	1052.45	1052.46	1052.46	1052.45	1052.44	1052.44	1052.44	1052.43	1052.40	1052.37
BEAM B3	1052.55	1052.57	1052.58	1052.58	1052.58	1052.56	1052.56	1052.56	1052.55	1052.52	1052.50
BEAM B4	1052.62	1052.64	1052.64	1052.64	1052.64	1052.63	1052.63	1052.63	1052.61	1052.59	1052.56
BEAM B5	1052.74	1052.76	1052.77	1052.77	1052.76	1052.75	1052.75	1052.75	1052.74	1052.71	1052.68
LEFT CONSTRUCTION JOINT	1052.76	1052.78	1052.79	1052.79	1052.78	1052.77	1052.77	1052.77	1052.75	1052.73	1052.70
RIGHT CONSTRUCTION JOINT	1052.81	1052.82	1052.83	1052.83	1052.83	1052.81	1052.82	1052.82	1052.80	1052.77	1052.75
BEAM B6	1052.86	1052.88	1052.89	1052.89	1052.89	1052.87	1052.87	1052.87	1052.86	1052.83	1052.80
Q CONSTRUCTION & CROWN	1052.88	1052.90	1052.91	1052.91	1052.90	1052.89	1052.89	1052.89	1052.87	1052.85	1052.82
BEAM B7	1052.77	1052.79	1052.80	1052.80	1052.79	1052.78	1052.78	1052.78	1052.77	1052.74	1052.71
BEAM B8	1052.65	1052.67	1052.67	1052.67	1052.67	1052.66	1052.66	1052.66	1052.64	1052.61	1052.59
BEAM B9	1052.52	1052.54	1052.55	1052.55	1052.54	1052.53	1052.53	1052.53	1052.52	1052.49	1052.46
RIGHT GUTTER	1052.50	1052.52	1052.53	1052.53	1052.53	1052.51	1052.51	1052.51	1052.50	1052.47	1052.45

CONSTRUCTION ELEVATIONS (SCREEDS) FOR BRIDGE DECK PLACEMENT

	PIER 2	0.2 L	0.4 L	0.6 L	0.8 L	PIER 3	0.2 L	0.4 L	0.6 L	0.8 L	Q BEARING FORWARD ABUT.
LEFT GUTTER	1052.23	1052.21	1052.20	1052.17	1052.12	1052.07	1052.04	1052.02	1051.99	1051.95	1051.91
BEAM B1	1052.25	1052.23	1052.22	1052.19	1052.14	1052.09	1052.06	1052.04	1052.01	1051.97	1051.93
BEAM B2	1052.37	1052.36	1052.34	1052.31	1052.27	1052.22	1052.19	1052.16	1052.13	1052.10	1052.05
BEAM B3	1052.50	1052.48	1052.47	1052.44	1052.39	1052.34	1052.31	1052.29	1052.26	1052.22	1052.18
BEAM B4	1052.56	1052.54	1052.53	1052.50	1052.45	1052.40	1052.37	1052.35	1052.32	1052.28	1052.24
BEAM B5	1052.68	1052.67	1052.65	1052.62	1052.58	1052.53	1052.50	1052.47	1052.44	1052.41	1052.36
LEFT CONSTRUCTION JOINT	1052.70	1052.69	1052.67	1052.64	1052.59	1052.54	1052.52	1052.49	1052.46	1052.42	1052.38
RIGHT CONSTRUCTION JOINT	1052.75	1052.73	1052.72	1052.69	1052.64	1052.59	1052.56	1052.54	1052.51	1052.47	1052.43
BEAM B6	1052.80	1052.79	1052.77	1052.74	1052.70	1052.65	1052.62	1052.60	1052.57	1052.53	1052.49
Q CONSTRUCTION & CROWN	1052.82	1052.81	1052.79	1052.76	1052.71	1052.66	1052.64	1052.61	1052.58	1052.54	1052.50
BEAM B7	1052.71	1052.70	1052.68	1052.65	1052.61	1052.56	1052.53	1052.50	1052.47	1052.44	1052.39
BEAM B8	1052.59	1052.57	1052.56	1052.53	1052.48	1052.43	1052.40	1052.38	1052.35	1052.31	1052.27
BEAM B9	1052.46	1052.45	1052.43	1052.40	1052.36	1052.31	1052.28	1052.26	1052.22	1052.19	1052.15
RIGHT GUTTER	1052.45	1052.43	1052.42	1052.39	1052.34	1052.29	1052.26	1052.24	1052.21	1052.17	1052.13

NOTES:

- FOR DEFLECTIONS & CHAMBER TABLES SEE SHEET 17 / 27.
- SCREED ELEVATIONS ARE GIVEN FOR THE TOP SURFACE OF THE CONCRETE DECK PRIOR TO CONCRETE PLACEMENT. ALLOWANCE HAS BEEN MADE FOR ANTICIPATED CALCULATED DEAD LOAD DEFLECTIONS.
- L DENOTES LENGTH OF SPAN

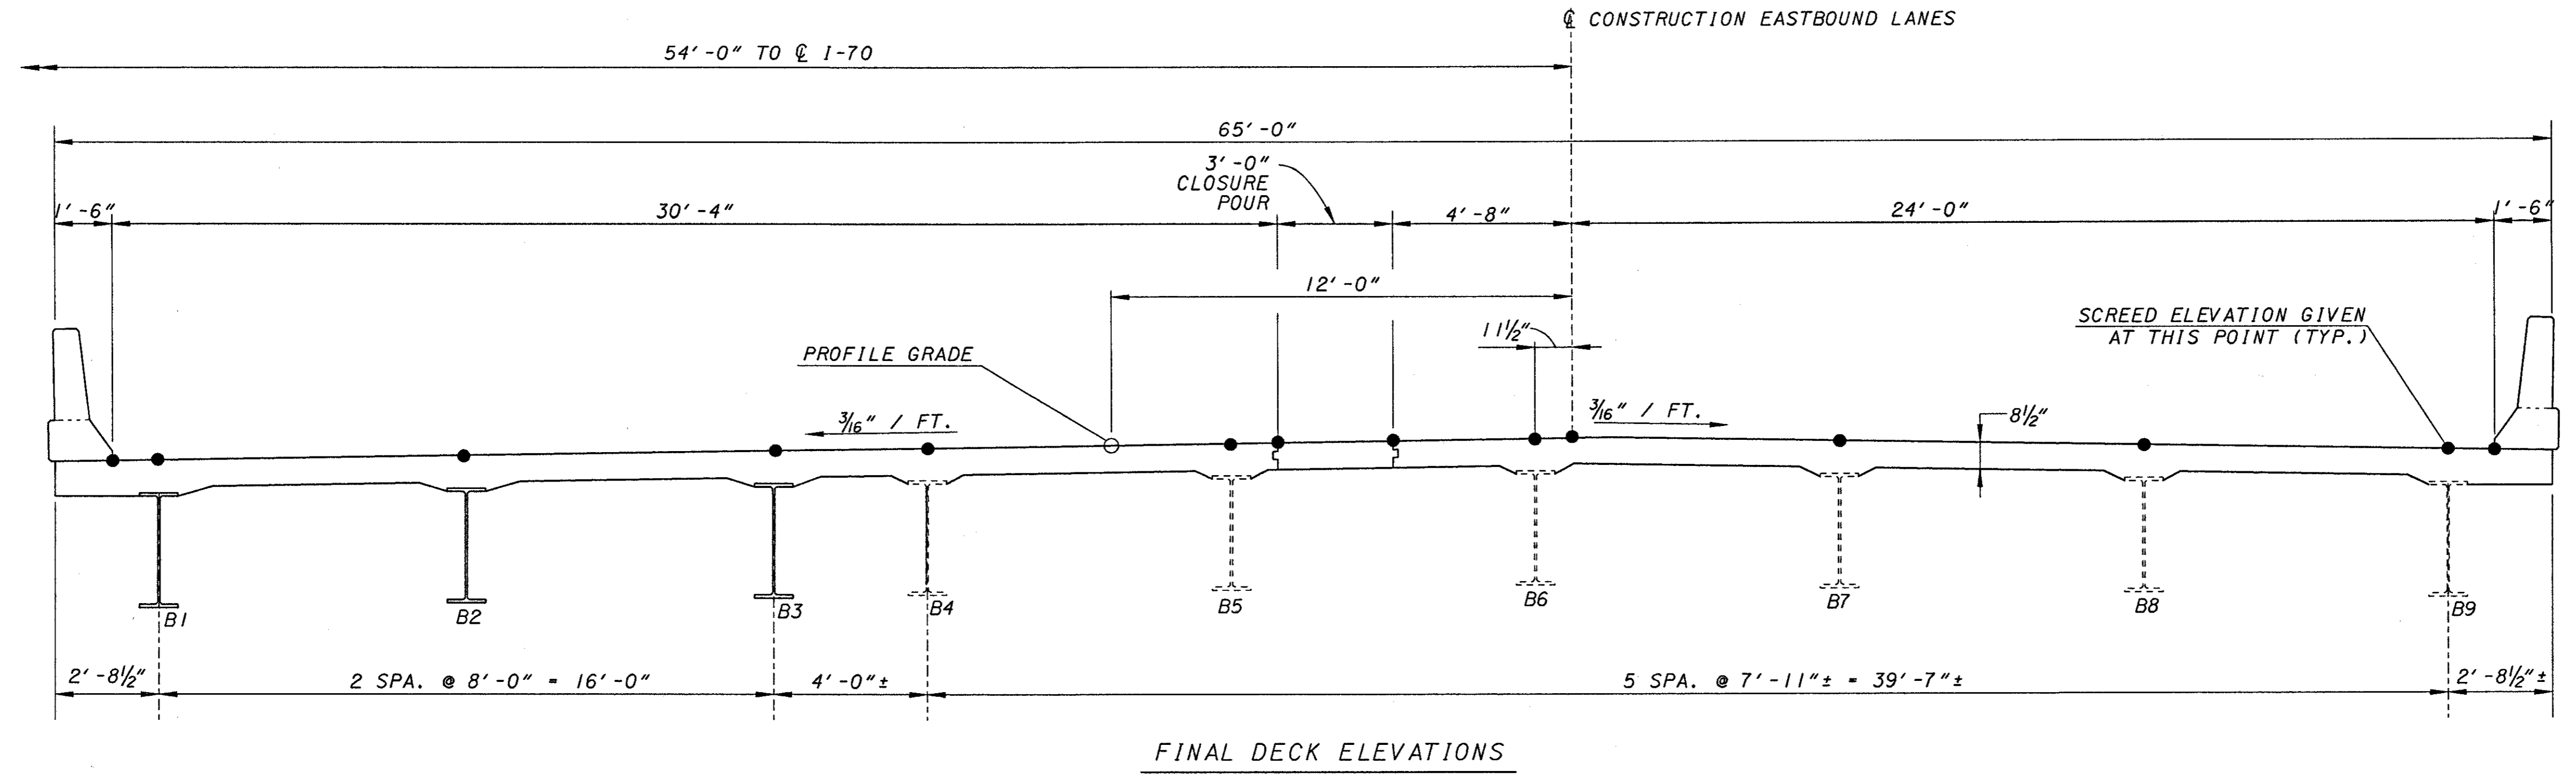

REF: **REF**
 REF: **REF**

REF: **REF**
REF: **REF**
DESIGNER: *****
CHECKER: *****
DATE: *****

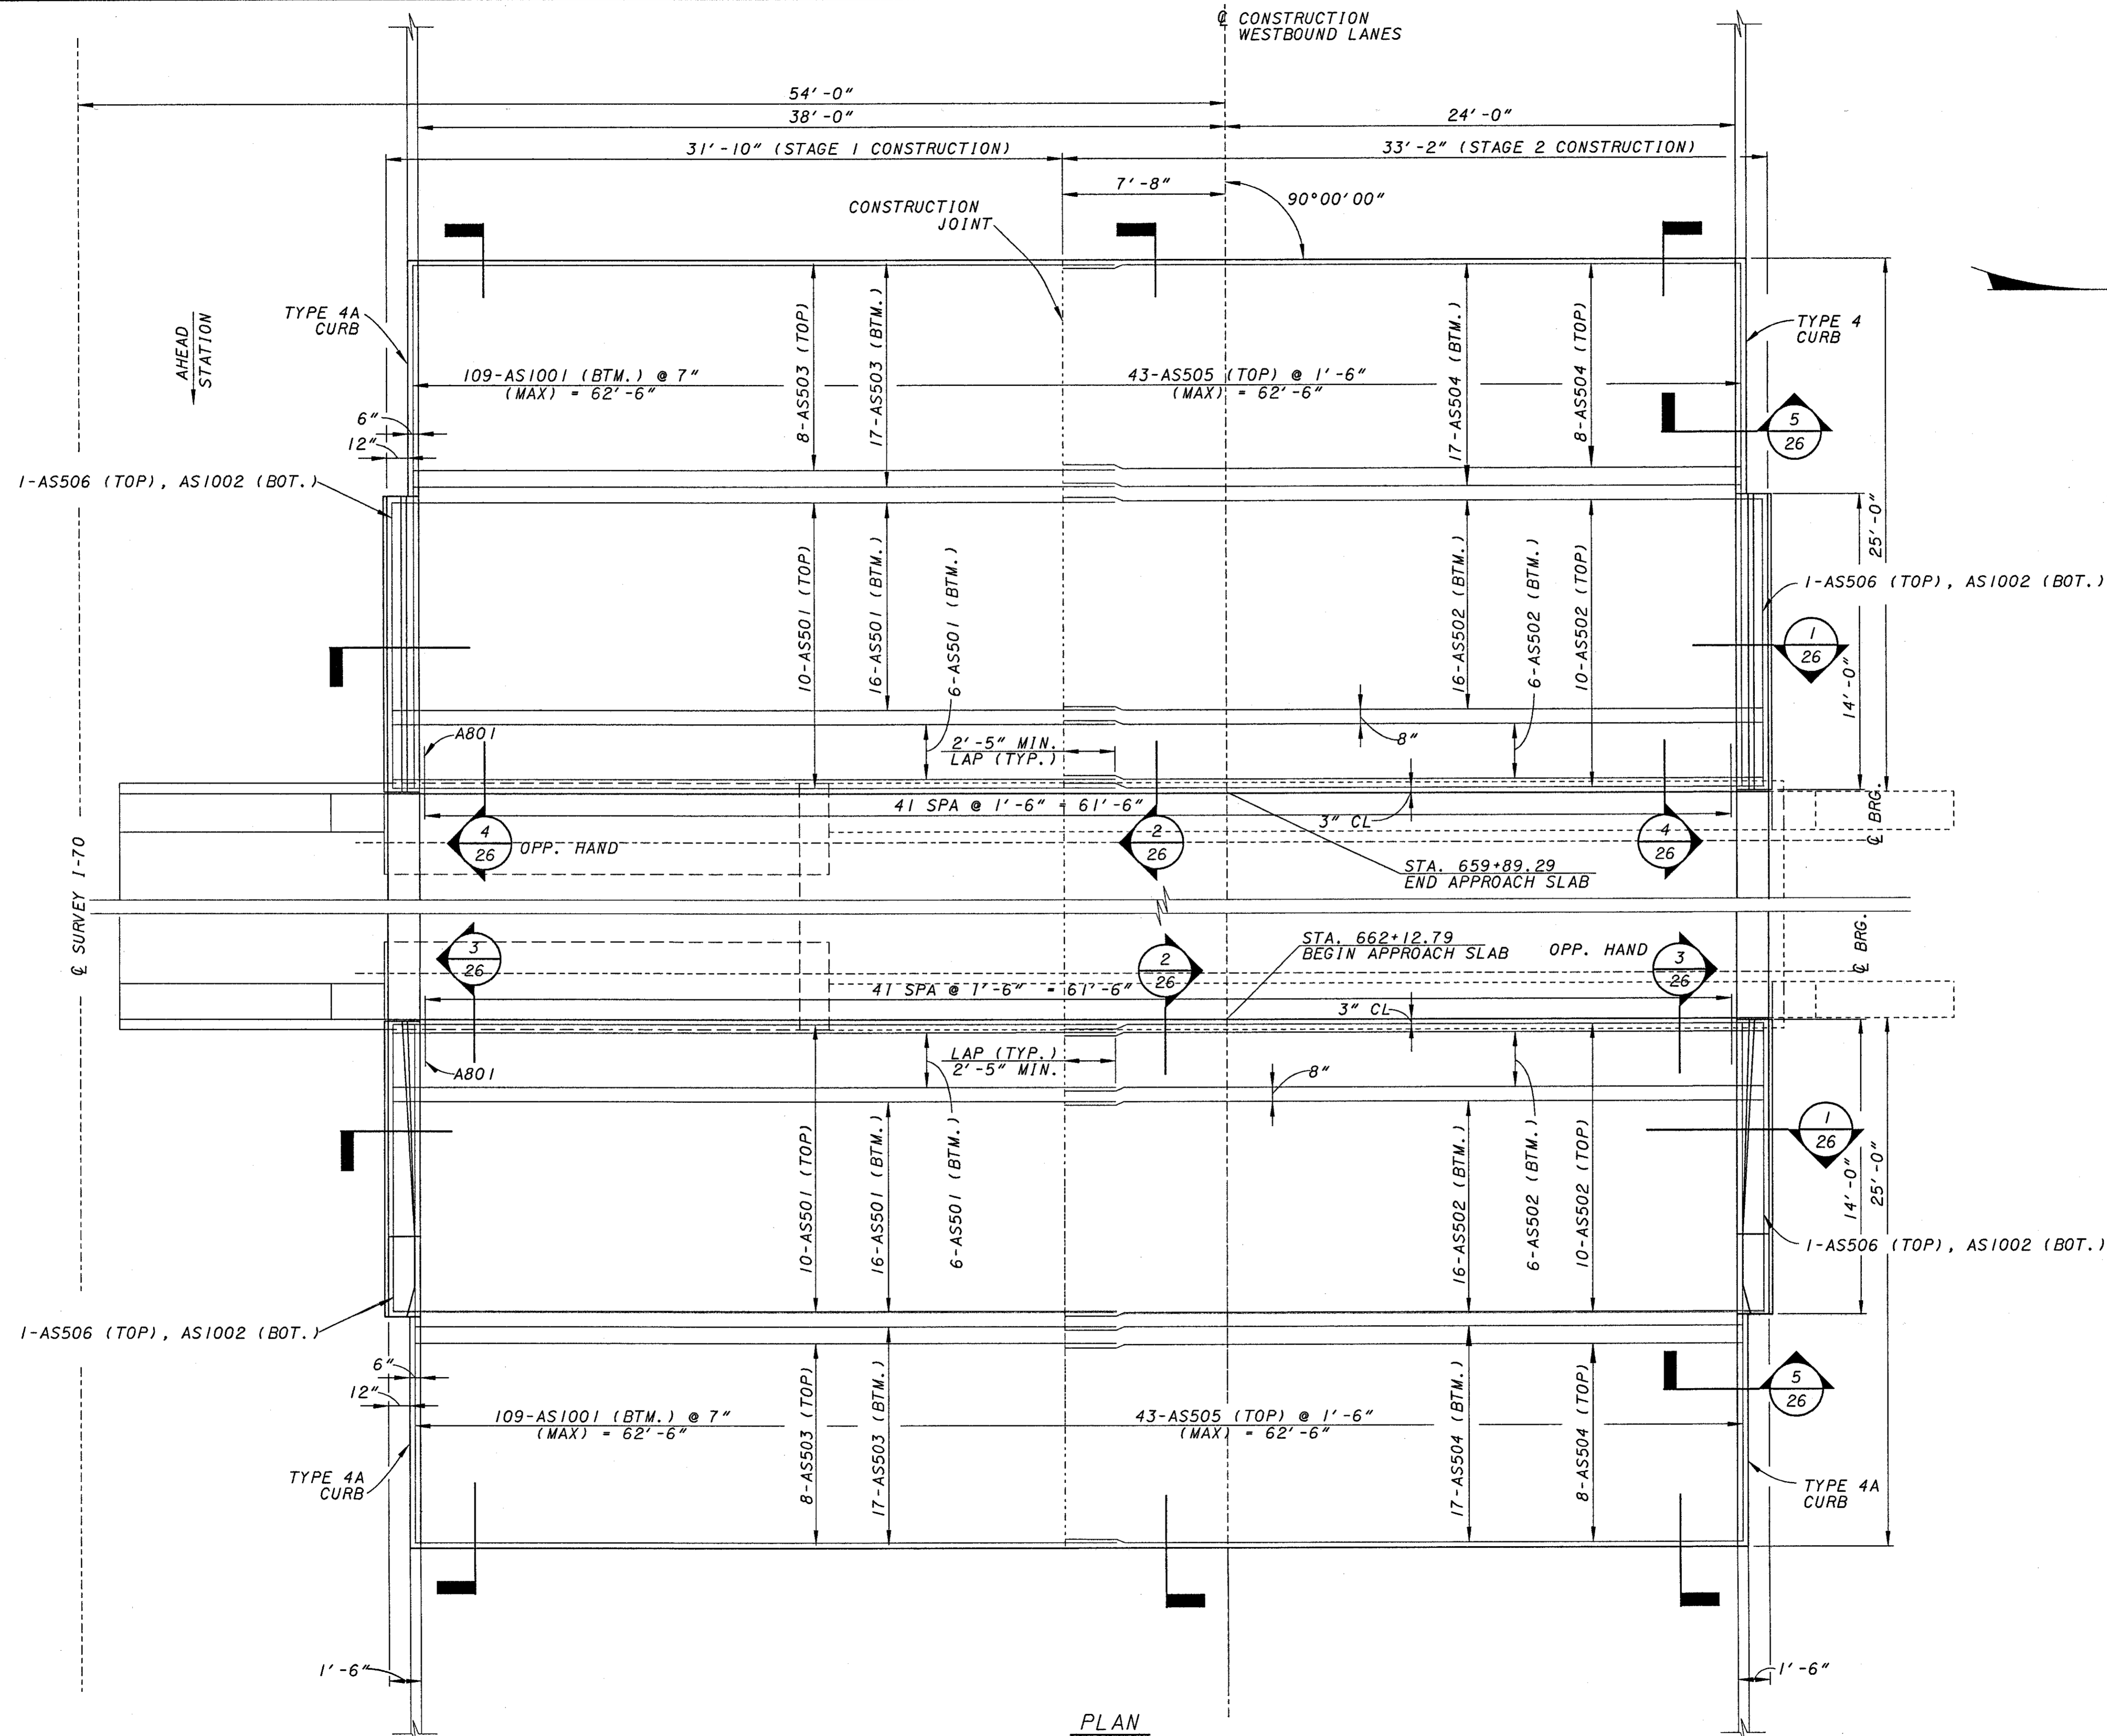

PLAN

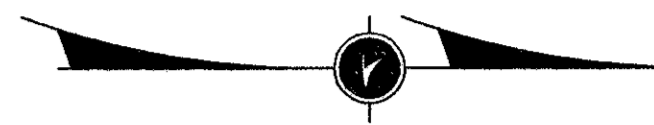

DATE	09/20/00
REVIEWED	DGK
STRUCTURE FILE NUMBER	680/269/680/293
DESIGNED	SJA
CHECKED	WBS
DRAWN	SJA
REVISED	

DESIGNED	SJA
CHECKED	WBS
DRAWN	SJA
REVISED	

KZF #13

APPROACH SLABS - LEFT BRIDGE
BRIDGE NO. PRE-70-1249 L/R
I.R. 70 OVER PRICE CREEK

PRE-70-0.00


REF: **REF**
 REF: **REF**
 DATE: 09/20/00
 TIME: 10:00 AM
 USER: JJA
 PROJECT: I.R. 70 OVER PRICE CREEK
 DRAWING: PRE-70-0.00
 SHEET: 210 OF 283

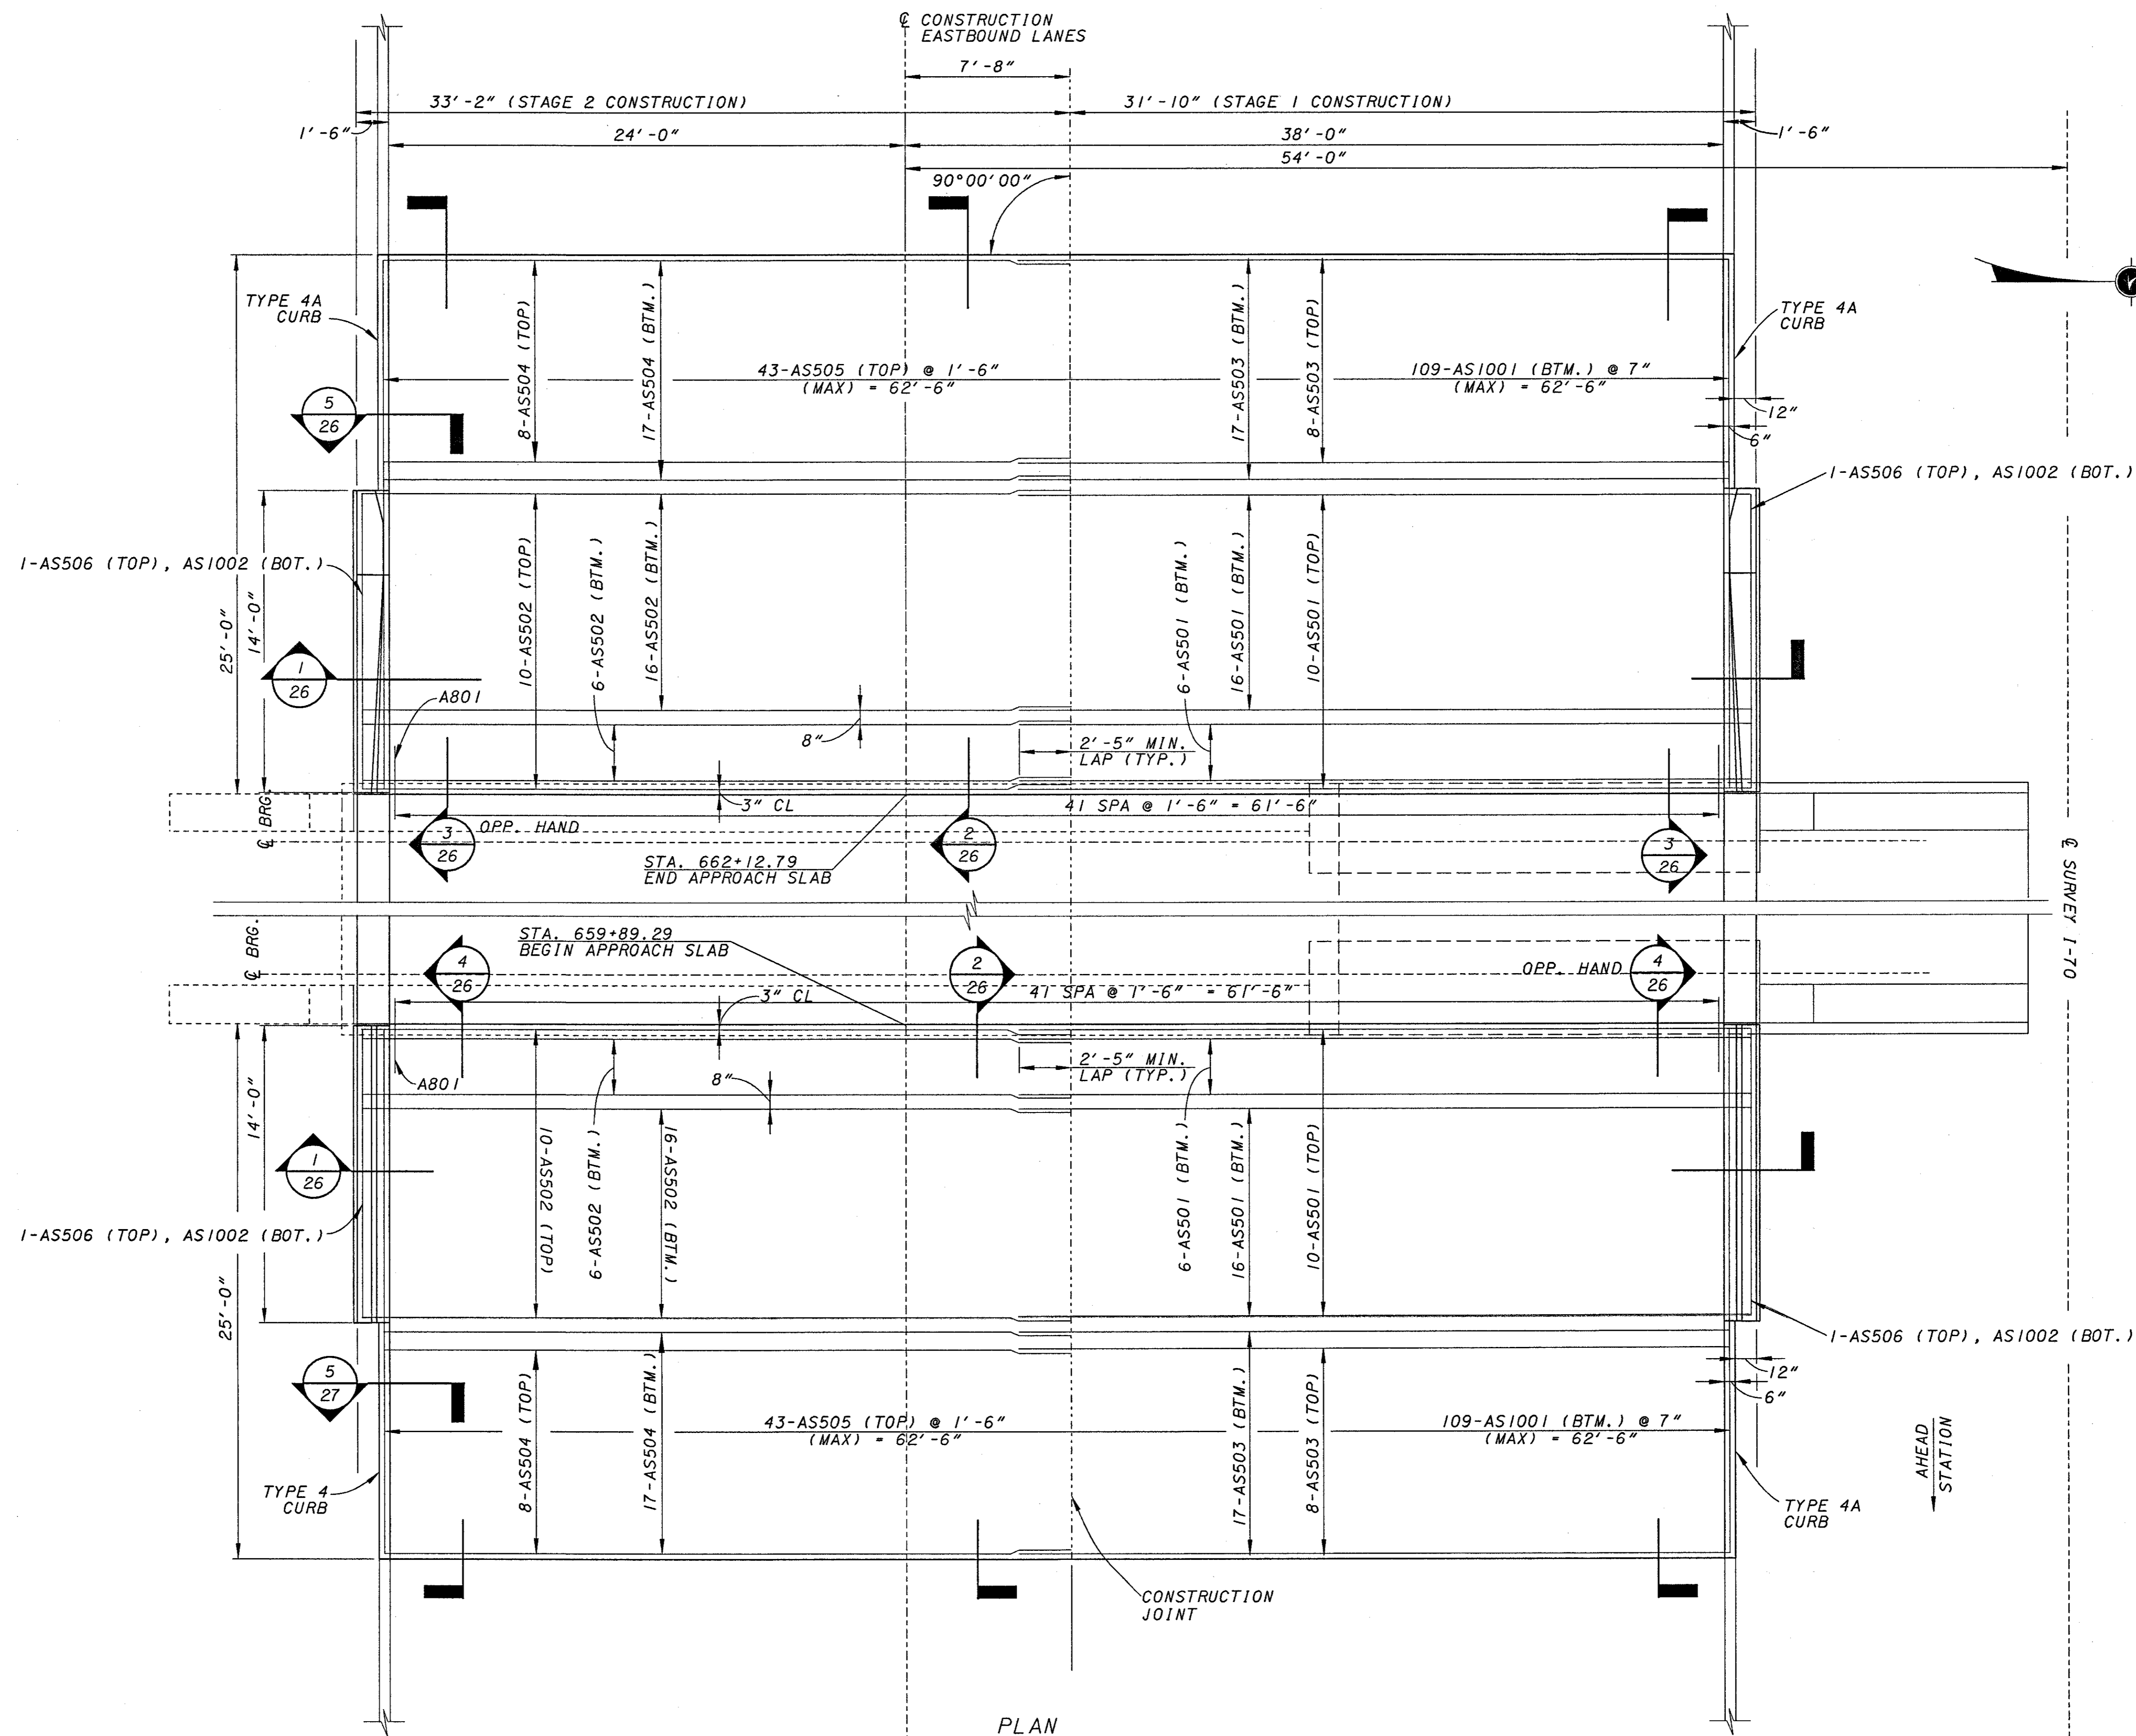

PLAN

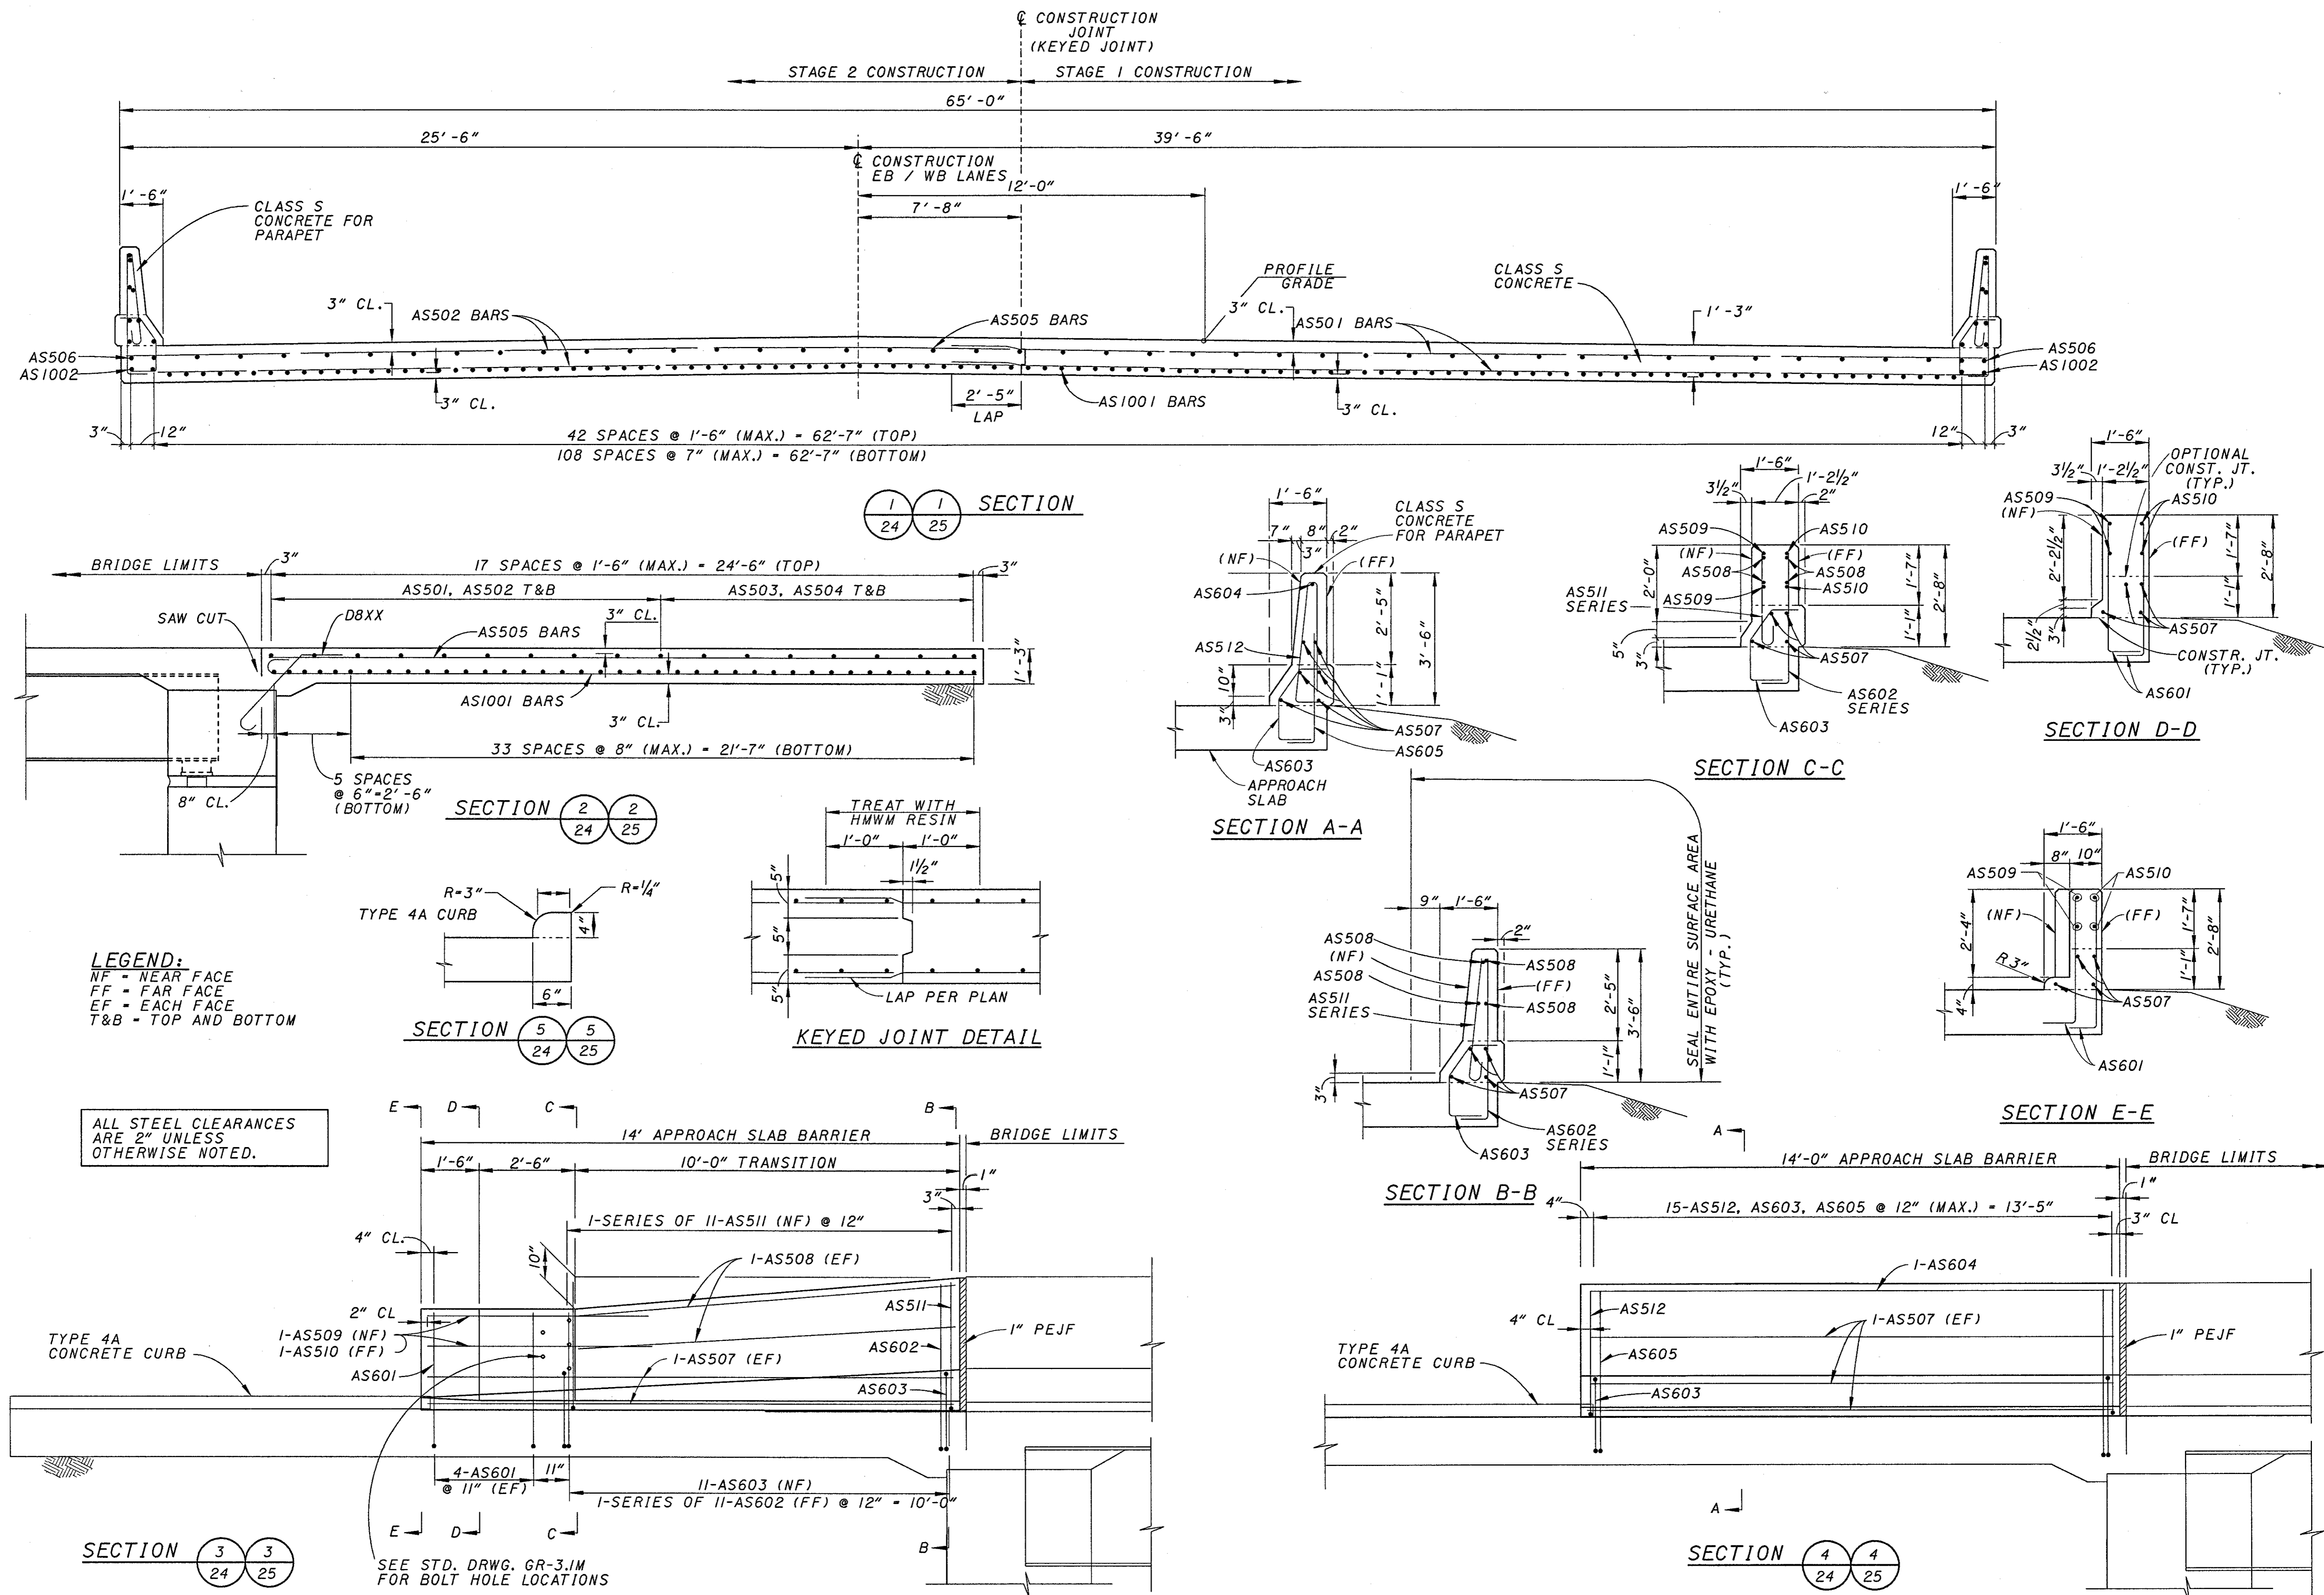

REF: AS501
REF: AS502
REF: AS503
REF: AS504
REF: AS505
REF: AS506
REF: AS507
REF: AS508
REF: AS509
REF: AS510
REF: AS511
REF: AS512
REF: AS601
REF: AS602
REF: AS603
REF: AS604
REF: AS605

SUPERSTRUCTURE REINFORCING STEEL LIST

MARK	LENGTH	SHAPE	LEFT BRIDGE		RIGHT BRIDGE	
			NUMBER	WEIGHT	NUMBER	WEIGHT
S406	2'-7"	BENT	826	1426	826	1426
S501	7'-1"	BENT	448	3310	448	3310
S502	30'-0"	STR.	1136	35546	1136	35546
S503	34'-4"	STR.	826	29579	826	29579
S504	32'-9"	STR.	826	28215	826	28215
S505	30'-0"	STR.	294	9200	294	9200
S601	3'-0"	BENT	448	2019	448	2019
S602	3'-1"	BENT	448	2075	448	2075
S603	30'-0"	STR.	14	631	14	631
S604	33'-7"	STR.	2	101	2	101
TOTAL	LBS			112102		112102

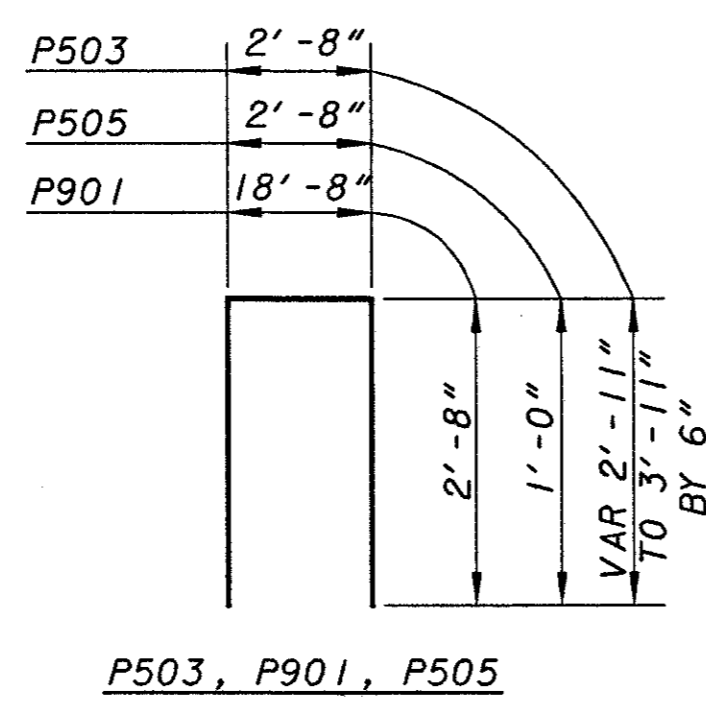

PIER REINFORCING STEEL LIST

MARK	LENGTH	SHAPE	LEFT BRIDGE		RIGHT BRIDGE	
			NUMBER	WEIGHT	NUMBER	WEIGHT
P501	11'-6"	STR.	36	432	36	432
P502	7'-6"	STR.	39	306	39	306
VAR 10'-3"			12		12	
BY 0'-6"			5		5	
P503	TO 8'-3"	BENT	SER OF	579	SER OF	579
P504	14'-3"	BENT	74	1100	78	1160
P505	4'-5"	BENT	63	291	63	291
P506	18'-8"	STR.	6	117	6	117
P507	17'-3"	STR.	6	108	6	108
P601	7'-6"	STR.	39	440	39	440
P602	19'-5"	BENT	6	175	6	175
P801	10'-4"	BENT	66	1821	66	1821
P802	23'-6"	STR.			22	1381
P803	23'-5"	STR.			22	1376
P804	19'-3"	STR.			22	1131
P805	22'-6"	STR.	22	1322		
P806	22'-4"	STR.	22	1312		
P807	19'-2"	STR.	22	1126		
P901	23'-5"	BENT	15	1195	15	1195
TOTAL	LBS			10,324		10,512

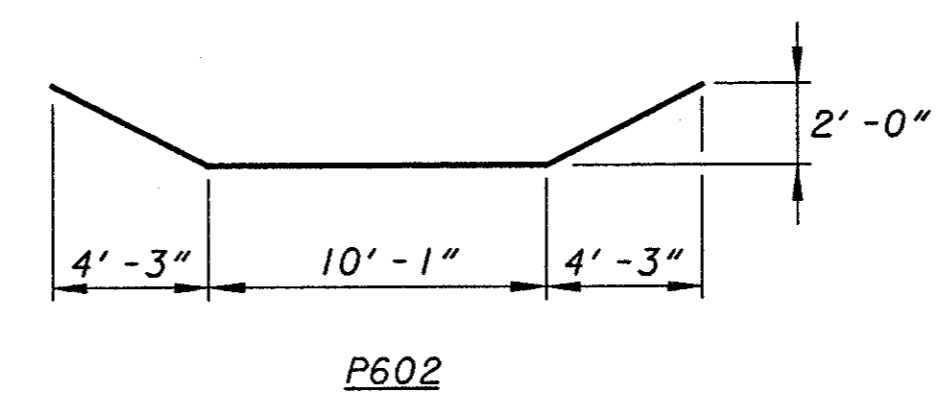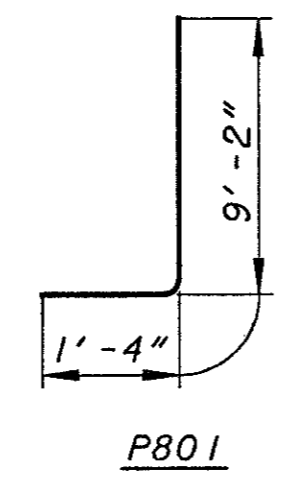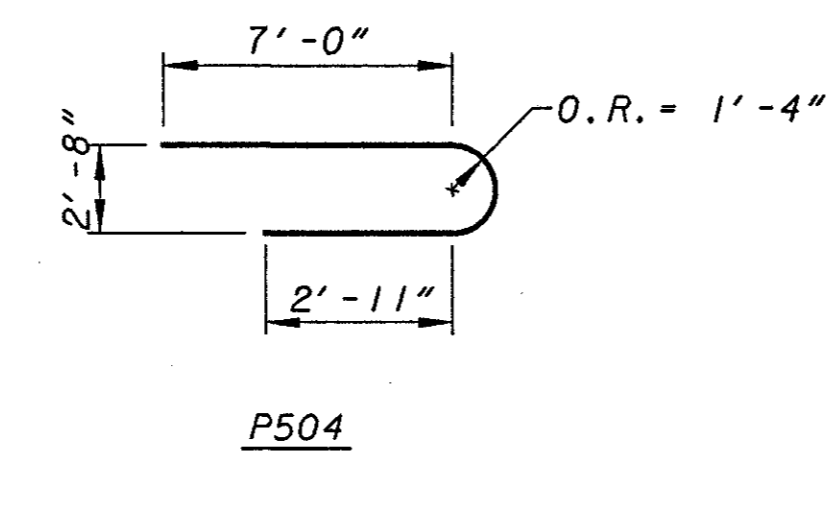

APPROACH SLAB REINFORCING STEEL LIST

MARK	LENGTH	SHAPE	LEFT BRIDGE		RIGHT BRIDGE	
			NUMBER	WEIGHT	NUMBER	WEIGHT
AS501	34'-0"	STR.	64	2,270	64	2,270
AS502	32'-11"	STR.	64	2,197	64	2,197
AS503	33'-0"	STR.	50	1,721	50	1,721
AS504	31'-11"	STR.	50	1,664	50	1,664
AS505	24'-6"	STR.	86	2,198	86	2,198
AS506	13'-6"	STR.	4	56	4	56
AS507	13'-5"	STR.	20	280	20	280
AS508	10'-0"	STR.	8	83	8	83
AS509	5'-8"	BENT	4	24	4	24
AS510	5'-8"	STR.	4	24	4	24
VAR 3'-10"			2		2	
TO 3'-0"			SER OF	78	SER OF	78
BY 0'-1"			11		11	
AS511	TO 3'-0"	BENT	SER OF	78	SER OF	78
BY 0'-1"			11		11	
AS512	7'-1"	BENT	30	222	30	222
AS601	4'-3"	BENT	16	102	16	102
VAR 4'-2"			2		2	
AS602	TO 5'-0"	BENT	SER OF	151	SER OF	151
BY 0'-1"			11		11	
AS603	3'-5"	BENT	52	267	52	267
AS604	13'-5"	STR.	2	40	2	40
AS605	3'-9"	BENT	30	169	30	169
AS1001	25'-11"	BENT	218	24,311	218	24,311
AS1002	14'-11"	BENT	4	257	4	257
TOTAL	LBS			36,114		36,114

ABUTMENT REINFORCING STEEL LIST









MARK	LENGTH	SHAPE	LEFT BRIDGE		RIGHT BRIDGE	
			NUMBER	WEIGHT	NUMBER	WEIGHT
A501	17'-0"	BENT	48	852	48	852
A502	20'-2"	BENT	30	632	30	632
A503	19'-6"	BENT	8	163	8	163
VAR 22'-1"			2		2	
TO 15'-5"			SER OF	235	SER OF	235
BY 1'-4"			6		6	
A505	9'-8"	BENT	6	61	6	61
A506	8'-2"	BENT	2	18	2	18
VAR 9'-7"			4		4	
TO 4'-7"			STR.	SER OF	SER OF	89
BY 2'-6"			3		3	
A508	13'-4"	BENT	4	56	4	56
A509	33'-3"	STR.	12	417	12	417
A510	14'-9"	STR.	12	185	12	185
A511	13'-8"	BENT	2	29	2	29
A512	22'-1"	STR.	8	185	8	185
A801	34'-8"	STR.	8	741	8	741
A802	23'-6"	STR.	8	502	8	502
TOTAL	LBS			4165		4165

- NOTES:**
- ALL DIMENSIONS ARE OUT TO OUT OF BAR EXCEPT ON STANDARD 180° AND 135° HOOKS.
 - DIMENSIONS ON HOOKS TO BE SHOWN ONLY WHERE NECESSARY TO RESTRICT HOOK SIZE, OTHERWISE STANDARD HOOKS ARE TO BE USED.
 - ALL BENDS SHOWN ARE BENT AROUND A STANDARD MANDREL, EXCEPT WHERE RADIUS "R" IS INDICATED.
 - ALL BARS ARE EPOXY COATED.
 - THE BAR SIZE NUMBER IS SPECIFIED ON THE PLANS IN THE BAR MARK COLUMN. THE FIRST DIGIT INDICATES THE BAR SIZE NUMBER. FOR EXAMPLE, A501 IS A NO. 5 BAR.

DIAPHRAGM REINFORCING STEEL LIST

MARK	LENGTH	SHAPE	LEFT BRIDGE		RIGHT BRIDGE	
			NUMBER	WEIGHT	NUMBER	WEIGHT
D501	6'-4"	BENT	102	667	102	667
D502	13'-0"	BENT	102	1369	102	1369
D801*	33'-2"	STR.	28	2480	28	2480
D802	31'-5"	STR.	18	1509	18	1509
D803	5'-0"	BENT	88	1175	88	1175
D804	30'-9"	STR.	10	821	10	821
TOTAL	LBS			8021		8021

* 28 MECH. CONNECTORS REQ'D AT EACH BRIDGE FOR D801 BARS

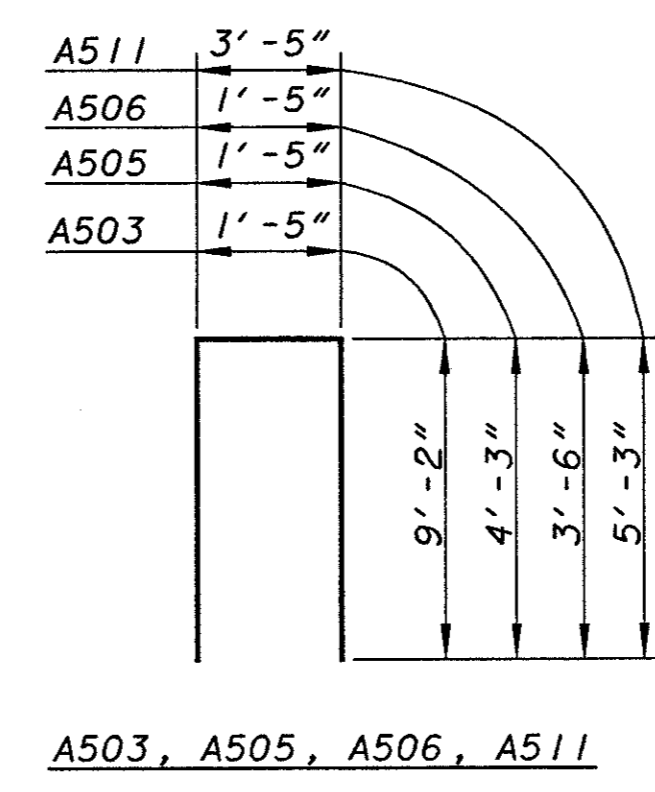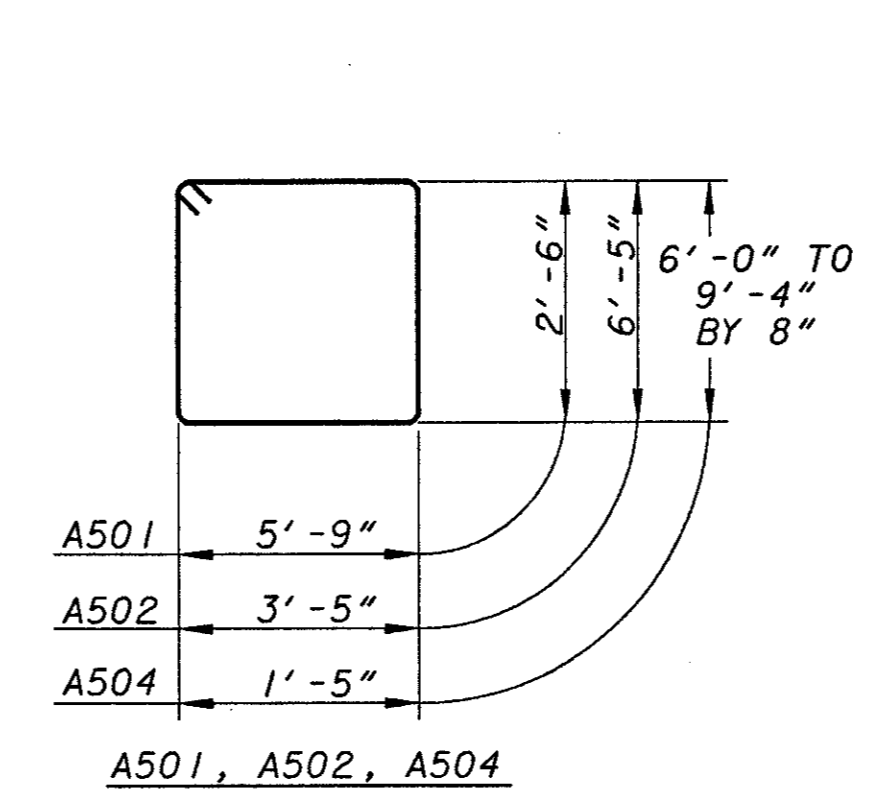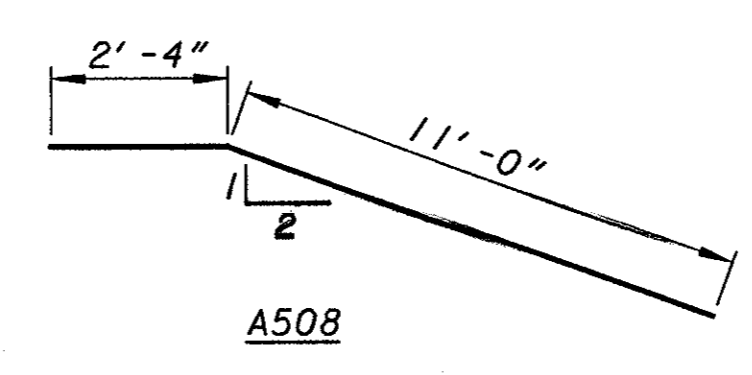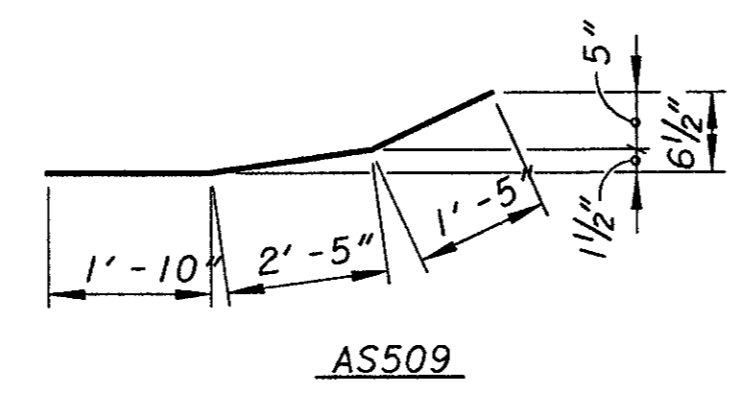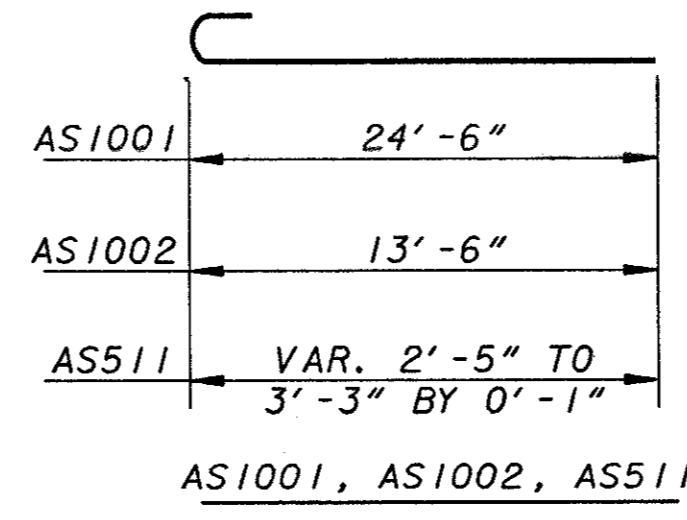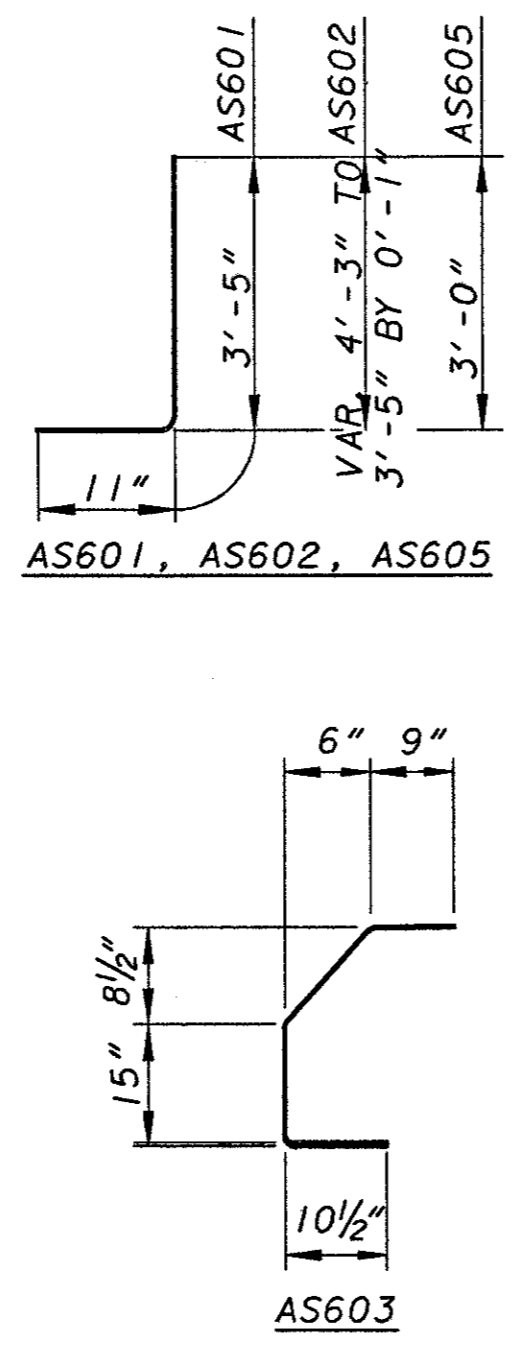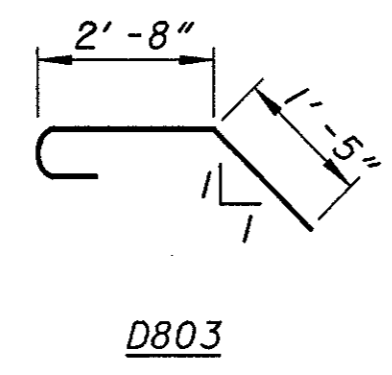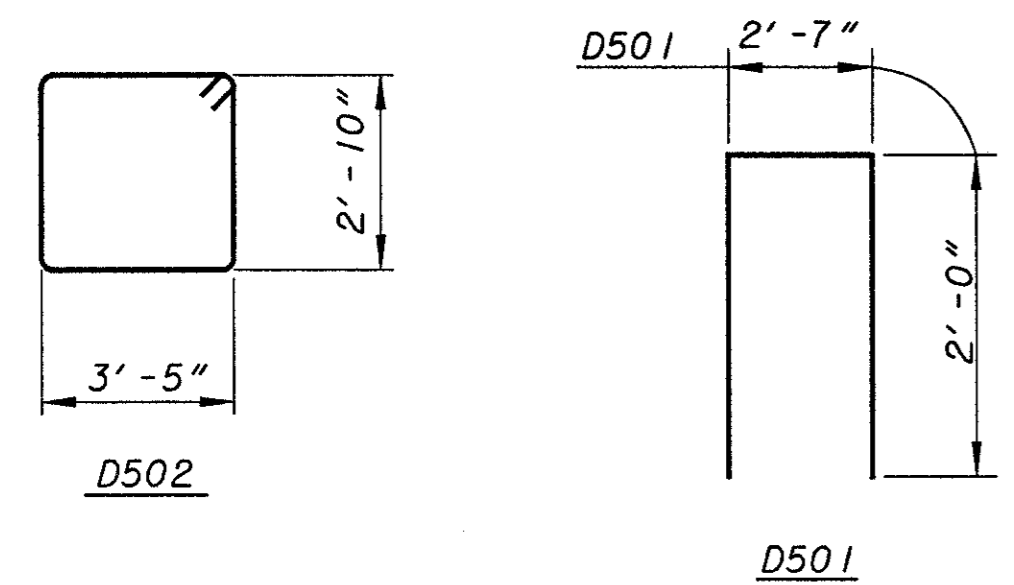






REF: **REF1**
REF: **REF2**
REF: **REF3**
REF: **REF4**
REF: **REF5**
REF: **REF6**
REF: **REF7**
REF: **REF8**
REF: **REF9**
REF: **REF10**

REF: **REF1**
REF: **REF2**
REF: **REF3**
REF: **REF4**
REF: **REF5**
REF: **REF6**
REF: **REF7**
REF: **REF8**
REF: **REF9**
REF: **REF10**

REF: **REF1**
REF: **REF2**
REF: **REF3**
REF: **REF4**
REF: **REF5**
REF: **REF6**
REF: **REF7**
REF: **REF8**
REF: **REF9**
REF: **REF10**

REF: **REF1**
REF: **REF2**
REF: **REF3**
REF: **REF4**
REF: **REF5**
REF: **REF6**
REF: **REF7**
REF: **REF8**
REF: **REF9**
REF: **REF10**

REF: **REF1**
REF: **REF2**
REF: **REF3**
REF: **REF4**
REF: **REF5**
REF: **REF6**
REF: **REF7**
REF: **REF8**
REF: **REF9**
REF: **REF10**

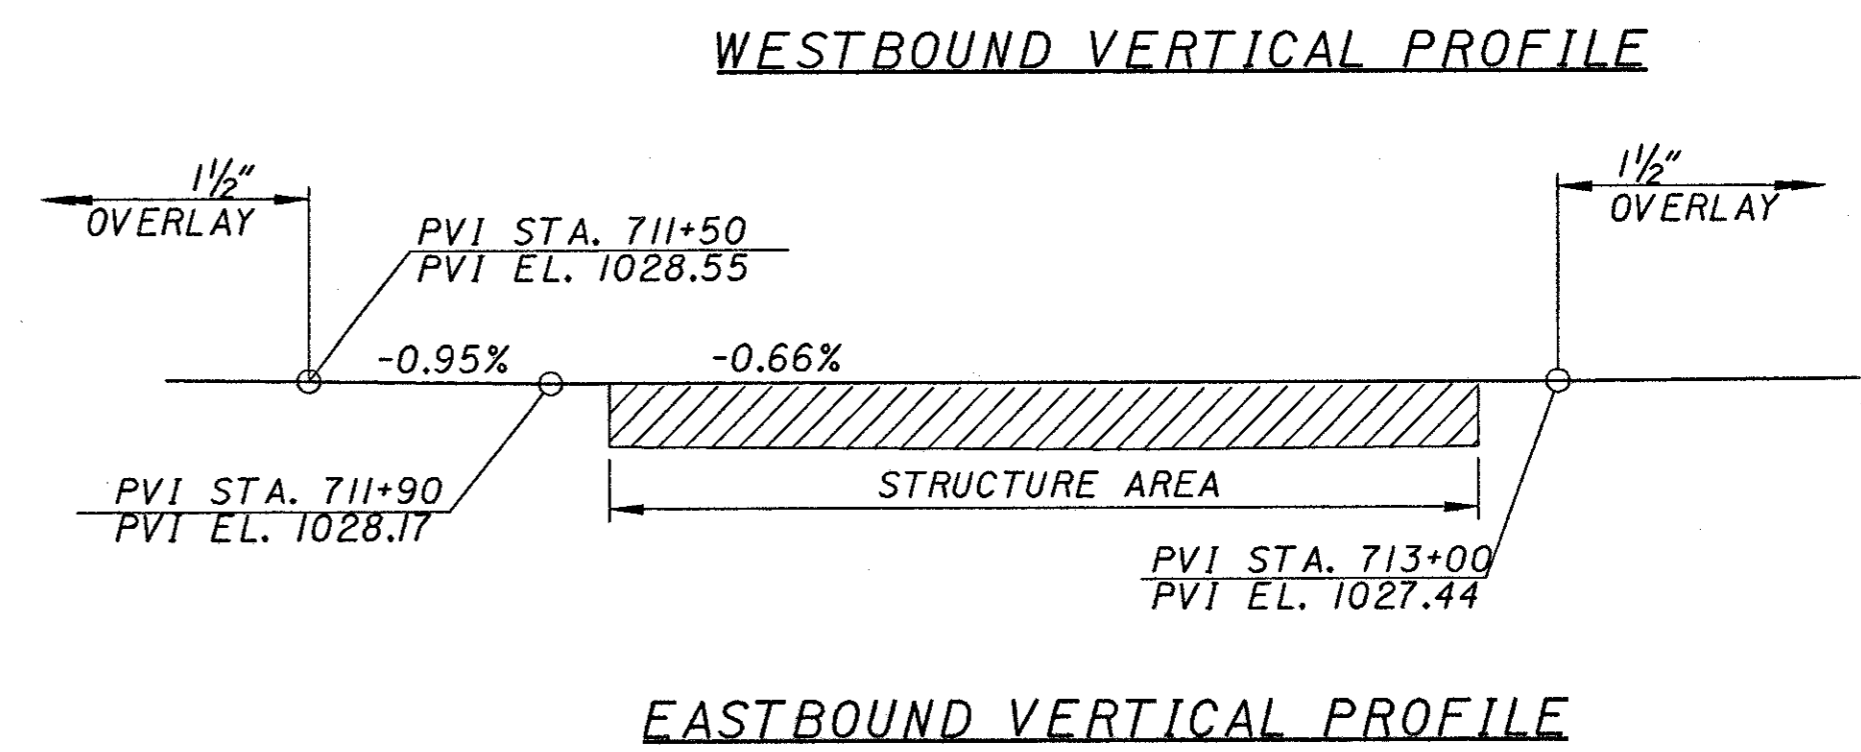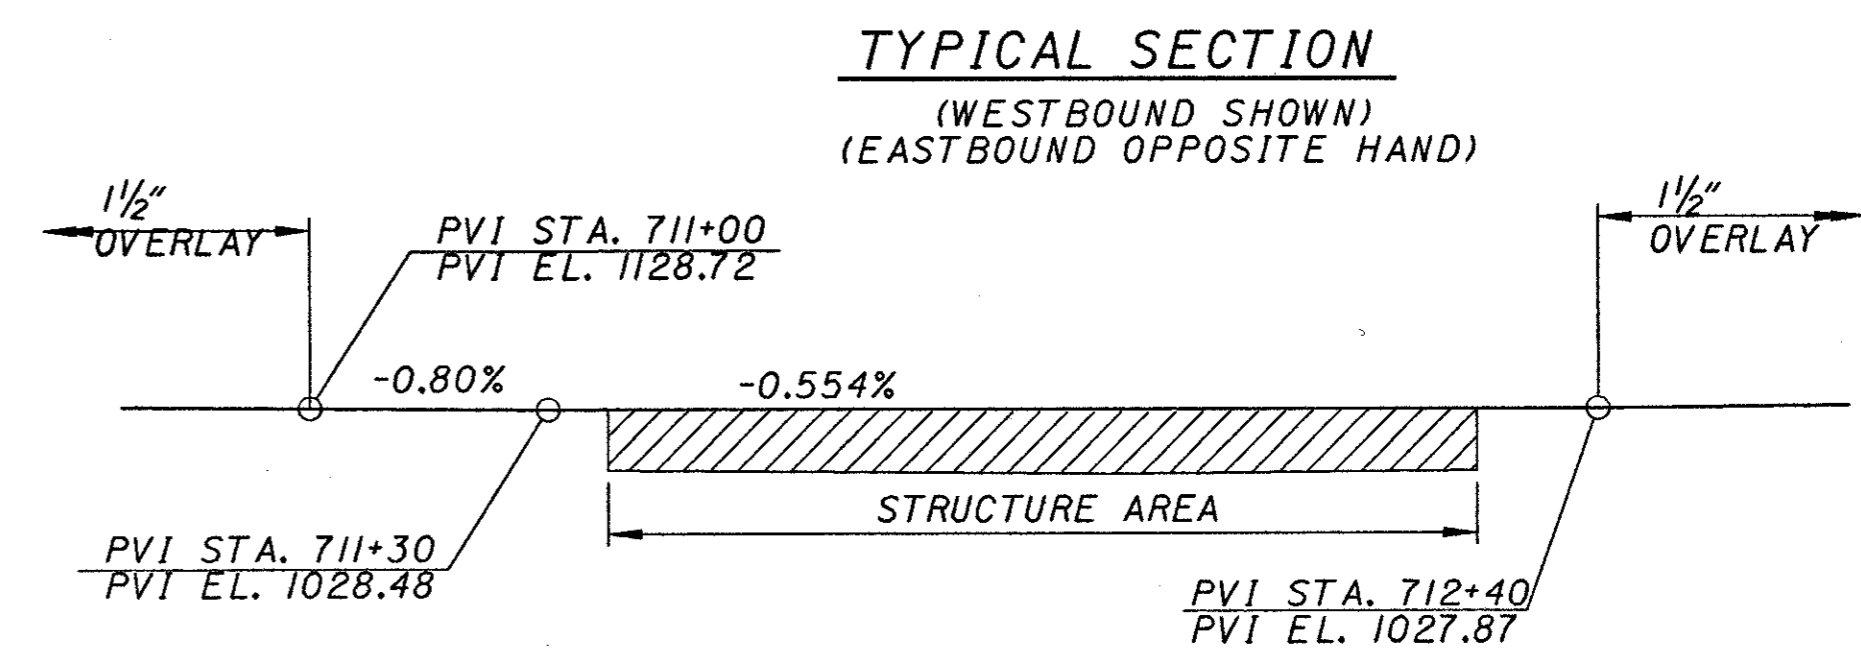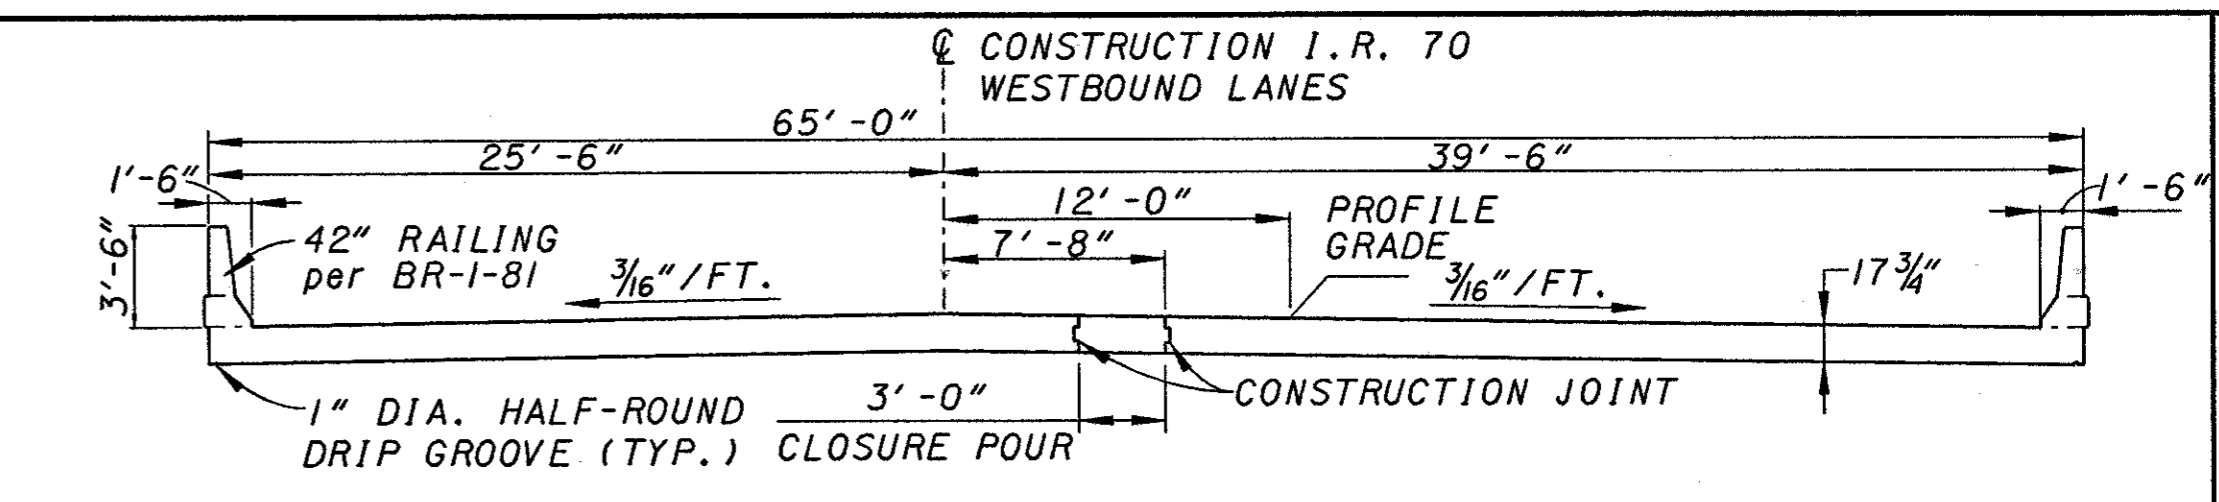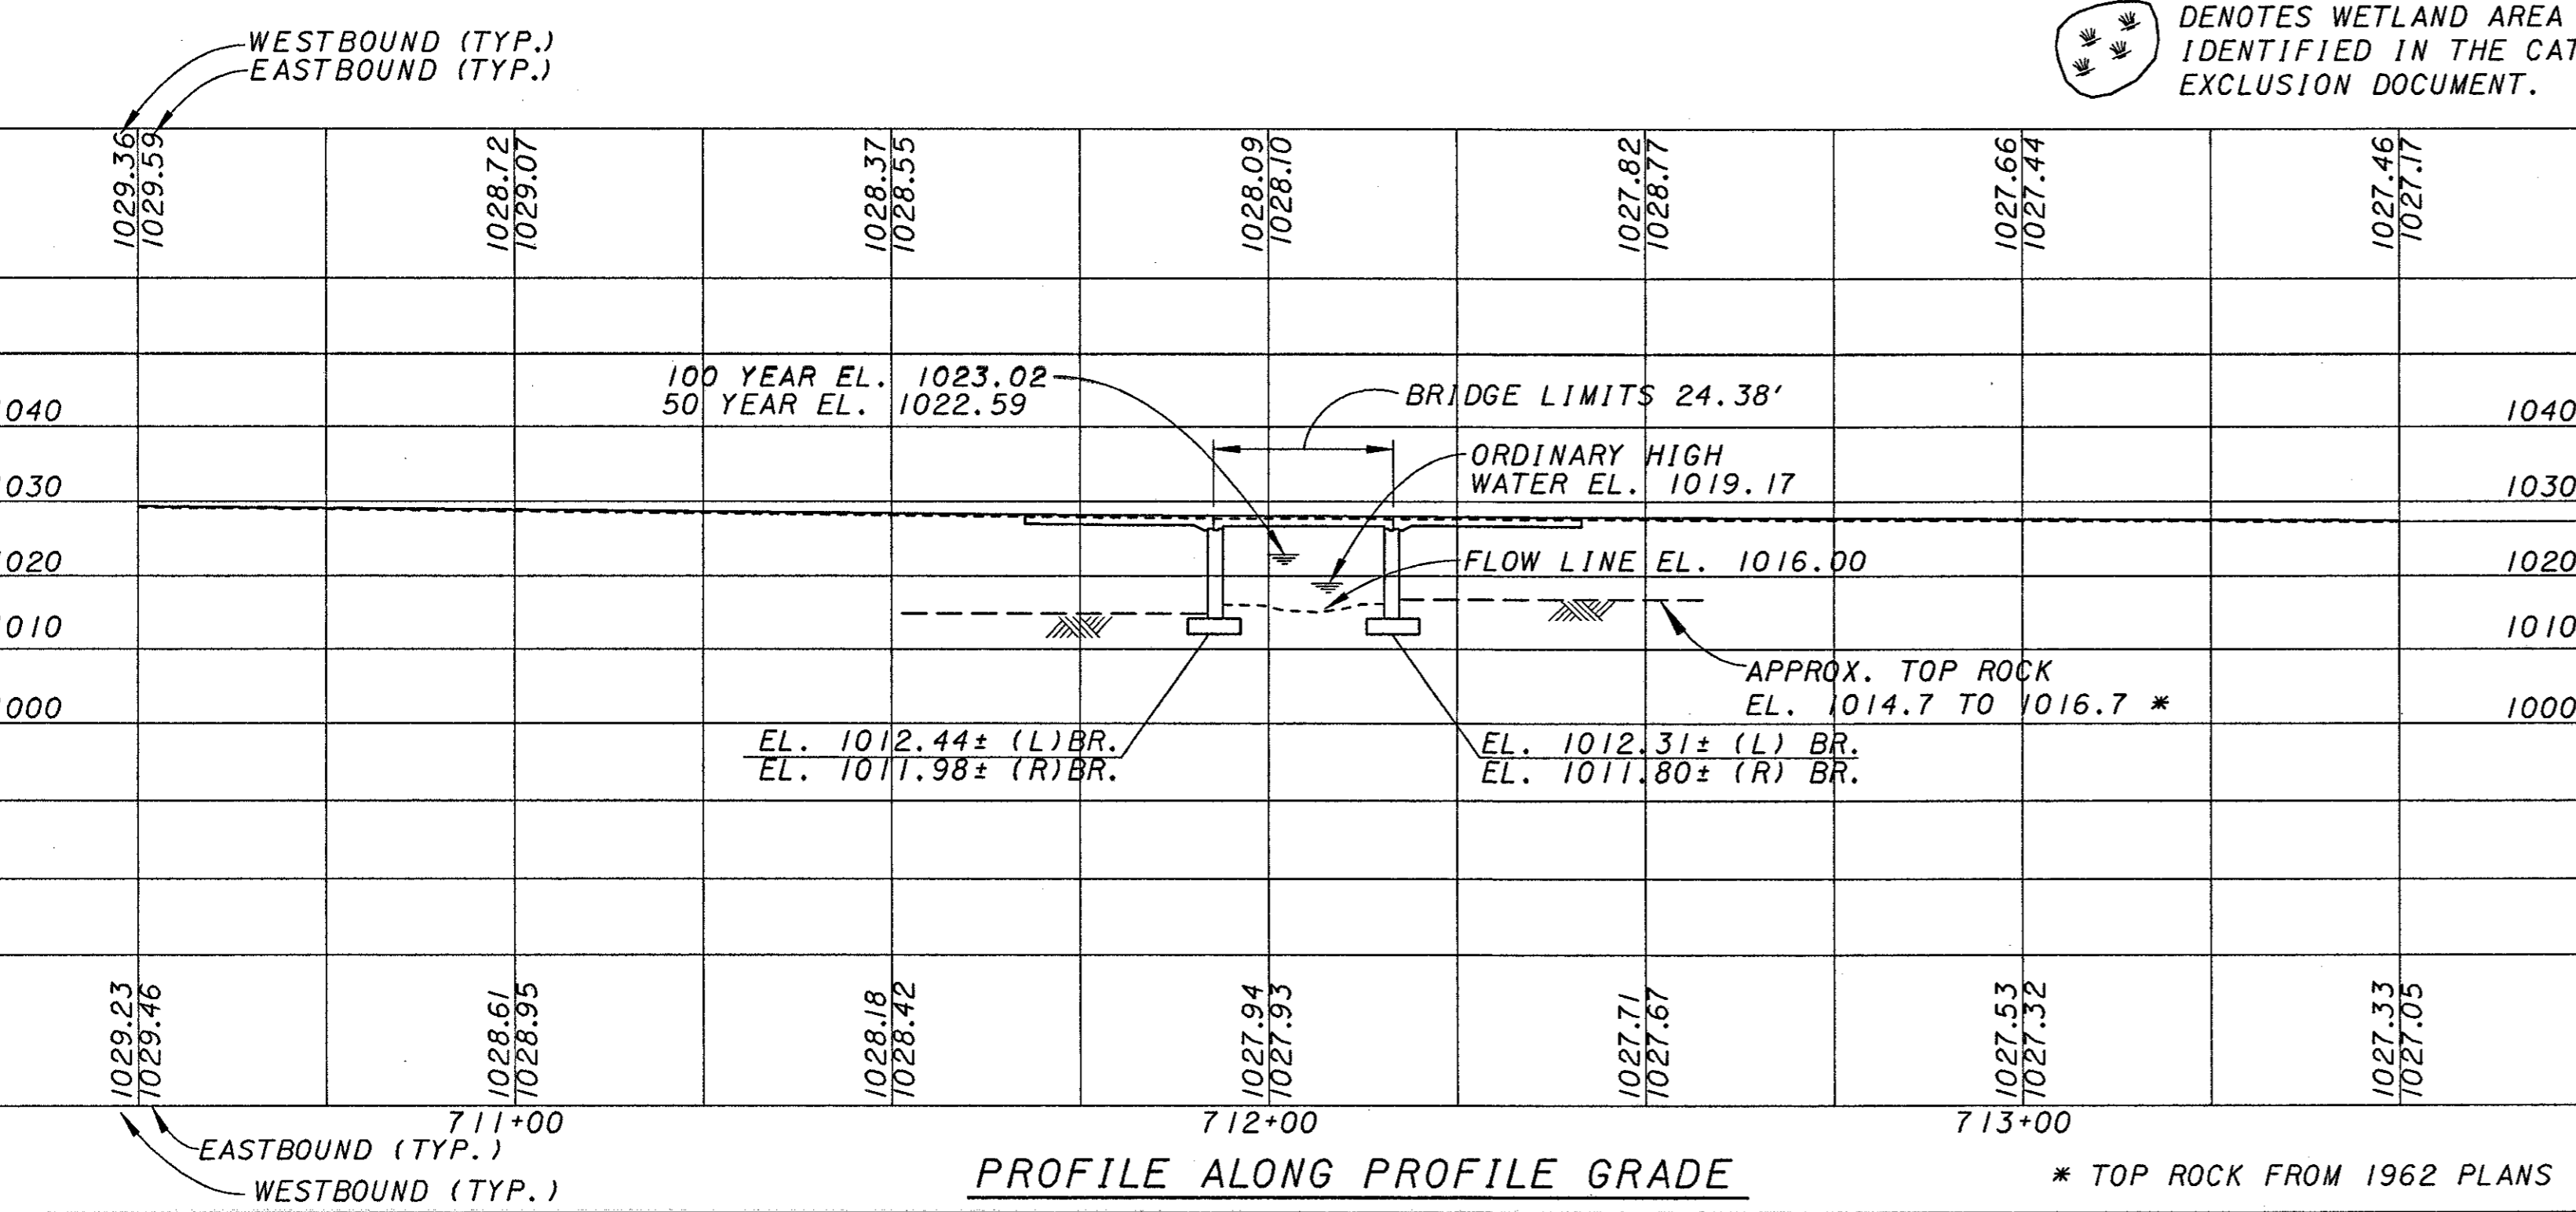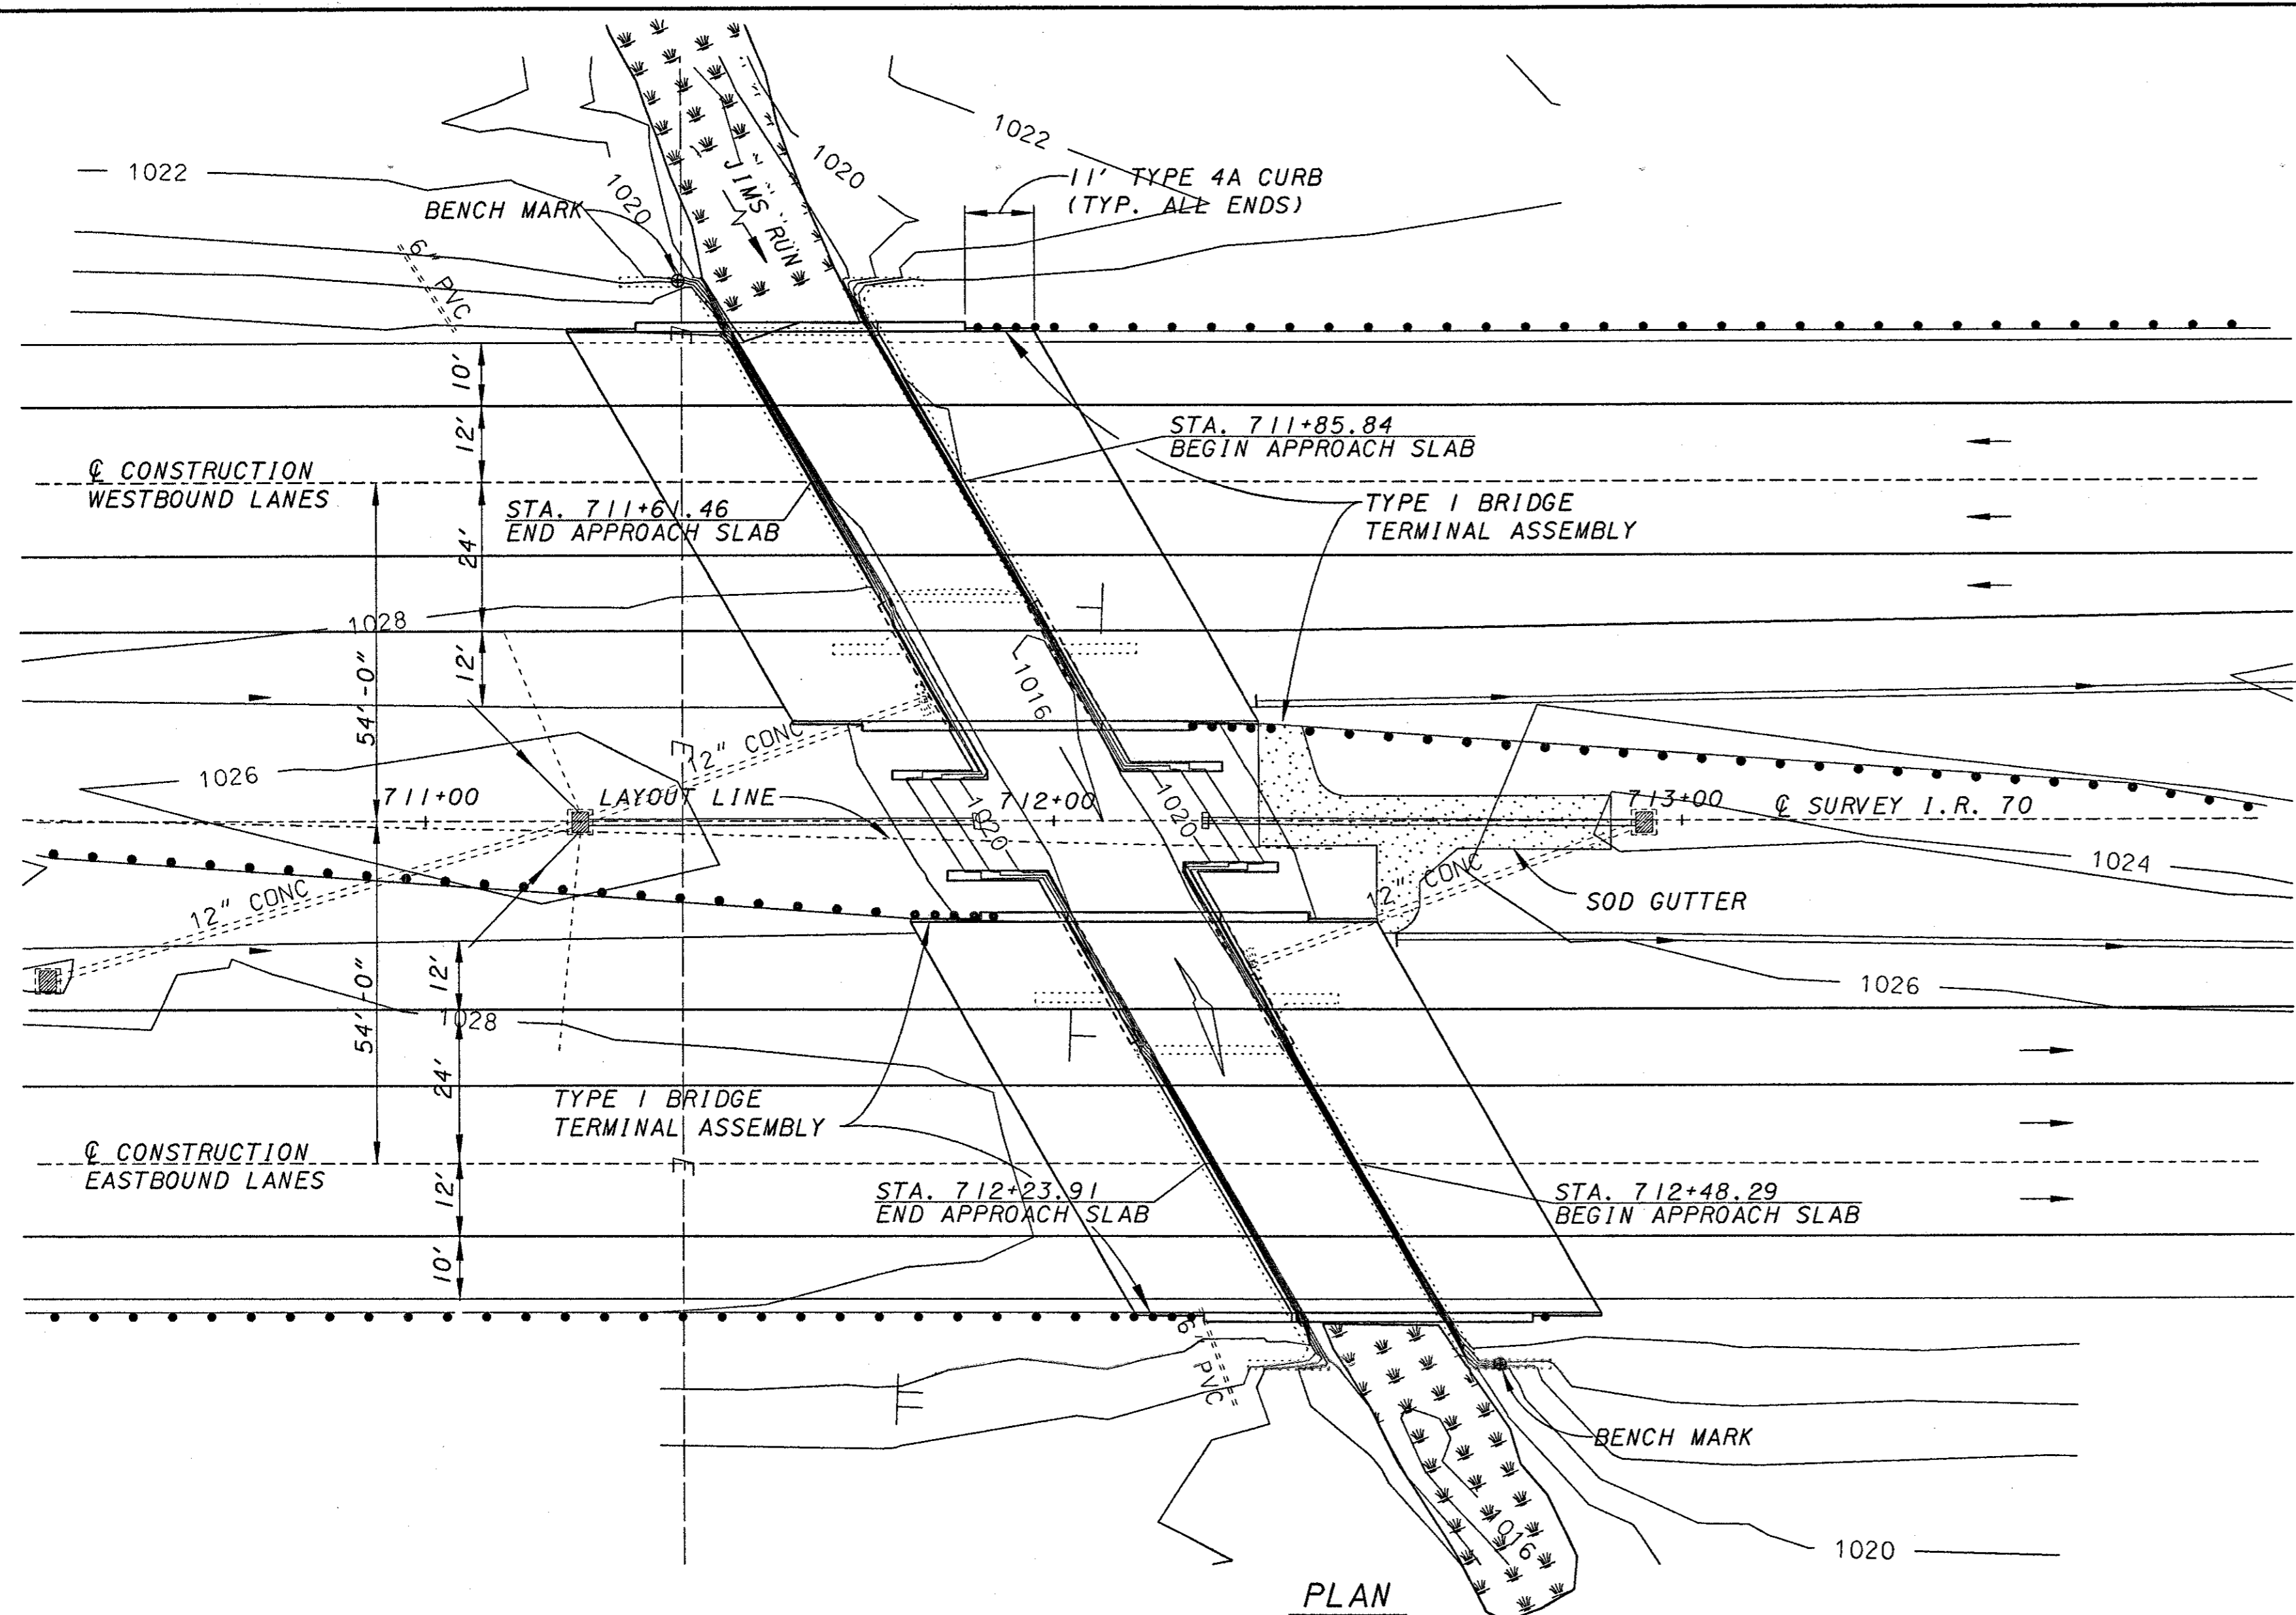

TRAFFIC DATA	
ADT (2001) -	35,860
ADT (2021) -	50,800
ADTT (2021) -	19,812
SOURCE -	ODOT

BENCH MARK	
BOX NOTCH ON S.E. ABUTMENT EASTBOUND AT STA. 712+65±, 80' RT. AT ELEVATION 1025.87	
BOX NOTCH ON N.W. ABUTMENT WESTBOUND AT STA. 711+40±, 80' LT. AT ELEVATION 1026.52	

DRAINAGE DATA	
DRAINAGE AREA:	1.5 SQ. MILES
EXISTING BRIDGE OPENING:	182 Sq. Ft.
PROPOSED BRIDGE OPENING:	182 Sq. Ft.
HW100:	1023.02
HW50:	1022.59
Q100:	734 C.F.S.
Q50:	649 C.F.S.
V100:	7.67 F.P.S.
V50:	7.29 F.P.S.
LOW CHORD ELEVATION:	1025.98
TOP OF DECK ELEVATION:	1027.45 TO 1028.44

EXISTING STRUCTURE - I.R. 70	
TYPE:	SIMPLE SPAN REINFORCED CONCRETE SLAB WITH CANTILEVER ABUTMENTS
LENGTH OF SPAN:	21'-6" CLEAR
ROADWAY WIDTH:	42'-0" ± FACE/FACE BARRIER
DESIGN LOADING:	C.F. 2000
SKEW ANGLE:	30°00'00" ± RT. FWD.
SUPERELEVATION:	NONE - NORMAL CROWN
WEARING SURFACE:	1" MONOLITHIC CONCRETE
ALIGNMENT:	TANGENT
YEAR BUILT:	1962

PROPOSED STRUCTURE	
PROPOSED WORK:	NEW REINFORCED CONCRETE DECK ON WIDENED SUBSTRUCTURE.
TYPE:	SIMPLE SPAN REINFORCED CONCRETE SLAB WITH CANTILEVER ABUTMENTS
LENGTH OF SPAN:	21'-6" CLEAR
ROADWAY WIDTH:	62'-0" ± FACE/FACE BARRIER
DESIGN LOADING:	HS-20 WITH ALTERNATE MILITARY
SKEW ANGLE:	30°00'00" ± RT. FWD.
SUPERELEVATION:	NONE - NORMAL CROWN
WEARING SURFACE:	1" MONOLITHIC CONCRETE
APPROACH SLAB:	AS-1-81 (25' LONG)
ALIGNMENT:	TANGENT
LATITUDE:	N 39°50'16"
LONGITUDE:	W 84°33'39"

DENOTES WETLAND AREA AS IDENTIFIED IN THE CATEGORICAL EXCLUSION DOCUMENT.

KZF DESIGN
 ARCHITECTURE | ENGINEERING | INTERIORS | PLANNING
 1000 N. W. 10th St., Suite 1000, Ft. Lauderdale, FL 33304
 TEL: 954.576.1111 FAX: 954.576.1112 WWW.KZFD.COM

DATE	1/29/01
REVIEWED	DGK
DRAWN	JDG
DESIGNED	S/A
PREFILE COUNTY	STA 17+96.00
	STA 21+23.00
STRUCTURE FILE NUMBER	6801323/6801358
CHECKED	WBS

S I T E P L A N
 BRIDGE NO. PRE-70-1349 L/R
 I.R. 70 OVER JIM'S RUN

KZF #14

PRE-70-0.00

1 / 15

213
 283




REF: **REF1**
REF: **REF2**
REF: **REF3**
REF: **REF4**
REF: **REF5**

REF: **REF1**
REF: **REF2**
REF: **REF3**
REF: **REF4**
REF: **REF5**

REF: **REF1**
REF: **REF2**
REF: **REF3**
REF: **REF4**
REF: **REF5**

REF: **REF1**
REF: **REF2**
REF: **REF3**
REF: **REF4**
REF: **REF5**

USER: *****
DATE: *****
TIME: *****
ACTIVE LEVELS: ON #1E1V#

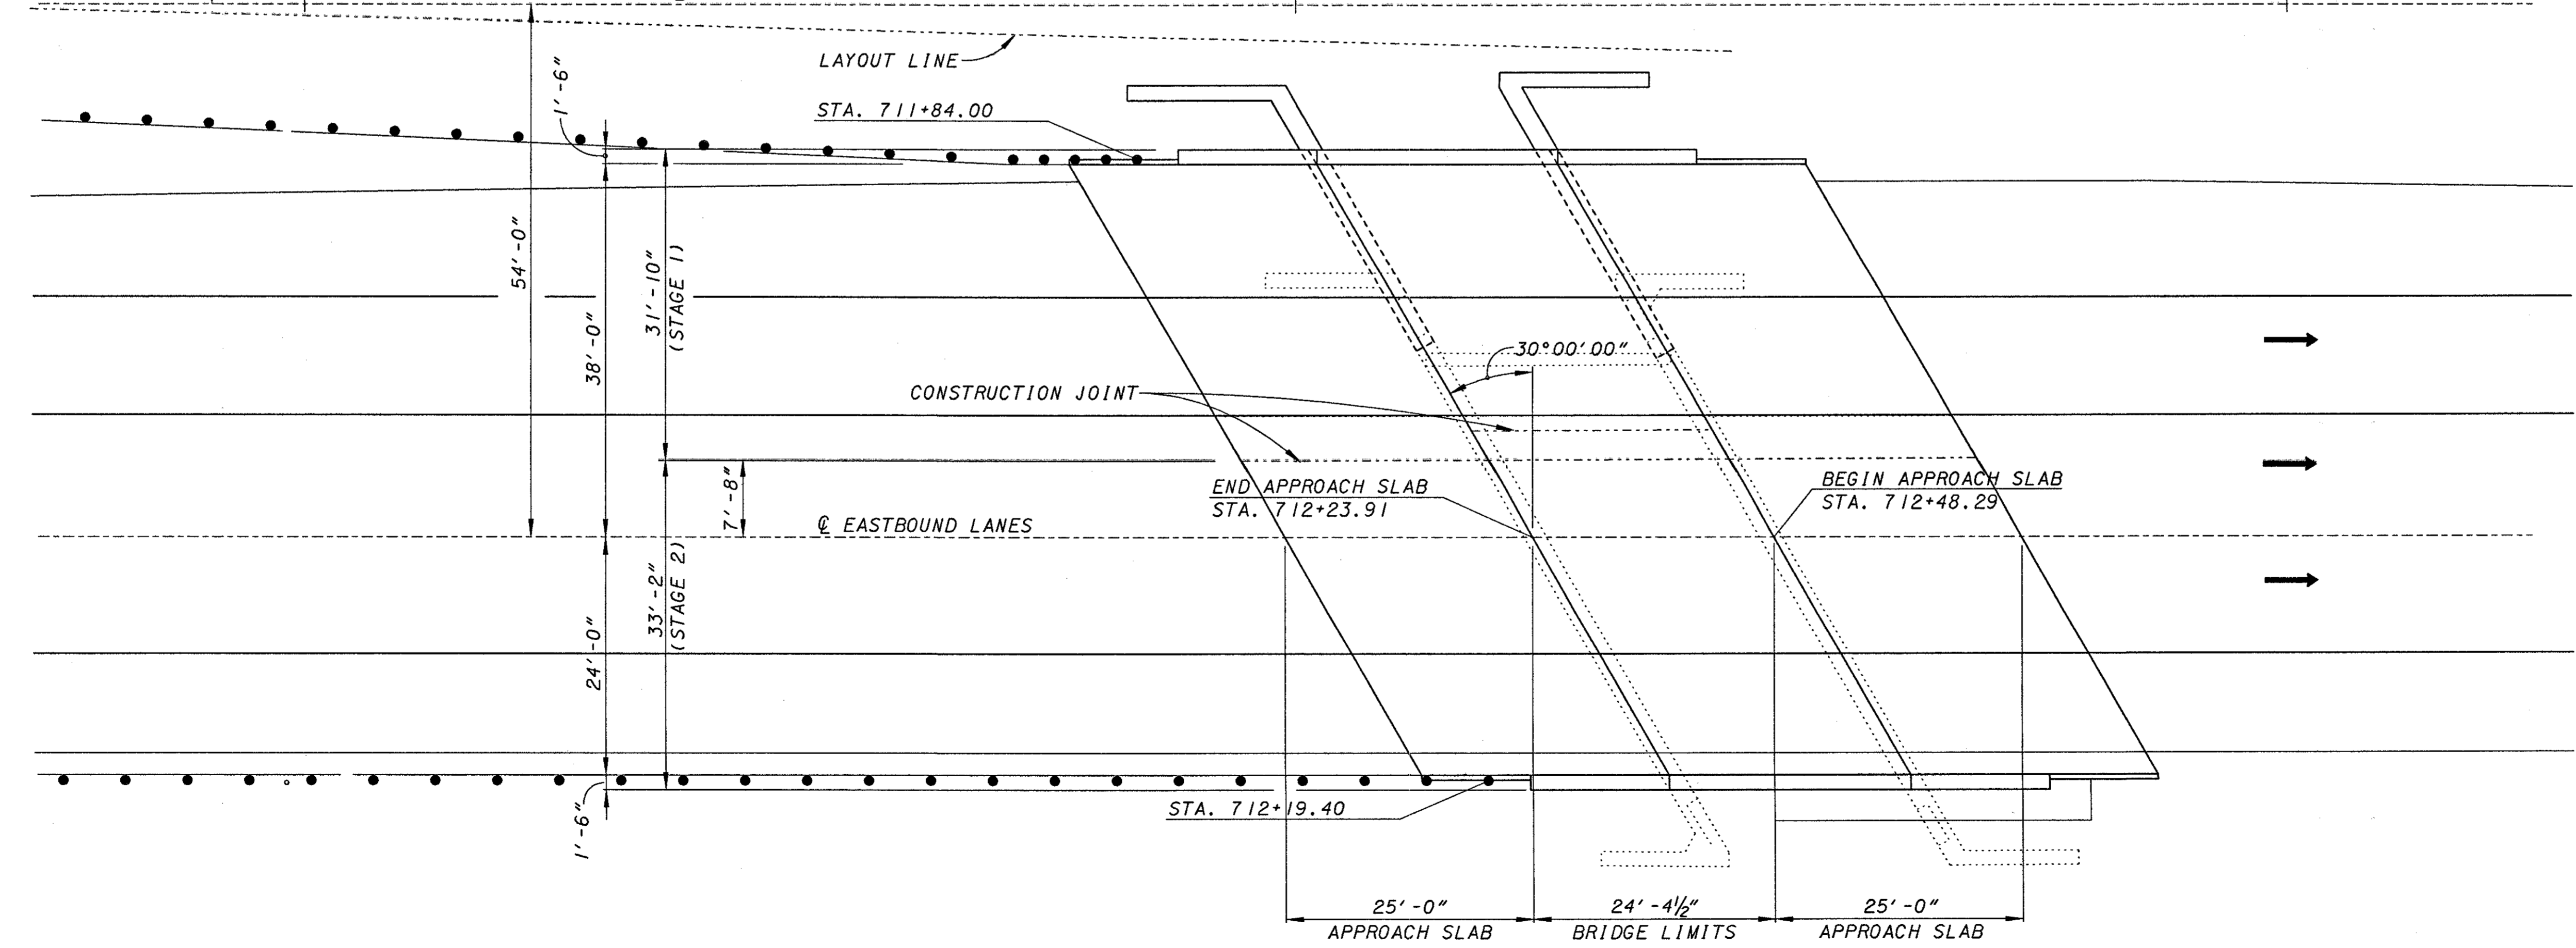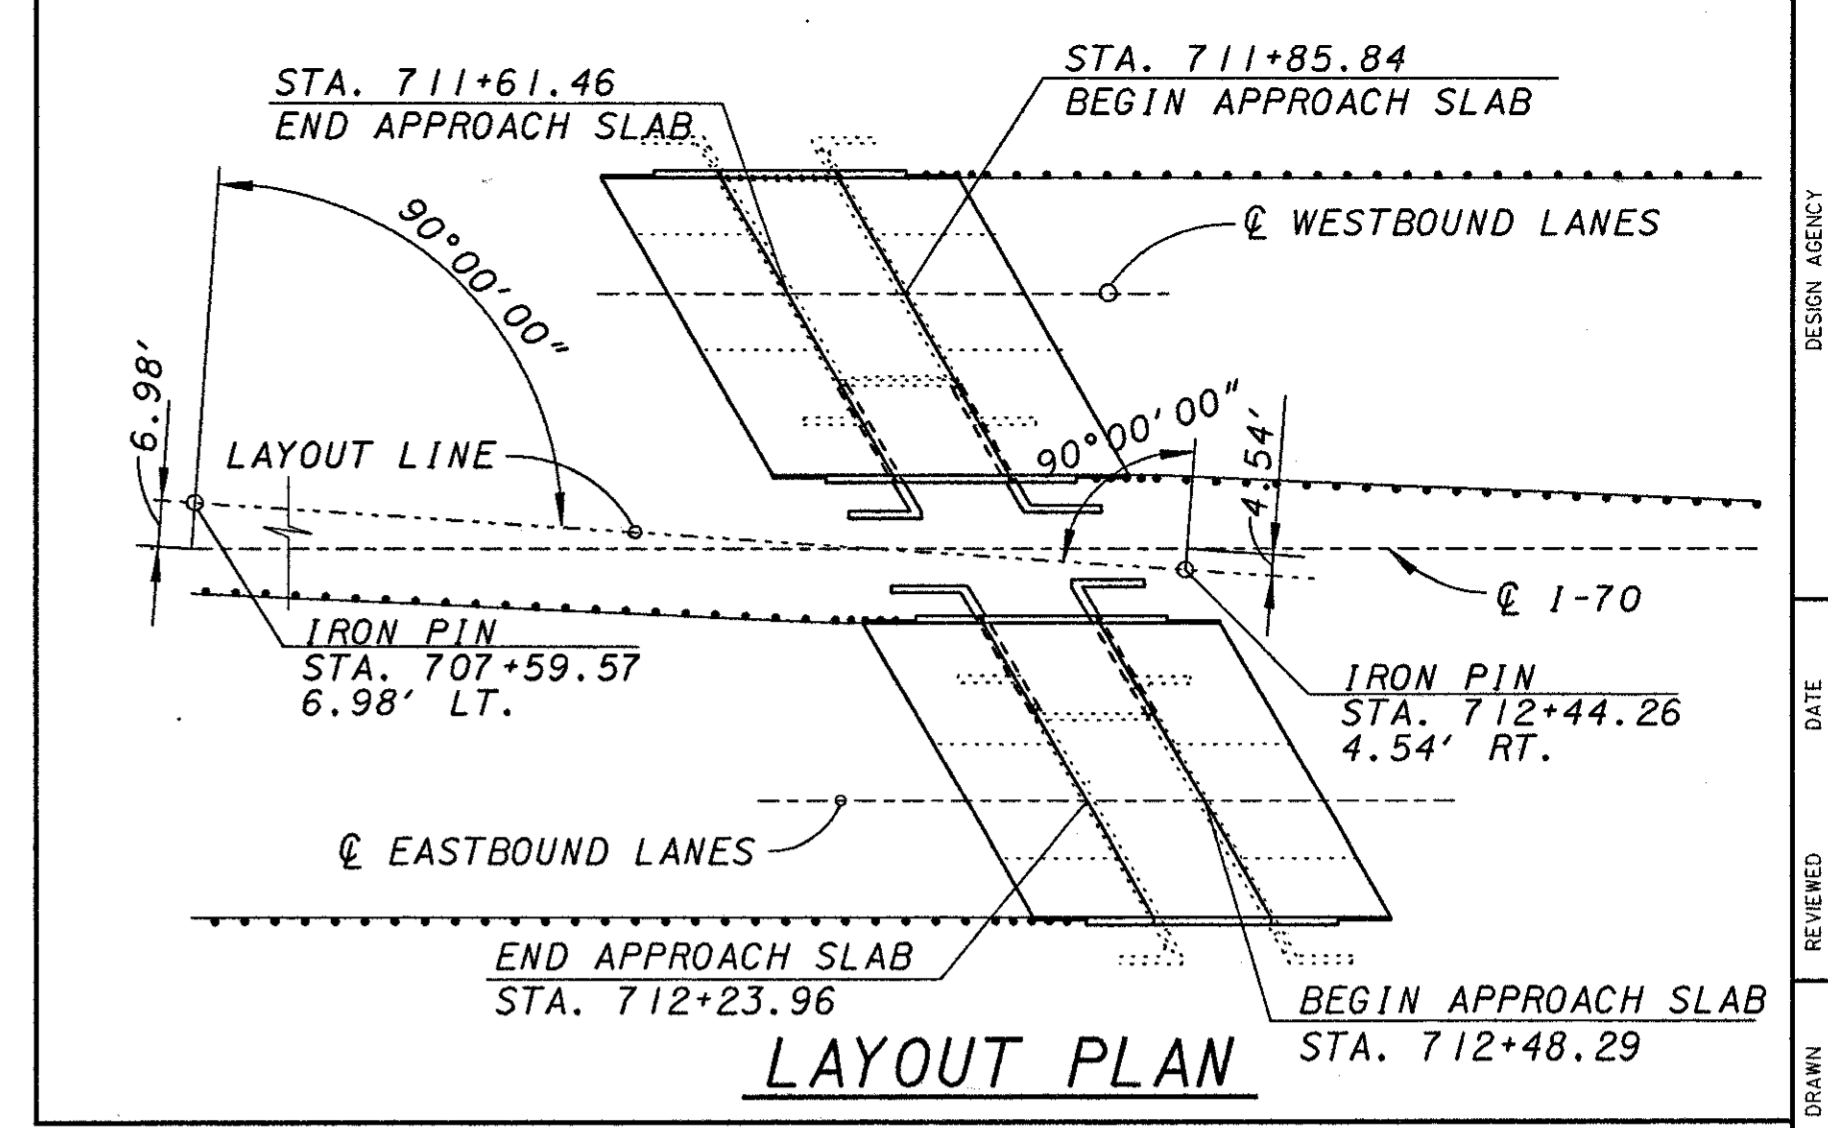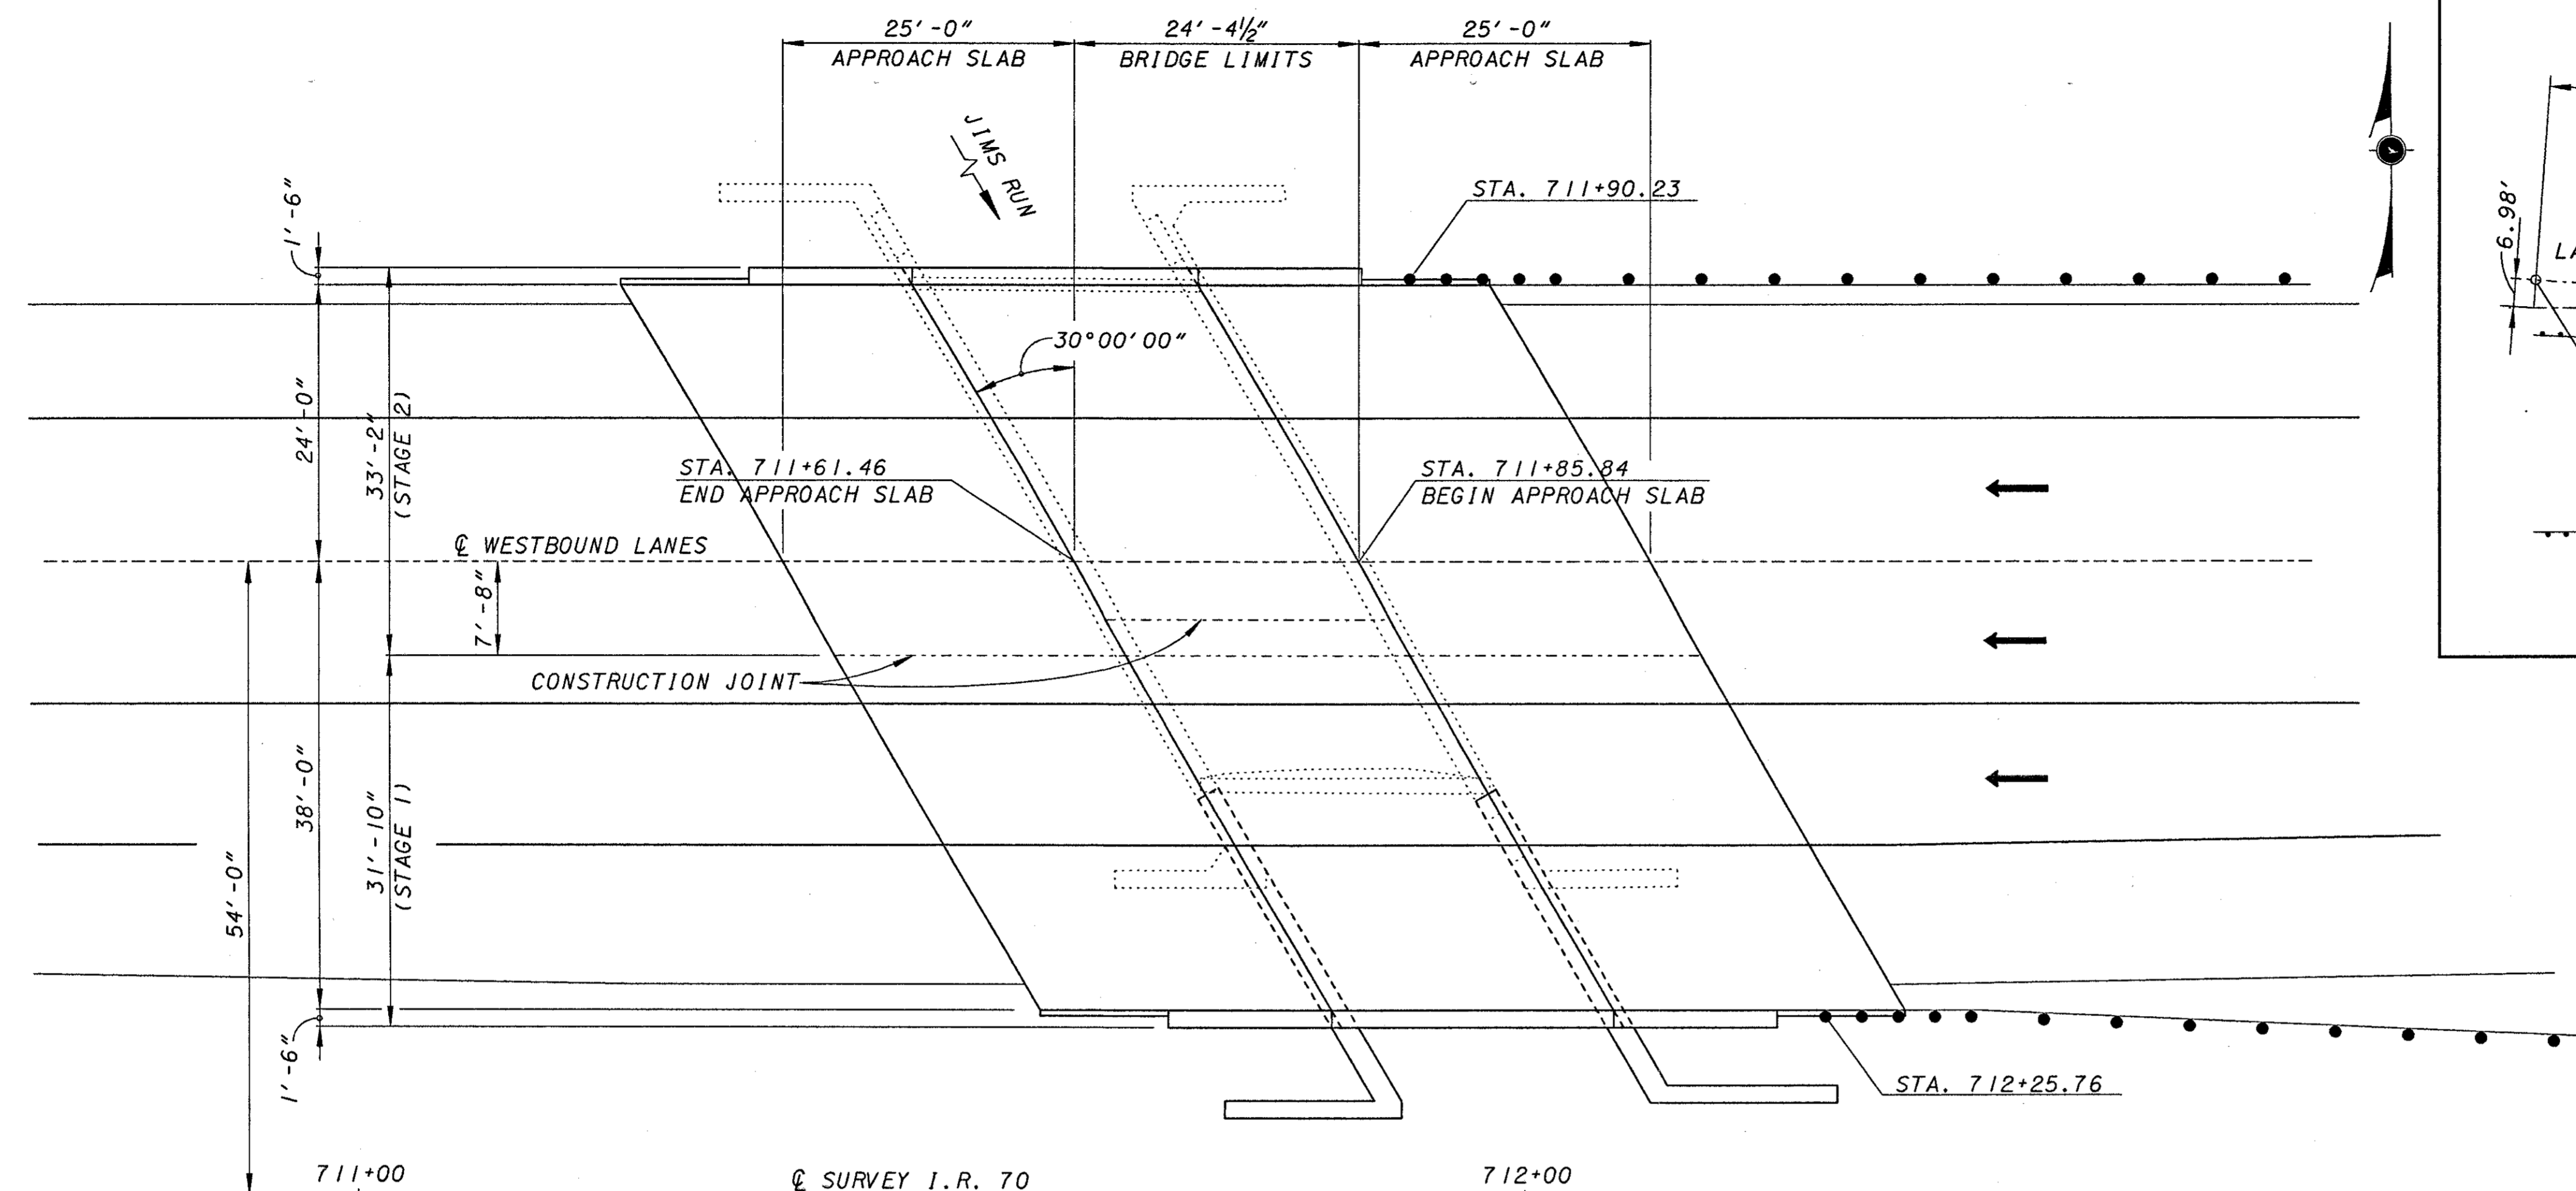

KZF DESIGN
ARCHITECTURE | ENGINEERING | INTERIORS | PLANNING
FOR DESIGN AND CONSTRUCTION OF COMMERCIAL, RESIDENTIAL, AND INDUSTRIAL PROJECTS
TEL: 714.221.1111 FAX: 714.221.1112 WWW.KZFDESIGN.COM

DESIGNED	SJA	CHECKED	WBS
DRAWN	JDG	REVISED	
REVIEWED	DGK	STRUCTURE FILE NUMBER	680/1323/680/1358
DATE	1/29/01		

KZF #14

GENERAL PLAN
BRIDGE NO. PRE-70-1349 L/R
I.R. 70 OVER JIM'S RUN

PRE-70-0.00

2 / 15

214
283

REF: **REF**
REF: **REF**
REF: **REF**
REF: **REF**


REF: **REF**
REF: **REF**
 DENOTES PORTION OF EXISTING STRUCTURE TO BE REMOVED.

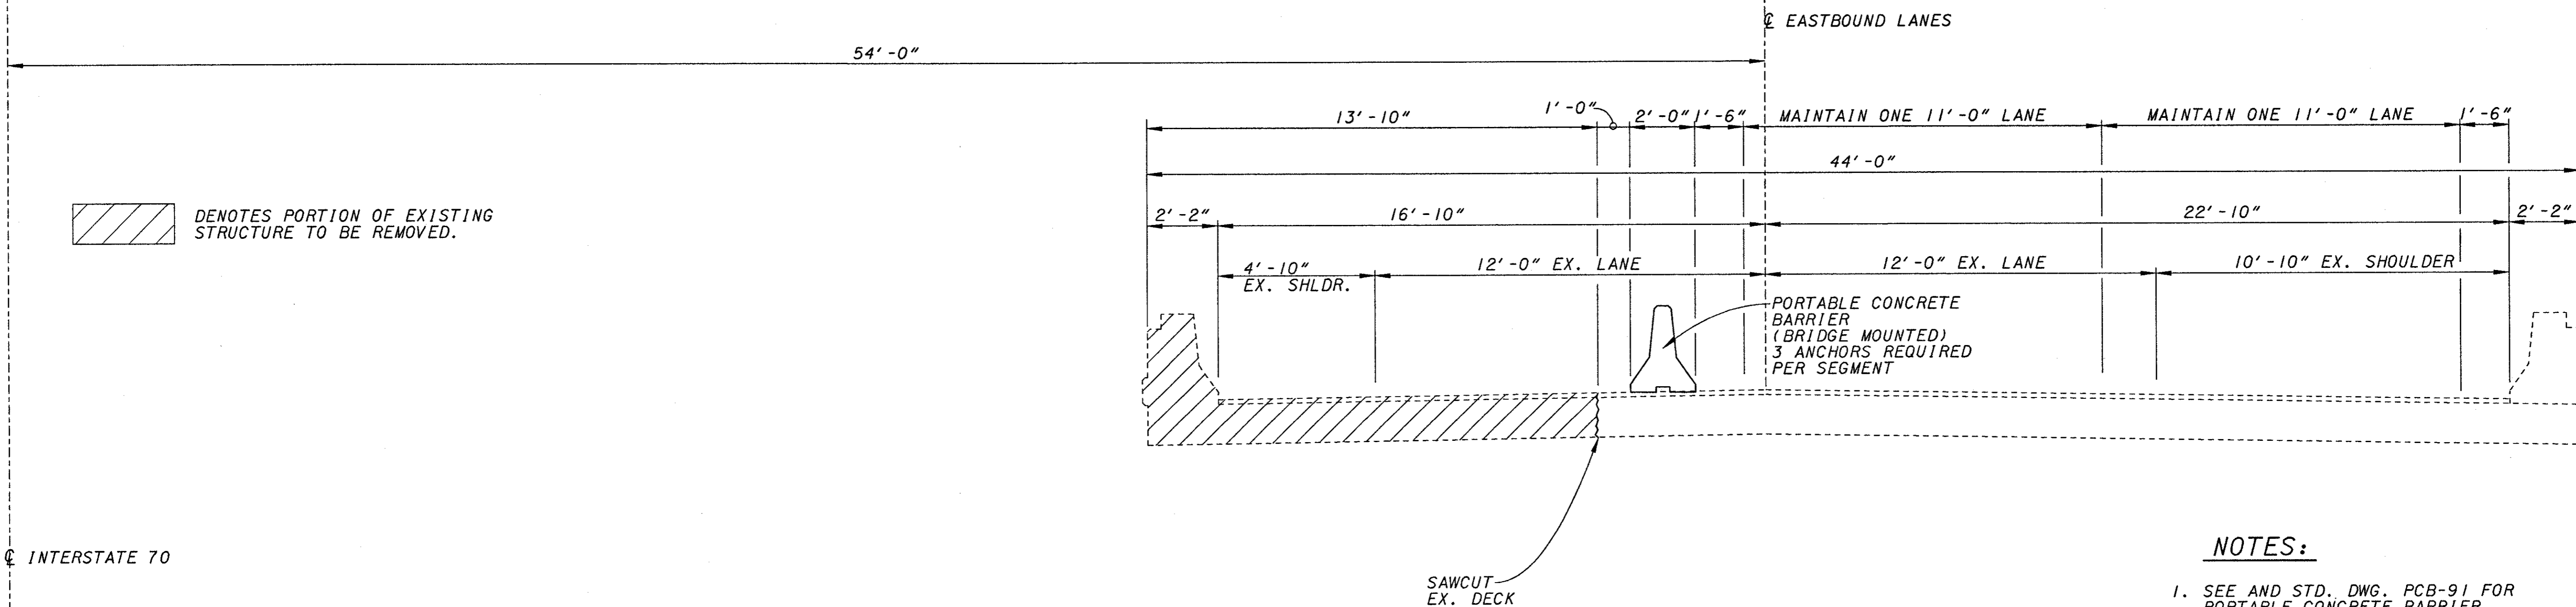

STAGE IA

NOTES:

1. SEE AND STD. DWG. PCB-91 FOR PORTABLE CONCRETE BARRIER DETAILS AND NOTES.
2. EASTBOUND BRIDGE SHOWN WESTBOUND BRIDGE SIMILAR.

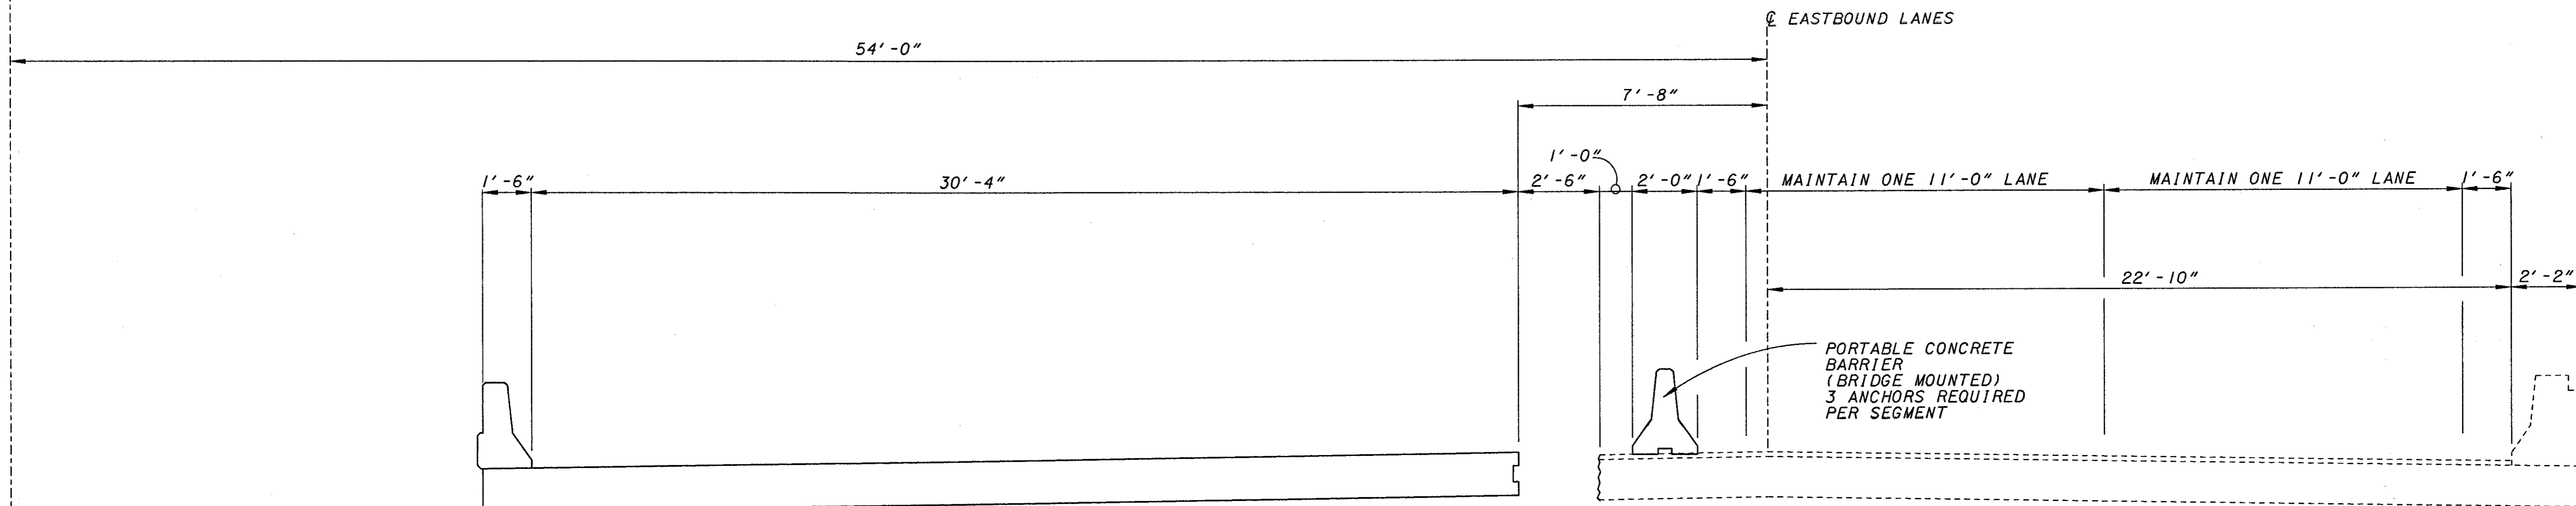


STAGE IB

DESIGNED	SJA	CHECKED	WBS
DRAWN	SJA	REVISED	
REVIEWED	DGK	STRUCTURE FILE NUMBER	680/323/680/358
DATE	1/29/01		


KZF #14

RIGHT BRIDGE STAGE I CONSTRUCTION
BRIDGE NO. PRE-70-1349 L/R
I.R. TO OVER JIM'S RUN

PRE-70-0.00

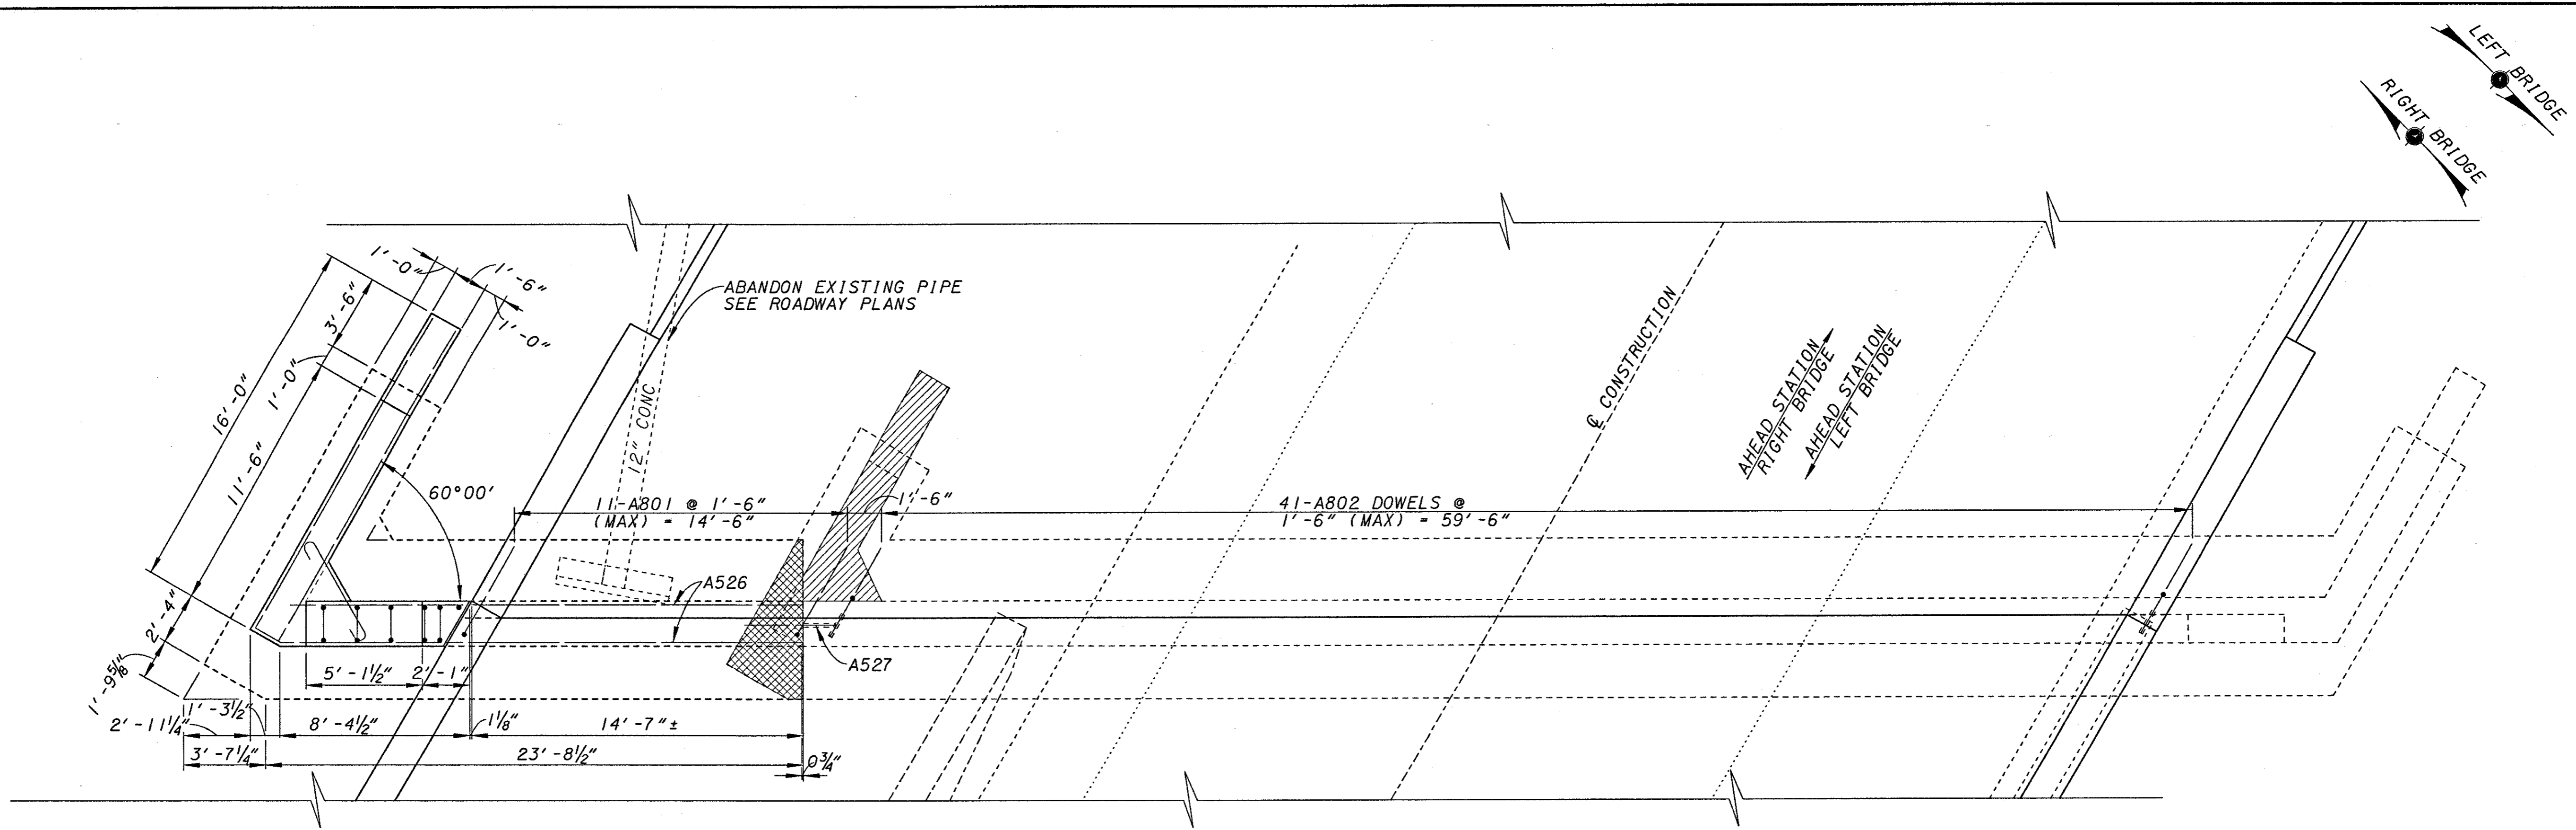

PLAN

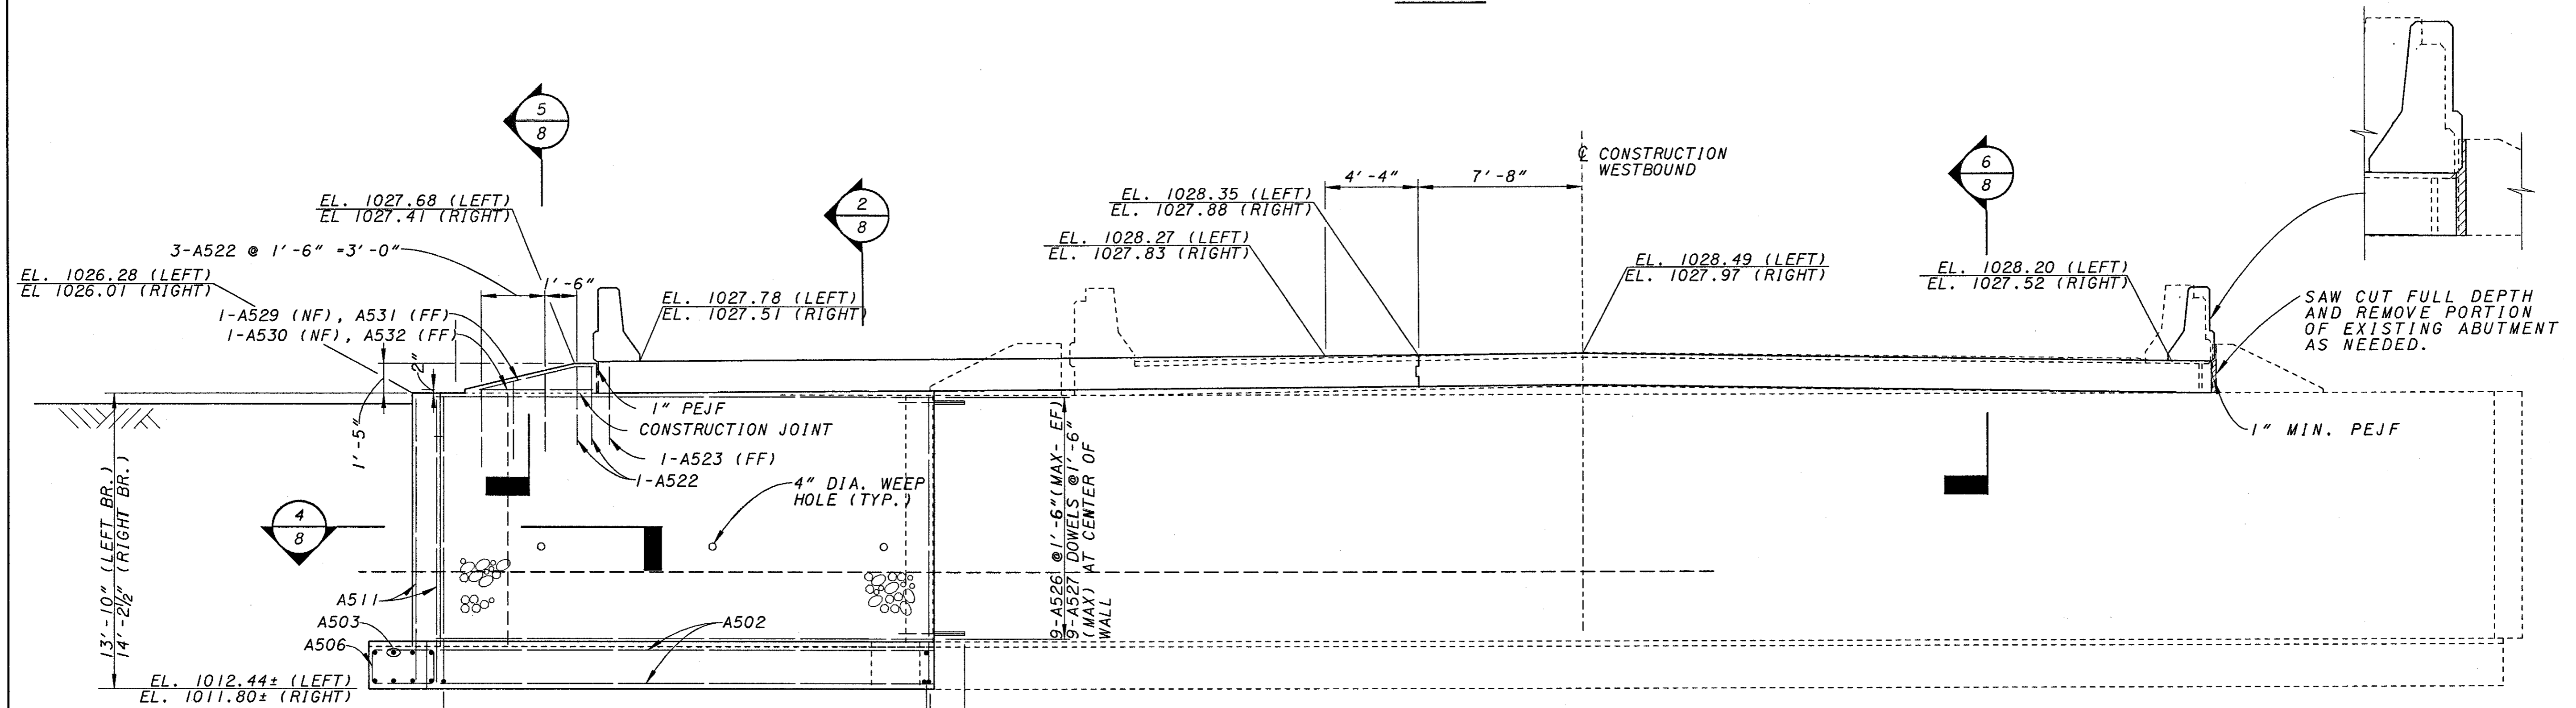



ELEVATION

REAR ABUTMENT LEFT BRIDGE,
 FORWARD ABUTMENT RIGHT BRIDGE

LEGEND

- F.F. = FAR FACE
- N.F. = NEAR FACE
- E.F. = EACH FACE
- R.B. = RIGHT BRIDGE
- L.B. = LEFT BRIDGE
- PEJF = PREFORMED EXPANSION JOINT FILLER

LEGEND

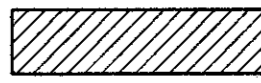-  DENOTES REMOVAL OF EXISTING STRUCTURE TO 1'-0" BELOW BOTTOM SURFACE OF PROPOSED APPROACH SLAB.
-  DENOTES REMOVAL OF EXISTING STRUCTURE.

REF: AREF1
REF: AREF2
REF: AREF3
REF: AREF4
REF: AREF5

REF: AREF1
REF: AREF2
REF: AREF3
REF: AREF4
REF: AREF5


REF: **REF1**
 REF: **REF2**
 REF: **REF3**
 REF: **REF4**
 REF: **REF5**
 REF: **REF6**

REF: **REF7**
 REF: **REF8**
 REF: **REF9**
 REF: **REF10**
 REF: **REF11**
 REF: **REF12**


REF: **REF13**
 REF: **REF14**
 REF: **REF15**
 REF: **REF16**
 REF: **REF17**
 REF: **REF18**

REF: **REF19**
 REF: **REF20**
 REF: **REF21**
 REF: **REF22**
 REF: **REF23**
 REF: **REF24**

 DESIGNATION *****
 DEST FILE: D:\ASSETS\DRAWINGS*****
 ACTIVE LEVELS ONLY *****

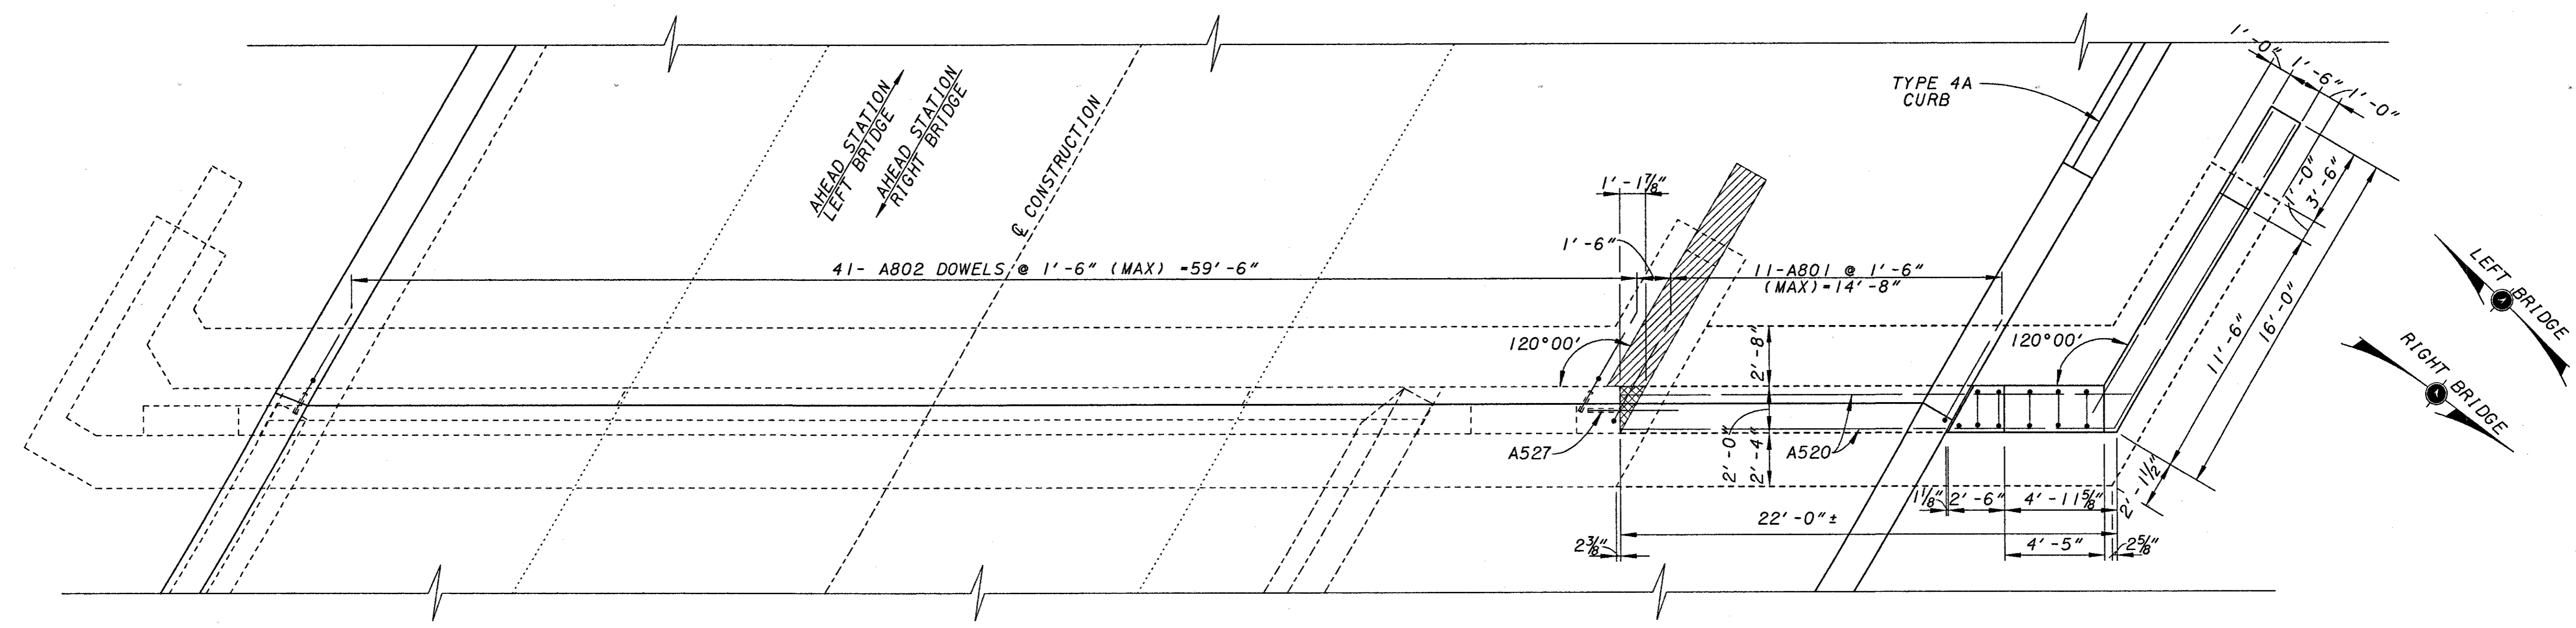








PLAN

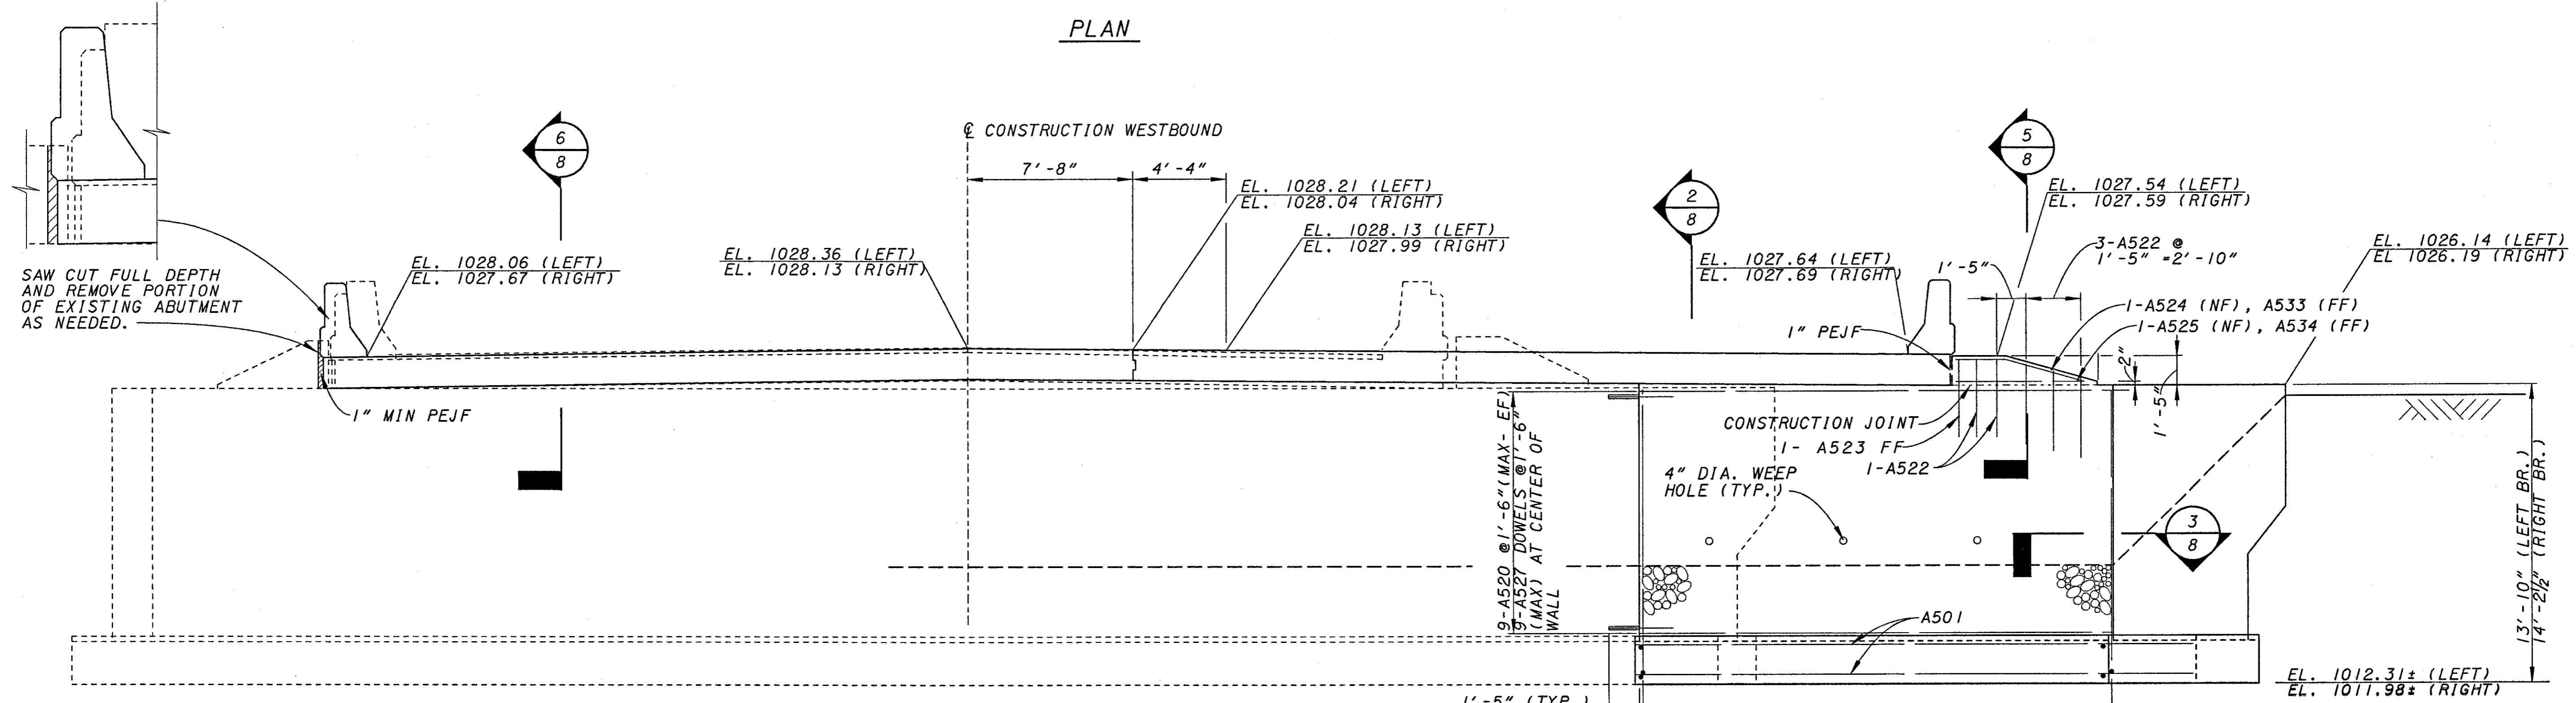

ELEVATION
 FORWARD ABUTMENT LEFT BRIDGE,
 REAR ABUTMENT RIGHT BRIDGE

LEGEND
 F.F. = FAR FACE
 N.F. = NEAR FACE
 E.F. = EACH FACE
 R.B. = RIGHT BRIDGE
 L.B. = LEFT BRIDGE
 PEJF = PREFORMED EXPANSION JOINT FILLER

LEGEND
 [Hatched Box] DENOTES REMOVAL OF EXISTING STRUCTURE TO 1'-0" BELOW BOTTOM SURFACE OF PROPOSED APPROACH SLAB.
 [Cross-hatched Box] DENOTES REMOVAL OF EXISTING STRUCTURE.

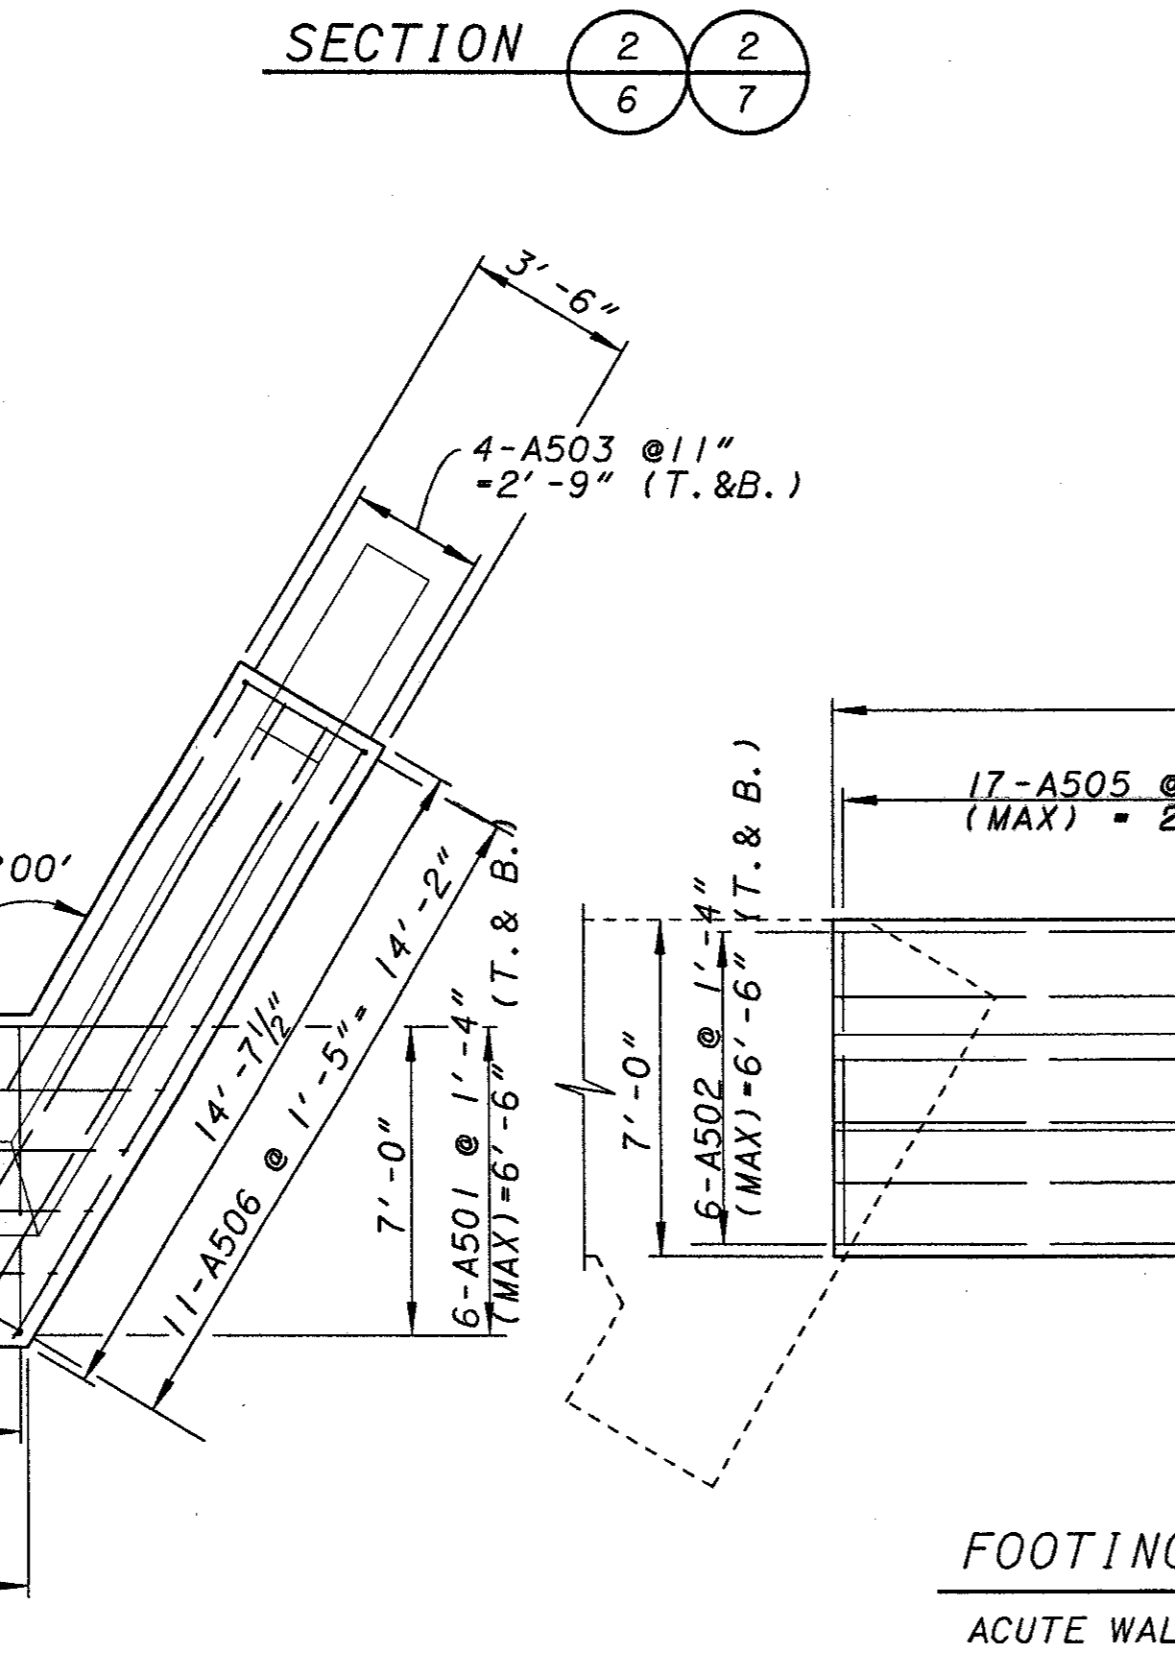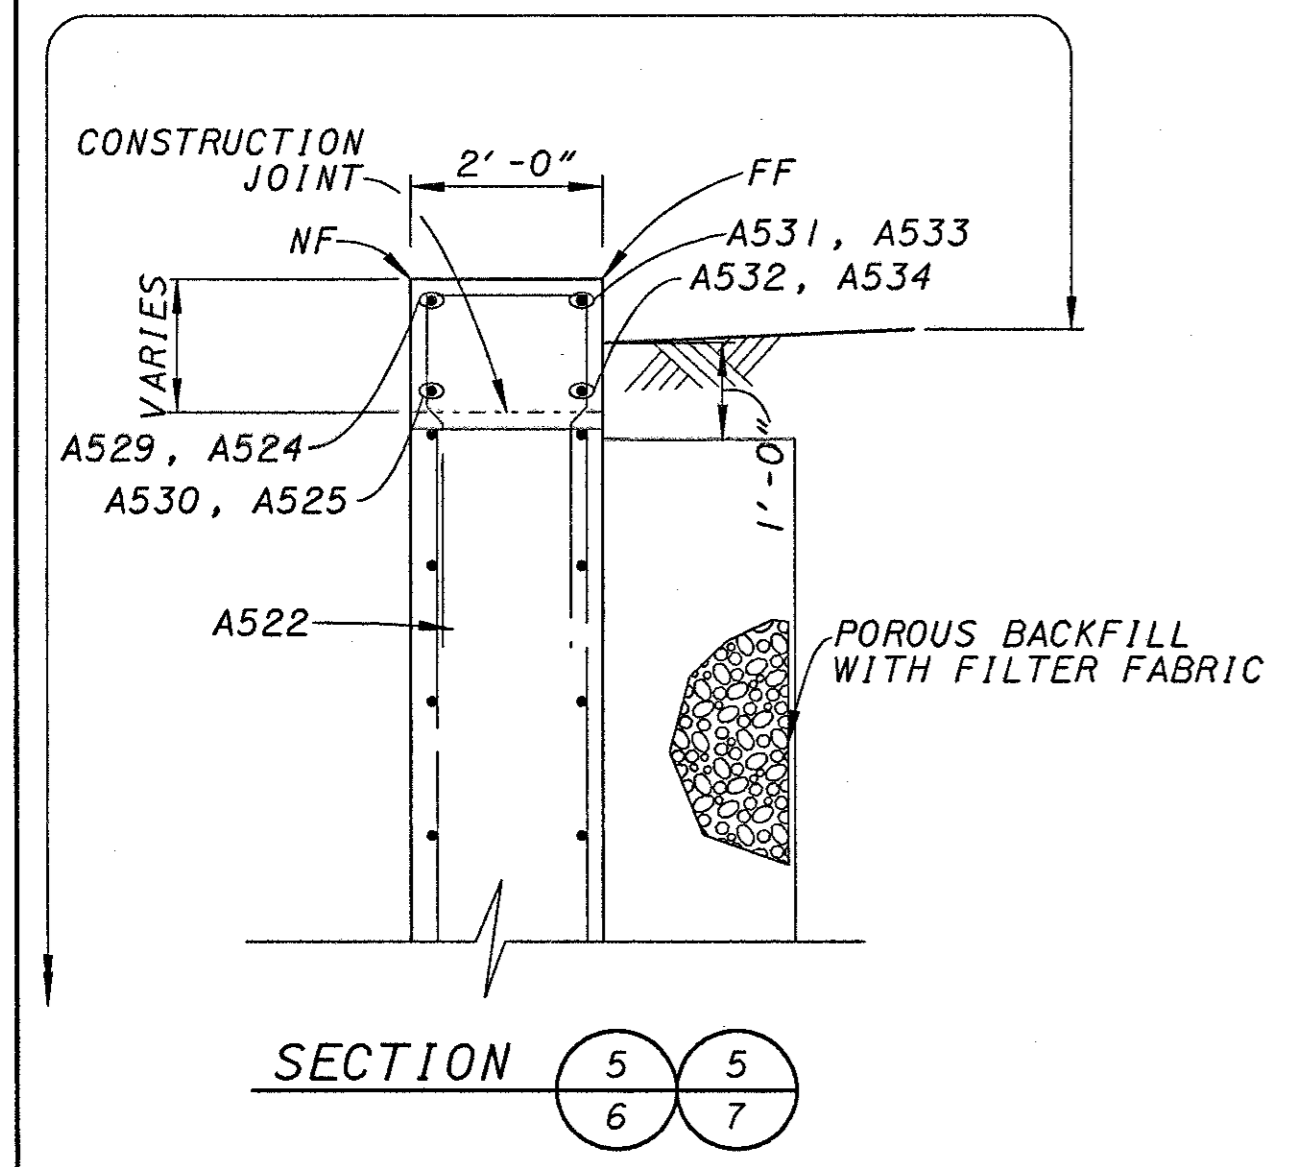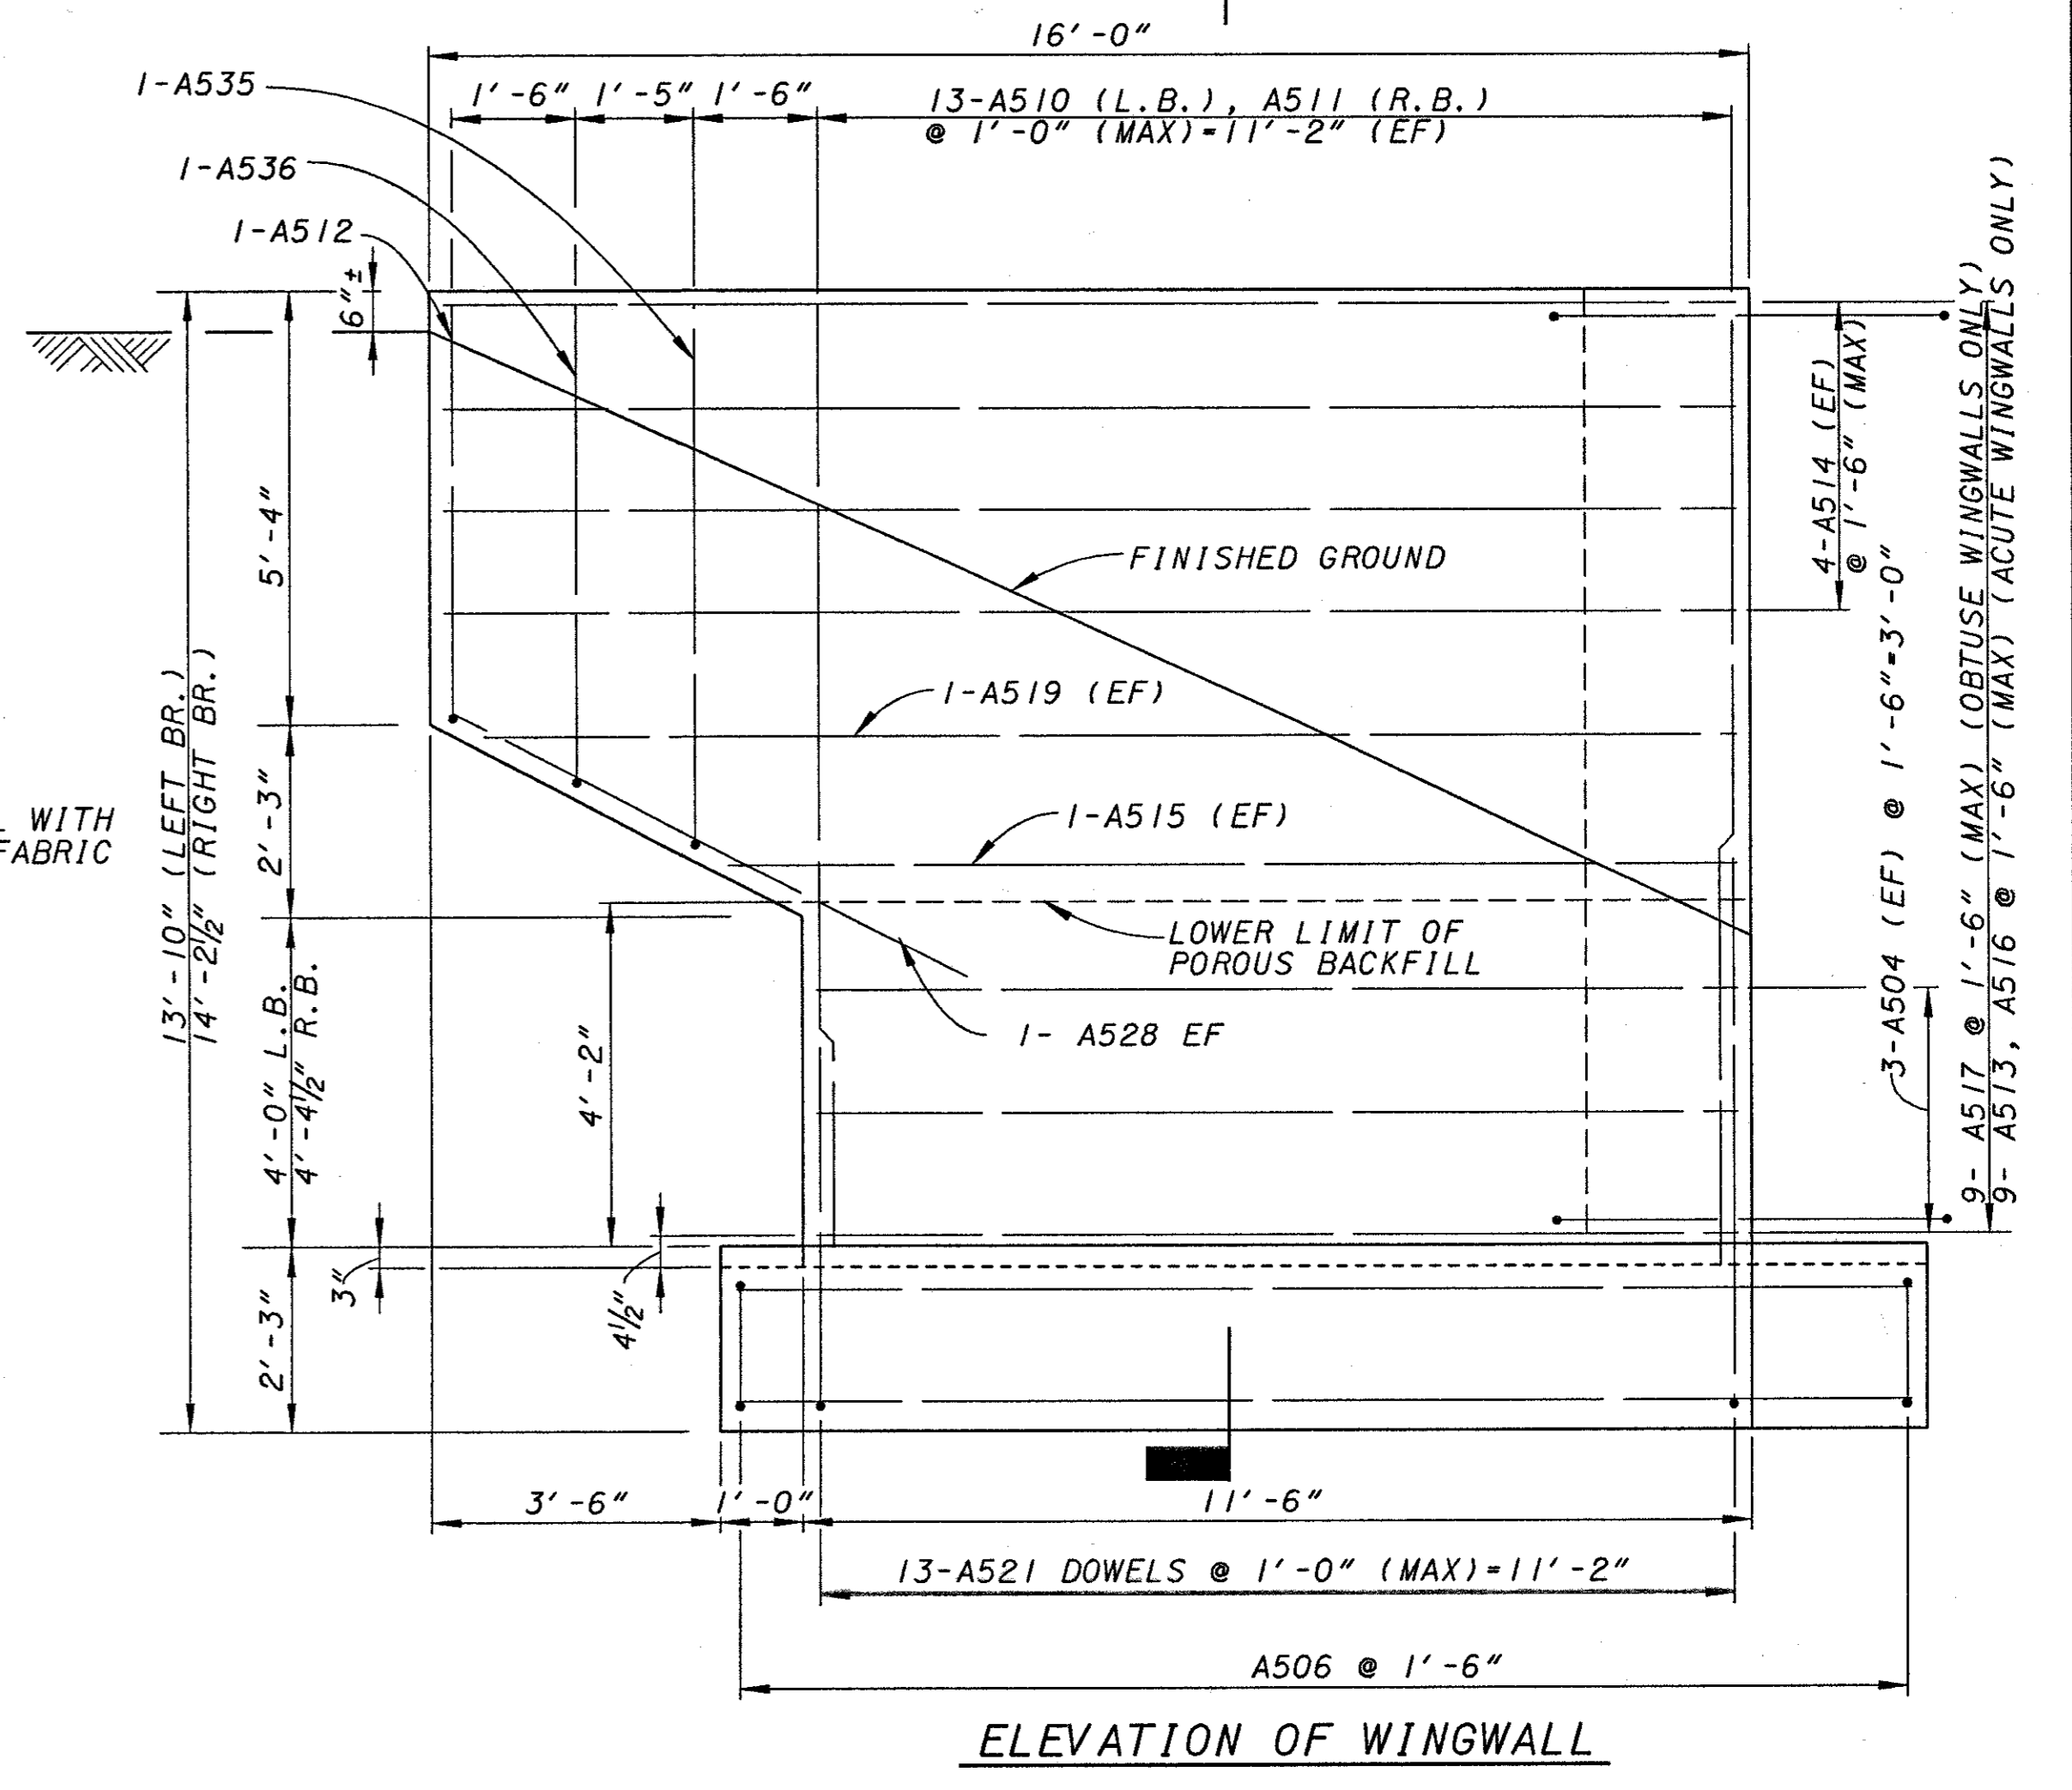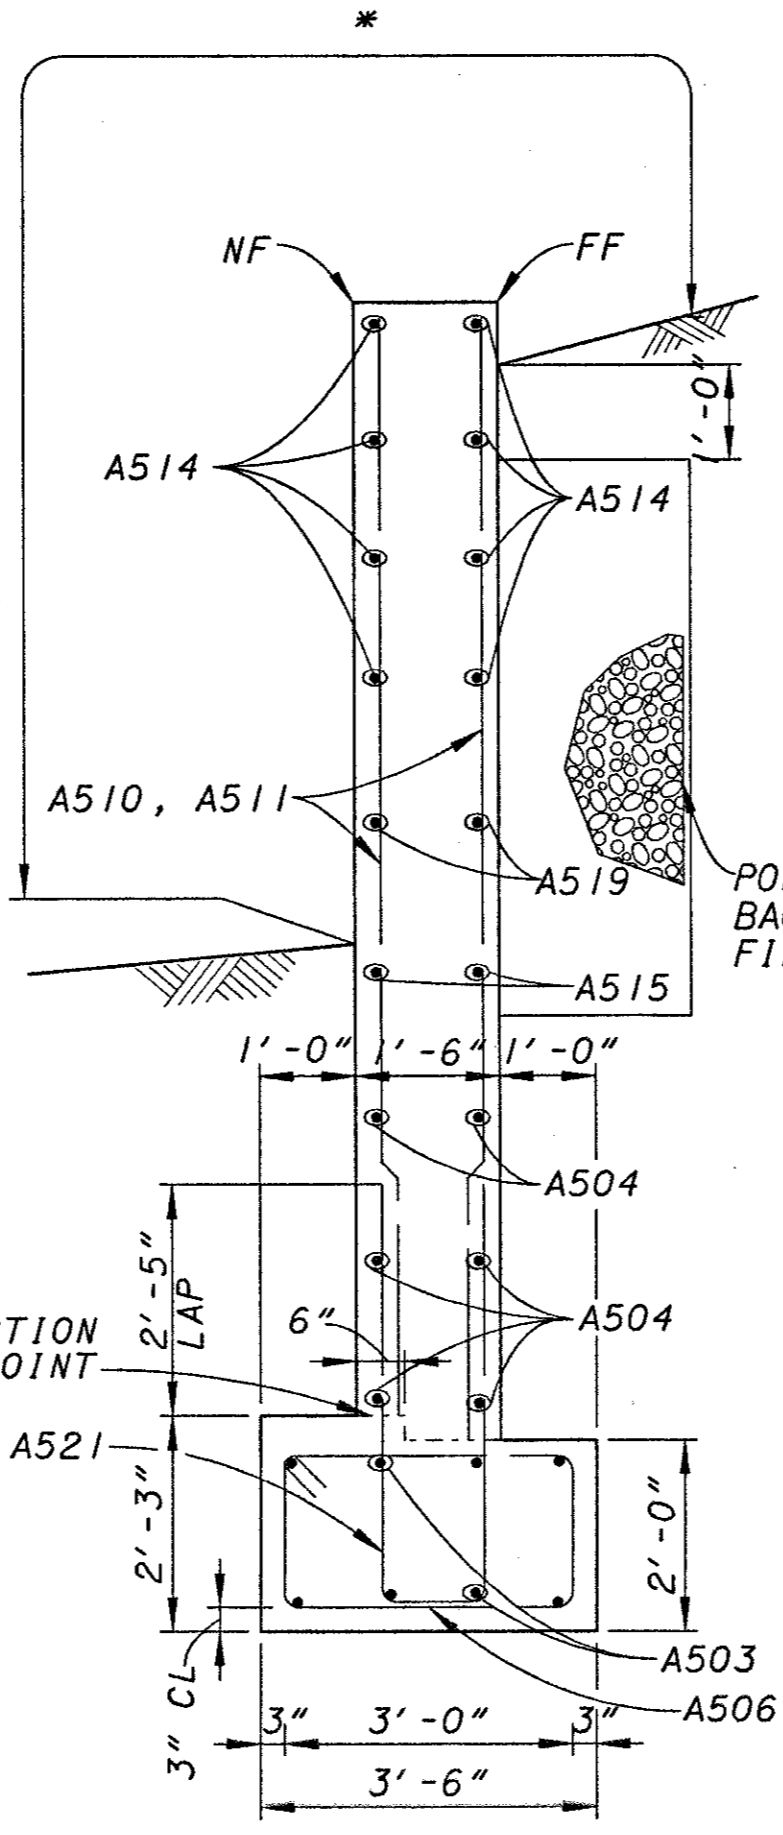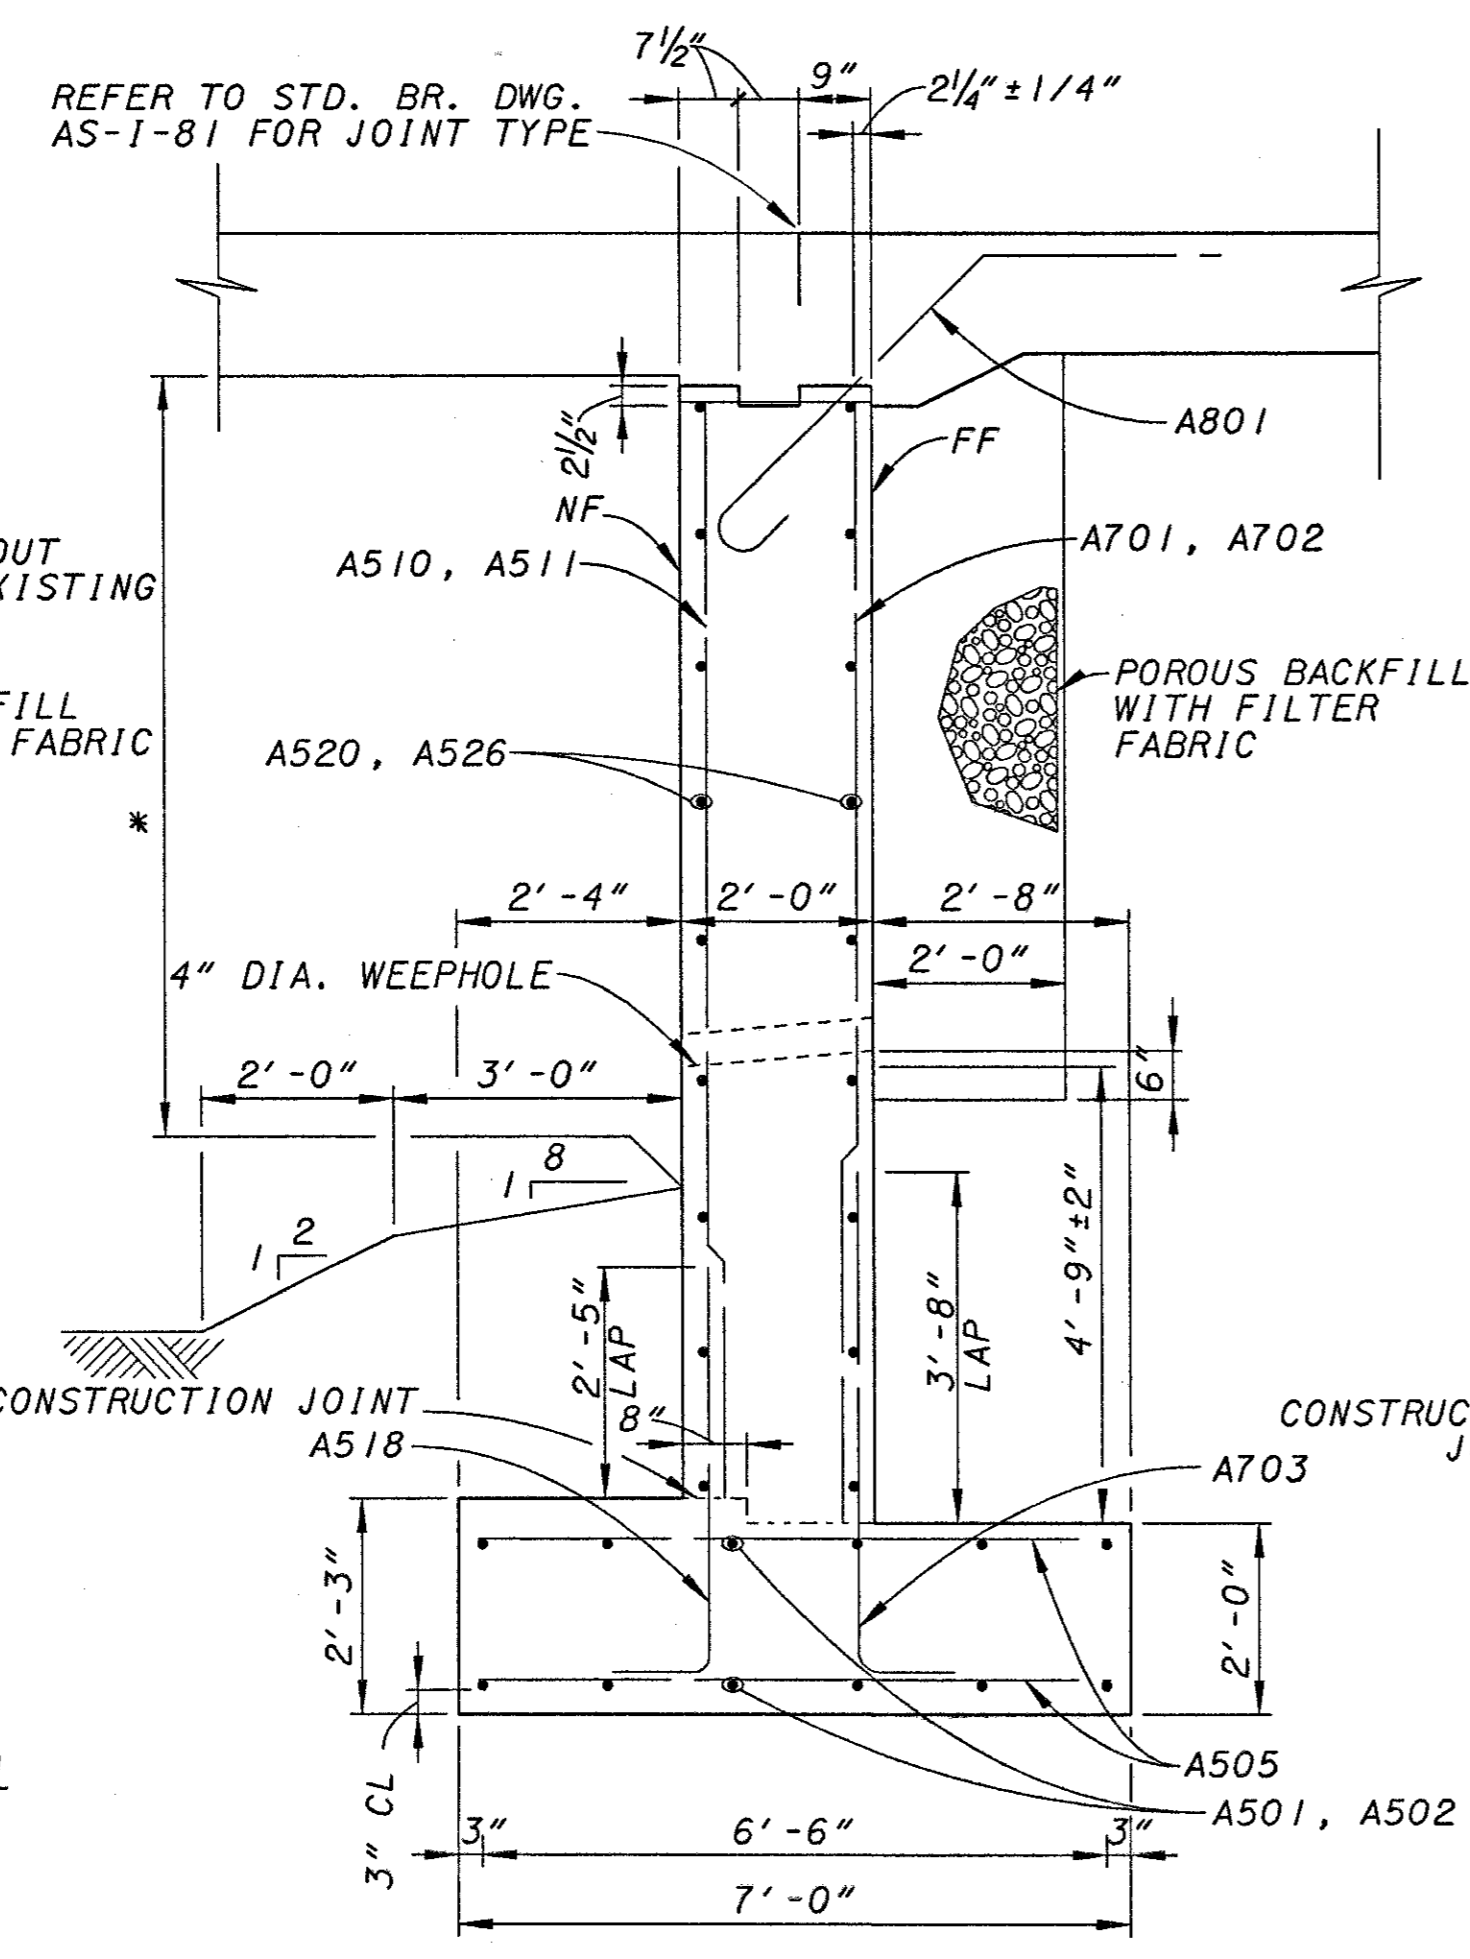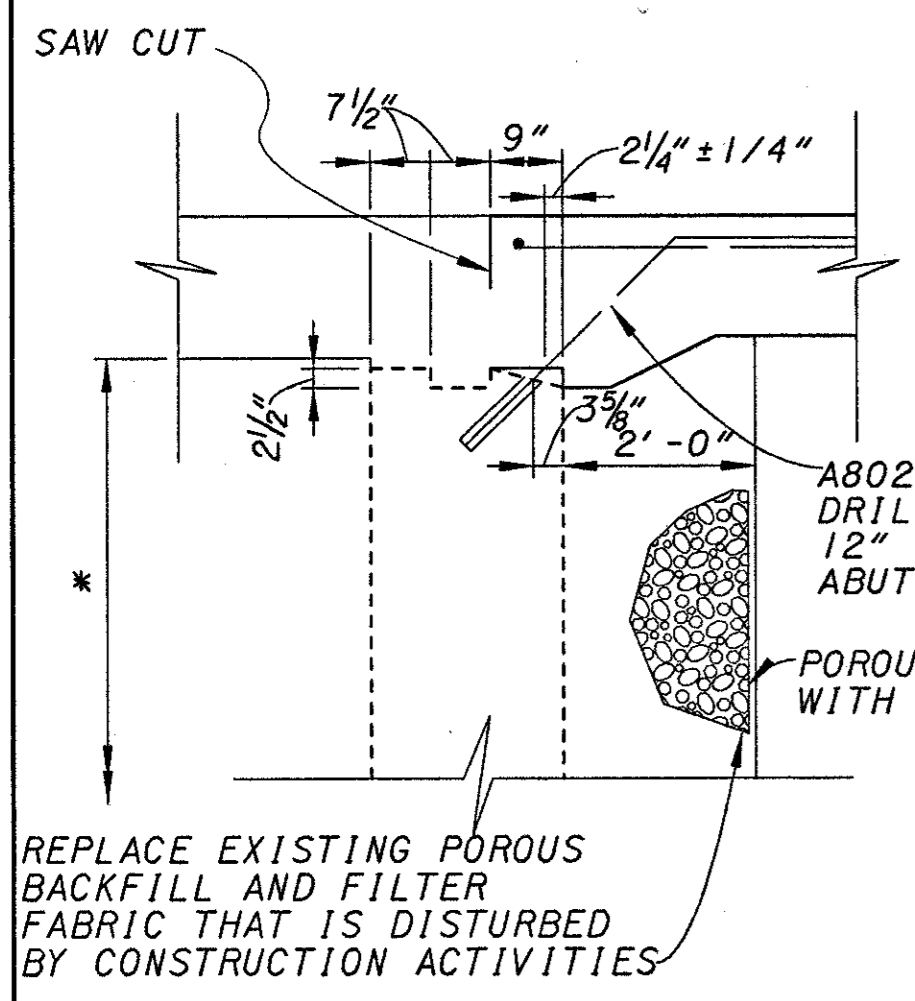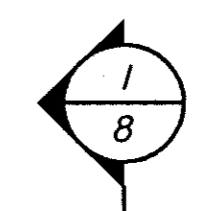

* SEAL ENTIRE SURFACE AREA WITH EPOXY URETHANE


NOTE:

1. POROUS BACKFILL WITH FILTER FABRIC, 2'-0" THICK SHALL EXTEND UP TO THE PLANE OF THE SUBGRADE, TO 1'-0" BELOW THE EMBANKMENT SURFACE AND LATERALLY TO THE ENDS OF THE WINGWALLS. GEOTEXTILE FABRIC SHALL CONFORM WITH 712.09, TYPE A. TURN GEOTEXTILE FABRIC UP 6" ALONG BACK OF WALL.


ALL STEEL CLEARANCES ARE 2" UNLESS OTHERWISE NOTED, EXCEPT IN FOOTINGS WHERE CONCRETE CONTACTS SOIL THE STEEL CLEARANCES ARE 3".

LEGEND

T. & B. = TOP AND BOTTOM
BOT. = BOTTOM
EF = EACH FACE
NF = NEAR FACE
FF = FAR FACE
L.B. = LEFT BRIDGE
R.B. = RIGHT BRIDGE
BR. = BRIDGE

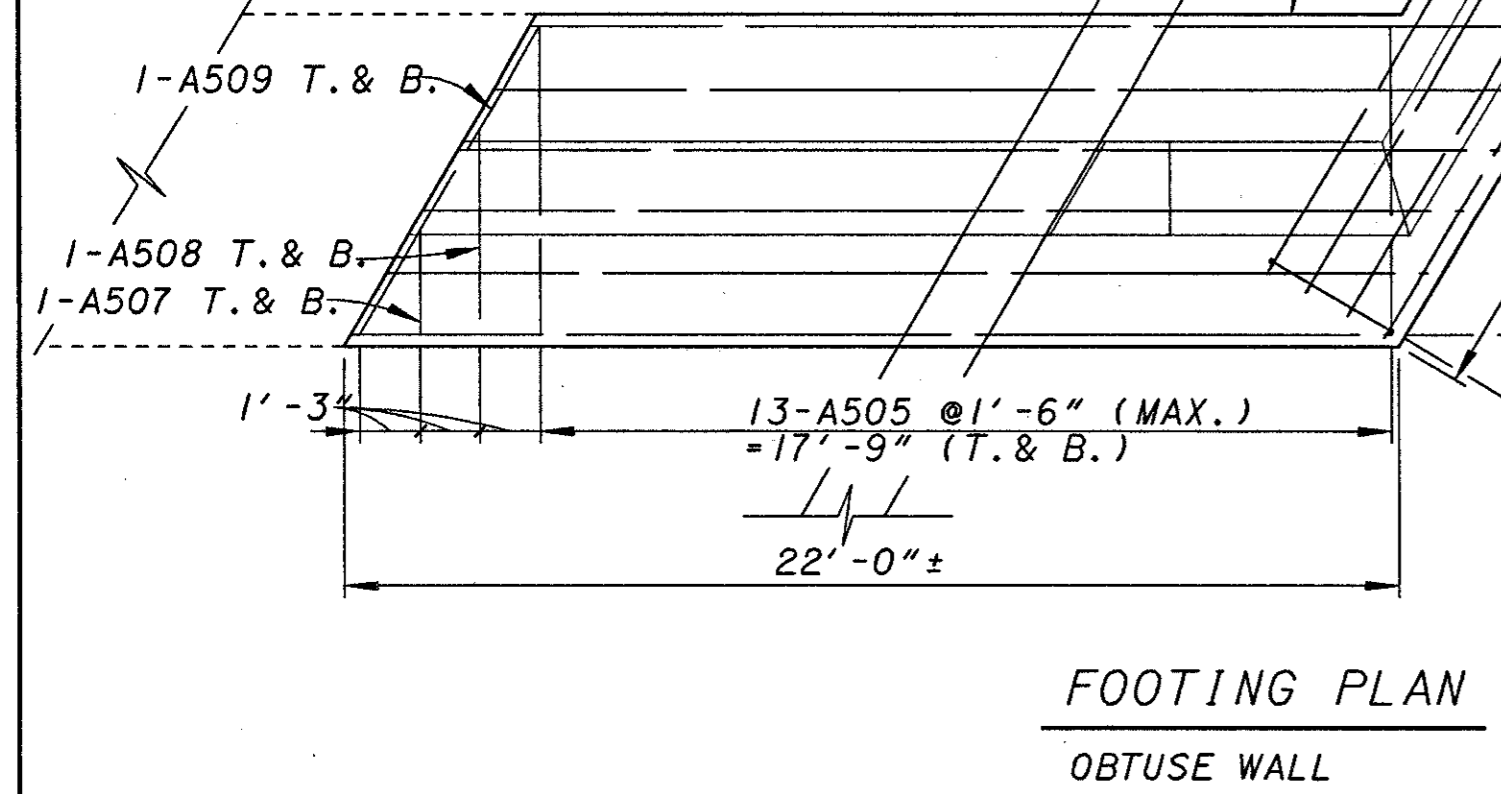

FOOTING PLAN
ACUTE WALL

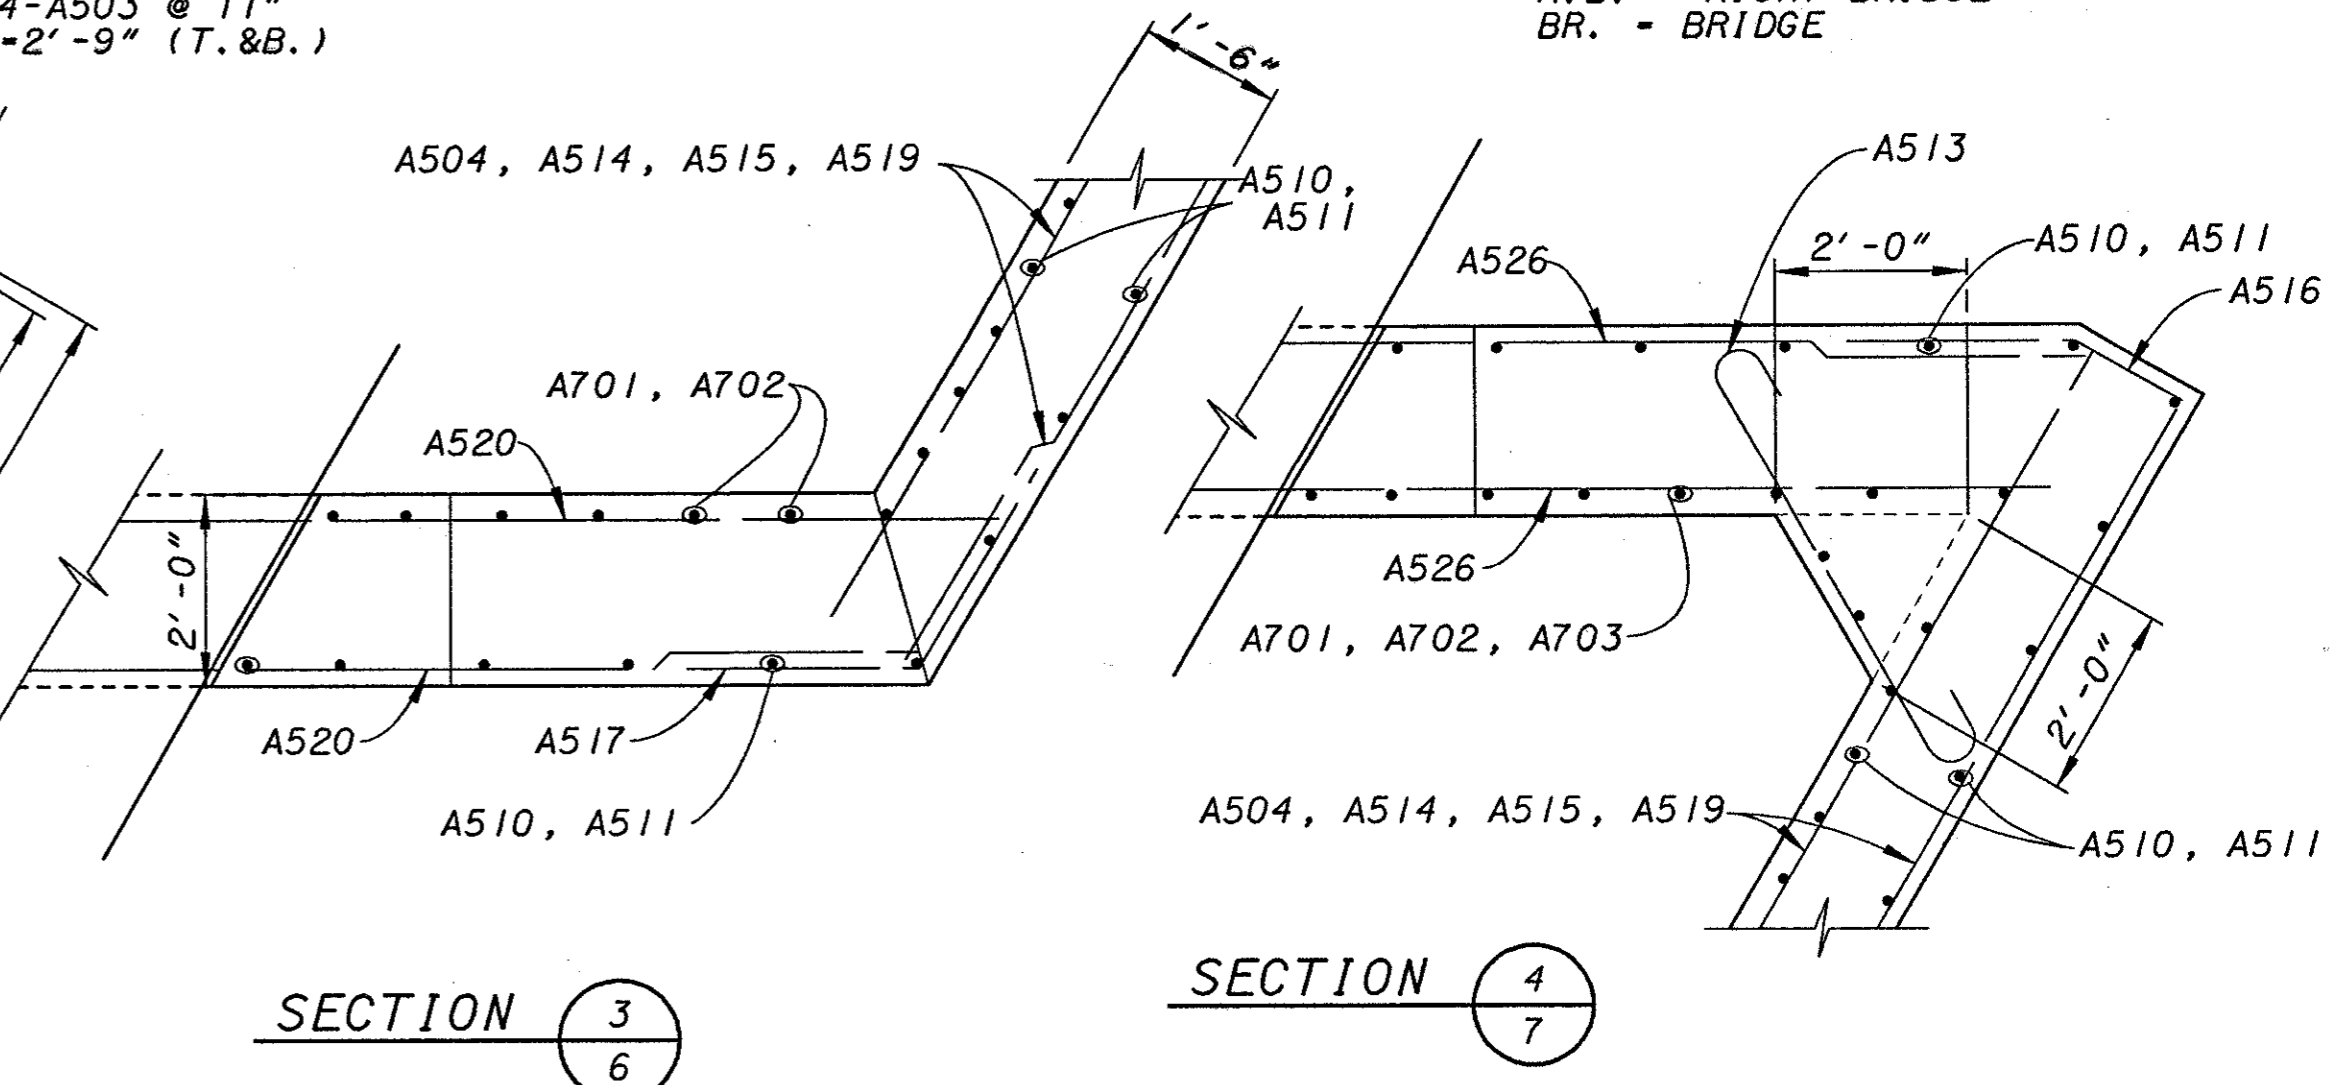

DESIGN AGENCY
KZF DESIGN
ARCHITECTURE | ENGINEERING | INTERIORS | PLUMBING
FOR DESIGN INC. 400 New Drive, Channahon, IL 60440-9000
TEL: 815.301.1001 FAX: 815.301.1001 WWW.KZFDESIGN.COM

DESIGNED	SJA	CHECKED	WBS
DRAWN	JDG	REVIEWED	
DATE	1/29/01	STRUCTURE FILE NUMBER	6801323/6801358
REVISED	DGK	REVISED	

ABUTMENT AND WINGWALL DETAILS
BRIDGE NO. PRE-70-1349 L/R
I.R. TO OVER JIM'S RUN

DESIGNED
KZF
#14

PRE-70-0.00

8 / 15

220
283

712+00

LAYOUT LINE


REF: **REF:***
REF: **REF:***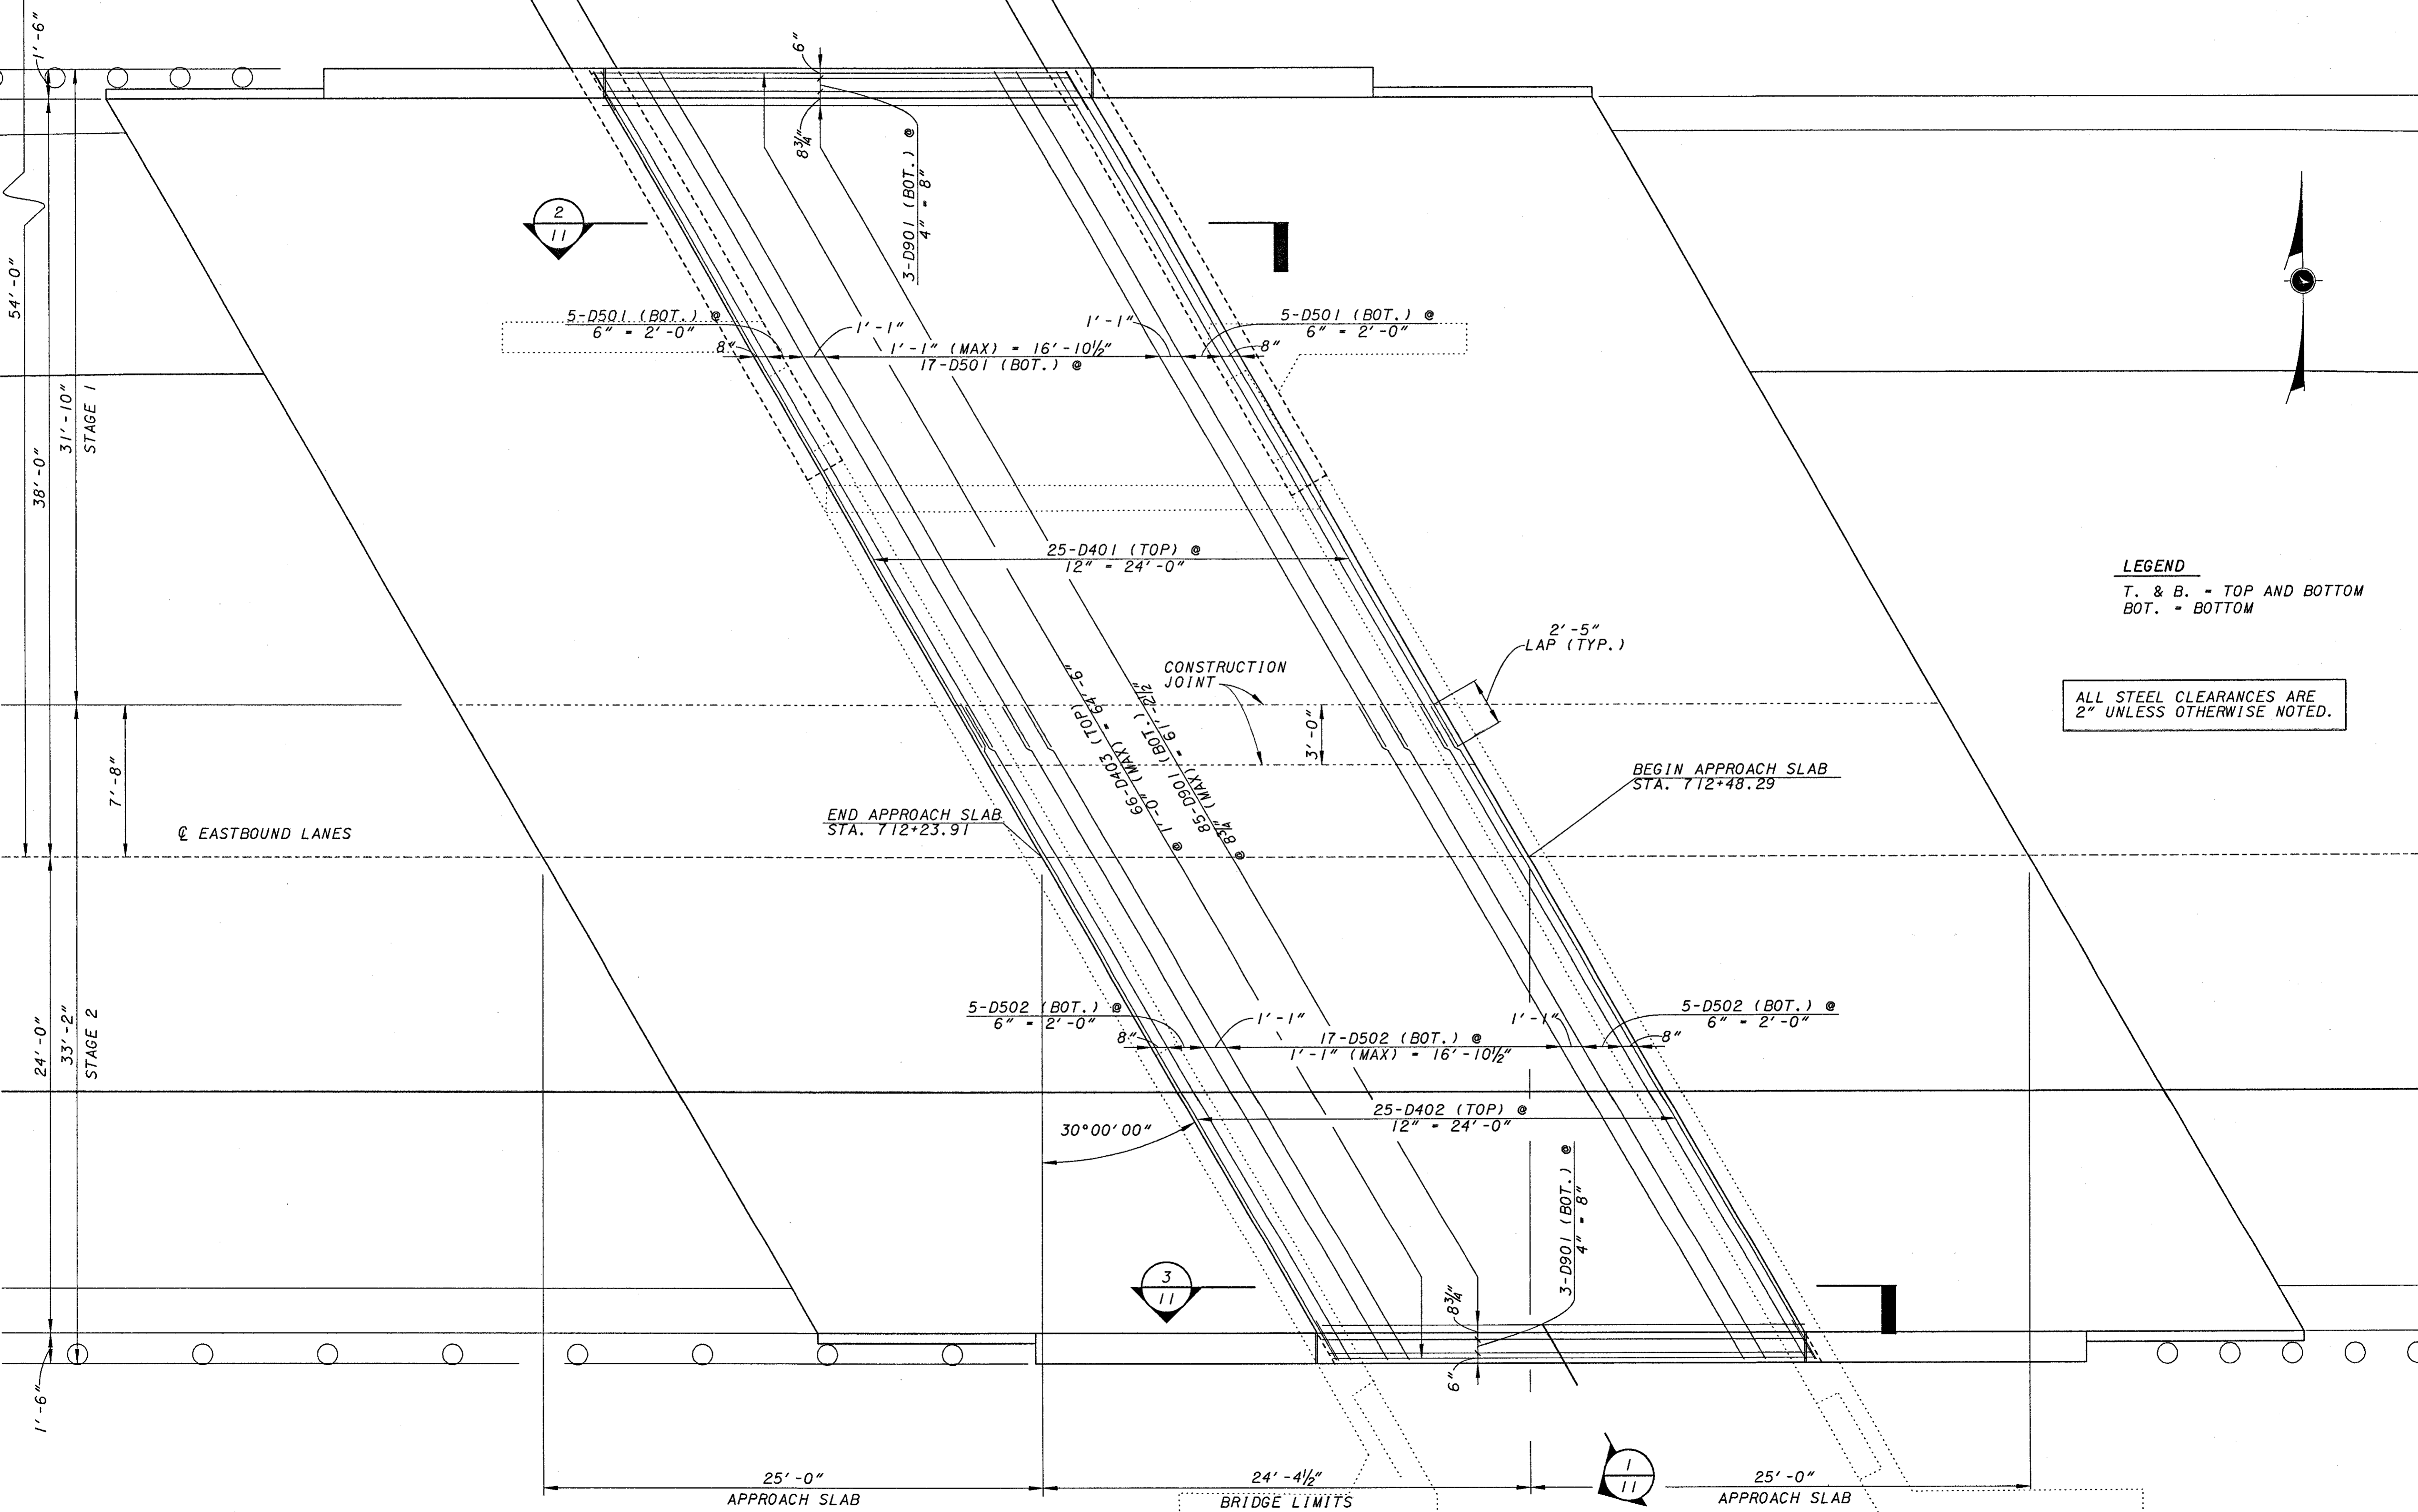
LEGEND
 T. & B. - TOP AND BOTTOM
 BOT. - BOTTOM

ALL STEEL CLEARANCES ARE
 2" UNLESS OTHERWISE NOTED.

DATE	1/29/01
REVIEWED	DGK
STRUCTURE FILE NUMBER	680/1323/680/358
DRAWN	JDG
DESIGNED	SVA
CHECKED	WDS

KZF #14

DECK PLAN - RIGHT BRIDGE
 BRIDGE NO. PRE-70-1349 L/R
 I.R. 70 OVER JIM'S RUN

PRE-70-0.00




REF: **REF**
 REF: **REF**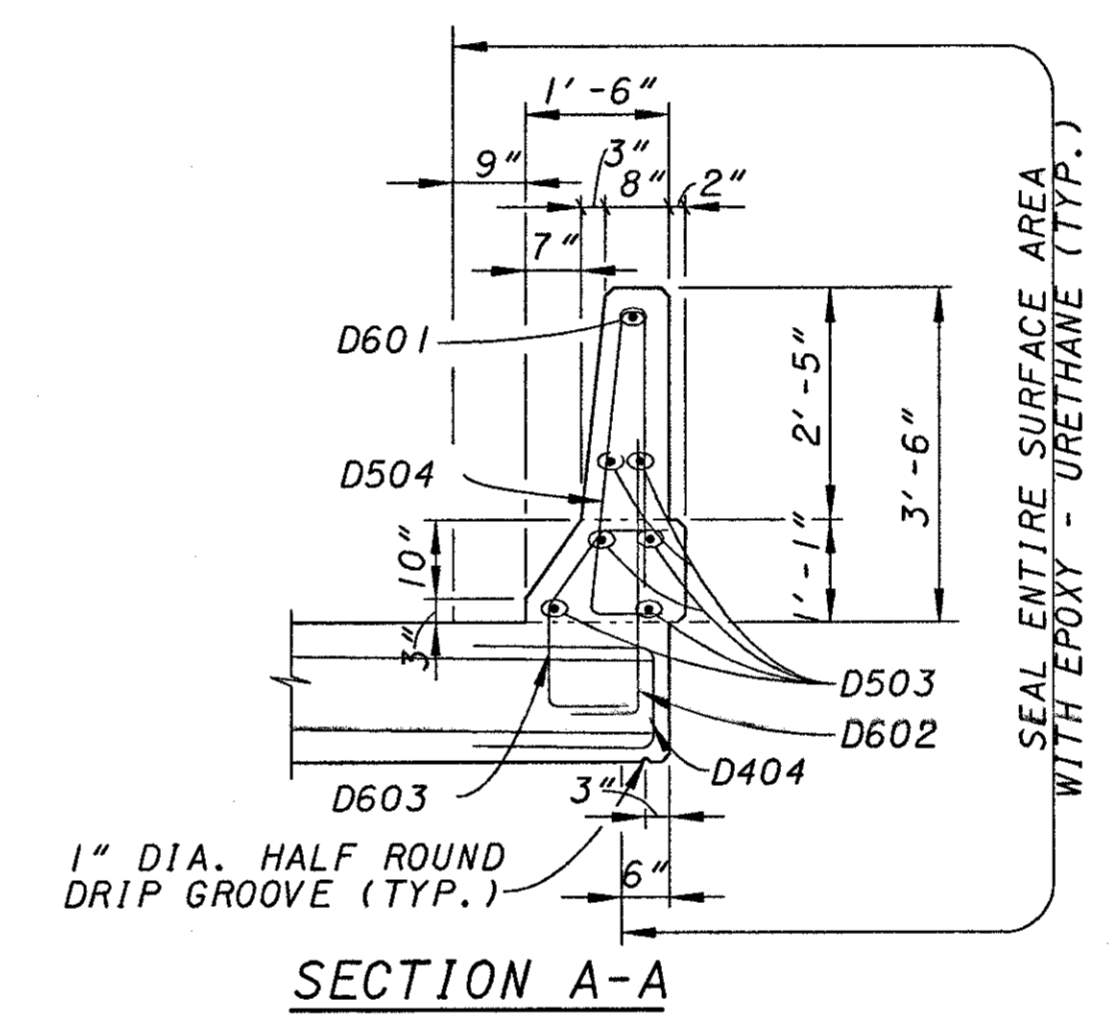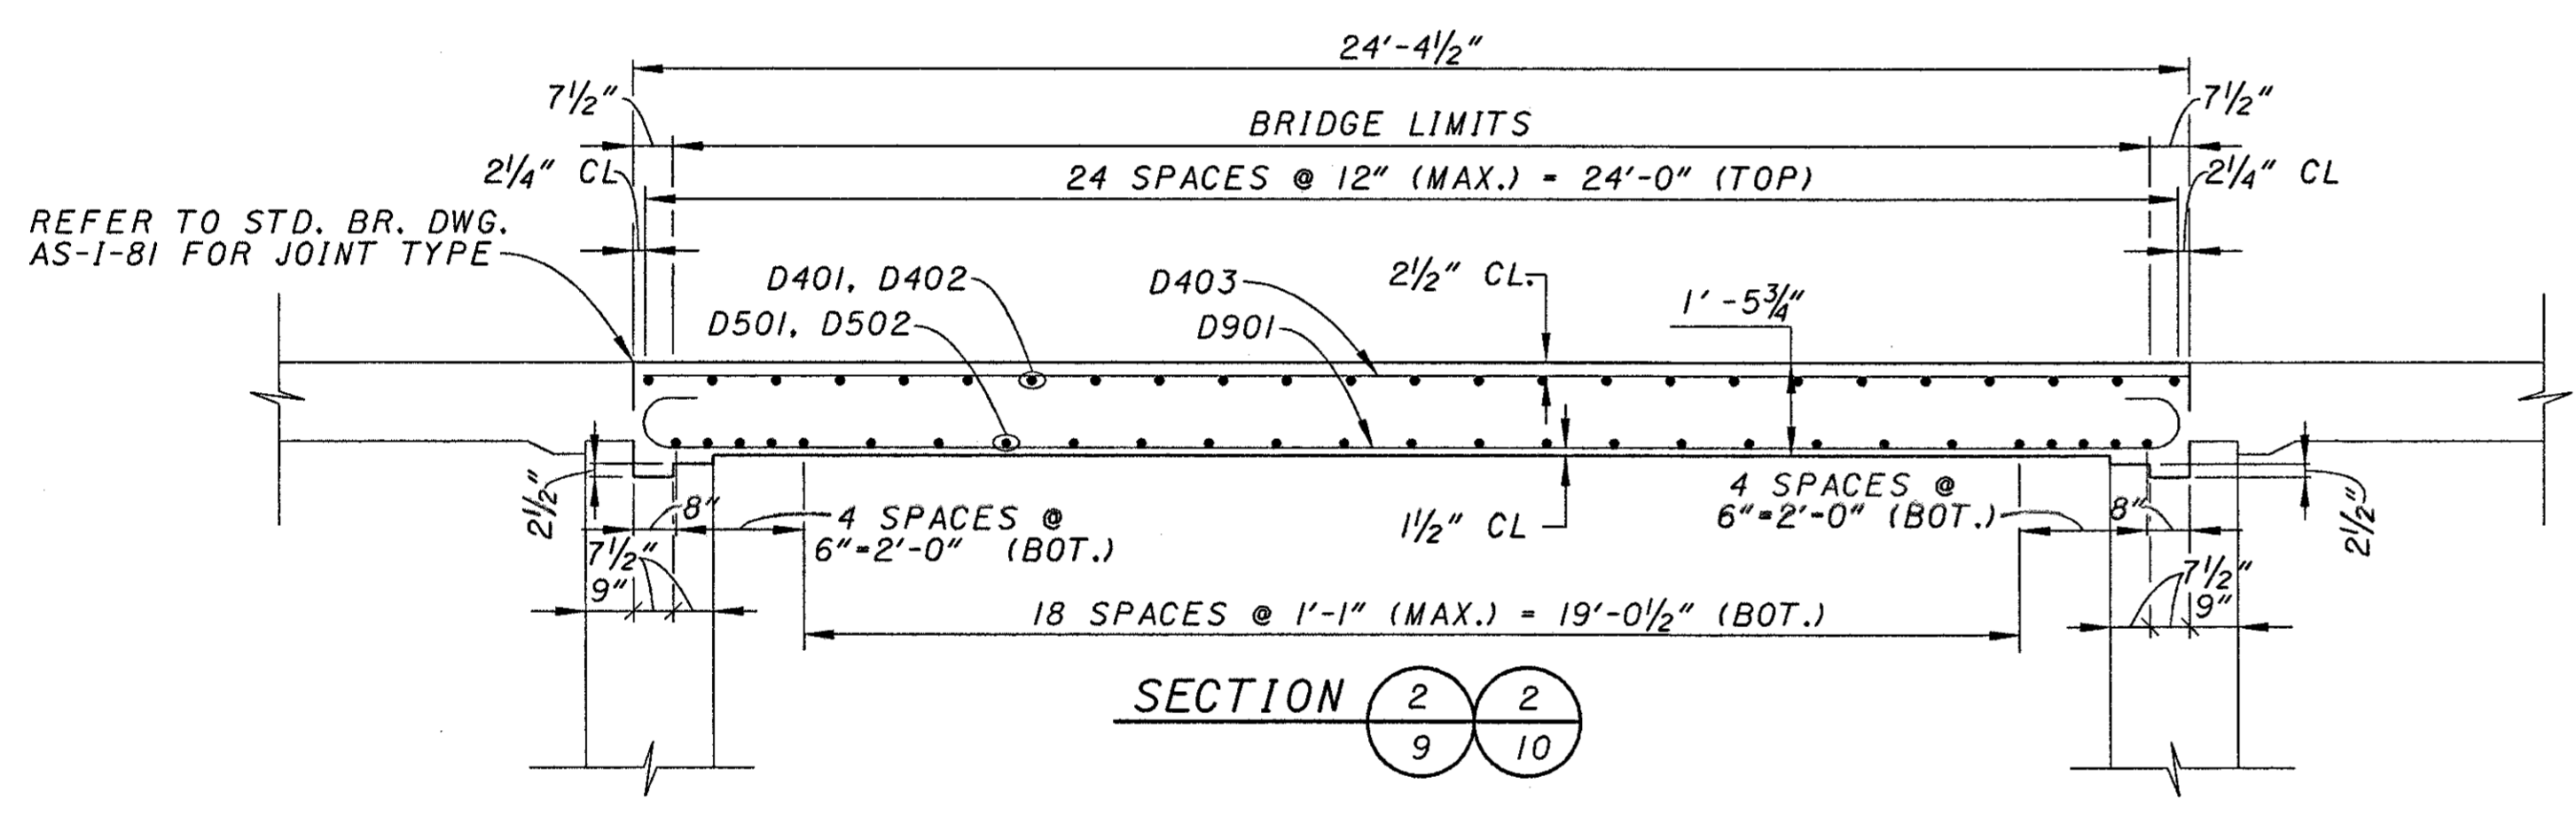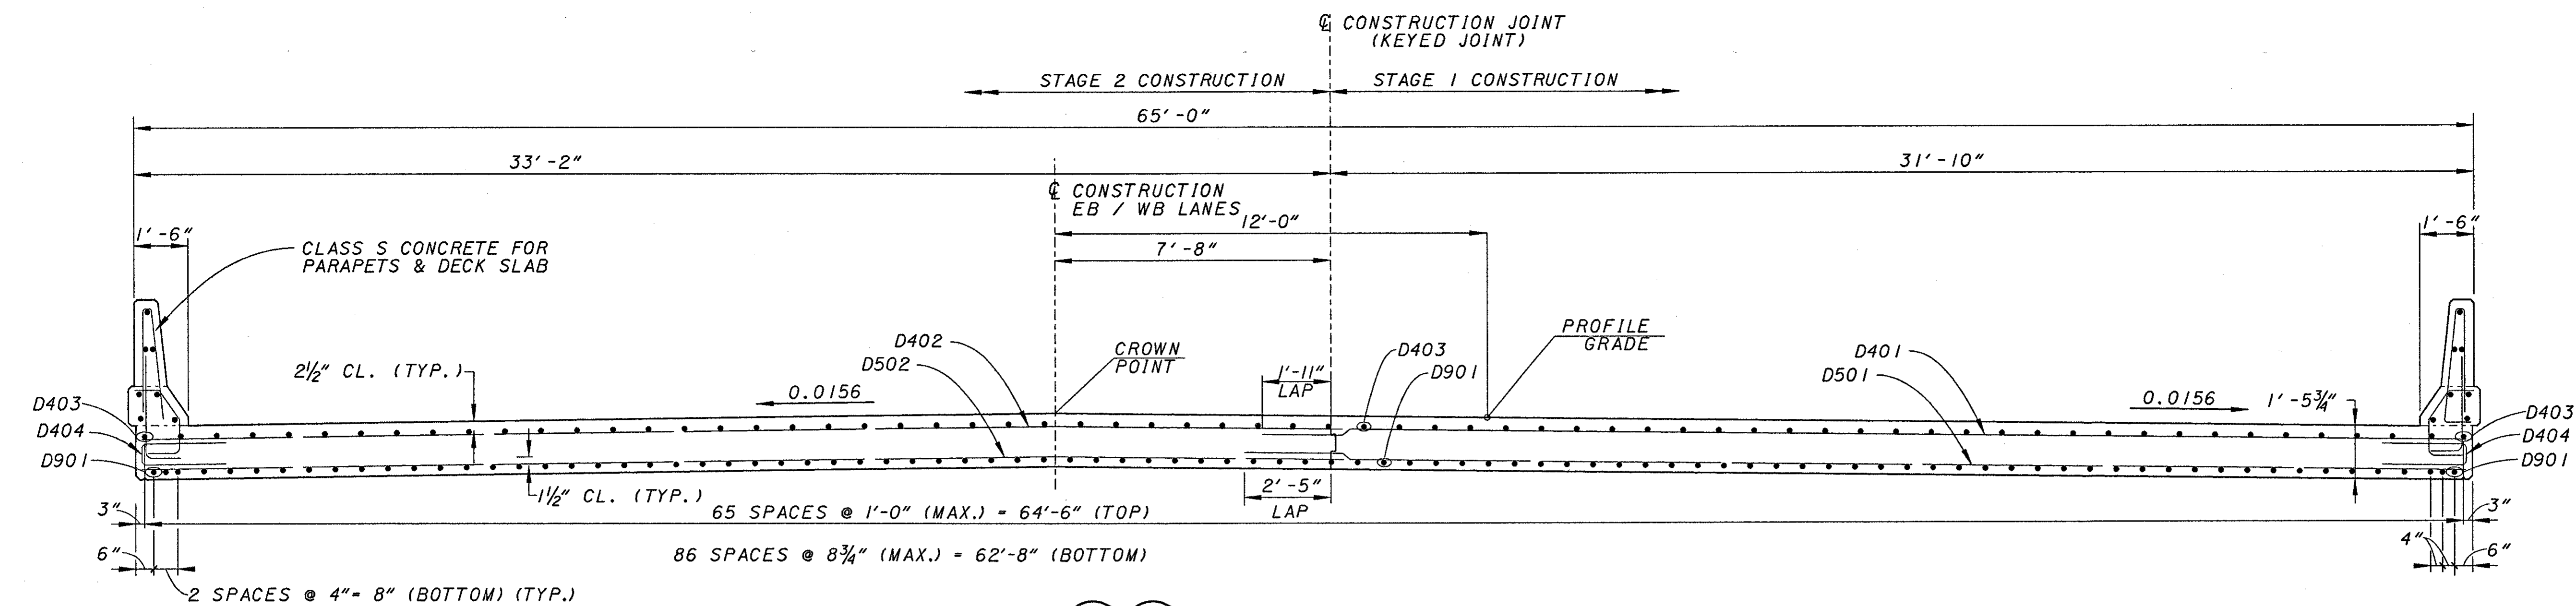
ALL STEEL CLEARANCES ARE 2" UNLESS OTHERWISE NOTED.

LEGEND:
 NF = NEAR FACE
 FF = FAR FACE
 EF = EACH FACE
 BOT. = BOTTOM
 PEJF = PERFORMED EXPANSION JOINT FILLER

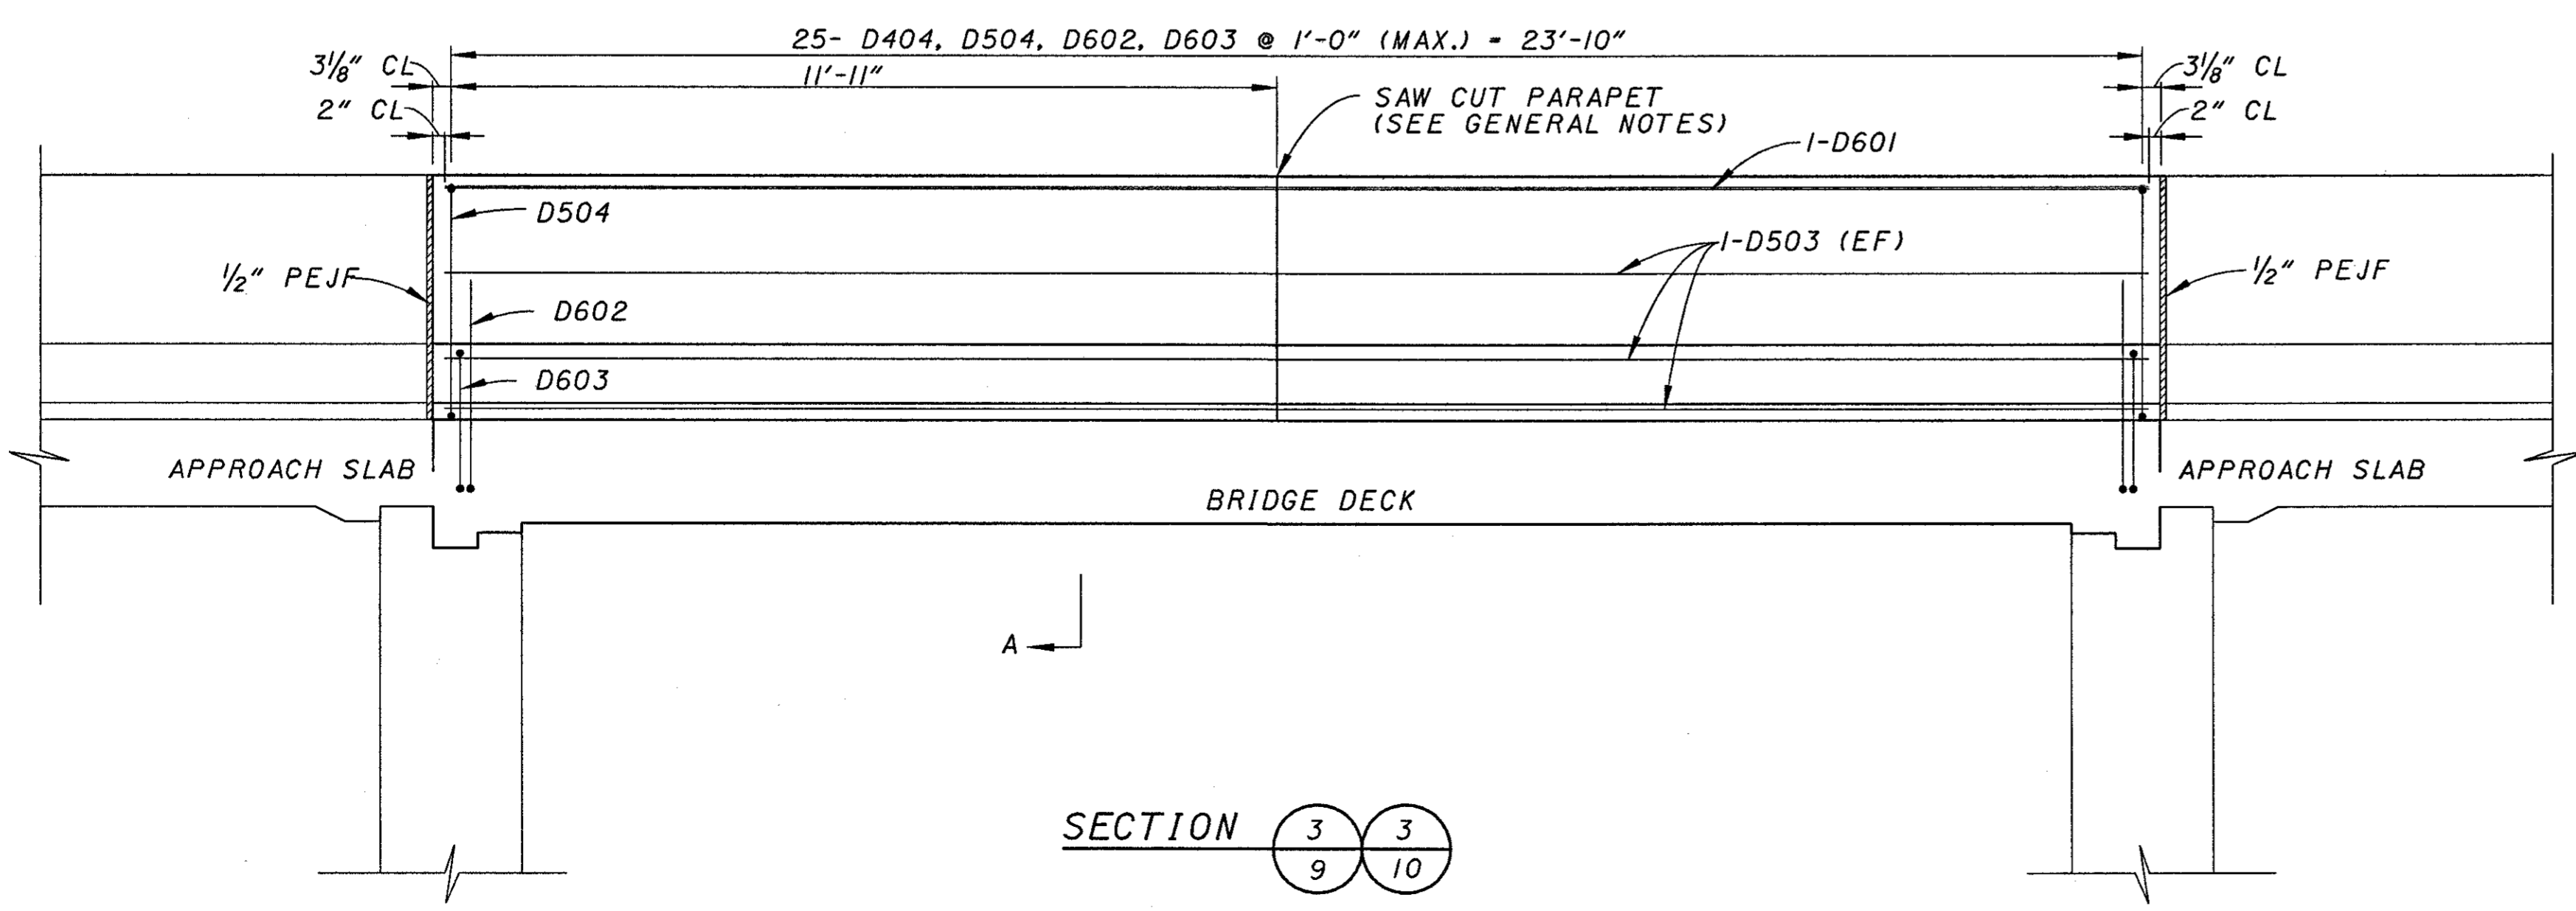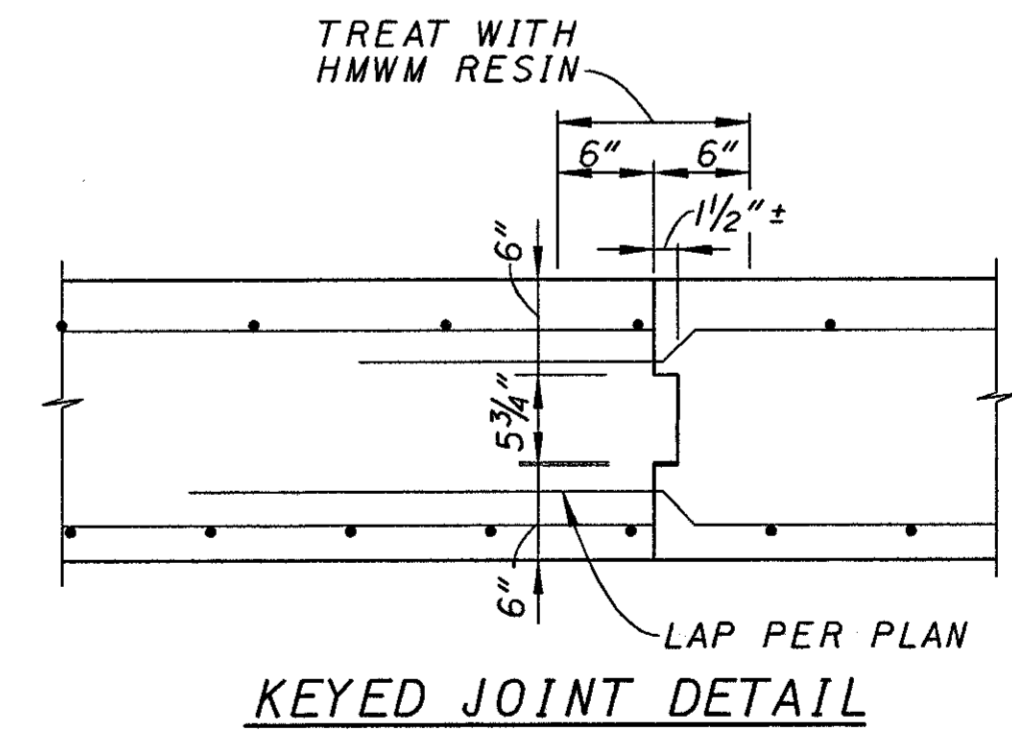

NOTES:

1. THE CONTRACTOR SHALL INCREASE FINISHED, MID-SPAN DECK ELEVATIONS BY 1/8" TO ACCOUNT FOR DEAD LOAD DEFLECTION OF THE CONCRETE SLAB AND PARAPET.
2. FALSEWORK FOR THE CONCRETE SLAB CONSTRUCTION STAGES SHALL BE INDEPENDENT OF EACH OTHER.

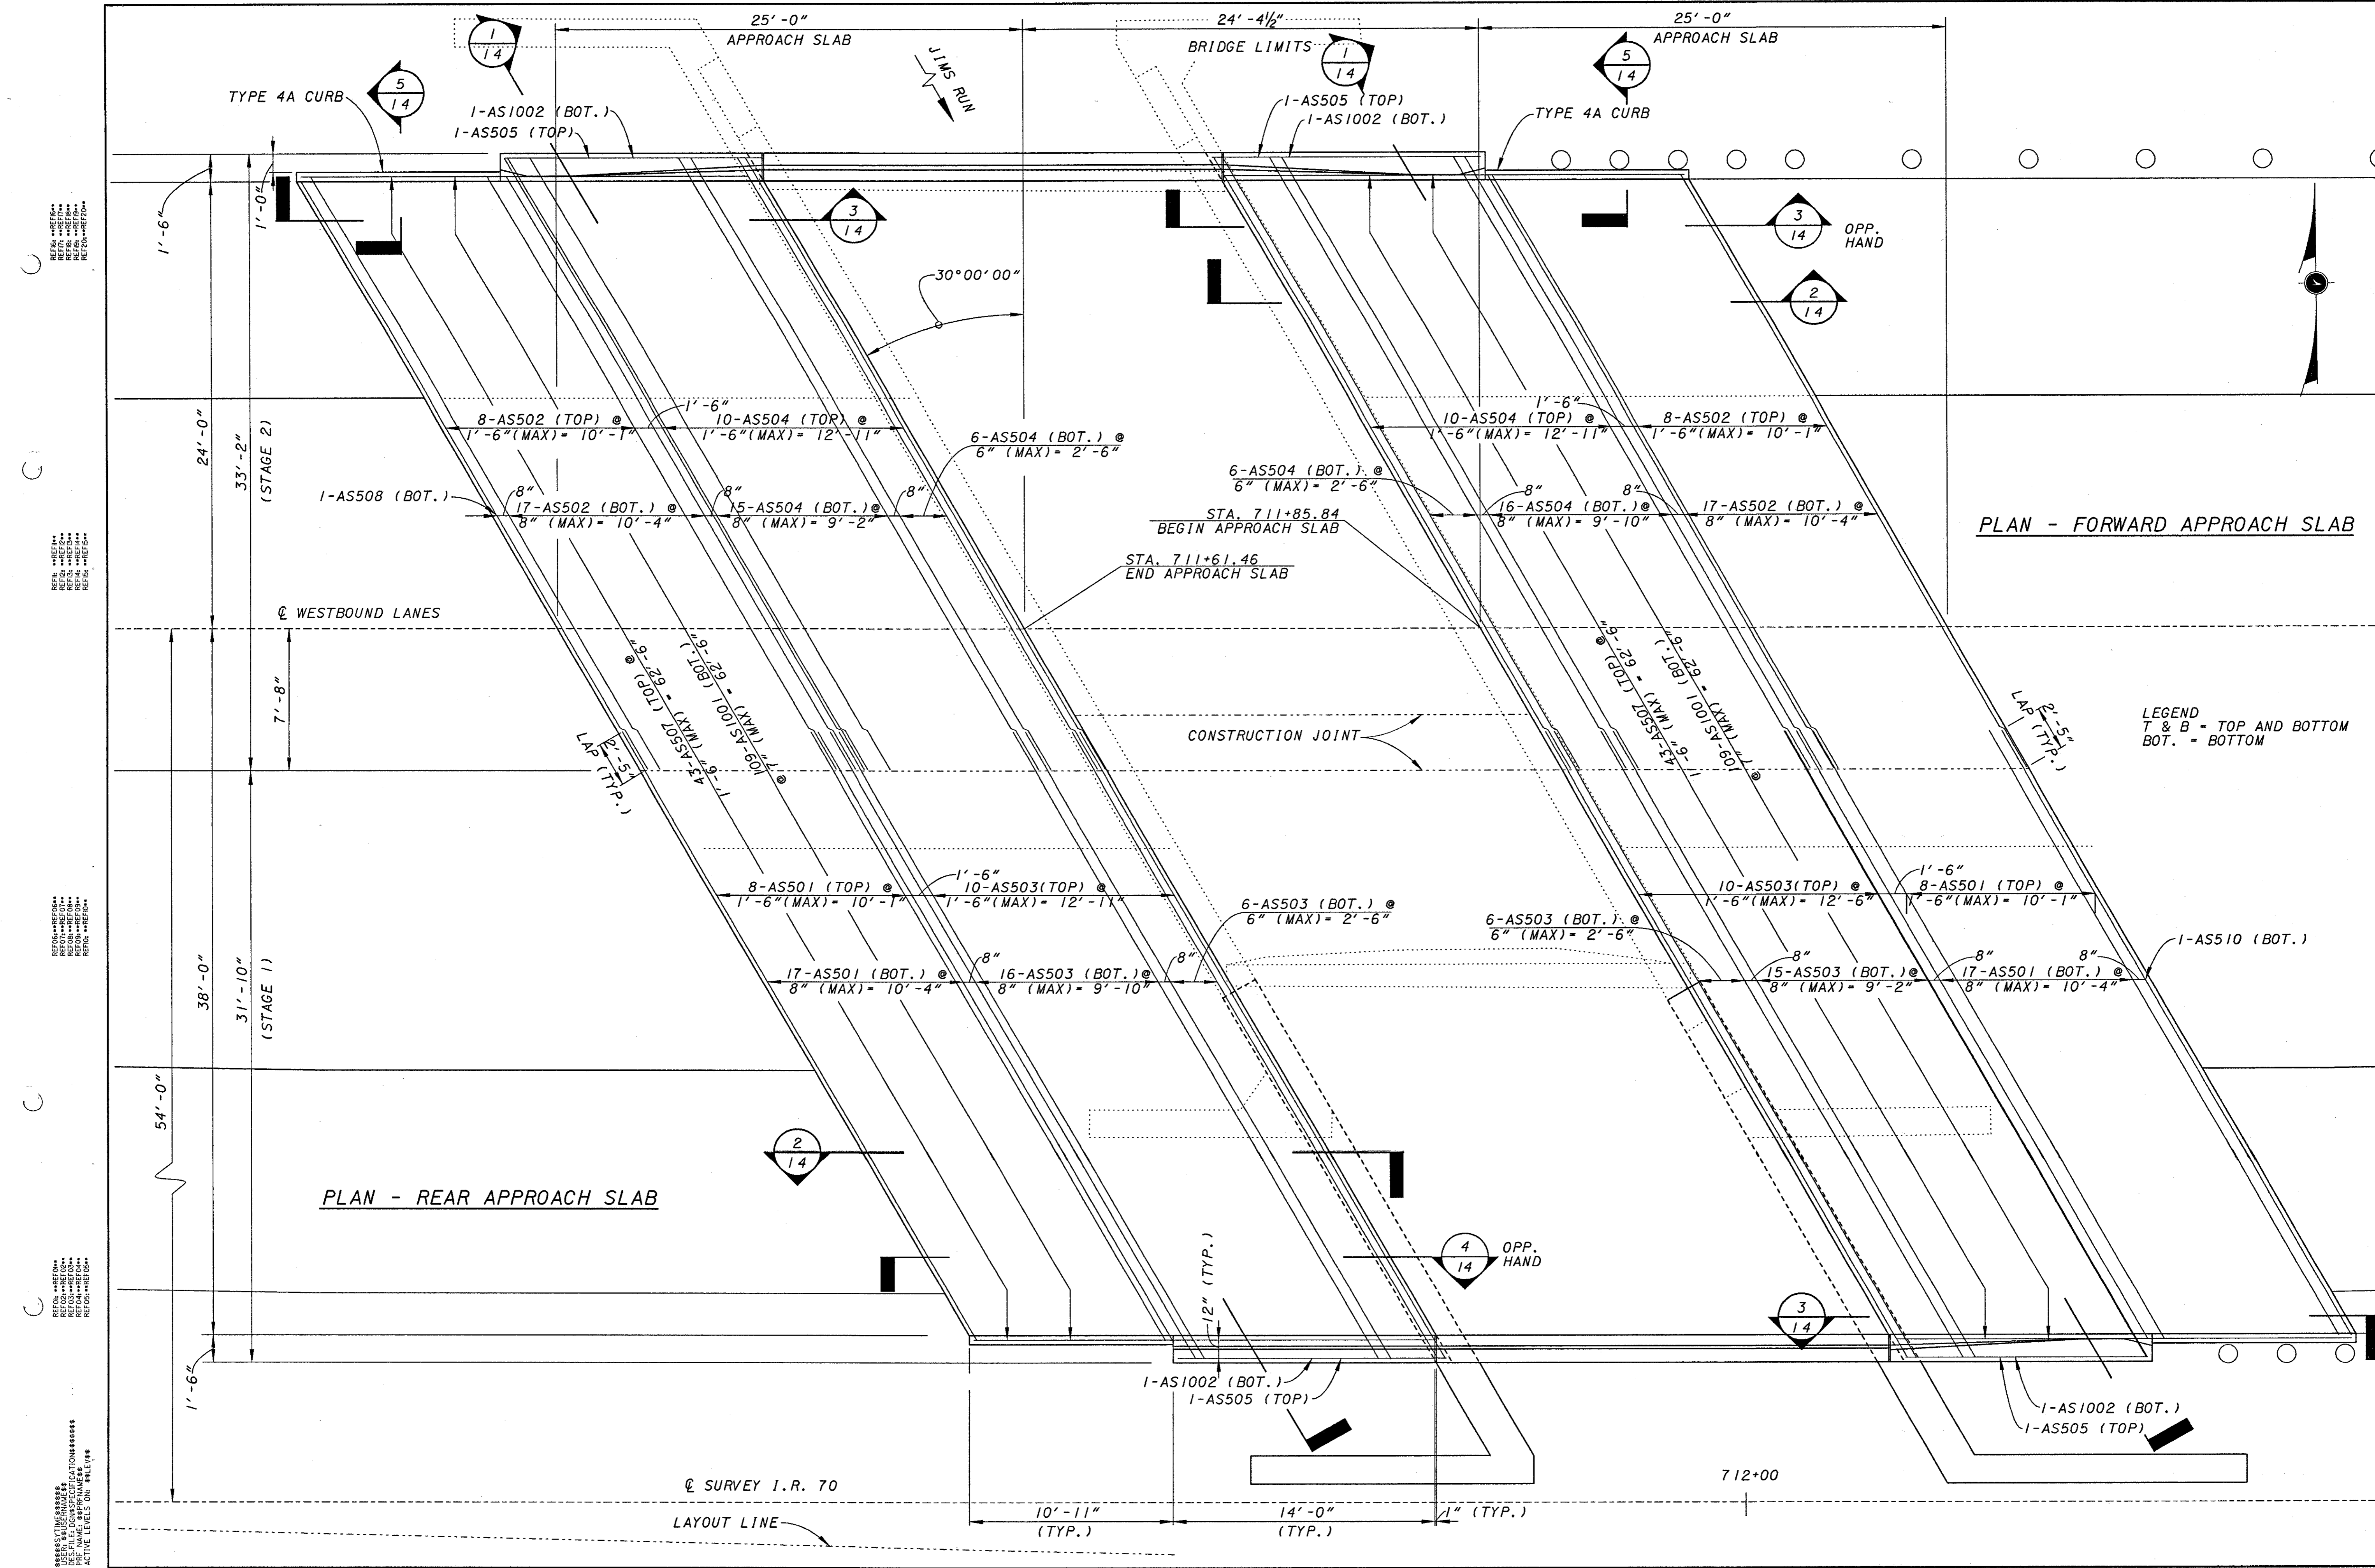

DESIGNED	S/A	CHECKED	WBS
DRAWN	J/DG	REVIEWED	
DATE	1/29/01	REVIEWED	DCK
STRUC. FILE NUMBER	6801323/6801358		

DESIGNED: KZF #14

APPROACH SLABS - LEFT BRIDGE
 BRIDGE NO. PRE-70-1349 L/R
 I.R. 70 OVER JIMS RUN

PRE-70-0.00

12 / 15

224
283

LEGEND
 T & B = TOP AND BOTTOM
 BOT. = BOTTOM

712+00

Q SURVEY I.R. 10

LAYOUT LINE

1-AS505 (TOP)
1-AS1002 (BOT.)

1-AS505 (TOP)
1-AS1002 (BOT.)

54'-0"
38'-0"
31'-10"
24'-0"
33'-2"

1-AS510 (BOT.)

8-AS501 (TOP) @ 1'-6" (MAX) = 10'-1"
10-AS503 (TOP) @ 1'-6" (MAX) = 12'-6"

17-AS501 (BOT.) @ 8" (MAX) = 10'-4"
15-AS503 (BOT.) @ 8" (MAX) = 9'-2"

6-AS503 (BOT.) @ 6" (MAX) = 2'-6"

6-AS503 (BOT.) @ 6" (MAX) = 2'-6"

10-AS503 (TOP) @ 1'-6" (MAX) = 12'-6"
8-AS501 (TOP) @ 1'-6" (MAX) = 10'-1"

16-AS503 (BOT.) @ 8" (MAX) = 9'-10"
17-AS501 (BOT.) @ 8" (MAX) = 10'-4"

PLAN - FORWARD APPROACH SLAB

LEGEND
T & B = TOP AND BOTTOM
BOT. = BOTTOM

CONSTRUCTION JOINT

BEGIN APPROACH SLAB
STA. 712+48.29

END APPROACH SLAB
STA. 712+23.97

Q EASTBOUND LANES

8-AS502 (TOP) @ 1'-6" (MAX) = 10'-1"
10-AS504 (TOP) @ 1'-6" (MAX) = 12'-6"

17-AS502 (BOT.) @ 8" (MAX) = 10'-4"
16-AS504 (BOT.) @ 8" (MAX) = 9'-10"

6-AS504 (BOT.) @ 6" (MAX) = 2'-6"

6-AS504 (BOT.) @ 6" (MAX) = 2'-6"

10-AS504 (TOP) @ 1'-6" (MAX) = 12'-6"
8-AS502 (TOP) @ 1'-6" (MAX) = 10'-1"

15-AS504 (BOT.) @ 8" (MAX) = 9'-2"
17-AS502 (BOT.) @ 8" (MAX) = 10'-4"

1-AS508 (BOT.)

PLAN - REAR APPROACH SLAB

TYPE 4A CURB

1-AS1002 (BOT.)
1-AS505 (TOP)

1-AS1002 (BOT.)
1-AS505 (TOP)

TYPE 4A CURB

25'-0" APPROACH SLAB

24'-4 1/2" BRIDGE LIMITS

25'-0" APPROACH SLAB

REVISIONS
NO. DATE BY
1 1/29/01 JJA
2 2/1/01 JJA
3 2/1/01 JJA
KZ DESIGN
DESIGN AGENCY
10000 W. 10th Ave., Suite 100
Denver, CO 80202
TEL: 303.751.1811 FAX: 303.751.1850 WEB: www.kzdesign.com

DATE 1/29/01
REVIEWED DCK
DRAWN JJD
DESIGNED SJA
CHECKED WBS

KZF #14

APPROACH SLABS - RIGHT BRIDGE
BRIDGE NO. PRE-70-1349 L/R
I.R. 70 OVER JIM'S RUN

PRE-70-0.00

13 / 15

225
283

ABUTMENT REINFORCING STEEL LIST





















MARK	LENGTH	SHAPE	LEFT BRIDGE		RIGHT BRIDGE	
			NUMBER	WEIGHT	NUMBER	WEIGHT
A501	21'-9"	STR.	12	272	12	272
A502	23'-1"	STR.	12	289	12	289
A503	14'-4"	STR.	16	239	16	239
A504	11'-2"	STR.	12	140	12	140
A505	6'-6"	STR.	30	203	30	203
A506	9'-8"	BENT	22	222	22	222
A507	2'-2"	STR.	2	5	2	5
A508	4'-4"	STR.	2	9	2	9
A509	7'-6"	STR.	2	16	2	16
A510	11'-5"	STR.	84	1,000	0	0
A511	11'-9"	STR.	0	0	84	1,029
A512	10'-11"	BENT	2	23	2	23
A513	8'-0"	BENT	9	75	9	75
A514	15'-8"	STR.	16	261	16	261
A515	12'-2"	STR.	4	51	4	51
A516	3'-8"	BENT	9	34	9	34
A517	4'-10"	BENT	9	45	9	45
A518	5'-2"	BENT	32	172	32	172
A519	15'-2"	STR.	4	63	4	63
A520	21'-9"	STR.	18	408	18	408
A521	9'-9"	BENT	26	264	26	264
A522	6'-9"	BENT	10	70	10	70
A523	2'-8"	BENT	2	6	2	6
A524	6'-0"	BENT	1	6	1	6
A525	6'-0"	STR.	1	6	1	6
A526	22'-9"	STR.	18	427	18	427
A527	4'-0"	STR.	18	75	18	75
A528	7'-0"	STR.	4	29	4	29
A529	5'-5"	BENT	1	6	1	6
A530	5'-3"	STR.	1	5	1	5
A531	6'-4"	BENT	1	7	1	7
A532	6'-3"	STR.	1	7	1	7
A533	5'-2"	BENT	1	5	1	5
A534	5'-2"	STR.	1	5	1	5
A535	13'-11"	BENT	2	29	2	29
A536	12'-5"	BENT	2	26	2	26
A701	11'-8"	STR.	47	1,121	0	0
A702	12'-0"	STR.	0	0	47	1,153
A703	6'-5"	BENT	47	616	46	603
A801	5'-10"	STR.	22	343	22	343
A802	4'-5"	STR.	82	967	82	967
TOTAL POUNDS				7,550		7,598

SUPERSTRUCTURE REINFORCING STEEL LIST

MARK	LENGTH	SHAPE	LEFT BRIDGE		RIGHT BRIDGE	
			NUMBER	WEIGHT	NUMBER	WEIGHT
D401	38'-10"	STR.	26	674	26	674
D402	38'-1"	STR.	26	661	26	661
D403	24'-0"	STR.	66	1,058	66	1,058
D404	4'-11"	BENT	50	164	50	164
D501	39'-0"	STR.	27	1,098	27	1,098
D502	38'-1"	STR.	27	1,072	27	1,072
D503	24'-0"	STR.	12	300	12	300
D504	7'-1"	BENT	50	369	50	369
D601	24'-0"	STR.	2	72	2	72
D602	3'-7"	BENT	50	269	50	269
D603	3'-4"	BENT	50	250	50	250
D901	26'-6"	BENT	91	8,199	91	8,199
TOTAL POUNDS				14,189		14,189

APPROACH SLAB REINFORCING STEEL LIST




MARK	LENGTH	SHAPE	LEFT BRIDGE		RIGHT BRIDGE					
			NUMBER	WEIGHT	NUMBER	WEIGHT				
AS501	37'-9"	STR.	50	1,969	50	1,969				
AS502	36'-10"	STR.	50	1,921	50	1,921				
AS503	38'-11"	STR.	63	2,557	63	2,557				
AS504	38'-0"	STR.	63	2,497	63	2,497				
AS505	14'-4"	STR.	4	60	4	60				
AS506	37'-5"	STR.	1	39	1	39				
AS507	24'-6"	STR.	86	2,198	86	2,198				
AS508	36'-7"	STR.	1	38	1	38				
VAR. 3'-10"							3		3	
AS511	TO 3'-0"	BENT	SER OF	118	SER OF	118				
BY 0'-1"							11		11	
AS512	7'-1"	BENT	15	111	15	111				
AS513	13'-8"	STR.	18	257	18	257				
AS514	10'-0"	STR.	12	125	12	125				
AS515	5'-8"	BENT	6	35	6	35				
AS516	5'-8"	STR.	6	35	6	35				
AS601	4'-1"	BENT	24	147	24	147				
VAR. 4'-11"							3		3	
AS602	TO 4'-1"	BENT	SER OF	223	SER OF	223				
BY 0'-1"							11		11	
AS603	3'-4"	BENT	48	240	48	240				
AS604	13'-8"	STR.	1	21	1	21				
AS605	3'-7"	BENT	15	81	15	81				
AS1001	25'-10"	BENT	218	24,233	218	24,233				
AS1002	14'-11"	BENT	4	257	4	257				
TOTAL POUNDS				37,161		37,161				

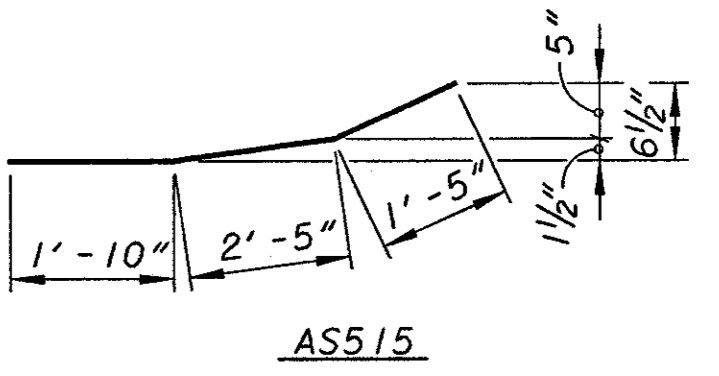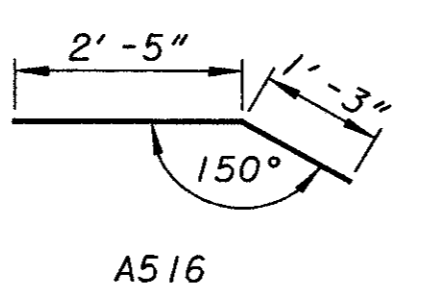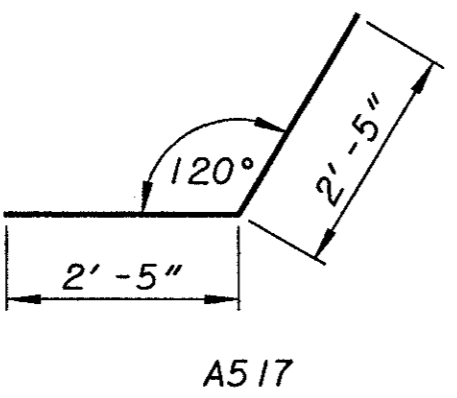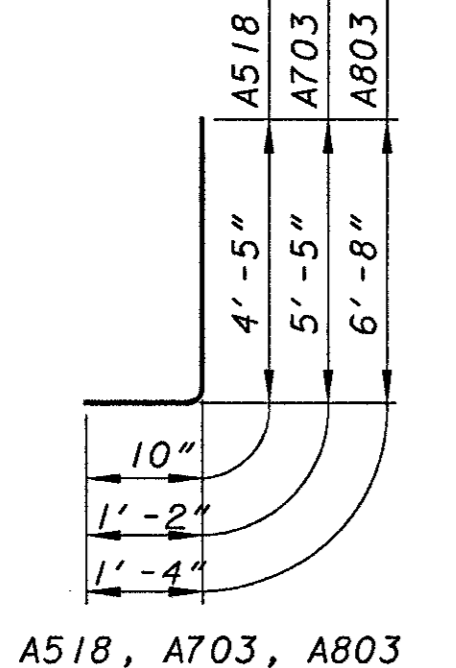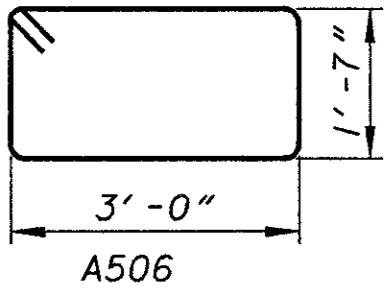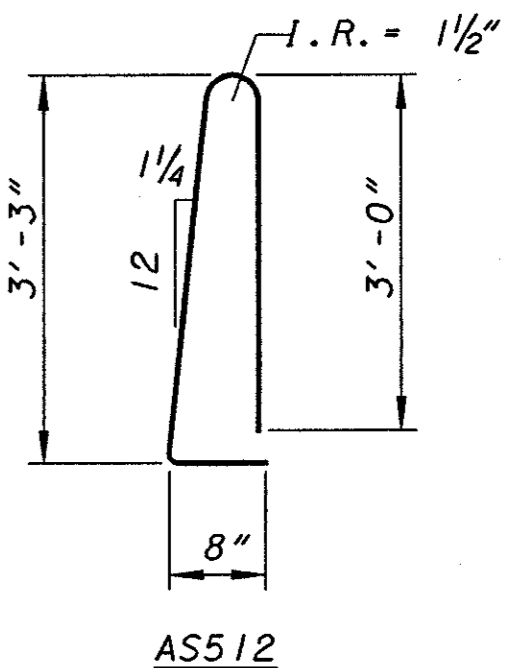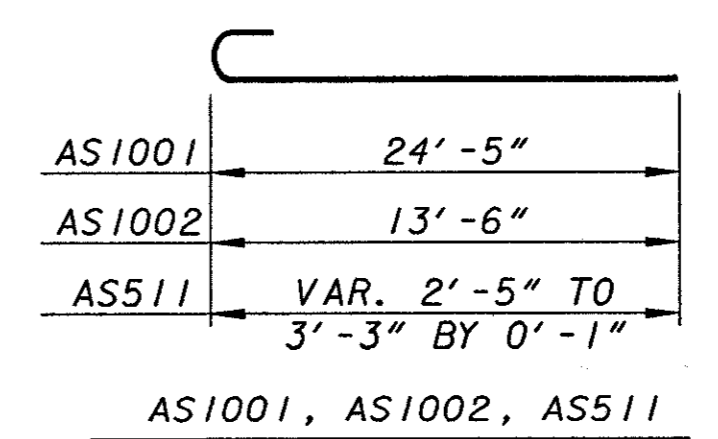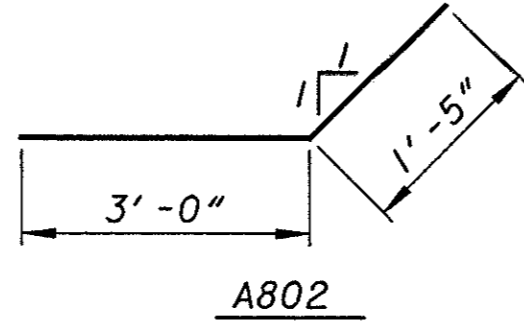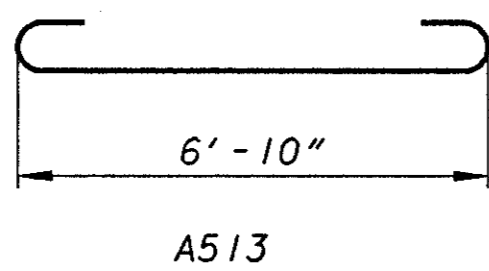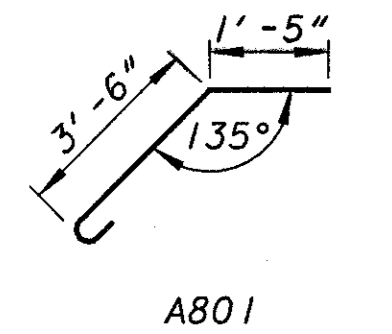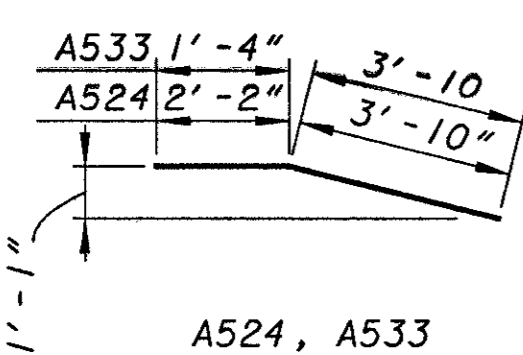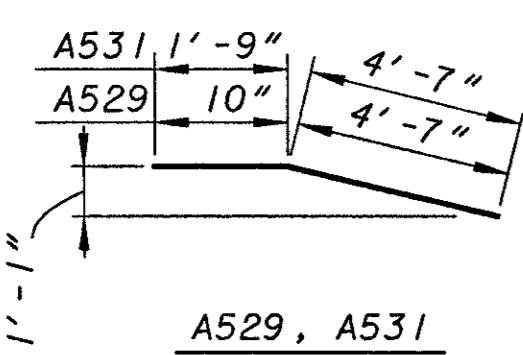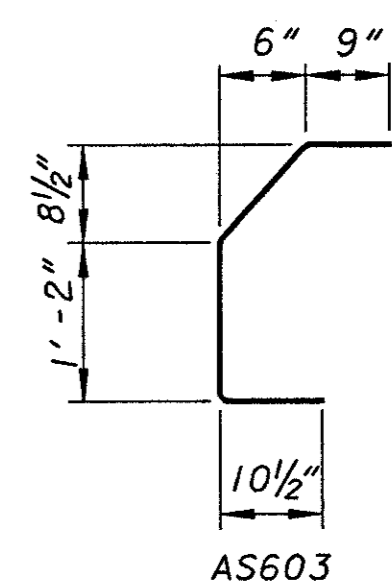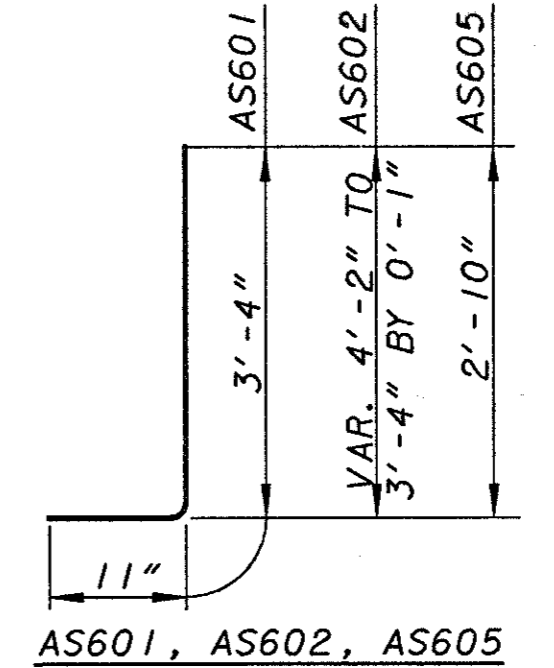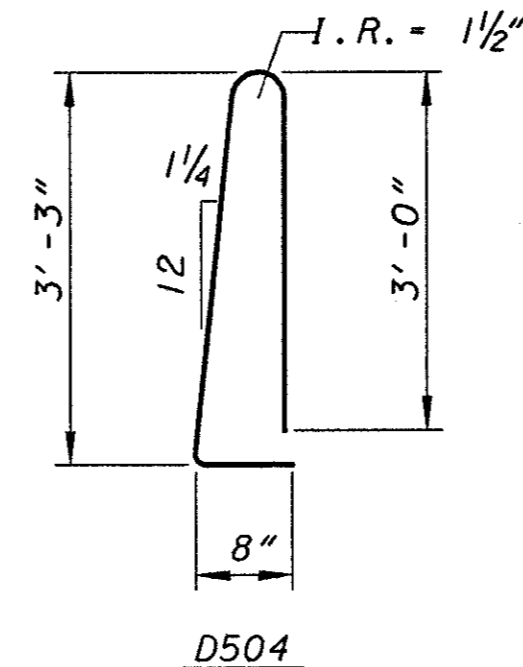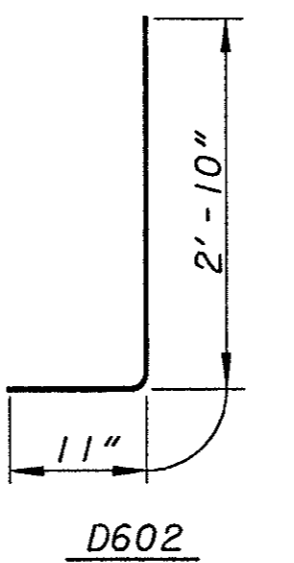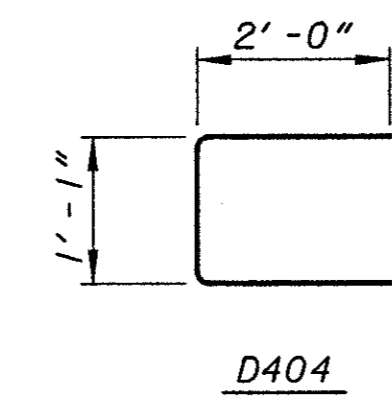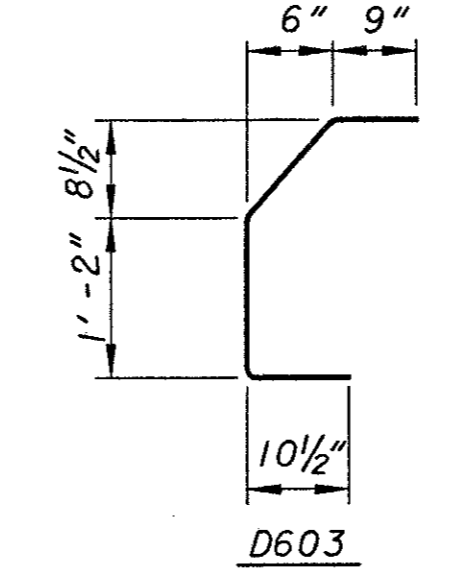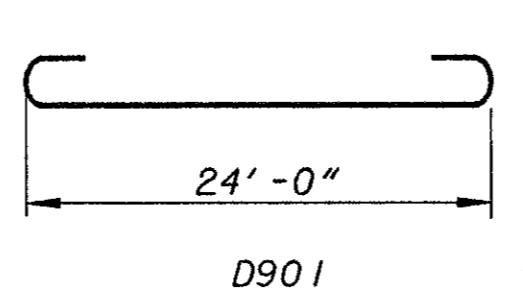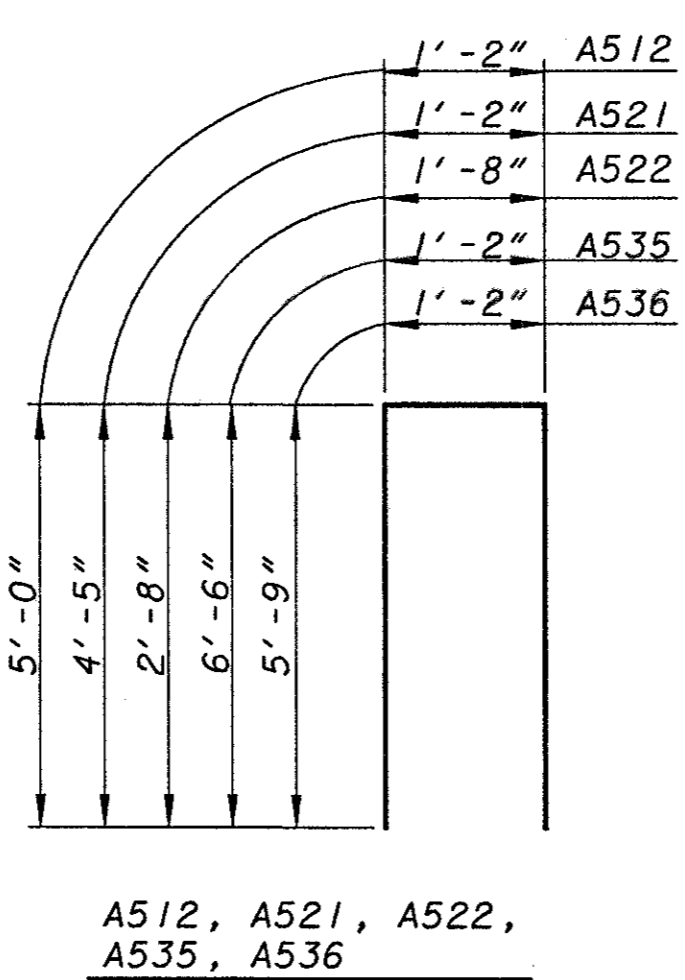

NOTES:

- ALL DIMENSIONS ARE OUT TO OUT OF BAR EXCEPT ON STANDARD 180° AND 135° HOOKS.
- DIMENSIONS ON HOOKS TO BE SHOWN ONLY WHERE NECESSARY TO RESTRICT HOOK SIZE, OTHERWISE STANDARD HOOKS ARE TO BE USED.
- ALL BENDS SHOWN ARE BENT AROUND A STANDARD MANDREL, EXCEPT WHERE RADIUS "R" IS INDICATED.
- ALL BARS ARE EPOXY COATED.
- THE BAR SIZE NUMBER IS SPECIFIED ON THE PLANS IN THE BAR MARK COLUMN. THE FIRST DIGIT INDICATES THE BAR SIZE NUMBER. FOR EXAMPLE, A501 IS A NO. 5 BAR.

REF: A501-503, 505-510, 512-516, 518-520, 522-526, 528-530, 532-536, 538-540, 542-544, 546-548, 994-996, 998-1000

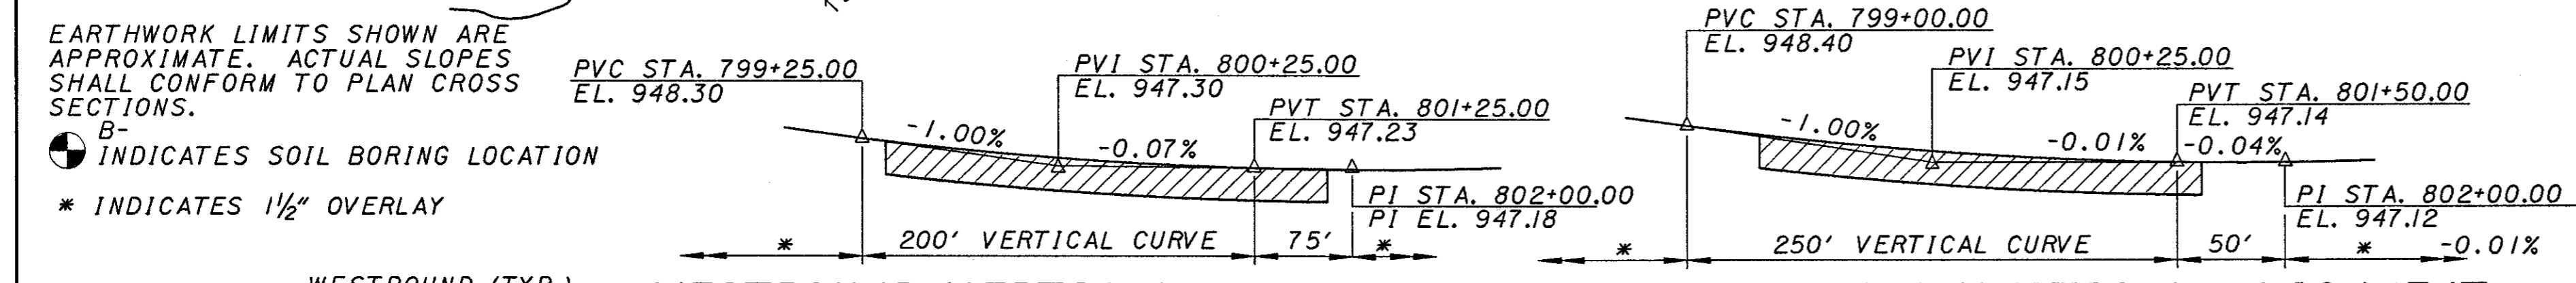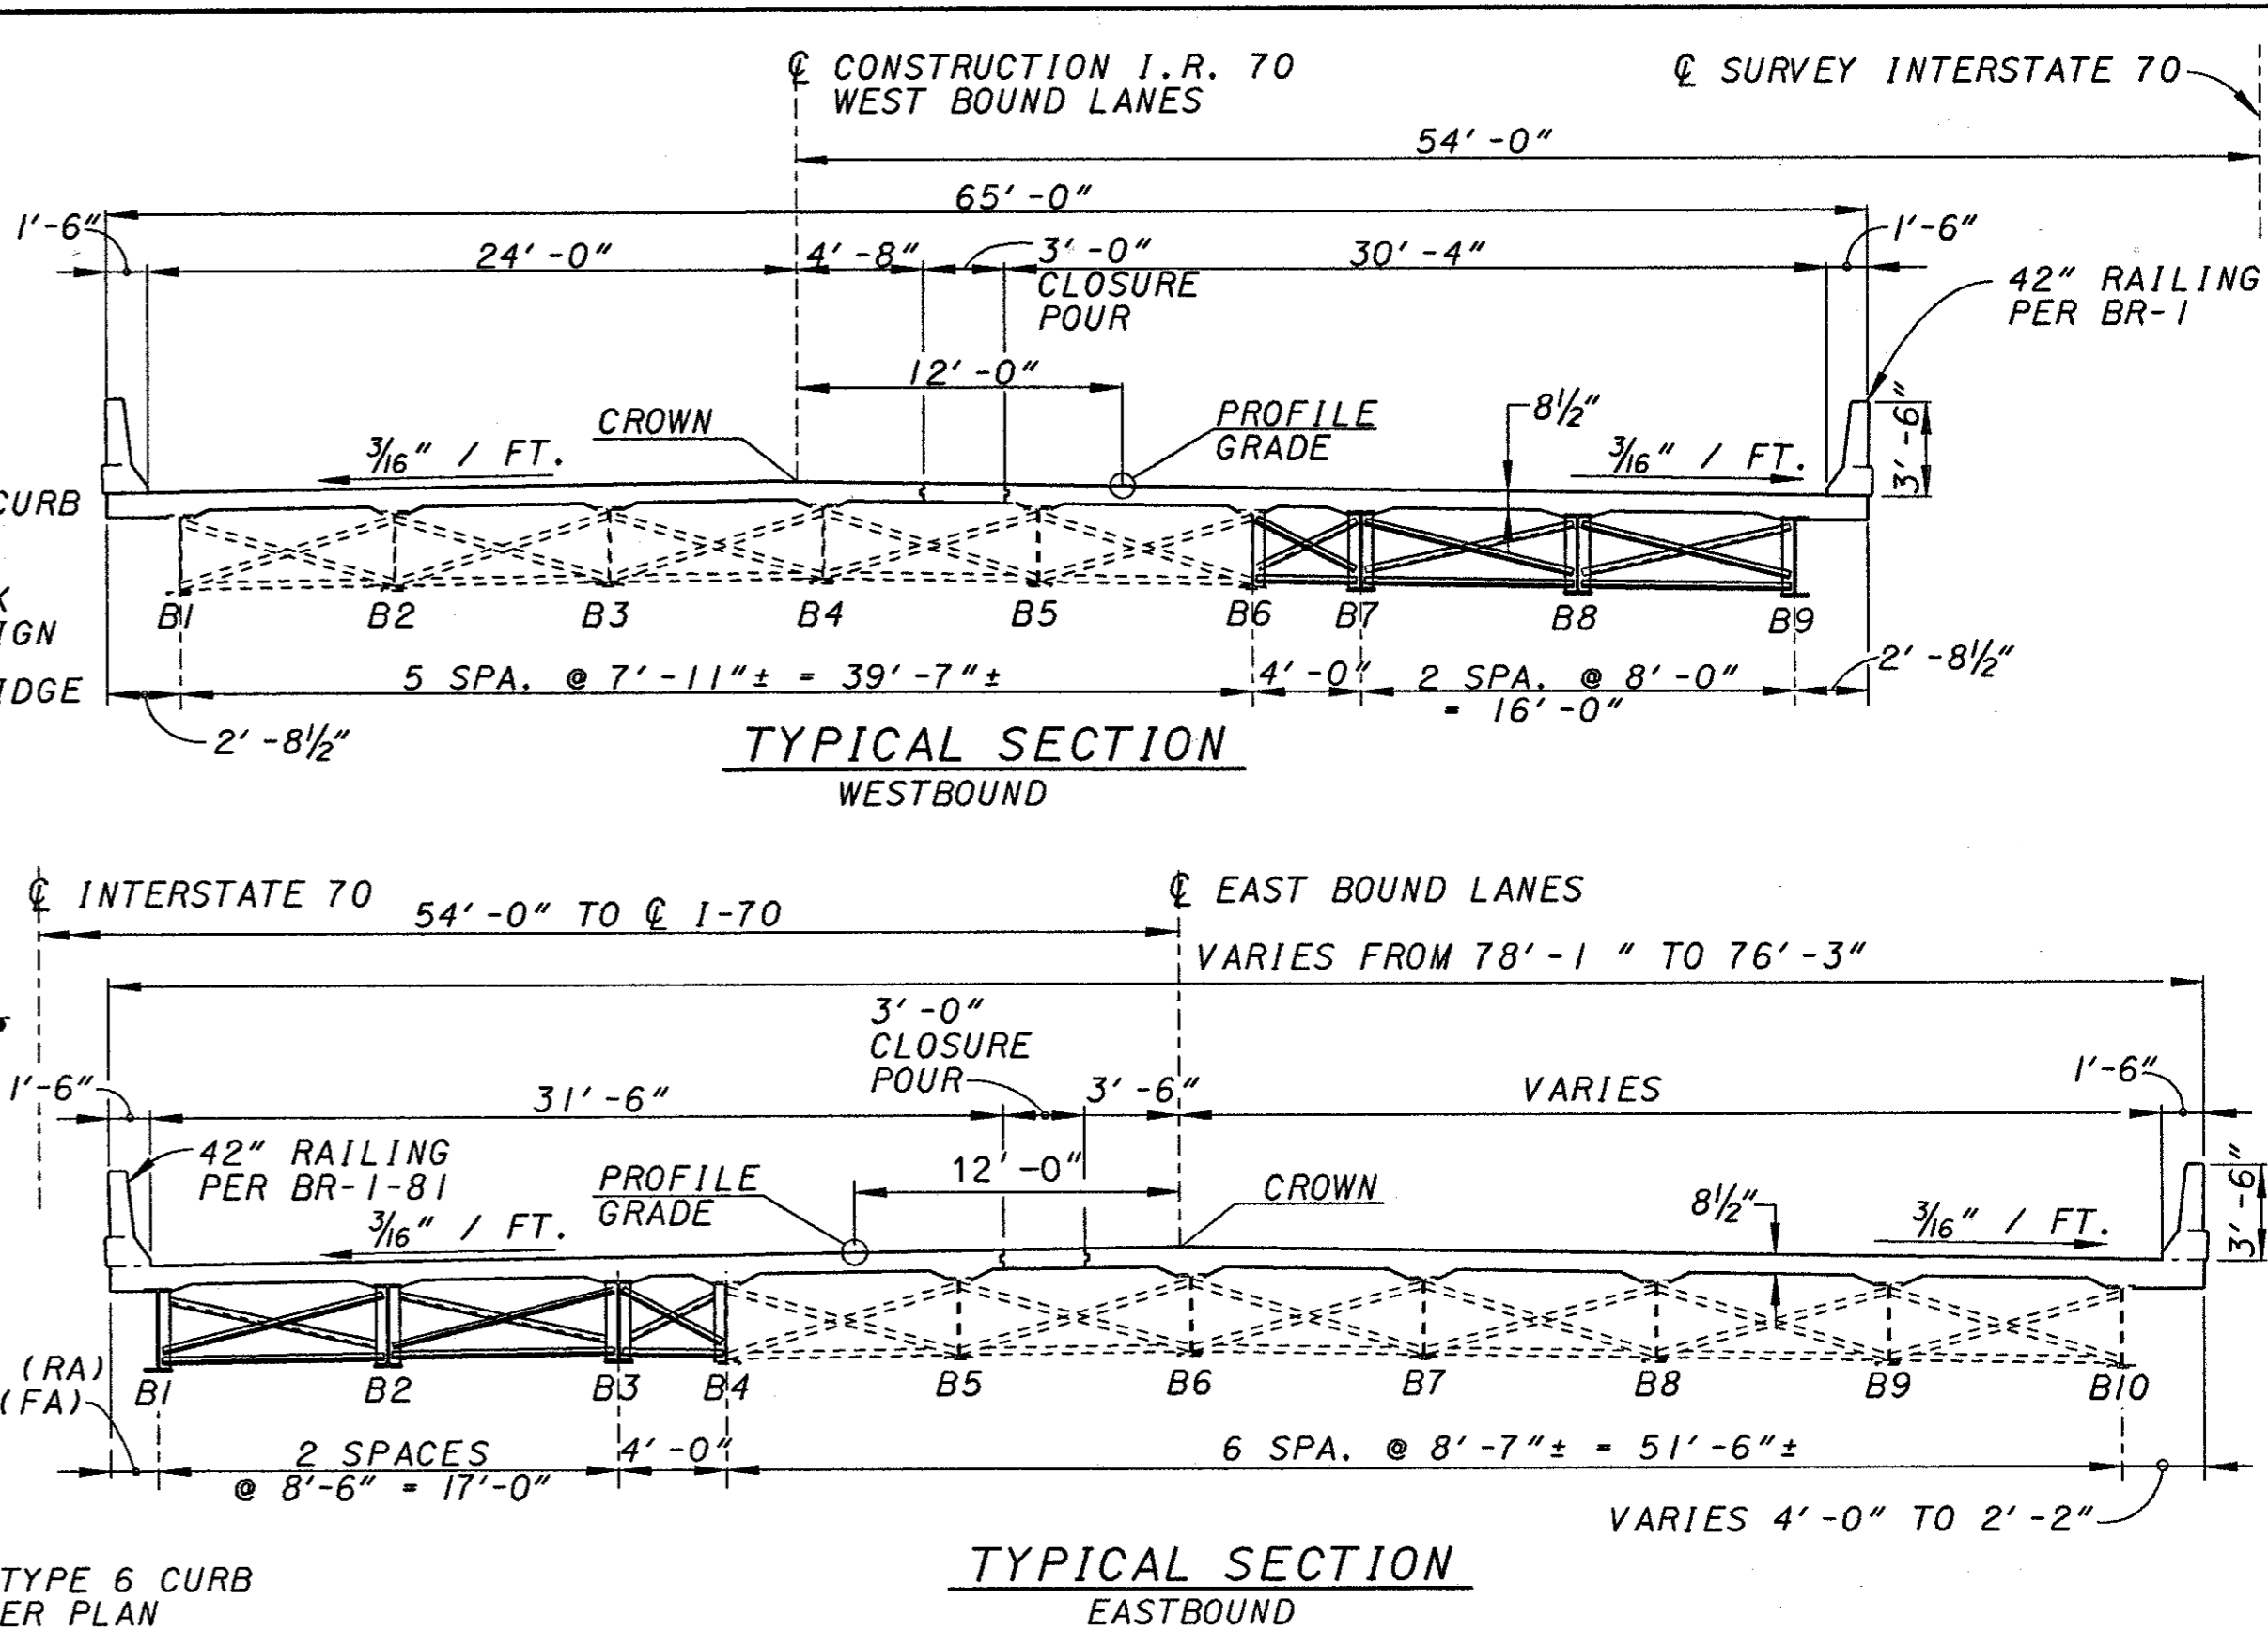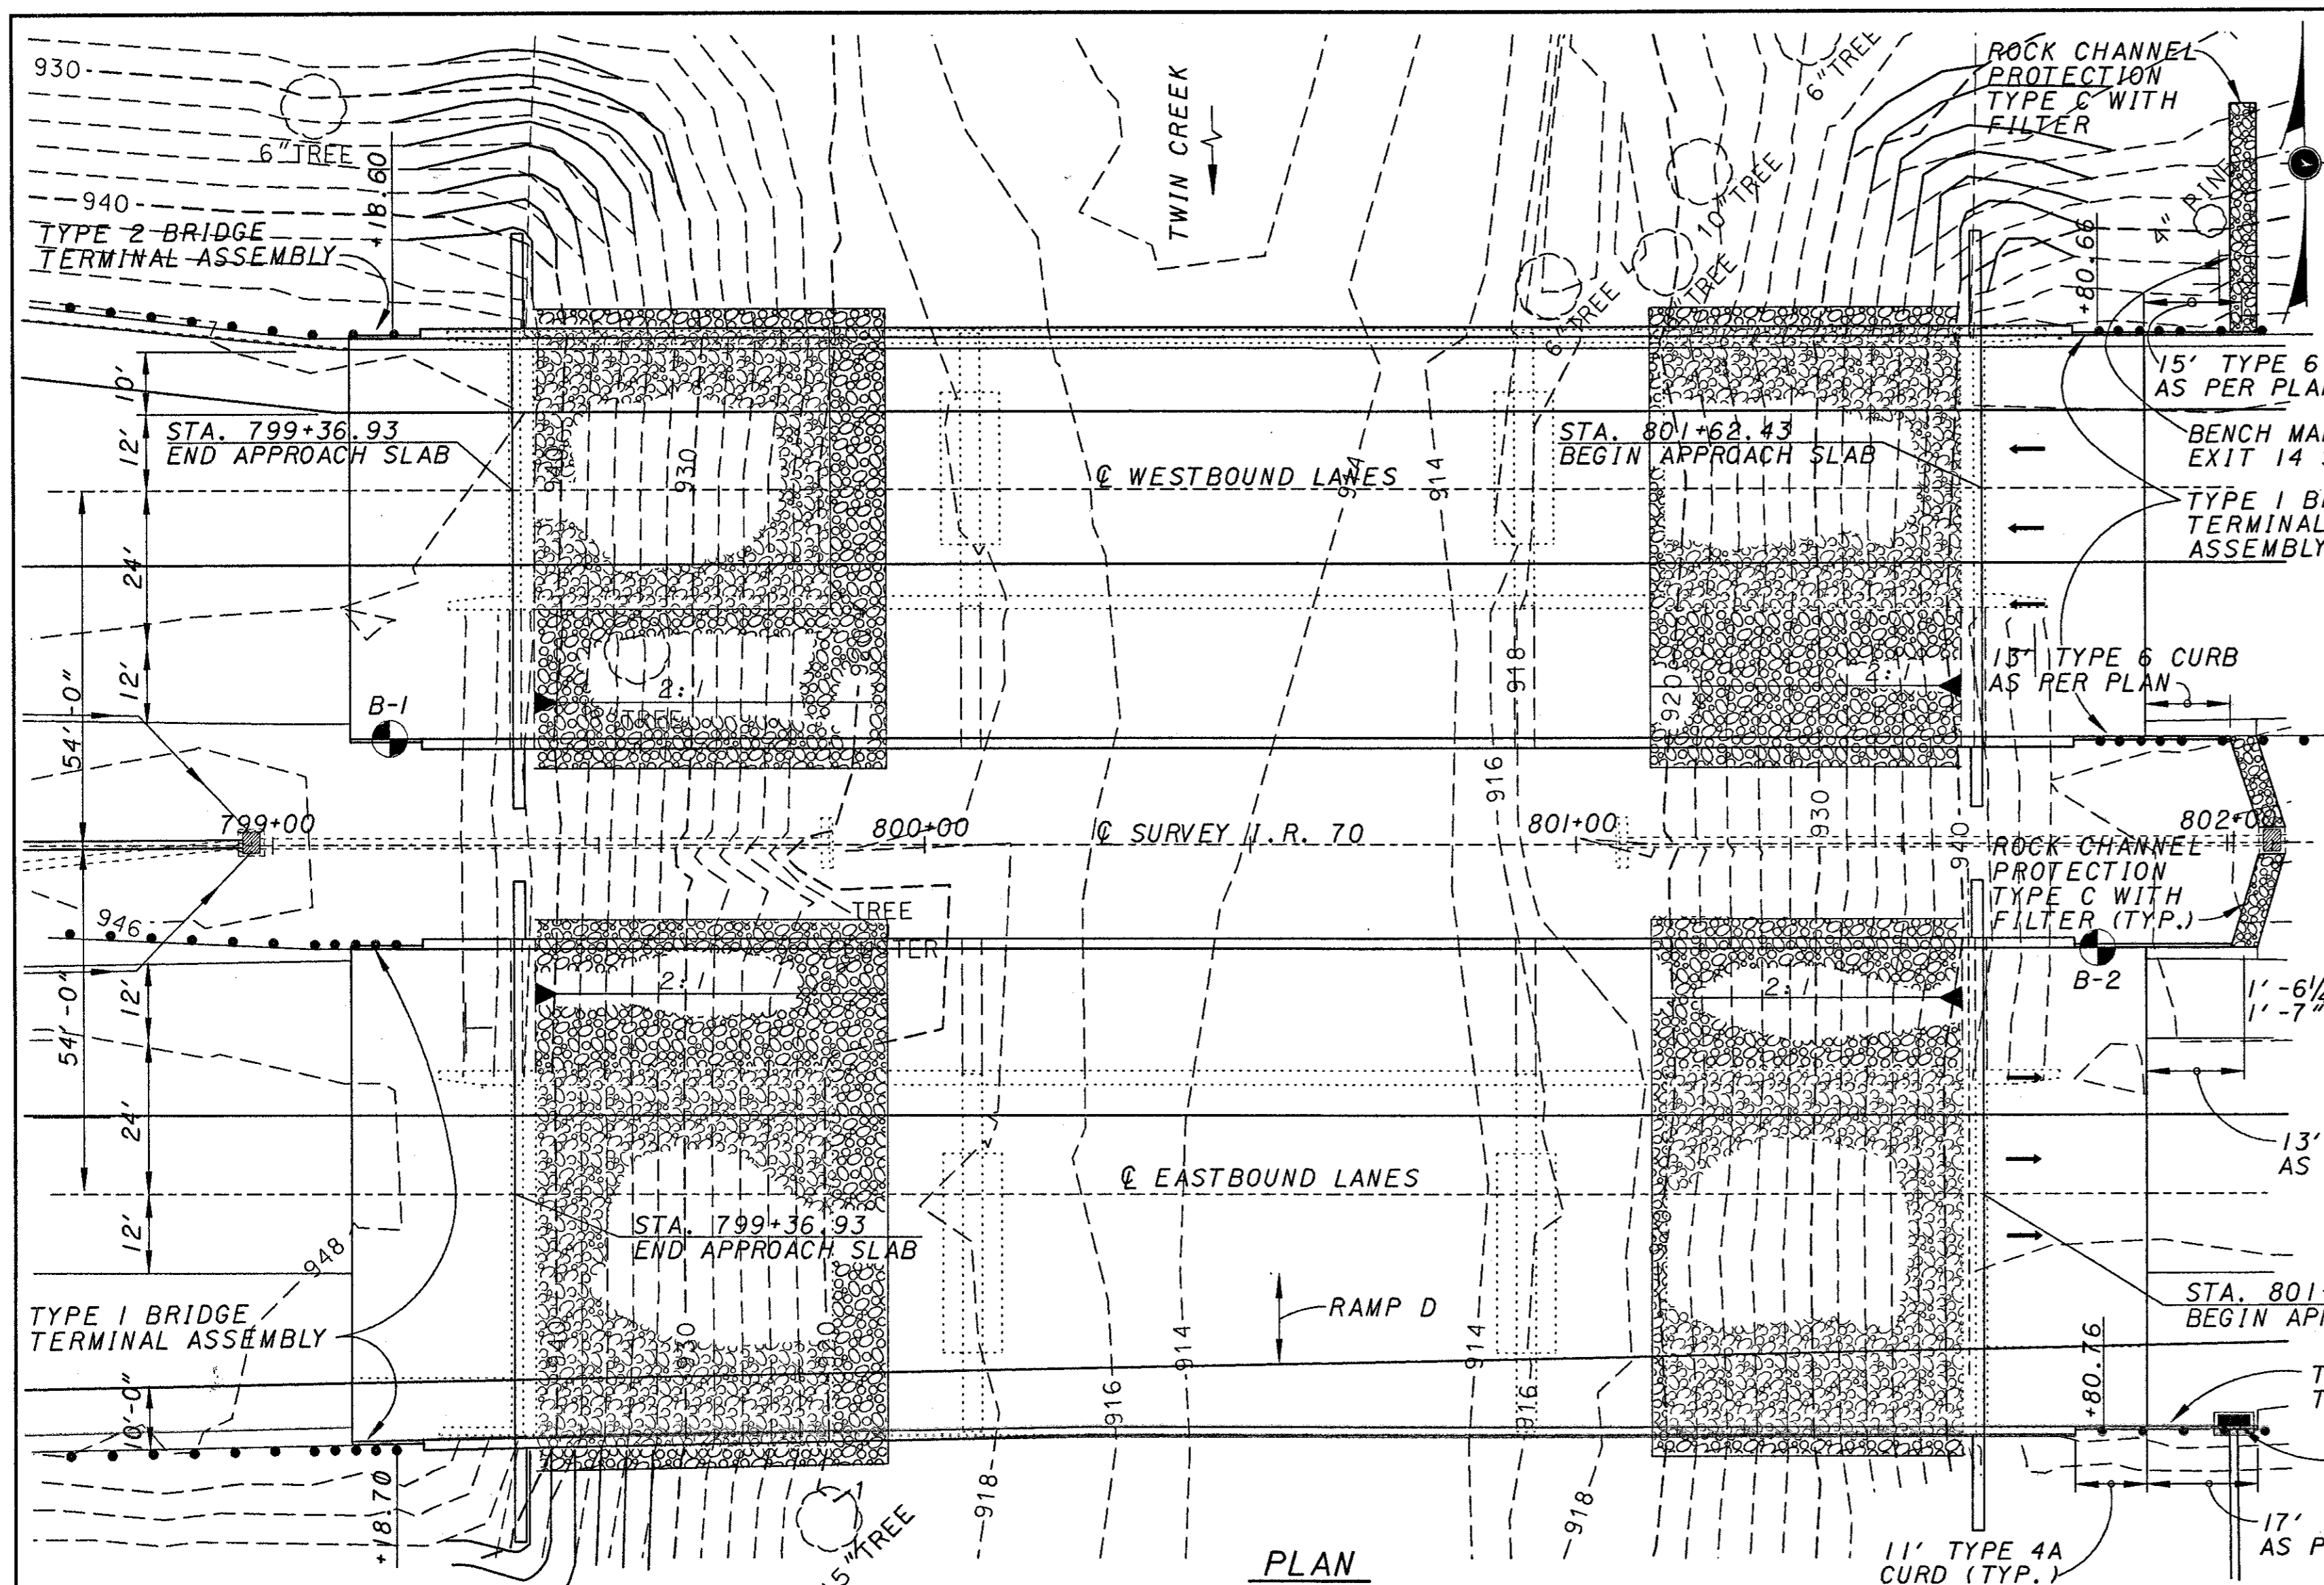


TRAFFIC DATA	
ADT (2001)	= 35,860
ADT (2021)	= 50,800
ADTT (2021)	= 19,812
SOURCE	= ODOT

BENCH MARK	
N.W. BOLT OF SOUTH SIGN	
POST AT STA. 802+01.75, 84' LT.	
AT EL. 946.28	
(EXIT 14 SIGN FOR S.R. 503)	

EXISTING STRUCTURE - I.R. 70	
TYPE: CONTINUOUS STEEL BEAM "PAINTED" WITH REINFORCED CONCRETE DECK, REINFORCED CONCRETE PIERS AND ABUTMENTS.	
LENGTH OF SPANS: 68'-0" ±, 85'-0" ±, 68'-0" ± MEASURED C/C BEARINGS	
ROADWAY WIDTH: 42'-0" ± F/F BARRIER (LT.) 54'-0" ± F/F BARRIER (RT.)	
DESIGN LOADING: C.F. 2000	
SKEW ANGLE: NONE	
SUPERELEVATION: NONE - NORMAL CROWN	
WEARING SURFACE: 1" MONOLITHIC CONCRETE	
ALIGNMENT: TANGENT	
YEAR BUILT: 1962	

PROPOSED STRUCTURE	
PROPOSED WORK: NEW COMPOSITE REINFORCED CONCRETE DECK WITH ADDITIONAL BEAMS ON WIDENED SUBSTRUCTURE	
TYPE: CONTINUOUS STEEL BEAM "A709-50 PAINTED" WITH COMPOSITE REINFORCED CONCRETE DECK, SEMI-INTEGRAL REINFORCED CONCRETE ABUTMENTS AND REINFORCED CONCRETE "T" TYPE PIERS.	
LENGTH OF SPANS: 68'-0" ±, 85'-0" ±, 68'-0" ± MEASURED C/C BEARINGS	
ROADWAY WIDTH: 62'-0" (LT.) & 72'-9" (RT.) TOE/TOE BARRIER	
DESIGN LOADING: HS-20 WITH ALTERNATE MILITARY LOADING, CASE 1	
SKEW ANGLE: NONE	
SUPERELEVATION: NONE - NORMAL CROWN	
WEARING SURFACE: 1" MONOLITHIC CONCRETE	
APPROACH SLAB: AS-1-81 (25' LONG)	
ALIGNMENT: TANGENT	
LATITUDE: N 39°50'15"	
LONGITUDE: W 84°33'45"	

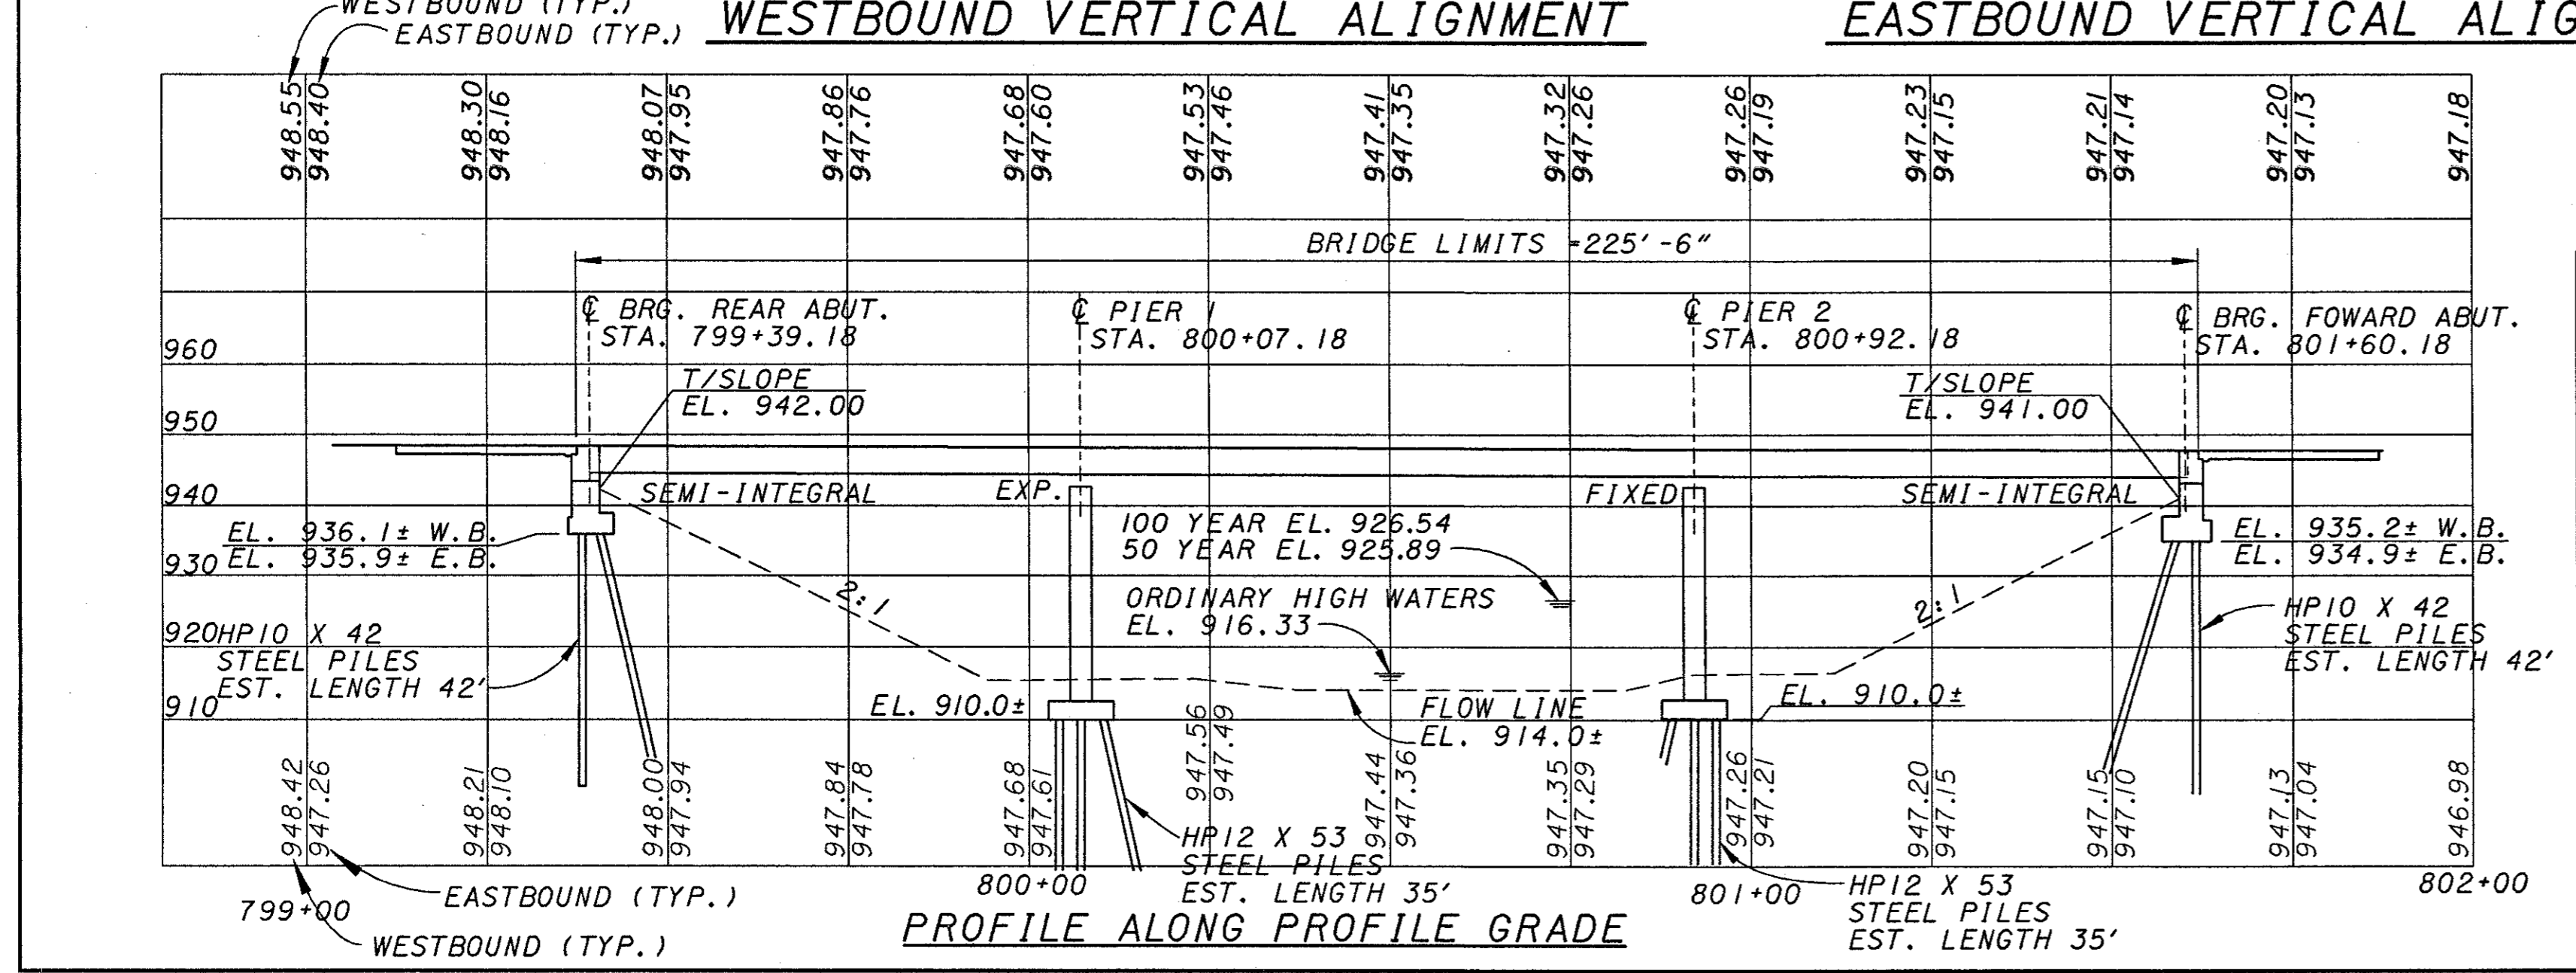

DRAINAGE DATA	
DRAINAGE AREA	: 96.0 SQ. MILES
EXISTING BRIDGE OPENING	: 4890 Sq. Ft.
PROPOSED BRIDGE OPENING	: 4890 Sq. Ft.
HW100	: 926.54
HW50	: 925.89
Q100	: 14,500 C.F.S.
Q50	: 12,900 C.F.S.
V100	: 10.6 F.P.S.
V50	: 10.2 F.P.S.
LOW CHORD ELEVATION	: 942.83
TOP OF DECK ELEVATION	: 946.76 TO 948.24

KZF DESIGN
 DESIGN AGENCY
 10000 N. 100th Ave., Suite 1000
 Greenwood Village, CO 80120
 TEL: 303.881.8811 FAX: 303.881.8800 WEB: www.kzfdesign.com

DATE: 11/20/00
 REVIEWED: DCK
 DRAWN: JDC
 DESIGNED: SJA
 CHECKED: WBS

PREBLE COUNTY
 STA 799+36.93
 STA 801+62.43

SITE PLAN
 BRIDGE NO. PRE-70-1500 L/R
 I.R. 70 OVER TWIN CREEK

PRE-70-0.00
 1/32
 228
 283



REF: 11/20/00
REF: 11/20/00
USER: JLM
PROJECT: PRE-70-0.00
PROF: JLM
DATE: 11/20/00
ACTIVE LEVELS ON: PRE-70-0.00

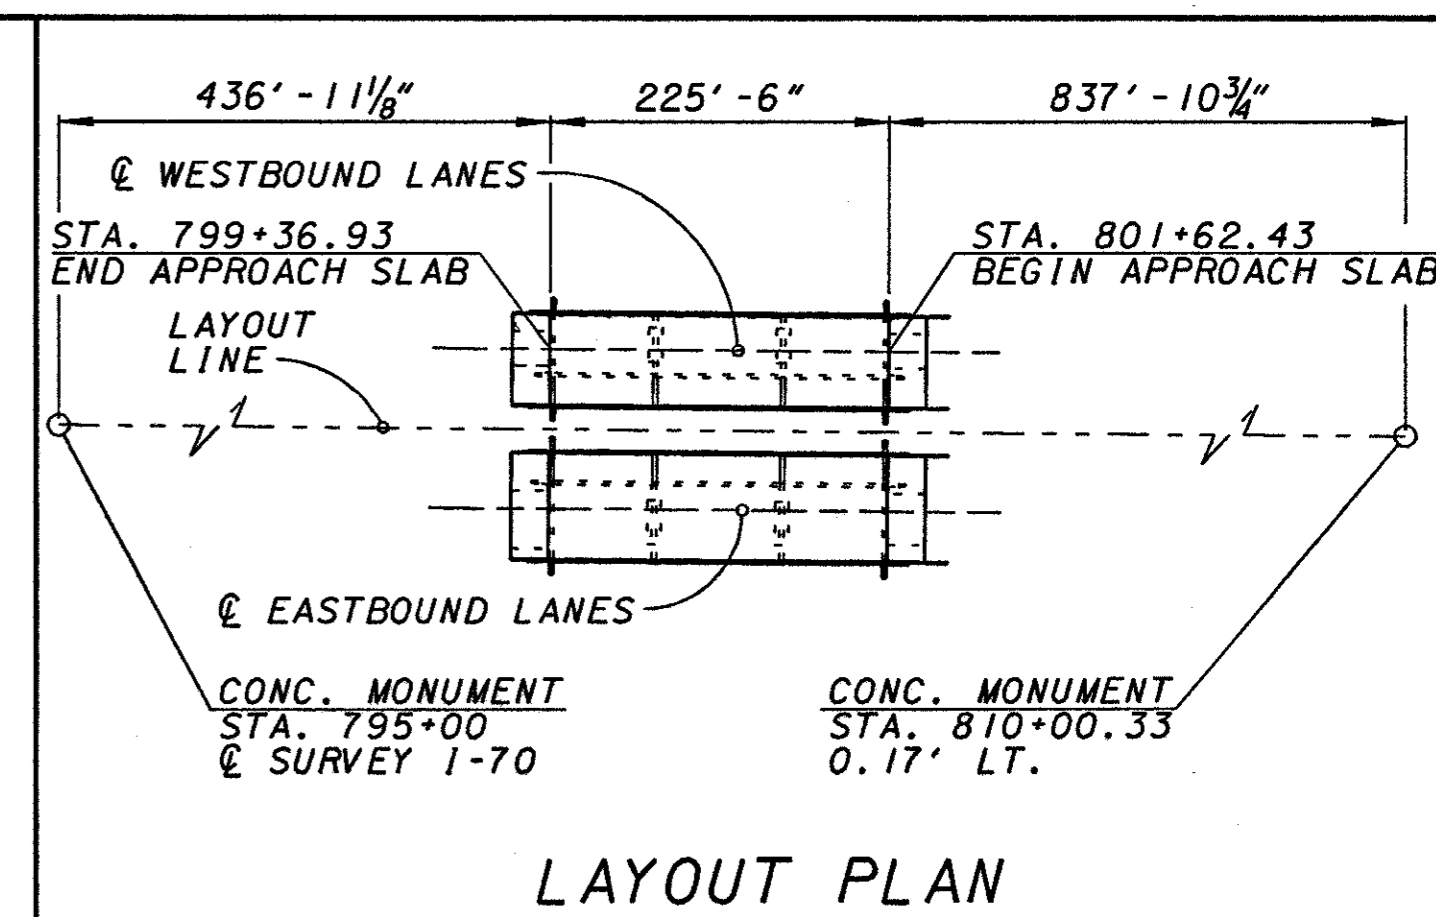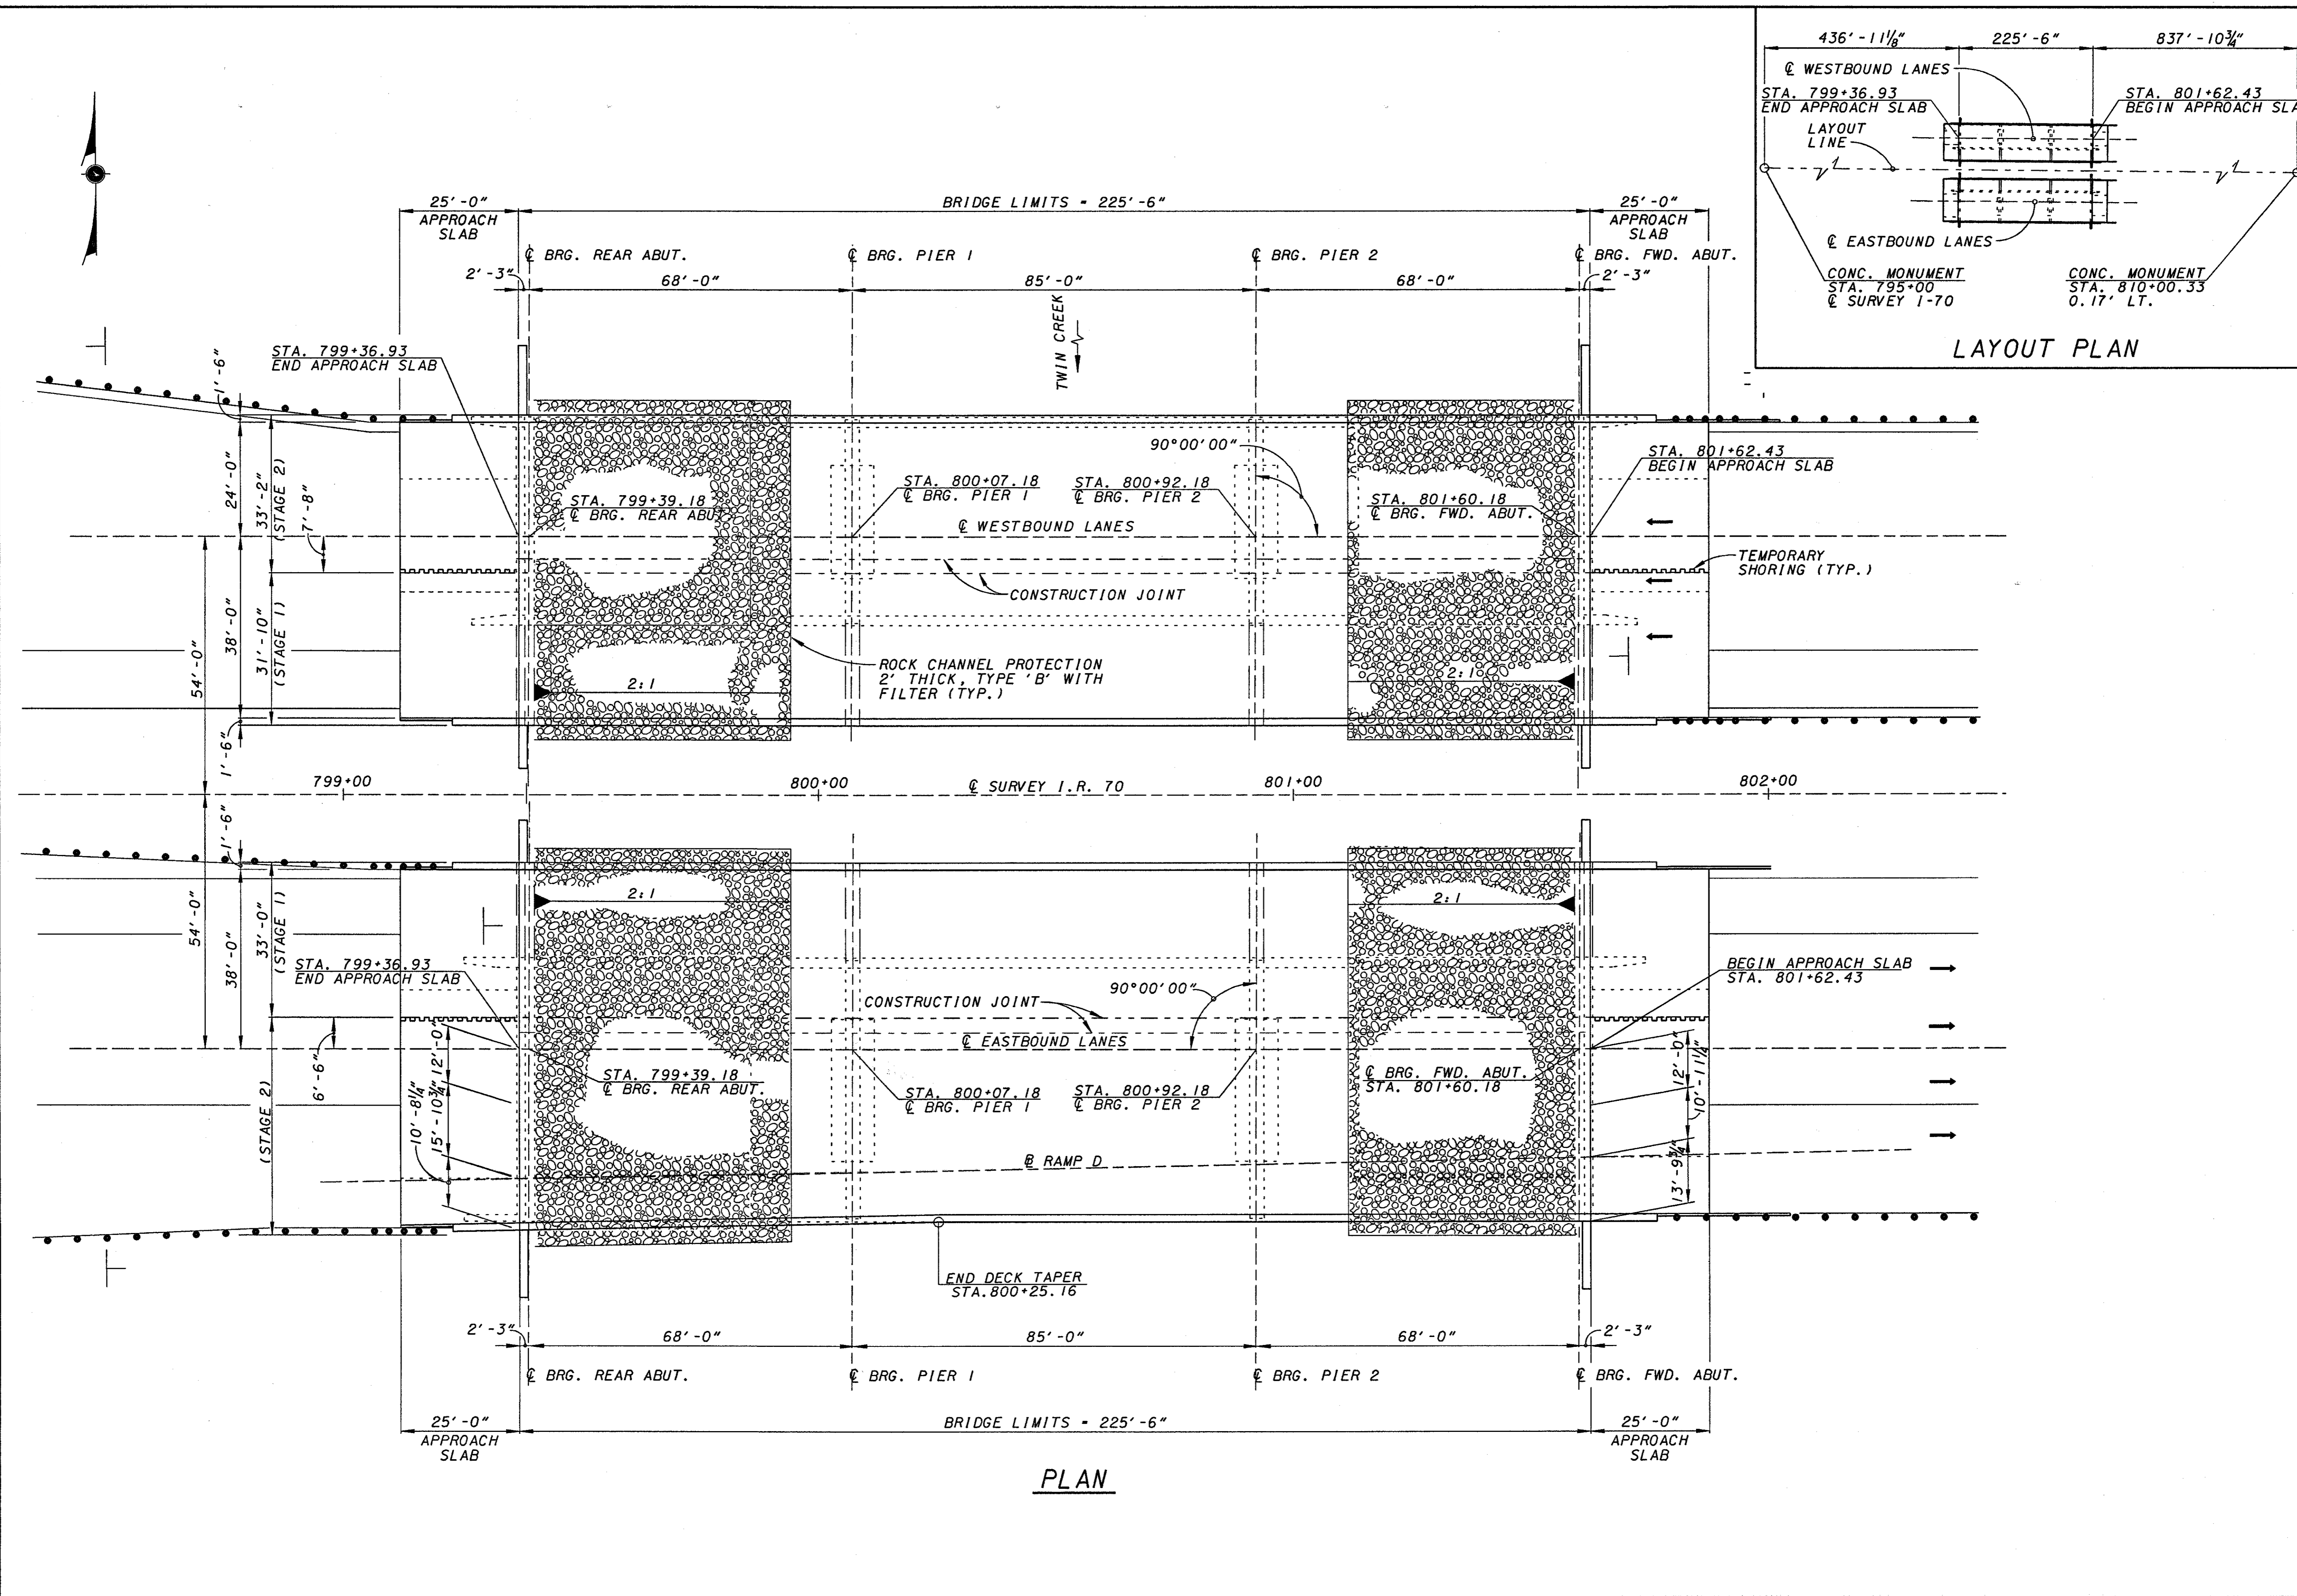

PLAN

KZF DESIGN
Architectural | Engineering | Planning
TEL: 680.147.1501 FAX: 680.147.1501

DESIGNED: KZF #17
DATE: 11/20/00
REVIEWED: DGK
DRAWN: JDG
CHECKED: WBS
STRUCTURE FILE NUMBER: 680147176801501

GENERAL PLAN
BRIDGE NO. PRE-70-1500 L/R
I.R. 70 OVER TWIN CREEK

PRE-70-0.00

2/32

229
283

REFERENCE: SHALL BE MADE TO STANDARD DRAWINGS :

AS-1-81 REVISED 09-15-94 (SHEETS 1,2 & 3)
 BR-1 REVISED 1-6-99
 BS-1-93 DATED 12-19-94
 GSD-1-96M DATED 11-21-97
 RB-1-55 REVISED 2-2-59
 SICD-1-96M DATED 2-12-97

AND TO SUPPLEMENTAL SPECIFICATION:

815 DATED 5/30/96
 816 DATED 4/21/97
 842 DATED 1/6/99
 846 DATED 9/9/97
 899 DATED 10/21/98
 910 DATED 7/28/98
 911 DATED 7/10/97
 954 DATED 9/9/97

DESIGN SPECIFICATIONS: THIS STRUCTURE CONFORMS TO "STANDARD SPECIFICATIONS FOR HIGHWAY BRIDGES" ADOPTED BY THE AMERICAN ASSOCIATION OF STATE HIGHWAY AND TRANSPORTATION OFFICIALS, 1996, INCLUDING THE 1997, 1998 AND 1999 INTERIM SPECIFICATIONS AND THE ODOT BRIDGE DESIGN MANUAL.

DESIGN LOADING: HS20-44, CASE 1 AND THE ALTERNATE MILITARY LOADING.

DESIGN STRESSES:

CLASS S CONCRETE - COMPRESSIVE STRENGTH 4500 PSI (28-DAY) (SUPERSTRUCTURE)
 CLASS C CONCRETE - COMPRESSIVE STRENGTH 4000 PSI (28-DAY) (SUBSTRUCTURE)
 STRUCTURAL STEEL - ASTM A572/A709 GRADE 50 - YIELD STRENGTH 50,000 PSI
 REINFORCING STEEL - ASTM A615, A616 OR A617. EPOXY COATED GRADE 60 - MINIMUM YIELD STRENGTH 60,000 PSI.

DECK PROTECTION METHOD: EPOXY COATED REINFORCING STEEL, SEALING OF CONCRETE SURFACES, CLASS S CONCRETE AND 2 1/2" CONCRETE COVER.

MONOLITHIC WEARING SURFACE: IS ASSUMED, FOR DESIGN PURPOSES, TO BE 1" THICK.

REINFORCING BAR SPLICES: REINFORCING BAR SPLICE LENGTHS SHALL CONFORM TO THE MINIMUM LENGTHS SPECIFIED BY 509.08 OF THE C.M.S. UNLESS OTHERWISE NOTED ON THE PLANS.

UTILITY LINES: ALL EXPENSE INVOLVED IN RELOCATION OF THE AFFECTED UTILITY LINES SHALL BE BORNE BY THE UTILITY. THE CONTRACTOR AND UTILITY ARE TO COOPERATE BY ARRANGING THEIR WORK IN SUCH A MANNER THAT INCONVENIENCE TO EITHER WILL BE HELD TO A MINIMUM.

PROPOSED WORK

1. CONSTRUCT NEW MEDIAN PIERS.
2. REINFORCE OF EXISTING PIERS.
3. REMOVE EXISTING CONCRETE DECK, PARAPETS, SCUPPERS, APPROACH SLABS AND PORTIONS OF CONCRETE SUBSTRUCTURES IN A SEQUENCE CONSISTENT WITH MAINTENANCE OF TRAFFIC PLANS AND NOTES AND STAGE CONSTRUCTION.
4. INSTALL PILING AND CONSTRUCT ABUTMENT WIDENING.
5. INSTALL NEW BEAMS AND CONSTRUCT A NEW CONCRETE DECK AT ELEVATIONS TO MEET PROPOSED OVERLAY ON EXISTING ROADWAY APPROACHES.
6. CONSTRUCT NEW CONCRETE APPROACH SLABS.
7. CONSTRUCT NEW CONCRETE BARRIERS ON DECK AND APPROACH SLABS.
8. PATCH CONCRETE SUBSTRUCTURES AS DIRECTED.
9. CLEAN AND SEAL CONCRETE BARRIERS, ABUTMENTS AND PIERS.
10. PAINT EXISTING STRUCTURAL STEEL WITH SYSTEM OZEU.
11. PAINT NEW STRUCTURAL STEEL WITH SYSTEM IZEU.

PILE DESIGN LOADS

THE ULTIMATE BEARING VALUE IS 98 TONS PER PILE FOR THE ABUTMENT PILES. THE ULTIMATE BEARING VALUE IS 124 TONS PER PILE FOR THE PIER PILES. THE PIER PILES INCLUDE AN ADDITIONAL 28 TONS PER PILE OF ULTIMATE BEARING VALUE DUE TO THE POSSIBILITY OF LOSING FRICTIONAL RESISTANCE DUE TO SCOUR.

ITEM 202 - PORTIONS OF STRUCTURE REMOVED, AS PER PLAN

DESCRIPTION: THIS WORK SHALL CONSIST OF THE REMOVAL OF CONCRETE DECKS INCLUDING PARAPETS AND OTHER APPURTENANCES FROM STEEL SUPPORTING SYSTEMS. PORTIONS OF THE ABUTMENTS SHALL ALSO BE REMOVED AS SHOWN ON THE PLANS. CARE SHALL BE TAKEN DURING REMOVALS TO PROTECT PORTIONS OF THE EXISTING STRUCTURE THAT ARE TO BE SALVAGED AND INCORPORATED INTO THE PROPOSED STRUCTURE. IN THIS RESPECT, THE USE OF EXPLOSIVES, HEADACHE BALLS AND/OR HOE-RAM TYPE OF EQUIPMENT IS PROHIBITED. ALL REMOVALS SHALL BE CONSISTENT WITH THE STAGE CONSTRUCTION REQUIREMENTS. EVERY EFFORT SHALL BE MADE TO KEEP DECK MATERIALS OUT OF THE STREAM CHANNEL. IF ANY MATERIAL FALLS INTO THE WATER, THE MATERIAL SHALL BE REMOVED IMMEDIATELY. ALL CONSTRUCTION DEBRIS AND OR EXCESS FILL MATERIAL SHALL BE DISPOSED AT AN ENGINEER APPROVED UPLAND SITE. (A DISPOSAL SITE LOCATED ABOVE THE 100-YEAR FLOOD PLAIN.) ALL WORK SHALL BE PERFORMED TO THE SATISFACTION OF THE ENGINEER.

PROTECTION OF TRAFFIC: PRIOR TO DEMOLITION OF ANY PORTIONS OF THE EXISTING SUPERSTRUCTURE, THE CONTRACTOR SHALL SUBMIT HIS PLANS FOR THE PROTECTION OF TRAFFIC (VEHICULAR, BOAT, ETC.) ADJACENT TO AND/OR UNDER THE STRUCTURE TO THE DIRECTOR FOR APPROVAL. THESE PLANS SHALL INCLUDE PROVISIONS FOR ANY DEVICES AND STRUCTURES THAT MAY BE NECESSARY TO ENSURE SUCH PROTECTION. TEMPORARY VERTICAL CLEARANCES SPECIFIED ON THE PLANS OR IN THE PROPOSAL SHALL BE MAINTAINED AT ALL TIMES EXCEPT AS OTHERWISE APPROVED BY THE DIRECTOR.

PROTECTION OF STEEL SUPPORT SYSTEMS: BEFORE DECK SLAB CUTTING IS PERMITTED, THE OUTLINE OF PRIMARY STEEL MEMBERS IN CONTACT WITH THE BOTTOM OF THE DECK SHALL BE DRAWN ON THE SURFACE OF DECK. SMALL DIAMETER PILOT HOLES SHALL BE DRILLED 2 INCHES OUTSIDE THESE LINES TO CONFIRM THE LOCATION OF FLANGE EDGES. DECK CUTS OVER OR WITHIN 2 INCHES OF FLANGE EDGES SHALL NOT EXTEND LOWER THAN THE BOTTOM LAYER OF DECK SLAB REINFORCING STEEL. CUTS MADE OUTSIDE 2 INCHES OF FLANGE EDGES MAY EXTEND THE FULL DEPTH OF THE DECK. DURING CUTTING OF THE DECK SLAB, CARE SHALL BE TAKEN NOT TO DAMAGE STEEL MEMBERS THAT ARE TO BE INCORPORATED INTO THE PROPOSED STRUCTURE.

REMOVAL METHODS: CONCRETE MAY BE REMOVED BY CUTTING AND BY MEANS OF HAND OPERATED PNEUMATIC HAMMERS EMPLOYING POINTED OR BLUNTED CHISEL TYPE TOOLS. FOR REMOVALS ABOVE STEEL MEMBERS, A HAMMER HEAVIER THAN 35 POUNDS BUT NOT TO EXCEED 90 POUNDS MAY BE USED AT THE APPROVAL OF THE ENGINEER. REMOVAL METHODS OVER BRIDGE MEMBERS SHALL ENSURE ADEQUATE DEPTH CONTROL AND PREVENT NICKING OR GOUGING THE PRIMARY STEEL MEMBERS.

SUBSTRUCTURE CONCRETE REMOVAL SHALL BE BY MEANS OF APPROVED PNEUMATIC HAMMERS EMPLOYING POINTED AND BLUNT CHISEL TOOLS. HYDRAULIC HOE-RAM TYPE HAMMERS WILL NOT BE PERMITTED. THE WEIGHT OF THE HAMMER SHALL NOT BE MORE THAN 35 POUNDS FOR REMOVAL WITHIN 18 INCHES OF PORTIONS TO BE PRESERVED. OUTSIDE THE 18 INCH LIMIT, A HAMMER HEAVIER THAN 35 POUNDS, BUT NOT TO EXCEED 90 POUNDS MAY BE USED AT THE APPROVAL OF THE ENGINEER. PNEUMATIC HAMMERS SHALL NOT BE PLACED IN DIRECT CONTACT WITH REINFORCING STEEL THAT IS TO BE RETAINED IN THE REBUILT STRUCTURE.

REPLACEMENT OF EXISTING REINFORCING STEEL: ANY EXISTING REINFORCING BARS WHICH ARE TO BE INCORPORATED INTO THE NEW WORK AND WHICH ARE MADE UNUSABLE BY THE CONTRACTOR'S CONCRETE REMOVAL OPERATIONS SHALL BE REPLACED WITH NEW STEEL AT HIS COST. ANY EXISTING REINFORCING BARS WHICH ARE DEEMED BY THE ENGINEER TO BE UNUSABLE BECAUSE OF CORROSION SHALL BE REPLACED WITH NEW REINFORCING STEEL.

EXISTING STRUCTURE VERIFICATION: DETAILS AND DIMENSIONS SHOWN ON THESE PLANS PERTAINING TO THE EXISTING STRUCTURE HAVE BEEN OBTAINED FROM PLANS OF THE EXISTING STRUCTURE AND/OR FROM FIELD OBSERVATIONS AND MEASUREMENTS. CONSEQUENTLY, THEY ARE INDICATIVE OF THE EXISTING STRUCTURE AND THE PROPOSED WORK BUT THEY SHALL BE CONSIDERED TENTATIVE AND APPROXIMATE. THE CONTRACTOR IS REFERED TO CMS SECTIONS 105.02 AND 513.02.

EXISTING STRUCTURE PLANS:

THE ORIGINAL DESIGN PLANS MAY BE EXAMINED AT THE DEPARTMENT OF TRANSPORTATION, DISTRICT 8 OFFICE, 505 SOUTH S.R. 741 LEBANON, OHIO 45036 (800) 831-2142. THE CONTRACTOR SHALL BECOME FAMILIAR WITH THESE DRAWINGS.

INSPECTION OF STRUCTURAL STEEL:

THE ENGINEER SHALL VISUALLY INSPECT ALL EXISTING BUTT-WELDED SPLICES AND/OR TOP FLANGE COVER PLATE FILLET WELDS TO ENSURE THAT THEY ARE FREE OF DEFECTS. THE DECK SLAB HAUNCH FORMS IMMEDIATELY ADJACENT TO SUCH WELDS SHALL NOT BE ERRECTED UNTIL THE ENGINEER HAS COMPLETED THIS INSPECTION. THIS INSPECTION SHALL NOT TAKE PLACE UNTIL AFTER THE TOP FLANGES ARE CLEANED AS SPECIFIED IN 511.08, BUT SHALL BE DONE BEFORE THE DECK SLAB REINFORCEMENT IS INSTALLED.

CUT LINE CONSTRUCTION JOINT PREPARATION: SAW CUT BOUNDARIES OF PROPOSED CONCRETE REMOVALS 1 INCH DEEP. REMOVE CONCRETE TO A ROUGH SURFACE. WHERE PRACTICABLE, THE EXISTING REINFORCING STEEL WHERE REQUIRED IN THE PLANS SHALL BE LEFT IN PLACE. INSTALL DOWEL BARS IF SPECIFIED. PRIOR TO CONCRETE PLACEMENT ABRASIVELY CLEAN JOINT SURFACE AND EXPOSED REINFORCEMENT TO REMOVE LOOSE AND DISINTEGRATED CONCRETE AND LOOSE RUST. THE JOINT SURFACE AND EXPOSED REINFORCEMENT SHALL BE THOROUGHLY CLEANED OF ALL DIRT, DUST, OR OTHER FOREIGN MATERIAL BY THE USE OF WATER, AIR UNDER PRESSURE, OR OTHER METHODS THAT PRODUCE SATISFACTORY RESULTS. CONCRETE BONDING SURFACES SHALL BE WET WITHOUT FREE WATER AS CONCRETE IS PLACED.

EXTRANEIOUS MEMBERS: EXISTING EXTRANEIOUS MEMBERS (I.E., FINISHING MACHINE AND FORM SUPPORTS, ETC.), AND THE SUPPORT FOR SCUPPERS AND BULB ANGLES WHICH ARE TO BE REMOVED) ATTACHED BY WELDED CONNECTIONS TO PORTIONS OF THE TOP FLANGES DESIGNATED "TENSION" SHALL BE REMOVED AND THE FLANGE SURFACES GROUND SMOOTH. GRINDING SHALL BE CAREFULLY DONE AND PARALLEL TO THE FLANGES.

DECK REMOVALS: DUE TO THE POSSIBLE PRESENCE OF WELDED ATTACHMENTS TO EXISTING STRUCTURAL STEEL (FINISHING MACHINE, SCUPPER AND FORM SUPPORTS, ETC.), CARE SHALL BE TAKEN DURING DECK REMOVAL TO AVOID DAMAGING STRINGERS WHICH ARE TO REMAIN. STRINGERS DAMAGED BY THE CONTRACTOR'S REMOVAL OPERATIONS SHALL, AT NO COST TO THE PROJECT, BE REPLACED OR REPAIRED. PROPOSED REPAIRS, DEVELOPED BY A REGISTERED PROFESSIONAL ENGINEER, SHALL BE SUBMITTED IN WRITING FOR REVIEW AND APPROVAL BY THE DIRECTOR.

MECHANICAL CONNECTORS: AN APPROVED MECHANICAL CONNECTOR FOR REINFORCING BARS SHALL BE PROVIDED. INSTALLATION OF CONNECTORS SHALL CONFORM WITH MANUFACTURER'S RECOMMENDED PROCEDURES. CONNECTORS AND DOWEL BARS USED WITH EPOXY COATED BARS SHALL BE EPOXY COATED. COATING FOR BOTH CONNECTORS AND BARS SHALL CONFORM TO THE SAME SPECIFICATION. COATINGS WHICH HAVE BEEN DAMAGED OR WHICH OTHERWISE DO NOT MEET SPECIFICATIONS WITH RESPECT TO COLOR, CONTINUITY, AND UNIFORMITY MAY BE REPAIRED AS DIRECTED BY THE ENGINEER OR THEY SHALL BE REPLACED WITH MATERIAL WHICH MEET THE SPECIFICATIONS. MECHANICAL CONNECTORS AND DOWEL BAR EXTENSIONS SHALL CONFORM WITH ITEM 509 AND BE INCLUDED IN THE BID PRICE PER CUBIC YARD FOR ITEMS 842 AND 844.

REF: AS-1-81
 REF: BR-1
 REF: BS-1-93
 REF: GSD-1-96M
 REF: RB-1-55
 REF: SICD-1-96M
 REF: 815
 REF: 816
 REF: 842
 REF: 846
 REF: 899
 REF: 910
 REF: 911
 REF: 954
 REF: DESIGN SPECIFICATIONS
 REF: DESIGN LOADING
 REF: DESIGN STRESSES
 REF: DECK PROTECTION METHOD
 REF: MONOLITHIC WEARING SURFACE
 REF: REINFORCING BAR SPLICES
 REF: UTILITY LINES
 REF: PROPOSED WORK
 REF: PILE DESIGN LOADS
 REF: ITEM 202 - PORTIONS OF STRUCTURE REMOVED, AS PER PLAN
 REF: PROTECTION OF TRAFFIC
 REF: PROTECTION OF STEEL SUPPORT SYSTEMS
 REF: REMOVAL METHODS
 REF: SUBSTRUCTURE CONCRETE REMOVAL
 REF: REPLACEMENT OF EXISTING REINFORCING STEEL
 REF: EXISTING STRUCTURE VERIFICATION
 REF: EXISTING STRUCTURE PLANS
 REF: INSPECTION OF STRUCTURAL STEEL
 REF: CUT LINE CONSTRUCTION JOINT PREPARATION
 REF: EXTRANEIOUS MEMBERS
 REF: DECK REMOVALS
 REF: MECHANICAL CONNECTORS



DESIGNED	SJA	CHECKED	WBS
DRAWN	JDG	REVIEWED	DGK
DATE	11/20/00	STRUCTURE FILE NUMBER	6801471/6601501

KZF #17

GENERAL NOTES
 BRIDGE NO. PRE-70-1500 L/R
 I.R. 70 OVER TWIN CREEK

PRE-70-0.00

ROCK CHANNEL PROTECTION

BROKEN CONCRETE FROM THE EXISTING BRIDGE DECK MAY BE USED FOR ROCK CHANNEL PROTECTION. MATERIAL CAN BE EITHER TYPE B OR TYPE C WITH A MINIMUM OF 50% OF THE MATERIAL BEING TYPE B.

SEAL PIER CAPS, WINGWALLS, ABUTMENTS, PARAPETS, AND DECK EDGES WITH EPOXY-URETHANE. COLOR SHALL BE FEDERAL COLOR STANDARD 17778 (OFF-WHITE)

THIS WORK SHALL CONSIST OF FURNISHING ALL NECESSARY LABOR, MATERIALS AND EQUIPMENT TO SEAL THE DESIGNATED EXPOSED CONCRETE SURFACE AREAS IN ACCORDANCE WITH THE PROJECT PROPOSAL DOCUMENT (PAGE 30) ENTITLED, ITEM SPECIAL - SEALING OF CONCRETE SURFACES

PATCH SUBSTRUCTURE CONCRETE

PATCHING SUBSTRUCTURE CONCRETE SHALL BE PERFORMED IN ACCORDANCE WITH THE STATE OF OHIO DEPARTMENT OF TRANSPORTATION CONSTRUCTION AND MATERIAL SPECIFICATIONS ITEM 519 PATCHING CONCRETE STRUCTURES. THE LOCATION AND SURFACE AREA EXTENT OF PATCHING CONCRETE STRUCTURES SHALL BE FIELD-DETERMINED BY THE ODOT PROJECT ENGINEER. THE CONTRACTOR SHALL PROVIDE THE PROJECT ENGINEER ACCESS TO CONCRETE SURFACES FOR INSPECTION. THE CONTRACTOR SHALL PROVIDE THE ENGINEER AEROSOL PAINT FOR THE PURPOSE OF MARKING SUBSTRUCTURE CONCRETE TO BE PATCHED.

ITEM 846 - TREATING CONCRETE WITH HMW RESIN

SEAL THE CONSTRUCTION JOINTS IN THE BRIDGE DECK AND APPROACH SLABS AS SHOWN IN THE PLANS. SEE SUPPLEMENTAL SPECIFICATIONS FOR SURFACE PREPARATION AND RATE OF APPLICATION.

REINFORCING CLEARANCE: UNLESS OTHERWISE NOTED, MINIMUM REINFORCING STEEL CLEARANCE TO FACE OF CONCRETE IS 2".

LOADING LIMITATION: NO PART OF THE STRUCTURE SHALL BE SUBJECTED TO UNIT STRESSES THAT EXCEED 136.5% OF THE ALLOWABLE UNIT STRESSES GIVEN IN THE AASHTO STANDARD SPECIFICATIONS FOR HIGHWAY BRIDGES DUE EITHER TO DEMOLITION, ERECTION OR CONSTRUCTION METHODS, OR TO THE USE OR MOVEMENT OF DEMOLITION OR ERECTION EQUIPMENT ON OR ACROSS THE STRUCTURE. STRUCTURAL ANALYSIS COMPUTATIONS, BY A REGISTERED PROFESSIONAL ENGINEER, SHOWING THE ALLOWABLE STRESSES AND THE MAXIMUM STRESSES PRODUCED BY THE CONTRACTOR'S METHODS OR EQUIPMENT SHALL BE SUBMITTED TO THE DIRECTOR FOR REVIEW AND APPROVAL AT LEAST TWO WEEKS PRIOR TO THE START OF THE WORK.

ENVIRONMENTAL COMMITMENTS & RESOURCES TO BE AVOIDED

THE CONTRACTOR SHALL REFER TO THE STORMWATER POLLUTION PREVENTION PLAN (SWAPP) TO ADDRESS EROSION ASSOCIATED WITH SHOULDER DISTURBANCE/ RECONSTRUCTION AND BRIDGE WORK. (CMS 877.03)

ALL CONDITIONS ATTACHED WITH C.O.E. PERMIT (NATIONWIDE 3 & 14) SHALL BE IMPLEMENTED IN THE FIELD WITH THE ACTUAL PERMIT BEING DISPLAYED ONSITE.

EVERY EFFORT SHALL BE MADE TO KEEP DEMOLITION MATERIAL OUT OF THE STREAM CHANNELS. IF ANY MATERIAL FALLS INTO THE WATER, IT SHALL BE REMOVED IMMEDIATELY. ALL DEBRIS OR EXCESS FILL MATERIAL SHOULD BE DISPOSED AT AN APPROVED UPLAND SITE. (ABOVE THE 100 YR. FLOODPLAIN)

IN-STREAM STRUCTURES SHALL BE KEPT TO THE MINIMAL SIZE NEEDED TO FACILITATE WORK AND WILL BE REMOVED IMMEDIATELY TO ORIGINAL GRADE AFTER IN-STREAM WORK IS COMPLETED.

WHILE PAINTING, SANDBLASTING OR SEALING OF ANY PORTION OF THE BRIDGE AN APPROPRIATE APRON WILL BE UTILIZED TO PREVENT DEBRIS AND PAINT OVERSPRAY AND SEALANTS FROM ENTERING INTO THE STREAM.

PROPER SEDIMENT AND EROSION CONTROLS SHALL BE IMPLEMENTED THROUGHOUT THE COURSE OF THE PROJECT. ALL DISTURBED AREAS SHALL BE SEEDED AND MULCHED IMMEDIATELY UPON COMPLETION OF EARTHWORK (ODOT CMS ITEM 877)

IMPLEMENT ODOT CMS ITEM 616, DUST CONTROL AS NECESSARY.

COMPLY WITH ODOT CMS ITEM 107.21 CONTROLLING POLLUTION OF THE ENVIRONMENT.

VEGETATION REMOVAL WILL BE HELD TO AN ABSOLUTE MINIMUM REQUIRED TO COMPLETE THE WORK.

WETLANDS EXIST WITHIN THE PROJECT AREA. ALL WETLANDS NOT DIRECTLY INVOLVED WITH BRIDGE DECK/SUBSTRUCTURE MODIFICATIONS SHALL BE AVOIDED. THE BRIDGE SITE PLANS SHOW WETLAND AREAS TO BE AVOIDED.

CLASS 'C' CONCRETE, ABUTMENT:

GENERAL PURPOSE HEAVY DUTY NEOPRENE SHEET WITH NYLON FABRIC REINFORCEMENT AT ABUTMENTS SHALL BE INSTALLED IN ACCORDANCE WITH STANDARD DRAWING SICD-9-96M

ITEM 516 - JACKING AND TEMPORARY SUPPORT OF SUPERSTRUCTURE, AS PER PLAN

THIS ITEM SHALL CONSIST OF FURNISHING ALL NECESSARY LABOR, MATERIALS AND ALL EQUIPMENT TO RAISE OR REPOSITION ANY EXISTING STRUCTURES TO THE DIMENSIONS AND REQUIREMENTS DEFINED IN THE PROJECT PLANS

JACKING SUBMITTALS SHALL INCLUDE AT LEAST THE FOLLOWING:

- 1. THE SIGNATURE AND NUMBER, OR PROFESSIONAL SEAL, OF THE OHIO REGISTERED PROFESSIONAL ENGINEER WHO PREPARED THE SUBMITTAL.
2. CALCULATIONS AND ANALYSIS OF THE STRUCTURE TO DETERMINE AND DEFINE THE ACTUAL LOADING APPLIED AT THE CONTRACTOR'S SELECTION JACKING POINTS.
3. A DRAWING SHOWING THE PHYSICAL AND DIMENSIONAL POSITION OF THE JACKS WITH RESPECT TO THE STRUCTURE INCLUDING CLEARANCES AND CENTER OF LIFT.
4. A SCHEMATIC LAYOUT OF JACKS, CHECK VALVES, PUMPS WITH 3 WAY REACTOR VALVE, PRESSURE GAGES, FLOW CONTROL VALVES, ETC. IN ACCORDANCE WITH MANUFACTURER'S RECOMMENDATIONS. ALL JACKS FOR EACH ABUTMENT OR PIER SHALL BE CONNECTED TOGETHER. ALL JACKS AT EACH ABUTMENT OR PIER SHALL BE THE SAME SIZE.
5. ANALYSIS AND CALCULATIONS OF THE STRESSES INDUCED OR CREATED IN THE STRUCTURE AND ANY TEMPORARY OR PERMANENT SUPPORTS. DESIGN CALCULATIONS FOR ANY TEMPORARY OR PERMANENT SUPPORTS.
6. PHYSICAL DIMENSIONS, MATERIALS, AND FABRICATION DETAILS OF ANY TEMPORARY OR PERMANENT SUPPORTS. HORIZONTAL AND VERTICAL MOVEMENT RESTRAINT SHALL BE PROVIDED.
7. A STEP BY STEP PROCEDURE DETAILING ALL STEPS IN THE JACKING OPERATION.
8. METHOD OF ATTACHMENT TO STRUCTURAL MEMBERS. WELDING TO TENSION AREAS WILL NOT BE PERMITTED.

THE ENTIRE SYSTEM INCLUDING JACKS SHALL HAVE 20% MORE CAPACITY THAN REQUIRED BASED ON CALCULATED LOADS. FOR LIFTS GREATER THAN 1 INCH, JACKS SHALL HAVE LOCKING NUTS TO POSITIVELY LOCK AND SUPPORT THE STRUCTURE DURING THE LIFT.

JACKS SHALL HAVE A SWIVEL LOAD CAP, A DOMED PISTON HEAD OR SOME OTHER DEVICE TO PROTECT AGAINST THE EFFECTS OF SIDE LOAD ON THE JACK.

JACKS ALONE SHALL NOT BE USED TO SUPPORT LOADS EXCEPT DURING THE ACTUAL JACKING OPERATION. TEMPORARY SUPPORTS, BLOCKING OR OTHER METHODS APPROVED BY THE DIRECTOR SHALL BE USED.

SINGLE ACTING RAMS WITH NO OVER-TRAVEL PROTECTION SYSTEM SHALL NOT BE USED.

SPARE EQUIPMENT SHALL BE AVAILABLE ON SITE FOR THE REQUIRED STRUCTURE RAISING TO PROCEED IN THE EVENT OF A BREAKDOWN. A LIST OF SPARE EQUIPMENT SHALL BE PROVIDED TO THE ENGINEER.

AT A MINIMUM, A JACKING OPERATION SHALL LIFT ALL BEAMS AT ANY ONE ABUTMENT OR PIER SIMULTANEOUSLY. THE ONLY EXCEPTION IS THE SITUATION WHERE THE WORK INVOLVES REPLACING OR REHABILITATING INDIVIDUAL BEARINGS, NO PERMANENT SHIMMING IS REQUIRED AND THE HEIGHT OF THE LIFT SHALL NOT EXCEED 1/4 INCH.

MAXIMUM DIFFERENTIAL JACKING HEIGHT BETWEEN ANY ADJACENT ABUTMENTS OR PIERS SHALL BE 1 INCH OR LESS.

IF, DURING THE JACKING OPERATIONS, CRACKING OF THE CONCRETE SUPERSTRUCTURE, SEPARATION OF THE CONCRETE DECK FROM THE STEEL STRINGERS, OR OTHER DAMAGE TO THE STRUCTURE IS OBSERVED, THE JACKING OPERATION SHALL IMMEDIATELY CEASE AND APPROVED SUPPORTS SHALL BE INSTALLED. THE CONTRACTOR SHALL ANALYZE THE DAMAGE AND SUBMIT A METHOD OF CORRECTION TO THE ENGINEER FOR APPROVAL. ANY BEAMS THAT SEPARATE FROM THE DECK SHALL BE EPOXY INJECTED FOR THE DISTANCE OF THE SEPARATION IN ACCORDANCE WITH THE PROPOSAL NOTE "CONCRETE REPAIR BY EPOXY INJECTION." COST OF THIS EPOXY INJECTION OR OTHER REQUIRED REPAIRS SHALL BE BORNE BY THE CONTRACTOR.

THE CONTRACTOR SHALL DEMONSTRATE TO THE ENGINEER THAT THE BRIDGE BEARINGS ARE FULLY SEATED BETWEEN ALL CONTACT AREAS. IF FULL SEATING IS NOT ATTAINED, SUITABLE MEANS OF REPAIR, SUBJECT TO THE APPROVAL OF THE ENGINEER, WILL BE REQUIRED AT THE CONTRACTOR'S EXPENSE

THE JACKING OPERATION SHALL BE DIRECTED BY A PROFESSIONAL ENGINEER EMPLOYED BY THE CONTRACTOR. FAILURE TO HAVE A PROFESSIONAL ENGINEER PRESENT SHALL BE CAUSE FOR CEASING JACKING OPERATIONS.

3. CONCRETE PARAPETS:

AS SOON AS A CONCRETE SAW CAN BE OPERATED WITHOUT DAMAGING THE FRESHLY PLACED CONCRETE, 1 1/4" DEEP CONTROL JOINTS SHALL BE SAWED INTO THE PERIMETER OF THE CONCRETE PARAPET. THE SAW CUT SHALL BE MADE IN THE COMPLETE CIRCUMFERENCE OF THE PARAPET, STARTING AND ENDING AT THE ELEVATION OF THE CONCRETE DECK. THE SAWCUTS SHALL BE PLACED AT A MINIMUM OF 6 FEET AND A MAXIMUM OF 10 FEET CENTERS. THE USE OF AN EDGE GUIDE, FENCE, OR JIG IS REQUIRED TO INSURE THAT THE CUT JOINT IS STRAIGHT, TRUE, AND ALIGNED ON ALL SURFACES OF THE PARAPET. THE JOINT WIDTH SHALL BE THE WIDTH OF THE SAW BLADE, A NOMINAL WIDTH OF 1/4 INCH. THE PERIMETER OF THE DEFLECTION CONTROL JOINT SHALL BE SEALED TO A MINIMUM DEPTH OF 1" WITH A POLYURETHANE OR POLYMERIC CAULKING MATERIAL CONFORMING TO FEDERAL SPECIFICATION, TT-S-00227E. THE BOTTOM 1/2 INCH OF THE INSIDE AND OUTSIDE FACE SHOULD BE LEFT UNSEALED TO ALLOW WATER TO ESCAPE.

ASBESTOS ABATEMENT

THE CONTRACTOR SHALL CONDUCT ASBESTOS INSPECTIONS OF ALL BRIDGES SUBJECT TO RENOVATION OR DEMOLITION AS PER CHAPTER 3745-20 OF THE OHIO ADMINISTRATIVE CODE (OAC) "ASBESTOS EMISSIONS CONTROL FROM RENOVATION/DEMOLITION AND WASTE DISPOSAL OPERATION" MAY 29, 1990 UTILIZING A CERTIFIED OHIO ASBESTOS HAZARD EVALUATION SPECIALIST. SHOULD SUSPECT ASBESTOS CONTAINING MATERIAL (ACM) BE ENCOUNTERED; PERFORM BULK SAMPLING AND ANALYSIS. PREPARE A LETTER REPORT (1-2 PAGES) INCLUDING A BRIEF DISCUSSION OF THE INSPECTION AND SAMPLING METHODOLOGY, MAPPING INDICATING THE BRIDGE LOCATION AND SAMPLING LOCATIONS, AND ANALYTICAL TEST RESULTS.

THE CONTRACTOR SHALL COMPLETE AN OEPA NOTIFICATION OF DEMOLITION AND RENOVATION FORM AND SUBMIT THIS TO THE OHIO EPA AT LEAST 10 WORKING DAYS BEFORE OPERATIONS BEGIN.

AS THESE INSPECTION REPORTS AND NOTIFICATION FORMS ARE COMPLETED, COPIES SHALL BE FORWARD TO ODOT'S ON SITE PROJECT ENGINEER.

PAYMENT OF THE ABOVE WORK SHALL BE INCLUDED IN THE LUMP SUM BID FOR EACH BRIDGE.

SHOULD ASBESTOS CONTAINING MATERIAL BE ENCOUNTERED, ALL SUSPECT MATERIALS SHALL BE REMOVED AND PROPERLY DESPOSED OF BY A CERTIFIED ASBESTOS REMOVAL CONTRACTOR IN ACCORDANCE WITH OAC 3745-20. AN INDIVIDUAL TRAINED IN THE PROVISIONS OF NESHAPS (30 CFR PART 61, SUBPART M) WILL BE ON SITE DURING THE DEMOLITION OR RENOVATION OF ANY STRUCTURE WITH ACM AND EVIDENCE THAT THE REQUIRED TRAINING HAS BEEN ACCOMPLISHED BY THIS PERSON WILL BE AVAILABLE DURING NORMAL BUSINESS HOURS.

ALL ASSOCIATED COSTS OF ASBESTOS MATERIALS TO BE REMOVED AND PROPERLY DISPOSED OF, WILL BE PAYED UNDER 'THIRD PARTY BILLING' PROVISIONS OF ODOT CHANGE ORDER POLICY 512-004(P) APPENDIX D.

CONVERSION OF STANDARD BRIDGE DRAWINGS:

SOME OF THE STANDARD BRIDGE DRAWINGS REFERENCED IN THIS PLAN ARE METRIC. ANY CONVERSION OF DIMENSIONS REQUIRED TO CONSTRUCT THE ITEMS SHOWN ON THE STANDARDS SHALL BE THE RESPONSIBILITY OF THE CONTRACTOR. CONVERSIONS SHALL BE MADE USING THE SI (METRIC) TO ENGLISH CONVERSION FACTORS PROVIDED IN SECTION 109.011 OF THE 1997 CONSTRUCTION AND MATERIALS SPECIFICATIONS. THE APPENDIX OF ASTM E380 SHALL BE UTILIZED FOR ANY ADDITIONAL CONVERSION FACTORS REQUIRED. CONVERSIONS SHALL BE APPROPRIATELY PRECISE AND SHALL REFLECT STANDARD INDUSTRY ENGLISH VALUES WHERE SUITABLE.

REF: 10-10-00

REF: 10-10-00

Table with columns: DESIGN AGENCY, DATE, REVIEWED, DRAWN, DESIGNED, CHECKED. Values include KZF #17, 1/20/00, DKG, JDG, SJA, WBS.

KZF #17

GENERAL NOTES BRIDGE NO. PRE-70-1500 L/R I.R. TO OVER TWIN CREEK

PRE-70-0.00


REF: **REF1**
REF: **REF2**
REF: **REF3**
REF: **REF4**
REF: **REF5**

REF: **REF1**
REF: **REF2**
REF: **REF3**
REF: **REF4**
REF: **REF5**


REF: **REF1**
REF: **REF2**
REF: **REF3**
REF: **REF4**
REF: **REF5**

REF: **REF1**
REF: **REF2**
REF: **REF3**
REF: **REF4**
REF: **REF5**

DESIGN SPECIFICATION
ACTIVE LEVELS ON FILE

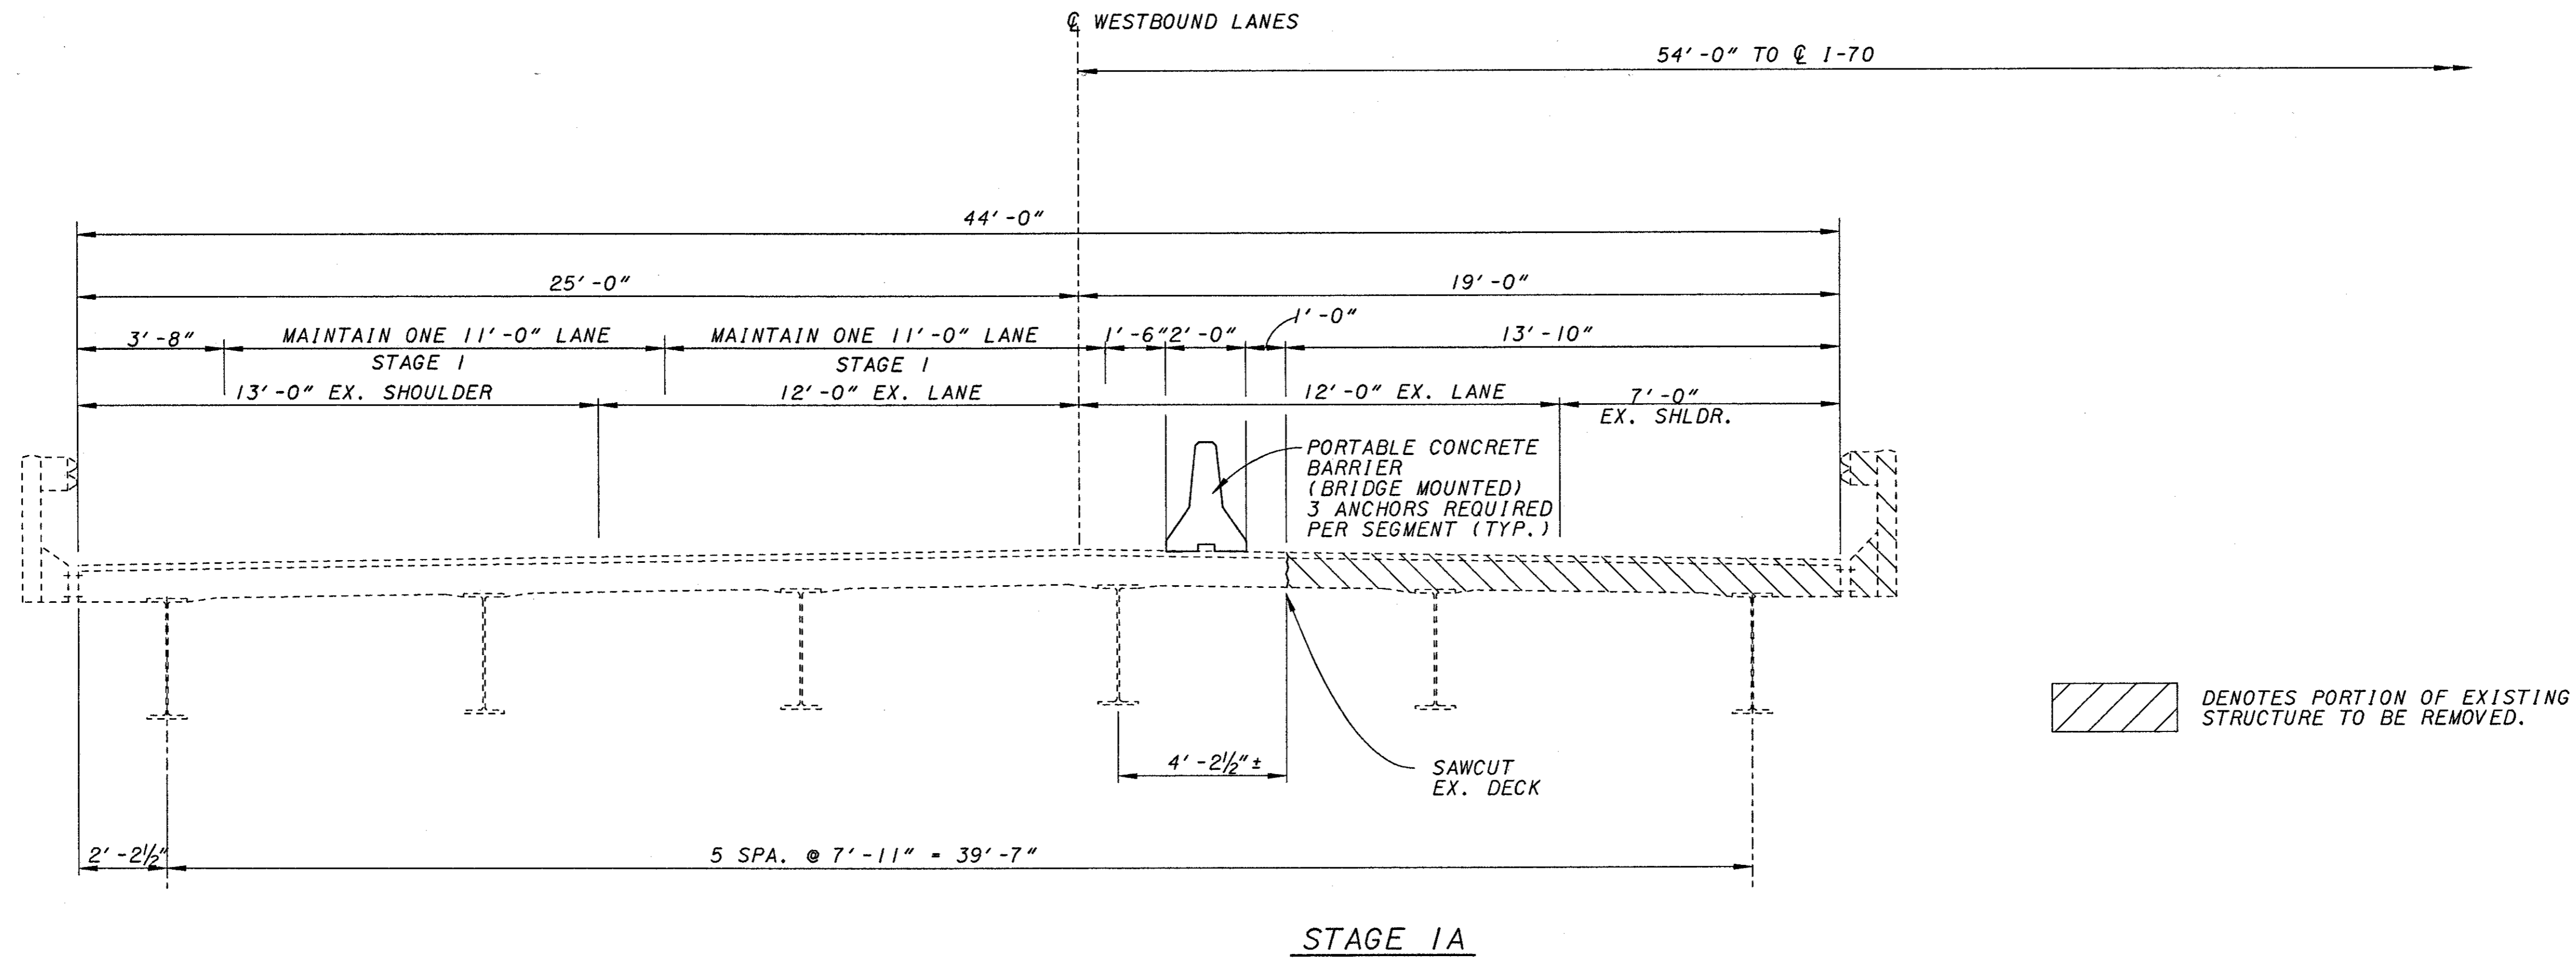

 DENOTES PORTION OF EXISTING STRUCTURE TO BE REMOVED.

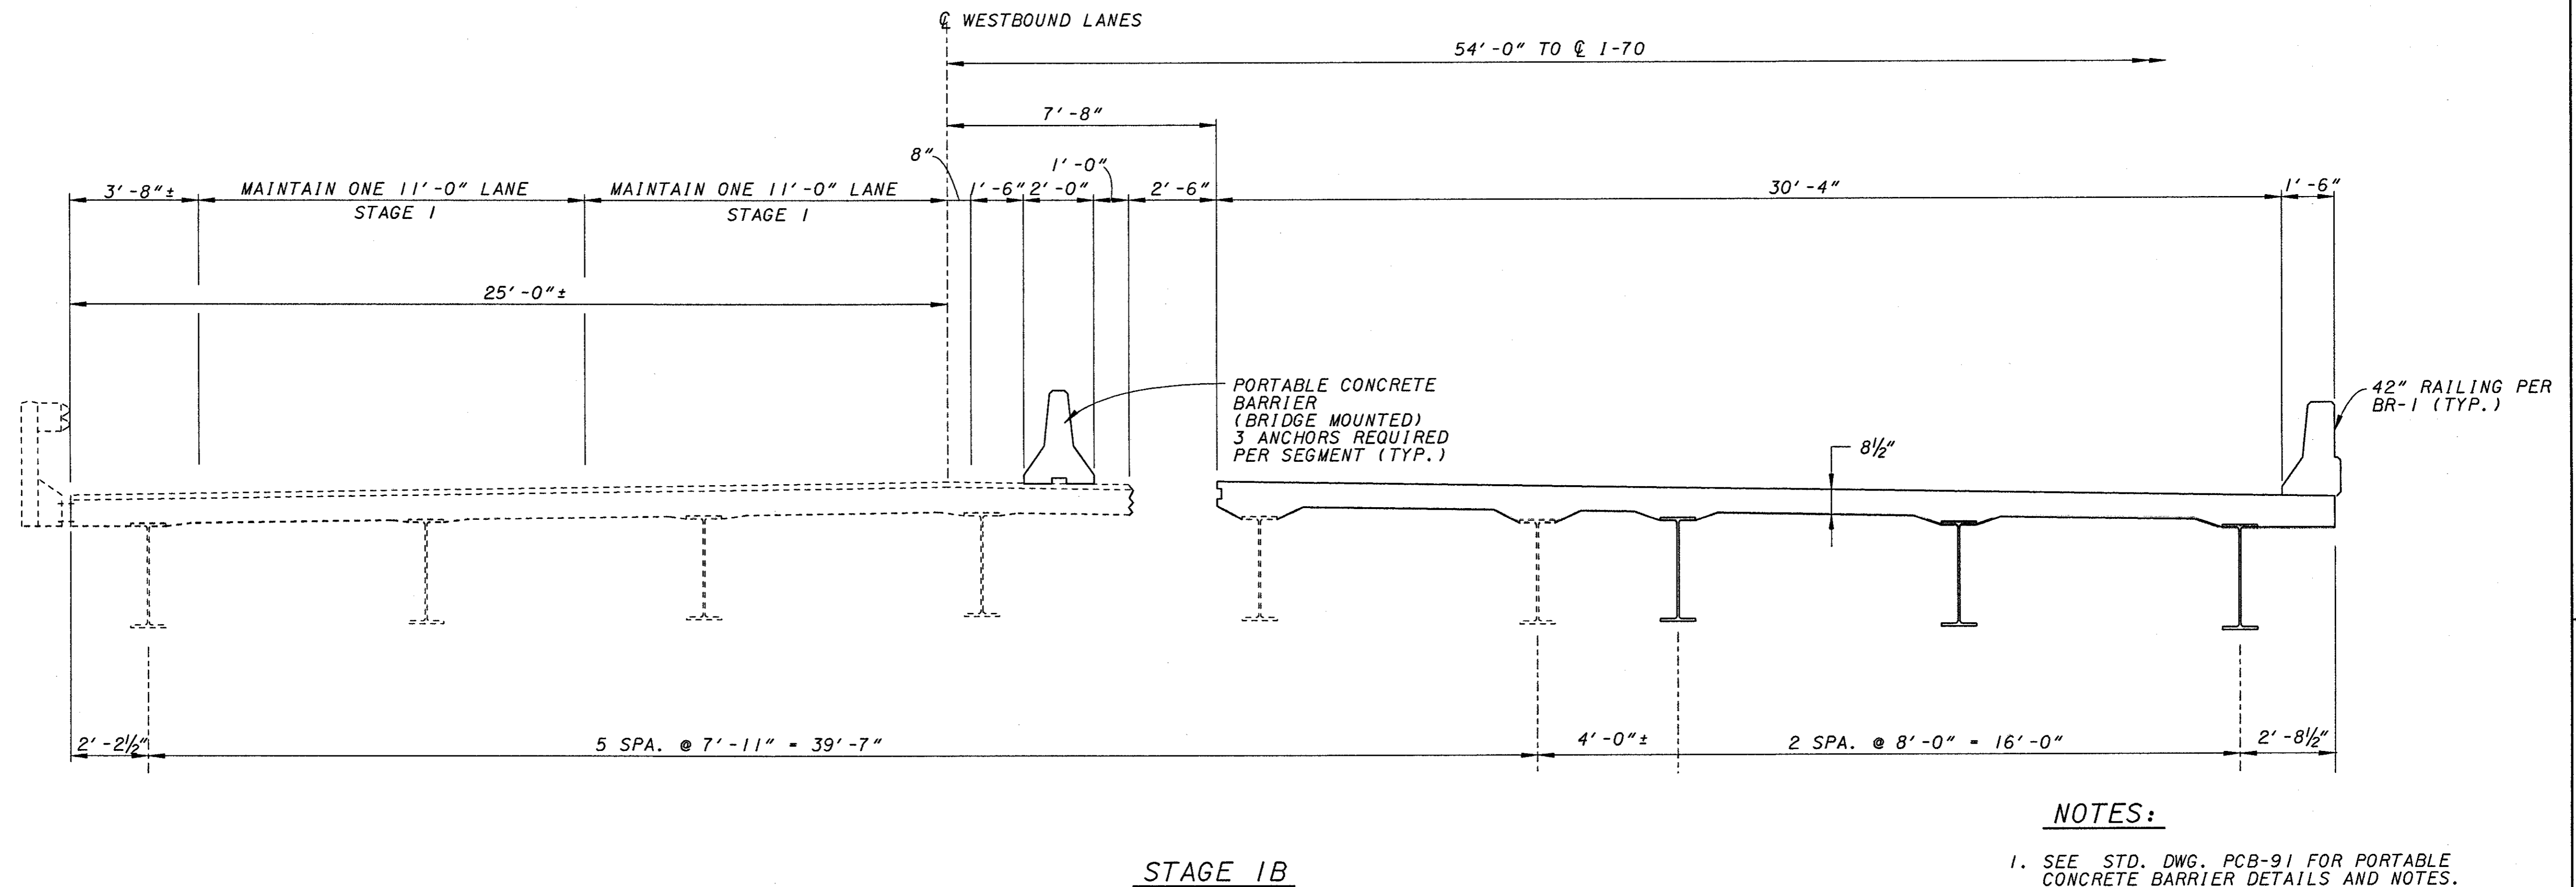

NOTES:
1. SEE STD. DWG. PCB-91 FOR PORTABLE CONCRETE BARRIER DETAILS AND NOTES.

DATE	11/20/00
REVIEWED	DGK
STRUCTURE FILE NUMBER	68014716801501
DESIGNED	SJA
CHECKED	WBS

BRIDGE STAGE IA CONSTRUCTION - LEFT BRIDGE
KZF #17
BRIDGE NO. PRE-70-1500 L/R
I.R. 70 OVER TWIN CREEK

PRE-70-0.00


REF: **REF: **
 REF: **REF: **
*****SYTIME*****
 DES:FILE:CONSTRUCTION*****
 PRE:NAME:*****
 ACTIVE LEVELS ON:*****

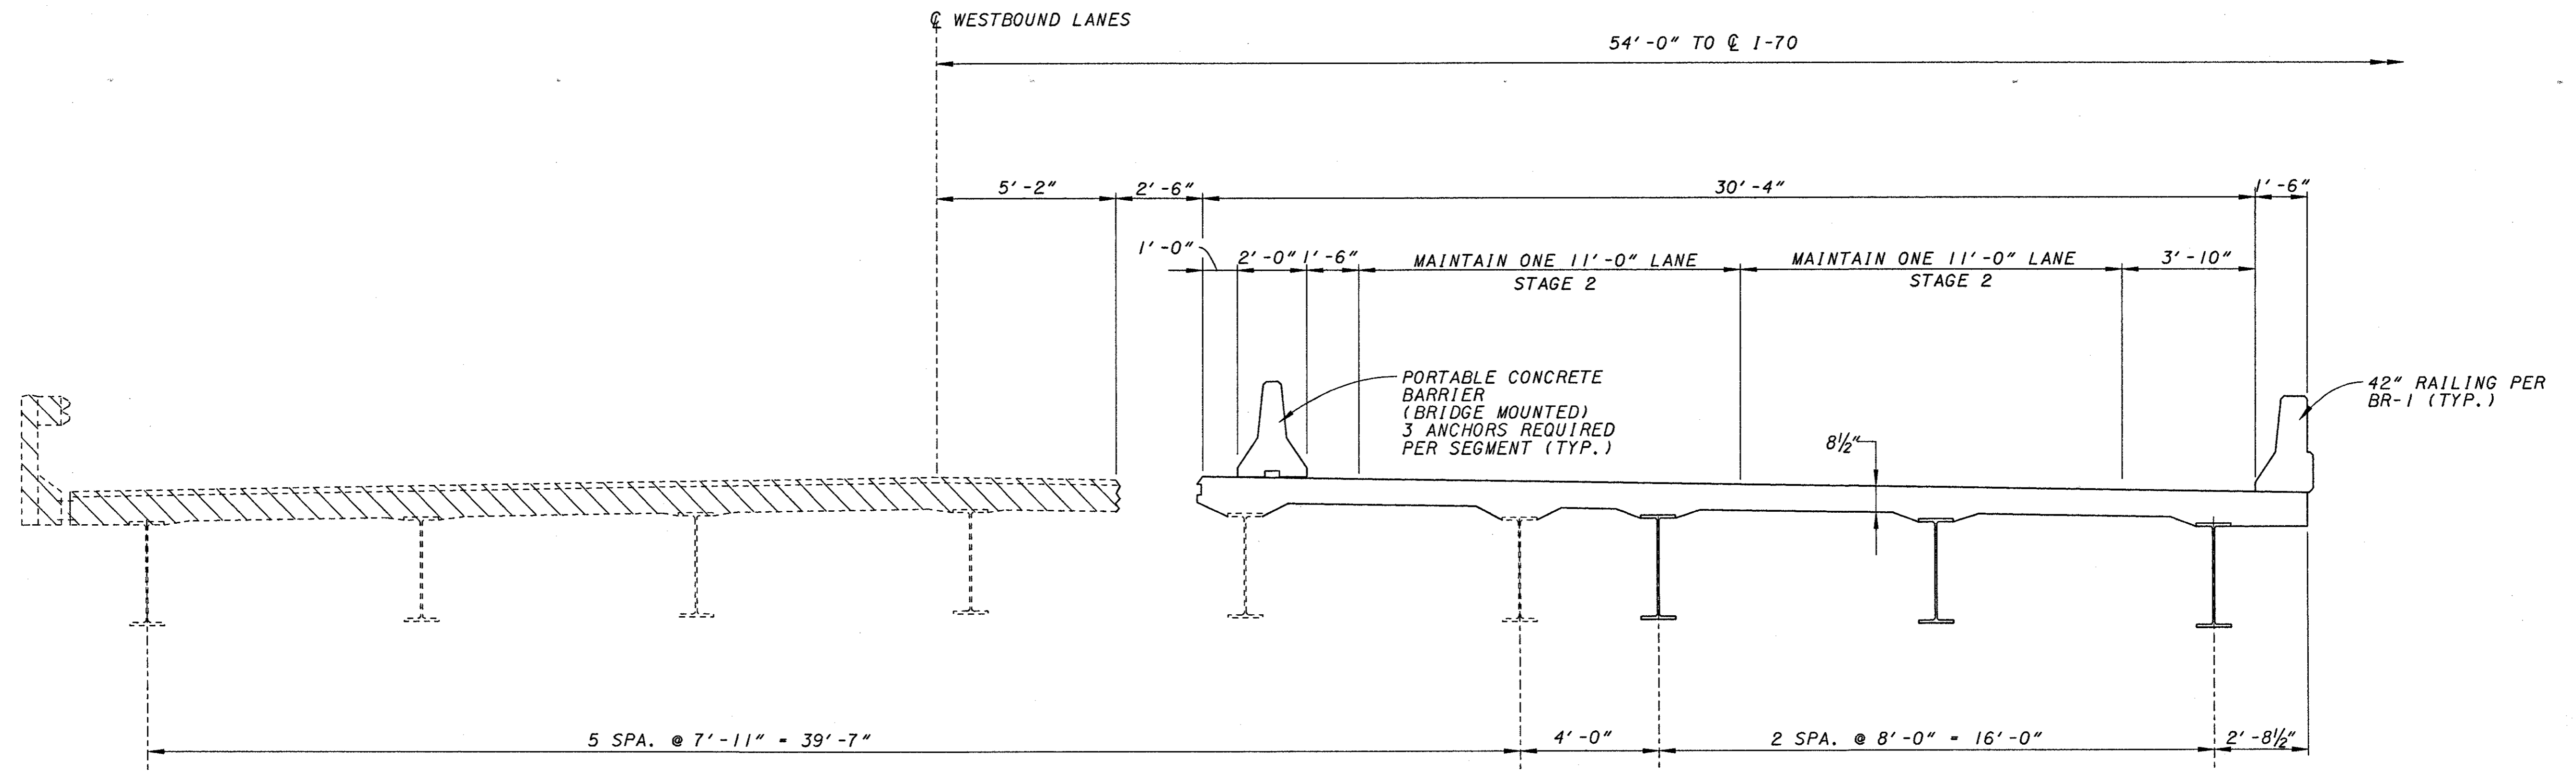


STAGE 2A

NOTES:

- SEE STD. DWG. PCB-91 FOR PORTABLE CONCRETE BARRIER DETAILS AND NOTES.

DENOTES PORTION OF EXISTING STRUCTURE TO BE REMOVED.

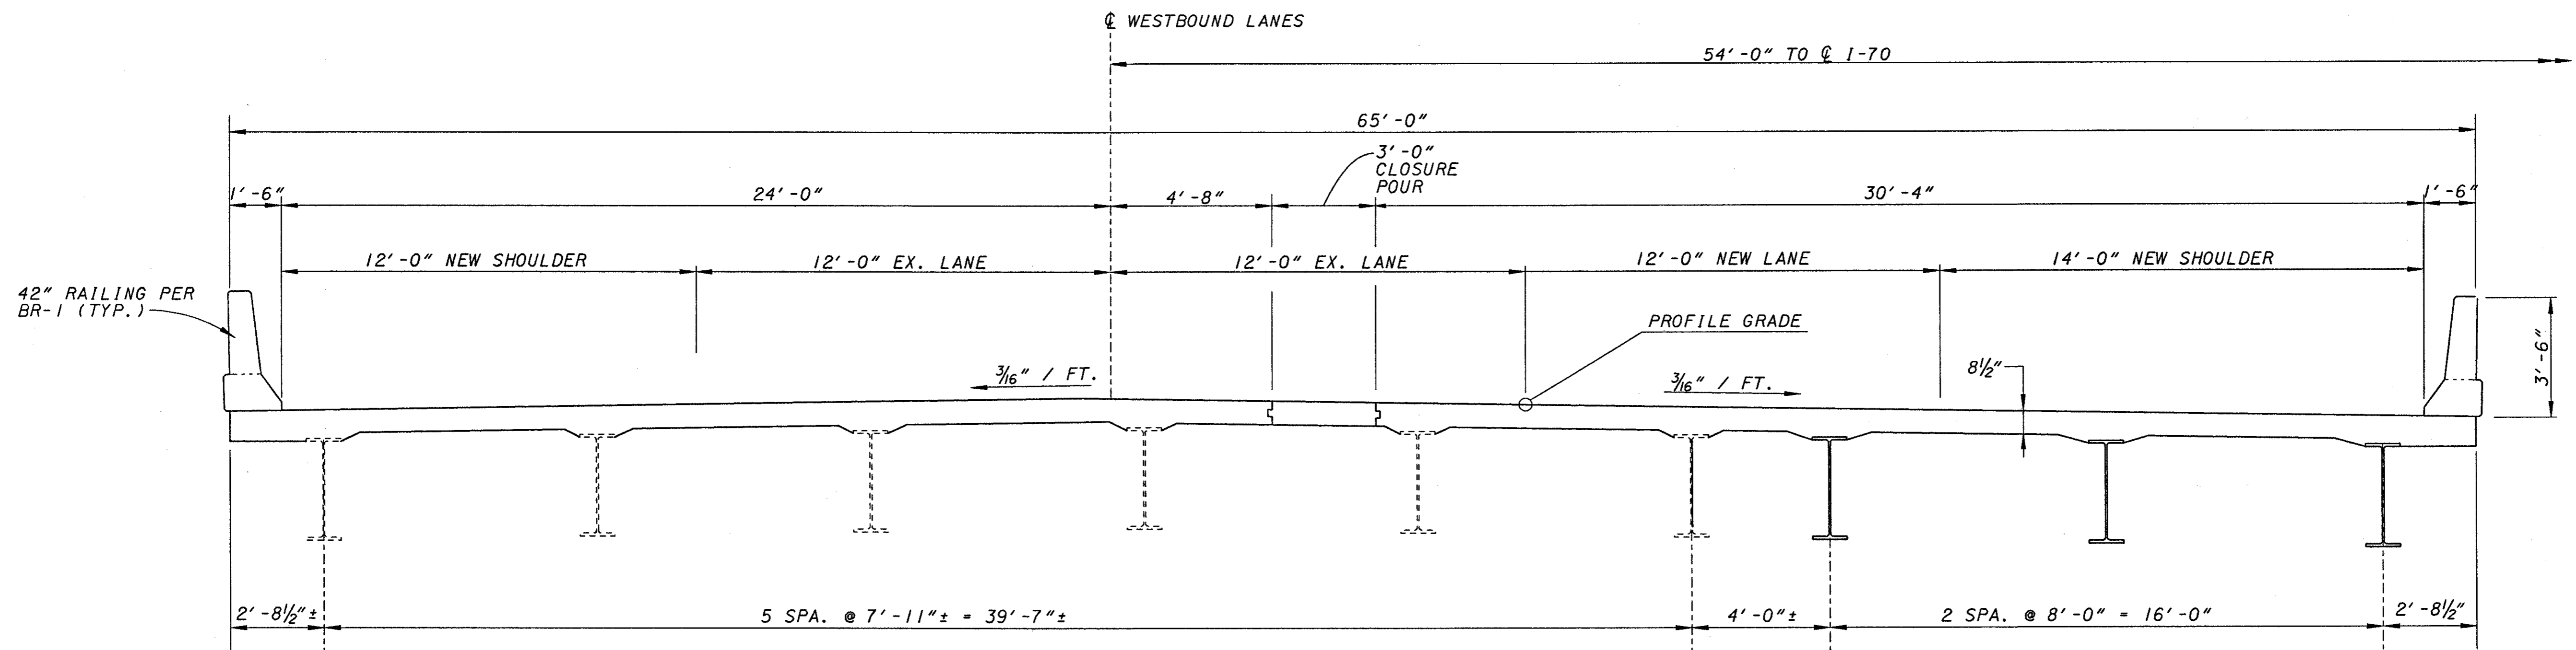

STAGE 2B


REF: **REF**
 REF: **REF**
 USER: JACOB
 PROJECT: PRE-70-0.00
 ACTIVE LEVELS ON: \$ELEV\$

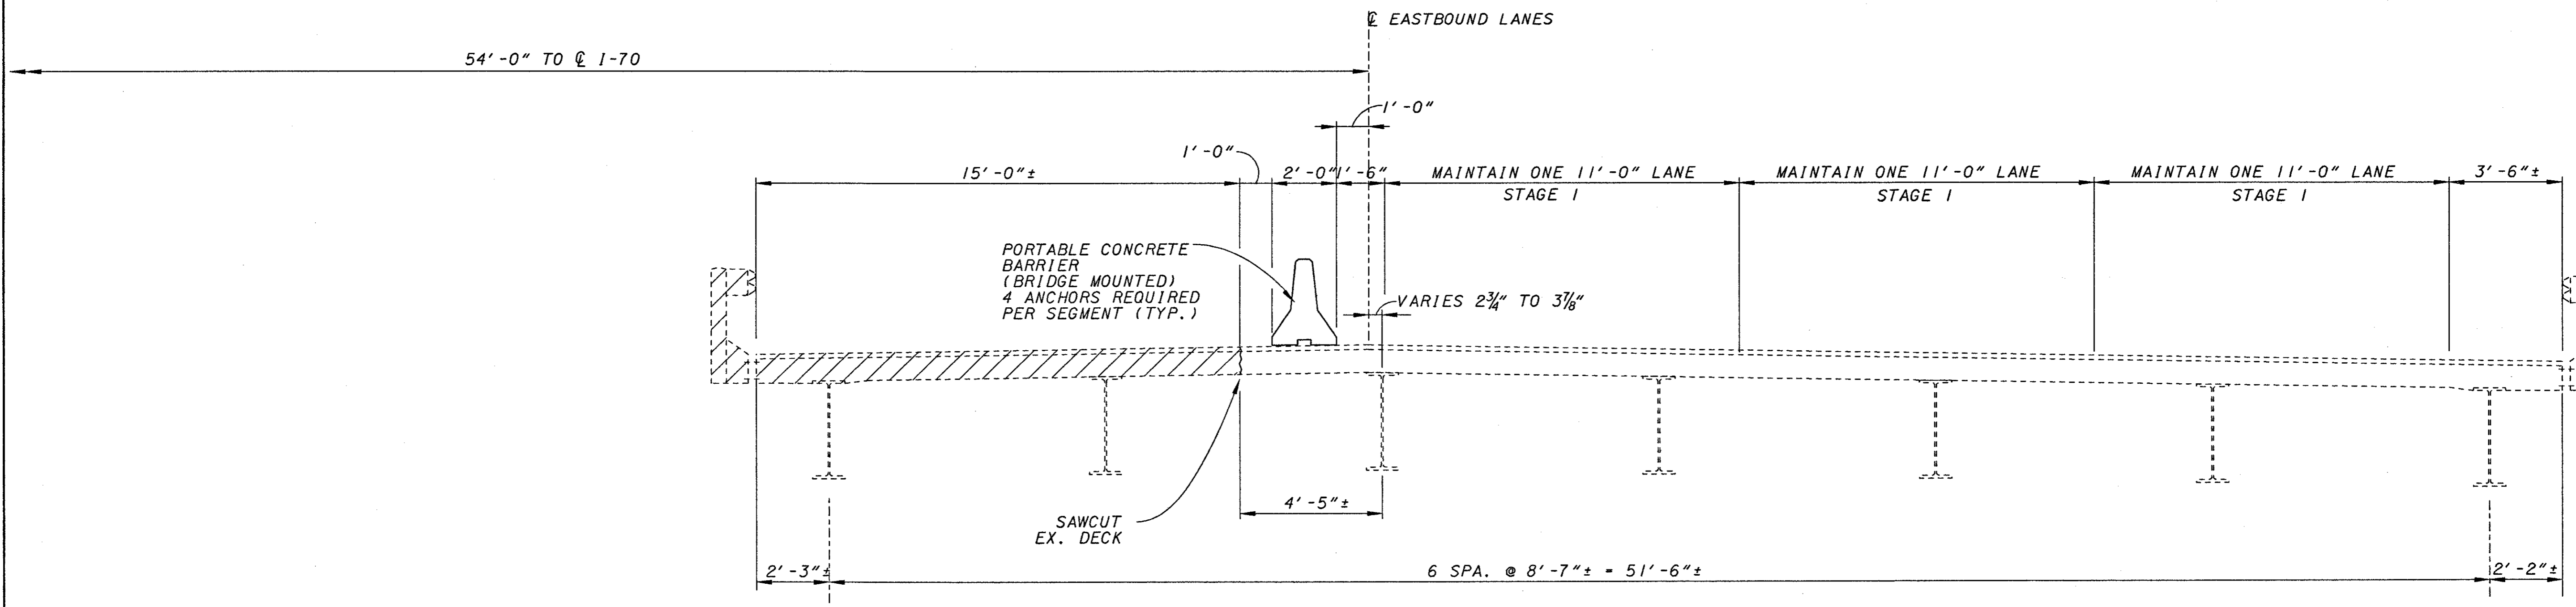

 DENOTES PORTION OF EXISTING STRUCTURE TO BE REMOVED.

STAGE 1A

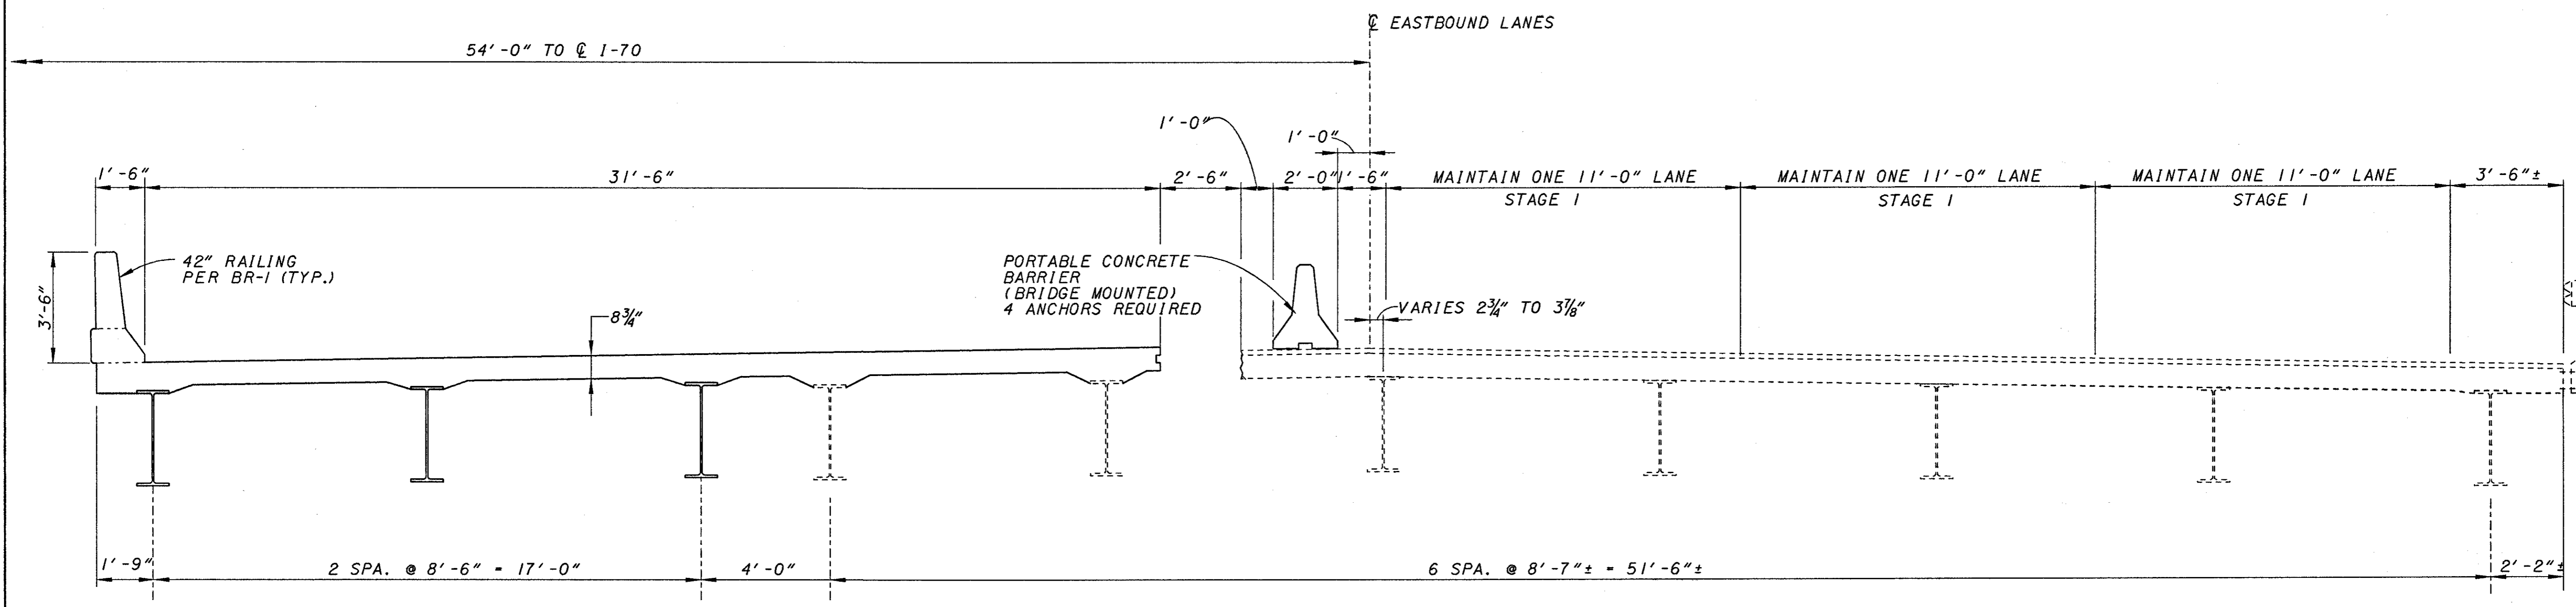

STAGE 1B

- NOTES:**
- 1. SEE STD. DWG. PCB-91 FOR PORTABLE CONCRETE BARRIER DETAILS AND NOTES.

DESIGNED	DATE	REVIEWED	DATE
SJA	11/20/00	DGK	11/20/00
CHECKED	STRUCTURE FILE NUMBER	DRAWN	REVISIONS
	680147176801501	JDG	

BRIDGE STAGE 1 CONSTRUCTION - RIGHT BRIDGE KZF #17
 BRIDGE NO. PRE-70-1500 L/R
 I.R. 70 OVER TWIN CREEK

PRE-70-0.00


REF: **REF**
REF: **REF**
USER: *****
APP: *****
ACTIVE LEVELS: *****

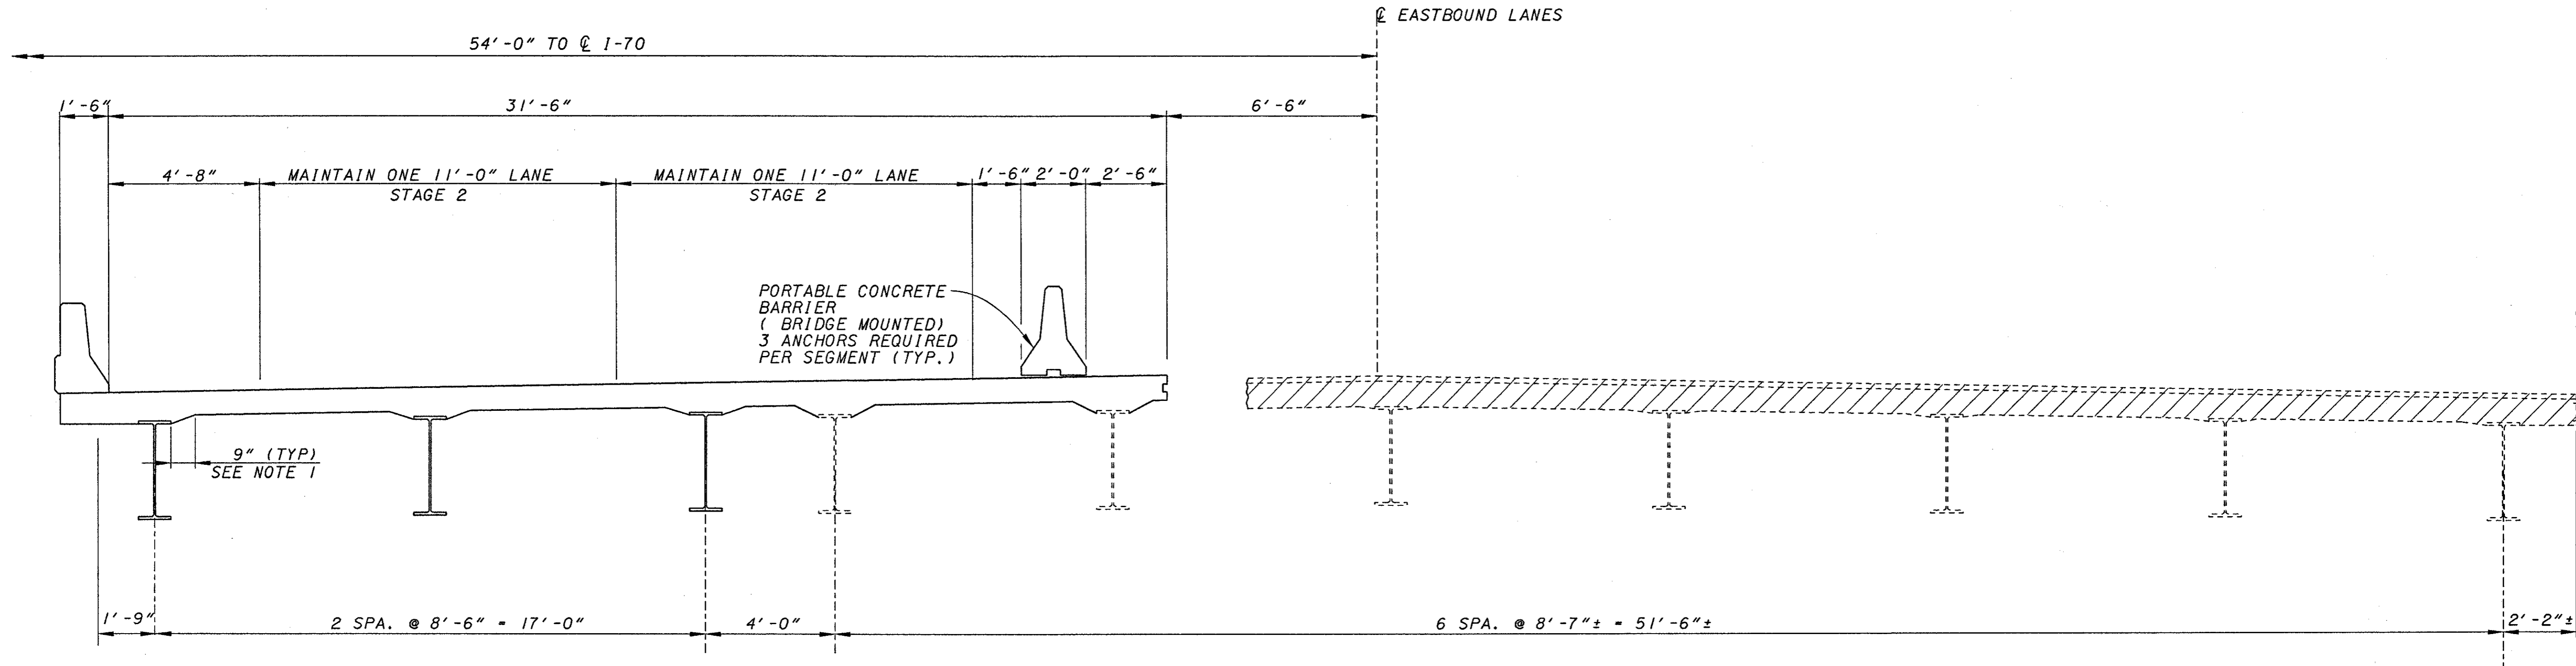

STAGE 2A

 DENOTES PORTION OF EXISTING STRUCTURE TO BE REMOVED.

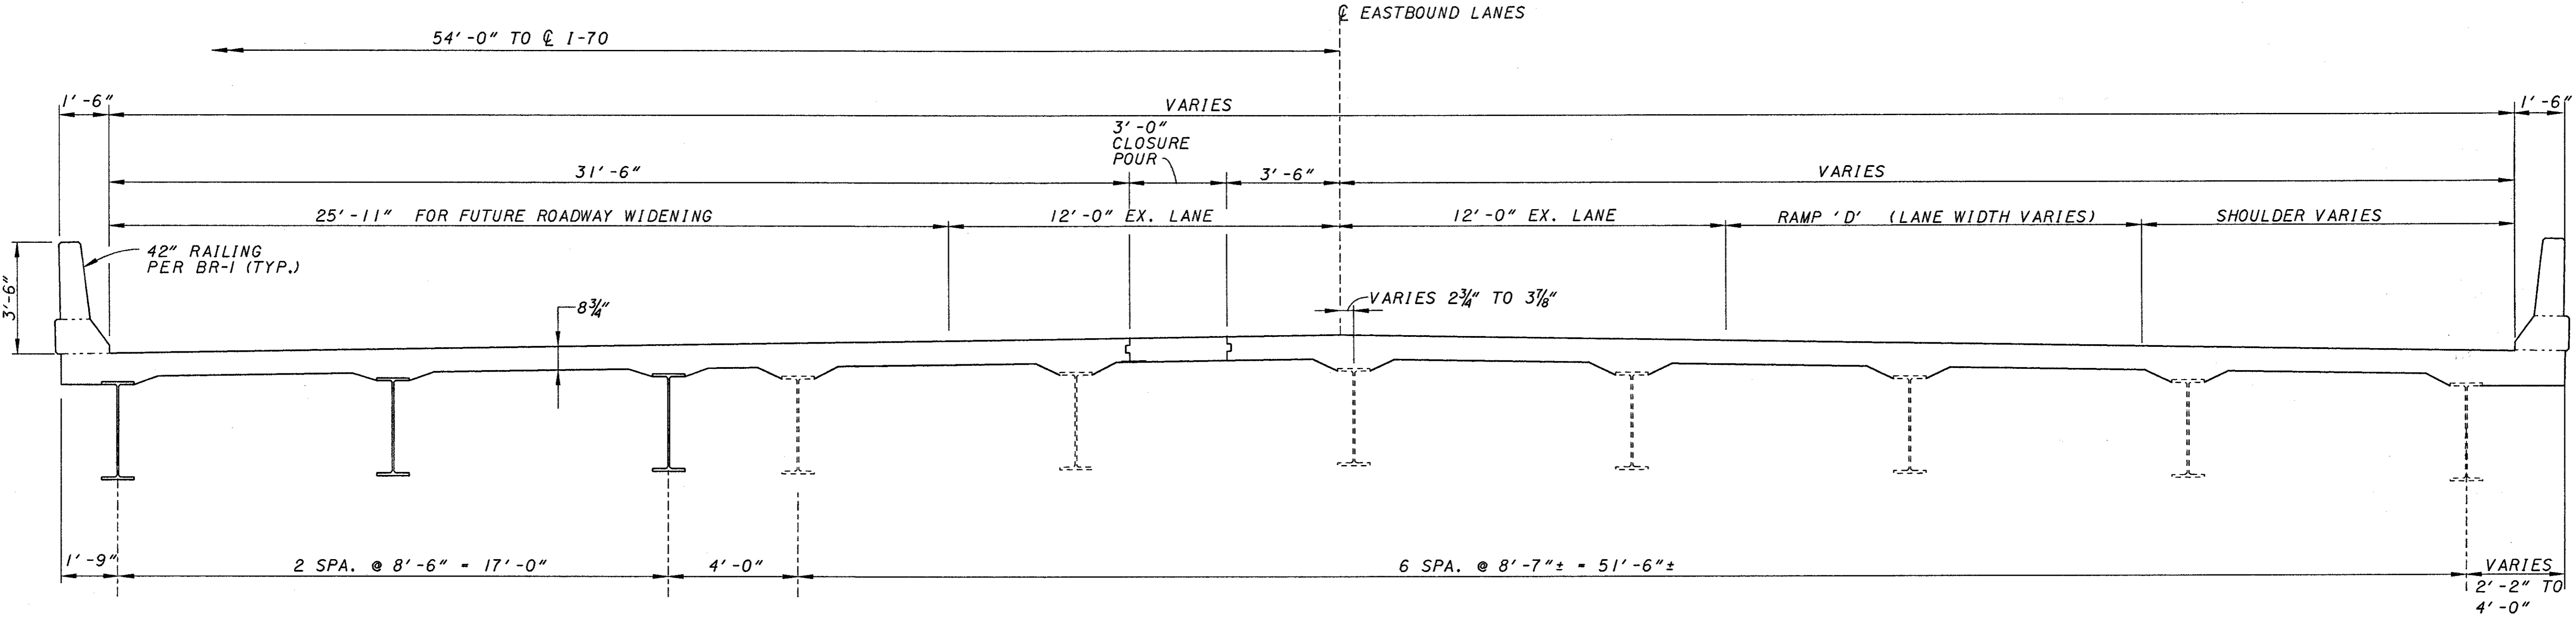

STAGE 2B


REF: **REF**
 REF: **REF**
DESIGNED BY: [Name]
 CHECKED BY: [Name]
 DATE: [Date]

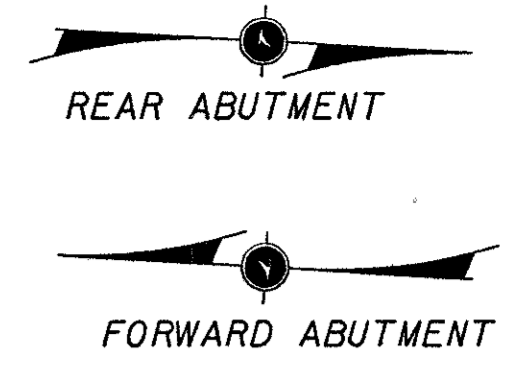


DESIGNED	SJA	CHECKED	WBS
DRAWN	JDG	REVISED	
REVIEWED	DGK	DATE	11/20/00
STRUCTURE FILE NUMBER	68014716801501		

ABUTMENT MODIFICATIONS - LEFT BRIDGE
 BRIDGE NO. PRE-70-1500 L/R
 I.R. 70 OVER TWIN CREEK
 KZF #17


PRE-70-0.00

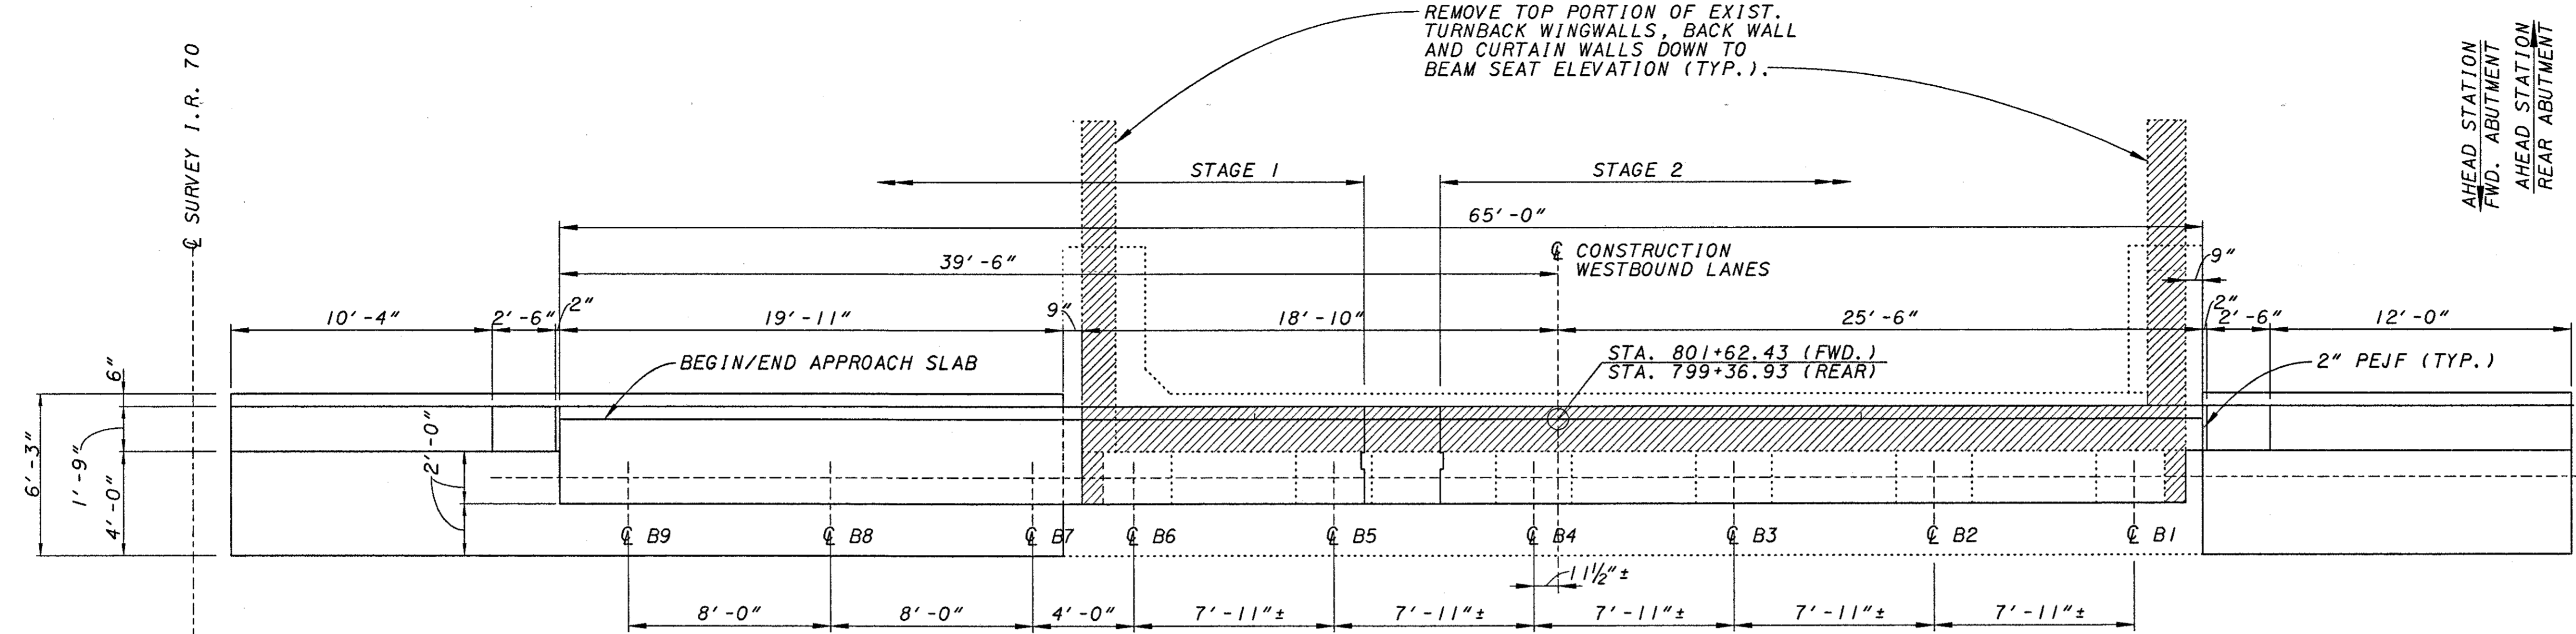

PLAN
 (REAR ABUTMENT SHOWN, FORWARD ABUTMENT OPPOSITE HAND)

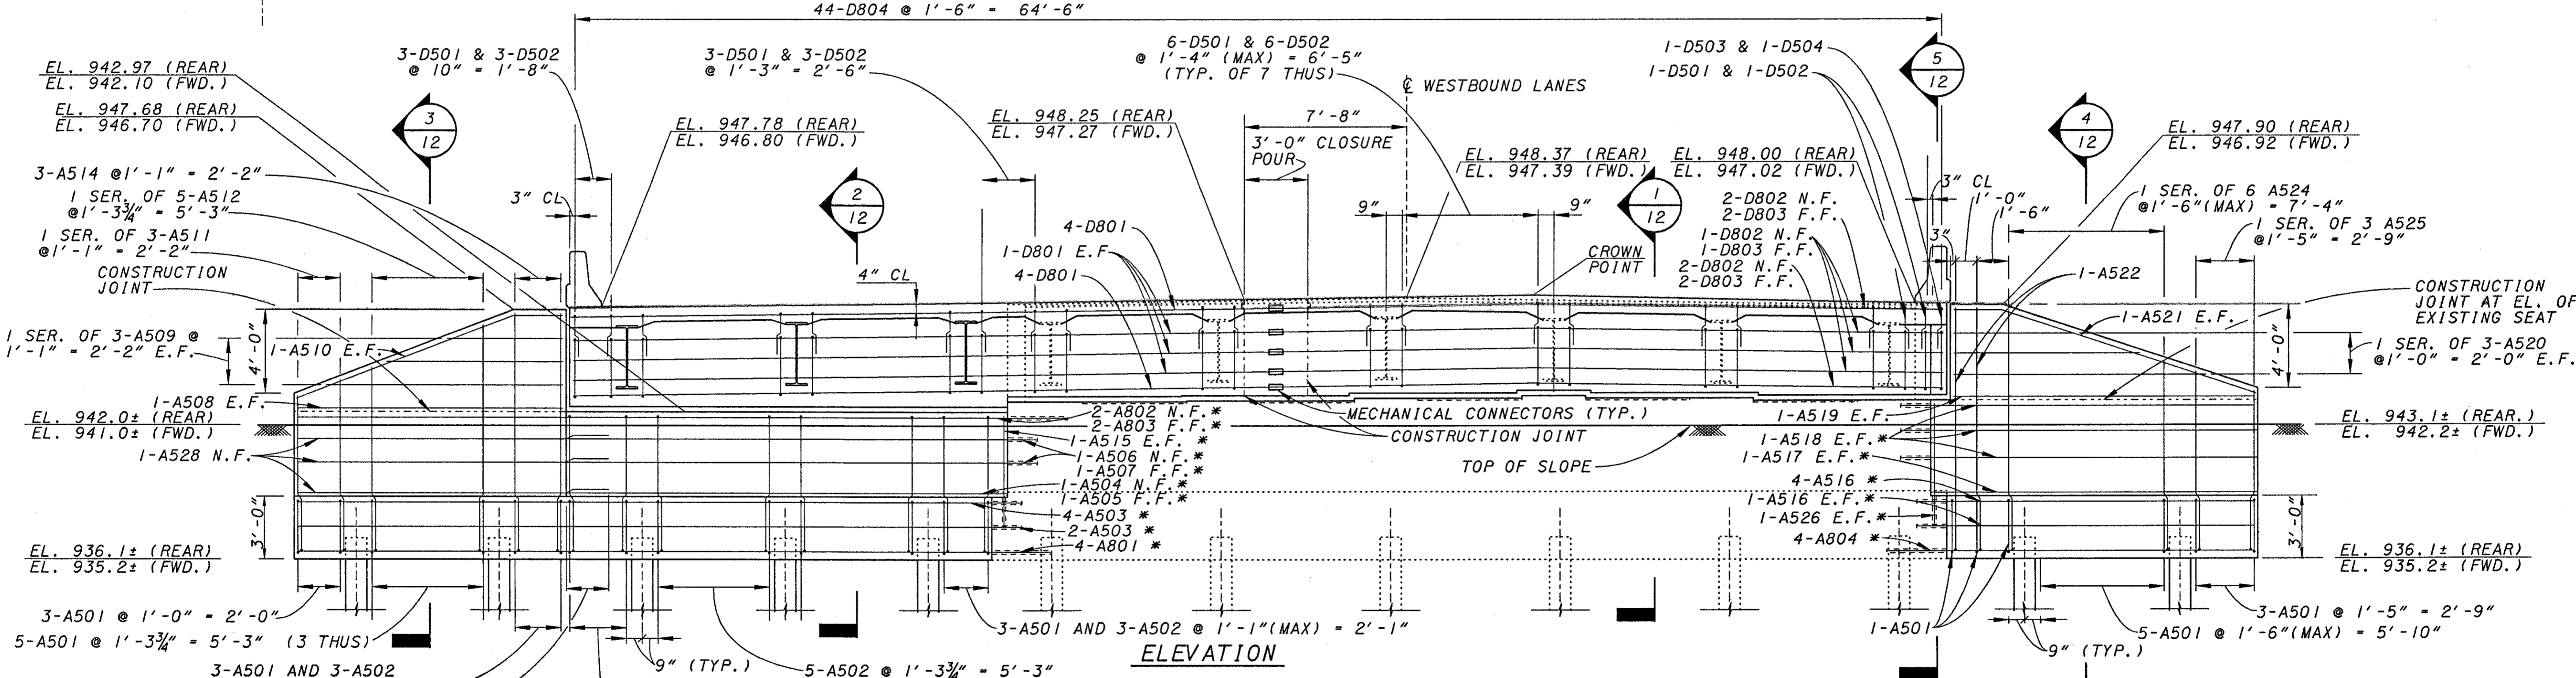

ELEVATION

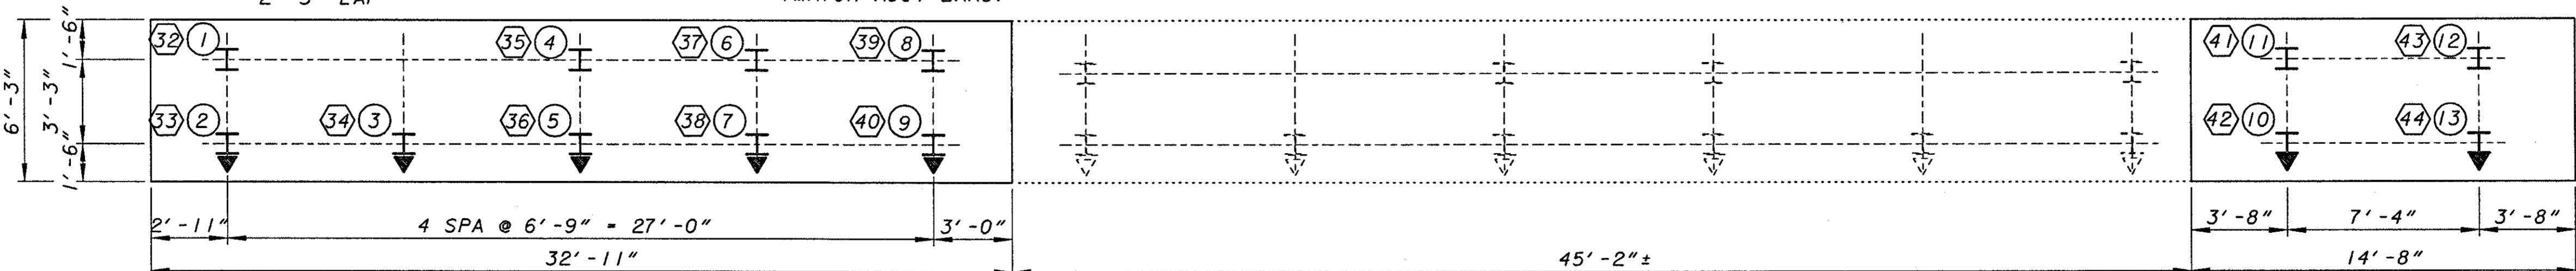

FOOTING PLAN

33 1 I
 REAR ABUTMENT PILE NUMBER
 FORWARD ABUTMENT PILE NUMBER

ALL REINFORCING STEEL CLEARANCES ARE 2" UNLESS NOTED OTHERWISE

* DOWEL #5 BARS 1'-5" (MIN.) AND #8 BARS 2'-10" (MIN.) INTO EXISTING ABUTMENT FOOTING AND BREASTWALL.

- LEGEND**
- DENOTES PORTION OF EXISTING STRUCTURE TO BE REMOVED
 - PEJF - PREFORMED EXPANSION JOINT FILLER
 - E.F. - EACH FACE
 - N.F. - NEAR FACE
 - F.F. - FAR FACE
 - APP. - APPROXIMATELY
 - DENOTES PROPOSED HP10x42 PILE BATTERED AT 1:4
 - DENOTES VERTICAL HP10x42 PILE


REF: **REF**
 REF: **REF**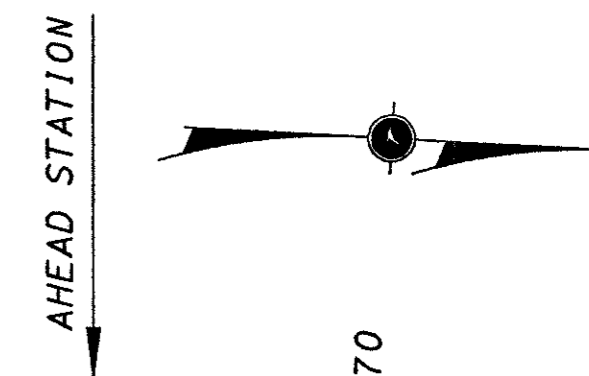
REMOVE TOP PORTION OF EXIST. TURNBACK WINGWALLS, BACK WALL AND CURTAIN WALLS DOWN TO BEAM SEAT ELEVATION (TYP.).

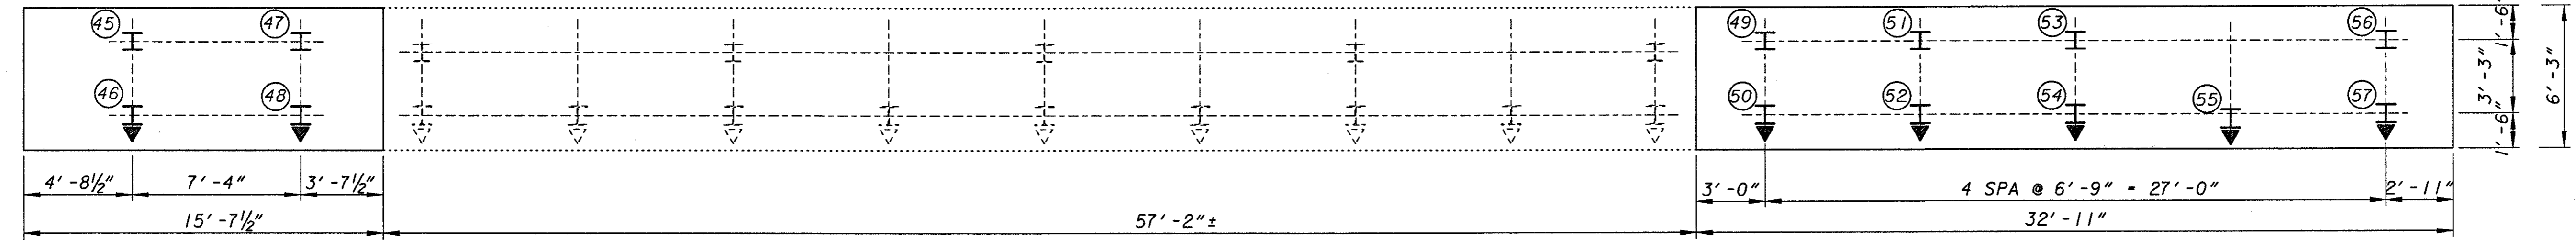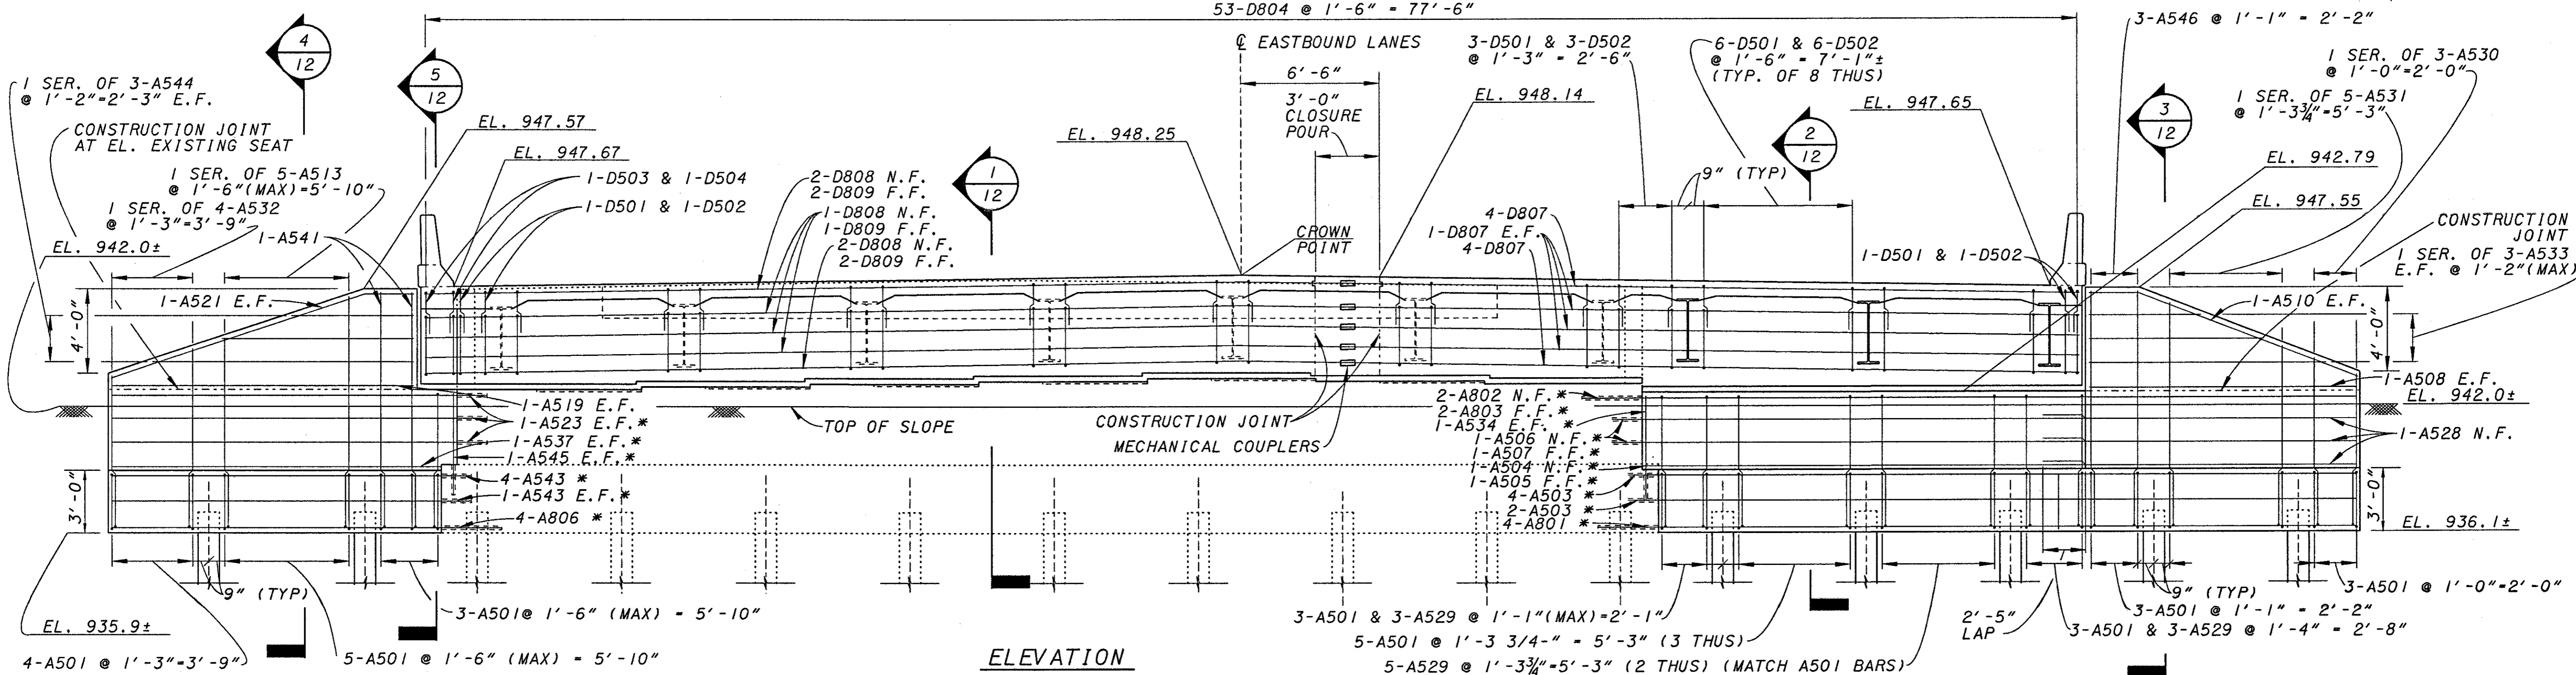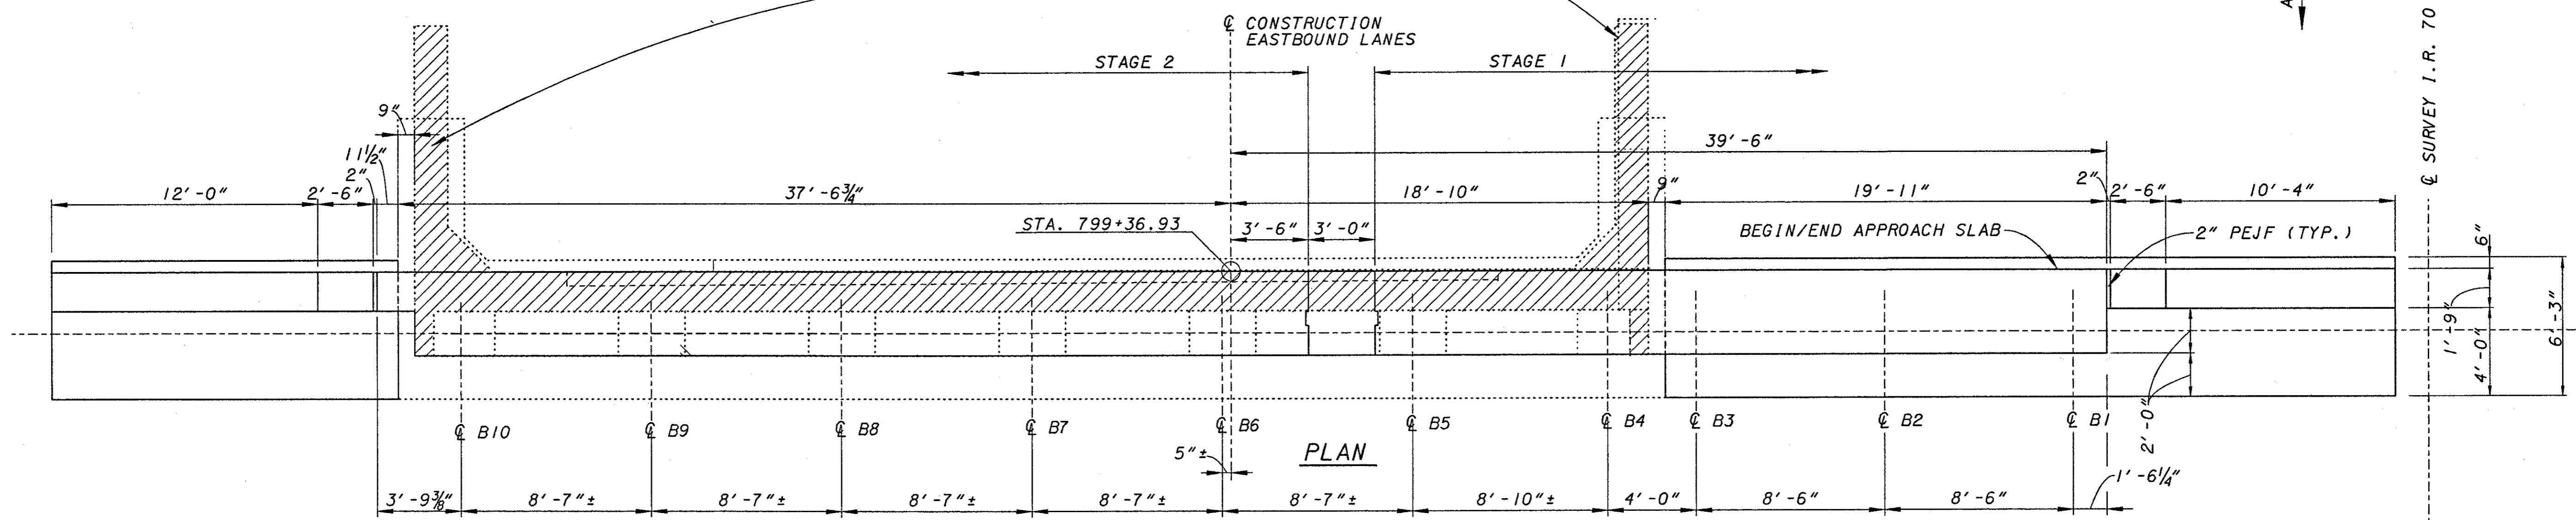

LEGEND

PEJF - PREFORMED EXPANSION JOINT FILLER
 E.F. - EACH FACE
 N.F. - NEAR FACE
 F.F. - FAR FACE
 APP. - APPROXIMATELY

⬇ DENOTES PROPOSED HP10x42 PILE BATTERED AT 1:4
 I DENOTES VERTICAL HP10x42 PILE

▨ DENOTES PORTION OF EXISTING STRUCTURE TO BE REMOVED

① I REAR ABUTMENT PILE NUMBER

* DOWEL #5 BARS 1'-5" (MIN.) AND #8 BARS 2'-10" (MIN.) INTO EXISTING ABUTMENT FOOTING AND BREASTWALL.

REF: **RFB**
REF: **RFB**
DATE	11/20/00
DESIGNED	SJA
CHECKED	WBS
DRAWN	JDG
REVIEWED	DGK
STRUCTURE FILE NUMBER	68014716801501

FORWARD ABUTMENT MODIFICATIONS - RIGHT BRIDGE KZF #17
BRIDGE NO. PRE-70-1500 L/R
I.R. 70 OVER TWIN CREEK

PRE-70-0.00

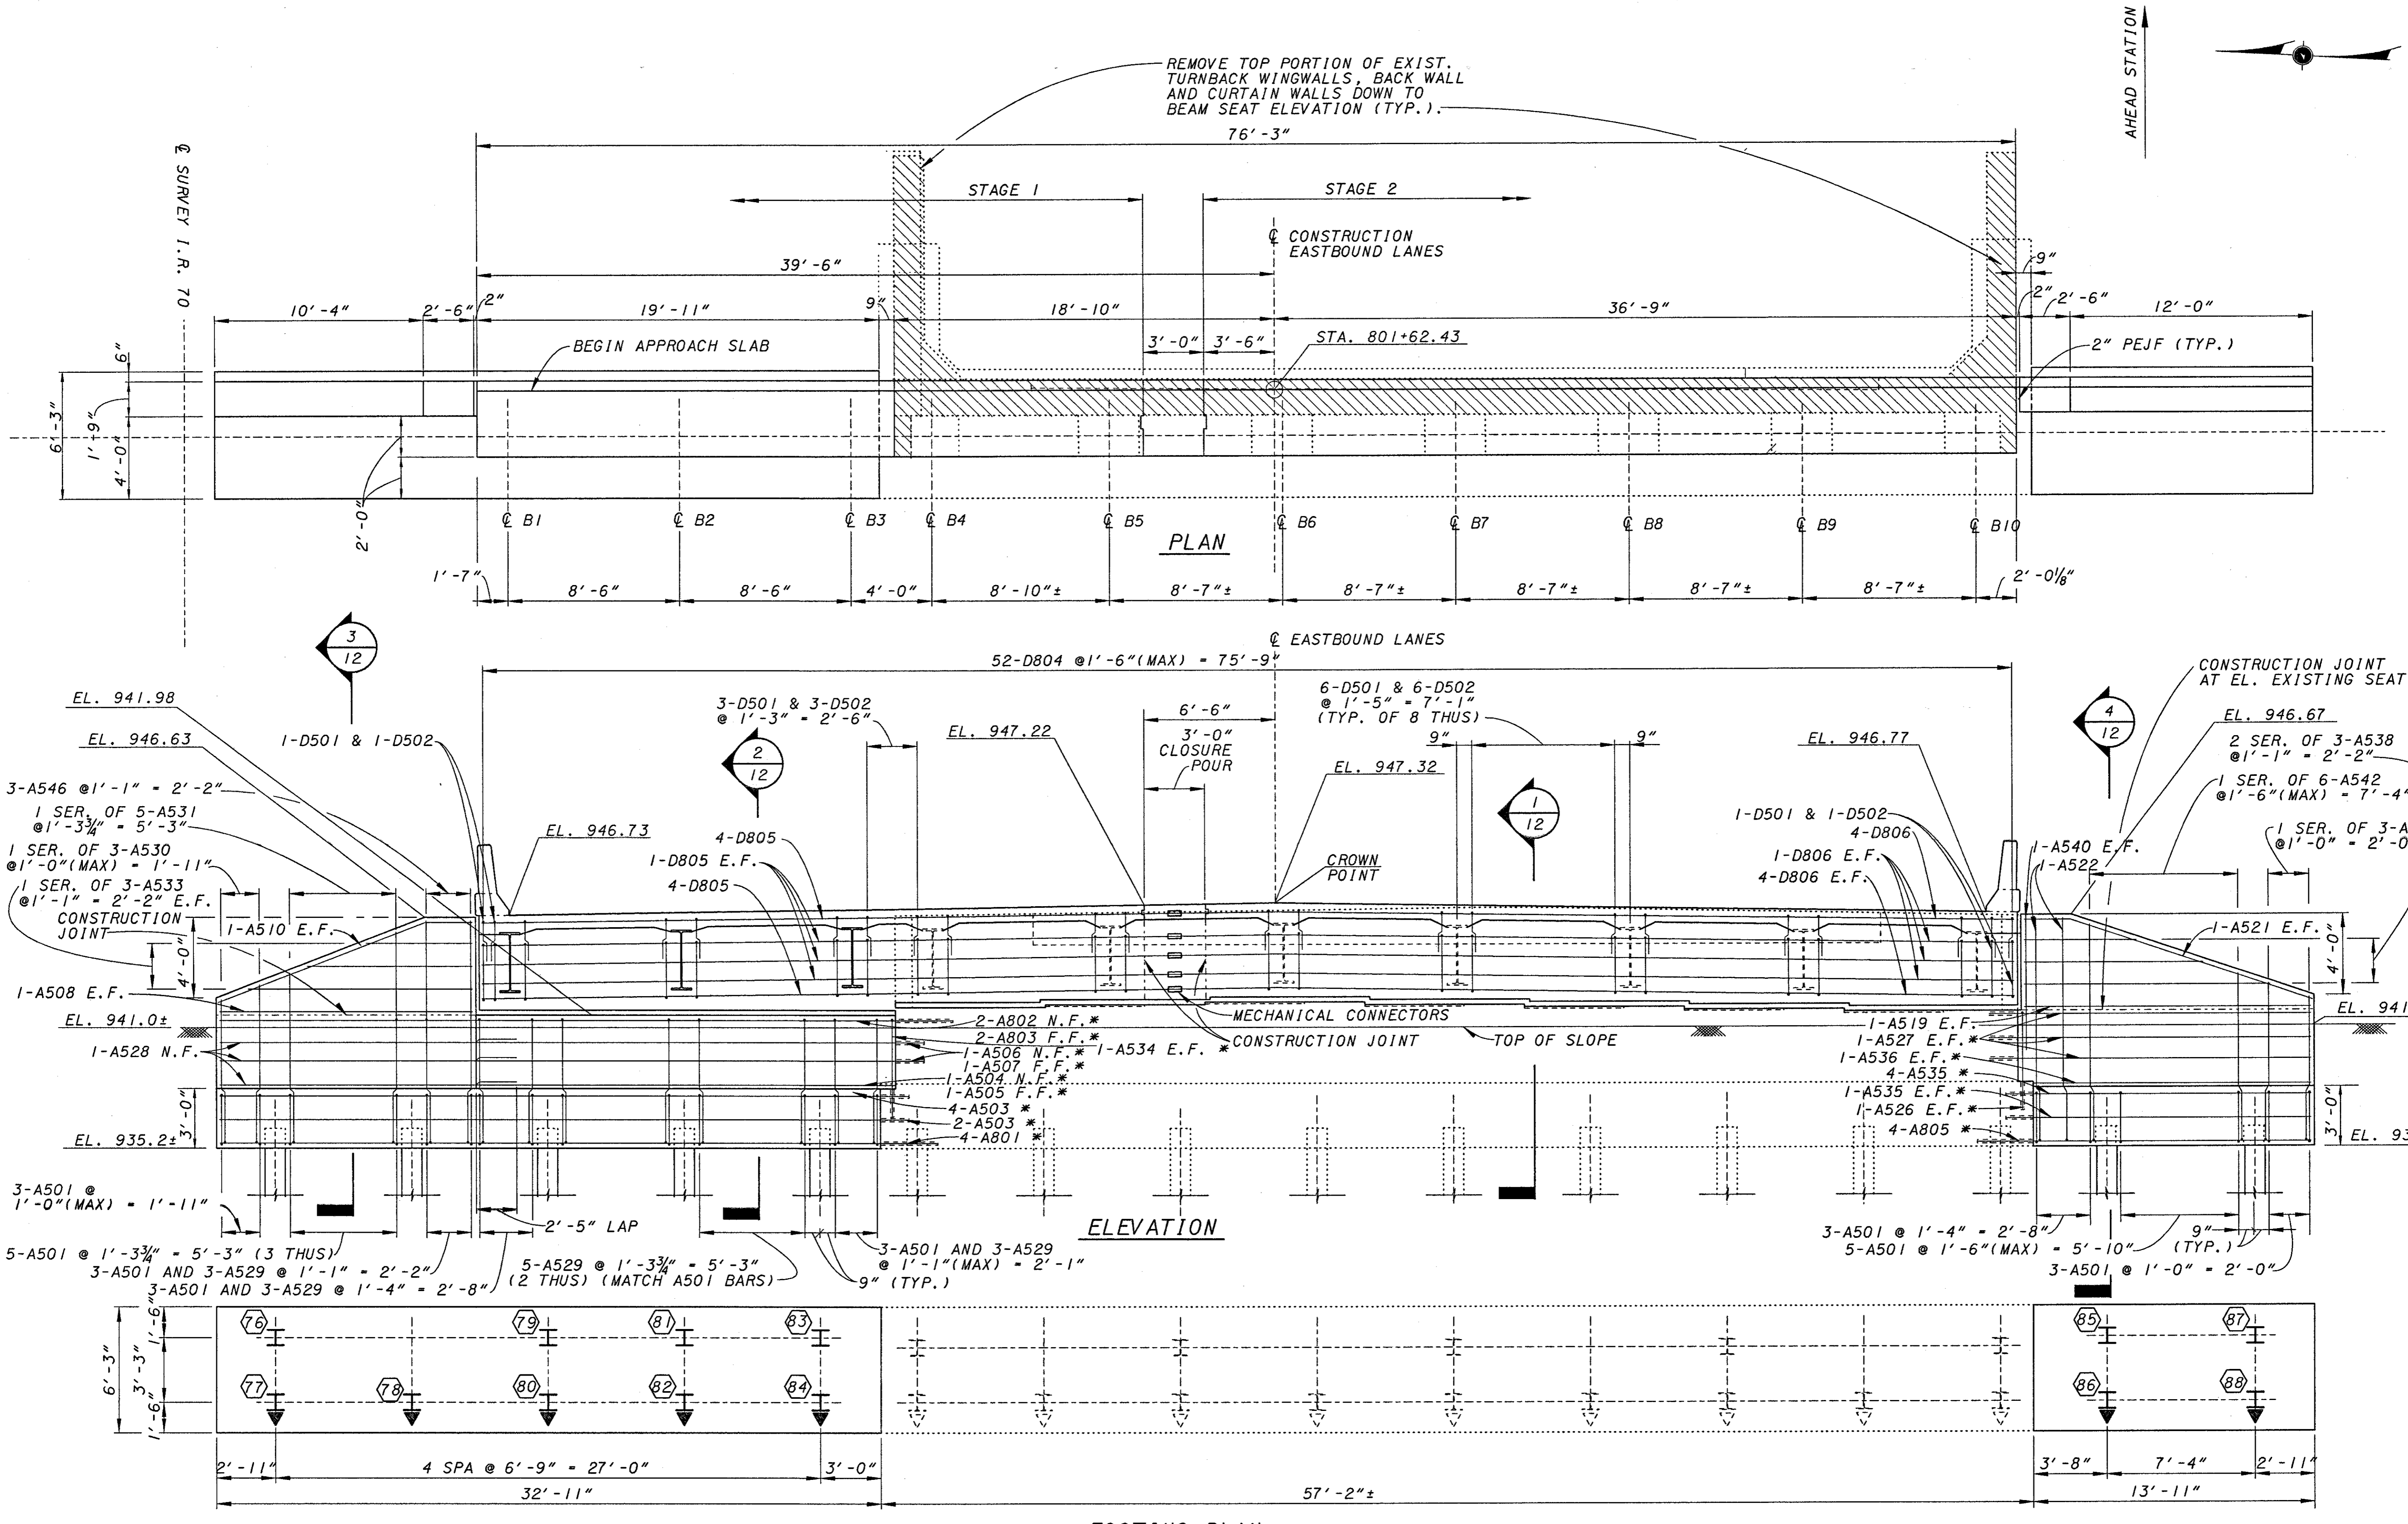

REMOVE TOP PORTION OF EXIST. TURNBACK WINGWALLS, BACK WALL AND CURTAIN WALLS DOWN TO BEAM SEAT ELEVATION (TYP.).

76'-3"

STAGE 1

STAGE 2

CONSTRUCTION EASTBOUND LANES

39'-6"

18'-10"

36'-9"

BEGIN APPROACH SLAB

SURVEY I.R. 70

PLAN

ELEVATION

FOOTING PLAN

LEGEND






- PEJF - PREFORMED EXPANSION JOINT FILLER
- E.F. - EACH FACE
- N.F. - NEAR FACE
- F.F. - FAR FACE
- APP. - APPROXIMATELY

- DENOTES PROPOSED HP10x42 PILE BATTERED AT 1:4
- DENOTES VERTICAL HP10x42 PILE

DENOTES PORTION OF EXISTING STRUCTURE TO BE REMOVED



FORWARD ABUTMENT PILE NUMBER

* DOWEL #5 BARS 1'-5" (MIN.) AND #8 BARS 2'-10" (MIN.) INTO EXISTING ABUTMENT FOOTING AND BREASTWALL.

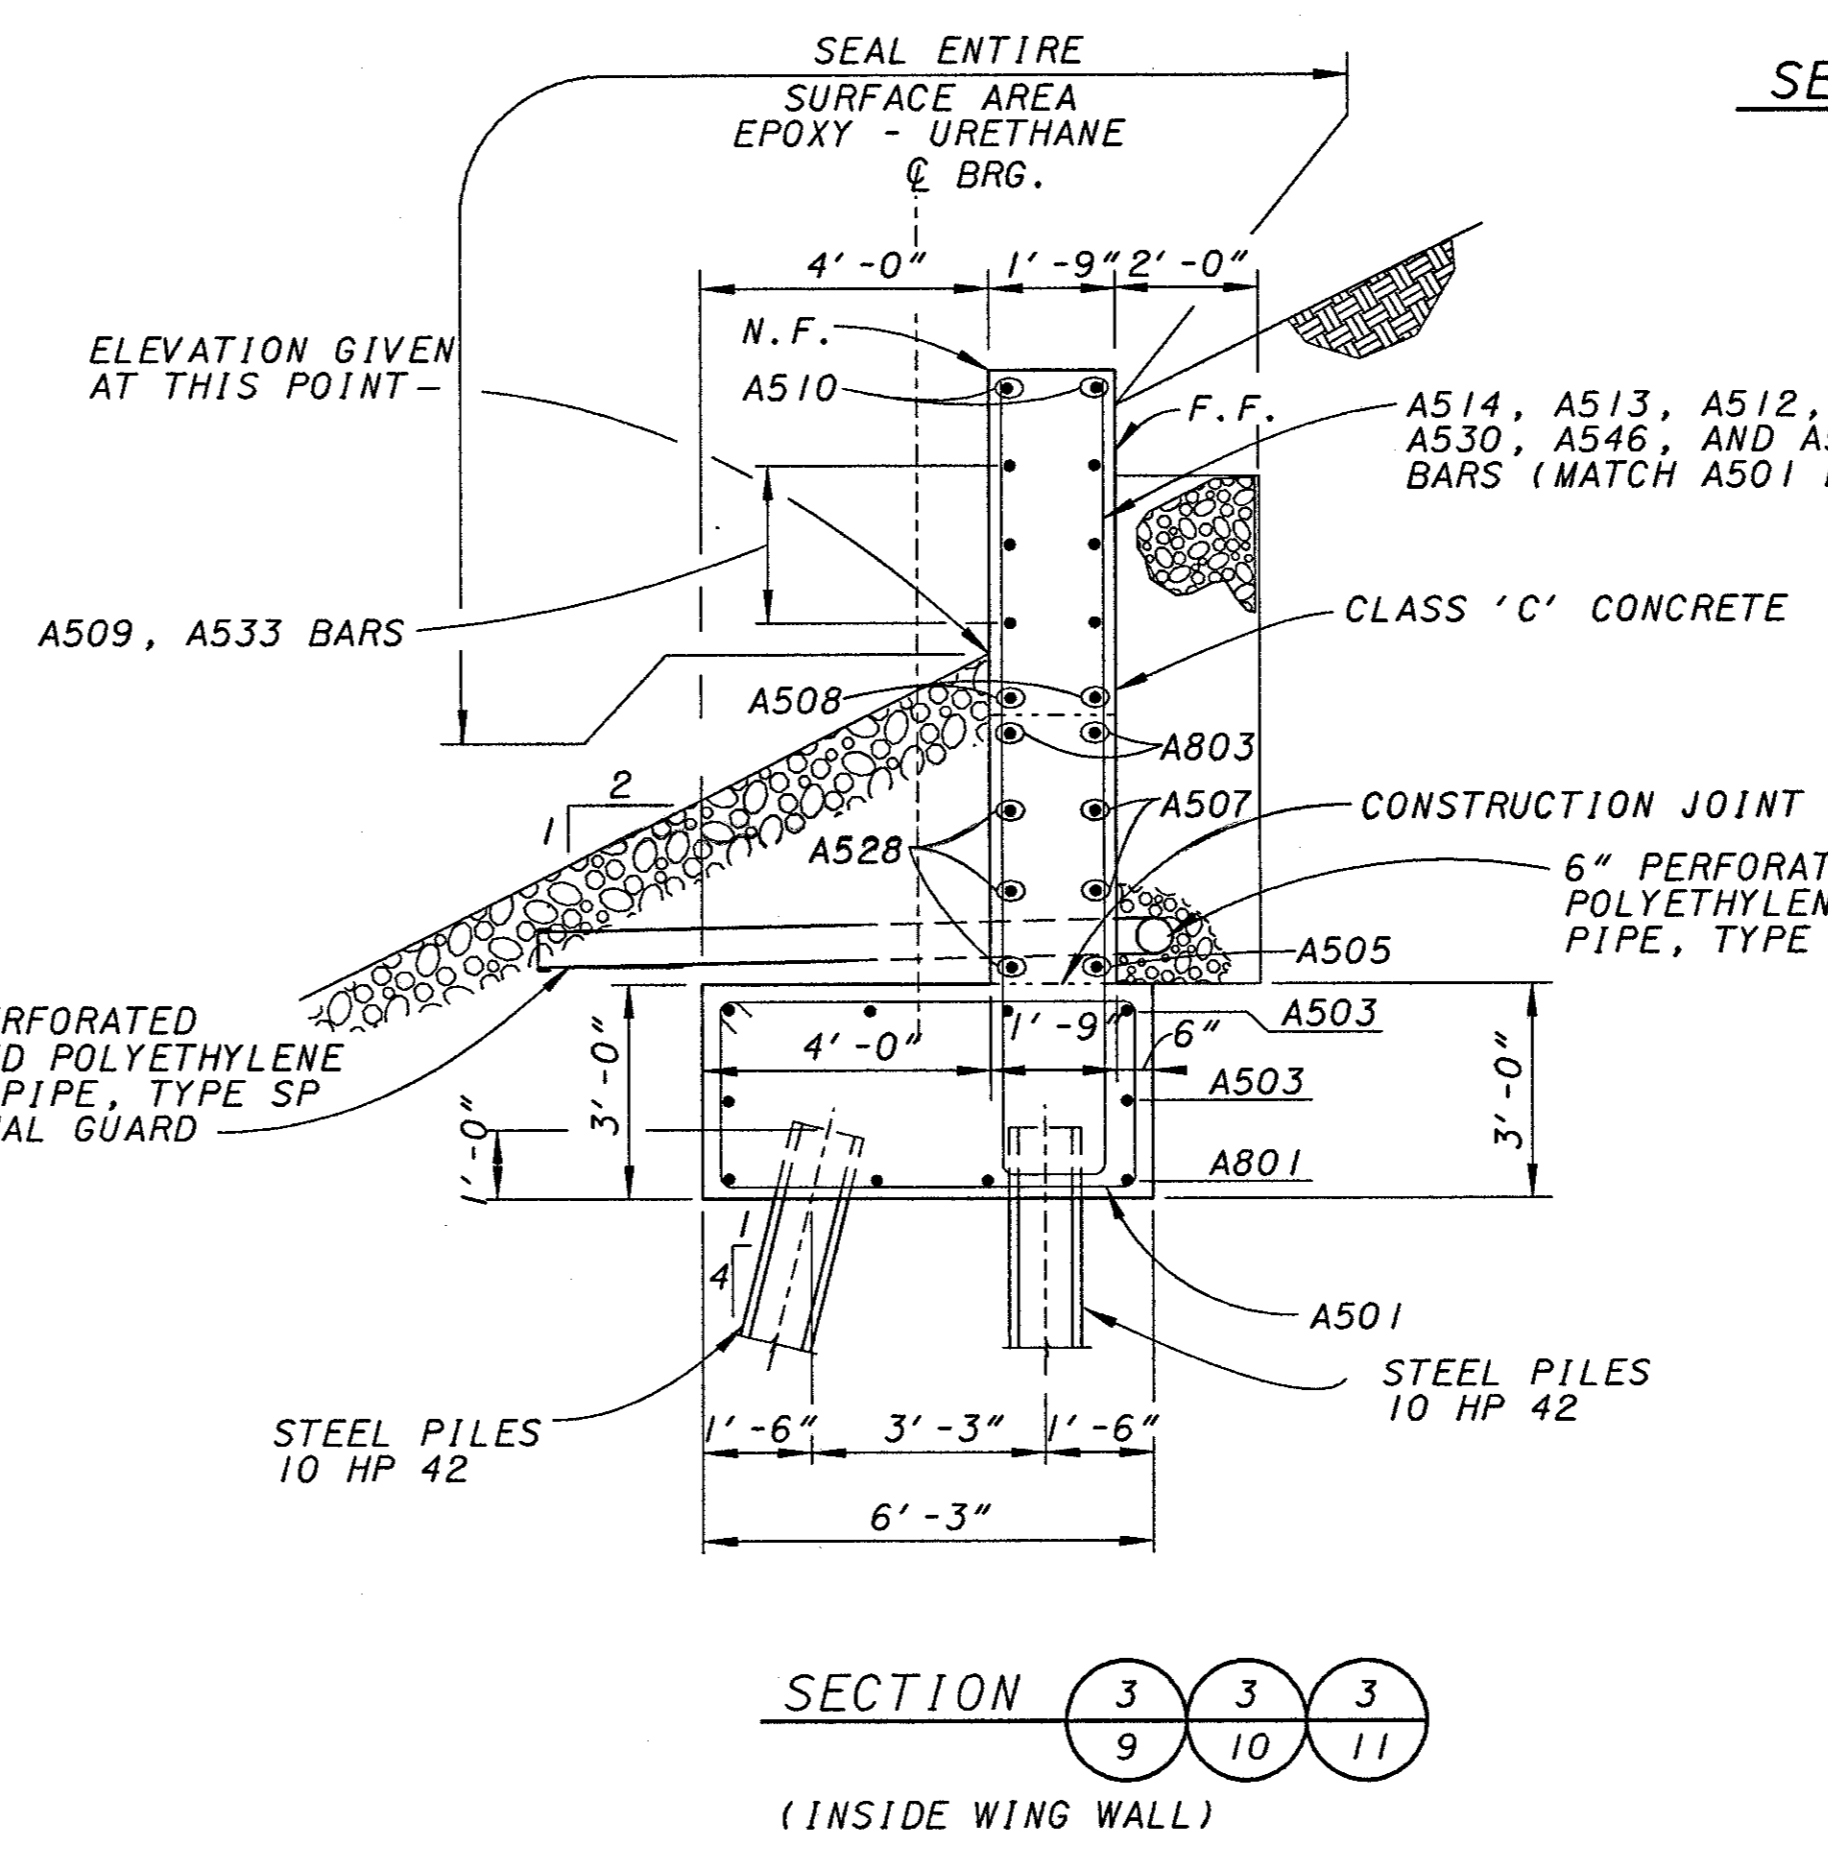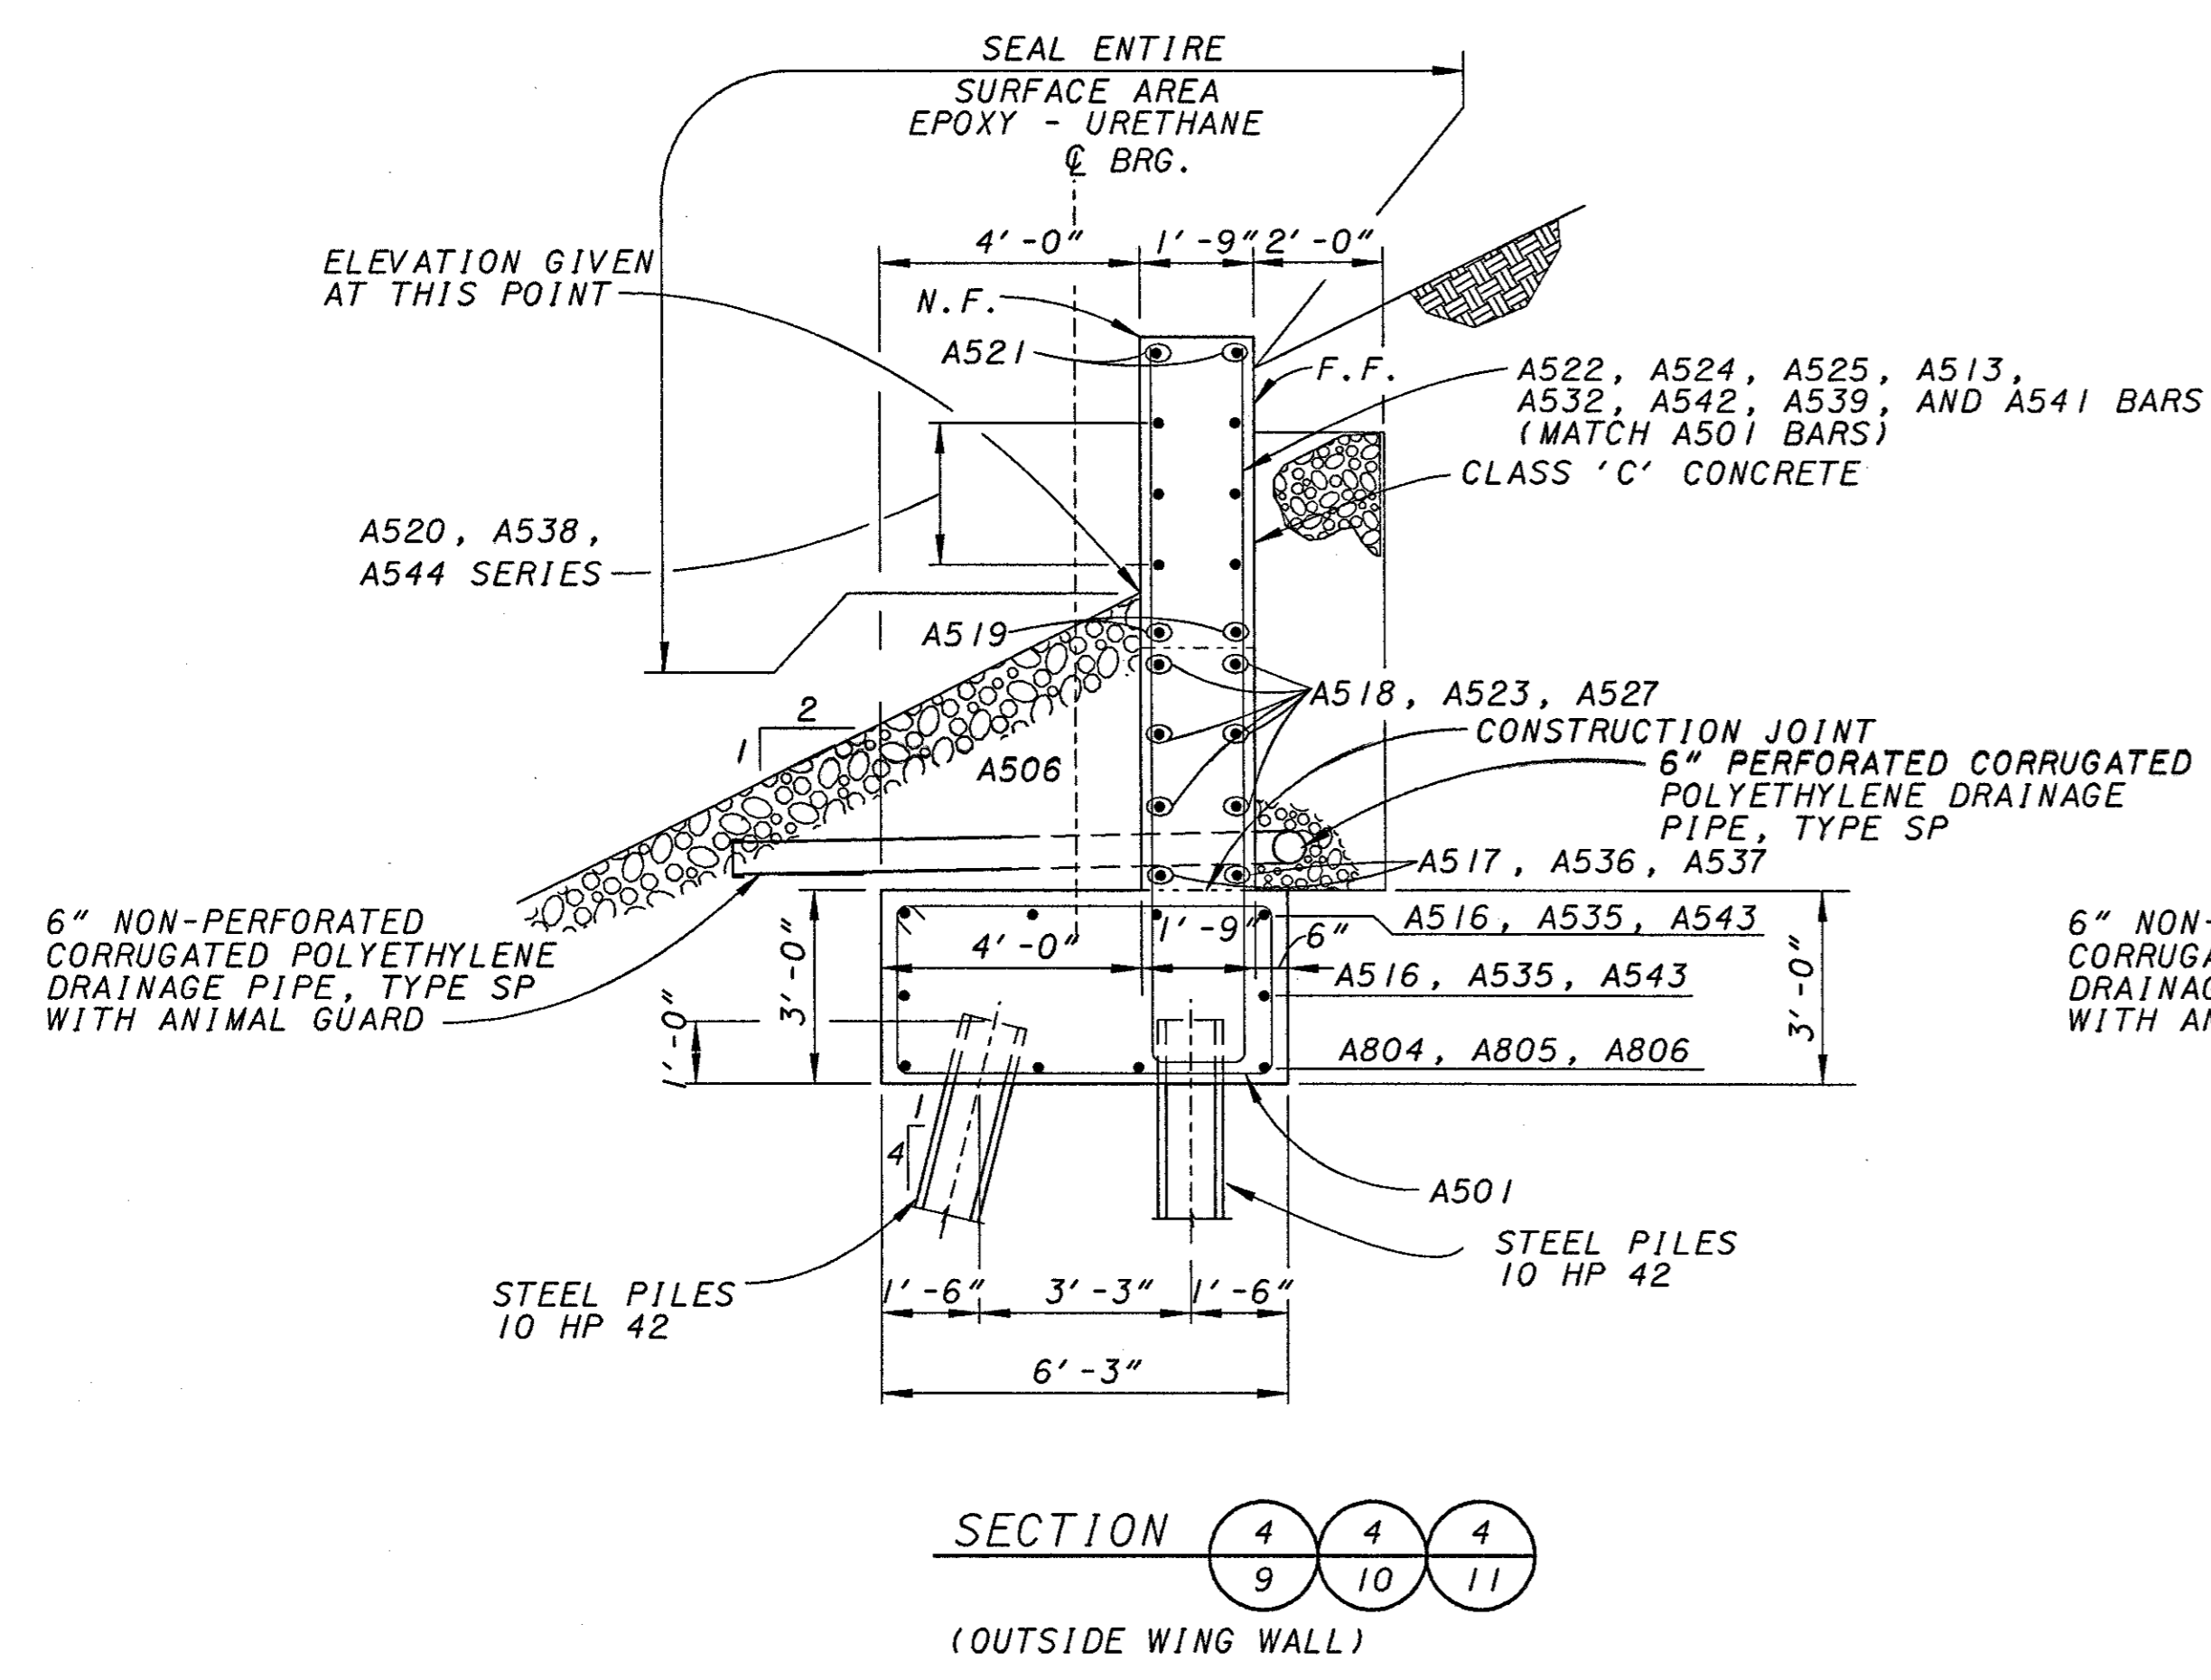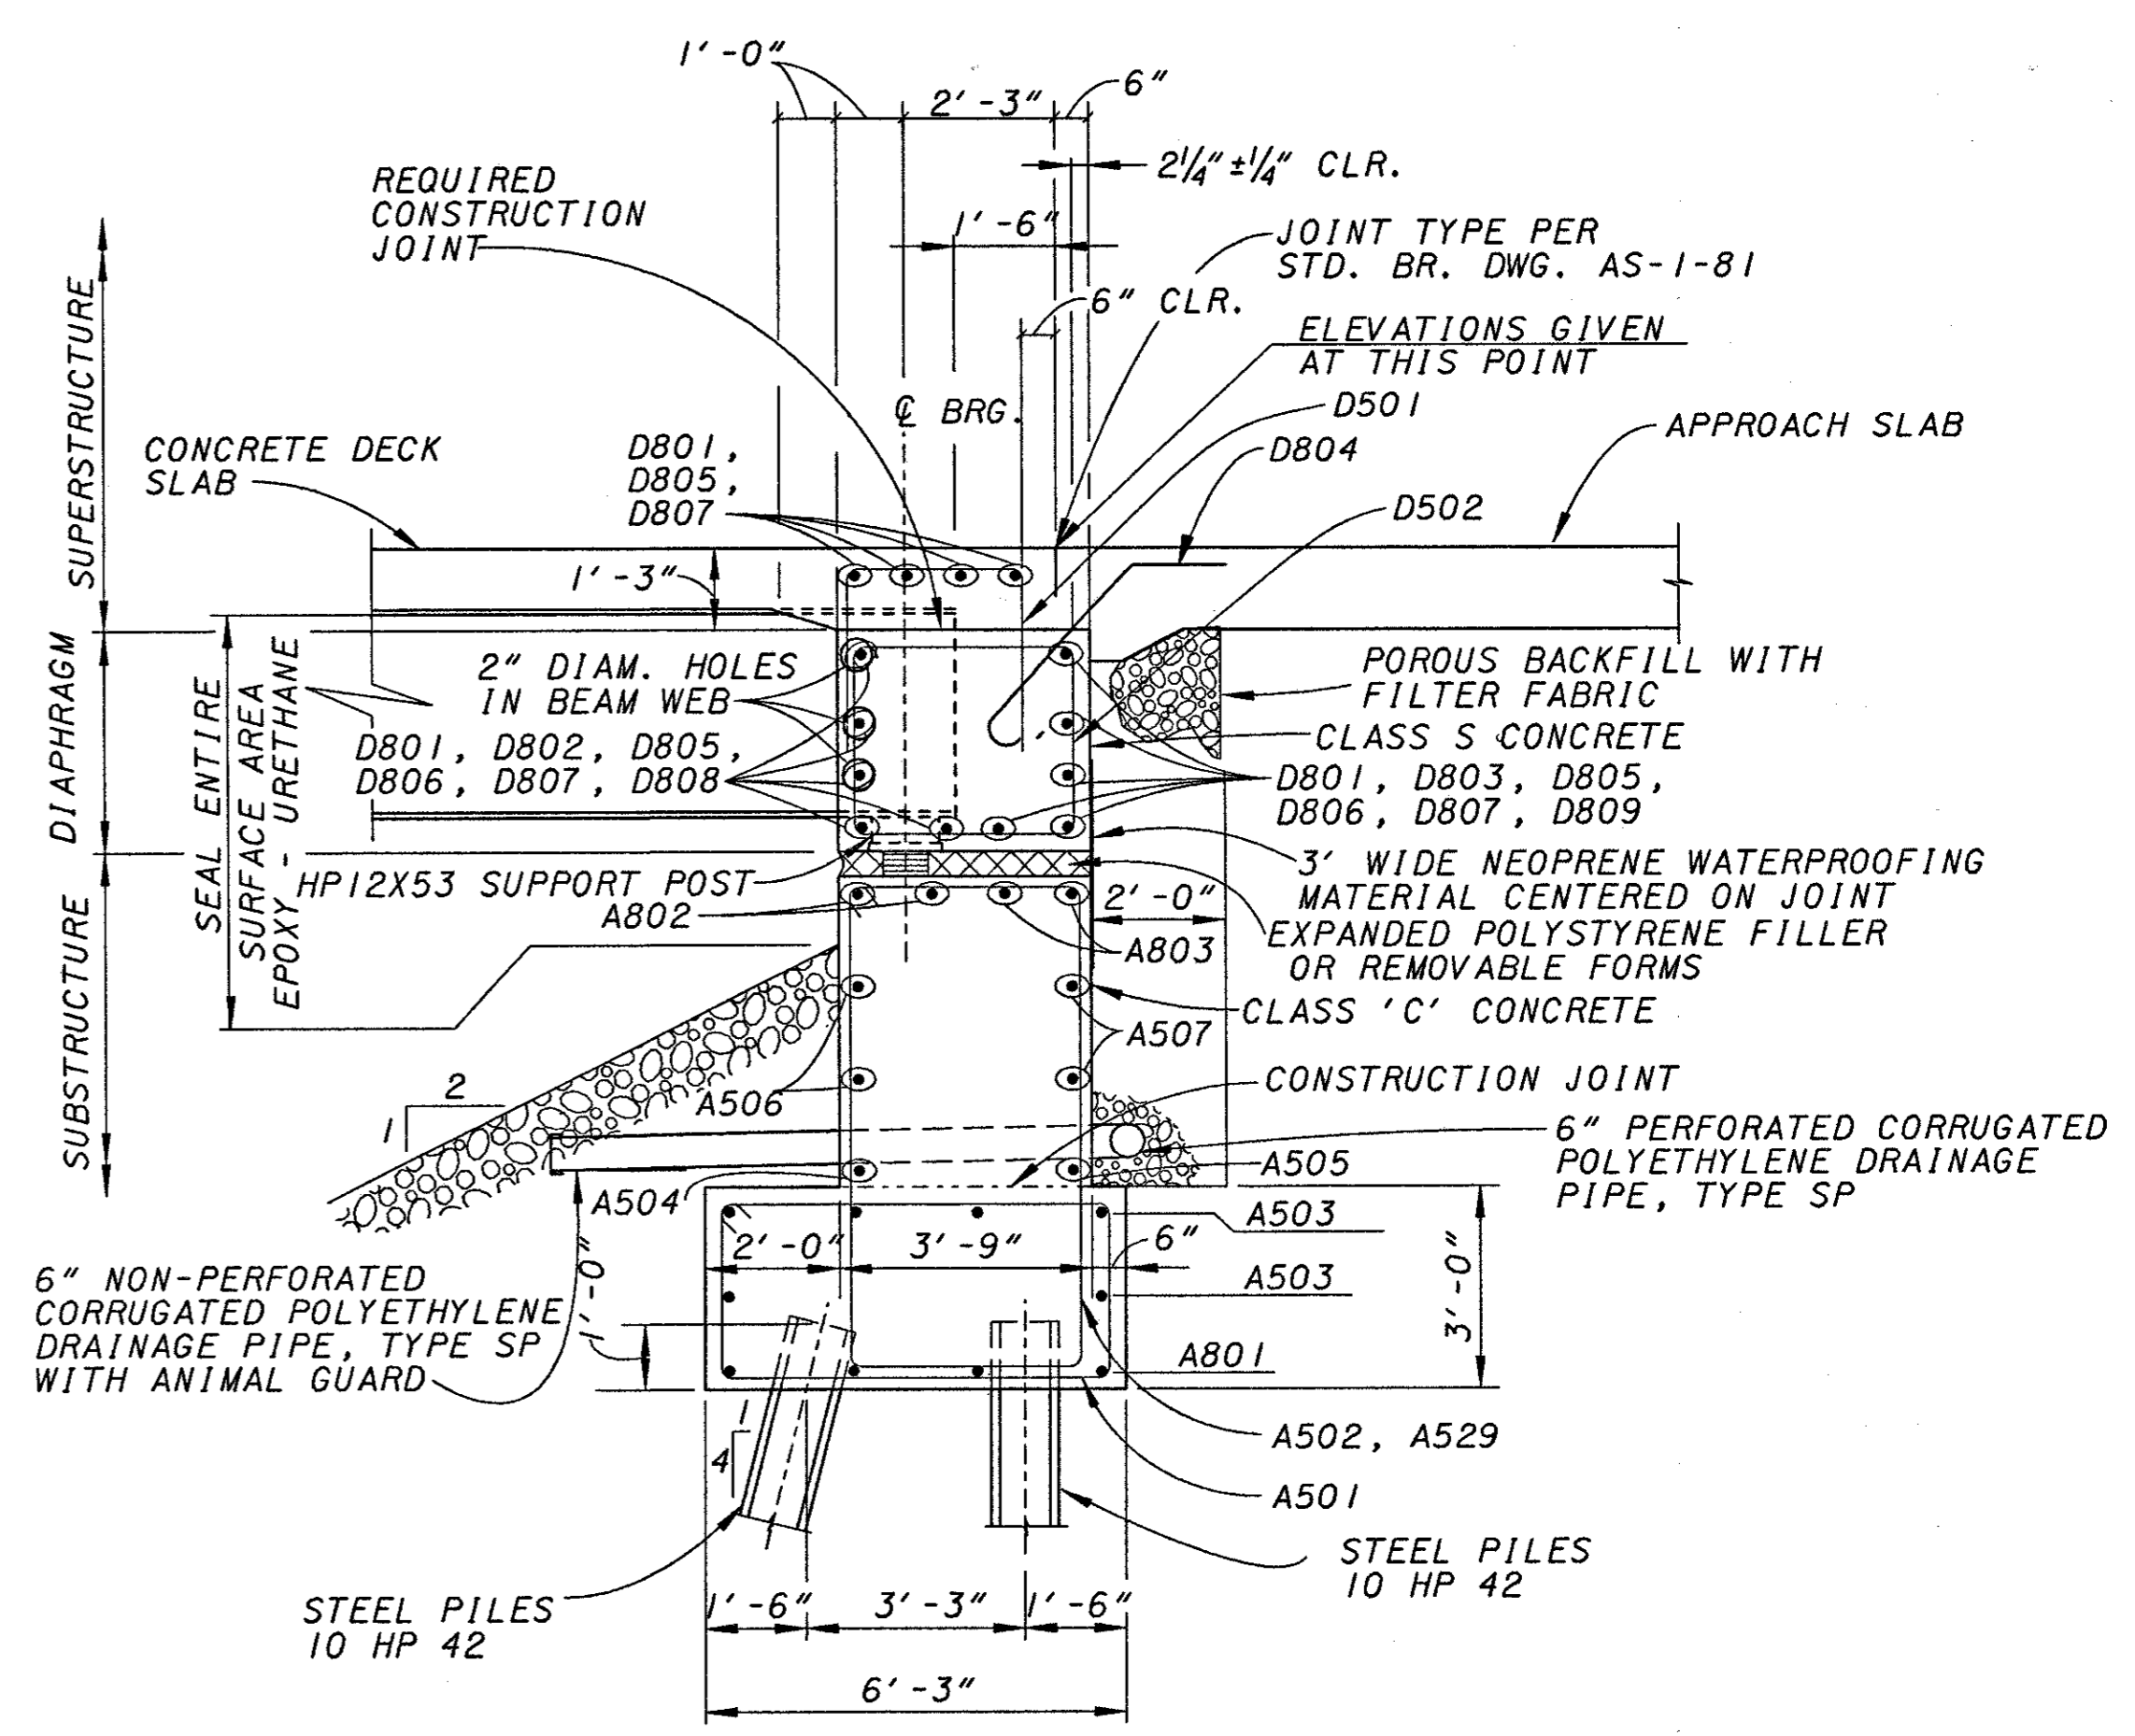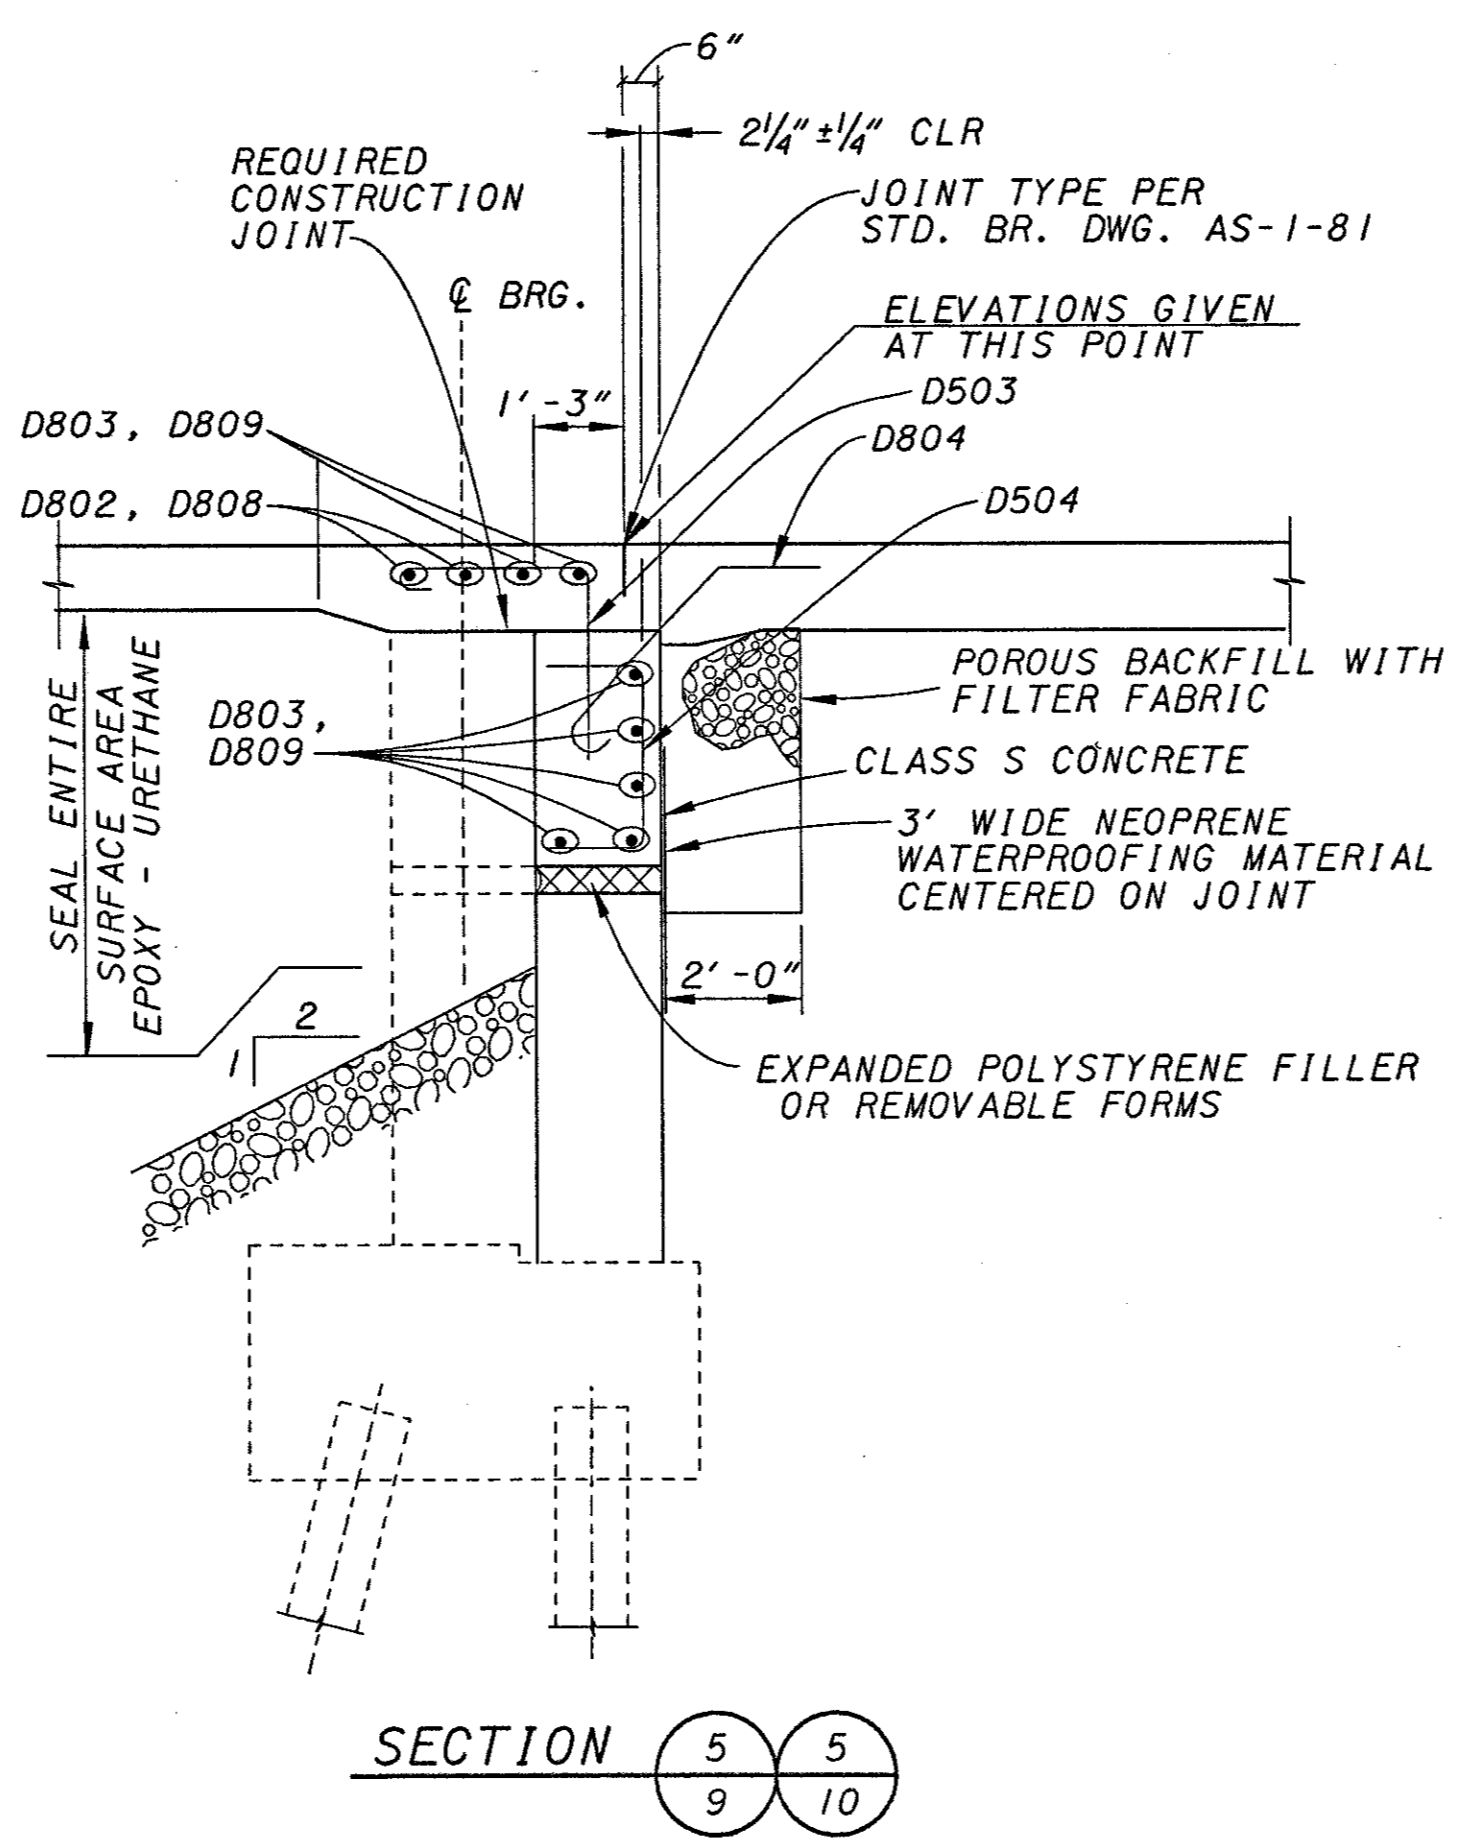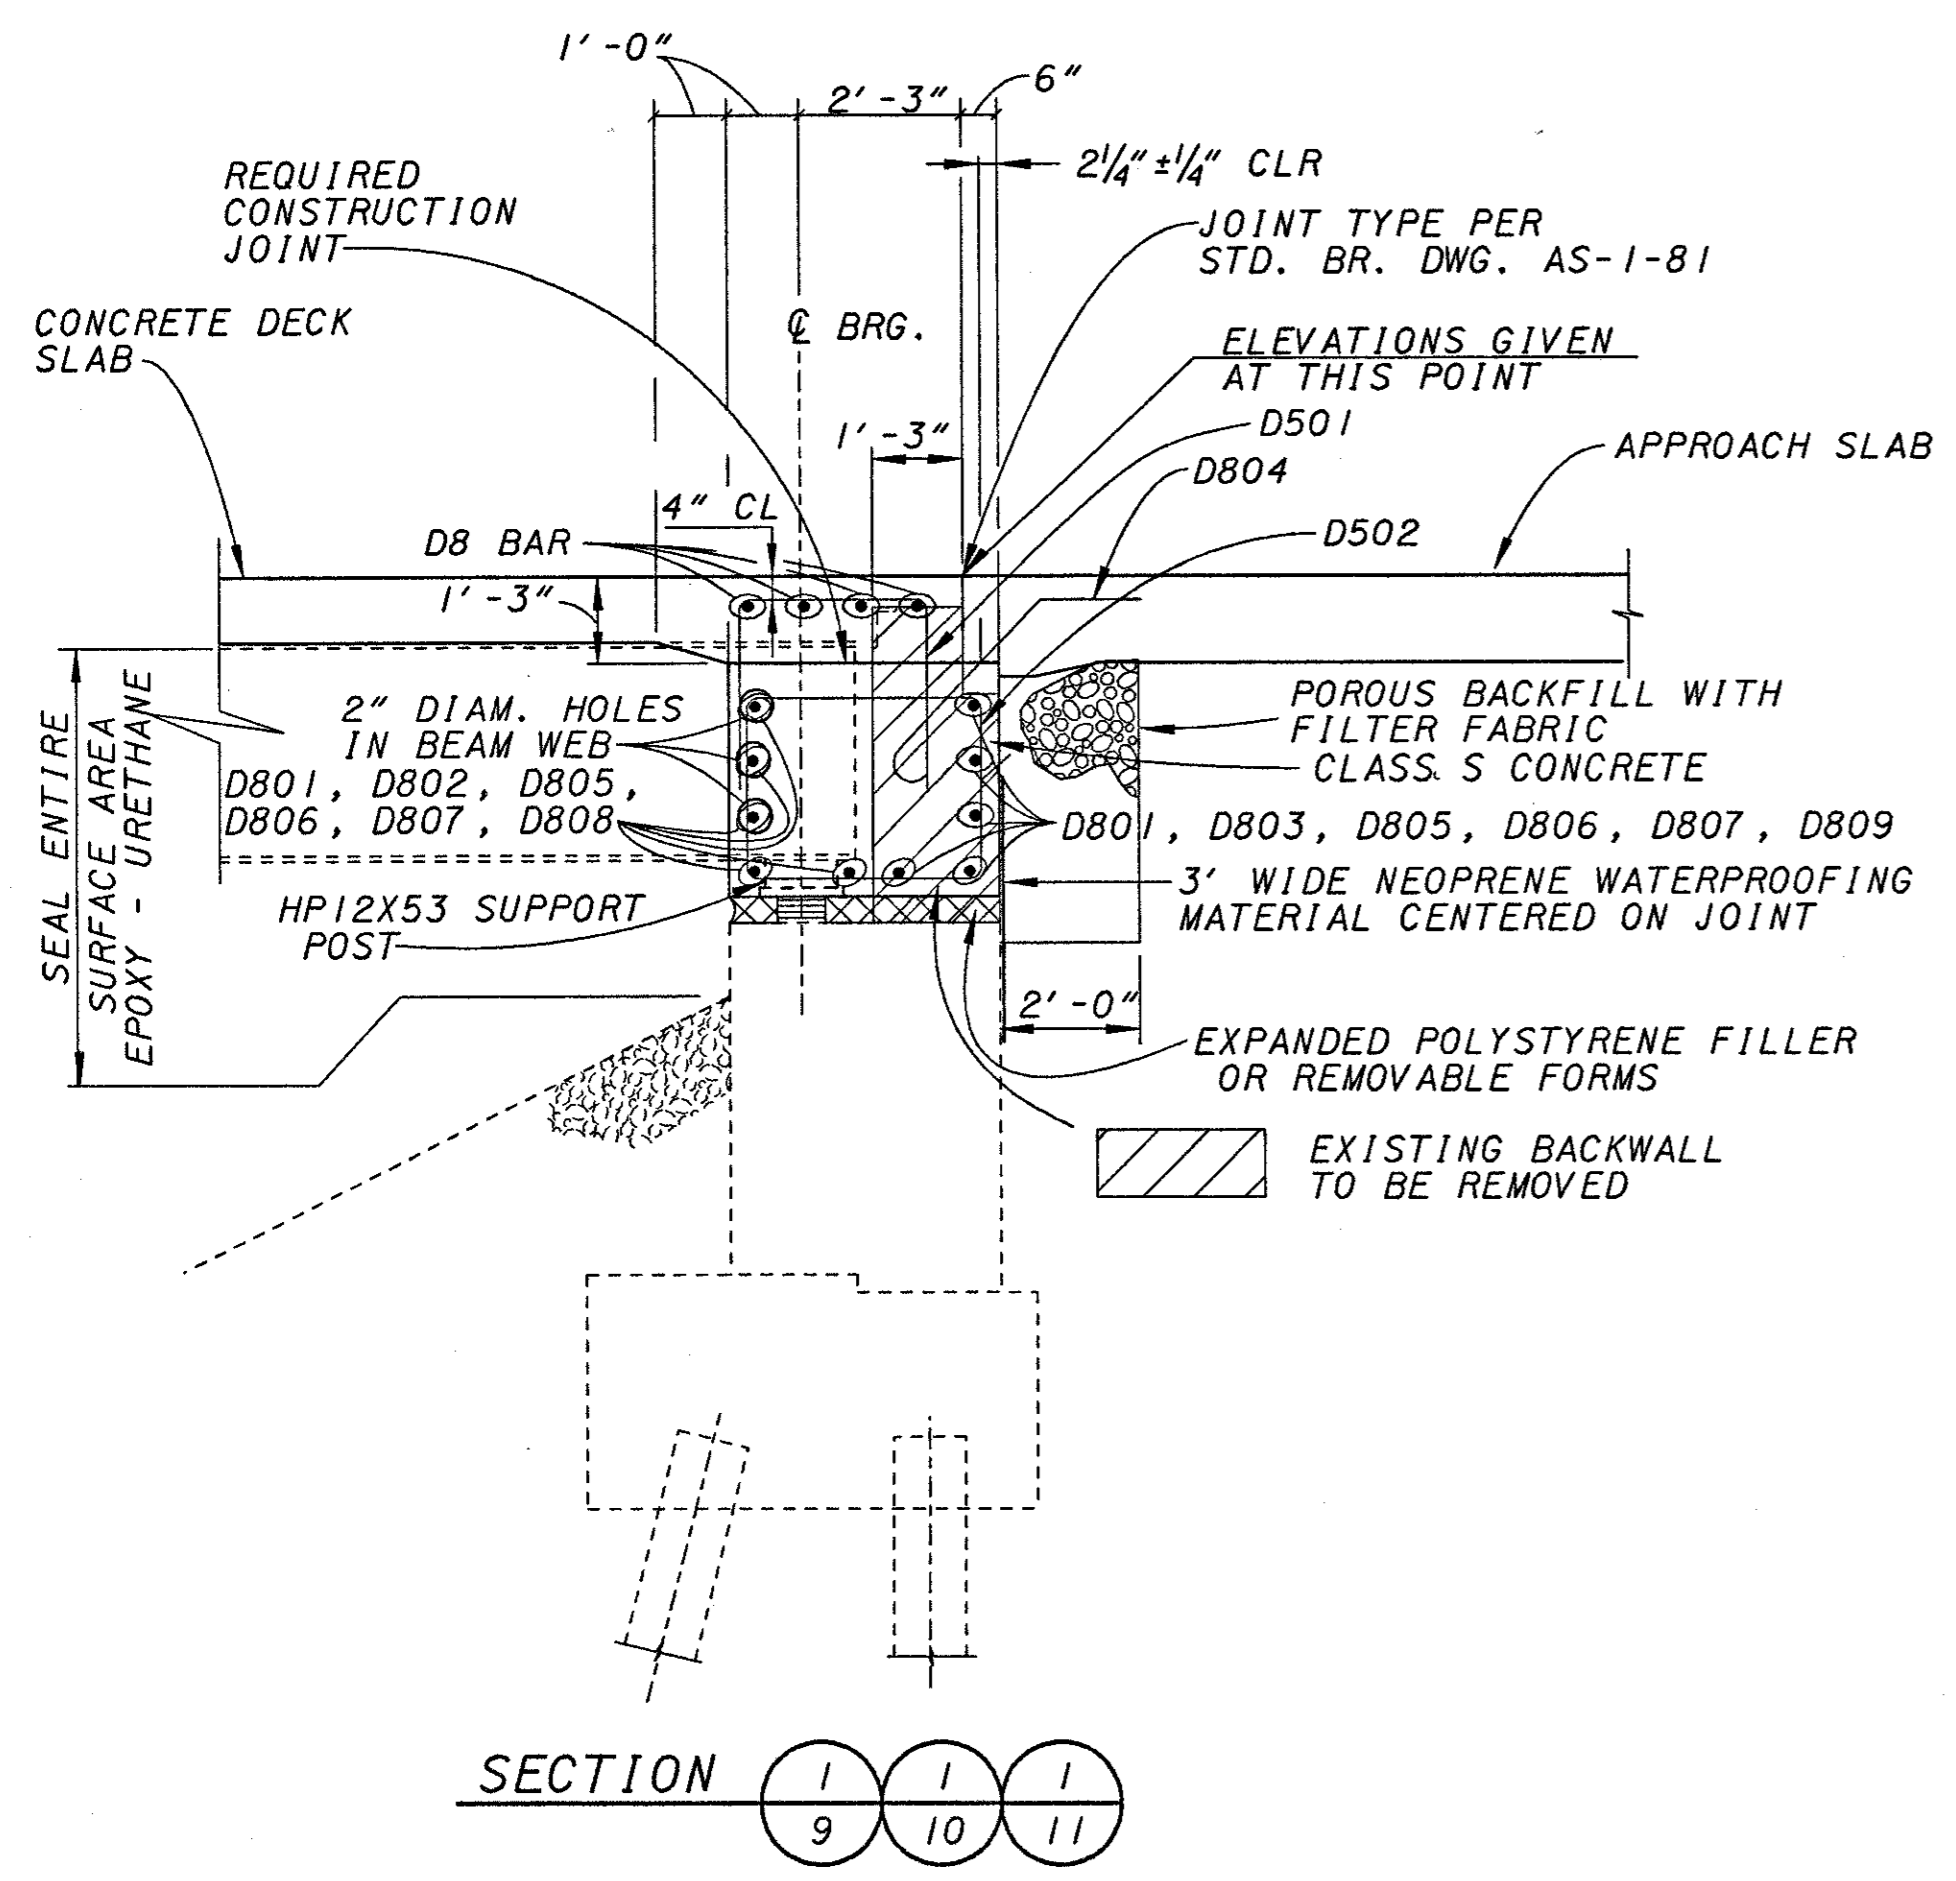

- NOTES:**
- SEE STD. DWG. SICD-1-96M FOR ADDITIONAL DETAILS.
 - SEE SHEET 22/32 FOR BEARING DETAILS.
 - POROUS BACKFILL WITH FILTER FABRIC, 2'-0" THICK SHALL EXTEND UP TO THE PLANE OF THE SUBGRADE, TO 1'-0" BELOW THE EMBANKMENT SURFACE AND LATERALLY TO THE ENDS OF THE WINGWALLS. GEOTEXTILE FABRIC SHALL CONFORM WITH 712.09, TYPE A. TURN GEOTEXTILE FABRIC UP 6" ALONG BACK OF WALL. GEOTEXTILE FABRIC SHALL BE INCLUDED WITH POROUS BACKFILL FOR PAYMENT.
 - BRIDGE SEAT REINFORCING STEEL IN THE VICINITY OF THE BRIDGE SEAT SHALL BE ACCURATELY PLACED TO AVOID INTERFERENCE WITH THE DRILLING OF RETAINER BOLT HOLES.

REF: A501, A502, A503, A999, A1000.

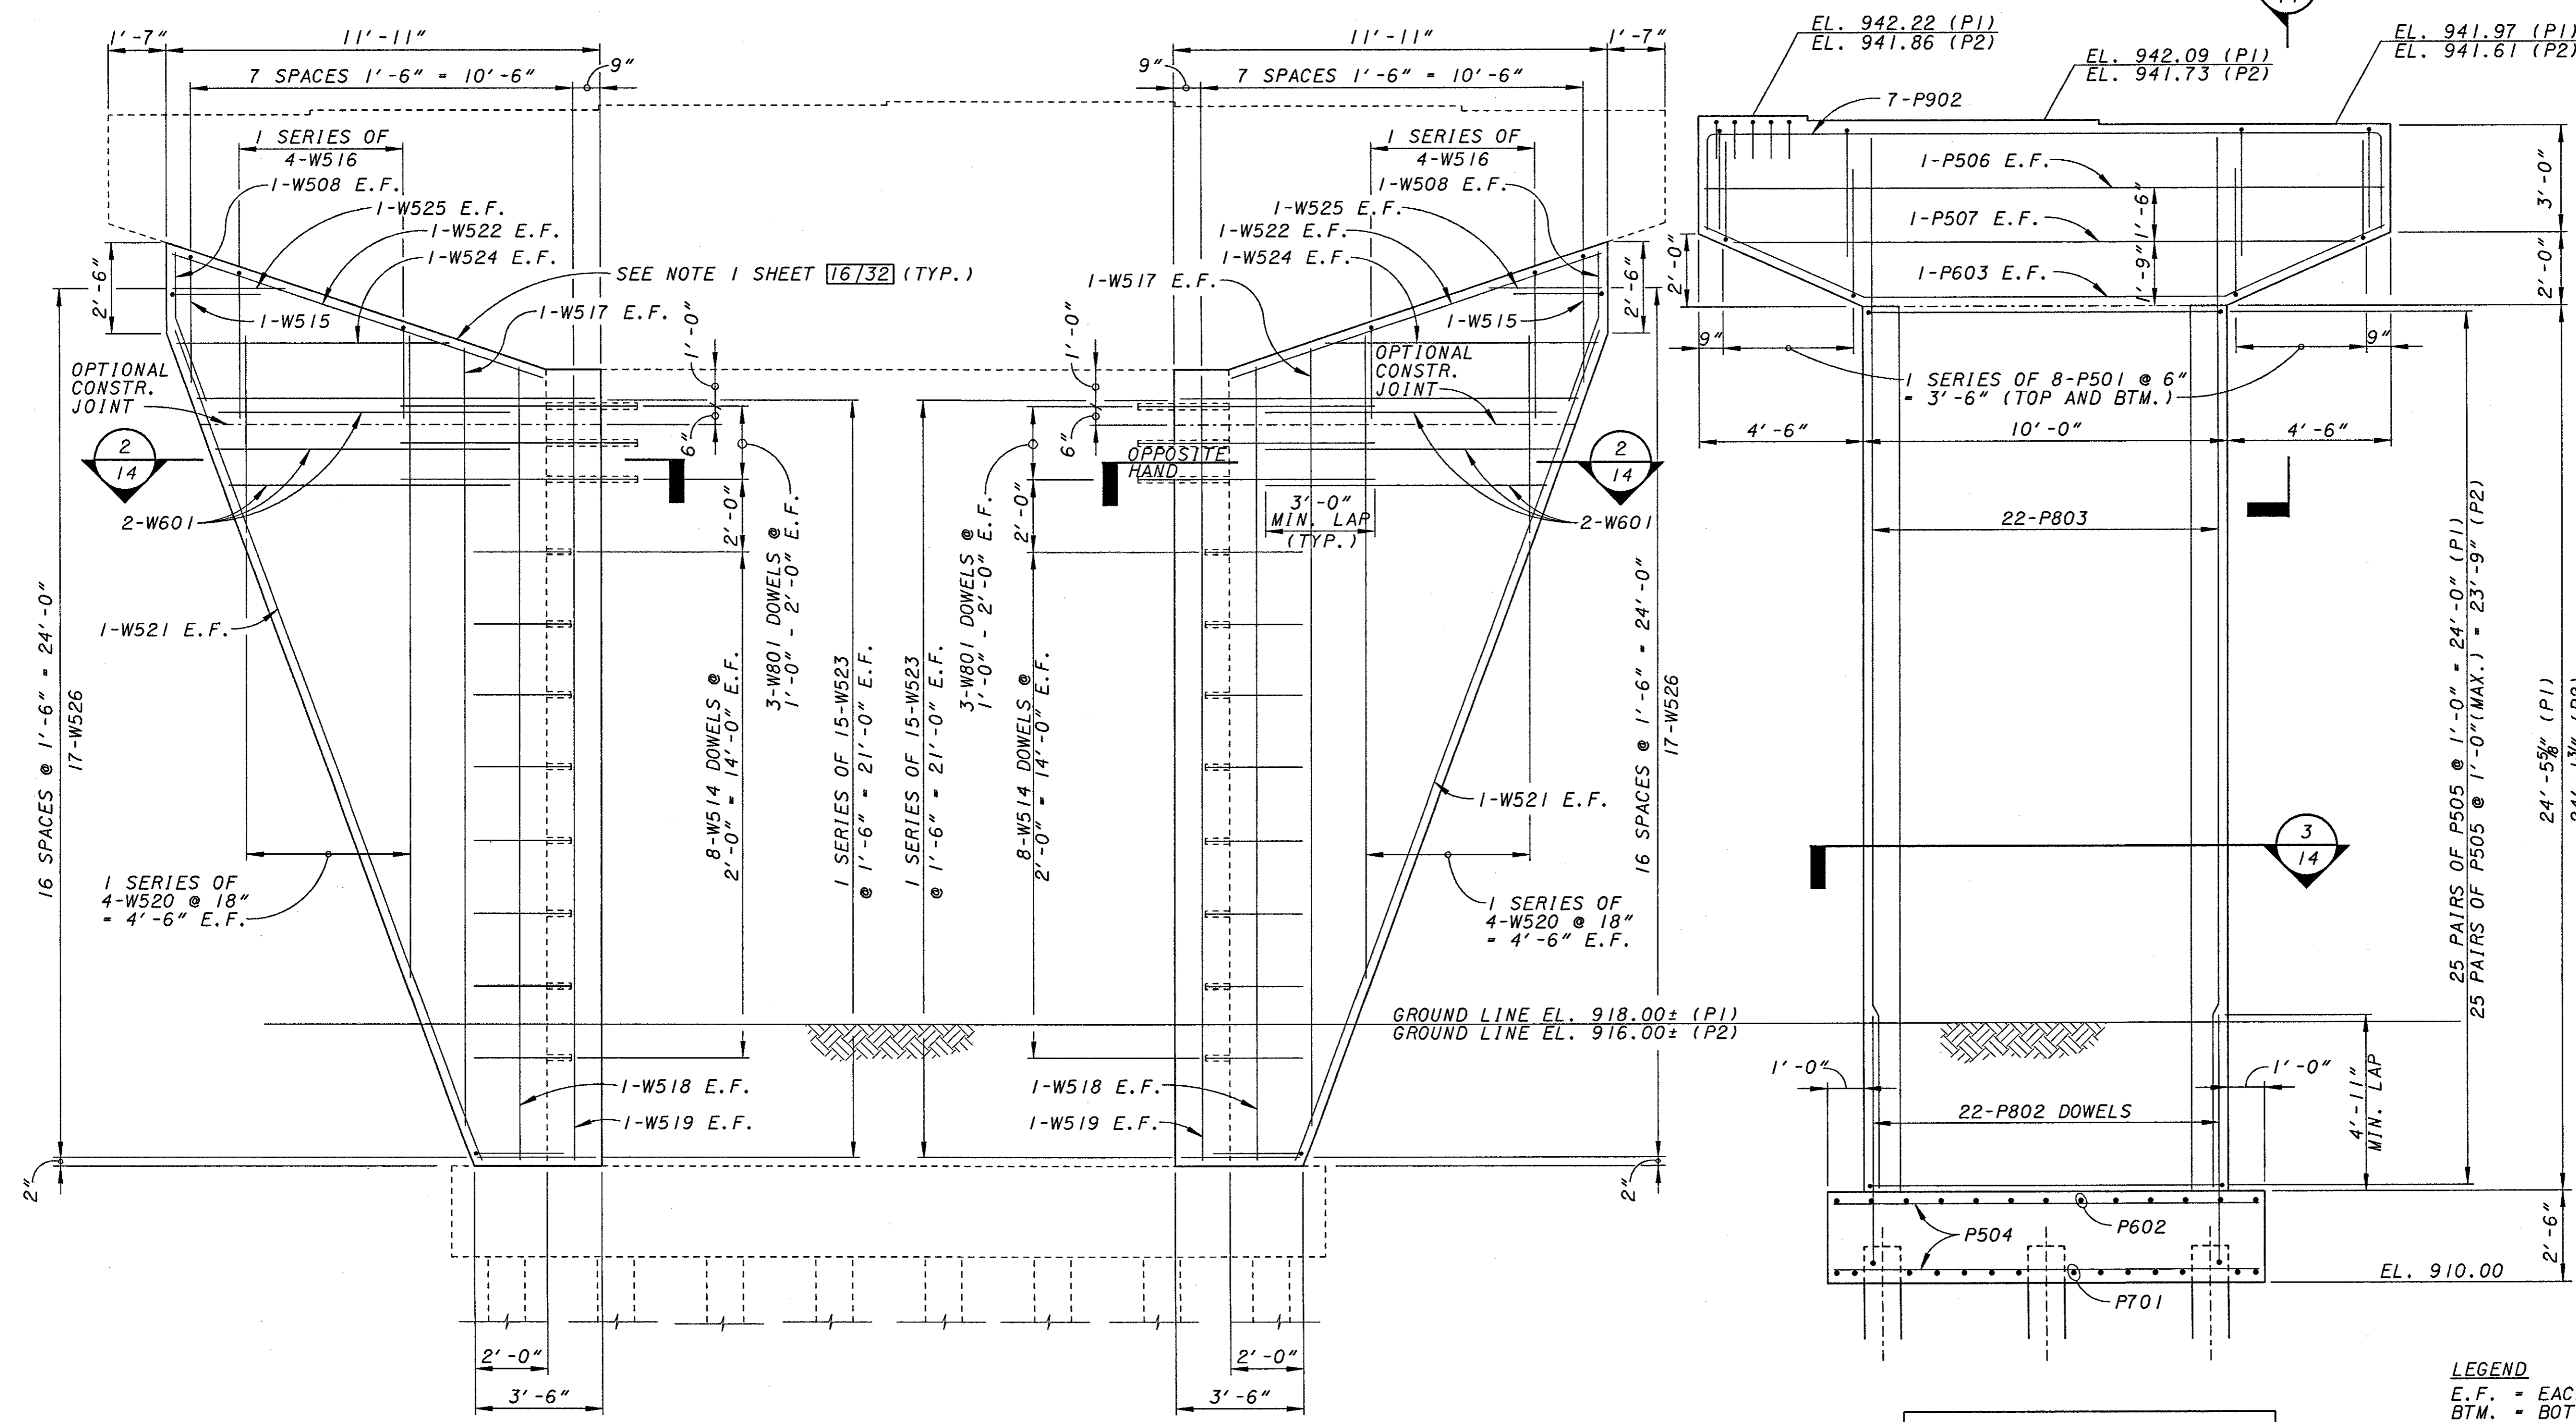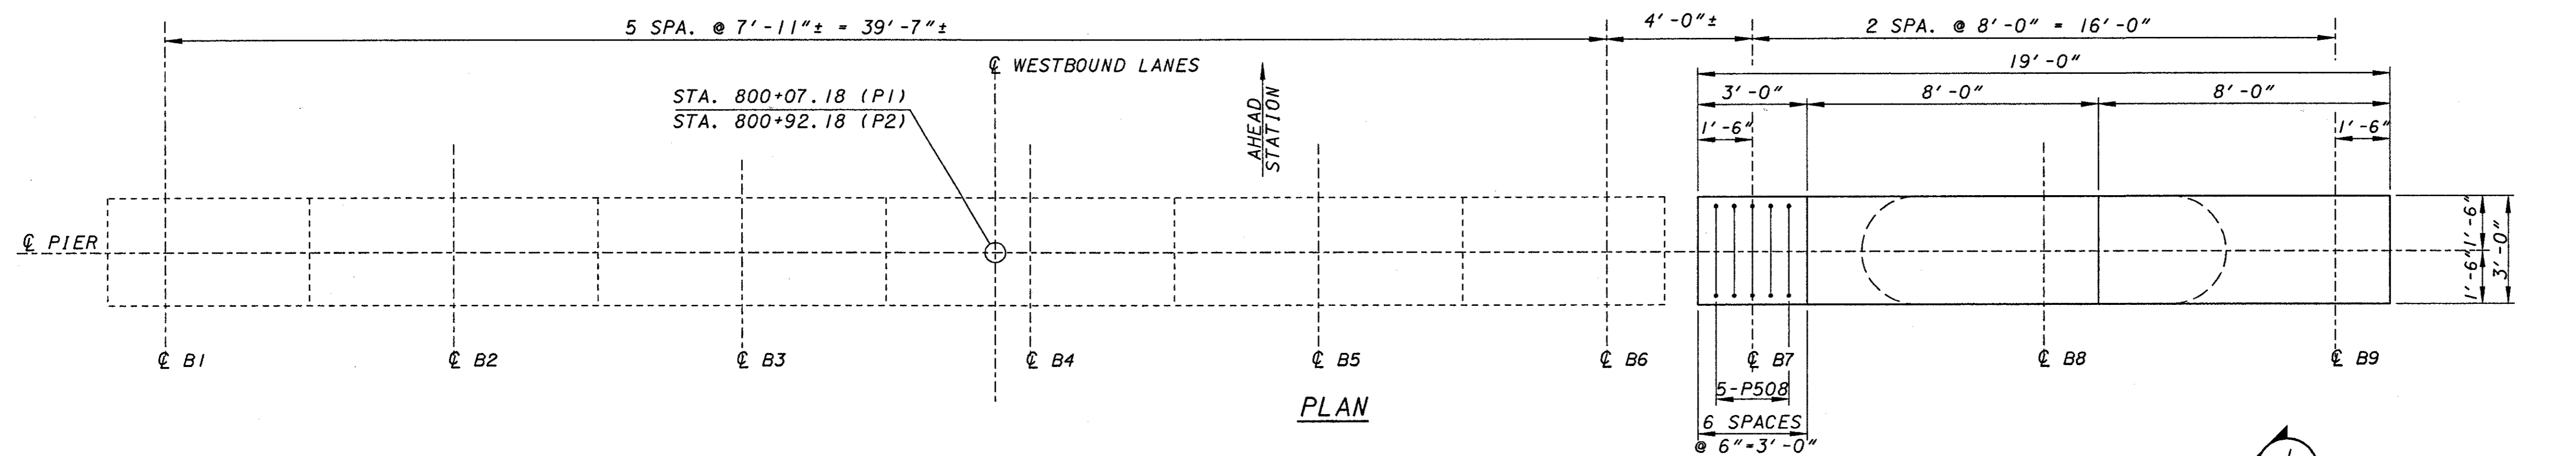

ALL STEEL CLEARANCES ARE 2" UNLESS OTHERWISE NOTED.

LEGEND
E.F. = EACH FACE
BTM. = BOTTOM
(P1) = PIER 1
(P2) = PIER 2

REF: **REVISIONS**
REF: **REVISIONS**
USER: *****
DATE: *****
PRJ: *****
SHEET: *****
ACTIVE LEVELS ON: *****



REF: **REF**
 REF: **REF**
 USER: *****
 PROJECT: *****
 SHEET: *****
 DATE: *****

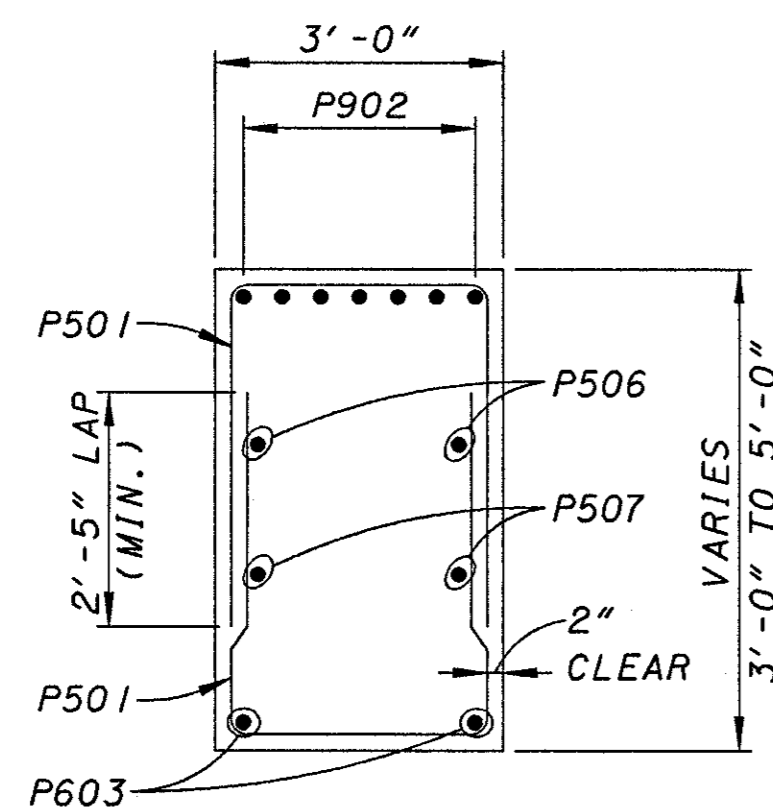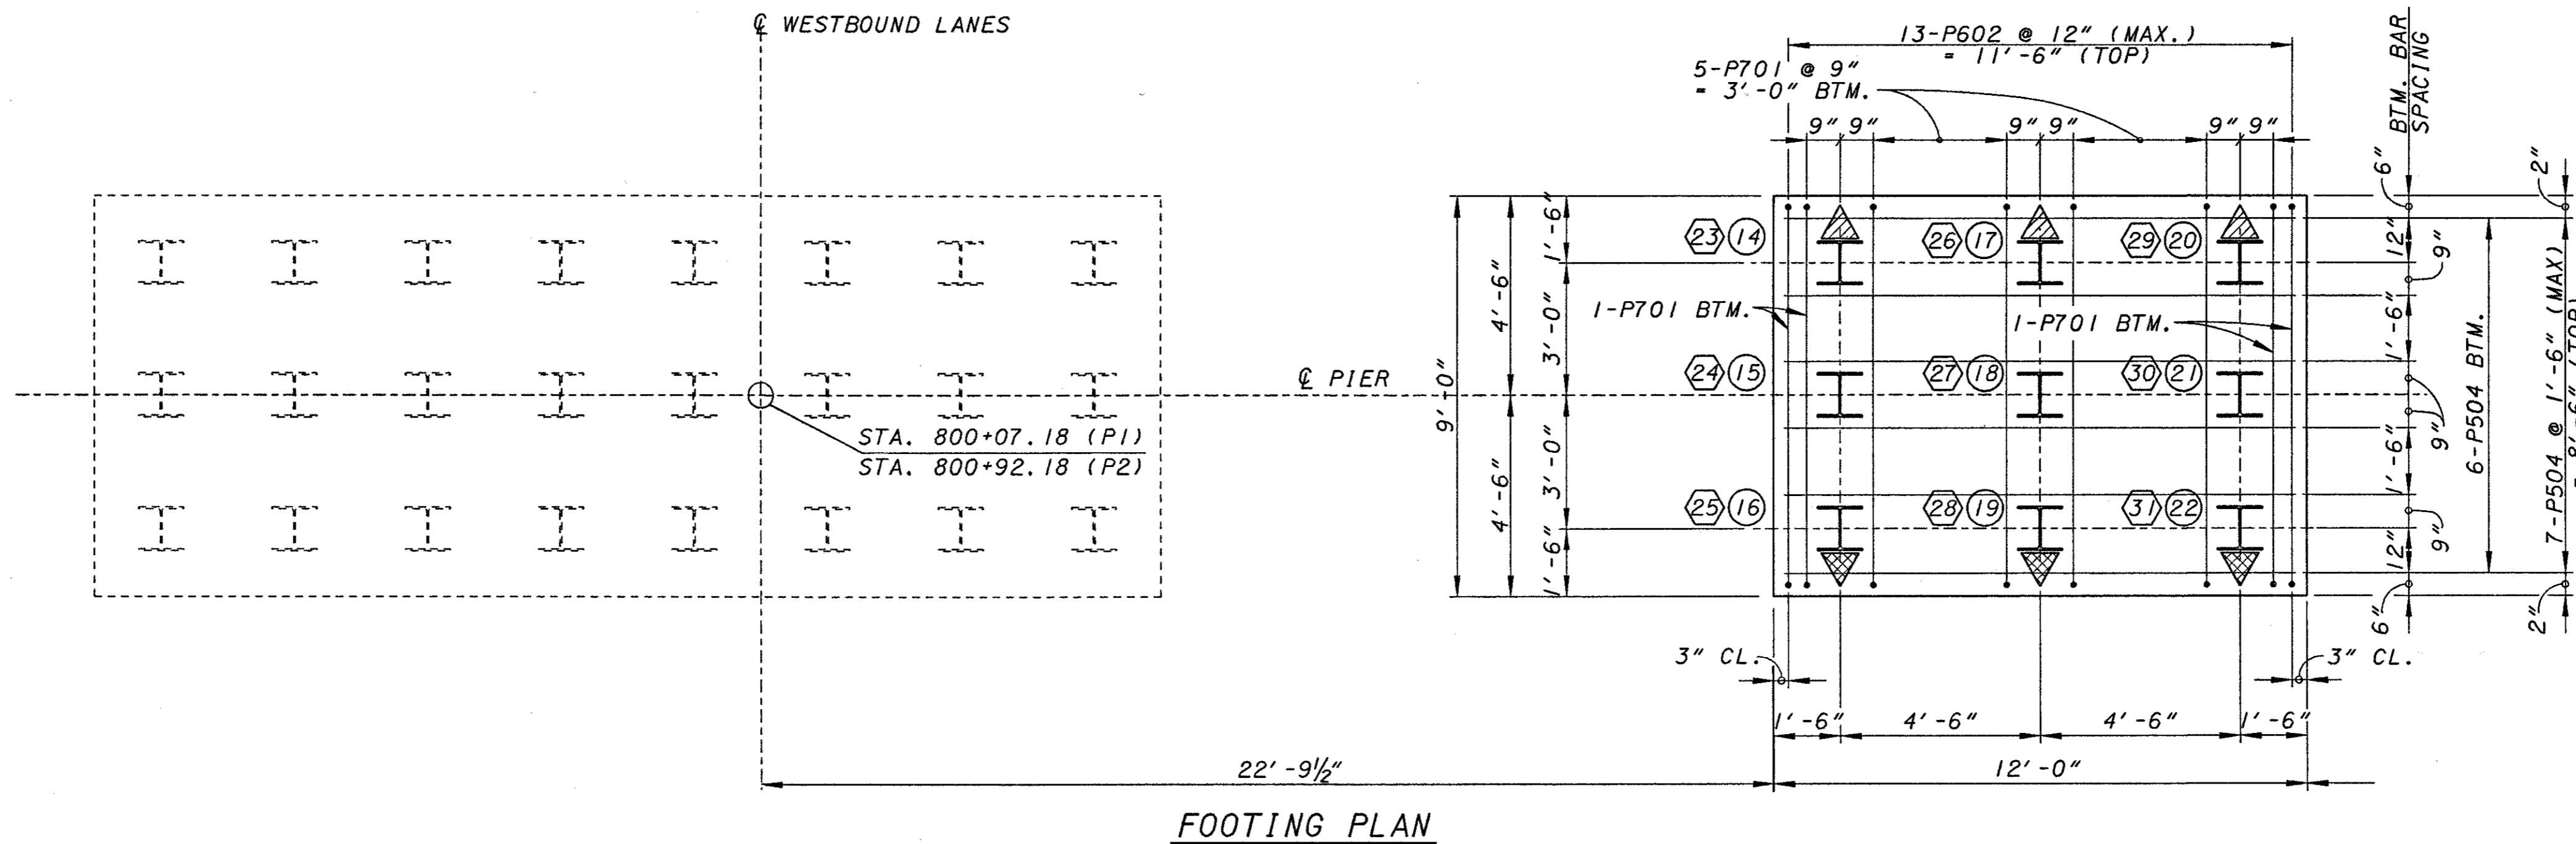

SECTION 1
 13

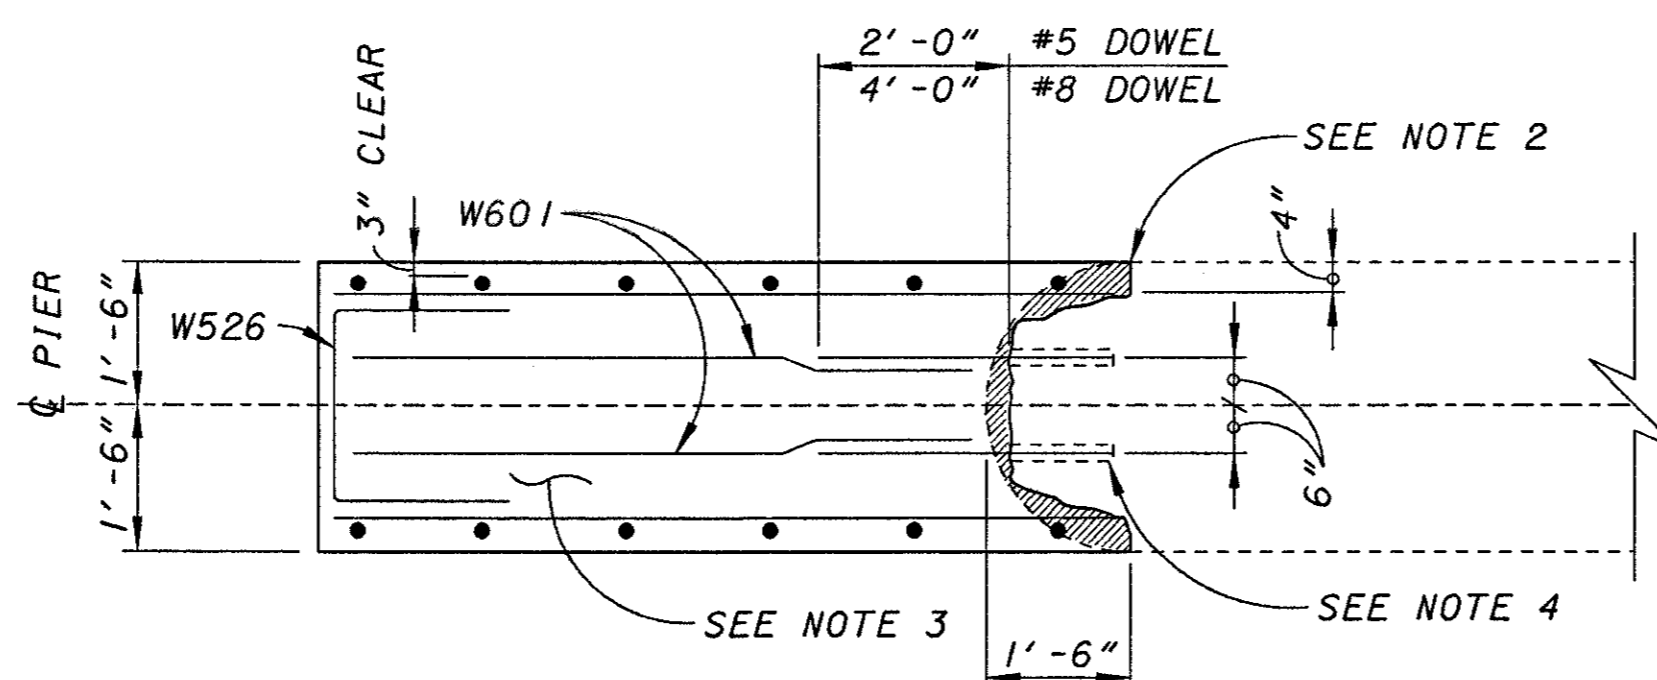

SECTION 2
 13

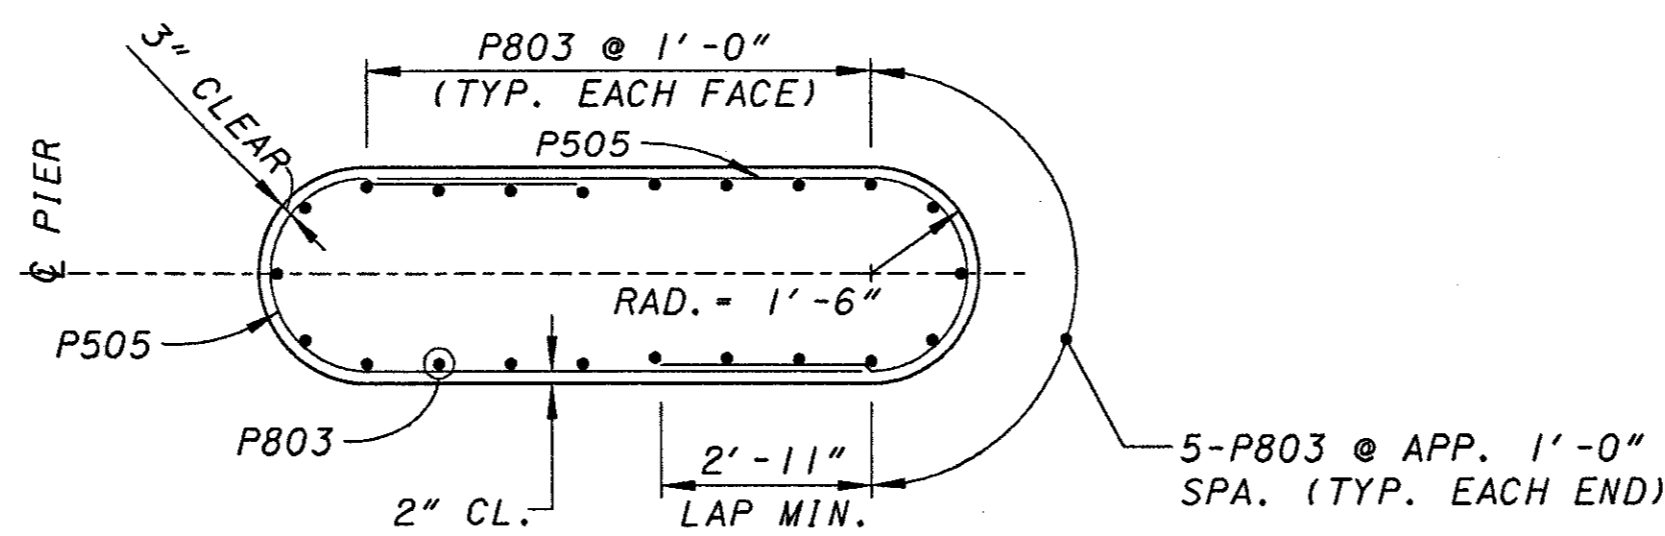

SECTION 3
 13



LEGEND

- DENOTES PROPOSED HP12x53 PILE BATTERED AT 1:4 (PIER 1 ONLY)
- DENOTES PROPOSED HP12x53 PILE BATTERED AT 1:4 (PIER 2 ONLY)
- DENOTES PROPOSED HP12x53 PILE VERTICAL

67 68
 PIER 1 PILE NUMBER
 PIER 2 PILE NUMBER

NOTES

- 1) FILL ANY VOIDS AND SHRINKAGE CRACKS BETWEEN NEW AND OLD CONCRETE BY EPOXY INJECTION PER PROPOSAL NOTE 522.
- 2) SAW CUT 1 1/2" INTO EXISTING CONCRETE FOR FULL HEIGHT OF STEM.
- 3) CONCRETE FOR SUPPORT WEDGE TO BE CLASS "C". CONCRETE SLUMP MAY BE INCREASED TO 7" ± 2" BY THE ADDITION OF A CHEMICAL ADMIXTURE MEETING THE REQUIREMENTS OF 705.12 TYPE F OR G
- 4) DRILL AND GROUT DOWELS INTO EXISTING PIER STEM USING NON SHRINK GROUT PER 510 AND 705.20. GROUT # 8 BARS 30" INTO EXISTING AND # 5 BARS 8" INTO EXISTING.
- 5) THE WORK INVOLVED IN REINFORCING THE EXISTING PIER CANTILVERS SHALL BE COMPLETED PRIOR TO SHIFTING TRAFFIC ON THE BRIDGE OR ANY DECK REMOVALS.
- 6) THE WORK INVOLVED IN REINFORCING THE EXISTING PIER CANTILEVER SHALL BE DONE AS A CHANGE ORDER.

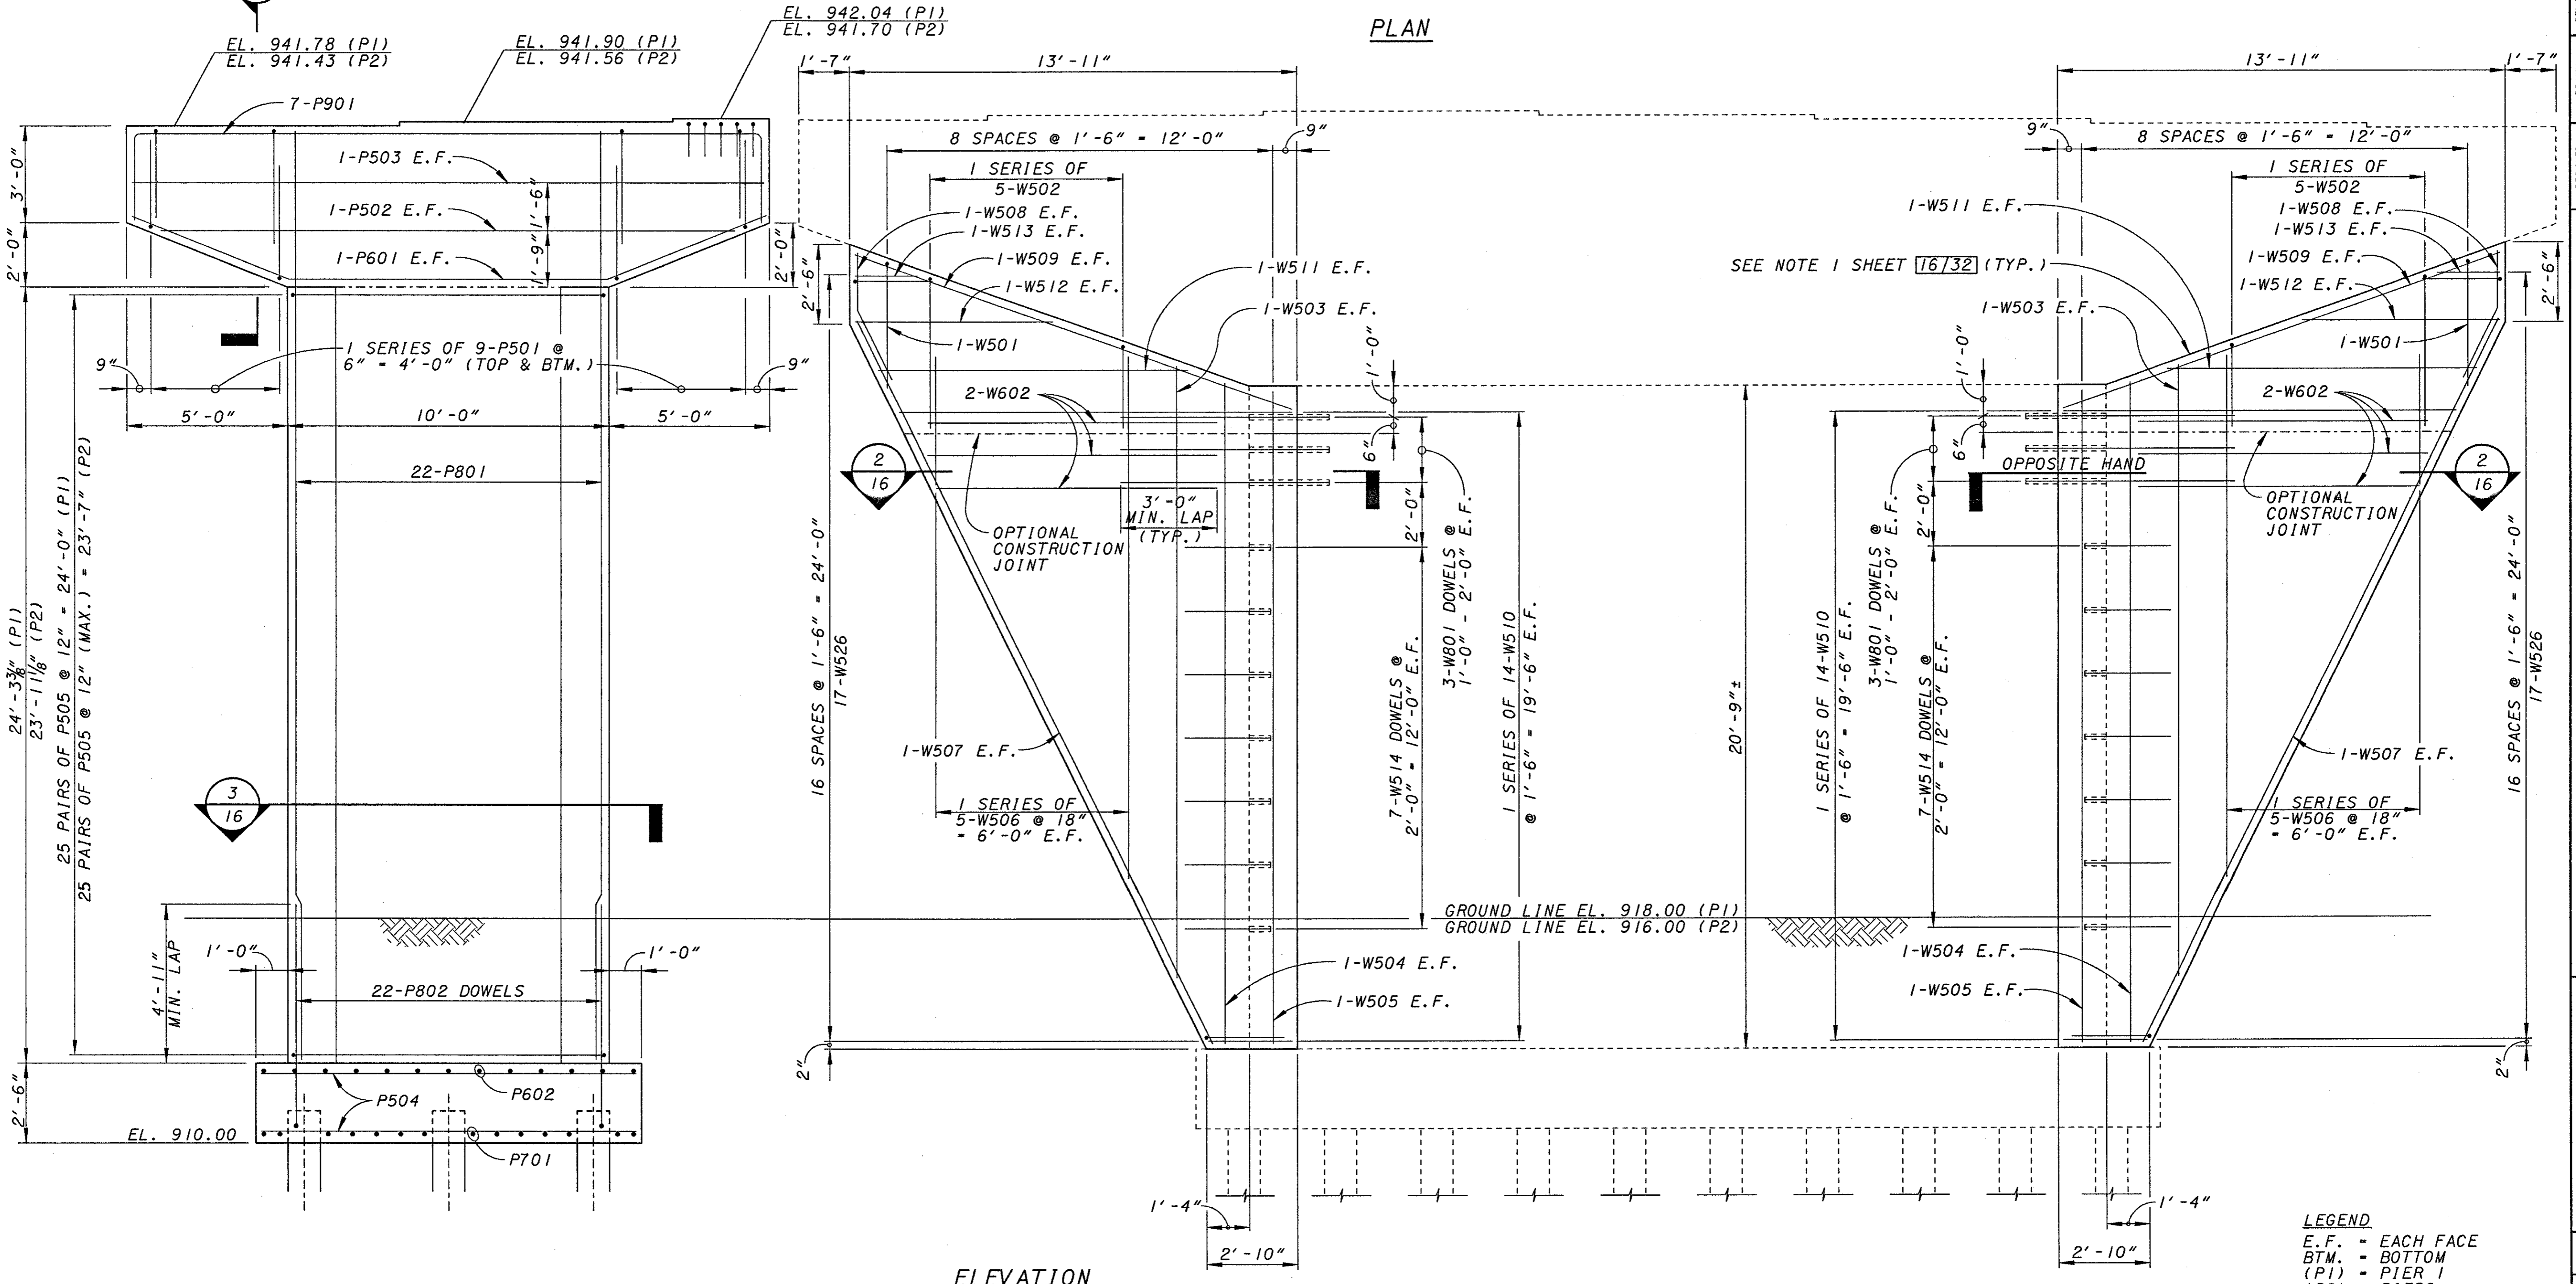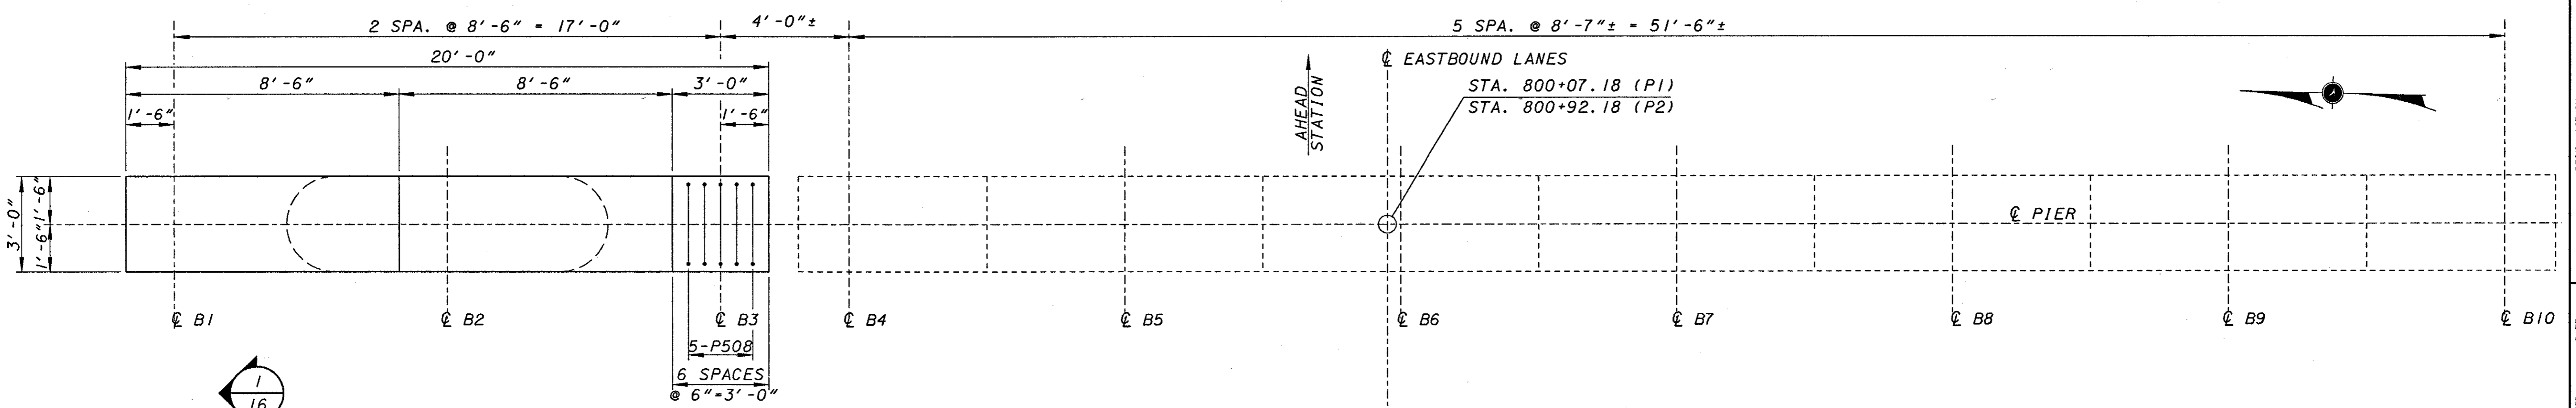

REF: **REF**
 REF: **REF**
 USER: *****
 PROJECT: *****
 DATE: *****
 ACTIVE LEVELS ON: *****

ELEVATION


REF: **REF**
 REF: **REF**
*****SYTIME*****
 *****DESIGN*****
 *****PROJ. NAME *****
 *****ACTIVE LEVELS OR *****

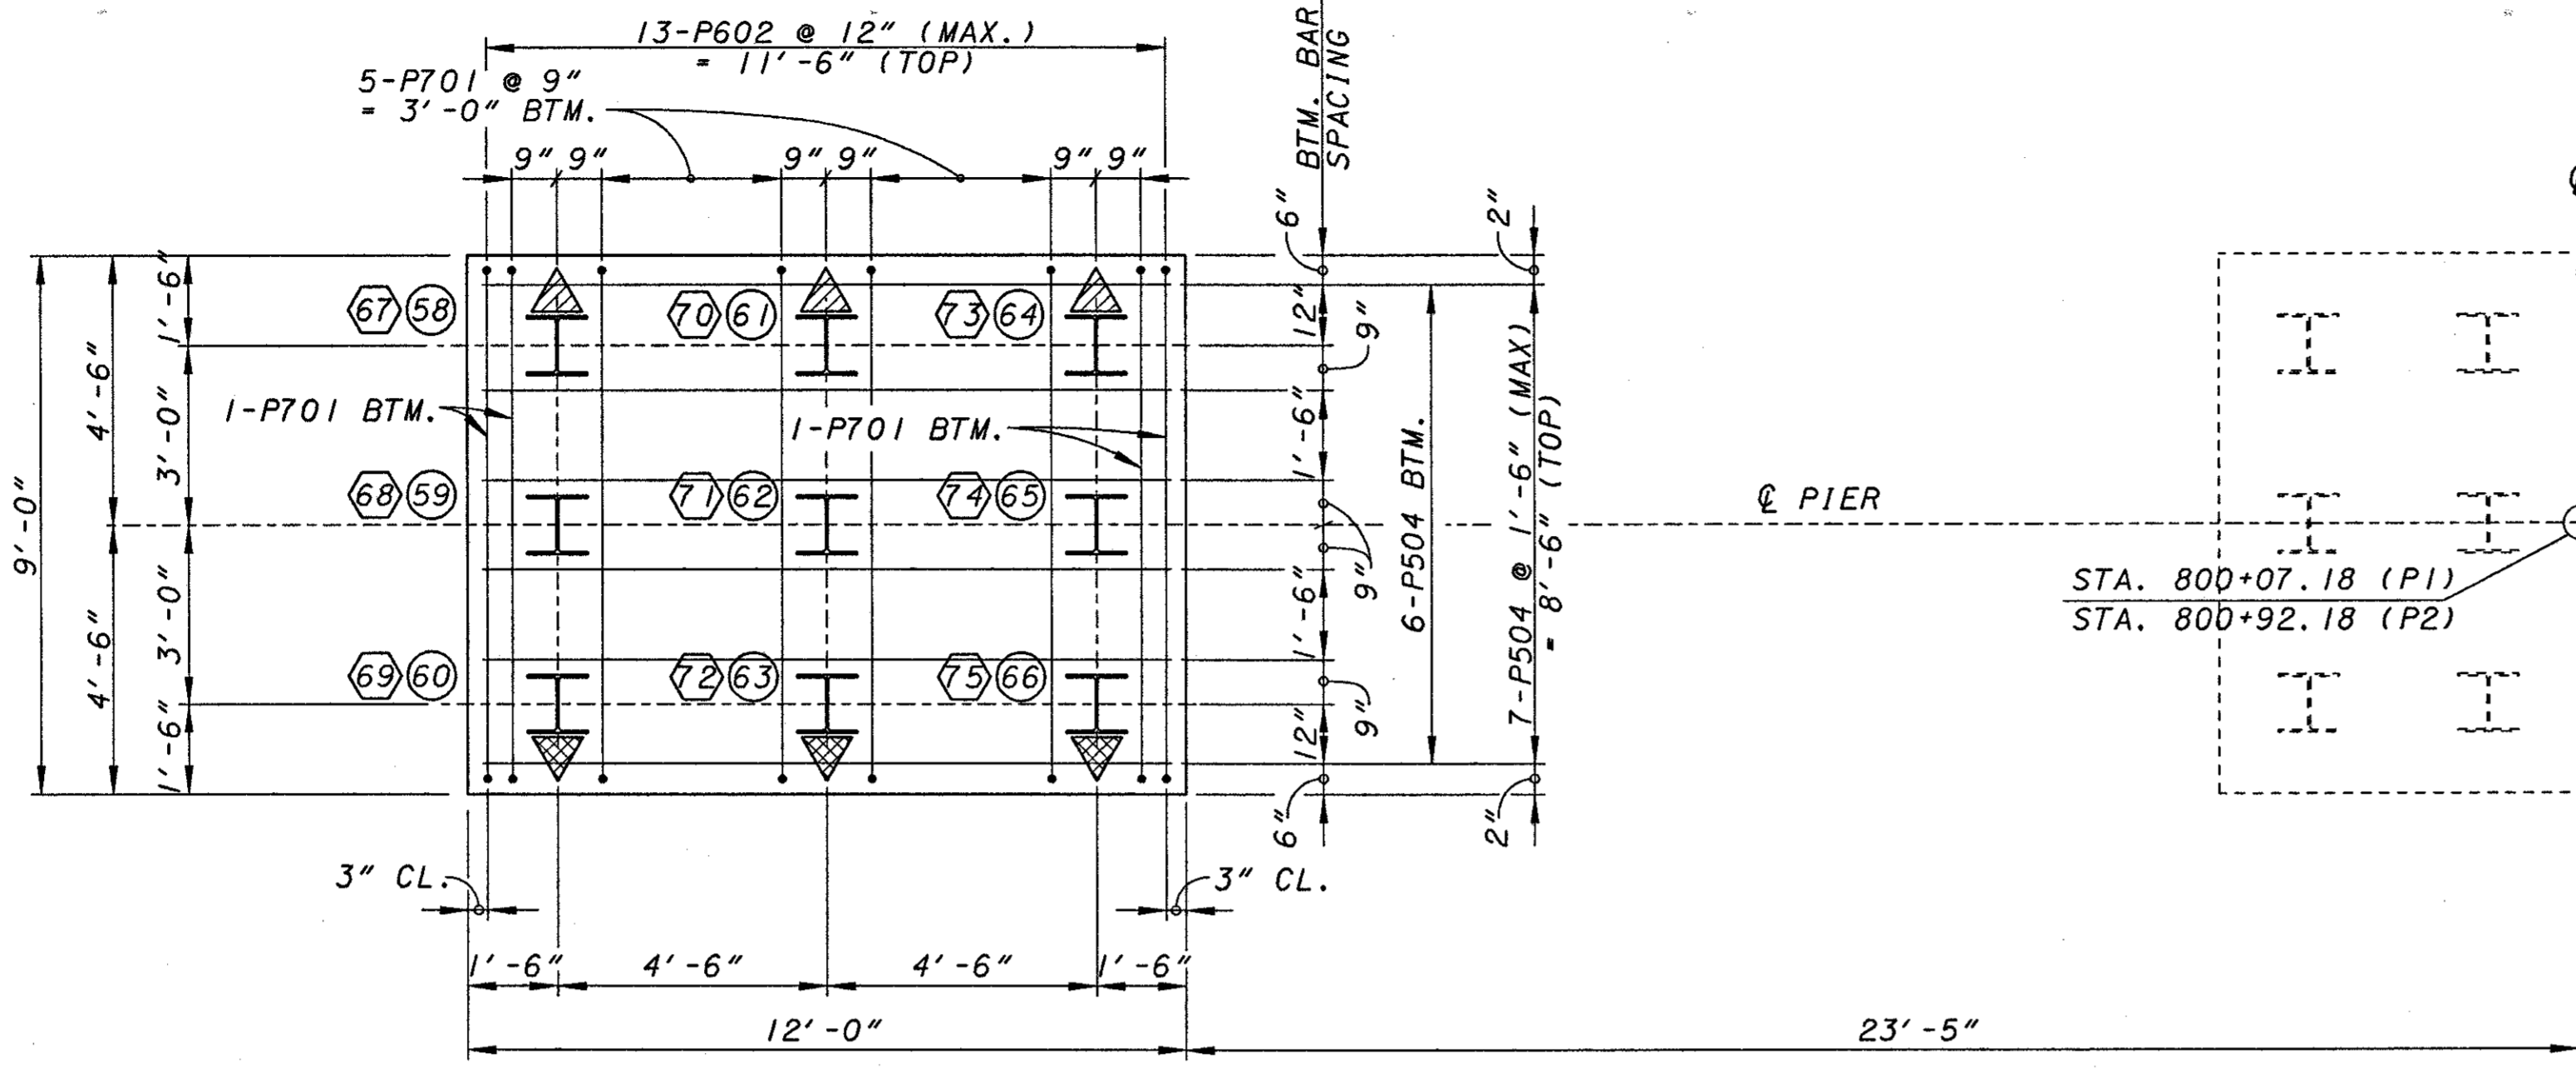


FOOTING PLAN

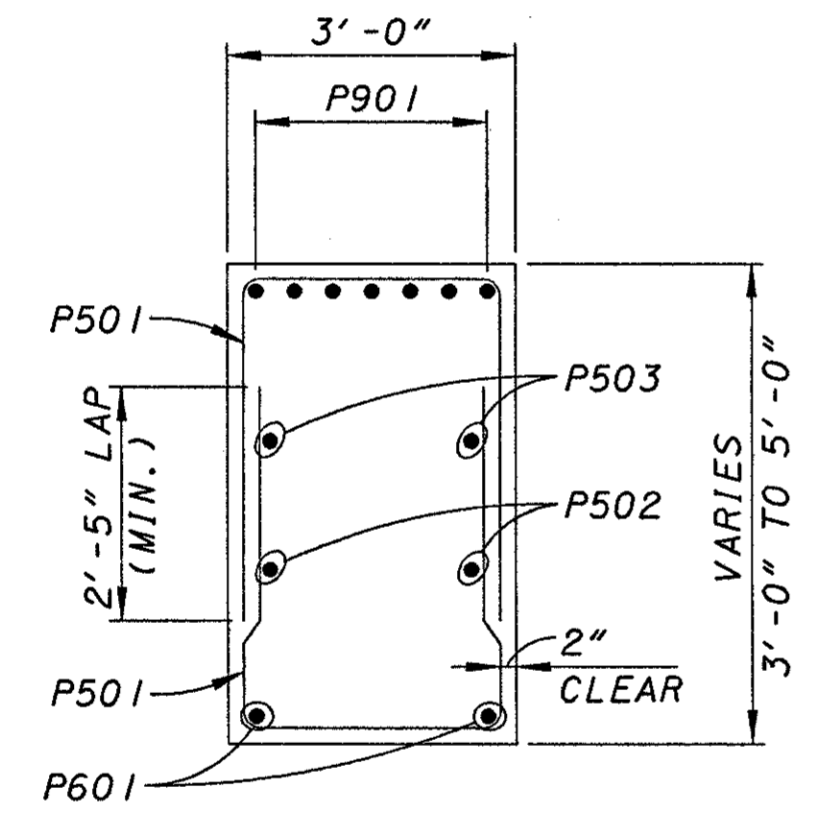

SECTION 1
15

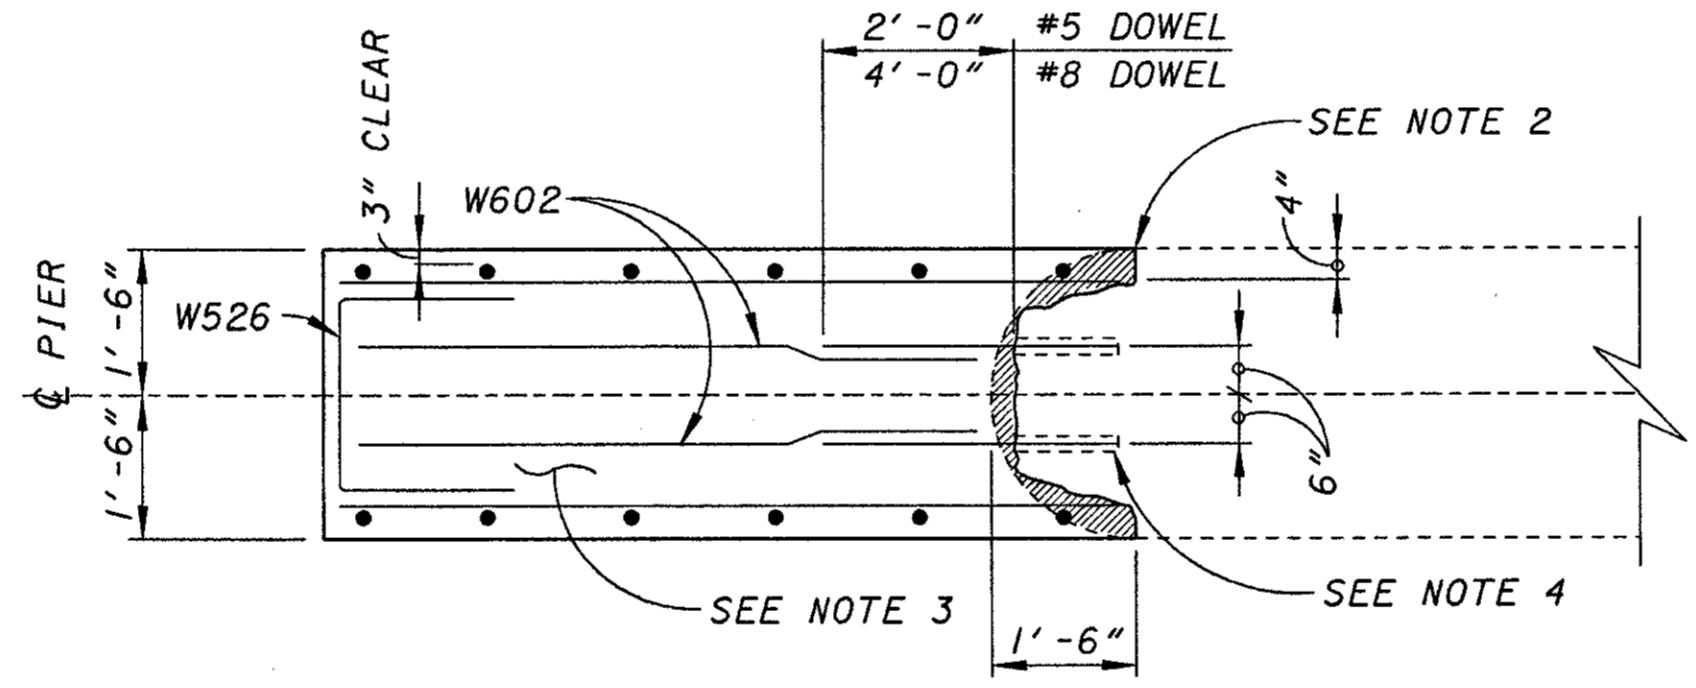

SECTION 2
15

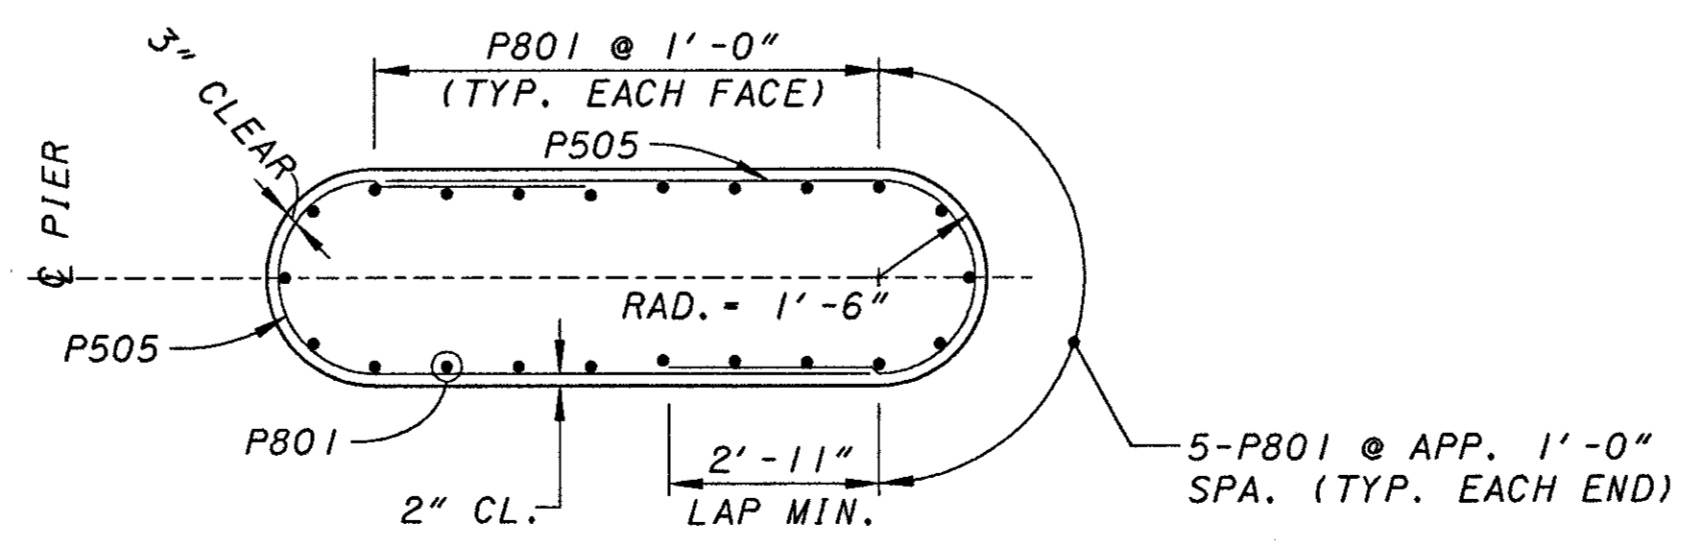

SECTION 3
15


LEGEND

- DENOTES PROPOSED HP12x53 PILE BATTERED AT 1:4 (PIER 1 ONLY)
- DENOTES PROPOSED HP12x53 PILE BATTERED AT 1:4 (PIER 2 ONLY)
- DENOTES PROPOSED HP12x53 PILE VERTICAL

67 58
 PIER 1 PILE NUMBER
 PIER 2 PILE NUMBER

NOTES

- 1) FILL ANY VOIDS AND SHRINKAGE CRACKS BETWEEN NEW AND OLD CONCRETE BY EPOXY INJECTION PER PROPOSAL NOTE 522.
- 2) SAW CUT 1 1/2" INTO EXISTING CONCRETE FOR FULL HEIGHT OF STEM.
- 3) CONCRETE FOR SUPPORT WEDGE TO BE CLASS "C". CONCRETE SLUMP MAY BE INCREASED TO 7" ± 2" BY THE ADDITION OF A CHEMICAL ADMIXTURE MEETING THE REQUIREMENTS OF 705.12 TYPE F OR G
- 4) DRILL AND GROUT DOWELS INTO EXISTING PIER STEM USING NON SHRINK GROUT PER 510 AND 705.20. GROUT # 8 BARS 30" INTO EXISTING AND # 5 BARS 8" INTO EXISTING.
- 5) THE WORK INVOLVED IN REINFORCING THE EXISTING PIER CANTILIVERS SHALL BE COMPLETED PRIOR TO SHIFTING TRAFFIC ON THE BRIDGE OR ANY DECK REMOVALS.
- 6) THE WORK INVOLVED IN REINFORCING THE EXISTING PIER CANTILEVER SHALL BE DONE AS A CHANGE ORDER.



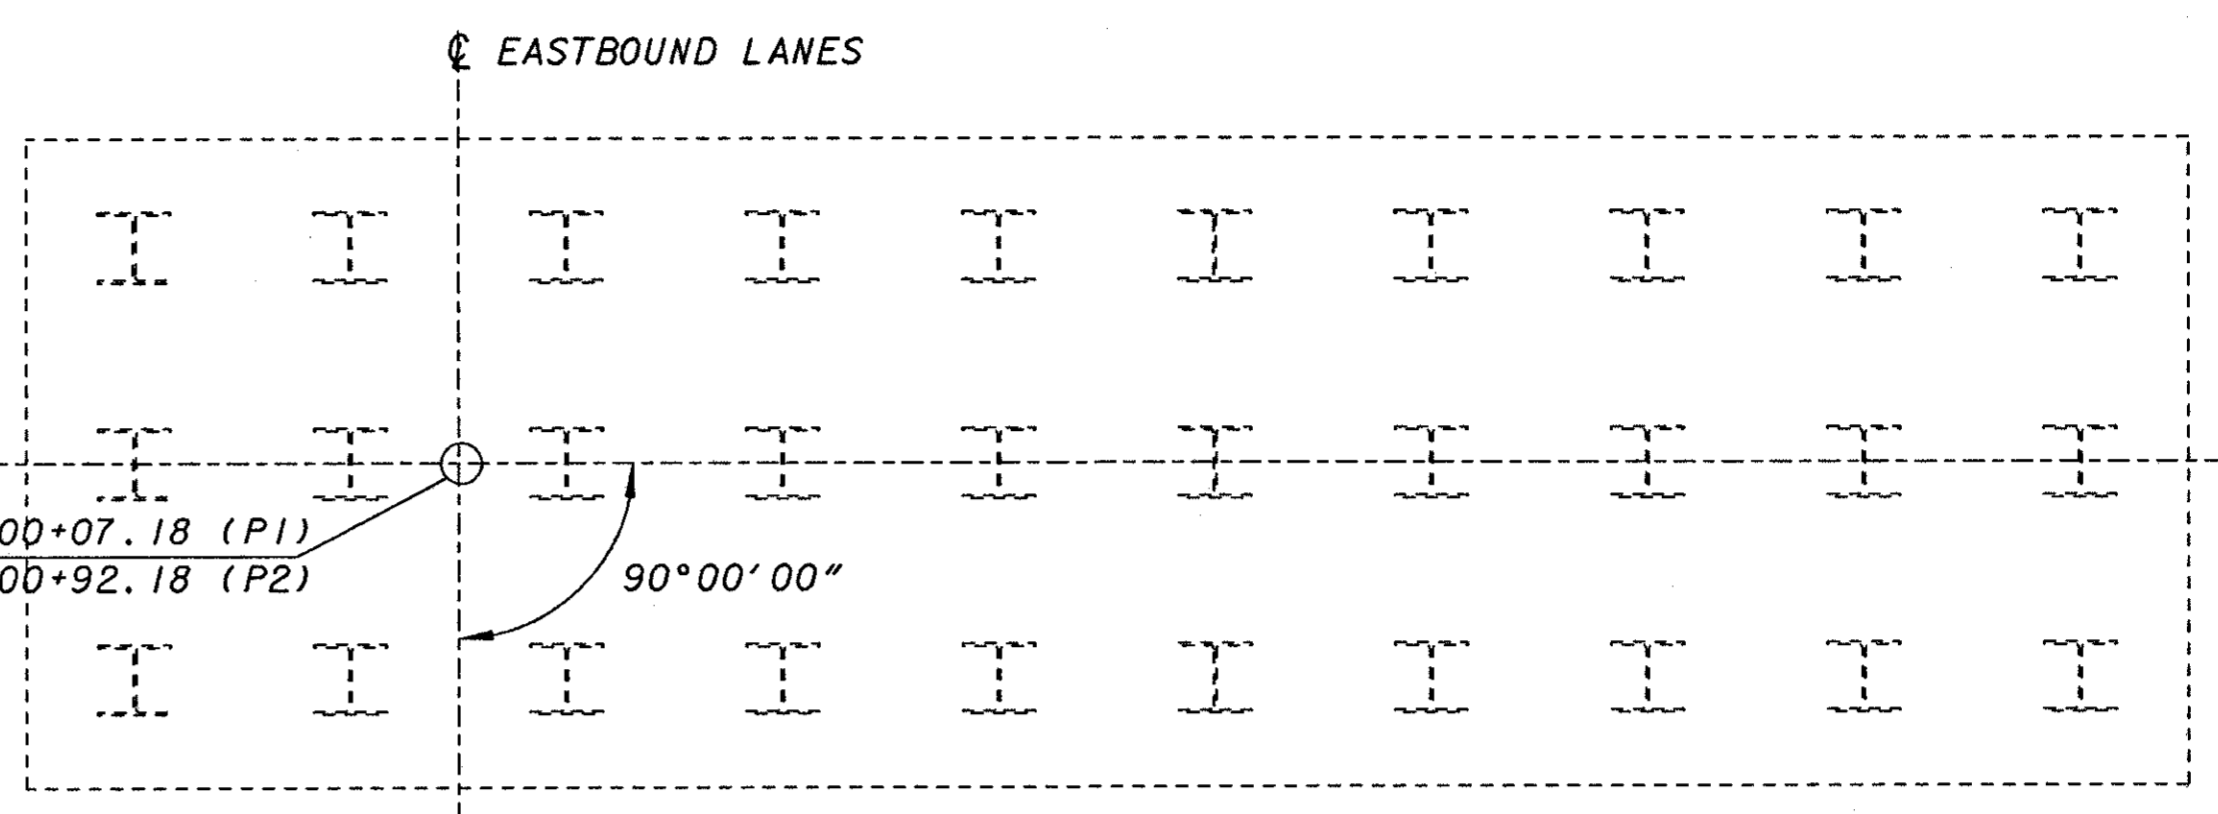


REF: **REF: **
 REF: **REF: **



REF: **REF: **
 REF: **REF: **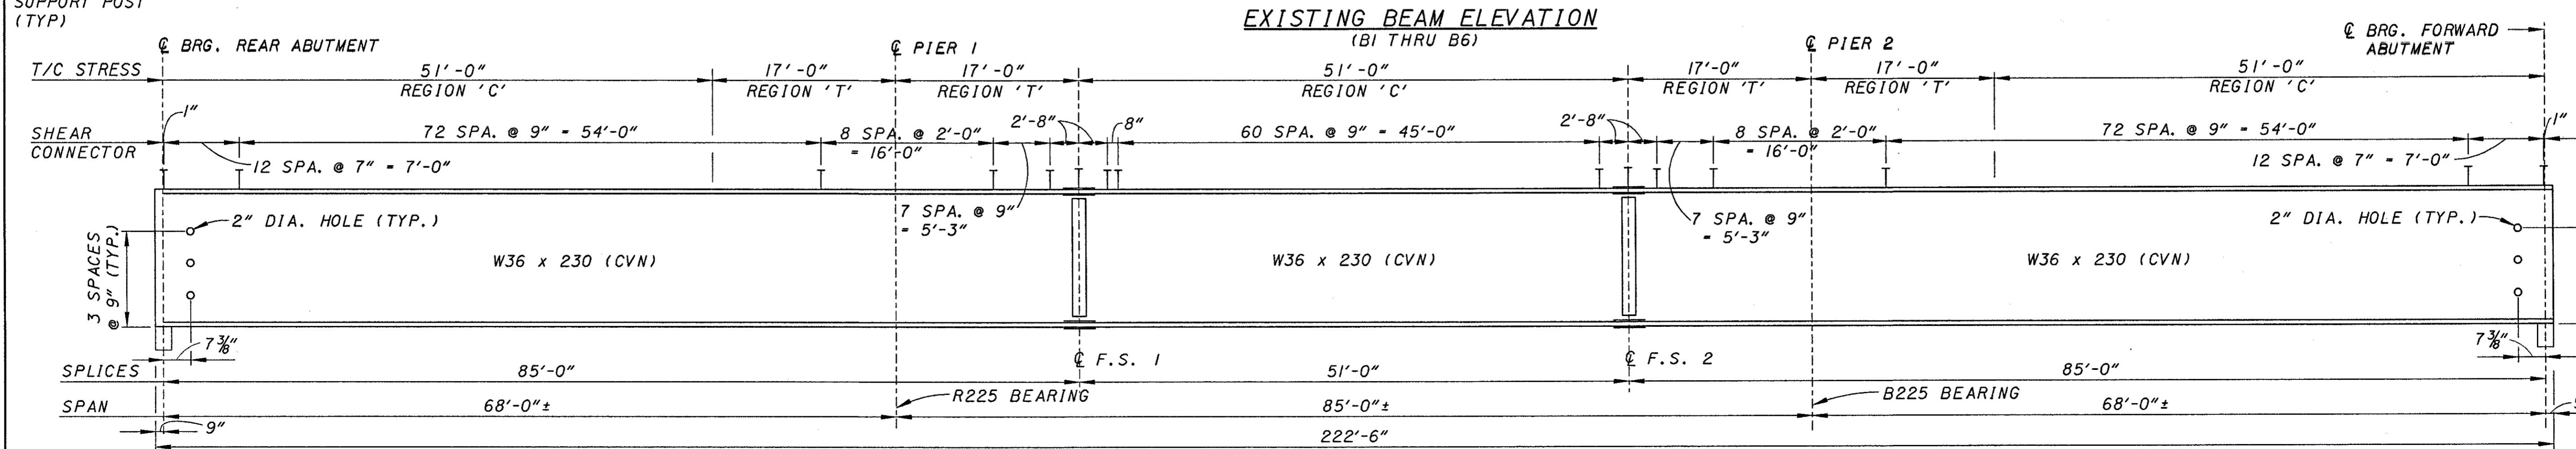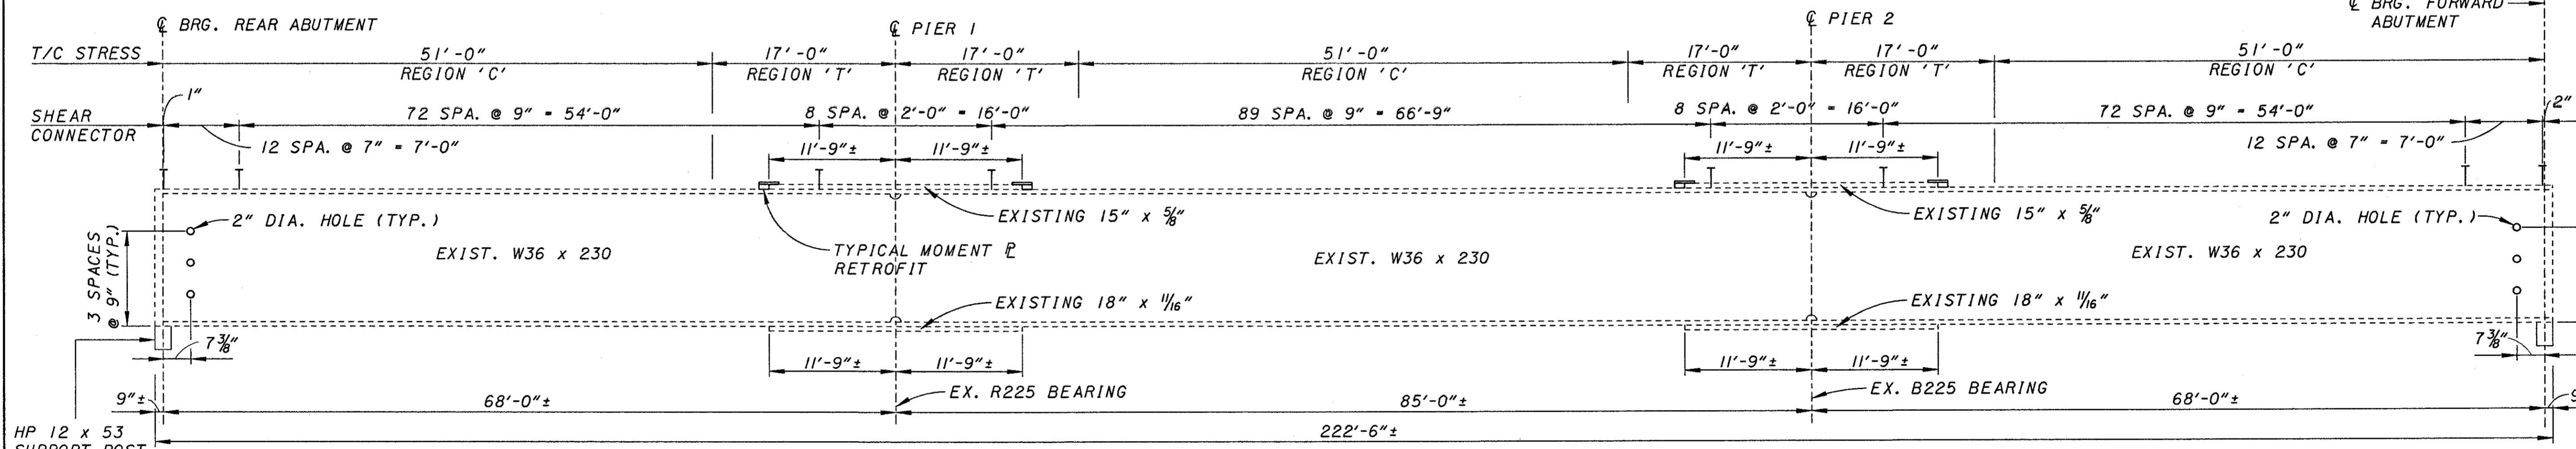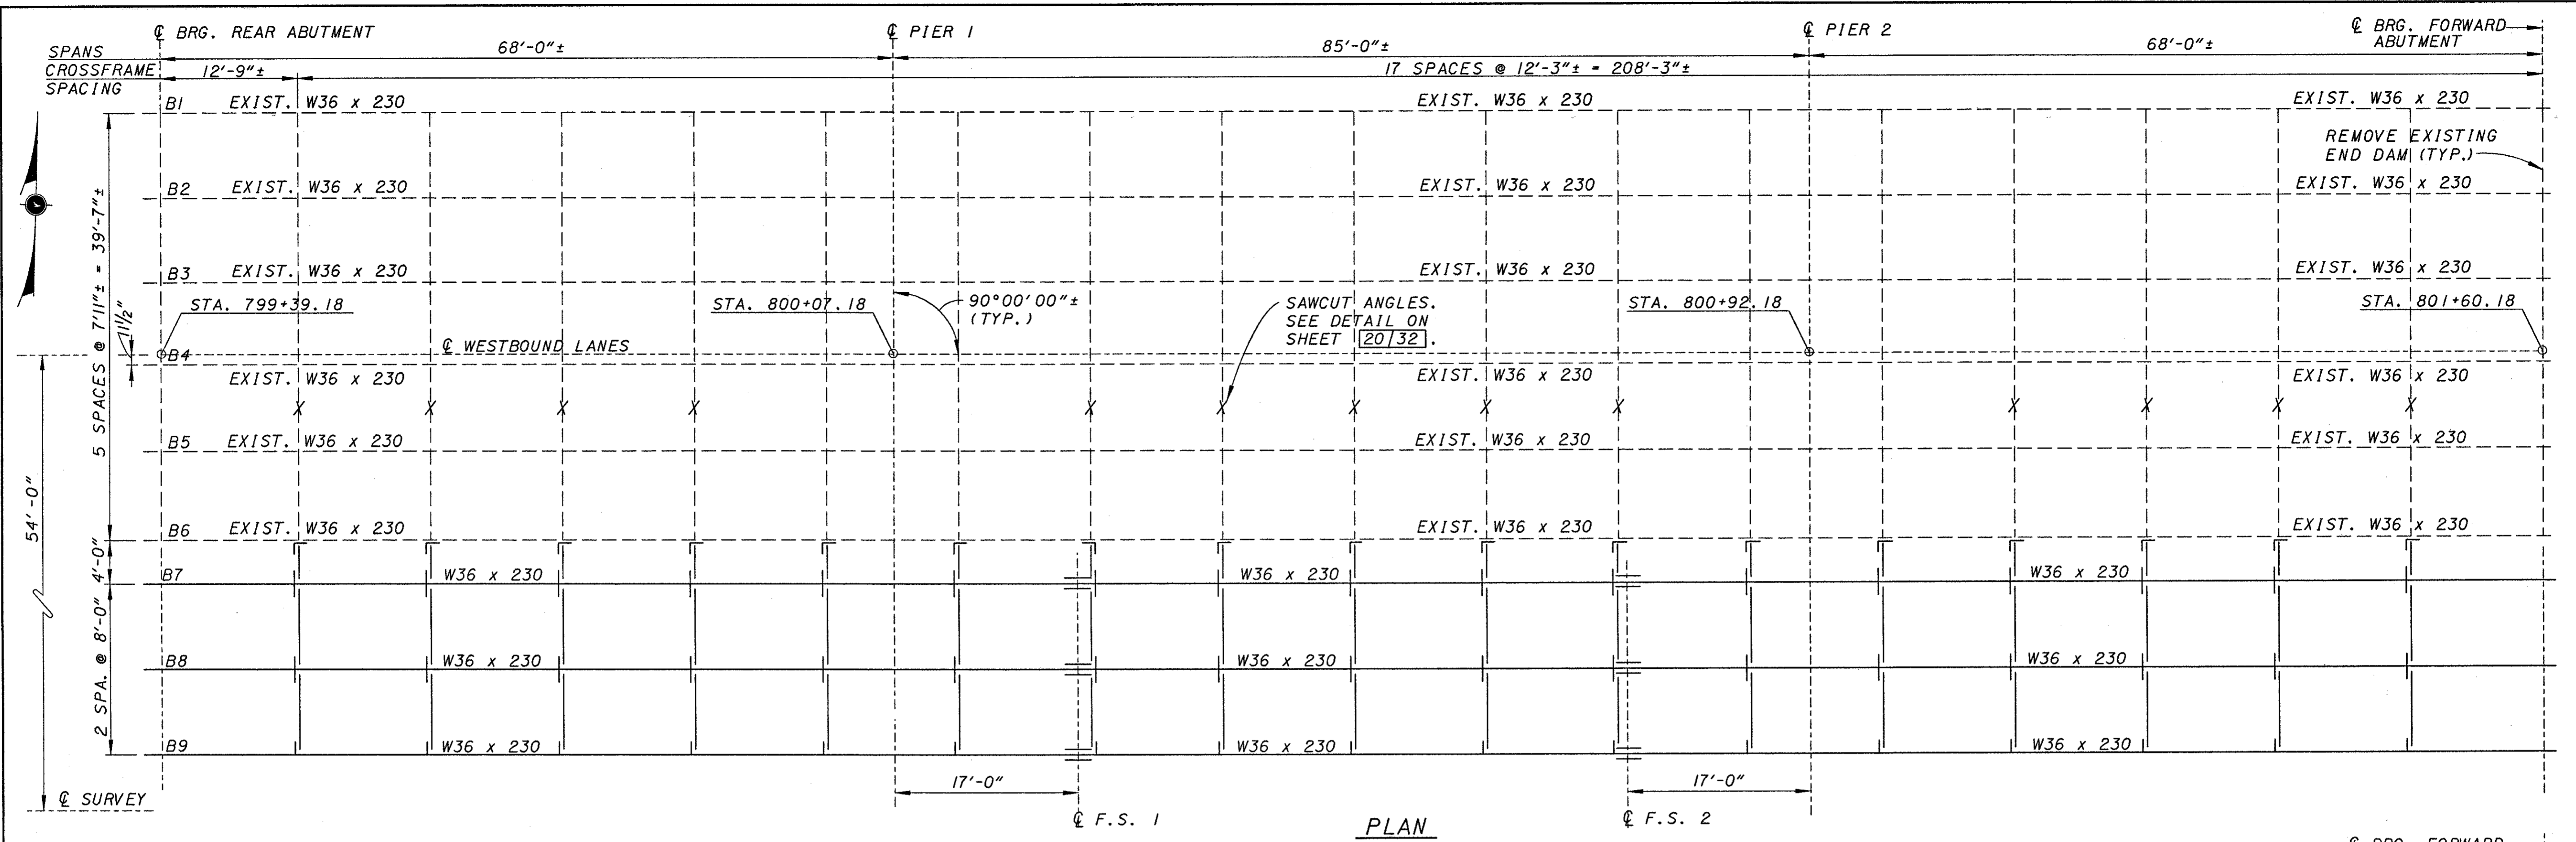
NEW BEAM ELEVATION
 (B7 THRU B9)

NOTES
 1. ALL BEAMS ARE TO BE GRADE 50 STEEL

REF: **REF1**
 REF: **REF2**
 REF: **REF3**
 REF: **REF100**

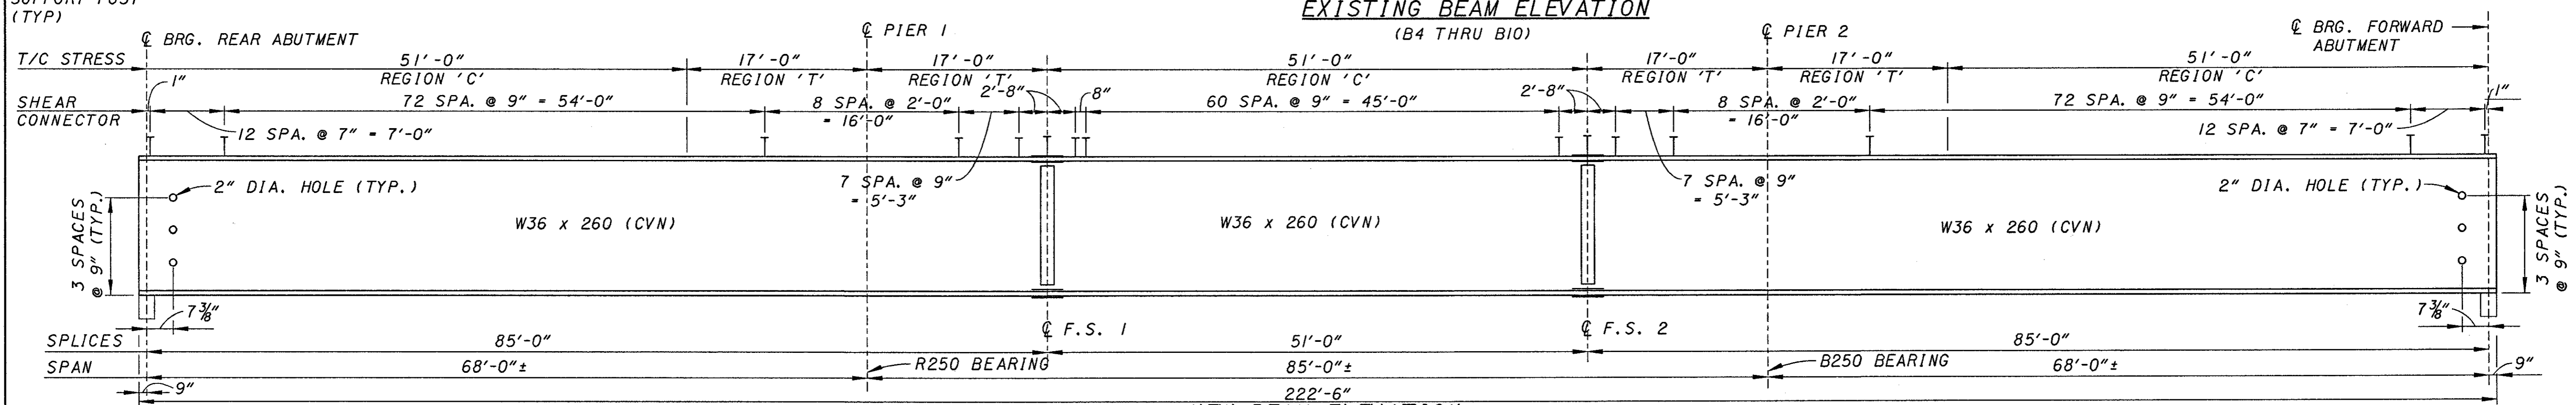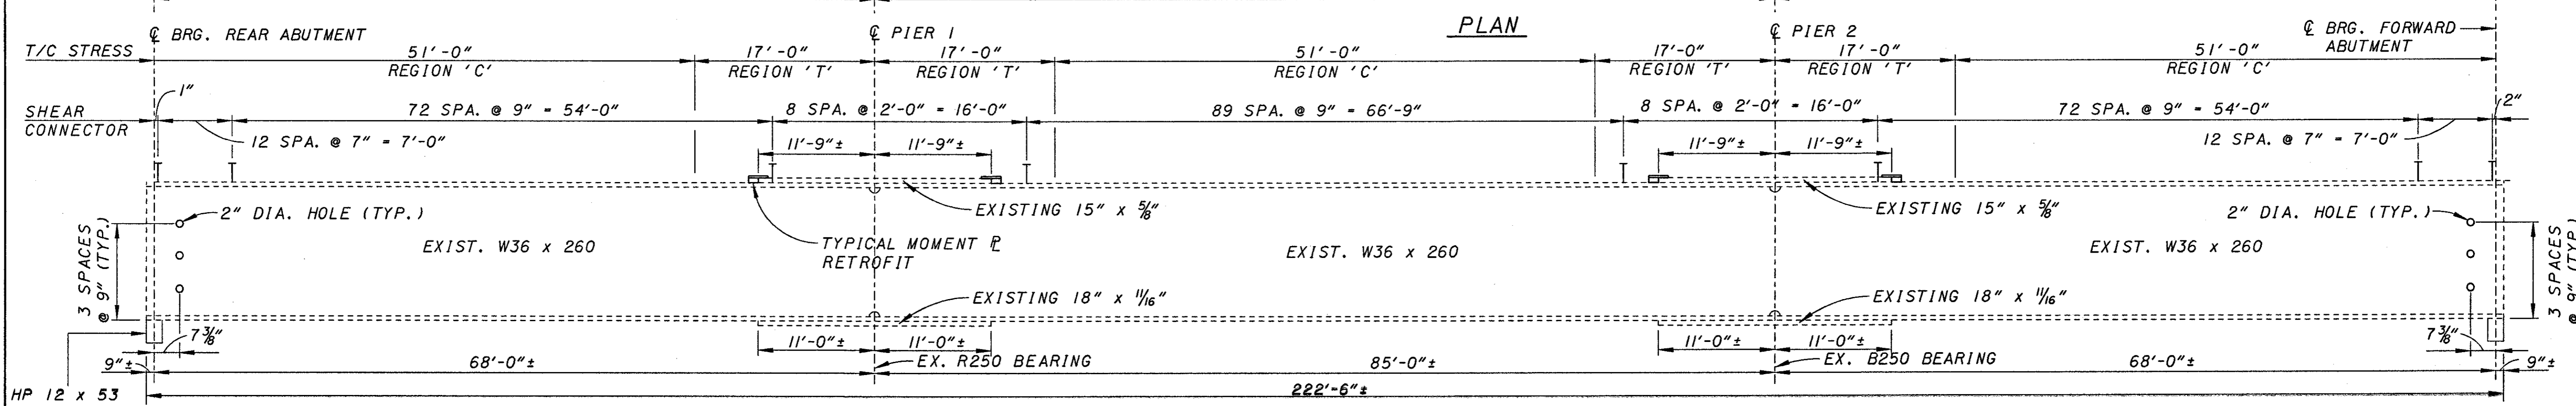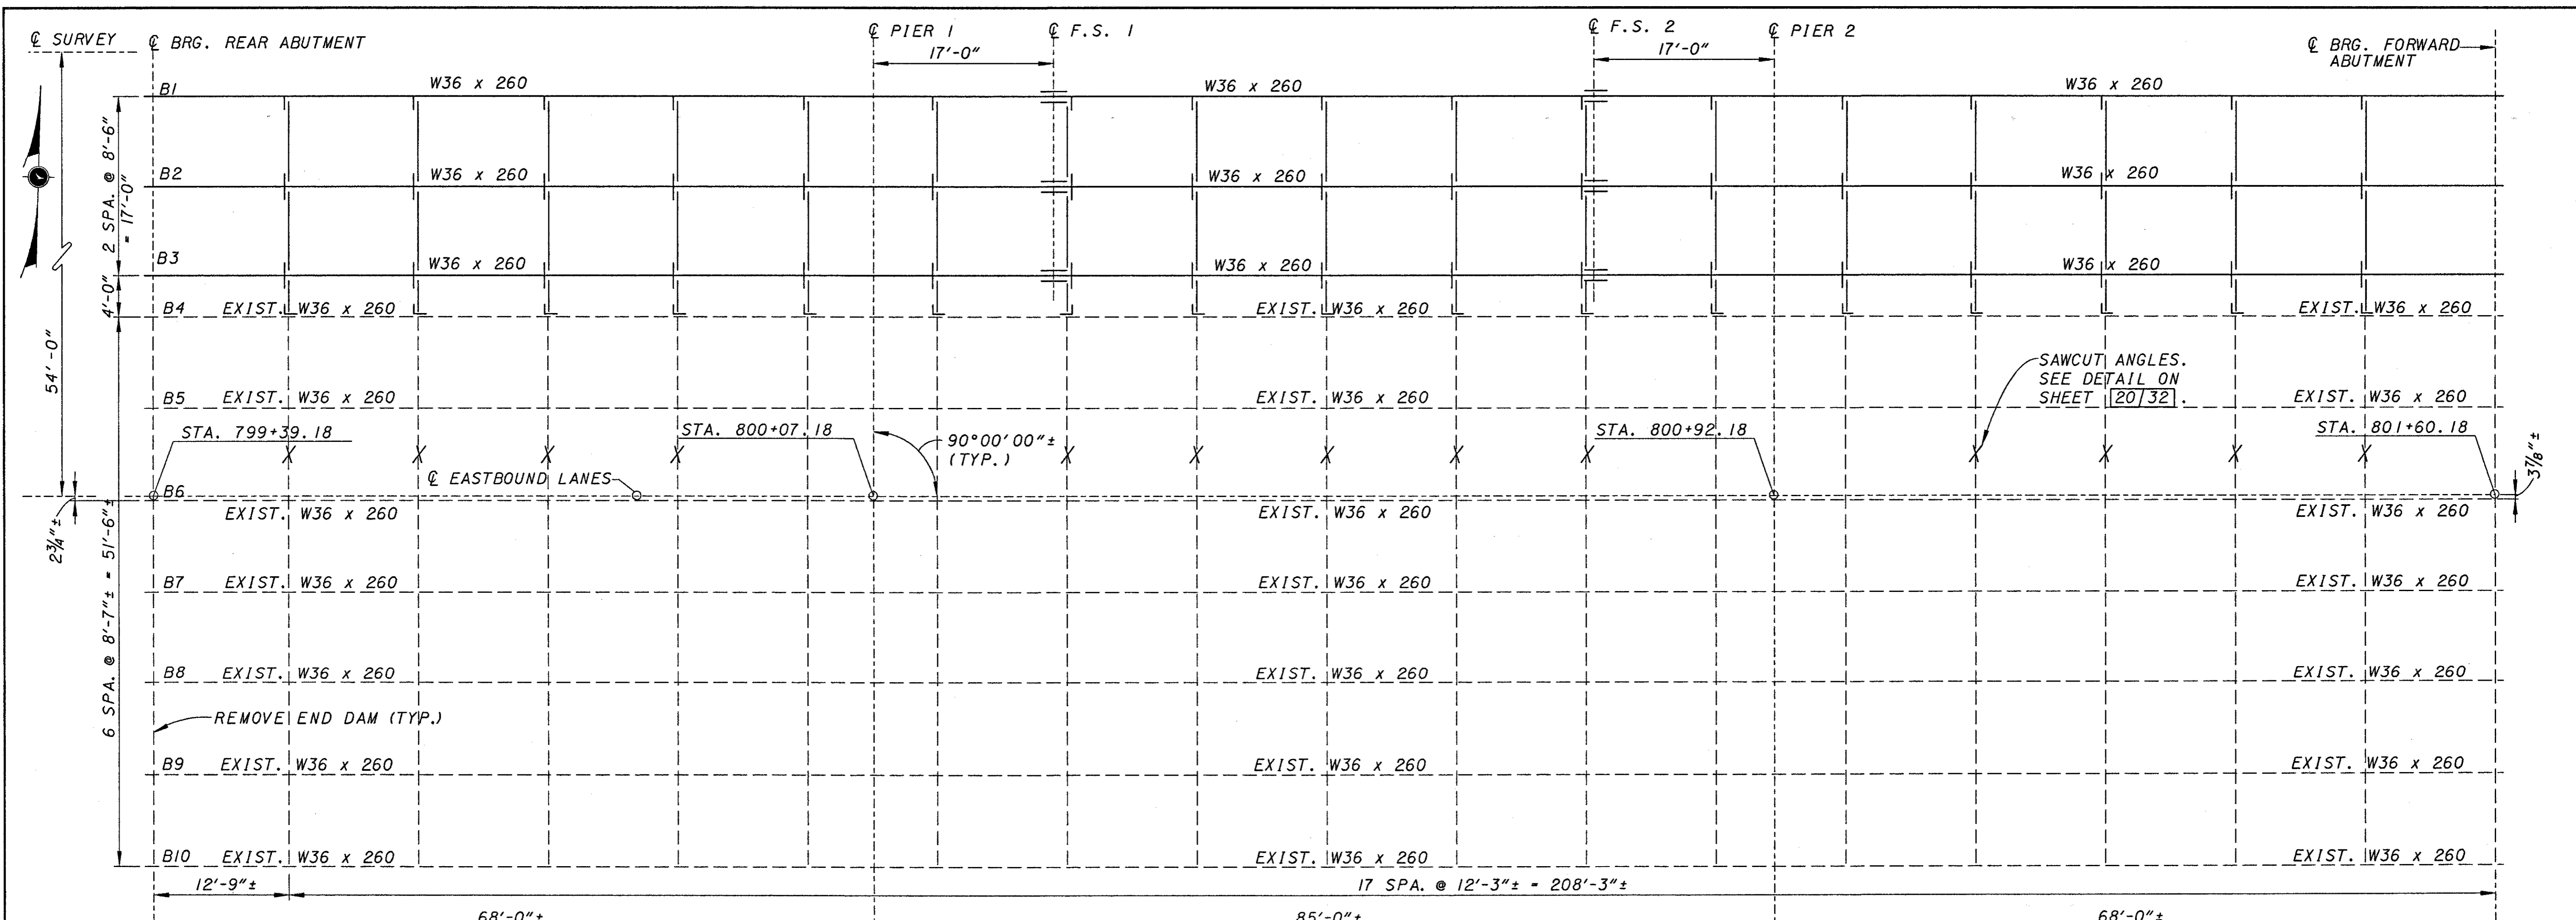

NOTES
 1. ALL BEAMS ARE TO BE GRADE 50 STEEL.

KZF DESIGN
 ARCHITECTURE | ENGINEERING | INTERIOR PLANNING
 1000 W. 10TH AVENUE, SUITE 1000, DENVER, CO 80202
 TEL: 303.733.1111 FAX: 303.733.1112 WEB: WWW.KZFDENVER.COM

DESIGNED	DATE	REVIEWED	DATE
SJA	11/20/00	DGK	11/20/00
CHECKED	STRUCTURE FILE NUMBER	MWL	DRAWN
WBS	68014716801501	REVISED	

KZF #17


FRAMING PLAN - RIGHT BRIDGE
 BRIDGE NO. PRE-70-1500 L/R
 I.R. TO OVER TWIN CREEK

PRE-70-0.00

18 / 32

245
283

CAMBER DIAGRAM DIMENSION (INCH)		
LOCATION	A	B
LEFT BRIDGE	2 ¹ / ₁₆ "	2 ¹ / ₁₆ "
RIGHT BRIDGE	2 ¹ / ₁₆ "	2 ¹ / ₁₆ "

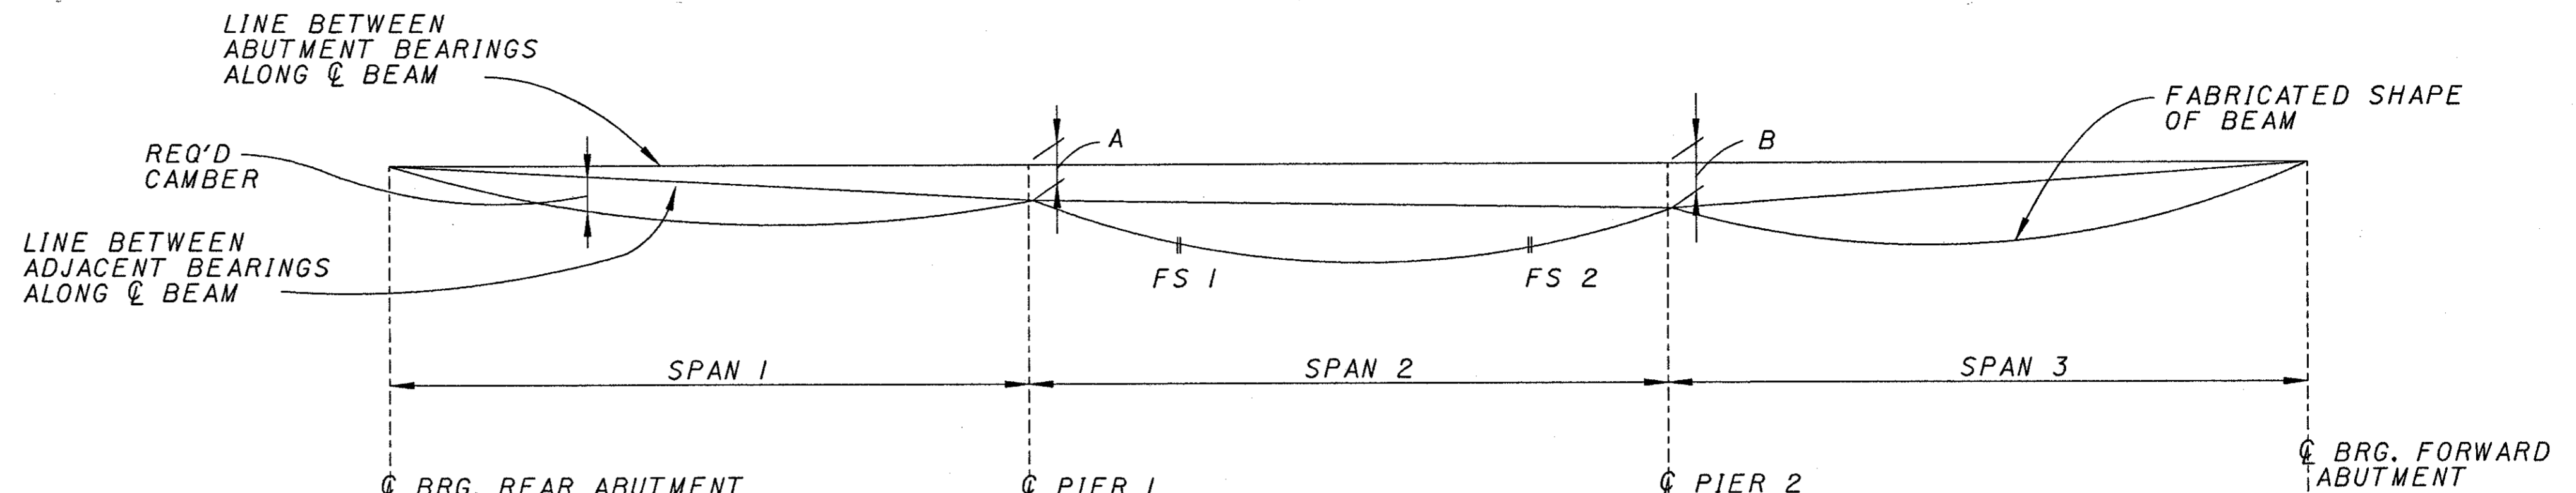

BEAMS	LOCATION	Q BRG. REAR ABUTMENT										Q PIER 1						Q PIER 2						Q BRG. FORWARD ABUTMENT						
		1/10	2/10	3/10	4/10	5/10	6/10	7/10	8/10	9/10	1/10	2/10	3/10	4/10	5/10	6/10	7/10	8/10	9/10	1/10	2/10	3/10	4/10	5/10	6/10	7/10	8/10	9/10	FS1	FS2
LEFT BRIDGE	DEFLECTION DUE TO WEIGHT OF STEEL	1/16	1/16	1/8	1/8	1/8	1/16	1/16	1/16	0	0	1/16	1/8	1/8	1/8	1/8	1/8	1/16	0	0	1/16	1/16	1/8	1/8	1/8	1/16	1/16	1/16	1/16	
	DEFLECTION DUE TO REMAINING DEAD LOAD	3/16	5/16	3/8	7/16	7/16	3/8	1/4	1/8	1/16	1/16	1/4	3/8	1/2	9/16	1/2	3/8	1/4	1/16	1/16	1/8	1/4	3/8	7/16	7/16	3/8	5/16	3/16	1/4	1/4
	VERTICAL CURVE CORRECTION	-1/8	-3/16	-1/4	-5/16	-5/16	-5/16	-1/4	-3/16	-1/8	-3/16	-5/16	-7/16	-1/2	-1/2	-1/2	-7/16	-5/16	-3/16	-1/16	-1/8	-3/16	-3/16	-1/8	-1/8	-1/16	0	-5/16	-5/16	
	REQUIRED SHOP CAMBER (INCHES)	1/8	3/16	1/4	1/4	1/4	1/8	1/16	0	-1/16	-1/8	0	1/16	1/8	3/16	1/8	1/16	0	-1/8	0	1/16	1/8	1/4	7/16	7/16	5/16	1/4	0	0	
RIGHT BRIDGE	DEFLECTION DUE TO WEIGHT OF STEEL	1/16	1/16	1/8	1/8	1/8	1/16	1/16	1/16	0	0	1/16	1/8	1/8	1/8	1/8	1/8	1/16	0	0	1/16	1/16	1/8	1/8	1/8	1/16	1/16	1/16	1/16	
	DEFLECTION DUE TO REMAINING DEAD LOAD	1/8	5/16	3/8	7/16	3/8	5/16	1/4	1/8	1/16	1/16	1/4	3/8	1/2	1/2	1/2	3/8	1/4	1/16	1/16	1/8	1/4	5/16	3/8	7/16	3/8	5/16	1/8	1/4	1/4
	VERTICAL CURVE CORRECTION	-1/8	-3/16	-1/4	-1/4	-1/4	-1/4	-1/4	-3/16	-1/8	-1/8	-1/4	-3/8	-7/16	-7/16	-7/16	-3/8	-1/4	-1/8	-1/8	-3/16	-1/4	-1/4	-1/4	-1/4	-3/16	-1/8	-1/16	-1/4	-1/4
	REQUIRED SHOP CAMBER (INCHES)	1/16	3/16	1/4	5/16	1/4	3/16	1/16	0	-1/16	-1/16	1/16	1/8	3/16	3/16	3/16	1/8	1/16	-1/16	-1/16	0	1/16	1/8	1/4	5/16	5/16	1/4	1/8	1/16	1/16

CAMBER NOTES:

1. POSITIVE CAMBER IS UPWARD

NOTES:

1. SEE SHEETS 17/32 AND 18/32 FOR BEAM ELEVATION.

REF: **REF**
REF: **REF**

REF: **REF**
 REF: **REF**
BASE SPECIFICATIONS
 USER: SALES MANAGER
 DES: FILE DOWN SPECIFICATIONS
 ACTIVE LEVELS: ON: **LEVEL**

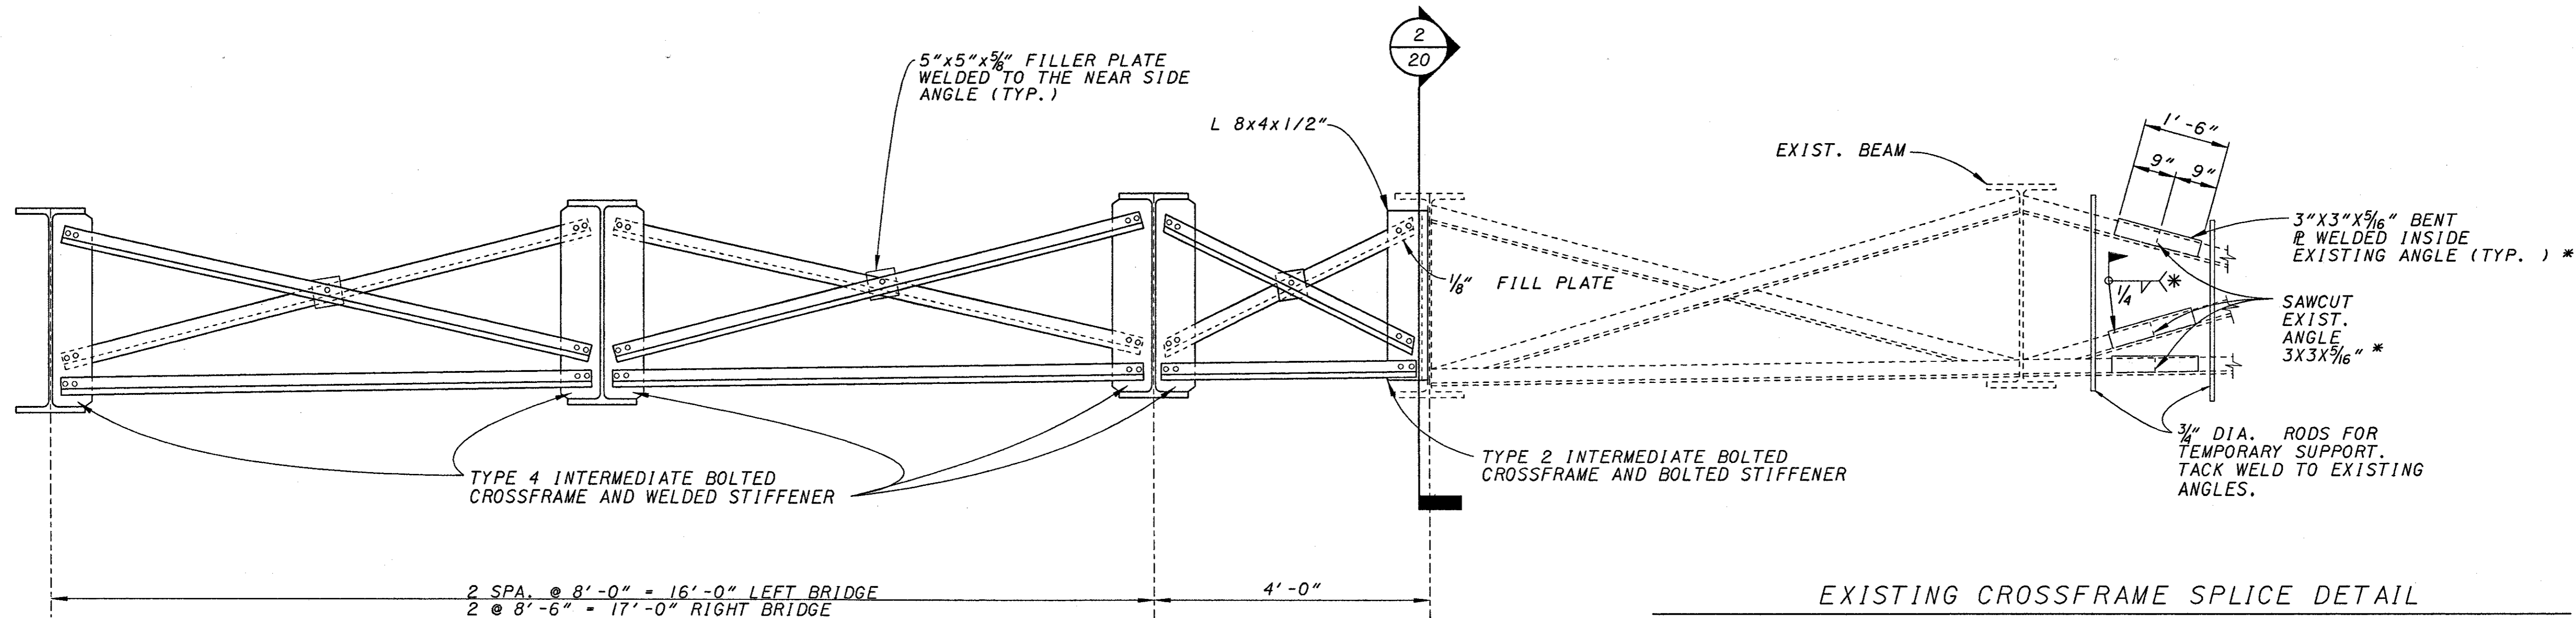


EXISTING CROSSFRAME SPLICE DETAIL


*SAWCUT EXISTING CROSSFRAME ANGLES BELOW DECK CLOSURE POUR LOCATION PRIOR TO DECK REMOVAL IN STAGE 1. SPLICE CROSSFRAME ANGLES BACK TOGETHER USING 3\"/>

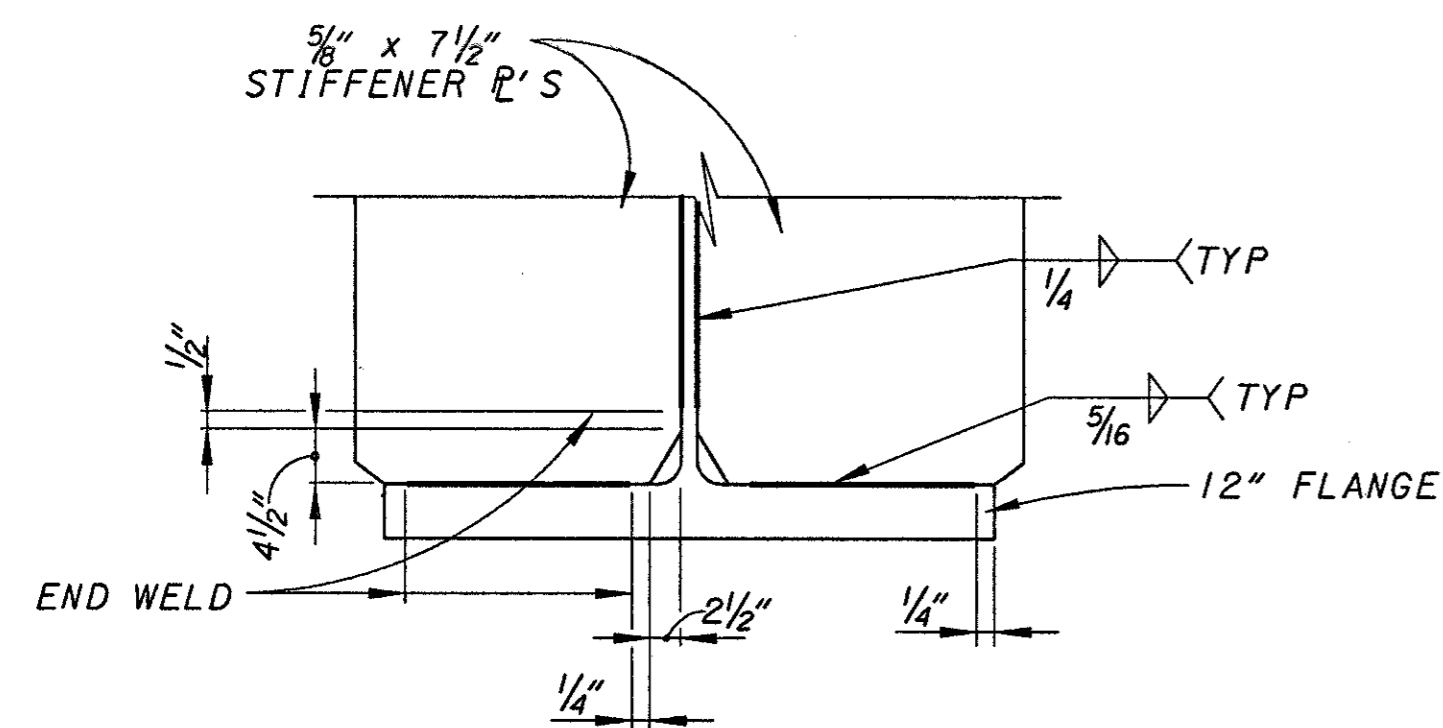

STIFFENER WELD DETAIL
 (TYPICAL)

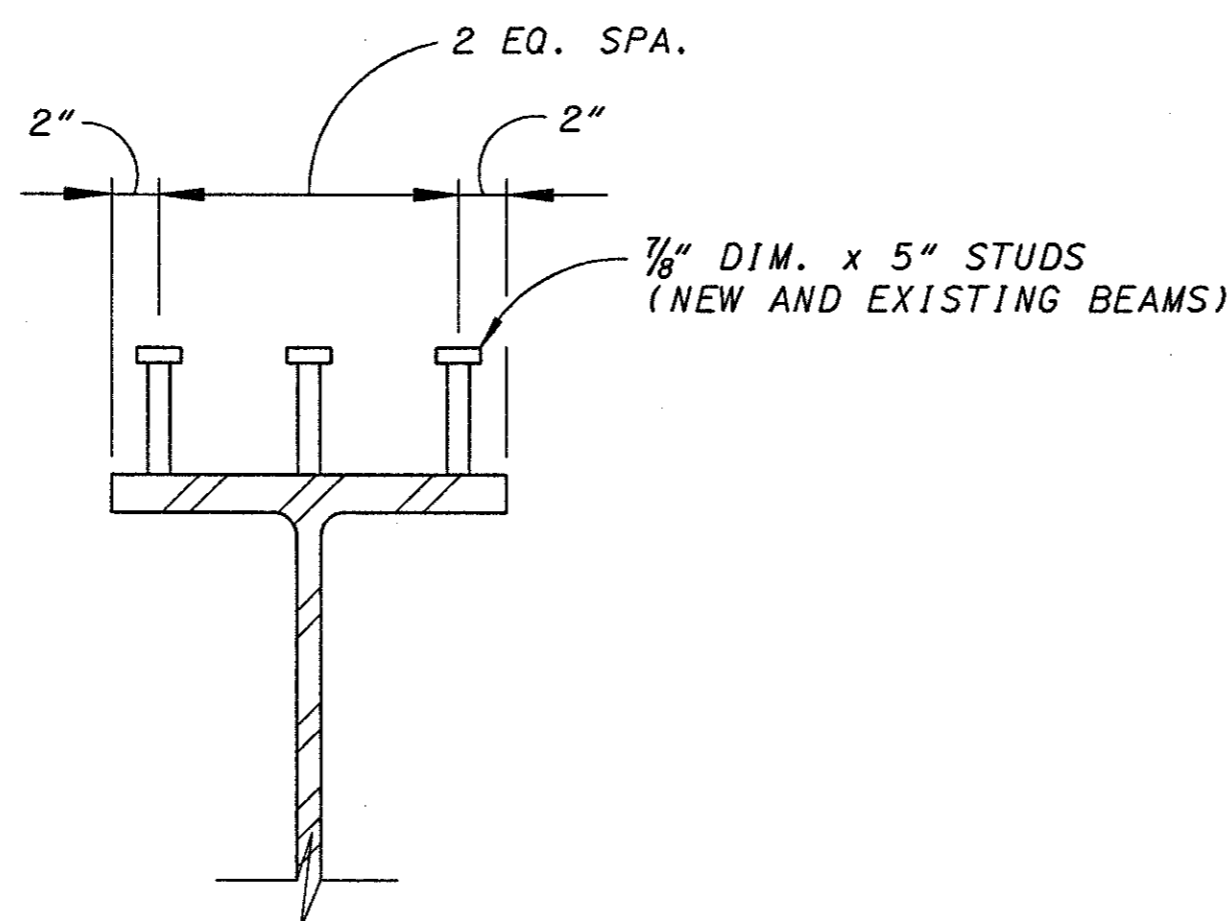

SHEAR CONNECTOR DETAIL

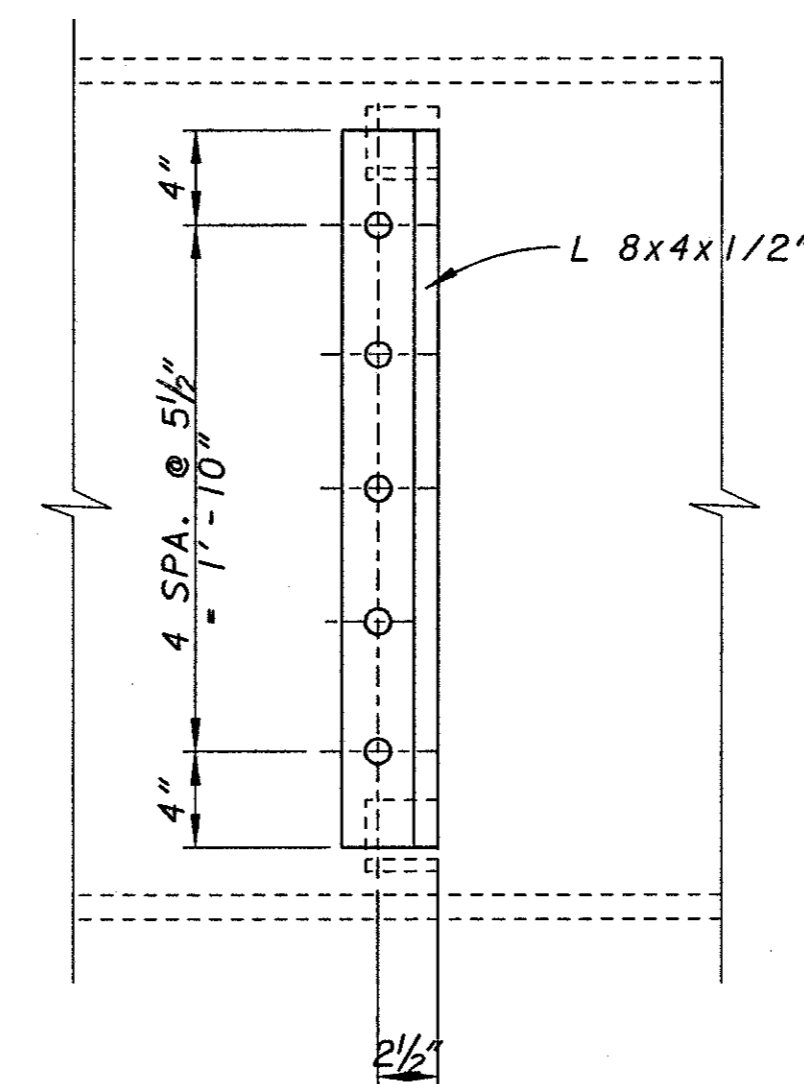

SECTION 2/20

NOTES

1. ALL NEW MATERIAL TO BE ASTM-A572/A709 GRADE 50 PAINTED UNLESS INDICATED OTHERWISE. ALL NEW AND EXISTING STEEL SHALL BE PAINTED OZEU (EXISTING) AND IZEU (NEW) WITH FEDERAL STANDARD COLOR 10324 (DARK NEUTRAL). STEEL SHALL BE FABRICATED IN ACCORDANCE WITH ODOT SUPPLEMENTAL SPECIFICATION 863.
2. SEE SHEET 24/32 FOR WELDED ATTACHMENT NOTE.
3. REGION "T" DENOTES TOP FLANGE IN TENSION AND BOTTOM FLANGE IN COMPRESSION (NEGATIVE MOMENT REGION).
4. REGION "C" DENOTES TOP FLANGE IN COMPRESSION AND BOTTOM FLANGE IN TENSION (POSITIVE MOMENT REGION).
5. SEE SHEET 19/32 FOR DEFLECTION AND CAMBER DETAILS.
6. SEE STANDARD DRAWING RB-1-55 FOR R-225 AND B-225 BEARINGS.
7. WHERE A SHAPE OR PLATE IS DESIGNATED (CVN) THE MATERIAL SHALL MEET MINIMUM NOTCH TOUGHNESS REQUIREMENTS AS SPECIFIED IN 711.01 OF CMS.
8. ALL BOLTS TO BE HIGH STRENGTH 1/8\"/>







REF: **REF**
 REF: **REF**
 USER: *****
 PROJECT: *****
 DATE: *****
 ACTIVE LEVELS ON: #LEV**

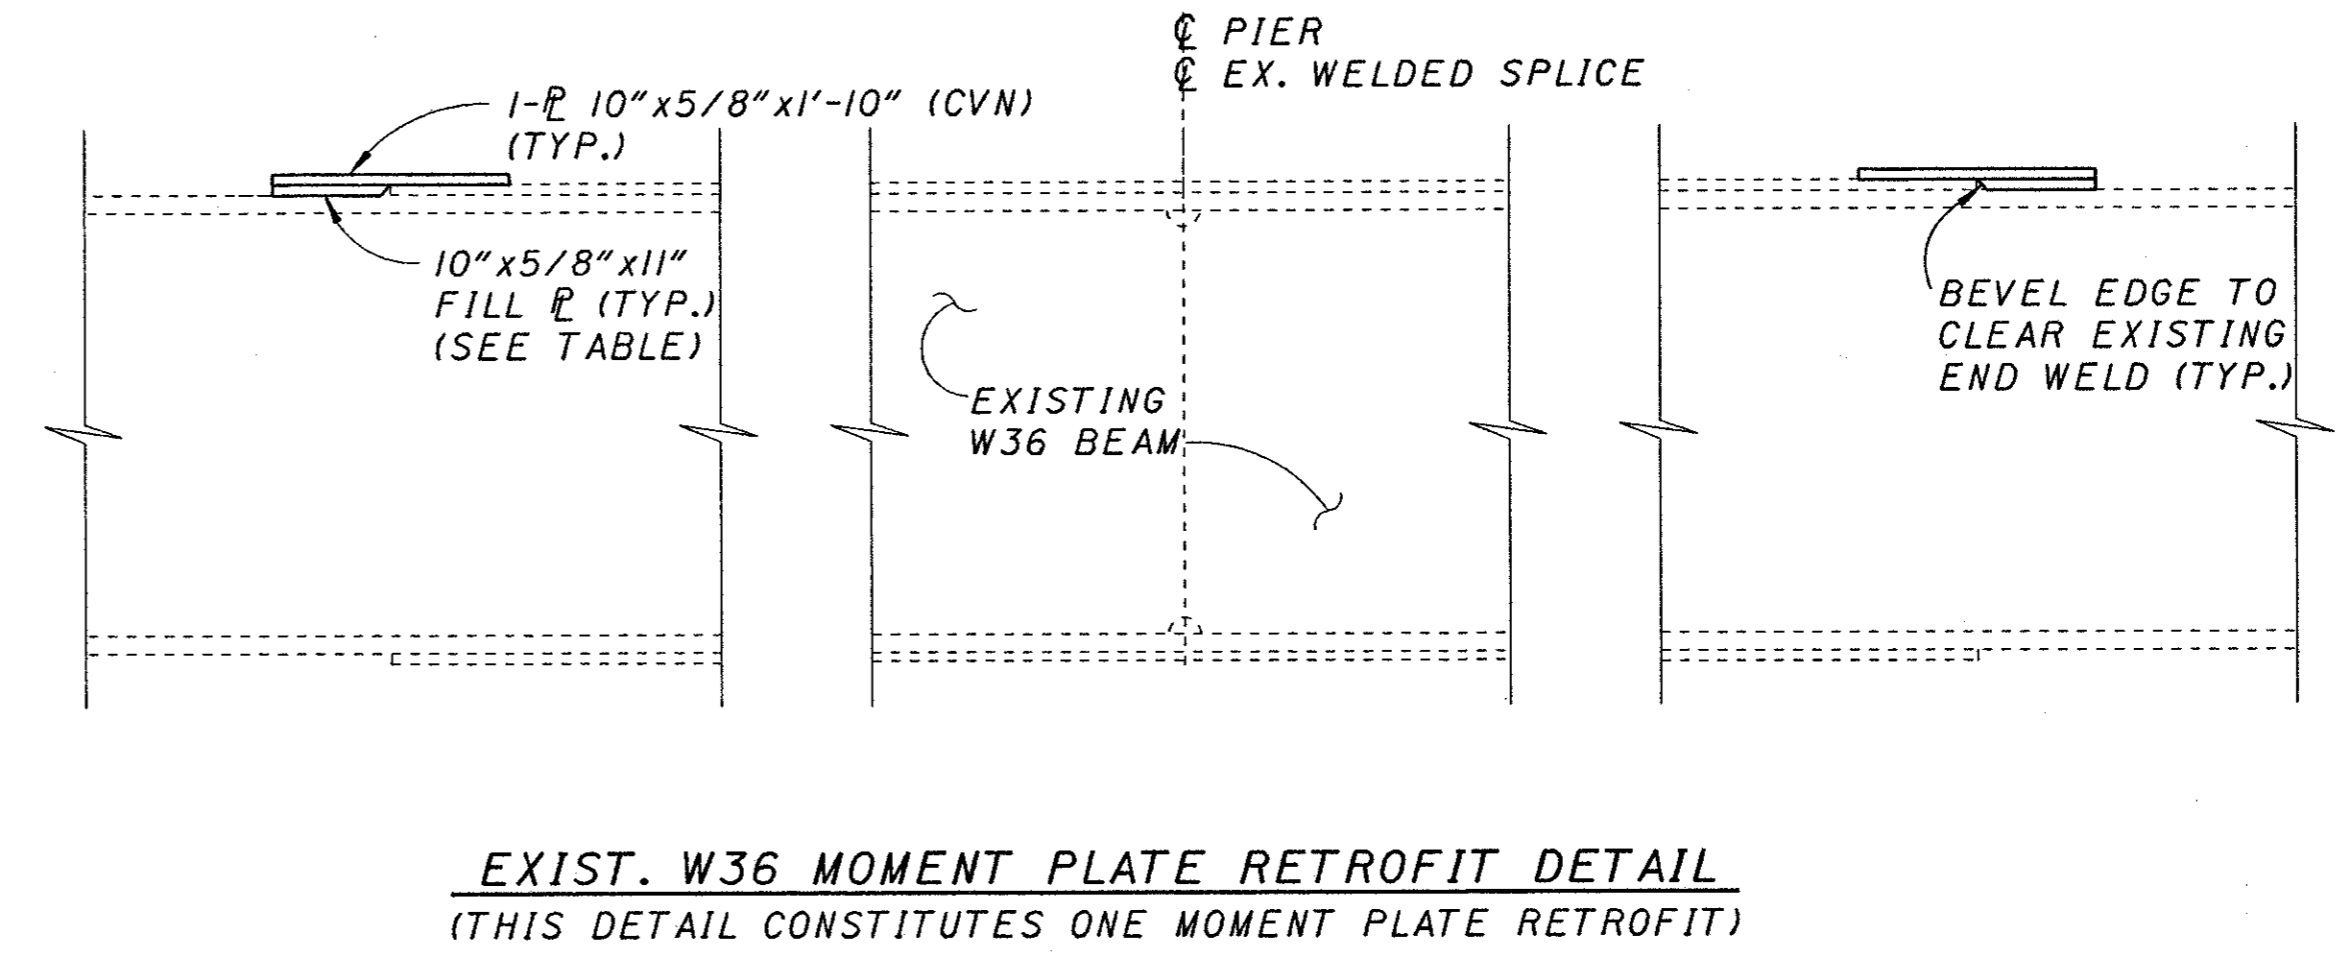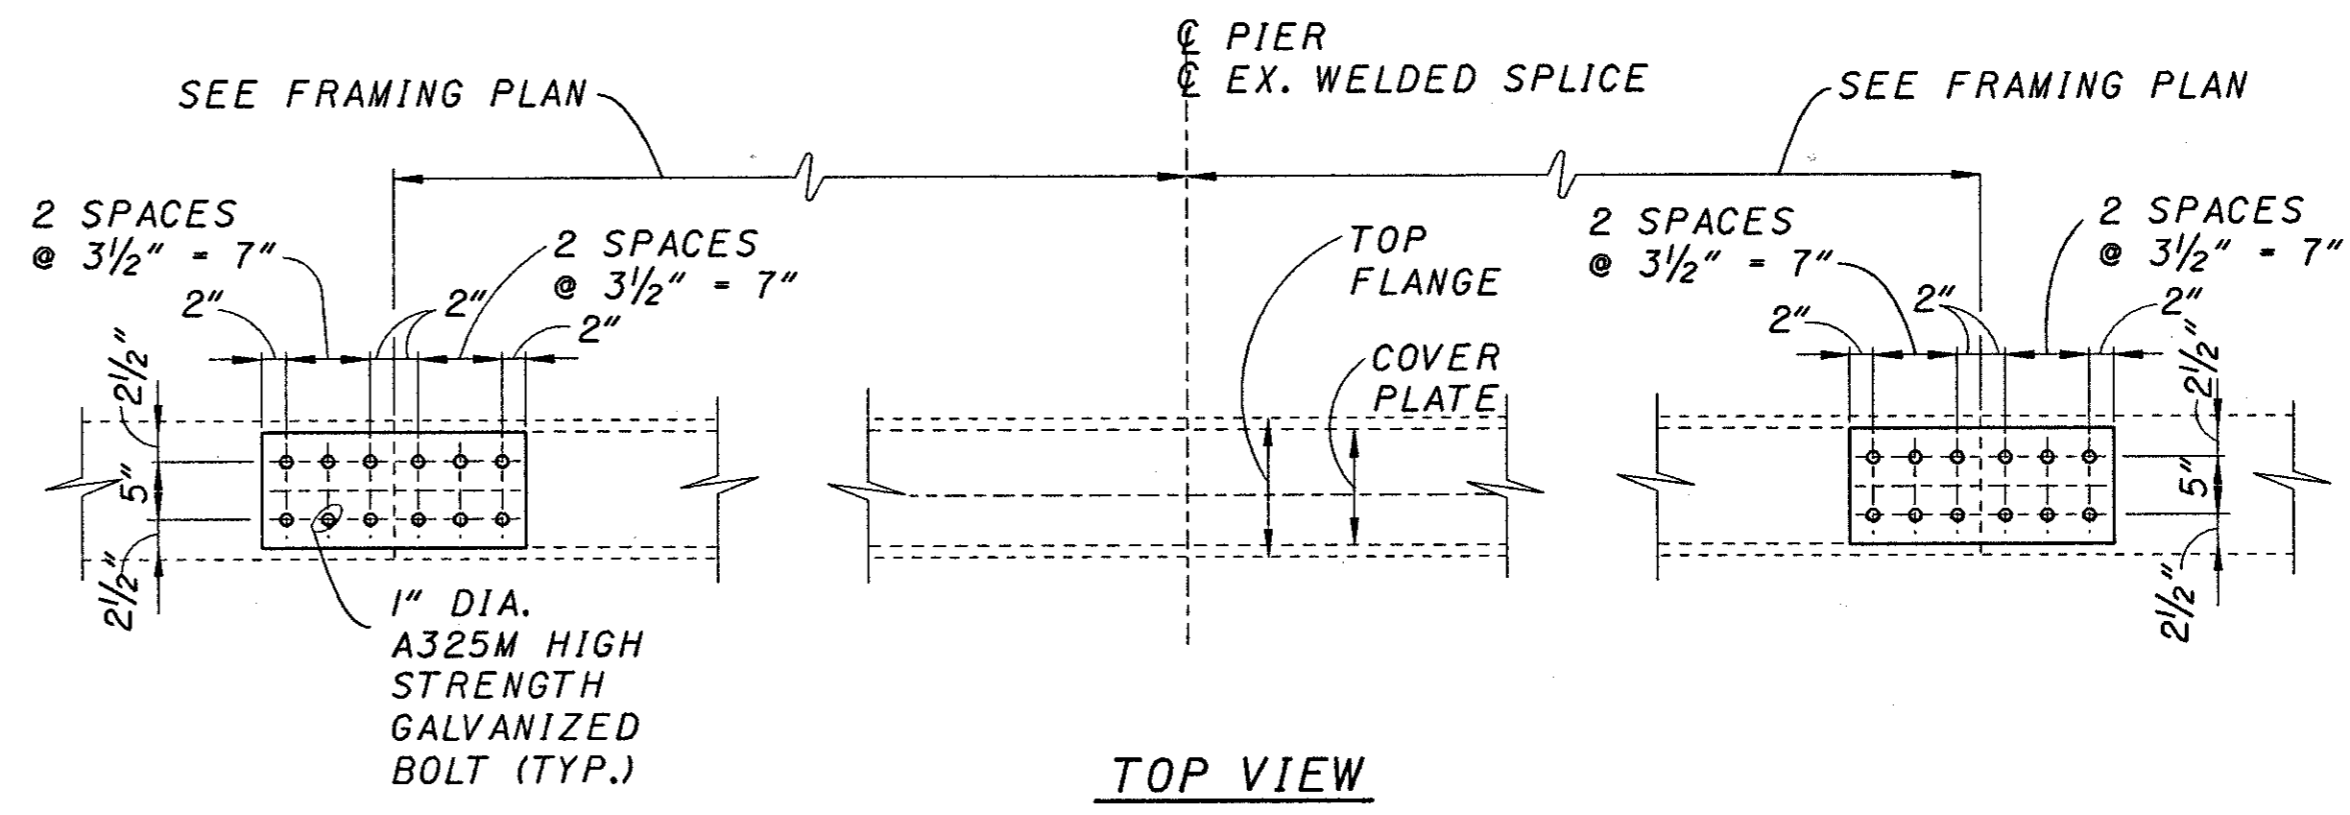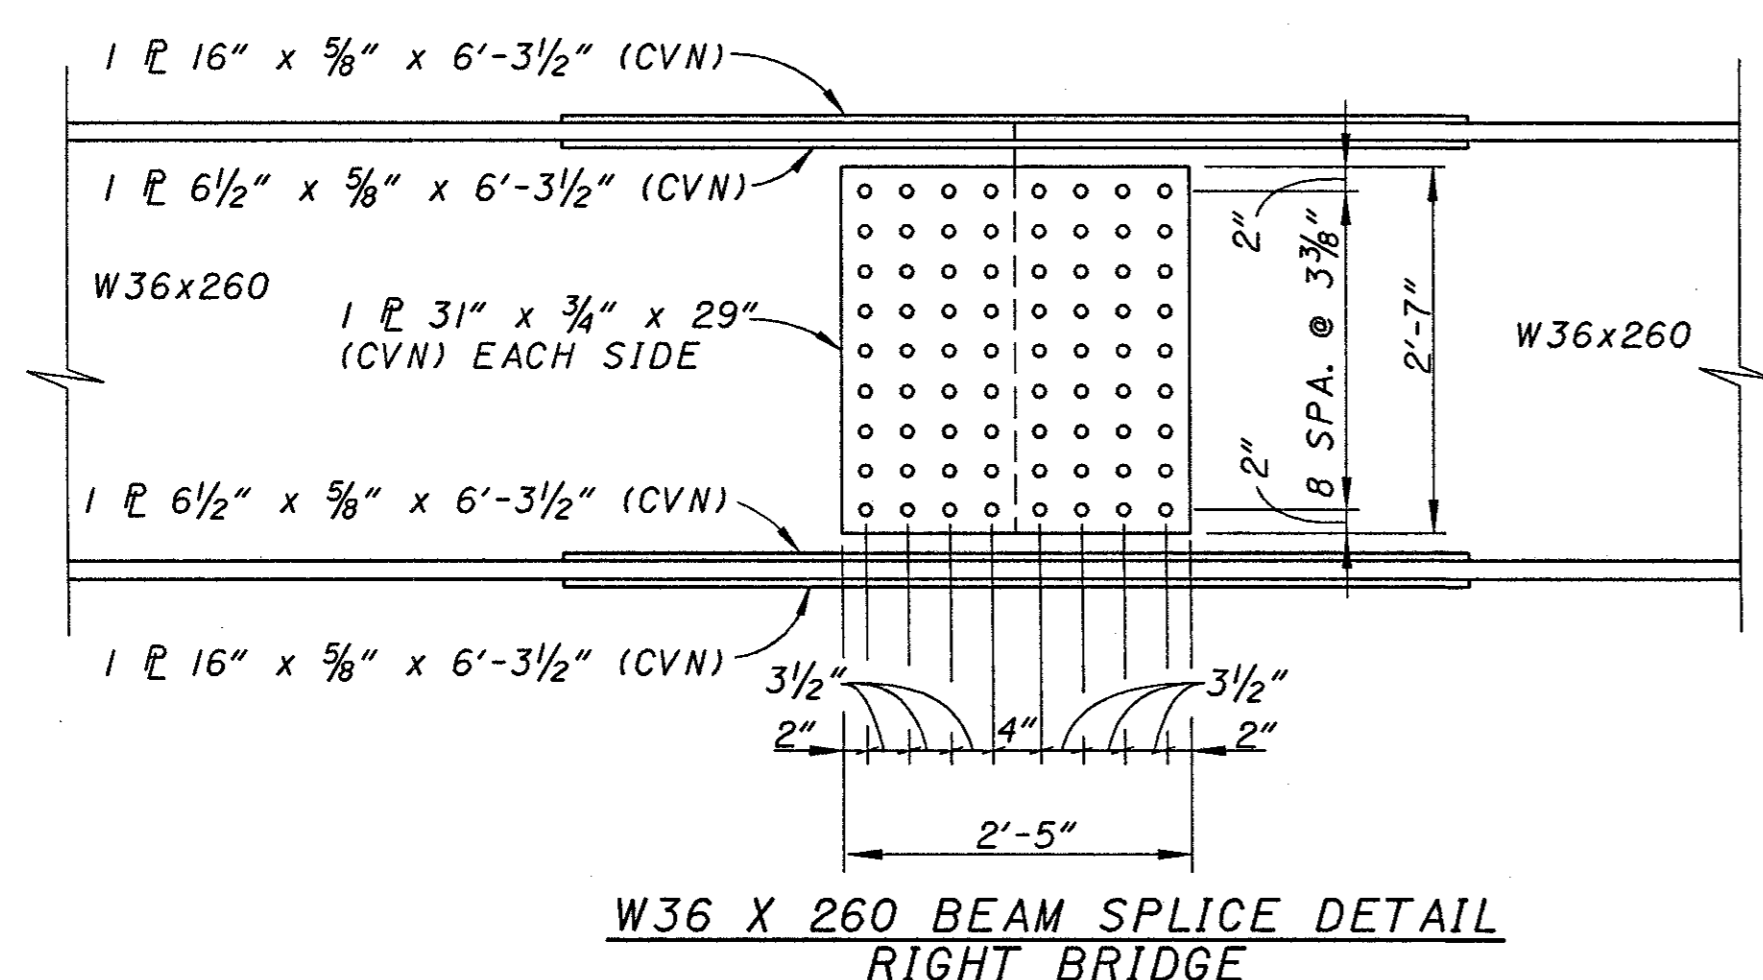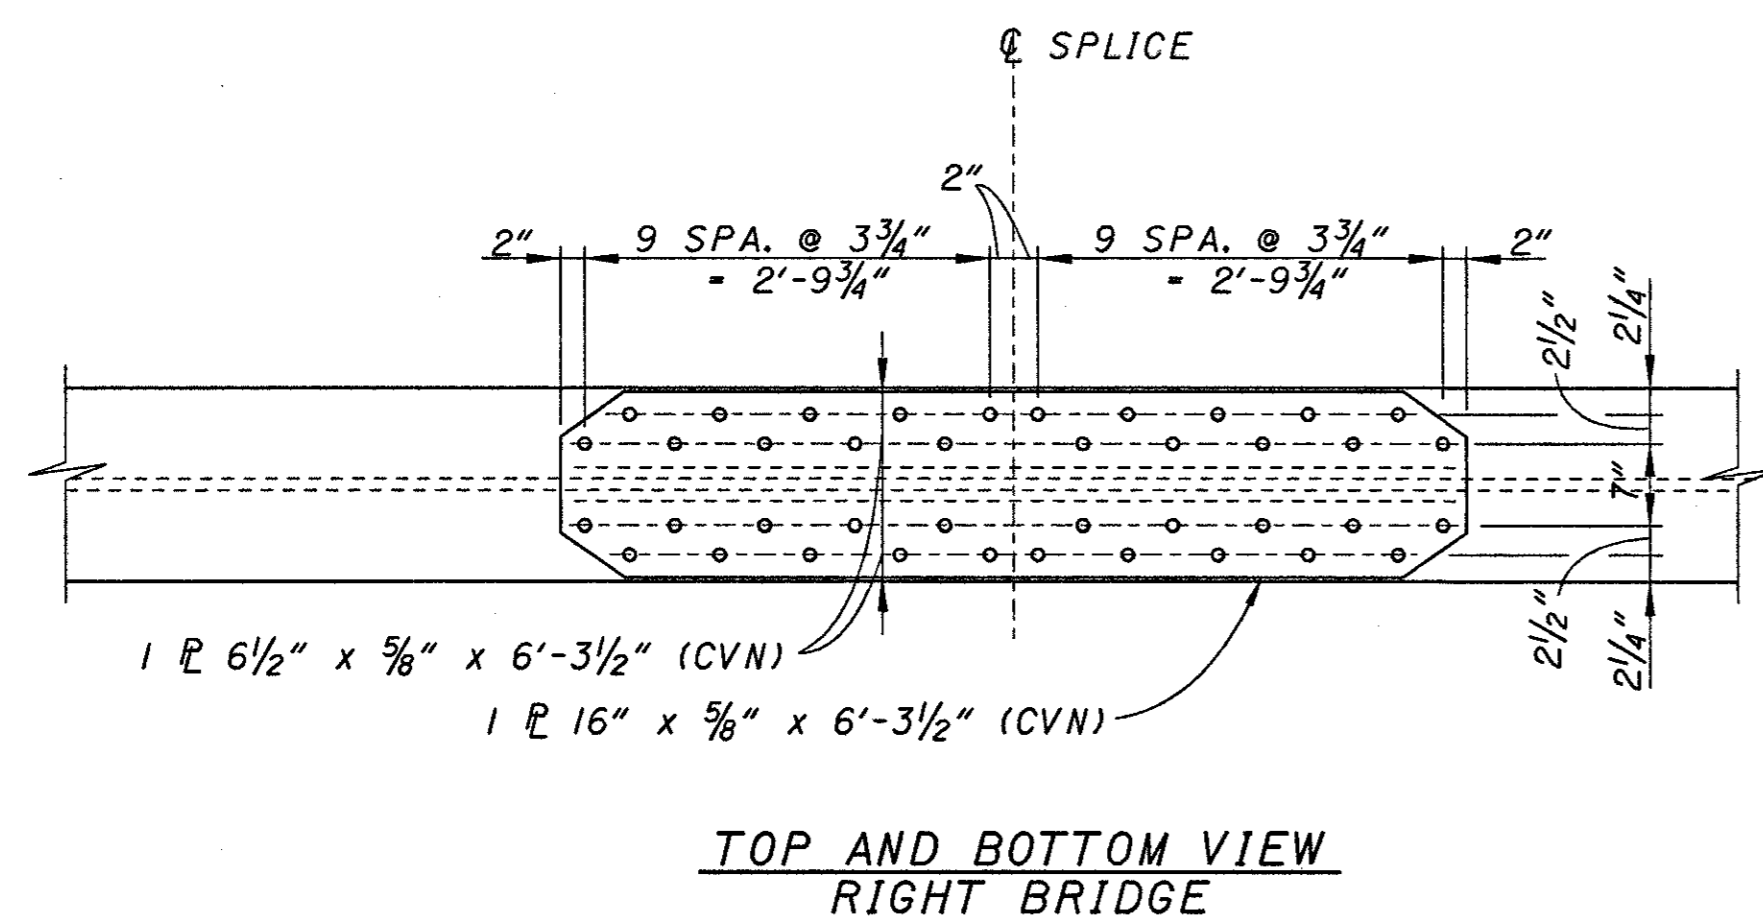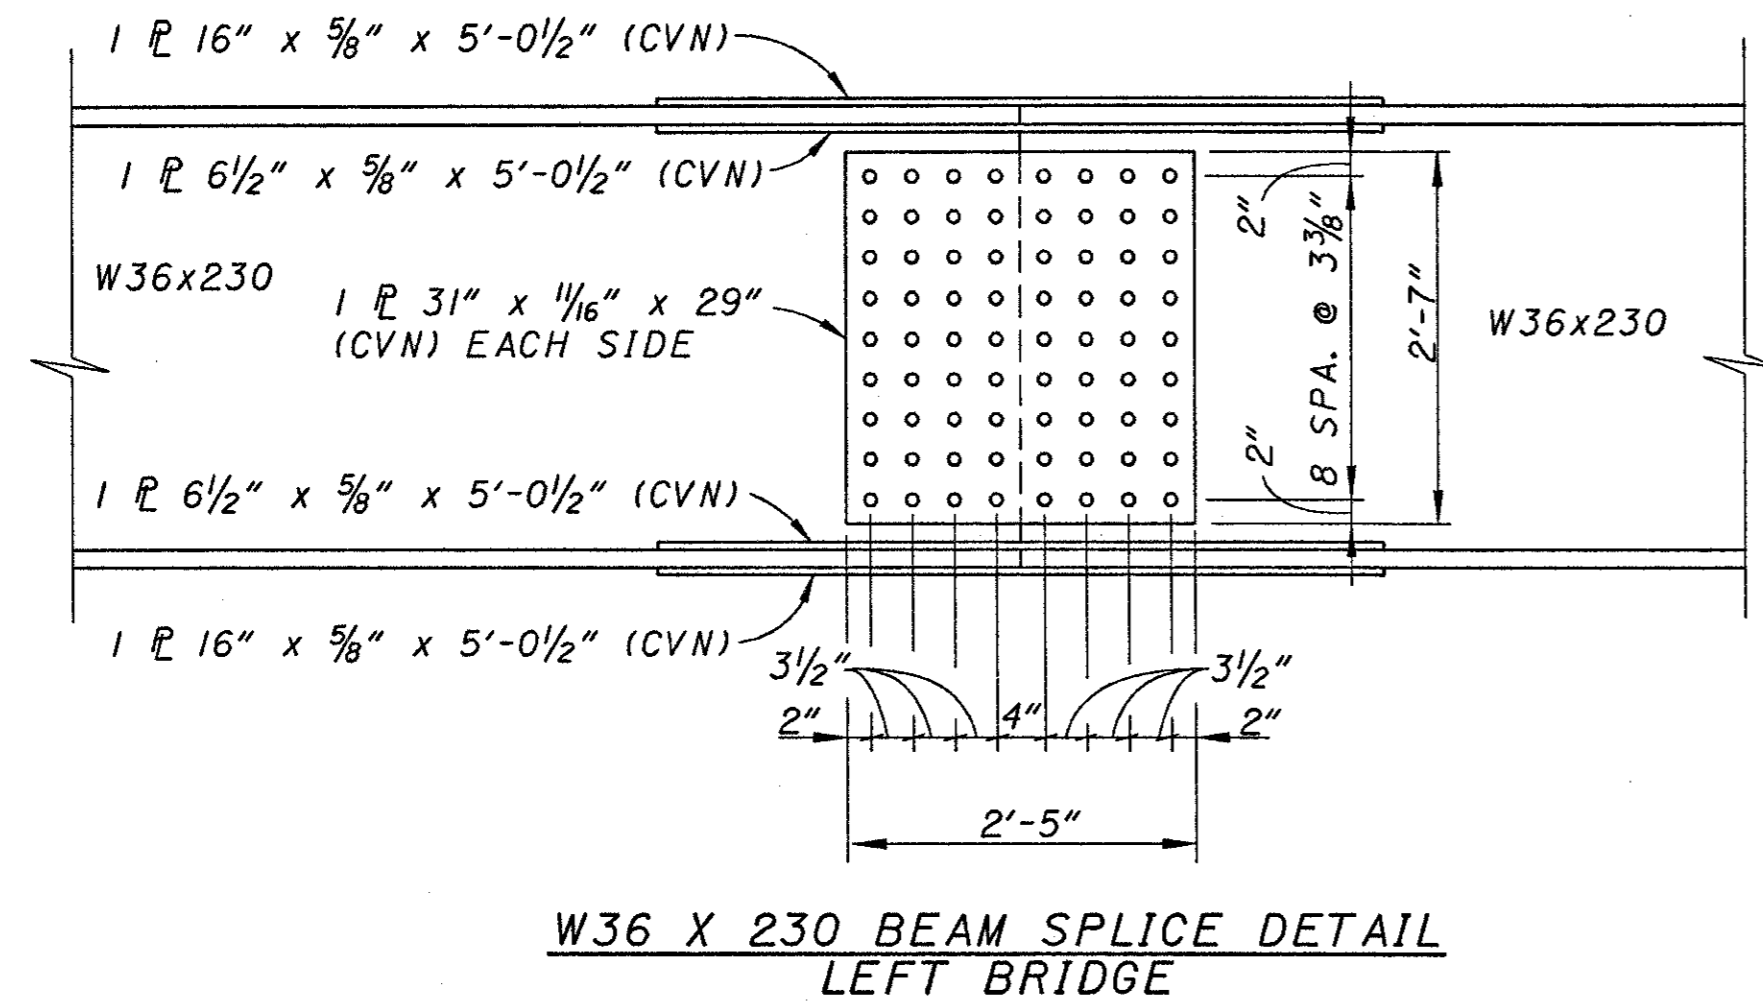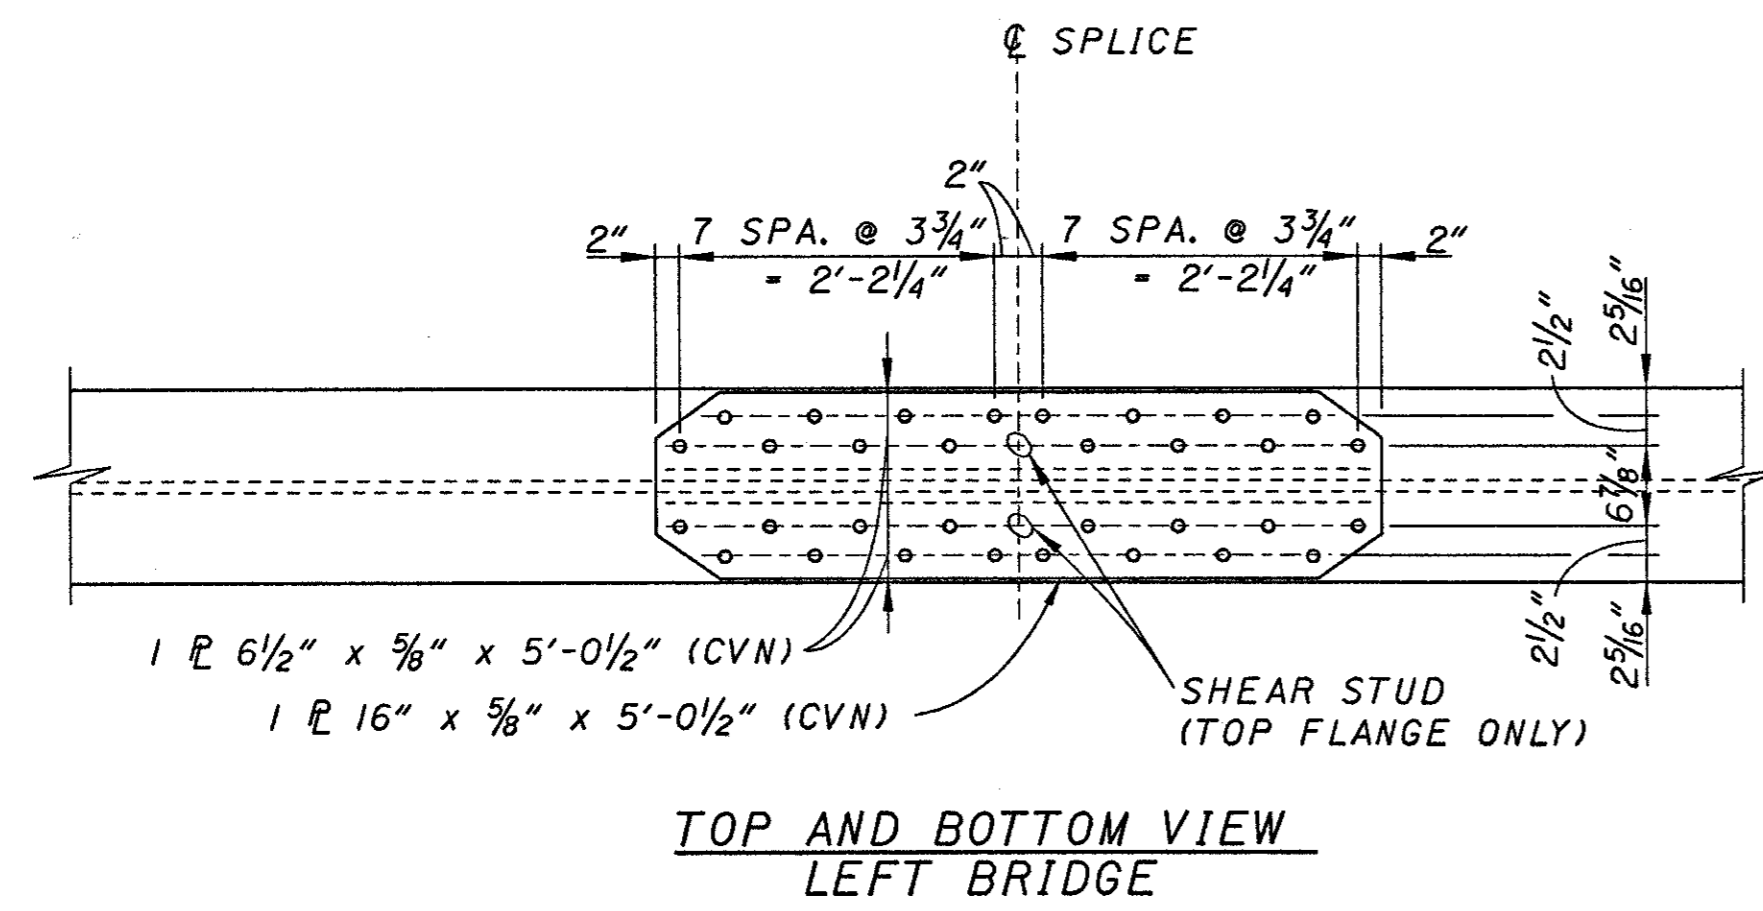

- NOTES:**
1. ALL MOMENT PLATE RETROFIT STEEL SHALL BE A36/A709-36.
 2. MOMENT PLATE RETROFIT WORK TO BE DONE ON A TIME AND MATERIAL BASIS.
 3. SEE STANDARD DRAWING GSD-I-96M FOR ADDITIONAL CROSSFRAME DETAILS.
 4. SEE STANDARD DRAWING BS-I-93 FOR ADDITIONAL DETAILS.


REF: **REF**
 REF: **REF**
USER: **USER**
 DEF: **DEF**
 FILE: **FILE**
 ACTIVE LEVELS ON: **ACTIVE LEVELS ON**

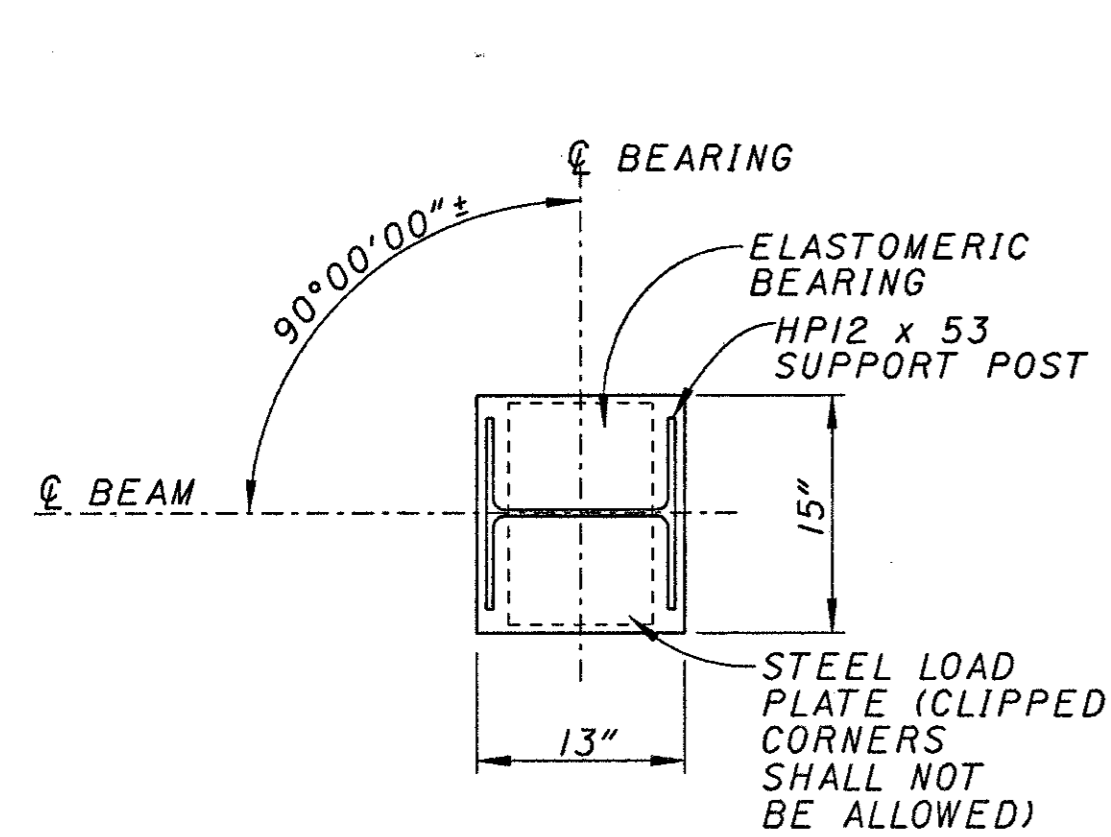

PLAN

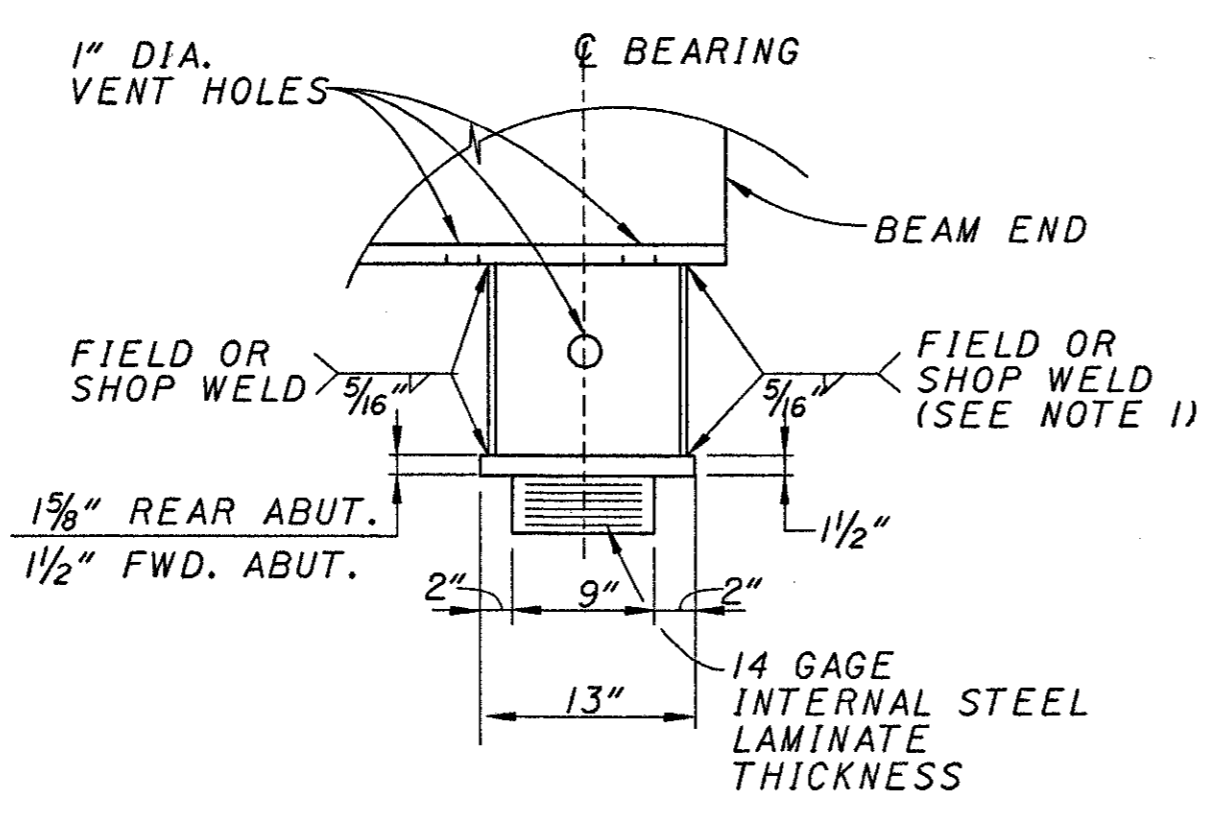

SIDE ELEVATION

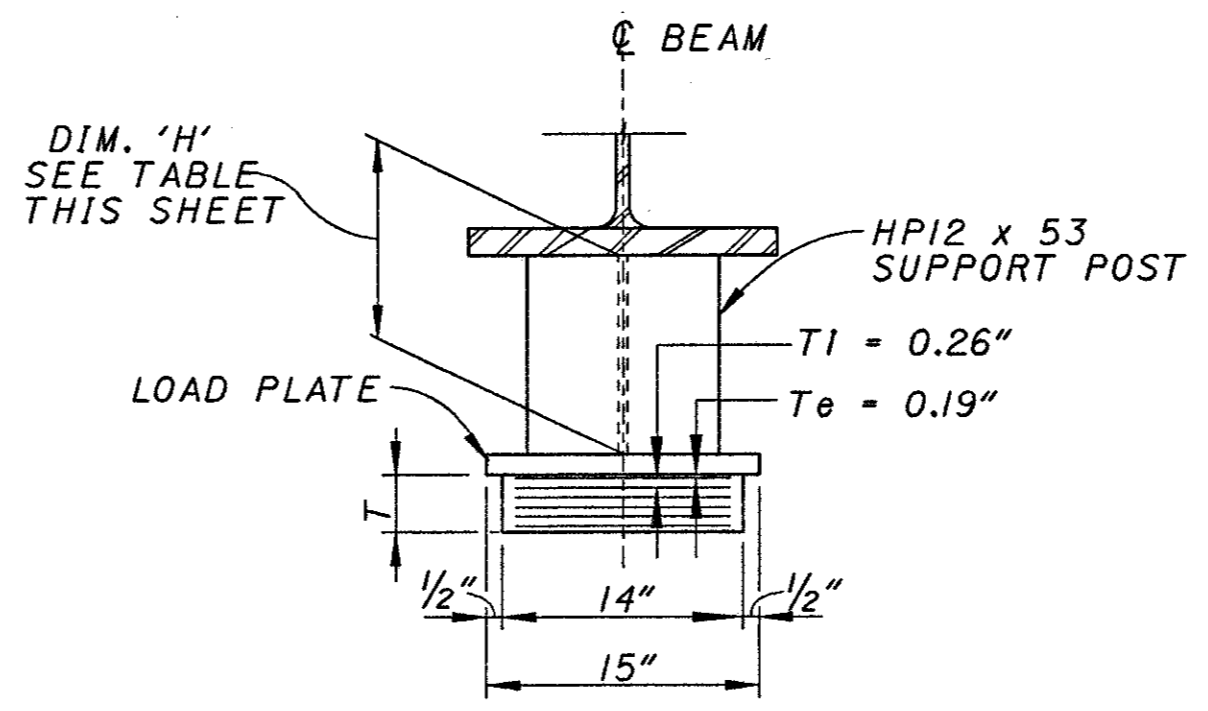

END ELEVATION

NEW BEAM SHOWN
 EX. BEAM SIMILIAR

LAMINATED ELASTOMERIC EXPANSION
 BEARING AT ABUTMENTS
 50 DUROMETER ELASTOMER, GRADE 3

ABUTMENT BEARINGS	
EXTERIOR ELASTOMERIC LAYERS	2 X 0.18 In = 0.36 In
INTERIOR ELASTOMERIC LAYERS	7 X 0.26 In = 1.82 In
STEEL PLATES	8 X 0.075 In = 0.60 In
TOTAL	'T' = 2.78 In

LEFT BRIDGE	
DEAD LOAD REACTION	= 63.2 KIPS
LIVE LOAD REACTION	= 48.4 KIPS
MAX DESIGN LOAD	= 111.6 KIPS

RIGHT BRIDGE	
DEAD LOAD REACTION	= 67.4 KIPS
LIVE LOAD REACTION	= 50.8 KIPS
MAX DESIGN LOAD	= 118.2 KIPS

SUPPORT POST HEIGHT TABLE			
LEFT BRIDGE			
REAR ABUTMENT	BEAM	FORWARD ABUTMENT	BEAM
B1	6 3/8"	B1	6 7/16"
B2	6 3/8"	B2	6 7/16"
B3	6 3/8"	B3	6 7/16"
B4	6 3/8"	B4	6 7/16"
B5	6 3/8"	B5	6 7/16"
B6	6 3/8"	B6	6 7/16"
B7	10"	B7	9"
B8	8 1/2"	B8	7 1/2"
B9	7"	B9	6"

SUPPORT POST HEIGHT TABLE			
RIGHT BRIDGE			
REAR ABUTMENT	BEAM	FORWARD ABUTMENT	BEAM
B1	7"	B1	6"
B2	8 5/8"	B2	7 5/8"
B3	10 1/4"	B3	9 1/4"
B4	6 3/8"	B4	6 7/16"
B5	6 3/8"	B5	6 7/16"
B6	6 3/8"	B6	6 7/16"
B7	6 3/8"	B7	6 7/16"
B8	6 3/8"	B8	6 7/16"
B9	6 3/8"	B9	6 7/16"

BEARING NOTES:

- WELDING OF THE LOAD PLATE TO THE HP12 x 53 SUPPORT POST OR GIRDER FLANGE SHALL BE CONTROLLED SO THAT THE PLATE TEMPERATURE AT THE ELASTOMERIC BONDED SURFACE DOES NOT EXCEED 300°F AS DETERMINED BY USE OF PYROMETRIC STICKS OR OTHER TEMPERATURE MONITORING DEVICES.
 STEEL FOR BEARING LOAD PLATES TO BE A709-36
 HP12 x 53 SUPPORT POSTS TO BE A709-36
 THE STEEL LOAD PLATE SHALL BE BONDED BY VULCANIZATION TO THE ELASTOMER DURING THE MOLDING PROCESS.
 IF THE STEEL IS ERECTED AT AN AMBIENT TEMPERATURE HIGHER THAN 80°F OR LOWER THAN 40°F, AND THE BEARING SHEAR DEFLECTION EXCEEDS ONE SIXTH OF THE BEARING HEIGHT AT 60°F ± 9°F, THE GIRDER SHALL BE RAISED TO ALLOW THE BEARINGS TO RETURN TO THEIR UNDEFORMED SHAPE AT 60°F.
- REINFORCING STEEL IN THE VICINITY OF THE BRIDGE SEAT SHALL BE ACCURATELY PLACED TO AVOID INTERFERENCE WITH THE DRILLING OF BEARING ANCHOR HOLES OR THE PRESETTING OF BEARING ANCHORS FOR THE BEARING RETAINERS.
- SEE STD. DWG. SICD-1-96M FOR ADDITIONAL DETAILS.
- ELASTOMERIC BEARINGS SHALL COMPLY WITH ITEM 516 AND AASHTO STANDARD SPECIFICATION FOR HIGHWAY BRIDGES, SECTION 18, BEARING DEVICES, DIVISION II, CONSTRUCTION, ARTICLES 18.4.5.1 AND 18.5.6.2. BEARINGS SHALL BE GRADE 3, 50 DUROMETER ELASTOMER, AND SHALL BE SUBJECTED TO THE LOAD TESTING REQUIREMENTS DEFINED IN ARTICLE 18.7.4.5 OF THE AASHTO DOCUMENT LISTED ABOVE. BEARINGS WERE DESIGNED UNDER SECTION 14.6.6 OF SECTION 14, BEARINGS, DIVISION I, DESIGN (METHOD A).

DESIGN AGENCY
KZF DESIGN
 ARCHITECTURE | ENGINEERING | PLANNING
 407 HERRING HILL ROAD, SUITE 200, CHICAGO, IL 60610
 TEL: 312.321.3800 FAX: 312.321.3808 WEB: WWW.KZF.COM

DATE: 1/20/00
 REVIEWED: DCK
 DRAWN: MWL
 DESIGNED: SJA
 STRUCTURE FILE NUMBER: 68014716801501
 CHECKED:

KZF #17

BEARING DETAILS
 BRIDGE NO. PRE-70-1500 L/R & R
 I.R. 70 OVER TWIN CREEK

PRE-70-0.00


REF: **REF**
 REF: **REF**
ACTIVE BASES
 USER: SAUERMAN
 PROJECT: I-70 OVER TWIN CREEK
 ACTIVE LEVELS ON: **ELEV**

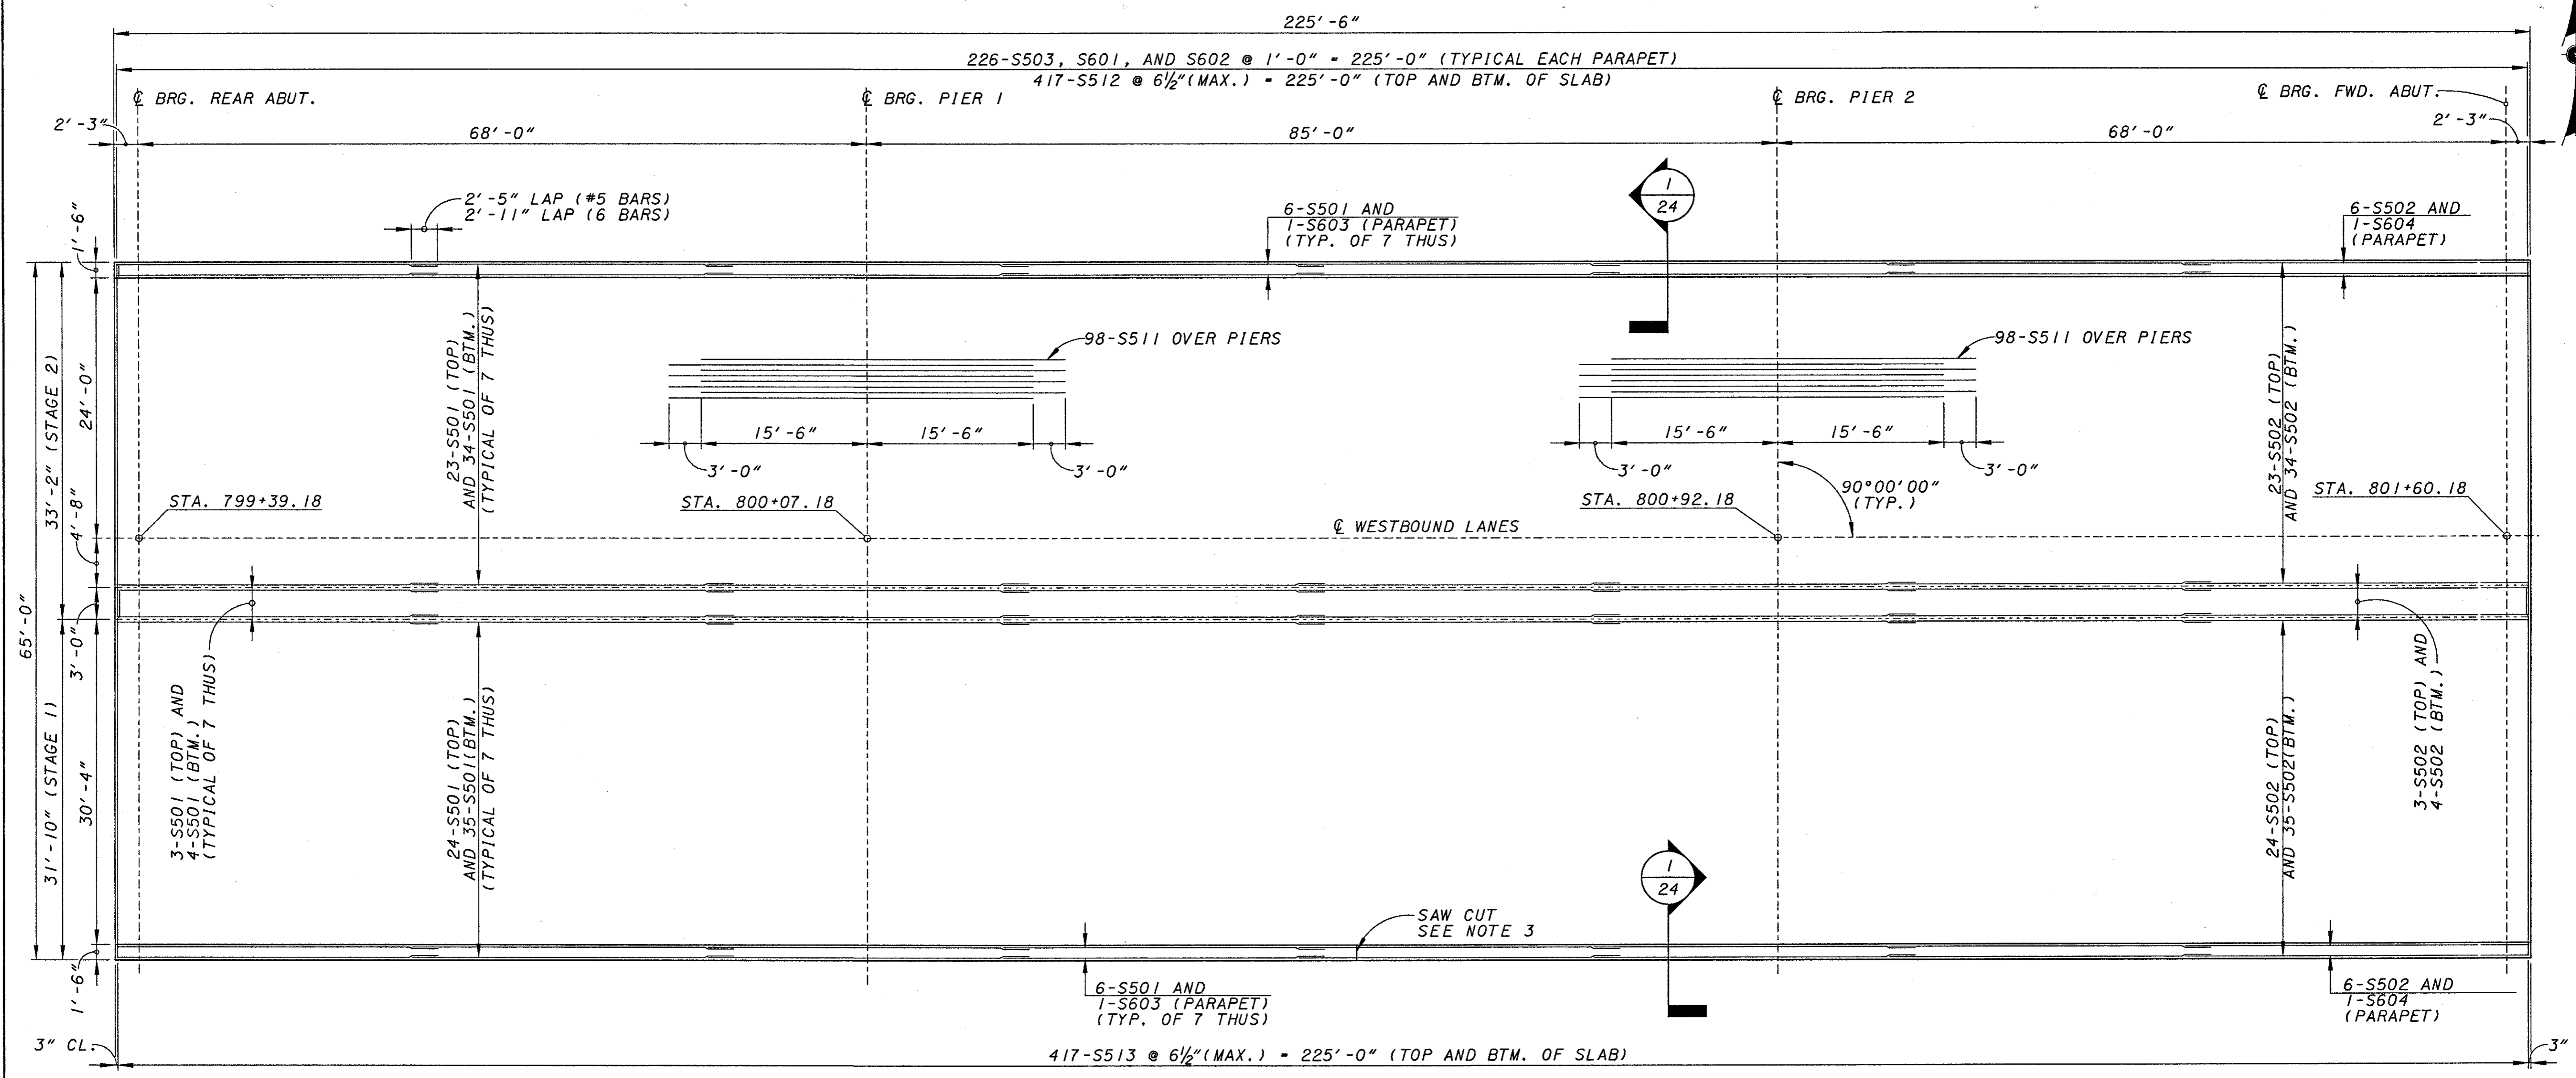


PLAN

NOTE:
 1. SEE SHEET 24/32 FOR SUPERSTRUCTURE NOTES.

DESIGNED	SJA	CHECKED	WBS
DRAWN	SJA	REVISED	
REVIEWED	DGK	DATE	11/20/00
STRUCTURE FILE NUMBER	68014716801501		


KZF #17
 DECK PLAN - LEFT BRIDGE
 BRIDGE NO. PRE-70-1500 L/R
 I.R. 70 OVER TWIN CREEK

PRE-70-0.00

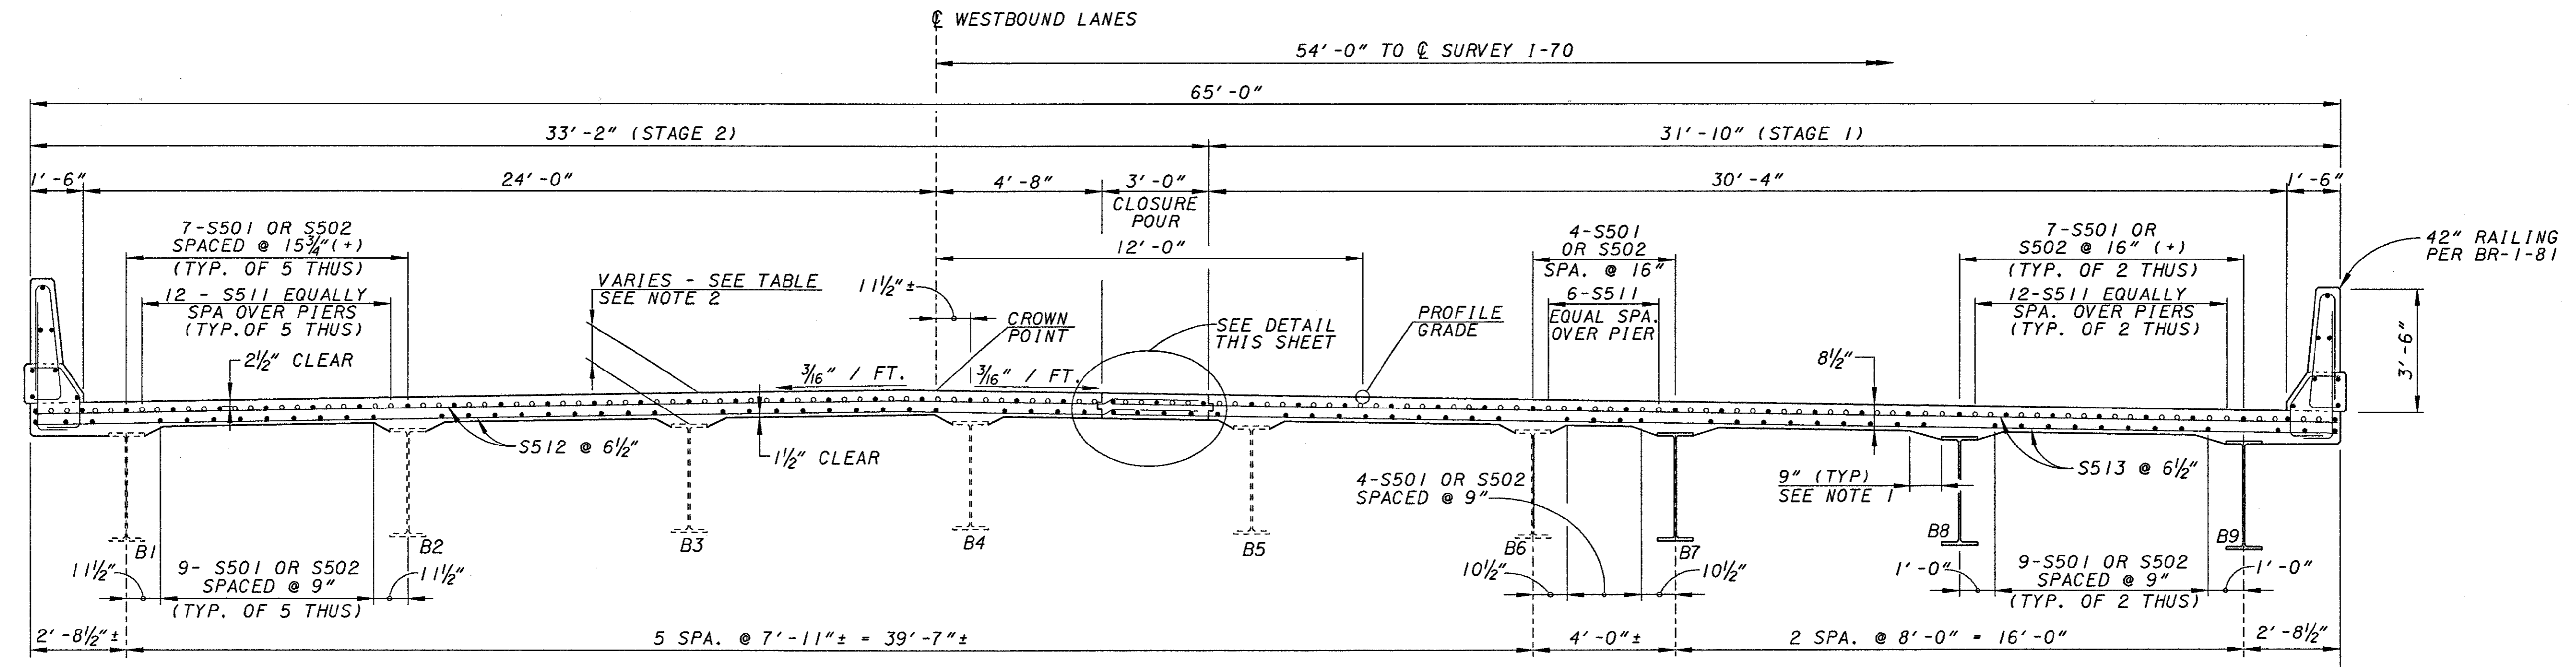


TYPICAL SECTION
LEFT BRIDGE

ALL STEEL CLEARANCES ARE 2" UNLESS OTHERWISE NOTED.

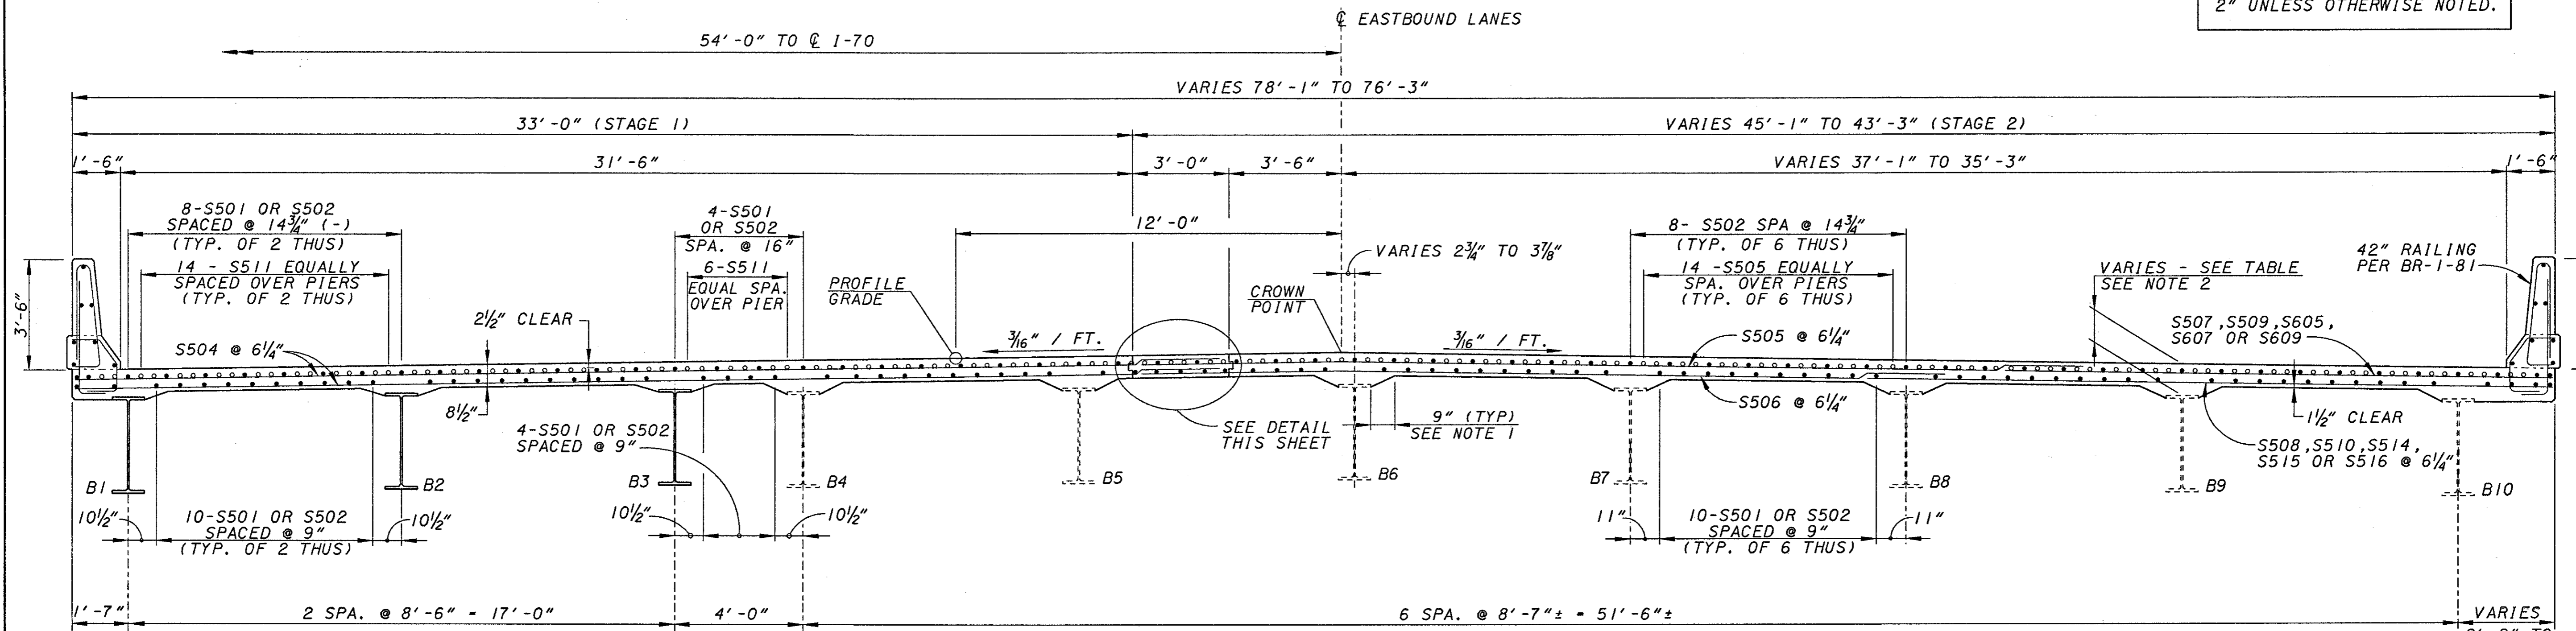

TYPICAL SECTION
RIGHT BRIDGE

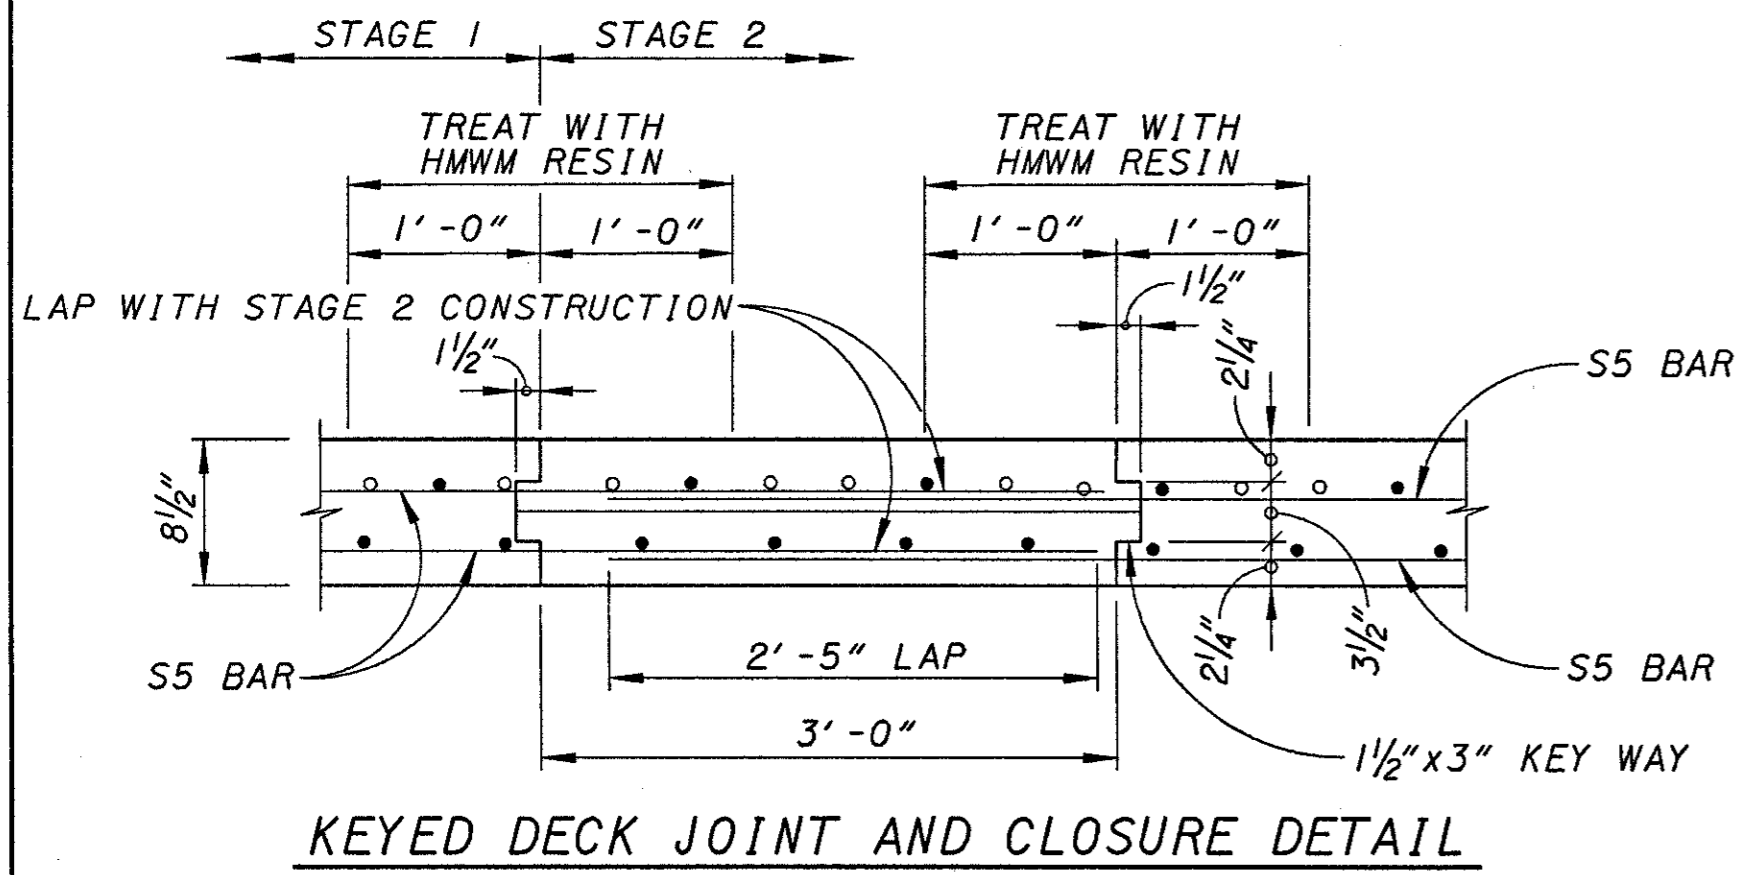

KEYED DECK JOINT AND CLOSURE DETAIL

LEFT BRIDGE
CONCRETE DECK HAUNCH DEPTH

BEAM	REAR ABUT.	PIER-1	PIER-2	FWD. ABUT.
B1	12"	10 7/8"	11 1/8"	11 3/8"
B2	11 3/4"	10 7/8"	11"	11 3/8"
B3	11 5/8"	10 7/8"	11 3/8"	11 3/8"
B4	11 3/8"	10 7/8"	11 1/8"	11 1/2"
B5	11 1/8"	10 7/8"	11 1/4"	11 1/4"
B6	11 5/8"	11 1/8"	11 1/8"	11 3/8"
B7-B9	10 1/2"	10 1/2"	10 1/2"	10 1/2"

RIGHT BRIDGE
CONCRETE DECK HAUNCH DEPTH

BEAM	REAR ABUT.	PIER-1	PIER-2	FWD. ABUT.
B1-B3	10 1/2"	10 1/2"	10 1/2"	10 1/2"
B4	10 1/2"	10 1/8"	10 3/8"	11"
B5	10 1/2"	9 7/8"	10 1/2"	10 7/8"
B6	10 3/4"	10 1/4"	10 1/4"	11"
B7	10 1/2"	10"	10 3/8"	10 3/4"
B8	10 1/4"	10 1/4"	10 3/8"	10 3/8"
B9	10 1/4"	10 1/4"	10 3/8"	10 1/2"
B10	10 3/8"	10 1/4"	10 5/8"	10 5/8"

- NOTES:**
1. A HAUNCH WIDTH OF 9" SHALL BE USED FOR COMPUTING QUANTITY OF CONCRETE (OVER NEW BEAMS). HOWEVER, THE HAUNCH WIDTH MAY VARY BETWEEN 6" AND 12".
 2. THE DISTANCE FROM TOP OF DECK SLAB TO TOP OF STEEL BEAM FLANGE IS THE THEORETICAL DESIGN DIMENSION INCLUDING THE DESIGN HAUNCH THICKNESS OF 2 INCHES. THE QUANTITY OF DECK CONCRETE SHALL BE BASED ON THIS DIMENSION, EVEN THOUGH DEVIATION FROM IT MAY BE NECESSARY BECAUSE THE TOP FLANGE OF THE GIRDER MAY NOT HAVE THE EXACT CAMBER OR CONFORMATION REQUIRED TO PLACE IT PARALLEL TO THE FINISHED GRADE. DEDUCTION SHALL BE MADE FOR VOLUME OF ENCASED STEEL PLATES AS PER 511.18.
 3. FOR ADDITIONAL NOTES SEE SHEET [24/32].

CONSTRUCTION ELEVATIONS (SCREEDS) FOR BRIDGE DECK PLACEMENT


	Q BEARING REAR ABUT.	0.2 L	0.4 L	0.6 L	0.8 L	PIER 1	0.2 L	0.4 L	0.6 L	0.8 L	PIER 2
LEFT GUTTER	947.98	947.88	947.78	947.66	947.55	947.45	947.37	947.31	947.24	947.16	947.09
BEAM B1	947.99	947.90	947.79	947.68	947.57	947.47	947.39	947.33	947.26	947.17	947.11
BEAM B2	948.12	948.02	947.92	947.81	947.69	947.59	947.51	947.45	947.38	947.30	947.23
BEAM B3	948.24	948.14	948.04	947.93	947.81	947.71	947.64	947.57	947.50	947.42	947.36
Q CONSTRUCTION & CROWN	948.35	948.25	948.15	948.04	947.92	947.82	947.74	947.68	947.61	947.53	947.47
BEAM B4	948.34	948.24	948.14	948.02	947.91	947.81	947.73	947.67	947.60	947.51	947.45
LEFT CONSTRUCTION JOINT	948.28	948.18	948.08	947.96	947.85	947.75	947.67	947.61	947.54	947.46	947.39
RIGHT CONSTRUCTION JOINT	948.23	948.13	948.03	947.92	947.80	947.70	947.62	947.56	947.49	947.41	947.35
BEAM B5	948.21	948.11	948.01	947.90	947.78	947.68	947.61	947.54	947.47	947.39	947.33
BEAM B6	948.09	947.99	947.89	947.78	947.66	947.56	947.48	947.42	947.35	947.27	947.20
BEAM B7	948.03	947.93	947.83	947.71	947.60	947.50	947.42	947.36	947.29	947.21	947.14
BEAM B8	947.90	947.80	947.70	947.59	947.47	947.37	947.29	947.23	947.16	947.08	947.02
BEAM B9	947.78	947.68	947.58	947.46	947.35	947.25	947.17	947.11	947.04	946.96	946.89
RIGHT GUTTER	947.76	947.66	947.56	947.44	947.33	947.23	947.15	947.09	947.02	946.94	946.87

CONSTRUCTION ELEVATIONS (SCREEDS) FOR BRIDGE DECK PLACEMENT

	PIER 2	0.2 L	0.4 L	0.6 L	0.8 L	Q BEARING FORWARD ABUT.
LEFT GUTTER	947.09	947.08	947.08	947.07	947.05	947.02
BEAM B1	947.11	947.09	947.10	947.09	947.07	947.04
BEAM B2	947.23	947.22	947.22	947.22	947.20	947.16
BEAM B3	947.36	947.34	947.34	947.34	947.32	947.28
Q CONSTRUCTION & CROWN	947.47	947.45	947.45	947.45	947.43	947.39
BEAM B4	947.45	947.44	947.44	947.43	947.41	947.38
LEFT CONSTRUCTION JOINT	947.39	947.38	947.38	947.38	947.36	947.32
RIGHT CONSTRUCTION JOINT	947.35	947.33	947.33	947.33	947.31	947.27
BEAM B5	947.33	947.31	947.31	947.31	947.29	947.25
BEAM B6	947.20	947.19	947.19	947.19	947.17	947.13
BEAM B7	947.14	947.13	947.13	947.12	947.10	947.07
BEAM B8	947.02	947.00	947.00	947.00	946.98	946.94
BEAM B9	946.89	946.88	946.88	946.87	946.85	946.82
RIGHT GUTTER	946.87	946.86	946.86	946.86	946.84	946.80

NOTES:

1. FOR DEFLECTIONS & CHAMBER TABLES SEE SHEET. 19/32
2. FOR SLAB PLAN SEE SHEET. 23/32
3. SCREED ELEVATIONS ARE GIVEN FOR THE TOP SURFACE OF THE CONCRETE DECK PRIOR TO CONCRETE PLACEMENT. ALLOWANCE HAS BEEN MADE FOR ANTICIPATED CALCULATED DEAD LOAD DEFLECTIONS.
4. L DENOTES LENGTH OF SPAN

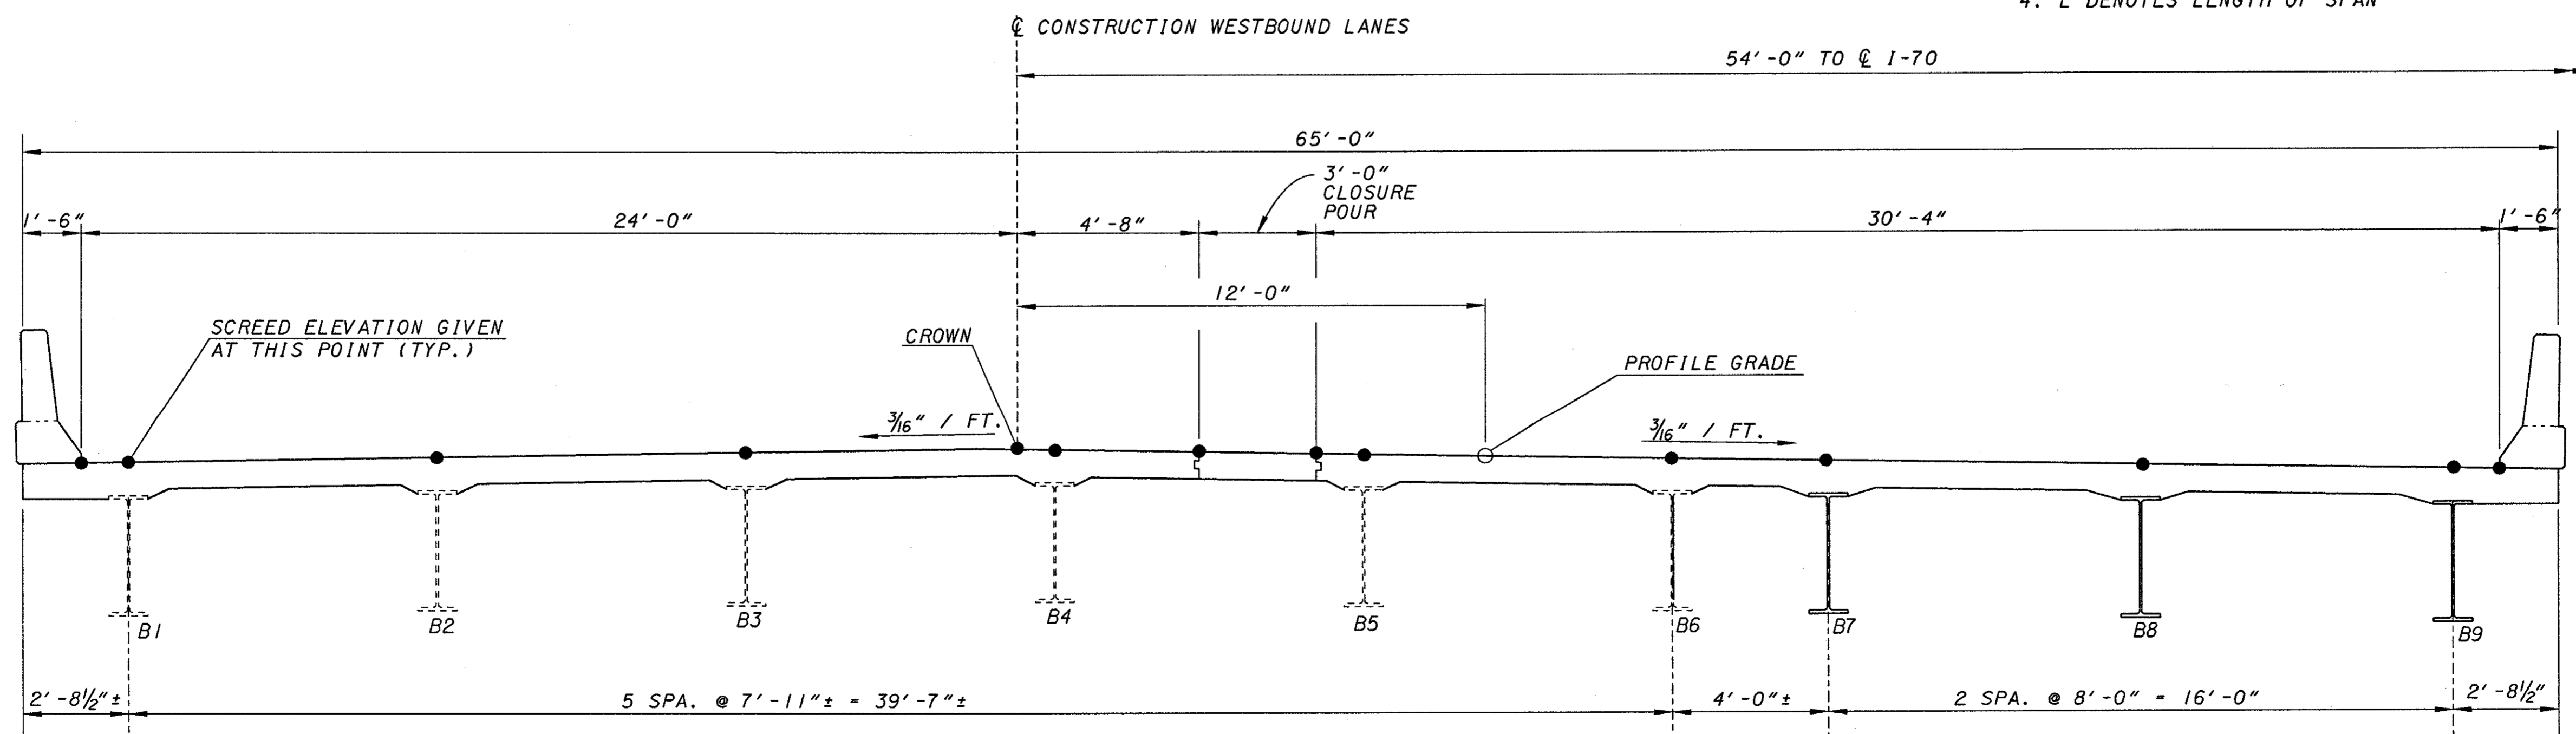

DECK ELEVATIONS

REF: **REF**
REF: **REF**
ACTIVE LEVELS ON: **LEVE**
REF: **REF**
REF: **REF**

REF: **REF1**
REF: **REF2**
REF: **REF3**
REF: **REF4**
REF: **REF5**
REF: **REF6**

REF: **REF1**
REF: **REF2**
REF: **REF3**
REF: **REF4**
REF: **REF5**
REF: **REF6**

REF: **REF1**
REF: **REF2**
REF: **REF3**
REF: **REF4**
REF: **REF5**
REF: **REF6**


REF: **REF1**
REF: **REF2**
REF: **REF3**
REF: **REF4**
REF: **REF5**
REF: **REF6**

USER: **USER**
DATE: **DATE**
TIME: **TIME**
ACTIVE LEVELS: ON

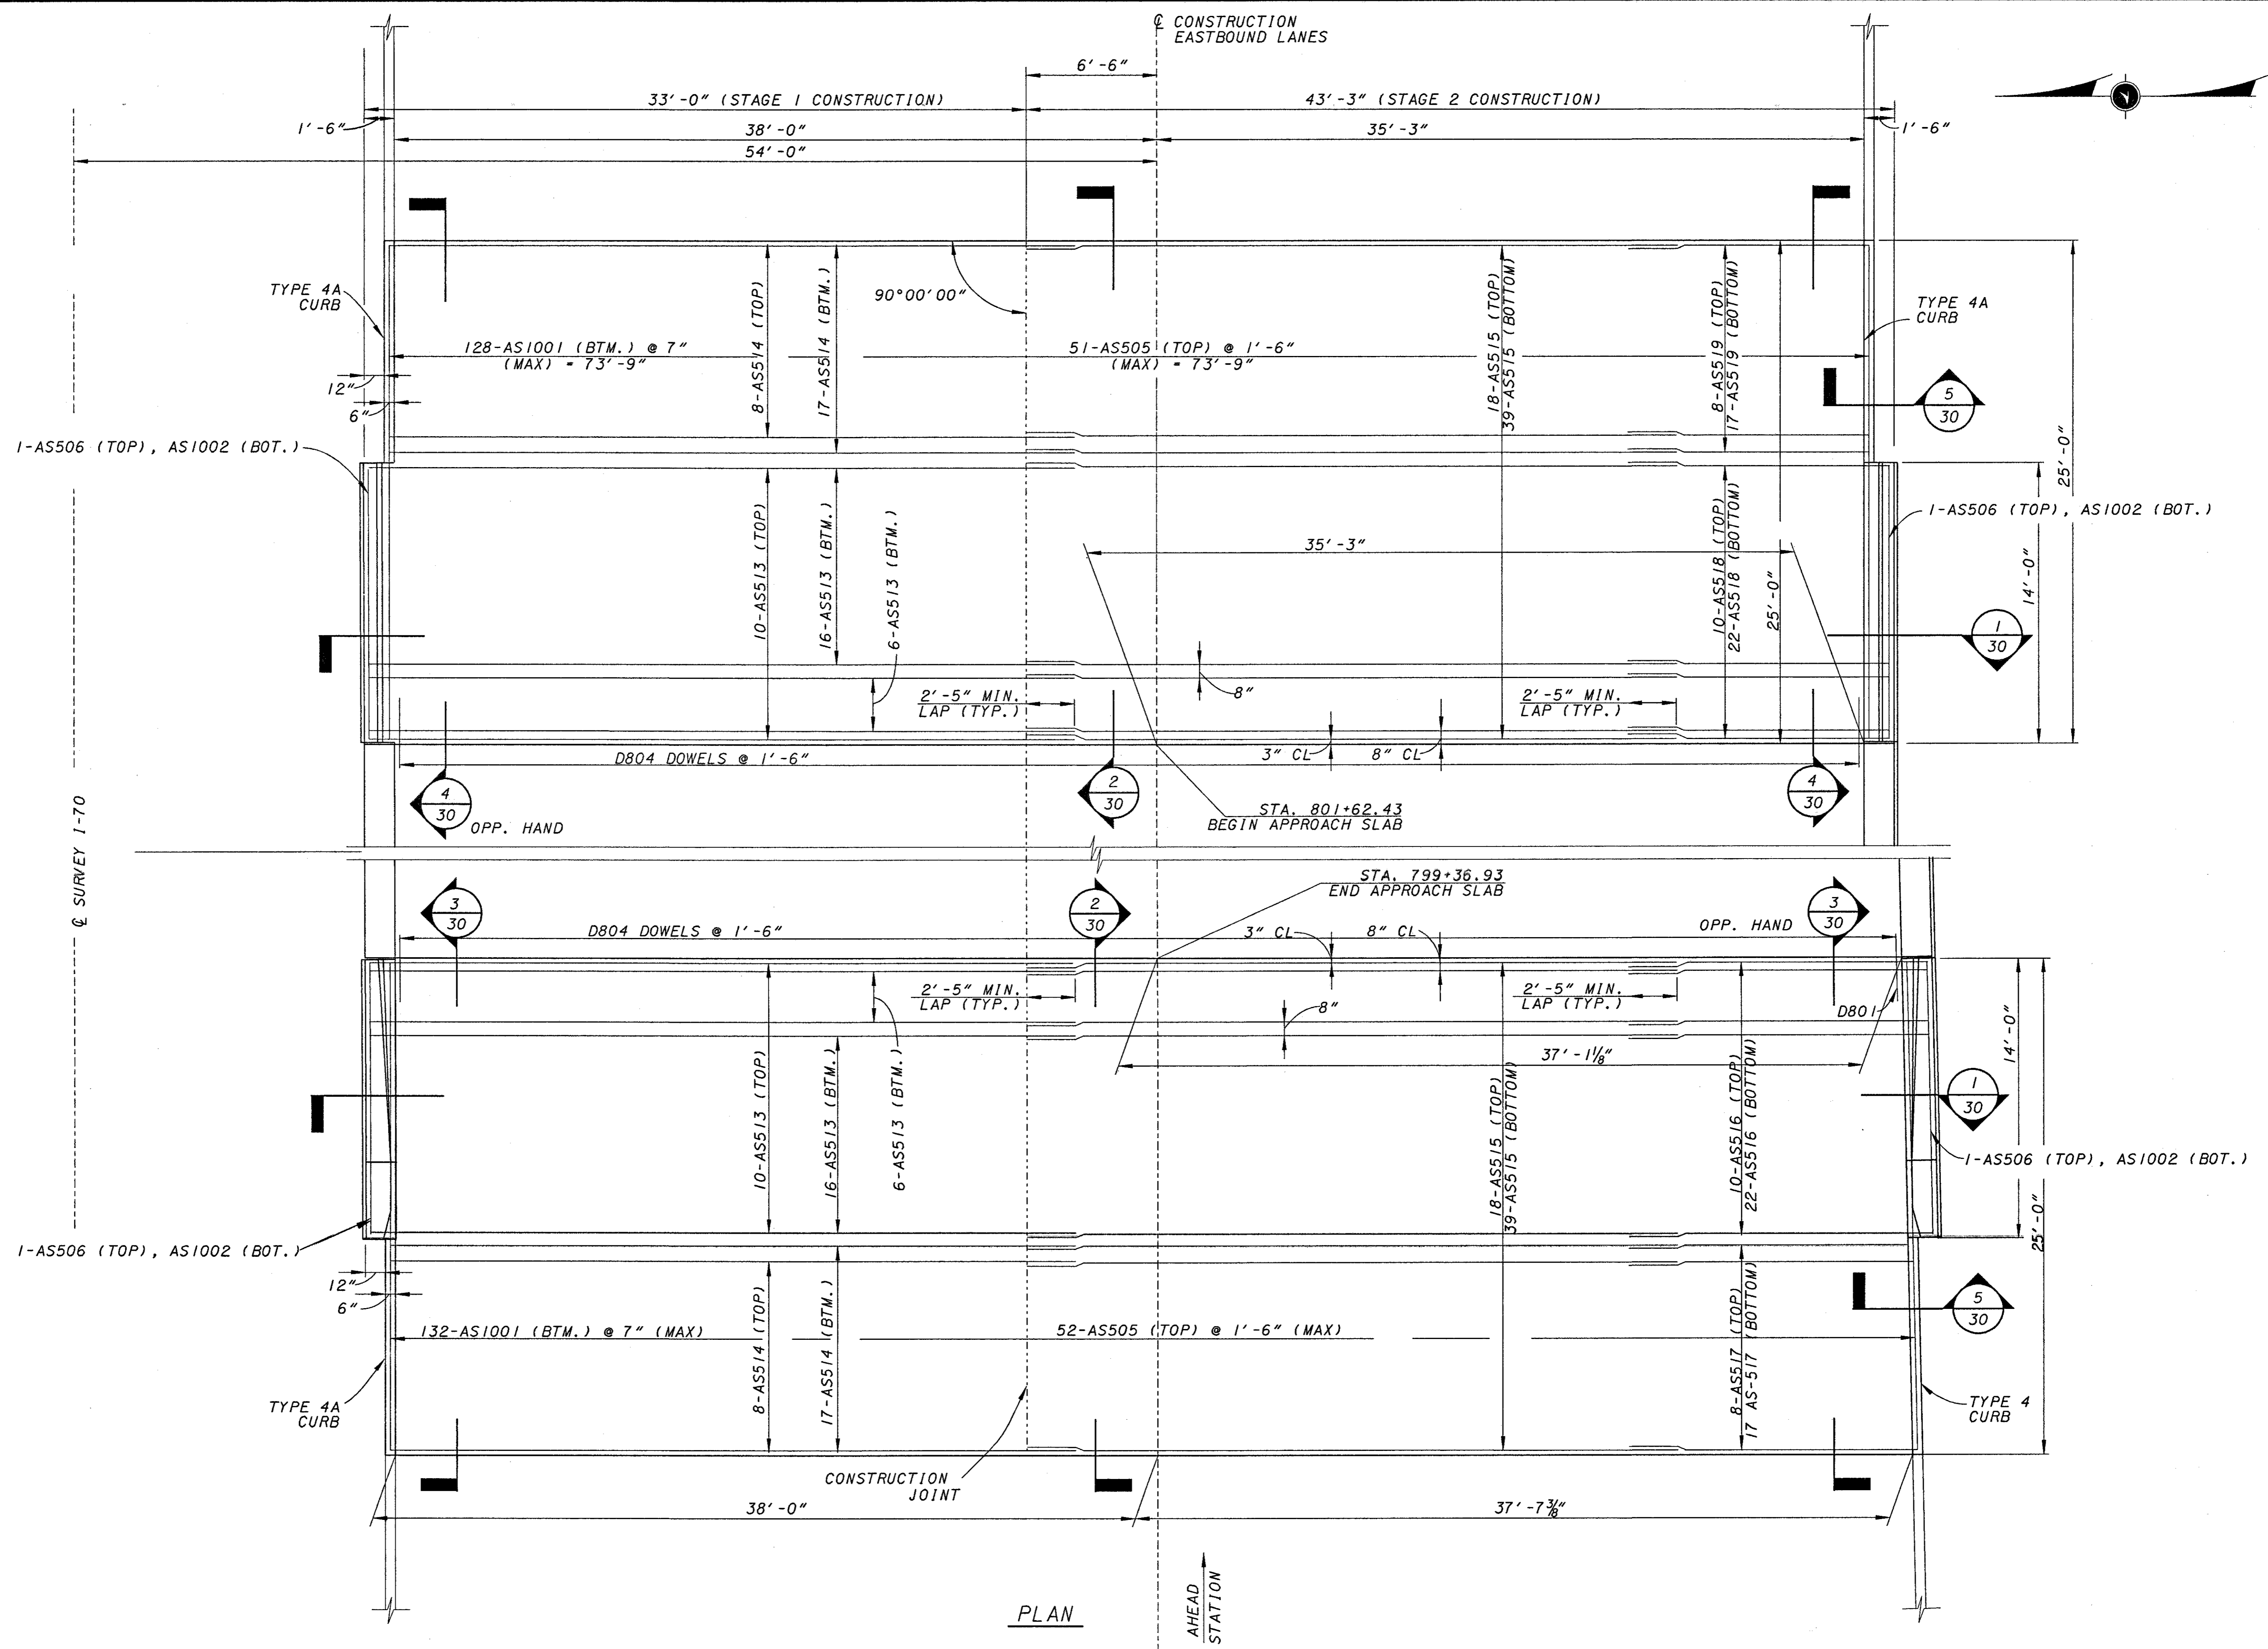

PLAN

AHEAD
STATION

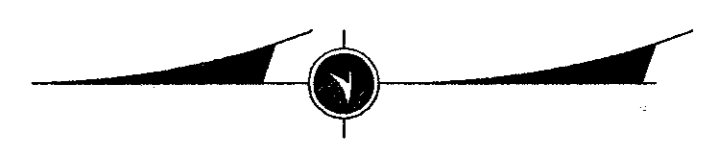

DESIGN AGENCY
KZF DESIGN
ARCHITECTURE | ENGINEERING | INTERIOR PLANNING
127 PLEASANT HILL ROAD, SUITE 100, CHESAPEAKE, VA 23041
TEL: 757/533-1111 FAX: 757/533-1112 WWW.KZFDESIGN.COM

REVIEWED DATE
DCK 11/20/00
STRUCTURE FILE NUMBER
6801471/6801501

DRAWN SJA
SJA
CHECKED WBS
REVISED

DESIGNED
KZF
#17

APPROACH SLABS - RIGHT BRIDGE
BRIDGE NO. PRE-70-1500 L/R
I.R. 70 OVER TWIN CREEK


PRE-70-0.00

29/32


256
283

ABUTMENT REINFORCING STEEL LIST


MARK	LENGTH	SHAPE	LEFT BRIDGE		RIGHT BRIDGE	
			NUMBER	WEIGHT	NUMBER	WEIGHT
A501	17'-1"	BENT	76	1,354	77	1,372
A502	19'-9"	BENT	32	659	0	0
A503	34'-2"	STR.	12	428	12	428
A504	20'-6"	STR.	2	43	2	43
A505	33'-6"	STR.	2	70	2	70
A506	21'-11"	STR.	4	91	4	91
A507	34'-11"	STR.	4	146	4	146
A508	12'-6"	STR.	4	52	4	52
VAR 11'-1"			4		0	
A509	TO 5'-6"	STR.	SER OF	104	0	0
BY 2'-10"			3			
A510	13'-4"	BENT	4	56	4	56
VAR 16'-10"			2		0	
A511	TO 15'-4"	BENT	SER OF	101	0	0
BY 9"			3			
VAR 22'-0"			2		0	
A512	TO 18'-0"	BENT	SER OF	209	0	0
BY 12"			5			
VAR 23'-0"			0		1	
A513	TO 19'-0"	BENT	0		SER OF	110
BY 12"			0		5	
A514	23'-2"	BENT	6	145	0	0
A515	5'-1"	STR.	4	21	0	0
A516	15'-11"	STR.	12	199	0	0
A517	15'-3"	STR.	4	64	0	0
A518	16'-8"	STR.	12	209	0	0
A519	14'-2"	STR.	4	59	4	59
VAR 11'-11"			4		0	
A520	TO 5'-11"	STR.	SER OF	112	0	0
BY 3'-0"			3			
A521	14'-11"	BENT	4	62	4	62
A522	23'-6"	BENT	4	98	2	49
A523	17'-7"	STR.	0	0	6	110
VAR 23'-4"			2		0	
A524	TO 18'-4"	BENT	SER OF	261	0	0
BY 12"			6			
VAR 17'-4"			2		0	
A525	TO 15'-6"	BENT	SER OF	103	0	0
BY 11"			3			
A526	5'-6"	STR.	4	23	0	0
A527	15'-11"	STR.	0	0	6	100
A528	14'-10"	STR.	6	93	6	93
A529	19'-5"	BENT	0	0	32	648
VAR 16'-6"			0		2	
A530	TO 15'-0"	BENT	0		SER OF	99
BY 9"			0		3	
VAR 21'-8"			0		2	
A531	TO 17'-8"	BENT	0		SER OF	205
BY 12"			0		5	
VAR 18'-0"			0		1	
A532	TO 15'-6"	BENT	0		SER OF	70
BY 10"			0		4	
VAR 11'-1"			0		4	
A533	TO 5'-3"	STR.	0		SER OF	102
BY 2'-11"			0		3	
A534	4'-11"	STR.	0	0	4	21
A535	15'-2"	STR.	0	0	6	95
A536	13'-9"	STR.	0	0	2	29
A537	16'-2"	STR.	0	0	2	34
VAR 12'-2"			0		2	
A538	TO 5'-8"	STR.	0		SER OF	56
BY 3'-3"			0		3	
VAR 17'-0"			0		1	
A539	TO 15'-8"	BENT	0		SER OF	51
BY 8"			0		3	
A540	6'-7"	STR.	0	0	2	14
A541	23'-4"	BENT	0	0	2	49
VAR 22'-10"			0		1	
A542	TO 18'-0"	BENT	0		SER OF	128
BY 12"			0		6	
A543	16'-10"	STR.	0	0	6	105
VAR 12'-3"			0		2	
A544	TO 5'-6"	STR.	0		SER OF	56
BY 3'-5"			0		3	
A545	4'-8"	STR.	0	0	2	10
A546	22'-10"	BENT	0	0	6	143
A801	35'-7"	STR.	8	760	8	760
A802	23'-4"	STR.	4	249	4	249
A803	36'-4"	STR.	4	388	4	388
A804	17'-4"	STR.	8	370	0	0
A805	16'-6"	STR.	0	0	4	176
A806	18'-3"	STR.	0	0	4	195
TOTAL POUNDS				6,527		6,520

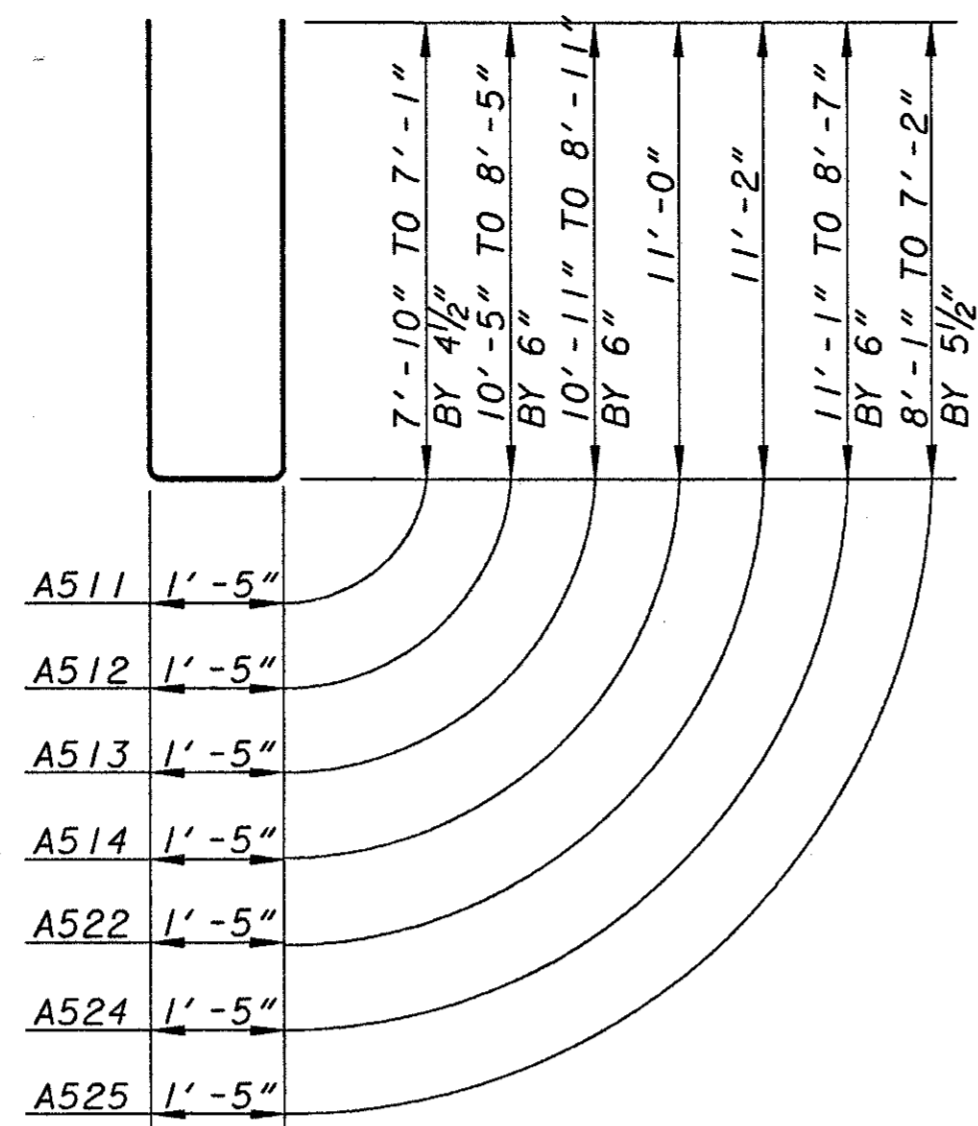

A511, A512, A513, A514, A522, A524, A525

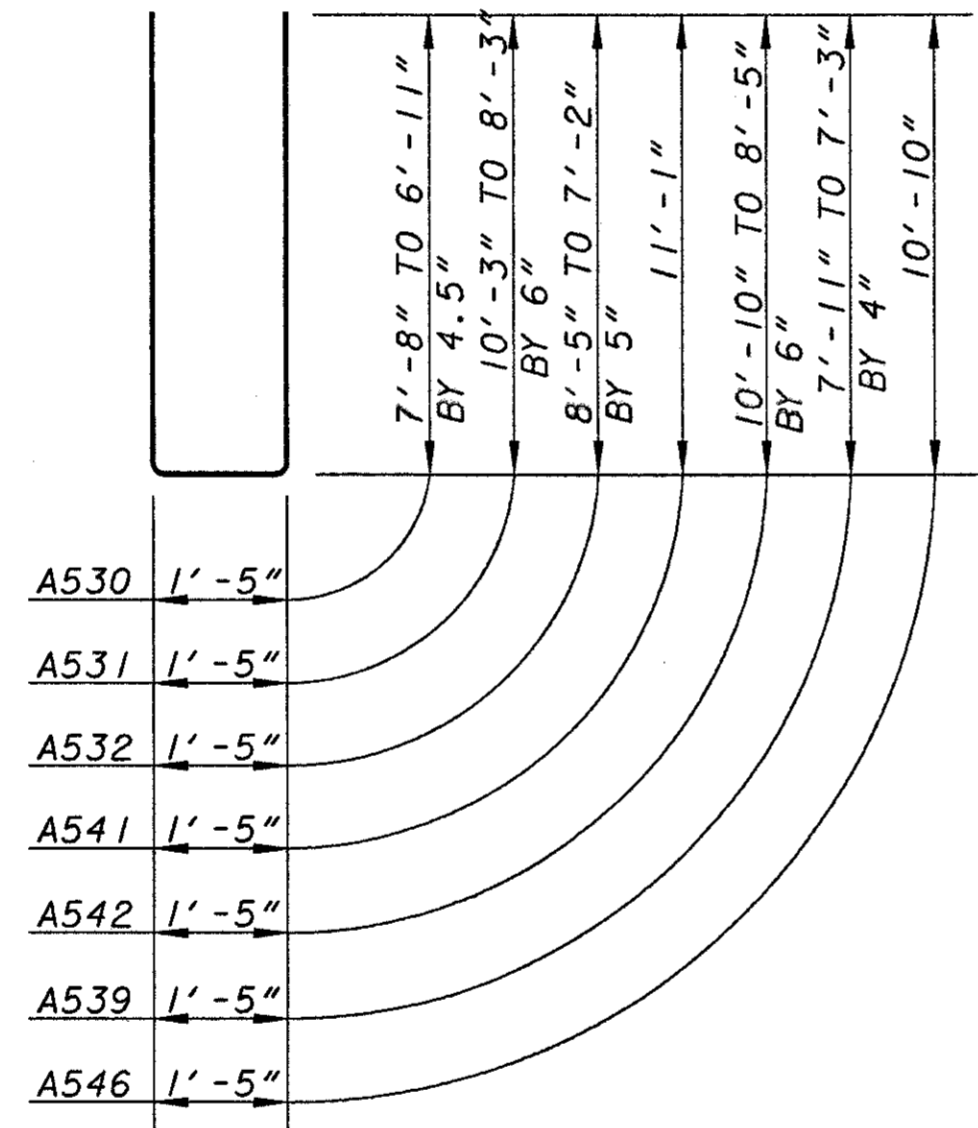


A530, A531, A532, A541, A542, A539, A543, A546

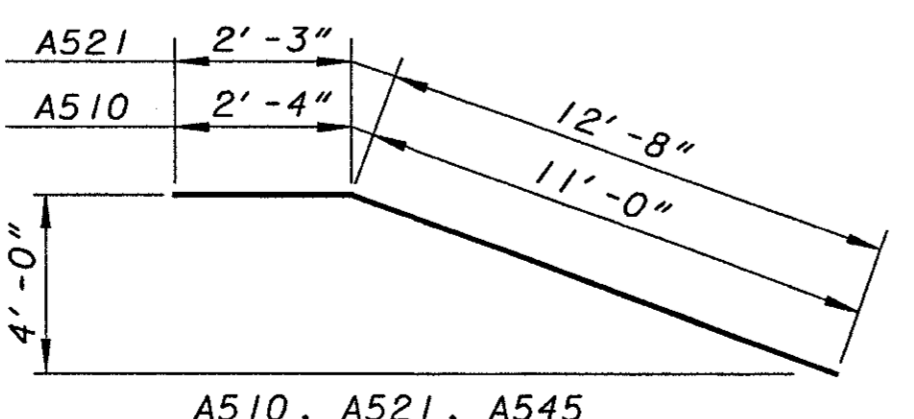


A510, A521, A545

PIER REINFORCING STEEL LIST


MARK	LENGTH	SHAPE	LEFT BRIDGE		RIGHT BRIDGE	
			NUMBER	WEIGHT	NUMBER	WEIGHT
VAR. 7'-11"			8		8	
P501	TO 9'-5"	BENT	SERIES OF 9	651	SERIES OF 9	651
BY 2 1/2"						
P502	17'-10"	STR.			4	74
P503	19'-8"	STR.			4	82
P504	11'-6"	STR.	26	312	26	312
P505	13'-10"	BENT	100	1,443	100	1,443
P506	18'-8"	STR.	4	78		
P507	17'-0"	STR.	4	71		
P508	4'-5"	BENT	10	46	10	46
P601	20'-3"	BENT			4	122
P602	8'-6"	STR.	26	332	26	332
P603	19'-5"	BENT	4	117		
P701	10'-2"	BENT	28	582	28	582
P801	28'-9"	STR.			44	3,378
P802	8'-4"	BENT	44	979	44	979
P803	28'-11"	STR.	44	3,397		
P901	24'-5"	BENT			14	1,162
P902	23'-5"	BENT	14	1,115		
TOTAL POUNDS				9,122		9,162

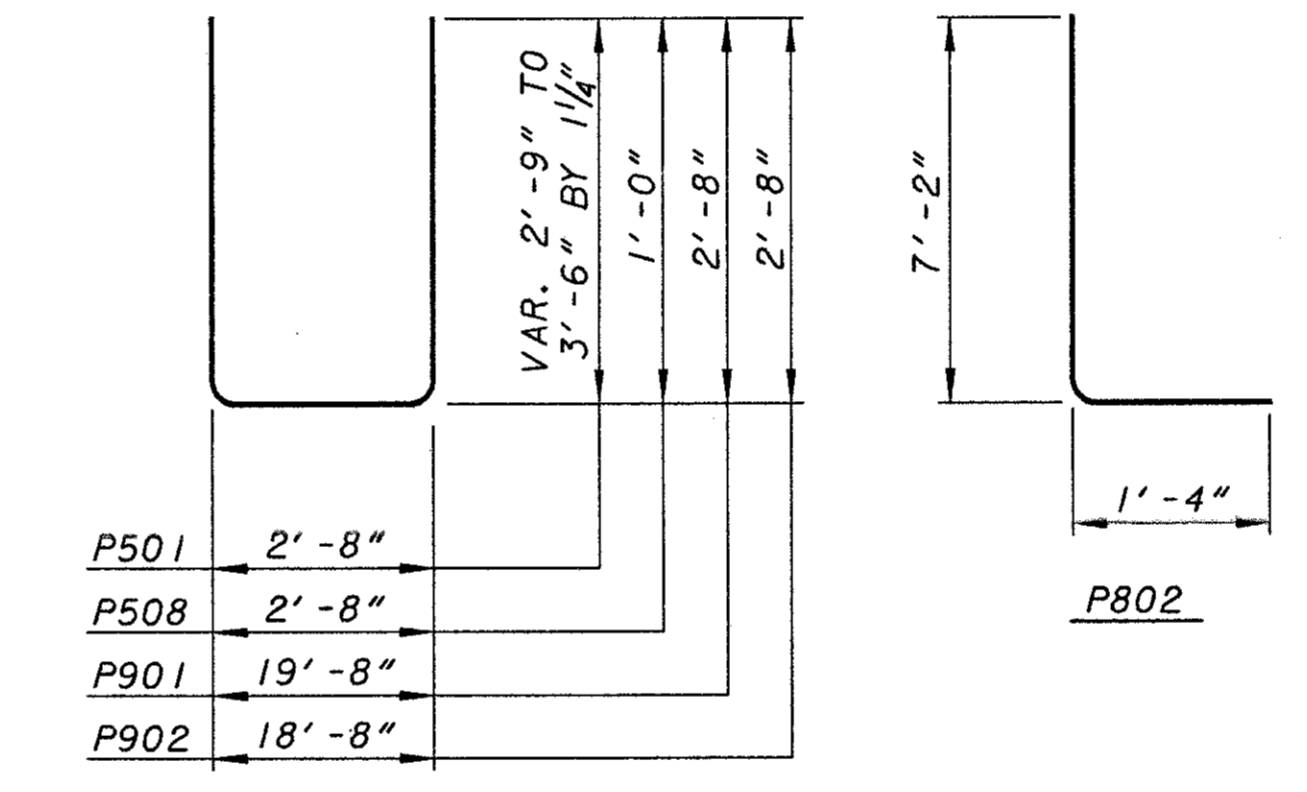


P501, P508, P901, P902

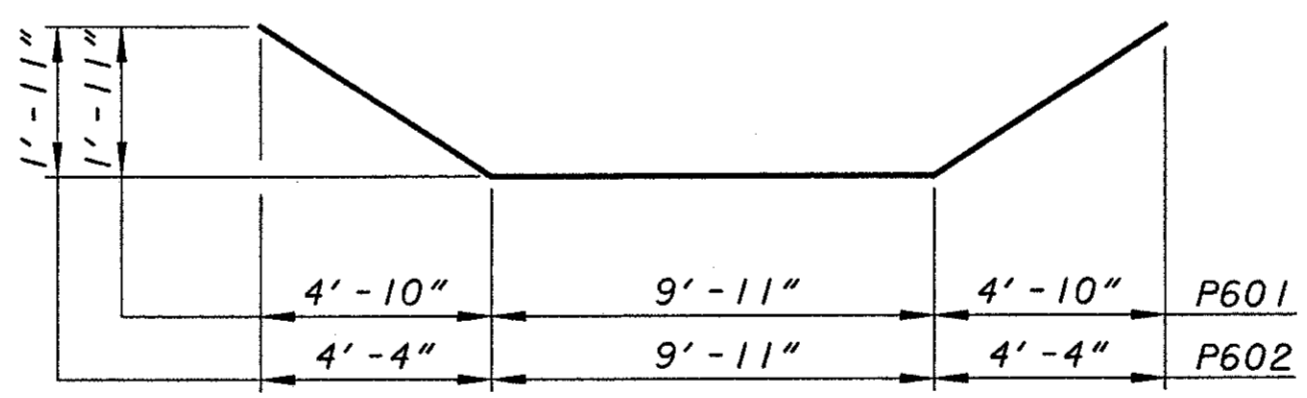

P601, P602

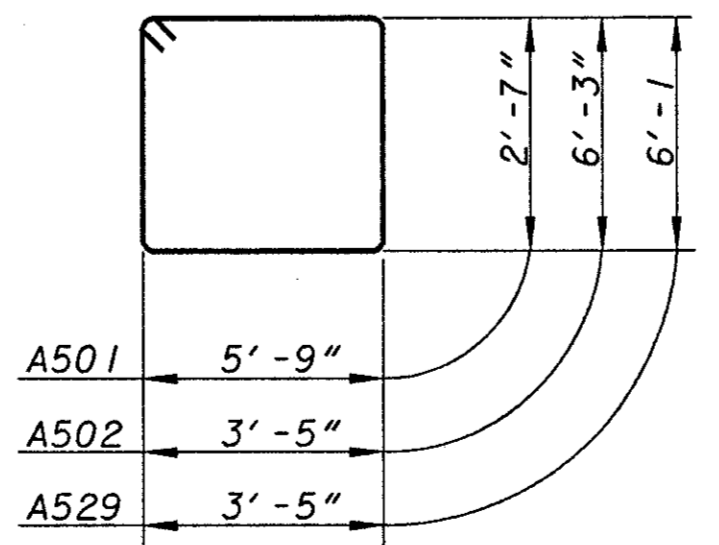


A501, A502, A529

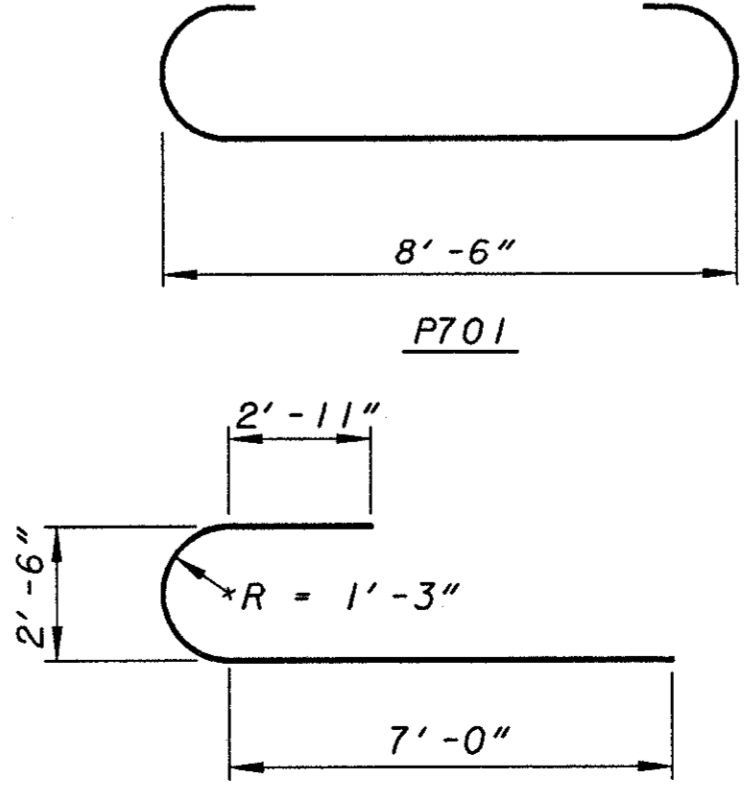

P505

EXISTING PIER SUPPORT REINFORCING STEEL LIST



MARK	LENGTH	SHAPE	LEFT BRIDGE		RIGHT BRIDGE	
			NUMBER	WEIGHT	NUMBER	WEIGHT
W501	10'-3"	BENT			4	43
VAR. 7'-9"					4	
W502	TO 12'-1"	BENT			SERIES OF 5	207
BY 1'-1"						
W503	19'-1"	STR.			8	159
W504	20'-10"	STR.			8	174
W505	20'-6"	STR.			8	171
VAR. 4'-0"					8	
W506	TO 16'-4"	STR.			SERIES OF 5	424
BY 3'-1"						
W507	25'-2"	STR.			8	210
W508	4'-7"	BENT	8	38	8	38
W509	14'-5"	STR.			8	120
VAR. 2'-7"					8	
W510	TO 12'-1"	STR.			SERIES OF 14	857
BY 8 1/4"						
W511	9'-7"	STR.			8	80
W512	6'-2"	STR.			8	51
W513	2'-0"	STR.			8	17
W514	2'-8"	STR.	64	178	56	156
W515	9'-3"	BENT	4	39		
VAR. 7'-7"			4			
W516	TO 10'-7"	BENT	SERIES OF 5	152		
BY 1'-0"						
W517	21'-5"	STR.	8	179		
W518	21'-11"	STR.	8	183		
W519	21'-8"	STR.	8	181		
VAR. 5'-4"			8			
W520	TO 17'-8"	STR.	SERIES OF 4	384		
BY 4'-1 3/4"						
W521	24'-5"	STR.	8	204		
W522	10'-8"	STR.	8	89		
VAR. 3'-3"			8			
W523	TO 10'-11"	STR.	SERIES OF 15	887		
BY 6 3/4"						
W524	7'-6"	STR.	8	63		
W525	3'-1"	STR.	8	26		
W526	7'-0"	BENT	68	496	68	496
W601	8'-0"	STR.	24	288		
W602	9'-0"	STR.			24	324
W801	6'-6"	STR.	24	417	24	417
TOTAL POUNDS				3,803		3,945

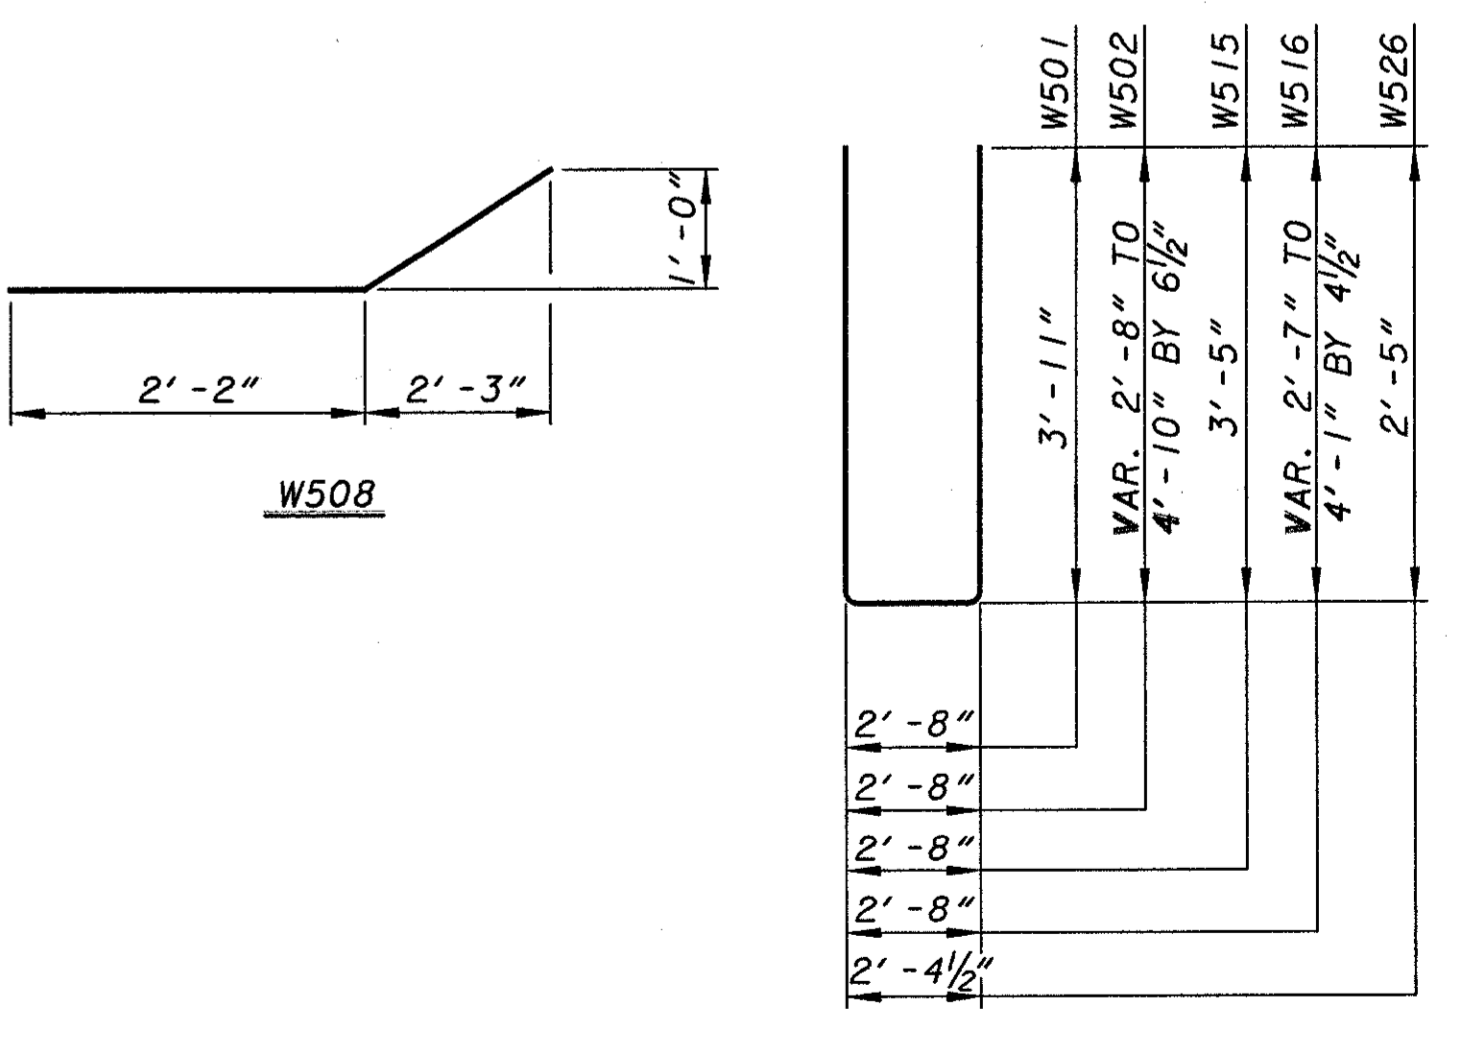

W501, W502, W515, W516, W526

PROPOSED WORK

1. SEAL PIERS, PIER CAPS, WINGWALLS, ABUTMENTS, RAILING, AND DECK EDGES WITH EPOXY-URETHANE; COLOR SHALL BE FEDERAL COLOR STANDARD 17778.
2. PATCH SUBSTRUCTURE CONCRETE.
3. INSPECT ALL BEARINGS AND REPOSITION OR REFRUBISH IF NECESSARY. AT THE OPTION OF THE CONTRACTOR, BEARINGS SHALL BE EITHER REFRUBISHED OR REPLACED.
4. REMOVE THE EXISTING CONCRETE OVERLAY AND REPLACE WITH A NEW MICRO-SILICA CONCRETE OVERLAY.
5. EXTEND SCUPPERS SO THAT THE OUTLET IS 8" BELOW THE BOTTOM FLANGE.
6. UPGRADE APPROACH GUARDRAIL AND BRIDGE TERMINAL ASSEMBLIES TO CURRENT STANDARDS.
7. MAINTAIN EXISTING MINIMUM VERTICAL CLEARANCE.
8. REMOVE AND REPLACE STRIP SEALS AT EXPANSION JOINTS.

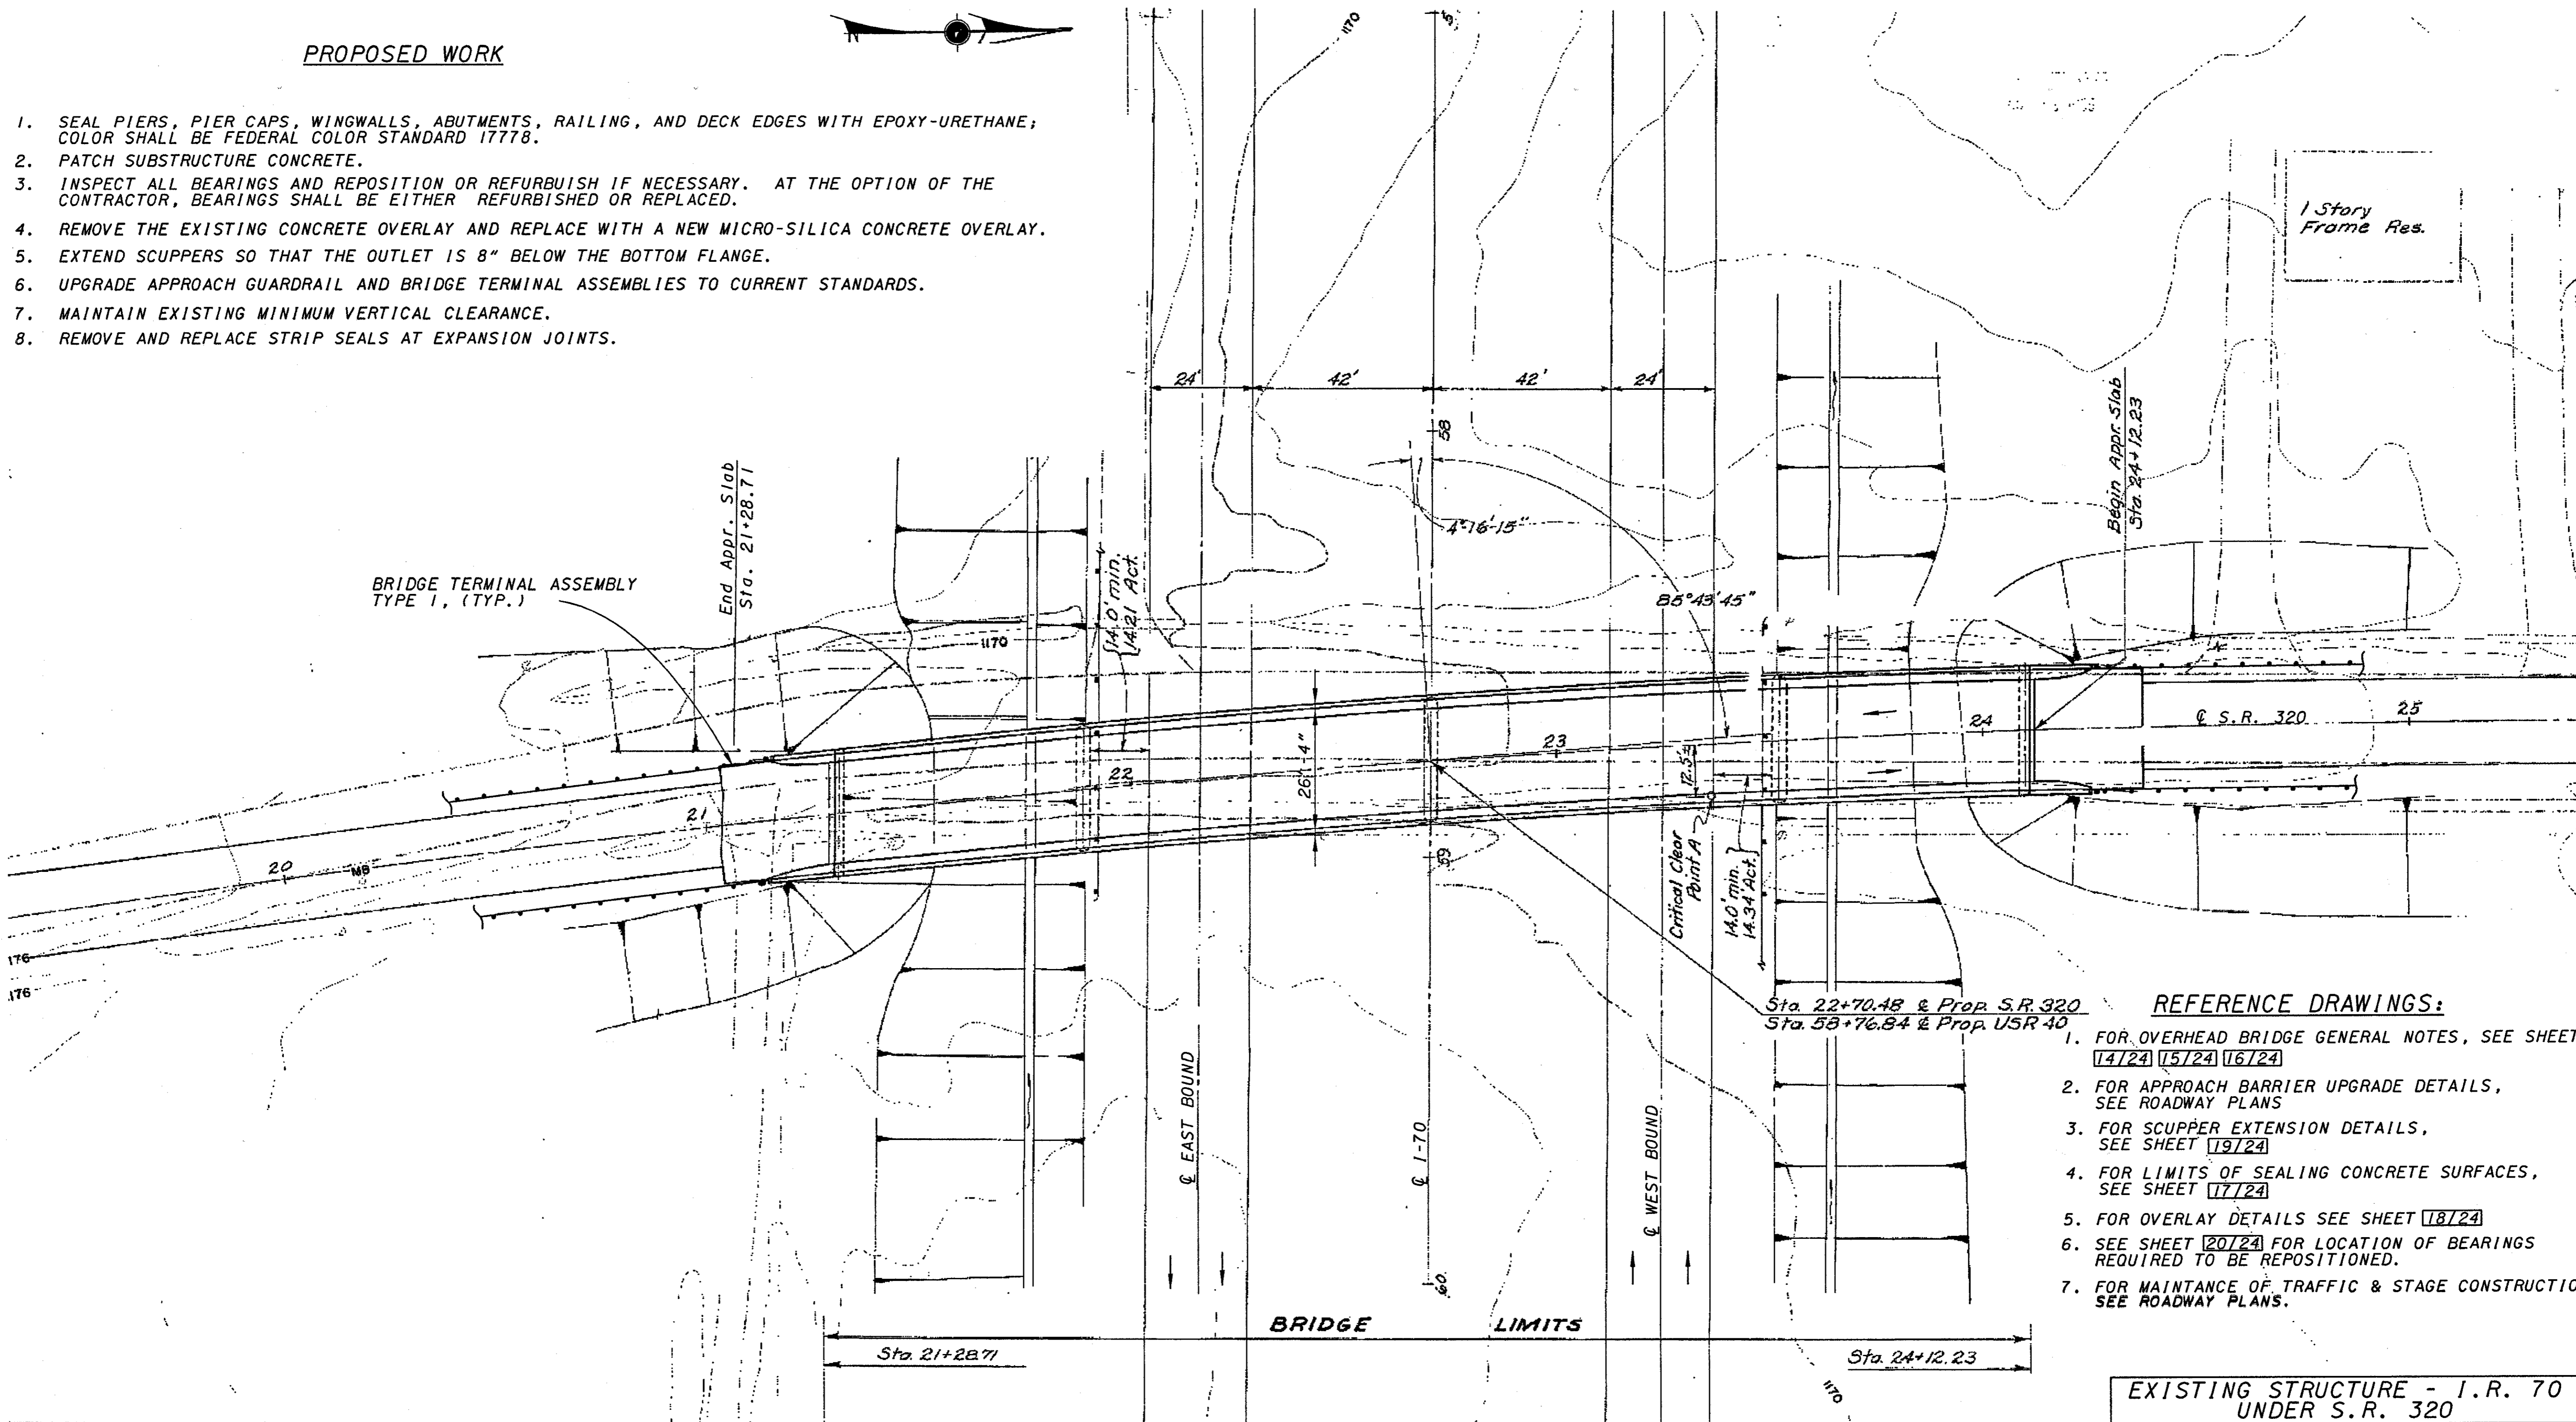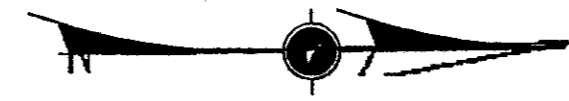


REFERENCE DRAWINGS:

1. FOR OVERHEAD BRIDGE GENERAL NOTES, SEE SHEETS [14/24] [15/24] [16/24]
2. FOR APPROACH BARRIER UPGRADE DETAILS, SEE ROADWAY PLANS
3. FOR SCUPPER EXTENSION DETAILS, SEE SHEET [19/24]
4. FOR LIMITS OF SEALING CONCRETE SURFACES, SEE SHEET [17/24]
5. FOR OVERLAY DETAILS SEE SHEET [18/24]
6. SEE SHEET [20/24] FOR LOCATION OF BEARINGS REQUIRED TO BE REPOSITIONED.
7. FOR MAINTANCE OF TRAFFIC & STAGE CONSTRUCTION, SEE ROADWAY PLANS.

EXISTING STRUCTURE - I.R. 70 UNDER S.R. 320

TYPE: CONTINUOUS STEEL BEAM WITH REINFORCED CONCRETE DECK AND SUBSTRUCTURE.
 LENGTH OF SPANS: 57'-6"±, 82'-0"±, 82'-0"±, 57'-6"± MEASURED CENTER TO CENTER OF BEARINGS.
 ROADWAY WIDTH: 26'-4" MEASURED TOE TO TOE OF BARRIER.
 DESIGN LOADING: CF-130 (57)
 SKEW ANGLE: 4° 16' 15"± LEFT FORWARD
 ALIGNMENT: 1° 28' CURVE RIGHT
 SUPERELEVATION: 0.024 FOOT / FOOT
 WEARING SURFACE: 1¾" DENSE CONCRETE OVERLAY
 APPROACH SLABS : AS-1-54 (25' LONG)
 YEAR BUILT: 1960±
 YEAR REHABBED: 1990±
 STRUCTURE FILE NO.: 6803180

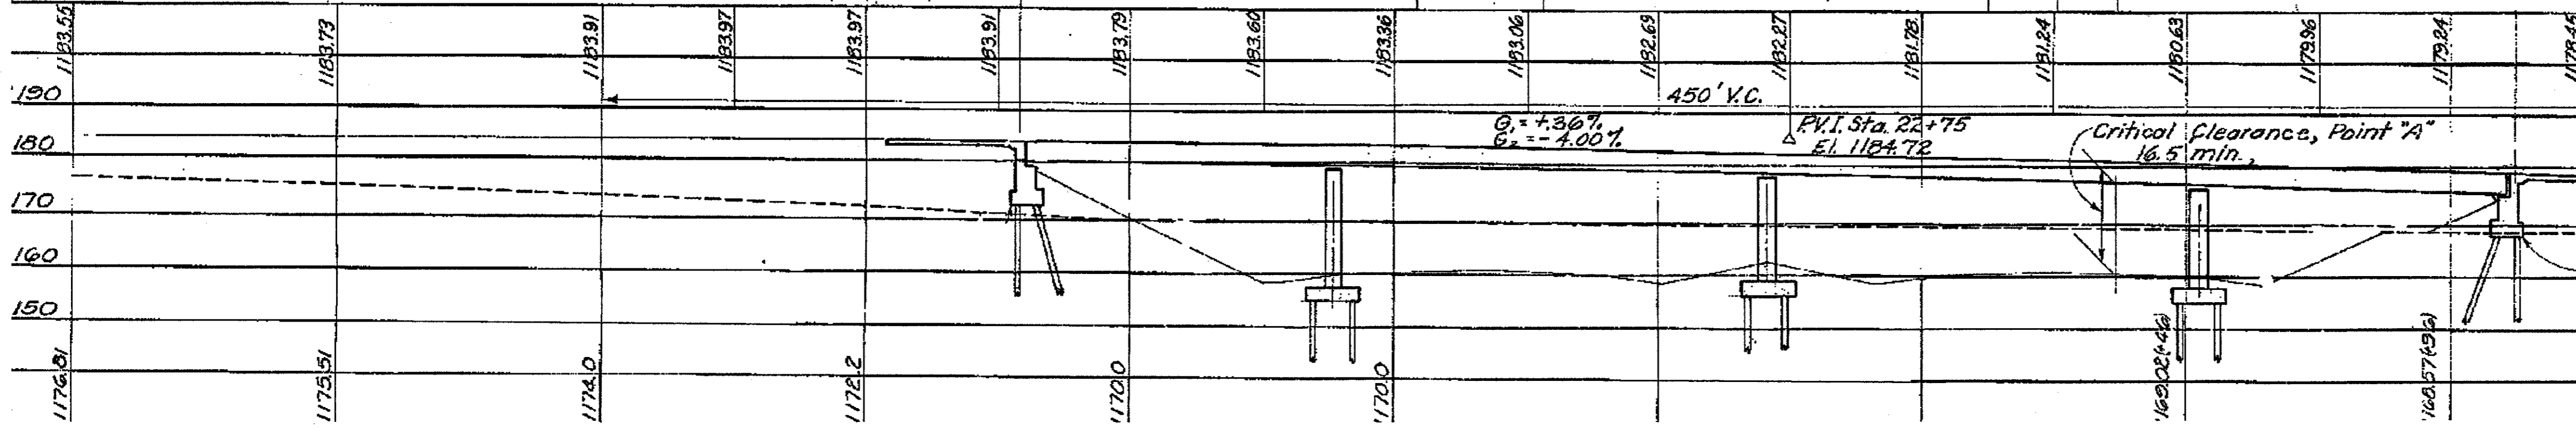

REF: **REF1**
REF: **REF2**
REF: **REF3**
REF: **REF4**
REF: **REF5**
REF: **REF6**
REF: **REF7**

REF: **REF1**
REF: **REF2**
REF: **REF3**
REF: **REF4**
REF: **REF5**
REF: **REF6**
REF: **REF7**

REF: **REF1**
REF: **REF2**
REF: **REF3**
REF: **REF4**
REF: **REF5**
REF: **REF6**
REF: **REF7**

REF: **REF1**
REF: **REF2**
REF: **REF3**
REF: **REF4**
REF: **REF5**
REF: **REF6**
REF: **REF7**

USER: VALUE NAME
DATE: ALL DIMENSIONS IN FEET AND INCHES
ACTIVE LEVELS ONLY


REF: **REF**
 REF: **REF**
BASELINE ELEVATIONS
 DES. FILE: ION SPECIFICATIONS
 ACTIVE LEVELS: ON SCALE

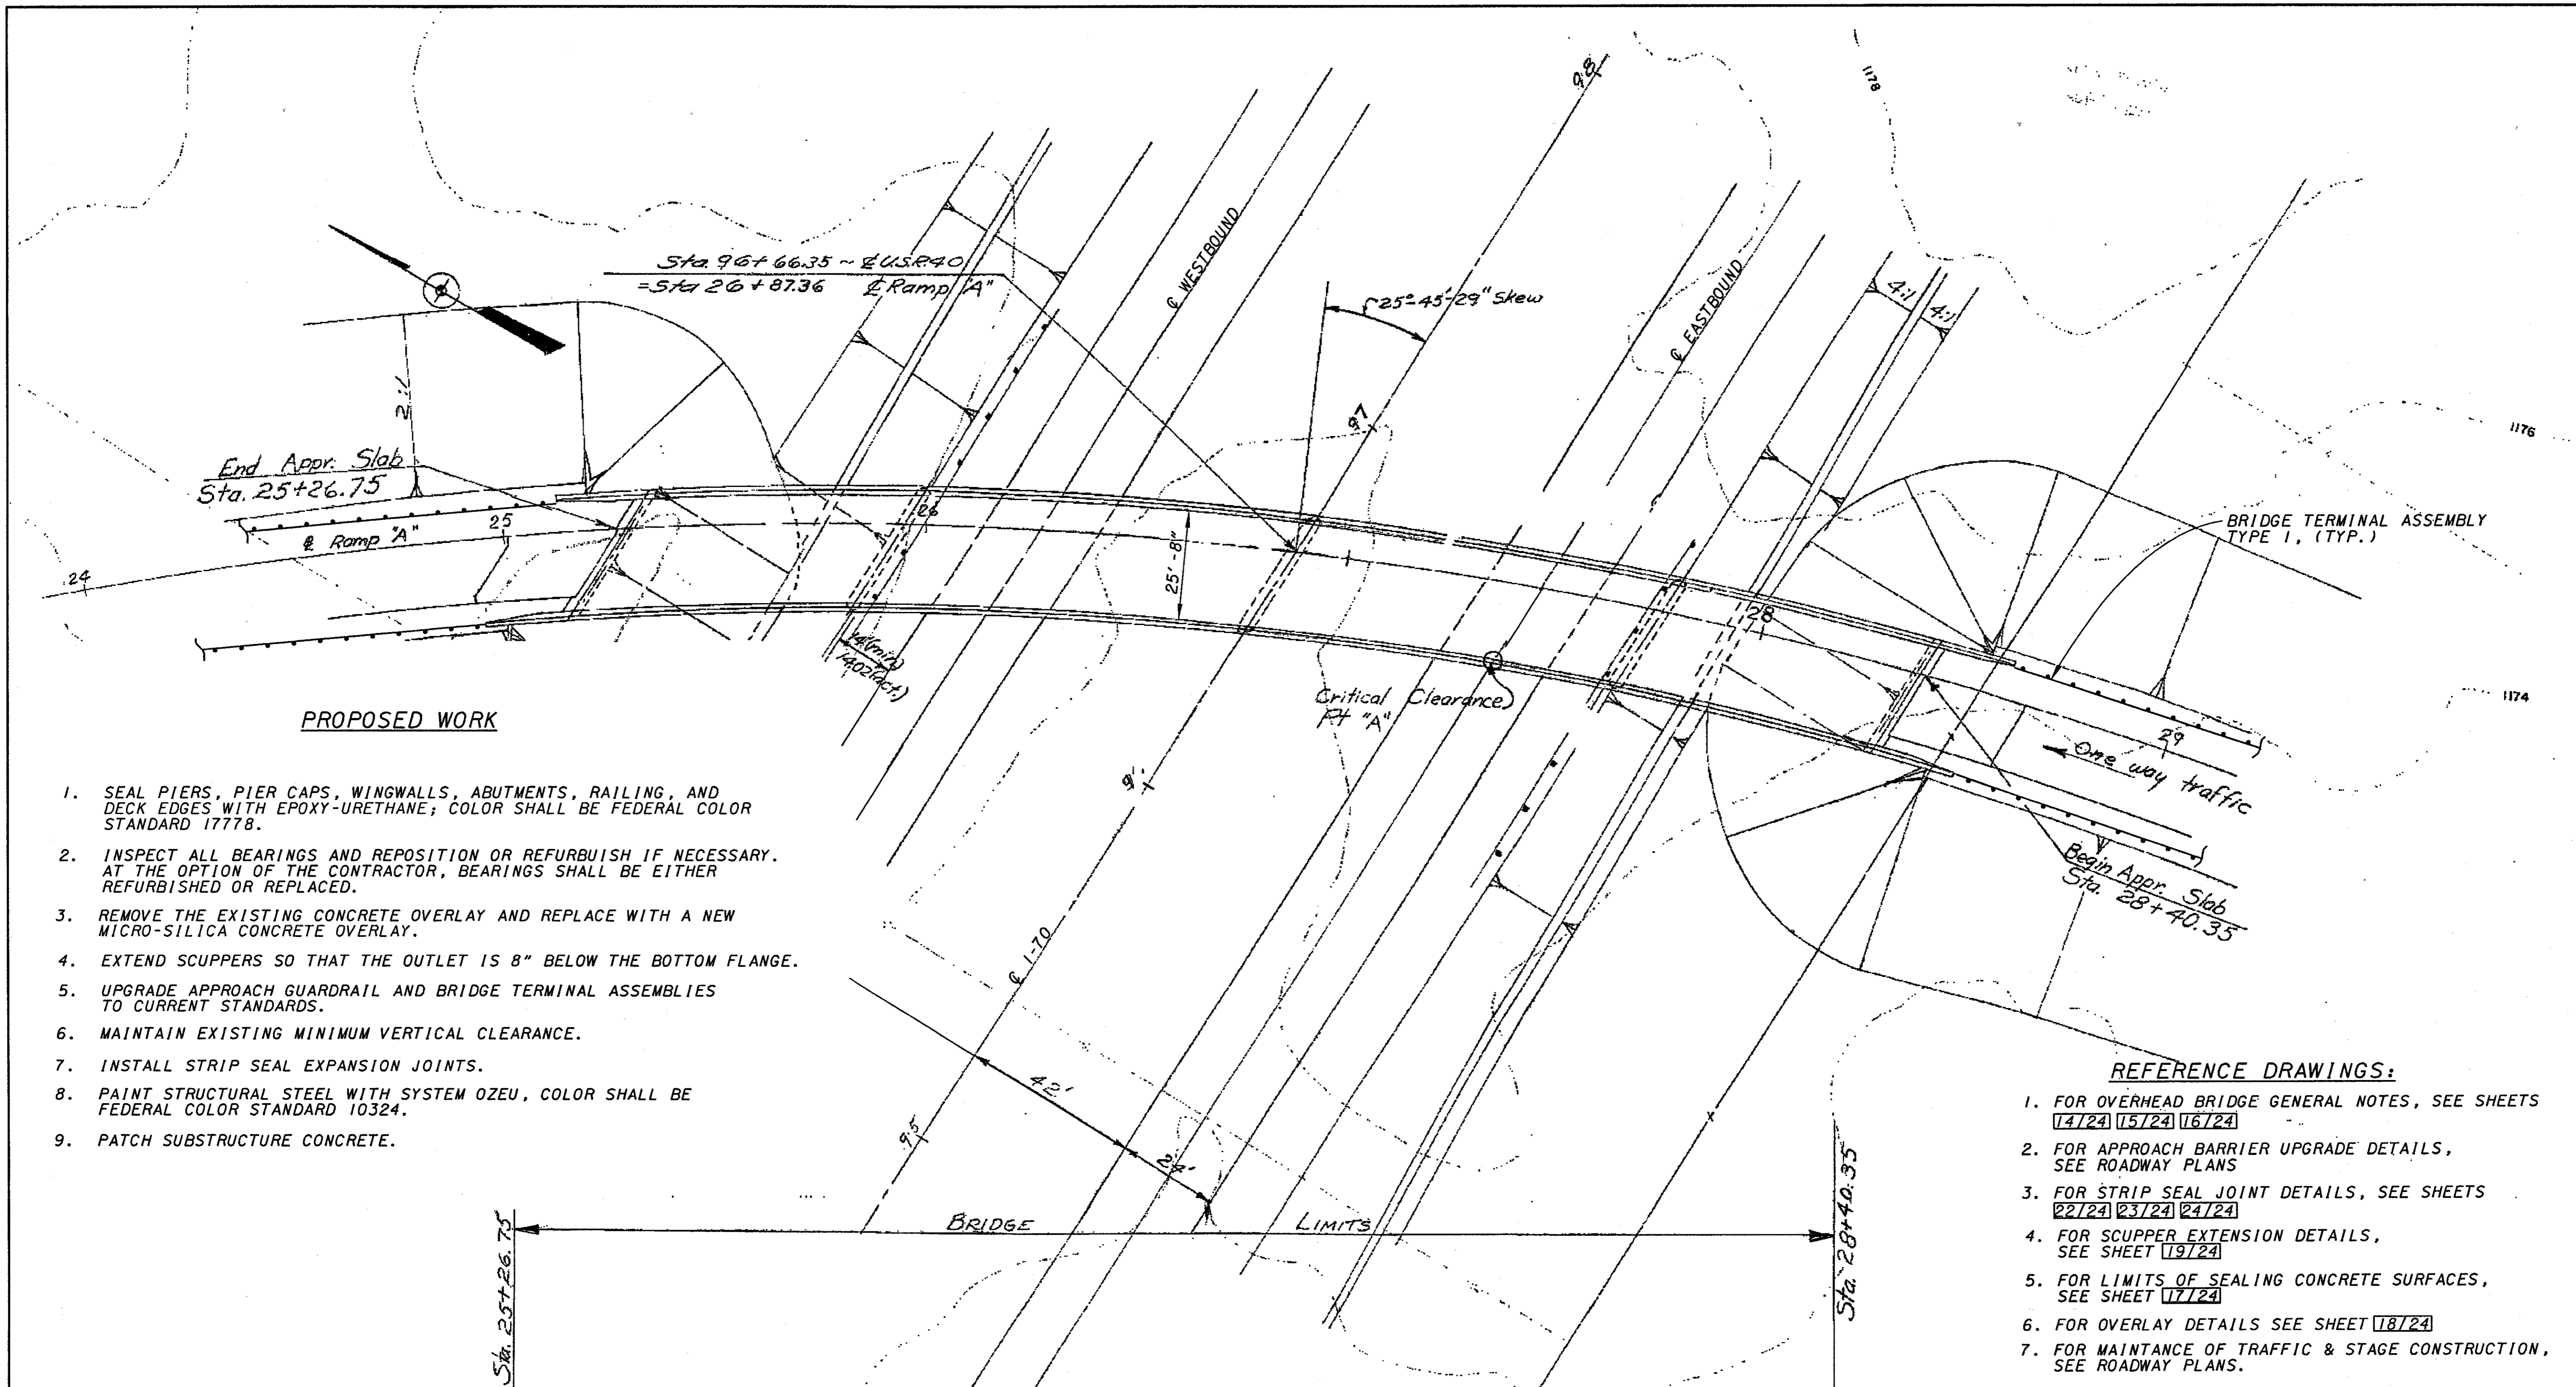


PROPOSED WORK

1. SEAL PIERS, PIER CAPS, WINGWALLS, ABUTMENTS, RAILING, AND DECK EDGES WITH EPOXY-URETHANE; COLOR SHALL BE FEDERAL COLOR STANDARD 17778.
2. INSPECT ALL BEARINGS AND REPOSITION OR REFURBUISH IF NECESSARY. AT THE OPTION OF THE CONTRACTOR, BEARINGS SHALL BE EITHER REFURBUISHED OR REPLACED.
3. REMOVE THE EXISTING CONCRETE OVERLAY AND REPLACE WITH A NEW MICRO-SILICA CONCRETE OVERLAY.
4. EXTEND SCUPPERS SO THAT THE OUTLET IS 8" BELOW THE BOTTOM FLANGE.
5. UPGRADE APPROACH GUARDRAIL AND BRIDGE TERMINAL ASSEMBLIES TO CURRENT STANDARDS.
6. MAINTAIN EXISTING MINIMUM VERTICAL CLEARANCE.
7. INSTALL STRIP SEAL EXPANSION JOINTS.
8. PAINT STRUCTURAL STEEL WITH SYSTEM OZEU, COLOR SHALL BE FEDERAL COLOR STANDARD 10324.
9. PATCH SUBSTRUCTURE CONCRETE.

REFERENCE DRAWINGS:

1. FOR OVERHEAD BRIDGE GENERAL NOTES, SEE SHEETS [14/24] [15/24] [16/24]
2. FOR APPROACH BARRIER UPGRADE DETAILS, SEE ROADWAY PLANS
3. FOR STRIP SEAL JOINT DETAILS, SEE SHEETS [22/24] [23/24] [24/24]
4. FOR SCUPPER EXTENSION DETAILS, SEE SHEET [19/24]
5. FOR LIMITS OF SEALING CONCRETE SURFACES, SEE SHEET [17/24]
6. FOR OVERLAY DETAILS SEE SHEET [18/24]
7. FOR MAINTANCE OF TRAFFIC & STAGE CONSTRUCTION, SEE ROADWAY PLANS.

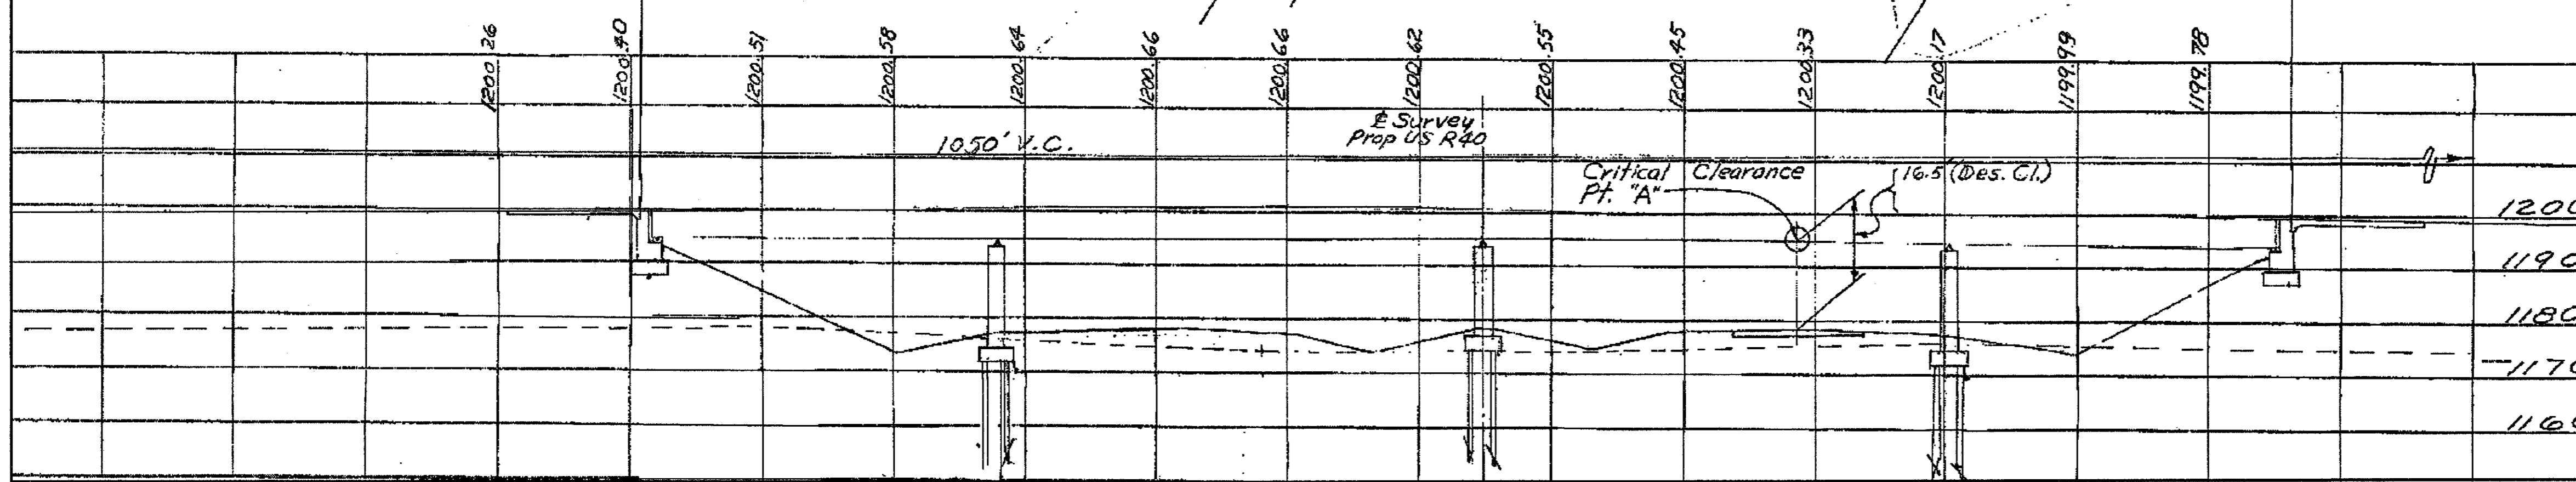

EXISTING STRUCTURE - I.R. 70 UNDER U.S. 35 WB	
TYPE: CONTINUOUS STEEL BEAM WITH REINFORCED CONCRETE DECK AND SUBSTRUCTURE.	
LENGTH OF SPANS: 65'-0"±, 92'-10"±, 88'-7"±, 62'-0"± MEASURED CENTER TO CENTER OF BEARINGS.	
ROADWAY WIDTH: 25'-8" MEASURED TOE TO TOE OF BARRIER.	
DESIGN LOADING: CF-2000 (57)	
SKEW ANGLE: 25°45'29"± LEFT FORWARD	
ALIGNMENT: 6°00' CURVE RIGHT	
SUPERELEVATION: 0.083 FOOT / FOOT	
WEARING SURFACE: 1 3/4 LATEX MOD. CONC. OVERLAY	
APPROACH SLABS: AS-1-54 (25' LONG)	
YEAR BUILT: 1960±	
YEAR REHABBED: 1990±	
STRUCTURE FILE NO.: 6800033	

PROPOSED WORK

1. SEAL PIERS, PIER CAPS, WINGWALLS, ABUTMENTS, RAILING, AND DECK EDGES WITH EPOXY-URETHANE; COLOR SHALL BE FEDERAL COLOR STANDARD 17778.
2. INSPECT ALL BEARINGS AND REPOSITION OR REFRUBISH IF NECESSARY. AT THE OPTION OF THE CONTRACTOR, BEARINGS SHALL BE EITHER REFRUBISHED OR REPLACED.
3. UPGRADE APPROACH GUARDRAIL AND BRIDGE TERMINAL ASSEMBLIES TO CURRENT STANDARDS.
4. MAINTAIN EXISTING MINIMUM VERTICAL CLEARANCE.
5. REMOVE AND REPLACE STRIPS SEALS AT EXPANSION JOINTS.
6. PATCH SUBSTRUCTURE CONCRETE.


REF: **REF**
 REF: **REF**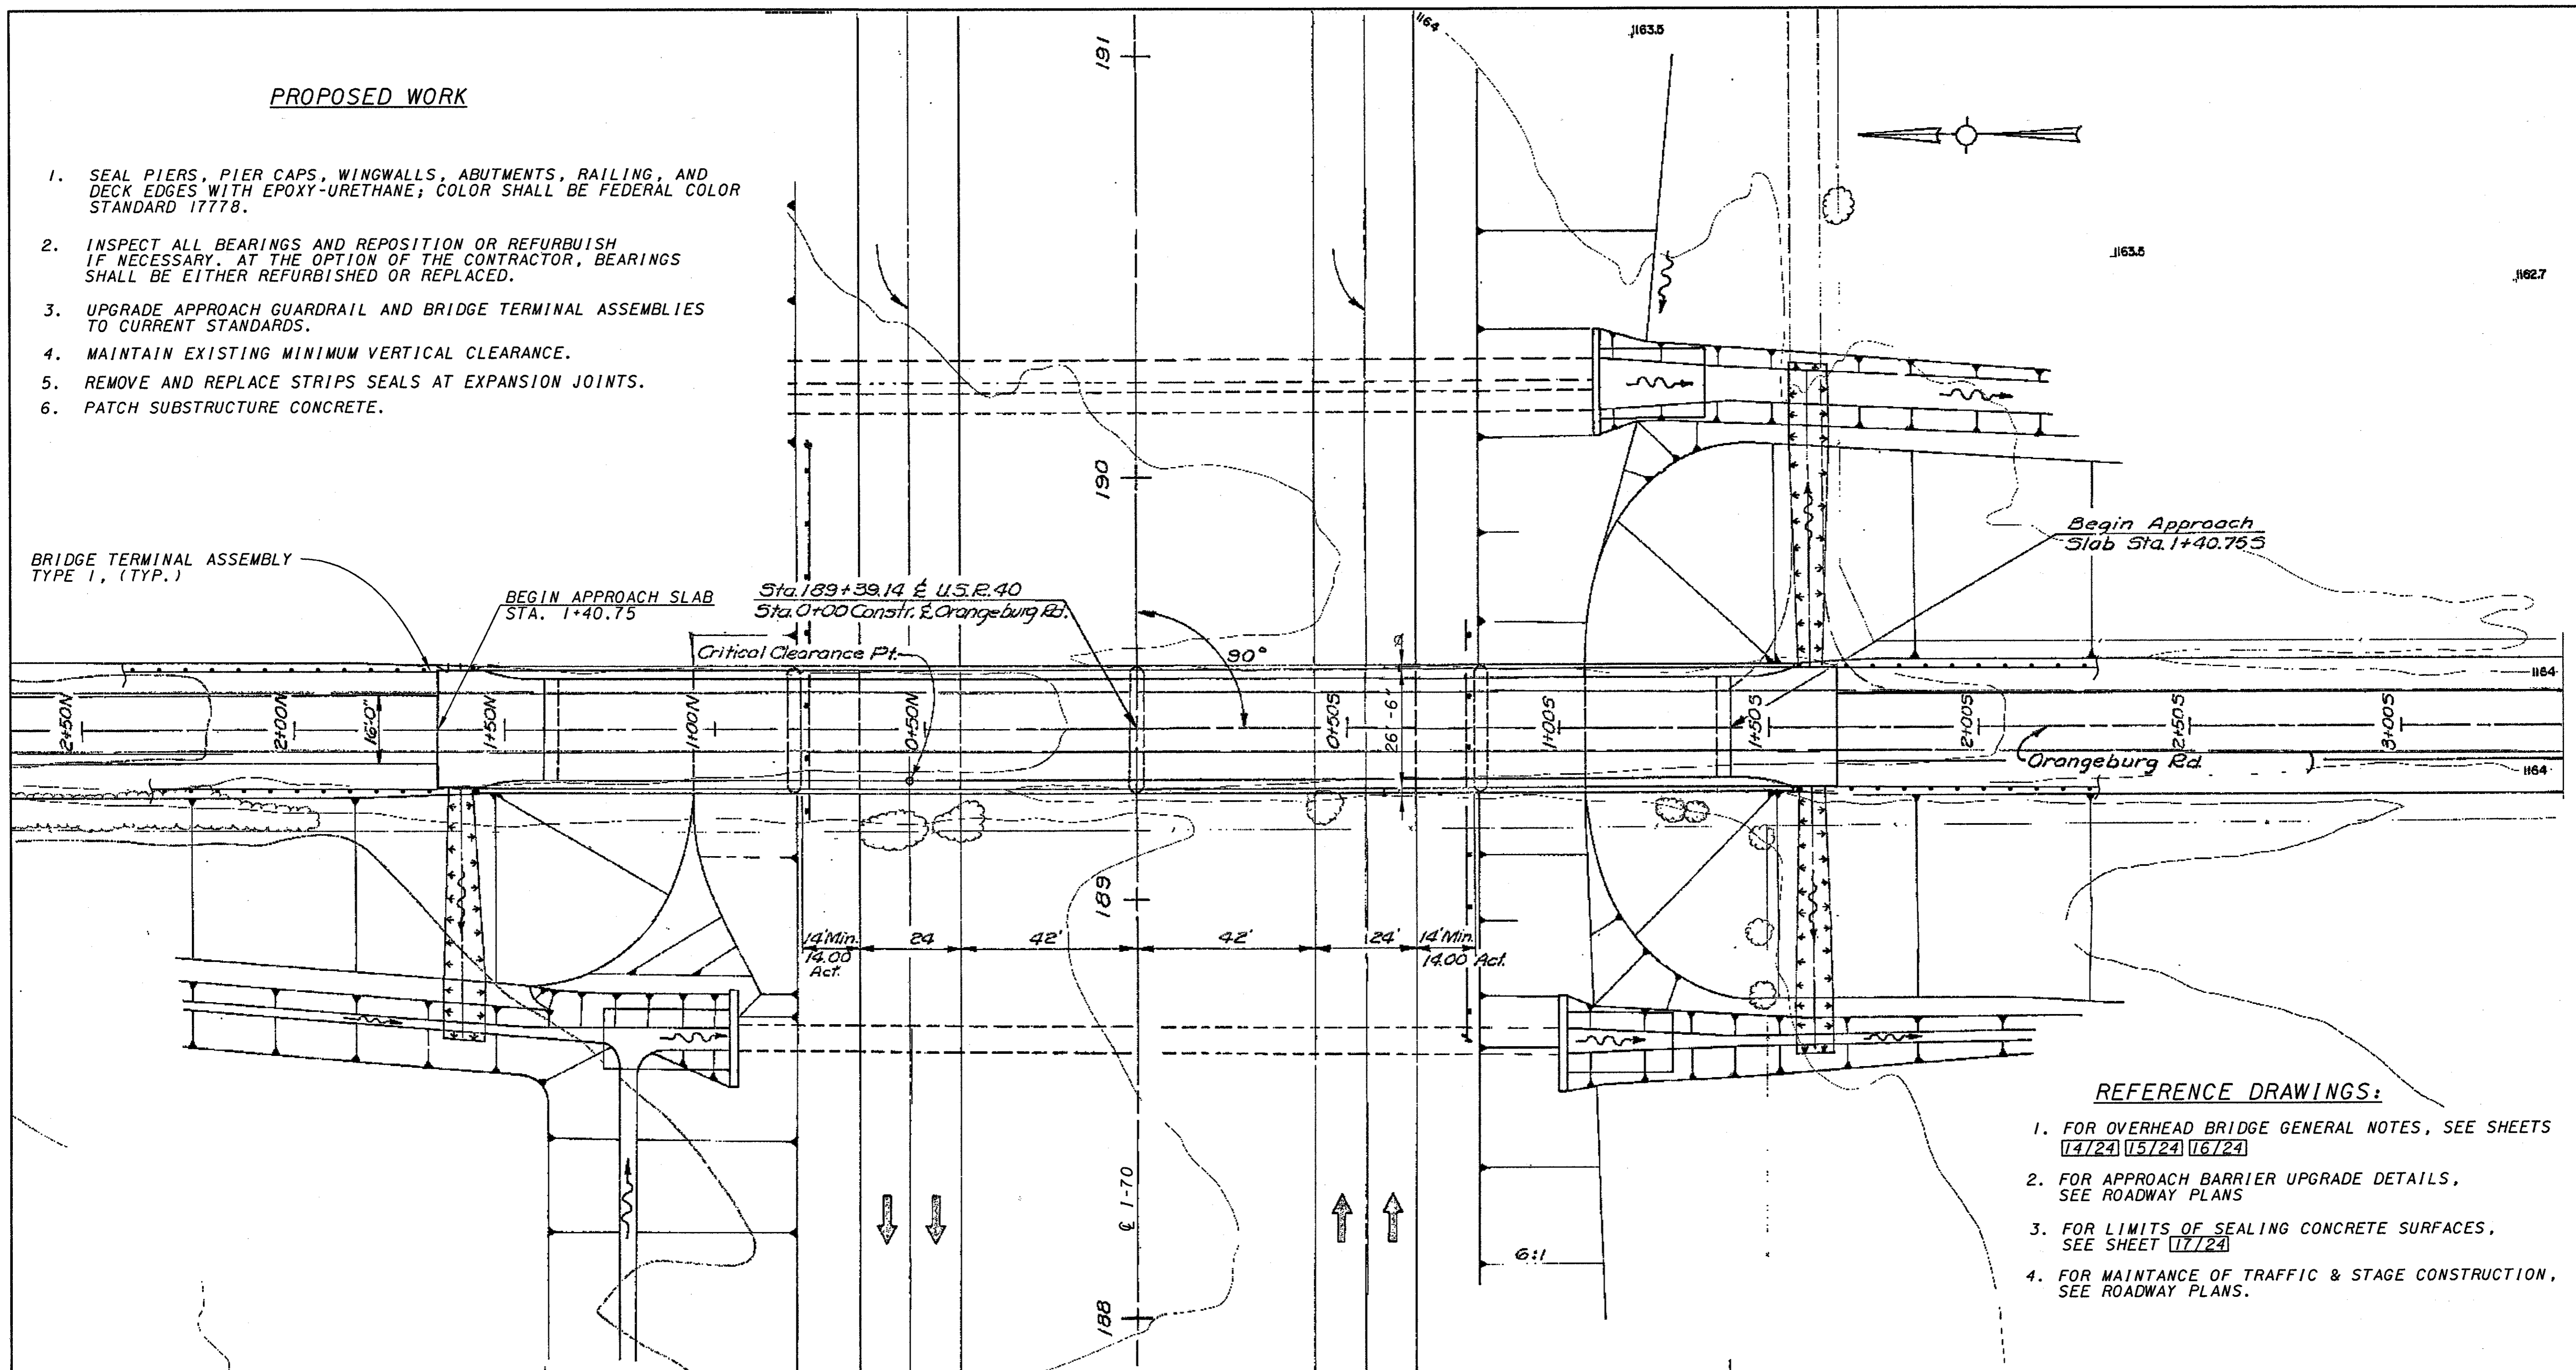
REFERENCE DRAWINGS:

1. FOR OVERHEAD BRIDGE GENERAL NOTES, SEE SHEETS 14724 15724 16724
2. FOR APPROACH BARRIER UPGRADE DETAILS, SEE ROADWAY PLANS
3. FOR LIMITS OF SEALING CONCRETE SURFACES, SEE SHEET 17724
4. FOR MAINTANCE OF TRAFFIC & STAGE CONSTRUCTION, SEE ROADWAY PLANS.

EXISTING STRUCTURE - I.R. 70 UNDER ORANGEBURG RD.

TYPE: CONTINUOUS STEEL BEAM WITH REINFORCED CONCRETE DECK AND SUBSTRUCTURE.
 LENGTH OF SPANS: 57'-0"±, 81'-6"±, 81'-6"±, 57'-0"± MEASURED CENTER TO CENTER OF BEARINGS.
 ROADWAY WIDTH: 26'-6" MEASURED TOE TO TOE OF BARRIER.
 DESIGN LOADING: CF-130 (57)
 SKEW ANGLE: NONE
 ALIGNMENT: TANGENT
 SUPERELEVATION: NONE, NORMAL CROWN
 WEARING SURFACE: 1 3/4" DENSE CONCRETE OVERLAY
 APPROACH SLABS: AS-1-54 (25' LONG)
 YEAR BUILT: 1960±
 YEAR REHABBED: 1990±
 STRUCTURE FILE NO.: 6800815

1170.12	1169.8	1169.3	1168.6	1168.3	1167.8	1167.4	1167.2	1166.9	1166.7	1150
1189.56	1190.23	1190.83	1191.36	1191.81	1192.20	1192.52	1192.76	1192.83	1193.04	1210
					1192.20	1192.52	1192.76	1192.83	1193.04	1200
					1192.20	1192.52	1192.76	1192.83	1193.04	1190
					1192.20	1192.52	1192.76	1192.83	1193.04	1180
					1192.20	1192.52	1192.76	1192.83	1193.04	1170
					1192.20	1192.52	1192.76	1192.83	1193.04	1160
					1192.20	1192.52	1192.76	1192.83	1193.04	1150
					1192.20	1192.52	1192.76	1192.83	1193.04	1140

KZF DESIGN

DESIGN AGENCY
 1000 W. ORANGEBURG RD., SUITE 100
 ORANGEBURG, SC 29117
 TEL: 803/681-1111 FAX: 803/681-1100 WEB: www.kzf.com

DATE	08/02/00
REVIEWED	SJA
STRUCTURE FILE NUMBER	
DRAWN	MWL
CHECKED	WBS
DESIGNED	DGK

PREBLE COUNTY
 STA 1+40.75 N
 STA 1+40.75 S

S I T E P L A N
 BRIDGE NO. PRE-70-0358
 I.R. 70 UNDER ORANGEBURG RD.

KZF #4

PRE-70-0.00

3/24

262
 283

PROPOSED WORK

1. SEAL PIERS, PIER CAPS, WINGWALLS, ABUTMENTS, RAILING, AND DECK EDGES WITH EPOXY-URETHANE; COLOR SHALL BE FEDERAL COLOR STANDARD 17778.
2. INSPECT ALL BEARINGS AND REPOSITION OR REFURBISH IF NECESSARY. AT THE OPTION OF THE CONTRACTOR, BEARINGS SHALL BE EITHER REFURBISHED OR REPLACED.
3. REMOVE THE EXISTING CONCRETE WEARING SURFACE AND OVERLAY AND REPLACE WITH A NEW MICRO-SILICA CONCRETE OVERLAY.
4. PLUG BRIDGE SCUPPERS AND FILL WITH MICRO SILICA CONCRETE OVERLAY.
5. UPGRADE APPROACH GUARDRAIL AND BRIDGE TERMINAL ASSEMBLIES TO CURRENT STANDARDS.
6. MAINTAIN EXISTING MINIMUM VERTICAL CLEARANCE.
7. PAINT STRUCTURAL STEEL WITH SYSTEM OZEU, COLOR SHALL BE FEDERAL COLOR STANDARD 10324.
8. REMOVE AND REPLACE STRIP SEALS AT EXPANSION JOINTS.
9. PATCH SUBSTRUCTURE CONCRETE.


REF: 17778
REF: 10324
REF: 17778
REF: 10324

DESIGNER: [Name]
DATE: [Date]
ACTIVE LEVELS ON: [List]

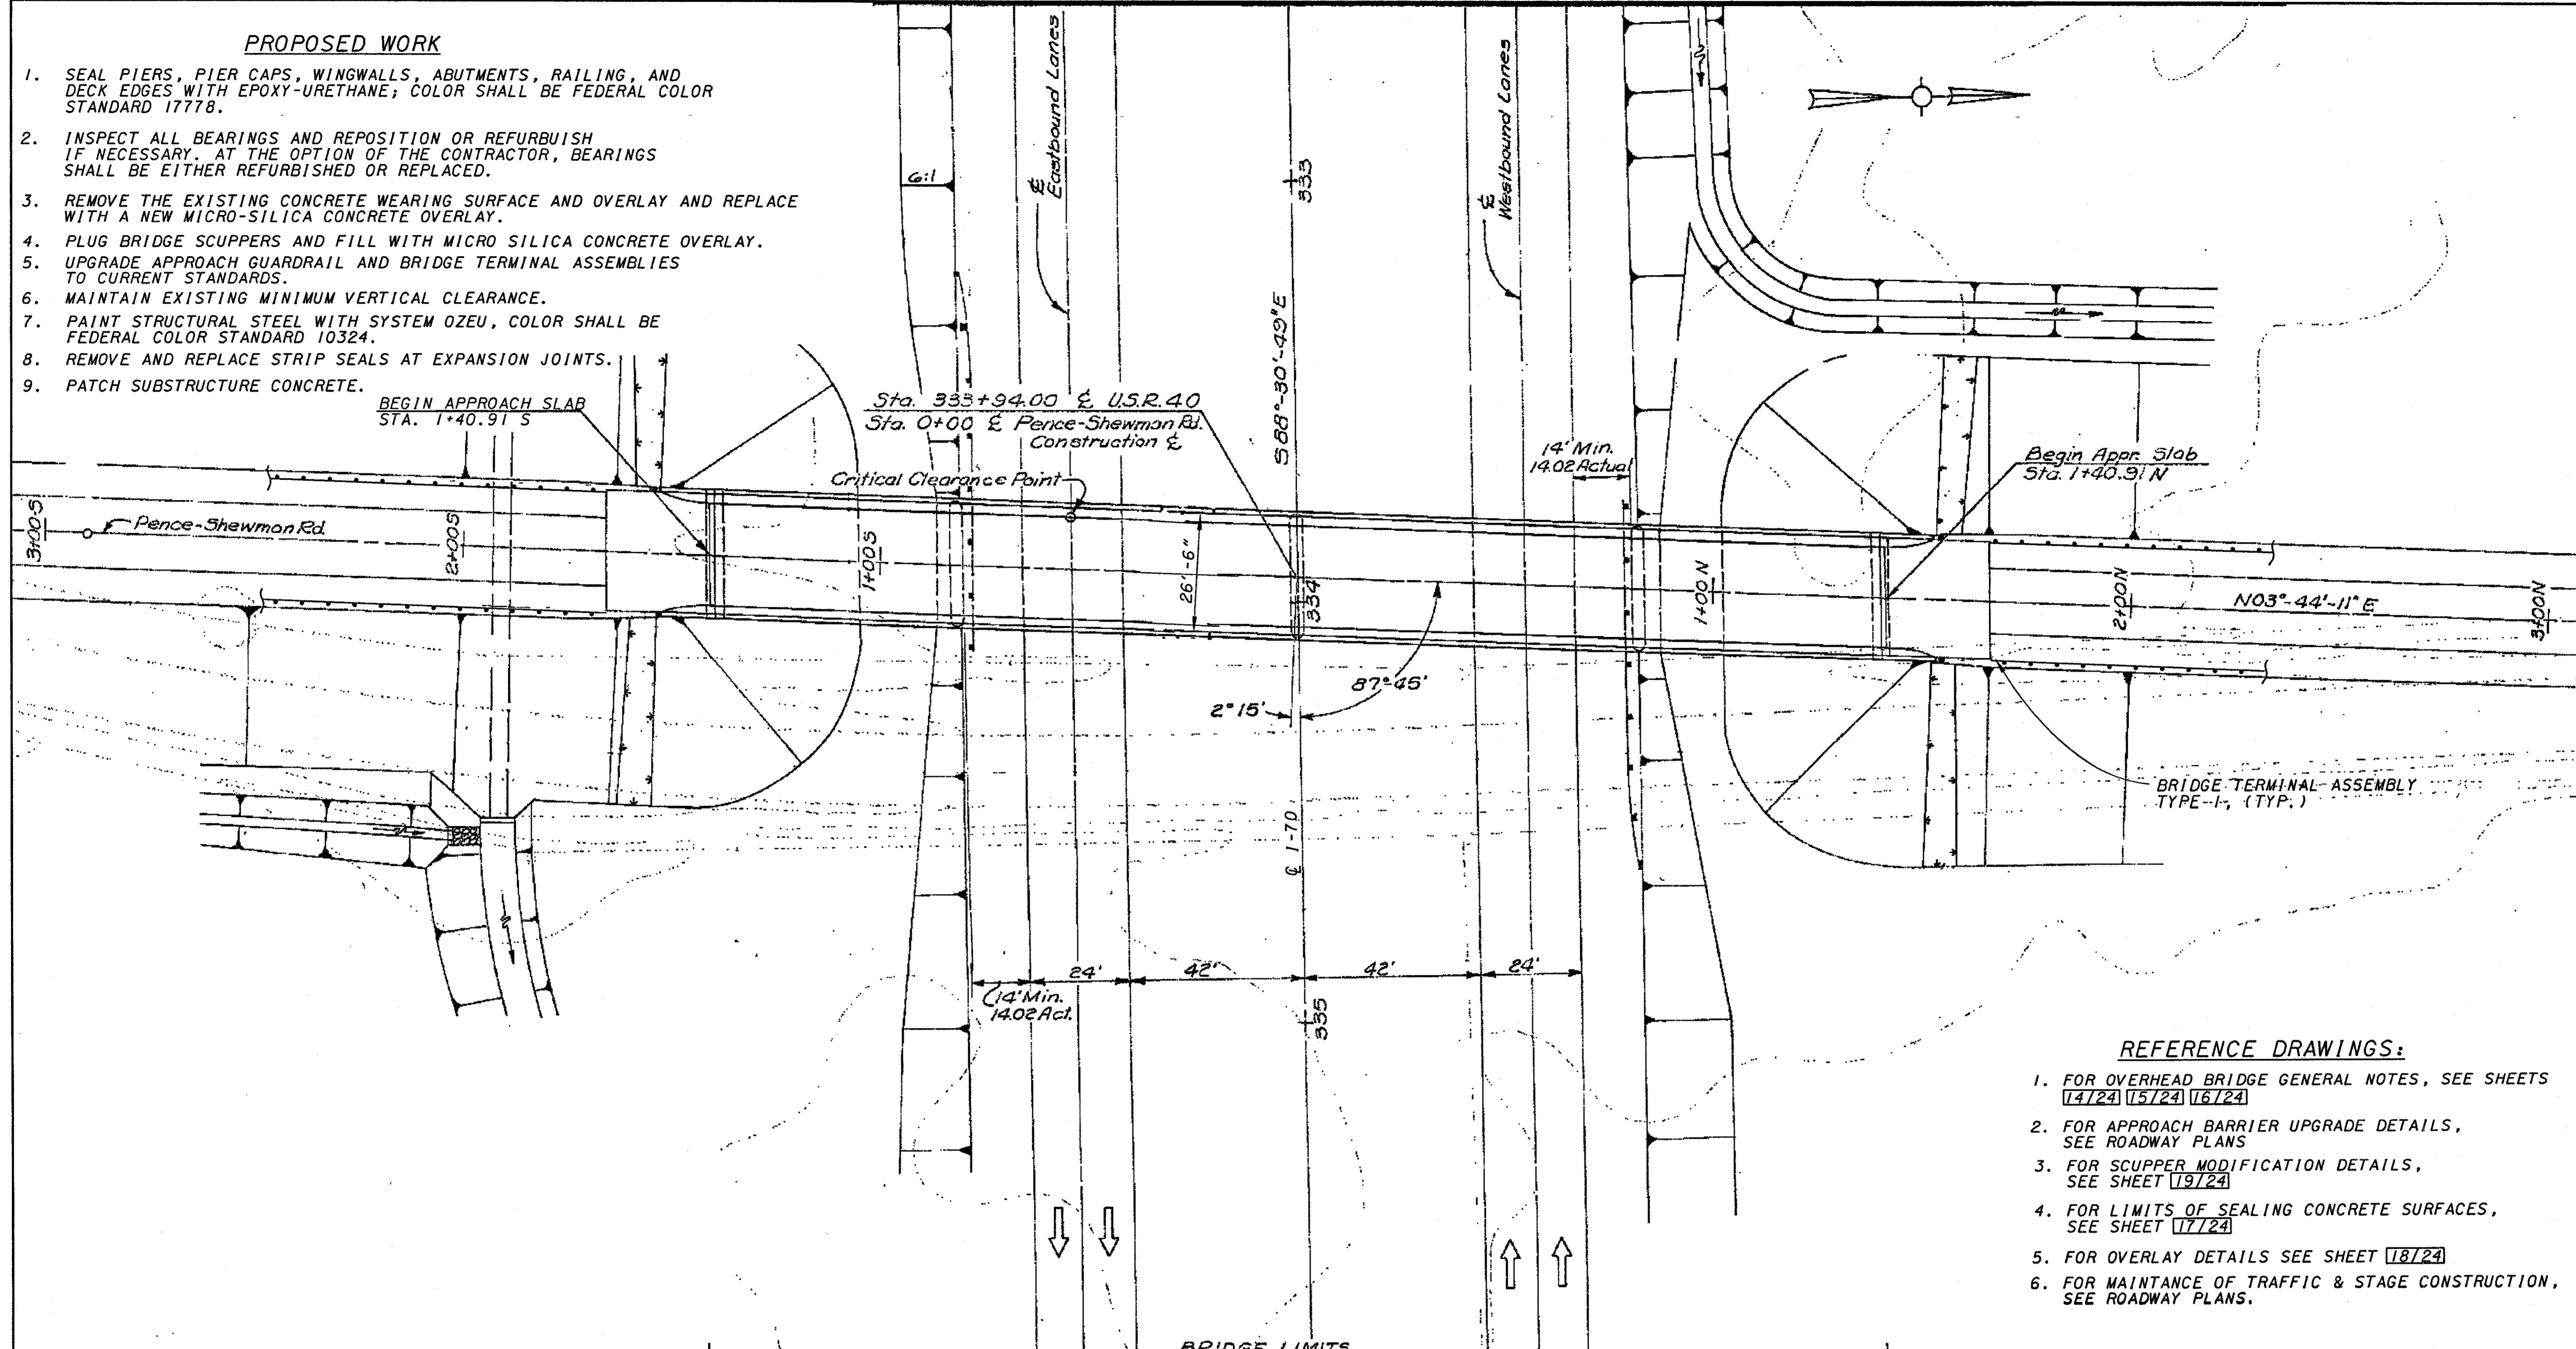

- REFERENCE DRAWINGS:**
1. FOR OVERHEAD BRIDGE GENERAL NOTES, SEE SHEETS 17/24 15/24 16/24
 2. FOR APPROACH BARRIER UPGRADE DETAILS, SEE ROADWAY PLANS
 3. FOR SCUPPER MODIFICATION DETAILS, SEE SHEET 19/24
 4. FOR LIMITS OF SEALING CONCRETE SURFACES, SEE SHEET 17/24
 5. FOR OVERLAY DETAILS SEE SHEET 18/24
 6. FOR MAINTANCE OF TRAFFIC & STAGE CONSTRUCTION, SEE ROADWAY PLANS.

EXISTING STRUCTURE - I.R. 70 UNDER PENCE SHEWMAN RD.

TYPE: CONTINUOUS STEEL BEAM WITH REINFORCED CONCRETE DECK AND SUBSTRUCTURE.

LENGTH OF SPANS: 57'-1"±, 81'-7"±, 81'-7"±, 57'-1"± MEASURED CENTER TO CENTER OF BEARINGS.

ROADWAY WIDTH: 26'-6" MEASURED TOE TO TOE OF BARRIERS.

DESIGN LOADING: CF-130 (57)

SKEW ANGLE: 02° 15' 00"±

ALIGNMENT: TANGENT

SUPERELEVATION: NONE, NORMAL CROWN


WEARING SURFACE: 3/4" MONOLITHIC CONCRETE AND 1 3/4" DENSE CONCRETE OVERLAY

APPROACH SLABS: AS-1-54 (25' LONG)

YEAR BUILT: 1960±

YEAR REHABBED: 1990±

STRUCTURE FILE NO.: 6800963

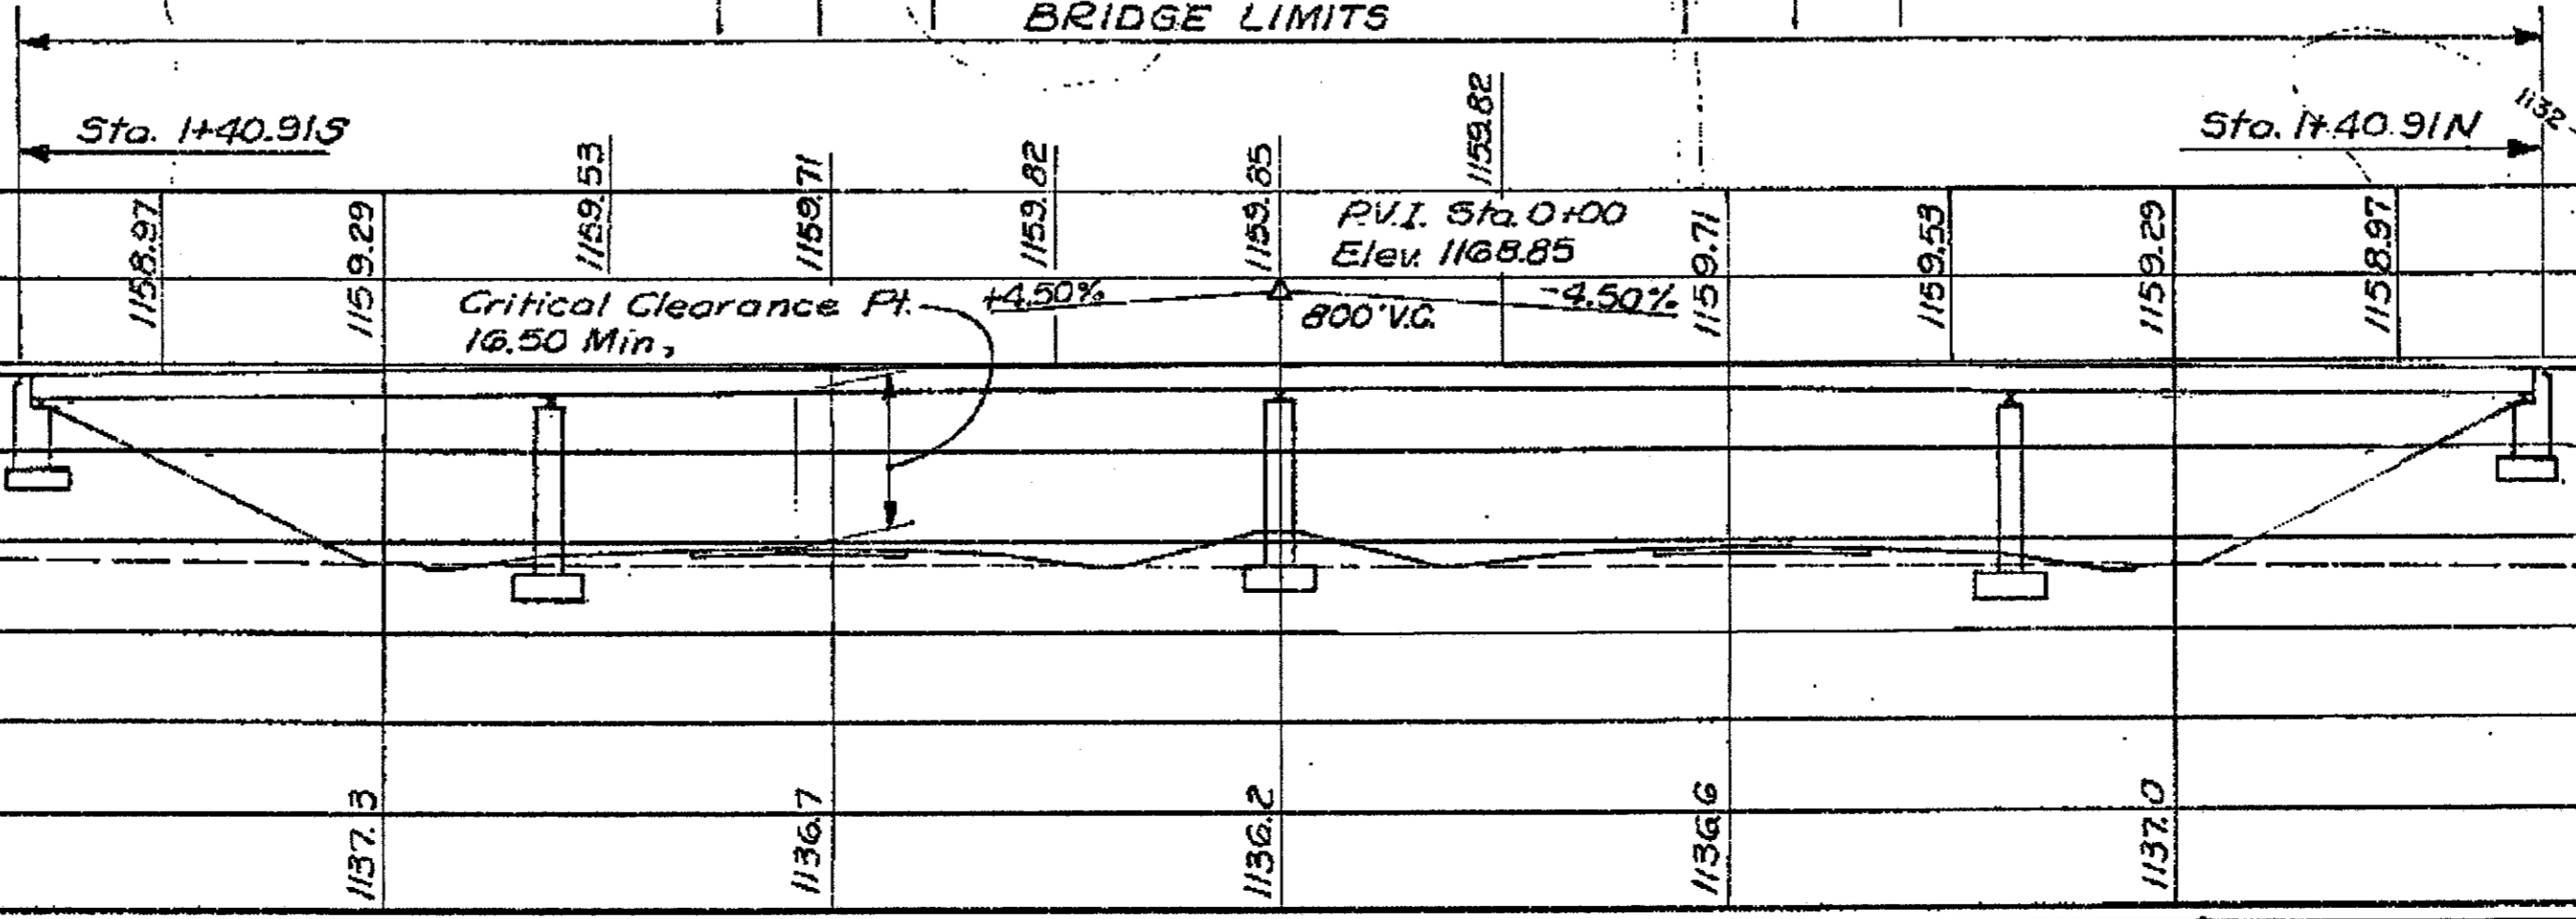

PROPOSED WORK

1. SEAL PIERS, PIER CAPS, WINGWALLS, ABUTMENTS, RAILING, AND DECK EDGES WITH EPOXY-URETHANE; COLOR SHALL BE FEDERAL COLOR STANDARD 17778.
2. INSPECT ALL BEARINGS AND REPOSITION OR REFURBISH IF NECESSARY. AT THE OPTION OF THE CONTRACTOR, BEARINGS SHALL BE EITHER REFURBISHED OR REPLACED.
3. EXTEND SCUPPERS SO THAT THE OUTLET IS 8" BELOW THE BOTTOM FLANGE.
4. UPGRADE APPROACH GUARDRAIL AND BRIDGE TERMINAL ASSEMBLIES TO CURRENT STANDARDS.
5. MAINTAIN EXISTING MINIMUM VERTICAL CLEARANCE.
6. PAINT STRUCTURAL STEEL WITH SYSTEM OZEU, COLOR SHALL BE FEDERAL COLOR STANDARD 10324.
7. SEAL DECK WITH GRAVITY-FED RESIN.
8. PATCH SUBSTRUCTURE CONCRETE.

REF: **REF**
REF: **REF**
PROJECT NUMBER: 265
USER: J. J. J.
DATE: 08/02/00
DRAWN: M.W.L.
CHECKED: D.G.K.
DESIGNED: D.G.K.
DATE: 08/02/00
STRUCTURE FILE NUMBER: 6804659

KZF DESIGN
ARCHITECTURE | ENGINEERING | INTERIORS | PLANNING
FOR DESIGN AND CONSTRUCTION OF ALL TYPES OF STRUCTURES
10000 W. 10TH AVENUE, SUITE 100, DENVER, CO 80202
TEL: 303.751.1111 FAX: 303.751.1112

DATE: 08/02/00
SJA: SJA
DRAWN: M.W.L.
CHECKED: D.G.K.
DESIGNED: D.G.K.

PREBLE COUNTY
STA 1+40.75 S
STA 1+40.75 N


KZF #9

S I T E P L A N
BRIDGE NO. PRE-726-0428
I.R. 70 UNDER S.R. 726

PRE-70-0.00

6 / 24

265
283

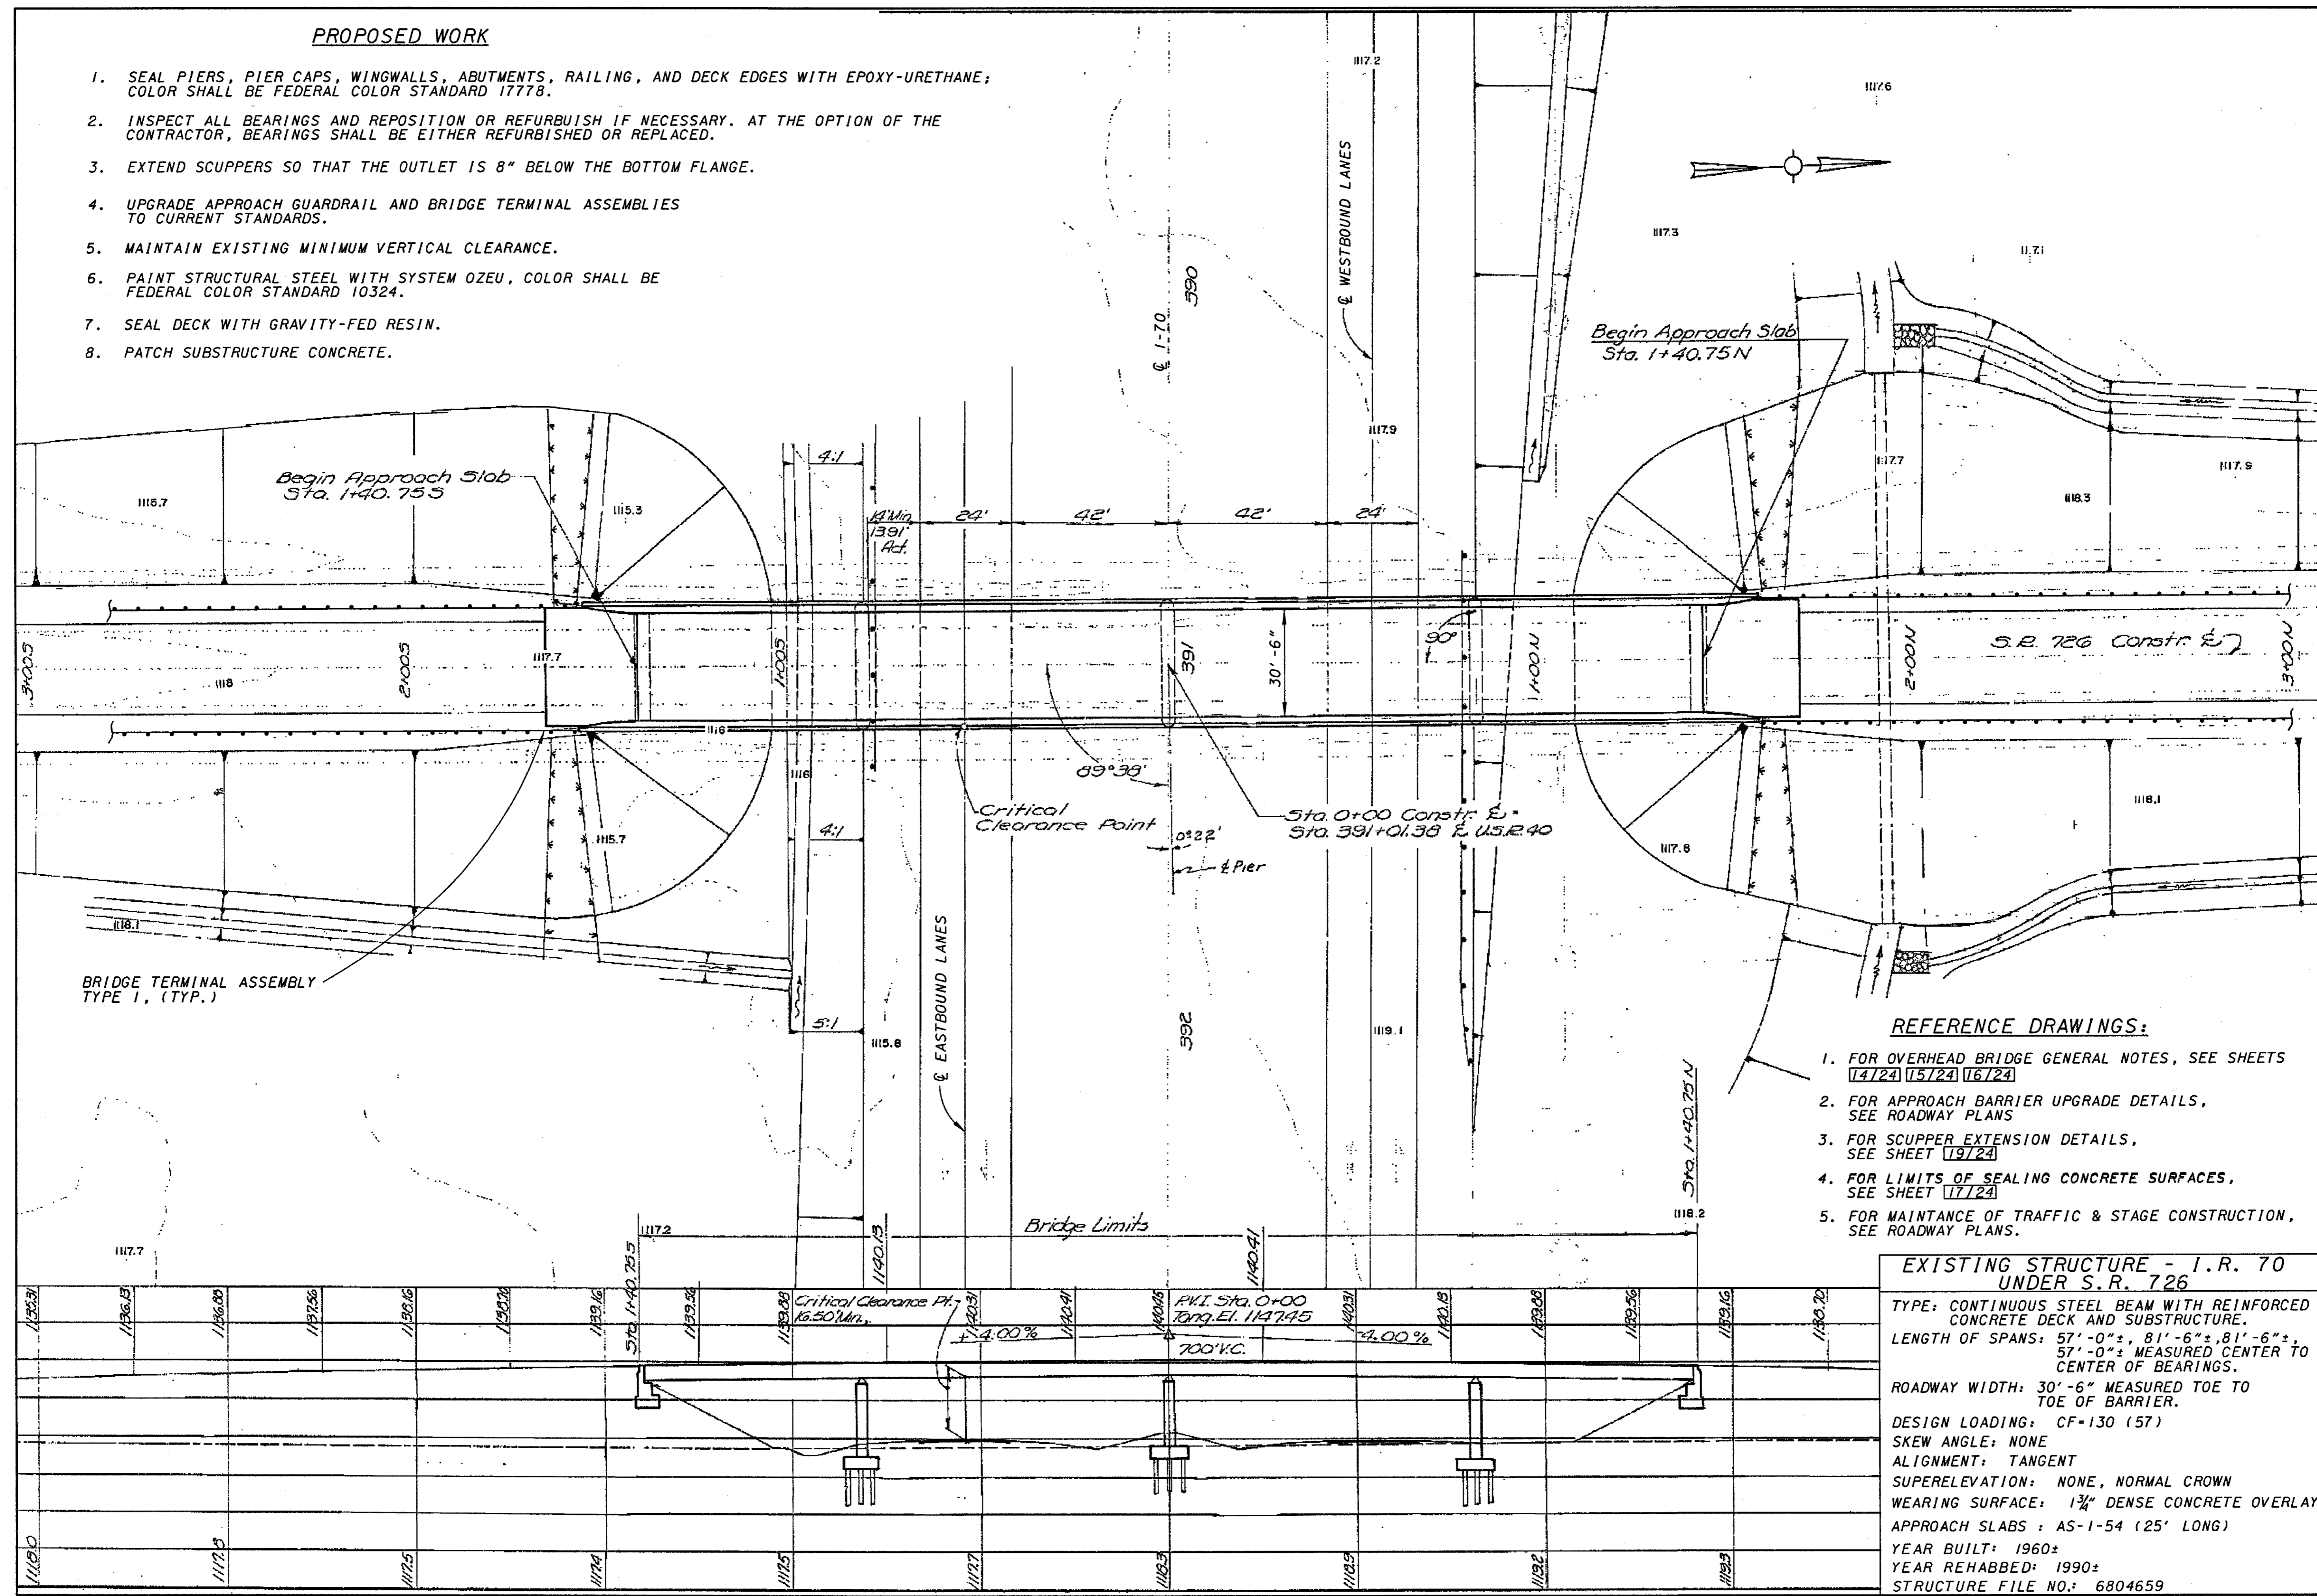

REFERENCE DRAWINGS:

1. FOR OVERHEAD BRIDGE GENERAL NOTES, SEE SHEETS [14/24] [15/24] [16/24]
2. FOR APPROACH BARRIER UPGRADE DETAILS, SEE ROADWAY PLANS
3. FOR SCUPPER EXTENSION DETAILS, SEE SHEET [19/24]
4. FOR LIMITS OF SEALING CONCRETE SURFACES, SEE SHEET [17/24]
5. FOR MAINTANCE OF TRAFFIC & STAGE CONSTRUCTION, SEE ROADWAY PLANS.

EXISTING STRUCTURE - I.R. 70 UNDER S.R. 726

TYPE: CONTINUOUS STEEL BEAM WITH REINFORCED CONCRETE DECK AND SUBSTRUCTURE.
 LENGTH OF SPANS: 57'-0"±, 81'-6"±, 81'-6"±, 57'-0"± MEASURED CENTER TO CENTER OF BEARINGS.
 ROADWAY WIDTH: 30'-6" MEASURED TOE TO TOE OF BARRIER.
 DESIGN LOADING: CF=130 (57)
 SKEW ANGLE: NONE
 ALIGNMENT: TANGENT
 SUPERELEVATION: NONE, NORMAL CROWN
 WEARING SURFACE: 1 3/4" DENSE CONCRETE OVERLAY
 APPROACH SLABS: AS-1-54 (25' LONG)
 YEAR BUILT: 1960±
 YEAR REHABBED: 1990±
 STRUCTURE FILE NO.: 6804659


REF: 10270
REF: 10270
USER: JLD
NAME: JLD
ACTIVE LEVELS ON: 10270

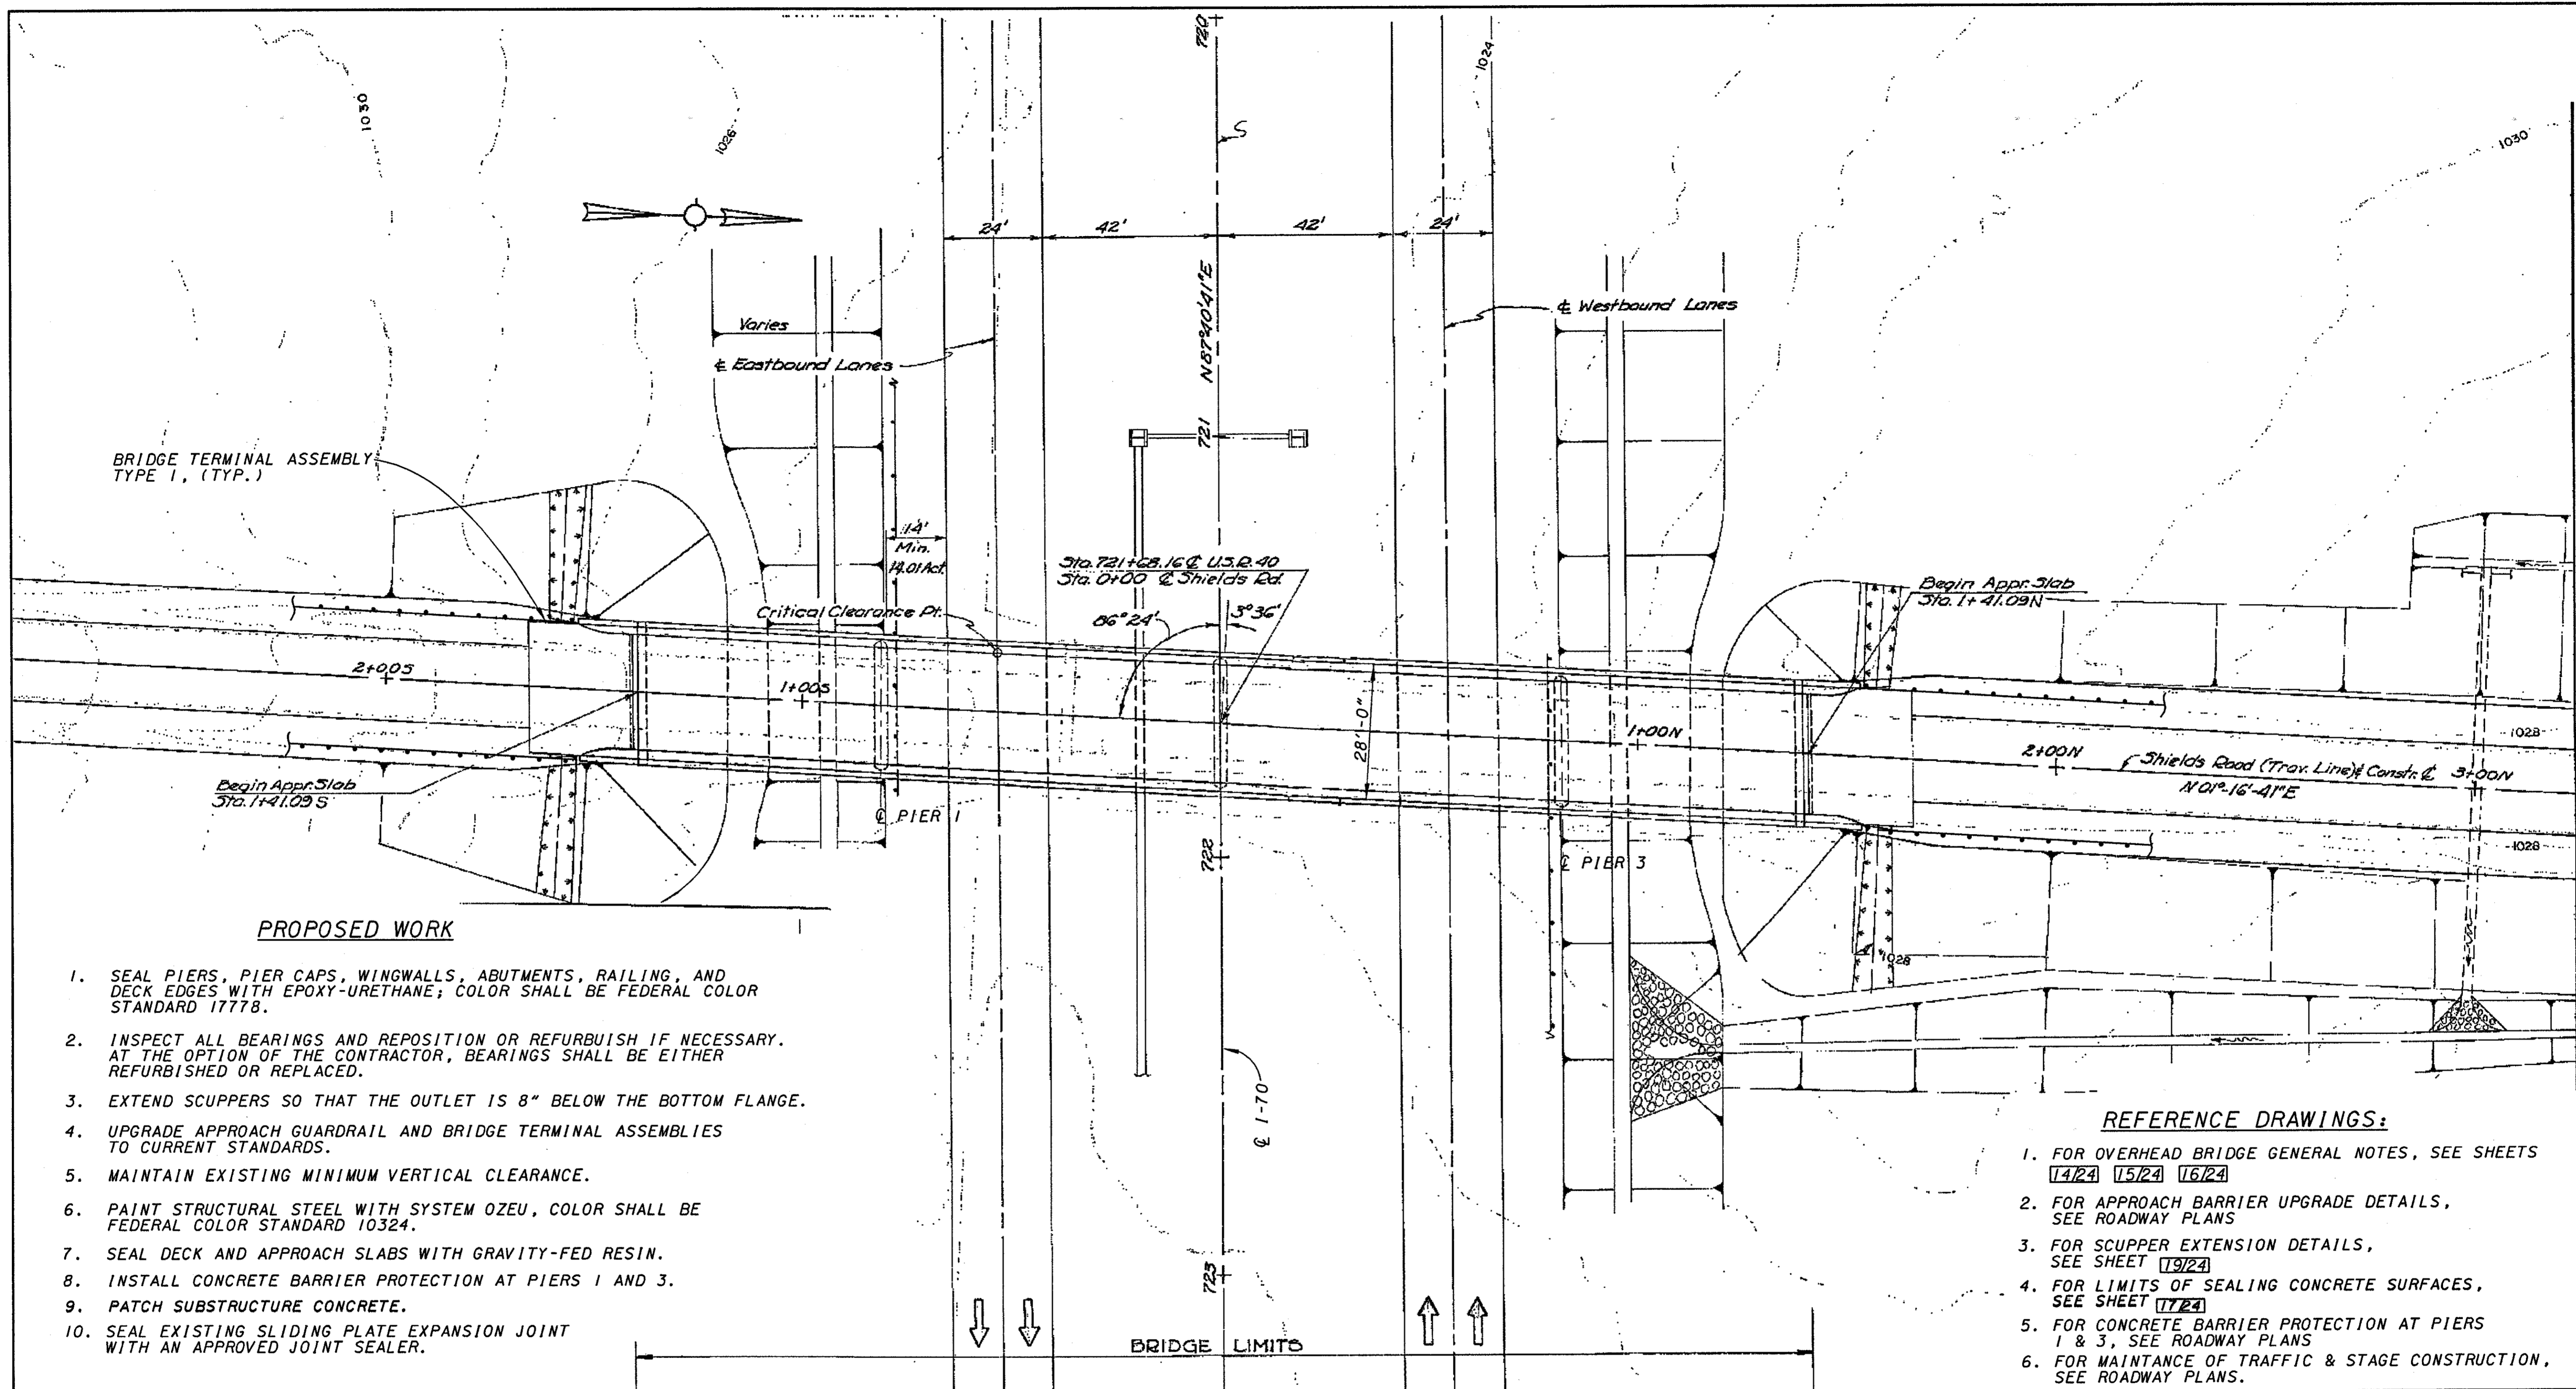

PROPOSED WORK


1. SEAL PIERS, PIER CAPS, WINGWALLS, ABUTMENTS, RAILING, AND DECK EDGES WITH EPOXY-URETHANE; COLOR SHALL BE FEDERAL COLOR STANDARD 1777B.
2. INSPECT ALL BEARINGS AND REPOSITION OR REFURBISH IF NECESSARY. AT THE OPTION OF THE CONTRACTOR, BEARINGS SHALL BE EITHER REFURBISHED OR REPLACED.
3. EXTEND SCUPPERS SO THAT THE OUTLET IS 8" BELOW THE BOTTOM FLANGE.
4. UPGRADE APPROACH GUARDRAIL AND BRIDGE TERMINAL ASSEMBLIES TO CURRENT STANDARDS.
5. MAINTAIN EXISTING MINIMUM VERTICAL CLEARANCE.
6. PAINT STRUCTURAL STEEL WITH SYSTEM OZEU, COLOR SHALL BE FEDERAL COLOR STANDARD 10324.
7. SEAL DECK AND APPROACH SLABS WITH GRAVITY-FED RESIN.
8. INSTALL CONCRETE BARRIER PROTECTION AT PIERS 1 AND 3.
9. PATCH SUBSTRUCTURE CONCRETE.
10. SEAL EXISTING SLIDING PLATE EXPANSION JOINT WITH AN APPROVED JOINT SEALER.

REFERENCE DRAWINGS:

1. FOR OVERHEAD BRIDGE GENERAL NOTES, SEE SHEETS 1424 1524 1624
2. FOR APPROACH BARRIER UPGRADE DETAILS, SEE ROADWAY PLANS
3. FOR SCUPPER EXTENSION DETAILS, SEE SHEET 1924
4. FOR LIMITS OF SEALING CONCRETE SURFACES, SEE SHEET 1724
5. FOR CONCRETE BARRIER PROTECTION AT PIERS 1 & 3, SEE ROADWAY PLANS
6. FOR MAINTANCE OF TRAFFIC & STAGE CONSTRUCTION, SEE ROADWAY PLANS.

EXISTING STRUCTURE - I.R. 70 UNDER SHIELDS ROAD

TYPE: CONTINUOUS STEEL BEAM WITH REINFORCED CONCRETE DECK AND SUBSTRUCTURE.
 LENGTH OF SPANS: 57'-2"±, 81'-8"±, 81'-8"±, 57'-2"± MEASURED CENTER TO CENTER OF BEARINGS.
 ROADWAY WIDTH: 28'-0" MEASURED F/F OF SAFETY CURB
 DESIGN LOADING: CF-130 (57)
 SKEW ANGLE: 03° 36' 00"±
 ALIGNMENT: TANGENT
 SUPERELEVATION: NONE, NORMAL CROWN
 WEARING SURFACE: LATEX MOD. CONCRETE OVERLAY
 APPROACH SLABS: AS-1-54 (25' LONG)
 YEAR BUILT: 1960±
 STRUCTURE FILE NO.: 6801382

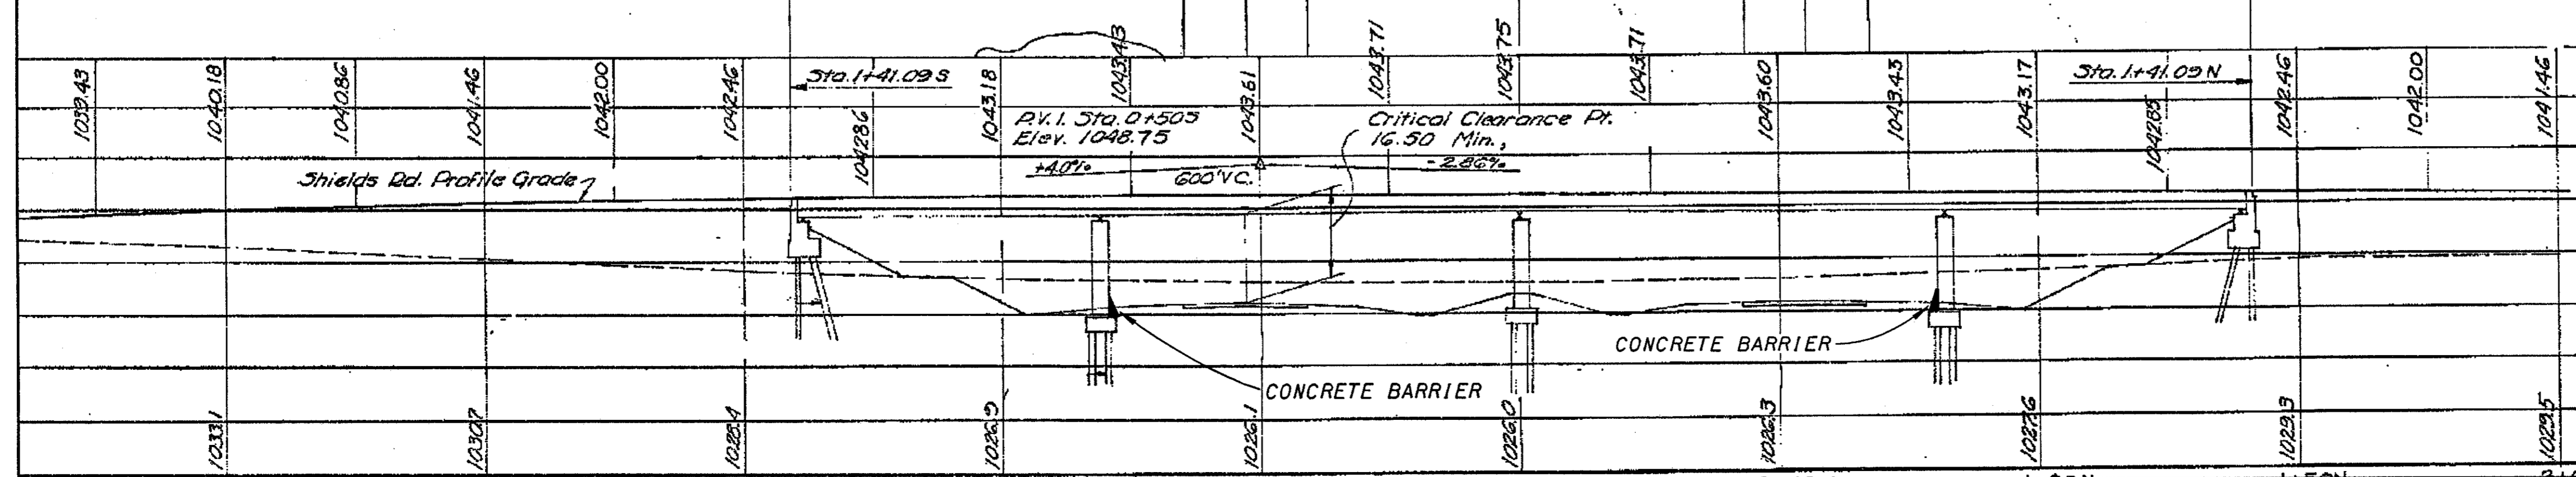

PROPOSED WORK

1. SEAL PIERS, PIER CAPS, WINGWALLS, ABUTMENTS, RAILING, AND DECK EDGES WITH EPOXY-URETHANE; COLOR SHALL BE FEDERAL COLOR STANDARD 17778.
2. PATCH SUBSTRUCTURE CONCRETE.
3. INSPECT ALL BEARINGS AND REPOSITION OR REFURBISH IF NECESSARY. AT THE OPTION OF THE CONTRACTOR, BEARINGS SHALL BE EITHER REFURBISHED OR REPLACED.
4. REMOVE THE EXISTING CONCRETE OVERLAY AND REPLACE WITH A NEW MICRO-SILICA CONCRETE OVERLAY.
5. EXTEND SCUPPERS SO THAT THE OUTLET IS 8" BELOW THE BOTTOM FLANGE.
6. UPGRADE APPROACH GUARDRAIL AND BRIDGE TERMINAL ASSEMBLIES TO CURRENT STANDARDS.
7. PROVIDE ADDITIONAL PLANNING UNDER THE BRIDGE TO PROVIDE 16.00 FT MINIMUM CLEARANCE UPON PROJECT COMPLETION. EXISTING MINIMUM CLEARANCE IS 15.81 FT±
8. INSTALL STRIP SEAL EXPANSION JOINTS.
9. INSTALL CONCRETE BARRIER PROTECTION AT PIERS 1 AND 3.


REF: **REF**
 REF: **REF**
 USER: *****
 PROJ: *****
 DATE: *****
 ACTIVE LEVELS ON: BELLEVUE

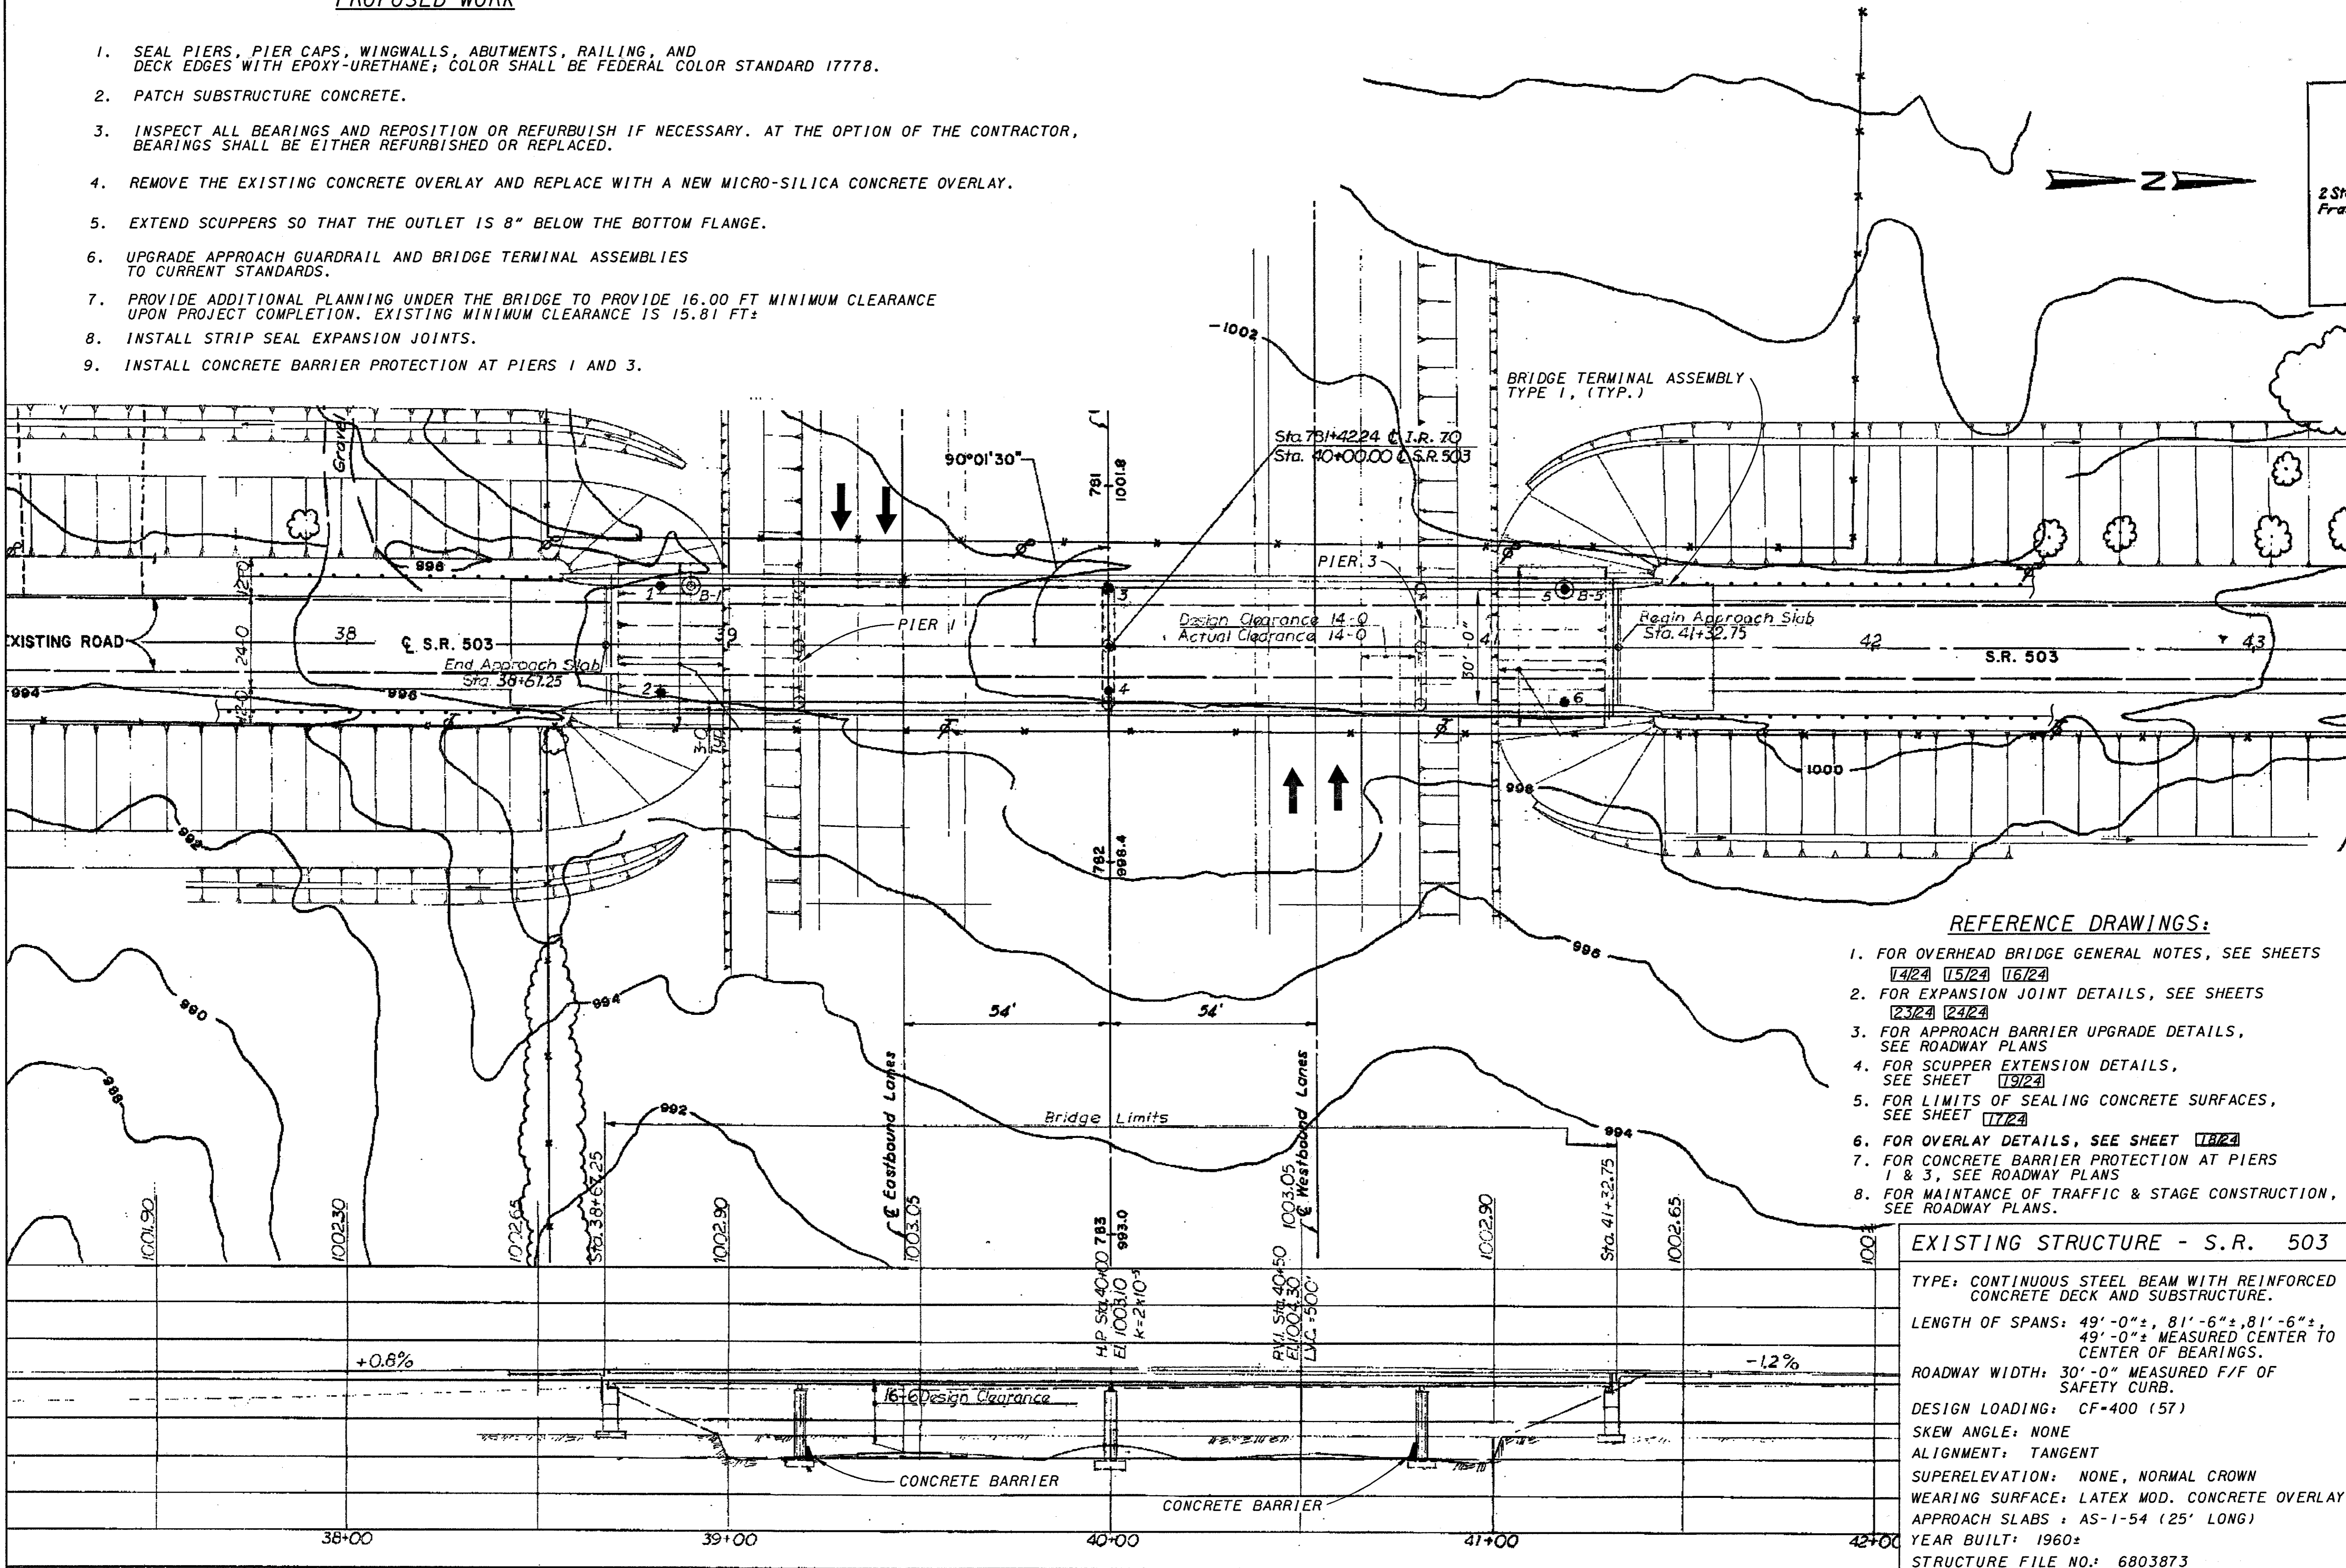

REFERENCE DRAWINGS:

1. FOR OVERHEAD BRIDGE GENERAL NOTES, SEE SHEETS 14/24 15/24 16/24
2. FOR EXPANSION JOINT DETAILS, SEE SHEETS 23/24 24/24
3. FOR APPROACH BARRIER UPGRADE DETAILS, SEE ROADWAY PLANS
4. FOR SCUPPER EXTENSION DETAILS, SEE SHEET 19/24
5. FOR LIMITS OF SEALING CONCRETE SURFACES, SEE SHEET 17/24
6. FOR OVERLAY DETAILS, SEE SHEET 18/24
7. FOR CONCRETE BARRIER PROTECTION AT PIERS 1 & 3, SEE ROADWAY PLANS
8. FOR MAINTANCE OF TRAFFIC & STAGE CONSTRUCTION, SEE ROADWAY PLANS.

EXISTING STRUCTURE - S.R. 503

TYPE: CONTINUOUS STEEL BEAM WITH REINFORCED CONCRETE DECK AND SUBSTRUCTURE.
 LENGTH OF SPANS: 49'-0"±, 81'-6"±, 81'-6"±, 49'-0"± MEASURED CENTER TO CENTER OF BEARINGS.
 ROADWAY WIDTH: 30'-0" MEASURED F/F OF SAFETY CURB.
 DESIGN LOADING: CF-400 (57)
 SKEW ANGLE: NONE
 ALIGNMENT: TANGENT
 SUPERELEVATION: NONE, NORMAL CROWN
 WEARING SURFACE: LATEX MOD. CONCRETE OVERLAY
 APPROACH SLABS: AS-1-54 (25' LONG)
 YEAR BUILT: 1960±
 STRUCTURE FILE NO.: 6803873

	DESIGN AGENCY	DATE	08/02/00
	REVIEWED	SJA	STRUCTURE FILE NUMBER
DESIGNED	DGK	CHECKED	WBS
DRAWN	MWL	REVISED	
PREBLE COUNTY		STA 38+67.25	STA 41+32.75
KZF #16			
S I T E P L A N			
BRIDGE NO. PRE-503-1955			
I.R. 70 UNDER S.R. 503			
PRE-70-0.00			
10/24			
269			
283			

PROPOSED WORK

1. SEAL PIERS, PIER CAPS, WINGWALLS, ABUTMENTS, RAILING, AND DECK EDGES WITH EPOXY-URETHANE; COLOR SHALL BE FEDERAL COLOR STANDARD 17778.
2. PATCH CONCRETE RAILING.
3. INSPECT ALL BEARINGS AND REPOSITION OR REFURBISH IF NECESSARY. AT THE OPTION OF THE CONTRACTOR, BEARINGS SHALL BE EITHER REFURBISHED OR REPLACED.
4. EXTEND SCUPPERS SO THAT THE OUTLET IS 8" BELOW THE BOTTOM FLANGE.
5. UPGRADE APPROACH GUARDRAIL AND BRIDGE TERMINAL ASSEMBLIES TO CURRENT STANDARDS.
6. PROVIDE ADDITIONAL PLANNING UNDER THE BRIDGE TO PROVIDE 16.00 FT MINIMUM VERTICAL CLEARANCE UPON PROJECT COMPLETION. EXISTING MINIMUM CLEARANCE IS 15.83 FT±.
7. INSTALL CONCRETE BARRIER PROTECTION AT PIERS 1 AND 3.
8. SEAL DECK AND APPROACH SLABS WITH GRAVITY-FED RESIN.
9. PAINT STRUCTURAL STEEL WITH SYSTEM OZEU, COLOR SHALL BE FEDERAL COLOR STANDARD 10324.
10. SEAL EXISTING SLIDING PLATE EXPANSION JOINT WITH AN APPROVED JOINT SEALER.
11. PATCH SUBSTRUCTURE CONCRETE.


REF: 11/27/01
REF: 11/27/01
USER: T:\ENGINEERING\PROJECTS\LEWISBURG-OZIAS\LEWISBURG-OZIAS.DWG
DATE: 11/27/01
TIME: 10:00 AM
ACTIVE LEVELS ON: BLEVELS

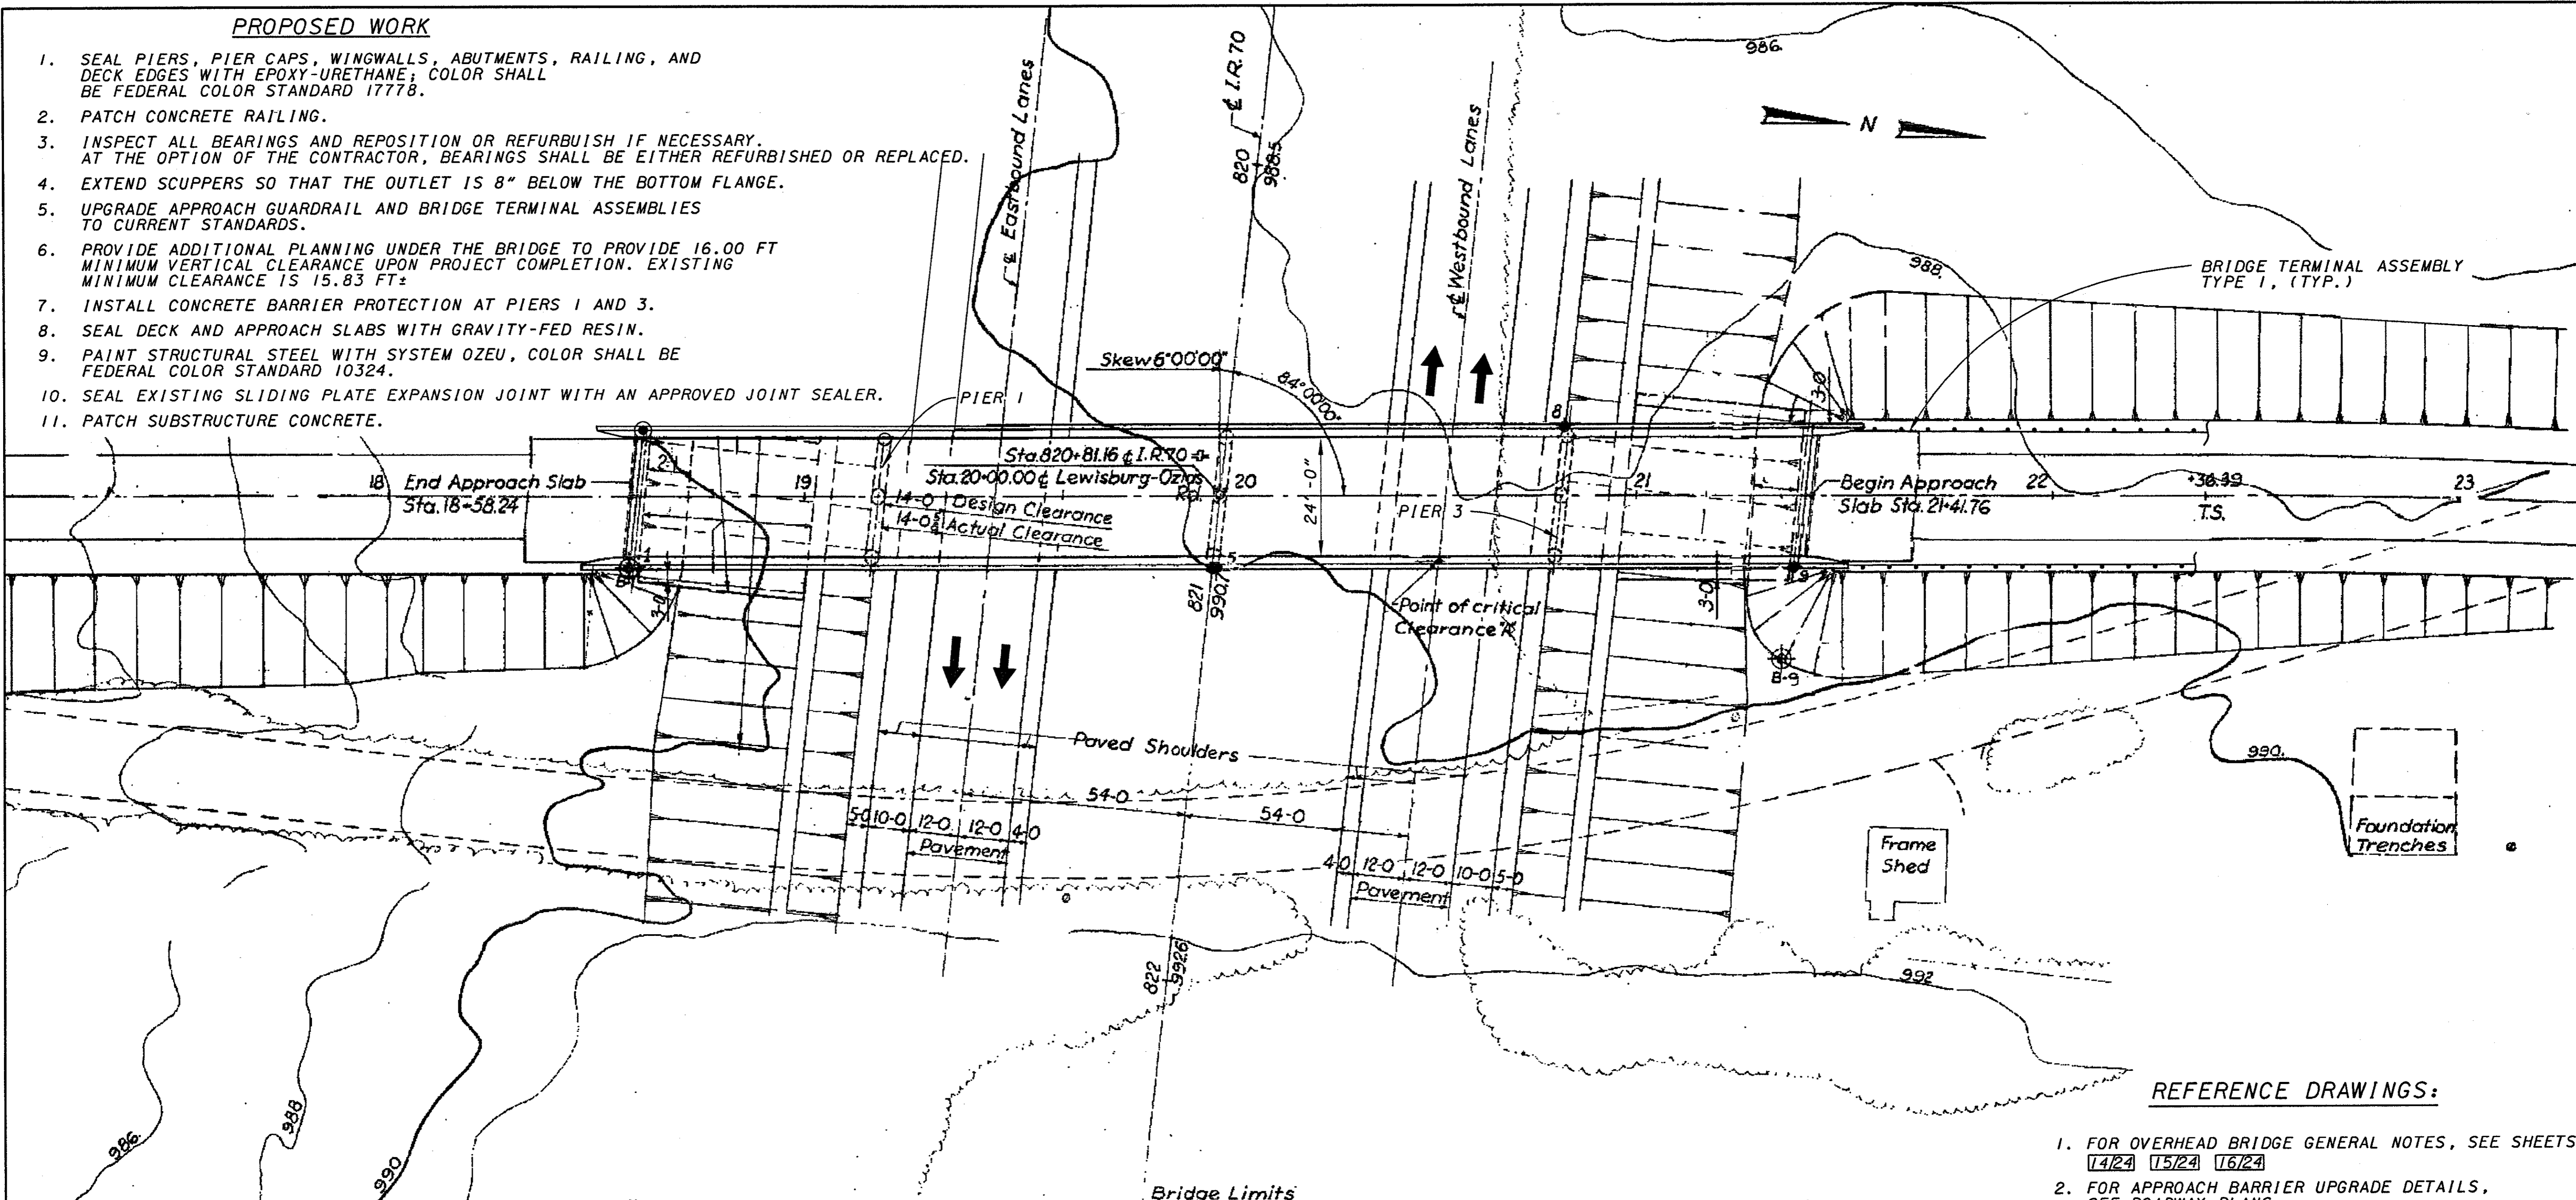

REFERENCE DRAWINGS:

1. FOR OVERHEAD BRIDGE GENERAL NOTES, SEE SHEETS 14/24 15/24 16/24
2. FOR APPROACH BARRIER UPGRADE DETAILS, SEE ROADWAY PLANS
3. FOR SCUPPER EXTENSION DETAILS, SEE SHEET 19/24
4. FOR LIMITS OF SEALING CONCRETE SURFACES, SEE SHEET 17/24
5. FOR CONCRETE BARRIER PROTECTION AT PIERS, SEE ROADWAY PLANS
6. FOR MAINTANCE OF TRAFFIC & STAGE CONSTRUCTION, SEE ROADWAY PLANS.

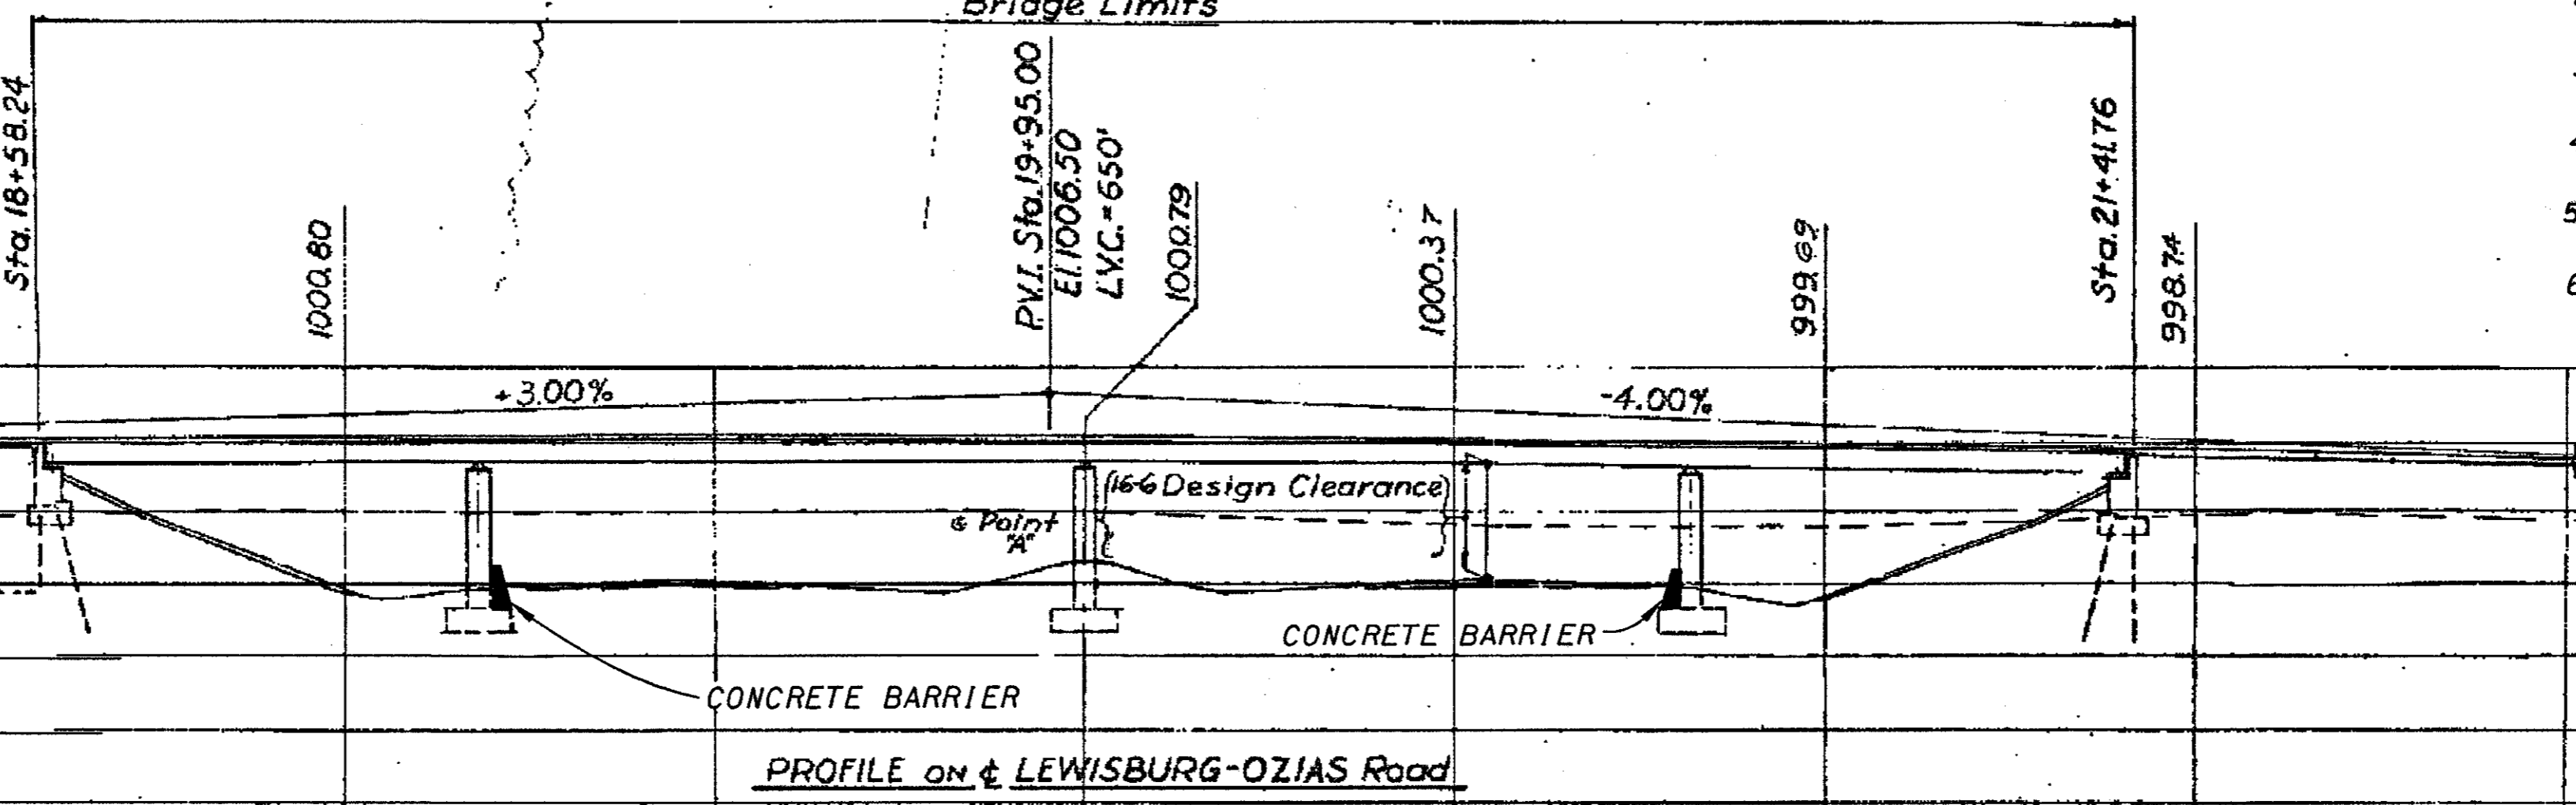

EXISTING STRUCTURE - I.R. 70 UNDER LEWISBURG-OZIAS RD.

TYPE: CONTINUOUS STEEL BEAM WITH REINFORCED CONCRETE DECK AND SUBSTRUCTURE.

LENGTH OF SPANS: 57'-6"±, 82'-0"±, 82'-0"±, 57'-6"± MEASURED CENTER TO CENTER OF BEARINGS.

ROADWAY WIDTH: 24'-0" MEASURED F/F OF SAFETY CURBS.

DESIGN LOADING: CF-130 (57)

SKEW ANGLE: 06°00'00" LEFT FORWARD

ALIGNMENT: TANGENT

SUPERELEVATION: NONE, NORMAL CROWN

WEARING SURFACE: LATEX MOD. CONCRETE OVERLAY

APPROACH SLABS: AS-1-54 (25' LONG)

YEAR BUILT: 1960±

STRUCTURE FILE NO.: 6801536

KZF DESIGN
 DESIGN AGENCY
 ARCHITECTS | ENGINEERS | PLANNERS | CONSULTANTS
 1100 N. 10TH ST., SUITE 100, OMAHA, NE 68102
 TEL: 402.466.1111 FAX: 402.466.1112

DATE: 08/02/00
 REVIEWED: SJA
 DRAWN: MWL
 DESIGNED: DCK
 CHECKED: WBS

PREBLE COUNTY
 STA 18+58.24
 STA 21+41.76

KZF #18
 S I T E P L A N
 BRIDGE NO. PRE-70-1541
 I.R. 70 LEWISBURG-OZIAS RD.

PRE-70-0.00
 11 / 24
 270
 283

PROPOSED WORK

1. SEAL PIERS, PIER CAPS, WINGWALLS, ABUTMENTS, RAILING, AND DECK EDGES WITH EPOXY-URETHANE; COLOR SHALL BE FEDERAL COLOR STANDARD 17778.
2. UPGRADE APPROACH GUARDRAIL AND BRIDGE TERMINAL ASSEMBLIES TO CURRENT STANDARDS.
3. MAINTAIN EXISTING MINIMUM VERTICAL CLEARANCE.
4. INSTALL CONCRETE BARRIER PROTECTION AT PIERS 1 AND 3.
5. SEAL DECK AND APPROACH SLABS WITH GRAVITY-FED RESIN.
6. PATCH SUBSTRUCTURE CONCRETE.


REF: **REF**
REF: **REF**
USER: WJL
PROJECT: I.R. 70 UNDER JORDAN RD.
DATE: 08/10/2000
ACTIVE LEVELS ON: BELIEVS

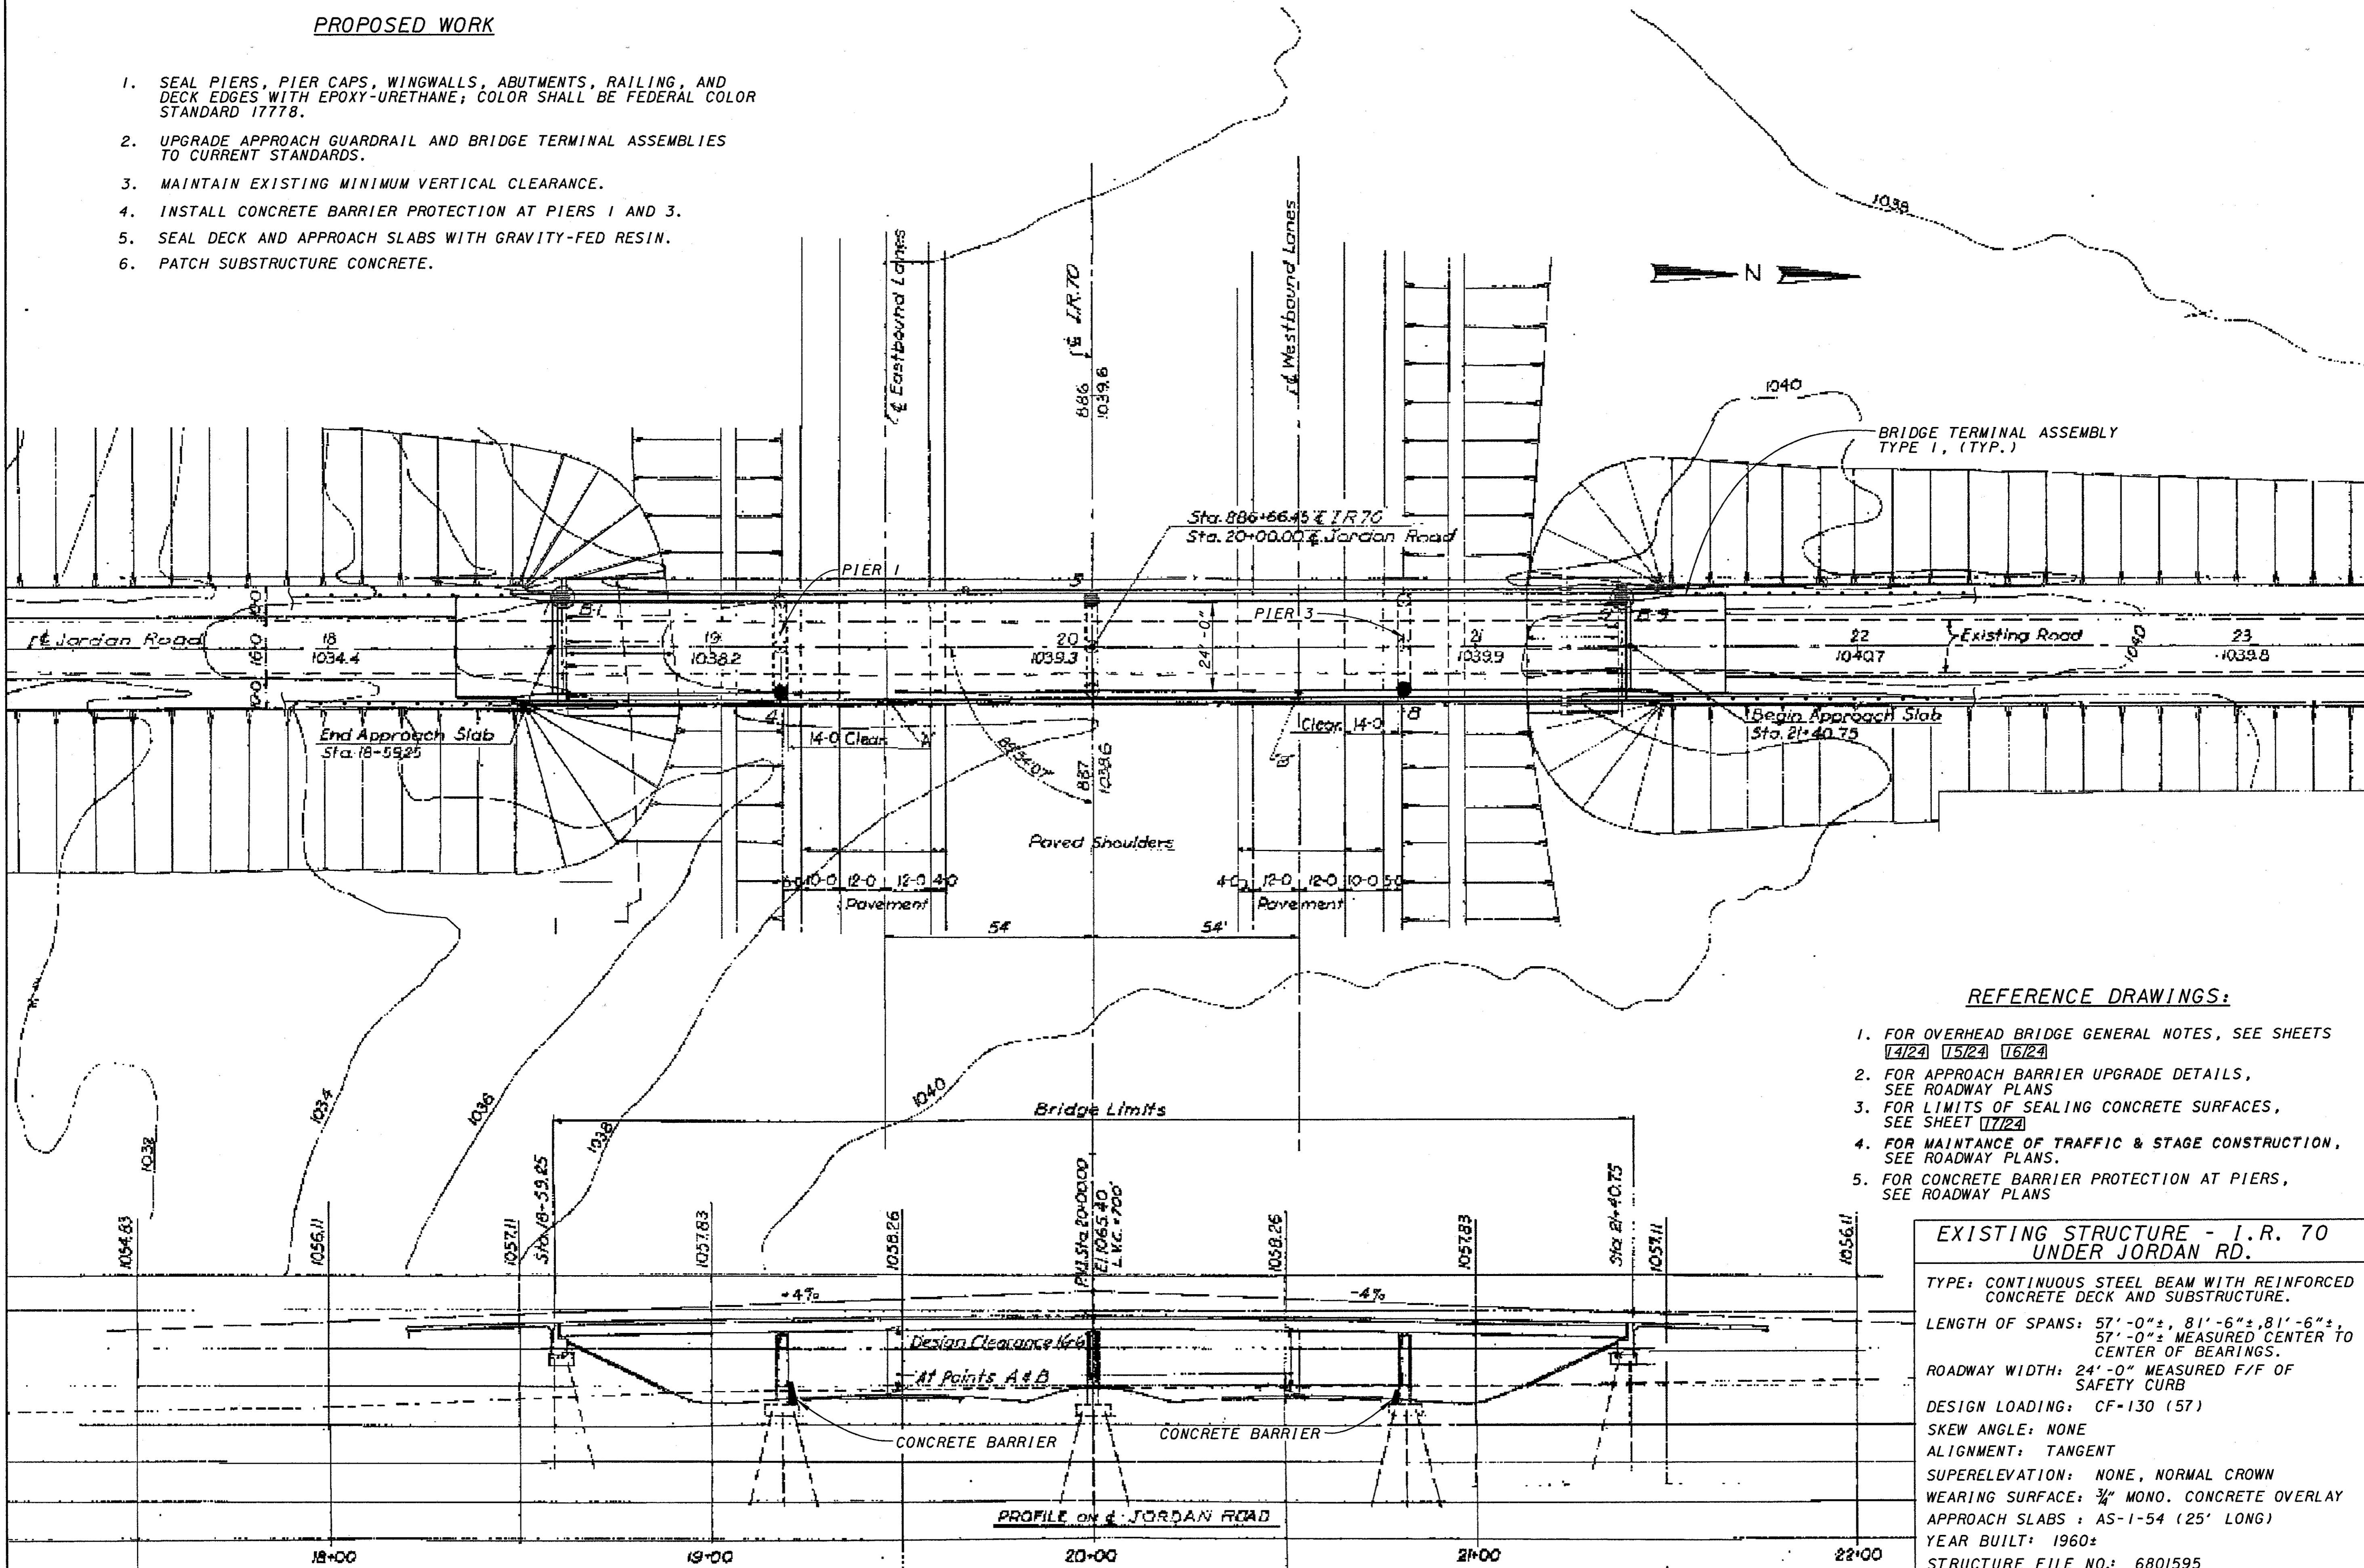

REFERENCE DRAWINGS:

1. FOR OVERHEAD BRIDGE GENERAL NOTES, SEE SHEETS 14/24 15/24 16/24
2. FOR APPROACH BARRIER UPGRADE DETAILS, SEE ROADWAY PLANS
3. FOR LIMITS OF SEALING CONCRETE SURFACES, SEE SHEET 17/24
4. FOR MAINTNANCE OF TRAFFIC & STAGE CONSTRUCTION, SEE ROADWAY PLANS.
5. FOR CONCRETE BARRIER PROTECTION AT PIERS, SEE ROADWAY PLANS


EXISTING STRUCTURE - I.R. 70 UNDER JORDAN RD.

TYPE: CONTINUOUS STEEL BEAM WITH REINFORCED CONCRETE DECK AND SUBSTRUCTURE.
 LENGTH OF SPANS: 57'-0"±, 81'-6"±, 81'-6"±
 57'-0"± MEASURED CENTER TO CENTER OF BEARINGS.
 ROADWAY WIDTH: 24'-0" MEASURED F/F OF SAFETY CURB
 DESIGN LOADING: CF-130 (57)
 SKEW ANGLE: NONE
 ALIGNMENT: TANGENT
 SUPERELEVATION: NONE, NORMAL CROWN
 WEARING SURFACE: 3/4" MONO. CONCRETE OVERLAY
 APPROACH SLABS: AS-1-54 (25' LONG)
 YEAR BUILT: 1960±
 STRUCTURE FILE NO.: 6801595

<p>KZF DESIGN Architectural Engineering Planning 1000 N. 10th Street, Suite 100 Tulsa, Oklahoma 74103 Tel: 918.438.1234</p>	DATE: 08/10/2000 REVIEWED: SJA DRAWN: MWL DESIGNED: DDK CHECKED: WBS
PREBLE COUNTY STA 18+59.25 STA 21+40.75	STRUCTURE FILE NUMBER KZF #20
S I T E P L A N BRIDGE NO. PRE-70-1665 I.R. 70 UNDER JORDON RD.	PRE-70-0.00 12/24 271 283


PROPOSED WORK

1. SEAL PIERS, PIER CAPS, WINGWALLS, ABUTMENTS, RAILING, AND DECK EDGES WITH EPOXY-URETHANE; COLOR SHALL BE FEDERAL COLOR STANDARD 17778.
2. INSPECT ALL BEARINGS AND REPOSITION OR REFURBISH IF NECESSARY. AT THE OPTION OF THE CONTRACTOR, BEARINGS SHALL BE EITHER REFURBISHED OR REPLACED.
3. EXTEND SCUPPERS SO THAT THE OUTLET IS 8" BELOW THE BOTTOM FLANGE.
4. UPGRADE APPROACH GUARDRAIL AND BRIDGE TERMINAL ASSEMBLIES TO CURRENT STANDARDS.
5. MAINTAIN EXISTING VERTICAL CLEARANCE.
6. INSTALL CONCRETE BARRIER PROTECTION AT PIERS 1 AND 3.
7. SEAL DECK AND APPROACH SLABS WITH GRAVITY-FED RESIN.
8. PAINT STRUCTURAL STEEL WITH SYSTEM OZEU, COLOR SHALL BE FEDERAL COLOR STANDARD 10324.
9. PATCH SUBSTRUCTURE CONCRETE.

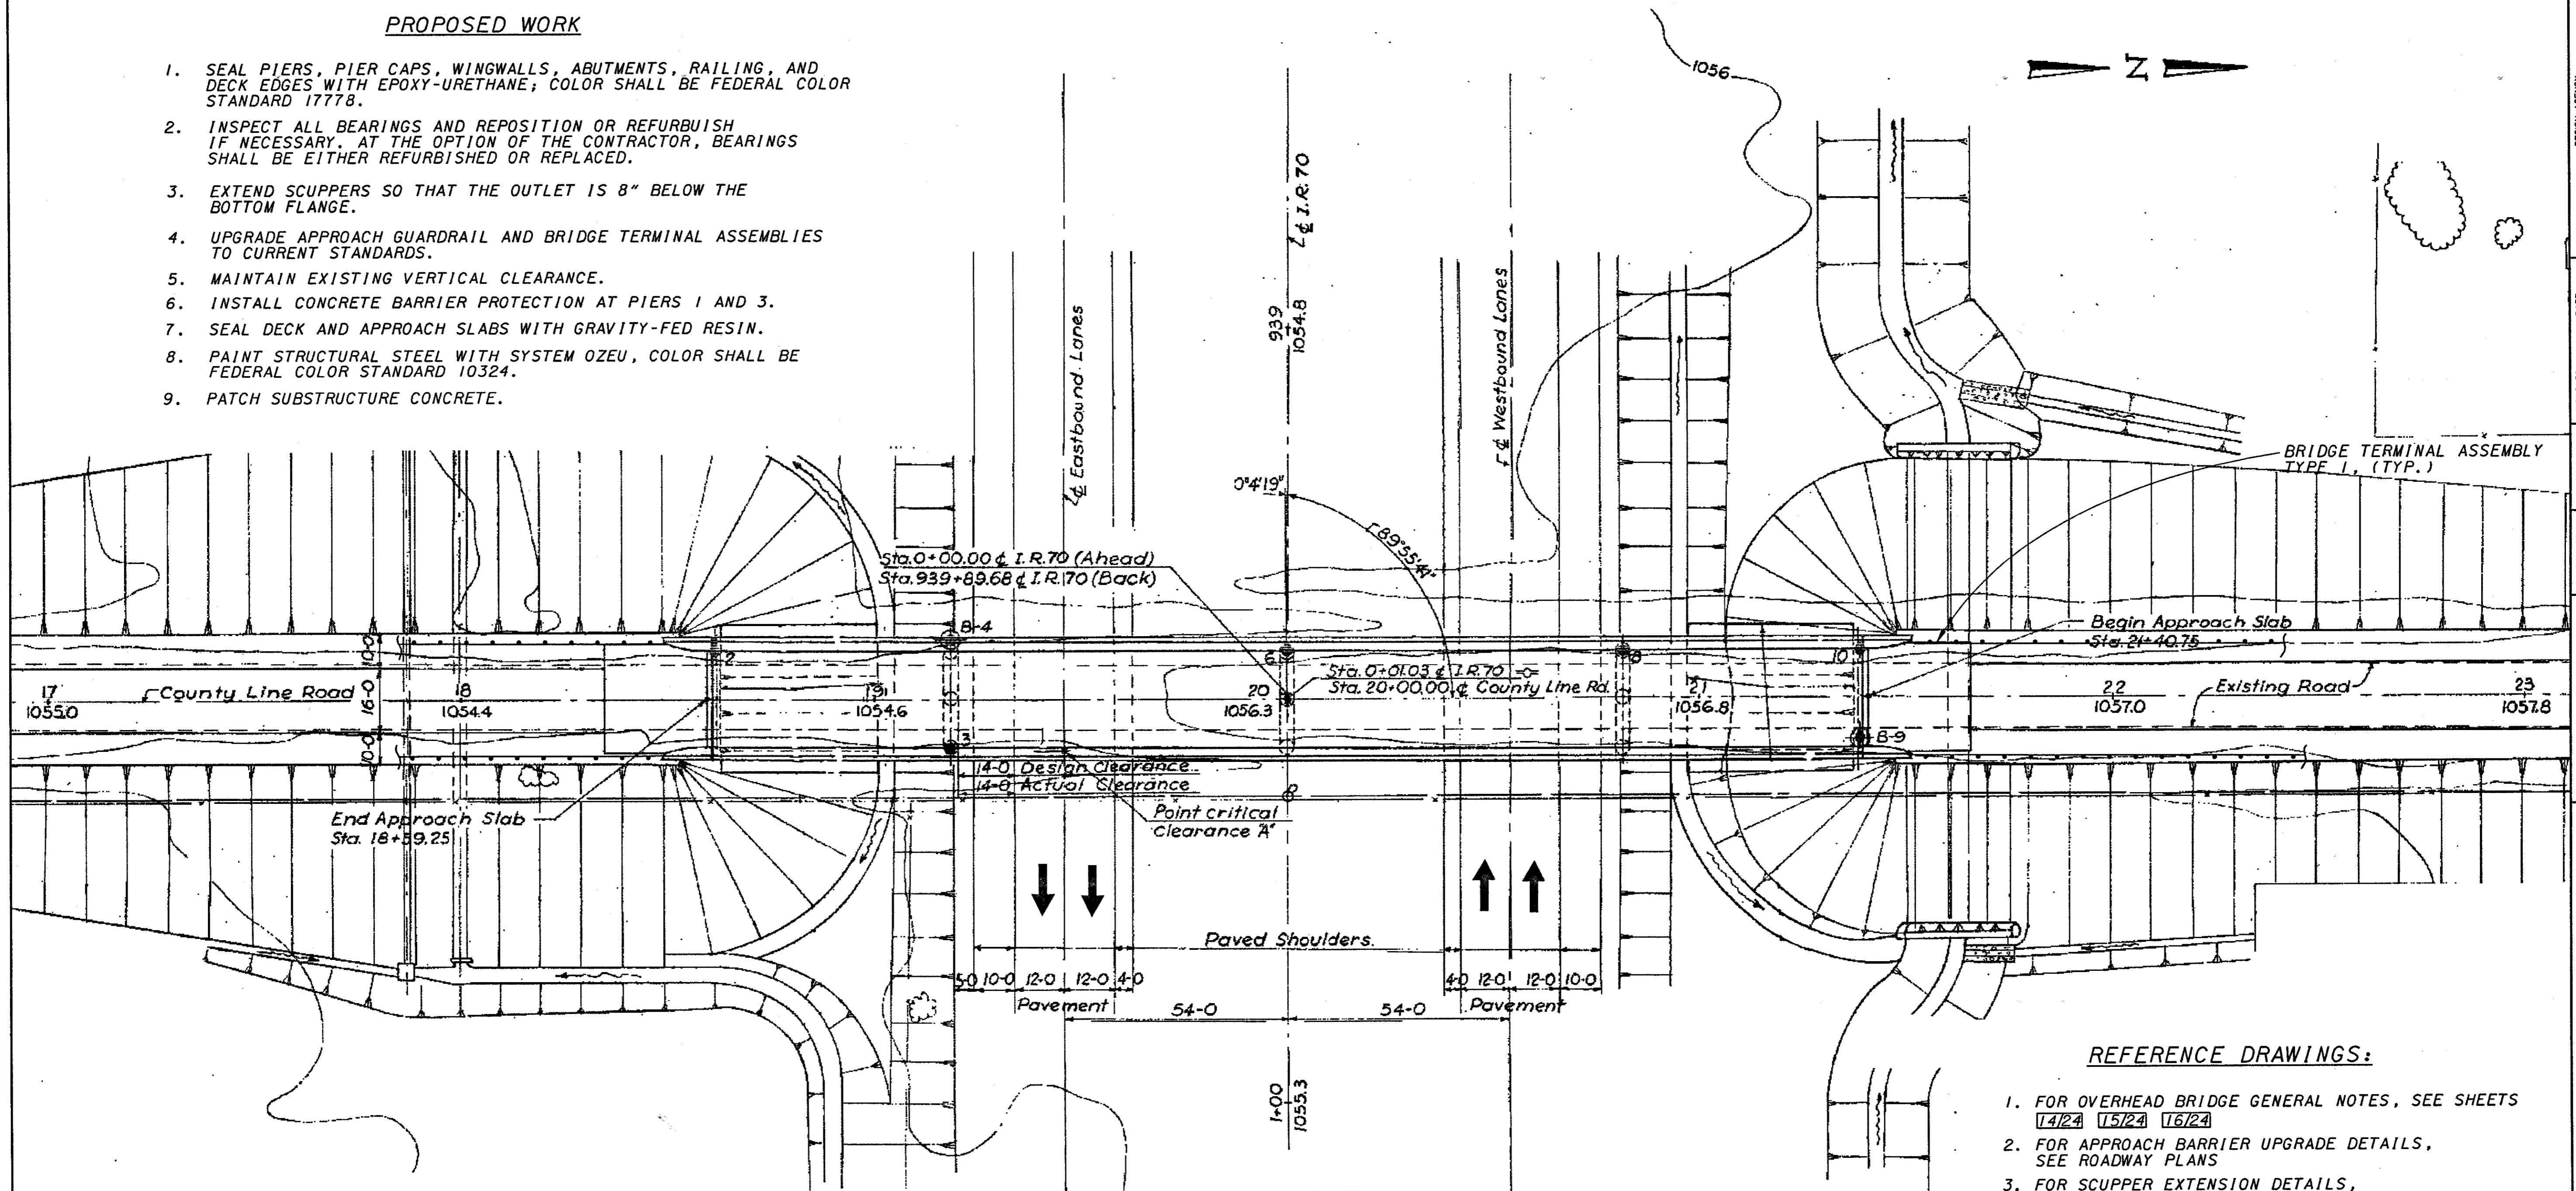

REFERENCE DRAWINGS:

1. FOR OVERHEAD BRIDGE GENERAL NOTES, SEE SHEETS 14/24 15/24 16/24
2. FOR APPROACH BARRIER UPGRADE DETAILS, SEE ROADWAY PLANS
3. FOR SCUPPER EXTENSION DETAILS, SEE SHEET 19/24
4. FOR LIMITS OF SEALING CONCRETE SURFACES, SEE SHEET 17/24
5. FOR MAINTANCE OF TRAFFIC & STAGE CONSTRUCTION, SEE ROADWAY PLANS.
6. FOR CONCRETE BARRIER PROTECTION AT PIERS, SEE ROADWAY PLANS

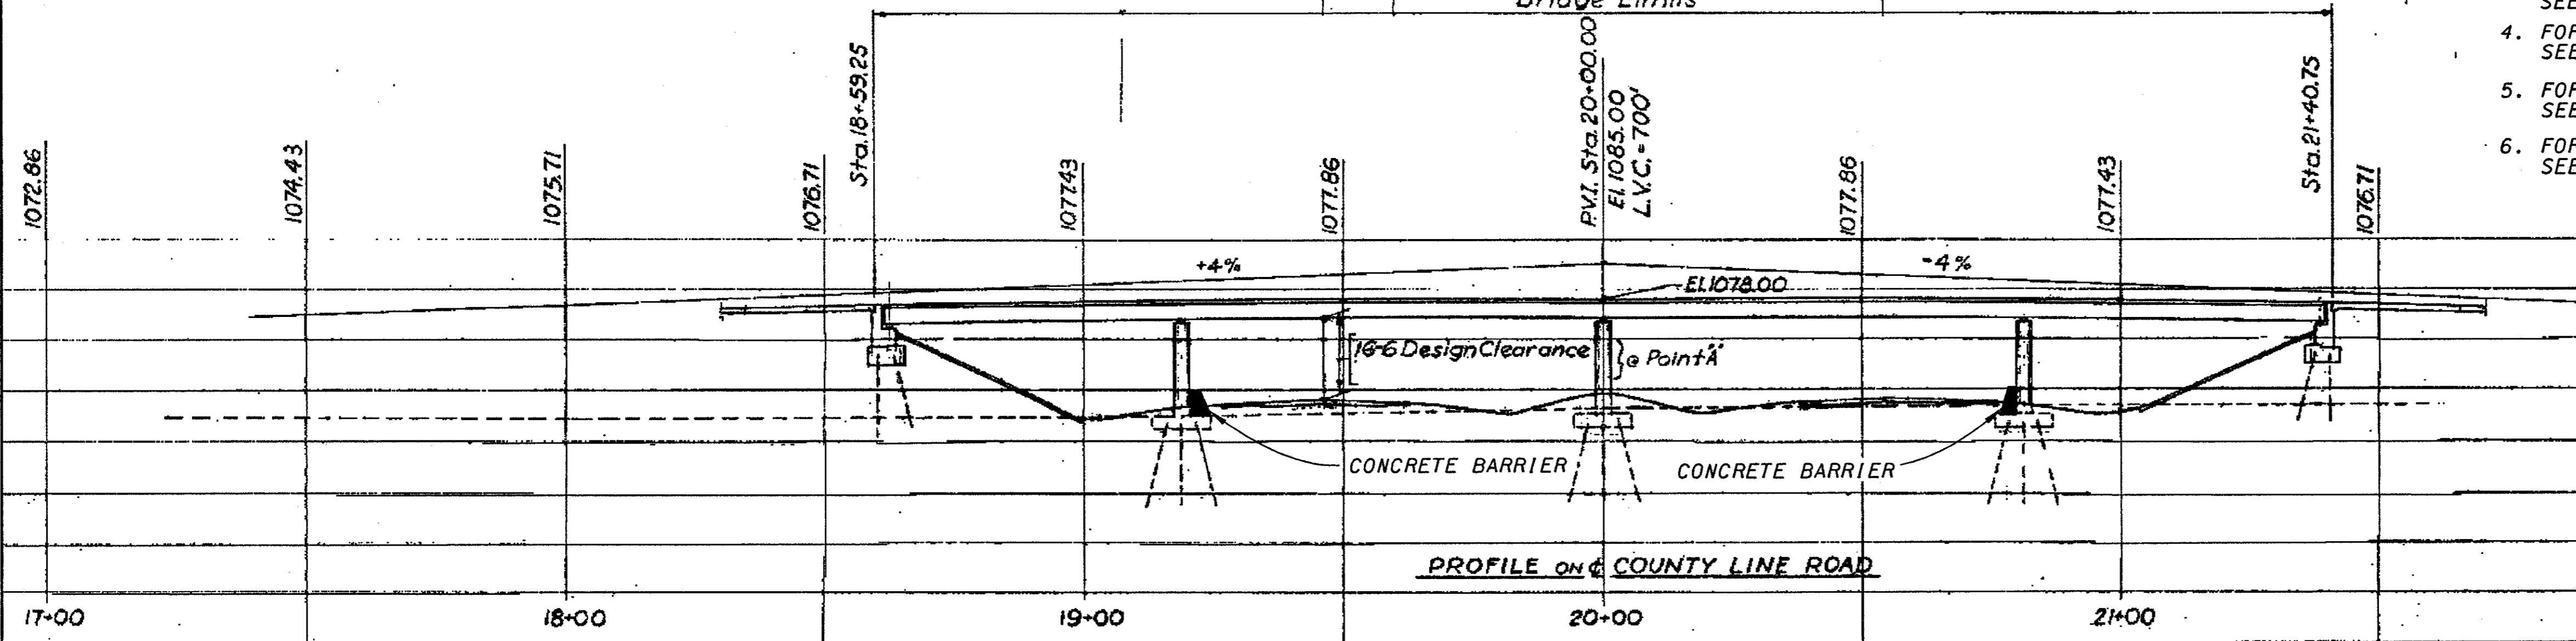

EXISTING STRUCTURE - I.R. 70 UNDER COUNTY LINE RD.

TYPE: CONTINUOUS STEEL BEAM WITH REINFORCED CONCRETE DCK AND SUBSTRUCTURE.
 LENGTH OF SPANS: 57'-0"±, 81'-6"±, 81'-6"±, 57'-0"± MEASURED CENTER TO CENTER OF BEARINGS.
 ROADWAY WIDTH: 24'-0" MEASURED F/F OF SATETY CURB
 DESIGN LOADING: CF=130 (57)
 SKEW ANGLE: NONE
 ALIGNMENT: TANGENT
 SUPERELEVATION: NONE, NORMAL CROWN
 WEARING SURFACE: 3/4" MONO. CONCRETE OVERLAY
 APPROACH SLABS: AS-1-54 (25' LONG)
 YEAR BUILT: 1960±
 STRUCTURE FILE NO.: 6801625

KZF DESIGN
 DESIGN AGENCY
 Architecture | Engineering | Interiors | Planning
 1000 N. 10th St., Suite 1000, Phoenix, AZ 85004
 TEL: 602.491.8871 WEB: www.kzf.com

DESIGNED	CHKD	DESIGNED	DATE
WBS	DGK	S/JA	08/02/00
CHECKED	REVISED	STRUCTURE FILE NUMBER	

PREBLE COUNTY
 STA 18+59.25
 STA 21+40.75

S I T E P L A N
 BRIDGE NO. PRE-70-1766
 I.R. 70 UNDER COUNTY LINE RD.

KZF #21

PRE-70-0.00

13 / 24

272
283

REFERENCE SHALL BE MADE TO THE FOLLOWING ODOT 1997 CONSTRUCTION AND MATERIAL SPECIFICATIONS:

ITEM 202 - REMOVAL OF STRUCTURES AND OBSTRUCTIONS.
ITEM 448 - ASPHALT CONCRETE
ITEM 508 - FALSEWORK AND FORMS.
ITEM 509 - REINFORCING STEEL.
ITEM 513 - STRUCTURAL STEEL.
ITEM 516 - EXPANSION AND CONTRACTION JOINTS, JOINT SEALER AND BEARING DEVICES.
ITEM 518 - DRAINAGE OF STRUCTURES
ITEM 519 - PATCHING CONCRETE STRUCTURE.

REFERENCE SHALL BE MADE TO THE FOLLOWING ODOT SUPPLEMENTAL SPECIFICATIONS:

815 DATED 5/30/96 - FIELD PAINTING OF EXISTING STEEL, SYSTEM OZEU.
842 DATED 1/6/99 - CONCRETE FOR STRUCTURES.
899 DATED 10/21/98 - CONCRETE - GENERAL
910 DATED 7/28/98 - OZEU STRUCTURAL STEEL PAINT.

REFERENCE SHALL BE MADE TO THE FOLLOWING ODOT STANDARD DRAWINGS:

EXJ - 4-87 REVISED 2-14-97
RB - 1- 55 REVISED 2-2-59

REFERENCE SHALL BE MADE TO THE FOLLOWING ODOT PROPOSAL NOTES:

NO. 515 - TREATING CONCRETE BRIDGE DECKS WITH GRAVITY FED RESIN - 11/15/94.
NO. 550 - FIELD PAINTING OF EXISTING STEEL USING EPOXY AND URETHANE (EEU) - 7/20/92
REFERENCE SHALL BE MADE TO THE FOLLOWING ODOT PROJECT 3003 PROPOSAL NOTES:

PAGE 31 - BRIDGE DECK REPAIR AND OVERLAY WITH MICRO-SILICA CONCRETE USING HYDRODEMOLITION - 4/15/96.
PAGE 42 - BRIDGE DECK REPAIR AND OVERLAY WITH MICRO - SILICA MODIFIED CONCRETE - 4/15/96.
PAGE 48 - PATCHING CONCRETE BRIDGE DECKS - 9/25/91.
PAGE 50 - SEALING OF CONCRETE SURFACES - 4/14/93.

DESIGN STRESSES:

CLASS S CONCRETE - COMPRESSIVE STRENGTH 4500 PSI (28 DAY) (PARAPETS)
CLASS C CONCRETE - COMPRESSIVE STRENGTH 4000 PSI (28 DAY) (SUBSTRUCTURE)
STRUCTURAL STEEL - ASTM-A36-YIELD STRENGTH 36,000 PSI
REINFORCING STEEL - ASTM A615, A616, OR A617. EPOXY COATED GRADE 60 - MINIMUM YIELD STRENGTH 60,000 PSI.

EXTEND SCUPPERS SO THAT THE OUTLET IS 8" BELOW THE BOTTOM FLANGE.

FURNISH AND INSTALL MATERIALS NECESSARY TO EXTEND SCUPPERS TO AN ELEVATION WHERE THE SCUPPER OUTLET IS LOCATED 8 INCHES BELOW THE BOTTOM FLANGE OF THE ADJACENT BRIDGE BEAM.
REFER TO SCUPPER DETAILS ON SHEET 19/24.

REFURBISHING BEARING DEVICES

THIS ITEM SHALL INCLUDE ALL WORK NECESSARY TO PROPERLY ALIGN BRIDGE BEARINGS AS WELL AS THEIR CLEANING AND PAINTING. INCLUDED WITH THIS ITEM THE CONTRACTOR SHALL PERFORM THE FOLLOWING WORK ITEMS: DISASSEMBLY OF THE BEARINGS; HAND TOOL CLEANING (GRINDING IF NECESSARY); PAINTING WITH OZEU; REPLACEMENT OF ANY DAMAGED SHEET LEAD WITH PRE-FORMED BEARING PADS (SEE ODOT SPEC SECTION 711.21); INSTALLATION OF ANY NECESSARY STEEL SHIMS OF THE SAME SIZE AS THE BEARINGS TO PROVIDE A SNUG FIT; REALIGNMENT OF THE UPPER BEARING PLATE BY REMOVING EXISTING WELDS; RE-WELDING SO THAT THE BEARINGS ARE VERTICALLY ALIGNED AT 60* F; LUBRICATING SLIDING SURFACES; AND RE-ASSEMBLY OF THE BEARINGS. THE CONTRACTOR SHALL ASSURE ALL BEARINGS ARE SHIMMED ADEQUATELY AND THAT NO BEAMS AND/OR BEARING DEVICES ARE "FLOATING". AT THE OPTION OF THE CONTRACTOR AND AT NO ADDITIONAL COST TO THE STATE, NEW BEARINGS OF THE SAME TYPE AS THE EXISTING MAY BE INSTALLED IN PLACE OF REFURBISHING THE BEARINGS. ALL WORK SHALL BE PERFORMED TO THE SATISFACTION OF THE ENGINEER.

JACKING AND TEMPORARY SUPPORT OF SUPERSTRUCTURE TO ENABLE PERFORMANCE OF BEARING REFURBISHMENT.

THIS ITEM SHALL CONSIST OF FURNISHING ALL NECESSARY LABOR, MATERIALS, AND EQUIPMENT TO RAISE OR RE-POSITION ANY EXISTING STRUCTURES TO THE DIMENSIONS AND REQUIREMENTS DEFINED IN THE PROJECT PLANS AND TO ENABLE REFURBISHMENT OF PROJECT OVERHEAD BRIDGE BEARINGS. THE CONTRACTOR SHALL BE RESPONSIBLE FOR THE DESIGN, INSTALLATION AND OPERATION OF AN ADEQUATE JACKING SYSTEM, INCLUDING ANY TEMPORARY OR PERMANENT SUPPORTS NECESSARY TO PERFORM THE WORK DESCRIBED IN THE PROJECT

SUBMITTAL REQUIREMENTS:

THREE (3) SETS OF JACKING PLANS CONSISTING OF AT LEAST THE INFORMATION REQUESTED BY THIS NOTE SHALL BE SUBMITTED TO THE DIRECTOR FOR APPROVAL AT LEAST THIRTY (30) DAYS BEFORE ACTUAL WORK IS SCHEDULED TO BEGIN. THE PLANS SHALL BE PREPARED AND STAMPED BY AN OHIO REGISTERED PROFESSIONAL ENGINEER. JACKING SUBMITTALS SHALL INCLUDE AT LEAST THE FOLLOWING:

1. THE SIGNATURE AND NUMBER, OR PROFESSIONAL SEAL, OF THE OHIO REGISTERED PROFESSIONAL ENGINEER WHO PREPARED THE SUBMITTAL.
2. CALCULATIONS AND ANALYSES OF THE STRUCTURE TO DETERMINE AND DEFINE THE ACTUAL LOADING APPLIED AT THE CONTRACTOR'S SELECTED JACKING POINTS.
3. A DRAWING SHOWING THE PHYSICAL AND DIMENSIONAL POSITION OF THE JACKS WITH RESPECT TO THE STRUCTURE INCLUDING CLEARANCES AND CENTER OF LIFT.
4. A SCHEMATIC LAYOUT OF JACKS, CHECK VALVES, PUMPS WITH 3-WAY RETRACTOR VALVES, PRESSURE GAGES, FLOW CONTROL VALVES, ETC. IN ACCORDANCE WITH MANUFACTURER'S RECOMMENDATIONS. ALL JACKS FOR EACH ABUTMENT OR PIER SHALL BE CONNECTED TOGETHER. ALL JACKS AT EACH ABUTMENT OR PIER SHALL BE THE SAME SIZE.
5. ANALYSIS AND CALCULATIONS OF THE STRESSES INDUCED OR CREATED IN THE STRUCTURE AND ANY TEMPORARY OR PERMANENT SUPPORTS. DESIGN CALCULATIONS FOR ANY TEMPORARY OR PERMANENT SUPPORTS.
6. PHYSICAL DIMENSIONS, MATERIALS, AND FABRICATION DETAILS OF ANY TEMPORARY OR PERMANENT SUPPORTS. HORIZONTAL AND VERTICAL MOVEMENT RESTRAINT SHALL BE PROVIDED.
7. A STEP BY STEP PROCEDURE DETAILING ALL STEPS IN THE JACKING OPERATION.
8. A METHOD OF ATTACHMENT TO STRUCTURAL MEMBERS. WELDING TO TENSION AREAS SHALL NOT BE PERMITTED.

JACKING PLAN

THE CONTRACTOR'S PROPOSED PLAN OF STRUCTURE JACKING PERFORMANCE SHALL BE IN CONFORMANCE WITH THE FOLLOWING ITEMS:

1. THE ENTIRE SYSTEM INCLUDING JACKS SHALL PROVIDE 20% MORE CAPACITY THAN REQUIRED BASED ON CALCULATED LOADS.
2. FOR LIFTS GREATER THAN 1 INCH, JACKS SHALL HAVE LOCKING NUTS TO POSITIVELY LOCK AND SUPPORT THE STRUCTURE DURING THE LIFT.
3. JACKS SHALL HAVE A SWIVEL LOAD CAP, A DOMED PISTON HEAD, OR SOME OTHER DEVICE TO PROTECT AGAINST THE EFFECTS OF SIDE LOAD ON THE JACK.
4. JACKS ALONE SHALL NOT BE USED TO SUPPORT LOADS EXCEPT DURING THE ACTUAL JACKING OPERATION. TEMPORARY SUPPORTS, BLOCKING, OR OTHER METHODS APPROVED BY THE DIRECTOR SHALL BE USED.
5. SINGLE ACTING RAMS WITH NO OVER-TRAVEL PROTECTION SYSTEM SHALL NOT BE USED.
6. SPARE EQUIPMENT SHALL BE AVAILABLE ON SITE FOR THE REQUIRED STRUCTURE RAISING TO PROCEED IN THE EVENT OF BREAKDOWN. A LIST OF SPARE EQUIPMENT SHALL BE PROVIDED TO THE ENGINEER.
7. AT A MINIMUM, A JACKING OPERATION SHALL LIFT ALL BEAMS AT ANY ONE ABUTMENT OR PIER SIMULTANEOUSLY. THE ONLY EXCEPTION IS THE SITUATION WHERE ALL THREE OF THE FOLLOWING ELEMENTS APPLY: THE WORK INVOLVES REPLACING OR REHABILITATING INDIVIDUAL BEARINGS, NO PERMANENT SHIMMING IS REQUIRED, AND THE HEIGHT OF THE LIFT SHALL NOT EXCEED 1/4 INCH. MAXIMUM DIFFERENTIAL JACKING HEIGHT BETWEEN ANY ADJACENT ABUTMENTS OR PIERS SHALL BE 1 INCH OR LESS. THIS HEIGHT MAY BE MODIFIED IF CALCULATIONS, BY THE CONTRACTOR'S OHIO REGISTERED PROFESSIONAL ENGINEER, SHOW THE SUPERSTRUCTURE COMPONENTS WILL NOT BE TEMPORARILY STRESSED BEYOND ALLOWABLE STRESSES FOR THOSE COMPONENTS AND THAT NO PERMANENT STRESSES WILL BE INDUCED IN THE COMPONENTS AFTER THEY OBTAIN THEIR FINAL POSITION.

IF, DURING THE JACKING OPERATIONS, CRACKING OF THE CONCRETE SUPERSTRUCTURE, SEPARATION OF THE CONCRETE DECK FROM THE STEEL STRINGERS, OR OTHER DAMAGE TO THE STRUCTURE IS VISUALLY OBSERVED, THE JACKING OPERATION SHALL IMMEDIATELY CEASE AND APPROVED SUPPORTS SHALL BE INSTALLED. THE CONTRACTOR SHALL THEN ANALYZE THE DAMAGE AND SUBMIT A METHOD OF CORRECTION TO THE ENGINEER FOR APPROVAL. ANY BEAMS THAT SEPARATE FROM THE DECK SHALL BE EPOXY INJECTED FOR THE DISTANCE OF THE SEPARATION IN ACCORDANCE WITH ODOT'S PROPOSAL NOTE "CONCRETE REPAIR BY EPOXY INJECTION". COST OF THIS EPOXY INJECTION OR OTHER REQUIRED REPAIRS SHALL BE BORNE BY THE CONTRACTOR.

THE CONTRACTOR SHALL DEMONSTRATE TO THE ENGINEER THAT THE BRIDGE BEARINGS ARE FULLY SEATED AT ALL CONTACT AREAS. IF FULL SEATING IS NOT ATTAINED, SUITABLE MEANS OF REPAIR, SUBJECT TO THE ENGINEER'S APPROVAL, WILL BE REQUIRED AT THE CONTRACTOR'S EXPENSE.

REMOVE AND REPLACE STRIP SEALS AT EXPANSION JOINTS

BRIDGES #2, #4, & #7

PROVIDE ALL LABOR AND MATERIALS TO REMOVE AND INSTALL A NEW 3" STRIP SEAL AT EXPANSION JOINTS. THIS WORK SHALL BE PERFORMED IN ACCORDANCE WITH THE NOTES AND SPECIFICATIONS ON STANDARD AND DRAWING EXJ-4-87 (SHEET 5 OF 5)

ITEM 509 REINFORCING STEEL, REPLACEMENT OF EXISTING REINFORCING STEEL

ANY EXISTING REINFORCING BARS WHICH ARE TO BE INCORPORATED INTO THE NEW WORK AND ARE MADE UNUSABLE BY CONCRETE REMOVAL OPERATIONS SHALL BE REPLACED WITH NEW STEEL AT THE CONTRACTOR'S COST.

ANY EXISTING REINFORCING BARS DEEMED BY THE ENGINEER TO BE UNUSABLE BECAUSE OF CORROSION SHALL BE REPLACED WITH NEW STEEL

PROTECTION OF TRAFFIC: PRIOR TO DEMOLITION OF ANY PORTIONS OF THE EXISTING SUPERSTRUCTURE, THE CONTRACTOR SHALL SUBMIT HIS PLANS FOR THE PROTECTION OF TRAFFIC (VEHICULAR, PEDESTRIAN, BOAT, ETC.) ADJACENT TO AND/OR UNDER THE STRUCTURE TO THE DIRECTOR FOR APPROVAL.

THESE PLANS SHALL INCLUDE PROVISIONS FOR ANY DEVICES AND STRUCTURES THAT MAY BE NECESSARY TO ENSURE SUCH PROTECTION. TEMPORARY VERTICAL CLEARANCES SPECIFIED ON THE PLANS OR IN THE PROPOSAL SHALL BE MAINTAINED AT ALL TIMES EXCEPT AS OTHERWISE APPROVED BY THE DIRECTOR.

CUT LINE CONSTRUCTION JOINT PREPARATION:

SAW CUT BOUNDARIES OF PROPOSED CONCRETE REMOVALS 1" DEEP. REMOVE CONCRETE TO A ROUGH SURFACE. WHERE PRACTICABLE, THE EXISTING REINFORCING STEEL WHERE REQUIRED IN THE PLANS SHALL BE LEFT IN PLACE. INSTALL DOWEL BARS IF SPECIFIED. PRIOR TO CONCRETE PLACEMENT ABRASIVELY CLEAN JOINT SURFACE AND EXPOSED REINFORCEMENT TO REMOVE LOOSE AND DISINTEGRATED CONCRETE AND LOOSE RUST. THE JOINT SURFACE AND EXPOSED REINFORCEMENT SHALL BE THOROUGHLY CLEANED OF ALL DIRT, DUST, OR OTHER FOREIGN MATERIAL BY THE USE OF WATER, AIR UNDER PRESSURE, OR OTHER METHODS THAT PRODUCE SATISFACTORY RESULTS. CONCRETE BONDING SURFACES SHALL BE WET WITHOUT FREE WATER AS CONCRETE IS PLACED.

SUBSTRUCTURE CONCRETE REMOVAL: SHALL BE BY MEANS OF APPROVED PNEUMATIC HAMMERS EMPLOYING POINTED AND BLUNT CHISEL TOOLS. HYDRAULIC HOE-RAM TYPE HAMMERS WILL NOT BE PERMITTED. THE WEIGHT OF THE HAMMER SHALL NOT BE MORE THAN 35 POUNDS FOR REMOVAL WITHIN 18 INCHES OF PORTIONS TO BE PRESERVED. OUTSIDE THE 18 INCH LIMIT, A HAMMER HEAVIER THAN 35 POUNDS, BUT NOT TO EXCEED 90 POUNDS, MAY BE USED UPON THE APPROVAL OF THE ENGINEER. PNEUMATIC HAMMERS SHALL NOT BE PLACED IN DIRECT CONTACT WITH REINFORCING STEEL THAT IS TO BE RETAINED IN THE REBUILT STRUCTURE.

SEAL EXISTING SLIDING PLATE EXPANSION JOINT WITH JOINT SEALER.
BRIDGE #15 AND #18

THIS WORK SHALL CONSIST OF PROVIDING ALL NECESSARY LABOR, MATERIALS AND EQUIPMENT TO CLEAN AND SEAL EXISTING SLIDING JOINTS.

THE SEALANT SHALL BE DOW CORNING #902 SEALANT (ONE PART/NON SAG/MED. MODULUS) AS MANUFACTURED BY DOW CORNING, ALL STATE CAULKING, COLUMBUS, OHIO (614-554-1528); OR APPROVED EQUIVALENT.

JOINTS SHALL BE THOROUGHLY CLEANED BY SANDBLASTING AND/ OR POWER TOOLS AND WITH A SUFFICIENT AMOUNT OF COMPRESSED AIR TO REMOVE ANY DIRT, OR DELETERIOUS MATTER. WHEN THE SURFACES ARE THOROUGHLY CLEAN AND DRY, AND JUST PRIOR TO PLACING THE JOINT SEALER, COMPRESSED AIR HAVING A PRESSURE OF AT LEAST 90 P.S.I. SHALL BE USED TO BLOW OUT THE JOINT AND REMOVE ALL TRACES OF DUST.

THE JOINT SHALL BE THOROUGHLY DRY WHEN THE SEALANT IS PLACED. AFTER CLEANING AND DRYING, A BOND-BREAKER MATERIAL SHALL BE APPLIED TO THE BOTTOM OF THE JOINT.

THE SILICONE SEALANT MATERIALS SHALL BE INSTALLED AS PER MANUFACTURER'S RECOMMENDATIONS, EXCEPT AS MODIFIED BY THESE NOTES. THE SEALANT SHALL BE INSTALLED WHEN THE AMBIENT TEMPERATURE IS 40 DEGREES F OR HIGHER. TRAFFIC SHALL NOT BE ALLOWED ON THE JOINT FOR ONE HOUR AFTER APPLICATION OF THE SEALANT.

FIELD PAINTING OF EXISTING STRUCTURAL STEEL.

ON THOSE BRIDGES REQUIRING FIELD PAINTING THE WORK SHALL BE PERFORMED IN ACCORDANCE WITH THE STATE OF OHIO DEPARTMENT OF TRANSPORTATION SUPPLEMENTAL SPECIFICATION 815 DATED MAY 30, 1996. ALL EXPOSED SURFACES OF BEAMS, CROSS FRAMES, SCUPPERS, DRAINS, AND BEARINGS SHALL BE PAINTED. FINISH COAT COLOR SHALL BE FEDERAL COLOR STANDARD 10324 (DARK NEUTRAL). ALL PAINTING SHALL BE PERFORMED IN ACCORDANCE WITH THE PROJECT STAGING AND THE MAINTENANCE OF TRAFFIC PLANS.

PATCH CONCRETE RAILING.

PATCHING CONCRETE RAILING SHALL BE PERFORMED IN ACCORDANCE WITH THE STATE OF OHIO DEPARTMENT OF TRANSPORTATION CONSTRUCTION AND MATERIAL SPECIFICATIONS ITEM 519 PATCHING CONCRETE STRUCTURES. THE LOCATION AND SURFACE AREA EXTENT OF PATCHING CONCRETE STRUCTURES SHALL BE FIELD-DETERMINED BY THE ODOT PROJECT ENGINEER.

PATCH SUBSTRUCTURE CONCRETE.

PATCHING SUBSTRUCTURE CONCRETE SHALL BE PERFORMED IN ACCORDANCE WITH THE STATE OF OHIO DEPARTMENT OF TRANSPORTATION CONSTRUCTION AND MATERIAL SPECIFICATIONS ITEM 519 PATCHING CONCRETE STRUCTURES. THE LOCATION AND SURFACE AREA EXTENT OF PATCHING CONCRETE STRUCTURES

SHALL BE FIELD-DETERMINED BY THE ODOT PROJECT ENGINEER. THE CONTRACTOR SHALL PROVIDE THE PROJECT ENGINEER ACCESS TO CONCRETE SURFACES FOR INSPECTION. THE CONTRACTOR SHALL PROVIDE THE ENGINEER AEROSOL PAINT FOR THE PURPOSE OF MARKING SUBSTRUCTURE CONCRETE TO BE PATCHED.

REMOVE THE EXISTING CONCRETE OVERLAY AND REPLACE WITH A NEW MICRO-SILICA CONCRETE OVERLAY. THIS NOTE REFERS TO BRIDGES 2, 3, AND 16.

REMOVE THE EXISTING CONCRETE WEARING SURFACE AND REPLACE WITH A NEW MICRO-SILICA CONCRETE OVERLAY. THIS NOTE REFERS TO BRIDGE 7 ONLY.

THIS WORK SHALL CONSIST OF FURNISHING ALL NECESSARY LABOR, MATERIALS AND EQUIPMENT TO REMOVE THE EXISTING CONCRETE SURFACE AND OVERLAY THE SPECIFIED CONCRETE BRIDGE DECKS IN ACCORDANCE WITH THE PROJECT PROPOSAL DOCUMENT (PAGES 31-50). REMOVAL DEPTHS AND OVERLAY THICKNESS OF THE DESIGNATED BRIDGES ARE SHOWN ON THE BRIDGE OVERLAY DETAIL SHEET.

SEAL DECK AND APPROACH SLABS WITH GRAVITY-FED RESIN.

THE SPECIFIED WORK SHALL BE PERFORMED ACCORDING TO THE STATE OF OHIO DEPARTMENT OF TRANSPORTATION PROPOSAL NOTE NUMBERED 515, TREATING CONCRETE BRIDGE DECKS (AND APPROACH SLABS WHERE INDICATED) WITH GRAVITY-FED RESIN.

SEAL PIERS, PIER CAPS, WINGWALLS, ABUTMENTS, RAILING, AND DECK EDGES WITH EPOXY-URETHANE; COLOR SHALL BE FEDERAL COLOR STANDARD 17778.

THIS WORK SHALL CONSIST OF FURNISHING ALL NECESSARY LABOR, MATERIALS AND EQUIPMENT TO SEAL THE DESIGNATED EXPOSED CONCRETE SURFACE AREAS IN ACCORDANCE WITH THE PROJECT PROPOSAL DOCUMENT (PAGE 30) ENTITLED, ITEM SPECIAL - SEALING OF CONCRETE SURFACES.

MAINTAIN EXISTING MINIMUM VERTICAL CLEARANCE

CONTRACTOR TO DETERMINE MINIMUM VERTICAL CLEARANCE FOR ALL OVERHEAD BRIDGES. THIS CLEARANCE SHALL BE MAINTAINED (EASTBOUND AND WESTBOUND) AND PROPER ADJUSTMENTS MADE FOR THE OVERLAY ON I-70. THIS WILL REQUIRE SOME ADDITIONAL PAVEMENT PLANNING. BRIDGES #16 AND #18 REQUIRE ADDITIONAL CLEARANCE ABOVE THE EXISTING AND EVEN MORE PLANNING WILL BE REQUIRED. SEE ROADWAY PLANS FOR ADDITIONAL DETAILS. RAISING OF OVERHEAD BRIDGES IS NOT REQUIRED.

ASBESTOS ABATEMENT

THE CONTRACTOR SHALL CONDUCT ASBESTOS INSPECTIONS OF ALL BRIDGES SUBJECT TO RENOVATION OR DEMOLITION AS PER CHAPTER 3745-20 OF THE OHIO ADMINISTRATIVE CODE (OAC) "ASBESTOS EMISSIONS CONTROL FROM RENOVATION/DEMOLITION AND WASTER DISPOSAL OPERATION" MAY 29, 1990 UTILIZING A CERTIFIED OHIO ASBESTOS HAZARD EVALUATION SPECIALIST. SHOULD SUSPECT ASBESTOS CONTAINING MATERIAL (ACM) BE ENCOUNTERED; PERFORM BULK SAMPLING AND ANALYSIS. PREPARE A LETTER REPORT (1-2 PAGES) INCLUDING A BRIEF DISCUSSION OF THE INSPECTION AND SAMPLING METHODOLOGY, MAPPING INDICATING THE BRIDGE LOCATION AND SAMPLING LOCATIONS, AND ANALYTICAL TEST RESULTS.

THE CONTRACTOR SHALL COMPLETE AN OEPA NOTIFICATION OF DEMOLITION AND RENOVATION FORM AND SUBMIT THIS TO THE OHIO EPA AT LEAST 10 WORKING DAYS BEFORE OPERATIONS BEGIN.

AS THESE INSPECTION REPORTS AND NOTIFICATION FORMS ARE COMPLETED, COPIES SHALL BE FORWARD TO ODOT'S ON SITE PROJECT ENGINEER.

PAYMENT OF THE ABOVE WORK SHALL BE INCLUDED IN THE LUMP SUM BID FOR EACH BRIDGE.

SHOULD ASBESTOS CONTAINING MATERIAL BE ENCOUNTERED, ALL SUSPECT MATERIALS SHALL BE REMOVED AND PROPERLY DESPOSED OF BY A CERTIFIED ASBESTOS REMOVAL CONTRACTOR IN ACCORDANCE WITH OAC 3745-20. AN INDIVIDUAL TRAINED IN THE PROVISIONS OF NESHAPS (30 CFR PART 61, SUBPART M) WILL BE ON SITE DURING THE DEMOLITION OR RENOVATION OF ANY STRUCTURE WITH ACM AND EVIDENCE THAT THE REQUIRED TRAINING HAS BEEN ACCOMPLISHED BY THIS PERSON WILL BE AVAILABLE DURING NORMAL BUSINESS HOURS.

ALL ASSOCIATED COSTS OF ASBESTOS MATERIALS TO BE REMOVED AND PROPERLY DISPOSED OF, WILL BE PAYED UNDER 'THIRD PARTY BILLING' PROVISIONS OF ODOT CHANGE ORDER POLICY 512-004(P) APPENDIX D.

REF: *REF1*
REF: *REF2*
REF: *REF3*
REF: *REF4*

REF: *REF1*
REF: *REF2*
REF: *REF3*
REF: *REF4*

PROPOSAL NOTE 550

FIELD PAINTING OF EXISTING STEEL, USING EPOXY AND URETHANE (EEU) - 07/20/92

GENERAL NOTES

THIS PAINTING PROJECT SHALL CONSIST OF:

1. A COMPLETE WASHDOWN OF ALL STEEL USING A POWER WASHER WITH 7,000 PSI MINIMUM AT NOZZLE WITH A FLOWRATE OF 3-4 GAL./MIN. NOZZLE TO BE HELD AT RIGHT ANGLES TO AND NO MORE THAN 12 INCH FROM THE STEEL SURFACE.
2. SOLVENT CLEANING AS NEEDED.
3. SPOT CLEANING TO REMOVE ALL RUST, MILL SCALE, UNSOUND PAINT, ETC., USING POWER TOOLS GUNS, DESCALERS, ABRASIVE WHEELS, DISCS, ROTARY IMPACT FLAPS, WIRE BRUSHES, ETC. (SEE SSPC 11-8TR) THE APPEARANCE OF THE SURFACE AFTER POWER TOOL CLEANING SHALL CORRESPOND TO PICTORIAL STANDARDS B ST 3, C ST 3 OR D ST 3.
4. A TEST SECTION TO VERIFY COMPATIBILITY OF PRIMER WITH EXISTING PAINT.
5. A SPOT PRIME USING AN APPROVED EPOXY MASTIC (5 MILS) MINIMUM.
6. A FULL PRIME (5 MILS) MINIMUM USING EPOXY MASTIC OVER ALL AREAS OF THE BRIDGE INCLUDING OVER SPOT PRIME. SPOT PRIME OR FULL PRIME SHALL BE TINTED TO CONTRAST WITH PREVIOUS COAT.
7. A COMPLETE TOP COAT USING A URETHANE (3 MILS) MINIMUM.
8. ALL PROVISIONS OF OZEU PROPOSAL NOTE WILL APPLY TO THIS PROJECT, EXCEPT THOSE WHICH DIRECTLY CONFLICT WITH THIS NOTE.
9. THE FOLLOWING EXCEPTIONS APPLY TO THIS PROJECT:
 - A. AREAS OF RUST, UNSOUND (PEELING, FLAKING) PAINT, ETC. SHALL BE REMOVED BY HANDTOOL OR POWER TOOL CLEANING. THE REMOVAL SHALL EXTEND OUT ADEQUATELY TO LEAVE ONLY SOUND, WELL BONDED EXISTING PAINT AND SHALL BE FEATHER EDGED 2 INCHES MIN. FROM BARE STEEL TO SOUND TOP COAT AROUND THE PERIMETER OF EACH SPOT CLEANED. THE INTENT OF THIS SPECIFICATION IS TO PROVIDE FOR CLEANING AND PAINTING OF THE BRIDGE(S) WITHOUT THE USE OF ABRASIVE BLASTING. THE CONTRACTOR MAY CHOOSE TO USE SELECTIVE ABRASIVE BLASTING ON THIS PROJECT IN CONJUNCTION WITH HANDTOOL CLEANING, HOWEVER, ANY ABRASIVE BLASTING MUST BE ACCOMPANIED WITH CONTAINMENT, COLLECTION, STORAGE, TESTING AND DISPOSAL OF ALL BLASTING DEBRIS IN ACCORDANCE WITH THE PROVISIONS OF OZEU AND WASTE CONTROL PROPOSAL NOTES, EXCEPT NO SEPARATE PAYMENT WILL BE MADE FOR WASTE CONTROL. VACUUM BLASTING WILL ALSO BE CONSIDERED ACCEPTABLE, PROVIDING ALL ABRASIVE IS RECYCLED.
 - B. MINIMUM MIL THICKNESS OF EACH COAT OF PAINT SHALL BE VERIFIED WITH A POSITECTOR.
 - C. PRIME COATS TO BE APPLIED BY BRUSH OR ROLLER (SUBJECT TO APPROVAL OF THE ENGINEER). AIRLESS SPRAY ALLOWED ONLY IF OVERSPRAY IS CONTAINED BY ENCLOSURES.

PAINT COMPATIBILITY TEST SECTION

BEFORE ANY PAINTING CAN BEGIN ON THIS BRIDGE (AND AT LEAST 24 HOURS PRIOR TO PAINTING), A 2' X 2' SECTION OF EXISTING SOUND PAINT SHALL BE REMOVED DOWN TO BARE METAL. THE PRIMER TO BE USED SHALL BE APPLIED TO THE TEST SECTION MAKING SURE THAT PRIMER OVERLAPS EXPOSED EDGES OF SOUND PAINT. ANY LIFTING, WRINKLING OR OTHER DETRIMENTAL EFFECTS ON THE SURROUNDING SOUND PAINT WITHIN THE FIRST 24 HOURS SHALL BE GROUNDS FOR DISAPPROVAL OF THE SELECTED PRIMER AND ANOTHER PRIMER SHALL BE SELECTED FOLLOWED BY ANOTHER TEST SECTION. THE COST OF THESE TEST SECTIONS SHALL BE INCLUDED FOR PAYMENT WITH SURFACE PREPARATION. COATINGS WHICH WILL BE ACCEPTABLE (PENDING ACCEPTABILITY OF TEST SECTIONS) ARE:

<p>THE CARBOLINE CO. 350 HANLEY INDUSTRIAL CT. ST. LOUIS, MO 63144</p> <p>PRIMER - CARBOMASTIC 15 TOP COAT - CARBOHANE D 134 HS</p> <p>POLYCARB VALSPAR CORP. 33095 BAINBRIDGE ROAD SOLON, OH 44139</p> <p>PRIMER - UFTRAPOX 11, MARK 60.1 TOP COAT - MARK 73 ULTRAKOTE THE SHERWIN-WILLIAMS CO. 101 PROSPECT AVENUE NW CLEVELAND, OH 44115</p> <p>PRIMER - EPOXY MASTIC ALUMINUM 11 B62S100/B60V100 TOP COAT - POLYURETHANE B65 SERIES/B60 V2</p> <p>PRIMER AND TOP COAT MUST BE BY SAME MANUFACTURER.</p>	<p>AMERON PROTECTION COATINGS DIV. 201 NORTH BERRY STREET BREA, CA 92621</p> <p>PRIMER - AMEDOCK 400 OR 400 AL TOP COAT - AMERCOAT 450 HS</p> <p>901 NORTH GREENWOOD AVE. KANKAKEE, IL 60901</p> <p>PRIMER - ALUMAPOXY V75A1 TOP COAT - V40 SERIES URETHANE</p>
---	---

PROPOSAL NOTE 515

TREATING CONCRETE BRIDGE DECKS WITH GRAVITY-FED RESIN - 11/15/94

THIS WORK SHALL CONSIST OF PREPARING AND TREATING THE CONCRETE BRIDGE DECK WITH A GRAVITY-FED CRACK WELDING SYSTEM IN ACCORDANCE WITH THESE SPECIFICATIONS IN REASONABLY CLOSE CONFORMITY WITH THE PLANS AND THE MANUFACTURER'S RECOMMENDATIONS AND AS DIRECTED BY THE ENGINEER.

THIS WORK ITEM SHALL NOT BE PERFORMED DURING THE PERIOD BEGINNING NOVEMBER 1ST AND ENDING MARCH 31ST.

ROADWAY DIRT AND DEBRIS SHALL FIRST BE REMOVED FROM THE AREA TO BE TREATED. SURFACES TO WHICH THE SEALER IS TO BE APPLIED SHALL BE SWEEP ABRASIVE BLASTED, THEN MANUAL OR POWER BROOM SWEEP AND BLOWN WITH COMPRESSED AIR SO THAT THEY SHALL BE DRY AND FREE OF DUST AND DIRT. HIGH PRESSURE COMPRESSED AIR SHALL BE USED TO BLOW ALL LOOSE MATERIAL FROM VISIBLE CRACKS. IF PARTICLES ARE HIGHLY EMBEDDED IN THE CRACKS, A HIGH PRESSURE WATER BLAST FOLLOWED BY AN AIR BLAST SHALL BE USED TO CLEAN CRACKS. THE CLEANING EQUIPMENT SHALL BE FINED WITH SUITABLE TRAPS, FILTERS, DRIP PANS, DRYERS AND OTHER DEVICES TO PREVENT OIL AND OTHER FOREIGN MATERIAL FROM BEING DEPOSITED ON THE SURFACE. TRAFFIC SHALL NOT BE ALLOWED ON THE CLEAN SURFACES PRIOR TO APPLICATION OF THE SEALER. EXISTING PAVEMENT MARKING SHALL BE REMOVED ACCORDING TO SECTION 621.134 OF THE ODOT CMS. ALL TRACES OF ASPHALT OR PETROLEUM PRODUCTS AND CONCRETE CURING SEALS SHALL BE REMOVED BY THE ABRASIVE BLASTING PRIOR TO AIR SWEEPING.

THE MATERIAL USED FOR TREATING THE CONCRETE BRIDGE DECK SHALL BE:

MARK 135 SAFE-T-SEAL POLY-CARB 33095 BAINBRIDGE ROAD SOLON, OH 44139 (216) 248-1223	DURAL 335-FLOWABLE CRACK SEALER TAMMS INDUSTRIES, CO. 7405 PRODUCTION DRIVE MENTOR, OH 44060
---	---

VERSAFILL-PENETRATING CONCRETE CRACK FILLER
HENKEL
5325 SOUTH 9TH AVENUE
LAGRANGE, IL 60525-3602
(800) 248-1233

CLEANING AND FLUSHING OF EQUIPMENT, TOOLS, ETC. SHALL BE DONE WITH AN APPROPRIATE SOLVENT, AS APPROVED BY THE ENGINEER, IN SUCH A MANNER TO MINIMIZE PERSONAL AND ENVIRONMENTAL HAZARDS.

THE SURFACE TO BE TREATED SHALL BE VISIBLY DRY WITH A TEMPERATURE BETWEEN 40 DEGREES F AND 100 DEGREES F PRIOR TO RESIN APPLICATION. THE RESIN MAY NOT BE APPLIED WITHIN 24 HOURS AFTER A RAIN, DURING RAIN, WHEN RAIN IS FORECAST WITHIN 12 HOURS OR WHEN THE AMBIENT AIR TEMPERATURE IS BELOW 40 DEGREES F. NO STANDING WATER SHALL BE PRESENT DURING APPLICATION. THE DECK SHALL BE PRE-MARKED TO CONTROL MIXED MATERIAL USAGE AND TO PROVIDE A RATE OF APPLICATION OF APPROXIMATELY 100-150 SQUARE FEET PER GALLON. THE EXACT RATE SHALL BE DETERMINED BY THE ENGINEER BUT WILL NOT EXCEED 150 SQUARE FEET PER GALLON.

THE AREA TO BE SEALED SHALL BE FLOODED WITH RESIN. ALLOWING PENETRATION INTO THE CONCRETE AND FILLING OF ALL CRACKS. THE RESIN SHALL BE MIXED TO A LIMIT OF 5 GALLONS AT A TIME FOR MANUAL APPLICATION. A SIGNIFICANT INCREASE IN VISCOSITY SHALL BE CAUSE FOR REJECTION. EXCESS MATERIAL SHALL BE REDISTRIBUTED BY SQUEEGEE WITHIN 10 MINUTES AFTER APPLICATION. FRONT AND BACK MOVEMENT WITH THE SQUEEGEE IS RECOMMENDED OVER CRACKS AND PATCH PERIMETERS TO ENHANCE PENETRATION.

THE CONTRACTOR SHALL TAKE ALL STEPS NECESSARY TO PREVENT THE RESIN FROM FLOWING INTO LANES OPEN TO TRAFFIC. THE ENTIRE SEALED AREA OF THE BRIDGE DECK SHALL HAVE SAND BROADCAST BY MECHANICAL MEANS TO EFFECT A UNIFORM COVERAGE OF 1 POUND PER 2-3 SQUARE FOOT. THE SAND SHALL BE A UNIFORMLY GRADED AGGREGATE CONFORMING TO THE QUALITY REQUIREMENTS OF SECTION 703 OF THE CMS AND SHALL CONFORM TO THE FOLLOWING LIMITS FOR GRADING:

SIEVE SIZE	% PASSING MAX.
(NO. 4)	100
(NO. 8)	90 - 100
(NO. 20)	5 - 15
(NO. 50)	0 - 5

IT IS THE INTENTION OF THIS SPECIFICATION TO ONLY USE NATURAL SAND PRODUCTS APPLIED BY COMMON LAWN BROADCAST TYPE SEEDER/SPREADER. SAND SHALL BE PLACED BETWEEN 45 TO 75 MINUTES BEHIND THE RESIN SPREADING FRONT DEPENDING ON AIR AND SURFACE TEMPERATURE. THE CONTRACTOR SHALL PROVIDE TIMELY AND SUFFICIENT BROADCAST OF THE AGGREGATE TO INSURE THAT THE SKID RESISTANCE ON THE DECK DOES NOT DROP BELOW 40 AFTER CURING OF THE RESIN. IF THE SURFACE CONTAINS LARGE, DEEP CRACKS, THE LOW VISCOSITY LIQUID COULD RUN COMPLETELY THROUGH THE CONCRETE SLAB. IN THESE AREAS, A SECOND COAT WILL BE REQUIRED AFTER THE FIRST COAT HAS STARTED TO CURE.

BEFORE THE RESIN HARDENS, IMPERFECTIONS OR SPALLS WITH STANDING LIQUID SHALL BE FILLED WITH COMMERCIAL QUALITY CONCRETE OR SANDBLAST SAND, AND FINISHED TO A UNIFORM SURFACE. THE SAND SHALL HAVE A MAXIMUM MOISTURE CONTENT OF 0.5 OF THE PERCENT OF ABSORPTION WHEN TREATED IN ACCORDANCE TO CALIFORNIA TEST 226. TRAFFIC AND EQUIPMENT SHALL NOT BE PERMITTED ON THE TREATED DECK UNTIL IT IS TACK FREE, A MINIMUM OF 6 HOURS HAVE ELAPSED SINCE TREATMENT AND THE SAND COVER ADHERES SUFFICIENTLY TO RESIST BRUSHING OFF BY HAND. THE TREATMENT SHALL BE PROTECTED FROM MOISTURE FOR NOT LESS THAN 6 HOURS AFTER PLACEMENT.

REF: **REF**
REF: **REF**
KZF DESIGN
Architecture | Interiors | Planning
1000 West 12th Street, Suite 100
Denver, CO 80202 | PH: 303.733.1111 | FAX: 303.733.2800 | WWW.KZFDESIGN.COM

DATE	08/02/00
REVIEWED	SJA
STRUCTURE FILE NUMBER	
DRAWN	DGK
REVISION	
DESIGNED	DGK
CHECKED	WBS

GENERAL NOTES FOR OVERHEAD BRIDGES

PRE-70-0.00


REF: **REF: **
 REF: **REF: **
 USER: *****
 PROJ: *****
 ACTIVE LEVELS ON: #1 LEV#

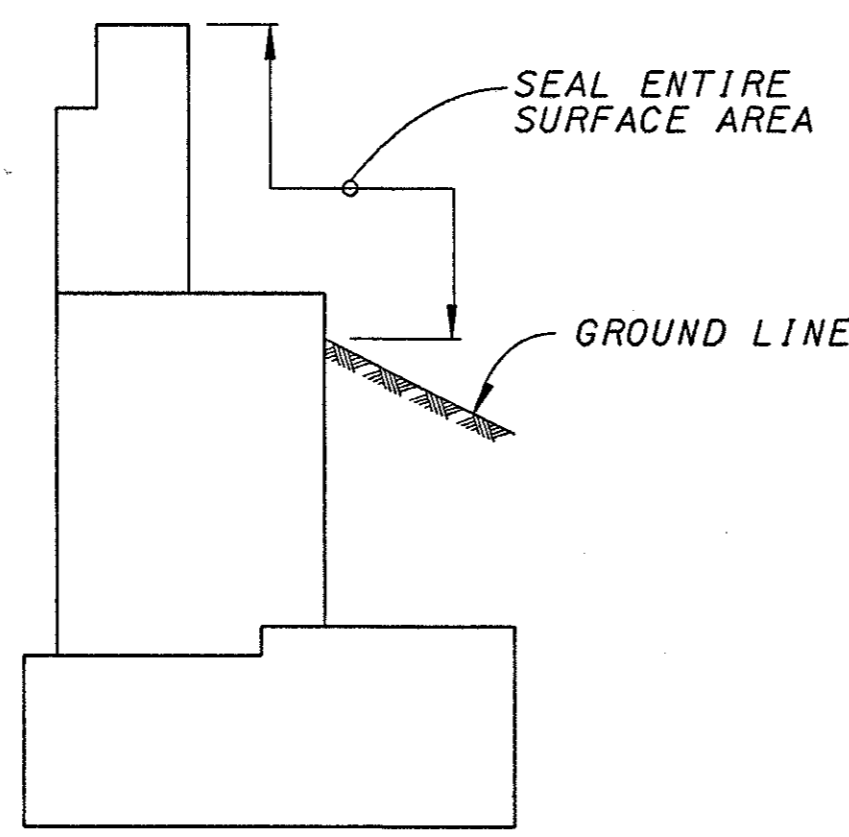


ABUTMENT SEALING LIMITS
 (FOR STEEL BEAM BRIDGE)

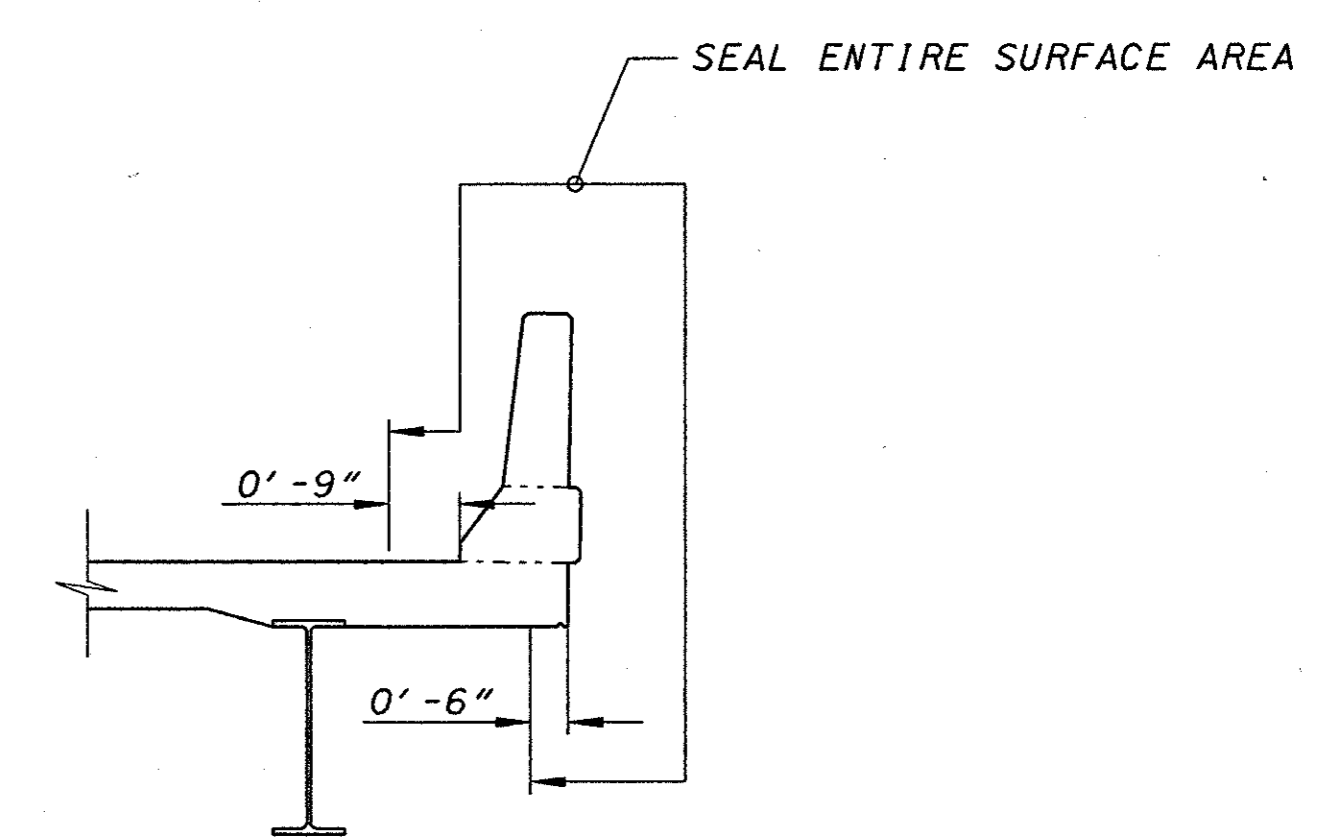


CONCRETE DECK WITH DEFLECTOR PARAPET


SEALING OF CONCRETE SURFACES, SUPERSTRUCTURE

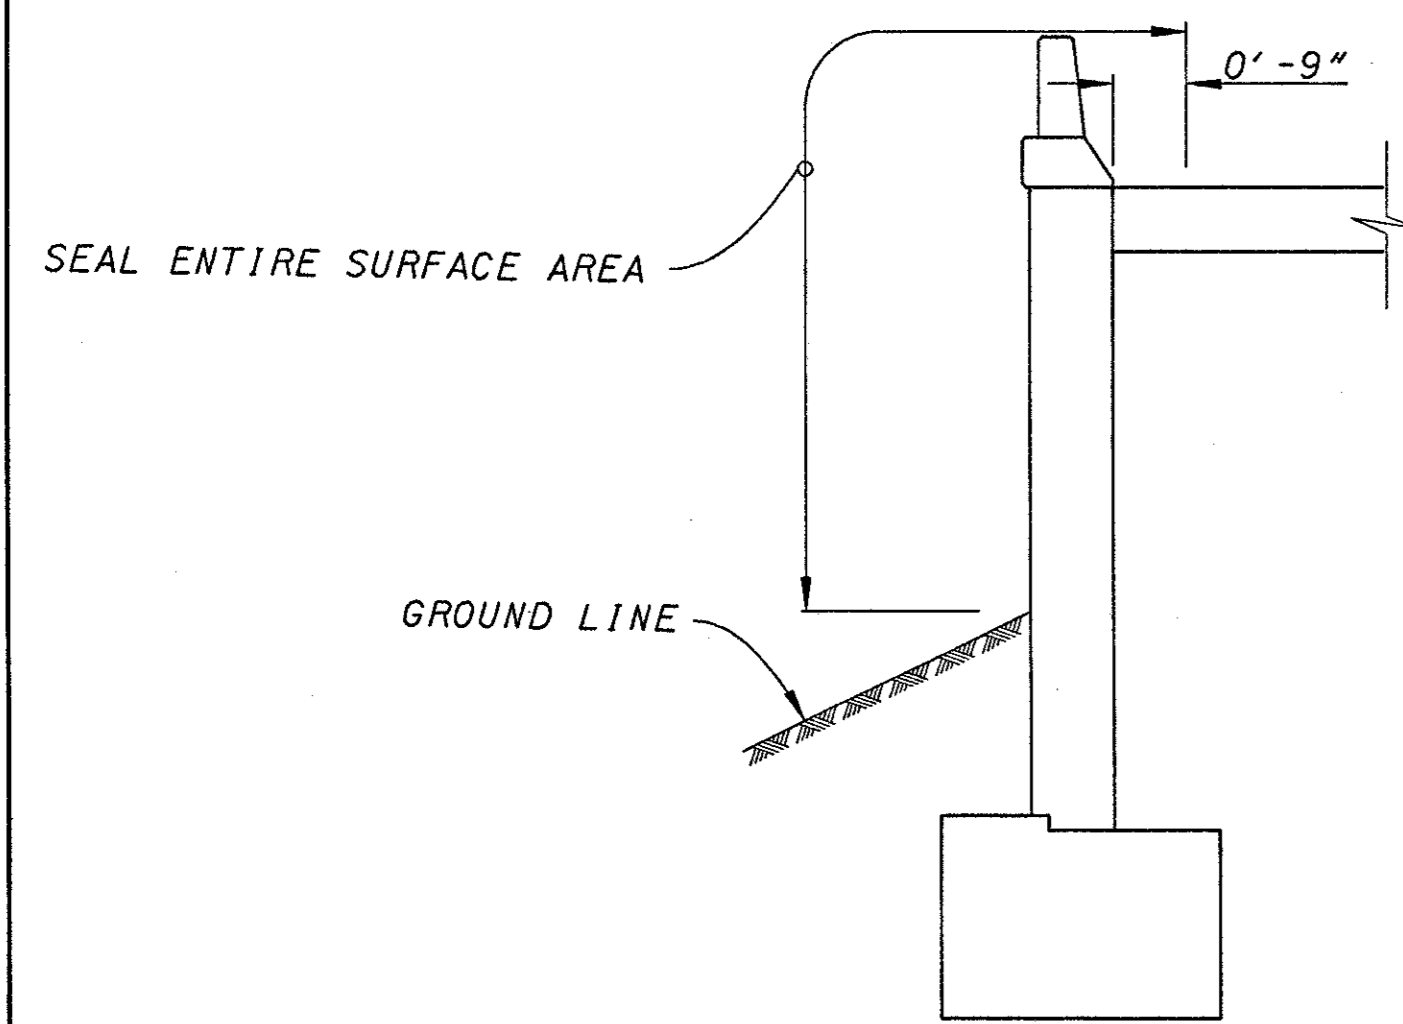

WINGWALL SEALING LIMITS
 (TURNBACK WALL ON U-TYPE ABUTMENT)

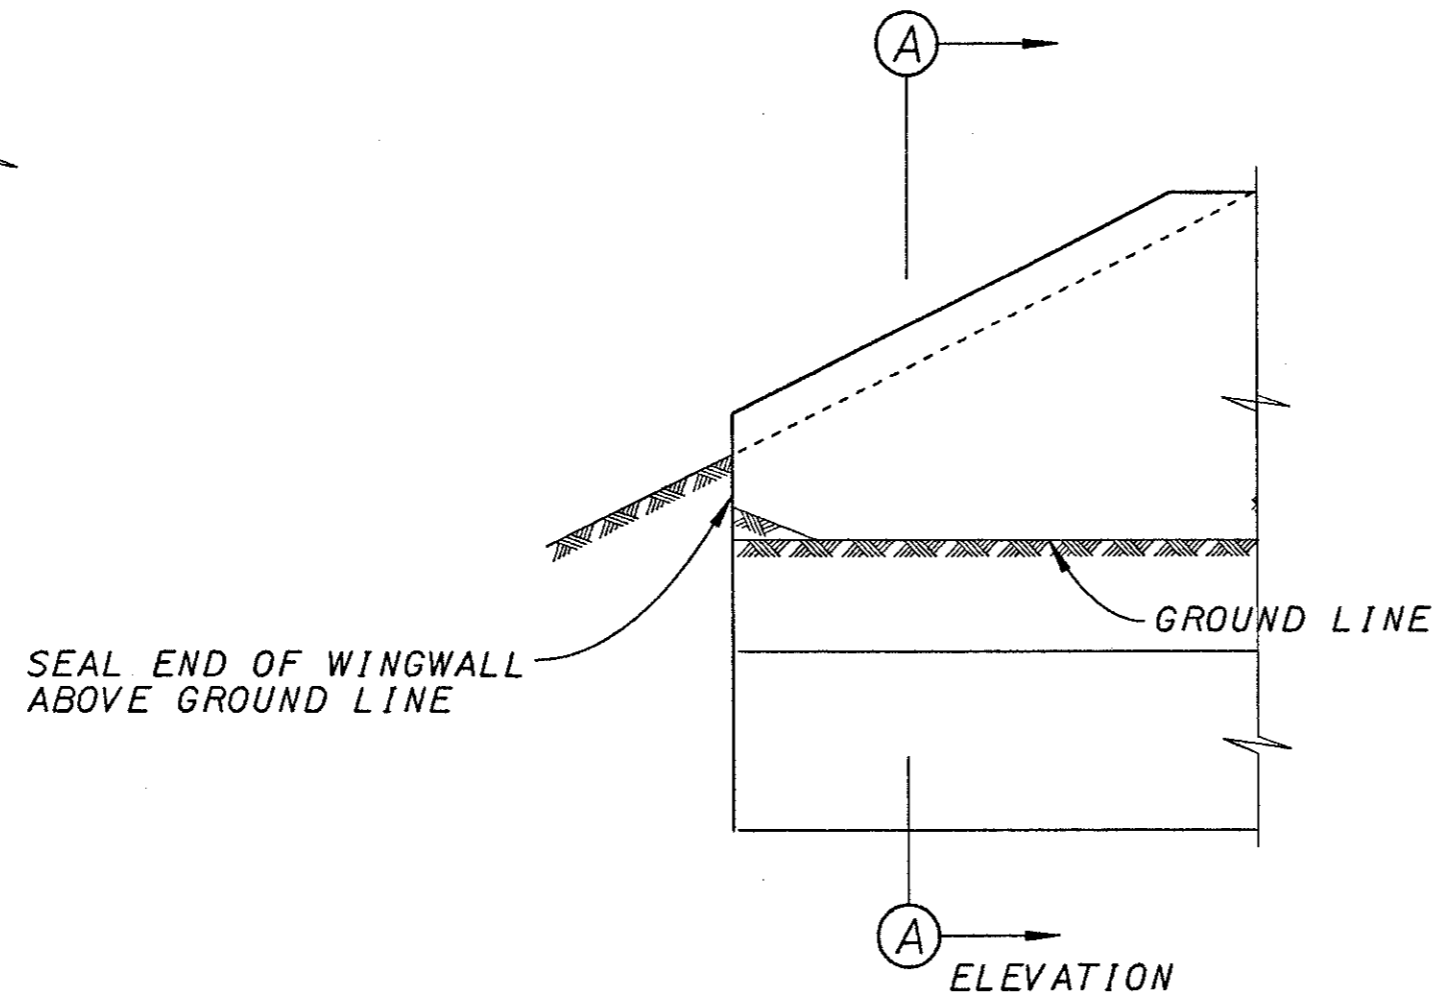


WINGWALL SEALING LIMITS
 (STRAIGHT WING ABUTMENT)

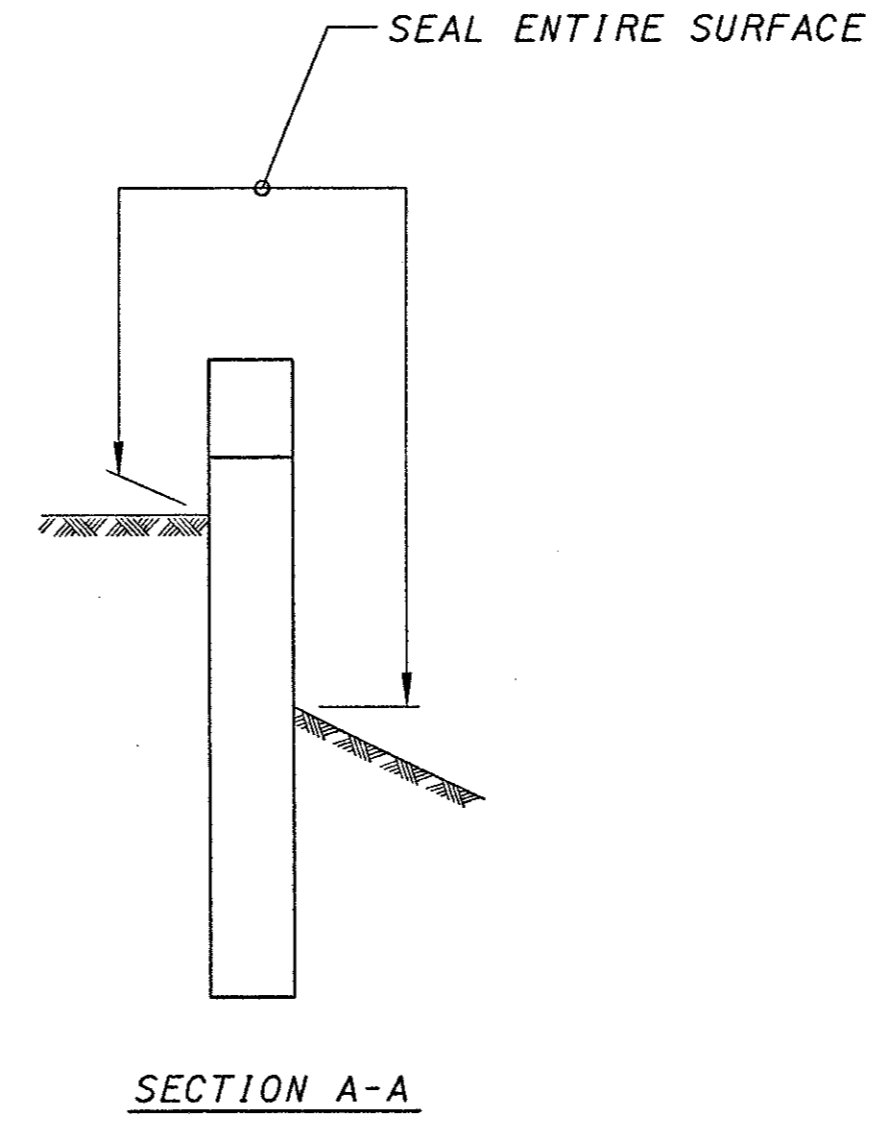


SECTION A-A

SEALING OF CONCRETE SURFACES, SUBSTRUCTURE

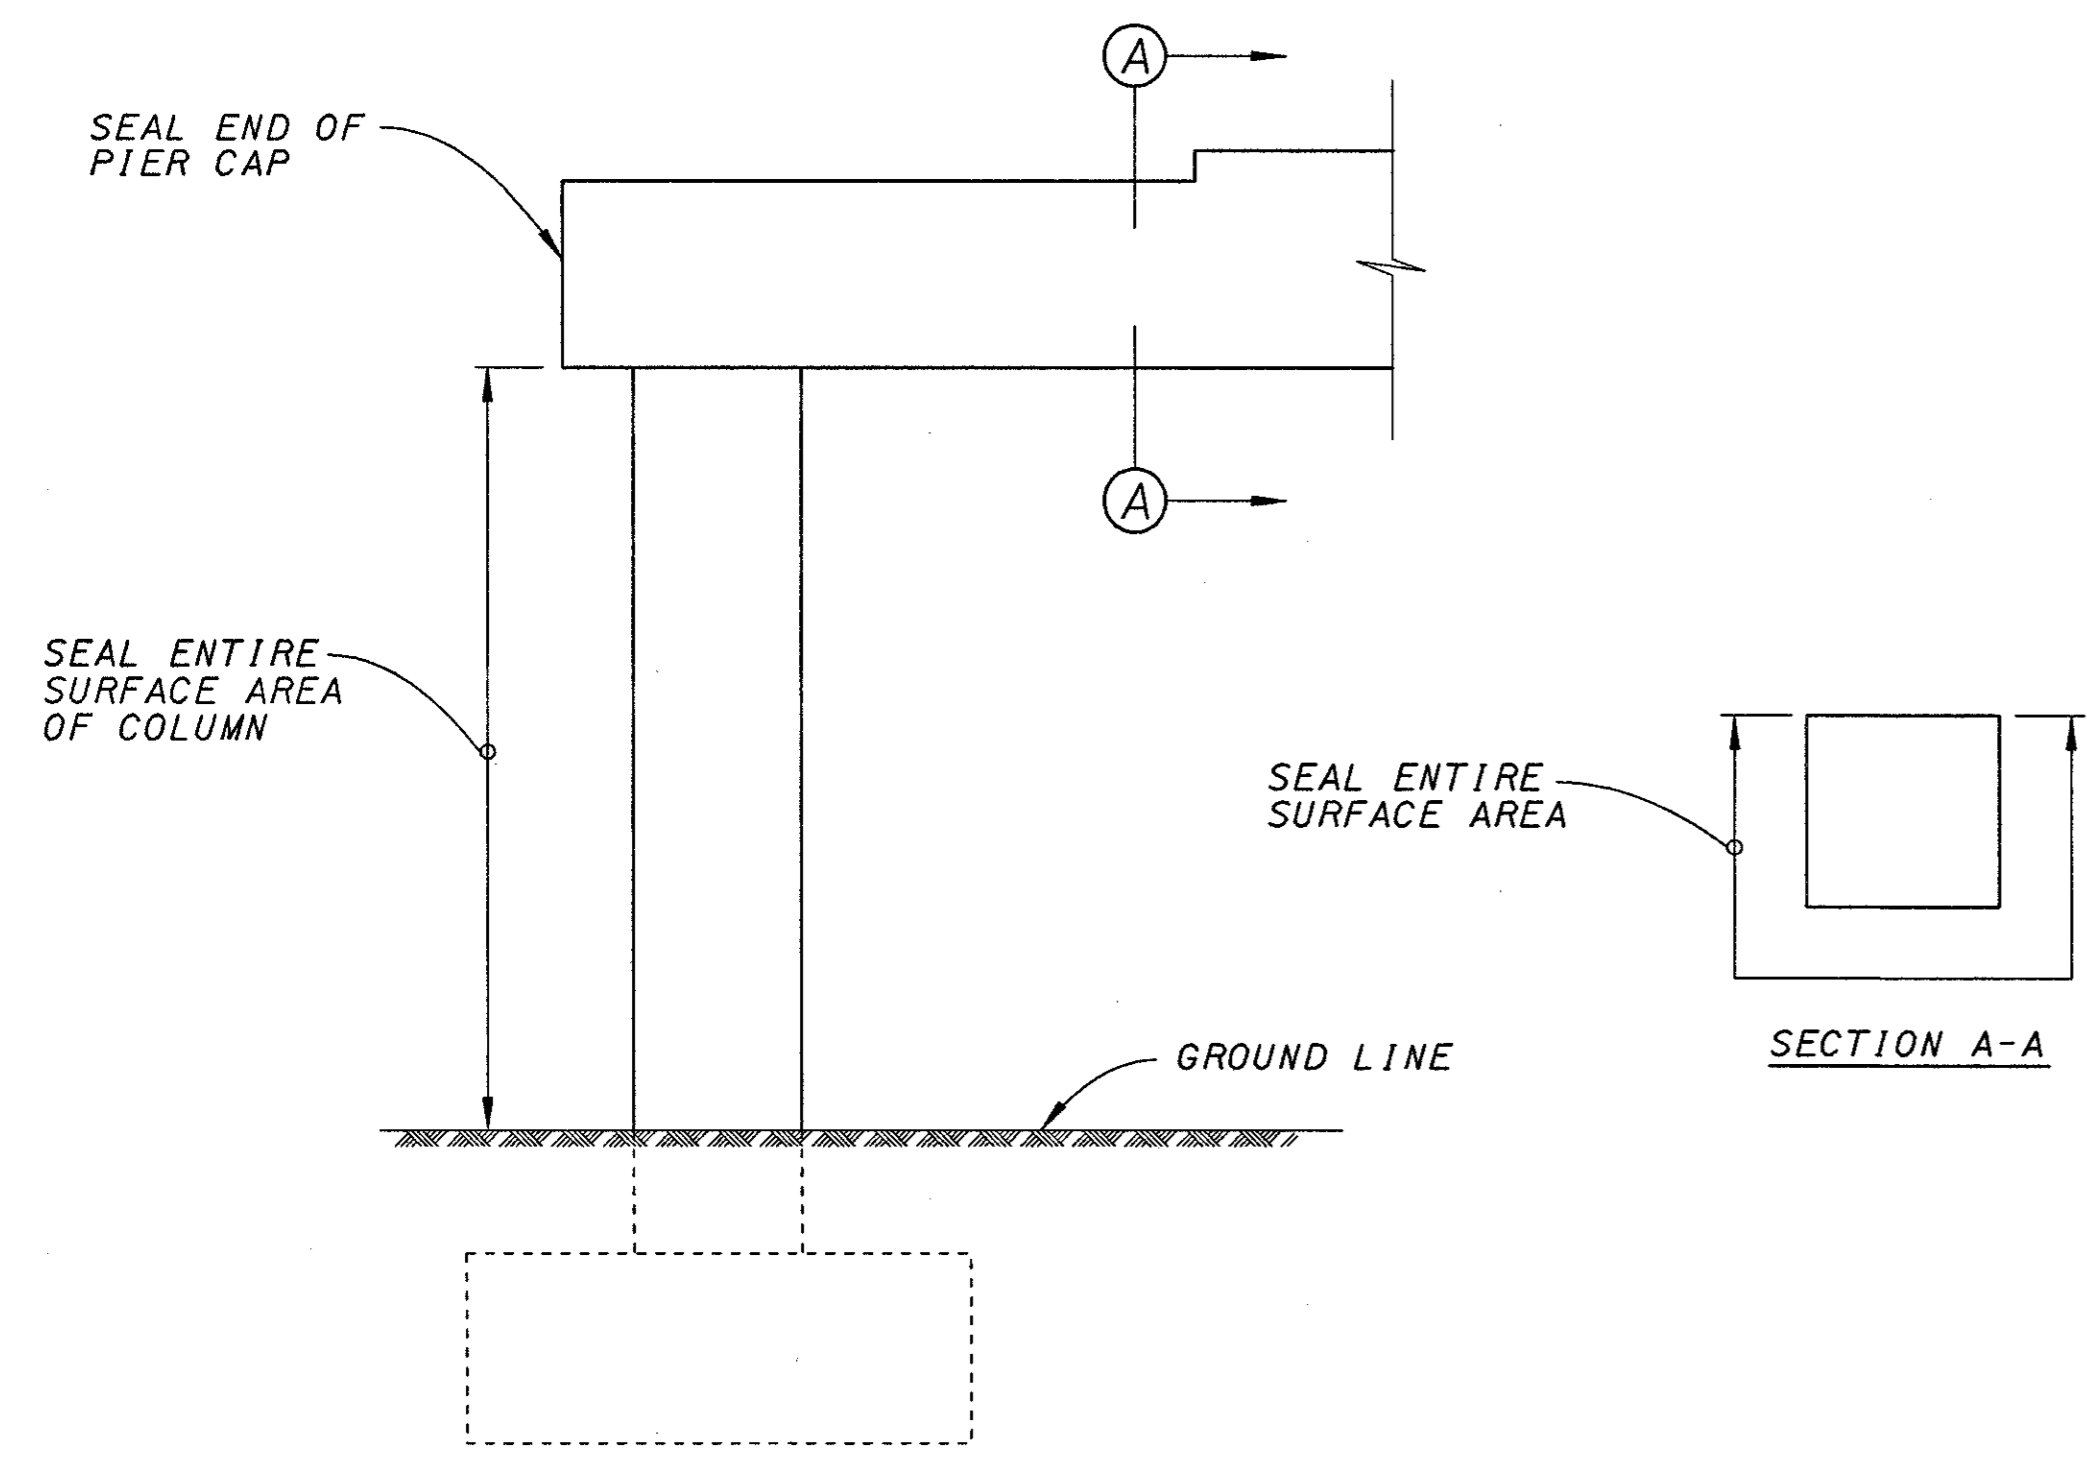

PIER SEALING LIMITS
SEALING OF CONCRETE SURFACES, SUBSTRUCTURE

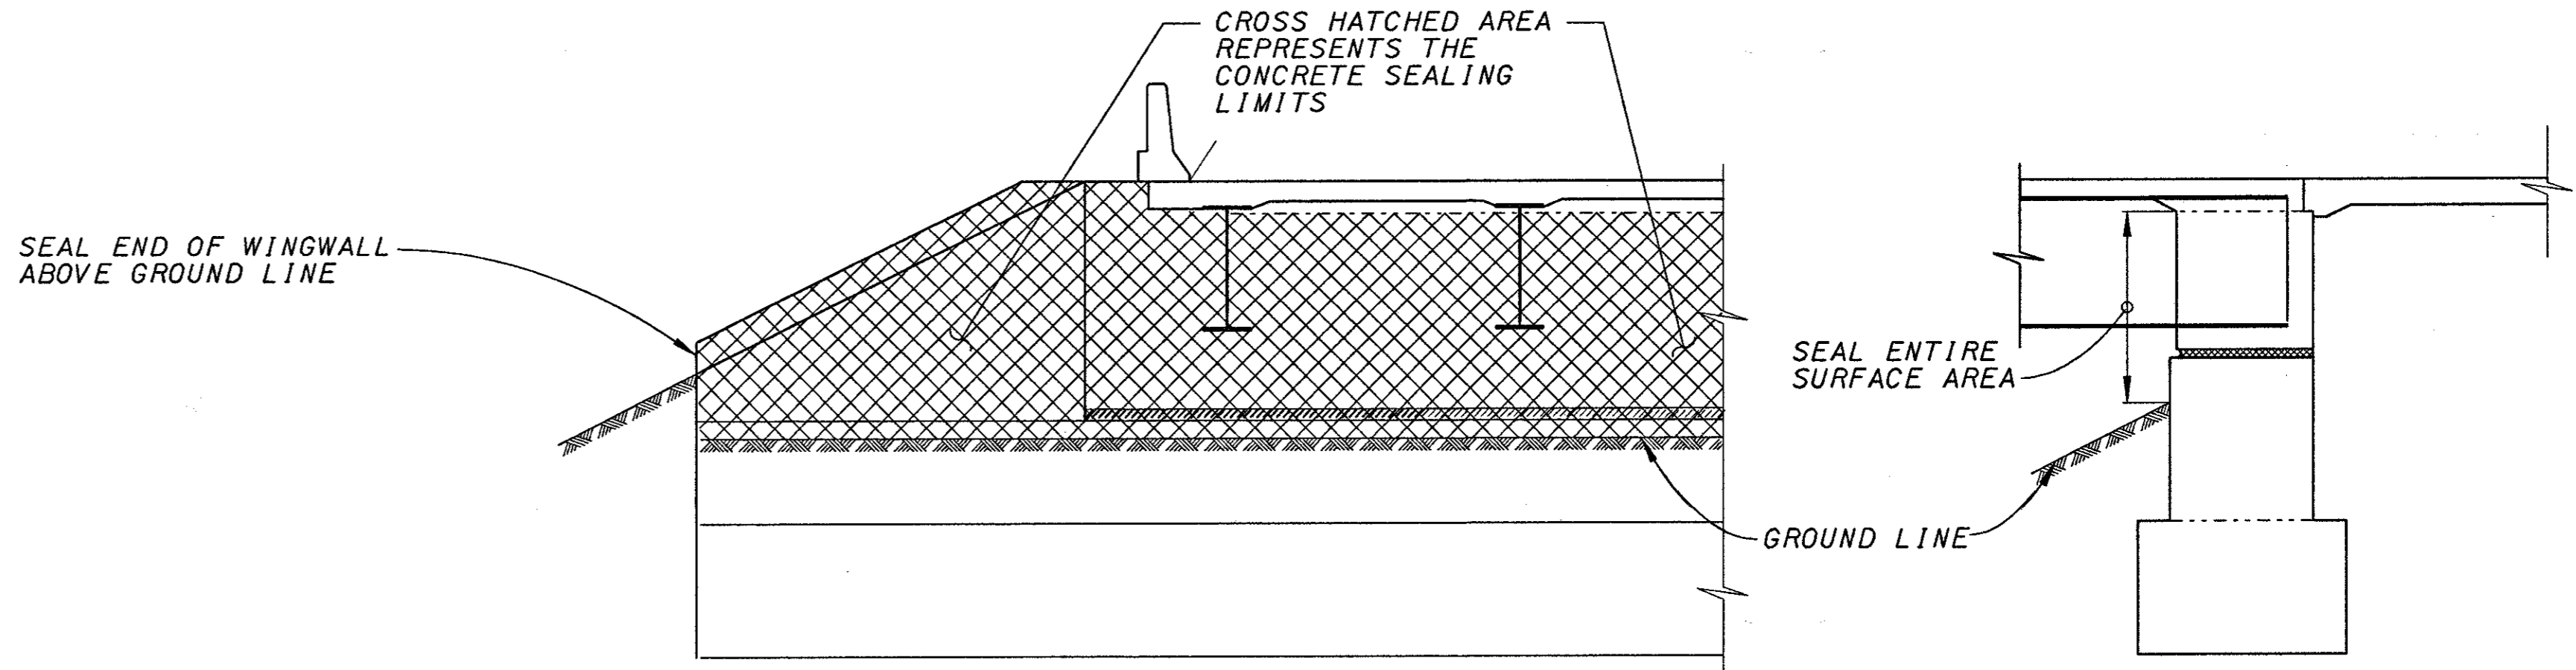

ABUTMENT SEALING LIMITS
 (FOR SEMI-INTREGAL ABUTMENT STEEL BEAM BRIDGE)

SEALING OF CONCRETE SURFACES, SUBSTRUCTURE

DESIGNED	WBS	CHECKED	DGK
DRAWN	JW	REVISED	
REVIEWED	SJA	STRUCTURE FILE NUMBER	
DATE			


REF: **REF**
 REF: **REF**
DATE: 11/11/00
 DRAWN: J. W. WILSON
 CHECKED: J. W. WILSON
 DESIGNED: J. W. WILSON
 PROJECT: BRIDGE #7
 SHEET: 277
 TOTAL SHEETS: 283

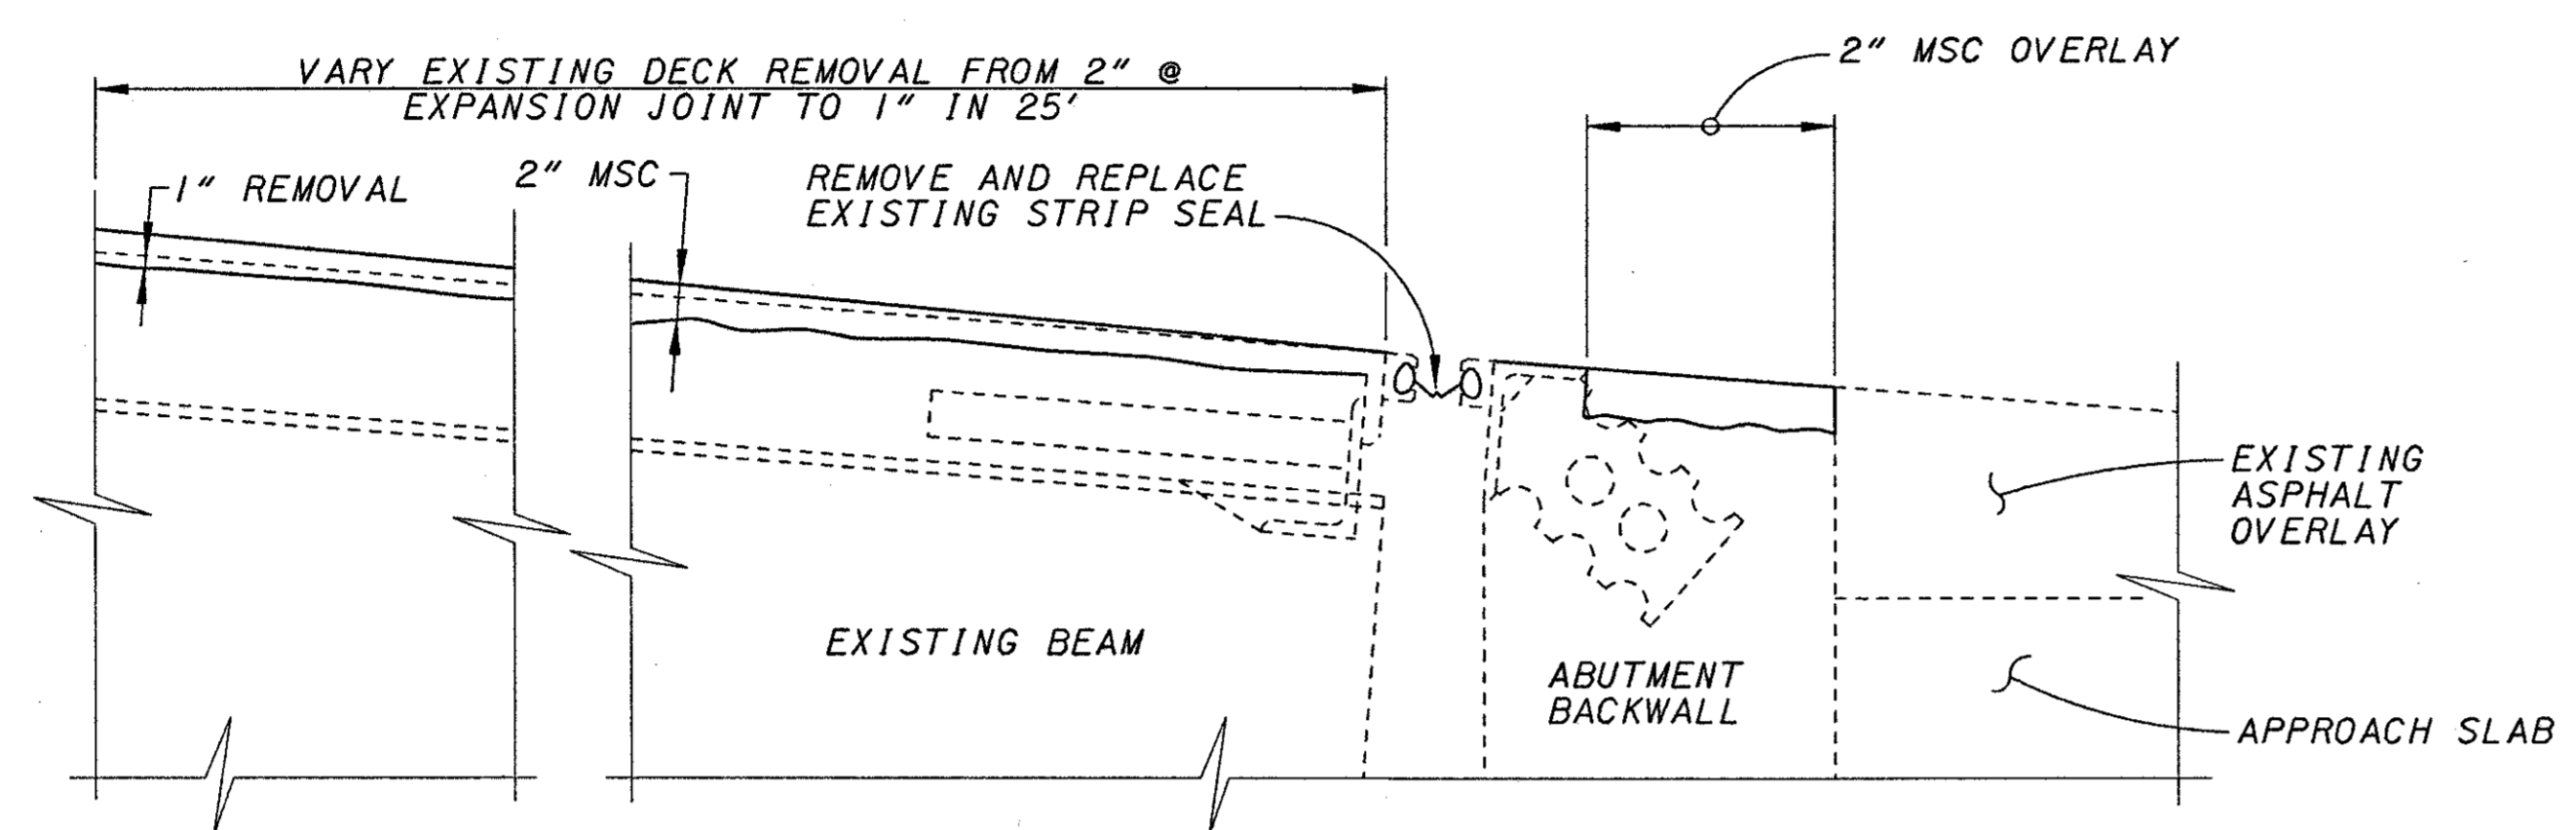


DETAIL AT ENDS OF BRIDGE #7

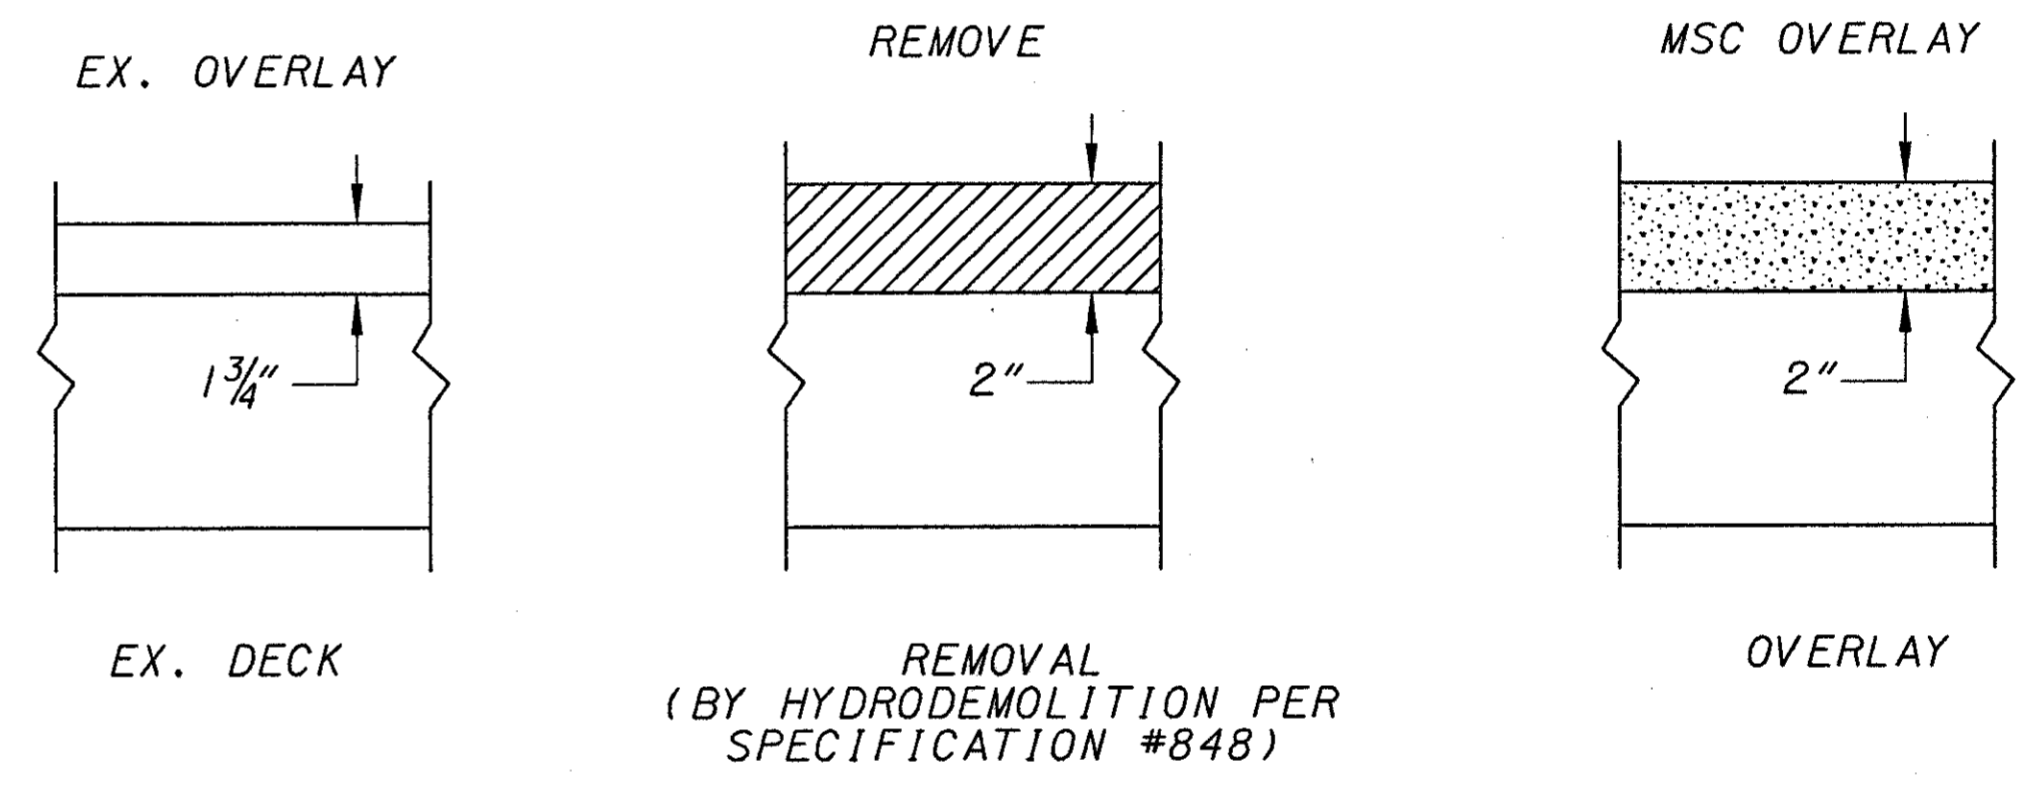

2' WIDE @ EACH GUTTER LINE

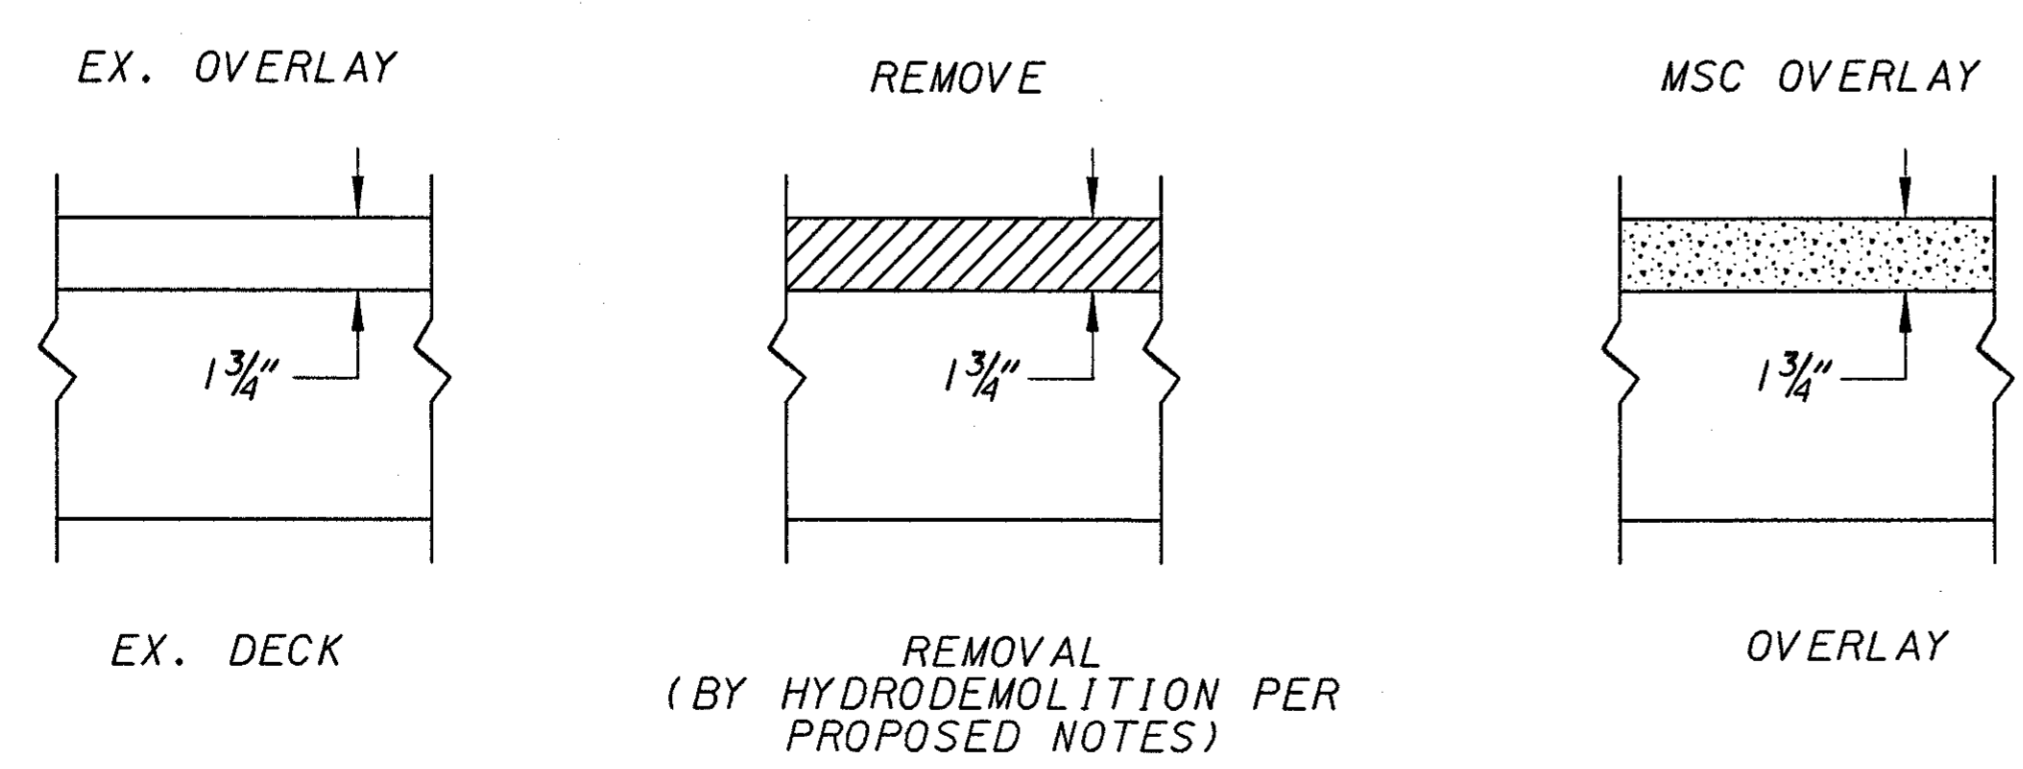

REMOVE THE EXISTING CONCRETE OVERLAY AND REPLACE WITH A NEW MICRO-SILICA OVERLAY.
TYPICAL OF BRIDGES NUMBERED 2, 3, AND 16

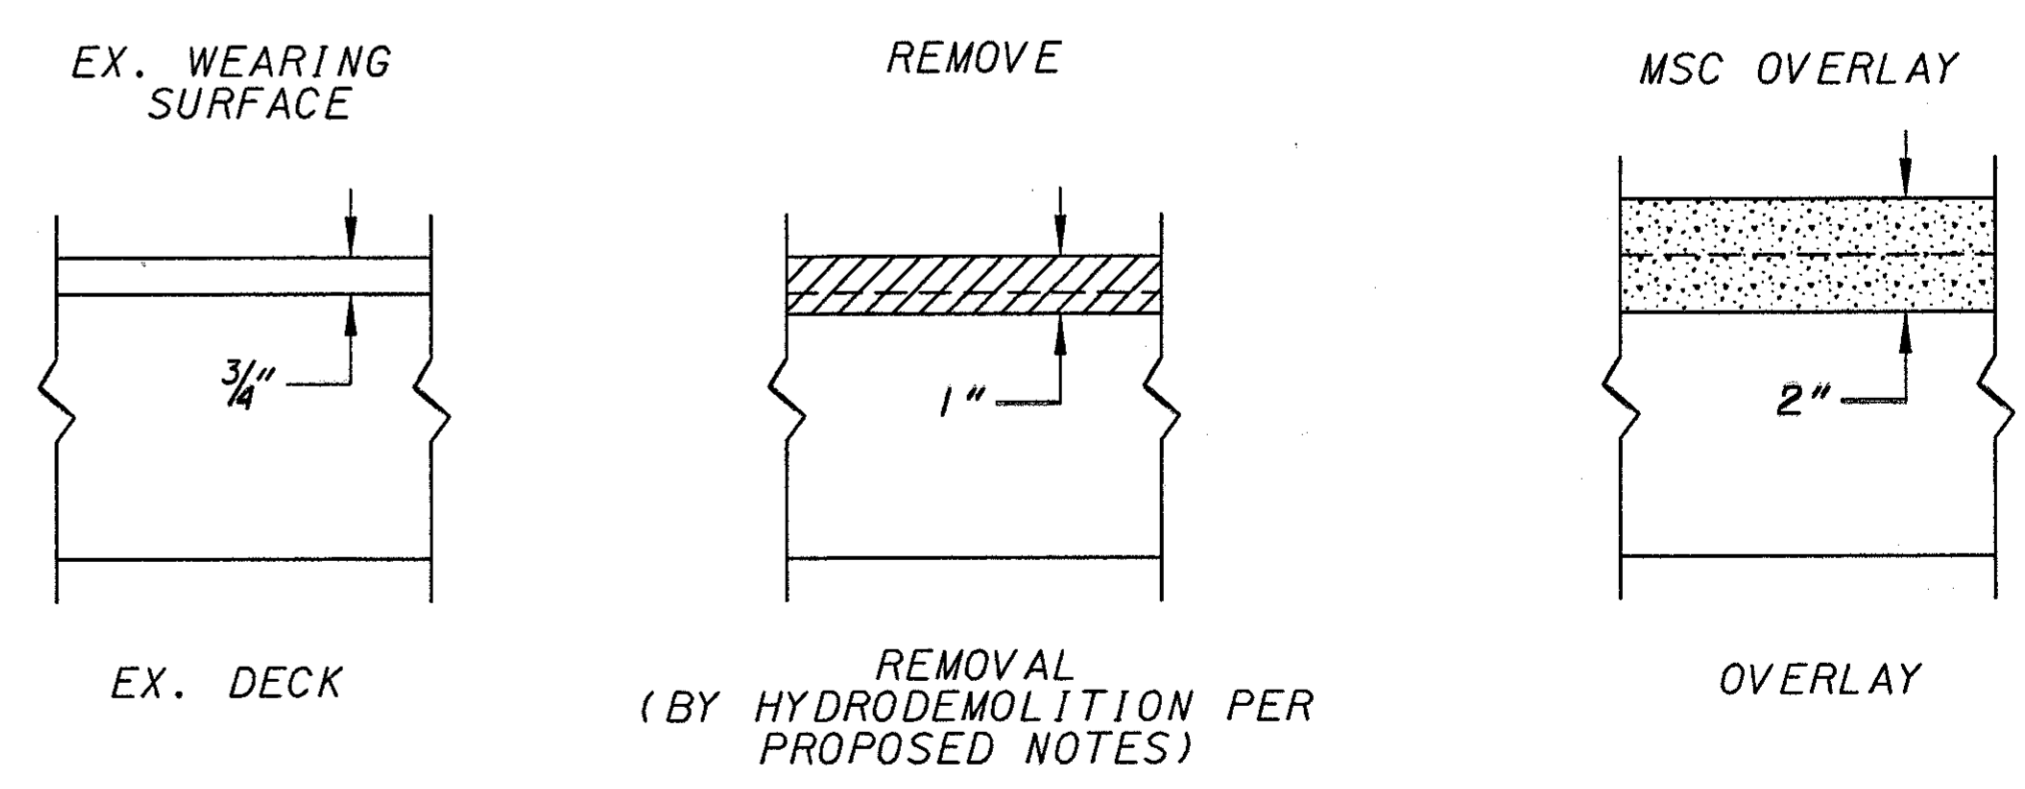

REMOVE THE EXISTING CONCRETE WEARING SURFACE AND REPLACE WITH NEW MICRO-SILICA OVERLAY
TYPICAL OF BRIDGE #7, ONLY

OVERLAY DETAILS

DESIGNED	DGK	CHECKED	WBS
DRAWN	DGK	REVISED	
REVIEWED	S/A	STRUCTURE FILE NUMBER	
DATE			

OVERLAY DETAILS

PRE-70-0.00


REF: **REF1**
REF: **REF2**
REF: **REF3**
REF: **REF4**
REF: **REF5**
REF: **REF6**
REF: **REF7**
REF: **REF8**
REF: **REF9**
REF: **REF10**
REF: **REF11**
REF: **REF12**
REF: **REF13**
REF: **REF14**
REF: **REF15**
REF: **REF16**
REF: **REF17**
REF: **REF18**
REF: **REF19**
REF: **REF20**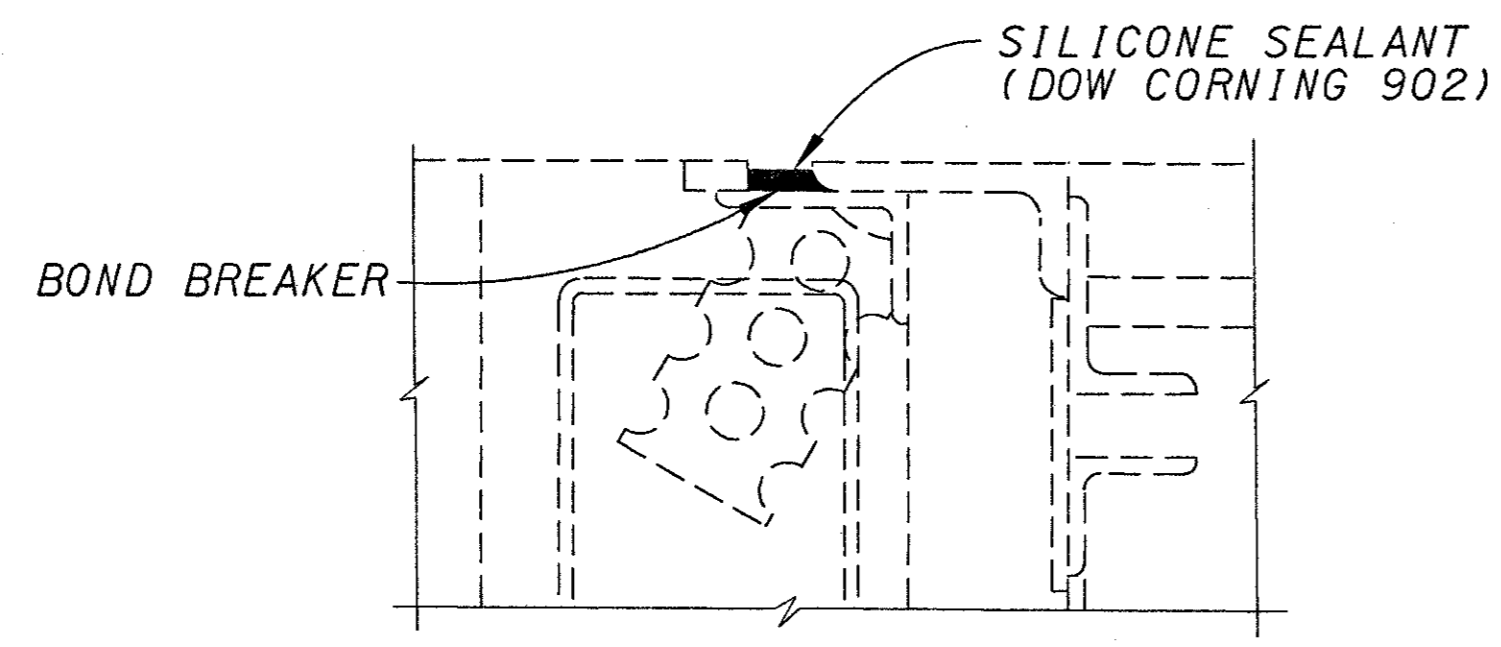

EXISTING SLIDING JOINT

ROCKER OR BOLSTER SIZE	MINIMUM JACKING CAPACITY REQUIRED
R 75	50 TON
R 100	60 TON
R 175	100 TON
R 200	120 TON
R 250	150 TON

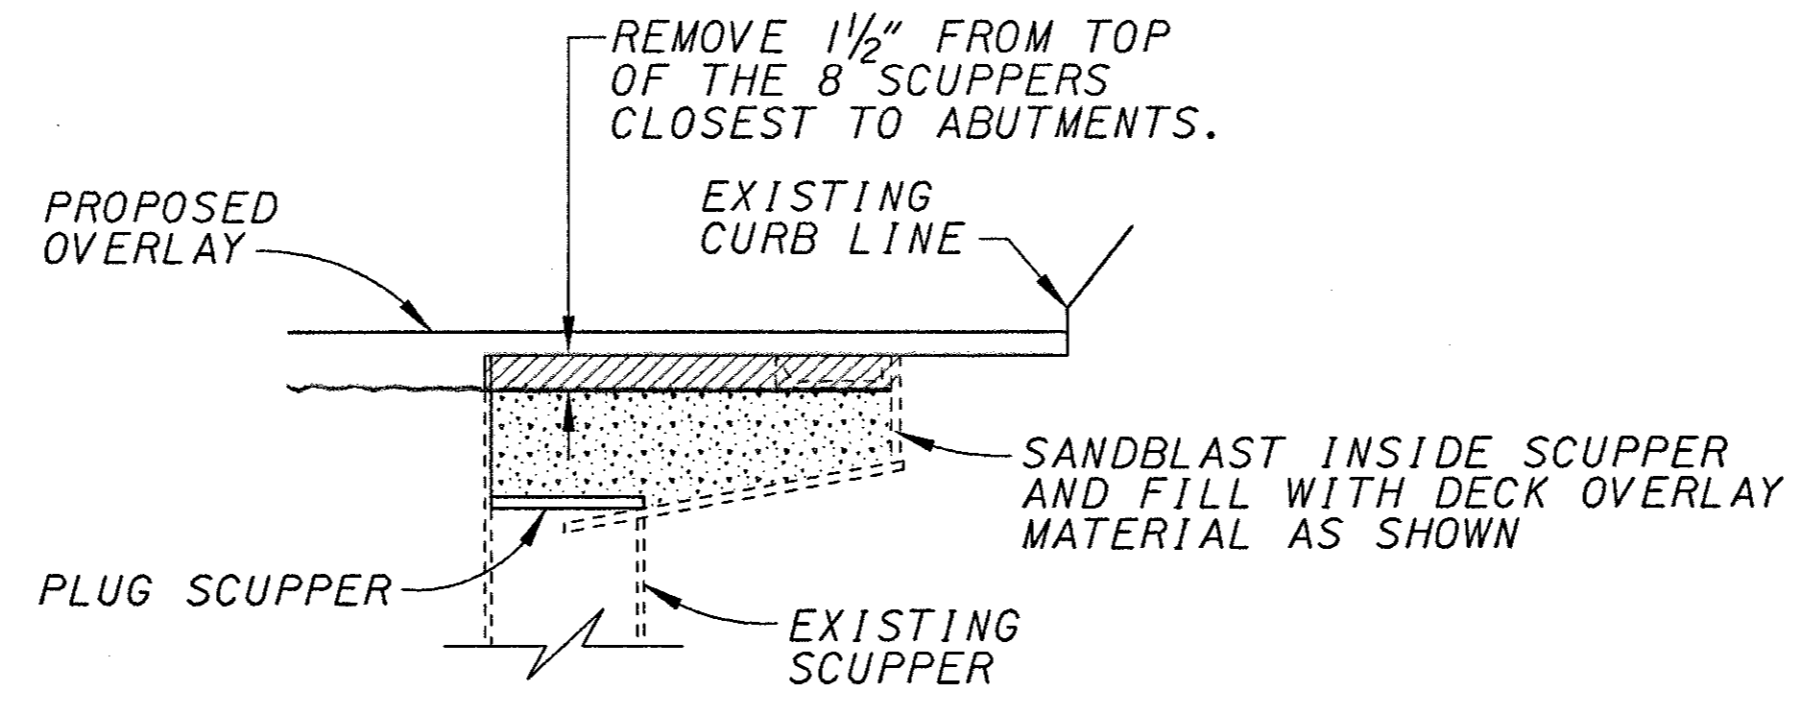

EXISTING SCUPPER TREATMENT AT BRIDGE #7

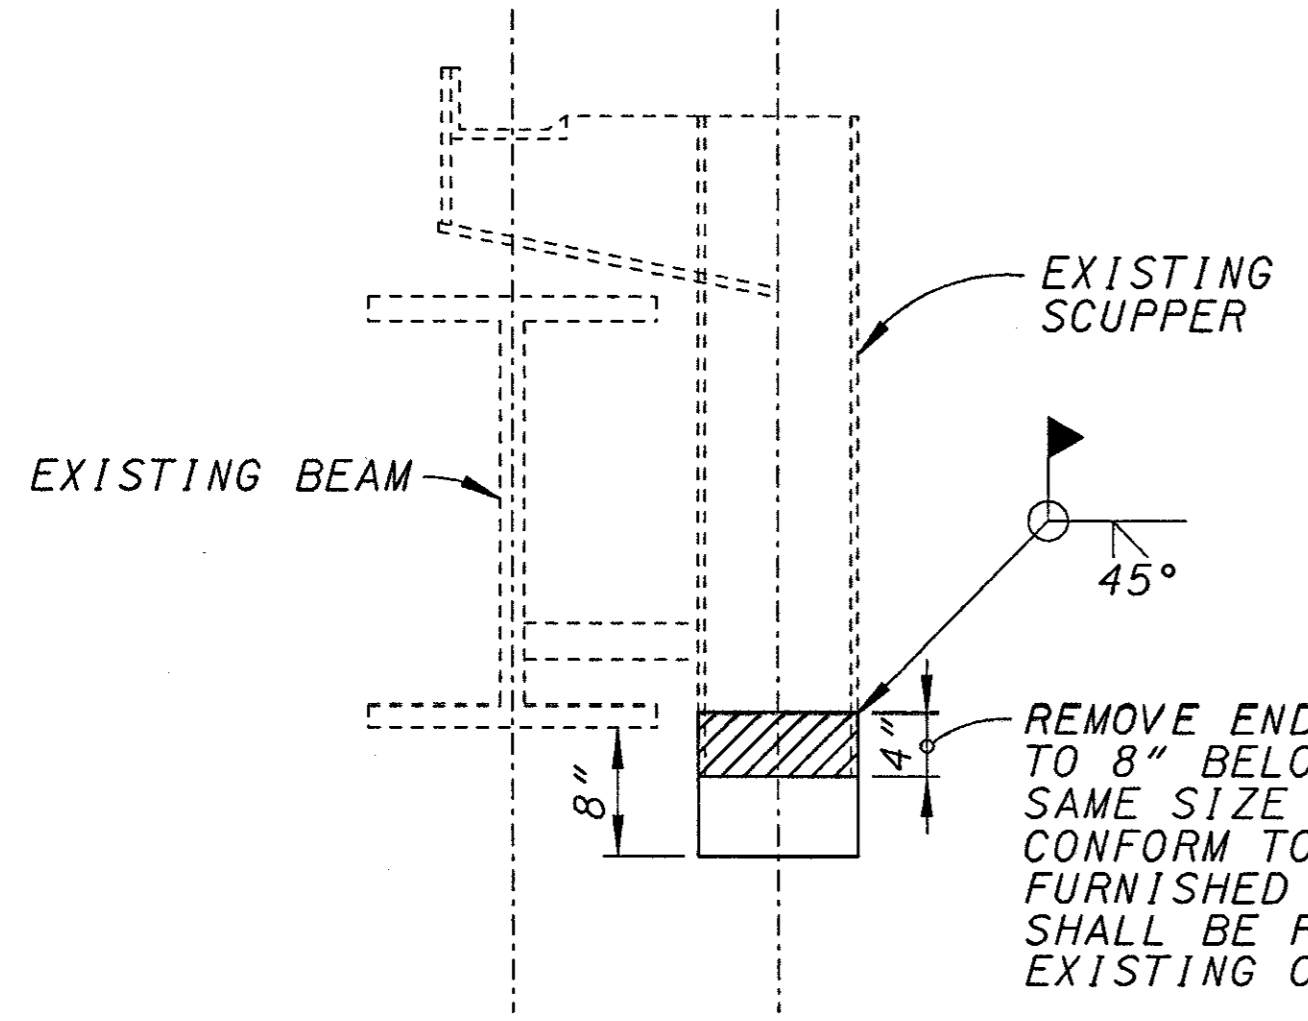

SCUPPER EXTENSION DETAIL

BRIDGE #	REAR ABUTMENT BEARING TYPE (KIPS)	PIER 1 BEARING TYPE (KIPS)	PIER 2 BEARING TYPE (KIPS)	PIER 3 BEARING TYPE (KIPS)	FORWARD ABUTMENT BEARING TYPE (KIPS)
2	R 75	R 175	B 200	R 175	R 75
3	R 100	R 250	B 275	R 250	R 100
4	R 75	R 200	B 200	R 200	R 75
5	R 75	R 200	B 200	R 200	R 75
7	R 75	R 200	B 200	R 200	R 75
9	R 100	R 200	B 225	R 200	R 100
10	R 75	R 200	B 200	R 200	R 75
11	R 100M	R 200	B 225	R 200	R 100M
15	R 100	R 200	B 225	R 200	R 100
16	R 100	R 175	B 200	R 175	R 100
18	R 75	R 175	B 200	R 175	R 75
20	NOT REQUIRED				
21	R 75	R 175	B 200	R 175	R 75

BEARING TYPES :
R - ROCKERS AND B - BOLSTERS

BEARING REFURBISHMENT FOR PROJECT OVERHEAD BRIDGES


REF: **REF1**
REF: **REF2**
REF: **REF3**
REF: **REF50**

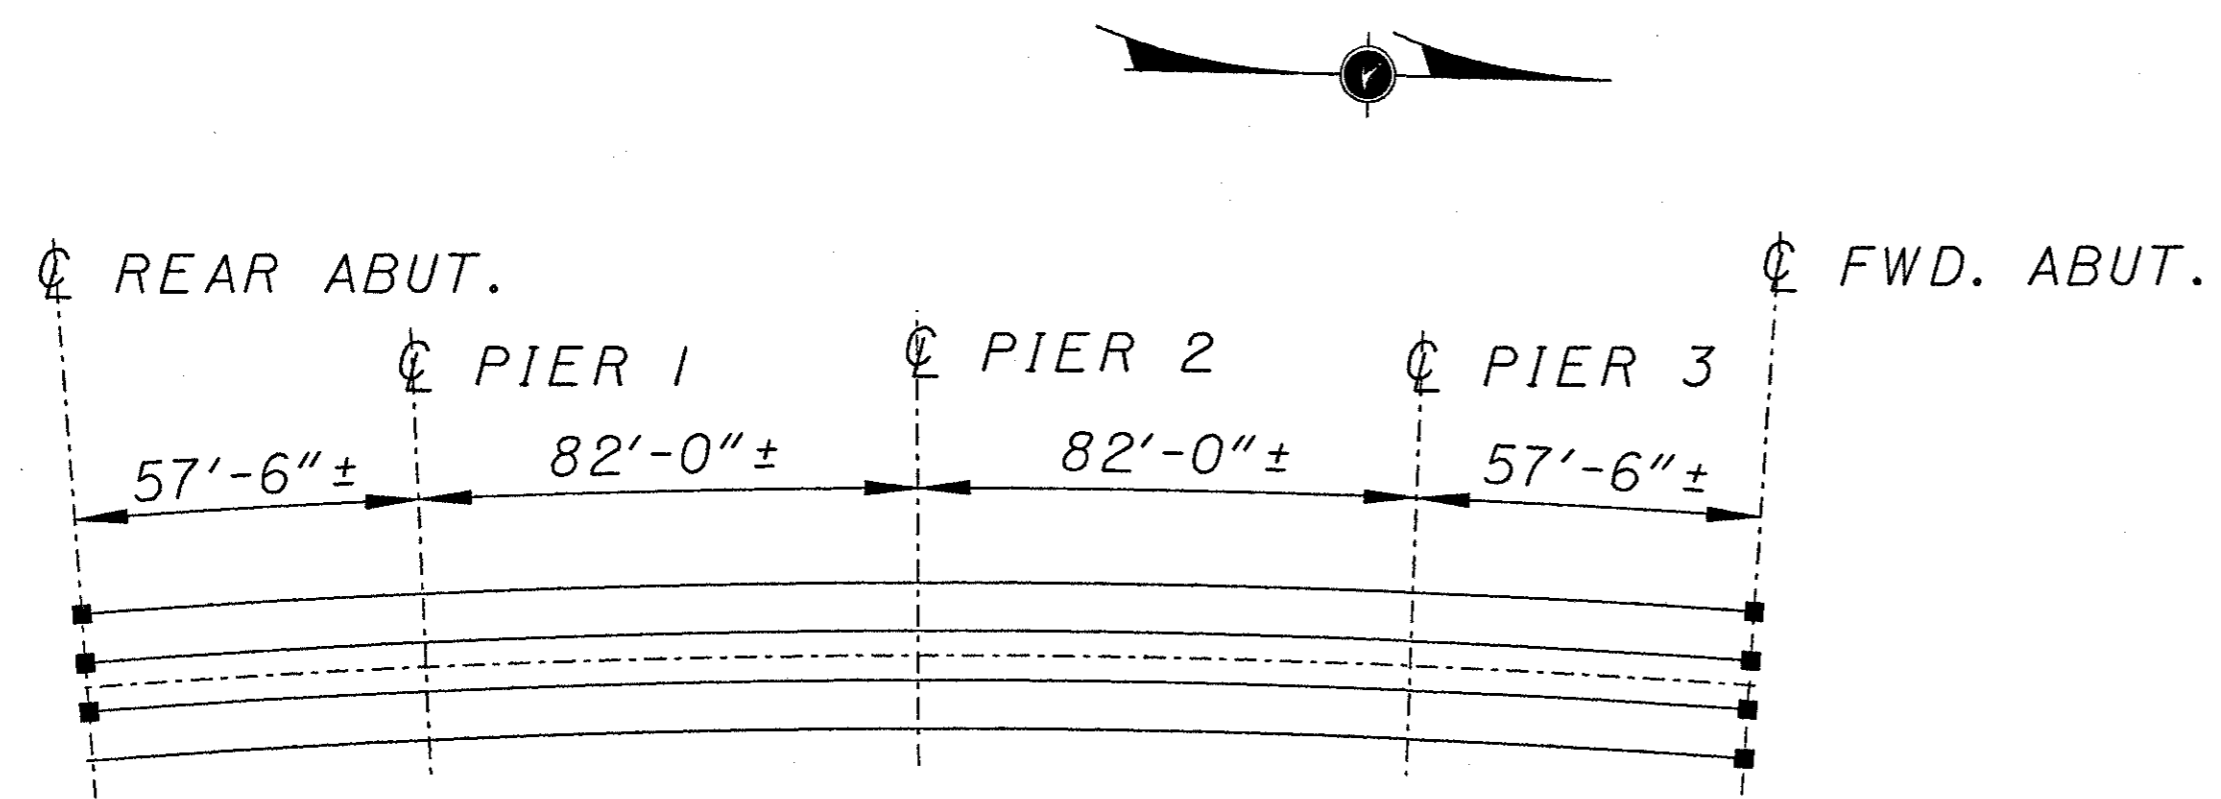

FRAMING PLAN

■ INDICATES R-75 BEARING THAT NEEDS TO BE REPOSITIONED.


KZF BRIDGE #2

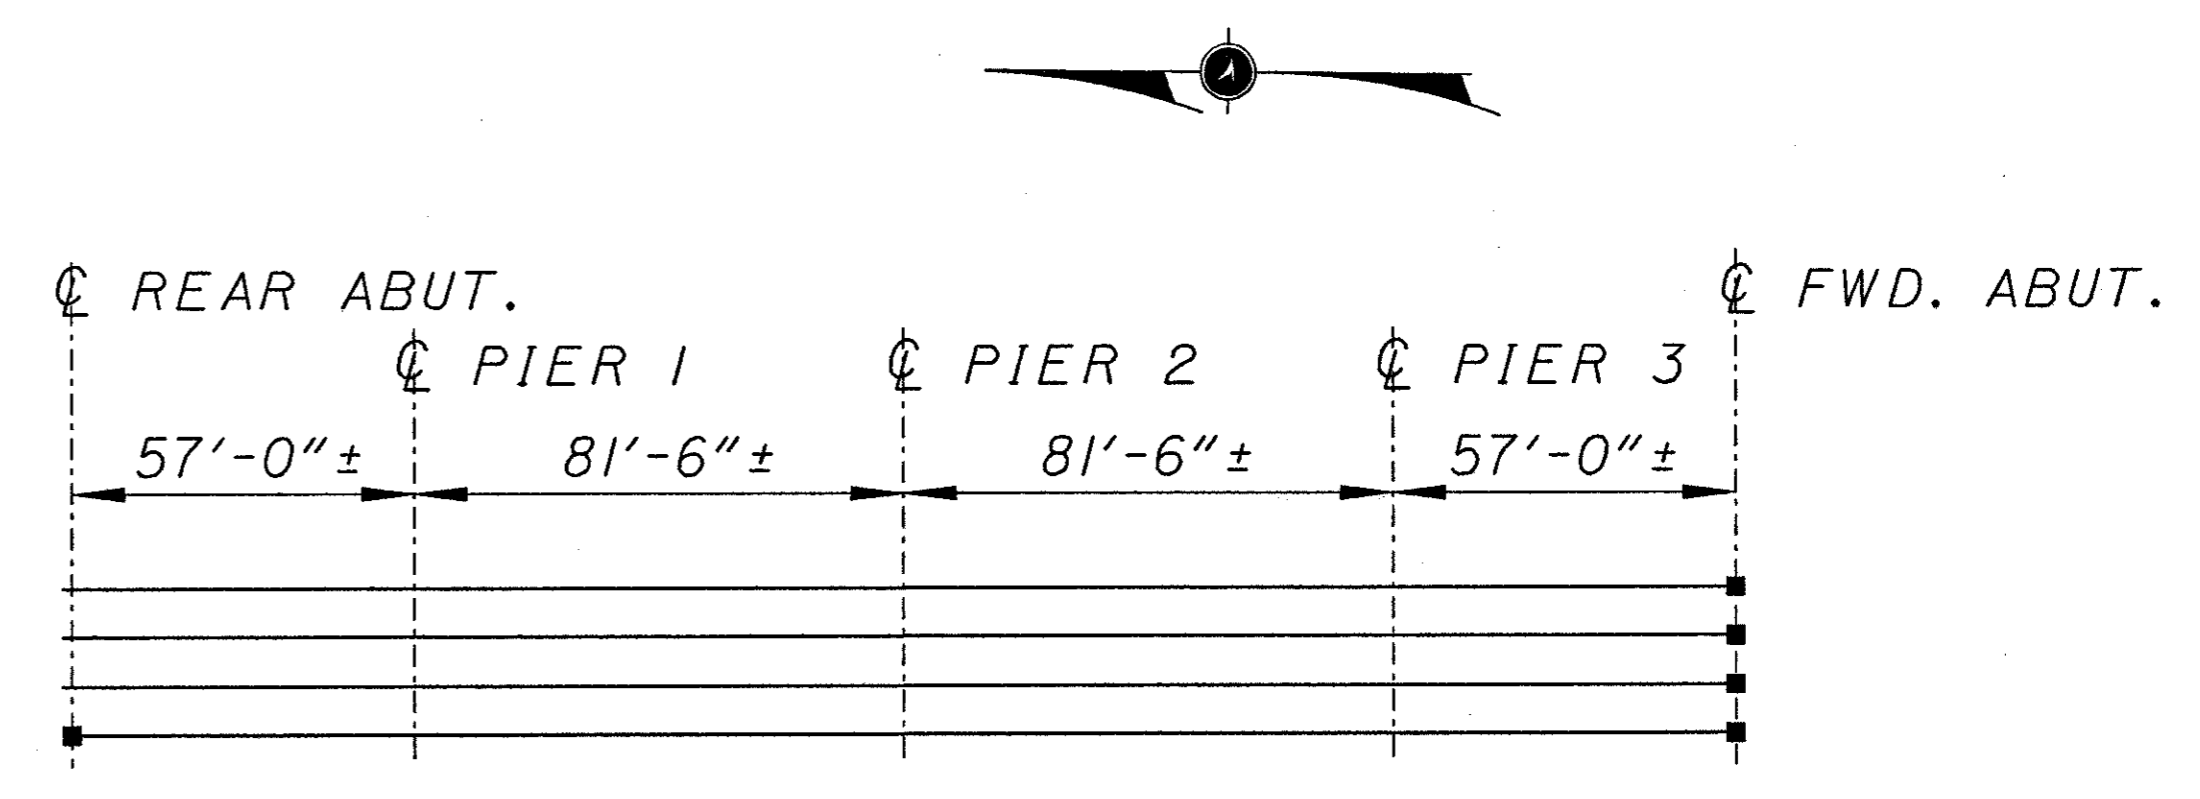

FRAMING PLAN

■ INDICATES R-75 BEARING THAT NEEDS TO BE REPOSITIONED.


KZF BRIDGE #4

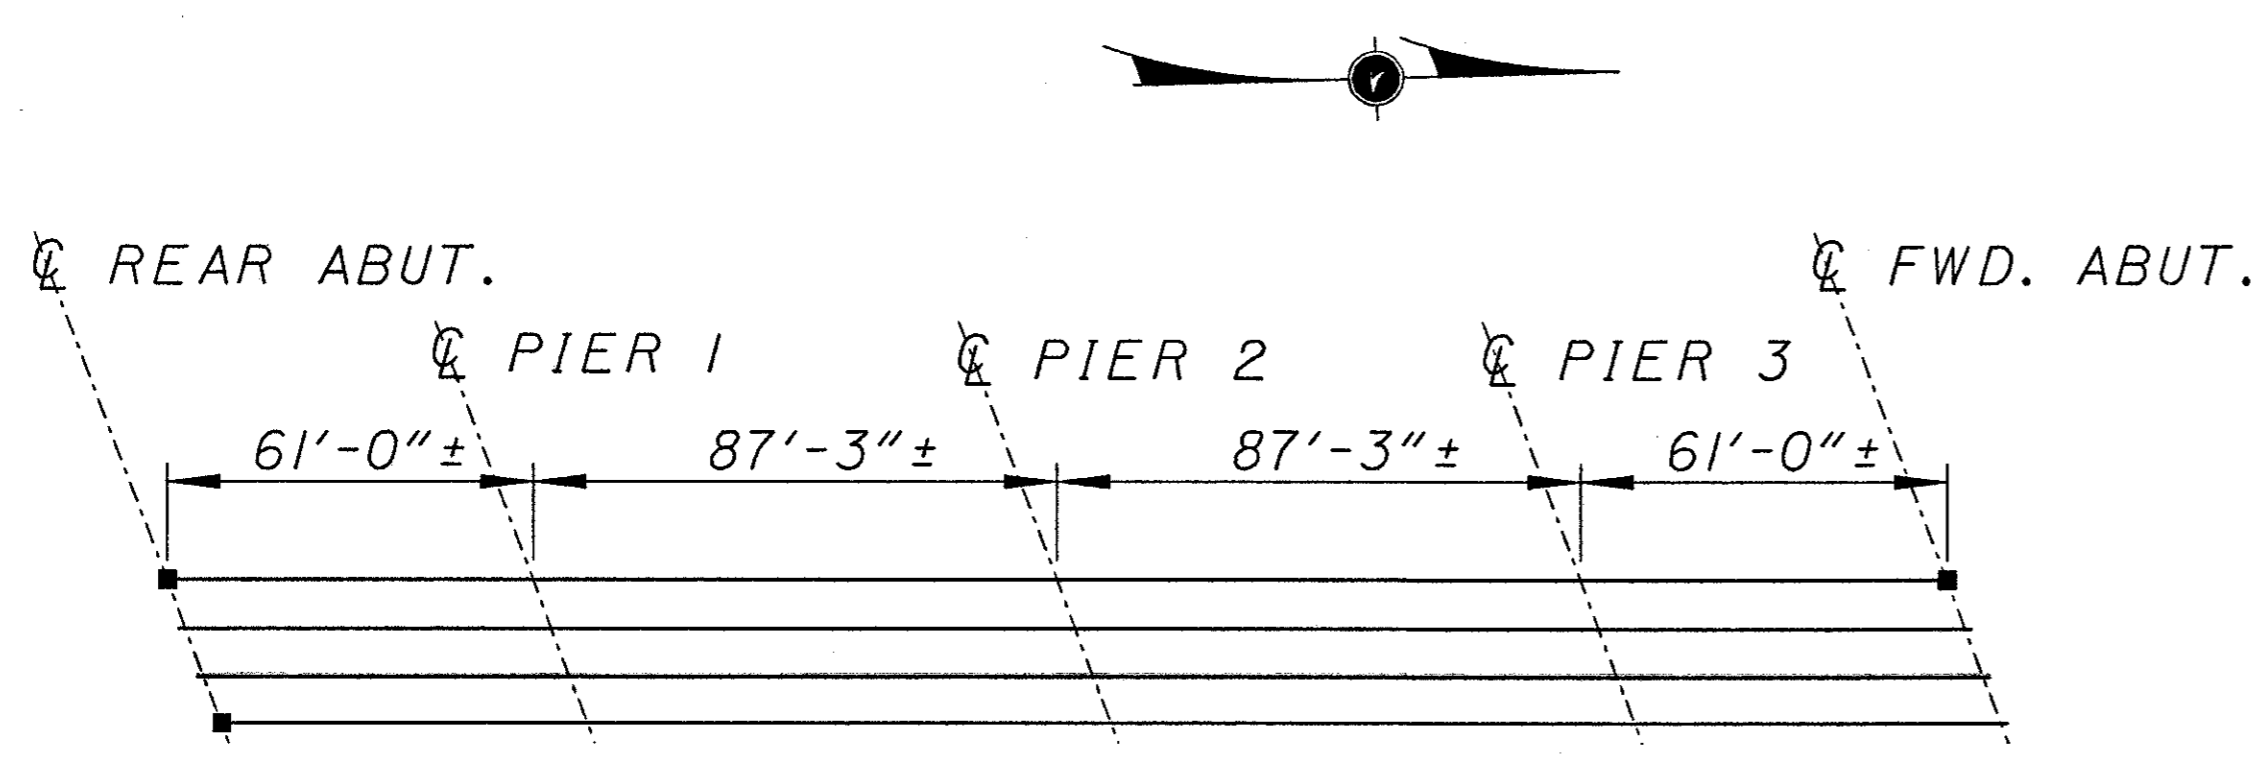

FRAMING PLAN

■ INDICATES R-75 BEARING THAT NEEDS TO BE REPOSITIONED.

KZF BRIDGE #5

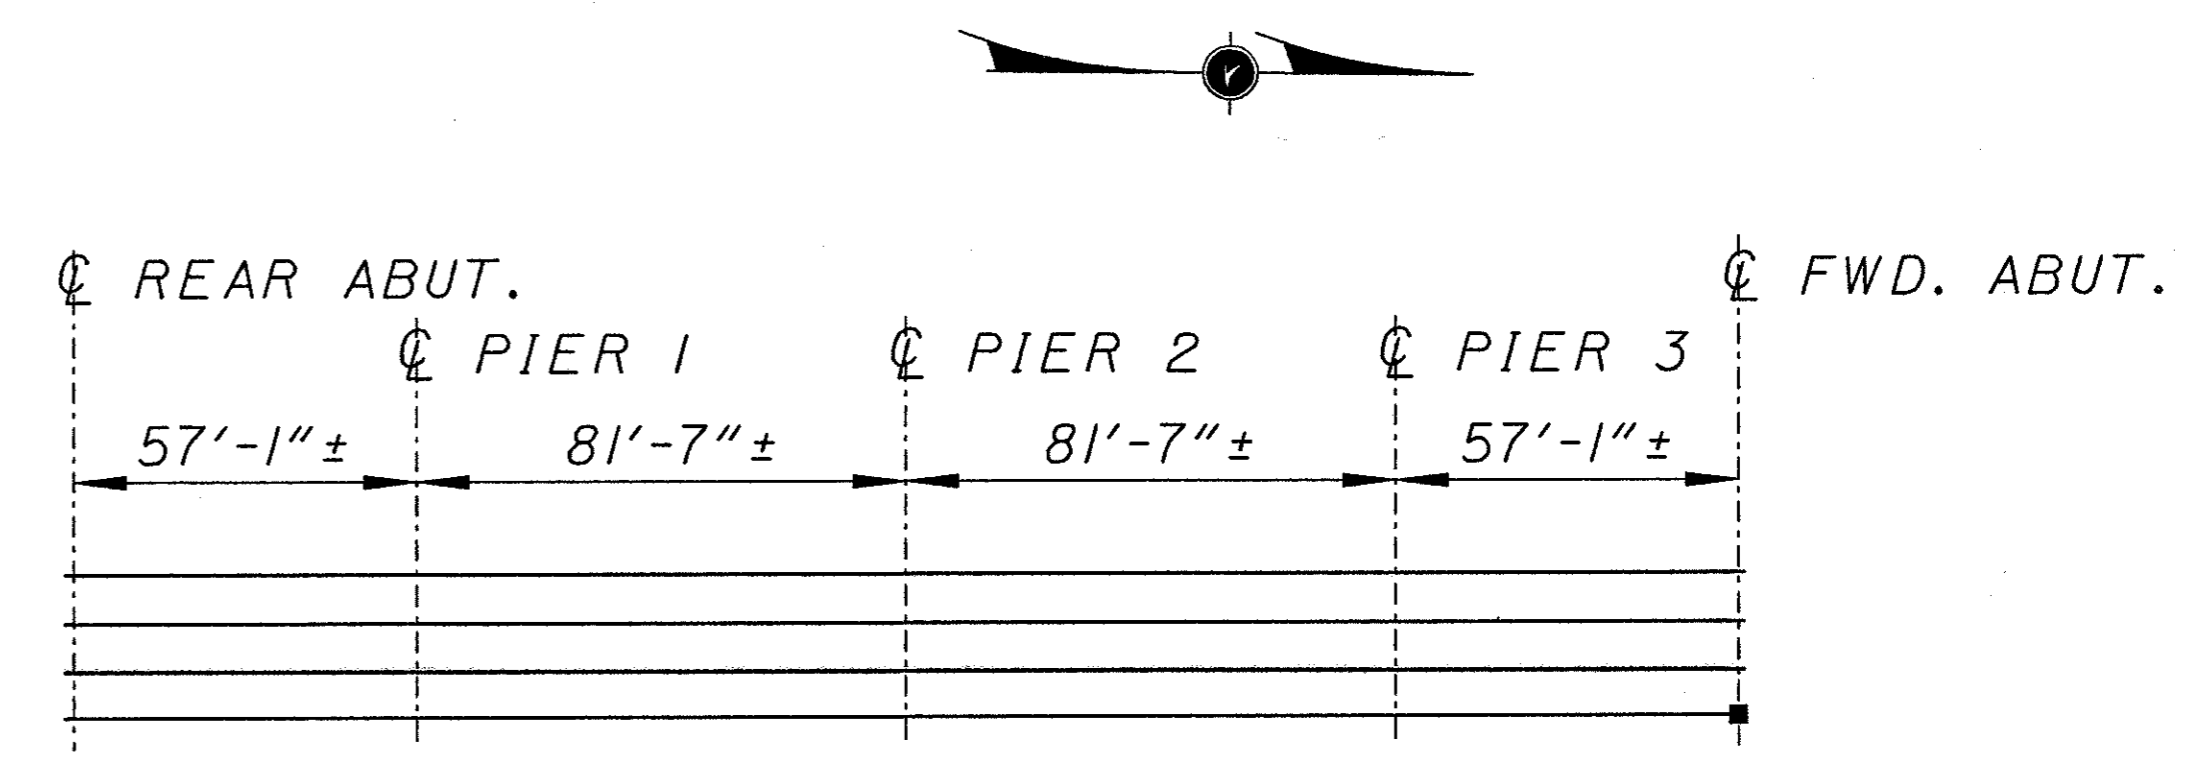

FRAMING PLAN

■ INDICATES R-75 BEARING THAT NEEDS TO BE REPOSITIONED.

KZF BRIDGE #7

DESIGNED	CHECKED	DRAWN	REVIEWED	DATE

BEARING REQUIRING REPOSITIONING

PRE-70-0.00

20/24

279
283


REF: **REF: **
REF: **REF: **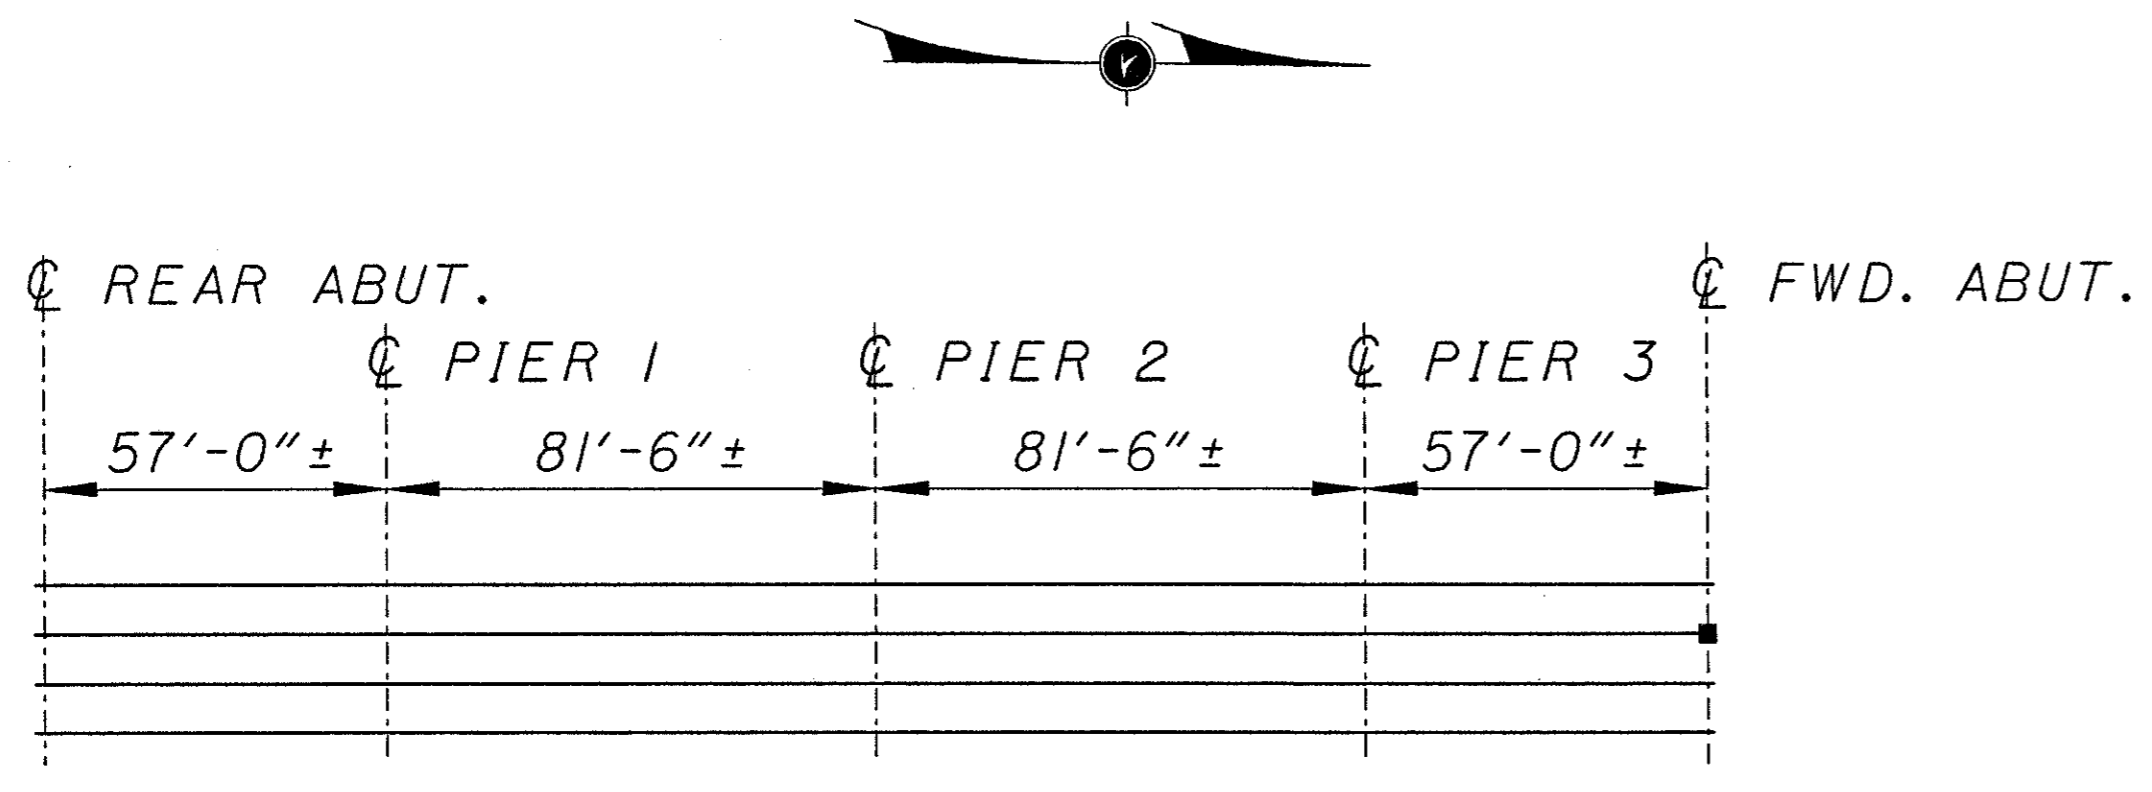
FRAMING PLAN

▪ INDICATES R-75 BEARING THAT NEEDS TO BE REPOSITIONED.


KZF BRIDGE #9

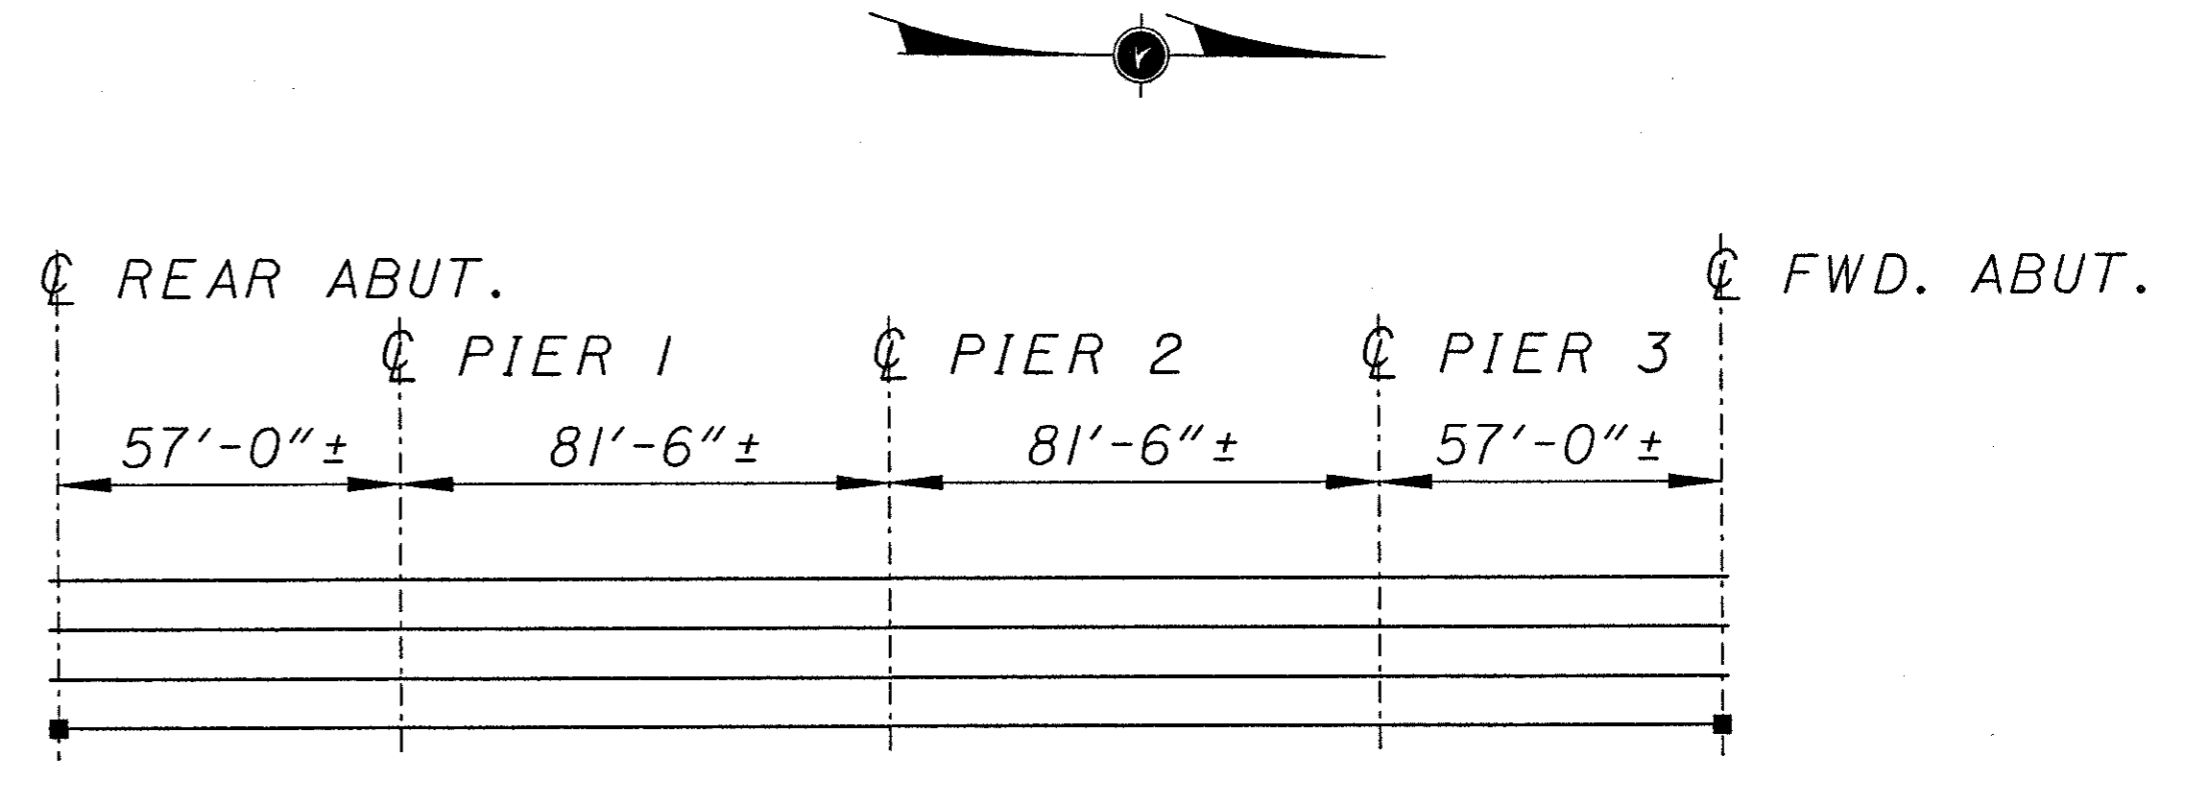

FRAMING PLAN

▪ INDICATES R-75 BEARING THAT NEEDS TO BE REPOSITIONED.

KZF BRIDGE #10

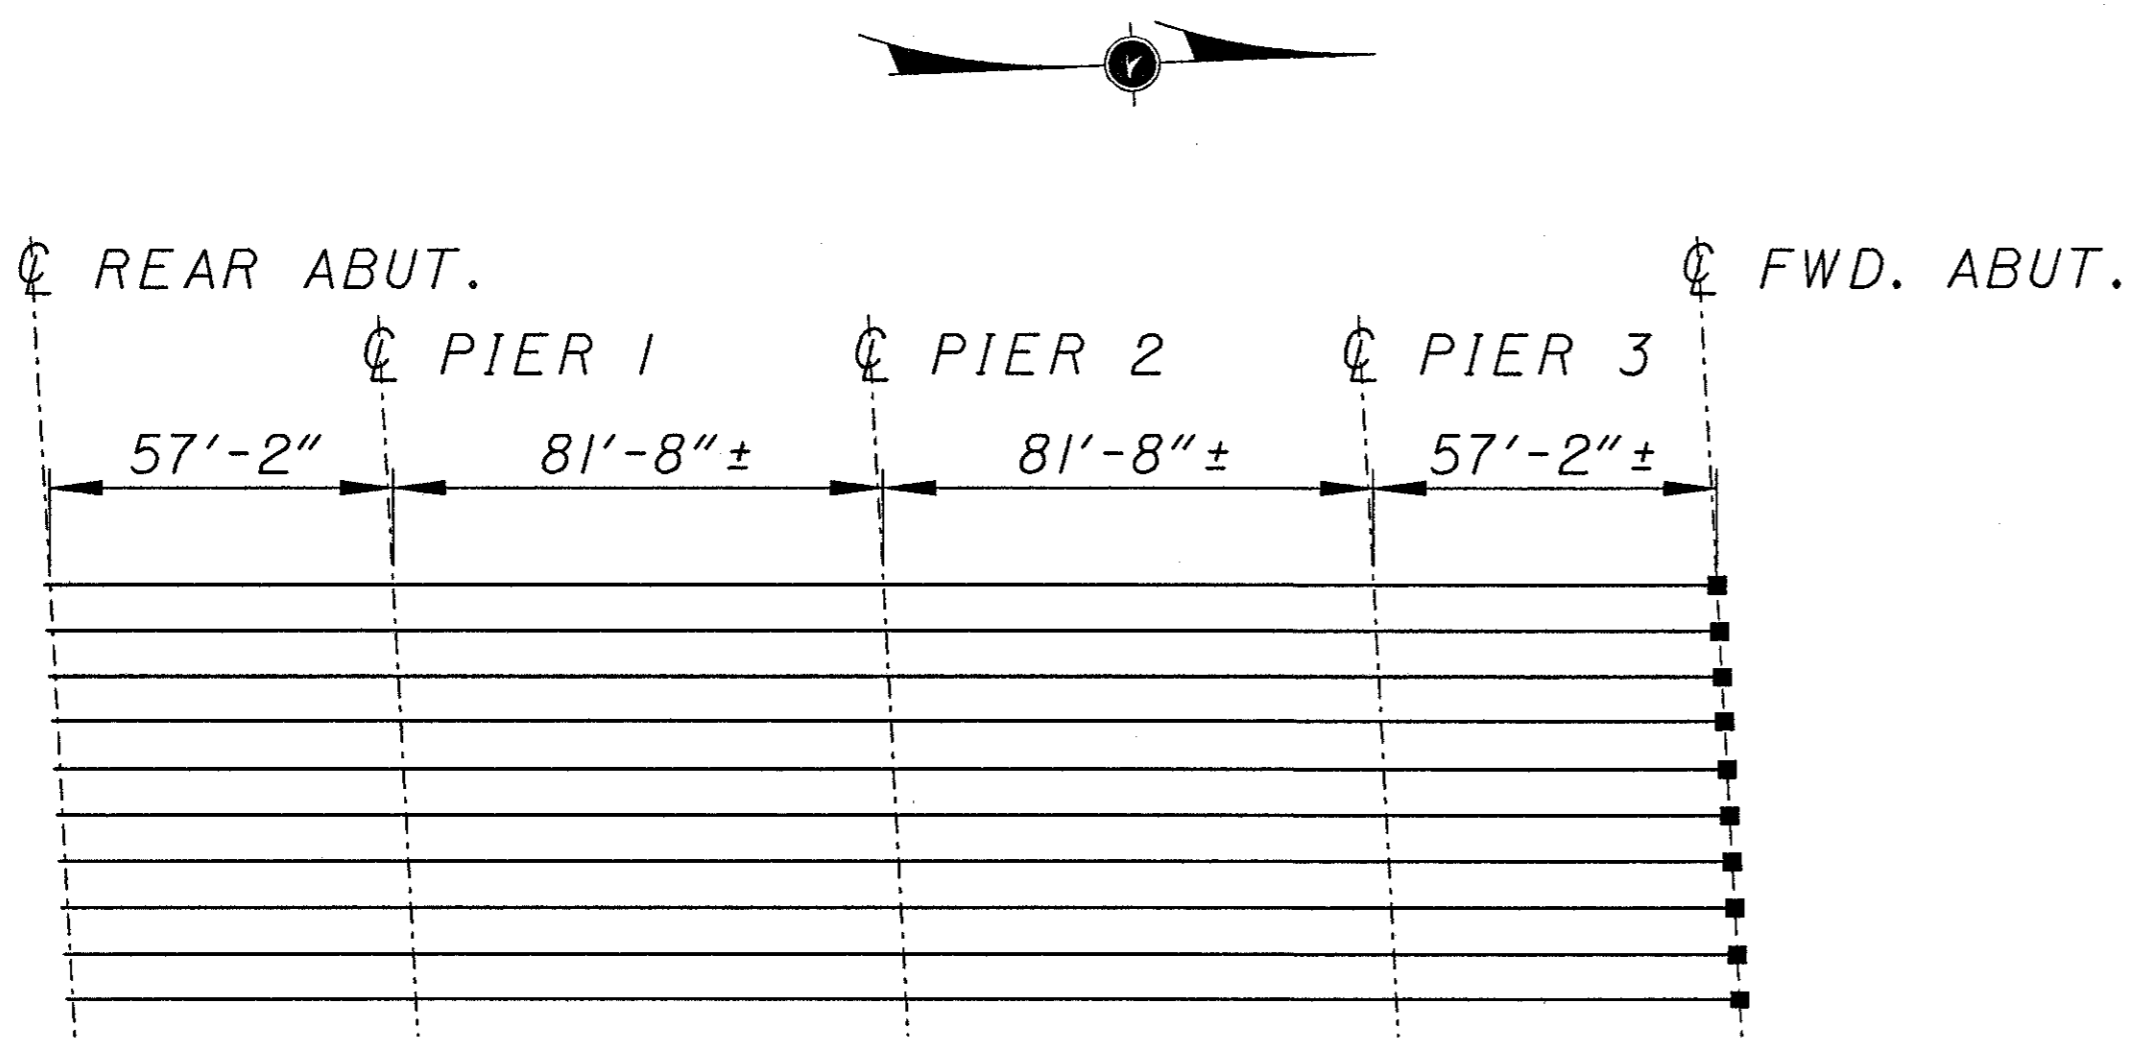

FRAMING PLAN

▪ INDICATES R-100 (MOD.) BEARING THAT NEEDS TO BE REPOSITIONED.

KZF BRIDGE #11

DATE	REVISION	STRUCTURE FILE NUMBER

DESIGNED
CHECKED










BEARING REQUIRING REPOSITIONING

PRE-70-0.00

21 / 24

280
283

REF: **REF1**
 REF: **REF2**
 REF: **REF3**
 REF: **REF100**

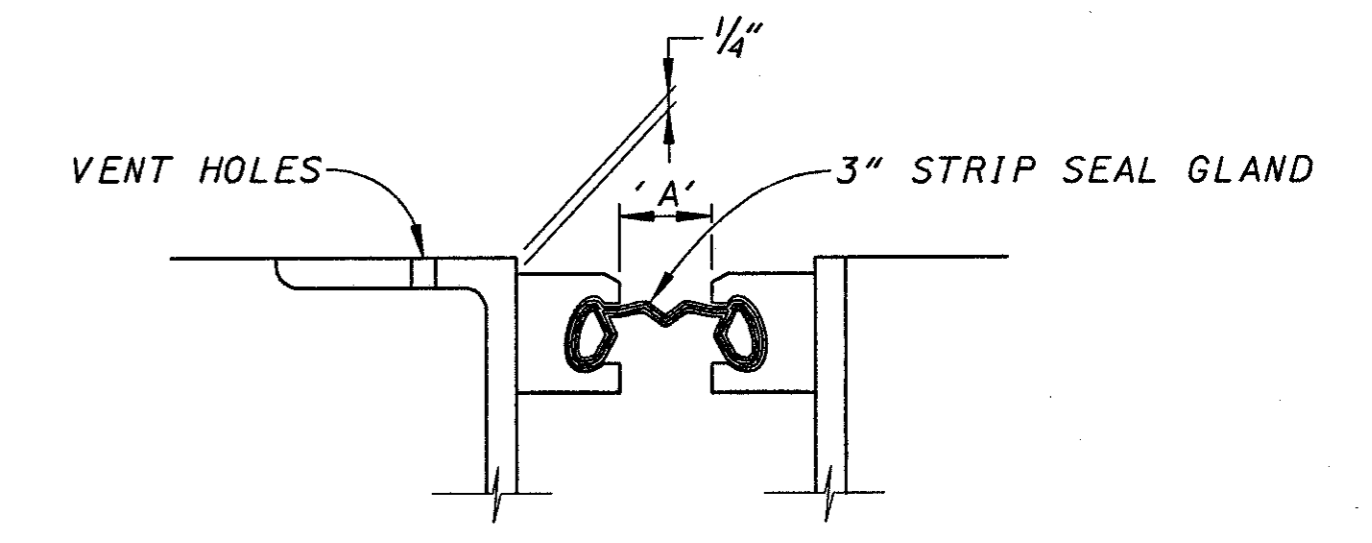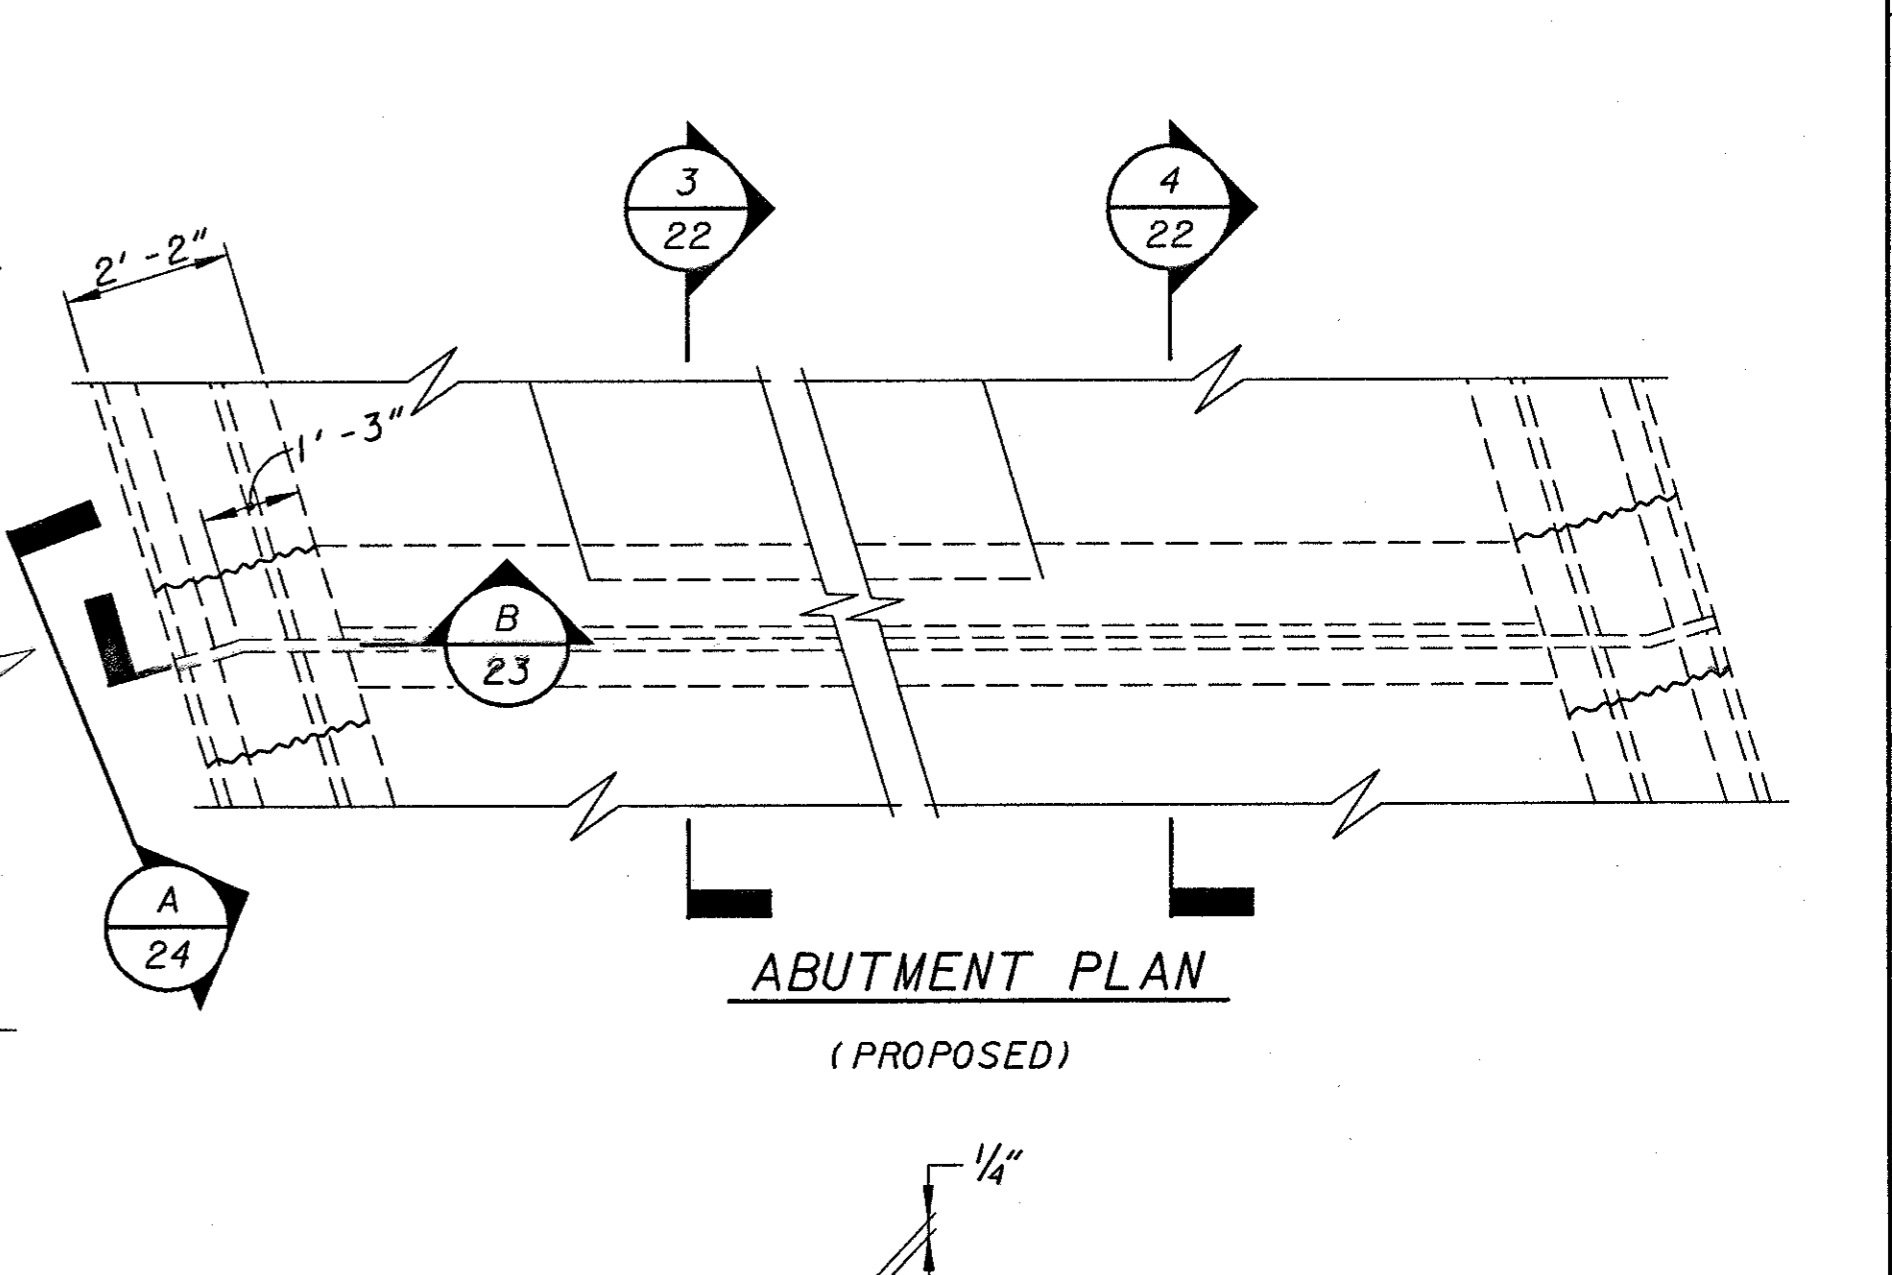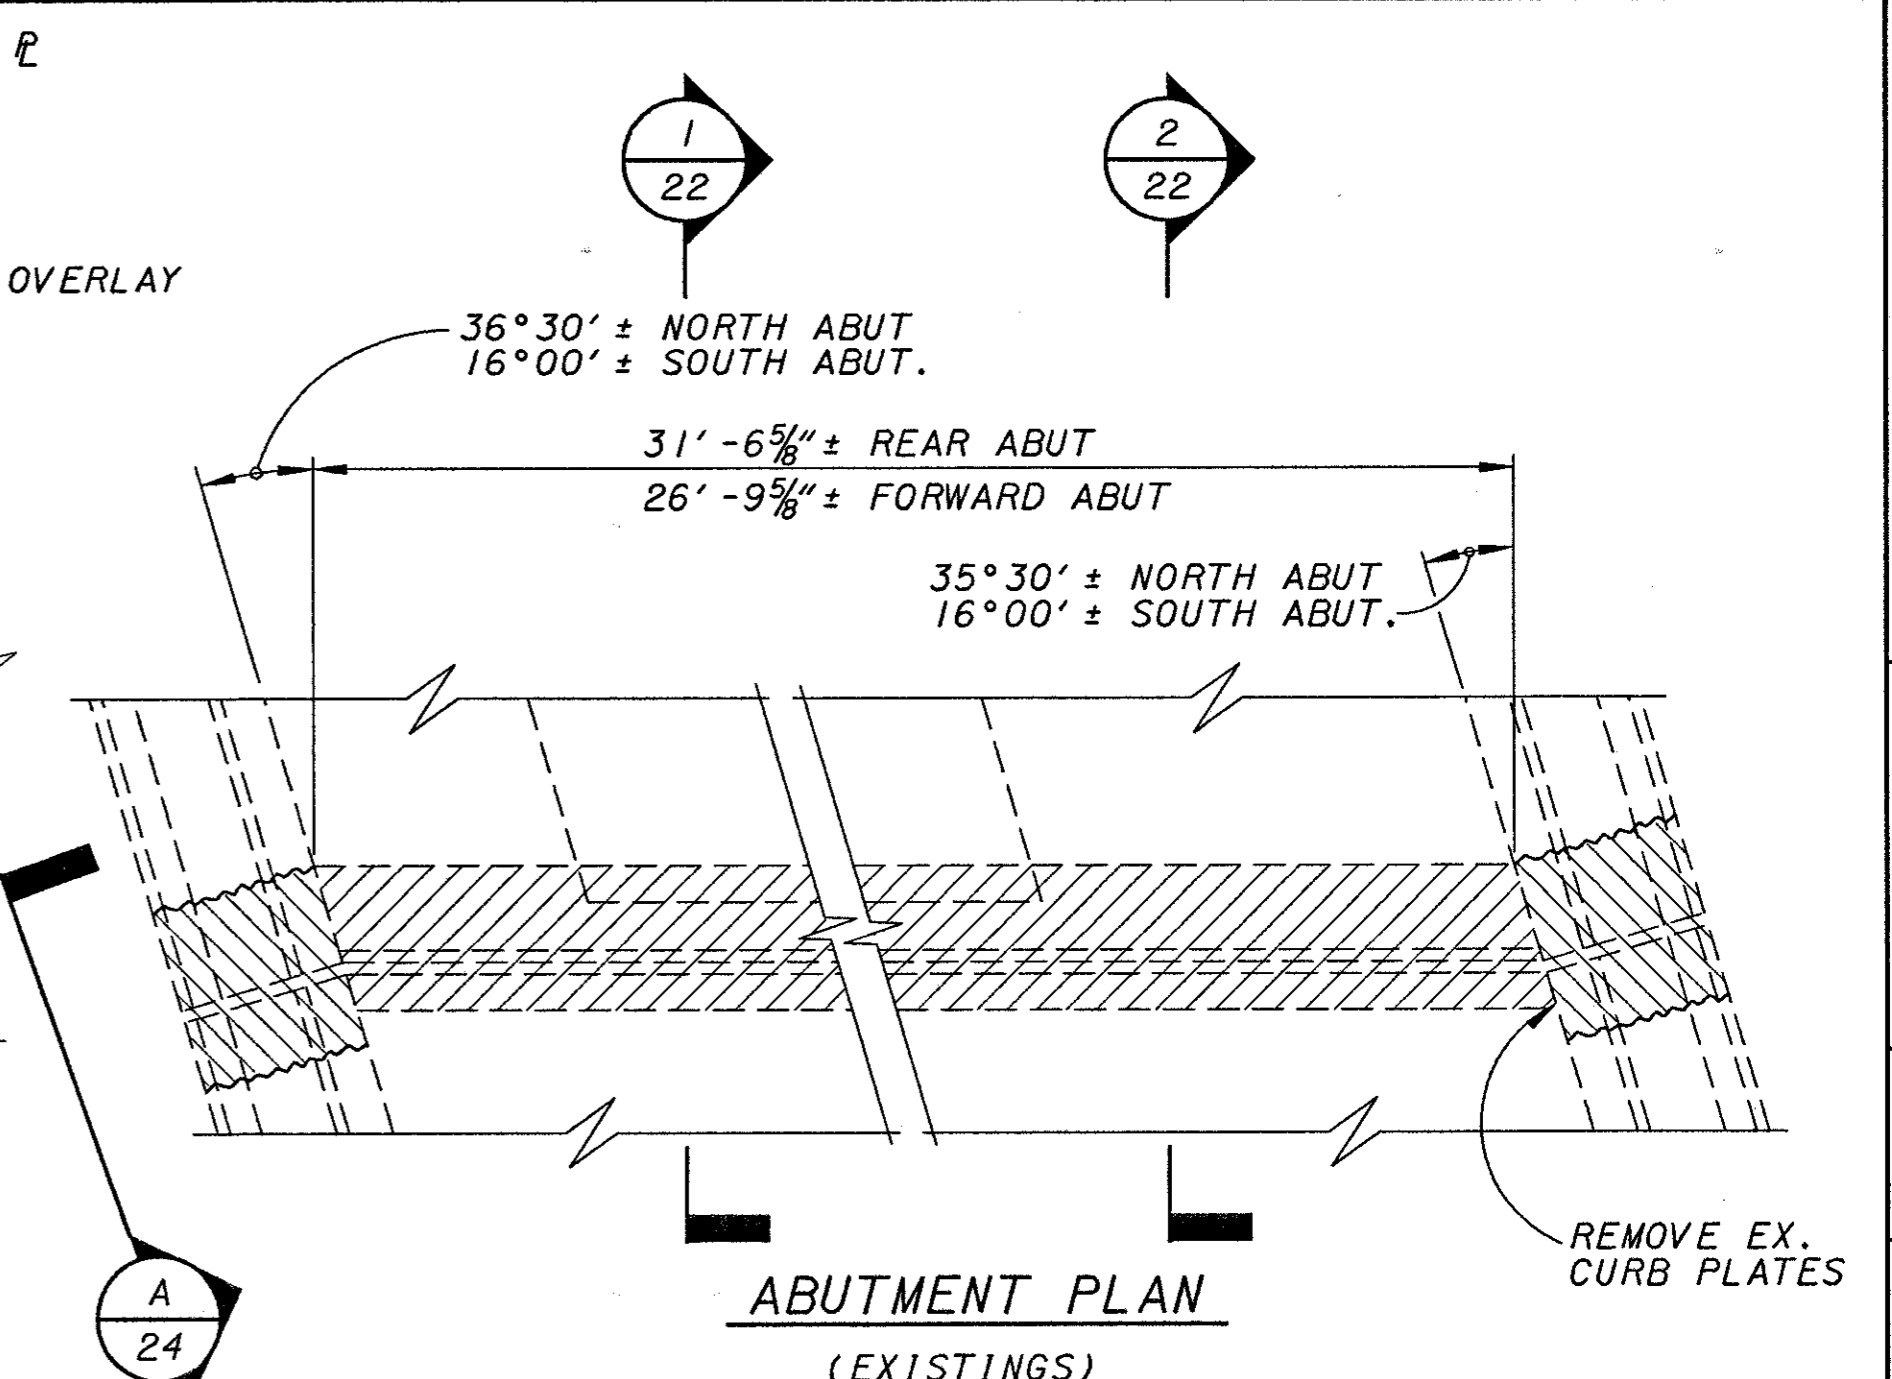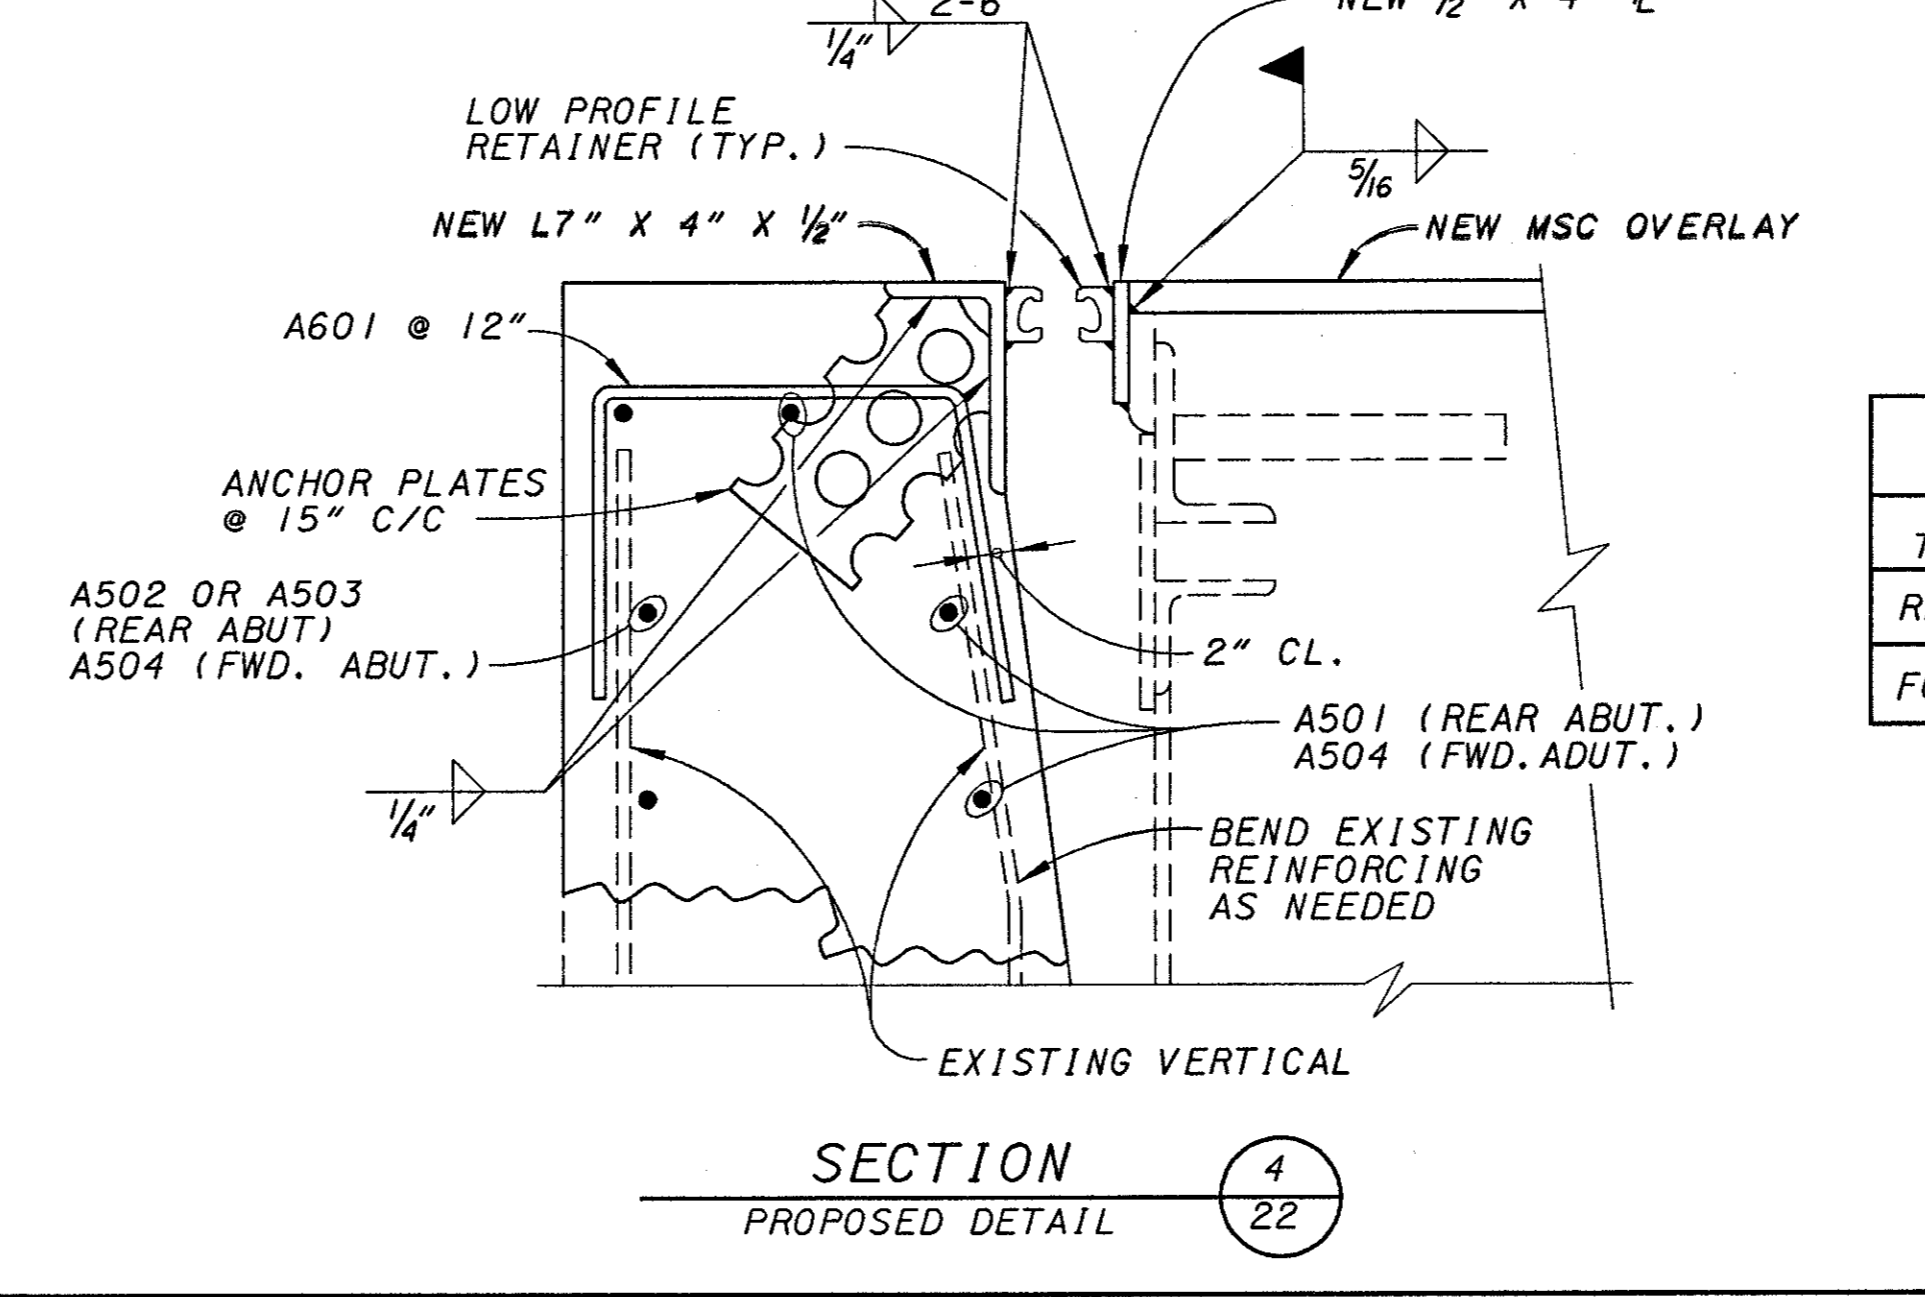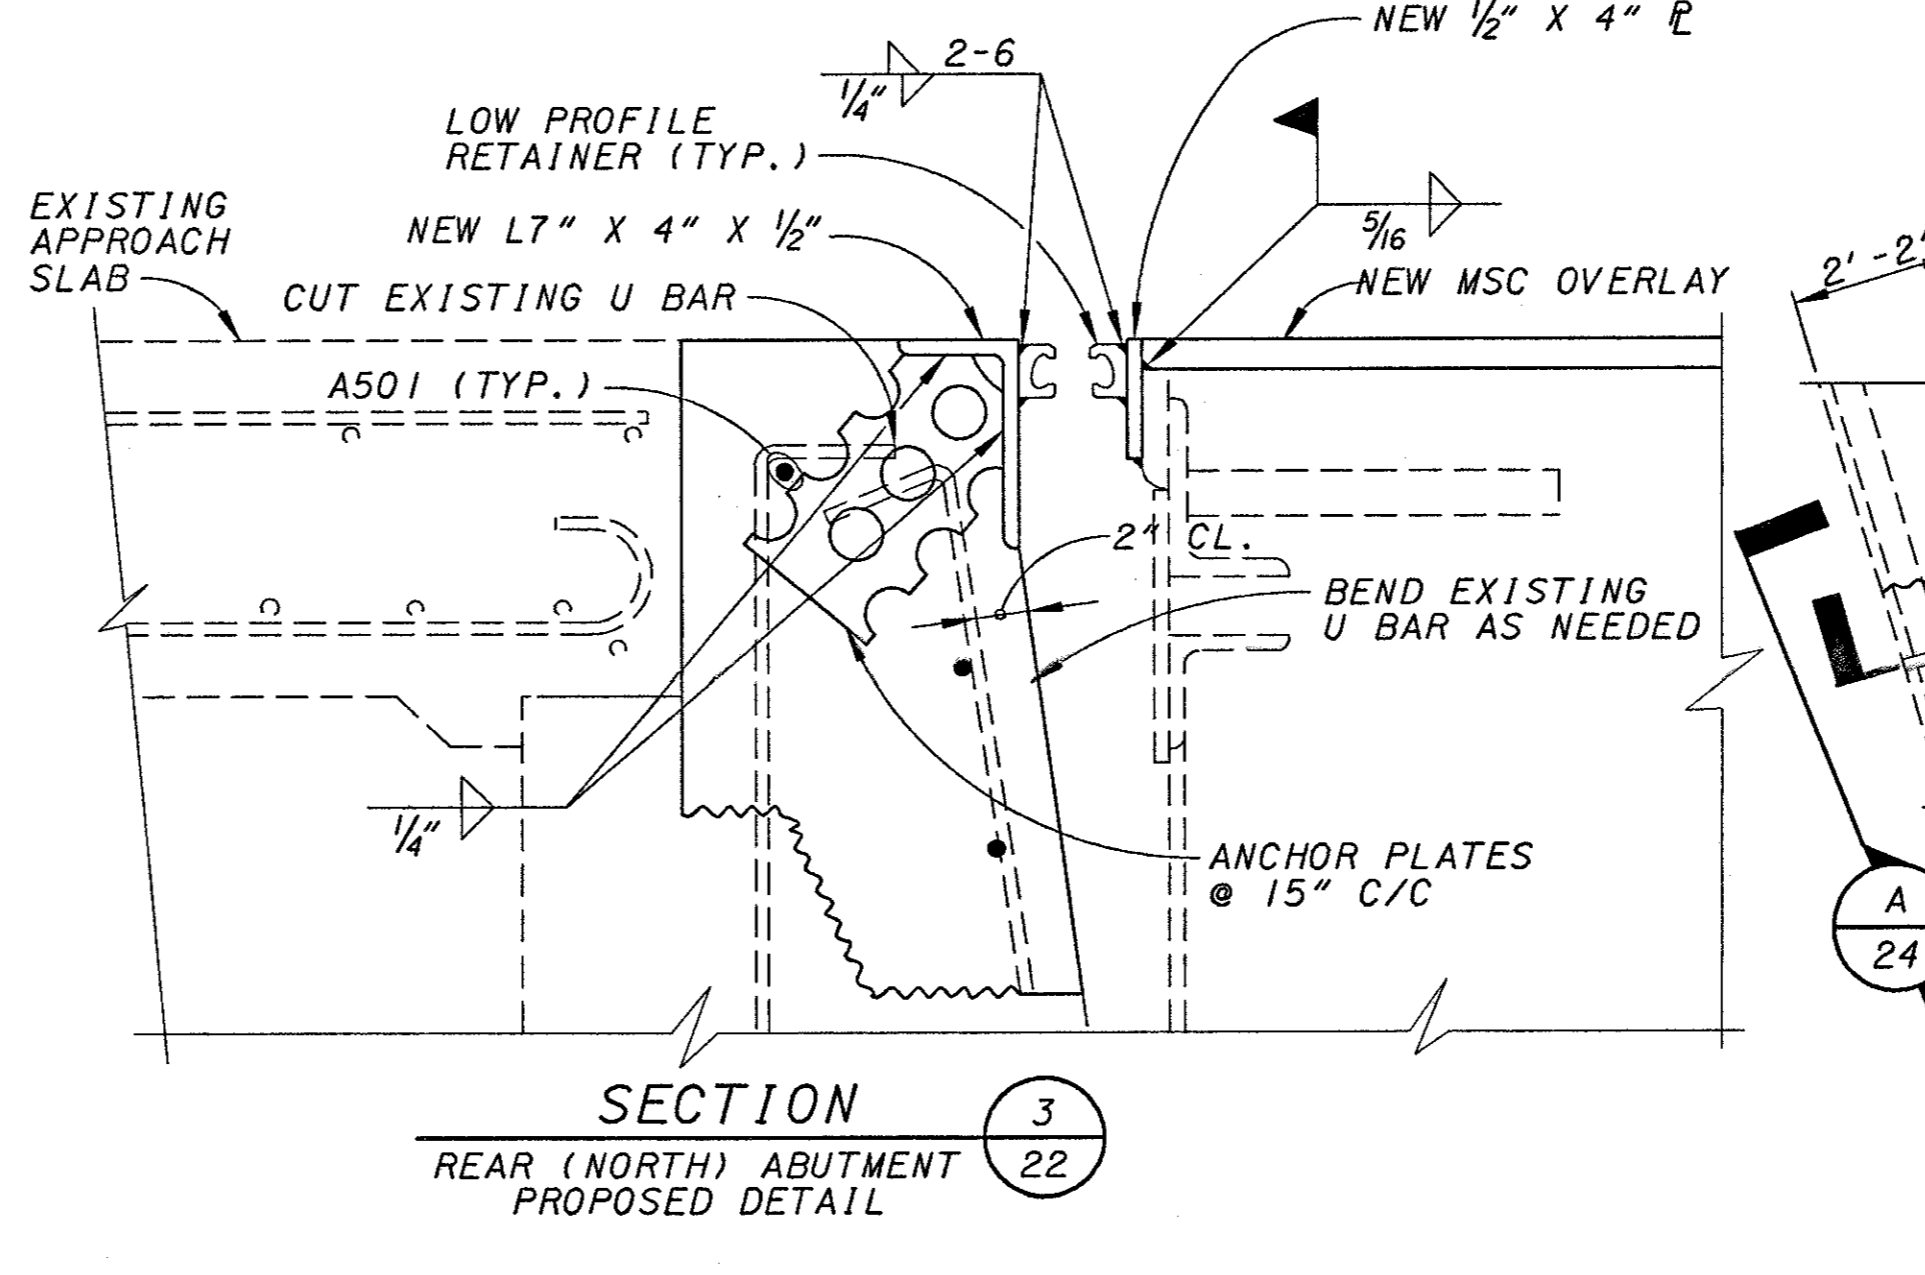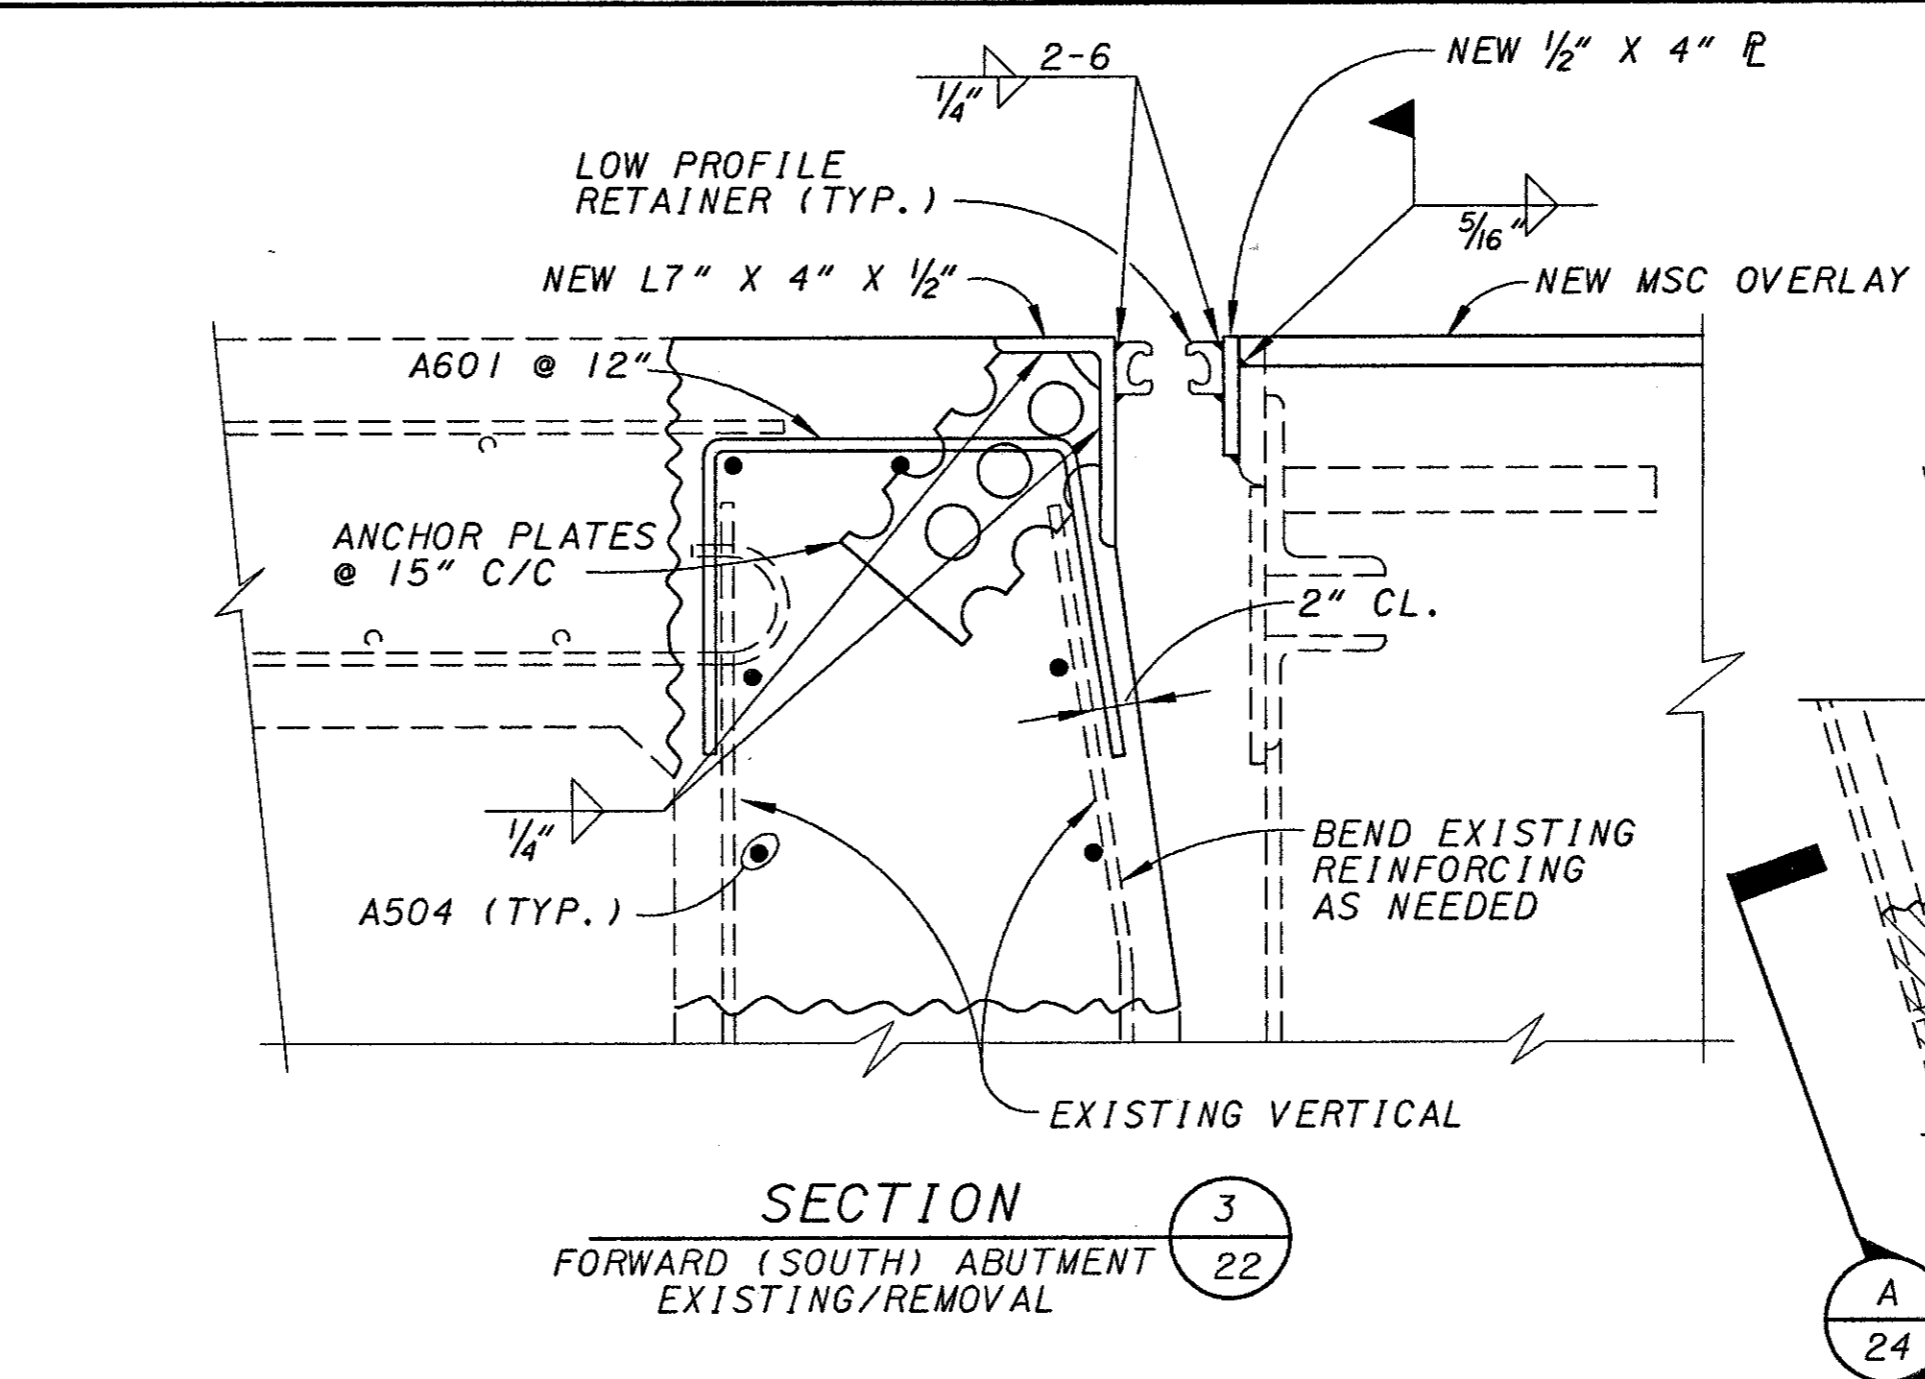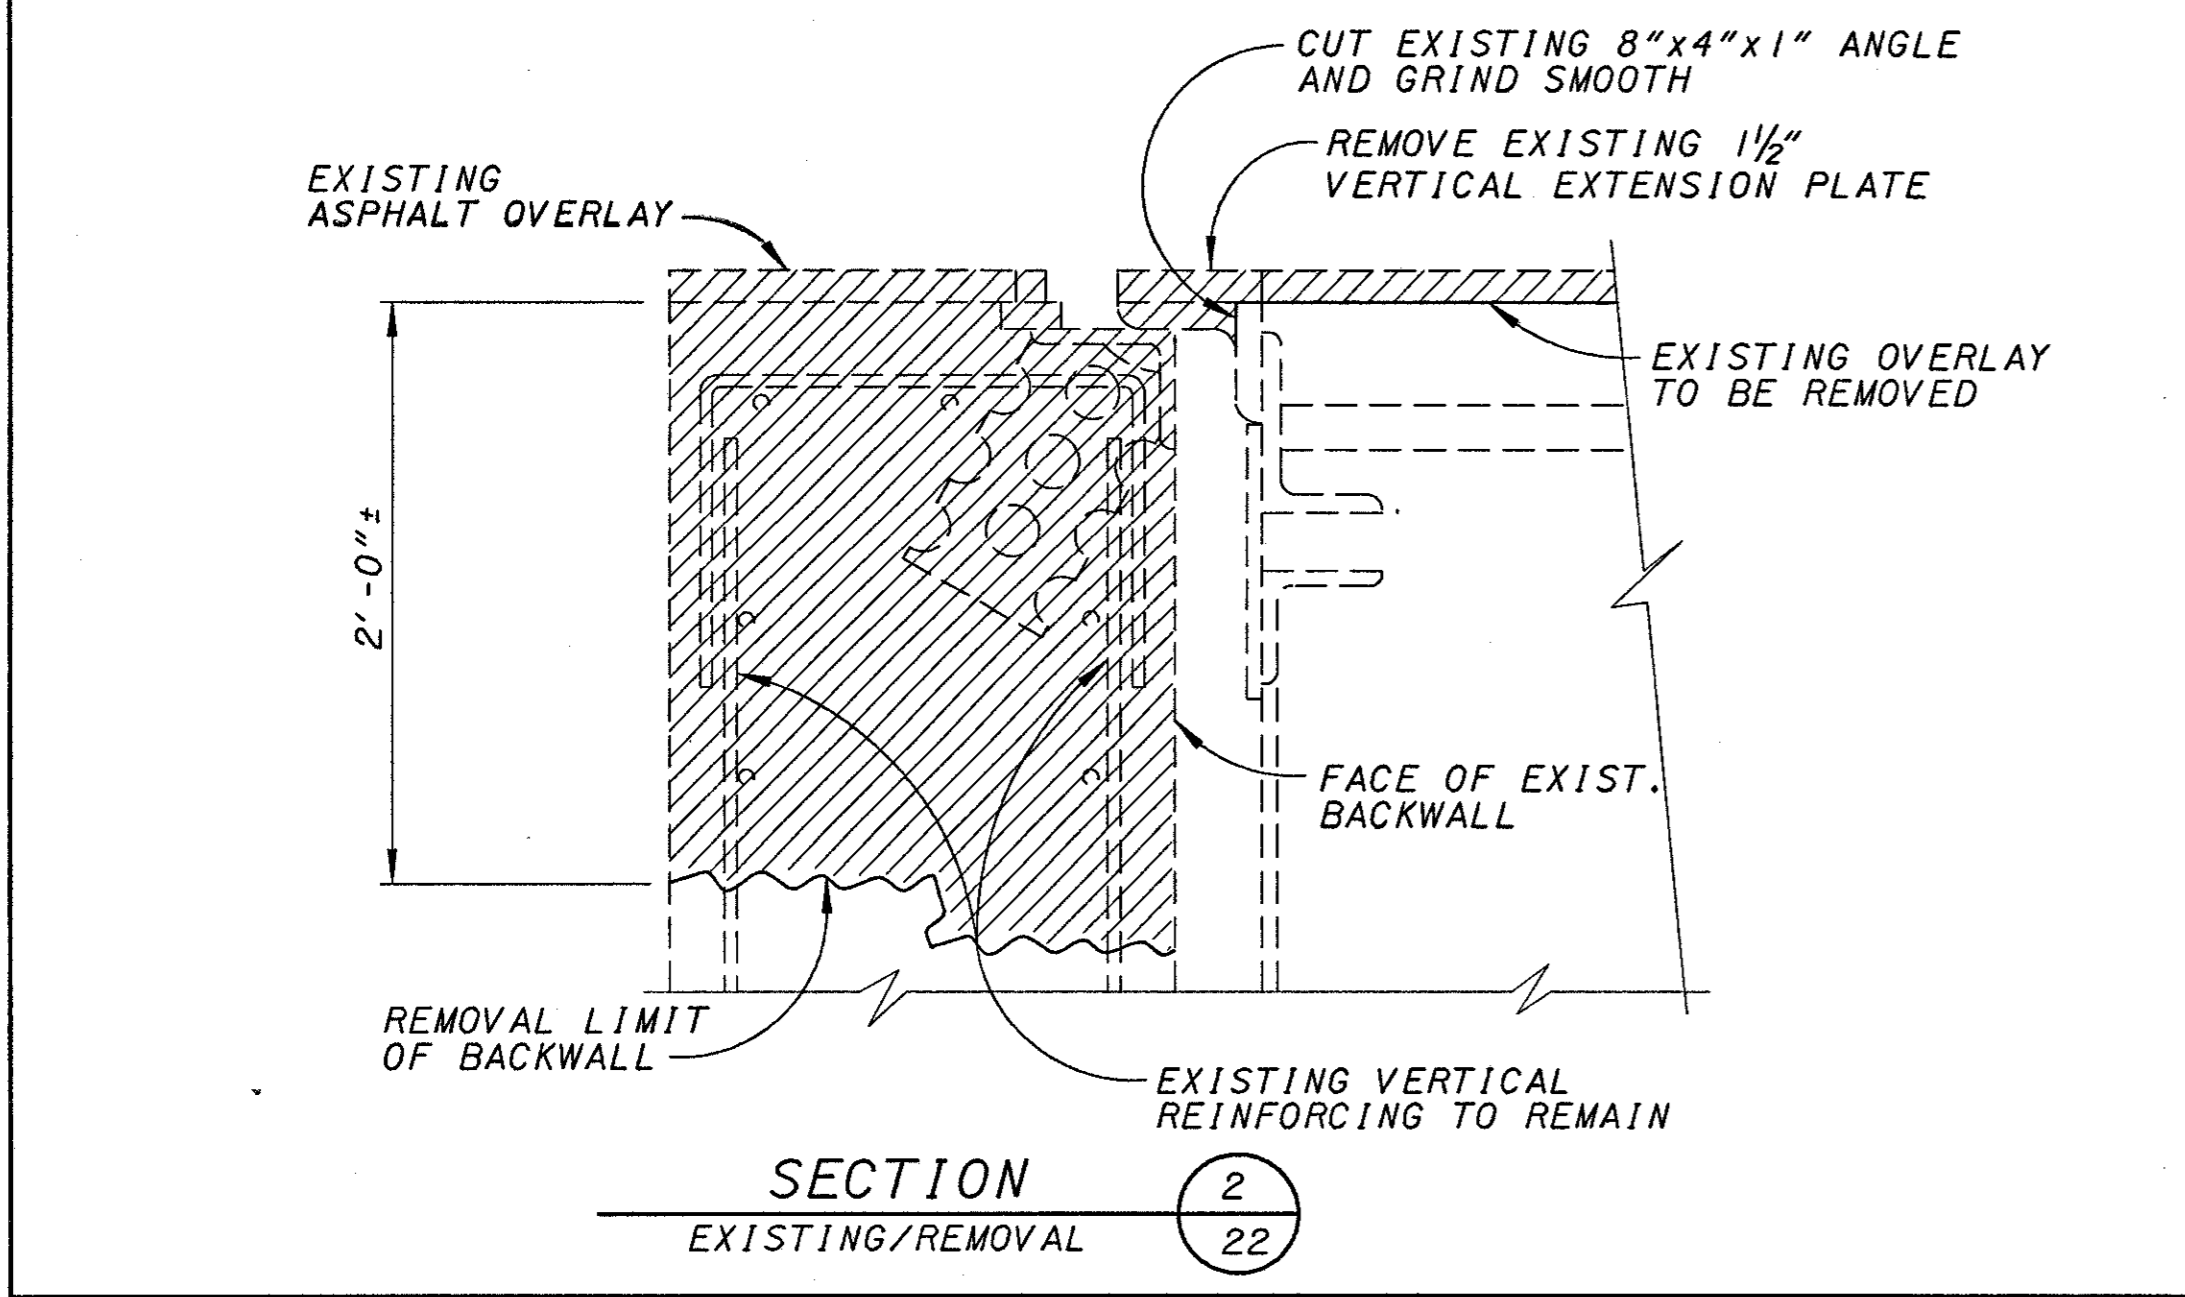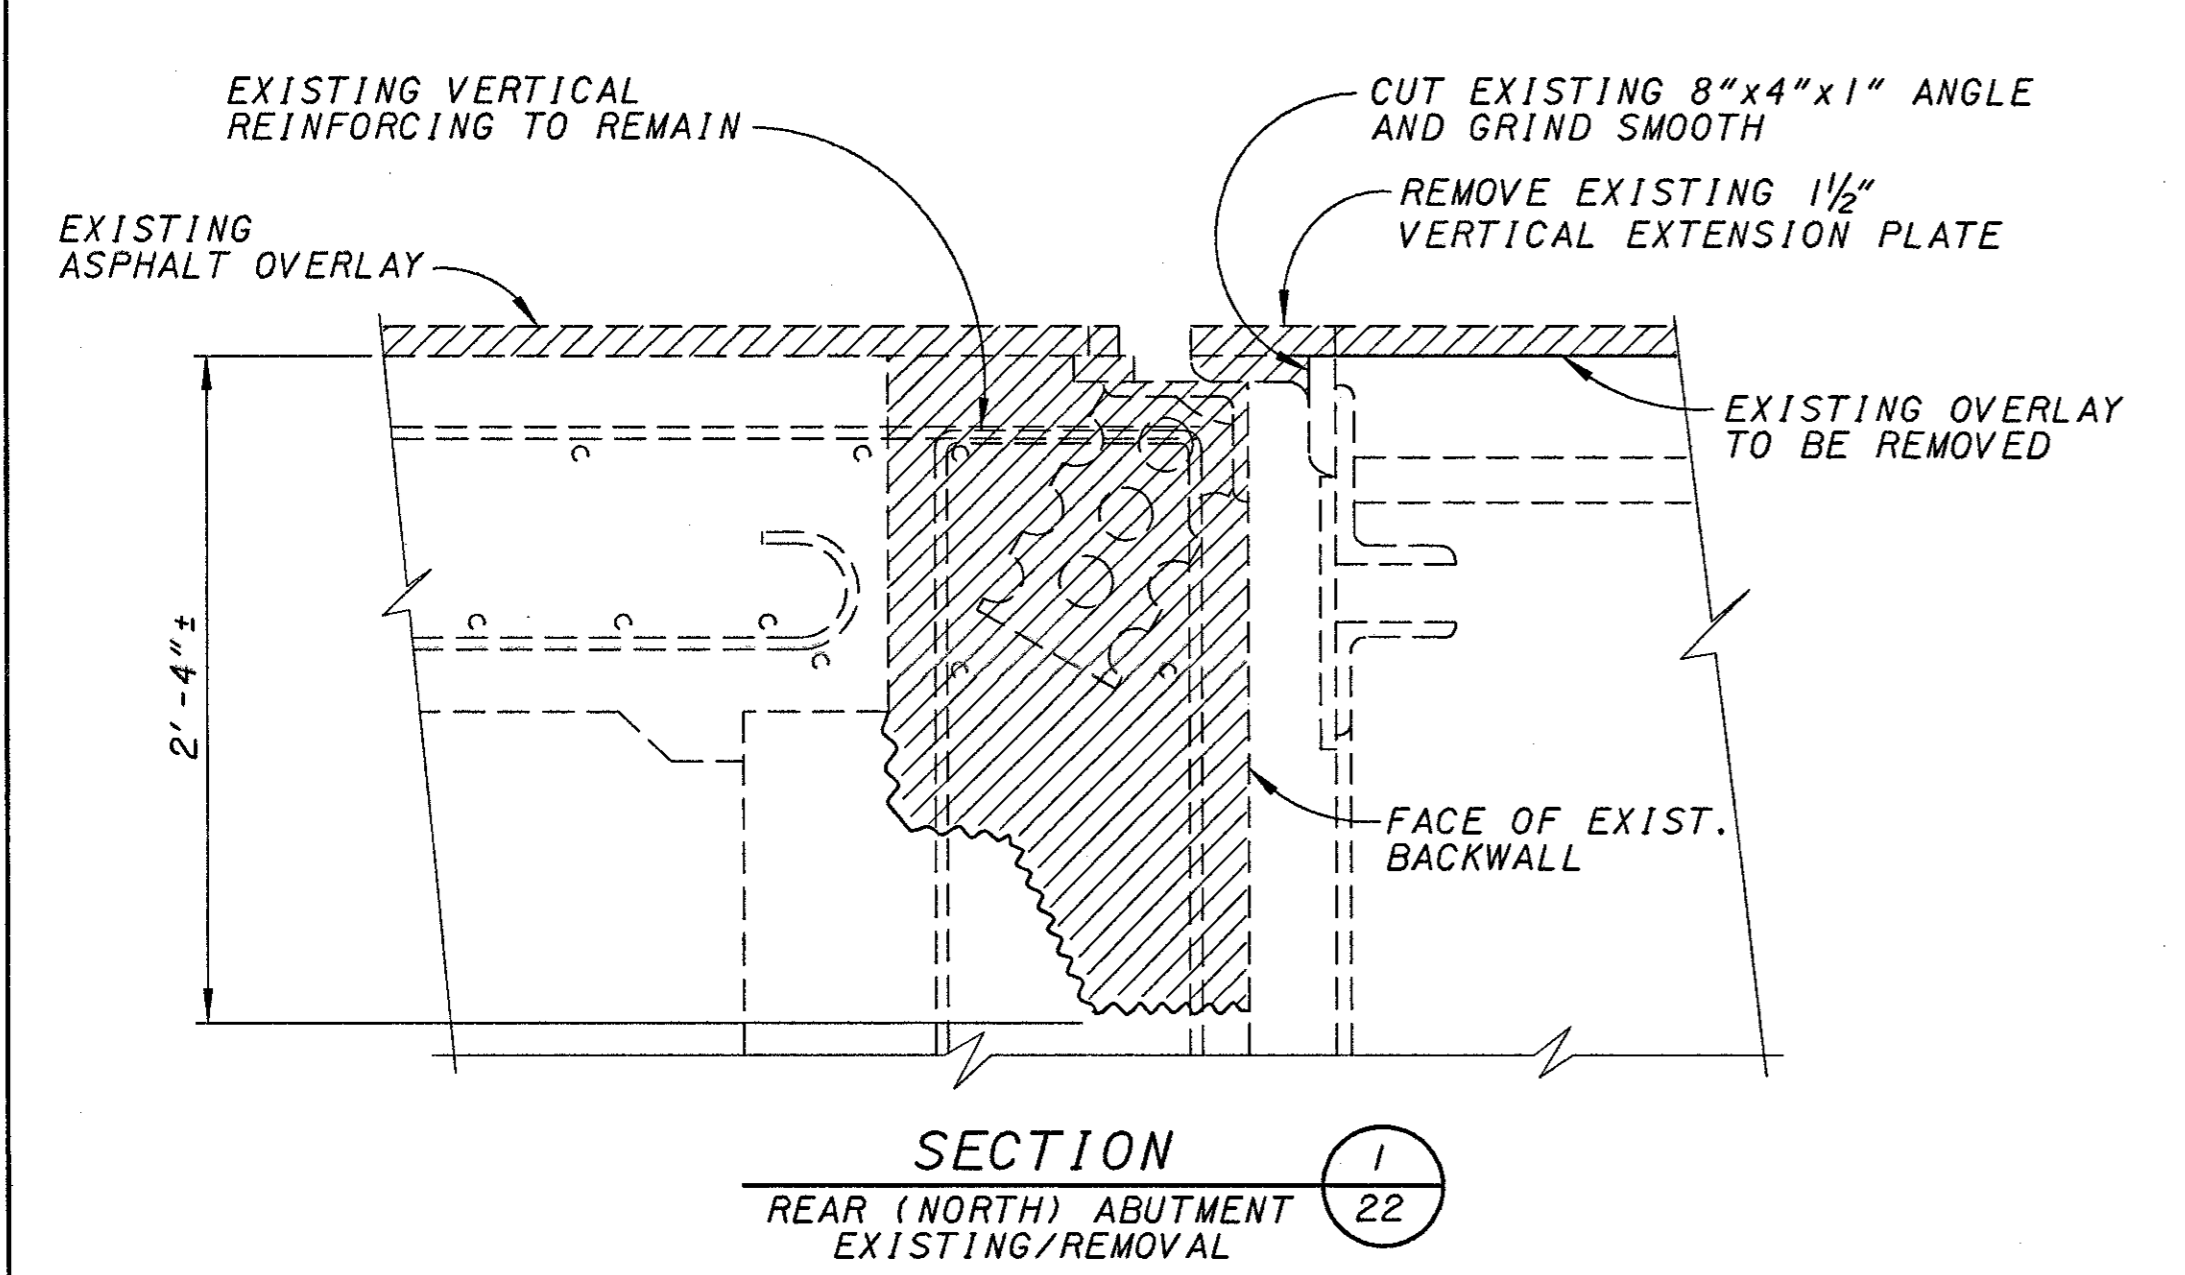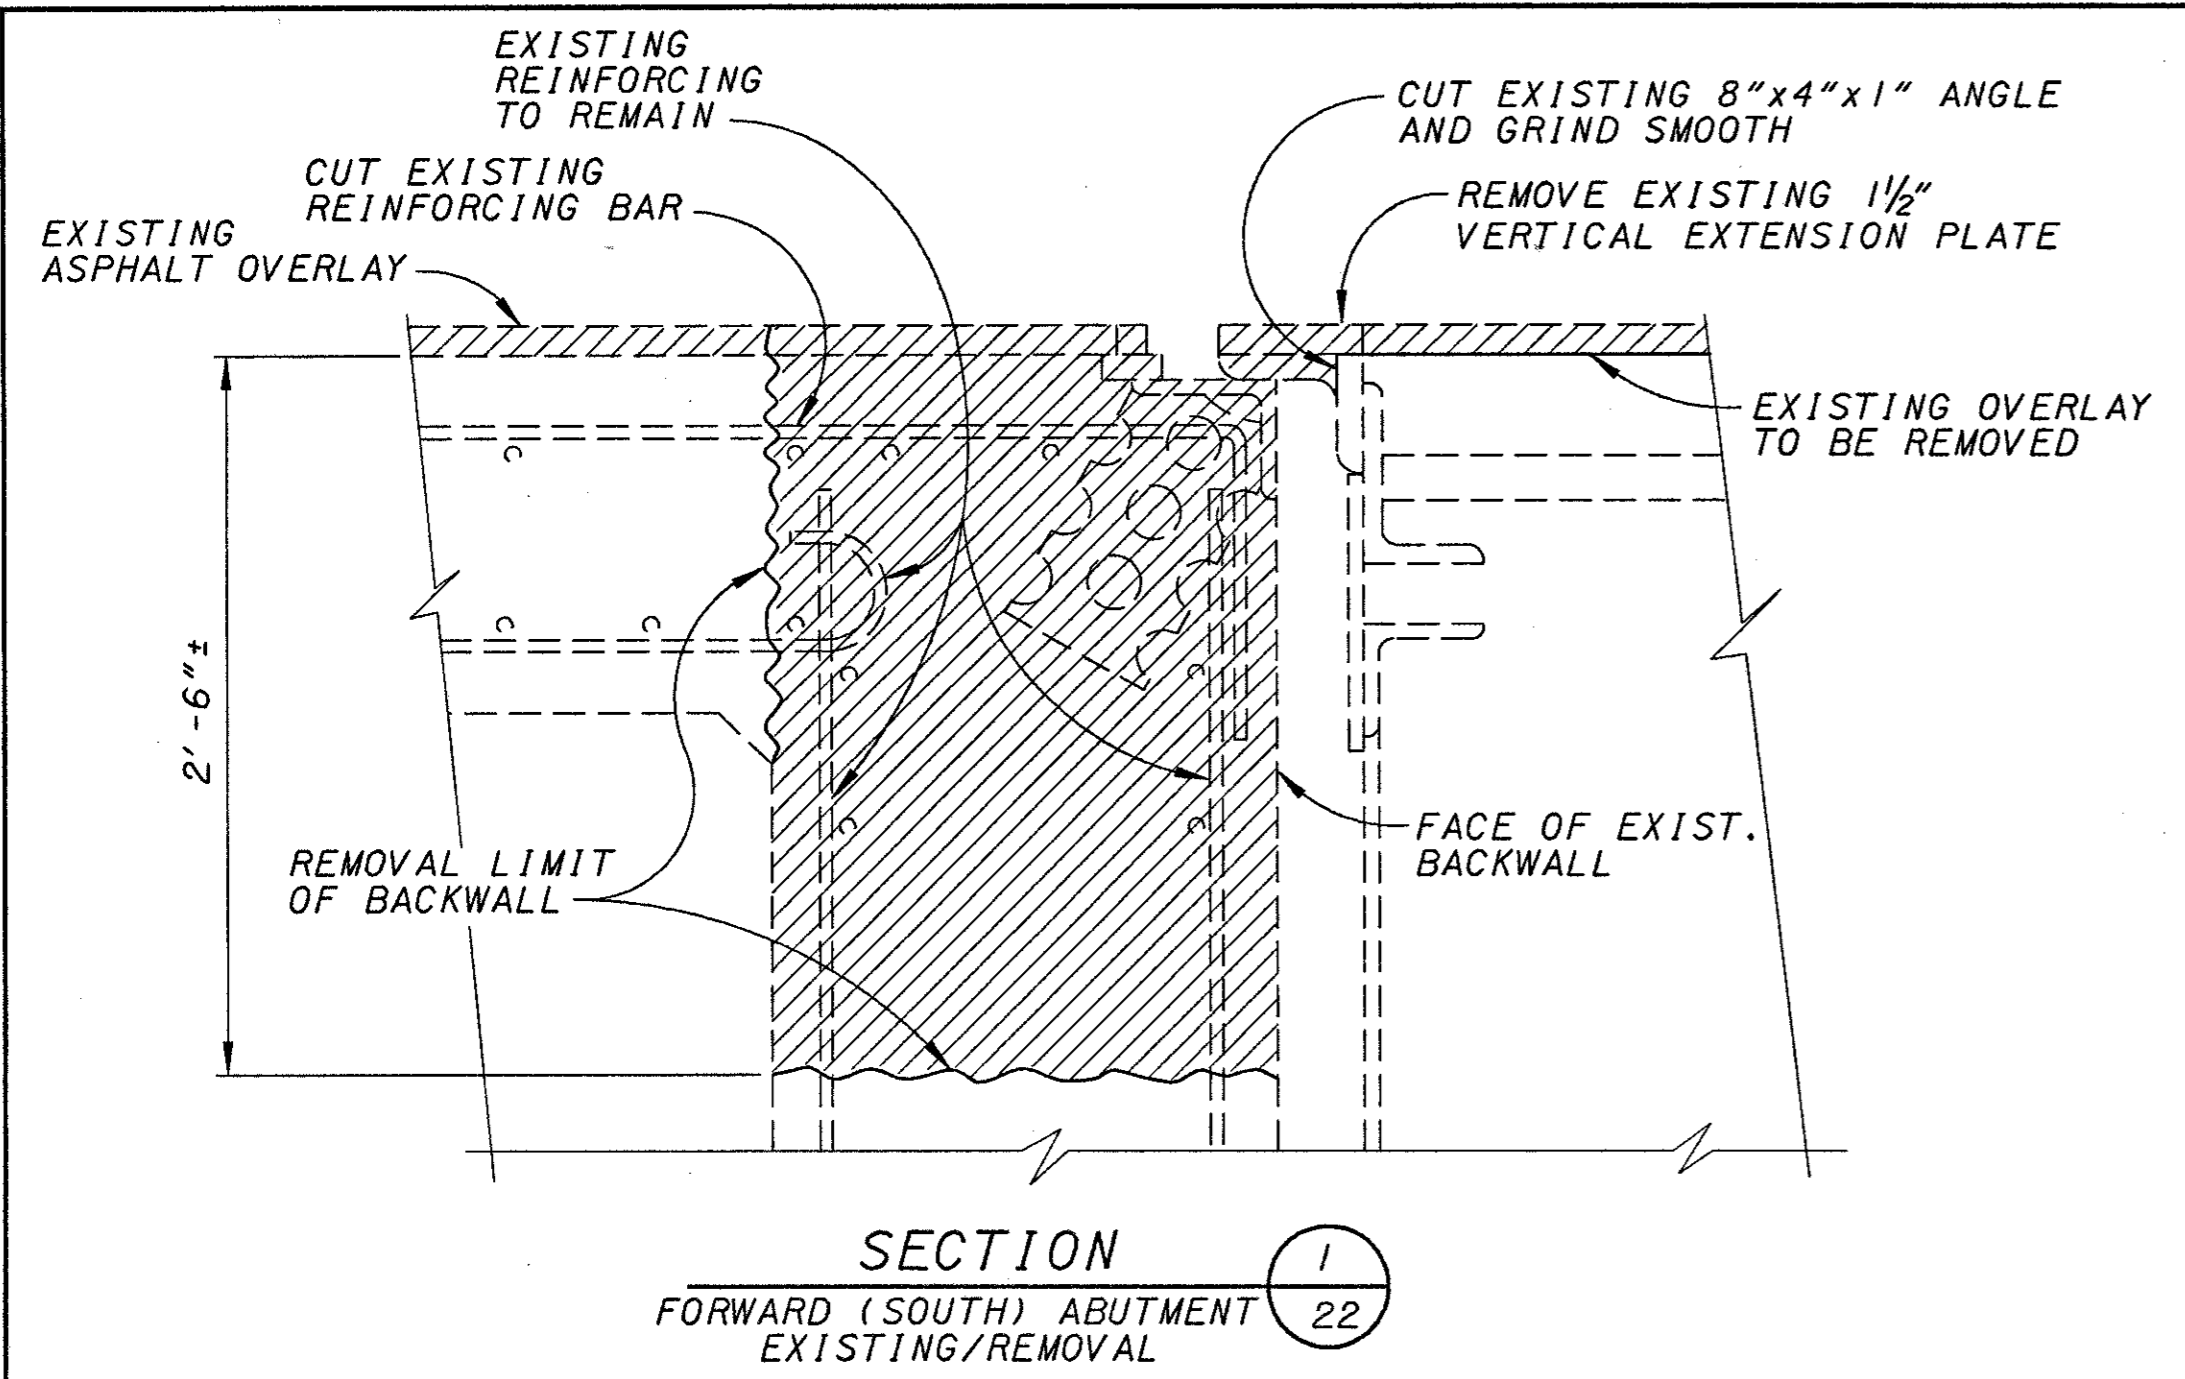

STRIP SEAL DIM. 'A' (SEE STD. DWG. EJ-4-87M)

TEMPERATURE	30°F	40°F	50°F	60°F	70°F	80°F	90°F	100°F
REAR ABUTMENT	1 1/8"	1 3/4"	1 5/8"	1 1/2"	1 3/8"	1 1/4"	1 1/8"	1"
FORWARD ABUTMENT	1 1/8"	1 3/4"	1 5/8"	1 1/2"	1 3/8"	1 1/4"	1 1/8"	1"

FOR ADDITIONAL JOINT DETAILS, NOTES AND INSTALLATION DETAILS SEE STD. DWG. EXJ-4-87.

/// DENOTES PORTION OF EXISTING STRUCTURE TO BE REMOVED.


DESIGN AGENCY
KZF DESIGN
 Architecture | Engineering | Interiors | Planning
 10000 E. Harvard Ave., Suite 1000, Denver, CO 80231
 TEL: (303) 750-0000 FAX: (303) 750-0001 WWW.KZFDESIGN.COM

DATE: 8/2/00
 REVISED: SJA
 DRAWN: JDG
 CHECKED: DDK
 DESIGNED: KZF #3


BRIDGE NO. PRE-35-0176
 I.R. TO UNDER U.S. 35 WB

PRE-70-0.00


22/24
 281
 283

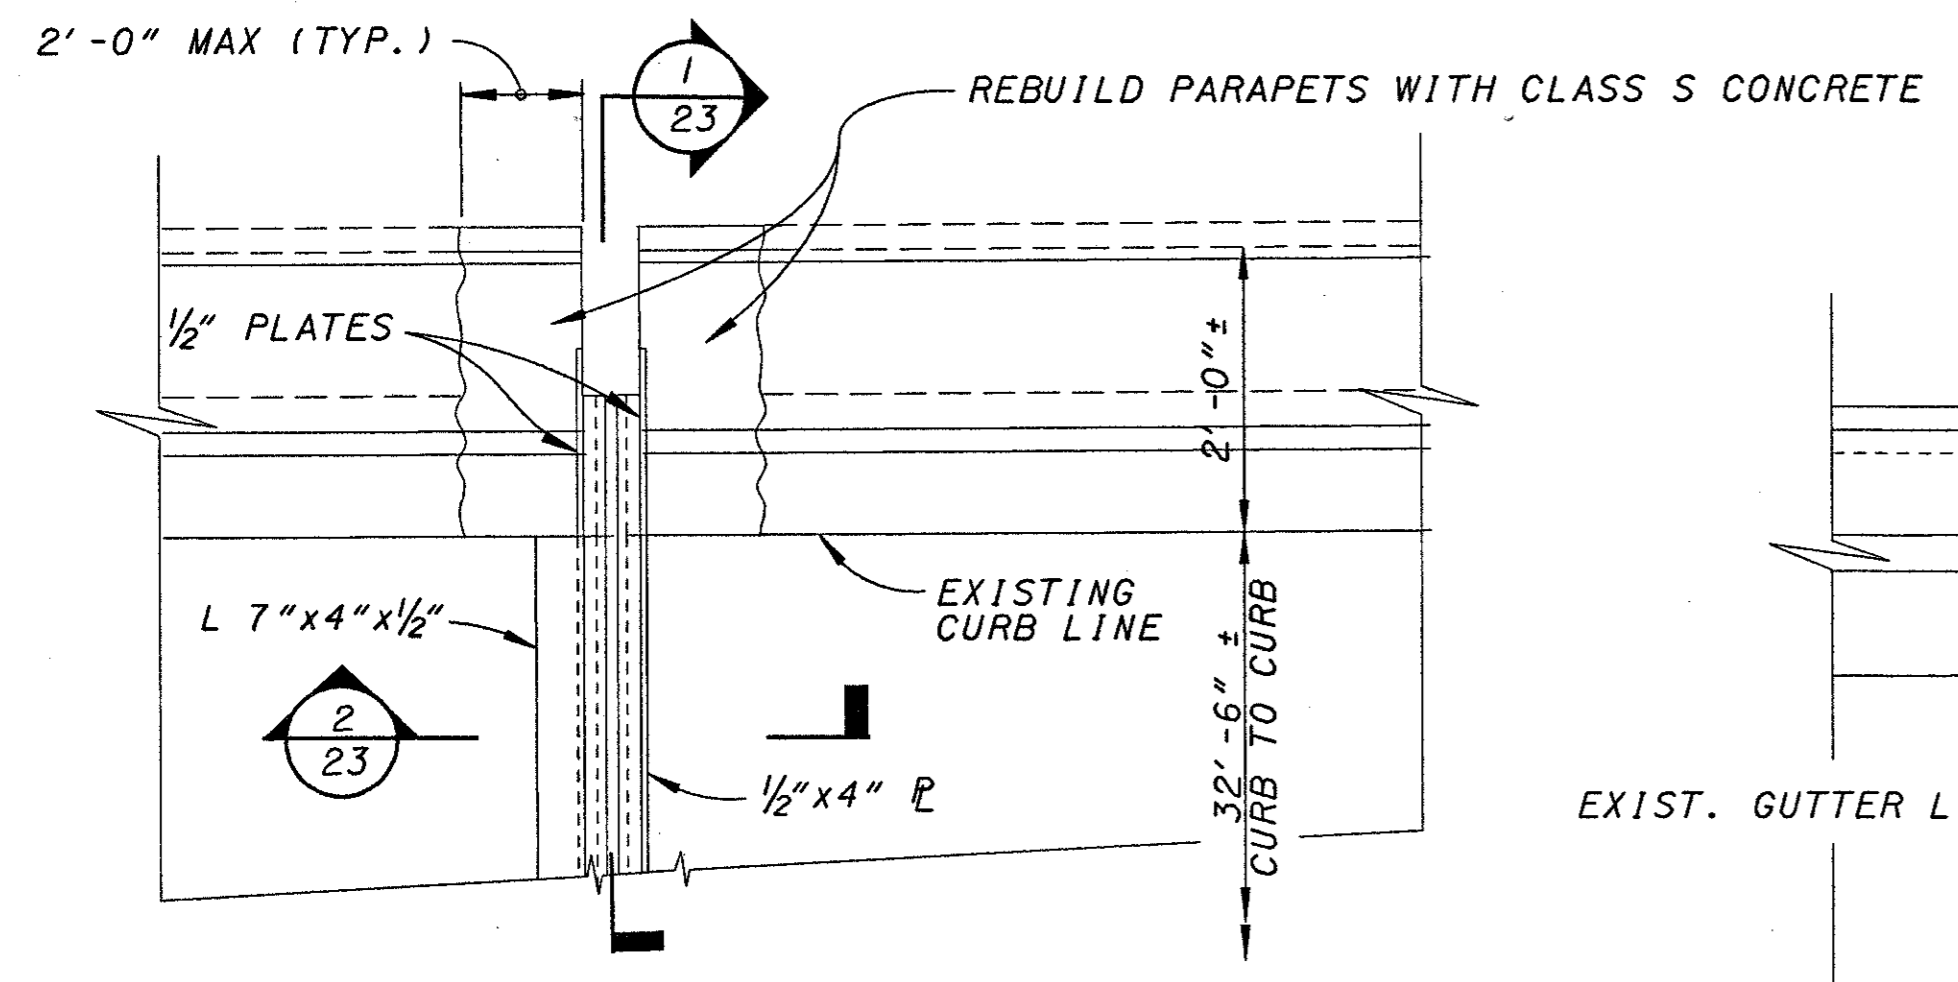

EXTENSION OF STRUCTURAL EXPANSION JOINT

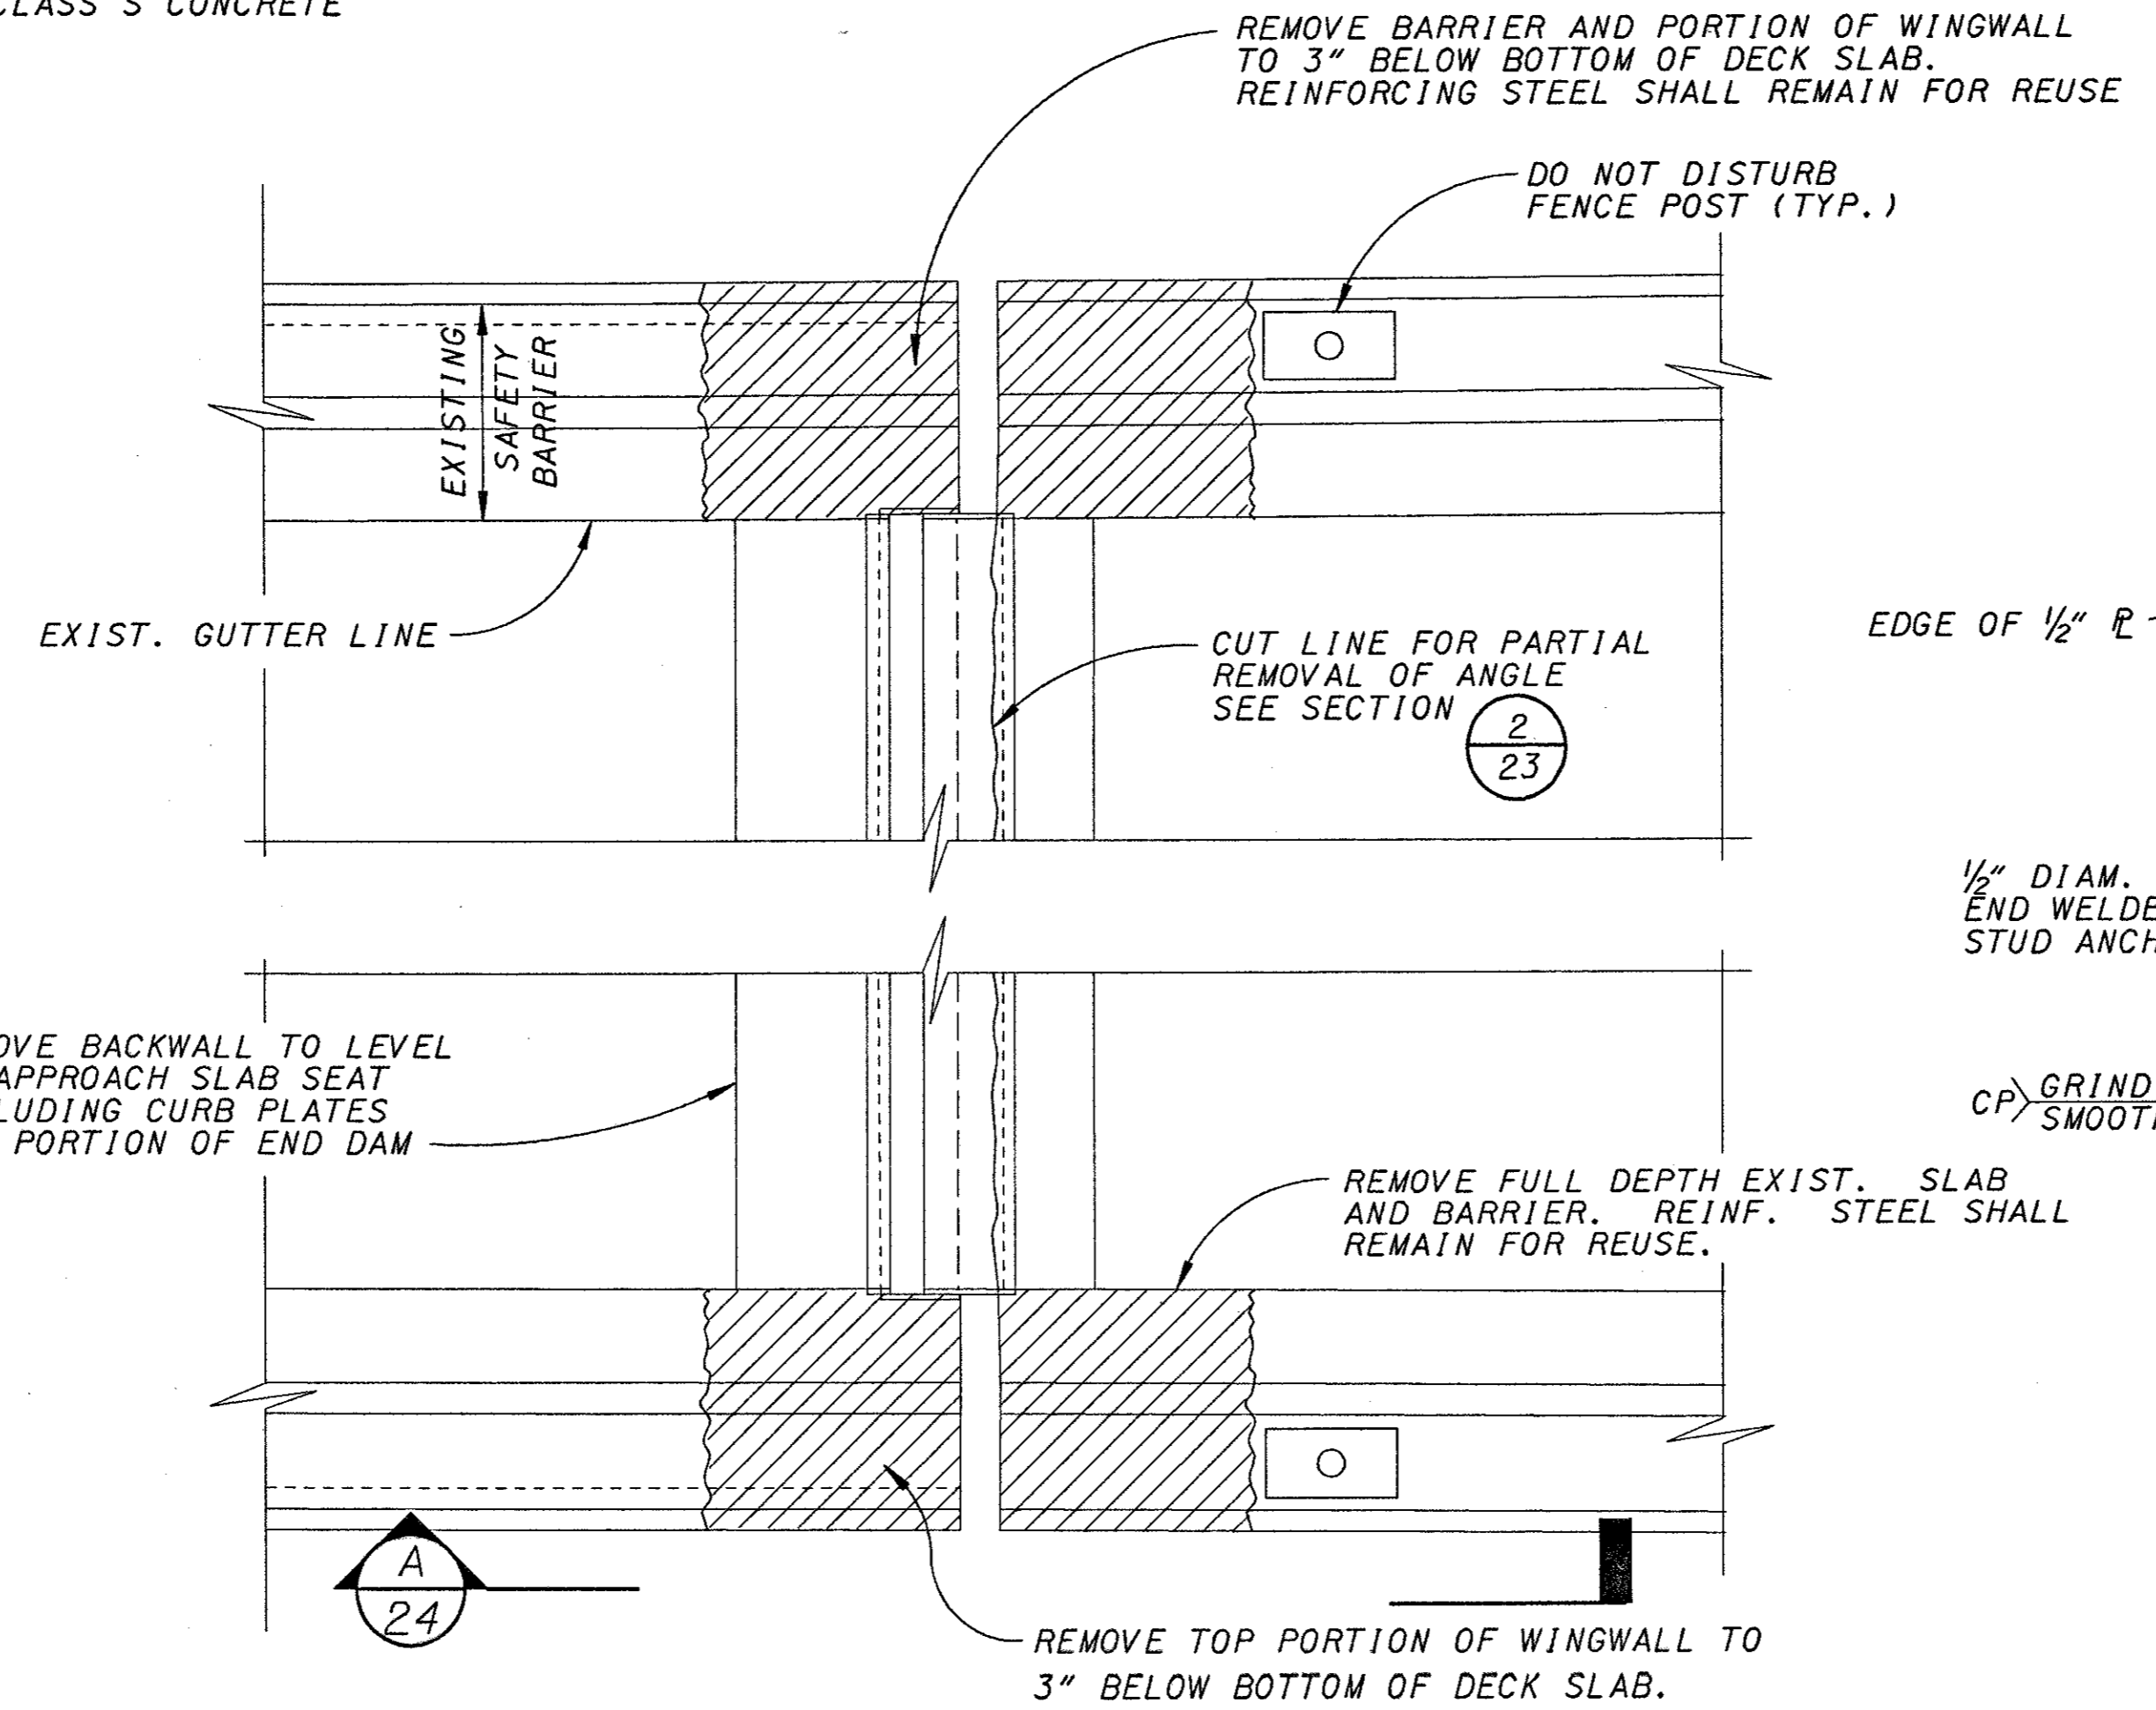


REMOVALS FOR JOINT MODIFICATION

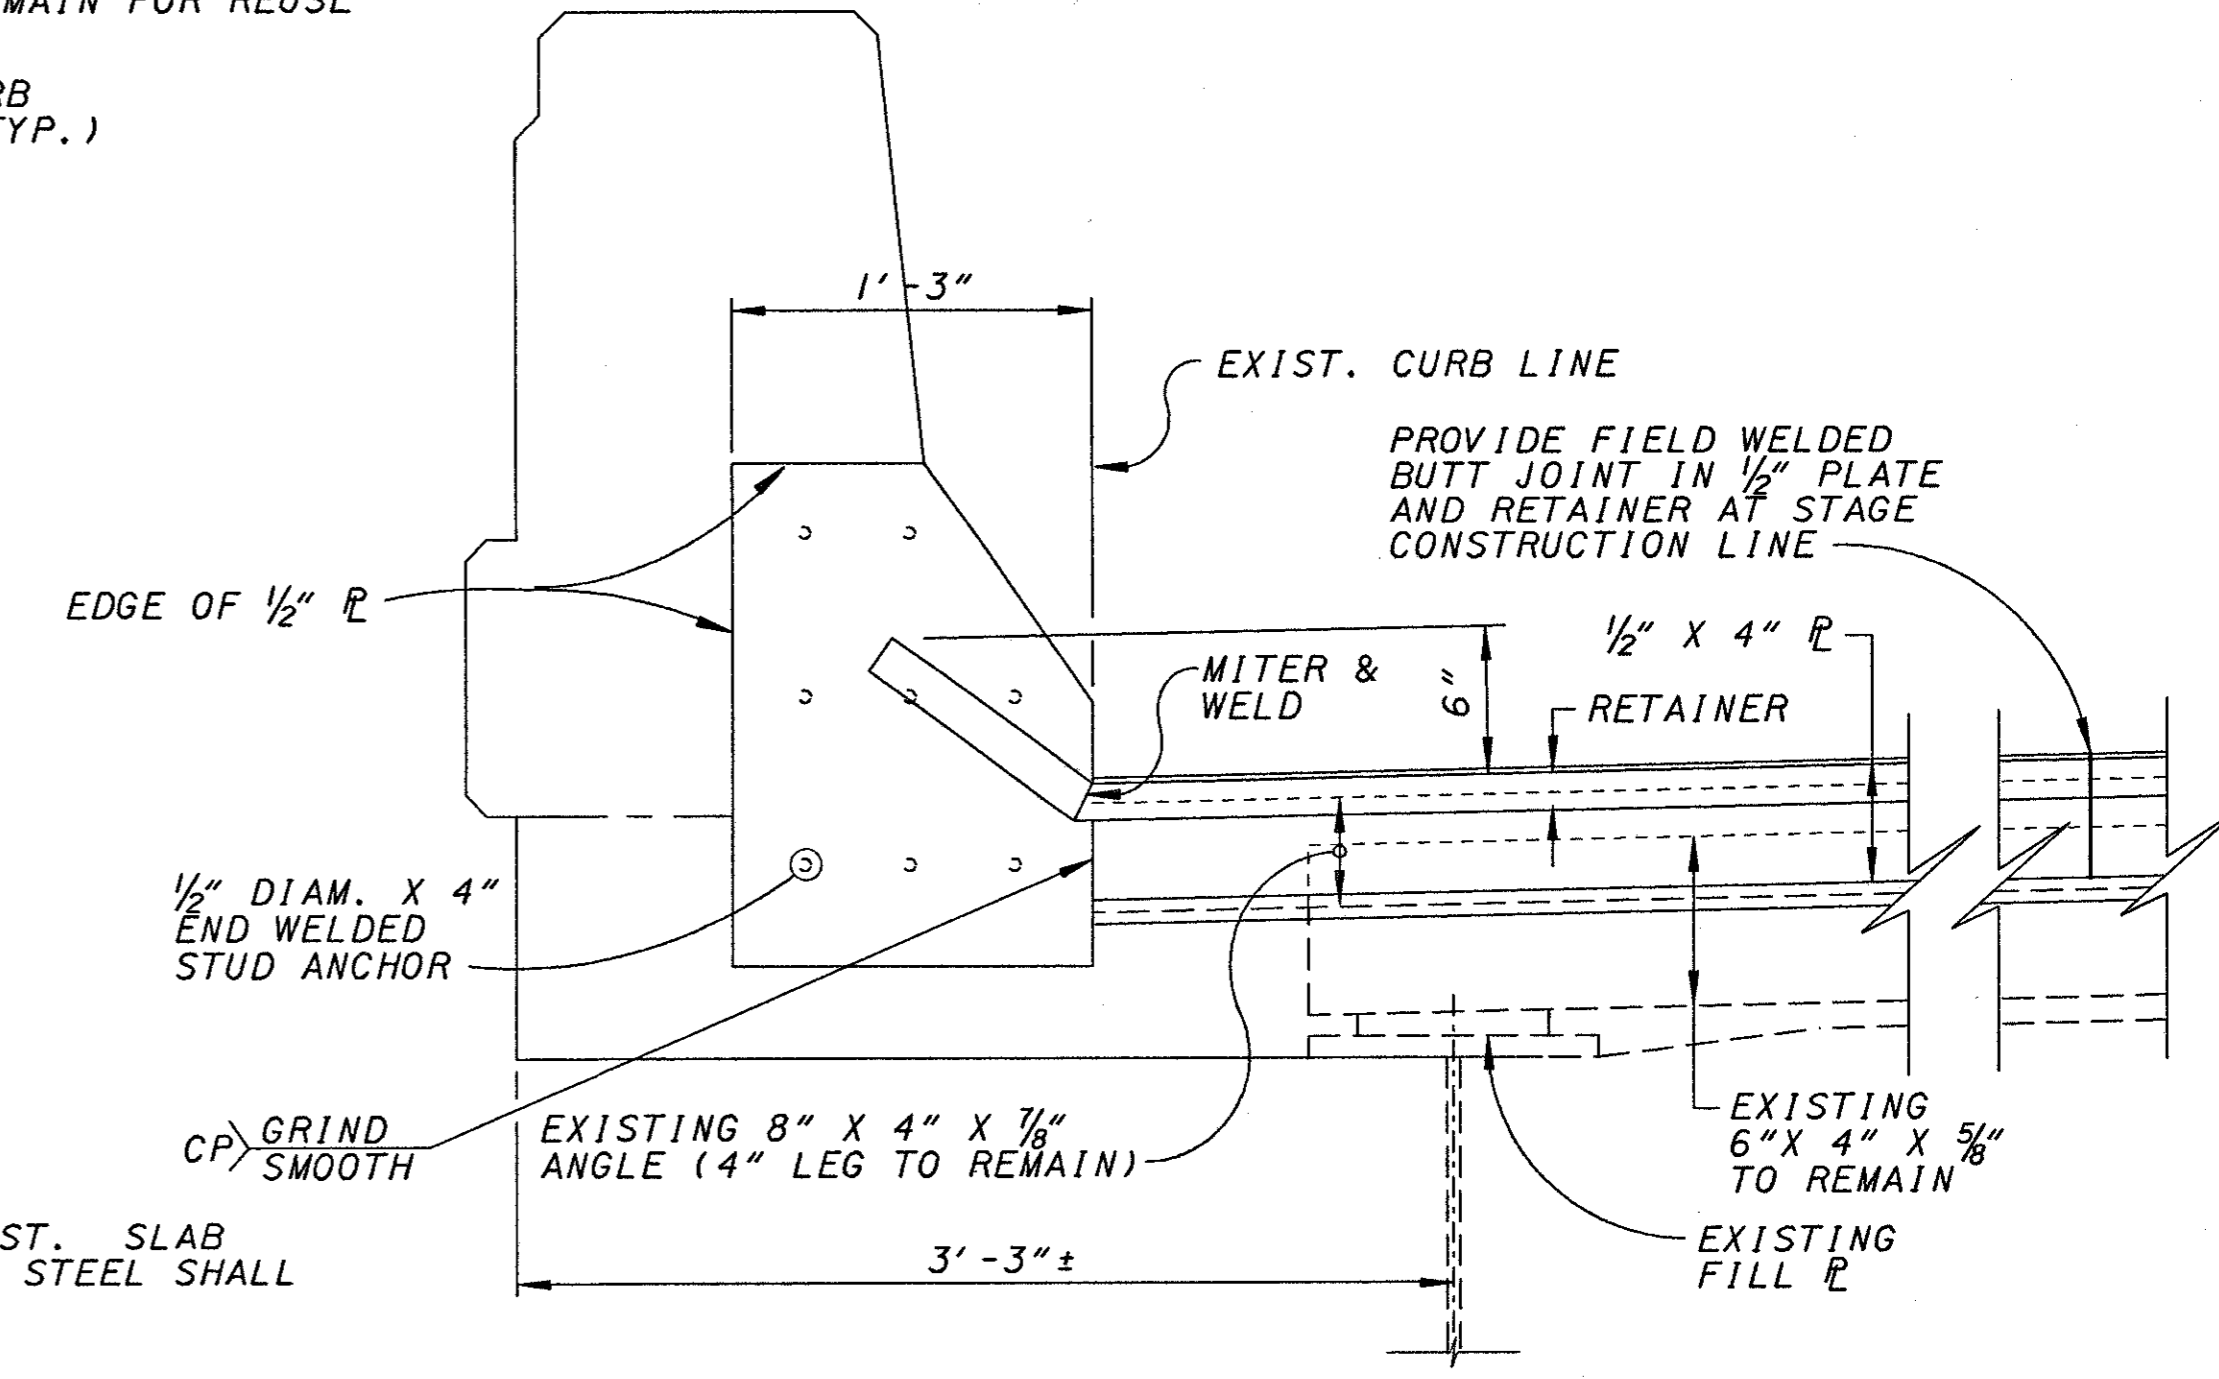


SECTION B I
 BRIDGE 16 SHOWN 22 23
 BRIDGE 3 SIMILAR

HORIZONTAL EXTENSION OF STRUCTURAL EXPANSION JOINT

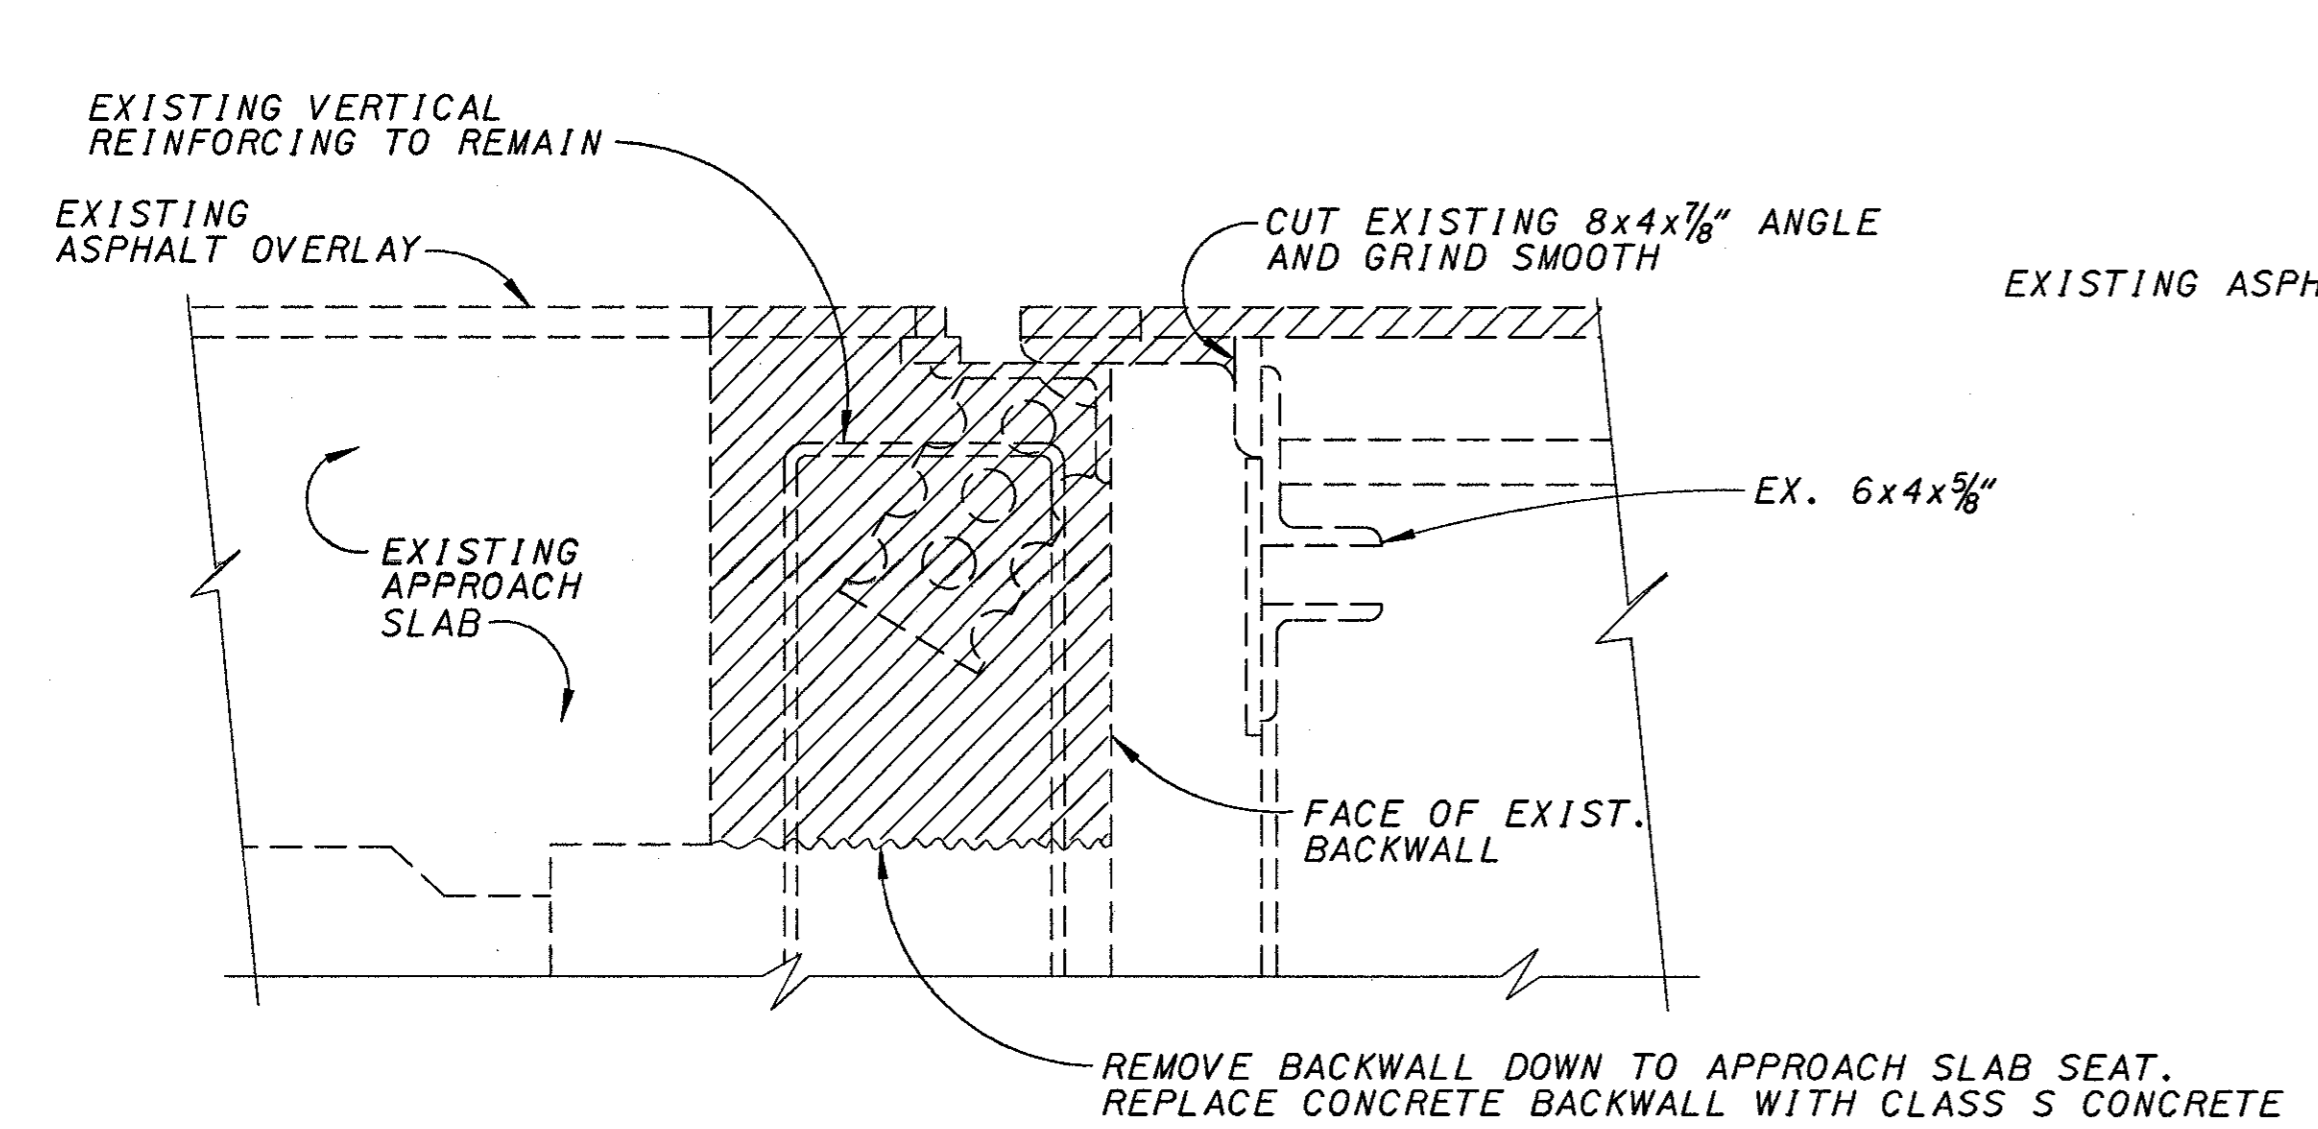


SECTION 2
 23

EXPANSION JOINT REMOVAL DETAIL

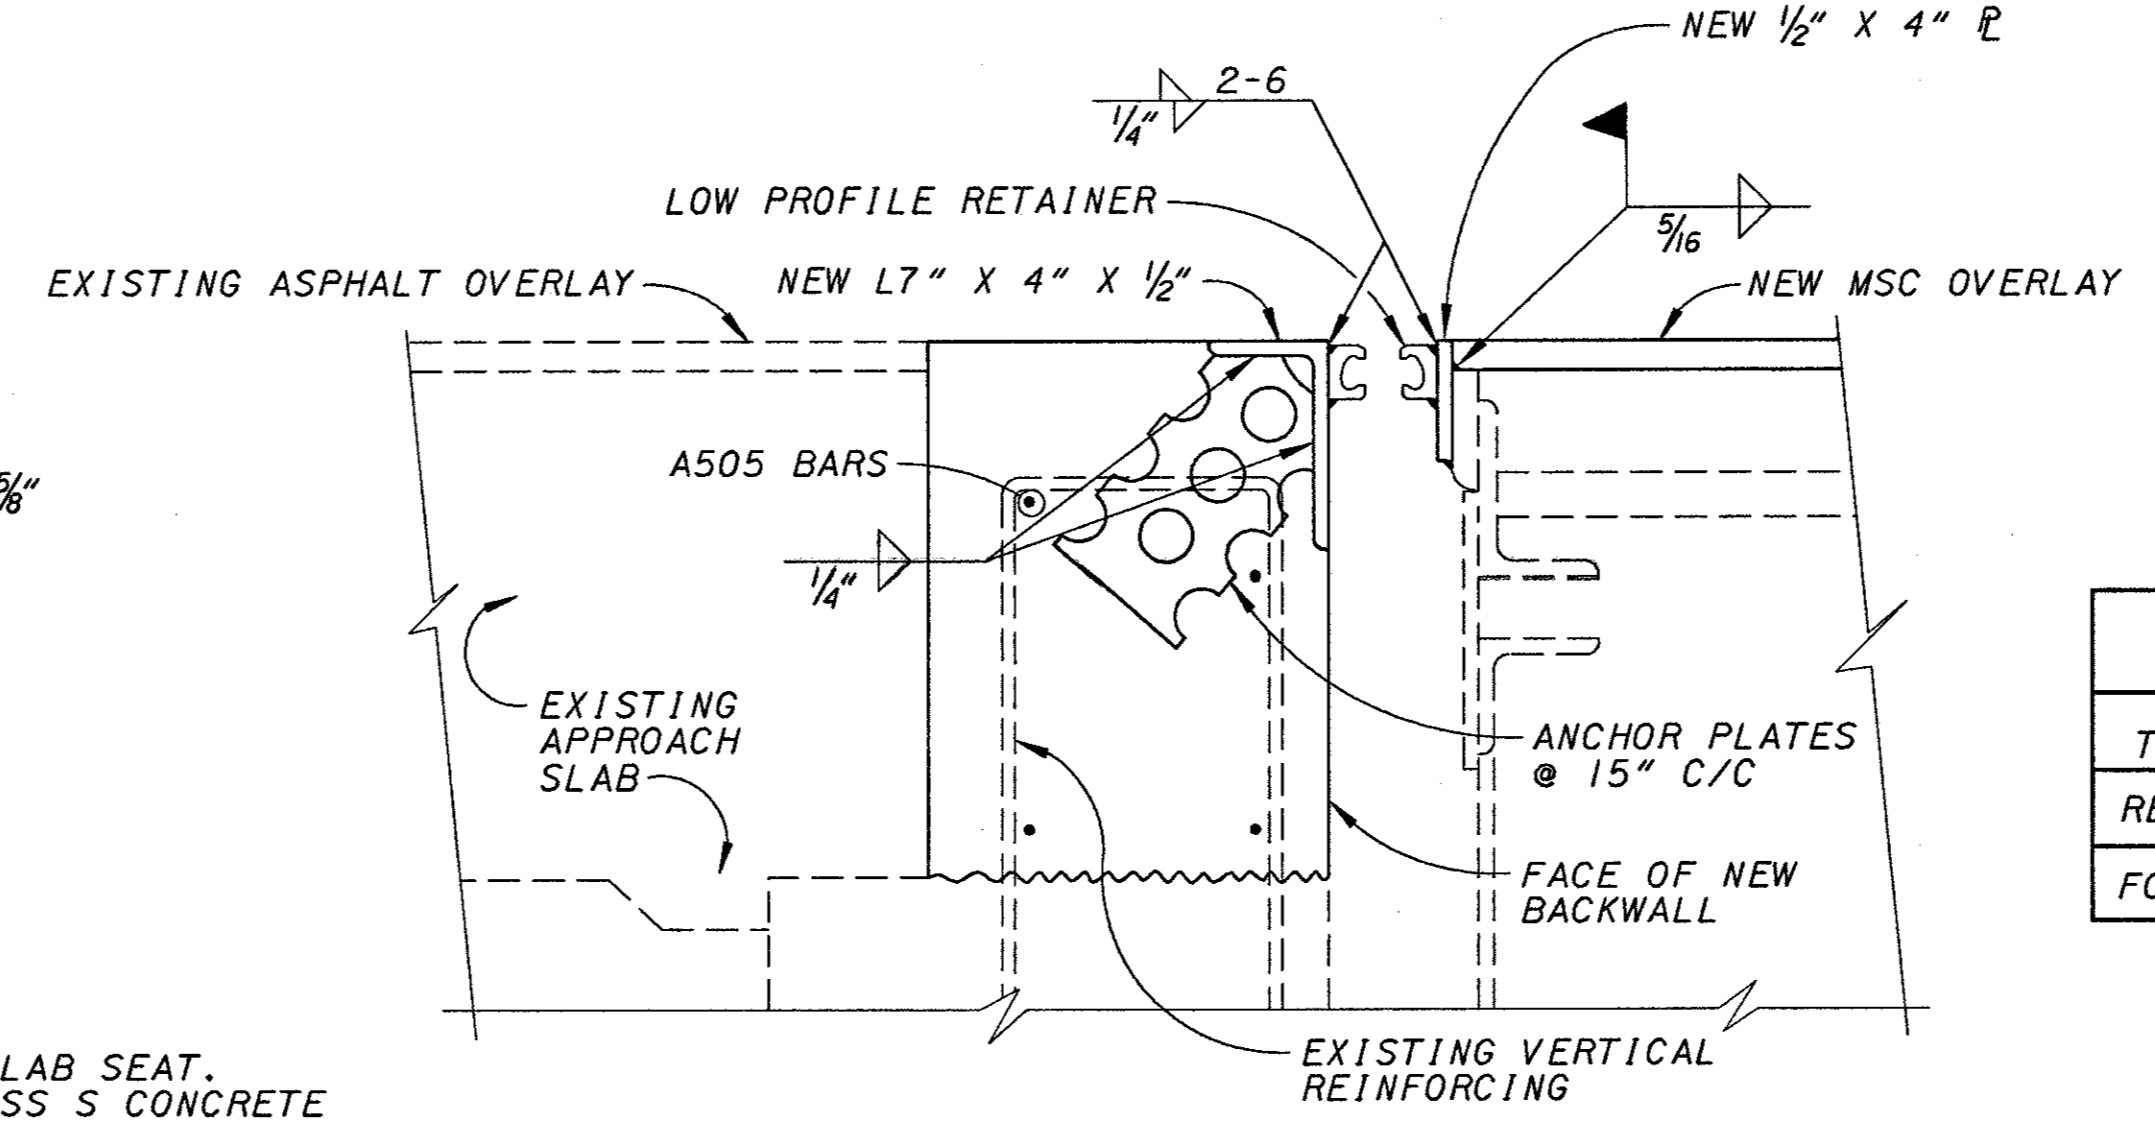

SECTION 2
 23

EXPANSION JOINT DETAIL

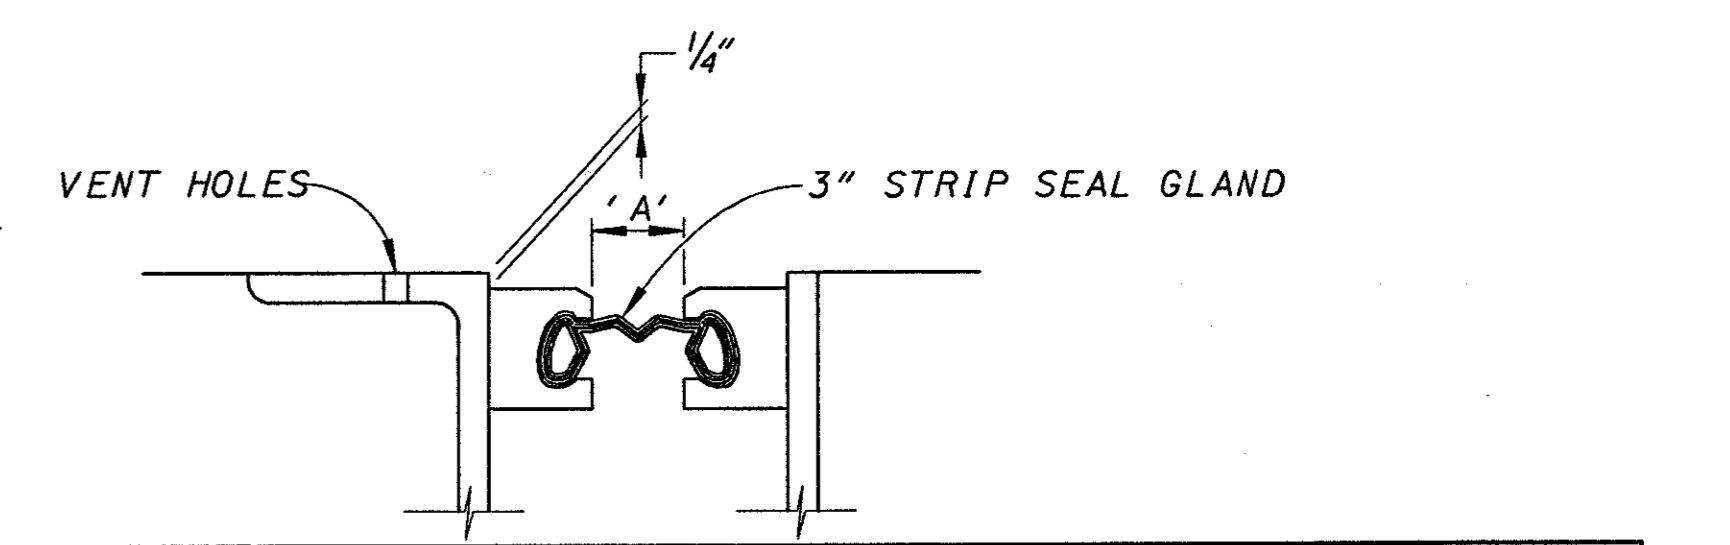

STRIP SEAL DIM. 'A' (SEE STD. DWG. EJ-4-87M)

TEMPERATURE	30°F	40°F	50°F	60°F	70°F	80°F	90°F	100°F
REAR ABUTMENT	1 7/8"	1 3/4"	1 5/8"	1 1/2"	1 3/8"	1 1/4"	1 1/8"	1"
FORWARD ABUTMENT	1 7/8"	1 3/4"	1 5/8"	1 1/2"	1 3/8"	1 1/4"	1 1/8"	1"

FOR ADDITIONAL JOINT DETAILS, NOTES AND INSTALLATION DETAILS SEE STD. DWG. EXJ-4-87.

/// DENOTES PORTION OF EXISTING STRUCTURE TO BE REMOVED.

REF: **REF**
 REF: **REF**
ASSOCIATIVE USER: *****
 USER: *****
 PROJECT: *****
 PRE NAME: *****
 ACTIVE LEVELS ON: #LEV#

ABUTMENT AND BARRIER REINFORCING


MARK	NUMBER			LENGTH	WEIGHT (LBS)	SHAPE
	BRIDGE 3	BRIDGE 16	TOTAL			
A501	6		6	19'-2"	120	STR.
A502	3		3	9'-0"	28	STR.
A503	3		3	4'-0"	13	STR.
A504	12		12	16'-10"	211	STR.
A505		16	16	19'-6"	325	STR.
TOTAL					1840	

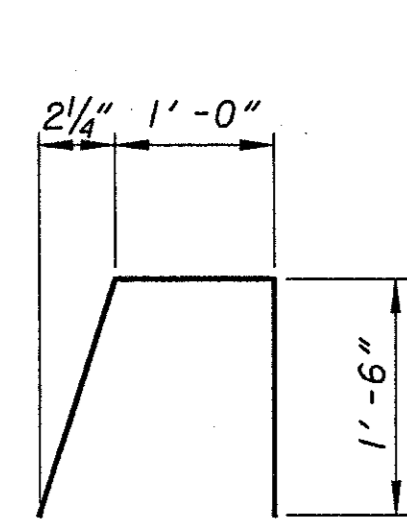


A601

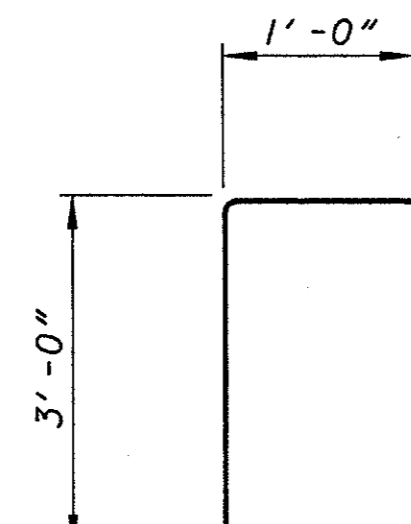


A602

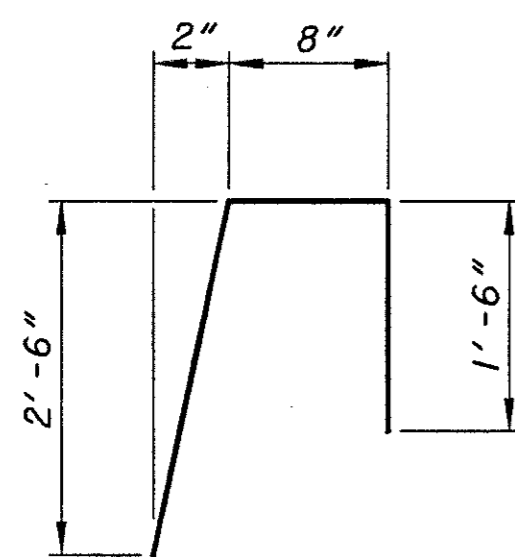

A603

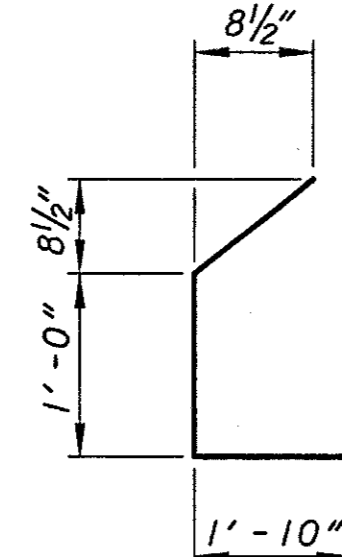


A604

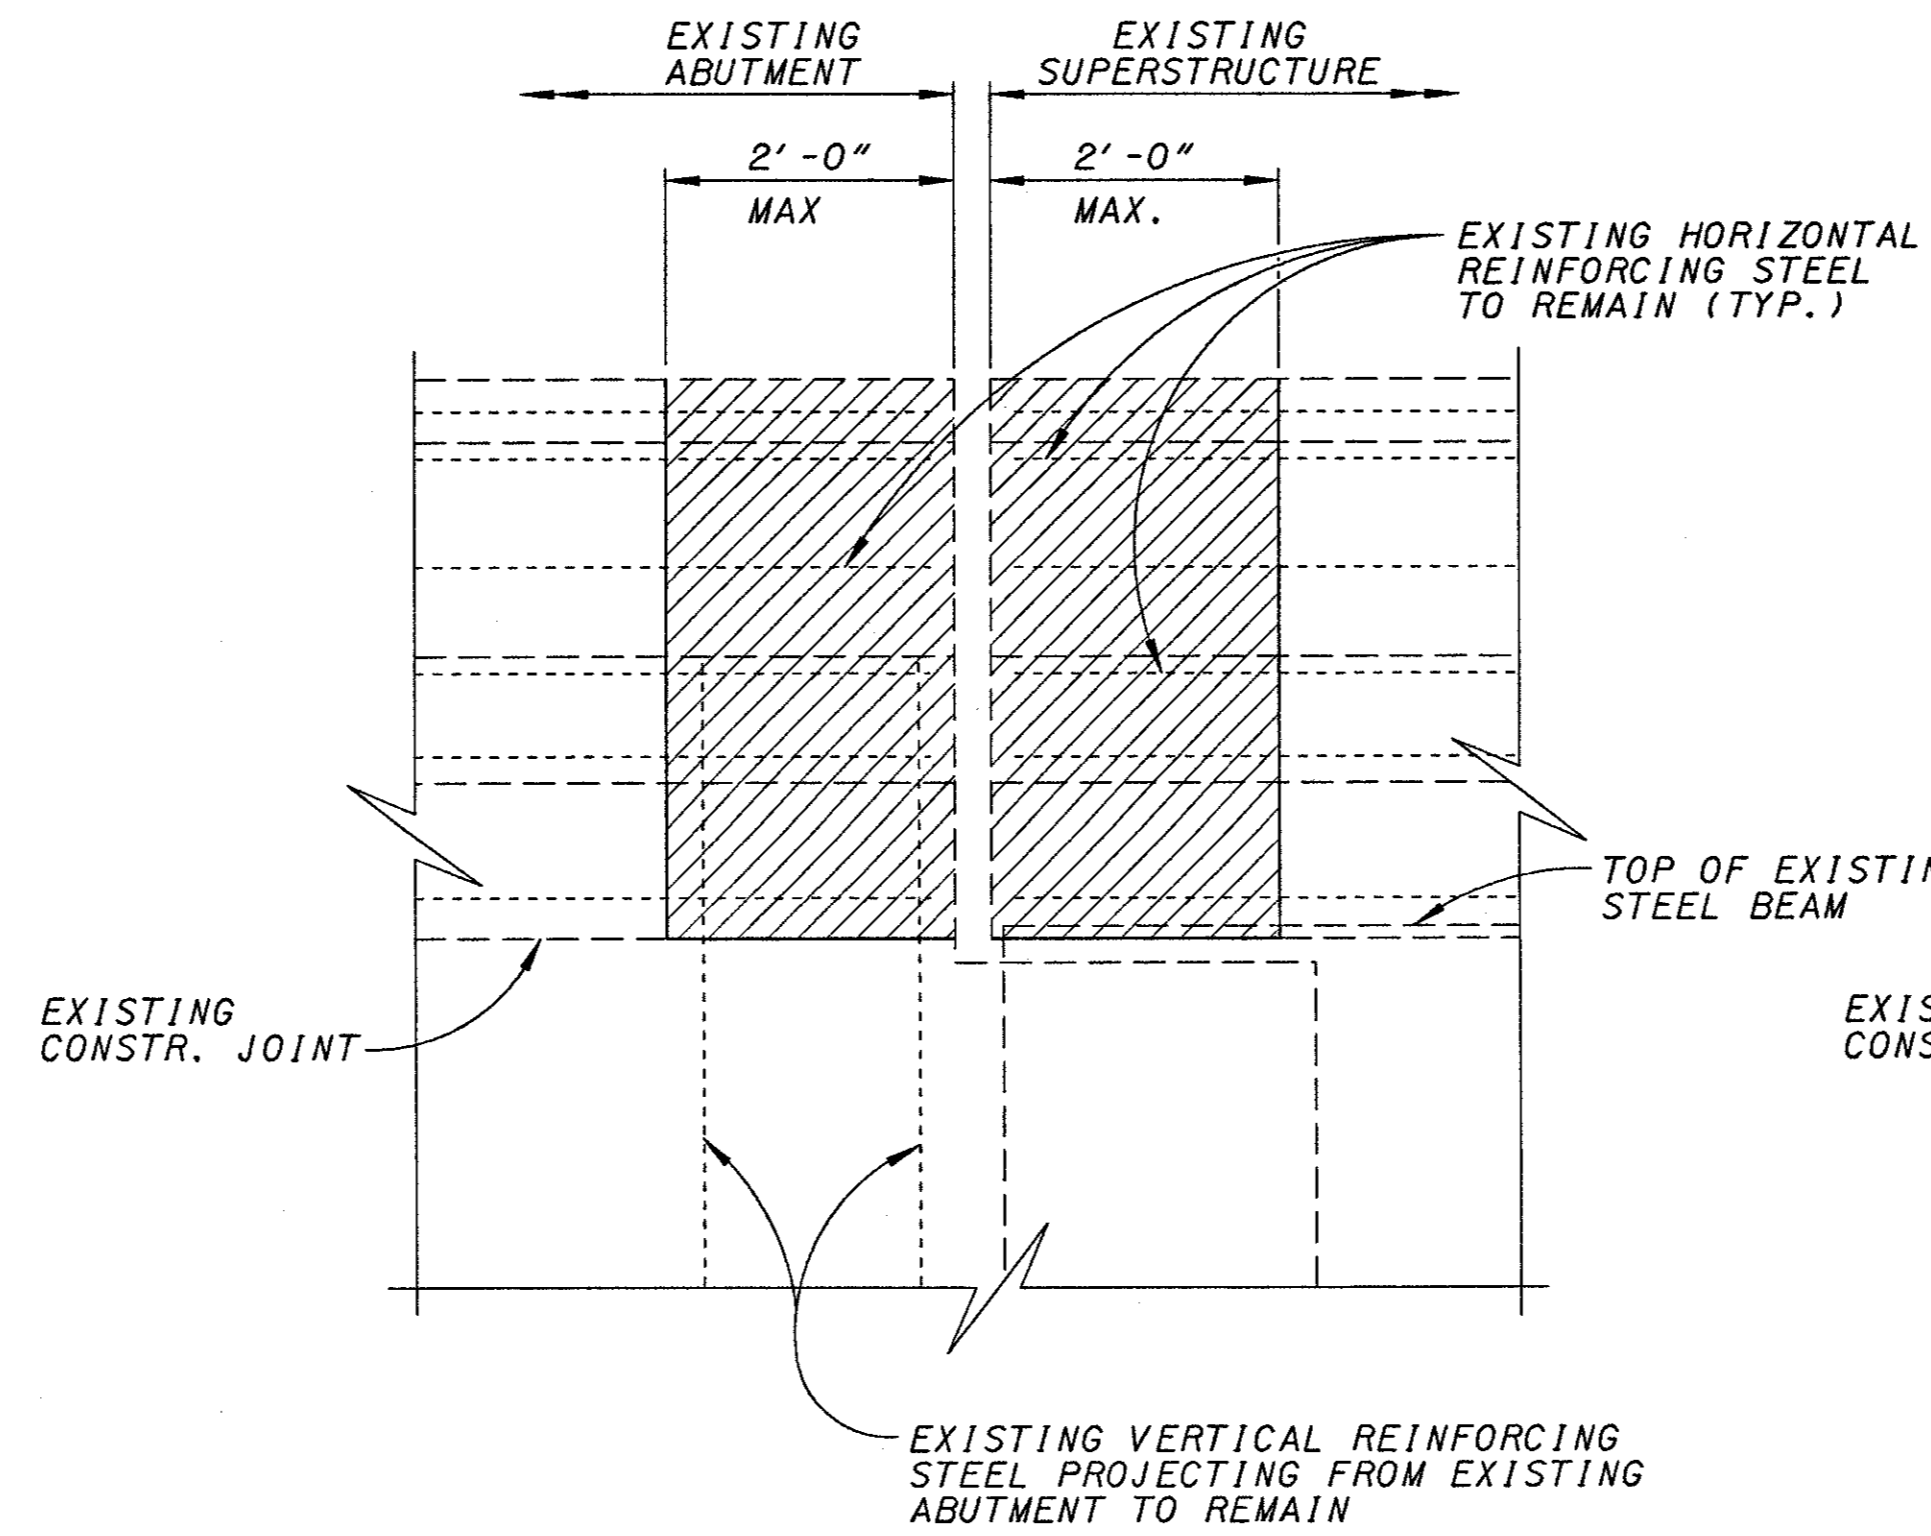


VIEW
EXISTING/REMOVAL (A) (A)
22 23


DENOTES PORTION OF EXISTING STRUCTURE TO BE REMOVED.

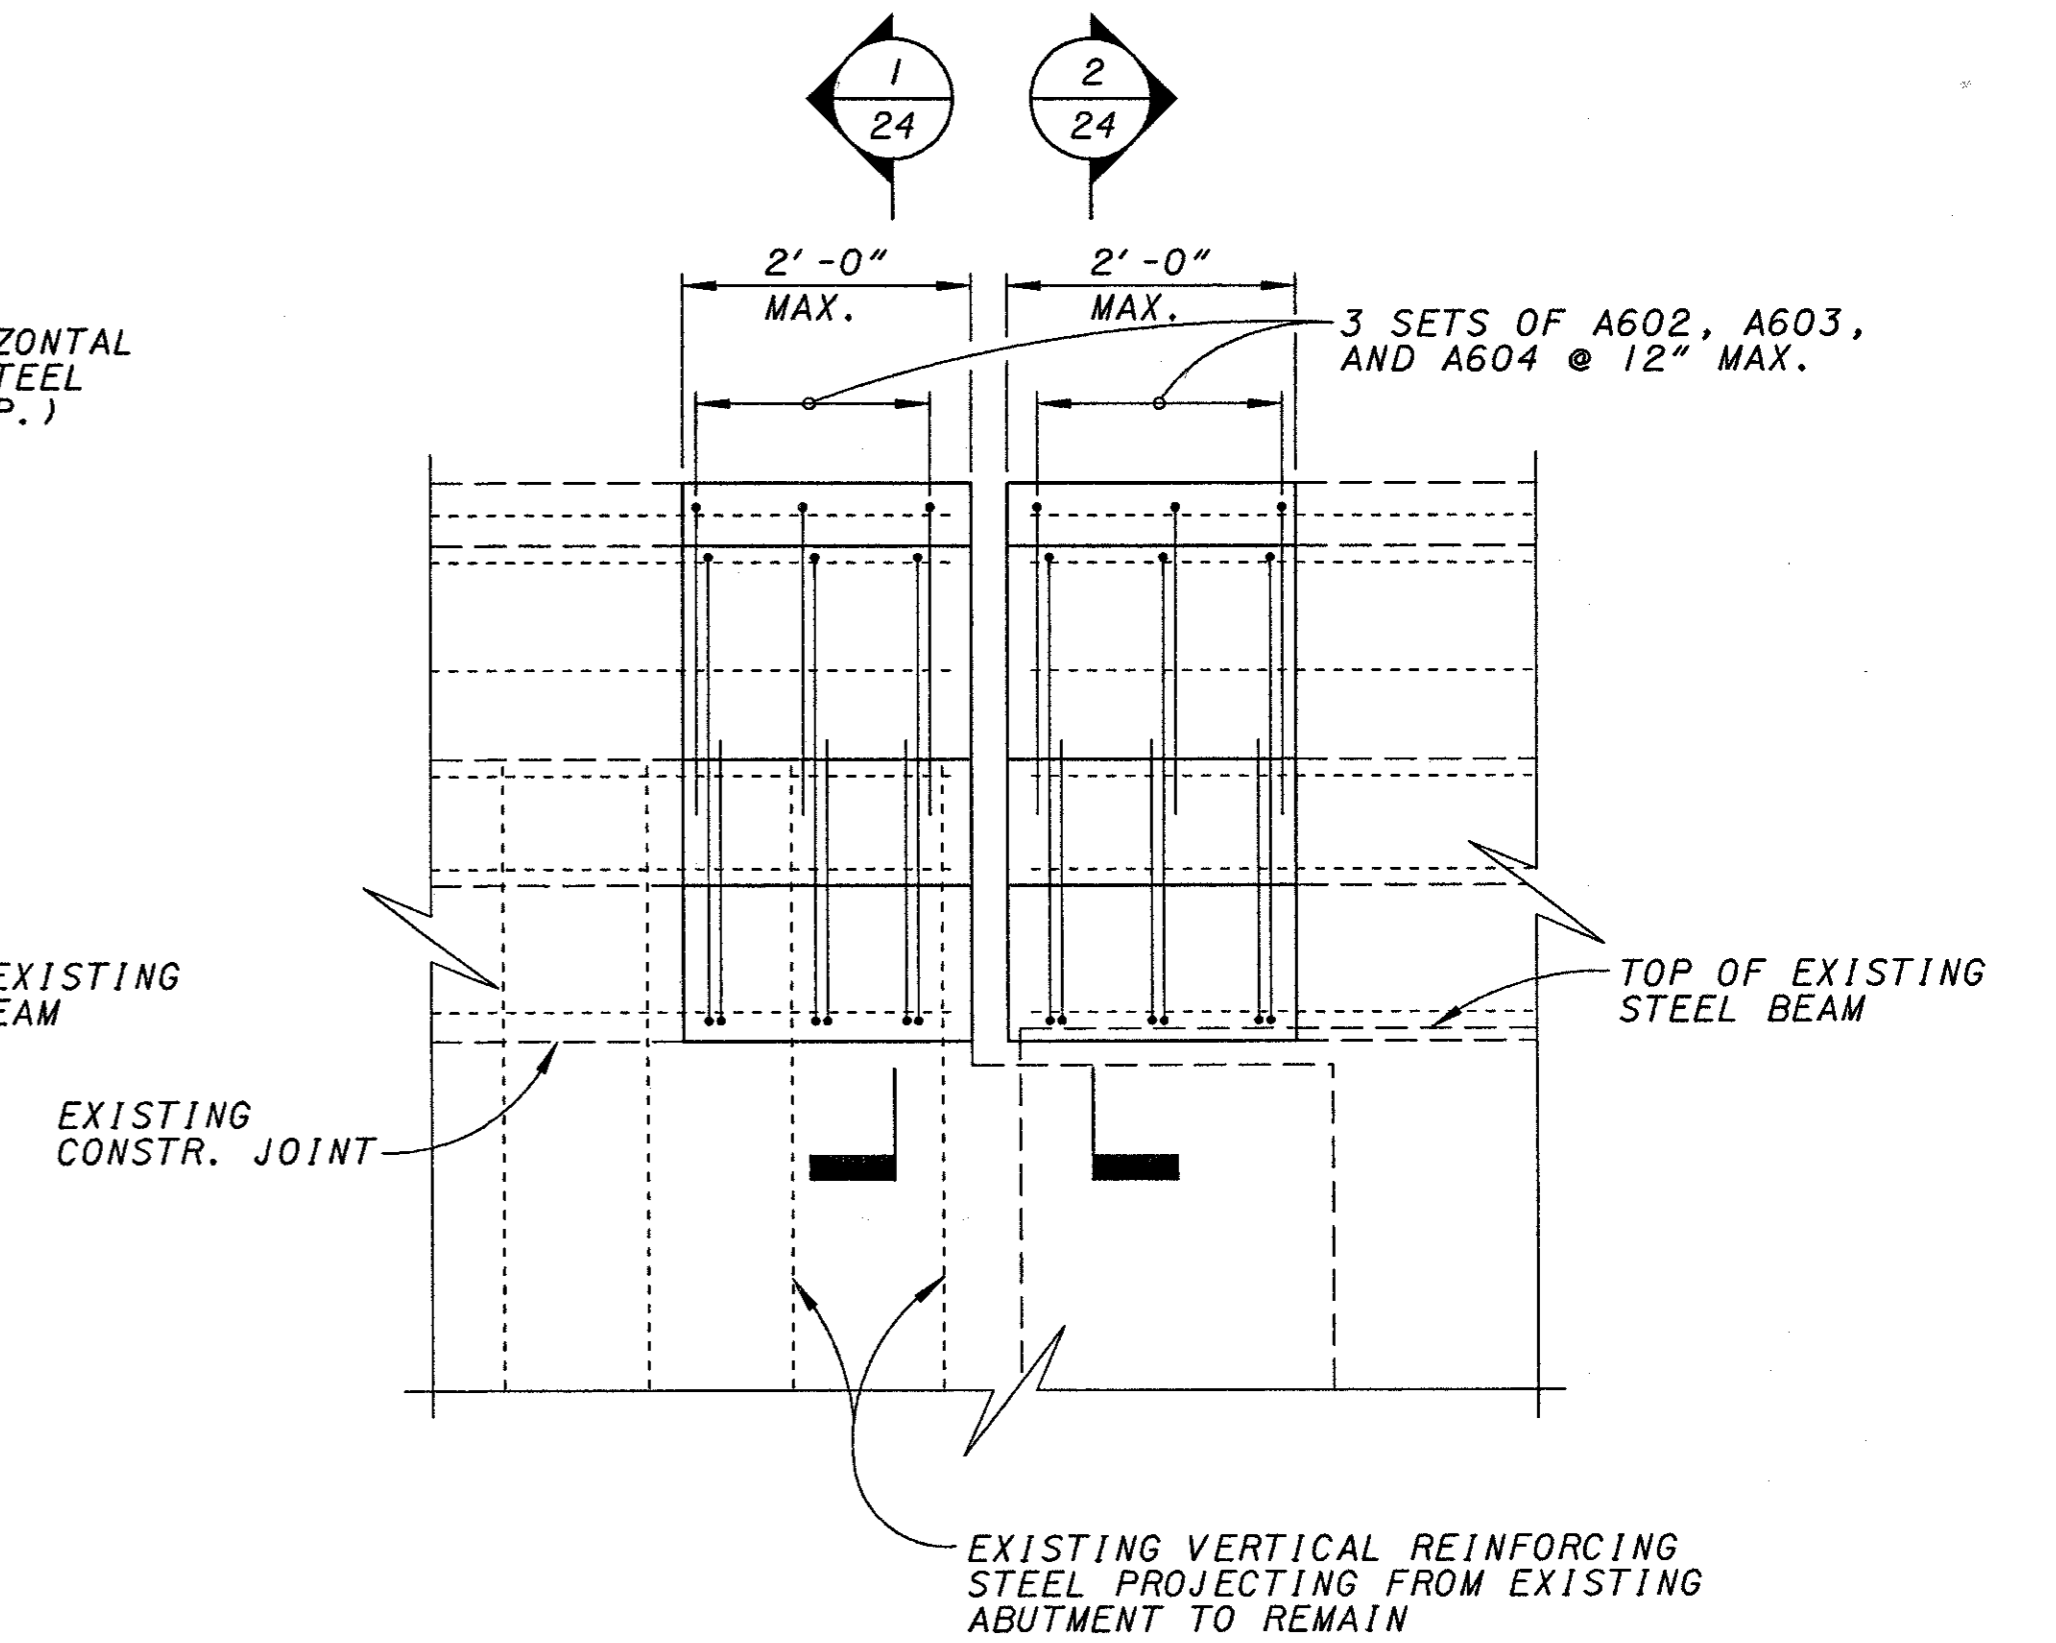

VIEW
PROPOSED (A) (A)
22 23

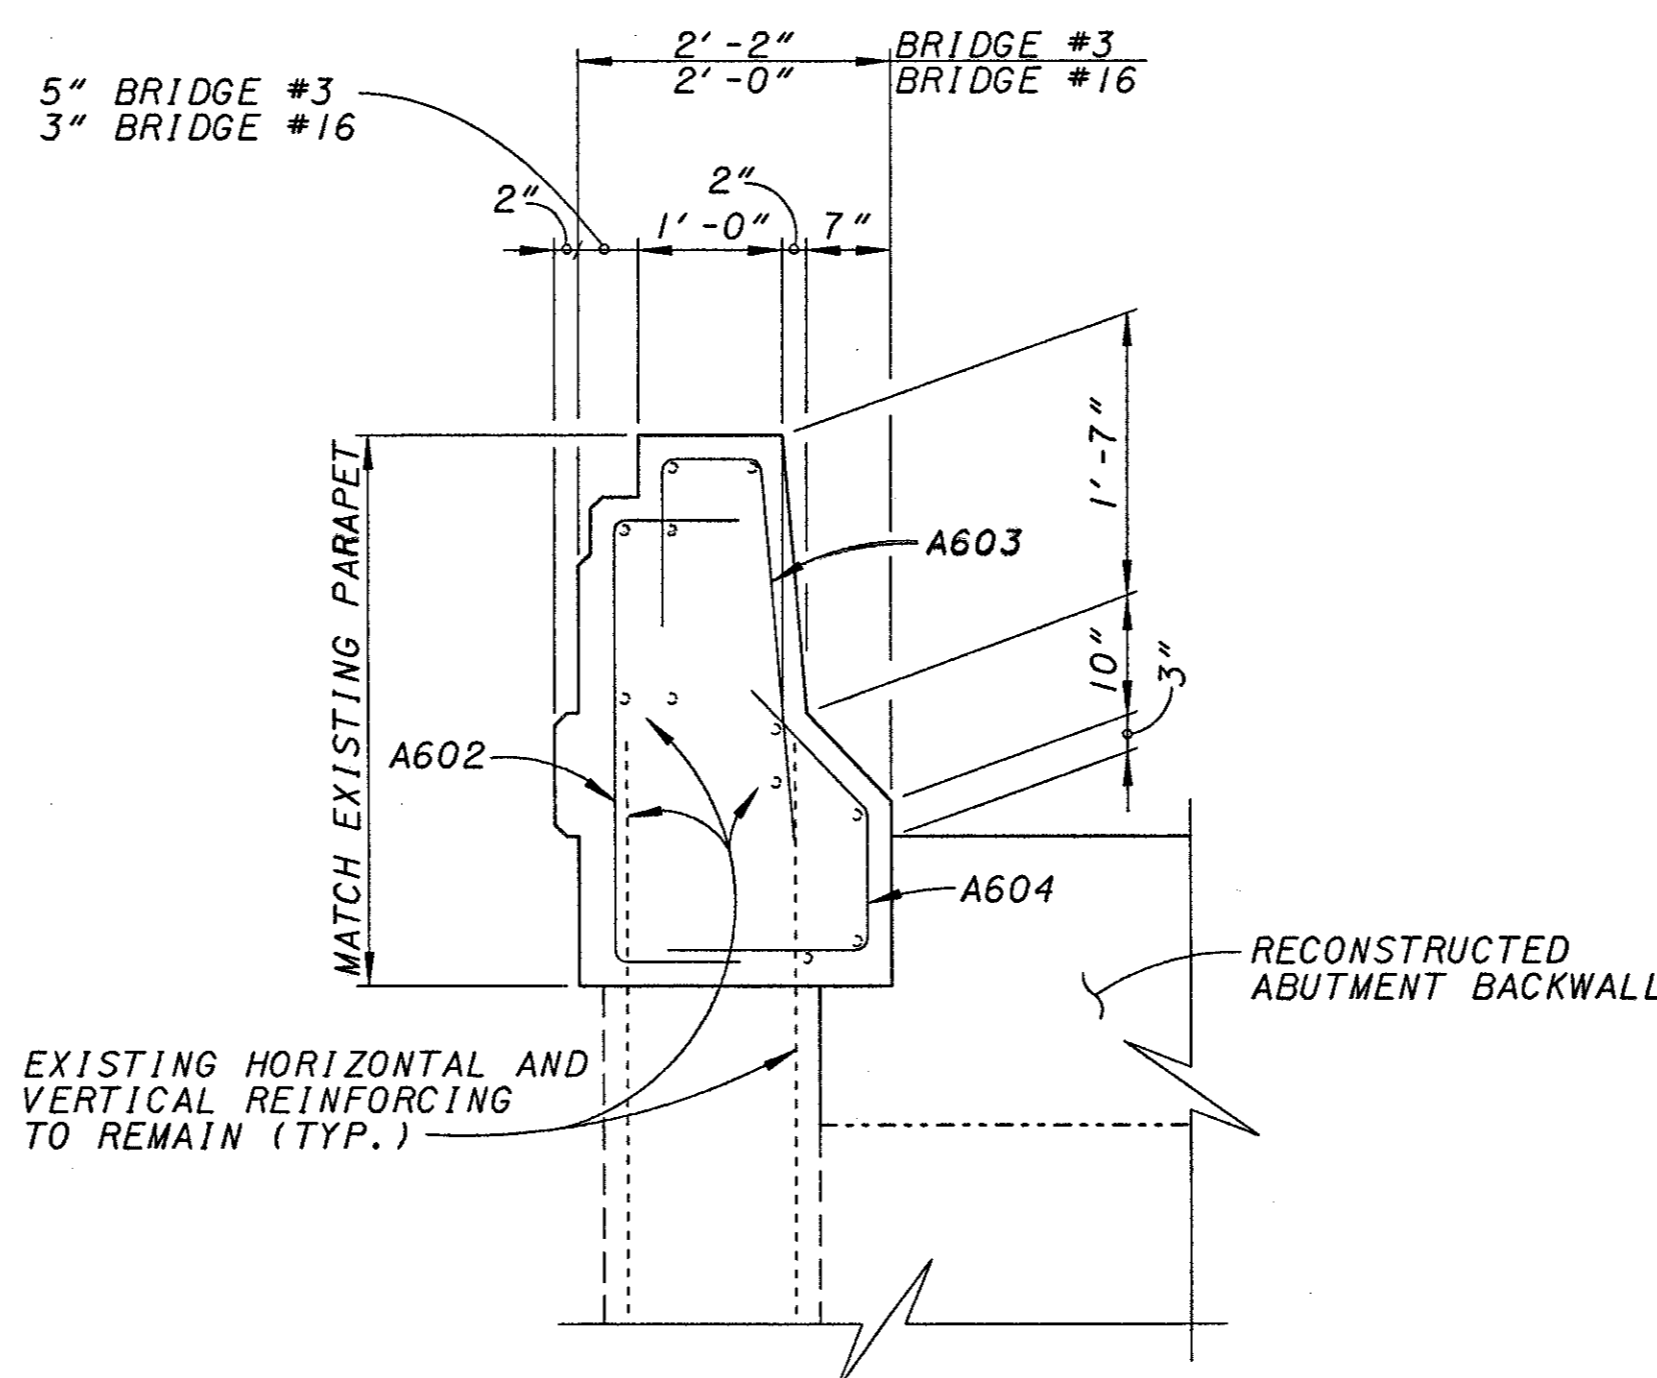

SECTION 1
24

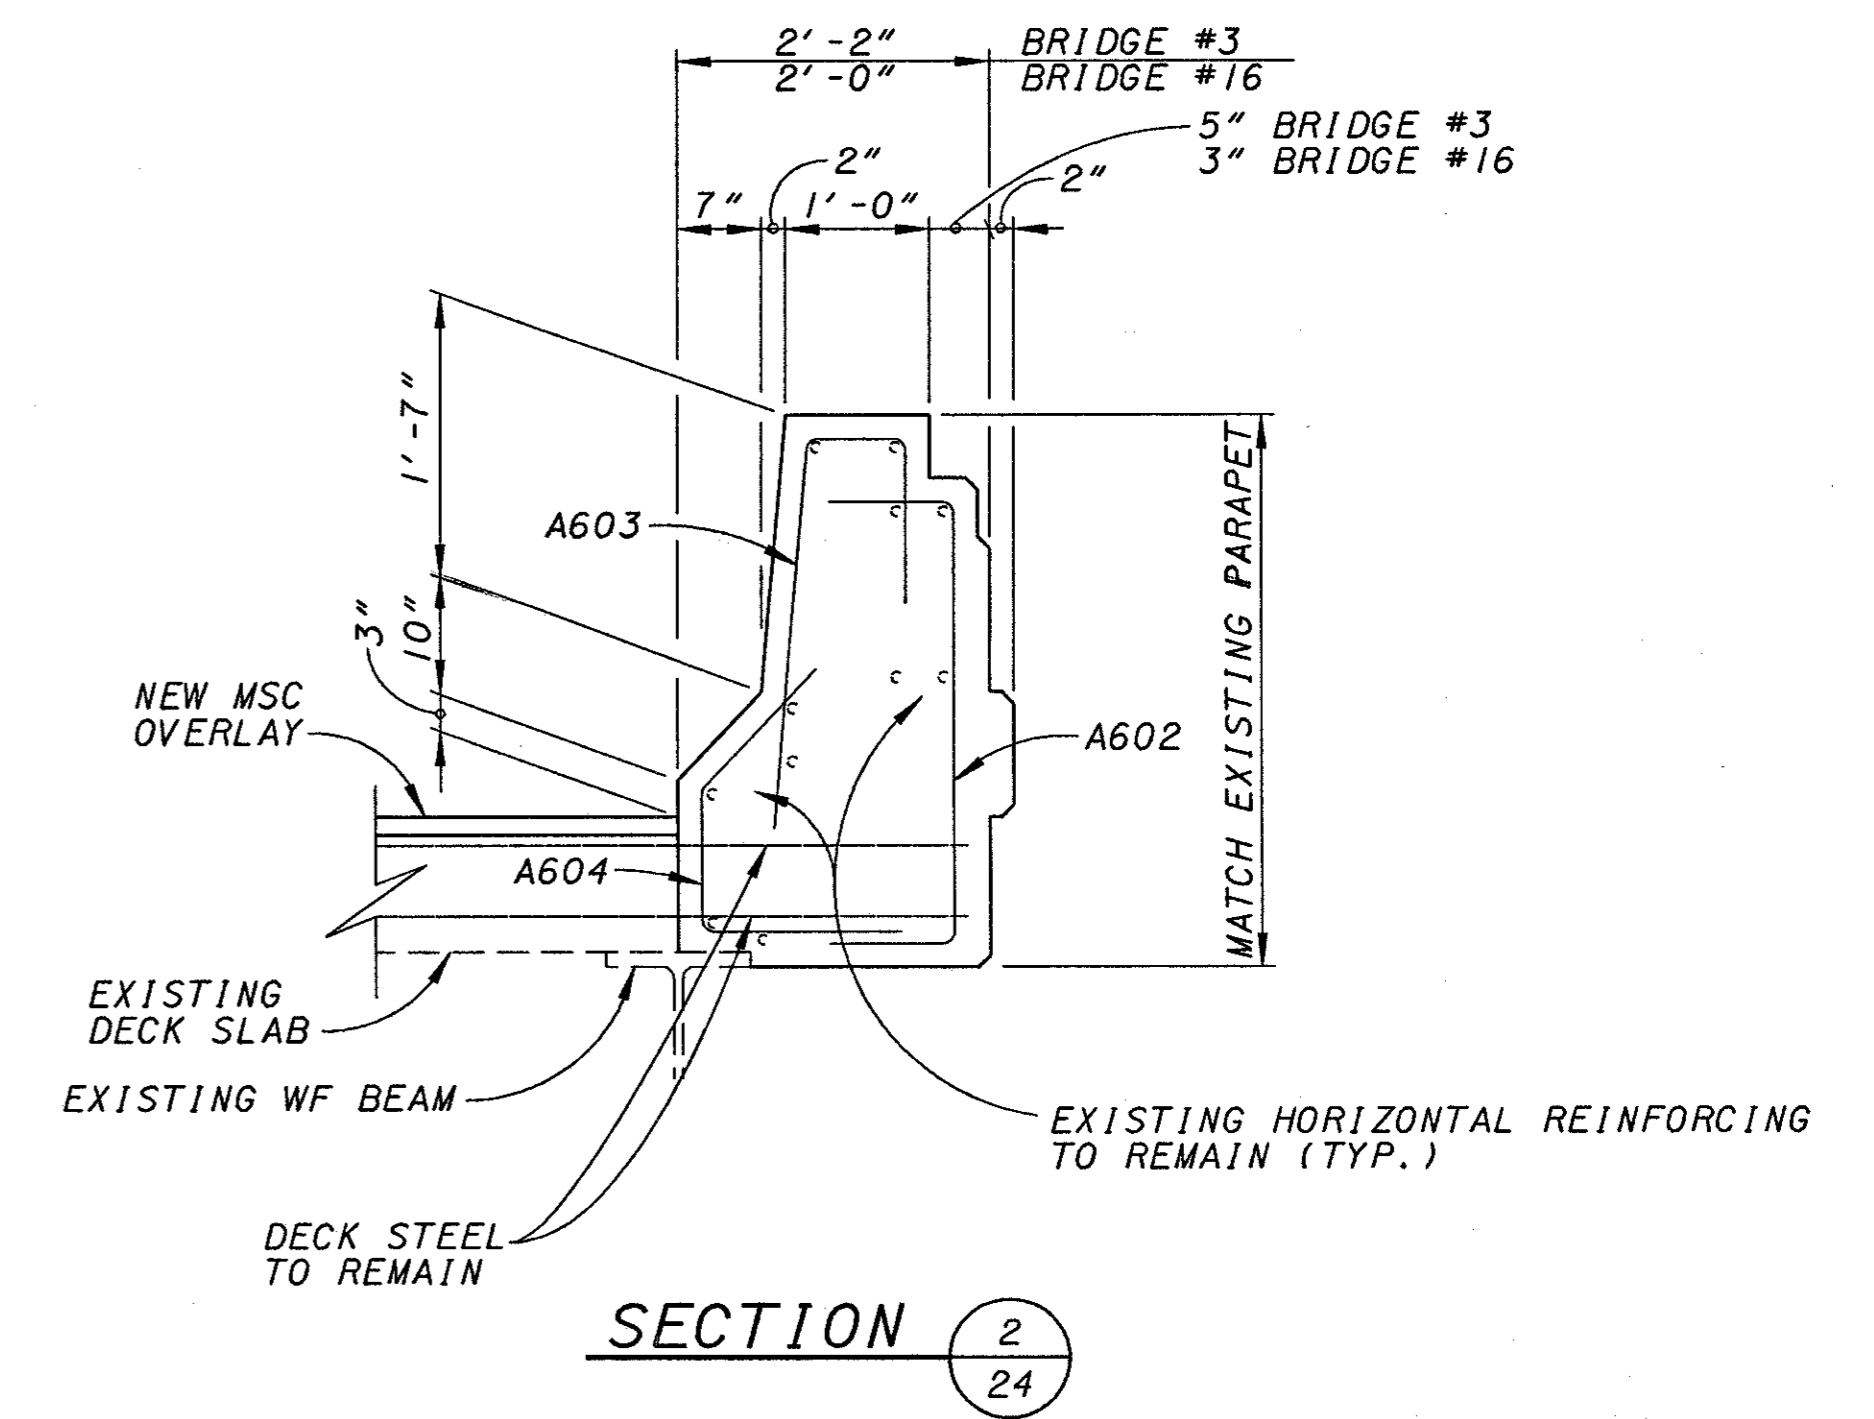

SECTION 2
24

REF: A501
REF: A502
REF: A503
REF: A504
REF: A505

REF: A601
REF: A602
REF: A603
REF: A604

REF: A501
REF: A502
REF: A503
REF: A504
REF: A505

REF: A601
REF: A602
REF: A603
REF: A604

ACTIVE LEVELS ON SHEET