



PRE - 70 - 0.00 Part 1&2
 200043 PID - 96654
 Dist 8 3/12/2020

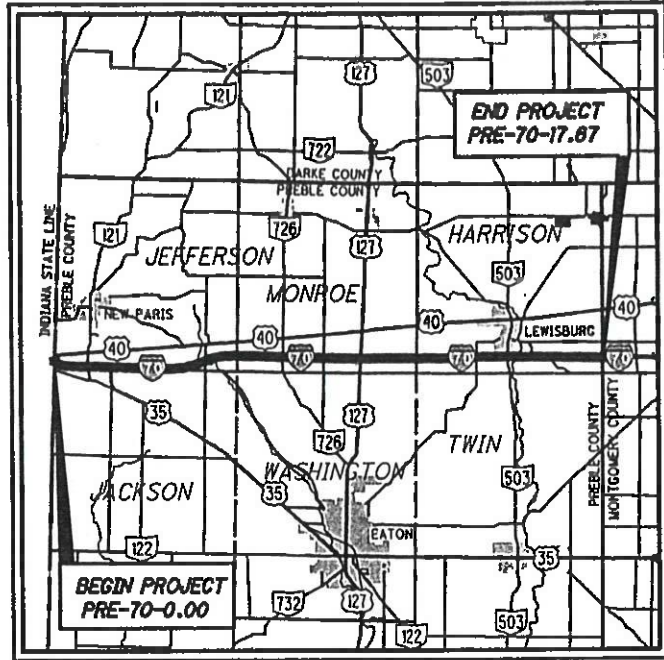

LOCATION MAP
 LATITUDE: 39°50'08" LONGITUDE: 84°38'59"
 SCALE IN MILES

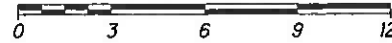

PORTION TO BE IMPROVED	-----
INTERSTATE HIGHWAY	=====
FEDERAL ROUTES	-----
STATE ROUTES	-----
COUNTY & TOWNSHIP ROADS	-----
OTHER ROADS	-----

DESIGN DESIGNATION	I.R. 70 0.00-1.66	I.R. 70 1.66-9.91	I.R. 70 9.91-14.66	I.R. 70 14.66-17.67	S.R. 320	S.R. 726
CURRENT ADT (2020)	38000	32000	35000	38000	1300	1200
DESIGN YEAR ADT (2040)	54000	39000	42000	44000	1300	1300
DESIGN HOURLY VOLUME (2040)	4900	3500	3800	4400	120	160
DIRECTIONAL DISTRIBUTION	53%	52%	50%	52%	52%	55%
TRUCKS (24 HOUR B&C)	35%	37%	30%	31%	7%	7%
DESIGN SPEED	70MPH	70MPH	70MPH	70MPH	45MPH	55MPH
LEGAL SPEED	70MPH	70MPH	70MPH	70MPH	45MPH	55MPH

DESIGN FUNCTIONAL CLASSIFICATION:
 I.R. 70 - 01 INTERSTATE (RURAL)
 S.R. 320 - 05 MAJOR COLLECTOR (RURAL)
 S.R. 726 - 05 MAJOR COLLECTOR (RURAL)
 NHS PROJECT ----- YES

DESIGN EXCEPTIONS
 VERTICAL ALIGNMENT: STOPPING SIGHT DISTANCE APPROVAL DATE 12/04/2018 SHEET No. 40

UNDERGROUND UTILITIES
 Contact Two Working Days
 Before You Dig



OHIO811, 8-1-1, or 1-800-362-2764
 (Non-members must be called directly)

PLAN PREPARED BY:
Stantec CARPENTER MARTY
 11687 Lebanon Road Cincinnati OH 45241 (513) 842-8200

STATE OF OHIO
 DEPARTMENT OF TRANSPORTATION

PRE-70-0.00

PART 1

JACKSON TOWNSHIP
 JEFFERSON TOWNSHIP
 MONROE TOWNSHIP
 HARRISON TOWNSHIP
 FOR PART 2, SEE PRE-35-1.95

INDEX OF SHEETS:

TITLE	1
SCHEMATIC	2-9
TYPICAL SECTIONS/QUANTITIES	10-15
PAVEMENT SUBSUMMARY	16
GENERAL NOTES/PROJECT CONTROL	17-20
MAINTENANCE OF TRAFFIC	21-30
GENERAL SUMMARY	31-33
SUBSUMMARIES	34-38
PLAN AND PROFILE	39-40
CROSS SECTIONS S.R. 726	41-45
DRIVE PROFILES	46
PAVEMENT REHABILITATION PLANS	47-48
WESTBOUND REST AREA PLAN	48A-48B
LIGHTING PLANS	49-72
STRUCTURES OVER 20'	
COMMON DETAILS AND QUANTITIES	73-76
PRE 70 0632 L/R	77-78
PRE 70 0689 L/R	79-81
PRE 70 1072 L/R	82-86
PRE 70 1249 L/R	87-89
PRE 70 1349 L/R	90-92
PRE 70 1500 L/R	93-95
PRE 70 1541	96-97
PRE 320 0117	98-117
PRE 70 0504	118-126
PRE 726 0428	127-147

SHEETS NOT USED: 53, 63, 64, 65
 ADDITIONAL SHEETS: 28A, 36A, 48A, 48B

PARTS 1 AND 2

STANDARD CONSTRUCTION DRAWINGS										SUPPLEMENTAL SPECIFICATIONS	
BP-1.1	7/28/00	MGS-2.1	1/19/18	HL-30.21	1/17/14	MT-98.20	4/19/19	TC-22.10	10/18/13	800	10/18/19
BP-2.2	7/18/08	MGS-3.1	1/19/18	HL-30.22	1/17/14	MT-98.22	1/20/17	TC-41.20	10/18/13	808	1/18/19
BP-2.4	7/19/13	MGS-3.2	1/18/13	HL-40.10	1/20/17	MT-98.28	1/20/17	TC-41.30	10/18/13	809	10/18/19
BP-2.5	7/19/13	MGS-4.2	7/19/13	HL-50.21	1/18/19	MT-98.29	7/19/19	TC-41.50	10/18/13	813	10/19/18
BP-2.6	7/15/16	MGS-4.3	1/18/13	HL-60.11	7/21/17	MT-99.20	4/19/19	TC-42.20	10/18/13	821	4/20/12
BP-3.1	10/18/19	MGS-5.2	7/15/16	HL-60.21	7/20/18	MT-99.30	1/19/18	TC-52.10	10/18/13	832	10/19/18
BP-4.1	7/19/13	MGS-5.3	7/15/16	HL-60.31	1/18/19	MT-99.60	7/15/16	TC-52.20	7/20/18	843	10/18/19
BP-5.1	1/18/19	MGS-6.1	1/19/18	MT-95.30	7/19/19	MT-100.00	1/15/16	TC-61.30	7/19/19	878	1/18/19
BP-6.1	7/19/13	RM-4.2	10/24/19	MT-95.31	7/19/19	MT-101.60	1/20/17	TC-65.10	1/17/14	908	10/20/17
BP-9.1	1/18/19	AS-1-15	7/17/15	MT-95.40	1/20/17	MT-101.70	7/20/18	TC-65.11	7/21/17	913	4/21/17
DM-1.1	7/21/17	EXJ-4-87	1/19/18	MT-95.41	7/21/17	MT-101.75	7/15/16	TC-71.10	1/19/18	921	4/20/12
DM-1.2	1/18/13	SBR-1-13	7/20/18	MT-95.45	1/17/20	MT-101.90	7/21/17	TC-72.20	7/20/18		
DM-4.2	7/20/12	HL-10.11	7/19/19	MT-95.50	7/21/17	MT-102.30	10/16/15	TC-73.20	7/21/17		
DM-4.4	1/15/16	HL-10.12	1/20/17	MT-95.70	7/20/18	MT-103.10	1/19/18	TC-81.10	7/15/16		
F-21	7/20/18	HL-10.13	7/20/18	MT-97.10	4/19/19	MT-104.10	10/16/15	TC-84.20	10/18/13		
F-3.4	7/19/13	HL-20.11	4/21/17	MT-98.10	1/20/17	MT-105.10	7/19/13				
MGS-1.1	1/19/18	HL-30.11	7/19/19	MT-98.11	4/19/19	TC-21.20	7/20/18				

ENGINEERS SEAL:

SIGNED: Steven N. Shadix
 DATE: OCTOBER 28, 2019

ENGINEERS SEAL: SHEETS 118-126

SIGNED: Shane T. Kalinski
 DATE: OCTOBER 25, 2019

ENGINEERS SEAL: SHEETS 73-117, 127-147

SIGNED: Michael R. Sturdevant
 DATE: OCTOBER 25, 2019

PROJECT DESCRIPTION

REPAIR AND RESURFACING OF ALL LANES, SHOULDERS, RAMPS AND MEDIAN CROSSOVERS ON I.R. 70 IN PREBLE COUNTY. THE PROJECT INCLUDES 22 BRIDGES THAT RECEIVE A RANGE OF WORK FROM SEALING TO DECK REPLACEMENT. THE EASTBOUND REST AREA IS ALSO INCLUDED FOR CONCRETE PAVEMENT REPAIR AND RESURFACING OF ASPHALT RAMPS. THE EASTBOUND WEIGH STATION ASPHALT PARKING AREA AND RAMPS ARE TO BE RESURFACED. REHABILITATION OF EXISTING LIGHTING SYSTEMS WEIGH STATION AND U.S. 127 INTERCHANGE. INSTALLATION OF PARTIAL INTERCHANGE LIGHTING AT U.S. 39 AND S.R. 503 INTERCHANGES. REMOVAL OF EXISTING PAVEMENT, LIGHTING AND OTHER APPURTENANCES IN THE FORMER WESTBOUND REST AREA.

EARTH DISTURBED AREAS

PROJECT EARTH DISTURBED AREA: N/A*
 ESTIMATED CONTRACTOR EARTH DISTURBED AREA: N/A*
 NOTICE OF INTENT EARTH DISTURBED AREA: N/A*
 * MAINTENANCE PROJECT

LIMITED ACCESS

THIS IMPROVEMENT IS ESPECIALLY DESIGNED FOR THROUGH TRAFFIC AND HAS BEEN DECLARED A LIMITED ACCESS HIGHWAY OR FREEWAY BY ACTION OF THE DIRECTOR IN ACCORDANCE WITH THE PROVISIONS OF SECTION 5511.02 OF THE OHIO REVISED CODE.

2019 SPECIFICATIONS

THE STANDARD SPECIFICATIONS OF THE STATE OF OHIO, DEPARTMENT OF TRANSPORTATION, INCLUDING SUPPLEMENTAL SPECIFICATIONS LISTED IN THE PLANS AND CHANGES LISTED IN THE PROPOSAL SHALL GOVERN THIS IMPROVEMENT.

I HEREBY APPROVE THESE PLANS AND DECLARE THAT THE MAKING OF THIS IMPROVEMENT WILL NOT REQUIRE THE CLOSING TO TRAFFIC OF THE HIGHWAY EXCEPT FOR THE FIVE LOCATIONS AS DESCRIBED ON SHEET 21 AND THAT PROVISIONS FOR THE MAINTENANCE AND SAFETY OF TRAFFIC WILL BE AS SET FORTH ON THE PLANS AND ESTIMATES.

APPROVED: *Tanya K. Campbell*
 DATE: 11/7/19 DISTRICT DEPUTY DIRECTOR

APPROVED: *Paul M. ...*
 DATE: 4/15/18 DIRECTOR, DEPARTMENT OF TRANSPORTATION


FEDERAL PROJECT NO. E150(996)
 PID NO. 96654
 CONSTRUCTION PROJECT NO. NONE
 RAILROAD INVOLVEMENT NONE
 PRE-70-0.00 PART 1
 147

SCHEMATIC PRE-70-2.59-3.13 REST AREA



CALCULATED
LBA
CHECKED
PJD

V:\1736\active\173620094\Engineering\96654\ProjAdmin\PlanReviews\Tracings\Tracings- Revised Addendum 3_3_6_2020\96654_GP005.dgn 3/6/2020 4:29:42 PM pdurham

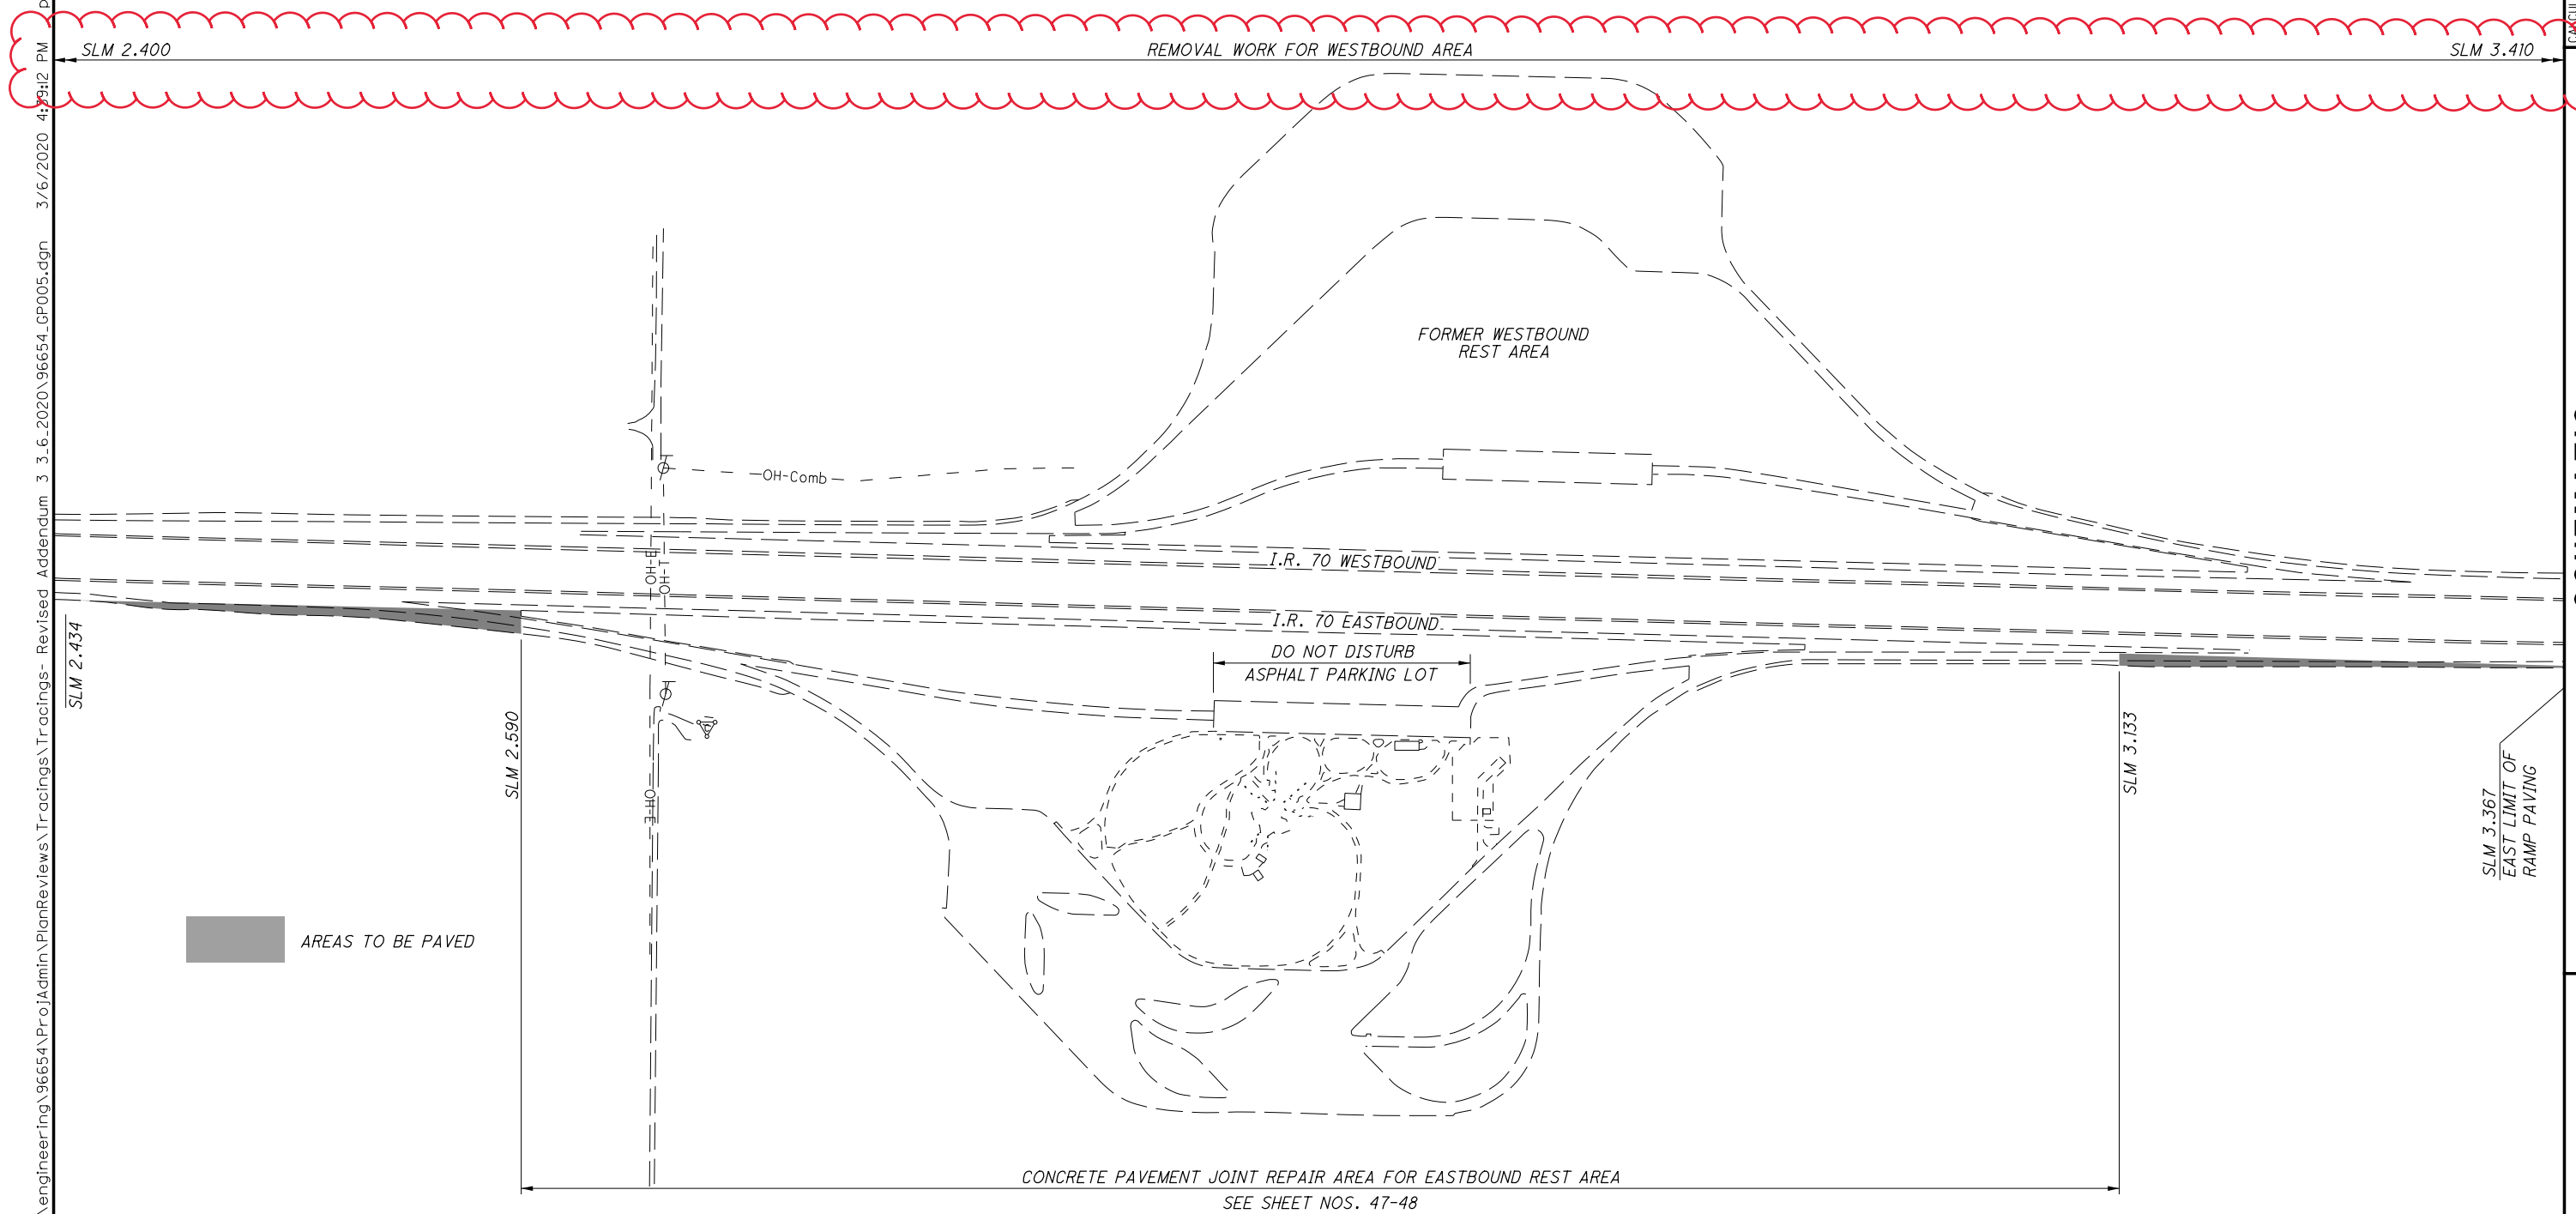

SCHEMATIC
EASTBOUND REST AREA

PRE-70-0.00

SEEDING AND MULCHING

THE FOLLOWING QUANTITIES ARE PROVIDED TO PROMOTE GROWTH AND CARE OF PERMANENT SEEDED AREAS:

659, REPAIR SEEDING AND MULCHING
24713 SQ. YD. (S&M) x 0.05 = 1235.6 SQ. YD.
USE 1236 SQ. YD.

659, COMMERCIAL FERTILIZER
24713 / 7410 = 3.34 TON

659, LIME
24713 x 9 / 43560 = 5.11 ACRES

659, WATER
24713 x 2 x .0027 = 133.4 M. GAL
USE 134 M. GAL.

SEEDING AND MULCHING SHALL BE APPLIED TO ALL AREAS OF EXPOSED SOIL BETWEEN THE RIGHT-OF-WAY LINES, AND WITHIN THE CONSTRUCTION LIMITS FOR AREAS OUTSIDE THE RIGHT-OF-WAY LINES COVERED BY WORK AGREEMENT OR SLOPE EASEMENT. QUANTITY CALCULATIONS FOR SEEDING AND MULCHING ARE BASED ON THESE LIMITS.

ITEM 832 EROSION CONTROL

THE FOLLOWING QUANTITY HAS BEEN CARRIED TO THE GENERAL SUMMARY FOR LOCATING, FURNISHING, INSTALLING AND MAINTAINING TEMPORARY SEDIMENT AND EROSION CONTROL FOR EARTH DISTURBED AREAS.

ITEM 832 EROSION CONTROL 5000 EACH

VERTICAL GRADE WARNING SIGNS

THE CONTRACTOR SHALL FURNISH AND INSTALL PERMANENT W7-6-36 "HILL BLOCKS VIEW" SIGNS WITH W13-IP-18 "ADVISORY SPEED PLAQUE" SIGNS ON SR 726 ON EITHER SIDE OF THE IR 70 OVERPASS BRIDGE TO WARN DRIVERS TO REDUCE SPEED APPROACHING THE CREST VERTICAL CURVE ON THE BRIDGE. THE ADVISORY SPEED TO BE LISTED ON THE W13-IP-18 SIGNS SHALL BE 45 MPH. THESE SIGNS SHOULD BE LOCATED AT APPROXIMATELY STA 6+00 AND STA 14+00.

SEE SHEET NO. 38 FOR QUANTITIES

COORDINATION BETWEEN CONTRACTORS

THE CONSTRUCTION AT PRE-70-0.00 MAY REQUIRE THE CONTRACTOR TO COORDINATE WITH THE ADJACENT PREBLE COUNTY CULVERT PROJECTS (PID 106504 AND PID 105967) AND PRE-35-1.76 (PID 100807).

COOPERATION WITH THE ENGINEER, INSPECTORS, AND ALL OTHER CONTRACTORS ON OR ADJACENT TO THE PROJECT IS REQUIRED, AS PER CMS 105.08.

ASBESTOS NOTIFICATION

SHOULD THE CONTRACTOR ENCOUNTER ASBESTOS CONTAINING MATERIALS (ACM) ON THE EXISTING STRUCTURES, THE HANDLING AND DISPOSAL OF SAID ACM WILL BE COVERED UNDER CMS ITEM 202 WITH PAYMENT IN ACCORDANCE WITH CMS 109.05.

A WEBLINK TO THE OHIO ENVIRONMENTAL PROTECTION AGENCY (OEPA) NOTIFICATION OF DEMOLITION AND RENOVATION FORM, WILL BE PROVIDED TO THE CONTRACTOR AT THE PRE-CONSTRUCTION MEETING. ODOT WILL SUPPLY THE INFORMATION FOR SECTIONS I-VII AND XVII-XVIII OF THE FORM. THE CONTRACTOR WILL COMPLETE THE ONLINE FORMS AND SUBMIT THEM TO THE SOUTHWEST OEPA DISTRICT OFFICE (OEPA-SWDO) AT LEAST 10 DAYS PRIOR TO DEMOLITION/RENOVATION ACTIVITIES. THE COSTS ASSOCIATED WITH ASBESTOS NOTIFICATION SHALL BE INCIDENTAL TO ITEM 202, PORTIONS OF STRUCTURE REMOVED, OVER 20 FOOT SPAN, AS PER PLAN.

IN THE EVENT THAT THE CONTRACTOR, OR THE ASSOCIATED SUB-CONTRACTORS, ENCOUNTER ANY MATERIAL SUSPECTED OF CONTAINING ACM, DEMOLITION ACTIVITIES SHALL CEASE AND THE SUSPECT AREAS WETTED. THE CONTRACTOR SHALL THEN NOTIFY THE PROJECT ENGINEER, OEPA-SWDO AND THE ODOT DISTRICT 08 CERTIFIED ASBESTOS HAZARD EVALUATION SPECIALIST (CAHES) (KEITH SMITH, (513) 933-6590).

ASBESTOS ABATEMENT

IN THE EVENT THAT ACM IS ENCOUNTERED, THE CONTRACTOR SHALL TAKE WHATEVER PRECAUTIONS ARE POSSIBLE TO ENSURE THAT THE ACM DOES NOT BECOME FRIABLE. TO ENSURE THAT THE NONFRIABLE ACM DOES NOT BECOME FRIABLE, OR IN THE EVENT THAT THE NONFRIABLE MATERIALS BECOME FRIABLE, THE CONTRACTOR SHALL PROVIDE AN INDIVIDUAL TRAINED IN THE PROVISIONS OF THE NATIONAL EMISSIONS STANDARDS FOR HAZARDOUS AIR POLLUTANTS (NESHA) TO BE LOCATED ON-SITE DURING DEMOLITION AND/OR REMOVAL OF THE ACM. ALL ACM SHALL BE PROPERLY CONTAINERIZED, TRANSPORTED AND DISPOSED OF IN ACCORDANCE WITH THE ASSOCIATED STATE AND FEDERAL REGULATIONS.

THE CONTRACTOR SHALL FURNISH ALL THE LABOR (INCLUDING A CAHES), EQUIPMENT AND MATERIALS NECESSARY TO COMPLETE, SUBMIT AND COMPLY WITH THE OEPA NOTIFICATION FOR, AND TO REMOVE, TRANSPORT AND DISPOSE OF ACM IN A LICENSED (BY THE LOCAL HEALTH DEPARTMENT) AND PERMITTED (BY THE OEPA) SOLID WASTE FACILITY.

NON-USE OF ASBESTOS-CONTAINING MATERIALS

THE CONTRACTOR SHALL AT NO TIME INCORPORATE ANY MATERIALS WHICH ARE COMPOSED OF OR CONTAIN ANY AMOUNTS OF ASBESTOS. THE SUBSTITUTION OF MATERIALS WHICH CONTAIN ANY AMOUNTS OF ASBESTOS WILL IN NO CIRCUMSTANCES BE ACCEPTABLE. UPON COMPLETION OF THE PROJECT, THE CONTRACTOR SHALL SUBMIT A WRITTEN STATEMENT OF CERTIFICATION ASSERTING THAT NO ASBESTOS CONTAINING MATERIALS WERE USED IN ANY PORTION OF THE CONSTRUCTION.

SURVEYING PARAMETERS

PRIMARY PROJECT CONTROL MONUMENTS GOVERN ALL POSITIONING ON ODOT PROJECTS. SEE TABLE ON THIS SHEET CONTAINING PROJECT CONTROL INFORMATION.

USE THE FOLLOWING PROJECT CONTROL, VERTICAL POSITIONING, AND HORIZONTAL POSITIONING PARAMETERS FOR ALL SURVEYING:

PROJECT CONTROL
POSITIONING METHOD: ODOT VRS
MONUMENT TYPE: AS NOTED IN PROJECT CONTROL TABLE BELOW

VERTICAL POSITIONING
ORTHOMETRIC HEIGHT DATUM: NAVD 88
GEOID: 12B

HORIZONTAL POSITIONING
REFERENCE FRAME: NAD 83 (2011)
ELLIPSOID: GRS 80
MAP PROJECTION: LAMBERT CONFORMAL CONIC
COORDINATE SYSTEM: OHIO STATE PLANE (SOUTH ZONE)
COMBINED SCALE FACTOR: 1.000000000
ORIGIN OF COORDINATE SYSTEM: 0,0

USE THE POSITIONING METHODS AND MONUMENT TYPE USED IN THE ORIGINAL SURVEY TO RESTORE ALL MONUMENTS RELATED TO PRIMARY PROJECT CONTROL THAT ARE DAMAGED OR DESTROYED BY CONSTRUCTION ACTIVITIES. RESTORE THE DAMAGED OR DESTROYED MONUMENTS IN ACCORDANCE WITH CMS 623.

UNITS ARE IN U.S. SURVEY FEET.

LOCATION	203		204			659
	EXCAVATION	EMBANKMENT	EXCAVATION OF SUBGRADE	GRANULAR MATERIAL, TYPE C	GEOTEXTILE FABRIC (AREA IS EQUAL TO SUBGRADE COMPACTION FROM PAVEMENT CALCS)	SEEDING AND MULCHING
	CY	CY	CY	CY	SY	SY
SR 320	325	20	223	223	825	556
SR 726	455	19	443	443	1167	668
SR 320 STA 20+20.19 DRIVE LT	12	1				
SR 320 STA 24+66.22 DRIVE LT	10	2				
SR 320 STA 24+66.55 DRIVE RT	22	2				
FROM SHEET NO. 50 (LIGHTING)						10860
TOTALS CARRIED TO GENERAL SUMMARY	824	44	666	666	1992	12084

PROJECT CONTROL				
PRE-70-0.00 Stantec Job#173620094				
CONTROL POINT COORDINATES SUPPLIED BY ODOT				
CONTROL FOR SR 320	Grid North	Grid East	Mon. Type	Elevation
SA1	674213.325	1324465.674	IPINS STA 22+71.20, 55.65 RT	1161.780
SA3	673998.722	1324443.235	MAGS STA 20+56.92, 16.89 RT	1183.520
VA2	674366.551	1324422.490	IPINS STA 24+27.06, 16.93 RT	1178.110
CONTROL FOR SR 726	Grid North	Grid East	TYPE	ELEVATION
SE2	675692.327	1357319.406	MAGS STA 7+93.86, 13.71 RT	1138.066
VE1	675186.493	1357277.530	MAGS STA 2+87.31, 18.30 LT	1118.836

V:\1736\active\173620094\engineering\96654\ProjAdmin\PlanReviews\Tracings\Tracings- Revised Addendum 3_3_16_2020\96654_GN001.dgn 3/6/2020 4:39:42 PM pdurnham

CALCULATED
JTK
CHECKED
PJD

GENERAL NOTES

PRE-70-0.00

V:\1736\active\173620094\engineering\96654\ProjAdmin\PlanReviews\Tracings\Tracings- Revised Addendum 3_3_16_2020\96654_MN001.dgn 3/6/2020 4:39:13 PM pdurham

SEQUENCE OF CONSTRUCTION

THE SEQUENCE OF CONSTRUCTION OUTLINED BELOW IS INTENDED TO GUIDE THE WORK IN A MANNER THAT PROVIDES A BASIC LEVEL OF SERVICE TO ALL MOTORISTS. ALTHOUGH THIS SEQUENCE OF CONSTRUCTION LISTS TASKS IN A SPECIFIC ORDER, NOT EVERY ITEM LISTED MUST BE COMPLETED BEFORE COMMENCING THE NEXT ITEM, AND SOME TASKS MAY BE PERFORMED CONCURRENTLY.

PHASE 1, TASK 1: MAJOR BRIDGE REHABILITATION OF PRE-320-0117

A MINIMUM OF ONE LANE OF TRAFFIC IN EACH DIRECTION SHALL BE MAINTAINED AT ALL TIMES EXCEPT FOR A PERIOD OF TIME AS DESCRIBED ON SHEET 24 WHEN TRAFFIC MAY BE DETOURED. THE DETOUR AND DETOUR SIGNING ARE SHOWN ON SHEET 26. ACCESS TO ALL DRIVES SHALL BE MAINTAINED AT ALL TIMES, INCLUDING DURING THE CLOSURE. FALSEWORK WILL BE REQUIRED ON THE BRIDGE DURING CONSTRUCTION AND SHOULD BE INSTALLED PRIOR TO ANY BRIDGE WORK. THE FALSEWORK CAN BE INSTALLED, AND SUBSEQUENTLY REMOVED, USING SINGLE LANE CLOSURES ON I.R. 70 AT PERMISSIBLE TIMES AS SHOWN ON SHEET 24. LANE CLOSURES ON I.R. 70 SHOULD BE INSTALLED ACCORDING TO STANDARD CONSTRUCTION DRAWING (SCD) MT-95.30.

PHASE 1, TASK 2: MAJOR BRIDGE REHABILITATION OF PRE-726-0428

A MINIMUM OF ONE LANE OF TRAFFIC IN EACH DIRECTION SHALL BE MAINTAINED AT ALL TIMES EXCEPT FOR A PERIOD OF TIME AS DESCRIBED ON SHEET 24 WHEN TRAFFIC MAY BE DETOURED. THE DETOUR AND DETOUR SIGNING ARE SHOWN ON SHEET 27. ACCESS TO ALL DRIVES SHALL BE MAINTAINED AT ALL TIMES, INCLUDING DURING THE CLOSURE. FALSEWORK WILL BE REQUIRED ON THE BRIDGE DURING CONSTRUCTION AND SHOULD BE INSTALLED PRIOR TO ANY BRIDGE WORK. THE FALSEWORK CAN BE INSTALLED, AND SUBSEQUENTLY REMOVED, USING SINGLE LANE CLOSURES ON I.R. 70 AT PERMISSIBLE TIMES AS SHOWN ON SHEET 24. LANE CLOSURES ON I.R. 70 SHOULD BE INSTALLED ACCORDING TO SCD MT-95.30.

PHASE 1, TASK 3: BRIDGE PARAPET REPAIR ON PRE-70-0632

A MINIMUM OF ONE LANE OF TRAFFIC IN EACH DIRECTION ON PENCE SHEWMAN ROAD SHALL BE MAINTAINED AT ALL TIMES EXCEPT FOR A PERIOD OF TIME AS DESCRIBED ON SHEET 24 WHEN TRAFFIC MAY BE DETOURED. THE DETOUR AND DETOUR SIGNING ARE SHOWN ON SHEET 28. ACCESS TO ALL DRIVES SHALL BE MAINTAINED AT ALL TIMES, INCLUDING DURING THE CLOSURE. FALSEWORK WILL BE REQUIRED ON THE BRIDGE DURING CONSTRUCTION AND SHOULD BE INSTALLED PRIOR TO ANY BRIDGE WORK. THE FALSEWORK CAN BE INSTALLED, AND SUBSEQUENTLY REMOVED, USING SINGLE LANE CLOSURES ON I.R. 70 AT PERMISSIBLE TIMES AS SHOWN ON SHEET 24. LANE CLOSURES ON I.R. 70 SHOULD BE INSTALLED ACCORDING TO STANDARD CONSTRUCTION DRAWING (SCD) MT-95.30.

THE DETOUR PLAN FOR THIS WORK UTILIZES S.R. 726. THEREFORE, TASK 2 AND TASK 3 SHALL NOT BE CONSTRUCTED CONCURRENTLY. ONLY ONE DETOUR MAY BE IN PLACE AT A TIME.

SEQUENCE OF CONSTRUCTION (CONTINUED)

PHASE 1, TASK 4: BRIDGE PARAPET REPAIR ON PRE-70-1541

A MINIMUM OF ONE LANE OF TRAFFIC IN EACH DIRECTION ON LEWISBURG ROAD SHALL BE MAINTAINED AT ALL TIMES EXCEPT FOR A PERIOD OF TIME AS DESCRIBED ON SHEET 24 WHEN TRAFFIC MAY BE DETOURED. THE DETOUR AND DETOUR SIGNING ARE SHOWN ON SHEET 28A. FALSEWORK WILL BE REQUIRED ON THE BRIDGE DURING CONSTRUCTION AND SHOULD BE INSTALLED PRIOR TO ANY BRIDGE WORK. THE FALSEWORK CAN BE INSTALLED, AND SUBSEQUENTLY REMOVED, USING SINGLE LANE CLOSURES ON I.R. 70 AT PERMISSIBLE TIMES AS SHOWN ON SHEET 24. LANE CLOSURES ON I.R. 70 SHOULD BE INSTALLED ACCORDING TO SCD MT-95.30.

PHASE 2, TASK 1: MINOR BRIDGE REHABILITATION ON THE REMAINING STRUCTURES AS DETAILED IN THE PLANS.

REHABILITATION OF THE FOLLOWING BRIDGES AS DETAILED IN THE PLANS SHOULD NOT REQUIRE ANY LANE OR SHOULDER CLOSURES OR RESTRICTIONS. ALTHOUGH NONE ARE ANTICIPATED, ALL TEMPORARY TRAFFIC CONTROL DEVICES SHALL BE INSTALLED ACCORDING TO AND WHEN REQUIRED BY THE OMUTCD AND SCDs.

- | | |
|-------------|--------------|
| PRE-70-358 | PRE-503-1955 |
| PRE-70-0489 | PRE-70-1665 |
| PRE-70-0632 | PRE-70-1766 |
| PRE-70-1366 | |

NIGHTTIME LANE CLOSURES WILL BE REQUIRED TO PERFORM BRIDGE REHABILITATION ON THE FOLLOWING STRUCTURES.

- | | |
|-----------------|-----------------|
| PRE-70-0504 L/R | PRE-70-1349 L/R |
| PRE-70-0689 L/R | PRE-70-1500 L/R |
| PRE-70-1072 L/R | |
| PRE-70-1249 L/R | |

THE HOURS OF SUCH CLOSURES ARE SUBJECT TO THE PERMITTED LANE CLOSURE SCHEDULE AND LANE VALUE CONTRACT TABLE SHOWN IN THE PLANS. LANES SHOULD BE CLOSED AS OUTLINED ON SCD MT-95.30, CLOSING RIGHT OR LEFT LANE OF A MULTI-LANE DIVIDED HIGHWAY WITH DRUMS. SOME BRIDGES ARE LOCATED NEAR ENTRANCE AND EXIT RAMP AND WILL ALSO REQUIRE SCDs MT-98.10 LANE CLOSURE AT ENTRANCE RAMP AND MT-98.20 LANE CLOSURE AT EXIT RAMP USING DRUMS. ONE LANE IN EACH DIRECTION MUST REMAIN OPEN TO TRAFFIC AT ALL TIMES.

PARAPET REPAIR ON PRE-70-1541 WILL REQUIRE ADDITIONAL MAINTENANCE OF TRAFFIC ON C.R. 34 (LEWISBURG RD). REPAIRS SHOULD NOT BE MADE ABOVE LIVE TRAFFIC ON I.R. 70. WORK MAY ONLY BE COMPLETED OVER ONE LANE AT A TIME, WHILE CLOSED, TO PREVENT DEBRIS FROM FALLING ONTO MOTORISTS. ALTERNATIVELY, AT THE APPROVAL OF THE ENGINEER, THE CONTRACTOR MAY CHOOSE TO PROTECT I.R. 70 MOTORISTS BY INSTALLING A CATCHMENT SYSTEM ON THE BRIDGE TO PREVENT DEBRIS FROM FALLING ON THE HIGHWAY BELOW. A FLAGGER SHOULD BE USED TO MAINTAIN ONE LANE OF TRAFFIC ON C.R. 34 DURING PARAPET REPAIR. USE SCD MT-97.10 FLAGGER CLOSING 1 LANE OF A 2-LANE HIGHWAY - STATIONARY OPERATION.

SEQUENCE OF CONSTRUCTION (CONTINUED)

PHASE 2, TASK 2: LIGHTING INSTALLATIONS

IT IS ANTICIPATED THAT ALL WORK RELATED TO LIGHTING CAN BE COMPLETED WITHOUT LANE RESTRICTIONS ON ANY ROAD. ALL LIGHTING WORK, WITH THE EXCEPTION OF LUMINAIRE REPLACEMENTS, ARE OUTSIDE OF THE EXISTING SHOULDERS OF ALL ROUTES. USE SCD MT-95.45 CLOSING RIGHT OF LEFT SHOULDER OF A MULTILANE DIVIDED HIGHWAY TO CLOSE SHOULDERS AS NECESSARY. ALL TEMPORARY TRAFFIC CONTROL DEVICES SHALL BE INSTALLED ACCORDING TO AND WHEN REQUIRED BY THE OMUTCD AND SCDs.

PHASE 2, TASK 3: MILLING AND FILLING OF WEIGH STATION PAVEMENT

THIS WORK SHALL CONSIST OF MILLING AND FILLING PAVEMENT WITHIN THE LIMITS OF THE WEIGH STATION. THE WEIGH STATION MAY BE CLOSED FOR A PERIOD NOT TO EXCEED THE NUMBER OF CONSECUTIVE CALENDAR DAYS SHOWN ON SHEET 24. CLOSURE OF THE WEIGH STATION SHALL BE PERFORMED AS OUTLINED ON SHEET NO. 29. A NOTICE OF CLOSURE SIGN SHALL BE INSTALLED PRIOR TO THE RAMP CLOSURE AS NOTED ON SHEET 21. FINAL PAVEMENT MARKINGS SHALL BE IN PLACE BEFORE THE WEIGH STATION IS OPENED TO TRAFFIC.

PHASE 2, TASK 4: PAVEMENT REPAIR IN REST AREA

THIS WORK SHALL CONSIST OF CONCRETE PAVEMENT REPAIR ON THE RAMPS AND TRUCK PARKING AREAS WITHIN THE EASTBOUND REST AREA. THE REST AREA MAY BE CLOSED FOR A PERIOD NOT TO EXCEED THE NUMBER OF CONSECUTIVE CALENDAR DAYS SHOWN ON SHEET 24 IN ORDER TO COMPLETE THIS WORK. CLOSURE OF THE REST AREA SHALL BE COMPLETE AS OUTLINED ON SHEET NO. 30. A NOTICE OF CLOSURE SIGN SHALL BE INSTALLED PRIOR TO THE RAMP CLOSURE AS NOTED ON SHEET 21. FINAL PAVEMENT MARKINGS SHALL BE IN PLACE BEFORE THE REST AREA IS OPENED TO TRAFFIC.

PHASE 3, TASK 1: WESTBOUND REST AREA

THE CONTRACTOR SHALL CLOSE THE SHOULDER OF WESTBOUND I.R. 70 AS NECESSARY TO PERFORM THE WORK. THE SHOULDER SHALL BE CLOSED ACCORDING TO SCD MT-95.45 CLOSING SHOULDER OF A MULTI-LANE DIVIDED HIGHWAY.

PHASE 3, TASK 2: PAVEMENT REPAIR ALONG IR 70 AND RAMPS

NIGHTLY LANE CLOSURES WILL BE REQUIRED TO PERFORM PAVEMENT REPAIRS ALONG MAINLINE I.R. 70. THE HOURS OF SUCH CLOSURES ARE SUBJECT TO THE PERMITTED LANE CLOSURE SCHEDULE AND LANE VALUE CONTRACT TABLE SHOWN IN THE PLANS. LANES SHOULD BE CLOSED AS OUTLINED ON SCD MT-95.30, CLOSING RIGHT OR LEFT LANE OF A MULTI-LANE DIVIDED HIGHWAY WITH DRUMS. SOME PAVEMENT REPAIRS ARE LOCATED NEAR ENTRANCE AND EXIT RAMP AND WILL REQUIRE SCDs MT-98.10 LANE CLOSURE AT ENTRANCE RAMP AND MT-98.20 LANE CLOSURE AT EXIT RAMP USING DRUMS. ONE LANE IN EACH DIRECTION MUST REMAIN OPEN TO TRAFFIC AT ALL TIMES.

SEQUENCE OF CONSTRUCTION (CONTINUED)

PHASE 3, TASK 3: MILLING PAVEMENT AND PLACING INTERMEDIATE COURSE

THIS WORK SHALL CONSIST OF MILLING THE EXISTING ASPHALT SURFACE AND PLACING A NEW INTERMEDIATE COURSE ON I.R. 70 AS INDICATED IN THE PLANS. PAVEMENT REPAIRS SHALL BE COMPLETED PRIOR TO PLACING THE NEW PAVEMENT. A MINIMUM OF ONE LANE OF TRAFFIC SHALL BE MAINTAINED ON I.R. 70 IN EACH DIRECTION AT ALL TIMES, INCLUDING RAMPS. LANE CLOSURES SHOULD BE PERFORMED AS OUTLINED IN SCD MT-95.30 CLOSING RIGHT OR LEFT LANE OF A MULTI-LANE DIVIDED HIGHWAY WITH DRUMS. PAVING WORK IN THE VICINITY OF RAMPS SHALL ALSO BE ACCORDING TO SCDs MT-98.10 LANE CLOSURE AT ENTRANCE RAMP, MT-98.11 LANE CLOSURE AT ENTRANCE RAMP ACCELERATION LANE, MT-98.20 LANE CLOSURE AT EXIT RAMP USING DRUMS, MT-98.22 LANE CLOSURE IN DECELERATION LANE, AND MT-98.28 LANE CLOSURE WITHIN EXIT RAMP. INSTALL TEMPORARY PAVEMENT MARKINGS PRIOR TO OPENING ANY PAVED SECTION TO TRAFFIC.

A MINIMUM OF ONE 10' LANE SHALL BE MAINTAINED ON ALL RAMPS DURING MILLING AND PAVING OPERATIONS. HALF OF EACH RAMP SHOULD BE CLOSED AT A TIME AS OUTLINED ON SCD MT-98.28 LANE CLOSURE WITHIN EXIT RAMP. TEMPORARY PAVEMENT MARKINGS SHOULD BE PERFORMED AS OUTLINED IN SCD MT-99.20 TRAFFIC CONTROL FOR LONG LINE PAVEMENT MARKING OPERATIONS.

PHASE 4: PLACING FINAL SURFACE COURSE ON IR 70

THIS WORK SHALL CONSIST OF PAVING THE FINAL SURFACE COURSE ON IR 70, INCLUDING RAMPS, AS INDICATED IN THE PLANS. LANE CLOSURES FOR PAVING SHALL BE IN ACCORDANCE WITH THE PERMITTED LANE CLOSURE SCHEDULE AND LAE VALUE CONTRACT TABLE SHOWN IN THE PLANS. A MINIMUM OF ONE LANE OF TRAFFIC SHALL BE MAINTAINED ON IR 70 IN EACH DIRECTION AT ALL TIMES, INCLUDING RAMPS. LANE CLOSURES SHOULD BE PERFORMED AS OUTLINED IN SCD MT-95.30 CLOSING RIGHT OR LEFT LANE OF A MULTI-LANE DIVIDED HIGHWAY WITH DRUMS. PAVING WORK IN THE VICINITY OF RAMPS SHALL ALSO BE ACCORDING TO SCDs MT-98.10 LANE CLOSURE AT ENTRANCE RAMP, MT-98.11 LANE CLOSURE AT ENTRANCE RAMP ACCELERATION LANE, MT-98.20 LANE CLOSURE AT EXIT RAMP USING DRUMS, MT-98.22 LANE CLOSURE IN DECELERATION LANE, AND MT-98.28 LANE CLOSURE WITHIN EXIT RAMP. INSTALL PERMANENT PAVEMENT MARKINGS PRIOR TO OPENING ANY PAVED SECTION TO TRAFFIC.

A MINIMUM OF ONE 10' LANE SHALL BE MAINTAINED ON ALL RAMPS DURING PAVING OPERATIONS. HALF OF EACH RAMP SHOULD BE CLOSED AT A TIME AS OUTLINED ON SCD MT-98.28 LANE CLOSURE WITHIN EXIT RAMP. PERMANENT PAVEMENT MARKINGS SHOULD BE PERFORMED AS OUTLINED IN SCD MT-99.20 TRAFFIC CONTROL FOR LONG LINE PAVEMENT MARKING OPERATIONS.

CALCULATED
P.JD
CHECKED
SNS

MAINTENANCE OF TRAFFIC NOTES

PRE-70-0:00

V:\1736\active\173620094\engineer\ng_96654\Proj\Admin\PlanReviews\Tracings\Tracings- Revised Addendum 3_3_6_2020\96654_gg001.dgn 3/7/2020 10:26:45 AM pdurham

SHEET NUM.								PART.				ITEM	ITEM EXT	GRAND TOTAL	UNIT	DESCRIPTION	SEE SHEET NO.	
16	17	19	20	35	36A	48		01/IMS/PV	02/IMS/BR	03/IMS/PV	05/STR/PV							
	LS							LS					201	11000	LS		ROADWAY	
					3,688					3,688			202	23000	3,688	SY	CLEARING AND GRUBBING	
				8,799	3,882			8,799		3,882			202	23010	12,681	SY	PAVEMENT REMOVED	
					472					472			202	32000	472	FT	PAVEMENT REMOVED, ASPHALT	
					76					76			202	35100	76	FT	CURB REMOVED	
				19,109				19,109					202	38000	19,109	FT	PIPE REMOVED, 24" AND UNDER	
				46				46					202	42010	46	EACH	GUARDRAIL REMOVED	
				14				14					202	42040	14	EACH	ANCHOR ASSEMBLY REMOVED, TYPE E	
				12				12					202	42050	12	EACH	ANCHOR ASSEMBLY REMOVED, TYPE T	
				63				63					202	47000	63	EACH	ANCHOR ASSEMBLY REMOVED, TYPE B	
					1					1			202	58100	1	EACH	BRIDGE TERMINAL ASSEMBLY REMOVED	
					2					2			202	58200	2	EACH	CATCH BASIN REMOVED	
					1					1			202	58400	1	EACH	INLET REMOVED	
		824			95			824		95			203	10000	919	CY	INLET ABANDONED	
		44						44					203	20000	44	CY	EXCAVATION	
1,992								1,992					204	10000	1,992	SY	EMBANKMENT	
		666						666					204	13000	666	CY	SUBGRADE COMPACTION	
		666						666					204	30020	666	CY	EXCAVATION OF SUBGRADE	
1								1					204	45000	1	HR	GRANULAR MATERIAL, TYPE C	
		1,992						1,992					204	50000	1,992	SY	PROOF ROLLING	
				227				227					209	15000	227	STA	GEOTEXTILE FABRIC	
				734				734					209	70000	734	CY	RESHAPING UNDER GUARDRAIL	
				15,250				15,250					606	15050	15,250	FT	BORROW	
				4,213				4,213					606	15100	4,213	FT	GUARDRAIL, TYPE MGS	
				12				12					606	26050	12	EACH	GUARDRAIL, TYPE MGS WITH LONG POSTS	
				46				46					606	26150	46	EACH	ANCHOR ASSEMBLY, MGS TYPE B	
				14				14					606	26550	14	EACH	ANCHOR ASSEMBLY, MGS TYPE E, (MASH 2016)	
				59				59					606	35002	59	EACH	ANCHOR ASSEMBLY, MGS TYPE T	
				4				4					606	35102	4	EACH	MGS BRIDGE TERMINAL ASSEMBLY, TYPE 1	
				5				5					SPECIAL	69050100	5	EACH	MGS BRIDGE TERMINAL ASSEMBLY, TYPE 2	18
			LS					LS					SPECIAL	69098400	LS		MAILBOX SUPPORT SYSTEM, SINGLE	
																	CONSULTANT FOR CONCRETE QUALITY CONTROL/INCLUDING TESTING AND INSPECTION	20
																	EROSION CONTROL	
		12,084		12,629	1,261			24,713		1,261			659	00300	1,261	CY	TOPSOIL	
		1,236			11,355			1,236		11,355			659	10000	36,068	SY	SEEDING AND MULCHING	
		3.34			1.54			3.34		1.54			659	14000	1,236	SY	REPAIR SEEDING AND MULCHING	
		5.11			2.35			5.11		2.35			659	20000	4.88	TON	COMMERCIAL FERTILIZER	
					62			134		62			659	35000	196	MGAL	LIME	
					4,861			4,861		4,861			670	00500	4,861	SY	WATER	
		5,000			10,000			5,000		10,000			832	30000	15,000	EACH	SLOPE EROSION PROTECTION	
					LS			LS		LS			832	15000	LS		EROSION CONTROL	
					LS			LS		LS			832	15002	LS		STORM WATER POLLUTION PREVENTION PLAN	
																	STORM WATER POLLUTION PREVENTION INSPECTIONS	
					LS			LS		LS			832	15010	LS		STORM WATER POLLUTION PREVENTION INSPECTION SOFTWARE	
																	PAVEMENT	
	5,000							5,000					253	01000	5,000	SY	PAVEMENT REPAIR	
2,811								2,811					253	02000	2,811	CY	PAVEMENT REPAIR	
888,996								888,678			4,318		254	01000	888,996	SY	PAVEMENT PLANING, ASPHALT CONCRETE, 3 1/4"	
8,890								8,847			43		254	01600	8,890	SY	PATCHING PLANED SURFACE	
					566			566					255	10160	566	SY	FULL DEPTH PAVEMENT REMOVAL AND RIGID REPLACEMENT, CLASS QC MS	
					852			852					255	20000	852	FT	FULL DEPTH PAVEMENT SAWING	
					2,452			2,452					256	10000	2,452	SF	BONDED PATCHING OF PORTLAND CEMENT CONCRETE PAVEMENT, TYPE A	
					1,270			1,270					258	10000	1,270	EACH	RETROFIT DOWEL BAR	
374								374					301	46000	374	CY	ASPHALT CONCRETE BASE, PG64-22	
354								354					304	20000	354	CY	AGGREGATE BASE	
242								242					407	10000	242	GAL	TACK COAT	
124,460								123,855			605		407	20000	124,460	GAL	NON-TRACKING TACK COAT	
51								51					441	50000	51	CY	ASPHALT CONCRETE SURFACE COURSE, TYPE 1, (448), PG64-22	

GENERAL SUMMARY

PRE-70-0.00

V:\1736\active\173620094\engineering\96654\ProjAdmin\PlanReviews\Tracings\Tracings- Revised Addendum 3_3_6_2020_96654_g0001.dgn 3/7/2020 10:26:45 AM pdurham

SHEET NUM.										PART.				ITEM	ITEM EXT	GRAND TOTAL	UNIT	DESCRIPTION	SEE SHEET NO.
18	35	37	36A	38	49	57	01/IMS/PV	02/IMS/BR	03/IMS/PV	05/STR/PV									
																	PAVEMENT CONTINUED		
							72					441	50300	72	CY	ASPHALT CONCRETE INTERMEDIATE COURSE, TYPE 2, (448)			
							13					441	50400	13	CY	ASPHALT CONCRETE SURFACE COURSE, TYPE 1, (448), (DRIVEWAYS)			
							47,814				233	442	00100	48,047	CY	ANTI-SEGREGATION EQUIPMENT			
							42,809				210	442	10101	43,019	CY	ASPHALT CONCRETE INTERMEDIATE COURSE, 19 MM, TYPE A (446), AS PER PLAN, PG64-28	17		
							36,652				180	442	10300	36,832	CY	ASPHALT CONCRETE SURFACE COURSE, 12.5 MM, TYPE A (447)			
												211	20000	211	CY	ASPHALT CONCRETE SURFACE COURSE, 12.5 MM, TYPE A (448)			
												246	20201	246	CY	ASPHALT CONCRETE INTERMEDIATE COURSE, 19 MM, TYPE A (448), AS PER PLAN, PG64-28	17		
	736											736	24510	736	FT	CURB, TYPE 4-C			
												70	40600	70	MILE	RUMBLE STRIPS, SHOULDER (ASPHALT CONCRETE)			
																	LIGHTING		
						118						625	00450	118	EACH	CONNECTION, FUSED PULL APART			
						20						625	00451	20	EACH	CONNECTION, FUSED PULL APART, AS PER PLAN	50		
						99						625	00480	99	EACH	CONNECTION, UNFUSED PERMANENT			
						42						625	10490	42	EACH	LIGHT POLE, CONVENTIONAL, AT20B40			
						42						625	14100	42	EACH	LIGHT POLE FOUNDATION, 24" X 8' DEEP			
												625	18400	18	EACH	BRACKET ARM, 20'			
						7,053						625	23200	7,053	FT	NO. 4 AWG 2400 VOLT DISTRIBUTION CABLE			
						10,725						625	23302	10,725	FT	NO. 6 AWG 2400 VOLT DISTRIBUTION CABLE			
						9,036						625	23400	9,036	FT	NO. 10 AWG POLE AND BRACKET CABLE			
						19,404						625	24320	19,404	FT	1-1/2" DUCT CABLE WITH THREE NO. 4 AWG 2400 VOLT CABLES			
						708						625	24324	708	FT	1-1/2" DUCT CABLE WITH THREE NO. 6 AWG 2400 VOLT CABLES			
						160						625	25500	160	FT	CONDUIT, 3", 725.04			
						1,926						625	25902	1,926	FT	CONDUIT, JACKED OR DRILLED, 725.04, 3"			
						67						625	26253	67	EACH	LUMINAIRE, CONVENTIONAL, SOLID STATE (LED), AS PER PLAN, DESIGN 1, 25000-11600 LUMENS	49		
												625	26273	2	EACH	LUMINAIRE, LOW MAST, SOLID STATE (LED), AS PER PLAN, DESIGN 2, 38400-42000 LUMENS	49		
						19,552						625	29000	19,552	FT	TRENCH			
						32						625	30700	32	EACH	PULL BOX, 725.08, 18"			
			11			6			11			625	31510	17	EACH	PULL BOX REMOVED			
						59						625	32000	59	EACH	GROUND ROD			
						5						625	34001	5	EACH	POWER SERVICE, AS PER PLAN	49		
						19,552						625	36000	19,552	FT	PLASTIC CAUTION TAPE			
					LS		LS					SPECIAL	62540000	15		MAINTAIN EXISTING LIGHTING	49		
												SPECIAL	62540010	2	EACH	REPLACEMENT OF EXISTING LIGHTING UNIT	49		
					2							625	75350	16	EACH	LIGHT TOWER REMOVED			
						16						625	75351	9	EACH	LIGHT TOWER REMOVED, AS PER PLAN	36A		
						82			9			625	75506	132	EACH	LUMINAIRE REMOVED			
						2			50			625	75510	2	EACH	POWER SERVICE REMOVED			
												625	75511	1	EACH	POWER SERVICE REMOVED, AS PER PLAN	49		
						1						625	75540	25	EACH	LIGHT TOWER FOUNDATION REMOVED			
						3						625	75800	3	EACH	DISCONNECT CIRCUIT			
						3,722						632	29901	3,722	FT	MESSANGER WIRE, 7 STRAND, 1/4" DIAMETER WITH ACCESSORIES, AS PER PLAN	50		
						17						632	64000	17	EACH	STRAIN POLE FOUNDATION			
												632	84501	17	EACH	COMBINATION STRAIN POLE, TYPE TC-81.10, DESIGN 5, AS PER PLAN	50		
																	TRAFFIC CONTROL		
												621	00100	1,996	EACH	RPM			
												621	54000	1,927	EACH	RAISED PAVEMENT MARKER REMOVED			
												626	00102	26	EACH	BARRIER REFLECTOR, TYPE 1, ONE WAY			
												626	00110	338	EACH	BARRIER REFLECTOR, TYPE 2, ONE WAY			
												630	03100	286	FT	GROUND MOUNTED SUPPORT, NO. 3 POST			
												630	08004	4	FT	ONE WAY SUPPORT, NO. 3 POST			
												630	08600	32	EACH	SIGN POST REFLECTOR			
												630	80100	186.5	SF	SIGN, FLAT SHEET			
												630	84900	10	EACH	REMOVAL OF GROUND MOUNTED SIGN AND DISPOSAL			
												630	86002	12	EACH	REMOVAL OF GROUND MOUNTED POST SUPPORT AND DISPOSAL			
10	16																		

CALCULATED
LBA
CHECKED
SNS

GENERAL SUMMARY

PRE-70-0.00

32
147

ITEM 625 - LIGHT TOWER REMOVED, AS PER PLAN

THE CONTRACTOR SHALL REMOVE AND PROPERLY DISPOSE OF ALL LIGHT TOWER COMPONENTS ACCORDING TO C&MS 625 EXCEPT THAT THE LIGHT RINGS SHALL BE SALVAGED AND STORED ON THE PROJECT SITE. THE LIGHT RINGS WILL BE PICKED UP BY ODOT FOR USE ON ANOTHER PROJECT.

V:\1736\active\173620094\engineering\96654\Proj\Admin\PlanReviews\Tracings\Tracings- Revised Addendum 3_3_6_2020\96654_GS001.dgn 3/6/2020 4:39:15 PM pdurham

CALCULATED
LBA
CHECKED
PJD

		SUBSUMMARY																											
REF. NO	SHEET NO	202							203	614		622	625			626	630		659					832					
		PAVEMENT REMOVED	PAVEMENT REMOVED, ASPHALT	CURB REMOVED	PIPE REMOVED, 24" AND UNDER	CATCH BASIN REMOVED	INLET REMOVED	INLET ABANDONED	EXCAVATION	WORK ZONE IMPACT ATTENUATOR (UNIDIRECTIONAL)	OBJECT MARKER, ONE WAY	PORTABLE BARRIER, UNANCHORED	PULL BOX REMOVED	LIGHT TOWER REMOVED, AS PER PLAN	LUMINAIRE REMOVED	LIGHT TOWER FOUNDATION REMOVED	BARRIER REFLECTOR, TYPE 1, ONE WAY	REMOVAL OF GROUND MOUNTED SIGN AND DISPOSAL	REMOVAL OF GROUND MOUNTED POST SUPPORT AND DISPOSAL	TOPSOIL	SEEDING AND MULCHING	COMMERCIAL FERTILIZER	LIME	WATER	EROSION CONTROL	STORM WATER POLLUTION PREVENTION PLAN	STORM WATER POLLUTION PREVENTION INSPECTIONS	STORM WATER POLLUTION PREVENTION SOFTWARE	
		SY	SY	FT	FT	EACH	EACH	EACH	SY	EACH	EACH	FT	EACH	EACH	EACH	EACH	EACH	EACH	CY	SY	TON	ACRE	MGAL	EACH	LUMP	LUMP	LUMP		
RA1	48A,48B																		1261	11355	1.54	2.35	62						
RA2	48A																												
RA3	48A		1927																										
RA4	48A																												
RA5	48A	2575		472					95																				
RA6	NOT USED																												
RA7	48A																												
RA8	48A		514																										
RA9	48A				28		1	1																					
RA10	48A												1																
RA11	48A												1	1	6	1													
RA12	48A												1																
RA13	48A												1																
RA14	48A												1	1	6	1													
RA15	48A												1																
RA16	48A												1																
RA17	48A												1	1	6	1													
RA18	48B												1																
RA19	48B												1	1	6	1													
RA20	48B												1																
RA21	48B												1																
RA22	48B												1																
RA23	48B												1																
RA24	48B												1	1	6	1													
RA25	48B												1																
RA26	48B	1113																											
RA27	48B												1	6	1														
RA28	48B				48	1	1																						
RA29	48B		1441																										
RA30	48B												1	4	1														
RA31	48A																							10000	LUMP	LUMP	LUMP		
MAINTENANCE OF TRAFFIC											60	2950					60												
TOTALS CARRIED TO GENERAL SUMMARY		3688	3882	472	76	1	2	1	95	2	60	2950	11	9	50	9	60	2	4	1261	11355	1.54	2.35	62	10000	LUMP	LUMP	LUMP	

WESTBOUND REST AREA SUBSUMMARY

PRE-70-0.00

36A
147

V:\1736\active\173620094\engineering\96654\Proj\Admin\PlanReviews\Tracings\Tracings- Revised Addendum 3_3_16_2020\96654_GM001.dgn 3/6/2020 4:39:16 PM pdurham

CALCULATED
JTK
CHECKED
PJD

0 50 100
HORIZONTAL
SCALE IN FEET

**PAVEMENT REHABILITATION PLAN
EASTBOUND REST AREA SHEET 1**

PRE-70-0.00

EASTBOUND I.R. 70

NOTES:
- EXISTING PLANS ENTITLED PRE-70-2.41 MAY BE INSPECTED IN THE ODOT DISTRICT 8 OFFICE IN LEBANON, OHIO.

- TYPICAL SLAB DIMENSIONS ARE 21' LONG X 16' WIDE

- CONCRETE PAVEMENT DETERIORATION WAS SURVEYED IN JULY 2018 AND THE PROPOSED REPAIRS SHOWN ON THESE PLANS CORRECT HIGH PRIORITY PROBLEMS AT THAT TIME. NOT ALL PAVEMENT REPAIRS SHOWN ON SHEETS 47 AND 48 WILL BE PERFORMED. THE REPAIR WORK SHALL NOT EXCEED THE QUANTITIES SHOWN ON SHEET 48. FINAL DETERMINATION OF REPAIRS INCLUDING, BUT NOT LIMITED TO, THOSE SHOWN IN THE PLANS SHALL BE AT THE DISCRETION AND APPROVAL OF THE ENGINEER. THE ENGINEER WILL LOCATE AND MARK ALL AREAS TO BE REPAIRED AS INDICATED IN THE C&MS.

- LOAD TRANSFER RETROFIT REPAIRS WILL BE PAID FOR ACCORDING TO ITEM 258 RETROFIT DOWEL BARS. THE TYPICAL SPACING FOR THE DOWEL BARS SHOULD BE MODIFIED FROM SCD BP-2.6 AS SHOWN, OR AS DIRECTED BY THE ENGINEER.

- ALL FULL DEPTH PAVEMENT REPAIRS SHOULD BE MADE ACCORDING TO SCD BP-2.5 AND ITEM 255 FULL DEPTH PAVEMENT REMOVAL AND RIGID REPLACEMENT. FULL DEPTH REPAIRS CONSIST OF FULL SLAB REPLACEMENTS AND PARTIAL SLAB REPLACEMENTS. CLASS QC MS SHALL BE USED FOR PAVEMENT REPAIRS. WHERE FULL DEPTH REPAIRS OCCUR AT EXISTING EXPANSION JOINTS, THE EXPANSION JOINT SHALL BE REPLACED ACCORDING TO SCD BP-2.2. WHERE FULL DEPTH REPAIRS REPLACE EXISTING REINFORCED SLABS, AS SHOWN ON THE PLANS, THE REPLACEMENT PAVEMENT SHALL ALSO INCLUDE STEEL REINFORCING ACCORDING TO SCD BP-1.1. THE FOLLOWING ASSUMPTION HAS BEEN MADE TO CALCULATE A BIDDABLE ESTIMATE OF QUANTITIES:

- PARTIAL SLAB REPLACEMENTS ARE ON AVERAGE 4' x 4' AND REQUIRE 16' OF PAVEMENT SAWING.

- JOINTS ARE TO BE REPAIRED ACCORDING TO ITEM 256, BONDED PATCHING OF PORTLAND CEMENT CONCRETE PAVEMENT. IT HAS BEEN ASSUMED THAT EACH JOINT, AS INDICATED, WILL REQUIRE 12 SQUARE FEET OF BONDED PATCHING. AN ADDITIONAL 160 SF OF ITEM 256 HAS BEEN INCLUDED IN THE PLANS TO BE USED AS NEEDED, AND DIRECTED, BY THE ENGINEER.

- A SUMMARY TABLE OF THE QUANTITIES REQUIRED TO REPAIR THE REST AREA PAVEMENT HAS BEEN INCLUDED ON THE FOLLOWING SHEET AND CARRIED TO THE GENERAL SUMMARY.

EXISTING PAVEMENT MAKEUP

11" UNREINFORCED CONCRETE PAVEMENT
(EX. PAVEMENT REINFORCED AS INDICATED IN THE LEGEND)
6" AGGREGATE BASE


EX EXPANSION JOINT

EX EXPANSION JOINT

EX ITEM 451 REINFORCED CONCRETE PAVEMENT AS PER PLAN

EX ITEM 452 PLAIN CONCRETE PAVEMENT AS PER PLAN

ASPHALT PARKING LOT (DO NOT DISTURB)

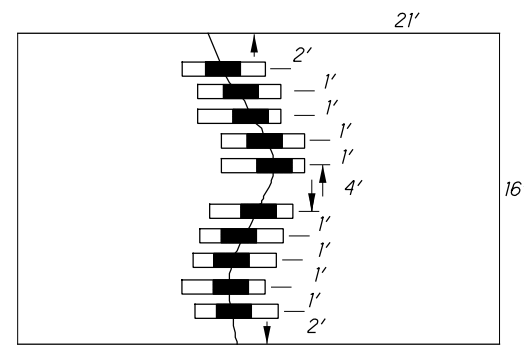

TYPICAL RETROFIT DOWEL BAR SPACING

LEGEND

ITEM 255 FULL SLAB REPLACEMENT	
ITEM 255 FULL SLAB REPLACEMENT WITH REINFORCEMENT	
ITEM 255 PARTIAL SLAB REPLACEMENT	
ITEM 258 LOAD TRANSFER RETROFIT USING DOWEL BARS	
ITEM 256 JOINT REPAIRS	

OR


EX EXPANSION JOINT

EX EXPANSION JOINT

MATCHLINE A-SEE SHEET 48

FOR QUANTITIES SEE SHEET NO. 48

V:\1736\active\173620094\engineering\96654\Proj\Admin\PlanReviews\Tracings\Tracings- Revised Addendum 3_3_6_2020\96654_GM002.dgn 3/6/2020 4:39:17 PM pdurham

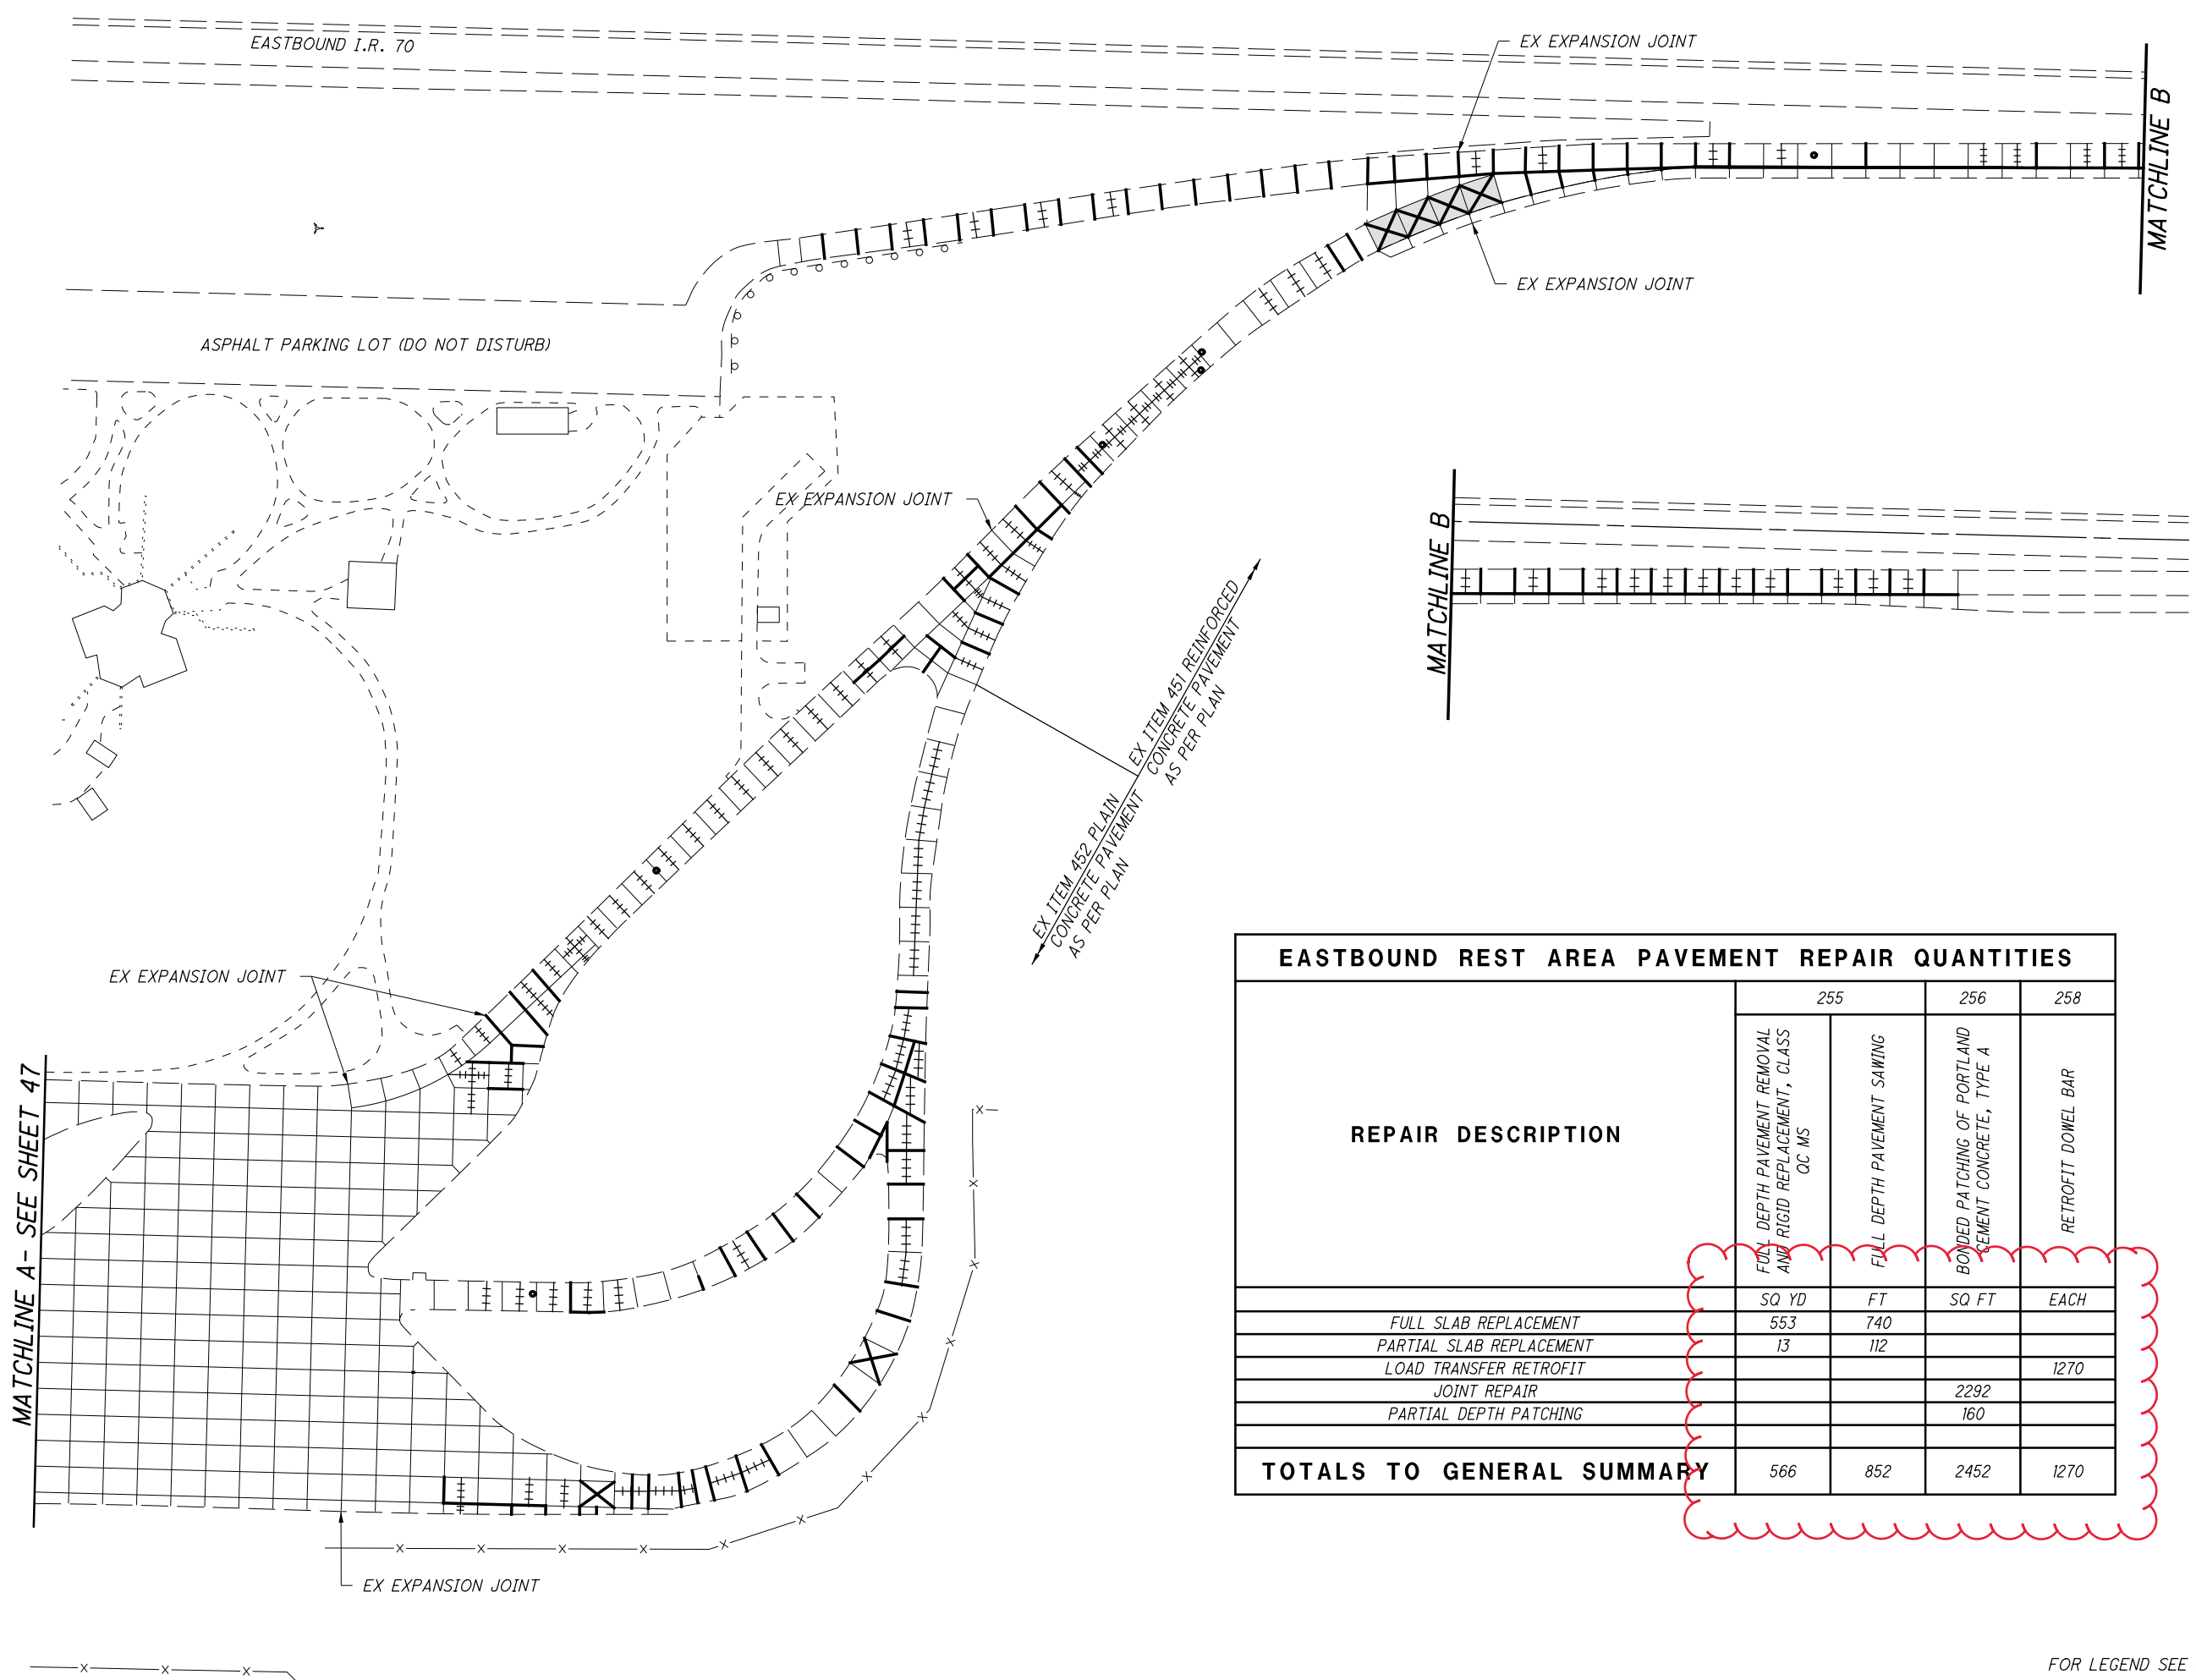

EASTBOUND REST AREA PAVEMENT REPAIR QUANTITIES				
REPAIR DESCRIPTION	255		256	258
	FULL DEPTH PAVEMENT REMOVAL AND RIGID REPLACEMENT, CLASS CC MS SQ YD	FULL DEPTH PAVEMENT SAWING FT	BONDED PATCHING OF PORTLAND CEMENT CONCRETE, TYPE A SQ FT	RETROFIT DOWEL BAR EACH
FULL SLAB REPLACEMENT	553	740		
PARTIAL SLAB REPLACEMENT	13	112		
LOAD TRANSFER RETROFIT				1270
JOINT REPAIR			2292	
PARTIAL DEPTH PATCHING			160	
TOTALS TO GENERAL SUMMARY	566	852	2452	1270

CALCULATED
JTK
CHECKED
PJD


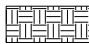

HORIZONTAL SCALE IN FEET

**PAVEMENT REHABILITATION PLAN
EASTBOUND REST AREA SHEET 2**



PRE-70-0.00

FOR LEGEND SEE SHEET NO. 47

LEGEND

-  ASPHALT PAVEMENT REMOVED
-  CONCRETE PAVEMENT REMOVED
(11" REINFORCED CONCRETE PAVEMENT)
-  FILL REMOVED

NOTE:
ALL BACKFILL MATERIAL REQUIRED BY C&MS 202.02
AND 202.05 THAT IS LOCATED WITHIN 15' OF THE EDGE
OF TRAVELED WAY OF I.R. 70, SHALL HAVE A SLOPE
OF NO MORE THAN 12:1.

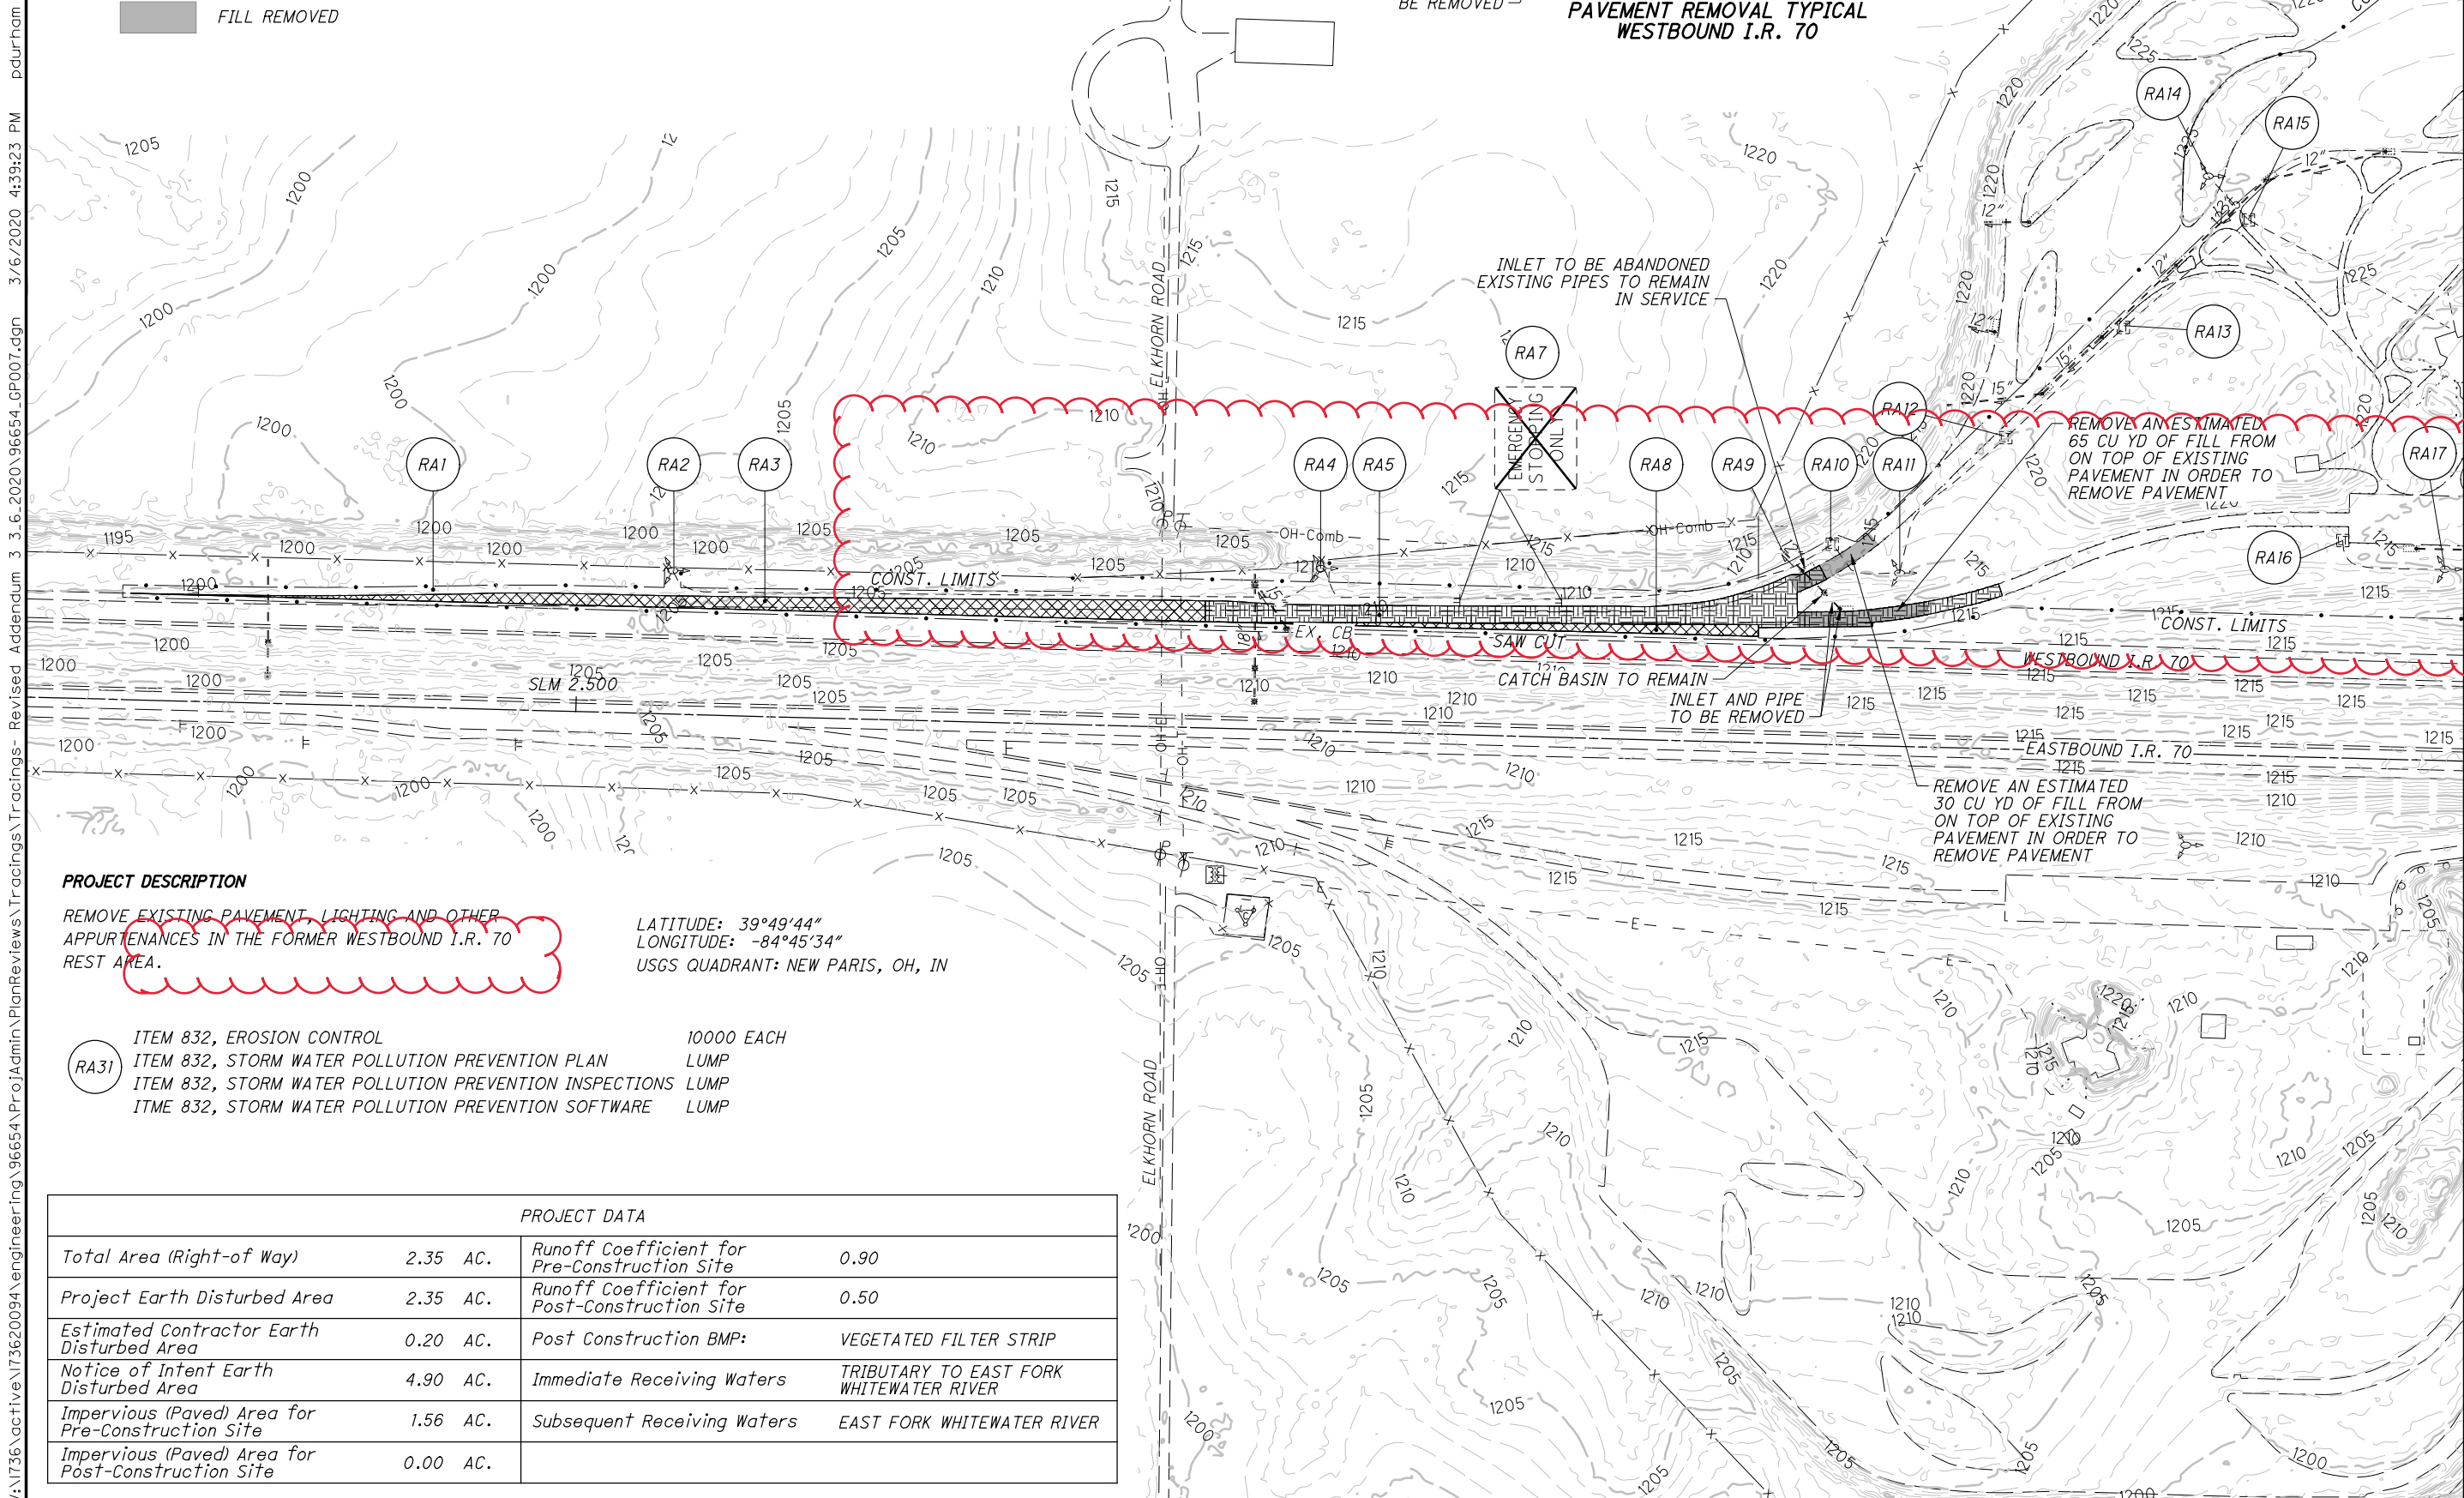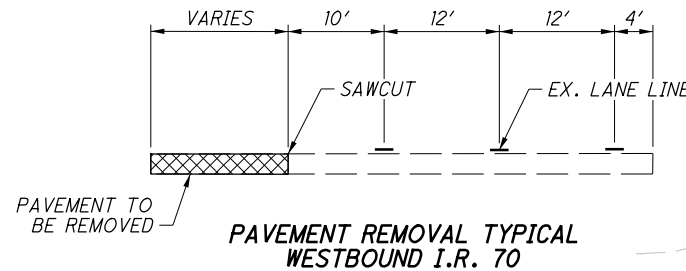

PROJECT DESCRIPTION

REMOVE EXISTING PAVEMENT, LIGHTING AND OTHER APPURTENANCES IN THE FORMER WESTBOUND I.R. 70 REST AREA.

LATITUDE: 39°49'44"
LONGITUDE: -84°45'34"
USGS QUADRANT: NEW PARIS, OH, IN



- ITEM 832, EROSION CONTROL 10000 EACH
- ITEM 832, STORM WATER POLLUTION PREVENTION PLAN LUMP
- ITEM 832, STORM WATER POLLUTION PREVENTION INSPECTIONS LUMP
- ITEM 832, STORM WATER POLLUTION PREVENTION SOFTWARE LUMP

PROJECT DATA			
Total Area (Right-of Way)	2.35 AC.	Runoff Coefficient for Pre-Construction Site	0.90
Project Earth Disturbed Area	2.35 AC.	Runoff Coefficient for Post-Construction Site	0.50
Estimated Contractor Earth Disturbed Area	0.20 AC.	Post Construction BMP:	VEGETATED FILTER STRIP
Notice of Intent Earth Disturbed Area	4.90 AC.	Immediate Receiving Waters	TRIBUTARY TO EAST FORK WHITEWATER RIVER
Impervious (Paved) Area for Pre-Construction Site	1.56 AC.	Subsequent Receiving Waters	EAST FORK WHITEWATER RIVER
Impervious (Paved) Area for Post-Construction Site	0.00 AC.		

V:\1736\active\173620094\engineering\96654\ProjAdmin\PlanReviews\Tracings\Tracings- Revised Addendum 3 3.6.2020\96654_GPO07.dgn 3/6/2020 4:39:23 PM pdurham

V:\1736\active\173620094\engineering\96654\ProjAdmin\PlanReviews\Tracings\Tracings- Revised Addendum 3_3_6_2020\96654_GP008.dgn 3/6/2020 4:39:27 PM pdurham

LEGEND

-  ASPHALT PAVEMENT REMOVED
-  CONCRETE PAVEMENT REMOVED


0 100 200
50
HORIZONTAL
SCALE IN FEET

CALCULATED
LBA
CHECKED
PJD

**WEST BOUND REST AREA PLAN
EXIT RAMP REMOVAL**

PRE-70-0.00

48B
147

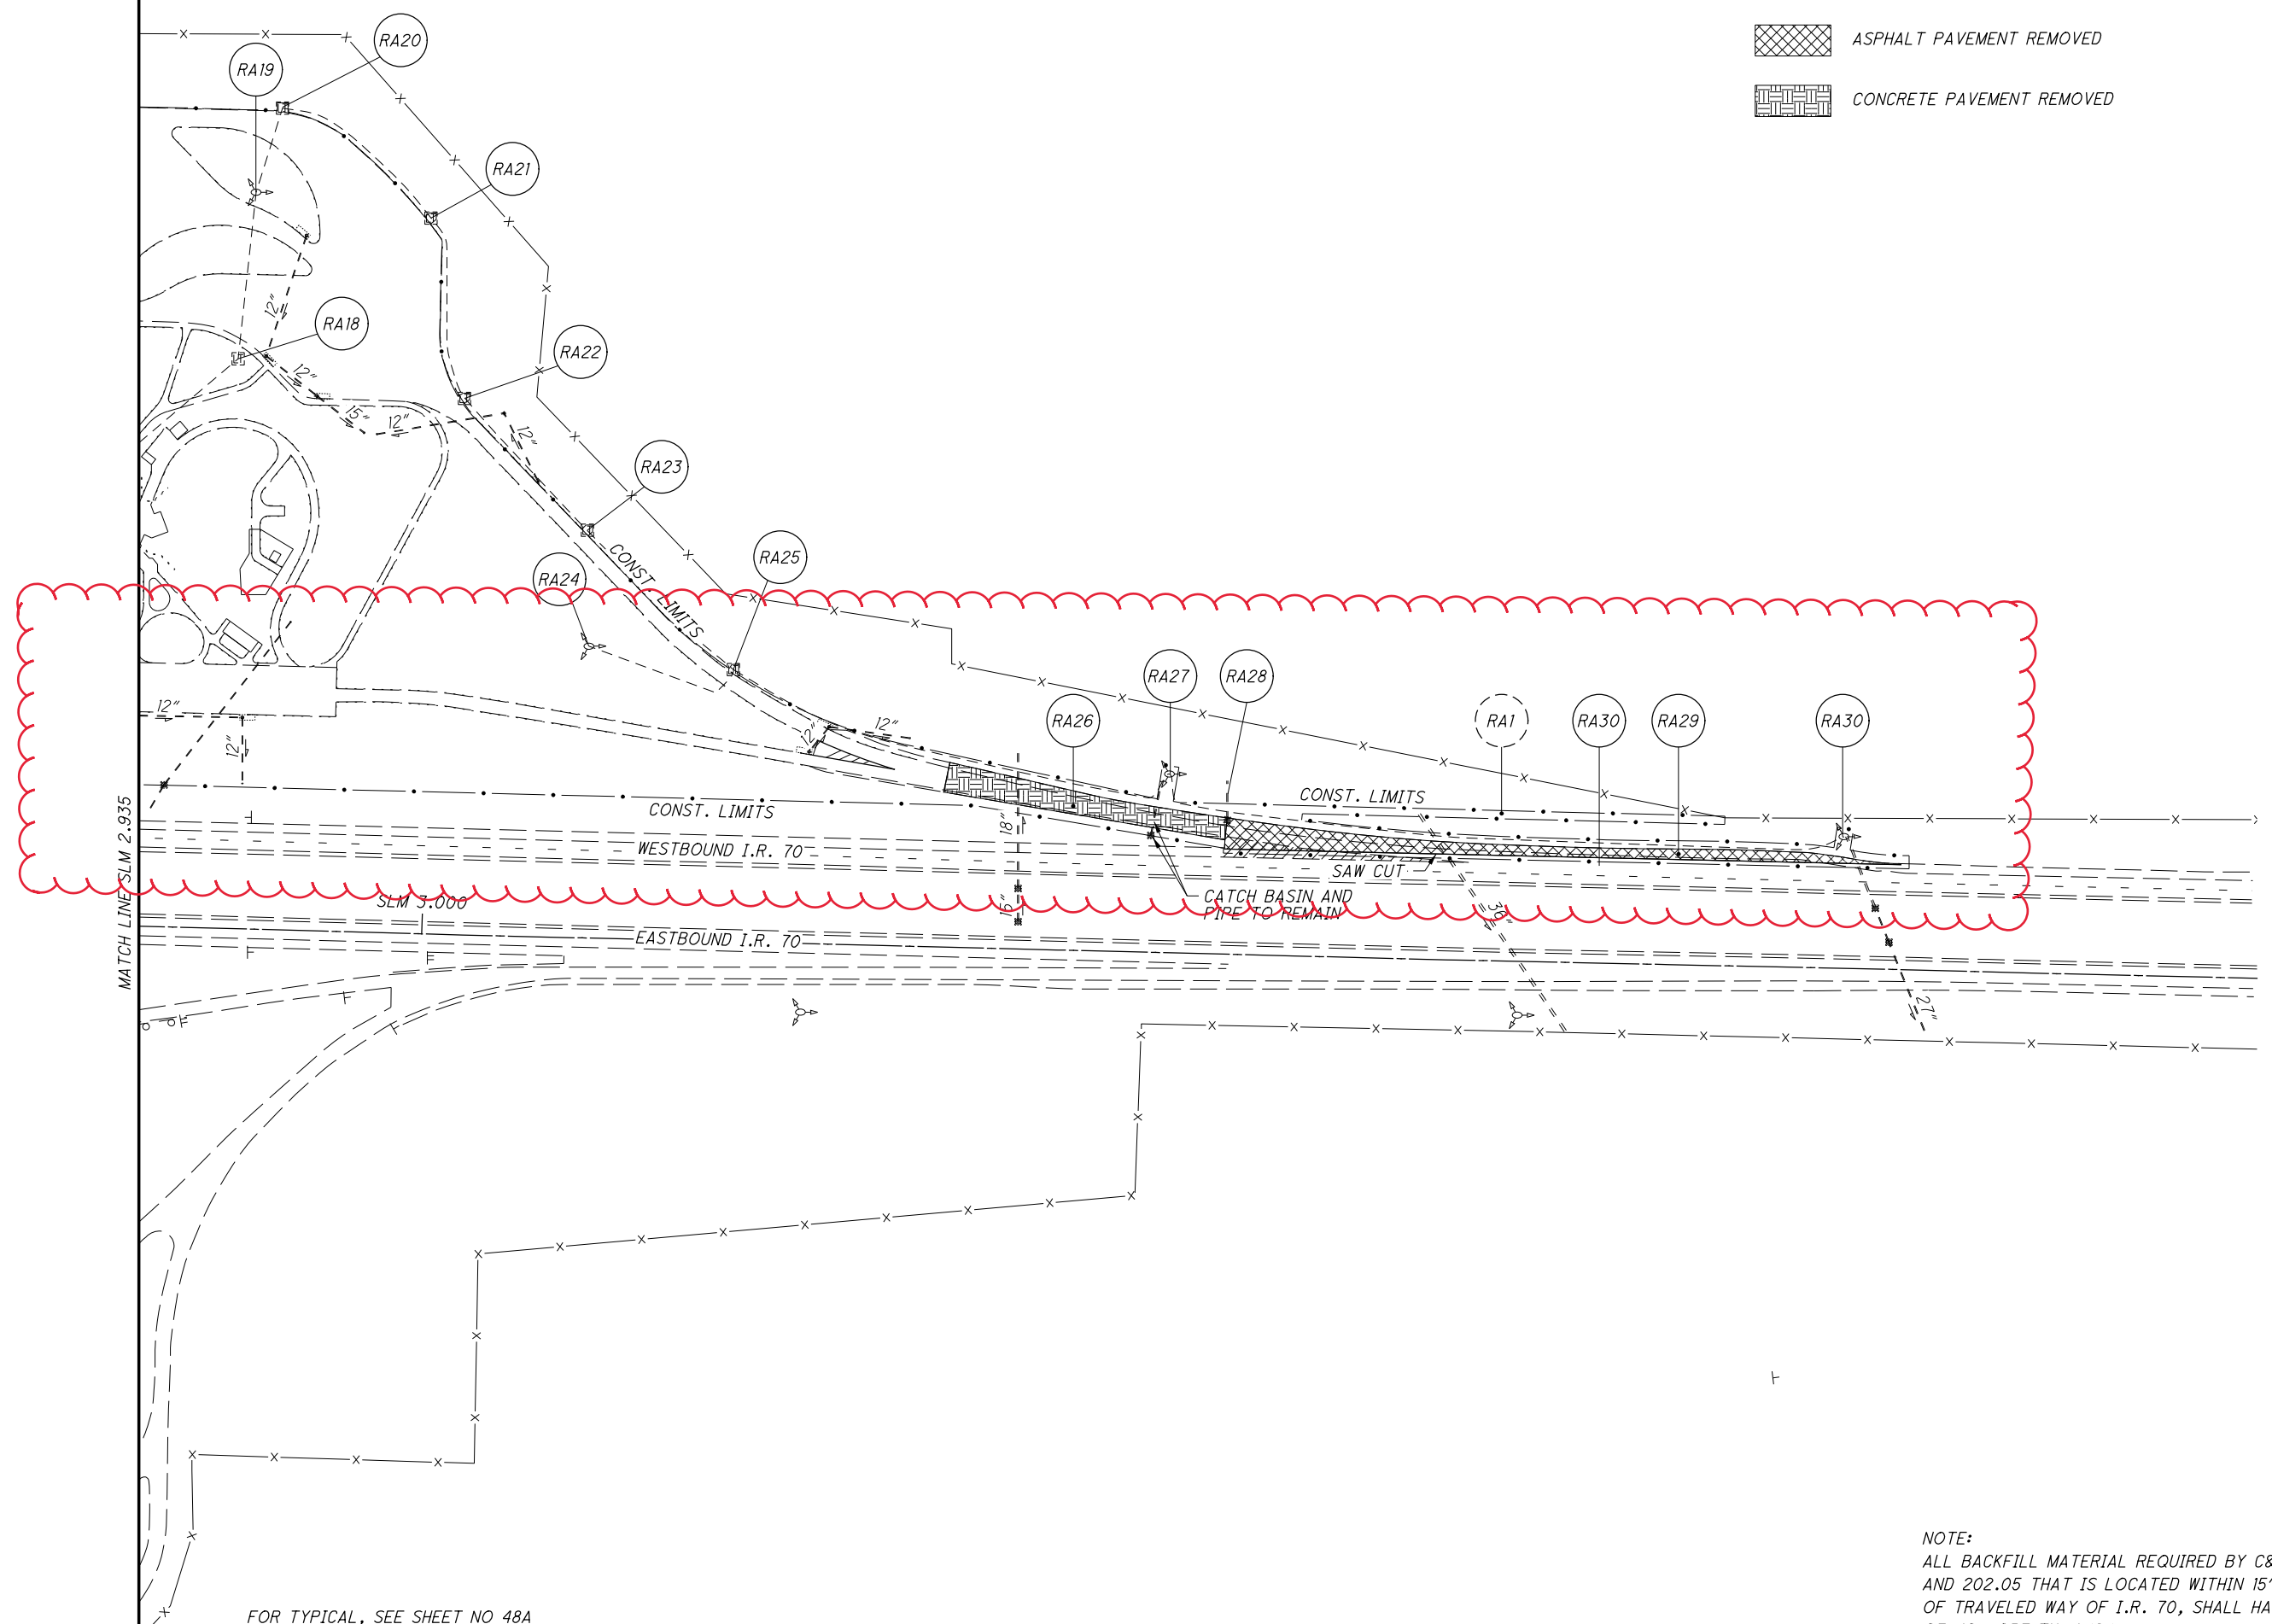

FOR TYPICAL, SEE SHEET NO 48A

NOTE:
ALL BACKFILL MATERIAL REQUIRED BY C&MS 202.02
AND 202.05 THAT IS LOCATED WITHIN 15' OF THE EDGE
OF TRAVELED WAY OF I.R. 70, SHALL HAVE A SLOPE
OF NO MORE THAN 12:1.

ITEM 625, POWER SERVICE, AS PER PLAN

IN ADDITION TO THE REQUIREMENTS OF THE SPECIFICATIONS, THE FOLLOWING IS ADDED.

THE POWER SUPPLYING AGENCY FOR THIS PROJECT IS:

DAYTON POWER & LIGHT
1900 DRYDEN ROAD
DAYTON, OHIO 45439
(937) 331-4521 (BILL GOURLEY)
WILLIAM.GOURLEY@AES.COM

THE ENGINEER SHALL ENSURE THAT EACH POWER SERVICE ELECTRICAL ENERGY ACCOUNT IS IN THE NAME OF AND THAT THE BILLING ADDRESS IS TO THE MAINTAINING AGENCY NOTED IN THE PLANS. THIS SHALL BE DONE NOT ONLY FOR EACH NEW POWER SERVICE ESTABLISHED BY THIS PROJECT BUT ALSO FOR EACH EXISTING POWER SERVICE, SINCE THERE MAY BE A REASSIGNMENT OF THE RESPONSIBILITY FOR AN EXISTING SERVICE AS A RESULT OF THE WORK PERFORMED BY THIS PROJECT.

PAYMENT WILL BE MADE AT THE UNIT BID PRICE FOR EACH C&S ITEM 625, "POWER SERVICE, AS PER PLAN" WHICH SHALL BE FULL COMPENSATION FOR ALL LABOR, MATERIALS AND INCIDENTALS REQUIRED TO COMPLETE THIS ITEM IN A SATISFACTORY AND WORKMANLIKE MANNER.

PADLOCKS AND KEYS

PADLOCKS FURNISHED SHALL BE EITHER BRASS OR BRONZE, EQUAL TO MASTER NO. 4BKA OR WILSON BOHANNAN 660A, AND SHALL BE KEYED IN ACCORDANCE WITH C&S 631.06. PAYMENT SHALL BE INCLUDED IN THE BID FOR THE ITEMS BEING LOCKED.

ITEM SPECIAL, MAINTAIN EXISTING LIGHTING

DURING CONSTRUCTION OF THIS PROJECT, THE CONTRACTOR SHALL BE RESPONSIBLE FOR MAINTAINING THE ENTIRETY OF ANY CIRCUIT, INCLUDING BUT NOT LIMITED TO POLES, FIXTURES, CABLE, FUSES, ETC., THAT PASSES THROUGH THE PROJECT LIMITS.

BEFORE ANY WORK IS STARTED IN THE IMMEDIATE VICINITY OF THE EXISTING LIGHTING CIRCUITS, REPRESENTATIVES OF ODOT, THE MAINTAINING AGENCY AND THE CONTRACTOR SHALL MAKE A VISUAL INSPECTION OF THE EXISTING ROADWAY LIGHTING CIRCUITS TO BE MAINTAINED. DURING THIS INSPECTION, A WRITTEN RECORD OF THE CONDITION OF EXISTING LIGHTING SHALL BE MADE BY ODOT'S REPRESENTATIVE. THIS WRITTEN REPORT SHALL NOTE INDIVIDUAL LUMINAIRES WHICH ARE NOT IN WORKING ORDER, INDIVIDUAL POLES WHICH ARE NOT STANDING, AND INDIVIDUAL CIRCUITS WHICH ARE NOT IN WORKING ORDER. THE COMPLETED REPORT SHALL BE SIGNED BY THE REPRESENTATIVES OF ODOT, THE MAINTAINING AGENCY AND THE CONTRACTOR.

IF, AS A RESULT OF THIS INSPECTION, IT IS DETERMINED THAT THE CONDITION OF THE EXISTING SYSTEM IS BELOW THAT REQUIRED FOR THE SAFETY OF THE TRAVELING PUBLIC, THEN THE MAINTAINING AGENCY SHALL MAKE THE REPAIRS NECESSARY TO RETURN THE SYSTEM TO AN ACCEPTABLE CONDITION. FOLLOWING THESE REPAIRS, THE SYSTEM SHALL AGAIN BE INSPECTED AND A REPORT SHALL BE MADE AND SIGNED AS OUTLINED HEREIN.

WHEN THE EXISTING SYSTEM IS IN AN ACCEPTABLE CONDITION, IT SHALL BE TURNED OVER TO THE CONTRACTOR WHO SHALL THEN BE REQUIRED TO MAINTAIN THE EXISTING LIGHTING TO THE CONDITION OUTLINED IN THIS REPORT WITH THE EXCEPTION OF KNOCKDOWNS DUE TO TRAFFIC ACCIDENTS.

ITEM SPECIAL, MAINTAIN EXISTING LIGHTING (CONTINUED)

REPLACEMENT OF KNOCKED DOWN UNITS SHALL BE DONE ONLY WHEN THE ENGINEER HAS DETERMINED THAT THE REPLACEMENT OF THE KNOCKED DOWN UNIT IS NECESSARY AND SHALL BE PAID SEPARATELY ON A UNIT BASIS.

BETTERMENTS SHALL BE COVERED IN ITEMS OF WORK PERTAINING TO THE CONSTRUCTION OF PERMANENT IMPROVEMENT.

WHEN THE SEQUENCE OF CONSTRUCTION ACTIVITIES REQUIRES, OR SHOULD THE CONTRACTOR DESIRE, THE REMOVAL OF THE EXISTING LIGHTING BEFORE THE NEW LIGHTING IS OPERATIONAL, THE CONTRACTOR SHALL BE RESPONSIBLE FOR PROVIDING TEMPORARY LIGHTING OF THIS PORTION OF THE ROADWAY.

PRIOR TO INSTALLING SUCH LIGHTING, THE CONTRACTOR SHALL PREPARE AND SUBMIT FOUR SETS OF THE TEMPORARY LIGHTING PLAN TO THE ENGINEER FOR REVIEW AND APPROVAL.

THIS PLAN SHALL SHOW LOCATIONS OF POLES, LENGTHS OF BRACKET ARMS, STYLES OF LUMINAIRES, MOUNTING HEIGHTS, WIRING METHODS AND OTHER PERTINENT INFORMATION. THE TEMPORARY LIGHTING SHALL PROVIDE AN AVERAGE INITIAL INTENSITY OF 1.2 FOOTCANDLES WITH AN AVERAGE TO MINIMUM UNIFORMITY NOT TO EXCEED 3:1. MOUNTING HEIGHT OF TEMPORARY LUMINAIRES SHALL NOT BE LESS THAN 30 FEET, AND THE MINIMUM OVERHEAD CONDUCTOR CLEARANCE SHALL BE 20 FEET. TEMPORARY OVERHEAD CONSTRUCTION SHALL NOT BE LESS THAN GRADE "B" FOR STRENGTH REQUIREMENTS AS DEFINED BY THE NATIONAL ELECTRIC SAFETY CODE. WOOD POLES WITH OVERHEAD WIRING MAY BE USED. HOWEVER, TEMPORARY LIGHTING SHALL MEET FEDERAL AND STATE SAFETY CRITERIA. IF BREAKAWAY POLES ARE USED TO MEET THESE CRITERIA, THEN UNDERGROUND WIRING SHALL BE USED. RECONDITIONED OR USED MATERIALS MAY BE FURNISHED FOR TEMPORARY LIGHTING.

ALL MATERIALS NECESSARY TO COMPLETE THE TEMPORARY LIGHTING SHALL BE FURNISHED AND INSTALLED BY THE CONTRACTOR. WHEN NO LONGER NEEDED, THE TEMPORARY LIGHTING INSTALLATION SHALL BE REMOVED AND PROPERLY DISPOSED OF BY THE CONTRACTOR.

THE MAINTAINING AGENCY WILL PAY FOR ELECTRICAL ENERGY CONSUMED BY EXISTING POWER SERVICES. THE CONTRACTOR WILL PAY FOR ELECTRICAL ENERGY, INSTALLATION, REMOVAL AND MAINTENANCE OF ANY TEMPORARY POWER SERVICES.

THE LUMP SUM PRICE BID FOR ITEM SPECIAL "MAINTAIN EXISTING LIGHTING" SHALL INCLUDE PAYMENT FOR ALL LABOR, EQUIPMENT, MATERIALS AND INCIDENTALS NECESSARY TO MAINTAIN THE EXISTING LIGHTING AS SPECIFIED HEREIN.

THE UNIT PRICE BID FOR ITEM SPECIAL "REPLACEMENT OF EXISTING LIGHTING UNIT" SHALL BE FULL PAYMENT FOR THE REPLACEMENT OF AN EXISTING LIGHTING UNIT WHICH HAS BEEN KNOCKED DOWN AFTER THE AFOREMENTIONED INSPECTION AND SHALL INCLUDE ALL LABOR, EQUIPMENT, MATERIALS AND INCIDENTALS NECESSARY TO PROVIDE A REPLACEMENT FOR SUCH UNIT.

THE FOLLOWING ESTIMATED QUANTITIES ARE INCLUDED IN THE GENERAL SUMMARY FOR THE WORK NOTED ABOVE:

ITEM SPECIAL, MAINTAIN EXISTING LIGHTING LUMP
ITEM SPECIAL, REPLACEMENT OF EXISTING LIGHTING UNIT 2 EACH

ITEM 625, LUMINAIRE, CONVENTIONAL, SOLID STATE (LED), AS PER PLAN, IES-III-M, LED, 9200-11600 LUMENS

LUMINAIRES FOR CONVENTIONAL LIGHTING UNITS SHALL BE AMERICAN ELECTRIC LIGHTING "AUTOBAHN ATBM D 480 R2 4B", COOPER INDUSTRIES "VERDEON VERD-A02-E-U-T2-7030-10K-IP66-4B-AP", GENERAL ELECTRIC "EVOLVE ERLH-5-10-B3-30-E-GRAY", OR EQUAL AS APPROVED BY THE ENGINEER. PAYMENT WILL BE MADE AT THE UNIT BID PRICE FOR EACH C&S ITEM 625 LUMINAIRE, CONVENTIONAL, SOLID STATE (LED), IES-III-M, LED, 9200-11600 LUMENS, AS PER PLAN FOR EACH LUMINAIRE WHICH SHALL BE FULL COMPENSATION FOR ALL LABOR, MATERIALS, AND INCIDENTALS REQUIRED TO COMPLETE THIS ITEM IN A SATISFACTORY AND WORKMANLIKE MANNER.

ITEM 625, LUMINAIRE, LOW MAST, SOLID STATE (LED), AS PER PLAN, IES-V-M, LED, 38400-42000 LUMENS

THE LUMINAIRE ARRAYS AND ASSOCIATED ILLUMINATION TEST AREAS SPECIFIED IN C&S 725.11 ARE HEREBY WAIVED. INSTEAD, THE LUMINAIRES FOR LOW-MAST AND HIGH-MAST LIGHTING SHALL MEET THE FOLLOWING REQUIREMENTS:


LUMINAIRES FOR LOW-MAST UNITS SHALL BE HOLOPHANE "HMLD3-PK2-30K-HVOLT- G-AW", CAROLINA HIGH MAST "CLED-4M-G-30-SO-B-05", GENERAL ELECTRIC "ERHM-01-5-40-VM-7-30-N-1-4B-GRAY-R", OR EQUAL AS APPROVED BY THE ENGINEER.

IN ADDITION, OTHER LUMINAIRES WILL BE CONSIDERED IF THE DESIGNED INTENSITY AND UNIFORMITY ARE PROVIDED USING THE DESIGNED POLE LOCATIONS AND THE DESIGNED NUMBER AND TYPE OF FIXTURES PER POLE.


PAYMENT WILL BE MADE AT THE UNIT BID PRICE FOR EACH C&S ITEM 625, LUMINAIRE, LOW MAST, SOLID STATE (LED), AS PER PLAN, IES-V-M, LED, 38400-42000 LUMENS FOR EACH LUMINAIRE WHICH SHALL BE FULL COMPENSATION FOR ALL LABOR, MATERIALS, AND INCIDENTALS REQUIRED TO COMPLETE THIS ITEM IN A SATISFACTORY AND WORKMANLIKE MANNER.

ITEM 625, POWER SERVICE REMOVED, AS PER PLAN

REMOVE THE EXISTING POWER SERVICE FOR CIRCUITS A AND B FROM THE BASEMENT OF THE WEIGH STATION BUILDING AS SHOWN IN THE DETAILS BELOW. ALL ASPECTS OF ITEM 625.21 F SHALL APPLY WITH THE ADDITION THAT ANY HOLES IN THE WEIGH STATION BUILDING SHALL BE FILLED AND REPAIRED WITH MORTAR OR OTHER APPROPRIATE MATERIAL TO THE SATISFACTION OF THE ENGINEER.

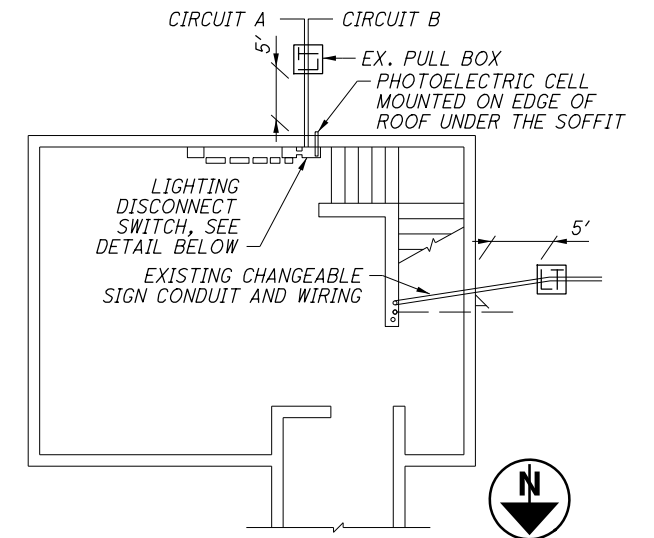

WEIGH STATION BASEMENT PLAN

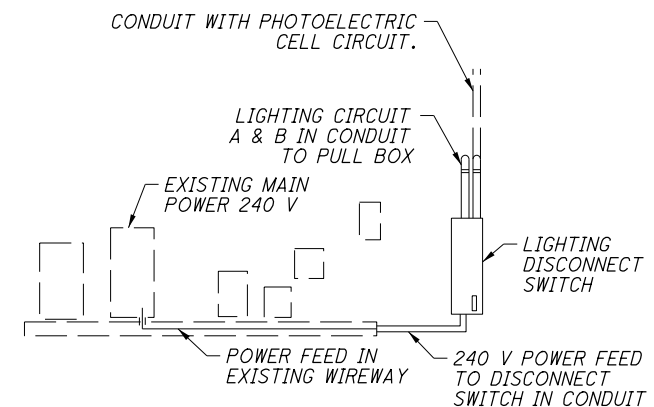

CONTROL CENTER ELEVATION

CONTROL CENTER DATA TABLE									
CONTROL CENTER DESIGNATION	LINE VOLTS	CONNECTED LOAD (KW)	SERVICE ENTRANCES CONDUCTOR SIZE - AWG	ENCLOSURE RATING (AMPS)	CIRCUIT	CIRCUIT LOAD (AMPS)	CIRCUIT FUSE SIZE	CIRCUIT CABLE SIZE AWG	MAINTAINING AGENCY
B	480	2.09	4	60	B	4.36	15	4	ODOT
C	480	1.3	4	60	C	2.7	15	4	ODOT
D	480	1.56	4	60	D	3.24	15	4	ODOT
E	480	1.56	4	60	E	3.24	15	4	ODOT
F	480	3.11	4	60	F	3.51	15	4	ODOT
					G	2.97	15	4	ODOT

NOTE: FOR ADDITIONAL CONTROL CENTER DETAILS, SEE STANDARD DRAWINGS.

V:\1736\active\173620094\engineer\ing\96654\ProjAdmin\PlanReviews\Tracings\Tracings- Revised Addendum 3 3.6.2020\96654_LN001.dgn 3/6/2020 4:39:27 PM pdurham

CALCULATED P.J.D. CHECKED SNS LIGHTING NOTES PRE-70-0:00 49 147

GROUNDING AND BONDING

THE REQUIREMENTS OF THE CONSTRUCTION AND MATERIAL SPECIFICATIONS (CMS) AND THE TC SERIES OF STANDARD CONSTRUCTION DRAWINGS ARE MODIFIED AS FOLLOWS:

1. ALL METALLIC PARTS CONTAINING ELECTRICAL CONDUCTORS SHALL BE PERMANENTLY JOINED TO FORM AN EFFECTIVE GROUND FAULT CURRENT PATH BACK TO THE GROUNDING CONDUCTOR IN THE POWER SERVICE DISCONNECT SWITCH.
 - A. PROVIDE AN EQUIPMENT GROUNDING CONDUCTOR IN METALLIC CONDUITS (725.04) IN ADDITION TO THE CONDUCTORS SPECIFIED AND BOND THE CONDUIT TO THIS GROUNDING CONDUCTOR.
 - B. WHEN AN EQUIPMENT GROUNDING CONDUCTOR IS REQUIRED IN PLASTIC CONDUIT (725.05), THE INSTALLATION SHALL INCLUDE A SEPARATE EQUIPMENT GROUNDING CONDUCTOR IN ADDITION TO THE CONDUCTORS SPECIFIED.
 - C. METALLIC CONDUIT CARRYING THE LOOP WIRES FROM IN THE PAVEMENT TO THE PULL BOX SPLICE LOCATION WILL ONLY BE BONDED AT THE PULL BOX END, AND WILL NOT CONTAIN AN EQUIPMENT GROUNDING CONDUCTOR.
 - D. IF MULTIPLE CONDUIT RUNS BEGIN AND END AT THE SAME POINTS, ONLY ONE EQUIPMENT GROUNDING CONDUCTOR IS REQUIRED.
 - E. THE MESSENGER WIRE AT SIGNALIZED INTERSECTIONS WILL BE USED AS THE CONDUCTIVE PATH FROM CORNER TO CORNER IF CONDUIT IS NOT PROVIDED UNDER THE ROADWAY. WHEN CONDUIT CONNECTS THE CORNERS OF AN INTERSECTION, AN EQUIPMENT GROUNDING CONDUCTOR SHALL BE USED IN THE CONDUIT.
2. CONDUITS.
 - A. THE 725.04 CONDUIT SHALL HAVE GROUNDING BUSHINGS INSTALLED AT ALL TERMINATION POINTS. THE BUSHING MATERIAL SHALL BE COMPATIBLE WITH GALVANIZED STEEL CONDUIT AND THE GROUNDING LUG MATERIAL SHALL BE COMPATIBLE FOR USE WITH COPPER WIRE. THREADED OR COMPRESSION TYPE BUSHINGS MAY BE USED.
 - B. THE 725.05 CONDUIT SHALL HAVE THE INSIDE AND OUTSIDE DIAMETERS OF THE CONDUIT DEBURRED AT ALL TERMINATION POINTS.
 - C. BOTH ENDS OF METALLIC CONDUIT SHALL BE BONDED TO THE EQUIPMENT GROUNDING CONDUCTOR.
 - D. METALLIC CONDUIT MAY BE BONDED TO METALLIC BOXES THROUGH THE USE OF CONDUIT FITTINGS UL APPROVED FOR THIS TYPE OF CONNECTION, WITH THE BOX BONDED TO THE EQUIPMENT GROUNDING CONDUCTOR.
3. WIRE FOR GROUNDING AND BONDING.
 - A. USE INSULATED, COPPER WIRE FOR THE EQUIPMENT GROUNDING CONDUCTOR. BONDING JUMPERS IN BOXES AND ENCLOSURES MAY BE BARE OR INSULATED COPPER WIRE. WIRE SIZE SHALL BE AS FOLLOWS:
 - I. USE 4 AWG BETWEEN THE POWER SERVICE AND SUPPORTS, POLES, PEDESTALS, CONTROLLER OR FLASHER CABINETS.
 - II. THE INSULATION SHALL BE GREEN OR GREEN WITH YELLOW STRIPE(S). FOR 4 AWG OR LARGER, INSULATION MAY ALSO BE BLACK WITH GREEN TAPE/LABELS INSTALLED AT ALL ACCESS POINTS.

GROUNDING AND BONDING (CONTINUED)

- B. IN A HIGHWAY LIGHTING SYSTEM, THE EQUIPMENT GROUNDING CONDUCTOR SHALL BE THE SAME WIRE SIZE AS THE DUCT CABLE OR DISTRIBUTION CABLE CIRCUIT CONDUCTORS, WITH THE MINIMUM CONDUCTOR SIZE OF 4 AWG. BONDING JUMPERS WILL BE MINIMUM SIZE 4 AWG.
4. GROUND ROD.
 - A. A 3/4 INCH SCHEDULE 40 PVC CONDUIT WILL BE USED IN FOUNDATIONS AND CONCRETE WALLS FOR THE GROUNDING CONDUCTOR (GROUND WIRE) RACEWAY TO THE GROUND ROD. SHOULD METALLIC CONDUIT BE USED, BOTH ENDS OF THE CONDUIT SHALL BE BONDED TO THE GROUNDING CONDUCTOR.
 - B. THE TYPICAL GROUNDING CONDUCTOR (GROUND WIRE) SHALL BE 4 AWG INSULATED, COPPER.
5. POWER SERVICE AND DISCONNECT SWITCH.
 - A. AT THE POWER SERVICE LOCATION, THE GROUNDING CONDUCTOR (GROUND WIRE) FROM THE DISCONNECT SWITCH NEUTRAL (AC-) BAR TO THE GROUND ROD SHALL BE A CONTINUOUS, UN-SPLICED CONDUCTOR. IF SPLICED, IT SHALL BE AN EXOTHERMIC WELD BUTT SPLICE.
 - B. THE SERVICE NEUTRAL (AC-) SHALL ONLY BE CONNECTED TO GROUND AT THE PRIMARY POWER SERVICE DISCONNECT SWITCH.
 - I. NEMA CONTROLLER CABINETS: IF A POWER SERVICE DISCONNECT SWITCH IS LOCATED BEFORE THE CONTROLLER CABINET, THE NEUTRAL (AC-) AND THE GROUNDING BARS IN THE CONTROLLER CABINET SHALL NOT BE CONNECTED TOGETHER AS SHOWN IN NEMA TS-2, FIGURE 5-4.
 - II. IF SECONDARY DISCONNECT SWITCHES ARE CONNECTED AFTER THE PRIMARY DISCONNECT SWITCH, THE NEUTRAL (AC-) SHALL ONLY BE GROUNDED AT THE PRIMARY SWITCH. EQUIPMENT GROUNDING CONDUCTORS SHALL BE BROUGHT TO THE PRIMARY SWITCH, BUT SHALL BE GROUNDED AT BOTH SECONDARY AND PRIMARY SWITCHES.
6. PAYMENT - ALL MATERIALS AND WORK REQUIRED TO COMPLETE THE EFFECTIVE GROUND FAULT CURRENT PATH SYSTEM ARE INCIDENTAL TO THE CONDUCTORS INSTALLED BY CONTRACT.

ITEM 625, CONNECTION, FUSED PULL APART, AS PER PLAN

THIS ITEM SHALL CONSIST OF FURNISHING AND INSTALLING A FUSED PULL APART CONNECTION AS DETAILED IN C&MS 625. ADDITIONAL WORK INCLUDED WITH THIS ITEM SHALL CONSIST OF REMOVING AND DISPOSING OF THE REMAINING PORTION OF THE EXISTING PULL APART CONNECTION AT THE END OF THE POLE AND BRACKET CABLE. PAYMENT SHALL BE MADE AT THE UNIT PRICE BID UNDER C&MS ITEM 625, "CONNECTION, FUSED PULL APART, AS PER PLAN" FOR EACH CONNECTION AND SHALL INCLUDE ALL LABOR, MATERIALS, AND INCIDENTALS REQUIRED TO COMPLETE THIS ITEM IN A SATISFACTORY AND WORKMANLIKE MANNER.

ITEM 632, MESSENGER WIRE, 7 STRAND, 1/4" DIAMETER WITH ACCESSORIES, AS PER PLAN

ALL ASPECTS OF ITEM 632 SHALL APPLY WITH THE EXCEPTION THAT PVC COATED MESSENGER SUPPORT RINGS SHALL BE USED TO SUPPORT LIGHTING CONDUCTORS INSTEAD OF LASHING ROD. MESSENGER SUPPORT RINGS SHOULD BE INSTALLED ACCORDING TO THE MANUFACTURER'S RECOMMENDATIONS. PAYMENT SHALL BE MADE AT THE UNIT PRICE BID UNDER C&MS ITEM 632 MESSENGER WIRE, 7 STRAND, 1/4" DIAMETER WITH ACCESSORIES, AS PER PLAN PER FOOT AND SHALL INCLUDE ALL LABOR, MATERIALS, AND INCIDENTALS REQUIRED TO COMPLETE THIS ITEM IN A SATISFACTORY AND WORKMANLIKE MANNER.

ITEM 632, COMBINATION STRAIN POLE, TYPE TC-81.10, DESIGN 5, AS PER PLAN

ALL ASPECTS OF 632 SHALL APPLY. ADDITIONALLY, LABEL EACH STRAIN POLE WITH THE ALPHA NUMERIC IDENTIFIER. PLACE THE IDENTIFIER ON THE QUADRANT OF THE SURFACE OF THE POLE THAT FACES ONCOMING TRAFFIC AT APPROXIMATELY 7 FEET (2 METERS) ABOVE THE ROADWAY SURFACE. APPLY THE IDENTIFIER LETTERS AND NUMERALS WHEN THE AMBIENT AIR TEMPERATURE, THE TEMPERATURE OF THE LABELING MATERIAL AND THE TEMPERATURE OF THE SURFACE TO WHICH THE LABELS ARE APPLIED ARE ALL ABOVE 40° F (4° C).

ITEM 659, SEEDING AND MULCHING

THE FOLLOWING QUANTITY HAS BEEN CARRIED TO THE GENERAL NOTES TO COVER SEEDING AND MULCHING OF DISTURBED AREAS DUE TO THE CONSTRUCTION OF THE PROPOSED LIGHTING CIRCUITS. THE ESTIMATED QUANTITY WAS CALCULATED BASED ON AN ASSUMPTION OF 5 FEET OF DISTURBANCE PER LINEAR FOOT OF TRENCH.

ITEM 659, SEEDING & MULCHING 10860 SY



V:\1736\active\173620094\engineering\96654\ProjAdmin\PlanReviews\Tracings\Tracings- Revised Addendum 3_3_6_2020\96654_LN001.dgn 3/6/2020 4:39:27 PM pduham

CALCULATED
PJD
CHECKED
SNS

LIGHTING NOTES

PRE-70-0.00

SHEET NO.	REFERENCE NO.	CIRCUIT	COORDINATES		625																							632						
			NORTHING	EASTING	CONNECTION, FUSED PULL APART	CONNECTION, FUSED PULL APART, AS PER PLAN	CONNECTION, UNFUSED PERMANENT	LIGHT POLE, CONVENTIONAL, AT20B40	LIGHT POLE FOUNDATION, 24" X 8' DEEP	BRACKET ARM, 20'	NO. 4 AWG 2400 VOLT DISTRIBUTION CABLE	NO. 6 AWG 2400 VOLT DISTRIBUTION CABLE	NO. 10 AWG POLE AND BRACKET CABLE	1-1/2" DUCT CABLE WITH THREE NO.4 AWG 2400 VOLT CABLES	1-1/2" DUCT CABLE WITH THREE NO.6 AWG 2400 VOLT CABLES	CONDUIT, 3", 725.04	CONDUIT, 3", 725.04, 3"	LUMINAIRE, CONVENTIONAL, SOUTH STATE (LED), AS PER PLAN	LUMINAIRE, LOW VOLT, SOUTH STATE (LED), AS PER PLAN	TRENCH	PULL BOX, 725.08, 18"	PULL BOX REMOVED	GROUND ROD	POWER SERVICE, AS PER PLAN	PLASTIC CAUTION TAPE	LIGHT TOWER REMOVED	LUMINAIRE REMOVED	POWER SERVICE REMOVED	POWER SERVICE REMOVED, AS PER PLAN	LIGHT TOWER FOUNDATION REMOVED	DISCONNECT CIRCUIT	MESSANGER WIRE, 7 STRAND, 1/4" DIAMETER WITH ACCESSORIES, AS PER PLAN	STRAIN POLE FOUNDATION	COMBINATION STRAIN POLE, TYPE TC-81.10, DESIGN 5, AS PER PLAN
			EACH	EACH	EACH	EACH	EACH	EACH	FT	FT	FT	FT	FT	FT	FT	FT	EACH	EACH	FT	EACH	EACH	EACH	EACH	FT	EACH	EACH	EACH	EACH	EACH	FT	EACH	EACH		
58	1	B	674220	1320831	2																													
	2	B																																
	3	B	674173	1321287	2																													
	4	B																																
	5	B	674132	1321514	2																													
	6	B																																
	7	B	674065	1321756		6																												
	8	B																																
	9	B	673924	1321833	2																													
	10	B																																
	11	B	673918	1322041	2																													
	12	B																																
	13	B	674068	1322133		3																												
	14	B																																
	15	B	674064	1321728																														
	16	B							135																									
	17	B							360																									
	18	B	674087	1321864	2																													
	19	B							315																									
	20	B	674082	1322039	2																													
	21	B	674087	1321746																														
	22	B	674068	1321996																														
59	1	B																																
60	1	B																																
	2	B	674131	1323558	2																													
	3	B																																
	4	B	674129	1324032	2																													
	5	B																																
	6	B	674123	1324540	2																													

TOTALS CARRIED TO SHEET NO. 57

0 20 9 0 0 0 810 0 0 4061 0 30 205 18 2 4001 2 2 0 1 4001 0 10 0 1 0 1 0 0 0

CALCULATED	PJD
	CHECKED
51	SNS
	147

LIGHTING QUANTITIES

PRE - 70 - 0.00

SHEET NO.	REFERENCE NO.	CIRCUIT	COORDINATES		CONNECTION, FUSED PULL APART	CONNECTION, FUSED PULL APART, AS PER PLAN	CONNECTION, UNFUSED PERMANENT	LIGHT POLE, CONVENTIONAL, AT20B40	LIGHT POLE FOUNDATION, 24" X 8' DEEP	BRACKET ARM, 20'	NO. 4 AWG 2400 VOLT DISTRIBUTION CABLE	NO. 6 AWG 2400 VOLT DISTRIBUTION CABLE	NO. 10 AWG POLE AND BRACKET CABLE	1-1/2" DUCT CABLE WITH THREE NO.4 AWG 2400 VOLT CABLES	1-1/2" DUCT CABLE WITH THREE NO.6 AWG 2400 VOLT CABLES	CONDUIT, 3", 725.04	CONDUIT, JACKED OR DRILLED, 725.04, 3"	LUMINAIRE, CONVENTIONAL, SOLID STATE (LED), AS PER PLAN	LUMINAIRE, LOW VOLT SOLID STATE (LED), AS PER PLAN	TRENCH	PULL BOX, 725.08, 18"	PULL BOX REMOVED	GROUND ROD	POWER SERVICE, AS PER PLAN	PLASTIC CAPTION TAPE	LIGHT TOWER REMOVED	LUMINAIRE REMOVED	POWER SERVICE REMOVED	POWER SERVICE REMOVED, AS PER PLAN	LIGHT TOWER FOUNDATION REMOVED	DISCONNECT CIRCUIT	MESSENGER WIRE, 7 STRAND, 1/4" DIAMETER WITH ACCESSORIES, AS PER PLAN	STRAIN POLE FOUNDATION	COMBINATION STRAIN POLE, TYPE TC-81.10, DESIGN 5, AS PER PLAN			
			NORTHING	EASTING																															EACH	EACH	EACH
60	7	C	674346	1324324																			1														
	8	C									195					50								50													
	9	C	674294	1324323			3														1																
	10	C												210										200													
	11	C	674294	1324523	2			1	1				180											1													
	12	C												277																							
61	1	C												109																							
	2	C	674291	1324897	2			1	1				180											1													
	3	C												366																							
	4	C	674290	1325253	2			1	1				180											1													
	5	C												345																							
	6	C	674288	1325587	2			1	1				180											1													
	7	C												320																							
	8	C	674287	1325897	2			1	1				180											1													
	9	C												15																							
	10	C	674282	1325897			3																														
	11	C									624						188																				
	12	C	674084	1325897			3																														
	13	C												295																							
62	1	C												451																							
	2	C	674055	1326626	2			1	1				180											1													
	3	C												487																							
	4	C	674035	1327102	2			1	1				180											1													
	5	C												185																							
	6	C	674013	1327275	2			1	1				180											1													
	7	C												210																							
	8	C	671977	1327470	2			1	1				180											1													
	9	C																																			
	10	C	674022	1327457			3																														
	11	C																																			
	12	C	674046	1327450	2			1	1				180											1													

TOTALS CARRIED TO SHEET NO. 57

20 0 12 10 10 0 990 0 1800 3306 0 50 245 10 0 3246 4 0 10 1 3246 0 0 0 0 0 0 0 0 0 0 0

CALCULATED	PJD
	CHECKED
PRE-70-0.00	SNS

LIGHTING QUANTITIES

SHEET NO.	REFERENCE NO.	CIRCUIT	COORDINATES		625																										632								
			NORTHING	EASTING	CONNECTION, FUSED PULL APART	CONNECTION, FUSED PULL APART, AS PER PLAN	CONNECTION, UNFUSED PERMANENT	LIGHT POLE, CONVENTIONAL, AT20B40	LIGHT POLE FOUNDATION, 24" X 8' DEEP	BRACKET ARM, 20'	NO. 4 AWG 2400 VOLT DISTRIBUTION CABLE	NO. 6 AWG 2400 VOLT DISTRIBUTION CABLE	NO. 10 AWG POLE AND BRACKET CABLE	1-1/2" DUCT CABLE WITH THREE NO.4 AWG 2400 VOLT CABLES	1-1/2" DUCT CABLE WITH THREE NO.6 AWG 2400 VOLT CABLES	CONDUIT, 3", 725.04	CONDUIT, JACKED OR DRILLED, 725.04, 3"	LUMINAIRE, CONVENTIONAL, SOLID STATE (LED), AS PER PLAN	LUMINAIRE, LOW WAST, SOLID STATE (LED), AS PER PLAN	TRENCH	PULL BOX, 725.08, 18"	PULL BOX REMOVED	GROUND ROD	POWER SERVICE, AS PER PLAN	PLASTIC CAUTION TAPE	LIGHT TOWER REMOVED	LUMINAIRE REMOVED	POWER SERVICE REMOVED	POWER SERVICE REMOVED, AS PER PLAN	LIGHT TOWER FOUNDATION REMOVED	DISCONNECT CIRCUIT	MESSNGER WIRE, 7 STRAND, 1/4" DIAMETER WITH ACCESSORIES, AS PER PLAN	STRAIN POLE FOUNDATION	COMBINATION STRAIN POLE, TYPE TC-8.10, DESIGN 5, AS PER PLAN					
			EACH	EACH	EACH	EACH	EACH	EACH	FT	FT	FT	FT	FT	FT	FT	EACH	EACH	FT	EACH	EACH	EACH	EACH	FT	EACH	EACH	EACH	EACH	EACH	EACH	EACH	FT	EACH	EACH						
66	1	D	675698	1368143	2							180																											
	2	D											384																										
	3	D	675697	1368517	2							180																											
	4	D											366																										
	5	D	675696	1368873	2							180																											
	6	D											344																										
	7	D	675694	1369207	2							180																											
	8	D											332																										
	9	D	675694	1369529	2							180																											
	10	D											91																										
	11	D	675717	1368721																																			
	12	D	675714	1369330																																			
	13	E	675498	1368919	2							180																											
	14	E											505																										
	15	E	675478	1369413	2							180																											
	16	E											186																										
	17	E	675456	1369587	2							180																											
	18	E											31																										
	19	E	675468	1369085																																			
	20	E	675432	1369578																																			
67	1	D											1086																										
	2	D	676103	1370589																																			
	3	D																																					
	4	D										159																											
	5	D	676021	1370585								276																											
	6	D											37																										
	7	D	675995	1370584	2							180																											
	8	D	675736	1369832																																			
	9	D	675668	1369857																																			
	10	D	675732	1370389																																			
	11	E											123																										
	12	E	675430	1369728																																			
	13	E											65																										
	14	E	675417	1369782	2							180																											
	15	E											820																										
	16	E	675057	1370493																																			
	17	E																																					
	18	E										237																											
	19	E	675475	1369739								171																											
	20	E																																					
	21	E	675491	1369761	2							180																											
	22	E											67																										
	23	E	675012	1370527	2							180																											
	24	E	675477	1369708																																			
	25	E	675381	1370157																																			
	26	E	675188	1370507																																			
TOTALS CARRIED TO SHEET NO. 57					24	0	15	12	12	0	843	0	2160	4474	0	0	251	12	0	4344	5	2	12	0	4344	8	36	0	0	8	0	0	0	0	0				

LIGHTING QUANTITIES

CALCULATED
PJD
CHECKED
SNS

PRE-70-0.00

SHEET NO.	REFERENCE NO.	CIRCUIT	COORDINATES		625																				632											
			NORTHING	EASTING	CONNECTION, FUSED PULL APART	CONNECTION, FUSED PULL APART, AS PER PLAN	CONNECTION, UNFUSED PERMANENT	LIGHT POLE, CONVENTIONAL, AT20B40	LIGHT POLE FOUNDATION, 24" X 8' DEEP	BRACKET ARM, 20'	NO. 4 AWG 2400 VOLT DISTRIBUTION CABLE	NO. 6 AWG 2400 VOLT DISTRIBUTION CABLE	NO. 10 AWG POLE AND BRACKET CABLE	1-1/2" DUCT CABLE WITH THREE NO.4 AWG 2400 VOLT CABLES	1-1/2" DUCT CABLE WITH THREE NO.6 AWG 2400 VOLT CABLES	CONDUIT, 3", 725.04	CONDUIT, JACKED OR DRILLED, 725.04, 3"	LUMINAIRE CONVENTIONAL SOLID STATE (LED), AS PER PLAN	LUMINAIRE, LOW WAST, SOLID STATE (LED), AS PER PLAN	TRENCH	PULL BOX, 725.08, 18"	PULL BOX REMOVED	GROUND ROD	POWER SERVICE, AS PER PLAN	PLASTIC CAUTION TAPE	LIGHT TOWER REMOVED	LUMINAIRE REMOVED	POWER SERVICE REMOVED	POWER SERVICE REMOVED, AS PER PLAN	LIGHT TOWER FOUNDATION REMOVED	DISCONNECT CIRCUIT	MESSANGER WIRE, 7 STRAND, 1/4" DIAMETER WITH ACCESSORIES, AS PER PLAN	STRAIN POLE FOUNDATION	COMBINATION STRAIN POLE, TYPE TC-81.10, DESIGN 5, AS PER PLAN		
			EACH	EACH	EACH	EACH	EACH	EACH	FT	FT	FT	FT	FT	FT	FT	EACH	EACH	FT	EACH	EACH	EACH	EACH	FT	EACH	EACH	EACH	EACH	EACH	EACH	FT	EACH	EACH				
68	1	D							219							68				1																
	2	D	676124	1370701		3							378																							
	3	D																																		
	4	D	675947	1371009		3																														
	5	D																																		
	6	D	675719	1371452	2		1	1				180				1						1														
	7	D											45																							
	8	D	675711	1371485		3																														
	9	D																																		
	10	D																																		
	11	D	676133	1370700	2		1	1				180				1						1														
	12	D							180																											
	13	D	675985	1371043																																
	14	D	675668	1371476		3			165							45																				
	15	D																																		
	16	D	675647	1371472	2		1	1				180				1						1														
	17	D																																		
	18	D	675976	1371043																																
	19	D	675761	1371198																																
	20	D	675667	1371200																																
	21	D																																		
	22	E							261							82																				
	23	E	675057	1370649		3																														
	24	E																																		
	25	E	675130	1370788		3																														
	26	E																																		
	27	E							264							78																				
	28	E	675135	1370649		3																														
	29	E																																		
	30	E	675144	1370635	2		1	1				180				1						1														
	31	E							150																											
	32	E	675092	1370813																																
	33	E	675104	1370815																																
	34	E	675299	1370900																																
	35	E	675362	1370810																																
69	1	D																																		
	2	D	675684	1371646	2		1	1				180				1						1														
	3	D																																		
	4	D	675666	1371820	2		1	1				180				1						1														
	5	D																																		
	6	D	675654	1372353	2		1	1				180				1						1														
	7	D	675692	1371764																																
	8	D	675674	1372366																																
	9	E																																		
	10	E	675448	1371664	2		1	1				180				1						1														
	11	E																																		
	12	E	675450	1371986	2		1	1				180				1						1														
	13	E																																		
	14	E	675455	1372320	2		1	1				180				1						1														
	15	E																																		
	16	E	675463	1372676	2		1	1				180				1						1														
	17	E																																		
	18	E	675469	1373050	2		1	1				180				1						1														
	19	E	675420	1371668																																
	20	E	675427	1372173																																
	21	E	675440	1372670																																

TOTALS CARRIED TO SHEET NO. 57			24	0	21	12	12	0	1239	0	2160	4441	0	80	273	12	0	4291	7	2	12	2	4291	8	36	2	0	8	2	0	0	0	0
---------------------------------------	--	--	----	---	----	----	----	---	------	---	------	------	---	----	-----	----	---	------	---	---	----	---	------	---	----	---	---	---	---	---	---	---	---

CALCULATED	PJD	LIGHTING QUANTITIES
	CHECKED	
SNS		
PRE - 70 - 0.00		
55		147

SHEET NO.	REFERENCE NO.	CIRCUIT	COORDINATES		CONNECTION, FUSED PULL APART	CONNECTION, FUSED PULL APART, AS PER PLAN	CONNECTION, UNFUSED PERMANENT	LIGHT POLE, CONVENTIONAL, AT20B40	LIGHT POLE FOUNDATION, 24" X 8" DEEP	BRACKET ARM, 20'	NO. 4 AWG 2400 VOLT DISTRIBUTION CABLE	NO. 6 AWG 2400 VOLT DISTRIBUTION CABLE	NO. 10 AWG POLE AND BRACKET CABLE	1-1/2" DUCT CABLE WITH THREE NO.4 AWG 2400 VOLT CABLES	1-1/2" DUCT CABLE WITH THREE NO.6 AWG 2400 VOLT CABLES	CONDUIT, 3", 725.04	625		TRENCH	PULL BOX, 725.08, 18"	PULL BOX REMOVED	GROUND ROD	POWER SERVICE, AS PER PLAN	632		DISCONNECT CIRCUIT	MESSENGER WIRE, 7 STRAND, 1/4" DIAMETER WITH ACCESSORIES, AS PER PLAN	STRAIN POLE FOUNDATION	COMBINATION STRAIN POLE, TYPE TC-81.0, DESIGN 5, AS PER PLAN													
			NORTHING	EASTING													EACH	EACH						EACH	FT					FT	FT	FT	FT	FT	FT	FT	FT	FT	FT	FT	EACH	EACH
			CONDUIT, JACKED OR DRILLED, 725.04, 3"	LUMINAIRE CONVENTIONAL SOLID STATE (LED), AS PER PLAN													LUMINAIRE, LOW MAINT., SOLID STATE (LED), AS PER PLAN	PLASTIC PROTON TUBE						LIGHT TOWER REMOVED	LUMINAIRE REMOVED					POWER SERVICE REMOVED	POWER SERVICE REMOVED, AS PER PLAN	LIGHT TOWER FOUNDATION REMOVED										
70	1	F	675773	1393545	2			1	1				180										1							180												
	2	F								1			150				385						1							150			1									
	3	F	675786	1393919	2																		1									1										
	4	F											1098										1								1098			1								
	5	F	675782	1394275	2					1			60										1								60			1								
	6	F																					1										1									
	7	F	675786	1394609	2					1			60										1								60			1								
	8	F																					1										1									
	9	F	675791	1394943	2					1			150										1								150			1								
	10	F																					1										1									
	11	F	675593	1393861	2			1	1				174										1								174			1								
	12	F																					1										1									
	13	F	675576	1394171	2					1			150										1										150			1						
	14	F																					1											1								
	15	F	675566	1394345	2					1			54										1											54			1					
	16	F																					1												1							
	17	F	675560	1394519	2					1			555										1												555			1				
	18	F																					1													1						
	19	F	675557	1394693	2					1			54										1													54			1			
	20	F																					1													1						
	21	F	675555	1394888	2					1			150										1													150			1			
	22	F																					1														1					
	23	F	675554	1394938				3															1														3					
	24	F																					1														1					
	25	F	675595	1394938				3															1														3					
	26	F																					1														1					
71	1	F																					1														1					
	2	F	675823	1395203				3															1														3					
	3	F																					1														1					
	4	F, G	675893	1395168																			1														1					
	5	G																					1														1					
	6	G	676209	1395609				3															1														3					
	7	G																					1														1					
	8	G	676209	1395671				3															1														3					
	9	G																					1														1					
	10	G	676209	1395676	2			1	1				180										1														180			2		
	11	G																					1															1				
	12	G																					1															1				
	13	G	676089	1395612				3															1															3				
	14	G																					1															1				
	15	G	676084	1395612	2			1	1				180										1															180			2	
	16	F																					1															1				
	17	F	675784	1395222				3															1															3				
	18	F																					1															1				
	19	F	675592	1395220				3															1															3				
	20	F																					1															1				
	21	F																					1															1				
	22	F	675234	1395595				3															1															3				
	23	F																					1															1				
	24	F	675146	1395604				3															1															3				
	25	F																					1															1				
	26	F	675131	1395606	2			1	1				180										1															180			2	
	27	F																					1															1				
	28	F	675240	1395653				3															1															3				
	29	F																					1															1				
	30	F	675241	1395653	2			1	1				180										1															180			2	
TOTALS CARRIED TO SHEET NO. 57					30	0	33	6	6	9	2313	5442	1902	2505	708	0	686	15	0	3098	11	0	15	1	3088	0	0	0	0	0	0	0	1744	9	9							

