


STATE OF OHIO DEPARTMENT OF TRANSPORTATION

PUT-108-2.65


VILLAGE OF MILLER CITY

PUTNAM COUNTY

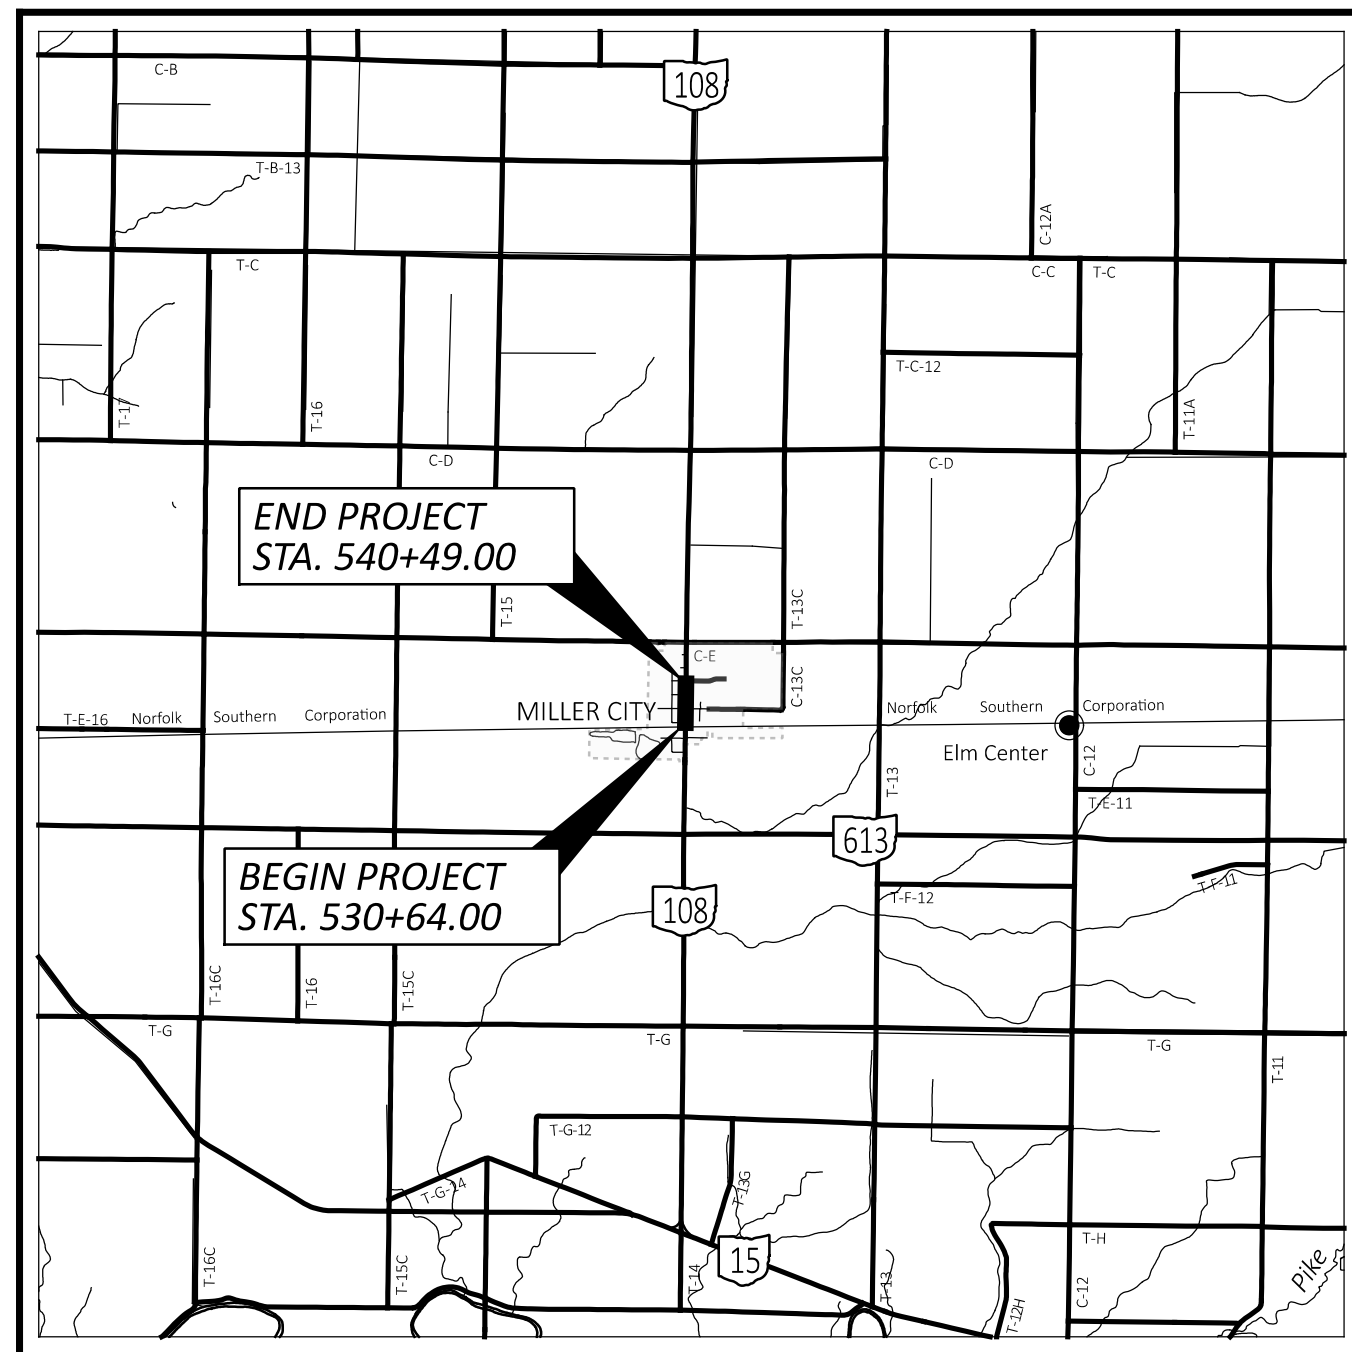

LOCATION MAP

LATITUDE: 41°06'10" LONGITUDE: 84°07'55"

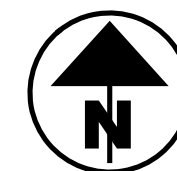

PORTION TO BE IMPROVED	—————	=====
INTERSTATE HIGHWAY	—————	=====
FEDERAL ROUTES	—————	=====
STATE ROUTES	—————	=====
COUNTY & TOWNSHIP ROADS	—————	=====
OTHER ROADS	—————	=====

DESIGN DESIGNATION

CURRENT ADT (2025)	1,900
DESIGN YEAR ADT (2045)	2,100
DESIGN HOURLY VOLUME (2045)	300
DIRECTIONAL DISTRIBUTION	61%
TRUCKS (24 HOUR B&C)	9%
DESIGN SPEED	40 MPH
LEGAL SPEED	35 MPH
DESIGN FUNCTIONAL CLASSIFICATION:	
04 MINOR ARTERIAL (RURAL)	
NHS PROJECT	NO

DESIGN EXCEPTIONS

NONE REQUIRED

ADA DESIGN WAIVERS

NONE REQUIRED

UNDERGROUND UTILITIES
Contact Two Working Days
Before You Dig

OHIO811.org
Before You Dig

OHIO811, 8-1-1, or 1-800-362-2764
(Non members must be called directly)

PLAN PREPARED BY:
ODOT DISTRICT 1
1885 N. MCCULLOUGH ST.
LIMA, OH 45801

INDEX OF SHEETS:

TITLE SHEET	1
TYPICAL SECTIONS	2
GENERAL NOTES	3-4
MAINTENANCE OF TRAFFIC	5-6
GENERAL SUMMARY	7-8
SUBSUMMARIES	9
PLAN AND PROFILE	10-11
CROSS SECTIONS	12-24
DRILLED SHAFT WALL DETAILS	25-29
MISCELLANEOUS DETAILS	30
TRAFFIC CONTROL	31-32
GEOTECHNICAL PROFILE - LANDSLIDE	33-38

STANDARD CONSTRUCTION DRAWINGS				SUPPLEMENTAL SPECIFICATIONS		SPECIAL PROVISIONS	
BP-3.1	1/19/24	TC-41.20	10/18/13	800-2023	7/19/24	WATERWAY PERMITS CONDITIONS 1/16/25	
BP-7.1	1/19/24	TC-41.30	4/21/23	832	7/21/23		
		TC-42.20	10/18/13	902	7/19/19		
RM-5.2	7/21/23	TC-52.10	10/18/13				
		TC-52.20	1/15/21				
DM-1.1	7/17/20	TC-61.10	4/21/23				
DM-1.2	7/16/21	TC-71.10	4/21/23				
DM-4.3	1/15/16	TC-74.10	7/21/23				
DM-4.4	1/15/16						
MH-3	7/19/24						
MT-101.60	4/21/23						
MT-101.90	7/17/20						
MT-105.10	1/17/20						

ENGINEER'S SEAL



FEDERAL PROJECT NUMBER

E240 (334)

RAILROAD INVOLVEMENT

NONE

PROJECT DESCRIPTION

CONSTRUCTION OF TWO PLUG PILE WALLS IN THE VILLAGE OF MILLER CITY.

PROJECT LENGTH: 0.19 MILES

EARTH DISTURBED AREAS

PROJECT EARTH DISTURBED AREA:	0.4 ACRES
ESTIMATED CONTRACTOR EARTH DISTURBED AREA:	0.4 ACRES
NOTICE OF INTENT EARTH DISTURBED AREA:	N/A (NOI NOT REQUIRED)

2023 SPECIFICATIONS

THE STANDARD SPECIFICATIONS OF THE STATE OF OHIO, DEPARTMENT OF TRANSPORTATION, INCLUDING SUPPLEMENTAL SPECIFICATIONS LISTED IN THE PLANS AND CHANGES LISTED IN THE PROPOSAL SHALL GOVERN THIS IMPROVEMENT.

I HEREBY APPROVE THESE PLANS AND DECLARE THAT THE MAKING OF THIS IMPROVEMENT WILL REQUIRE THE CLOSING TO TRAFFIC OF THE HIGHWAY AND THAT DETOURS WILL BE PROVIDED AS INDICATED ON SHEET 6.

Christopher A. Hughes, P.E.
District 01 Deputy Director

Pamela Boratyn
Director, Department of Transportation

PUT-108-2.65

MODEL: Sheet_SurvFI PAPER SIZE: 34x42 (in.) DATE: 1/17/2025 TIME: 9:51:22 AM USER: kostlerma pvc:\ohiodot-pw-bentley.com\ohiodot-pw-02\Documents\01 Active Projects\District 01\Putnam\113024\400-Engineering\Roadway\Sheets\113024_GT001.dgn

TITLE SHEET

DESIGN AGENCY



DESIGNER	KCO
REVIEWER	MJM 02-08-24
PROJECT ID	113024
SHEET	TOTAL
P.1	38