


ELEVATION OF INTAKE (NORTH) OF STRUCTURE  
WINGWALLS NOT SHOWN

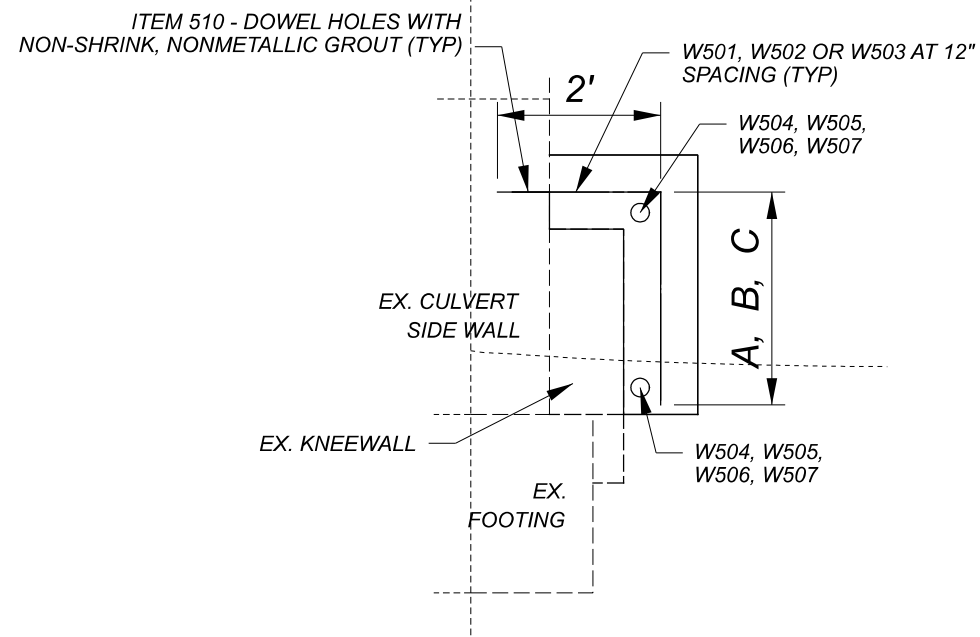

KNEE WALL REINFORCMENT DETAIL

ITEM 202 - PORTIONS OF STRUCTURE REMOVED, AS PER PLAN (FASCIA STONES)

**STRUCTURE QUANTITIES**

ITEM	QUANTITY	UNIT	DESCRIPTION
202	18	EACH	PORTIONS OF STRUCTURE REMOVED, AS PER PLAN (FASCIA STONES)
202	LS	LS	PORTIONS OF STRUCTURE REMOVED, AS PER PLAN (KNEEWALL)
503	LS	LS	COFFERDAMS AND EXCAVATION BRACING
509	1866	LB	EPOXY COATED REINFORCING STEEL, AS PER PLAN
510	222	EACH	DOWEL HOLES WITH NON-SHRINK, NONMETALLIC GROUT
512	200	FT	CONCRETE REPAIR BY EPOXY INJECTION
602	50	CY	CONCRETE MASONRY, AS PER PLAN
SPECIAL	18	EACH	STRUCTURES: RESET STONE MASONRY

ALL QUANTITIES CARRIED TO THE GENERAL SUMMARY

**NOTES:**

1. INJECT EPOXY INTO HORIZONTAL CRACKS THROUGHOUT THE INTERIOR OF THE STRUCTURE THAT ARE 5'-6" ABOVE WATER LINE AS DETERMINED BY THE ENGINEER.
2. PROPOSED KNEE WALL SHALL BE 1 FOOT WIDER THAN EXISTING AND BEGIN 4 INCHES BELOW EXISTING WEEPHOLES. PROPOSED KNEE WALL SHALL EXTEND TO A VARYING DEPTH MEETING THE BEDROCK ENCAPSULATING THE EXISTING KNEE WALL.
3. REINFORCMENT STEEL SHALL BE PLACED CENTERED IN THE PROPOSED CONCRETE KNEE WALL POURS (INCIDENTAL TO CONCRETE MASONRY).
4. "L" SHAPED REINFORCMENT STEEL SHALL BE DOWELED 4 INCHES INTO THE EXISTING WALL TO SECURE PROPOSED KNEE WALL. DOWEL HOLES SHALL BE MADE CENTERED ON THE STONE FACE WITH REGARD TO THE SPACING DETAILED ON SHEET 9.

**BAR CHART**

MARK	TYPE	LENGTH (FEET)			QTY NEEDED	WEIGHT (LBS)	
		HORIZ	VERTICAL	OVERALL		EACH	TOTAL
W501	BENT	2.00	3.00	5.00	65	5.22	339
W502	BENT	2.00	4.00	6.00	114	6.26	714
W503	BENT	2.00	6.00	8.00	43	8.34	359
W504	STR			106.80	2	111.39	223
W505	STR			32.47	2	33.86	68
W506	STR			56.89	2	59.33	119
W507	STR			21.05	2	21.96	44

