


RIC - US 30-18.10
 230194 PID - 115082
 Dist 3 3/30/2023

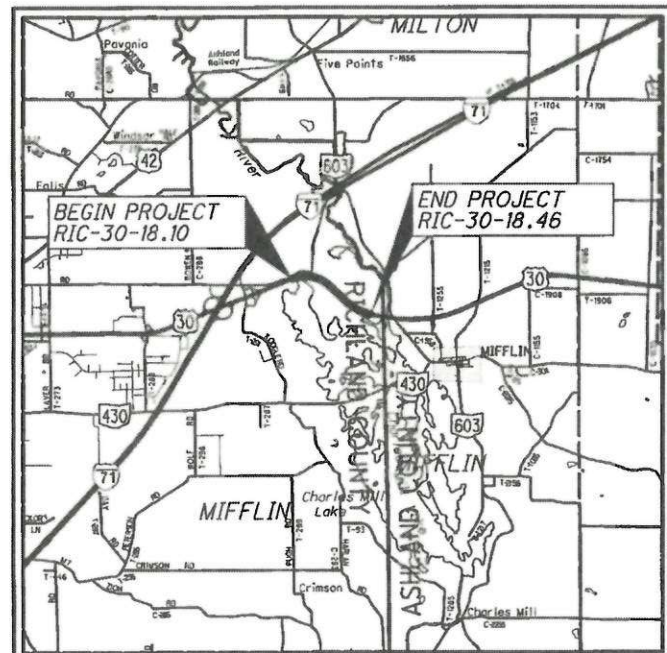

LOCATION MAP
 SCALE IN MILES
 LATITUDE: 40° 47' 13" LONGITUDE: 82° 23' 50"

PORTION TO BE IMPROVED
 INTERSTATE HIGHWAY
 FEDERAL ROUTES
 STATE ROUTES
 COUNTY & TOWNSHIP ROADS
 OTHER ROADS

DESIGN DESIGNATIONS RIC-30-18.10 TO 19.10
 CURRENT ADT (2023) 16,000
 DESIGN YEAR ADT (2043) 19,000
 DESIGN HOURLY VOLUME 1,900
 DIRECTIONAL DISTRIBUTION 53%
 TRUCKS (24 HOUR B&C) 26%
 DESIGN & LEGAL SPEED (MPH) 60
 NHS PROJECT YES
 DESIGN FUNCTIONAL CLASSIFICATIONS:
 RIC-30-18.10 TO 19.10 OTHER PRINCIPAL ARTERIAL

ADA WAVIER
 NONE

DESIGN EXCEPTIONS
 DESIGN FEATURE APPROVAL DATE SHEET NUMBERS
 SHOULDER WIDTH 11/23/22 3

UNDERGROUND UTILITIES
 Contact Two Working Days Before You Dig

 OHIO811. 8-1-1. or 1-800-362-2764 (Non-members must be called directly)

ENGINEERS SEAL:

 SIGNED: Nicholas R. Foster
 DATE: 12/15/2022

STATE OF OHIO
 DEPARTMENT OF TRANSPORTATION

RIC-30-18.10

MIFFLIN TOWNSHIP
 RICHLAND COUNTY

INDEX OF SHEETS:

TITLE SHEET	1
SCHEMATIC & PROJECT CONTROL	2
TYPICAL SECTIONS	3
GENERAL NOTES	4 - 5
MAINTENANCE OF TRAFFIC	6 - 12
GENERAL SUMMARY	13 - 14
ROADWAY SUBSUMMARY	15
PLAN VIEW - U.S. 30	16 - 19
CROSS SECTIONS - U.S. 30	20 - 44
SIGNING PLAN - U.S. 30	45
PLAN INSERT SHEETS	
GR-1.1	46 - 48
GR-2.1	49 - 50
GR-4.2	51 - 52

STANDARD CONSTRUCTION DRAWINGS				SUPPLEMENTAL SPECIFICATIONS		SPECIAL PROVISIONS	
DM-1.1	7/17/20	MT-99.30	1/17/20	TC-72.20	7/20/18	800-SEE PROPOSAL	WATERWAY
DM-4.3	1/15/16	MT-101.70	1/17/20			808	1/18/19 PERMIT
DM-4.4	1/15/16	MT-101.75	1/17/20			821	4/20/12 PERMIT
		MT-101.90	7/17/20			832	7/15/22 DATED 2/15/2023
F-3.4	7/19/13	MT-104.10	10/16/15			902	7/19/19
		MT-105.10	1/17/20			908	10/20/17
RM-4.2	4/17/20					921	4/20/12
		TC-41.10	7/19/13				
HW-2.1	7/20/18	TC-41.20	10/18/13				
		TC-42.10	10/18/13				
MT-95.30	7/19/19	TC-42.20	10/18/13				
MT-95.40	1/17/20	TC-52.10	10/18/13				
MT-95.50	7/21/17	TC-52.20	1/15/21				
MT-98.10	1/17/20	TC-61.10	1/17/20				
MT-98.11	1/17/20	TC-61.30	7/19/19				
MT-99.20	4/19/19	TC-71.10	7/15/22				

PROJECT DESCRIPTION
 THIS PROJECT INCLUDES EXCAVATION AND EMBANKMENT WORK TO REMOVE MATERIAL WITHIN THE MUSKINGUM WATERSHED CONSERVANCY DISTRICT FLOWAGE EASEMENT TO MITIGATE THE PLACEMENT OF FILL MATERIAL THAT WAS PLACED WITH AN ADJOURNING PROJECT. MISCELLANEOUS GUARDRAIL AND DRAINAGE WORK WILL ALSO BE PERFORMED.

EARTH DISTURBED AREAS
 PROJECT EARTH DISTURBED AREA: 4.78 ACRES
 ESTIMATED CONTRACTOR EARTH DISTURBED AREA: 2.05 ACRES
 NOTICE OF INTENT EARTH DISTURBED AREA: 6.83 ACRES

LIMITED ACCESS
 THIS IMPROVEMENT IS ESPECIALLY DESIGNED FOR THROUGH TRAFFIC AND HAS BEEN DECLARED A LIMITED ACCESS HIGHWAY OR FREEWAY BY ACTION OF THE DIRECTOR IN ACCORDANCE WITH THE PROVISIONS OF SECTION 5511.02 OF THE OHIO REVISED CODE.

PLANS PREPARED BY:

 OHIO DEPARTMENT OF TRANSPORTATION
 DISTRICT THREE ENGINEERING

2019 SPECIFICATIONS
 THE STANDARD SPECIFICATIONS OF THE STATE OF OHIO, DEPARTMENT OF TRANSPORTATION, INCLUDING SUPPLEMENTAL SPECIFICATIONS LISTED IN THE PLANS AND CHANGES LISTED IN THE PROPOSAL SHALL GOVERN THIS IMPROVEMENT.

I HEREBY APPROVE THESE PLANS AND DECLARE THAT THE MAKING OF THIS IMPROVEMENT WILL NOT REQUIRE THE CLOSING OF TRAFFIC OF THE HIGHWAY AND THAT PROVISIONS OF THE MAINTENANCE AND SAFETY OF TRAFFIC WILL BE ASS SET FORTH ON THE PLANS AND ESTIMATES.

APPROVED
 DATE 12/16/22 ROBERT WEAVER, PE, PS
 DISTRICT DEPUTY DIRECTOR

APPROVED
 DATE 2-8-2023 JACK MARCHBANKS, PhD, DIRECTOR
 DEPARTMENT OF TRANSPORTATION

FEDERAL PROJECT NO. E220278
 PID NO. 115082
 CONSTRUCTION PROJECT NO. NONE
 RAILROAD INVOLVEMENT NONE
 RIC-30-18.10
 1/52

I:\ProjectData\115082\Design\Roadway\Sheets\115082_GTO01.dgn

Contract Proposal available @
 www.contracts.dot.state.oh.us