

O.D.O.T. DISTRICT 2 SURVEY OFFICE (USE ONLY)

PERSONNEL _____ REFERENCE NO. 5 SHEET 9 OF 33

NOTES RHOADES ✓ DATE 4-14-16 12-15-23 ROUTE SR 19

H.C. O'DONNELL MILLER WEATHER CLOUDY COUNTY SANDUSKY

R.C. RHOADES ✓ TEMP. 40°F TOWNSHIP GREEN CREEK

SECTION 19 20 30 29

T 4 N R 16 E

TYPE MONUMENT MAG SHANK MAG/WASHER

~~ON SURFACE~~ - BELOW 2" ON

LEFT - Q PAV'T - RIGHT ON

- TO - EDGE PAVEMENT

S.L.M. 103+88 1239' to 5A

Grid: Northing: 590149.4176 Easting: 1816720.0557

19	20
30	29



RECORD:
 $\Delta = 00^{\circ}06'00''$ LT
 P.I. 78+04.20
 REPLACE STONE
 WITH I.P.I.PE
 FIELD BOOK #55


SET MAG NAIL
 09-17-02, DCH

FD MAG SHANK
 GPS, REF5
 4-14-16, JFO

RESET (UNCOVERED SHANK)
 WITH MAG WASHER
 9-2-16, JFO

FD MAG/WASHER
SEC 20 SW
12-15-23, JAM


SANDUSKY LPD:
N:
E:

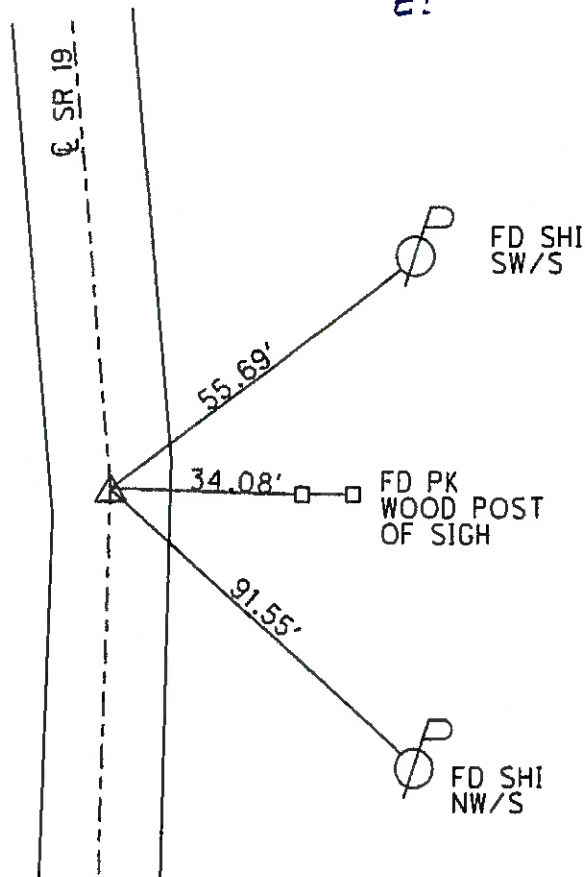

O.D.O.T. DISTRICT 2 SURVEY OFFICE (USE ONLY)

PERSONNEL _____ REFERENCE NO. 5 A SHEET 10 OF 33
 NOTES RHOADES ✓ DATE 4-15-16 12-21-23 ROUTE SR 19
 H.C. O'DONNELL MILLER WEATHER CLOUDY ✓ COUNTY SANDUSKY
 R.C. RHOADES ✓ TEMP. 40°F 46' TOWNSHIP GREEN CREEK
 SECTION 19
 T 4 N R 16 E

TYPE MONUMENT MAG/WASHER ✓
 ON SURFACE - ~~BELOW~~ ON ✓
 LEFT - ℄ PAV'T - RIGHT ON ✓
 - TO - EDGE PAVEMENT
 S.L.M. 116+27

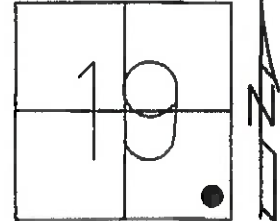

Grid: Northing: 591382.0365 Easting: 1816739.7190

RECORD: 0=00 AHD.
 90+42.10±
 PK/WASHER
 ATOP PK/WASHER
 ATOP IRON ROD
 ATOP STONE WITH
 "X" CUT & PUNCH HOLE
 22" BELOW SURFACE
 REF. FIELD BOOK #55
 1986


NOTE: DIS. REF 5A TO REF 5B = 6.72'
 DIS. REF 5A TO REF 6 = 3.92'
 DIS. REF 5B TO REF 6 = 5.45'

SET MAG NAIL
 09-17-02, DCH

FD MAG/WASHER
 GPS, REF 5A
 4-15-16, JFO

POINT
 UNCOVERED
 7-2-16, JFO


FD MAG/WASHER
 REF 5A
 12-21-23, JAM

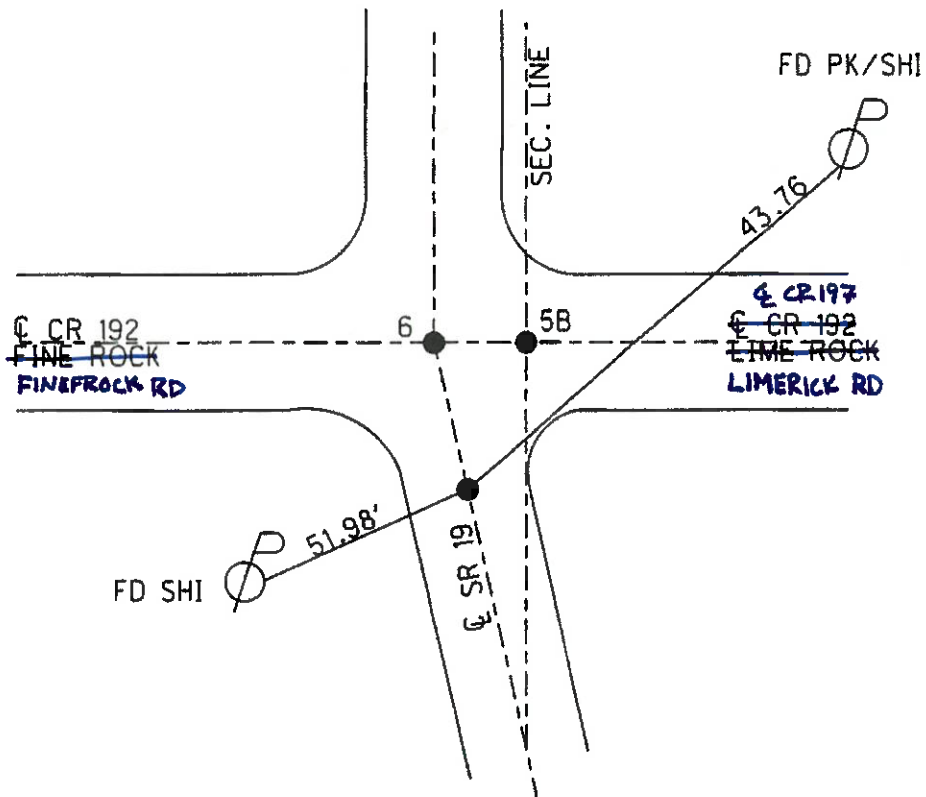

O.D.O.T. DISTRICT 2 SURVEY OFFICE (USE ONLY)

PERSONNEL _____ REFERENCE NO. 5 B SHEET 11 OF 33
 NOTES RHOADES ✓ DATE 4-15-16 12-21-23 ROUTE SR 19
 H.C. O'DONNELL MILLER WEATHER CLOUDY ✓ COUNTY SANDUSKY
 R.C. RHOADES ✓ TEMP. 40°F 46° TOWNSHIP GREEN CREEK
 SECTION 19
 T 4 N R 16 E

TYPE MONUMENT PK/WASHER ✓
~~ON SURFACE~~ - BELOW 2.5" 3"
~~LEFT~~ - Q PAV'T - RIGHT 5.5' ✓
 - TO - EDGE PAVEMENT
 S.L.M. 116+31

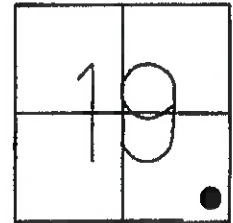

Grid: Northing: 591385.8484 Easting: 1816745.2679

RECORD: 0=00 AHD.
 90+42.10±
 PK/WASHER
 ATOP PK/WASHER
 ATOP IRON ROD
 ATOP STONE WITH
 "X" CUT & PUNCH HOLE
 22" BELOW SURFACE
 REF. FIELD BOOK #55
 1986


NOTE: DIS. REF 5A TO REF 5B = 6.72'
 DIS. REF 5A TO REF 6 = 3.92'
 DIS. REF 5B TO REF 6 = 5.45'

SET MAG NAIL
 09-17-02, DCH

FD PK/WASHER
 2.5" DOWN
 GPS, REFB5
 4-15-16, JFO

POINT
 UNCOVERED
 7-2-16, JFO

FD P.K./WASHER
 3" DOWN
 REF 5B
 12-21-23, JAM

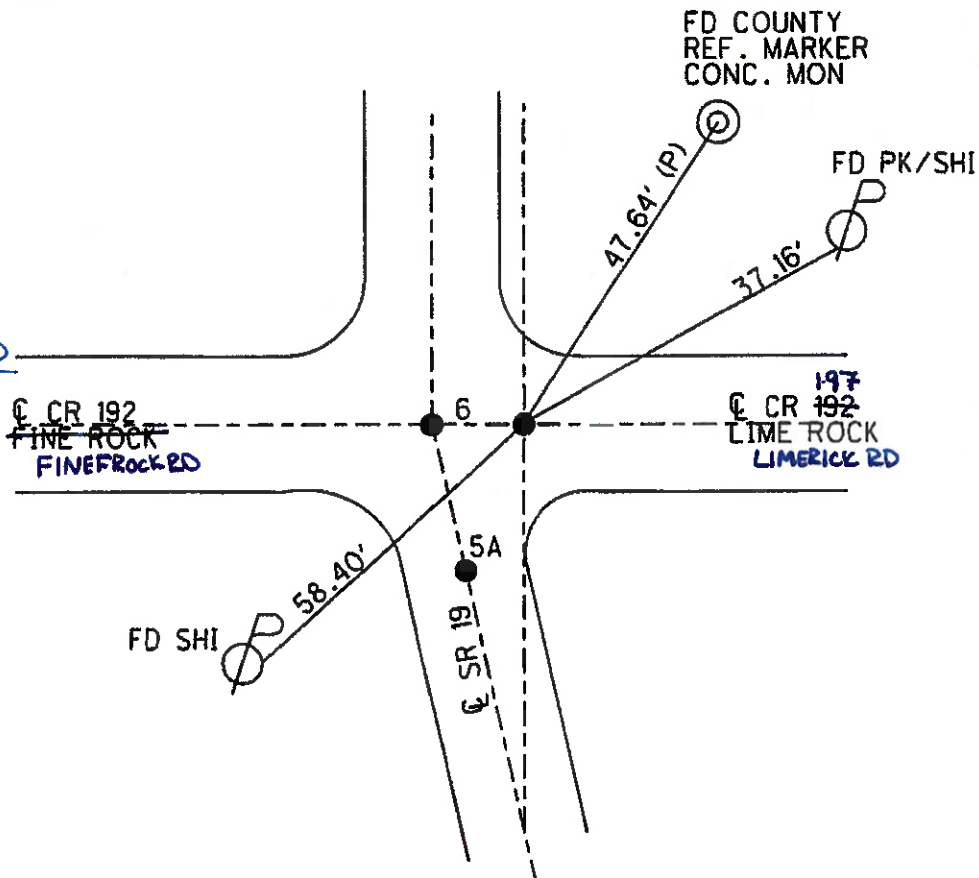

O.D.O.T. DISTRICT 2 SURVEY OFFICE (USE ONLY)

PERSONNEL REFERENCE NO. 6 SHEET 12 OF 33

NOTES RHOADES ✓ DATE 4-15-16 12-21-23 ROUTE SR 19

H.C. O'DONNELL MUR WEATHER CLOUDY ✓ COUNTY SANDUSKY

R.C. RHOADES ✓ TEMP. 40°F 46° TOWNSHIP GREEN CREEK

SECTION 19

T_4_N R_16_E

TYPE MONUMENT MAG/WASHER ✓


ON SURFACE - ~~BELOW~~ ON ✓

LEFT - C PAV'T - RIGHT ON ✓

TO - EDGE PAVEMENT

S.L.M. 116+31 992' to 6A

Grid: Northing: 591385.9374 Easting: 1816739.8071

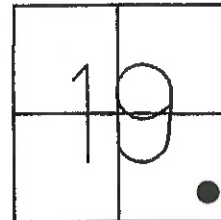

RECORD: 0=00 AHD.
90+42.10±
PK/WASHER
ATOP PK/WASHER
ATOP IRON ROD
ATOP STONE WITH
"X" CUT & PUNCH HOLE
22" BELOW SURFACE
REF. FIELD BOOK #55
1986

SET MAG NAIL
09-17-02, DCH


FD MAG/WASHER
GPS, REF6
4-15-16, JFO

POINT
UNCOVERED
7-2-16, JFO

FD MAG/WASHER

REF
12-21-23, JAM

NOTE: DIS. REF 5A TO REF 5B= 6.72'
DIS. REF 5A TO REF 6 = 3.92'
DIS. REF 5B TO REF 6 = 5.45'

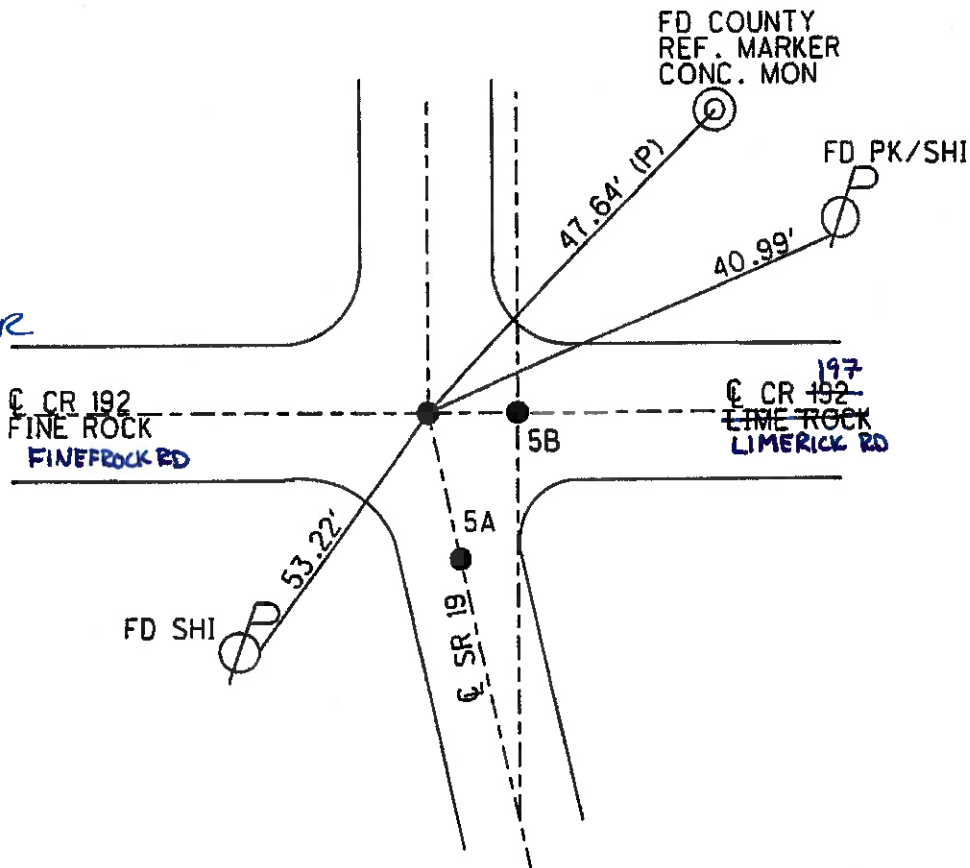

O.D.O.T. DISTRICT 2 SURVEY OFFICE (USE ONLY)

PERSONNEL _____ REFERENCE NO. 0 RA / 6 A SHEET 13 OF 33

NOTES ROUSOS RHODES DATE 04-10-02 12-21-23 ROUTE SR 19
H.C. HOMAN MILLER WEATHER SUNNY CLOUDY COUNTY SANDUSKY
R.C. ROUSOS RHODES TEMP. 50°F 46° TOWNSHIP GREEN CREEK
SECTION 19

T 4 N R 16 E

TYPE MONUMENT PK/WASHER FD MON BOX W/5/8" PIN


ON SURFACE - ~~BELOW~~ ON ✓

LEFT - Q PAV'T - ~~RIGHT~~ 1'

- TO - EDGE PAVEMENT

S.L.M. 126+23 143' to 6B

Grid: Northing: 592378.3454 Easting: 1816755.5695

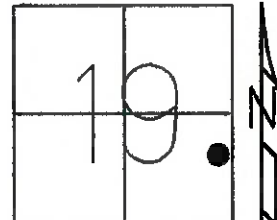

RECORD:
PC 9+92.50 ✓
PK/WASHER
ATOP PK/WASHER
REF FIELD BOOK #55
SEE NOTE ON SHEET #15
REF #7-C, 1986


FD PK NAIL
SET BY
CONTRACTOR
9-17-02, DCH

FD MON BOX
GPS, REFA6
4-15-16, JFO

FND MONBOX
9-2-16

FD MONBOX
W/5/8" PIN
REF 6A
12-21-23, JAM

FD MONBOX
W/5/8" PIN
REF 6A
12-21-23, JAM

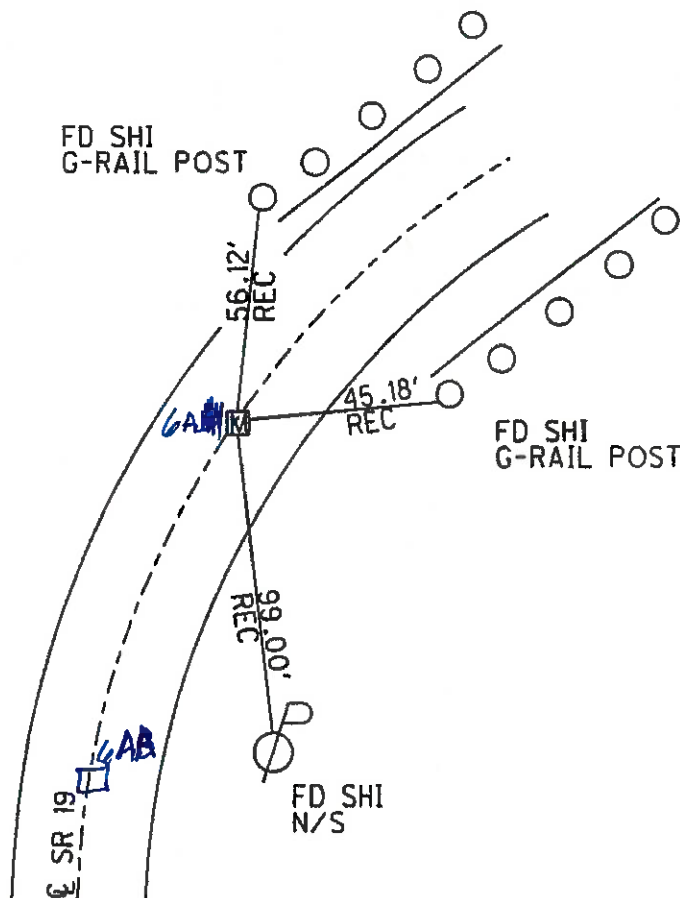

O.D.O.T. DISTRICT 2 SURVEY OFFICE (USE ONLY)

PERSONNEL

REFERENCE NO.

6 B

SHEET

14

OF 33

NOTES

ROUSOS

DATE

04-10-02

ROUTE SR 19

H.C.

HOMAN

WEATHER

SUNNY

COUNTY SANDUSKY

R.C.

ROUSOS

TEMP.

50°F

TOWNSHIP GREEN CREEK

SECTION

19

T 4 N R 16 E

TYPE MONUMENT PK/WASHER

ON SURFACE - ~~BELOW~~ ON


LEFT - C PAV'T - ~~RIGHT~~ 2'

TO - EDGE PAVEMENT

S.L.M. 127+66

143' to 7

Grid: Northing: - Easting: -

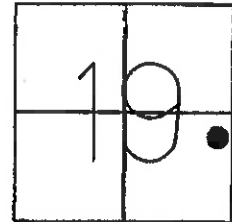

RECORD:

MC 11+35.28

PK/WASHER

ATOP PK/WASHER

REF. FIELD BOOK #55

SEE NOTE ON SHEET #15

REF #7-C

1986


SET MAG NAIL

09-17-02, DCH

DNF

NEW CULVERT

4-15-16

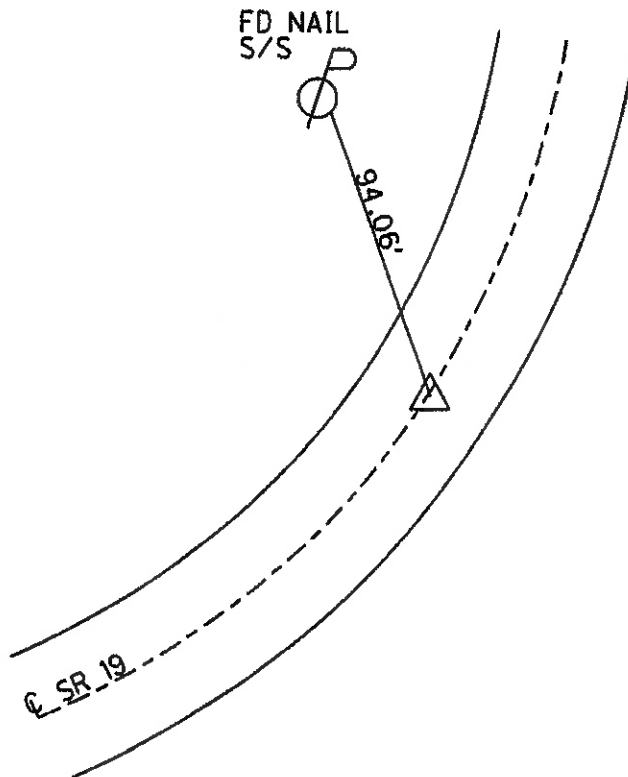

O.D.O.T. DISTRICT 2 SURVEY OFFICE (USE ONLY)

PERSONNEL

REFERENCE NO.

7/7A SHEET 15 OF 33

NOTES ROUSOS

DATE 04-10-02

ROUTE SR 19

H.C. HOMAN

WEATHER SUNNY

COUNTY SANDUSKY

R.C. ROUSOS

TEMP. 50°F

TOWNSHIP GREEN CREEK

SECTION 20

T 4 N R 16 E

TYPE MONUMENT PK/WASHER


ON SURFACE - ~~BELOW~~ ON

LEFT - ℄ PAV'T - RIGHT ON

- TO - EDGE PAVEMENT

S.L.M. 129+09 490 to 7A

Grid: Northing: 592645.7365 Easting: 1816842.7337

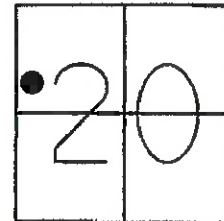


RECORD:
PT 12+78.06
PK/WASHER
ATOP PK/WASHER
REF. FIELD BOOK #55
SEE NOTE ON SHEET #15
REF 7-C
1986

FD PK SET BY
CONTRACTOR
9-17-02, DCH

FD MON BOX
GPS, REF7
4-15-16, JFO

FND MONBOX
9-2-16

TOP OF TOP BRICK
PORCH STOOP

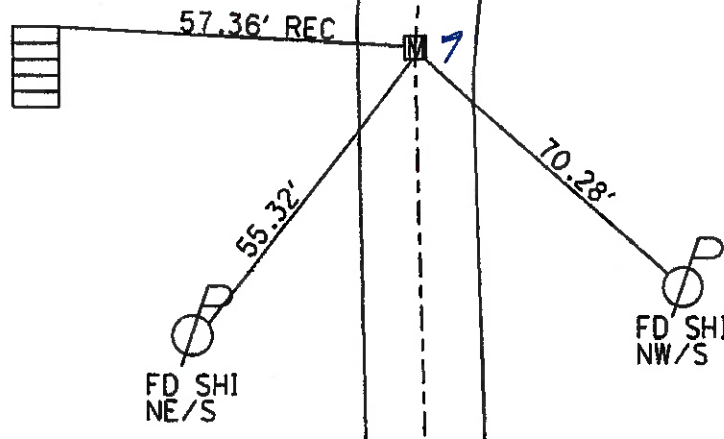

O.D.O.T. DISTRICT 2 SURVEY OFFICE (USE ONLY)

PERSONNEL _____ REFERENCE NO. 7 A SHEET 16 OF 33

NOTES RHOADES ✓ DATE 4-15-16 12-21-23 ROUTE SR 19

H.C. O'DONNELL MILLER WEATHER SUNNY (CLOUD) COUNTY SANDUSKY

R.C. RHOADES ✓ TEMP. 50°F 46° TOWNSHIP GREEN CREEK

SECTION 20

T 4 N R 16 E

TYPE MONUMENT 1 1/2" PIPE ✓


ON SURFACE - BELOW ON 3"

~~LEFT~~ - Q PAV'T - RIGHT 24.5'

- TO - EDGE PAVEMENT

S.L.M. 133+99 296' to 7B


Grid: Northing: 593046.5905 Easting: 1817125.1845

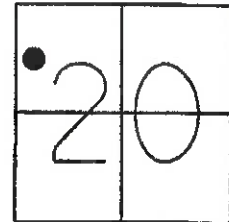

RECORD
 $\Delta=39^{\circ}13'00''$ LT R&M
 REF. FIELD BOOK #55
 SEE NOTE ON SHEET #15
 REF#7-C
 1986

FD UNDISTURBED
 9-17-02, DCH


~~FD 1 1/2" PIPE~~
 1.5' PIPE
 GPS, REFA7
 4-15-16, JFO
 FD 1 1/2" PIPE
 3" DOWN
 REFA7
 12-21-23, JAM

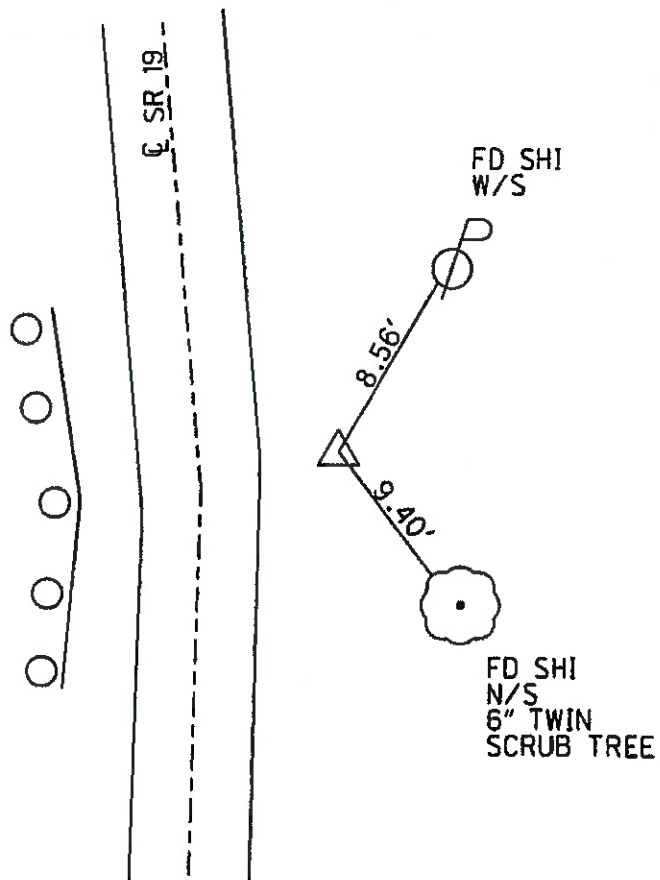

O.D.O.T. DISTRICT 2 SURVEY OFFICE (USE ONLY)

PERSONNEL _____ REFERENCE NO. 7 B SHEET 17 OF 33
 NOTES RHOADES ✓ DATE 4-15-16 12-21-23 ROUTE SR 19
 H.C. O'DONNELL MILLER WEATHER SUNNY CLOUDY COUNTY SANDUSKY
 R.C. RHOADES ✓ TEMP. 50°F 46' TOWNSHIP GREEN CREEK
 SECTION 20
 T 4 N R 16 E

TYPE MONUMENT MAG/WASHER MAG SHANK
 ON SURFACE - ~~BELOW~~ ON ✓
~~LEFT~~ Q PAV'T - RIGHT 8.5'
 - TO - EDGE PAVEMENT
 S.L.M. 136+95 586' to 7C

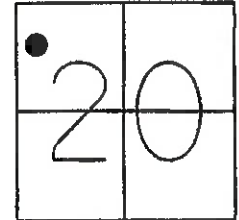

Grid: Northing: 593323.0123 Easting: 1817111.9249


RECORD:
 $\Delta=17^{\circ}27'00''$ LT R&M
 PI 20+64.35
 REF FIELD BOOK #55
 SEE NOTE ON SHEET #15
 REF. #7-C
 1986

SET MAG/WASHER
 9-17-02, DCH

FD MAG/WASHER
 GPS, REFB7
 4-15-16, JFO

POINT
 UNCOVERED
 9-2-16

FD MAG SHANK
REF 7B
12-21-23, JAM

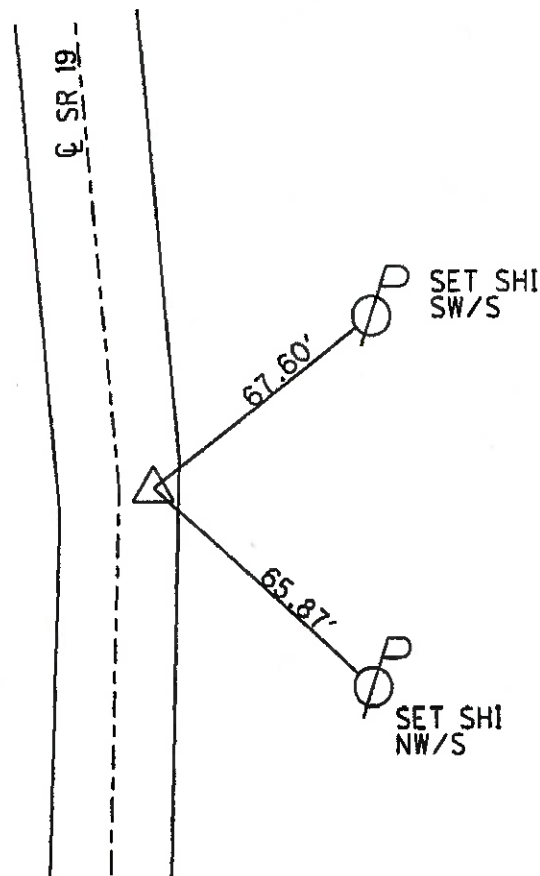


O.D.O.T. DISTRICT 2 SURVEY OFFICE (USE ONLY)

PERSONNEL _____ REFERENCE NO. 7-C SHEET 18 OF 33
 NOTES RHOADES ✓ DATE 4-15-16 12-21-23 ROUTE SR 19
 H.C. O'DONNELLY MILF WEATHER SUNNY CLOUDY COUNTY SANDUSKY
 R.C. RHOADES ✓ TEMP. 50°F 46° TOWNSHIP GREEN CREEK
 SECTION 20
 T 4 N R 16 E

TYPE MONUMENT 1 1/4" IPIPE ✓
 ON SURFACE - BELOW ON 3"
 LEFT - ℄ PAV'T - RIGHT 18'
 - TO - EDGE PAVEMENT
 S.L.M. 142+76 1468 to 8

Grid: Northing: 593900.2573 Easting: 1816892.5051

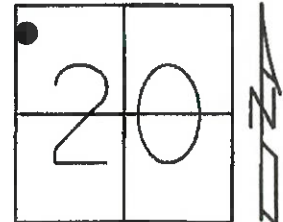


RECORD:
 $\Delta = 20^{\circ}08'00''$ RT REC.
 PI 26+44.80
 REF. FIELD BOOK #55
 CONTROL POINTS NO. 10 THRU 15
 MAY HAVE TO BE RETURN AS A
 DISCREPANCY EXIST BETWEEN
 REFS #15 & #16
 1986

FD UNDISTURBED
 09-17-02, DCH

FD 1" IPIPE
 3" DOWN
 GPS, REFC7
 4-15-16, JFO

POINT
 NOT COVERED
 9-2-16

FD 1 1/4" IPIPE
 BENT WESTERLY
 REF 7C
 12-21-23, JAM

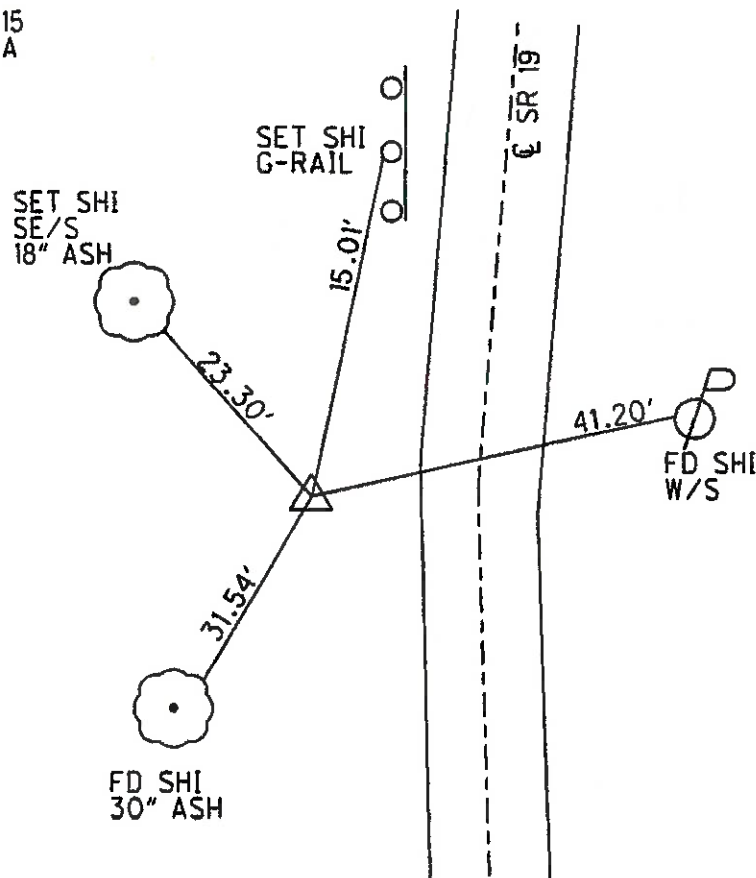

O.D.O.T. DISTRICT 2 SURVEY OFFICE (USE ONLY)

PERSONNEL _____ REFERENCE NO. 8 SHEET 19 OF 33
 NOTES RHOADES DATE 4-25-16 ROUTE SR 19
 H.C. O'DONNELL WEATHER CLOUDY COUNTY SANDUSKY
 R.C. RHOADES TEMP. 62°F TOWNSHIP GREEN CREEK
 SECTION 17 18 19 20
 T 4 N R 16 E

TYPE MONUMENT PK/WASHER
~~ON SURFACE~~ - BELOW 3.5"
 LEFT - ℄ PAV'T - ~~RIGHT~~ 1.3'
 - TO - EDGE PAVEMENT
 S.L.M. 157+44 1480' to 8A

18	17
19	20

Grid: Northing: 595364.7286 Easting: 1816860.1145


RECORD:
 $\Delta=02^{\circ}26'00"$ RT REC.
 PI 41+21.90
 PK/WASHER
 ATOP PK/WASHER
 ATOP RR. SPK
 REF. FIELD BOOK #55

SET MAG/WASHER
 09-17-02, DCH

FD PK/WASHER
 3.5" DOWN
 GPS, REF8
 4-25-16

FND PK/WASHER
 9-2-16

FD P.K. NAIL
 1" DOWN
 SEC 20 NW
 12-15-23, JAM

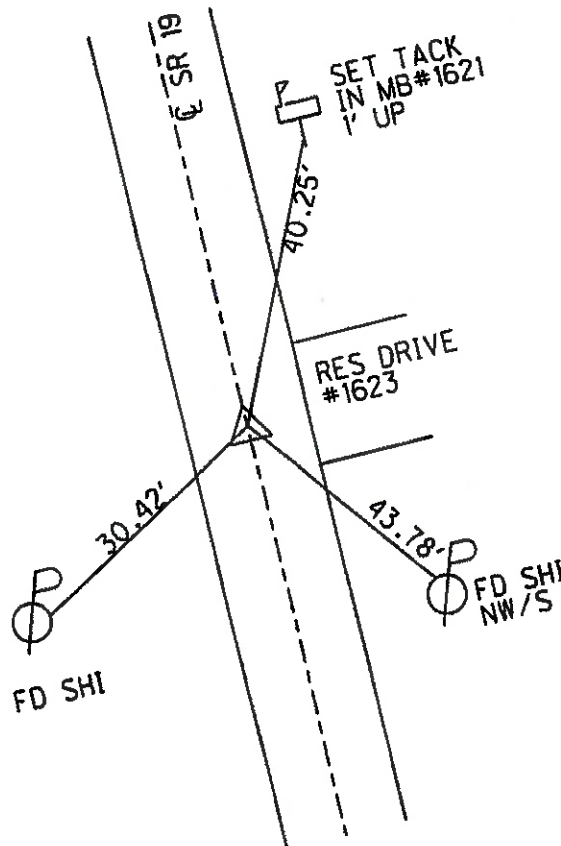

O.D.O.T. DISTRICT 2 SURVEY OFFICE (USE ONLY)

PERSONNEL

REFERENCE NO.

8 A

SHEET 20 OF 33

NOTES RHOADES

DATE

4-25-16

ROUTE SR 19

H.C. O'DONNELL

WEATHER

CLOUDY

COUNTY SANDUSKY

R.C. RHOADES

TEMP.

62°F

TOWNSHIP GREEN CREEK

SECTION 18

T 4 N R 16 E

TYPE MONUMENT HARROW TOOTH


ON SURFACE - ~~BELOW~~ ON

~~LEFT~~ - C PAV'T - RIGHT 13.6'

- TO - EDGE PAVEMENT

S.L.M. 172+24

Grid: Northing: - Easting: -

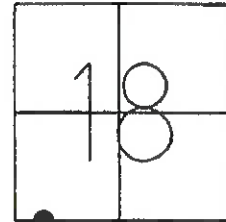

RECORD:

$\Delta=20^{\circ}32'00''$ LT REC.

PI 55+93.45

REF. FIELD BOOK #55

1986

DID NOT FIND

4-10-02

4-25-16

9-2-16

