


# PLAT of SURVEY 4

FOR OSCAR MAPUS

PART SE 1/4, SEC. 18; PART NE 1/4, SEC. 19; PART W 1/2, NW 1/4, SEC. 20, TAN-RIDGE  
GREEN CREEK TOWNSHIP, SANDUSKY COUNTY, OHIO

DEC. 1991 - OCT. 1992

15-207

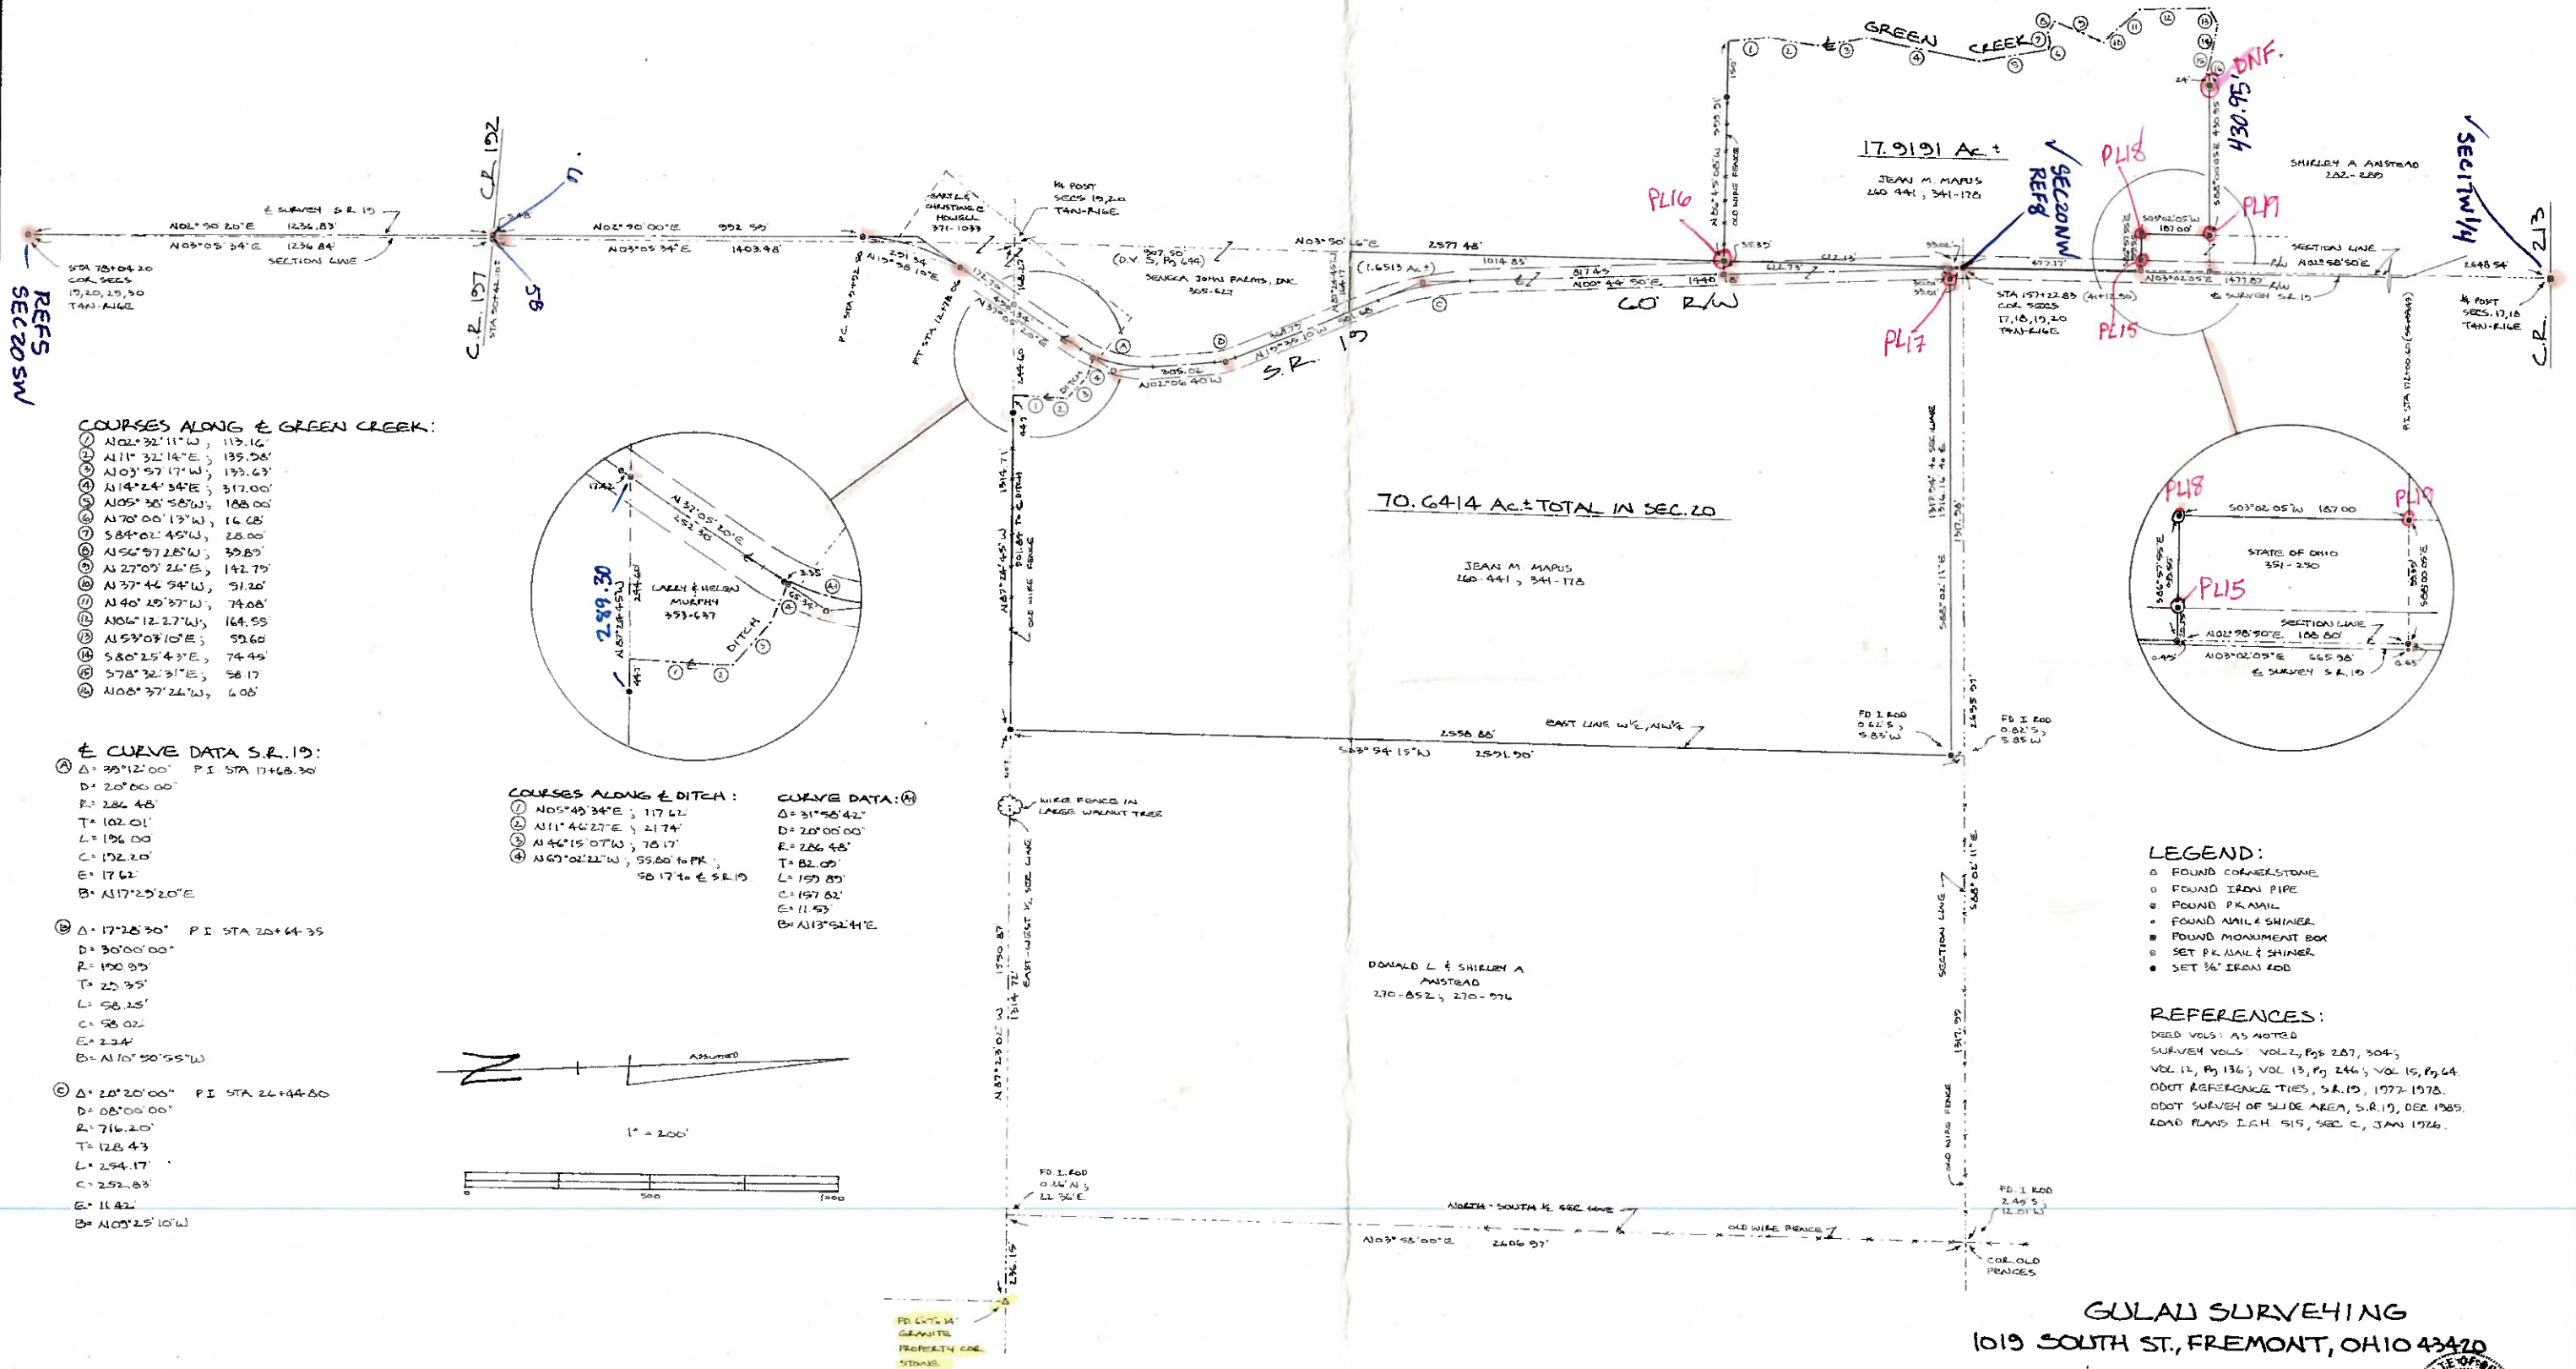

GULAU SURVEYING  
1019 SOUTH ST., FREMONT, OHIO 43420

DAVID W. GULAU, SUR #6727

