


LOCATION MAP

LATITUDE: 41°14'9" N LONGITUDE: 81°37'41" W

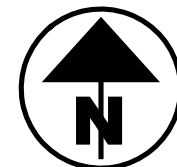

PORTION TO BE IMPROVED: INTERSTATE HIGHWAY, FEDERAL ROUTES, STATE ROUTES, COUNTY & TOWNSHIP ROADS, OTHER ROADS

DESIGN EXCEPTIONS

Table with columns: DESIGN FEATURE, APPROVAL DATE, SHEET NUMBERS. Rows include SUPERELEVATION RATE and SHOULDER WIDTH.

ADA DESIGN WAIVERS

N/A

STATE OF OHIO DEPARTMENT OF TRANSPORTATION SUM-77-28.75 VILLAGE OF RICHFIELD RICHFIELD TOWNSHIP SUMMIT COUNTY

FEDERAL PROJECT NUMBER

E200136

RAILROAD INVOLVEMENT

NONE

PROJECT DESCRIPTION

THIS PROJECT INCLUDES THE FULL REMOVAL AND REPLACEMENT OF THE ORIGINAL PAVEMENT ON IR-77 AND WIDENING TO SIX LANES FROM SLM 28.75 TO SLM 33.06 IN SUMMIT COUNTY, OHIO. COMPLETE REMOVAL AND REPLACEMENT OF ALL FOUR INTERCHANGE RAMPS AT SR-176 (WHEATLEY ROAD), THE FOUR RAMP TERMINALS AT IR-271, AND NORTHBOUND OFF RAMP WITH SR -21 (BRECKSVILLE ROAD). THE PROJECT ALSO INCLUDES THE WIDENING OF SIX MAINLINE BRIDGES (SUM-77-3069 L/R, SUM-77-3187 L/R, AND SUM-77-3197 L/R). IN ADDITION, GENERAL GRADING, MEDIAN DRAINAGE, GUARDRAIL, MEDIAN CABLE BARRIER AND TRAFFIC CONTROL IMPROVEMENTS ARE BEING MADE. CULVERT REHABILITATION UNDER IR-77 WILL BE COMPLETED BY THE PROJECT.

EARTH DISTURBED AREAS

PROJECT EARTH DISTURBED AREA: 99.9 ACRES ESTIMATED CONTRACTOR EARTH DISTURBED AREA: 1.0 ACRES NOTICE OF INTENT EARTH DISTURBED AREA: 100.9 ACRES

LIMITED ACCESS

THIS IMPROVEMENT IS ESPECIALLY DESIGNED FOR THROUGH TRAFFIC AND HAS BEEN DECLARED A LIMITED ACCESS HIGHWAY OR FREEWAY BY ACTION OF THE DIRECTOR IN ACCORDANCE WITH THE PROVISIONS OF SECTION 5511.02 OF THE OHIO REVISED CODE.

2019 SPECIFICATIONS

THE STANDARD SPECIFICATIONS OF THE STATE OF OHIO, DEPARTMENT OF TRANSPORTATION, INCLUDING SUPPLEMENTAL SPECIFICATIONS LISTED IN THE PLANS AND CHANGES LISTED IN THE PROPOSAL SHALL GOVERN THIS IMPROVEMENT.

I HEREBY APPROVE THESE PLANS AND DECLARE THAT THE MAKING OF THIS IMPROVEMENT WILL NOT REQUIRE THE CLOSING TO TRAFFIC OF THE HIGHWAY EXCEPT FOR SR-21 AND ENTRANCE RAMP AS DESCRIBED ON SHEET 25 AND AS SHOWN ON SHEETS 46 & 50, AND THAT PROVISIONS FOR THE MAINTENANCE AND SAFETY OF TRAFFIC WILL BE AS SET FORTH ON THE PLANS AND ESTIMATES.

INDEX OF SHEETS:

Table listing sheet titles and numbers, including Title Sheet, Schematic Plan, Interchange Geometrics, Typical Sections, etc.

Professional Engineer seals for Roadway, Drainage, Lighting, and Bridge disciplines, including names like Daniel R. Jozity, Matthew Hebebrand, Matthew J. Burger, Eric F. Dues, and Ryan Jacob Brinkman.

* - SEE PROPOSAL FOR REVISION DATE


UNDERGROUND UTILITIES Contact Two Working Days Before You Dig OHIO811.org Before You Dig OHIO811, 8-1-1, or 1-800-362-2764 (Non members must be called directly)

PLAN PREPARED BY: GANNETT FLEMING 2500 CORPORATE EXCHANGE DR, SUITE 230 COLUMBUS, OHIO 43231

Main project sheet index table with columns for sheet numbers, descriptions, and specifications.

DISTRICT DEPUTY DIRECTOR (Signature) APPROVED (Signature) DIRECTOR, DEPARTMENT OF TRANSPORTATION

DESIGN AGENCY: GANNETT FLEMING 2500 Corporate Exchange Dr. Suite 230 Columbus, OH 43231 DESIGNER: TQD REVIEWER: DRJ 10/5/2022 PROJECT ID: 111405 SHEET TOTAL: 1 927

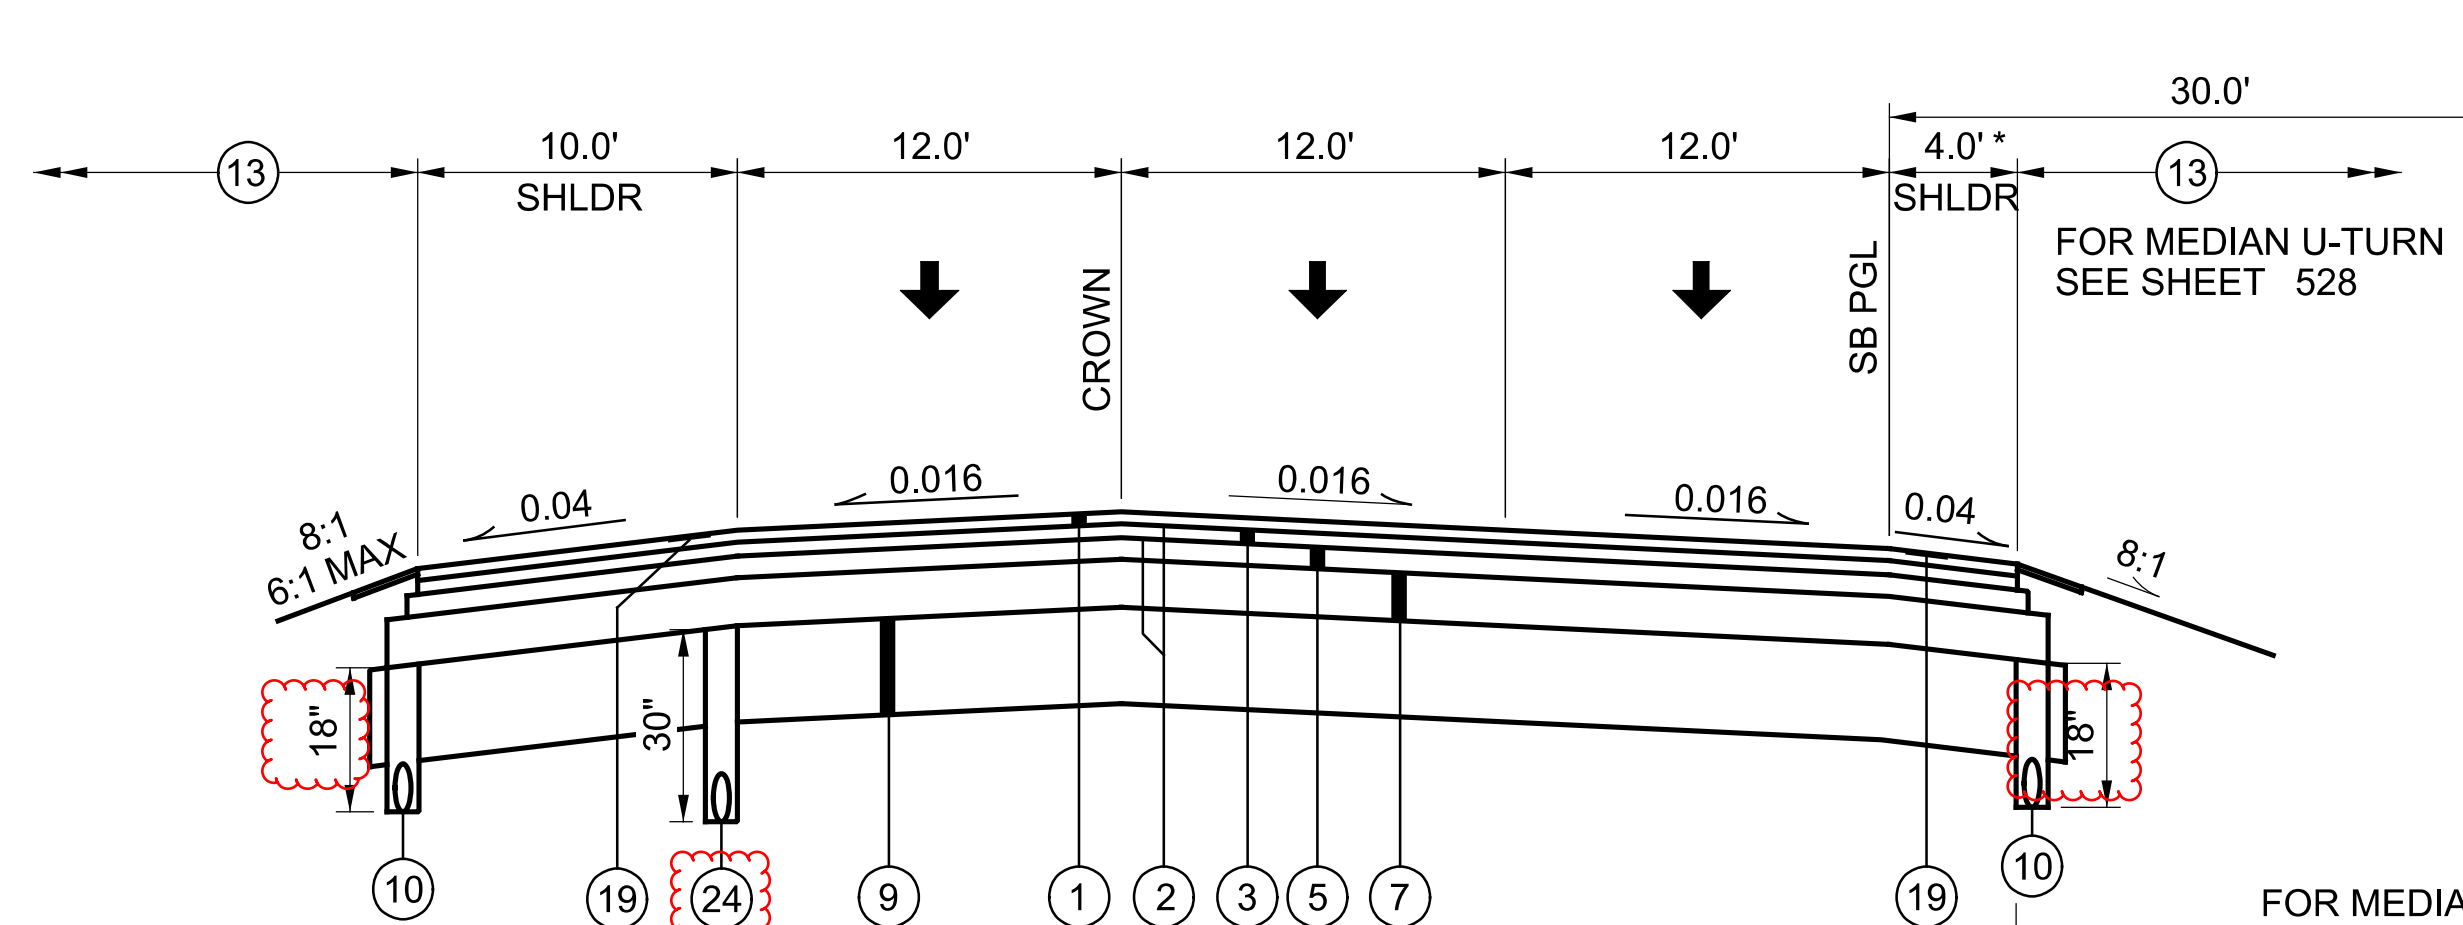

CONSTRUCTION IR-77

*(NDC = 10')

FOR MEDIAN U-TURN SEE SHEET 528

FOR MEDIAN GRADING SEE SHEET 17 TO 18





COMPACTED AGGREGATE ADJACENT TO PAVED SHOULDER WITHOUT GUARDRAIL

BASE AND SUBBASE STEP DETAIL

CEMENT STABILIZATION DETAIL

PROPOSED NORMAL SECTION - IR-77 SOUTHBOUND


STA 842+00.00 TO STA 956+56.67
 STA 958+47.31 TO STA 1005+52.73
 STA 1007+37.54 TO STA 1011+01.49
 STA 1013+12.51 TO STA 1023+50.00

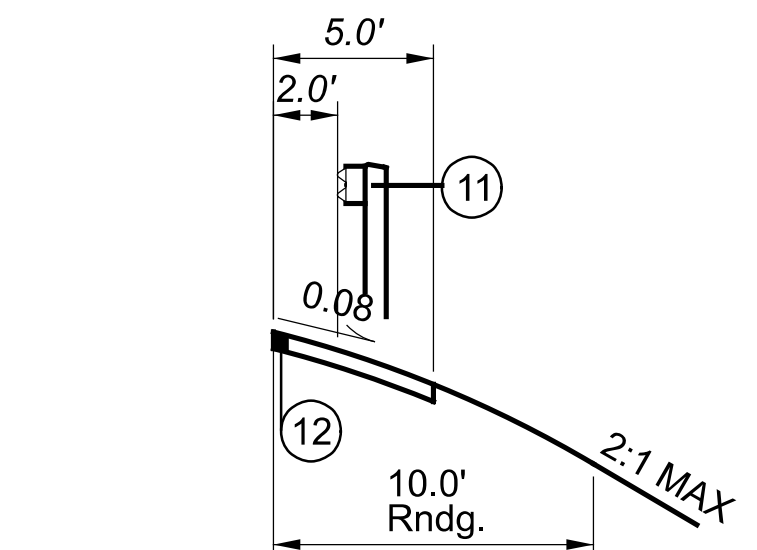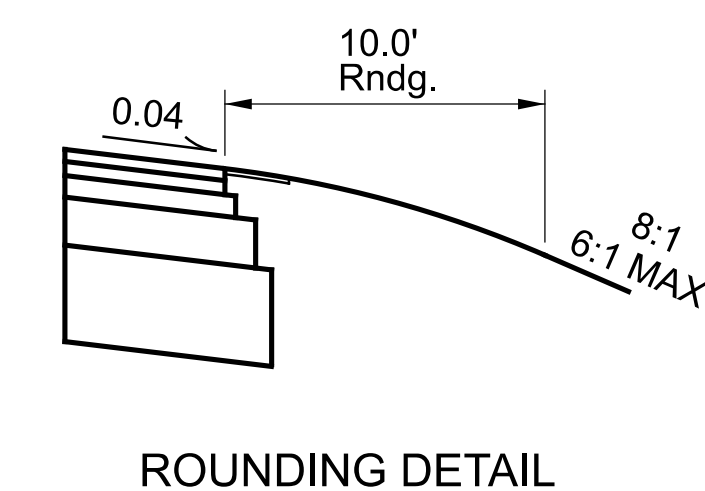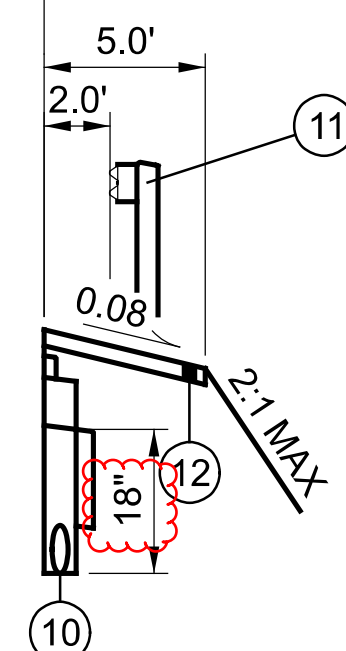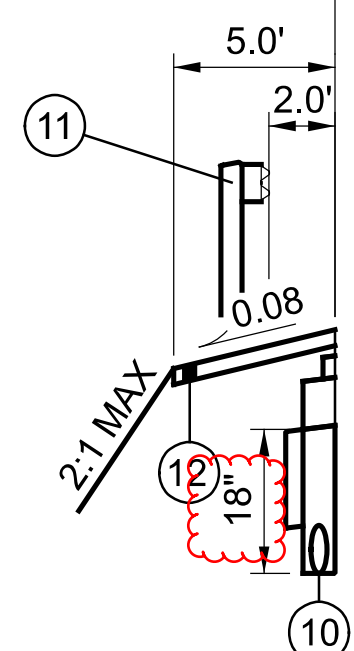


BENCHING OF FOUNDATION SLOPES

| | SHOULDER | WIDTH |
|---------------|--------------------------------|----------------|
| A | STA 905+26.51 TO STA 911+48.89 | 8.0' |
| | STA 934+46.61 TO STA 939+24.09 | 8.0' |
| | STA 939+24.09 TO STA 940+24.09 | 8.0' TO 10.0' |
| B | AUX LANE | WIDTH |
| | STA 905+26.51 TO STA 911+48.89 | 16.0' |
| IR-271 RAMP A | WIDTH | |
| | STA 934+46.61 TO STA 936+17.09 | 16.0' to 12.0' |
| | STA 936+17.09 TO STA 939+24.09 | 12.0' |
| | STA 939+24.09 TO STA 940+24.09 | 12.0' to 0.0' |

AUX LANE - STA 905+26.51 TO STA 911+48.89
 IR-271 RAMP A - STA 934+46.61 TO STA 940+24.09

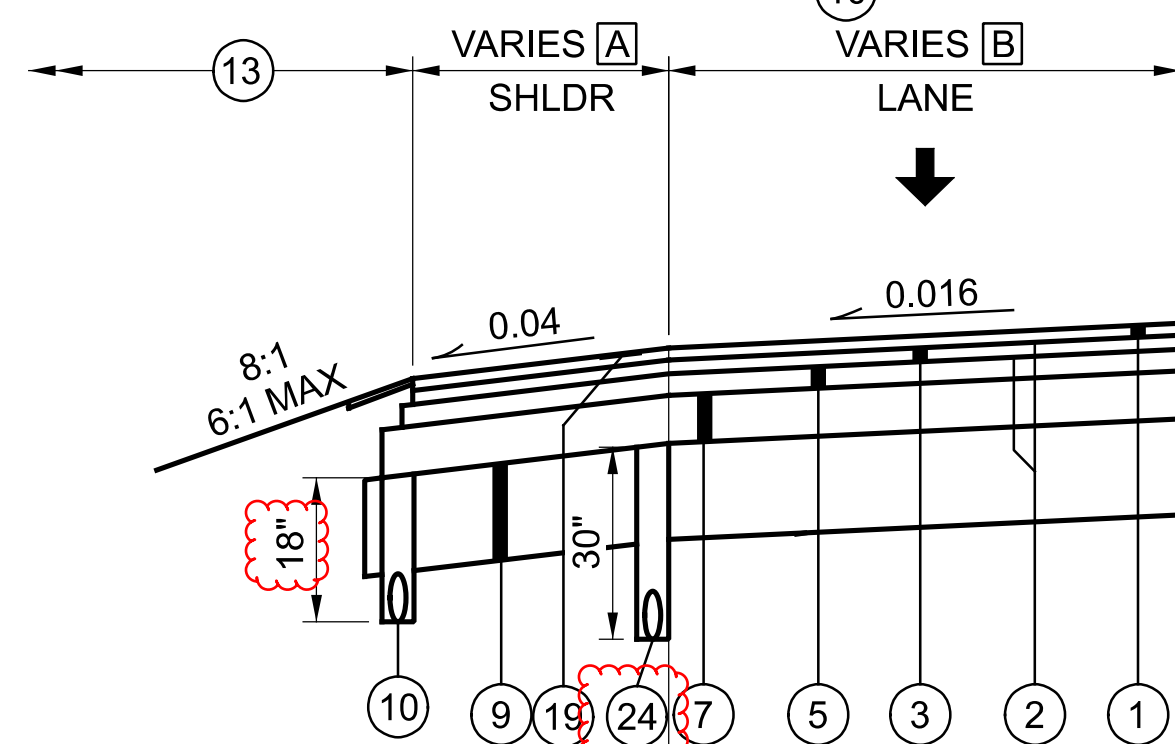

SR-176 RAMP A - STA 860+95.13 TO STA 876+51.88
 SR-176 RAMP B - STA 901+18.26 TO STA 905+26.51
 IR-271 RAMP D - STA 911+74.88 TO STA 920+25.60
 IR-271 RAMP A - STA 931+74.88 TO STA 934+46.61

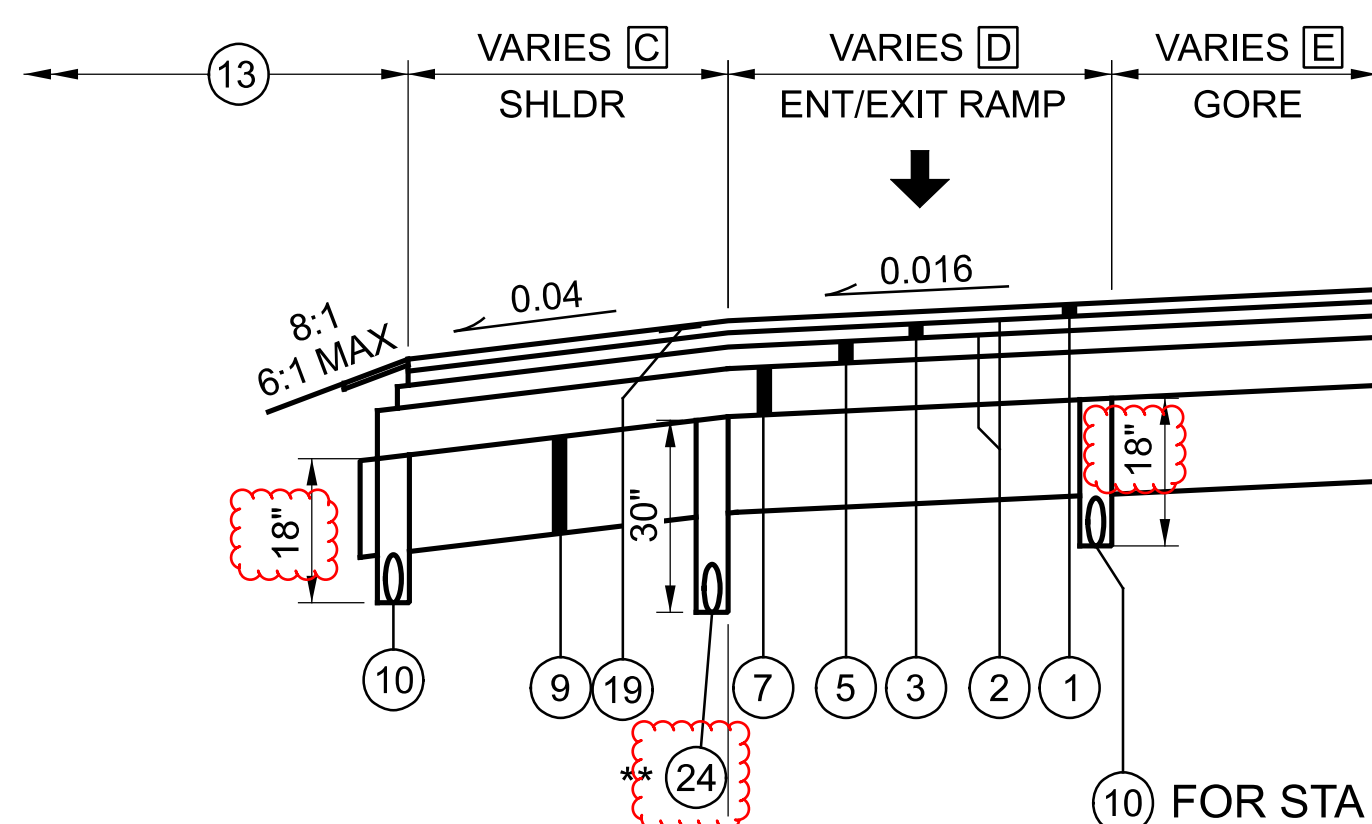

FOR STA 914+15.00 TO STA 920+25.00

** SEE DRAINAGE DETAILS SHEET 562 FOR UNDERDRAIN LOCATION

STA 918+43.66 TO STA 918+93.55 (8.0' TO 6.0' SHLDR)
 STA 918+93.55 TO STA 920+25.60 (6.0' SHLDR)


| | SHOULDER | WIDTH |
|--------------------------------|--------------------------------|---------------|
| C | STA 860+95.13 TO STA 861+95.13 | 10.0' TO 8.0' |
| | STA 861+95.13 TO STA 873+45.13 | 8.0' |
| | STA 873+45.13 TO STA 873+95.13 | 8.0' TO 6.0' |
| | STA 873+95.13 TO STA 876+51.88 | 6.0' |
| D | SR-176 RAMP A | WIDTH |
| | STA 860+95.13 TO STA 868+95.29 | 0.0' TO 16.0' |
| | STA 868+95.29 TO STA 876+51.88 | 16.0' |
| | SR-176 RAMP B | WIDTH |
| STA 901+18.26 TO STA 905+26.51 | 16.0' | |
| E | IR-271 RAMP D | WIDTH |
| | STA 911+48.89 TO STA 920+25.60 | 16.0' |
| | IR-271 RAMP A | WIDTH |
| | STA 931+74.88 TO STA 934+46.61 | 16.0' |
| SR-176 RAMP A GORE | WIDTH | |
| | STA 868+95.29 TO STA 876+51.88 | 0.0' TO 23.0' |
| | SR-176 RAMP B | WIDTH |
| | STA 901+18.26 TO STA 905+26.51 | 23.0' TO 0.0' |
| IR-271 RAMP D | WIDTH | |
| | STA 911+48.89 TO STA 915+98.80 | 0.0' TO 9.0' |
| | STA 915+98.80 TO STA 918+43.66 | 9.0' |
| | STA 918+43.66 TO STA 920+25.60 | 9.0' TO 23.0' |
| IR-271 RAMP A | WIDTH | |
| | STA 931+74.88 TO STA 934+46.61 | 23.0' TO 0.0' |

PROPOSED PAVEMENT LEGEND

- ① ITEM 442 - 1 1/2" ASPHALT CONCRETE SURFACE COURSE, 12.5mm, TYPE A (447), PG70-22, AS PER PLAN
- ② ITEM 407 - NON-TRACKING TACK COAT (0.055 GAL/SY)
- ③ ITEM 442 - 1.75" ASPHALT CONCRETE INTERMEDIATE COURSE, 12.5mm, TYPE A (446)
- ④ ITEM 526 - REINFORCED CONCRETE APPROACH SLAB WITH QC/QA (T=15"), AS PER PLAN
- ⑤ ITEM 302 - 7.5" ASPHALT CONCRETE BASE, PG 64-22, (449), AS PER PLAN
- ⑥ ITEM 452 - 11.5" NON-REINFORCED CONCRETE PAVEMENT, CLASS QC1P, AS PER PLAN
- ⑦ ITEM 304 - 6" AGGREGATE BASE
- ⑧ ITEM 206 - CEMENT STABILIZATION (14" DEEP) (5% SPREAD RATE AT 115 LBS/CUBIC FOOT DRY UNIT WEIGHT)
- ⑨ ITEM 206 - CEMENT STABILIZATION (12" DEEP) (5% SPREAD RATE AT 115 LBS/CUBIC FOOT DRY UNIT WEIGHT)
- ⑩ ITEM 605 - 6" BASE PIPE UNDERDRAINS WITH GEOTEXTILE FABRIC
- ⑪ ITEM 606 - GUARDRAIL, TYPE MGS
- ⑫ ITEM 441 - 2" ASPHALT CONCRETE INTERMEDIATE COURSE, TYPE 1, (449), (UNDER GUARDRAIL), AS PER PLAN
- ⑬ ITEM 659 - SEEDING AND MULCHING
- ⑭ ITEM 622 - CONCRETE BARRIER, TYPE D
- ⑮ ITEM 606 - CABLE BARRIER WITH CONCRETE LINE POST FOUNDATION
- ⑯ ITEM 441 - 1 1/2" ASPHALT CONCRETE SURFACE COURSE, TYPE 1, (446), PG64-22, AS PER PLAN
- ⑰ ITEM 441 - 1.75" ASPHALT CONCRETE INTERMEDIATE COURSE, TYPE 2, (446)
- ⑱ ITEM 302 - 6" ASPHALT CONCRETE BASE, PG 64-22 (449)
- ⑲ ITEM 618 - RUMBLE STRIPS (ASPHALT CONCRETE)
- ⑳ ITEM 609 - CURB, TYPE 4-C
- ㉑ ITEM 609 - 6" CONCRETE TRAFFIC ISLAND
- ㉒ ITEM 408 - PRIME COAT, AS PER PLAN
- ㉓ ITEM 617 - 2" COMPACTED AGGREGATE, AS PER PLAN
- ㉔ ITEM 605 - 6" SHALLOW PIPE UNDERDRAIN WITH GEOTEXTILE FABRIC


PGL = PROFILE GRADE LINE

FOR UNDERDRAIN DETAILS, SEE SHEETS 562 - 563

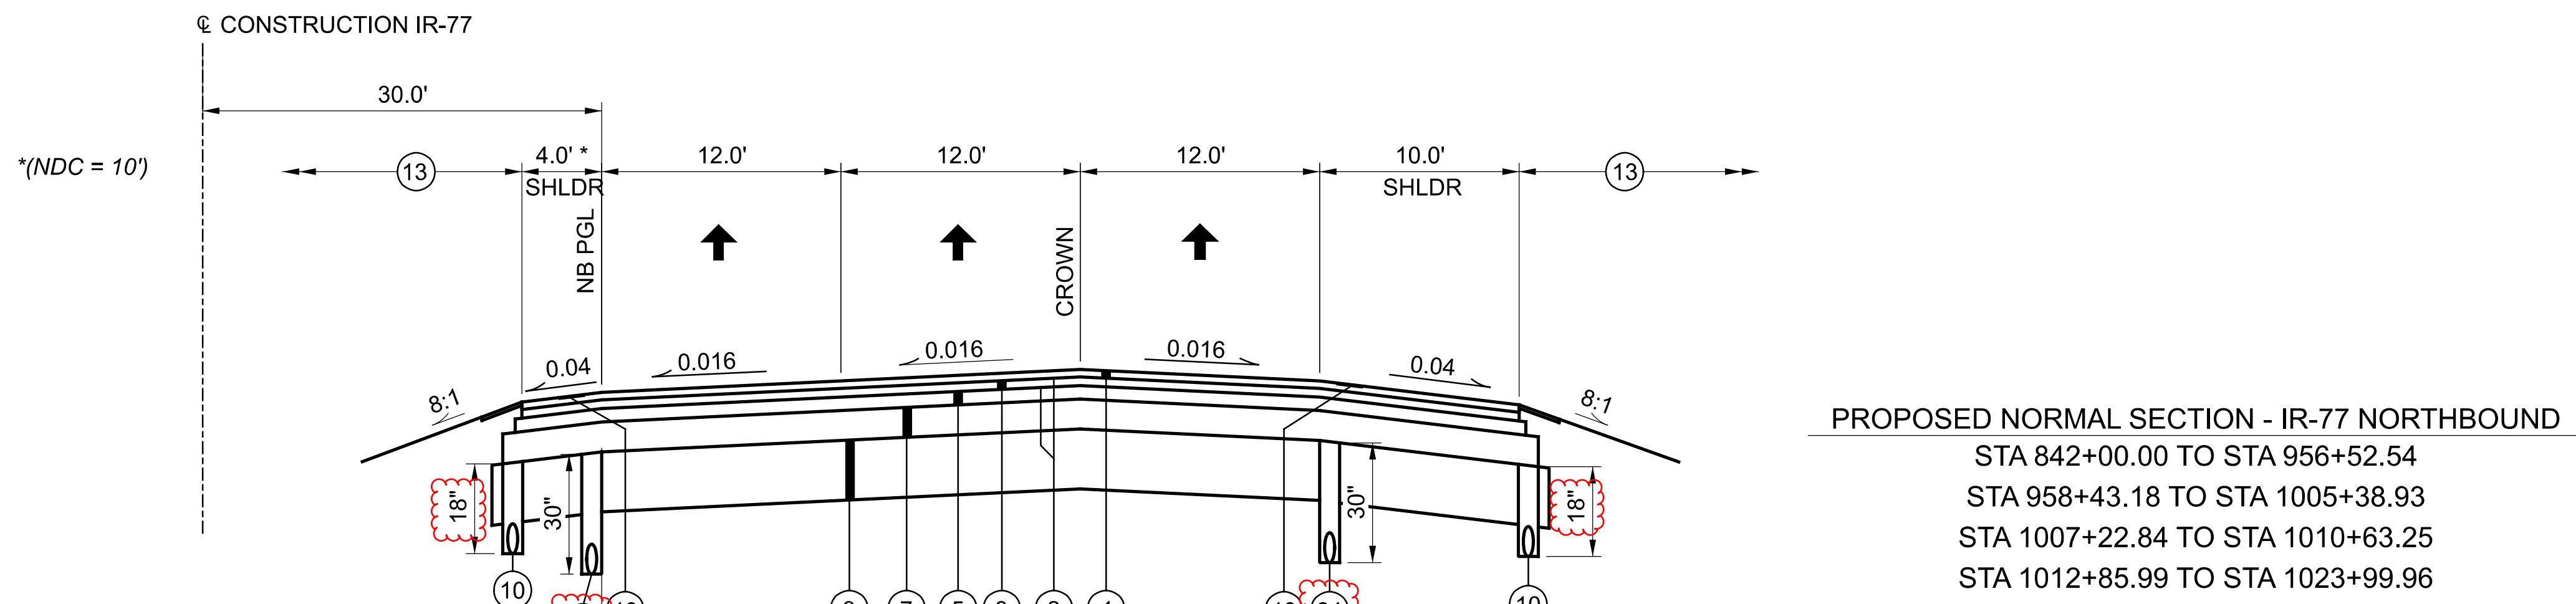

PROPOSED NORMAL SECTION - IR-77 NORTHBOUND

STA 842+00.00 TO STA 956+52.54
STA 958+43.18 TO STA 1005+38.93
STA 1007+22.84 TO STA 1010+63.25
STA 1012+85.99 TO STA 1023+99.96

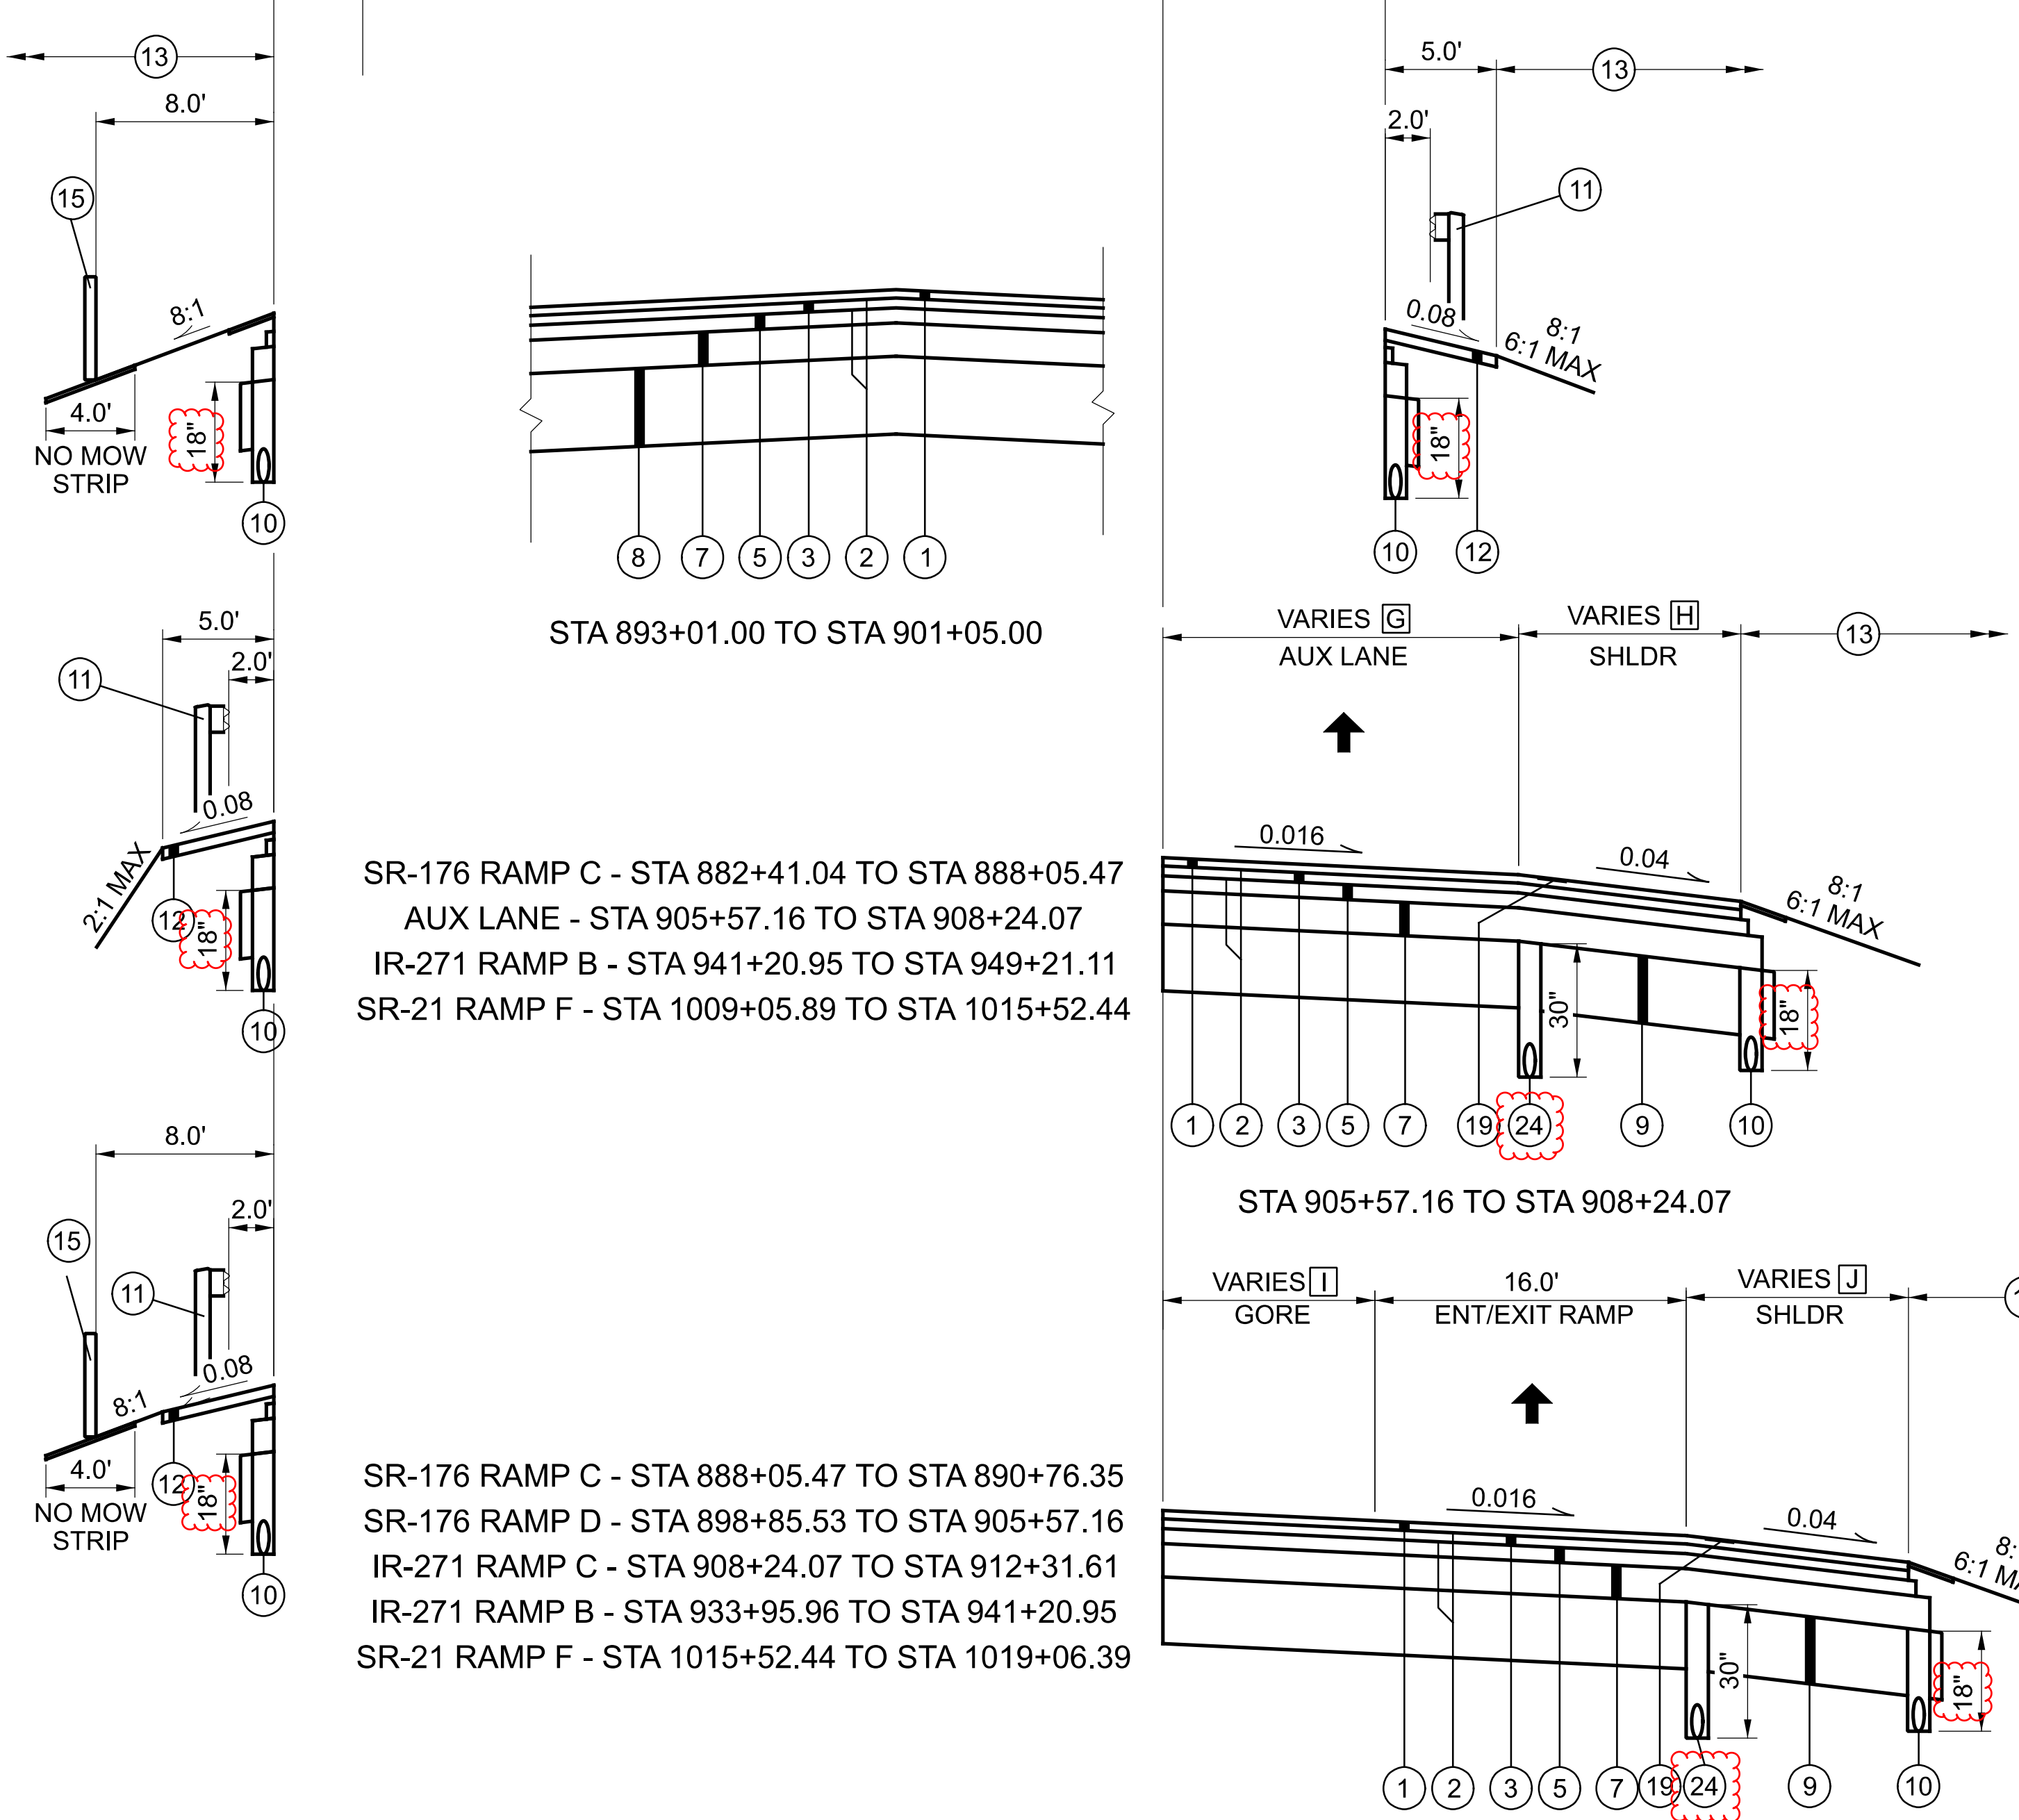


| SR-176 RAMP C | WIDTH |
|----------------------------------|----------------|
| STA 882+41.04 TO STA 883+41.04 | 0.0' TO 12.0' |
| STA 883+41.04 TO STA 886+35.00 | 12.0' |
| STA 886+35.00 TO STA 888+05.47 | 12.0' TO 16.0' |
| AUX LANE | WIDTH |
| STA 905+57.16 TO STA 908+24.07 | 16.0' |
| IR-271 RAMP B | WIDTH |
| STA 941+20.95 TO STA 949+21.11 | 16.0' TO 0.0' |
| SR-21 RAMP F | WIDTH |
| STA 1009+05.89 TO STA 1010+06.39 | 0.0' TO 12.0' |
| STA 1010+06.39 TO STA 1013+32.51 | 12.0' |
| STA 1013+32.51 TO STA 1015+49.96 | 12.0' TO 16.0' |
| SHOULDER | WIDTH |
| STA 882+41.04 TO STA 883+41.04 | 10.0' TO 8.0' |
| STA 883+41.04 TO STA 888+05.47 | 8.0' |
| STA 905+57.16 TO STA 908+24.07 | 8.0' |
| STA 941+20.95 TO STA 948+21.11 | 8.0' |
| STA 948+21.11 TO STA 949+21.11 | 8.0' TO 10.0' |
| STA 1009+06.39 TO STA 1010+06.39 | 10.0' TO 8.0' |
| STA 1010+06.39 TO STA 1015+52.44 | 8.0' |

| SR-176 RAMP C | WIDTH |
|----------------------------------|---------------|
| STA 888+05.47 TO STA 890+76.35 | 0.0' TO 23.0' |
| SR-176 RAMP D | WIDTH |
| STA 898+85.53 TO STA 905+57.16 | 23.0' TO 0.0' |
| IR-271 RAMP C | WIDTH |
| STA 908+24.07 TO STA 912+31.61 | 0.0' TO 23.0' |
| IR-271 RAMP B | WIDTH |
| STA 933+95.96 TO STA 941+20.95 | 23.0' TO 0.0' |
| SR-21 RAMP F | WIDTH |
| STA 1015+52.44 TO STA 1019+06.39 | 0.0' TO 23.0' |
| SHOULDER | WIDTH |
| STA 888+05.47 TO STA 890+76.35 | 8.0' |
| STA 898+85.53 TO STA 900+56.98 | 6.0' |
| STA 900+56.98 TO STA 901+06.82 | 6.0' TO 8.0' |
| STA 908+24.07 TO STA 912+31.61 | 8.0' |
| STA 933+95.96 TO STA 936+21.11 | 6.0' |
| STA 936+21.11 TO STA 936+71.11 | 6.0' TO 8.0' |
| STA 936+71.11 TO STA 941+20.95 | 8.0' |
| STA 1015+52.44 TO STA 1019+06.39 | 8.0' |
| STA 1019+06.39 TO STA 1019+62.02 | 8.0' TO 6.0' |

SR-176 RAMP C - STA 882+41.04 TO STA 888+05.47
AUX LANE - STA 905+57.16 TO STA 908+24.07
IR-271 RAMP B - STA 941+20.95 TO STA 949+21.11
SR-21 RAMP F - STA 1009+05.89 TO STA 1015+52.44

SR-176 RAMP C - STA 888+05.47 TO STA 890+76.35
SR-176 RAMP D - STA 898+85.53 TO STA 905+57.16
IR-271 RAMP C - STA 908+24.07 TO STA 912+31.61
IR-271 RAMP B - STA 933+95.96 TO STA 941+20.95
SR-21 RAMP F - STA 1015+52.44 TO STA 1019+06.39

FOR COMPACTED AGGREGATE DETAIL, SEE SHEET 12
FOR BASE AND SUBBASE STEP DETAIL, SEE SHEET 12
FOR ROUNDING DETAIL, SEE SHEET 12
FOR BENCHING DETAIL, SEE SHEET 12
FOR PROPOSED PAVEMENT LEGEND, SEE SHEET 12
FOR UNDERDRAIN DETAILS, SEE SHEETS 562 - 563
FOR GUARDRAIL LOCATIONS, SEE SHEETS 202 - 232
FOR MEDIAN GRADING SEE SHEET 17 - 18.

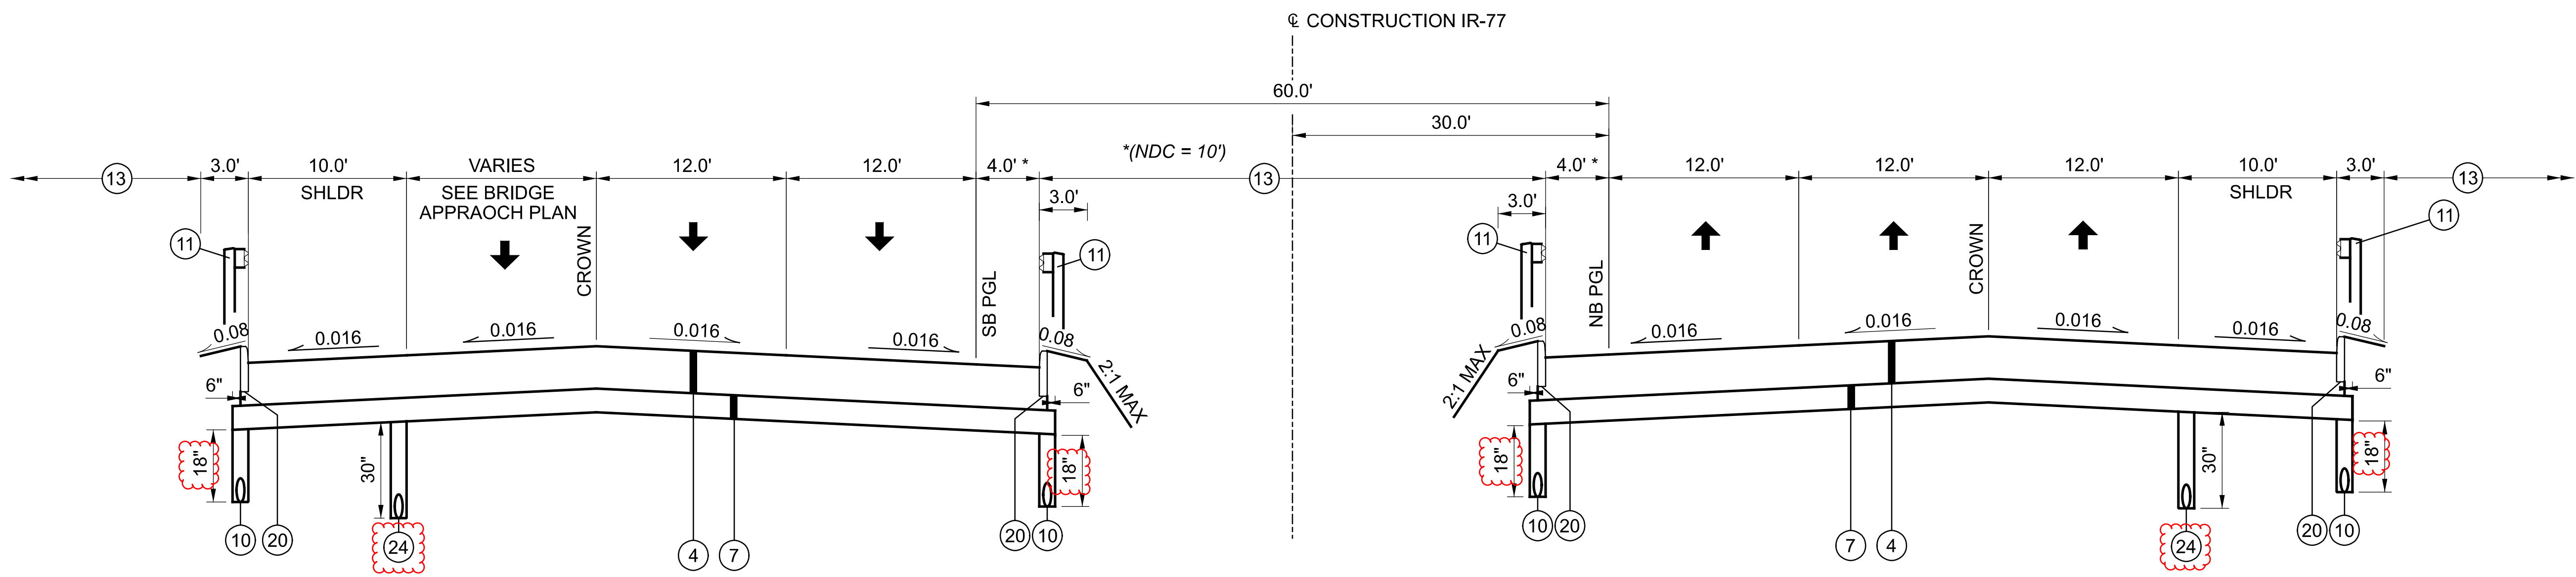


STA 956+56.67 TO STA 956+81.67
 BRIDGE LIMITS: STA 956+81.67 TO STA 958+22.31
 STA 958+22.31 TO STA 958+47.31
 STA 1005+52.73 TO STA 1005+77.75
 BRIDGE LIMITS: STA 1005+77.75 TO STA 1007+12.44
 STA 1007+12.44 TO STA 1007+37.54
 STA 1011+01.55 TO STA 1011+26.55
 BRIDGE LIMITS: STA 1011+26.55 TO STA 1012+87.46
 STA 1012+87.46 TO STA 1013+12.46

FOR MEDIAN GRADING SEE SHEET 17 TO 18 .

STA 956+52.54 TO STA 956+77.54
 BRIDGE LIMITS: STA 956+77.54 TO STA 958+18.18
 STA 958+18.18 TO STA 958+43.18
 STA 1005+38.93 TO STA 1005+63.83
 BRIDGE LIMITS: STA 1005+63.83 TO STA 1006+97.84
 STA 1006+97.84 TO STA 1007+22.84

PROPOSED APPROACH SLAB - IR-77

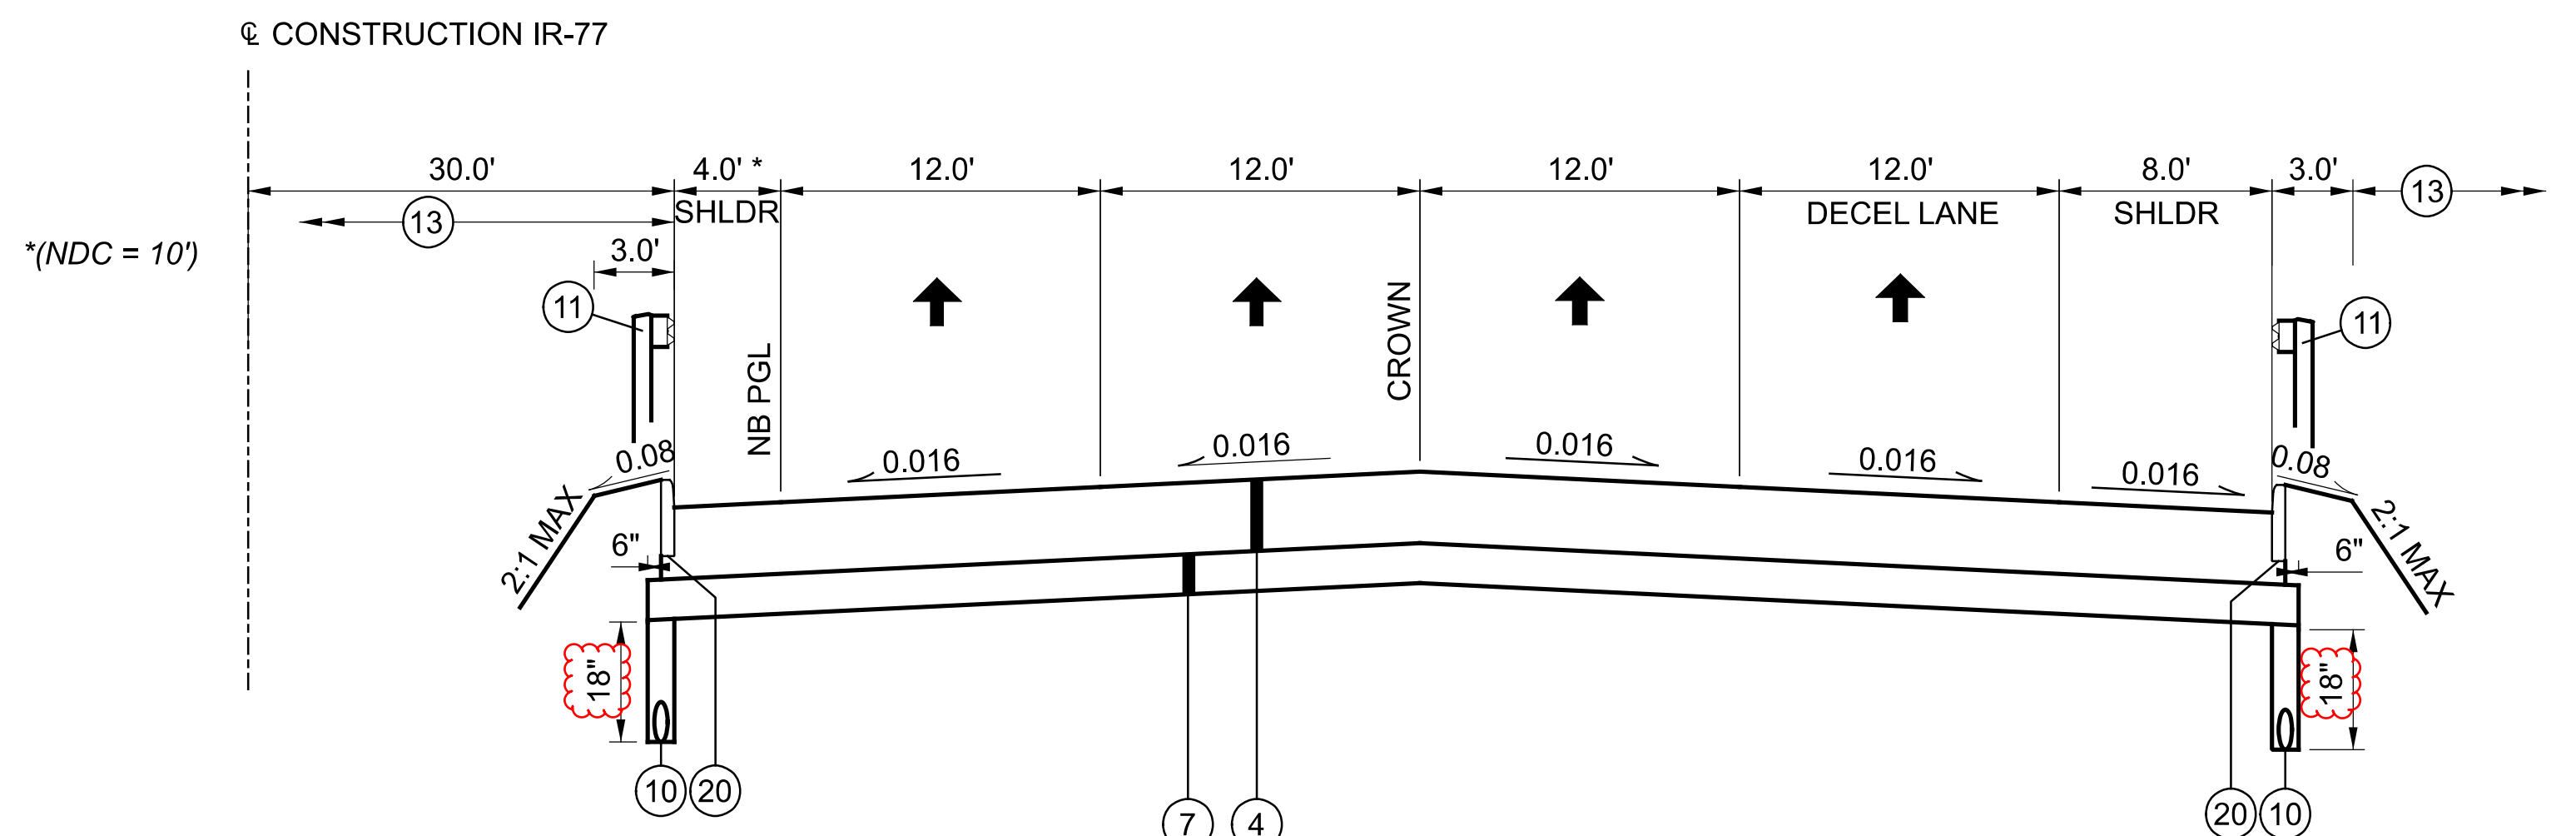


FOR MEDIAN GRADING SEE SHEET 17 TO 18 .

STA 1010+63.20 TO STA 1010+88.20
 BRIDGE: STA 1010+88.20 TO STA 1012+61.04
 STA 1012+61.04 TO STA 1012+86.04

PROPOSED APPROACH SLAB - IR-77

FOR COMPACTED AGGREGATE DETAIL, SEE SHEET 12
 FOR BASE AND SUBBASE STEP DETAIL, SEE SHEET 12
 FOR ROUNDING DETAIL, SEE SHEET 12
 FOR BENCHING DETAIL, SEE SHEET 12
 FOR PROPOSED PAVEMENT LEGEND, SEE SHEET 12
 FOR UNDERDRAIN DETAILS, SEE SHEETS 562 - 563

FOR GUARDRAIL LOCATIONS, SEE SHEETS 202 - 232

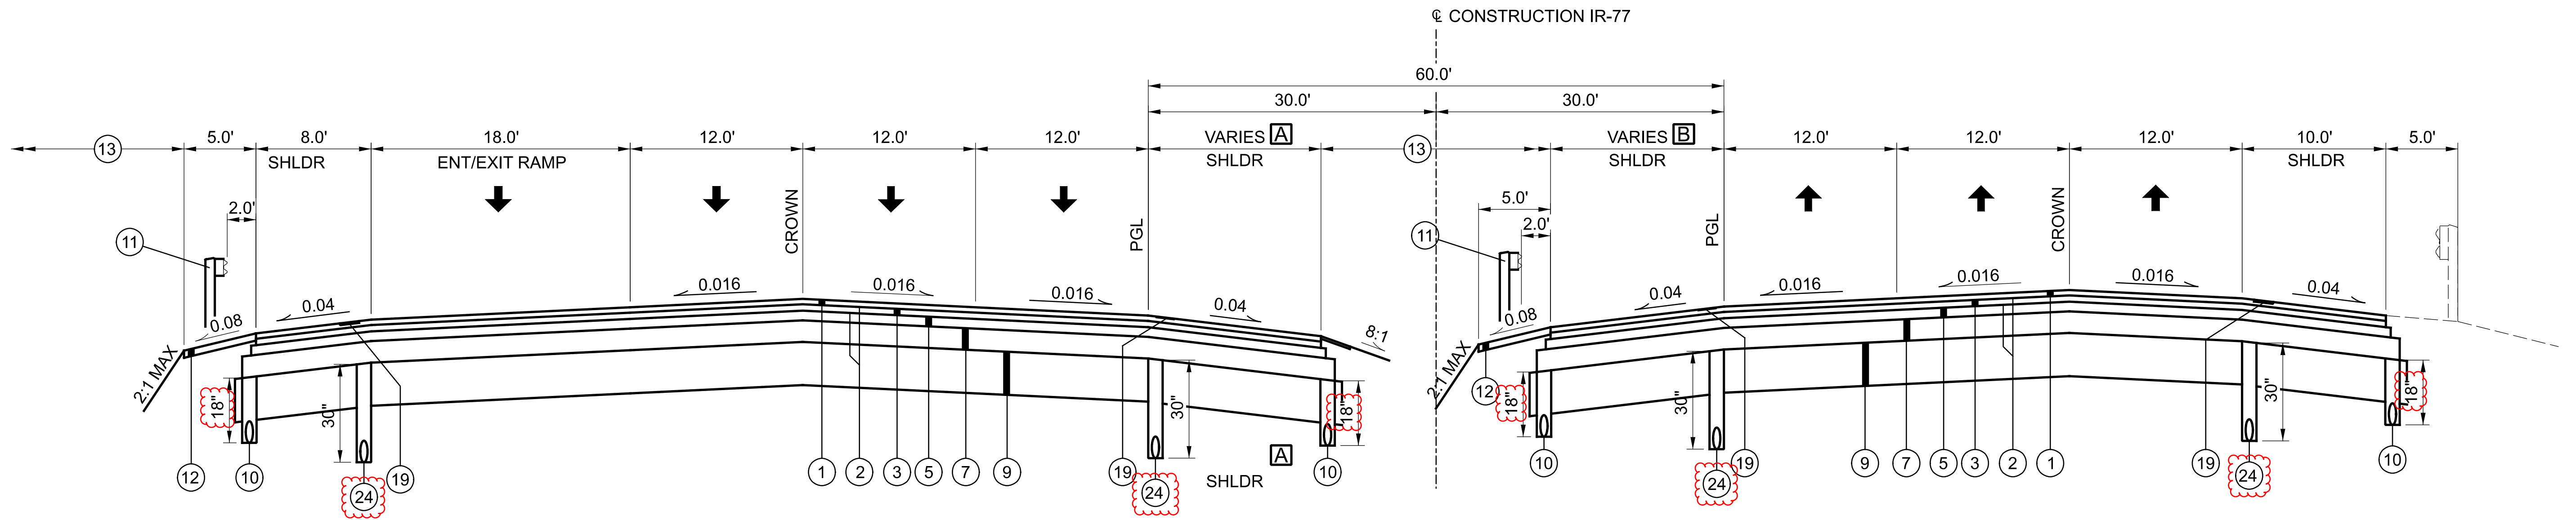


STA 1023+50.00 TO STA 1025+18.00

STA 1023+99.96 TO STA 1026+40.00

STA 1025+18.00 TO STA 1025+50.00
PROPOSED NORMAL SECTION - IR-77


*(NDC = 10')

- A** 4.0' TO 10.7' STA 1023+50.00 TO STA 1025+18.00
10.7' TO 12.0' STA 1025+18.00 TO STA 1025+50.00
- B** 4.0' TO 12.0' STA 1023+99.96 TO STA 1026+00.00
12.0' STA 1026+00.00 TO STA 1026+40.00

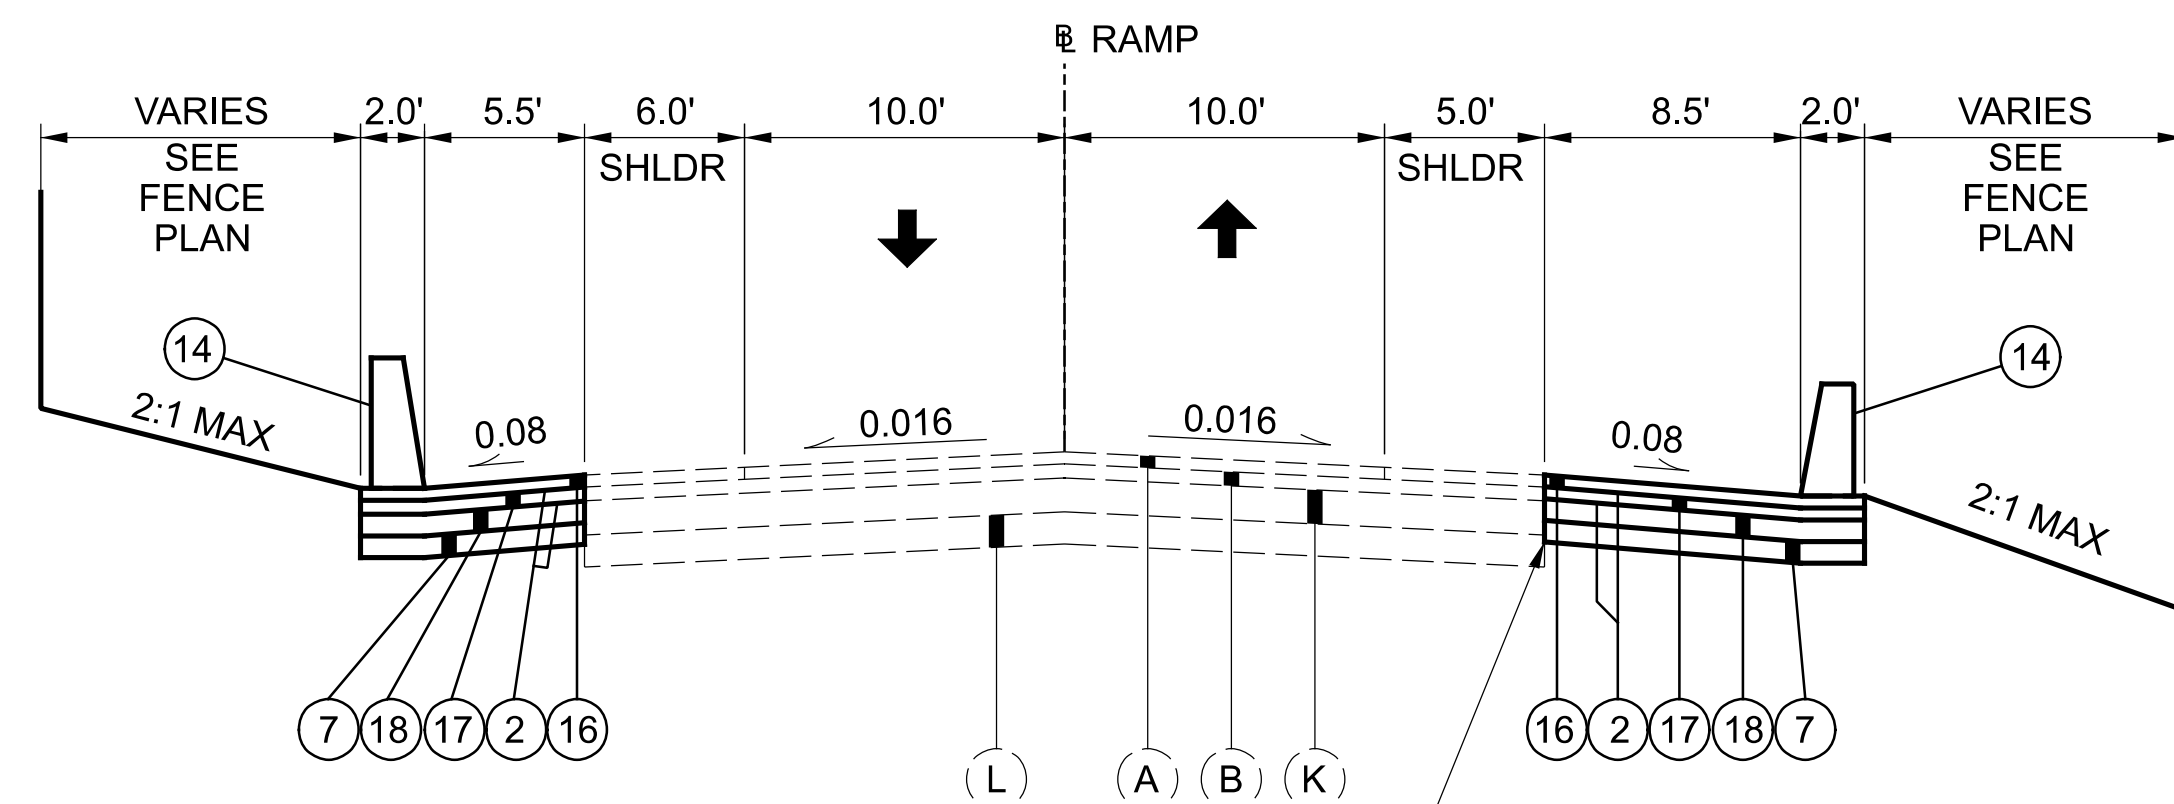

SAW CUT TO ESTABLISH CLEAN VERTICAL EDGE.
COAT ENTIRE VERTICAL FACE WITH BINDER.
WORK SHALL BE INCIDENTAL TO PAVEMENT WORK.
(TYPICAL)

PROPOSED NORMAL SECTION - SR-303
STA 155+88.00 TO 156+82.50

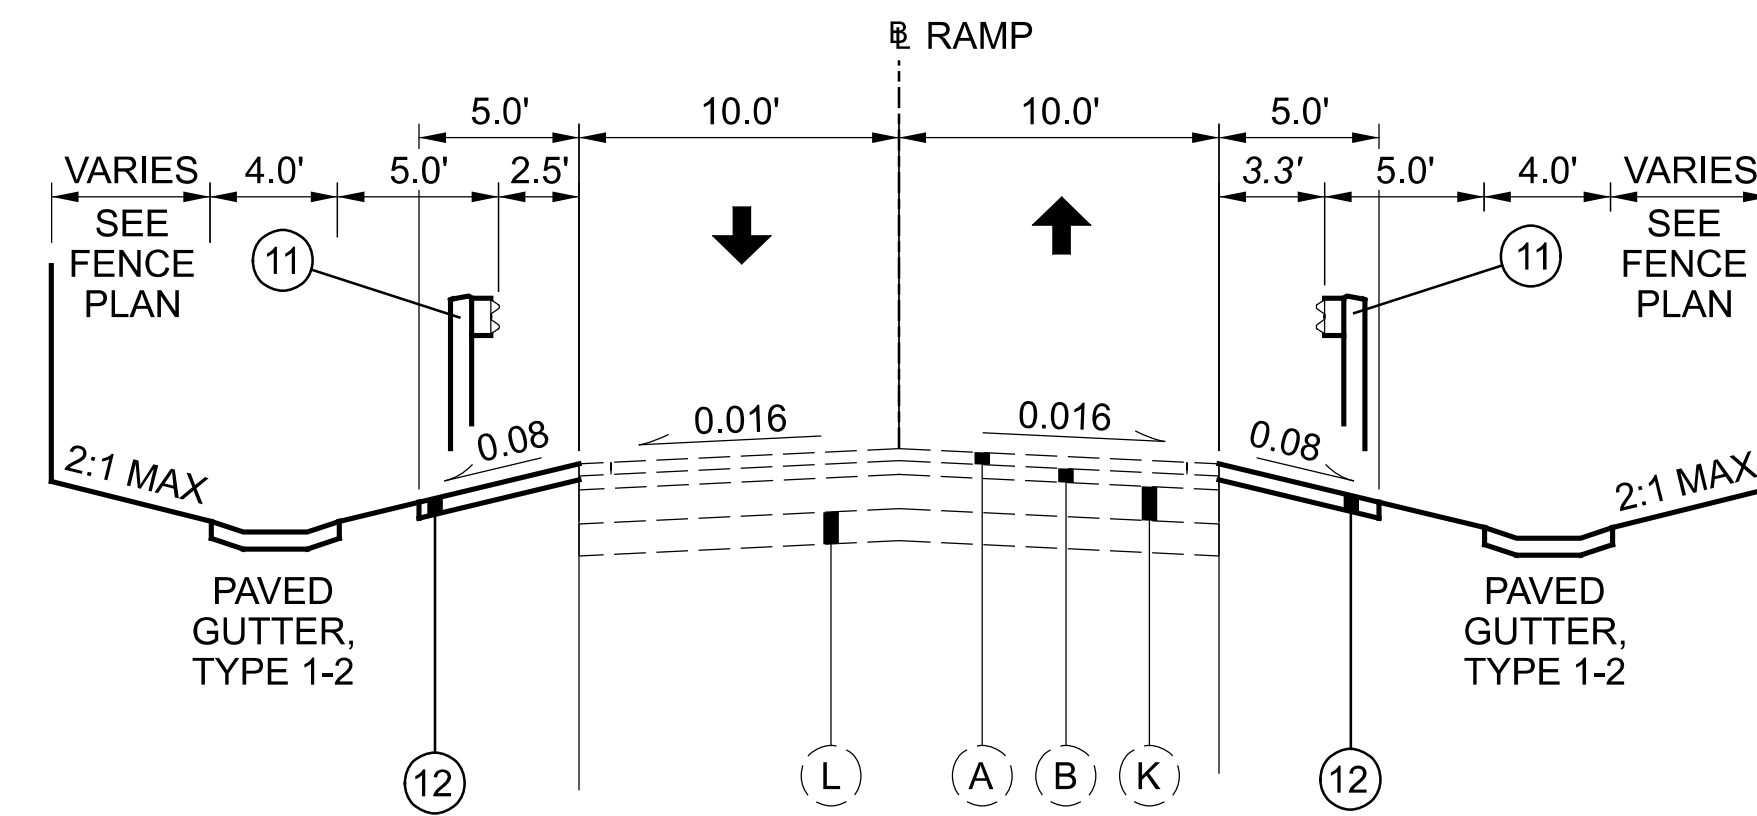


PROPOSED NORMAL SECTION - CH-178

STA 10+98.00 TO 11+98.00

STA 11+06.00 TO 12+06.00


FOR GUARDRAIL LOCATIONS, SEE SHEETS 202 - 232

FOR COMPACTED AGGREGATE DETAIL, SEE SHEET 12
FOR BASE AND SUBBASE STEP DETAIL, SEE SHEET 12
FOR ROUNDING DETAIL, SEE SHEET 12
FOR BENCHING DETAIL, SEE SHEET 12
FOR PROPOSED PAVEMENT LEGEND, SEE SHEET 12
FOR UNDERDRAIN DETAILS, SEE SHEETS 562 - 563

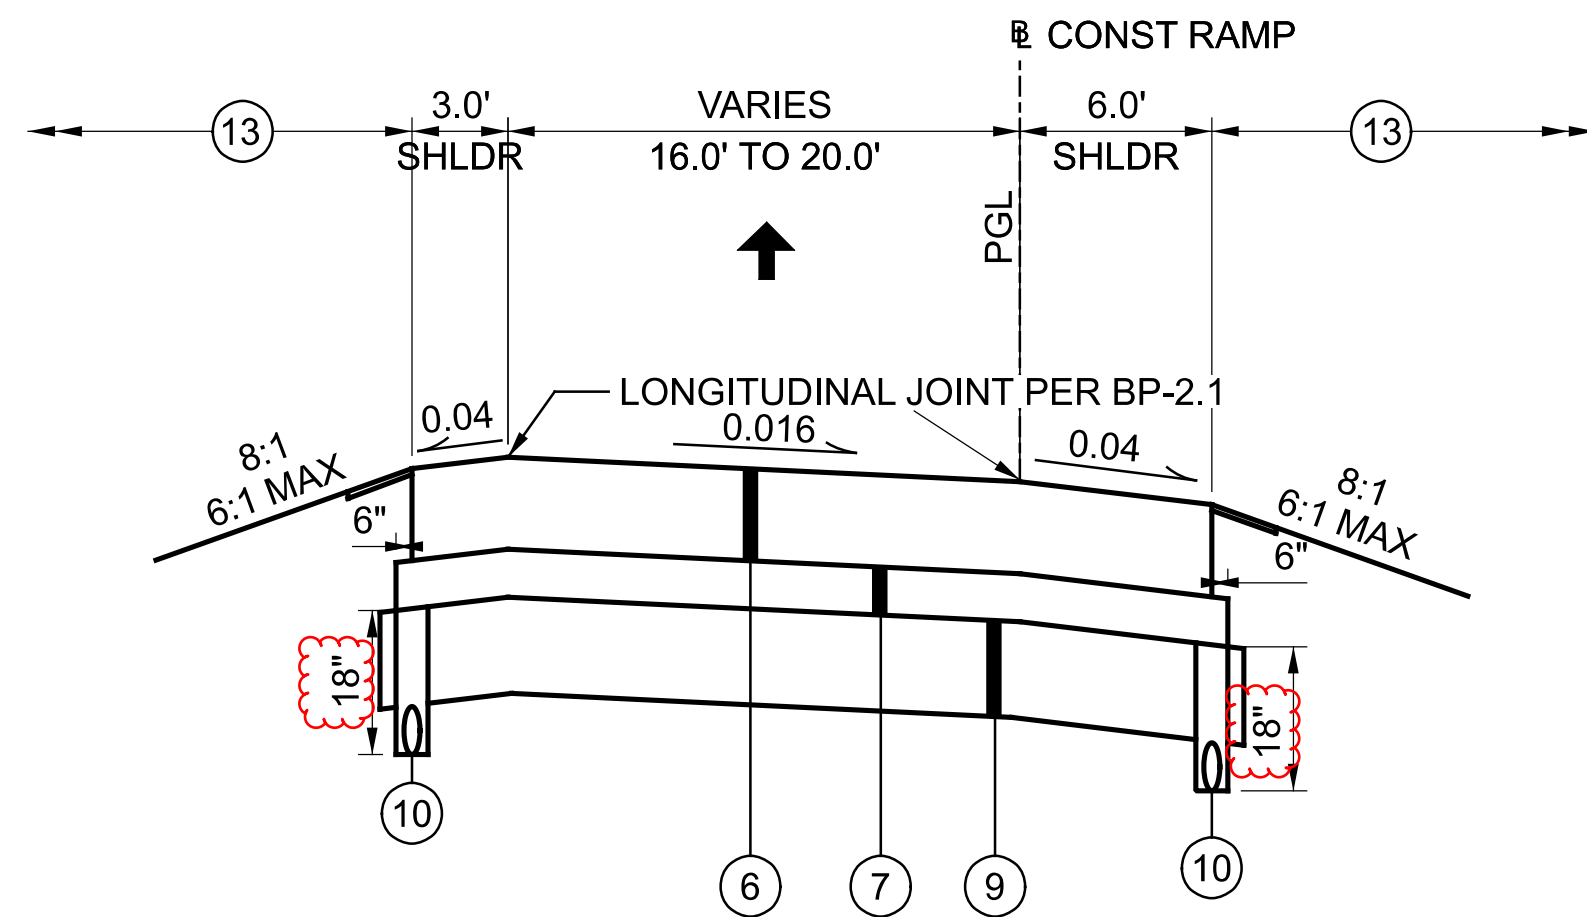


PROPOSED NORMAL SECTION - RAMP

SR-176 RAMP A: STA 1862+64.19 TO STA 1867+38.08 (16.0')
 SR-176 RAMP B: STA 4912+32.45 TO STA 4917+71.84 (VARIES, SEE NOTE 1)
 SR-176 RAMP D: STA 3893+16.88 TO STA 3894+05.29 (16.0')
 SR-21 RAMP F: STA 9019+09.90 TO STA 9022+64.89 (16.0')
 STA 9034+68.16 TO STA 9036+40.16 (16.0')

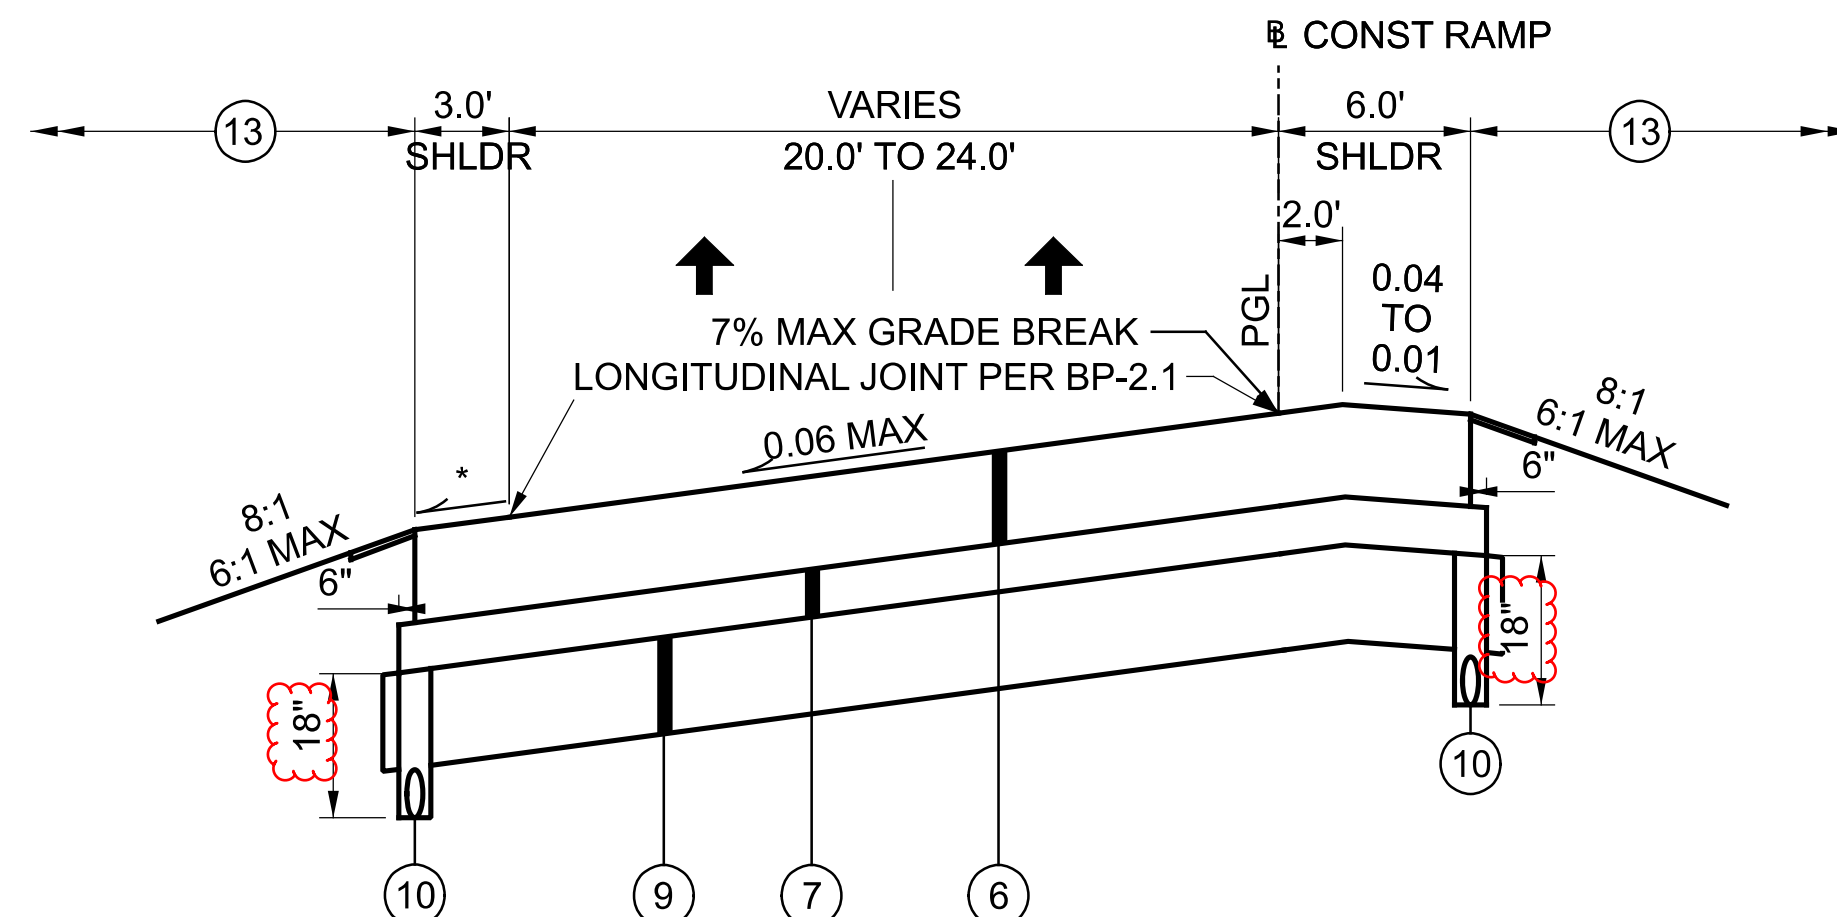

PROPOSED SUPERELEVATED SECTION - RAMP


SR-176 RAMP B: STA 4917+71.84 TO STA 4922+74.21 (VARIES, SEE NOTE 1)

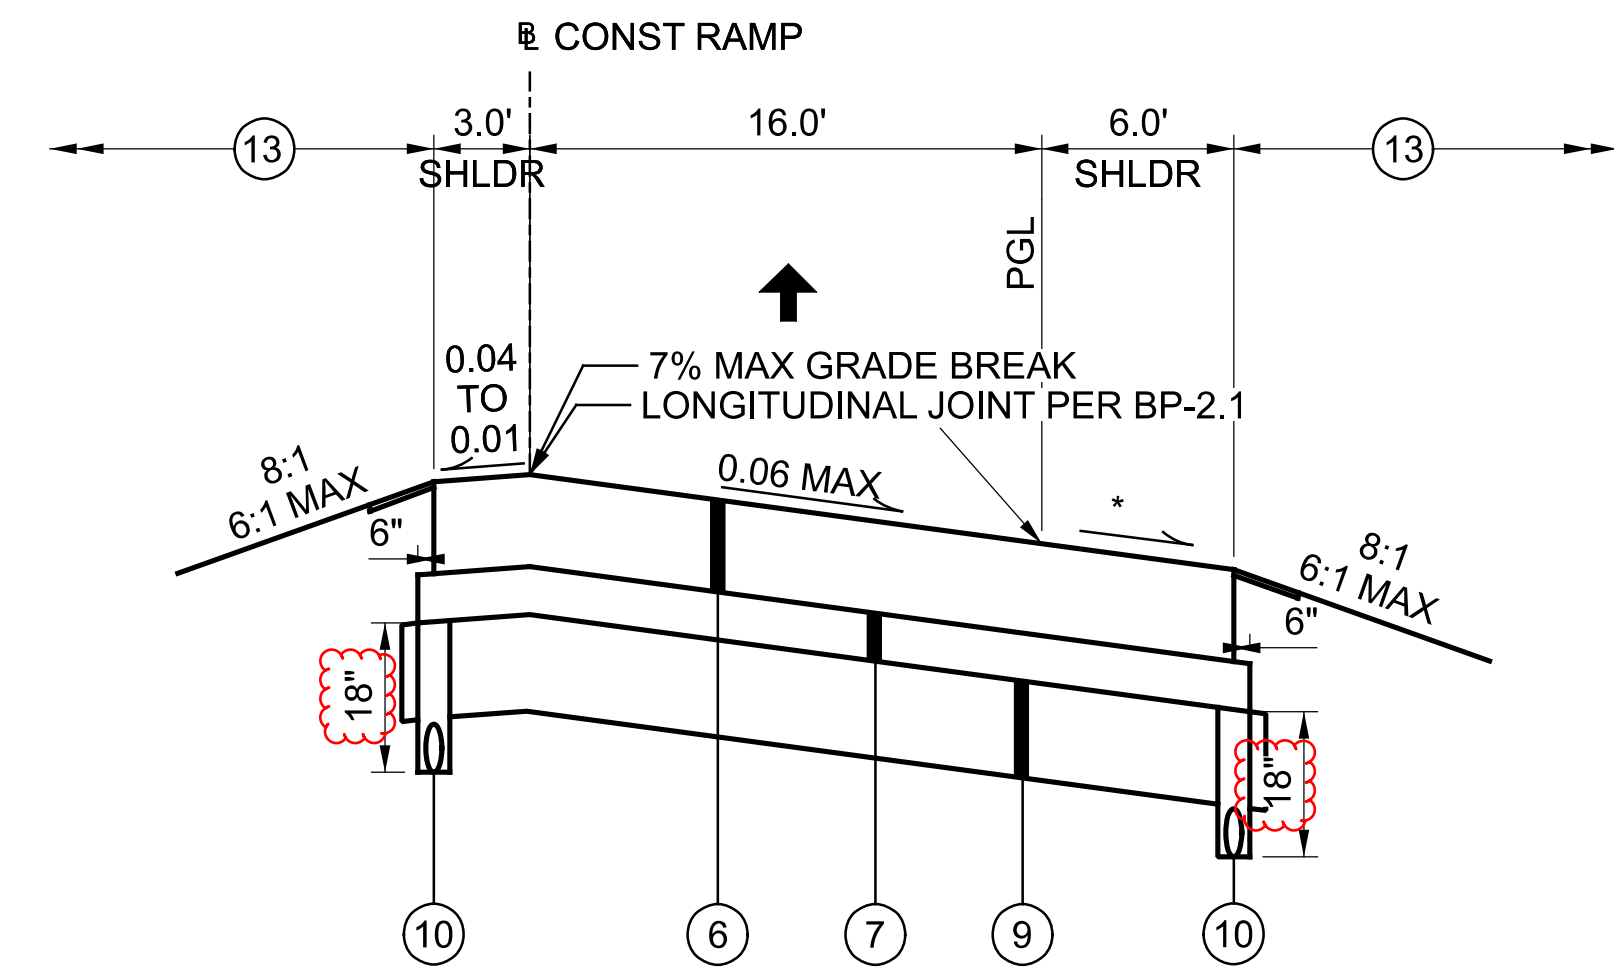

PROPOSED SUPERELEVATED SECTION - RAMP


SR-176 RAMP A: STA 1859+17.13 TO STA 1861+01.82

NOTE 1: RAMP WIDTH VARIES FROM 16.0' AT STA 4917+25 TO 24.0' AT STA 4917+75

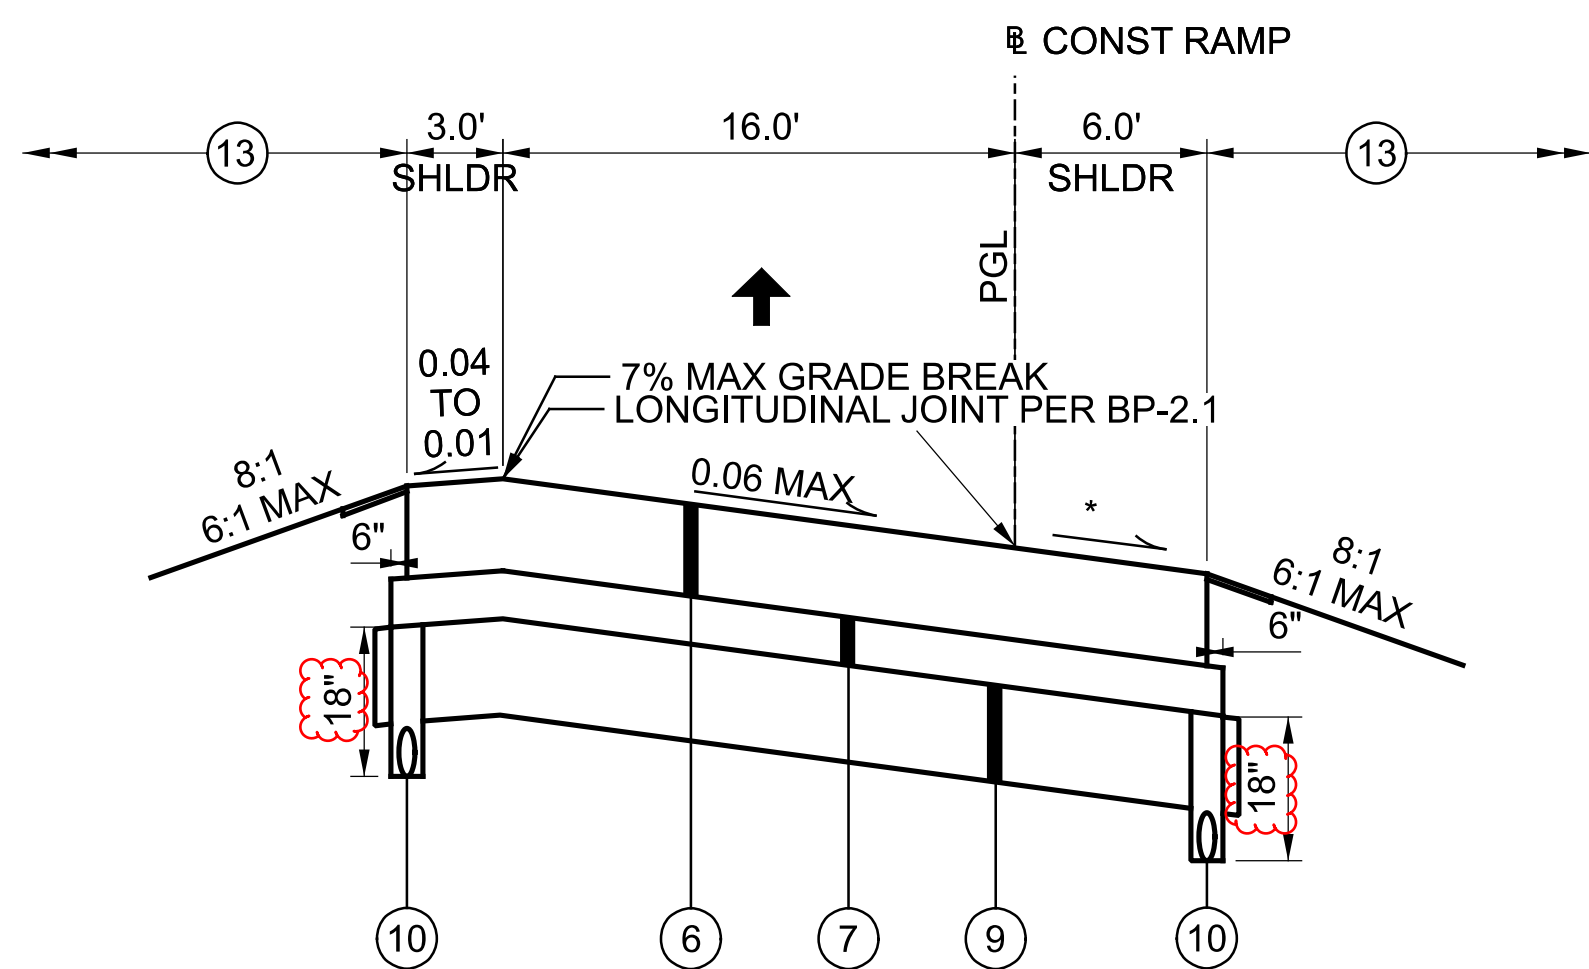


PROPOSED SUPERELEVATED SECTION - RAMP

SR-176 RAMP A: STA 1867+38.08 TO STA 1870+39.83
 SR-176 RAMP B: STA 4909+33.82 TO STA 4912+32.45
 SR-176 RAMP C: STA 2890+75.35 TO STA 2896+69.15 **
 STA 2898+96.40 TO STA 2903+21.92
 SR-176 RAMP D: STA 3891+56.88 TO STA 3893+16.88
 STA 3894+05.29 TO STA 3898+87.74
 SR-176 RAMP E: STA 26+29.62 TO STA 29+29.78
 SR-21 RAMP F: STA 9022+14.84 TO STA 9034+18.11

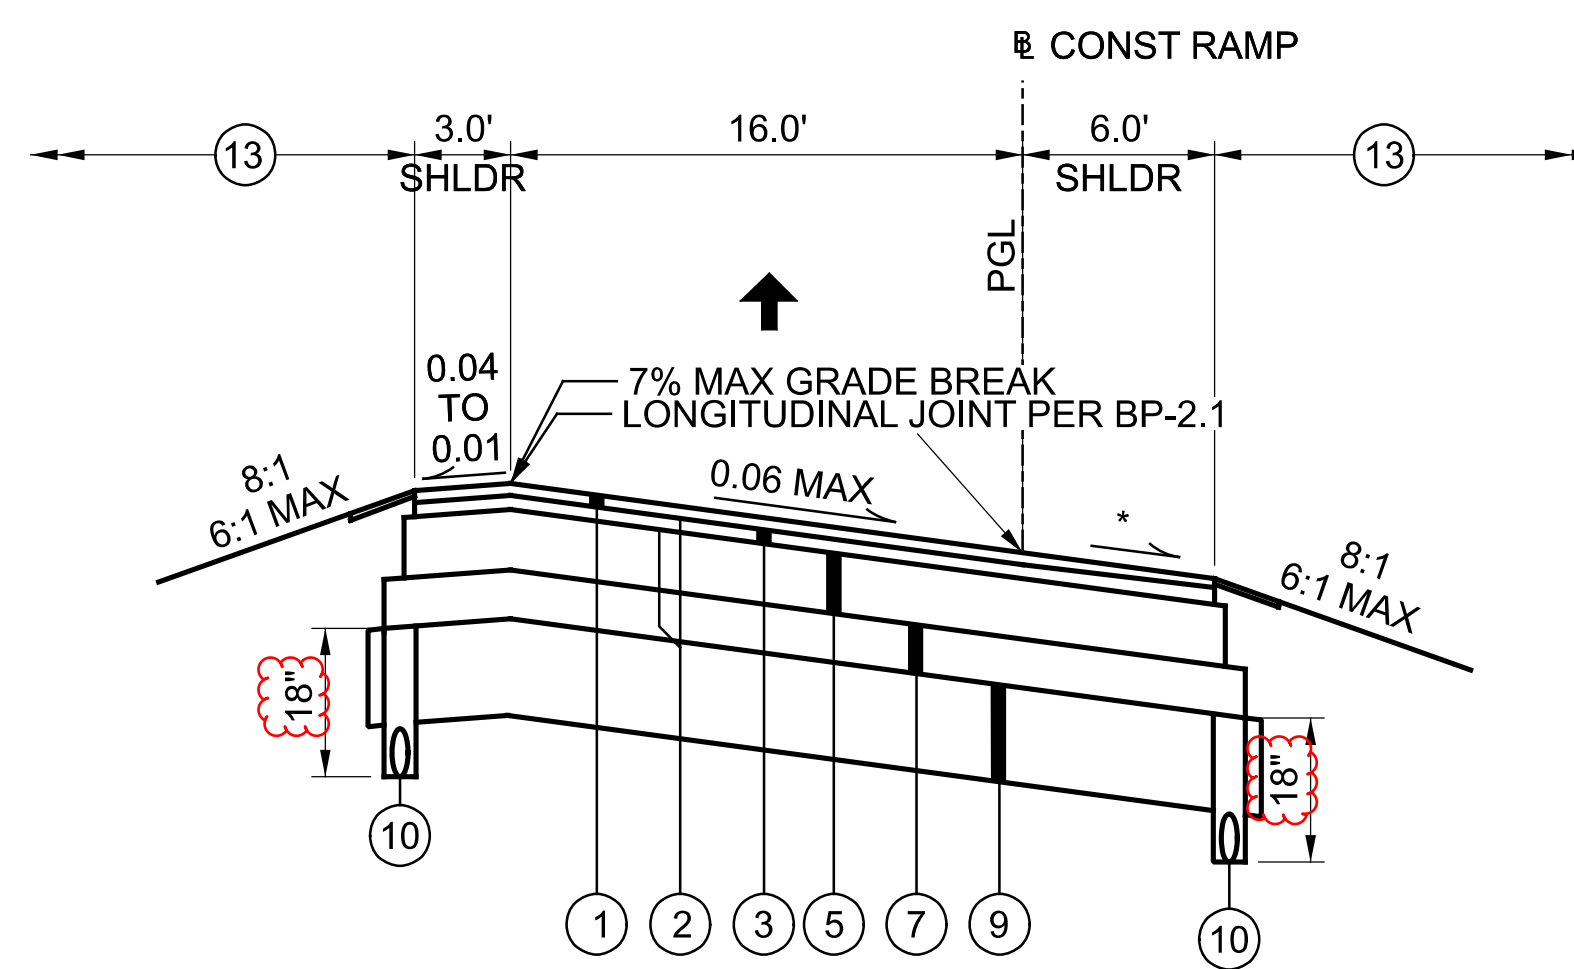

PROPOSED SUPERELEVATED SECTION - RAMP

SR-176 RAMP A: STA 1870+39.83 TO STA 1873+45.13
 SR-176 RAMP C: STA 2903+21.92 TO STA 2905+21.92
 IR-271 RAMP B: STA 8933+10.00 TO STA 8936+71.11
 IR-271 RAMP C: STA 5908+24.07 TO STA 5914+18.08

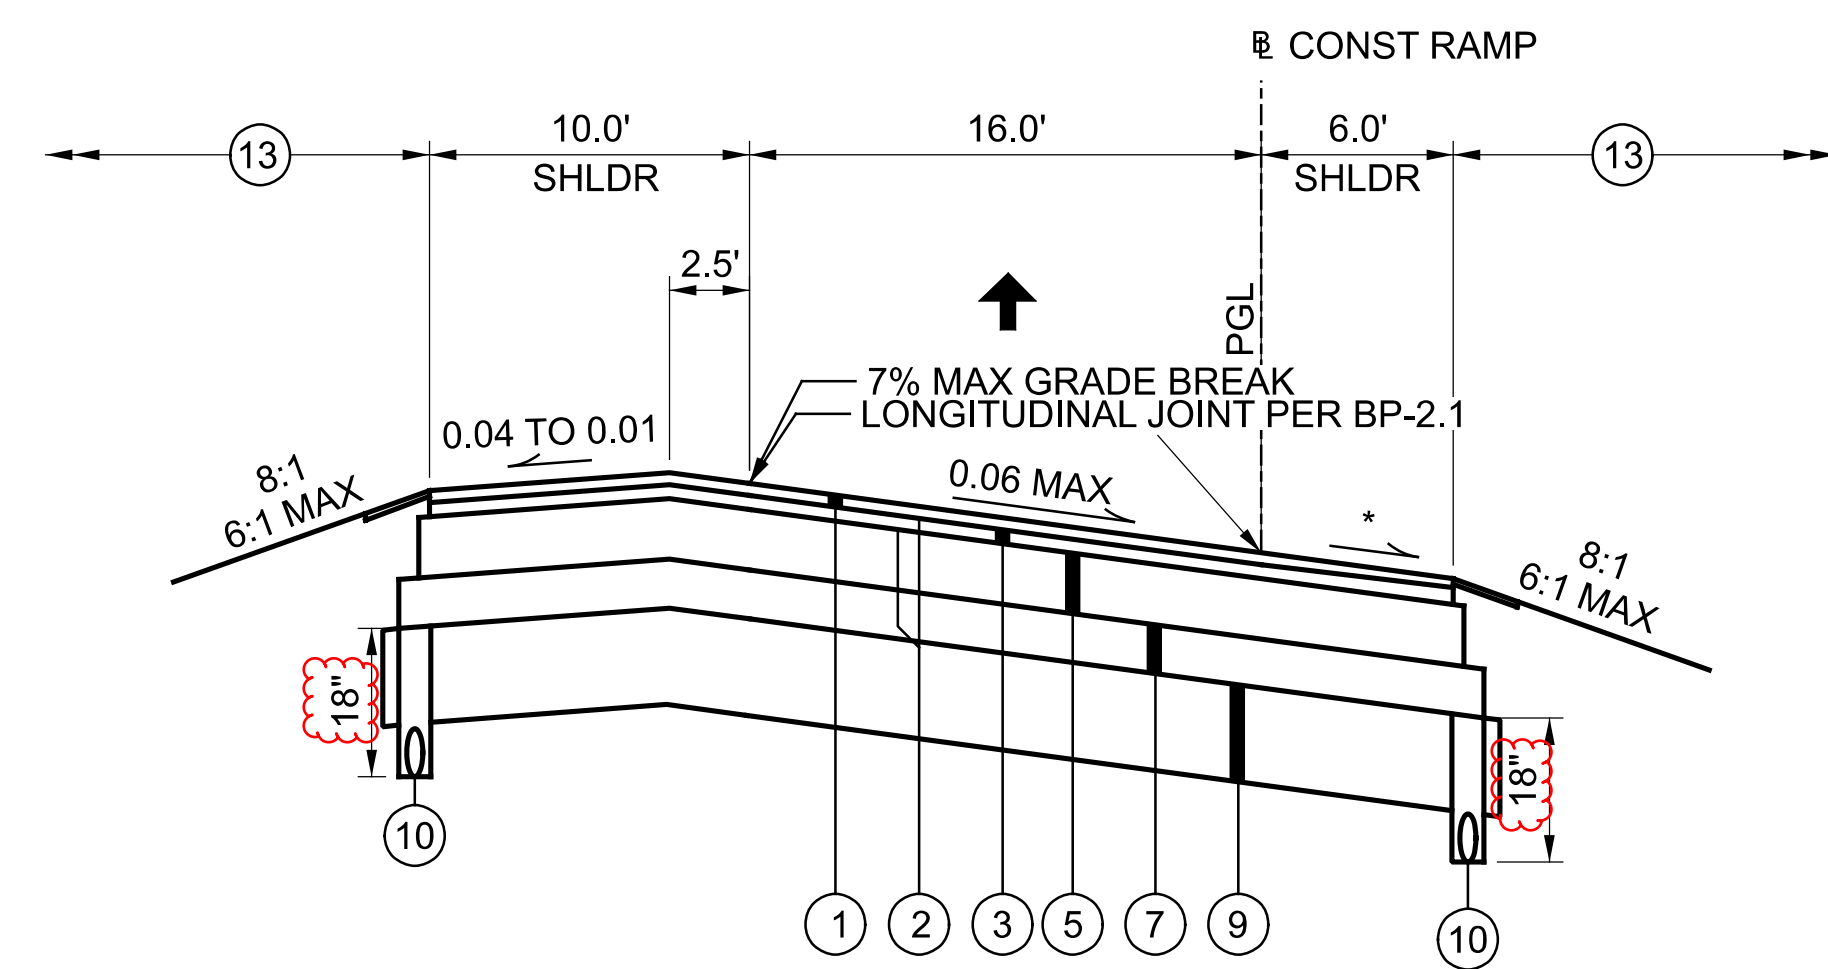

PROPOSED SUPERELEVATED SECTION - RAMP

IR-271 RAMP D: STA 6915+00.00 TO STA 6917+99.95

* CROSS SLOPE SHALL BE 0.04 OR MATCH SUPERELEVATION RATE IF GREATER THAN 0.04.


** FOR SR-176 RAMP C: STA 2896+69.15 TO STA 2898+96.40, SEE SR-176 RAMP D: STA 3888+19.25 TO STA 3891+56.88

*** FOR SR-176 RAMP A: STA 1861+01.82 TO STA 1862+64.19, SEE SR-176 RAMP E: STA 30+73.68 TO STA 29+29.78

****SEE MAINLINE TYPICAL SECTIONS AND INTERCHANGE DETAILS FOR STATIONS BELOW:
 FOR SR-176 RAMP B: STA 4905+26.51 TO STA 4909+33.82
 FOR SR-176 RAMP C: STA 2886+35.00 TO STA 2890+43.21
 FOR SR-176 RAMP D: STA 3898+87.74 TO STA 3901+06.82
 FOR SR-176 RAMP E: STA 29+29.78 TO STA 30+33.59, STA 30+33.59 TO STA 30+87.87
 FOR SR-271 RAMP D: STA 6916+64.47 TO STA 6918+43.66
 FOR SR-21 RAMP F: STA 9013+31.85 TO STA 9019+09.90

NOTE A: TYPICAL SECTIONS ARE SHOWN FOR REPRESENTATIVE OF RAMP SECTIONS.

FOR COMPACTED AGGREGATE DETAIL, SEE SHEET 12
 FOR BASE AND SUBBASE STEP DETAIL, SEE SHEET 12
 FOR ROUNDING DETAIL, SEE SHEET 12
 FOR BENCHING DETAIL, SEE SHEET 12
 FOR PROPOSED PAVEMENT LEGEND, SEE SHEET 12
 FOR UNDERDRAIN DETAILS, SEE SHEETS 562 - 563
 FOR SUPERELEVATION TABLES, SEE SHEET 488 - 495
 FOR INTERCHANGE DETAILS, SEE SHEET 496 - 517

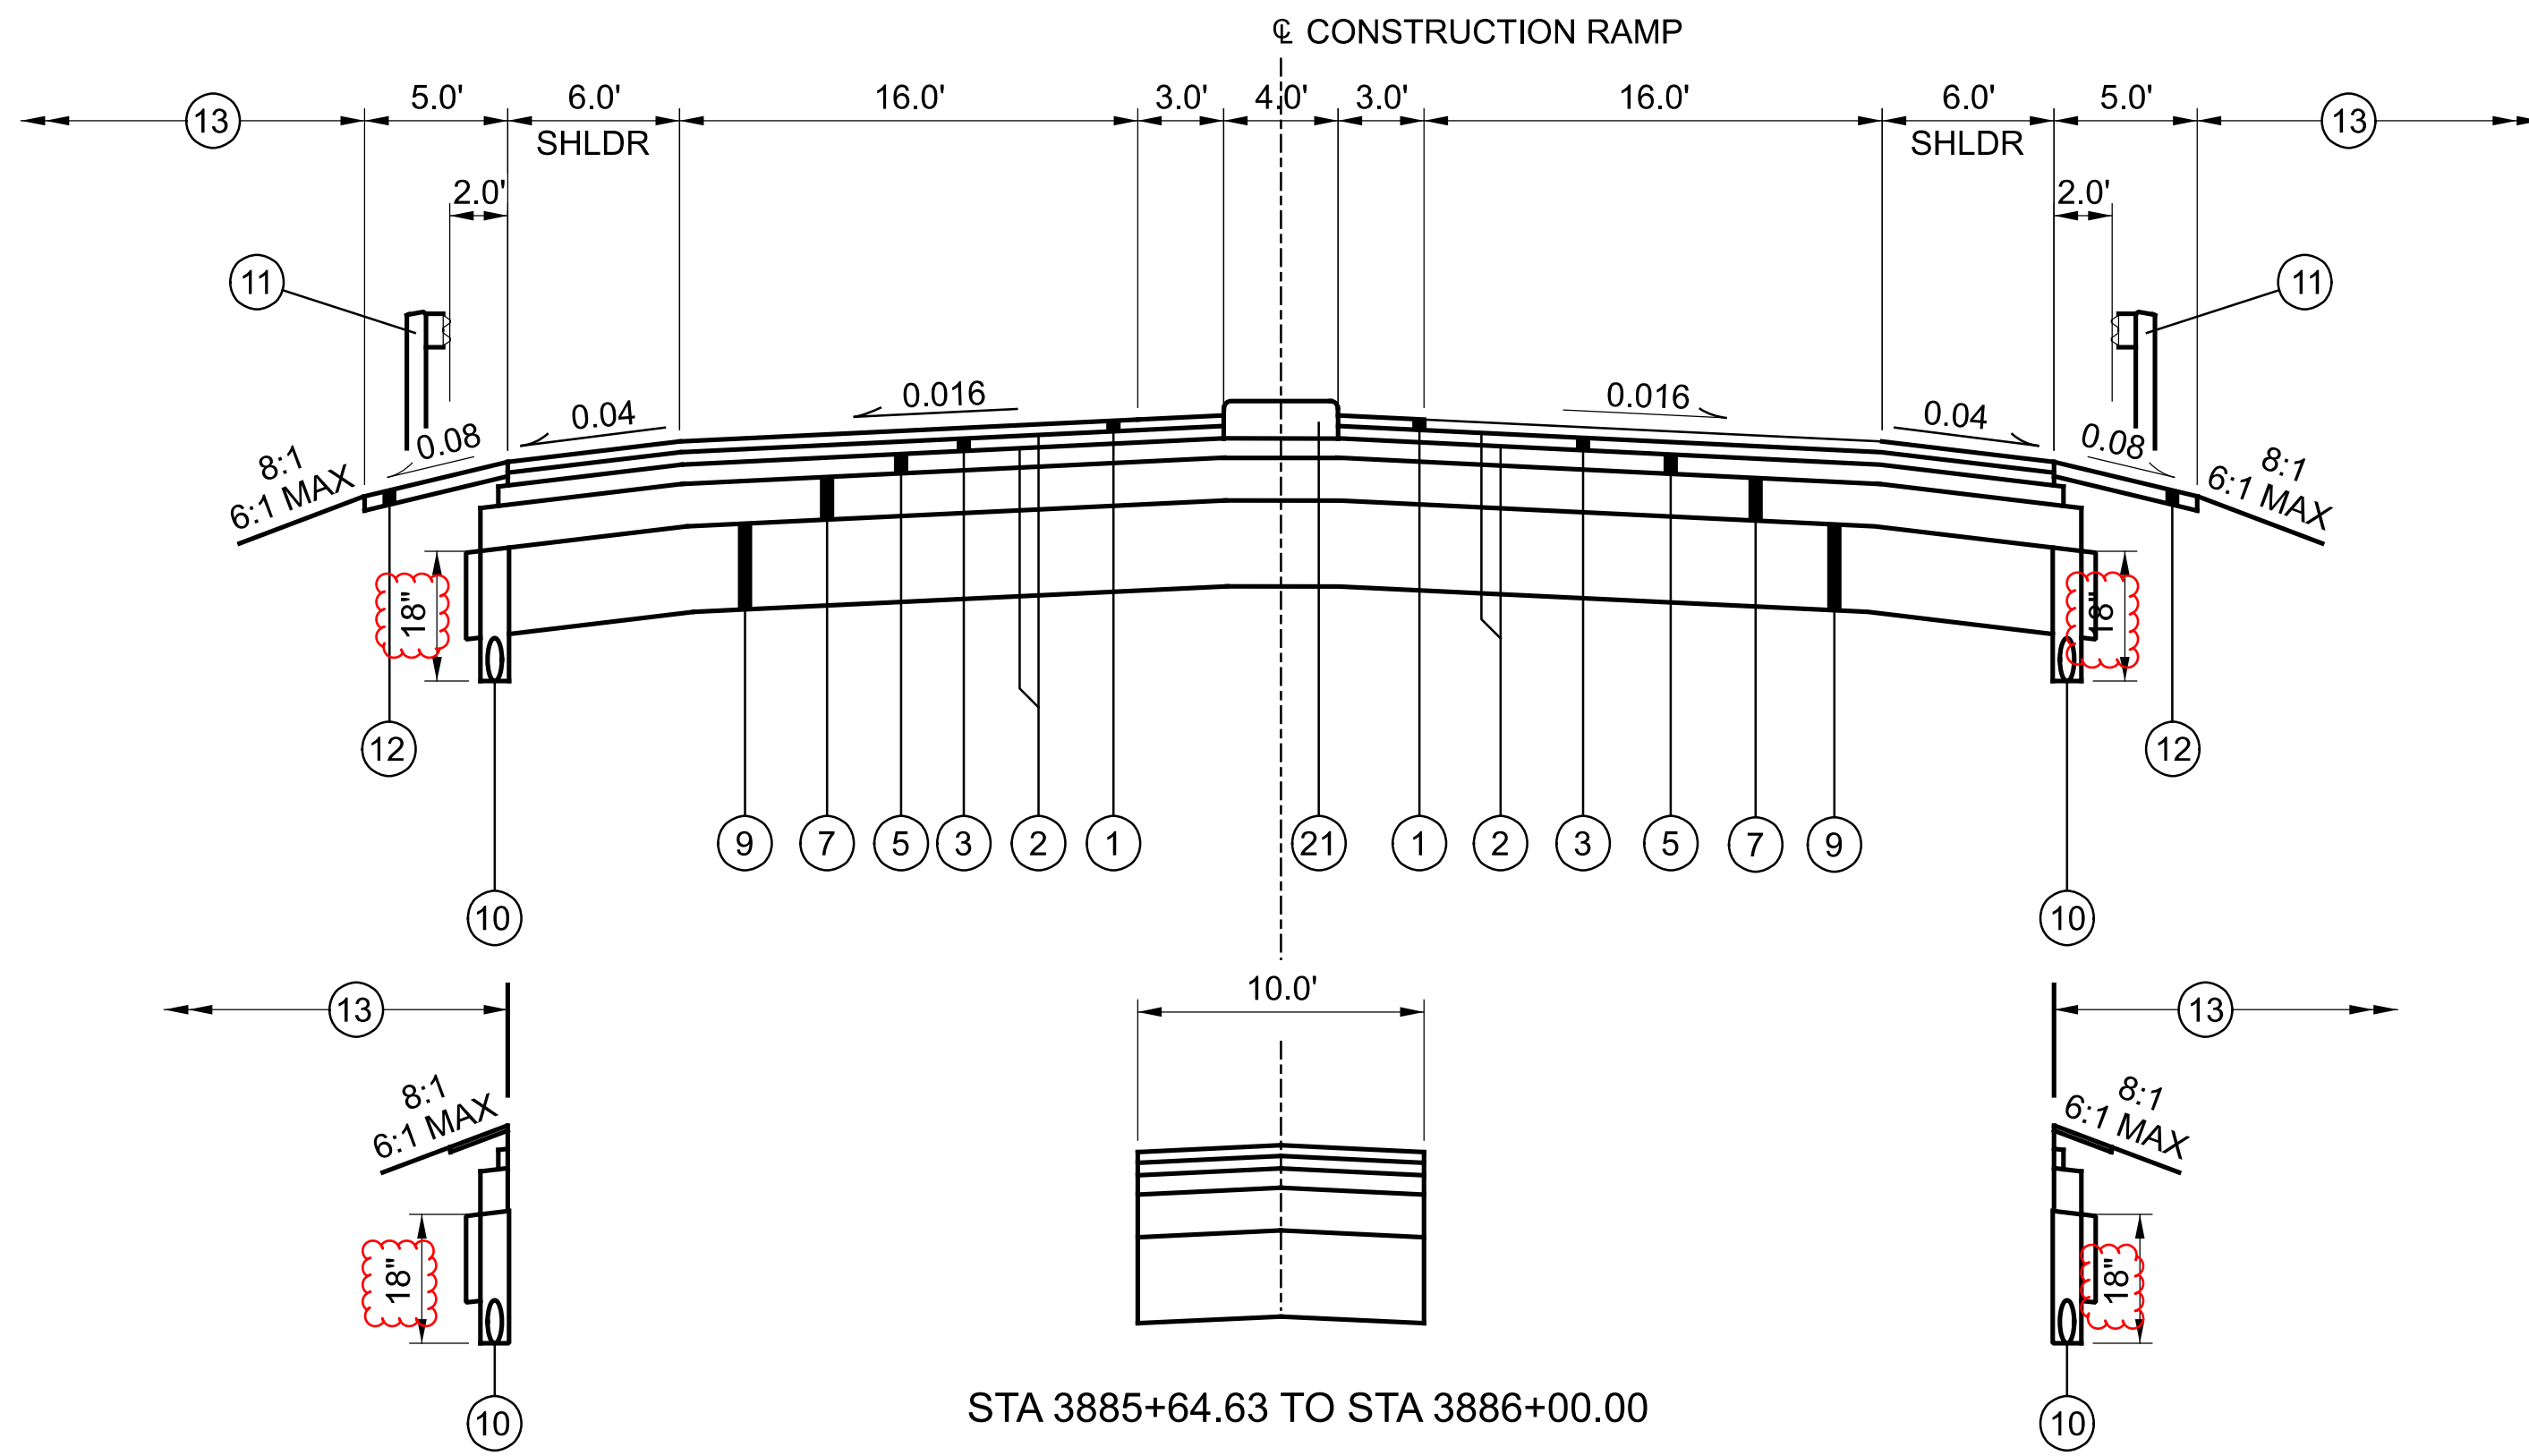


STA 3885+64.63 TO STA 3886+00.00


STA 3885+64.63 TO STA 3886+93.03

STA 3885+64.63 TO STA 3887+07.09


PROPOSED NORMAL SECTION - RAMP
SR-176 RAMP D: STA 3885+64.63 TO STA 3888+19.25

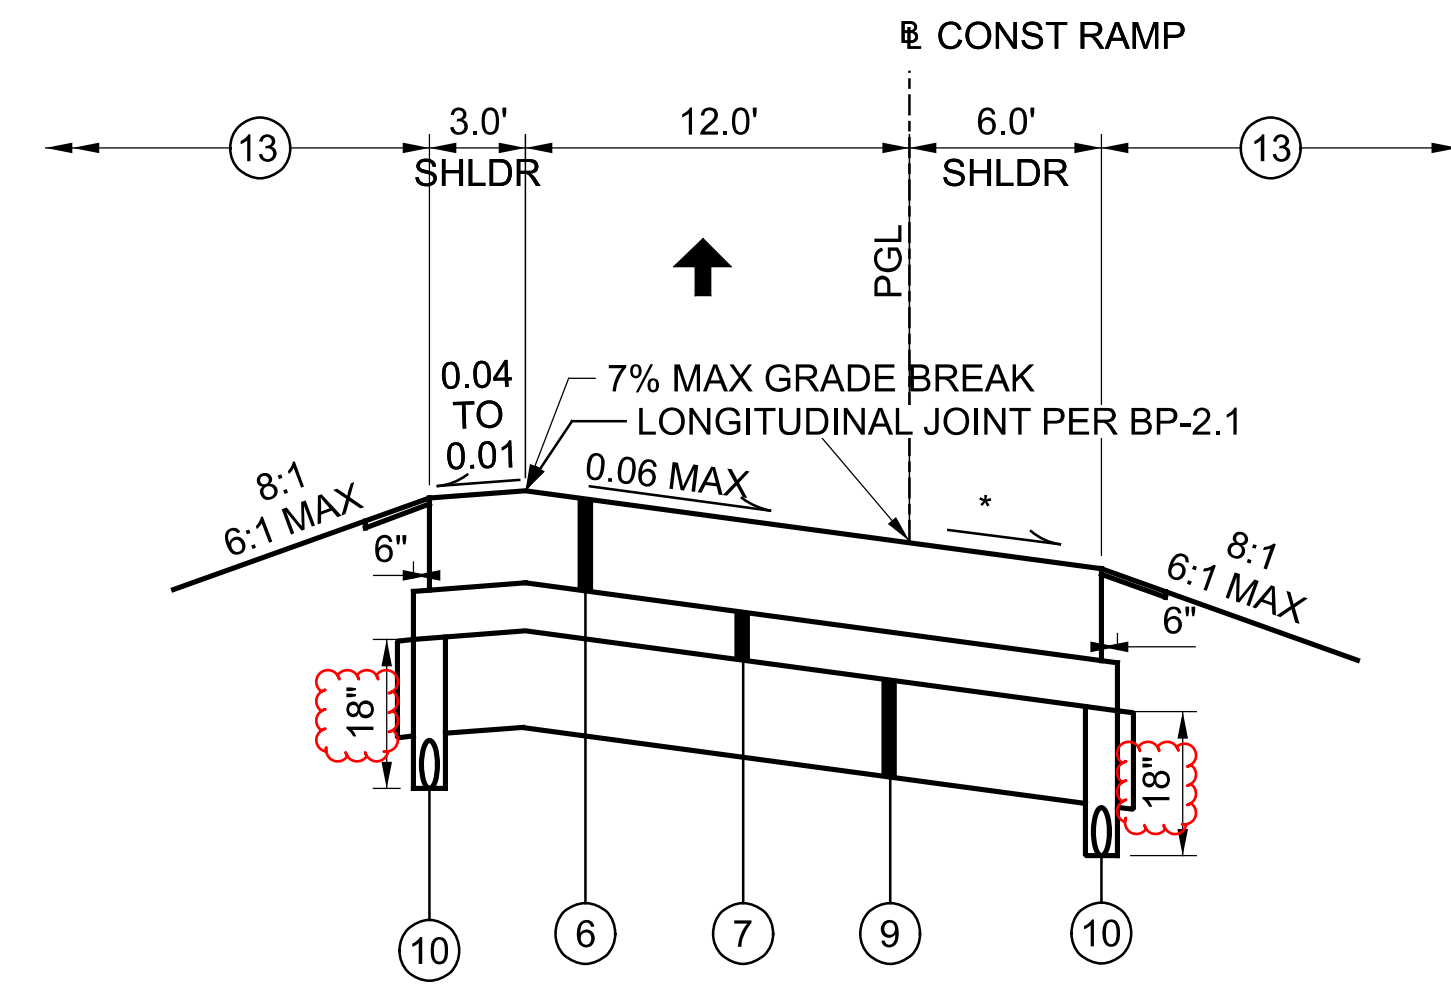

PROPOSED SUPERELEVATED SECTION - RAMP
SR-176 RAMP E: STA 25+28.45 TO STA 26+29.62

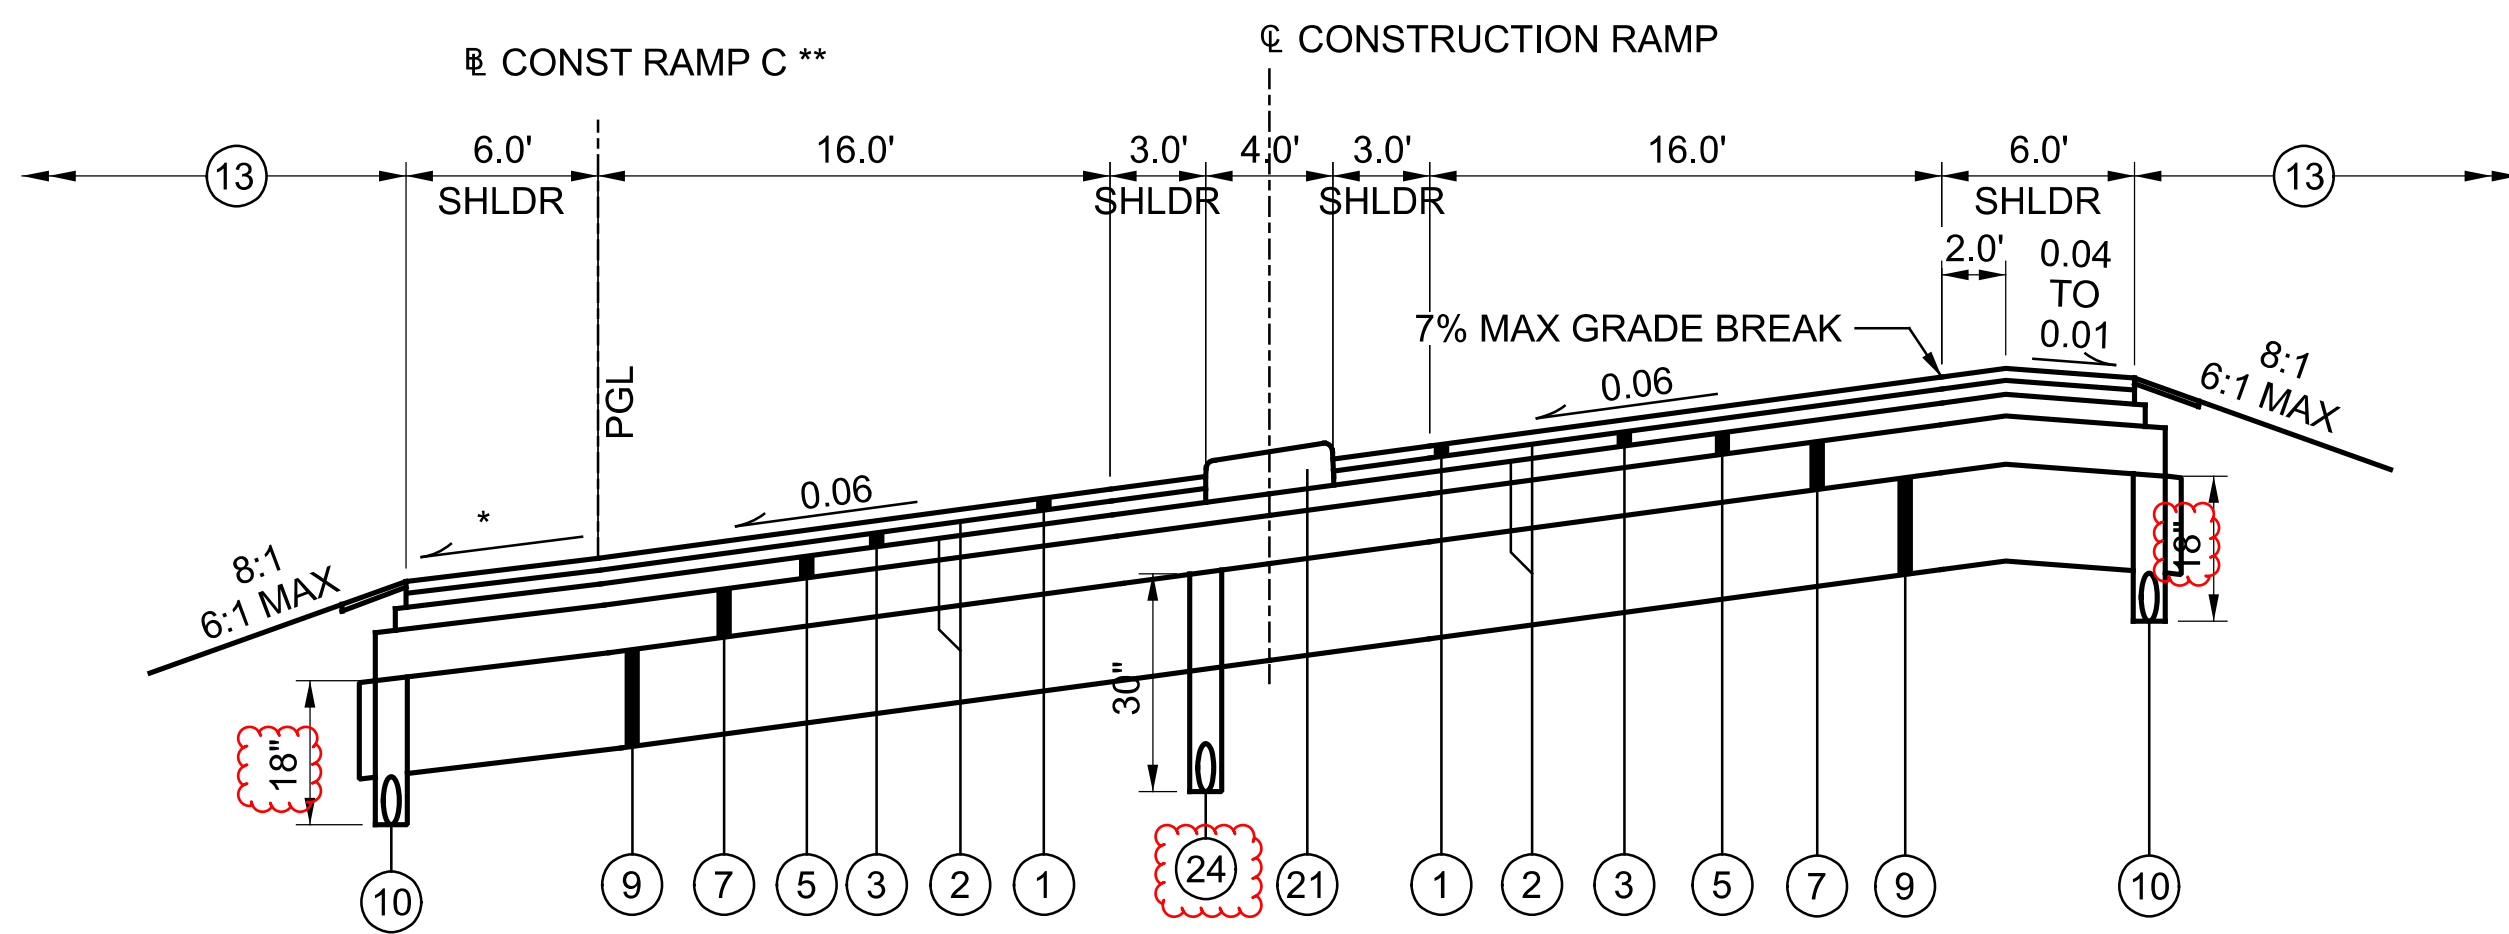

PROPOSED SUPERELEVATED SECTION - RAMP
SR-176 RAMP D: STA 3888+19.25 TO STA 3891+56.88

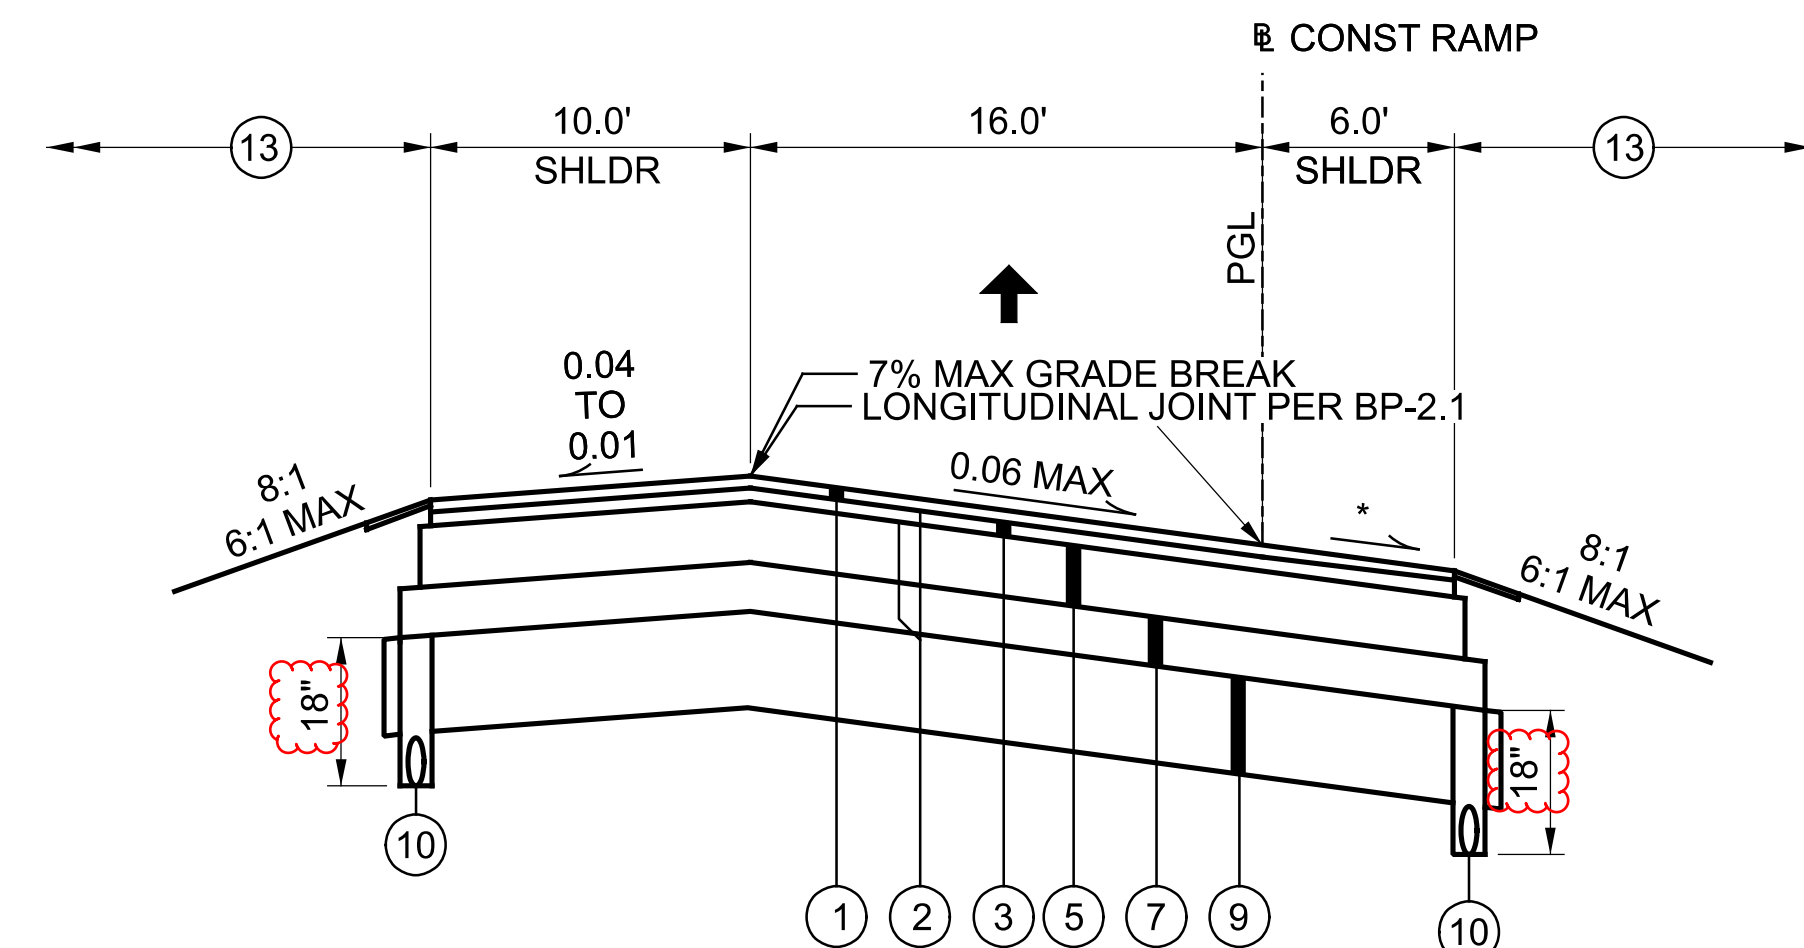


PROPOSED SUPERELEVATED SECTION - RAMP
IR-271 RAMP A: STA 7940+58.44 TO STA 7941+09.76

* CROSS SLOPE SHALL BE 0.04 OR MATCH SUPERELEVATION RATE IF GREATER THAN 0.04.


** FOR SR-176 RAMP C: STA 2896+69.15 TO STA 2899+84.22, SEE SR-176 RAMP D: STA 3888+19.25 TO STA 3891+56.88

NOTE A: TYPICAL SECTIONS ARE SHOWN FOR REPRESENTATIVE OF RAMP SECTIONS.


FOR COMPACTED AGGREGATE DETAIL, SEE SHEET 12
FOR BASE AND SUBBASE STEP DETAIL, SEE SHEET 12
FOR ROUNDING DETAIL, SEE SHEET 12
FOR BENCHING DETAIL, SEE SHEET 12
FOR PROPOSED PAVEMENT LEGEND, SEE SHEET 12
FOR UNDERDRAIN DETAILS, SEE SHEETS 562 - 563
FOR SUPERELEVATION TABLES, SEE SHEET 488 - 495
FOR INTERCHANGE DETAILS, SEE SHEET 496 - 517

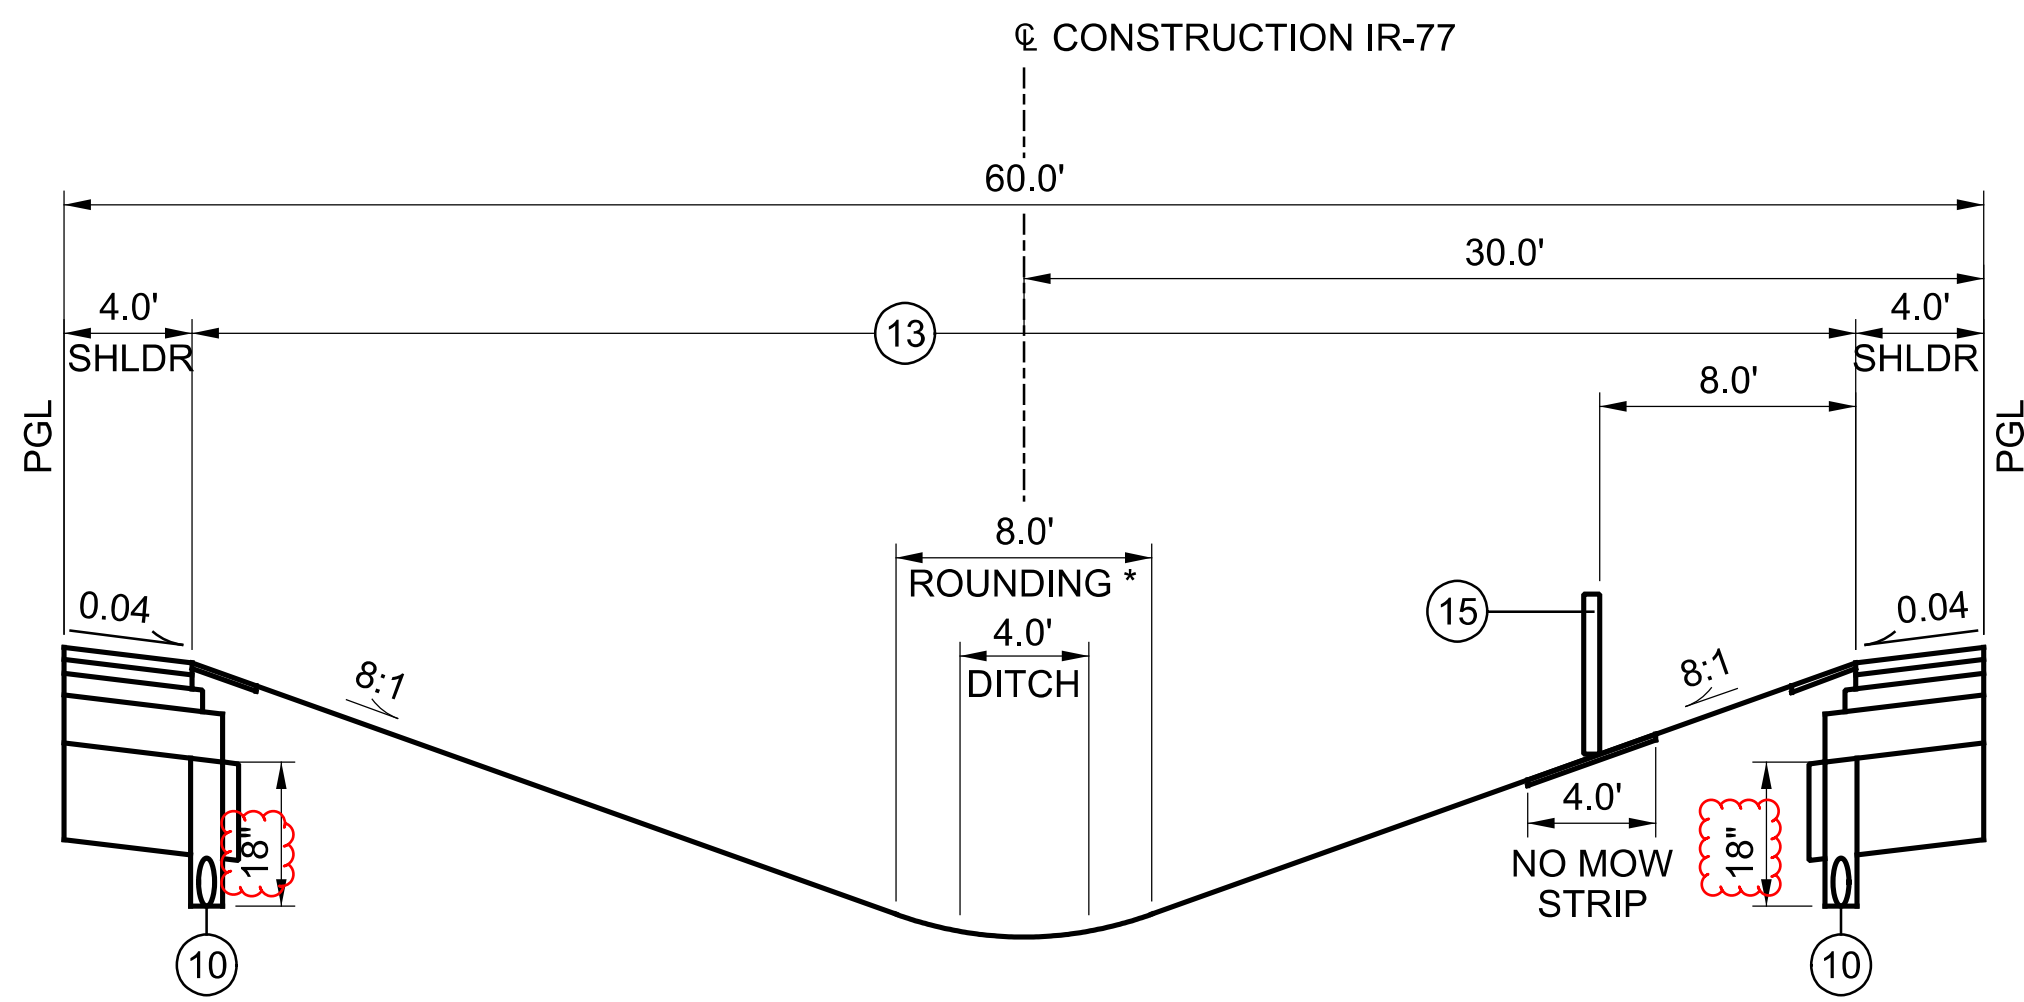


PROPOSED MEDIAN GRADING - IR-77
 STA 842+00.00 TO STA 851+83.25
 STA 858+64.64 TO STA 884+28.15
 STA 891+15.58 TO STA 898+00.45
 STA 951+02.43 TO STA 953+41.40
 STA 961+58.45 TO STA 1002+29.03

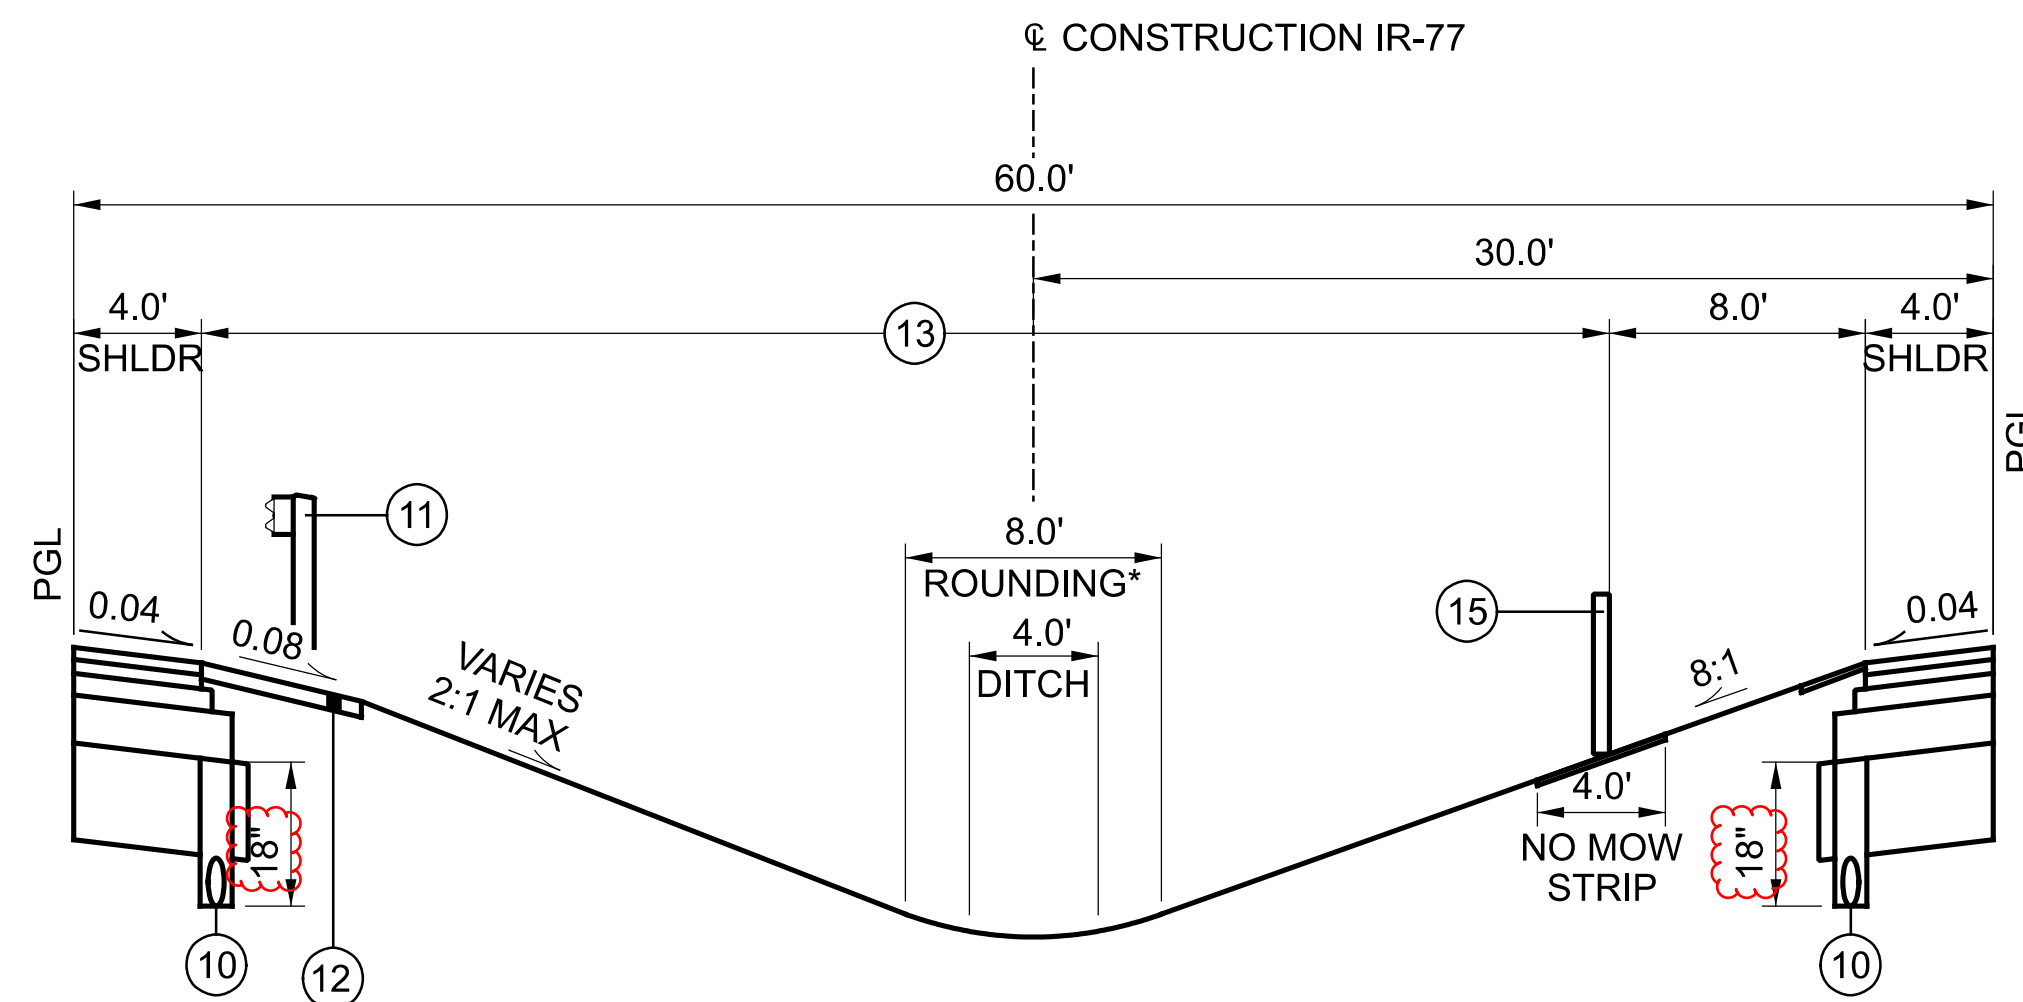

PROPOSED MEDIAN GRADING - IR-77
 STA 855+06.82 TO STA 858+64.64
 STA 887+28.08 TO STA 891+15.58
 STA 946+02.43 TO STA 951+02.43
 STA 959+00.00 TO STA 961+58.45

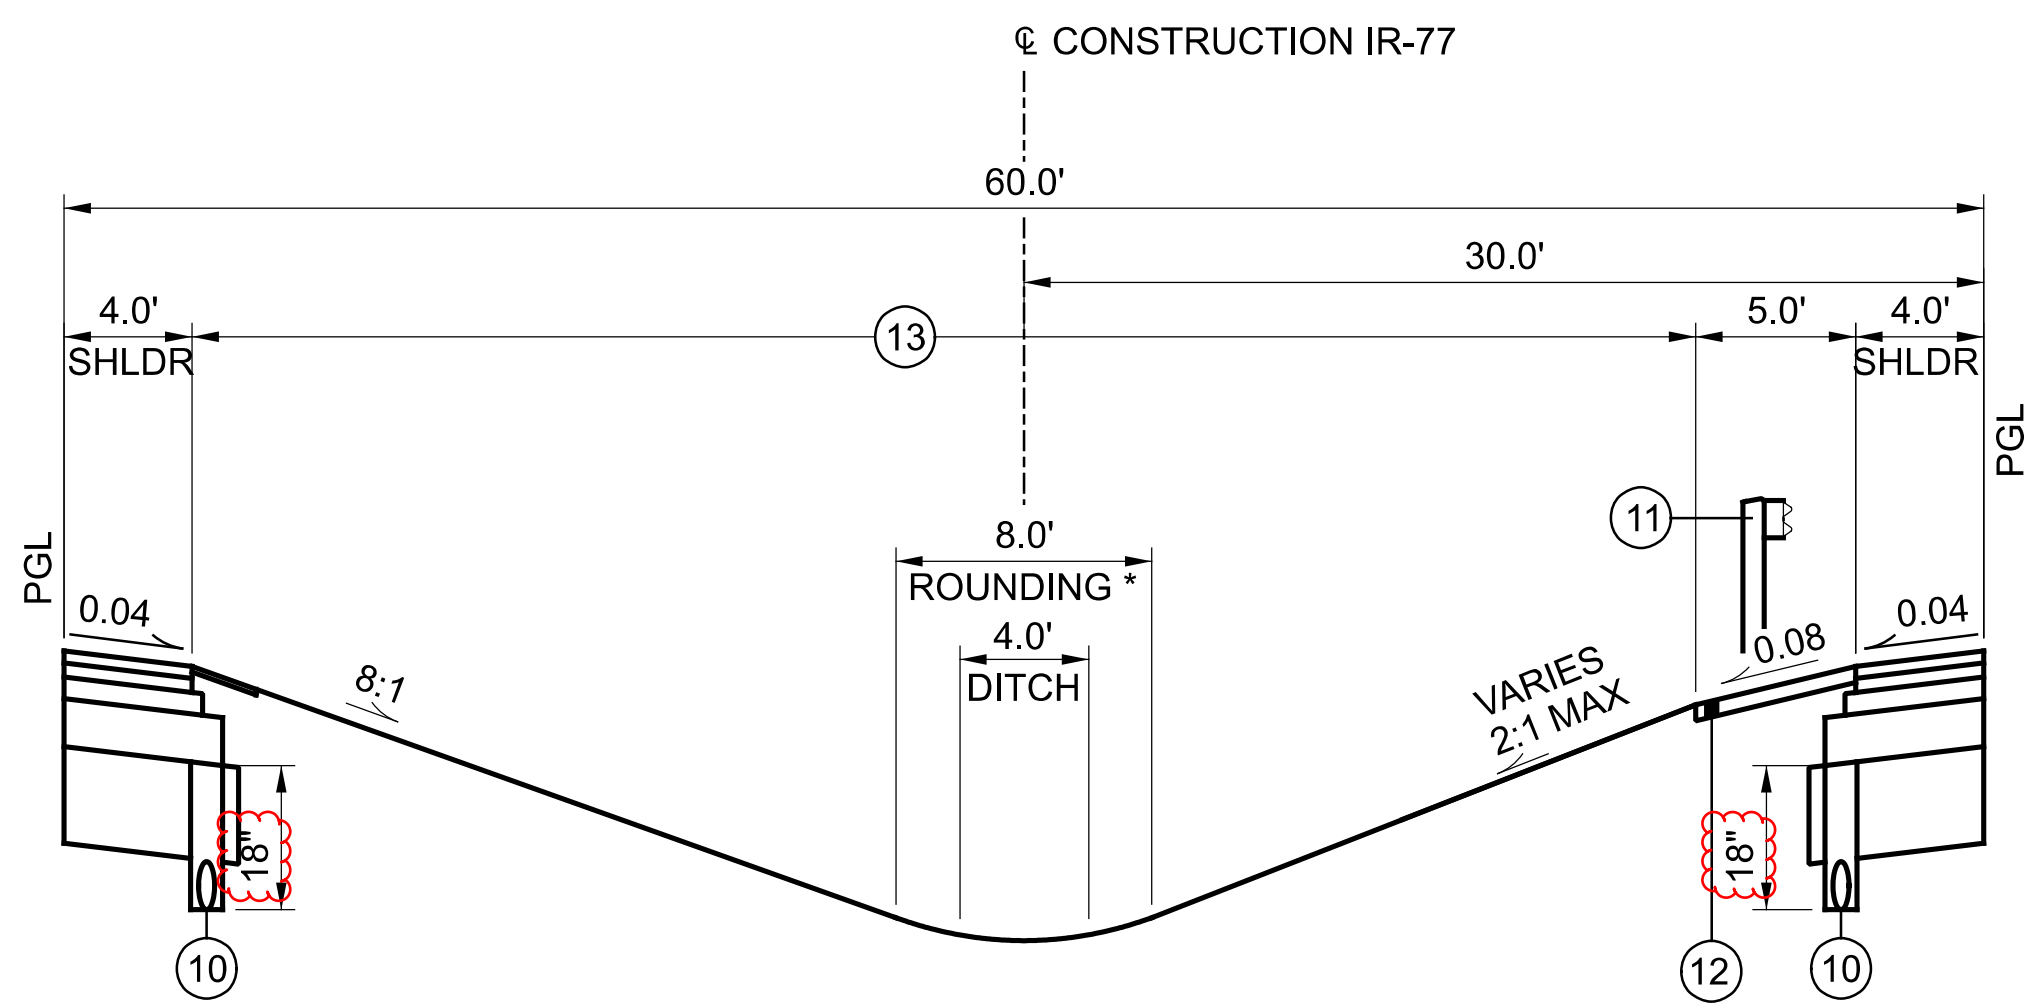

PROPOSED MEDIAN GRADING - IR-77
 STA 851+83.25 TO STA 855+06.82
 STA 884+28.15 TO STA 887+28.08
 STA 898+00.45 TO STA 911+52.42
 STA 953+41.40 TO STA 956+52.54
 STA 1002+29.03 TO STA 1005+38.89

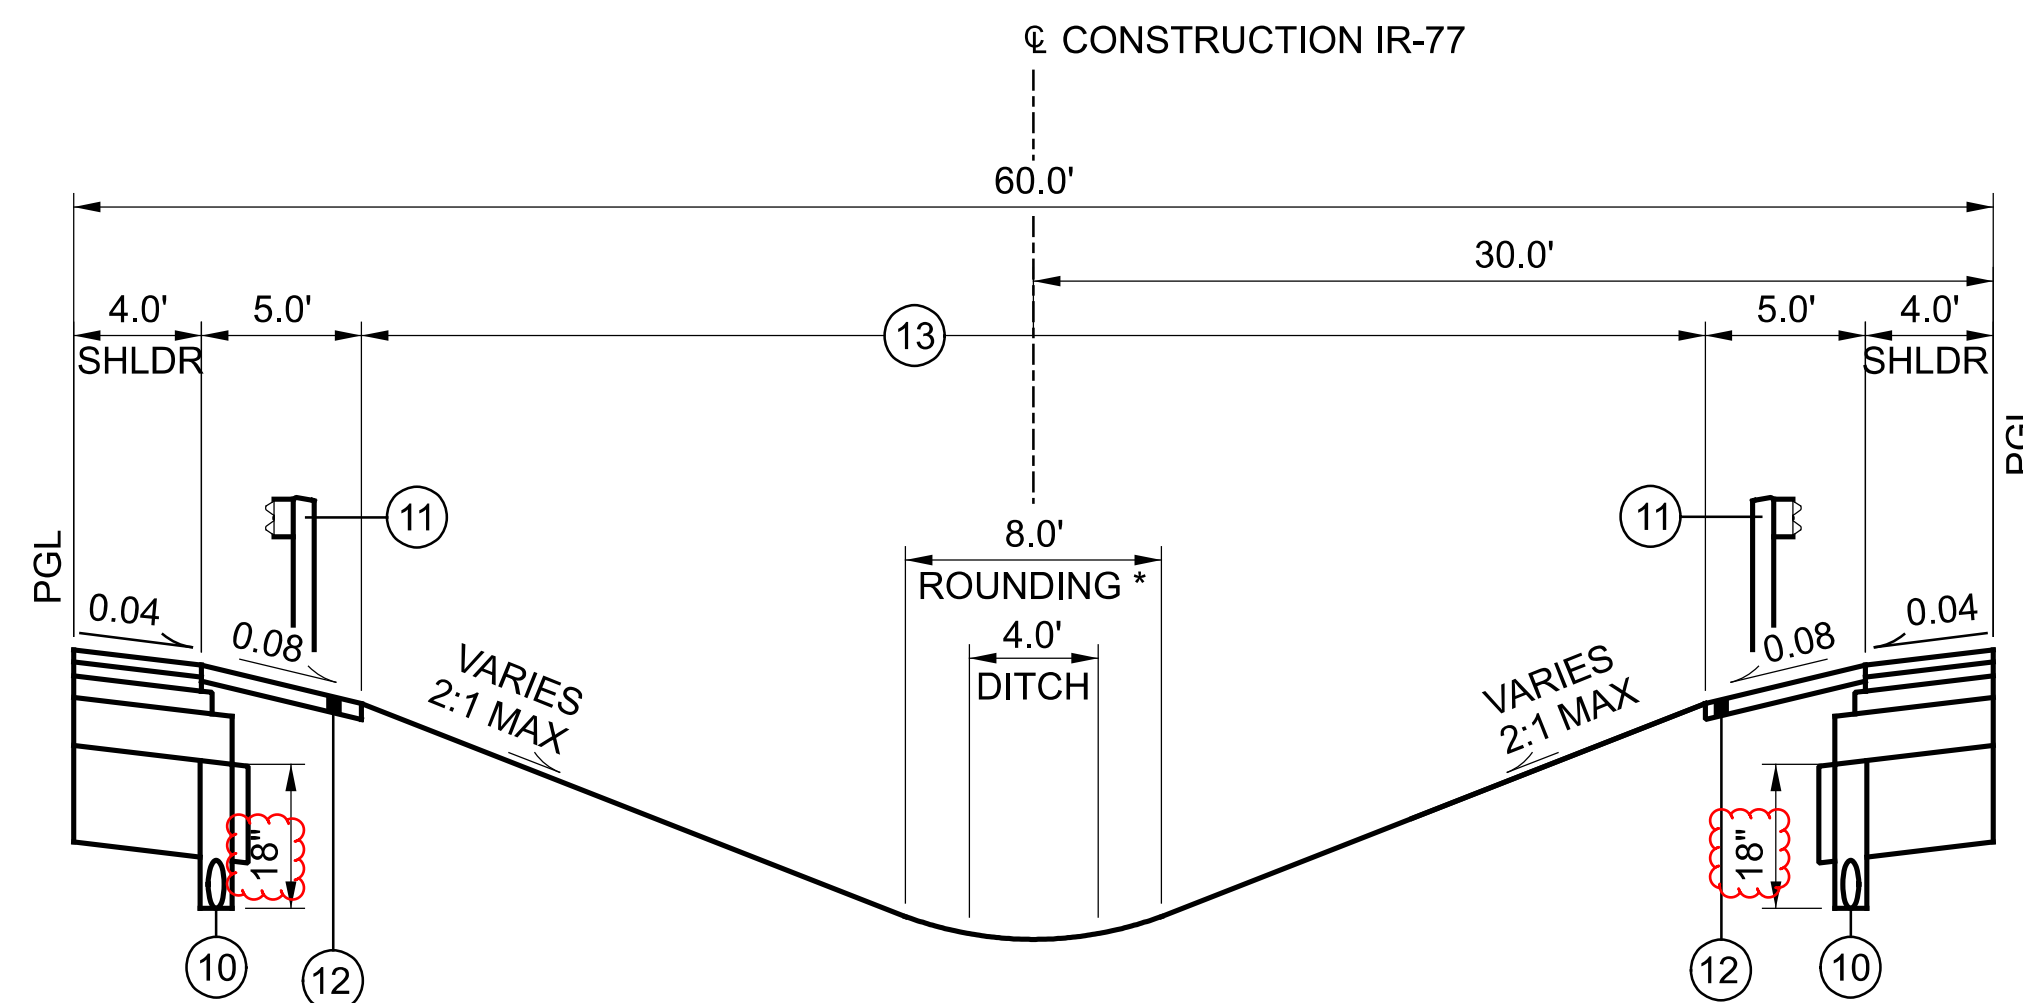


PROPOSED MEDIAN GRADING - IR-77
 STA 911+52.42 TO STA 918+12.95


TYPICAL SECTIONS - PROPOSED

* WHERE VEGETATED BIOFILTERS ARE PROPOSED, NO ROUNDING IS REQUIRED.
 FOR GUARDRAIL LOCATIONS, SEE SHEETS 202 - 232


FOR COMPACTED AGGREGATE DETAIL, SEE SHEET 12
 FOR BASE AND SUBBASE STEP DETAIL, SEE SHEET 12
 FOR ROUNDING DETAIL, SEE SHEET 12
 FOR BENCHING DETAIL, SEE SHEET 12
 FOR PROPOSED PAVEMENT LEGEND, SEE SHEET 12
 FOR UNDERDRAIN DETAILS, SEE SHEETS 562 - 563

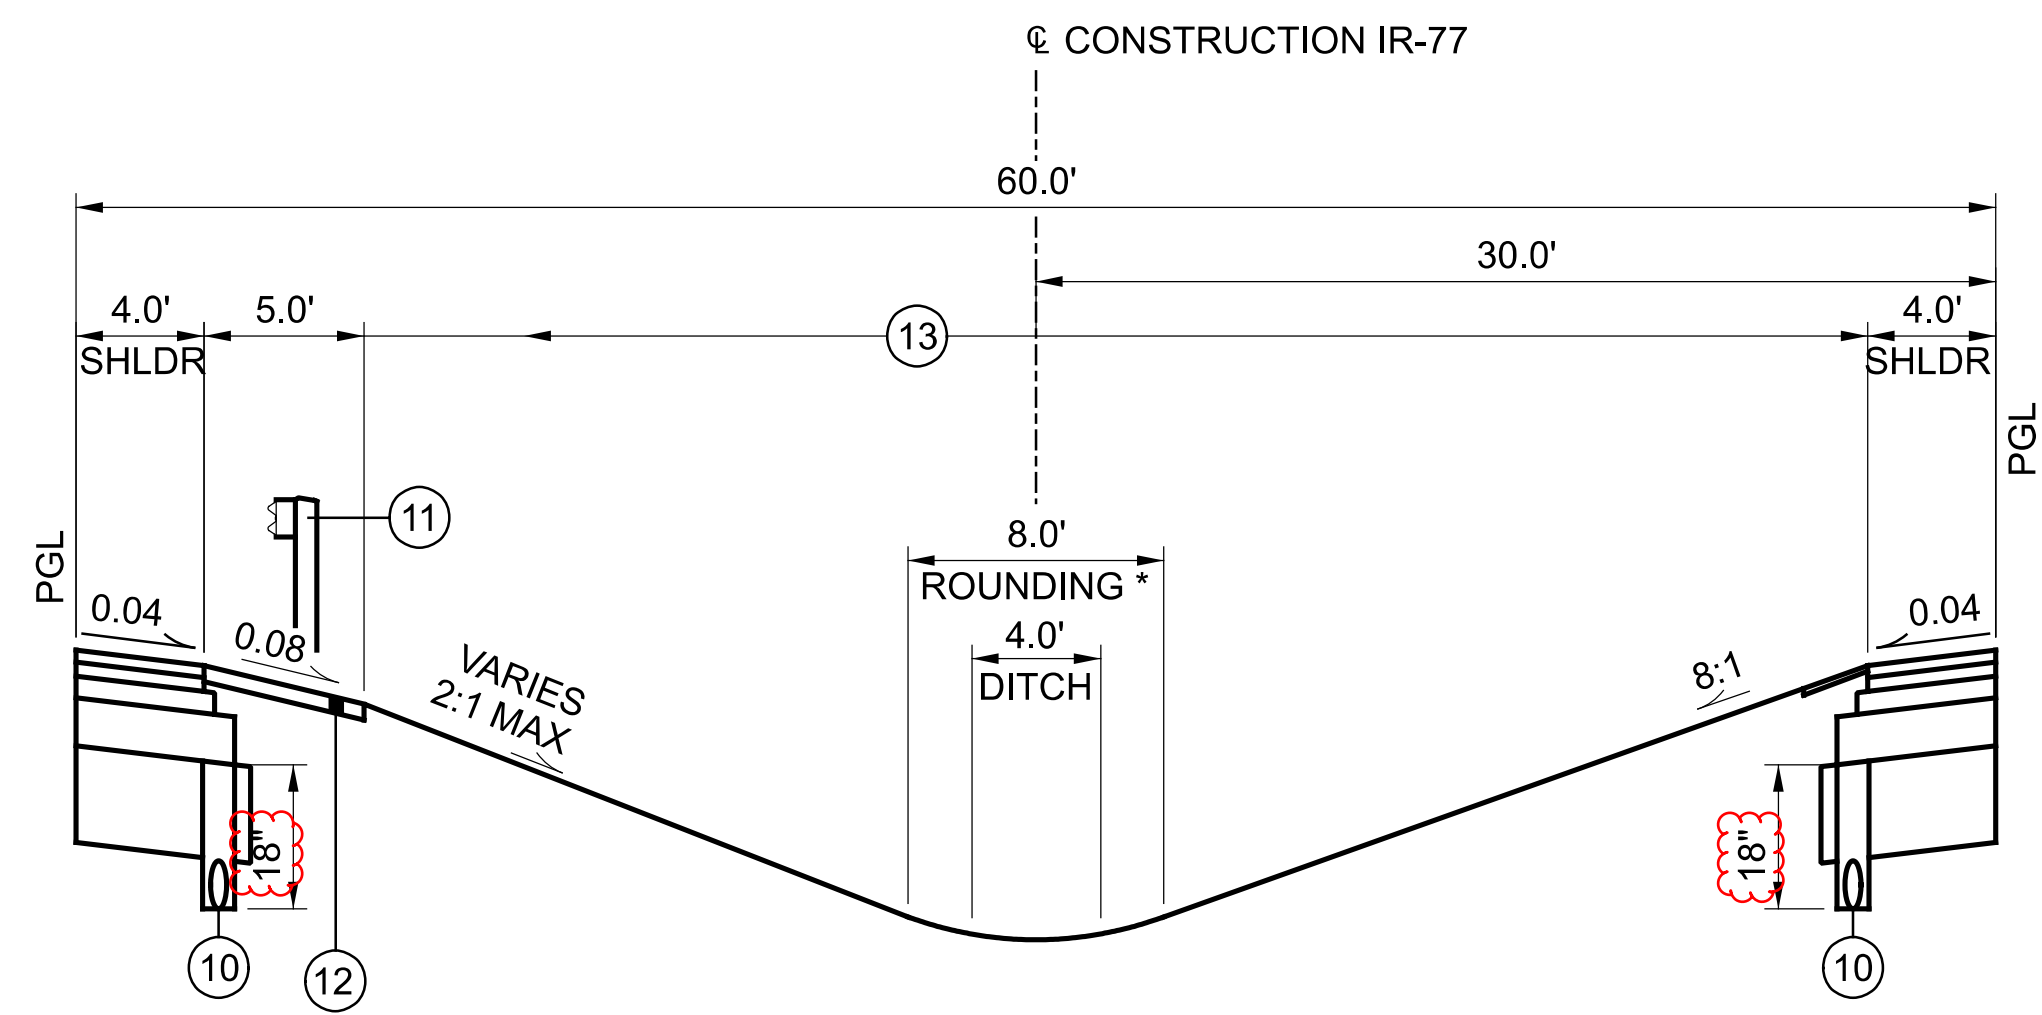


PROPOSED MEDIAN GRADING - IR-77
 STA 918+12.95 TO STA 946+02.43
 STA 958+47.31 TO STA 959+00.00

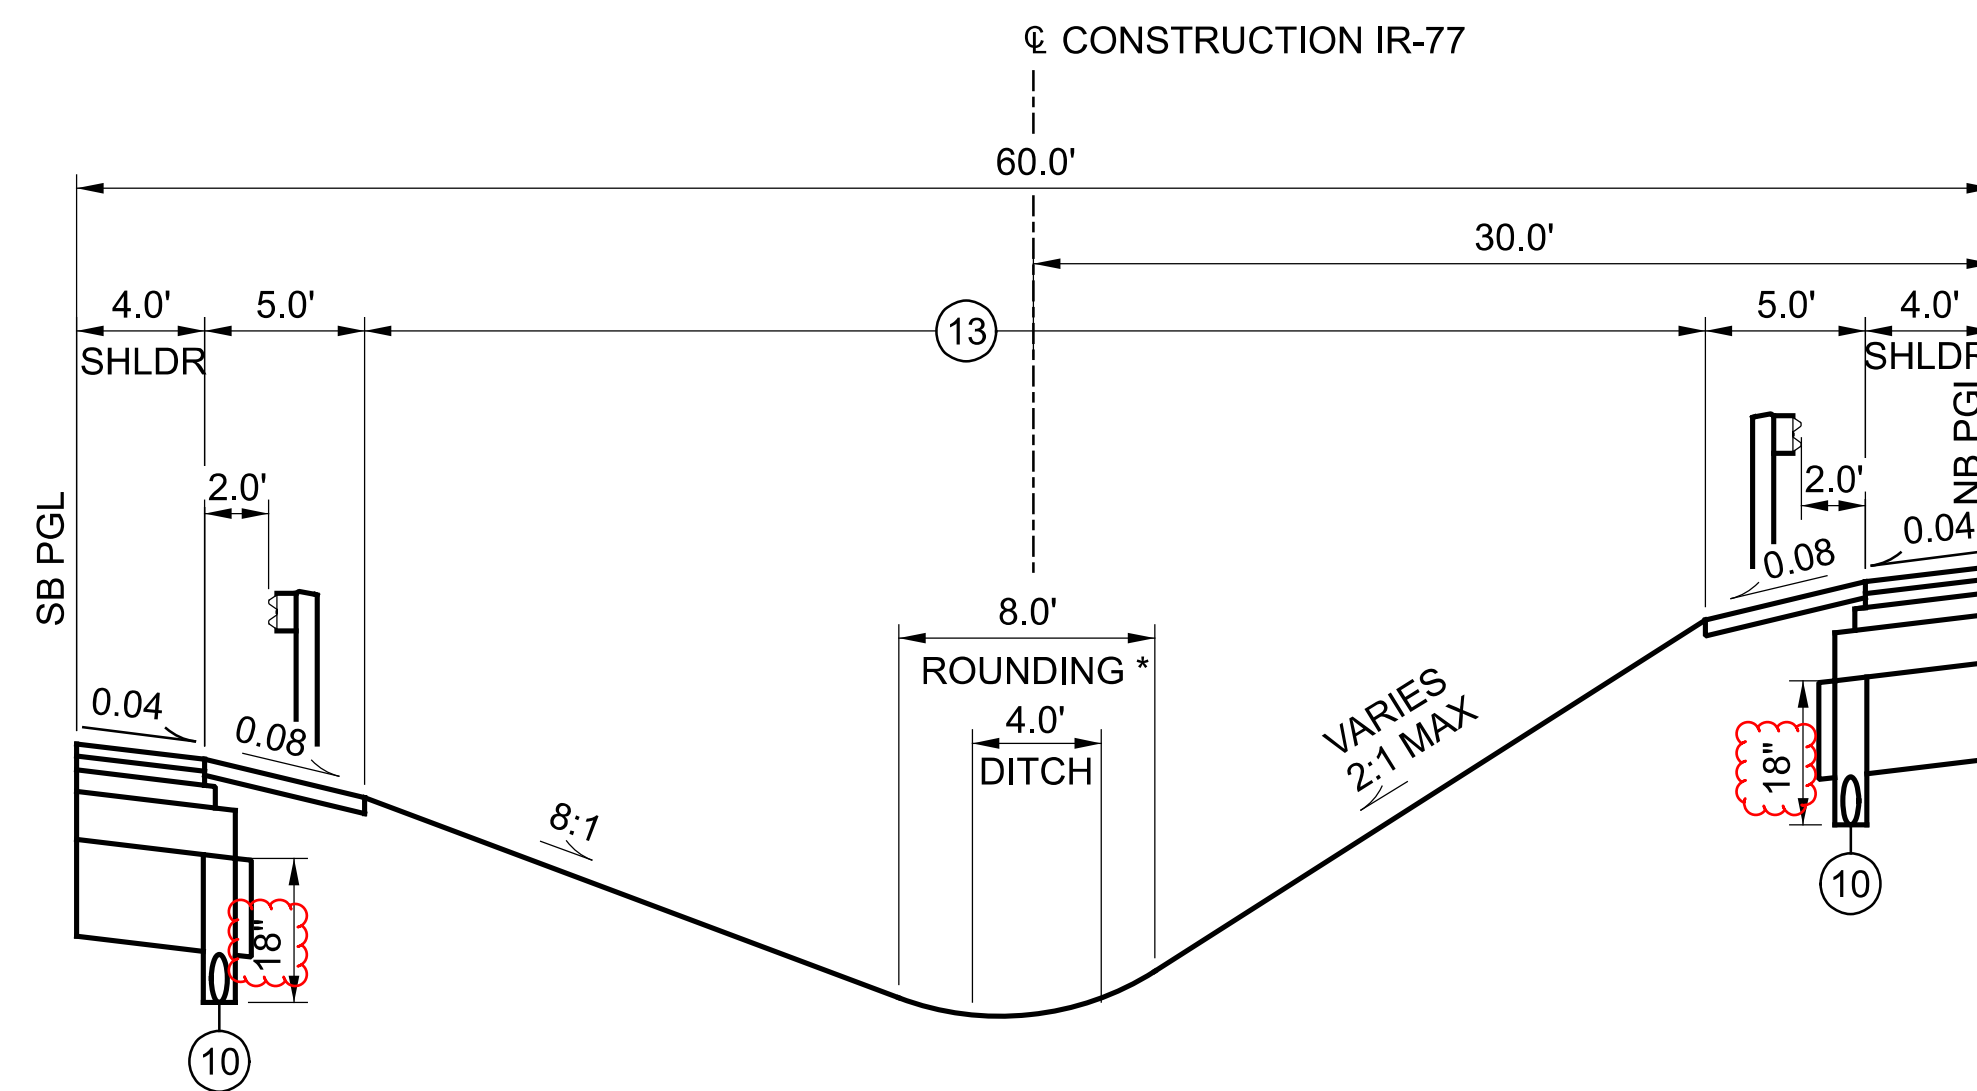

PROPOSED BIFURCATED MEDIAN GRADING - IR-77
 STA 1012+85.99 TO STA 1016+23.34

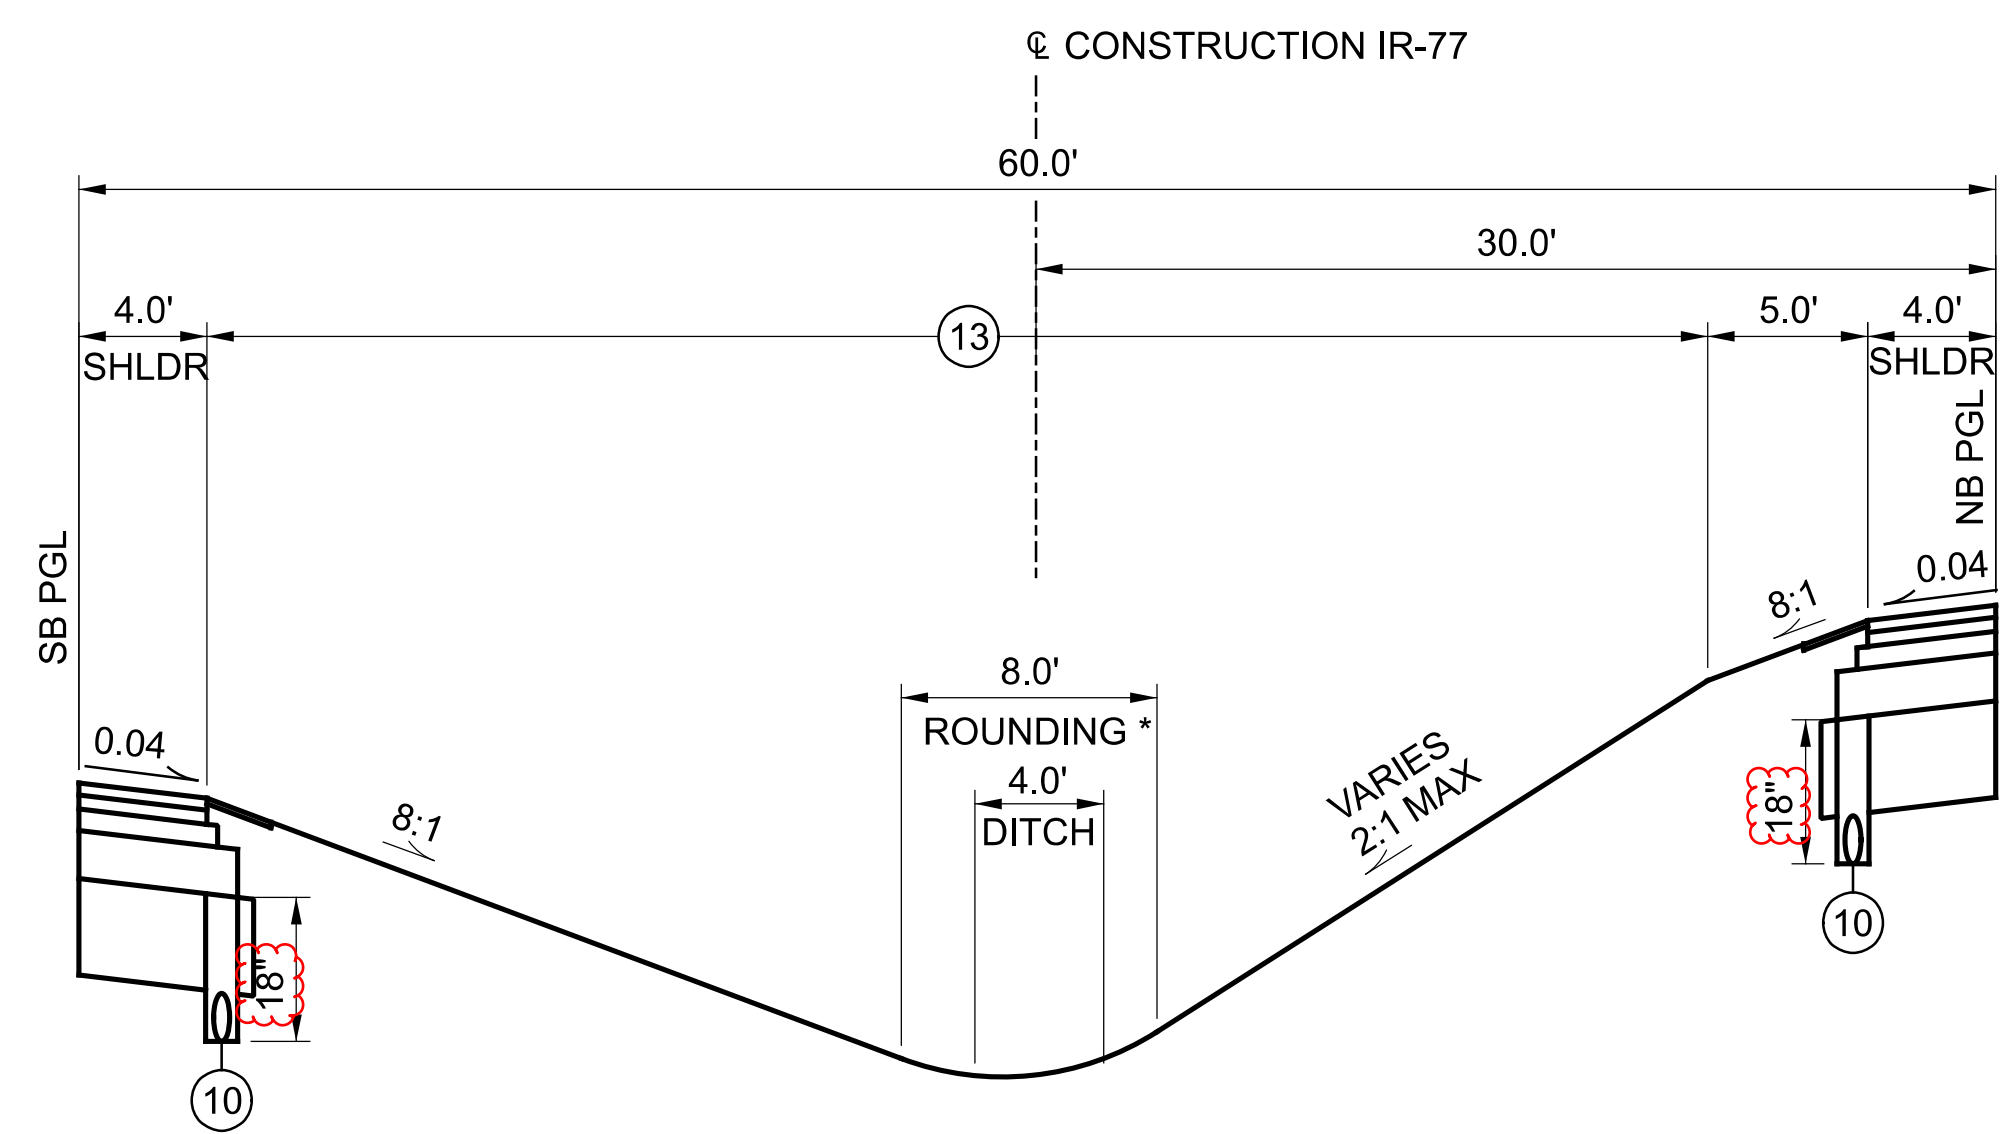

PROPOSED BIFURCATED MEDIAN GRADING - IR-77
 STA 1007+22.84 TO STA 1011+01.49

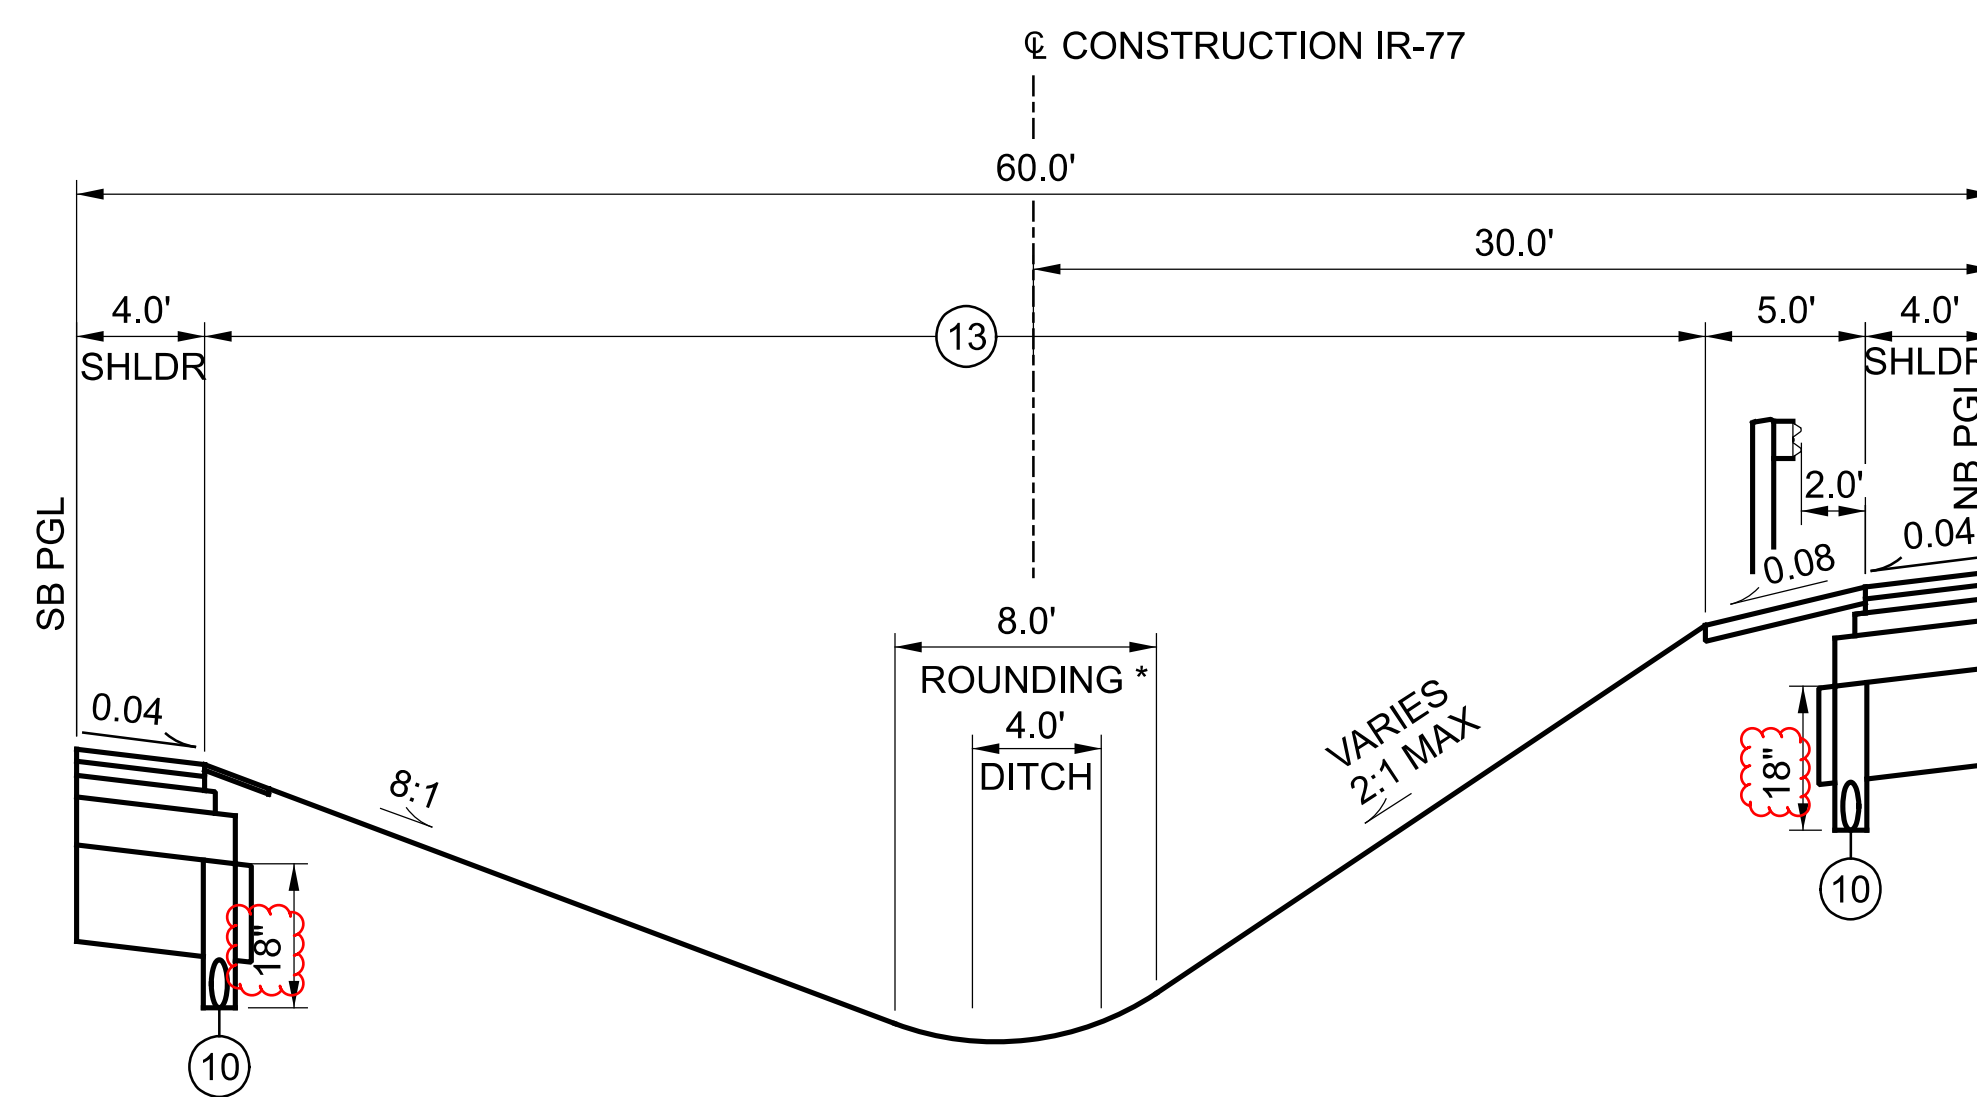

PROPOSED BIFURCATED MEDIAN GRADING - IR-77
 STA 1016+23.34 TO STA 1023+50.00

TYPICAL SECTIONS - PROPOSED

* WHERE VEGETATED BIOFILTERS ARE PROPOSED, NO ROUNDING IS REQUIRED.
 FOR GUARDRAIL LOCATIONS, SEE SHEETS 202 - 232

FOR COMPACTED AGGREGATE DETAIL, SEE SHEET 12
 FOR BASE AND SUBBASE STEP DETAIL, SEE SHEET 12
 FOR ROUNDING DETAIL, SEE SHEET 12
 FOR BENCHING DETAIL, SEE SHEET 12
 FOR PROPOSED PAVEMENT LEGEND, SEE SHEET 12
 FOR UNDERDRAIN DETAILS, SEE SHEETS 562 - 563

REVIEW OF DRAINAGE FACILITIES

PRIOR TO THE START OF WORK AND AGAIN BEFORE FINAL ACCEPTANCE, PERFORM AN INSPECTION WITH REPRESENTATIVES OF THE DEPARTMENT, CONTRACTOR AND LOCALS OF ALL EXISTING DRAINAGE FACILITIES THAT ARE TO REMAIN IN SERVICE WHICH MAY BE AFFECTED BY THE WORK. THE CONDITION OF THE EXISTING CONDUITS AND THEIR APPURTENANCES IS DETERMINED FROM FIELD OBSERVATIONS. RECORDS OF THE INSPECTION ARE MAINTAINED BY THE DEPARTMENT.

CONFIRM ALL EXISTING SEWERS INSPECTED INITIALLY BY THE ABOVE-MENTIONED PARTIES ARE MAINTAINED AND LEFT IN A CONDITION COMPARABLE TO THAT DETERMINED BY THE ORIGINAL INSPECTION. THE CONTRACTOR IS RESPONSIBLE TO CORRECT ANY CHANGE IN THE CONDITION RESULTING FROM THEIR OPERATIONS AS DIRECTED AND APPROVED BY THE ENGINEER.

PAYMENT FOR ALL OPERATIONS DESCRIBED ABOVE IS INCLUDED IN THE CONTRACT PRICE FOR THE PERTINENT 611 CONDUIT ITEMS.

EXISTING SUBSURFACE DRAINAGE

PROVIDE UNOBSTRUCTED OUTLETS FOR ALL EXISTING UNDERDRAINS OR AGGREGATE DRAINS ENCOUNTERED DURING CONSTRUCTION.

PROVIDE AN OUTLET PER STANDARD CONSTRUCTION DRAWING DM-1.1 FOR ALL UNDERDRAINS THAT OUTLET TO A SLOPE. UNDERDRAINS THAT CAN BE CONNECTED TO THE NEW OR EXISTING UNDERDRAINS AT THE END OF THE PROJECT LIMITS AS WELL AS ALL NECESSARY BENDS OR BRANCHES REQUIRED FOR CONNECTION ARE INCLUDED IN THE BASIS OF PAYMENT FOR UNCLASSIFIED PIPE UNDERDRAINS.

THE FOLLOWING ESTIMATED QUANTITIES HAVE BEEN INCLUDED IN THE GENERAL SUMMARY FOR THE WORK NOTED ABOVE:

ITEM 601, TIED CONCRETE BLOCK MAT WITH TYPE 1 UNDERLAYMENT 25 SQ. YD.

ITEM 611, 6 " CONDUIT TYPE F FOR UNDERDRAIN OUTLETS 100 FT.
ITEM 611, PRECAST REINFORCED CONCRETE OUTLET 2 EACH
ITEM 605, 6 " UNCLASSIFIED PIPE UNDERDRAINS WITH GEOTEXTILE FABRIC 200 FT.

POST CONSTRUCTION STORM WATER TREATMENT

THIS PLAN UTILIZES STRUCTURAL BEST MANAGEMENT PRACTICES (BMP'S) FOR POST CONSTRUCTION STORM WATER TREATMENT.

VEGETATED FILTER STRIP

THIS PLAN UTILIZES VEGETATED FILTER STRIP(S) FOR POST CONSTRUCTION STORM WATER TREATMENT. PLACE EITHER ITEM 660 SODDING OR ITEM 659 SEEDING AND MULCHING WITH A 4-INCH LIFT OF TOPSOIL AND ITEM 670, SLOPE EROSION PROTECTION TO ALL DISTURBED AREAS DESIGNATED AS VEGETATED FILTER STRIPS, THE EDGE OF SHOULDER, AND THE FORESLOPE AS SPECIFIED IN THE PLANS.

ROUNDING

THE ROUNDING AT SLOPE BREAKPOINTS SHOWN ON THE TYPICAL SECTIONS APPLIES TO ALL CROSS SECTIONS, EVEN THOUGH OTHERWISE SHOWN.

SEEDING AND MULCHING

THE FOLLOWING QUANTITIES ARE PROVIDED TO PROMOTE GROWTH AND CARE OF PERMANENT SEEDED AREAS:

ITEM 659, SOIL ANALYSIS TEST 2 EACH
ITEM 659, TOPSOIL 21145 CU. YD.
ITEM 659, SEEDING AND MULCHING 190487 SQ. YD.
ITEM 659, REPAIR SEEDING AND MULCHING 9525 SQ. YD.
ITEM 659, INTER-SEEDING 9525 SQ. YD.
ITEM 659, COMMERCIAL FERTILIZER 51.5 TON
ITEM 659, LIME 39.4 ACRES
ITEM 659, WATER 1543 M. GAL.
ITEM 659, MOWING 429 M. SQ.FT.

SEEDING AND MULCHING SHALL BE APPLIED TO ALL AREAS OF EXPOSED SOIL BETWEEN THE RIGHT-OF-WAY LINES, AND WITHIN THE CONSTRUCTION LIMITS FOR AREAS OUTSIDE THE RIGHT-OF-WAY LINES COVERED BY WORK AGREEMENT OR SLOPE EASEMENT.

QUANTITY CALCULATIONS FOR SEEDING AND MULCHING ARE BASED ON LIMITS IDENTIFIED AS NECESSARY IN THE CROSS-SECTIONS. ANY ADDITIONAL AREAS OUTSIDE OF THE AREAS IDENTIFIED IN THE CROSS-SECTIONS THAT ARE DISTURBED BY THE CONTRACTOR TO FACILITATE CONSTRUCTION MUST BE RESTORED IN ACCORDANCE WITH C&MS 107.10 AND CONSIDERED INCIDENTAL TO THE WORK. NO ADDITIONAL COMPENSATION WILL BE MADE FOR THESE AREAS

PART-WIDTH CONSTRUCTION

BECAUSE OF THE NECESSITY TO BUILD THIS PROJECT UNDER TRAFFIC AND TO CONSTRUCT THE FULL PAVEMENT WIDTH IN STAGES, EXERCISE CARE TO PREVENT THE CONSTRUCTION OF A BUTT JOINT IN THE BASE COURSES. LAP LONGITUDINAL JOINTS AS SHOWN ON STANDARD CONSTRUCTION DRAWING BP-3.1.

CONNECTION BETWEEN EXISTING AND PROPOSED GUARDRAIL

WHEN IT IS NECESSARY TO SPLICE PROPOSED GUARDRAIL TO EXISTING GUARDRAIL, ONLY THE EXISTING GUARDRAIL SHALL BE CUT, DRILLED, OR PUNCHED. THE CONNECTION SHALL BE MADE USING A W-BEAM, BEAM SPLICE AS SHOWN IN AASHTO M 180-12, EXCEPT THE BEAM WASHERS ARE NOT TO BE USED. PAYMENT SHALL BE INCLUDED IN THE CONTRACT PRICE FOR THE RESPECTIVE GUARDRAIL ITEMS.



ITEM 606 - ANCHOR ASSEMBLY, MGS TYPE E MASH 2016

THIS ITEM SHALL CONSIST OF FURNISHING AND INSTALLING ANY OF THE GUARDRAIL END TERMINALS FOR TYPE MGS GUARDRAIL AS LISTED ON ROADWAY ENGINEERING'S WEB PAGE UNDER ROADSIDE SAFETY DEVICES FOR APPROVED GUARDRAIL END TREATMENTS. INSTALLATION SHALL BE AT THE LOCATIONS SPECIFIED IN THE PLANS, IN ACCORDANCE WITH THE MANUFACTURER'S SPECIFICATIONS.

THE FACE OF THE TYPE E IMPACT HEAD SHALL BE COVERED WITH A SHEET OF TYPE G REFLECTIVE SHEETING, PER CMS 730.19.

REFER TO THE MANUFACTURER'S INSTRUCTIONS REGARDING THE INSTALLATION OF, AND THE GRADING AROUND THE FOUNDATION TUBES AND GROUND STRUT. THE TOP OF ANY FOUNDATION TUBE SHOULD BE LESS THAN 4 INCHES ABOVE THE GROUND. THE PLACEMENT OF THE FOUNDATION TUBES SHOULD BE AN APPROPRIATE DEPTH BELOW THE LEVEL LINE IN ORDER TO MAINTAIN THE FINISHED GUARDRAIL HEIGHT OF 31 INCHES FROM THE EDGE OF THE SHOULDER.

ON-SITE GRADING IS REQUIRED IF THE TOP OF THE FOUNDATION TUBES OR TOP OF THE GROUND STRUT DOES PROJECT MORE THAN 4 INCHES ABOVE THE GROUND LINE.

PAYMENT FOR THE ABOVE WORK SHALL BE MADE AT THE UNIT PRICE BID FOR ITEM 606, ANCHOR ASSEMBLY, MGS TYPE E MASH 2016 EACH, AND SHALL INCLUDE ALL LABOR, TOOLS, EQUIPMENT AND MATERIALS NECESSARY TO CONSTRUCT A COMPLETE AND FUNCTIONAL ANCHOR ASSEMBLY SYSTEM, INCLUDING ALL RELATED TRANSITIONS, REFLECTIVE SHEETING, HARDWARE, GRADING, EMBANKMENT AND EXCAVATION NOT SEPARATELY SPECIFIED, AS REQUIRED BY THE MANUFACTURER.

ITEM 622 - CONCRETE BARRIER, END ANCHORAGE REINFORCED TYPE D

PROVIDE REINFORCED END ANCHORAGES AT THE ENDS OF CONCRETE BARRIER RUNS AND AT INTERRUPTIONS IN BARRIER CAUSED BY EXPANSION JOINTS. WHEN BARRIER DOES NOT ABUT ANOTHER BARRIER RUN, CONSTRUCT THE LAST 15' USING THE END ANCHORAGE PER STD DWG RM-4.5.

ITEM 622 - CONCRETE BARRIER, END ANCHORAGE REINFORCED TYPE D, 4 EA.

ITEM SPECIAL - FILL AND PLUG EXISTING CONDUIT

THIS ITEM CONSISTS OF THE CONSTRUCTION OF BULKHEADS IN AN EXISTING LESS THAN 24" IN DIAMETER CONDUIT AND FILLING THE AREA SEALED OFF WITH ITEM 613, SAND OR OTHER MATERIAL APPROVED BY THE ENGINEER.

LOCATE THE BULKHEADS AT THE LIMITS OF THE AREA TO BE FILLED, AS INDICATED ON THE PLANS. THE BULKHEADS CONSIST OF BRICK OR CONCRETE MASONRY WITH A MINIMUM THICKNESS OF 12 INCHES. PUMP THE FILL MATERIAL INTO PLACE OR BY OTHER MEANS APPROVED BY THE ENGINEER, SO THAT AFTER SETTLEMENT, AT LEAST 90 PERCENT OF THE CROSSSECTIONAL AREA OF THE CONDUIT, FOR ITS ENTIRE LENGTH IS FILLED. THE LENGTH OF FILLED AND PLUGGED CONDUIT TO BE PAID FOR IS THE ACTUAL NUMBER OF FEET (MEASURED ALONG THE CENTERLINE OF EACH CONDUIT FROM OUTER FACE TO OUTER FACE OF BULKHEADS) FILLED AND PLUGGED AS DESCRIBED ABOVE.

IN LIEU OF FILLING AND PLUGGING THE EXISTING CONDUIT, THE PIPE MAY BE CRUSHED AND BACKFILLED PER 203, OR IT MAY BE REMOVED. THE LENGTH, MEASURED AS PROVIDED ABOVE, WILL BE PAID FOR AT THE CONTRACT PRICE PER FOOT FOR, ITEM SPECIAL, FILL AND PLUG EXISTING CONDUIT.

PAVING UNDER GUARDRAIL

THIS OPERATION SHALL INCLUDE PREPARATION OF THE GRADED SHOULDER USING ITEM 209, LINEAR GRADING, AS PER PLAN AND PAVING UNDER THE GUARDRAIL USING 441 ASPHALT CONCRETE INTERMEDIATE COURSE, TYPE 1, (449), UNDER GUARDRAIL, AS PER PLAN.

ITEM 209, LINEAR GRADING, AS PER PLAN SHALL CONSIST OF EXCAVATING TOPSOIL, AND PLACING GRANULAR MATERIAL.

ALL COLLECTED DEBRIS AND TOPSOIL, INCLUDING RHIZOMES, ROOTS AND OTHER VEGETATIVE PLANT MATERIAL SHALL BE REMOVED AND DISPOSED OF AS SPECIFIED IN 105.17.

THE REMOVED MATERIAL SHALL BE REPLACED WITH COMPACTIBLE GRANULAR MATERIAL CONFORMING TO 703.16 PLACED TO GRADE AS DETAILED ON THE TYPICAL SECTION OR AS APPROVED BY THE ENGINEER.

ALL EQUIPMENT, MATERIALS AND LABOR REQUIRED TO PERFORM THE WORK OUTLINED ABOVE SHALL BE INCLUDED FOR PAYMENT UNDER ITEM 209, LINEAR GRADING, AS PER PLAN.

PAVING UNDER GUARDRAIL SHALL CONSIST OF PLACING ITEM 441 TO THE DEPTH SPECIFIED USING ONE OF THE FOLLOWING METHODS:

METHOD A:

- 1. SET GUARDRAIL POSTS
- 2. PLACE ITEM 441

METHOD B:

- 1. PLACE ITEM 441
- 2. BORE ASPHALT AT POST LOCATIONS (MAY BE OMITTED IF STEEL POSTS ARE USED)
- 3. SET GUARDRAIL POSTS
- 4. PATCH AROUND POSTS. THE MATERIALS USED FOR PATCHING SHALL BE AN ASPHALT CONCRETE APPROVED BY THE ENGINEER. PATCHED AREAS SHALL BE COMPACTED USING EITHER HAND OR MECHANICAL METHODS. FINISHED SURFACES SHALL BE SMOOTH AND SLOPED TO DRAIN AWAY FROM THE POSTS.

ALL EQUIPMENT, MATERIALS AND LABOR REQUIRED TO PERFORM THE WORK OUTLINED ABOVE, WITH THE EXCEPTION OF SETTING GUARDRAIL POSTS, SHALL BE INCLUDED FOR PAYMENT UNDER ITEM 441, ASPHALT CONCRETE, INTERMEDIATE COURSE, TYPE 1 (448), UNDER GUARDRAIL, AS PER PLAN.

EARTHWORK FOR MAINLINE PAVEMENT

ITEM 203, EMBANKMENT INCLUDES CONSTRUCTION EMBANKMENTS TO PLAN LINES AND INCLUDES FURNISHING AND PLACING SUITABLE BORROW MATERIAL AS SPECIFIED IN 203. BENCHING PER SECTION 800 OF THE GEOTECHNICAL DESIGN MANUAL SHALL BE FOLLOWED AND ANY TEMPORARY FILL SHALL BE CONSIDERED INCIDENTAL TO THE PROJECT.

EXCAVATED SOILS ON THE PROJECT SITE MAY NOT BE SUITABLE FOR EMBANKMENT USE. THE CONTRACTOR SHALL BE RESPONSIBLE FOR ENSURING THAT ANY ON-SITE SOIL USED AS EMBANKMENT MEETS THE REQUIREMENTS OF 203.

EXCAVATION SHALL INCLUDE THE FULL DEPTH ASPHALT PAVEMENT SHOULDERS AND/OR PAVEMENT LIMITS AND IS INCLUDED IN THE VOLUMES PROVIDED BELOW.

THE FOLLOWING IS A SUMMARY OF ALL EARTHWORK QUANTITIES GENERATED BY THE CROSS SECTIONS.

IR-77

| | |
|-----------------|----------------|
| 203, EXCAVATION | 125565 CU. YD. |
| 203, EMBANKMENT | 50788 CU. YD. |

SR-176

| | | |
|--------|-----------------|--------------|
| RAMP A | 203, EXCAVATION | 1624 CU. YD. |
| | 203, EMBANKMENT | 337 CU. YD. |
| RAMP E | 203, EXCAVATION | 487 CU. YD. |
| | 203, EMBANKMENT | 264 CU. YD. |
| RAMP B | 203, EXCAVATION | 1489 CU. YD. |
| | 203, EMBANKMENT | 1516 CU. YD. |
| RAMP C | 203, EXCAVATION | 1805 CU. YD. |
| | 203, EMBANKMENT | 1658 CU. YD. |
| RAMP D | 203, EXCAVATION | 1766 CU. YD. |
| | 203, EMBANKMENT | 1112 CU. YD. |

IR-271

| | | |
|--------|-----------------|-------------|
| RAMP A | 203, EXCAVATION | 446 CU. YD. |
| | 203, EMBANKMENT | 0 CU. YD. |
| RAMP B | 203, EXCAVATION | 499 CU. YD. |
| | 203, EMBANKMENT | 58 CU. YD. |
| RAMP C | 203, EXCAVATION | 431 CU. YD. |
| | 203, EMBANKMENT | 5 CU. YD. |
| RAMP D | 203, EXCAVATION | 227 CU. YD. |
| | 203, EMBANKMENT | 49 CU. YD. |

SR-21

| | | |
|--------|-----------------|--------------|
| RAMP F | 203, EXCAVATION | 2245 CU. YD. |
| | 203, EMBANKMENT | 813 CU. YD. |

THE FOLLOWING GRAND TOTAL HAS BEEN CARRIED TO THE GENERAL SUMMARY:

| | |
|-----------------|----------------|
| 203, EXCAVATION | 136584 CU. YD. |
| 203, EMBANKMENT | 56600 CU. YD. |

RUMBLE STRIPES (ASPHALT CONCRETE)

THE FOLLOWING ITEMS AND QUANTITIES HAVE BEEN PROVIDED TO INSTALL RUMBLE STRIPES ALONG THE FOLLOWING ROUTES:

EDGE LINE:
IR 77 NORTHBOUND: SLM 28.75 TO SLM 32.27
IR 77 SOUTHBOUND: SLM 28.75 TO SLM 32.27

THE LONGITUDINAL JOINT PREPARATION PAY ITEM IS ONLY PROVIDED FOR THE LOCATIONS OF THE INSTALLATION OF THE CENTERLINE RUMBLE STRIPES. IN ALL OTHER AREAS WHERE JOINTS ARE REQUIRED THE CONTRACTOR SHALL FOLLOW CMS 401.

OBJECT MARKERS AND CONDUIT IDENTIFICATION SIGNS

OBJECT MARKERS WILL BE PLACED ON EACH APPROACH OFF THE LEFT AND RIGHT SHOULDER, FACING TRAFFIC, AND BEHIND THE GUARDRAIL IF APPLICABLE. ONE OM3L AND ONE OM-3R WILL BE INSTALLED AT EACH APPROACH. THE SIGNS WILL BE MOUNTED ON NEW NO. 2 POSTS AND SHALL BE INSTALLED AS PER STANDARD CONSTRUCTION DRAWING TC-41.20, MOST CURRENT REVISION. EACH POST WILL BE 10.5' IN LENGTH.

CONDUIT IDENTIFICATION SIGNS (I-H25b) WILL BE INSTALLED ON THE SAME POST AND DIRECTLY BELOW THE OBJECT MARKER OFF THE RIGHT SHOULDER ON EACH APPROACH. A QUANTITY OF ONE SIGN WILL BE INSTALLED AT EACH APPROACH. THE SIGNS WILL HAVE A NON-REFLECTIVE WHITE SHEETING BACKGROUND. INSTALL SIGNS FOR THE FOLLOWING CONDUITS (CFN#):

| CFN # | ENDS | CFN # | ENDS | CFN # | ENDS | CFN # | ENDS |
|---------|------|---------|------|---------|------|---------|------|
| 1809158 | 1 | 1830176 | 2 | 1989936 | 1 | 1989970 | 1 |
| 1820914 | 2 | 1830178 | 2 | 1989937 | 1 | 1989971 | 1 |
| 1820915 | 2 | 1830179 | 2 | 1989938 | 1 | 1989972 | 1 |
| 1820920 | 2 | 1847706 | 2 | 1989950 | 1 | 1989973 | 1 |
| 1820921 | 2 | 1847707 | 2 | 1989960 | 1 | 1989974 | 1 |
| 1822009 | 2 | 1847709 | 2 | 1989961 | 1 | 1989975 | 1 |
| 1822010 | 1 | 1847711 | 2 | 1989962 | 1 | 1989976 | 1 |
| 1830170 | 2 | 1989922 | 1 | 1989963 | 1 | 1989977 | 1 |
| 1830171 | 1 | 1989923 | 1 | 1989964 | 1 | 1990047 | 1 |
| 1830172 | 2 | 1989924 | 2 | 1989965 | 1 | 1990048 | 1 |
| 1830174 | 2 | 1989925 | 1 | 1989969 | 1 | | |

THE FOLLOWING QUANTITIES ARE FOR EACH APPROACH END:

ITEM 630 – SIGN, FLAT SHEET, 730.20, 1 SQ FT
ITEM 630 – SIGN, FLAT SHEET, 6 SQ FT
ITEM 630 – GROUND MOUNTED SUPPORT, NO. 2 POST, 21 FT
ITEM 630 – REMOVAL OF GROUND MOUNTED SIGN AND DISPOSAL, 3 EACH
ITEM 630 – REMOVAL OF GROUND MOUNTED POST SUPPORT AND DISPOSAL, 2 EACH

THE FOLLOWING QUANTITIES HAVE BEEN CARRIED TO THE GENERAL SUMMARY:

| | |
|--|-----------|
| ITEM 630 – SIGN, FLAT SHEET, 730.20 | 59 SQ FT |
| ITEM 630 – SIGN, FLAT SHEET | 354 SQ FT |
| ITEM 630 – GROUND MOUNTED SUPPORT, NO. 2 POST | 1239 FT |
| ITEM 630 – REMOVAL OF GROUND MOUNTED SIGN AND DISPOSAL | 177 EACH |
| ITEM 630 – REMOVAL OF GROUND MOUNTED POST SUPPORT AND DISPOSAL | 118 EACH |


PAVEMENT RESTORATION FOR PIPE INSTALLATIONS AND/OR REMOVAL OF PIPES

THE FOLLOWING QUANTITIES HAVE BEEN PROVIDED FOR PAVEMENT RESTORATION FOLLOWING THE INSTALLATION AND/OR REMOVAL OF PIPES.

| | |
|---|-------|
| ITEM 202 - PAVEMENT REMOVED | 32 SY |
| ITEM 441 - 1 1/2" ASPHALT CONCRETE SURFACE COURSE, TYPE 1 (449), PG64-22, AS PER PLAN | 2 CY |
| ITEM 407 - NON-TRACKING TACK COAT (0.055 GAL/SY) | 2 GAL |
| ITEM 441 - 1 3/4" ASPHALT CONCRETE INTERMEDIATE COURSE, TYPE 2 (449) | 2 CY |
| ITEM 301 - 4" ASPHALT CONCRETE BASE, (449), PG64-22 | 4 CY |
| ITEM 304 - 4" AGGREGATE BASE | 4 CY |

THE ABOVE QUANTITIES ARE BASED ON A PAVEMENT RESTORATION WIDTH THAT INCLUDES THE TRENCH WIDTH PLUS TWO FEET ON EACH SIDE OF THE TRENCH.

PROVIDE ANY MATERIALS USED OUTSIDE THE LIMITS STATED ABOVE AT NO ADDITIONAL COST.

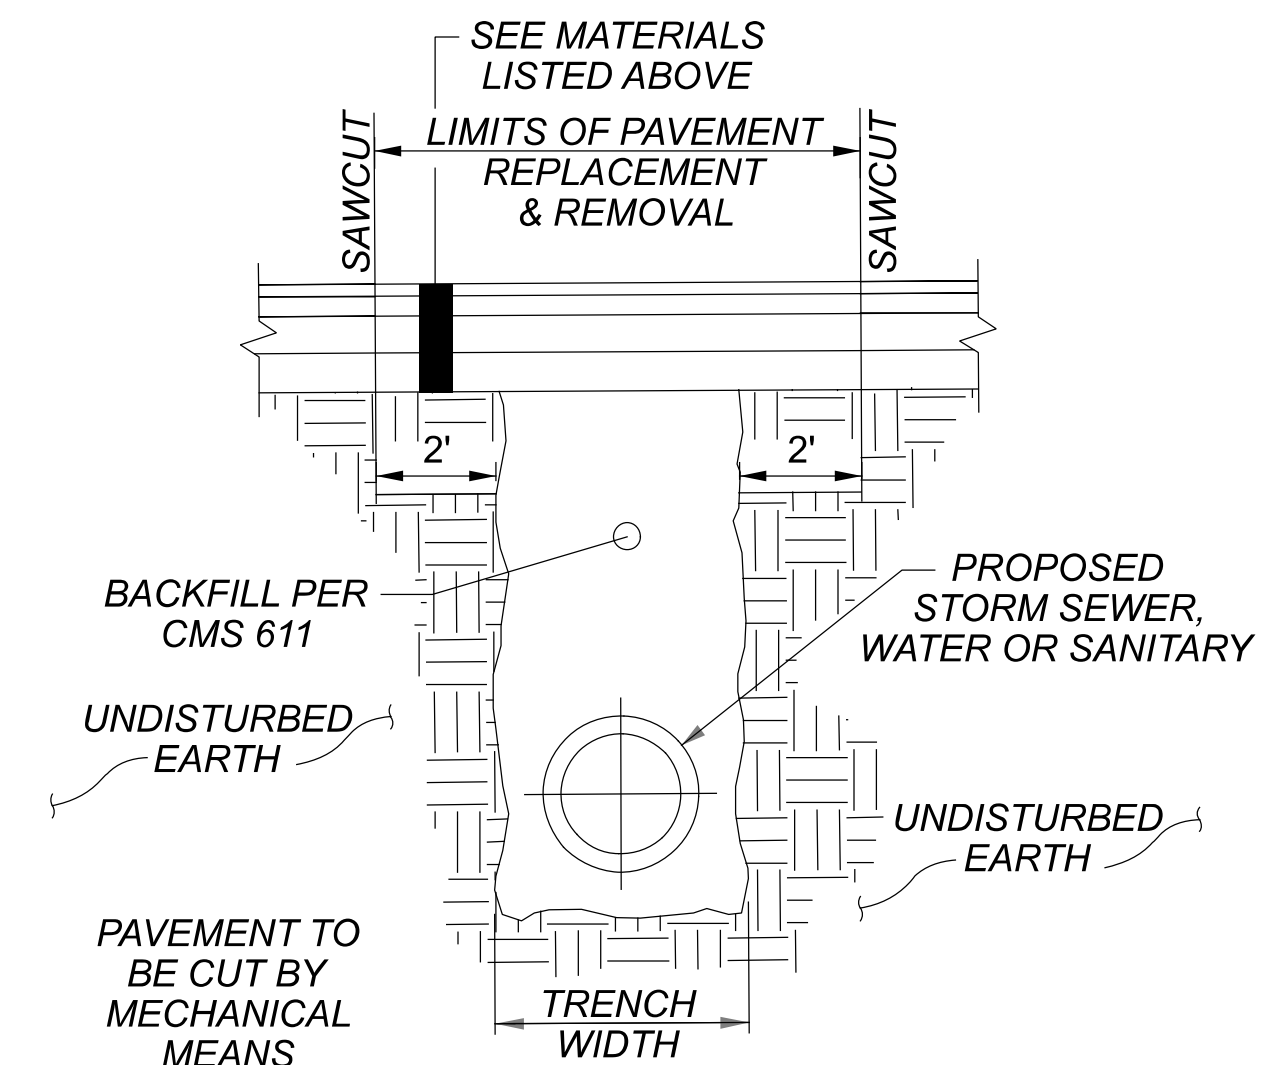

**PAVEMENT REPLACEMENT DETAIL
N.T.S.**

ITEM 617 - COMPACTED AGGREGATE, AS PER PLAN

IN LOW SHOULDER AREAS EXCEEDING 1", AND ADJACENT TO THE PAVED SHOULDERS WITHOUT GUARDRAIL, OR AS DIRECTED BY THE ENGINEER, RECYCLED ASPHALT PAVEMENT (RAP) SHALL BE USED IN AREAS ADJACENT TO THE PAVED BERM. THE RAP SHALL HAVE A MINIMUM PG CONTENT OF 4.5% AND MEET THE FOLLOWING GRADATION. ONCE THE STOCKPILE MEETS THE GRADATION, THE PG CONTENT OF THE RAP SHALL BE DETERMINED PER 441.03. THE RAP ANALYSIS MUST BE SUBMITTED TO THE ENGINEER FOR APPROVAL 2 WEEKS PRIOR TO USE. METHOD OF MEASUREMENT SHALL BE AS PER 617.06. PLACEMENT AND COMPACTION SHALL MEET THE REQUIREMENTS OF ITEM 617. ALL MATERIALS, LABOR, EQUIPMENT, TOOLS AND INCIDENTALS NECESSARY TO COMPLETE THE WORK SHALL BE INCLUDED IN THE UNIT PRICE BID FOR ITEM 617 COMPACTED AGGREGATE, AS PER PLAN.

MODIFIED GRADATION SHALL APPLY:
SIEVE TOTAL PERCENT PASSING
1- 1/2 " 100
3/4 " 50-100
NO. 4 35-70
NO. 30 9-33
NO. 200 0-13

AN ESTIMATED QUANTITY HAS BEEN PROVIDED IN THE GENERAL SUMMARY FOR THIS WORK.

ITEM 408 - PRIME COAT, AS PER PLAN

APPLY "MC-70" AT A RATE OF 0.4 GALLONS PER SQUARE YARD, OR AS DETERMINED BY THE ENGINEER, TO THE COMPLETED COMPACTED AGGREGATE SHOULDER.

ITEM 614 - MAINTAINING TRAFFIC

THIS ITEM SHALL CONSIST OF MAINTENANCE OF TRAFFIC ON EXISTING ROADWAYS AND RAMPS IN ACCORDANCE WITH THE OHIO MANUAL OF UNIFORM TRAFFIC CONTROL DEVICES FOR STREETS AND HIGHWAYS, CURRENT EDITION, LATEST REVISION, THE SPECIFICATIONS AND THE FOLLOWING:

- 1. RAMPS AND LOCAL ROADS: A MINIMUM OF ONE 11 FOOT LANE IN EACH DIRECTION SHALL BE MAINTAINED ON THE EXISTING PAVEMENT OR COMPLETED PAVEMENT DURING CONSTRUCTION OF THE WORK, EXCEPT AS NOTED IN THE PLANS.
2. A MINIMUM OF 2 LANES OF TRAFFIC IN EACH DIRECTION SHALL BE MAINTAINED ALONG THE MAINLINE OF IR-77 AT ALL TIMES BY USE OF THE EXISTING PAVEMENT, THE COMPLETED PAVEMENT, ITEM 615 PAVEMENT FOR MAINTAINING TRAFFIC, AND ITEM 615 ROADS FOR MAINTAINING TRAFFIC UNLESS APPROVED BY THE ENGINEER.
3. THE CONTRACTOR SHALL INFORM THE DISTRICT OFFICE (330) 786-2208, EIGHTEEN (18) DAYS PRIOR TO THE BEGINNING OF WORK.
4. TRUCK MOUNTED ATTENUATORS [TMA'S] SHALL BE USED AS SHOWN IN THE STANDARD CONSTRUCTION DRAWINGS.
5. FOR ROUTES NOT ON THE PERMITTED LANE CLOSURE CHART, ONLY DURING OFF-PEAK PERIODS (ie ANY PERIOD OTHER THAN 6-9AM AND 3-7PM) SHALL THE CONTRACTOR INSTALL AND SUBSEQUENTLY RESET ALL TRAFFIC CONTROL NECESSARY FOR THE WORK ZONE FOR EACH CONSTRUCTION PHASE. THIS REQUIREMENT SHALL ALSO APPLY TO THOSE ROUTES INCLUDED ON THE PERMITTED LANE CLOSURE CHART WHICH ARE NOT DETAILED IN THE PLAN SET.
6. A QUANTITY OF 250 CU. YDS. OF ITEM 614 ASPHALT CONCRETE FOR MAINTAINING TRAFFIC SHALL BE PROVIDED FOR USE IN MAINTAINING PAVEMENT, SHOULDERS AND OTHER LOCATIONS AS DIRECTED BY THE ENGINEER.
7. PRIOR TO OPENING TO TRAFFIC EACH LANE SHALL BE IN A SAFE, PASSABLE CONDITION. ALL TRANSVERSE JOINTS SHALL EXTEND ACROSS THE FULL LANE AND SHOULDER WIDTH AND EACH LANE SHALL BE FREE FROM UNEVEN LONGITUDINAL JOINTS. THE CONTRACTOR SHALL PROVIDE ASPHALT WEDGES FOR TRANSVERSE JOINTS WHEREVER THERE ARE PAVEMENT ELEVATION DIFFERENCES.
8. THE CONTRACTOR SHALL PLACE THE SIGNS: W8-1 [BUMP] PER OMUTCD 2C.28; W8-11 [UNEVEN LANES] PER OMUCTD 6F.45; AND W6-3 [TWO-WAY TRAFFIC] PER OMUTCD 6F.32. PAYMENT FOR THESE SIGNS SHALL BE INCIDENTAL TO THE LUMP SUM ITEM 614- MAINTAINING TRAFFIC.
9. ALL EXISTING LANES, INCLUDING RAMPS, SHALL BE OPEN AND AVAILABLE TO TRAFFIC IN THE ORIGINAL OR PROPOSED FINAL ALIGNMENT BETWEEN OCTOBER 01 AND APRIL 01. REFER TO THE "MAINTAINING TRAFFIC (TIME LIMITATION ON A DETOUR) NOTE SHOULD THE CONTRACTOR FAIL TO MEET THESE REQUIREMENTS.
10. NO WORK SHALL BE PERFORMED AND ALL AVAILABLE LANES SHALL BE OPEN TO TRAFFIC DURING THE FOLLOWING DESIGNATED HOLIDAYS OR EVENTS:

Table with 2 columns: Holiday Name and Date. Includes Christmas (Fourth of July), New Year's (Labor Day), and Memorial Day (Thanksgiving).

THE PERIOD OF TIME THAT THE LANES ARE TO BE OPEN DEPENDS ON THE DAY OF THE WEEK ON WHICH THE HOLIDAY OR EVENT FALLS. THE FOLLOWING SCHEDULE SHALL BE USED TO DETERMINE THIS PERIOD:

ITEM 614 - MAINTAINING TRAFFIC (CONTINUED)

Table with 2 columns: Day of Holiday and Time All Lanes Must Be Open to Traffic. Lists days from Sunday to Saturday with corresponding time ranges.

SHOULD THE CONTRACTOR FAIL TO MEET ANY OF THESE REQUIREMENTS, THE CONTRACTOR SHALL BE ASSESSED A DISINCENTIVE PER THE LANE VALUE CONTRACT (PN 127).

11. LENGTH AND DURATION OF LANE CLOSURES AND RESTRICTIONS SHALL BE AT THE APPROVAL OF THE ENGINEER. IT IS THE INTENT TO MINIMIZE THE IMPACT TO THE TRAVELING PUBLIC. LANE CLOSURES OR RESTRICTIONS OVER SEGMENTS OF THE PROJECT IN WHICH NO WORK IS ANTICIPATED WITHIN A REASONABLE TIME FRAME, AS DETERMINED BY THE ENGINEER, SHALL NOT BE PERMITTED. THE LEVEL OF UTILIZATION OF MAINTENANCE OF TRAFFIC DEVICES SHALL BE COMMENSURATE WITH THE WORK IN PROGRESS.

12. NOTICE OF CLOSURE SIGNS (W20-H13) SHALL BE ERECTED BY THE CONTRACTOR PRIOR TO THE SCHEDULED ROAD OR RAMP CLOSURE IN ACCORDANCE WITH THE NOTICE OF CLOSURE TIME TABLE BELOW. AT THE APPROVAL OF THE ENGINEER, PORTABLE CHANGEABLE MESSAGE SIGNS MAY BE USED IN LIEU OF THE STANDARD FLATSHEET SIGN FOR CLOSURE DURATIONS OF LESS THAN 1 WEEK.

THE SIGNS SHALL BE ERECTED ON THE RIGHT-HAND SIDE OF THE ROAD/RAMP FACING TRAFFIC. THEY SHALL BE PLACED SO AS NOT TO INTERFERE WITH THE VISIBILITY OF ANY OTHER TRAFFIC CONTROL SIGNS. ON ROADWAYS, THEY SHOULD BE ERECTED AT OR NEAR THE POINT OF CLOSURE. THE SIGNS MAY BE ERECTED ANYWHERE ON RAMPS AS LONG AS THEY ARE VISIBLE TO THE MOTORISTS USING THE RAMP. ON ENTRANCE RAMPS, THE SIGN SHALL BE ERECTED WELL IN ADVANCE OF THE MERGE AREA TO AVOID DISTRACTING MOTORISTS.

NOTICE OF CLOSURE SIGN TIME TABLE

Table with 3 columns: Item, Duration of Closure, and Sign Displayed to Public. Details sign requirements for ramps & road closures based on duration.

THE SIGN SHALL DISPLAY THE DATE OF THE CLOSURE IN MMM-DD FORMAT AND THE NUMBER OF DAYS OF THE CLOSURE. THE LAST LINE OF THE W20-H13 SIGN LISTS A PHONE NUMBER WHICH A MOTORIST MAY CALL FOR ADDITIONAL INFORMATION. THIS IS TO BE A SPECIFIC OFFICE WITHIN THE DISTRICT RATHER THAN THE GENERAL SWITCHBOARD NUMBER.

13. ALL WORK AND TRAFFIC CONTROL DEVICES SHALL BE IN ACCORDANCE WITH C&MS 614 AND OTHER APPLICABLE PORTIONS OF THE SPECIFICATIONS, AS WELL AS THE OHIO MANUAL OF UNIFORM TRAFFIC CONTROL DEVICES. PAYMENT FOR ALL LABOR, EQUIPMENT AND MATERIALS SHALL BE INCLUDED IN THE LUMP SUM CONTRACT PRICE FOR ITEM 614, MAINTAINING TRAFFIC, UNLESS SEPARATELY ITEMIZED IN THE PLAN.

MAINTAINING TRAFFIC (TIME LIMITATION ON A DETOUR)

A MINIMUM OF ONE LANE OF TRAFFIC ALONG PROJECT RAMPS SHALL BE MAINTAINED AT ALL TIMES, EXCEPT FOR PERIODS NOT TO EXCEED LISTED DURATION (CONSECUTIVE CALENDAR DAYS), WHEN AFFECTED RAMP TRAFFIC MAY BE DETOURED AS SHOWN ON THE FOLLOWING DETOUR SHEETS:

- IR-77 NB TO SR-176 (WHEATLEY ROAD) (90 DAYS) - SHEET 47
SR-176 (WHEATLEY ROAD) TO IR-77 NB (90 DAYS) - SHEET 48
SR-176 (WHEATLEY ROAD) TO IR-77 SB (90 DAYS) - SHEET 49
IR-77 SB TO SR-176 (WHEATLEY ROAD) (90 DAYS) - SHEET 53
BRUSH ROAD (14 DAYS) - SHEET 52
IR-77 NB TO SR-21 NB (60 DAYS) - SHEET 50
SR-303 DIRECTIONAL CLOSURE (90 DAYS) - SHEET 51

SR-21 (BRECKSVILLE ROAD) TO IR-77 SB (CLOSURE DURATION TIED TO MAINLINE CONSTRUCTION ACTIVITIES) - SHEET 46

CLOSURES SHALL NOT BE CONCURRENT WITH THE EXCEPTION OF RAMPS E/A AND RAMP G CLOSURE DETOURS DURING PHASE 5/5A. A DISINCENTIVE SHALL BE ASSESSED IN THE AMOUNT OF \$ 3000.00 PER DAY FOR EACH DAY A RAMP REMAINS CLOSED TO TRAFFIC BEYOND THE SPECIFIED LIMIT. A DISINCENTIVE SHALL BE ASSESSED IN THE AMOUNT OF \$ 305.00 PER MINUTE FOR EACH MINUTE A ROADWAY REMAINS CLOSED TO TRAFFIC BEYOND THE SPECIFIED LIMIT.

ASPHALT PAVING LIMITATION

THE CONTRACTOR SHALL NOT ANTICIPATE OR SCHEDULE PLACING ASPHALT (ASPHALT SURFACE COURSE, ASPHALT INTERMEDIATE COURSE, ASPHALT CONCRETE BASE COURSE, ETC.) BETWEEN NOVEMBER 01 AND APRIL 01 WHEN SUBMITTING THEIR INITIAL BAR CHART PROGRESS SCHEDULE TO THE DISTRICT CONSTRUCTION ENGINEER (DCE) AS SPECIFIED IN CMS SECTION 108.02A. THIS LIMITATION SHALL ALSO INCLUDE INITIAL BASE LINE SCHEDULES AND ALL UPDATES IN A CPM SCHEDULE IS REQUIRED.

COOPERATION BETWEEN CONTRACTORS

THE CONTRACTOR SHALL BE ADVISED THAT PROJECTS CUY-77-00.42 MILLER ROAD INTERCHANGE (PID 104983) AND SUM-77-24.12 (PID 111404) MAY BE ONGOING IN AN AREA IMMEDIATELY ADJACENT TO AND WITHIN THE PROJECT LIMITS OF THIS PROJECT. THE CONTRACTOR SHALL SCHEDULE HIS WORK SO AS TO CAUSE A MINIMUM OF DELAY OR CONFLICT WITH THE OTHER PROJECTS. IN ACCORDANCE WITH 105.08, THE CONTRACTOR SHALL ARRANGE WITH THE OTHER CONTRACTORS APPROVAL OF THE ENGINEER. THE CONTRACTOR SHALL RECEIVE DAILY APPROVALS FROM THE ENGINEER PRIOR TO COMMENCING ANY OPERATIONS. ANY CONFLICT BETWEEN CONTRACTORS INVOLVING WORK SCHEDULES, WORK AREA, OR COOPERATION SHALL BE RESOLVED BY THE ENGINEER. COMPENSATION FOR THE ABOVE COOPERATION SHALL BE INCIDENTAL TO THE VARIOUS PAY ITEMS INCLUDED WITHIN THIS PROJECT.

ADVANCED NOTICE TO PAVE

THE CONTRACTOR SHALL SUBMIT FOR APPROVAL TO THE DISTRICT CONSTRUCTION ENGINEER A DETAILED SCHEDULE 15 DAYS PRIOR TO THE PLACEMENT OF THE OVERLAY COURSES, ON HOW THEY PROPOSE TO PROSECUTE THE PAVING OPERATIONS. THE DETAILS SHALL SHOW THE ORDER OF PERFORMANCE OF EACH STAGE (START TO FINISH) OF THE WORK INCLUDING THE MAINTENANCE OF TRAFFIC THAT WILL BE USED.

DETOUR NOTIFICATION

THE CONTRACTOR SHALL ADVISE THE ODOT DISTRICT OFFICE (330-786-3148), SUMMIT COUNTY AND THE VILLAGE OF RICHFIELD TWENTY-ONE (21) DAYS IN ADVANCE OF WHEN THE DETOUR ROUTE SHOULD BE IN EFFECT. ALL WORK ZONE DEVICES REQUIRED SHALL BE FURNISHED, ERECTED, MAINTAINED, AND SUBSEQUENTLY REMOVED BY THE CONTRACTOR. PAYMENT FOR ALL WORK ASSOCIATED WITH THE DETOUR SHALL BE INCLUDED UNDER THE LUMP SUM BID FOR ITEM 614, DETOUR SIGNING. (REFER TO DETOUR SIGNING NOTE ON SHEET 28)

TRENCH FOR WIDENING [SPEED LIMIT > 45MPH]

TRENCH EXCAVATION FOR BASE WIDENING SHALL BE ONLY ON ONE SIDE OF THE PAVEMENT AT A TIME. THE OPEN TRENCH SHALL BE ADEQUATELY MAINTAINED AND PROTECTED WITH DRUMS OR BARRICADES AT ALL TIMES. AS SHOWN ON MT-101.90. PLACEMENT OF PROPOSED BASE MATERIAL SHALL FOLLOW AS CLOSELY AS POSSIBLE BEHIND THE EXCAVATION OPERATIONS. THE LENGTH OF WIDENING TRENCH WHICH IS OPEN AT ANY ONE TIME SHALL BE HELD TO A MINIMUM AND SHALL AT ALL TIMES BE SUBJECT TO THE APPROVAL OF THE ENGINEER. THE BASE WIDENING ON THIS PROJECT WILL BE COMPLETED TO A DEPTH OF 3 INCHES BELOW THE EXISTING PAVEMENT BY THE END OF THE WORK DAY. NO TRENCH WILL BE LEFT OPEN OVERNIGHT. IN CASE WORK MUST BE SUSPENDED BECAUSE OF INCLEMENT WEATHER OR OTHER REASONS, THE TRENCH FOR THE UNCOMPLETED BASE WIDENING WILL BE BACKFILLED AT THE DIRECTION OF THE ENGINEER.

OVERNIGHT TRENCH CLOSING

THE BASE WIDENING SHALL BE COMPLETED TO A DEPTH OF NO MORE THAN 3 INCHES BELOW THE EXISTING PAVEMENT BY THE END OF EACH WORK DAY. NO TRENCH SHALL BE LEFT OPEN OVERNIGHT EXCEPT FOR A SHORT LENGTH (25 FEET OR LESS) OF A WORK SECTION AT THE END OF THE TRENCH. IN CASE WORK MUST BE SUSPENDED BECAUSE OF INCLEMENT WEATHER OR OTHER REASONS, THE TRENCH FOR THE UNCOMPLETED BASE WIDENING SHALL BE BACKFILLED AT THE DIRECTION OF THE ENGINEER.

NOTIFICATION OF TRAFFIC RESTRICTIONS

THROUGHOUT THE DURATION OF THE PROJECT, THE CONTRACTOR SHALL NOTIFY THE PROJECT ENGINEER IN WRITING OF ALL TRAFFIC RESTRICTIONS AND UPCOMING MAINTENANCE OF TRAFFIC CHANGES. THE CONTRACTOR SHALL ENSURE THE WRITTEN NOTIFICATION IS SUBMITTED IN A TIMELY MANNER TO ALLOW THE PROJECT ENGINEER TO MEET THE REQUIRED TIME FRAMES SET FORTH IN THE TABLE BELOW TO INFORM THE SPECIAL HAULING PERMITS SECTION (HAULING.PERMITS@DOT.OHIO.GOV) AND THE DISTRICT PUBLIC INFORMATION OFFICE (PIO). THIS NOTIFICATION SHALL BE RECEIVED BY THE PROJECT ENGINEER PRIOR TO THE PHYSICAL SETUP OF ANY APPLICABLE SIGNS OR MESSAGE BOARDS.

INFORMATION SHOULD INCLUDE, BUT IS NOT LIMITED TO, ALL CONSTRUCTION ACTIVITIES THAT IMPACT OR INTERFERE WITH TRAFFIC AND SHALL LIST THE SPECIFIC LOCATION, TYPE OF WORK, ROAD STATUS, DATE AND TIME OF RESTRICTION, DURATION OF RESTRICTION, NUMBER OF LANES MAINTAINED, NUMBER OF LANES CLOSED, MINIMUM VERTICAL CLEARANCE, MINIMUM WIDTH OF DRIVABLE PAVEMENT, DETOUR ROUTES, IF APPLICABLE, AND ANY OTHER INFORMATION REQUESTED BY THE PROJECT ENGINEER.

NOTIFICATION TIME TABLE

Table with 3 columns: Item, Duration of Closure, and Notice Due to Permits & PIO. Details notification requirements for ramps & road closures, lane closures & restrictions, and start of construction & traffic pattern changes.

ANY UNFORESEEN CONDITIONS NOT SPECIFIED IN THE PLANS REQUIRING TRAFFIC RESTRICTIONS SHALL ALSO BE REPORTED TO THE PROJECT ENGINEER USING THE NOTIFICATION TIME TABLE.

ITEM 614 - LAW ENFORCEMENT OFFICER (WITH PATROL CAR) FOR ASSISTANCE DURING CONSTRUCTION OPERATIONS

USE OF LAW ENFORCEMENT OFFICERS (LEOS) BY CONTRACTORS OTHER THAN THE USES SPECIFIED BELOW WILL NOT BE PERMITTED AT PROJECT COST. LEOS SHOULD NOT BE USED WHERE THE OMUTCD INTENDS THAT FLAGGERS BE USED.

IN ADDITION TO THE REQUIREMENTS OF CMS 614 AND THE OMUTCD, A UNIFORMED LEO WITH AN OFFICIAL PATROL CAR (CAR WITH TOP-MOUNTED EMERGENCY FLASHING LIGHTS AND COMPLETE MARKINGS OF THE APPROPRIATE LAW ENFORCEMENT AGENCY) SHALL BE PROVIDED FOR THE FOLLOWING TRAFFIC CONTROL TASKS:

DURING THE ENTIRE ADVANCE PREPARATION AND CLOSURE SEQUENCE WHERE COMPLETE BLOCKAGE OF TRAFFIC IS REQUIRED.

DURING A TRAFFIC SIGNAL INSTALLATION WHEN IMPACTING THE NORMAL FUNCTION OF THE SIGNAL OR THE FLOW OF TRAFFIC OR WHEN TRAFFIC NEEDS TO BE DIRECTED THROUGH AN ENERGIZED TRAFFIC SIGNAL CONTRARY TO THE SIGNAL DISPLAY (E.G., DIRECTING MOTORISTS THROUGH A RED LIGHT).

FOR LANE CLOSURES: DURING INITIAL SET-UP PERIODS, TEAR DOWN PERIODS, SUBSTANTIAL SHIFTS OF A CLOSURE POINT OR WHEN NEW LANE CLOSURE ARRANGEMENTS ARE INITIATED FOR LONG-TERM LANE CLOSURES/SHIFTS (FOR THE FIRST AND LAST DAY OF MAJOR CHANGES IN TRAFFIC CONTROL SETUP).

LEOS SHOULD NOT FORGO THEIR TRAFFIC CONTROL RESPONSIBILITIES TO APPREHEND MOTORISTS FOR ROUTINE TRAFFIC VIOLATIONS. HOWEVER, IF A MOTORIST'S ACTIONS ARE CONSIDERED TO BE RECKLESS, THEN PURSUIT OF THE MOTORIST IS APPROPRIATE.

IN GENERAL LEOS SHOULD BE POSITIONED IN ADVANCE OF AND ON THE SAME SIDE AS THE LANE RESTRICTION OR AT THE POINT OF ROAD CLOSURE, AND TO MANUALLY CONTROL TRAFFIC MOVEMENTS THROUGH SIGNALIZED INTERSECTIONS IN WORK ZONE.

THE LEOS WORK AT THE DIRECTION OF THE ENGINEER. THE CONTRACTOR IS RESPONSIBLE FOR SECURING THE SERVICES OF THE LEOS WITH THE APPROPRIATE AGENCIES AND COMMUNICATING THE INTENTIONS OF THE PLANS WITH RESPECT TO DUTIES OF THE LEOS. THE ENGINEER SHALL HAVE FINAL CONTROL OVER THE LEOS' DUTIES AND PLACEMENT, AND WILL RESOLVE ANY ISSUES THAT MAY ARISE BETWEEN THE TWO PARTIES.

THE LEO SHALL REPORT IN TO THE CONTRACTOR PRIOR TO THE START OF THE SHIFT, IN ORDER TO RECEIVE INSTRUCTIONS REGARDING SPECIFIC WORK ASSIGNMENTS DURING HIS/HER SHIFT. THE LEO IS EXPECTED TO STAY AT THE PROJECT SITE FOR THE ENTIRE DURATION OF HIS/HER SHIFT. THE LEO SHALL REPORT TO THE CONTRACTOR AT THE END OF HIS/HER SHIFT. ONCE THE LEO HAS COMPLETED THE DUTIES DESCRIBED ABOVE AND STILL HAS TIME REMAINING ON HIS/HER SHIFT, THE LEO MAY BE ASKED TO PATROL THROUGH THE WORK ZONE (WITH FLASHING LIGHTS OFF) OR BE PLACED AT A LOCATION TO DETER MOTORISTS FROM SPEEDING. SHOULD IT BE NECESSARY TO LEAVE THE PROJECT SITE, THE LEO SHALL NOTIFY THE ENGINEER. THE CONTRACTOR SHALL PROVIDE THE LEO WITH A TWO-WAY COMMUNICATION DEVICE WHICH SHALL BE RETURNED TO THE CONTRACTOR AT THE END OF HIS/HER SHIFT.

LEOS (WITH PATROL CAR) REQUIRED BY THE TRAFFIC MAINTENANCE TASKS ABOVE SHALL BE PAID FOR ON A UNIT PRICE (HOURLY) BASIS UNDER ITEM 614, LAW ENFORCEMENT OFFICER (WITH PATROL CAR) FOR ASSISTANCE. THE FOLLOWING ESTIMATED QUANTITIES HAVE BEEN CARRIED TO THE GENERAL SUMMARY.

ITEM 614 - LAW ENFORCEMENT OFFICER (WITH PATROL CAR) FOR ASSISTANCE DURING CONSTRUCTION OPERATIONS (CONTINUED)

ITEM 614, LAW ENFORCEMENT OFFICER WITH PATROL CAR FOR ASSISTANCE 2400 HOURS

THE HOURS PAID SHALL INCLUDE ANY MINIMUM SHOW-UP TIME REQUIRED BY THE LAW ENFORCEMENT AGENCY INVOLVED.

ANY ADDITIONAL COSTS (ADMINISTRATIVE OR OTHERWISE) INCURRED BY THE CONTRACTOR TO OBTAIN THE SERVICES OF AN LEO ARE INCLUDED WITH THE BID UNIT PRICE FOR ITEM 614, LAW ENFORCEMENT OFFICER WITH PATROL CAR FOR ASSISTANCE.

ITEM 615 - PAVEMENT FOR MAINTAINING TRAFFIC, CLASS A, AS PER PLAN
IN ADDITION TO THE REQUIREMENTS OF 615

ON THIS PROJECT THE CLASS A PAVEMENT FOR MAINTAINING TRAFFIC SHALL BE 18 FEET WIDE AND THE ROADWAY WIDTH SHALL NOT BE LESS THAN 22 FEET OUT TO OUT OF SHOULDERS. THE ALIGNMENT AND PAVEMENT TYPICAL SECTION SHALL BE AS DETAILED ON SHEETS 160 THROUGH 180 . THE EXISTING PAVEMENT/SHOULDER SHALL BE SAWCUT AS PER 203.04(E).

THE FOLLOWING ESTIMATED QUANTITIES HAVE BEEN INCLUDED IN THE GENERAL SUMMARY TO BE USED IN CONSTRUCTING THE PAVEMENT FOR MAINTAINING TRAFFIC, CLASS A, AS PER PLAN.

615, ROADS FOR MAINTAINING TRAFFIC, LUMP SUM
615, PAVEMENT FOR MAINTAINING TRAFFIC, CLASS A,
AS PER PLAN, (QUANTIFIED IN SUBSUMMARY)
616, WATER, 9 M GAL
411, STABILIZED CRUSHED AGGREGATE, 158 CU. YD.

UPON COMPLETION OF THE PROJECT, THE CONTRACTOR SHALL REMOVE THE PAVEMENT FOR MAINTAINING TRAFFIC INCLUDING ANY TEMPORARY DRAINAGE FACILITIES. THE AFFECTED EXISTING EARTH MEDIAN AND PAVED SHOULDERS SHALL BE RESTORED TO THEIR ORIGINAL CONDITION AS DIRECTED BY THE ENGINEER AND AS PER 615.08.

PAVEMENT FOR MAINTAINING TRAFFIC SHALL NOT BE OPENED TO TRAFFIC UNTIL ALL WORK ZONE TRAFFIC CONTROL DEVICES, SIGNS, PAVEMENT MARKINGS AND PORTABLE CONCRETE BARRIERS HAVE BEEN ERECTED AND APPROVED BY THE ENGINEER.

ALTHOUGH ESTIMATES FOR TEMPORARY EXCAVATION, EMBANKMENT AND TEMPORARY DRAINAGE FACILITIES MAY BE SHOWN ON THE PLAN DETAILS, THESE ITEMS SHALL BE CONSIDERED INCIDENTAL TO, AND INCLUDED WITH PAYMENT FOR ITEM 615 ROADS FOR MAINTAINING TRAFFIC.

TRAFFIC INCIDENT MANAGEMENT (TIM) DURING MOT

OHIO TIM IS OHIO'S TRAFFIC INCIDENT MANAGEMENT PROGRAM WHICH IS COMMITTED TO MAINTAINING THE SAFE AND EFFECTIVE FLOW OF TRAFFIC DURING EMERGENCIES AS TO PREVENT FURTHER DAMAGE, INJURY OR UNDUE DELAY OF THE MOTORING PUBLIC. IN ADDITION TO COMPLYING WITH THE PROVISION OF OMUTCD CHAPTER 6I, CONTROL OF TRAFFIC THROUGH TRAFFIC INCIDENT MANAGEMENT AREAS, THE CONTRACTOR SHALL ACTIVELY PARTICIPATE IN TIM PLANNING AND IMPLEMENTATION AS OUTLINED BELOW.

1. SUPERINTENDENT SHALL IDENTIFY THE INDIVIDUAL PERSONS ON THE PROJECT WHO WILL, OR MAY NEED TO, PERFORM THE DUTIES HEREIN. AT A MINIMUM, INCLUDE THE SUPERINTENDENT, FOREMEN AND SUPERVISORS (OR EQUIVALENT) AS WELL AS THE WORKSITE TRAFFIC SUPERVISOR (WTS; IF APPLICABLE TO THE PROJECT). THESE INDIVIDUALLY IDENTIFIED PERSONS SHALL COLLECTIVELY BE KNOWN AS CONTRACTOR TRAFFIC INCIDENT MANAGEMENT (TIM) CONTACTS. NOTIFY THE PROJECT ENGINEER OF THE CONTRACTOR TIM CONTACTS (ALONG WITH CONTACT INFORMATION FOR EACH) AT OR BEFORE THE PRECONSTRUCTION MEETING.

2. SUPERINTENDENT SHALL NOTIFY THE ENGINEER IMMEDIATELY IF ANY CONTRACTOR TIM CONTACT IS ADDED, REMOVED OR THE CONTACT INFORMATION CHANGES OVER THE COURSE OF THE PROJECT.

3. PRIOR THE FIRST DAY OF WORK IN THE FIELD, EACH CONTRACTOR TIM CONTACT ON THE PROJECT SHALL HAVE ATTENDED AND SUCCESSFULLY COMPLETED OHIO TIM TRAINING PROVIDED BY THE DEPARTMENT OR DESIGNEE. TRAINING INFORMATION CAN BE FOUND AT www.OhioTIM.com.

4. SUPERINTENDENT, AT A MINIMUM, SHALL ATTEND AND ACTIVELY PARTICIPATE IN A DEPARTMENT SCHEDULED TIM MEETING BEFORE CONSTRUCTION WORK BEGINS AND BEFORE EACH PHASE CHANGE. THESE MEETINGS WILL RESULT IN A DEPARTMENT ISSUED PROJECT SPECIFIC TRAFFIC INCIDENT MANAGEMENT PLAN (TIMP). AT THE TIM MEETINGS THE ATTENDING CONTRACTOR TIM CONTACTS SHALL:
A. COLLABORATE WITH ODOT AND SAFETY FORCES;
B. SHARE PROJECT SPECIFIC DETAILS THAT IMPACT TIM RESPONDERS; AND
C. RECOMMEND WAYS TO INCORPORATE NECESSARY EMERGENCY ACCESS AND OTHER TIM ELEMENTS FOR TIM RESPONDERS GIVEN PROJECT SPECIFIC WORK BEING COMPLETED AND PROJECT SPECIFIC PHASING.

5. CONTRACTOR TIM CONTACTS SHALL IMPLEMENT COMPONENTS OF THE RESULTING TIMP (SUCH AS APPROVED EMERGENCY INGRESS/EGRESS POINTS, ETC), AS DIRECTED BY THE ENGINEER IN ACCORDANCE WITH 109.05.

6. CONTRACTOR TIM CONTACTS SHALL PERFORM, AT A MINIMUM, THE FOLLOWING FUNCTIONS WHEN AN INCIDENT/CRASH OCCURS:
A. IF OBSERVED OR PRESENT WHEN OCCURS, CALL 911 AND THEN NOTIFY THE TRAFFIC MANAGEMENT CENTER (TMC) TO PROVIDE THE FOLLOWING:

- I. LOCATION, INCLUDING MILEPOST NUMBER AND DIRECTION OF TRAVEL
 - II. NUMBER AND TYPE OF VEHICLES INVOLVED, IF KNOWN
 - III. ESTIMATED EXTENT OF DAMAGE OR INJURY, IF KNOWN
 - IV. ESTIMATED NUMBER OF PATIENTS INVOLVED, IF KNOWN
 - V. ANY POTENTIAL HAZARDOUS CONDITIONS, IF KNOWN
 - VI. THE PLACARD NUMBER ON ANY HAZARDOUS MATERIALS PLACARD FROM A SAFE DISTANCE, IF APPLICABLE AND VISIBLE
- B. FOLLOWING AN INCIDENT/CRASH:
I. INITIATE TRAFFIC MANAGEMENT/PROVIDE TEMPORARY TRAFFIC TRAFFIC CONTROL AS INDICATED IN THE TIMP, AS DIRECTED BY THE ENGINEER IN ACCORDANCE WITH 109.05.
II. RECOMMEND ROADWAY REPAIR NEEDS.
III. PROVIDE REPAIR RESOURCES AND INITIATE REPAIRS, AS DIRECTED BY THE ENGINEER IN ACCORDANCE WITH 109.05.
IV. ATTEND AND PARTICIPATE IN AN AFTER ACTION REVIEW (AAR).

TRAFFIC INCIDENT MANAGEMENT (TIM) DURING MOT (CONTINUED)

ALL COSTS, UNLESS OTHERWISE SPECIFIED, RESULTING FROM THE ABOVE REQUIREMENTS SHALL BE CONSIDERED TO BE INCLUDED IN THE LUMP SUM PRICE FOR ITEM 614, MAINTAINING TRAFFIC. FAILURE TO PERFORM THE REQUIREMENTS OF THIS PLAN NOTE WILL RESULT IN A DAILY FINE OF 2% OF ITEM 614, MAINTAINING TRAFFIC AND MAY RESULT IN ONE OR MORE CONTRACTOR TIM CONTACTS BEING REMOVED FROM THE LIST OF OHIO TIM TRAINED INDIVIDUALS (AT THE SOLE DISCRETION OF THE OHIO TIM EXECUTIVE COMMITTEE). IN THE EVENT AN INDIVIDUAL IS REMOVED FROM THE OHIO TIM TRAINED LIST, THE INDIVIDUAL WILL BE REMOVED FROM CONTRACTOR TIM CONTACT RESPONSIBILITIES ON ALL PROJECTS.

ITEM 615 - ROADS FOR MAINTAINING TRAFFIC

THIS WORK CONSISTS OF PROVIDING, MAINTAINING, AND SUBSEQUENTLY REMOVING ROADS AND APPURTENANCES AND PAVEMENTS FOR MAINTAINING TRAFFIC.

ADDITIONAL EXCAVATION AND EMBANKMENT IS REQUIRED BEYOND THE PHYSICAL LIMITS OF PROPOSED SHOULDER WIDTHS AT RAMP GORES, AT TAPERS AND CROSS OVER LOCATIONS. REQUIRED ADDITIONAL EARTHWORK IN THESE AREAS WILL BE PAID FOR UNDER THE LUMP SUM AMOUNT FOR ITEM 615, ROADS FOR MAINTAINING TRAFFIC.

REMOVE ALL PAVEMENT FOR MAINTAINING TRAFFIC IN ACCORDANCE WITH THE PROVISIONS OF ITEM 615 UNLESS OTHERWISE SPECIFIED IN THE PLANS.

PAYMENT FOR ABOVE REQUIREMENTS SHALL BE INCLUDED IN THE LUMP SUM BID FOR ITEM 615, ROADS FOR MAINTAINING TRAFFIC.

FULL DEPTH SAW CUTTING

DURING SOME OR ALL PHASES OF CONSTRUCTION, IT WILL BE NECESSARY TO PROTECT THE ADJACENT EXISTING, TEMPORARY OR PROPOSED PAVEMENT THAT WILL BE UTILIZED TO MAINTAIN TRAFFIC DURING PART-WIDTH CONSTRUCTION FOR PAVEMENT REPLACEMENT OPERATIONS. THE CONTRACTOR SHALL PERFORM FULL DEPTH SAW CUTTING AS A MEANS TO PROTECT THE PAVEMENT ADJACENT TO THE ACTIVE WORK ZONE. ANY DAMAGE TO THE ADJACENT PAVEMENT THAT WILL BE USED TO MAINTAIN TRAFFIC SHALL BE REPAIRED BY THE CONTRACTOR AT THE CONTRACTOR'S EXPENSE TO THE SATISFACTION OF THE ENGINEER. FULL DEPTH SAW CUTTING IS ANNOTATED ON MOT TYPICAL SECTION SHEETS.

PAYMENT FOR ALL WORK ASSOCIATED WITH FULL DEPTH SAW CUTTING SHALL BE CONSIDERED INCIDENTAL TO THE LUMP SUM BID FOR ITEM 614 - MAINTAINING TRAFFIC.

FLOODLIGHTING

FLOODLIGHTING OF THE WORK SITE FOR OPERATIONS CONDUCTED DURING NIGHTTIME PERIODS SHALL BE ACCOMPLISHED SO THAT THE LIGHTS DO NOT CAUSE GLARE TO THE DRIVERS ON THE ROADWAY. TO ENSURE THE ADEQUACY OF THE FLOODLIGHT PLACEMENT, THE CONTRACTOR AND THE ENGINEER SHALL DRIVE THROUGH THE WORK SITE EACH NIGHT WHEN THE LIGHTING IS IN PLACE AND OPERATIVE PRIOR TO COMMENCING ANY WORK. IF GLARE IS DETECTED, THE LIGHT PLACEMENT AND SHIELDING SHALL BE ADJUSTED TO THE SATISFACTION OF THE ENGINEER BEFORE WORK PROCEEDS.

PAYMENT FOR ALL LABOR, EQUIPMENT AND MATERIALS SHALL BE INCLUDED IN THE LUMP SUM CONTRACT PRICE FOR ITEM 614, MAINTAINING TRAFFIC.

SHEET NUMBER

| 34 | 35 | 36 | 37 | 38 | 39 | 40 | 41 | 42 | 43 | 44 | 45 |
|--------|-------|------|-------|------|-------|-------|------|------|-------|------|------|
| 1641 | | | | | | | | | | | |
| 132 | | | | | | | | | | | |
| 158 | | | | | | | | | | | |
| 69 | | | | | | | | | | | |
| 2400 | | | | | | | | | | | |
| | 210 | 429 | 210 | 1350 | 450 | | | 600 | | | |
| | 3 | 13 | 2 | 3 | 3 | 5 | 3 | 3 | 5 | 1 | |
| LUMP | | | | | | | | | | | |
| 34 | | | | | | | | | | | |
| 2 | | | | | | | | | | | |
| 52 | 1308 | 800 | 1090 | 441 | 471 | 946 | 129 | 678 | 246 | 19 | |
| 250 | | | | | | | | | | | |
| | 86 | 114 | 874 | 438 | 386 | 619 | 121 | 296 | 312 | 31 | |
| | | | | | 291 | 43 | | | | | |
| | | | | | 87 | 8 | 59 | 39 | 79 | | |
| | 86 | 114 | 382 | 58 | 95 | 466 | 13 | 190 | 391 | 31 | |
| | | | 246 | 174 | 378 | 106 | 113 | 88 | | | |
| 300000 | | | | | | | | | | | |
| 300000 | | | | | | | | | | | |
| 144 | | | | | | | | | | | |
| 6.2 | 8.47 | 2.25 | 19.78 | 5.11 | 8.46 | 22.07 | 5.97 | 7.25 | 2.03 | 0.6 | |
| 1.21 | | | 4.33 | 0.16 | | 3.82 | 0.08 | 0.31 | 0.17 | | |
| | | 0.1 | | | | | | | | | |
| 5505 | 10765 | 6210 | 5629 | 5789 | 1363 | 3158 | 3734 | 4851 | 3018 | 204 | |
| | 373 | 1311 | 3390 | 3576 | 1485 | 2370 | 4697 | 2671 | 2655 | 420 | |
| | | | 102 | | | | | 95 | | | |
| | | | | | | | | 16 | | | |
| LUMP | | | | 2 | | | | | | | |
| 28280 | 32821 | 1043 | 500 | 512 | | | | | | | |
| | 3250 | 1372 | | | | | | | | | |
| 895 | | | | | | | | | | | |
| 1.12 | | | | | | | | | | | |
| | | | 12290 | 8700 | 14520 | 4900 | 2700 | 2870 | | | |
| | | | | | 1 | 1 | | | 1 | 1 | |
| | 4270 | 5720 | 19080 | 2880 | 4760 | 23200 | 590 | 9060 | 15600 | 1540 | |
| | | | 1610 | | | | | | | | |
| | | | | | | | | | | | 1116 |
| | | | | | | | | | | | 18 |
| | | | | | | | | | | | 21 |
| 648 | | | | | | | | | | | |

| ITEM | ITEM EXT. | TOTAL | UNIT | DESCRIPTION |
|------|-----------|--------|------|--|
| 254 | 01000 | 1641 | SY | PAVEMENT PLANING, ASPHALT CONCRETE (1.5" DEPTH) |
| 407 | 20000 | 132 | GAL | NON-TRACKING TACK COAT |
| 411 | 10000 | 158 | CY | STABILIZED CRUSHED AGGREGATE |
| 442 | 20001 | 69 | CY | ASPHALT CONCRETE SURFACE COURSE, 12.5 MM, TYPE A (448), AS PER PLAN, PG70-22M |
| 614 | 11110 | 2400 | HOUR | LAW ENFORCEMENT OFFICER WITH PATROL CAR FOR ASSISTANCE |
| 614 | 11630 | 3249 | FT | INCREASED BARRIER DELINEATION |
| 614 | 12380 | 41 | EACH | WORK ZONE IMPACT ATTENUATOR, 24" WIDE HAZARDS, (UNIDIRECTIONAL) |
| 614 | 12420 | LUMP | | DETOUR SIGNING |
| 614 | 12484 | 34 | EACH | WORK ZONE INCREASED PENALTIES SIGN |
| 614 | 12756 | 2 | EACH | WORK ZONE CROSSOVER LIGHTING SYSTEM |
| 614 | 12801 | 6180 | EACH | WORK ZONE RAISED PAVEMENT MARKER, AS PER PLAN |
| 614 | 13000 | 250 | CY | ASPHALT CONCRETE FOR MAINTAINING TRAFFIC |
| 614 | 13310 | 3277 | EACH | BARRIER REFLECTOR, TYPE 1, 1 WAY |
| 614 | 13310 | 334 | EACH | BARRIER REFLECTOR, TYPE 1, BIDIRECTIONAL |
| 614 | 13312 | 272 | EACH | BARRIER REFLECTOR, TYPE 2, BIDIRECTIONAL |
| 614 | 13350 | 1826 | EACH | OBJECT MARKER, ONE WAY |
| 614 | 13360 | 1105 | EACH | OBJECT MARKER, TWO WAY |
| 614 | 18000 | 300000 | EACH | MAINTAINING TRAFFIC, MISC.: SAFETY REPAIRS |
| 614 | 18000 | 300000 | EACH | MAINTAINING TRAFFIC, MISC.: BRIDGE DECK AND PAVEMENT PATCHING |
| 614 | 18601 | 144 | SNMT | PORTABLE CHANGEABLE MESSAGE SIGN, AS PER PLAN |
| 614 | 98000 | 88.19 | MILE | WORK ZONE PAVEMENT MARKING, MISC.: EDGE LINE, 6", SPRAY THERMOPLASTIC |
| 614 | 98000 | 10.08 | MILE | WORK ZONE PAVEMENT MARKING, MISC.: LANE LINE, 6", SPRAY THERMOPLASTIC |
| 614 | 98000 | 0.1 | MILE | WORK ZONE PAVEMENT MARKING, MISC.: CENTER LINE, 6", SPRAY THERMOPLASTIC |
| 614 | 98100 | 50226 | FT | WORK ZONE PAVEMENT MARKING, MISC.: CHANNELIZING LINE, 12", SPRAY THERMOPLASTIC |
| 614 | 98100 | 22948 | FT | WORK ZONE PAVEMENT MARKING, MISC.: DOTTED LINE, 6", SPRAY THERMOPLASTIC |
| 614 | 98100 | 197 | FT | WORK ZONE PAVEMENT MARKING, MISC.: GORE MARKING, SPRAY THERMOPLASTIC |
| 614 | 98100 | 16 | FT | WORK ZONE PAVEMENT MARKING, MISC.: STOP LINE, SPRAY THERMOPLASTIC |
| 614 | 98200 | 2 | EACH | WORK ZONE PAVEMENT MARKING, MISC.: ARROW, SPRAY THERMOPLASTIC |
| 615 | 10000 | LUMP | | ROADS FOR MAINTAINING TRAFFIC |
| 615 | 20000 | 63156 | SY | PAVEMENT FOR MAINTAINING TRAFFIC, CLASS A |
| 615 | 20001 | 4622 | SY | PAVEMENT FOR MAINTAINING TRAFFIC, CLASS A, AS PER PLAN |
| 616 | 10000 | 895 | MGAL | WATER |
| 618 | 40600 | 1.12 | MILE | RUMBLE STRIPS, SHOULDER (ASPHALT CONCRETE) |
| 622 | 41011 | 45980 | FT | PORTABLE BARRIER, 50", AS PER PLAN |
| 622 | 41050 | 4 | EACH | PORTABLE BARRIER, "Y" CONNECTOR |
| 622 | 41100 | 86700 | FT | PORTABLE BARRIER, UNANCHORED |
| 622 | 80000 | 1610 | FT | GLARE SCREEN |
| 630 | 80200 | 1116 | SF | SIGN, GROUND MOUNTED EXTRUSHEET |
| 630 | 87101 | 18 | EACH | REMOVAL OF OVERHEAD MOUNTED SIGN AND REERECTION, AS PER PLAN |
| 630 | 97700 | 21 | EACH | SIGNING, MISC.: TEMPORARY GROUND MOUNTED SIGN SUPPORT |
| 808 | 18700 | 648 | SNMT | DIGITAL SPEED LIMIT (DSL) SIGN ASSEMBLY |

MOT SUBSUMMARY


DESIGN AGENCY
GANNETT FLEMING
 2500 Corporate Exchange Dr.
 Suite 230
 Columbus, OH 43231

DESIGNER
 ACW

REVIEWER
 DRJ 08-26-22


PROJECT ID
 111405

SHEET TOTAL
 33 927

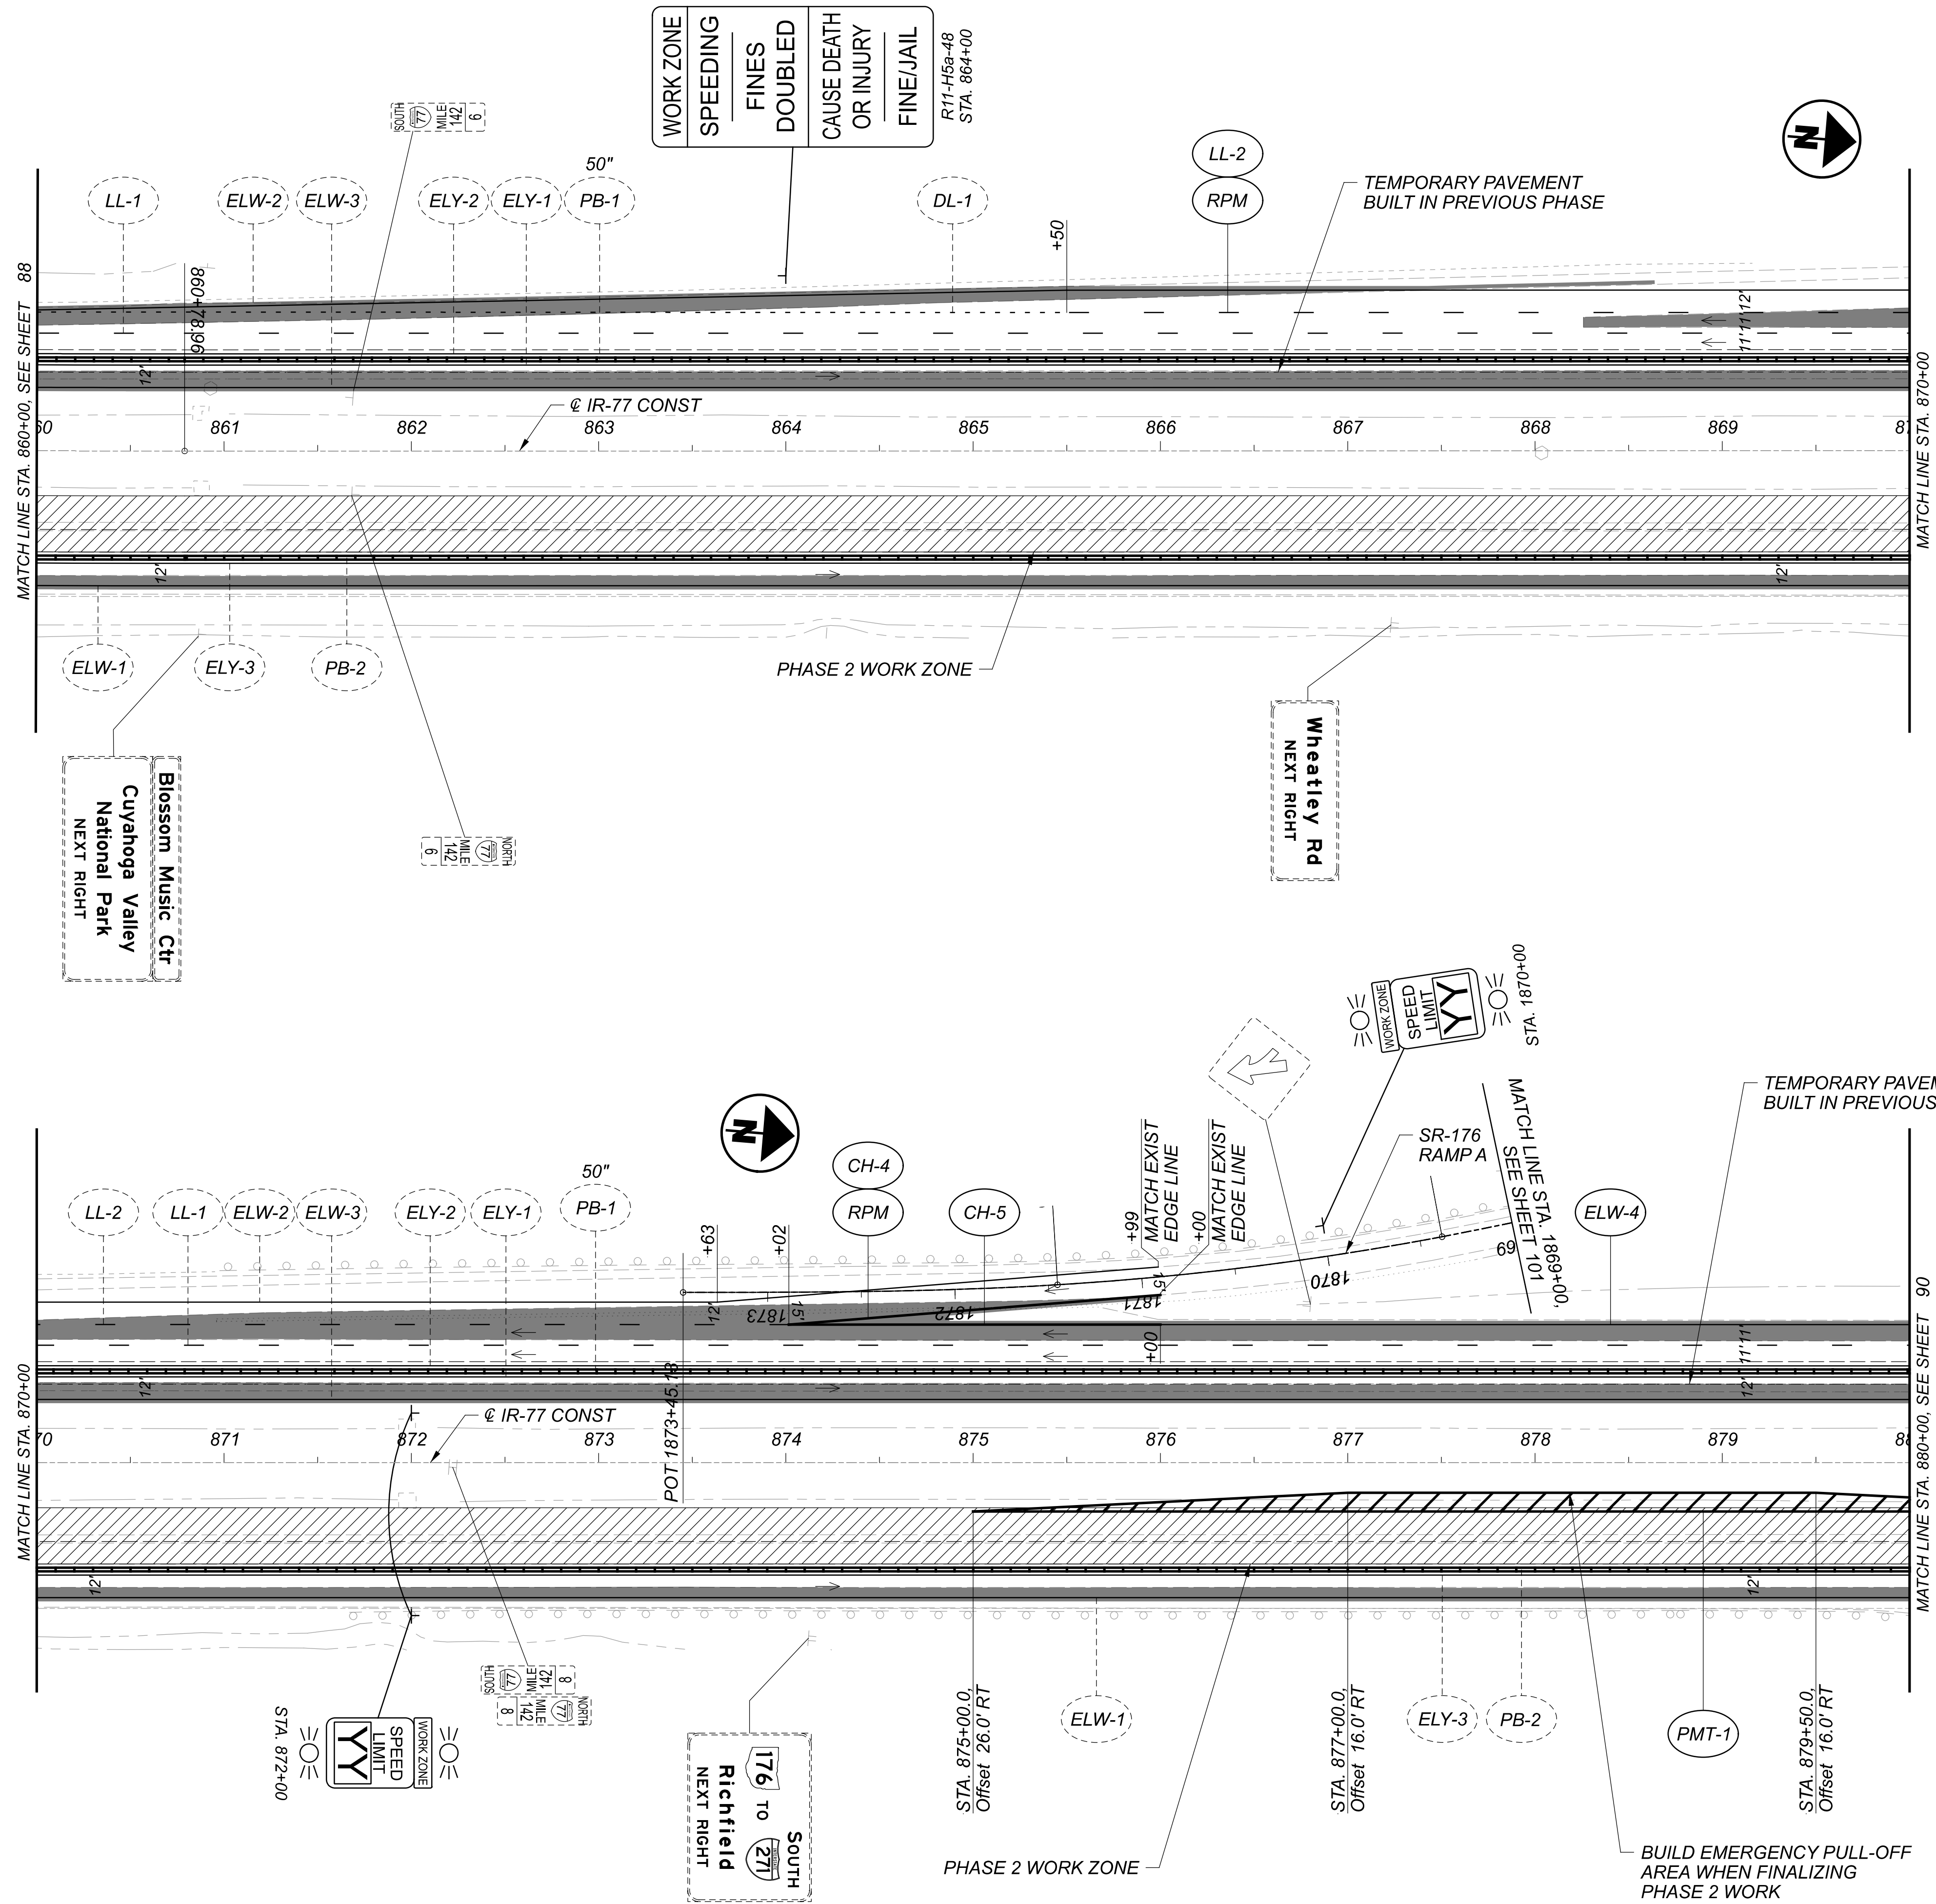


NOTES:

1. FOR MAINTENANCE OF TRAFFIC LEGEND, SEE SHEET 31
2. MAINTAIN EXISTING STRIPING UNLESS OTHERWISE NOTED. REMOVE CONFLICTING PAVEMENT MARKINGS.
3. INSTALL TEMPORARY PAVEMENT FOR EMERGENCY PULL-OFF AS SHOWN FOR USE IN MOT PHASE 3. EMERGENCY PULL-OFF IS BUILT ABUTTING FINAL SHOULDER PAVEMENT.

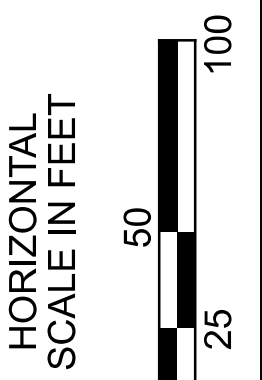

MAINTENANCE OF TRAFFIC - PHASE 2
 IR-77 - STA 860+00 TO STA 880+00

| | |
|--|-----------|
| DESIGN AGENCY | |
| GANNETT FLEMING | |
| 2500 Corporate Exchange Dr. Suite 230 Columbus, OH 43231 | |
| DESIGNER | ACW |
| REVIEWER | DRJ |
| PROJECT ID | 08-26-22 |
| SHEET | 11405 |
| 89 | TOTAL 927 |

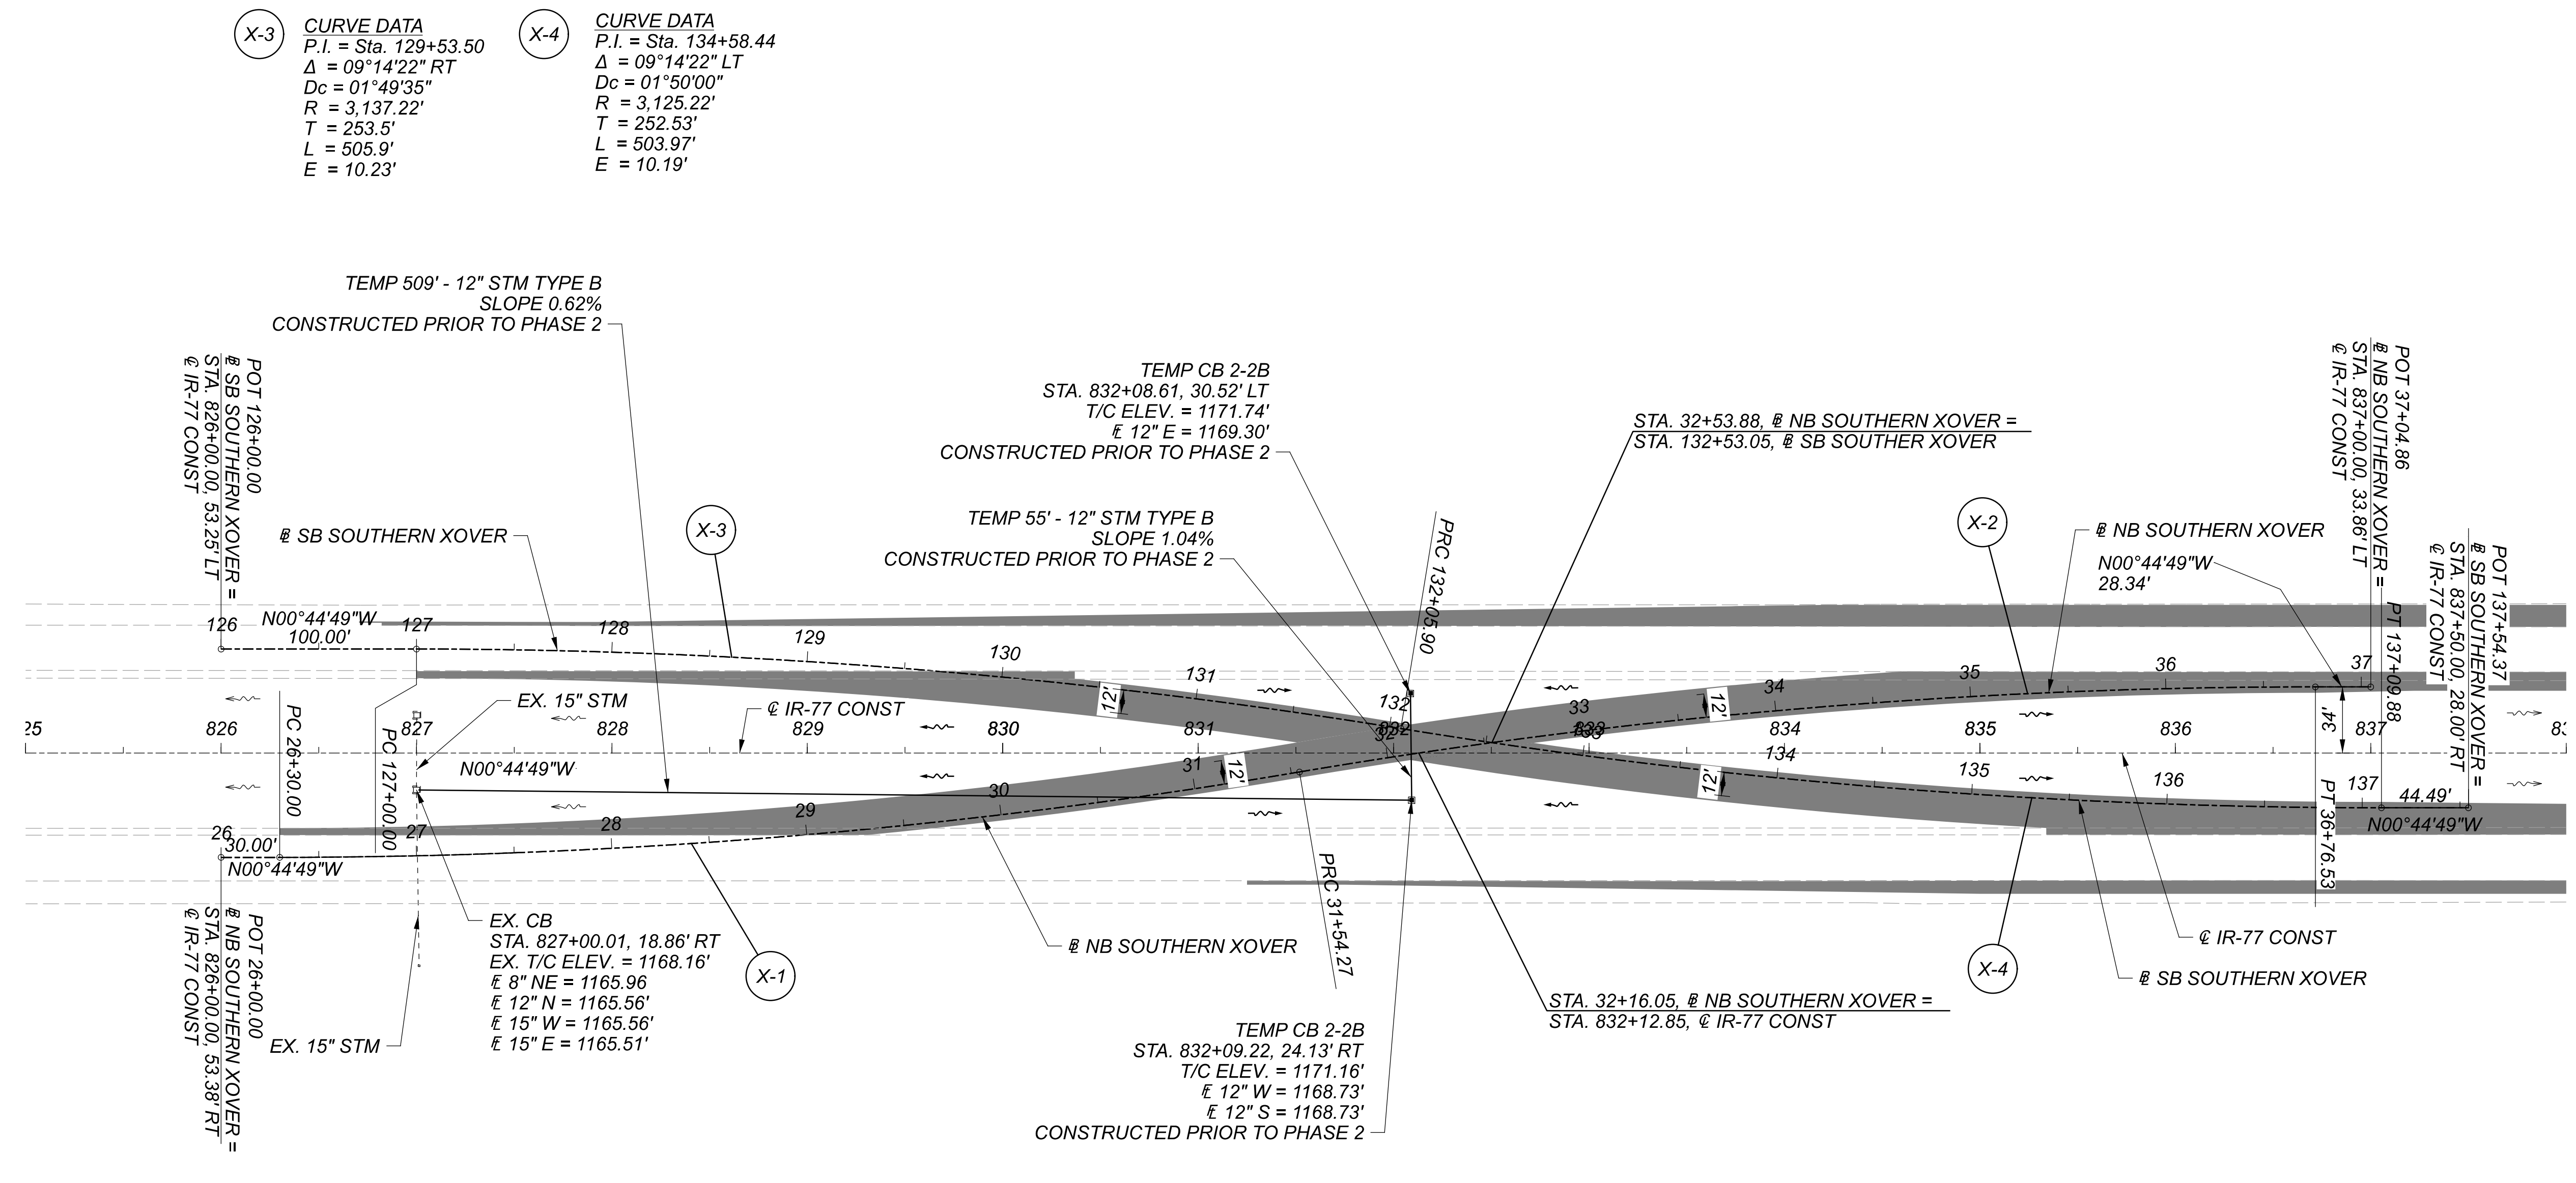


X-3 CURVE DATA
 P.I. = Sta. 129+53.50
 $\Delta = 09^\circ 14' 22''$ RT
 $D_c = 01^\circ 49' 35''$
 $R = 3,137.22'$
 $T = 253.5'$
 $L = 505.9'$
 $E = 10.23'$


X-4 CURVE DATA
 P.I. = Sta. 134+58.44
 $\Delta = 09^\circ 14' 22''$ LT
 $D_c = 01^\circ 50' 00''$
 $R = 3,125.22'$
 $T = 252.53'$
 $L = 503.97'$
 $E = 10.19'$

X-1 CURVE DATA
 P.I. = Sta. 28+92.74
 $\Delta = 09^\circ 34' 29''$ LT
 $D_c = 01^\circ 49' 35''$
 $R = 3,137.22'$
 $T = 262.74'$
 $L = 524.27'$
 $E = 10.98'$

X-2 CURVE DATA
 P.I. = Sta. 34+16.01
 $\Delta = 09^\circ 34' 29''$ RT
 $D_c = 01^\circ 50' 00''$
 $R = 3,125.22'$
 $T = 261.74'$
 $L = 522.26'$
 $E = 10.94'$

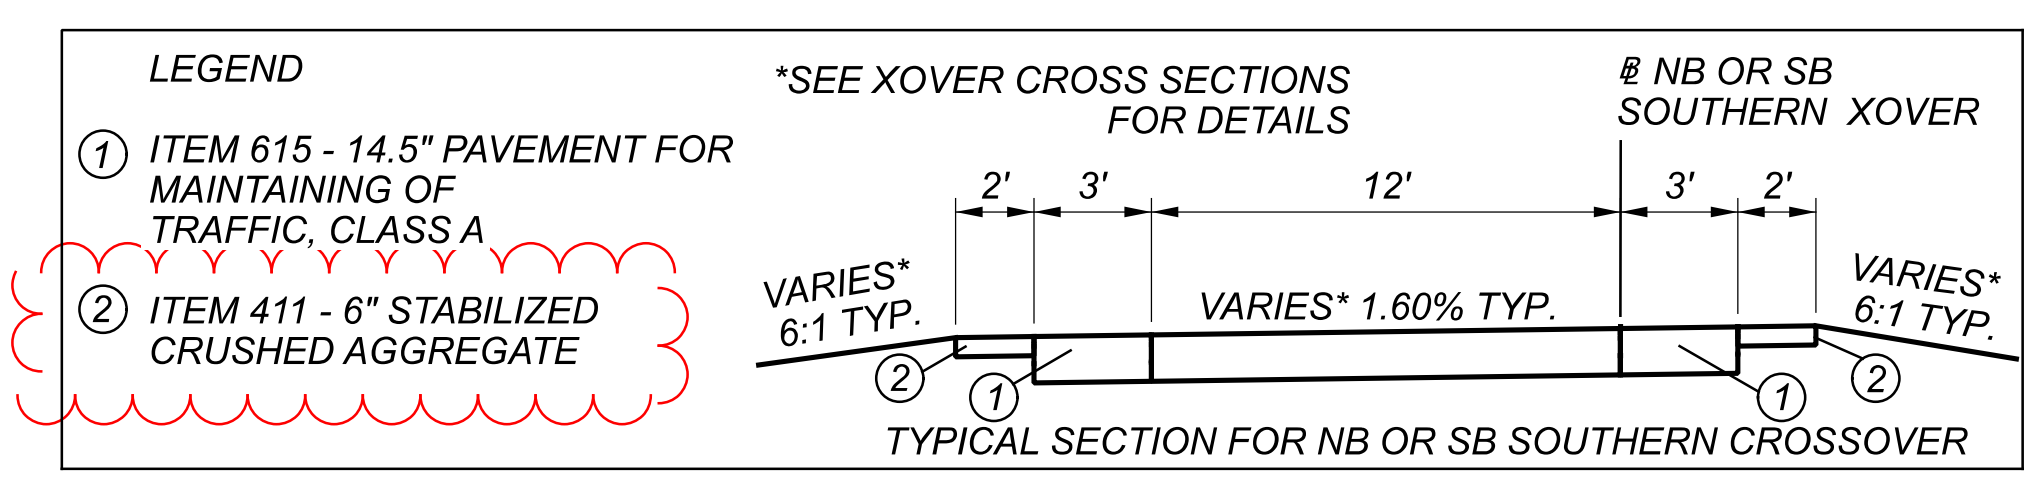

NOTES:
 FOR LEGEND SHEET, SEE SHEET 31
 FOR NB & SB SOUTHERN XOVER PROFILES, SEE SHEET 161

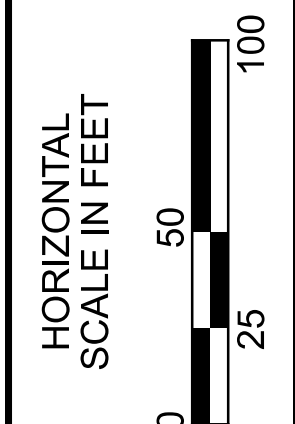


MAINTENANCE OF TRAFFIC - CROSSOVER DETAIL
 SOUTHERN CROSSOVER PLAN

| | |
|---|--------------|
| DESIGN AGENCY | |
| GANNETT FLEMING 2500 Corporate Exchange Dr. Suite 230 Columbus, OH 43231 | |
| DESIGNER | BRO |
| REVIEWER | DRJ 06-15-22 |
| PROJECT ID | 111405 |
| SHEET | TOTAL |
| 160 | 927 |


NORTHERN CROSSOVER WORK

DURING THE CONSTRUCTION OF THE NORTHERN CROSSOVER, THE CONTRACTOR SHALL REMOVE THE EXISTING MEDIAN CABLE RAIL RUN (CONSTRUCTED WITHIN SUM-77-32.27 PID 14983 PART 1 PROJECT) FROM STA. 1049+50 TO STA. 1060+14. WHEN THE MEDIAN CABLE IS REMOVED, THE CONTRACTOR SHALL ENSURE THAT ADEQUATE PROTECTION SHALL BE PROVIDED AT ALL TIMES FOR THE TRAVEL LANES IN THIS AREA. DURING PHASE 5, THE CONTRACTOR SHALL REPLACE THE PREVIOUSLY REMOVED MEDIAN CABLE RAIL IN KIND TO THE PREVIOUS EXISTING CONDITION.



THE WORK FOR THE REMOVAL OF THE CABLE RAIL AS WELL AS THE REINSTALLATION OF THE CABLE RAIL SHALL BE INCLUDED IN THE LUMP SUM BID PRICE FOR ITEM 614, MAINTAINING TRAFFIC.

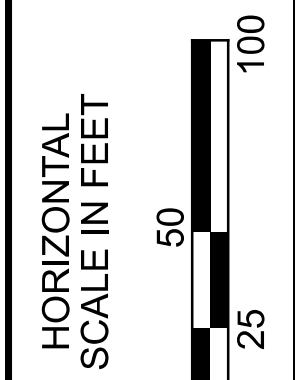

**MAINTENANCE OF TRAFFIC - CROSSOVER DETAIL
NORTHERN CROSSOVER PLAN**

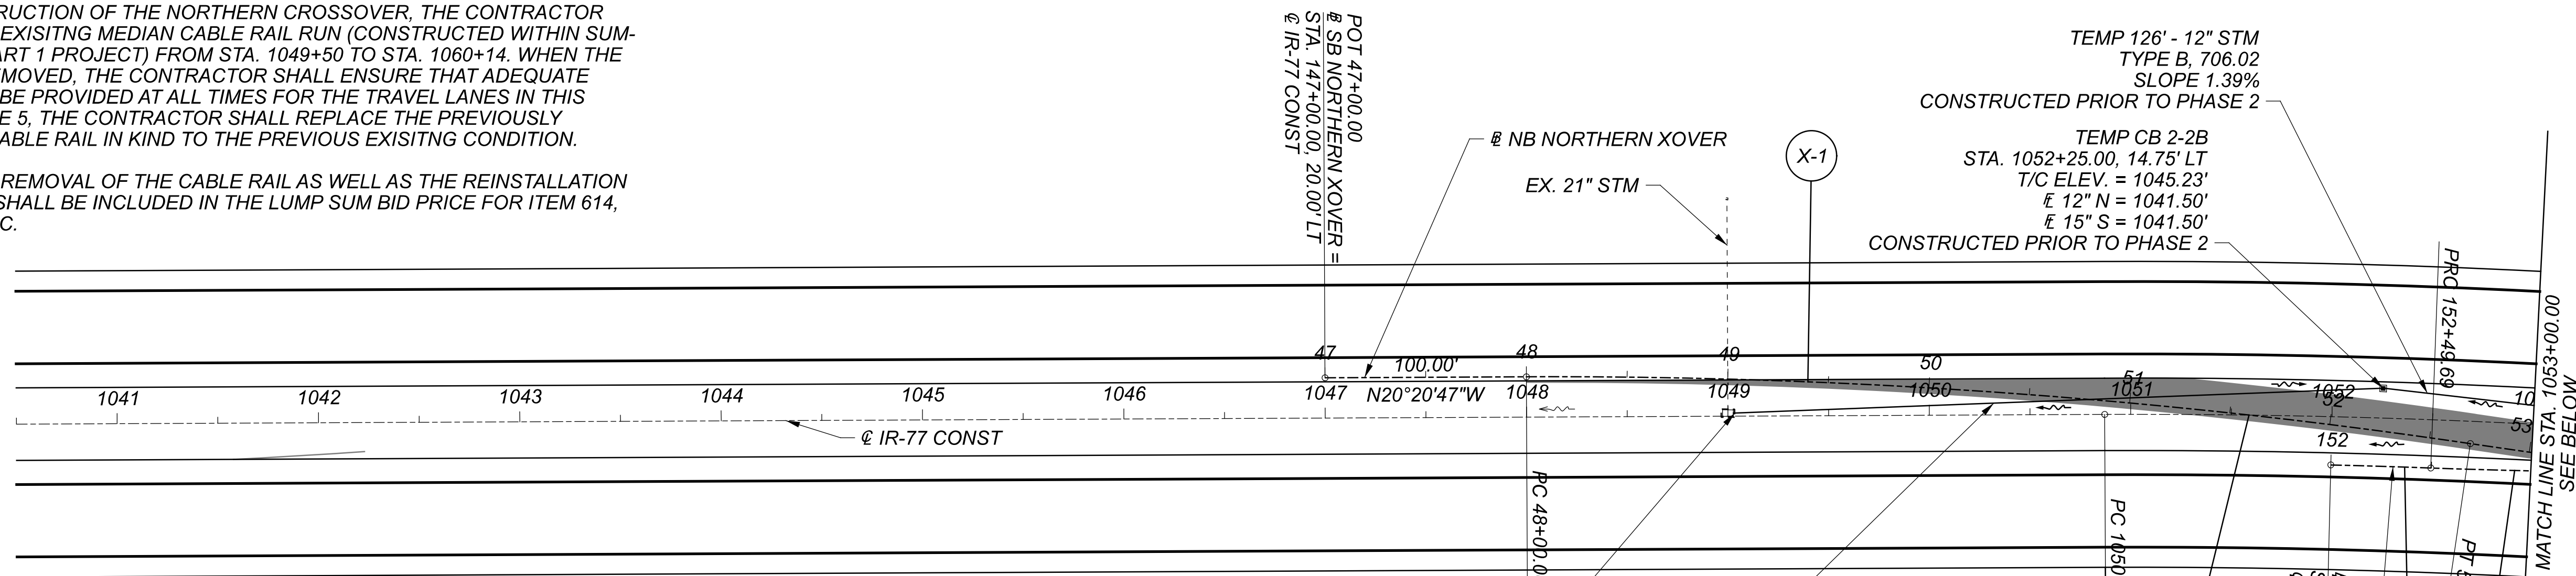

- LEGEND**
- ① ITEM 615 - 14.5" PAVEMENT FOR MAINTAINING OF TRAFFIC, CLASS A
 - ② ITEM 411 - 6" STABILIZED CRUSHED AGGREGATE

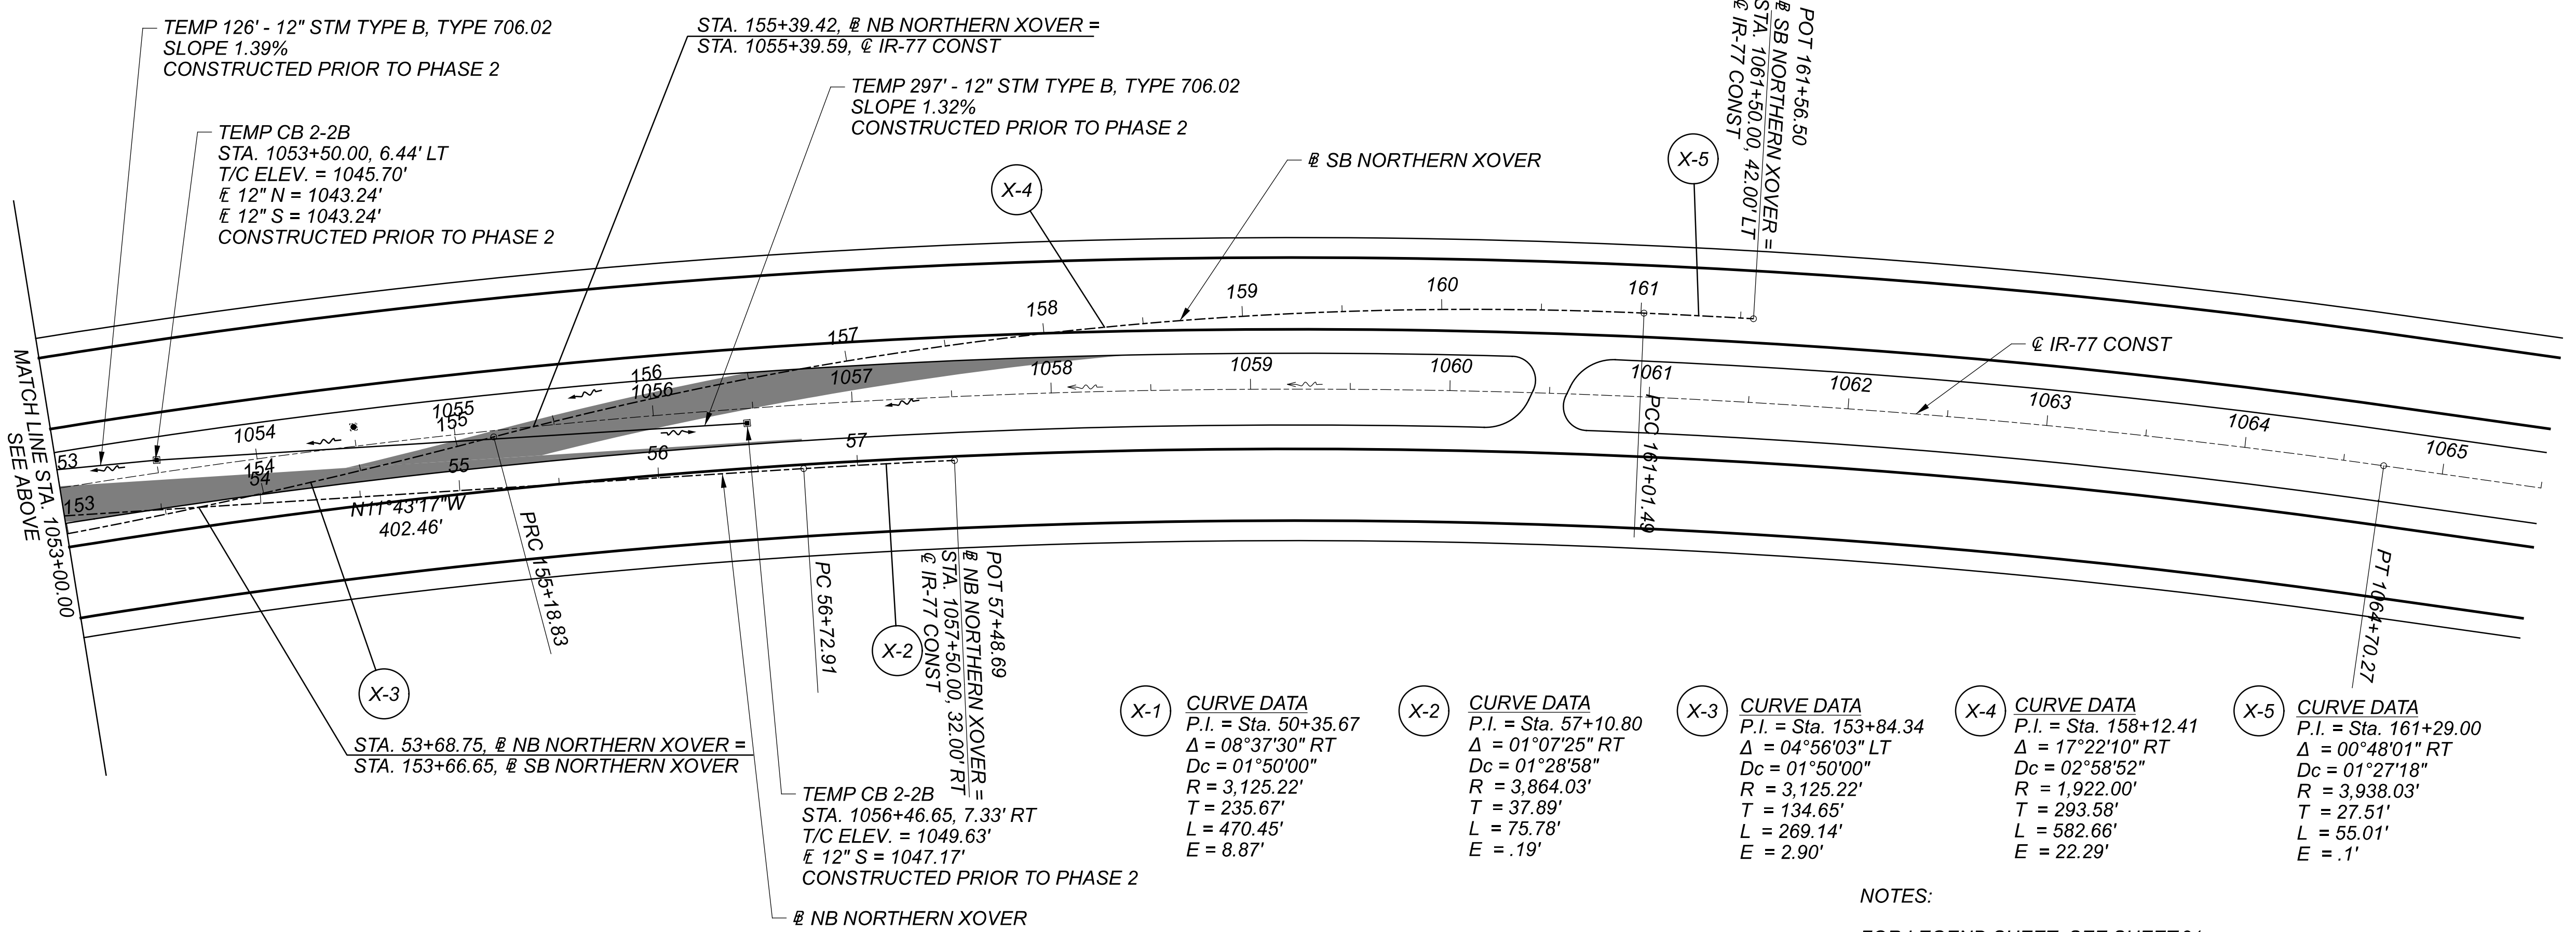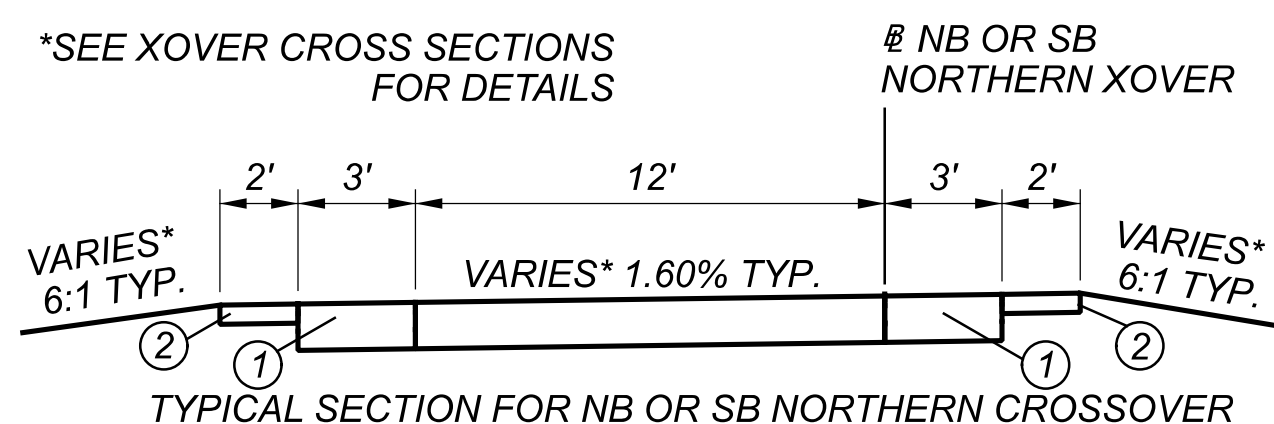

| Curve ID | P.I. | Delta | Dc | R | T | L | E |
|----------|----------------|--------------|-----------|-----------|---------|---------|--------|
| X-1 | Sta. 50+35.67 | 08°37'30" RT | 01°50'00" | 3,125.22' | 235.67' | 470.45' | 8.87' |
| X-2 | Sta. 57+10.80 | 01°07'25" RT | 01°28'58" | 3,864.03' | 37.89' | 75.78' | .19' |
| X-3 | Sta. 153+84.34 | 04°56'03" LT | 01°50'00" | 3,125.22' | 134.65' | 269.14' | 2.90' |
| X-4 | Sta. 158+12.41 | 17°22'10" RT | 02°58'52" | 1,922.00' | 293.58' | 582.66' | 22.29' |
| X-5 | Sta. 161+29.00 | 00°48'01" RT | 01°27'18" | 3,938.03' | 27.51' | 55.01' | .1' |

NOTES:
 FOR LEGEND SHEET, SEE SHEET 31
 FOR NB & SB NORTHERN XOVER PROFILES, SEE SHEET 172

DESIGNER: **GANNETT FLEMING**
 2500 Corporate Exchange Dr.
 Suite 230
 Columbus, OH 43231

BRO: DRJ
 REVIEWER: DRJ
 PROJECT ID: 111405
 SHEET: 171 TOTAL: 927

SHEET 3

SHEET NUMBER

FUNDING

ITEM

ITEM EXT.

GRAND TOTAL

UNIT

DESCRIPTION

SEE SHEET NO.

| OC | 20 | 21 | 22 | 23 | 24 | 33 | 187 | 194 | 195 | 575 | 648 | 650 | 654 | 01/IMS/04 | 02/IMS/03 | 05/S>2/04 | ITEM | ITEM EXT. | GRAND TOTAL | UNIT | DESCRIPTION | SEE SHEET NO. |
|-------|----|----|-------|----|----|----|-----|-----|-----|-----|-----|-----|-----|-----------|-----------|-----------|------|-----------|-------------|------|---|---------------|
| | | | | | | | | | | | | | | | | | | | | | DRAINAGE - CONTINUED FROM PREVIOUS PAGE | |
| | | | | | | | | 1 | | | | | | 1 | | | 611 | 98634 | 1 | EACH | CATCH BASIN RECONSTRUCTED TO GRADE | |
| | | | | | | | | 5 | | | | | | 5 | | | 611 | 99574 | 5 | EACH | MANHOLE, NO. 3 | |
| | | | 2 | | | | | 34 | | | | | | 36 | | | 611 | 99710 | 36 | EACH | PRECAST REINFORCED CONCRETE OUTLET | |
| | | | | | | | | | | | | | | 2 | | | 611 | 99720 | 2 | EACH | INSPECTION WELL | |
| | | | | | | | | | 520 | | | | | 520 | | | 833 | 10000 | 520 | FT | CULVERT (STA. 874+70.70) - OPTION A: (SPRAY APPLIED STRUCTURAL LINER) CONDUIT RENEWAL USING SPRAY APPLIED STRUCTURAL LINER, ROUND CONDUIT, 60" DIAMETER | |
| | | | | | | | | | 520 | | | | | 520 | | | 899 | 10000 | 520 | FT | CULVERT (STA. 874+70.70) - OPTION B: (CURED-IN-PLACE PIPE LINER) CURED-IN-PLACE PIPE LINER, 60" DIAMETER | |
| | | | | | | | | | 400 | | | | | 400 | | | 833 | 10000 | 400 | FT | CULVERT (STA. 880+81.58) - OPTION A: (SPRAY APPLIED STRUCTURAL LINER) CONDUIT RENEWAL USING SPRAY APPLIED STRUCTURAL LINER, ROUND CONDUIT, 36" DIAMETER | |
| | | | | | | | | | 400 | | | | | 400 | | | 899 | 10000 | 400 | FT | CULVERT (STA. 880+81.58) - OPTION B: (CURED-IN-PLACE PIPE LINER) CURED-IN-PLACE PIPE LINER, 36" DIAMETER | |
| | | | | | | | | | 378 | | | | | 378 | | | 833 | 10000 | 378 | FT | CULVERT (STA. 900+15.34) - OPTION A: (SPRAY APPLIED STRUCTURAL LINER) CONDUIT RENEWAL USING SPRAY APPLIED STRUCTURAL LINER, ROUND CONDUIT, 36" DIAMETER | |
| | | | | | | | | | 378 | | | | | 378 | | | 899 | 10000 | 378 | FT | CULVERT (STA. 900+15.34) - OPTION B: (CURED-IN-PLACE PIPE LINER) CURED-IN-PLACE PIPE LINER, 36" DIAMETER | |
| | | | | | | | | | 280 | | | | | 280 | | | 833 | 10000 | 280 | FT | CULVERT (STA. 905+30.72) - OPTION A: (SPRAY APPLIED STRUCTURAL LINER) CONDUIT RENEWAL USING SPRAY APPLIED STRUCTURAL LINER, ROUND CONDUIT, 48" DIAMETER | |
| | | | | | | | | | 280 | | | | | 280 | | | 899 | 10000 | 280 | FT | CULVERT (STA. 905+30.72) - OPTION B: (CURED-IN-PLACE PIPE LINER) CURED-IN-PLACE PIPE LINER, 48" DIAMETER | |
| | | | | | | | | | 248 | | | | | 248 | | | 833 | 10000 | 248 | FT | CULVERT (STA. 927+31.88) - OPTION A: (SPRAY APPLIED STRUCTURAL LINER) CONDUIT RENEWAL USING SPRAY APPLIED STRUCTURAL LINER, ROUND CONDUIT, 54" DIAMETER | |
| | | | | | | | | | 248 | | | | | 248 | | | 899 | 10000 | 248 | FT | CULVERT (STA. 927+31.88) - OPTION B: (CURED-IN-PLACE PIPE LINER) CURED-IN-PLACE PIPE LINER, 54" DIAMETER | |
| | | | | | | | | | 284 | | | | | 284 | | | 833 | 10000 | 284 | FT | CULVERT (STA. 941+57.97) - OPTION A: (SPRAY APPLIED STRUCTURAL LINER) CONDUIT RENEWAL USING SPRAY APPLIED STRUCTURAL LINER, ROUND CONDUIT, 60" DIAMETER | |
| | | | | | | | | | 284 | | | | | 284 | | | 899 | 10000 | 284 | FT | CULVERT (STA. 941+57.97) - OPTION B: (CURED-IN-PLACE PIPE LINER) CURED-IN-PLACE PIPE LINER, 60" DIAMETER | |
| | | | | | | | | | 216 | | | | | 216 | | | 833 | 10000 | 216 | FT | CULVERT (STA. 948+86.86) - OPTION A: (SPRAY APPLIED STRUCTURAL LINER) CONDUIT RENEWAL USING SPRAY APPLIED STRUCTURAL LINER, ROUND CONDUIT, 42" DIAMETER | |
| | | | | | | | | | 216 | | | | | 216 | | | 899 | 10000 | 216 | FT | CULVERT (STA. 948+86.86) - OPTION B: (CURED-IN-PLACE PIPE LINER) CURED-IN-PLACE PIPE LINER, 42" DIAMETER | |
| | | | | | | | | | 374 | | | | | 374 | | | 833 | 10000 | 374 | FT | CULVERT (STA. 958+67.83) - OPTION A: (SPRAY APPLIED STRUCTURAL LINER) CONDUIT RENEWAL USING SPRAY APPLIED STRUCTURAL LINER, ROUND CONDUIT, 54" DIAMETER | |
| | | | | | | | | | 374 | | | | | 374 | | | 899 | 10000 | 374 | FT | CULVERT (STA. 958+67.83) - OPTION B: (CURED-IN-PLACE PIPE LINER) CURED-IN-PLACE PIPE LINER, 54" DIAMETER | |
| | | | | | | | | | 348 | | | | | 348 | | | 833 | 10000 | 348 | FT | CULVERT (STA. 1019+32.03) - OPTION A: (SPRAY APPLIED STRUCTURAL LINER) CONDUIT RENEWAL USING SPRAY APPLIED STRUCTURAL LINER, ROUND CONDUIT, 36" DIAMETER | |
| | | | | | | | | | 348 | | | | | 348 | | | 899 | 10000 | 348 | FT | CULVERT (STA. 1019+32.03) - OPTION B: (CURED-IN-PLACE PIPE LINER) CURED-IN-PLACE PIPE LINER, 36" DIAMETER | |
| | | | | | | | | | 477 | | | | | 477 | | | 833 | 10000 | 477 | FT | CULVERT (STA. 1025+21.03) - OPTION A: (SPRAY APPLIED STRUCTURAL LINER) CONDUIT RENEWAL USING SPRAY APPLIED STRUCTURAL LINER, ROUND CONDUIT, 36" DIAMETER | |
| | | | | | | | | | 477 | | | | | 477 | | | 899 | 10000 | 477 | FT | CULVERT (STA. 1025+21.03) - OPTION B: (CURED-IN-PLACE PIPE LINER) CURED-IN-PLACE PIPE LINER, 36" DIAMETER | |
| | | | | | | | | | 232 | | | | | 232 | | | 833 | 10000 | 232 | FT | CULVERT (STA. 1054+09.98) - OPTION A: (SPRAY APPLIED STRUCTURAL LINER) CONDUIT RENEWAL USING SPRAY APPLIED STRUCTURAL LINER, ROUND CONDUIT, 36" DIAMETER | |
| | | | | | | | | | 232 | | | | | 232 | | | 899 | 10000 | 232 | FT | CULVERT (STA. 1054+09.98) - OPTION B: (CURED-IN-PLACE PIPE LINER) CURED-IN-PLACE PIPE LINER, 36" DIAMETER | |
| | | | 42917 | | | | | | | | | | | 42917 | | | 254 | 01000 | 42917 | SY | PAVEMENT PLANING - ASPHALT CONCRETE (1.5" DEPTH) | |
| | | | | | 4 | | | | | | | | | 3 | 1 | | 301 | 56000 | 4 | CY | ASPHALT CONCRETE BASE, (449), PG64-22 | 24 |
| 46629 | | | | | 4 | | | | | | | | | 31086 | 15543 | | 302 | 56000 | 46629 | CY | ASPHALT CONCRETE BASE, (449), PG64-22 | 22 |
| 41773 | | | | | 2 | | | | | | | | | 27851 | 13926 | | 304 | 20000 | 41777 | CY | AGGREGATE BASE | 22 |
| 24305 | | | | | | | | | | | | | | 16205 | 8102 | | 407 | 20000 | 24307 | GAL | NON-TRACKING TACK COAT (0.055 GAL/SY) | |
| 5031 | | | | | | | | | | | | | | 3355 | 1676 | | 408 | 10001 | 5031 | GAL | PRIME COAT, AS PER PLAN | 24 |
| 14890 | | | | | | | | | | | | | | 9928 | 4962 | | 441 | 00100 | 14890 | CY | ANTI-SEGREGATION EQUIPMENT | |
| 8 | | | | | 2 | | | | | | | | | 7 | 3 | | 441 | 70101 | 10 | CY | ASPHALT CONCRETE SURFACE COURSE, TYPE 1, (449), PG64-22 AS PER PLAN | 21 |
| 10 | | | | | 2 | | | | | | | | | 9 | 3 | | 441 | 70300 | 12 | CY | ASPHALT CONCRETE INTERMEDIATE COURSE, TYPE 2, (449) | |

GENERAL SUMMARY

SUM-77-28.75

MODEL: 111405_GG001_3 PAPER SIZE: 34x22 (in.) DATE: 7/25/2023 TIME: 7:28:13 AM USER: cmann
p:\gnet-pw\benley.com\gnet-pw-01\Documents\Projects\67490\111405\401-Engineering-GP\Roadway\Sheets\111405_GG001.dgn



| | |
|------------|--------------|
| DESIGNER | TQD |
| REVIEWER | DRJ 10/04/22 |
| PROJECT ID | 111405 |
| SHEET | TOTAL |
| 183 | 927 |

SHEET 4

SHEET NUMBER

FUNDING

ITEM ITEM EXT. GRAND TOTAL UNIT DESCRIPTION SEE SHEET NO.

PAVEMENT - CONTINUED FROM PREVIOUS PAGE

Table with columns: SHEET NUMBER (OC, 20, 21, 22, 23, 24, 33, 187, 194, 195, 575, 648, 650, 654), FUNDING (01/IMS/04, 02/IMS/03, 05/S>2/04), ITEM, ITEM EXT., GRAND TOTAL, UNIT, DESCRIPTION, SEE SHEET NO.

GENERAL SUMMARY

DESIGN AGENCY: GANNETT FLEMING, 2500 Corporate Exchange Dr., Suite 230, Columbus, OH 43231. Includes fields for Designer (TQD), Reviewer (DRJ), Project ID (111405), and Sheet Total (184/927).

SUM-77-28.75

MODEL: 111405_GG001_4_PAPER SIZE: 34x22 (in.) DATE: 7/25/2023 TIME: 7:42:13 AM USER: cmann p:\gnet-pw\benley.com\gnet-pw-01\Documents\Projects\67490111405401-Engineering-GF-Roadway\Sheets\111405_GG001.dgn

| SHEET NUMBER | | | | | | | | | | | | | FUNDING | | | ITEM | ITEM EXT. | GRAND TOTAL | UNIT | DESCRIPTION | SEE SHEET NO. | | | | |
|--------------|----|----|----|----|----|-----------|-----|-----|-----|-----|-----|-----|---------|-----------|-----------|------|-----------|-------------|--------|-------------|---|--|----|--|--|
| 0C | 20 | 21 | 22 | 23 | 24 | 33 | 187 | 194 | 195 | 575 | 648 | 650 | 654 | 01/IMS/04 | 02/IMS/03 | | | | | | | 05/S>2/04 | | | |
| | | | | | | 158 69 | | | | | | | | 158 69 | | | 411 | 10000 | 158 | CY | MAINTENANCE OF TRAFFIC - CONTINUED FROM PREVIOUS PAGE | | | | |
| | | | | | | 2400 | | | | | | | | 2400 | | | 442 | 20001 | 69 | CY | | ASPHALT CONCRETE SURFACE COURSE, 12.5 MM, TYPE A (448), AS PER PLAN, PG70-22M | 30 | | |
| | | | | | | | | | | | | | | | | | 614 | 11110 | 2400 | HOUR | | LAW ENFORCEMENT OFFICER WITH PATROL CAR FOR ASSISTANCE | | | |
| | | | | | | 3249 | | | | | | | | 3249 | | | 614 | 11630 | 3249 | FT | | INCREASED BARRIER DELINEATION | | | |
| | | | | | | 41 | | | | | | | | 41 | | | 614 | 12380 | 41 | EACH | | WORK ZONE IMPACT ATTENUATOR, 24" WIDE HAZARDS, (UNIDIRECTIONAL) | 28 | | |
| | | | | | | LS | | | | | | | | LUMP | | | 614 | 12420 | LS | | | DETOUR SIGNING | 28 | | |
| | | | | | | 34 | | | | | | | | 34 | | | 614 | 12484 | 34 | EACH | | WORK ZONE INCREASED PENALTIES SIGN | | | |
| | | | | | | 2 | | | | | | | | 2 | | | 614 | 12756 | 2 | EACH | | WORK ZONE CROSSOVER LIGHTING SYSTEM | | | |
| | | | | | | 6180 | | | | | | | | 6180 | | | 614 | 12801 | 6180 | EACH | | WORK ZONE RAISED PAVEMENT MARKER, AS PER PLAN | 27 | | |
| | | | | | | 250 | | | | | | | | 250 | | | 614 | 13000 | 250 | CY | | ASPHALT CONCRETE FOR MAINTAINING TRAFFIC | | | |
| | | | | | | 3277 | | | | | | | | 3277 | | | 614 | 13310 | 3277 | EACH | | BARRIER REFLECTOR, TYPE 1, 1 WAY | | | |
| | | | | | | 334 | | | | | | | | 334 | | | 614 | 13310 | 334 | EACH | | BARRIER REFLECTOR, TYPE 1, BIDIRECTIONAL | | | |
| | | | | | | 272 | | | | | | | | 272 | | | 614 | 13312 | 272 | EACH | | BARRIER REFLECTOR, TYPE 2, BIDIRECTIONAL | | | |
| | | | | | | 1826 | | | | | | | | 1826 | | | 614 | 13350 | 1826 | EACH | | OBJECT MARKER, ONE WAY | | | |
| | | | | | | 1105 | | | | | | | | 1105 | | | 614 | 13360 | 1105 | EACH | | OBJECT MARKER, TWO WAY | | | |
| | | | | | | 300000 | | | | | | | | 300000 | | | 614 | 18000 | 300000 | EACH | | MAINTAINING TRAFFIC, MISC.: SAFETY REPAIRS | 32 | | |
| | | | | | | 300000 | | | | | | | | 300000 | | | 614 | 18000 | 300000 | EACH | | MAINTAINING TRAFFIC, MISC.: BRIDGE DECK AND PAVEMENT PATCHING | 32 | | |
| | | | | | | 144 | | | | | | | | 144 | | | 614 | 18601 | 144 | SNMT | | PORTABLE CHANGEABLE MESSAGE SIGN, AS PER PLAN | 27 | | |
| | | | | | | 88.19 | | | | | | | | 88.19 | | | 614 | 98000 | 88.19 | MILE | | WORK ZONE PAVEMENT MARKING, MISC.: EDGE LINE, 6", SPRAY THERMOPLASTIC | 31 | | |
| | | | | | | 10.08 | | | | | | | | 10.08 | | | 614 | 98000 | 10.08 | MILE | | WORK ZONE PAVEMENT MARKING, MISC.: LANE LINE, 6", SPRAY THERMOPLASTIC | 31 | | |
| | | | | | | 0.1 | | | | | | | | 0.1 | | | 614 | 98000 | 0.1 | MILE | | WORK ZONE PAVEMENT MARKING, MISC.: CENTER LINE, 6", SPRAY THERMOPLASTIC | 31 | | |
| | | | | | | 50226 | | | | | | | | 50226 | | | 614 | 98100 | 50226 | FT | | WORK ZONE PAVEMENT MARKING, MISC.: CHANNELIZING LINE, 12", SPRAY THERMOPLASTIC | 31 | | |
| | | | | | | 22948 | | | | | | | | 22948 | | | 614 | 98100 | 22948 | FT | | WORK ZONE PAVEMENT MARKING, MISC.: DOTTED LINE, 6", SPRAY THERMOPLASTIC | 31 | | |
| | | | | | | 197 | | | | | | | | 197 | | | 614 | 98100 | 197 | FT | | WORK ZONE PAVEMENT MARKING, MISC.: GORE MARKING, SPRAY THERMOPLASTIC | 31 | | |
| | | | | | | 16 | | | | | | | | 16 | | | 614 | 98100 | 16 | FT | | WORK ZONE PAVEMENT MARKING, MISC.: STOP LINE, SPRAY THERMOPLASTIC | 31 | | |
| | | | | | | 2 | | | | | | | | 2 | | | 614 | 98200 | 2 | EACH | | WORK ZONE PAVEMENT MARKING, MISC.: ARROW, SPRAY THERMOPLASTIC | 31 | | |
| | | | | | | LS | | | | | | | | LUMP | | | 615 | 10000 | LS | | | ROADS FOR MAINTAINING TRAFFIC | | | |
| | | | | | | 63156 | | | | | | | | 63156 | | | 615 | 20000 | 63156 | SY | | PAVEMENT FOR MAINTAINING TRAFFIC, CLASS A | | | |
| | | | | | | 4622 | | | | | | | | 4622 | | | 615 | 20001 | 4622 | SY | | PAVEMENT FOR MAINTAINING TRAFFIC, CLASS A, AS PER PLAN | 29 | | |
| | | | | | | 895 | | | | | | | | 895 | | | 616 | 10000 | 895 | MGAL | | WATER | | | |
| | | | | | | 1.12 | | | | | | | | 1.12 | | | 618 | 40600 | 1.12 | MILE | | RUMBLE STRIPS, SHOULDER (ASPHALT CONCRETE) | | | |
| | | | | | | 45980 | | | | | | | | 45980 | | | 622 | 41011 | 45980 | FT | | PORTABLE BARRIER, 50", AS PER PLAN | 26 | | |
| | | | | | | 4 | | | | | | | | 4 | | | 622 | 41050 | 4 | EACH | | PORTABLE BARRIER, "Y" CONNECTOR | | | |
| | | | | | | 86700 | | | | | | | | 86700 | | | 622 | 41100 | 86700 | FT | | PORTABLE BARRIER, UNANCHORED | | | |
| | | | | | | 1610 | | | | | | | | 1610 | | | 622 | 80000 | 1610 | FT | | GLARE SCREEN | | | |
| | | | | | | 1116 | | | | | | | | 1116 | | | 630 | 80200 | 1116 | SF | | SIGN, GROUND MOUNTED EXTRUSHEET | | | |
| | | | | | | 18 | | | | | | | | 18 | | | 630 | 87101 | 18 | EACH | | REMOVAL OF OVERHEAD MOUNTED SIGN AND REERECTION, AS PER PLAN | 31 | | |
| | | | | | | 21 | | | | | | | | 21 | | | 630 | 97700 | 21 | EACH | | SIGNING, MISC.: TEMPORARY GROUND MOUNTED SIGN SUPPORT | 31 | | |
| | | | | | | 648 | | | | | | | | 648 | | | 808 | 18700 | 648 | SNMT | | DIGITAL SPEED LIMIT (DSL) SIGN ASSEMBLY | | | |
| | | | | | | | | | | | | | | | | | | | | | | INCIDENTALS | | | |
| | | | | | | | | | | | | | | LUMP | | | 108 | 10000 | LS | | | CPM PROGRESS SCHEDULE | | | |
| | | | | | | | | | | | | | | LUMP | | | 614 | 11000 | LS | | | MAINTAINING TRAFFIC | | | |
| | | | | | | | | | | | | | | 42 | | | 619 | 16021 | 42 | MNTH | | FIELD OFFICE, TYPE C, AS PER PLAN | 23 | | |
| | | | | | | | | | | | | | | LUMP | | | 623 | 10000 | LS | | | CONSTRUCTION LAYOUT STAKES AND SURVEYING | | | |
| | | | | | | | | | | | | | | LUMP | | | 624 | 10000 | LS | | | MOBILIZATION | | | |

| REF NO. | SHEET NO. | STATION | | | | SIDE | 202 | | 620 | | 618 | |
|--|-----------|---------|------------|--------------------------------|-------------------------|------|-------------------------------|---|-----|--------|-----|--|
| | | FROM | TO | CONCRETE BARRIER REMOVED FT | GUARDRAIL REMOVED FT | | REMOVAL OF DELINEATOR EACH | RUMBLE STRIPES, EDGE LINE (ASPHALT CONCRETE) MILE | | | | |
| R206 | 227 | 271C | 5908+48.29 | 271C | | | | | | 1 | | |
| R207 | 227 | 271C | 5909+68.29 | 271C | 5911+13.56 | | | 145.3 | | | | |
| R208 | 227 | 271C | 5911+13.56 | 271C | 5912+14.72 | | 101.2 | | | | | |
| R209 | 227 | 271C | 5912+54.88 | 271C | 5913+92.99 | | | | | 3 | | |
| R210 | 227 | 271C | 5912+82.44 | 271C | 5913+96.07 | | | | | 3 | | |
| R211 | 228 | 271D | 6915+20.78 | 271D | 6915+67.31 | | | | | 2 | | |
| R212 | 228 | 271D | 6915+22.71 | 271D | 6916+78.31 | | | | | 3 | | |
| R213 | 228 | 271D | 6916+99.57 | 271D | 6918+43.66 | | | 144.1 | | | | |
| R301 | 231 | 21F | 9013+31.85 | 21F | 9028+20.31 | | | | | | | |
| R302 | 231 | 21F | 9022+96.51 | 21F | 9026+92.93 | | | | | 1488.5 | | |
| R303 | 231 | 21F | 9030+48.29 | 21F | 9034+06.48 | | | | | 396.5 | | |
| R401 | 233 | 178 | 10+98.00 | 178 | 11+98.00 | | | | | | | |
| R402 | 233 | 178 | 11+06.00 | 178 | 12+06.00 | | | | | 100 | | |
| R501 | 234 | 303 | 155+88.00 | 303 | 156+82.50 | | | | | | | |
| R502 | 234 | 303 | 155+88.00 | 303 | 156+82.50 | | 94.5 | | | 94.5 | | |
| P1 | 202 | IR77 | 842+00.00 | IR77 | 873+45.13 | | | | | | 0.6 | |
| P2 | 202 | IR77 | 842+00.00 | IR77 | 956+56.67 | | | | | | 2.2 | |
| P3 | 202 | IR77 | 842+00.00 | IR77 | 956+52.54 | | | | | | 2.2 | |
| P4 | 202 | IR77 | 842+00.00 | IR77 | 886+35.00 | | | | | | 0.9 | |
| P5 | 205 | IR77 | 876+51.88 | IR77 | 901+18.26 | | | | | | 0.5 | |
| P6 | 206 | IR77 | 890+76.35 | IR77 | 898+85.53 | | | | | | 0.2 | |
| P7 | 207 | IR77 | 901+06.82 | IR77 | 908+24.07 | | | | | | 0.2 | |
| P8 | 207 | IR77 | 905+26.51 | IR77 | 918+43.66 | | | | | | 0.3 | |
| P9 | 208 | IR77 | 912+31.61 | IR77 | 933+95.96 | | | | | | 0.5 | |
| P10 | 208 | IR77 | 920+25.60 | IR77 | 931+74.88 | | | | | | 0.3 | |
| P11 | 210 | IR77 | 936+17.09 | IR77 | 956+56.67 | | | | | | 0.4 | |
| P12 | 210 | IR77 | 936+71.11 | IR77 | 956+52.54 | | | | | | 0.4 | |
| P13 | 211 | IR77 | 958+43.18 | IR77 | 1005+38.93 | | | | | | 0.9 | |
| P14 | 211 | IR77 | 958+43.18 | IR77 | 986+85.32 | | | | | | 0.6 | |
| P15 | 211 | IR77 | 958+47.31 | IR77 | 989+02.70 | | | | | | 0.6 | |
| P16 | 211 | IR77 | 958+43.18 | IR77 | 1005+61.07 | | | | | | 0.9 | |
| P17 | 214 | IR77 | 989+47.29 | IR77 | 1005+38.93 | | | | | | 0.4 | |
| P18 | 214 | IR77 | 991+64.63 | IR77 | 1005+52.73 | | | | | | 0.3 | |
| P19 | 215 | IR77 | 1007+22.84 | IR77 | 1010+63.25 | | | | | | 0.1 | |
| P20 | 215 | IR77 | 1007+22.84 | IR77 | 1010+63.25 | | | | | | 0.1 | |
| P21 | 215 | IR77 | 1007+37.54 | IR77 | 1011+01.49 | | | | | | 0.1 | |
| P22 | 215 | IR77 | 1007+37.54 | IR77 | 1011+01.49 | | | | | | 0.1 | |
| P23 | 216 | IR77 | 1012+85.99 | IR77 | 1013+31.85 | | | | | | 0.1 | |
| P24 | 216 | IR77 | 1012+85.99 | IR77 | 1026+57.27 | | | | | | 0.3 | |
| P25 | 216 | IR77 | 1013+12.51 | IR77 | 1025+93.57 | | | | | | 0.3 | |
| P26 | 216 | IR77 | 1013+12.51 | IR77 | 1025+32.76 | | | | | | 0.3 | |
| P27 | 216 | IR77 | 1019+06.39 | IR77 | 1026+92.32 | | | | | | 0.2 | |
| SUBTOTAL | | | | | | | 290.2 | 2732.6 | | 12 | 14 | |
| TOTALS CARRIED TO SUBSUMMARY ON SHEET | | | | | | | 291 | 2733 | | 12 | 14 | |

ESTIMATED QUANTITIES


DESIGN AGENCY
GANNETT FLEMING
 2500 Corporate Exchange Dr.
 Suite 230
 Columbus, OH 43231

DESIGNER
TQD

REVIEWER
DRJ 10/04/22

PROJECT ID
111405

SHEET TOTAL
190 | 927

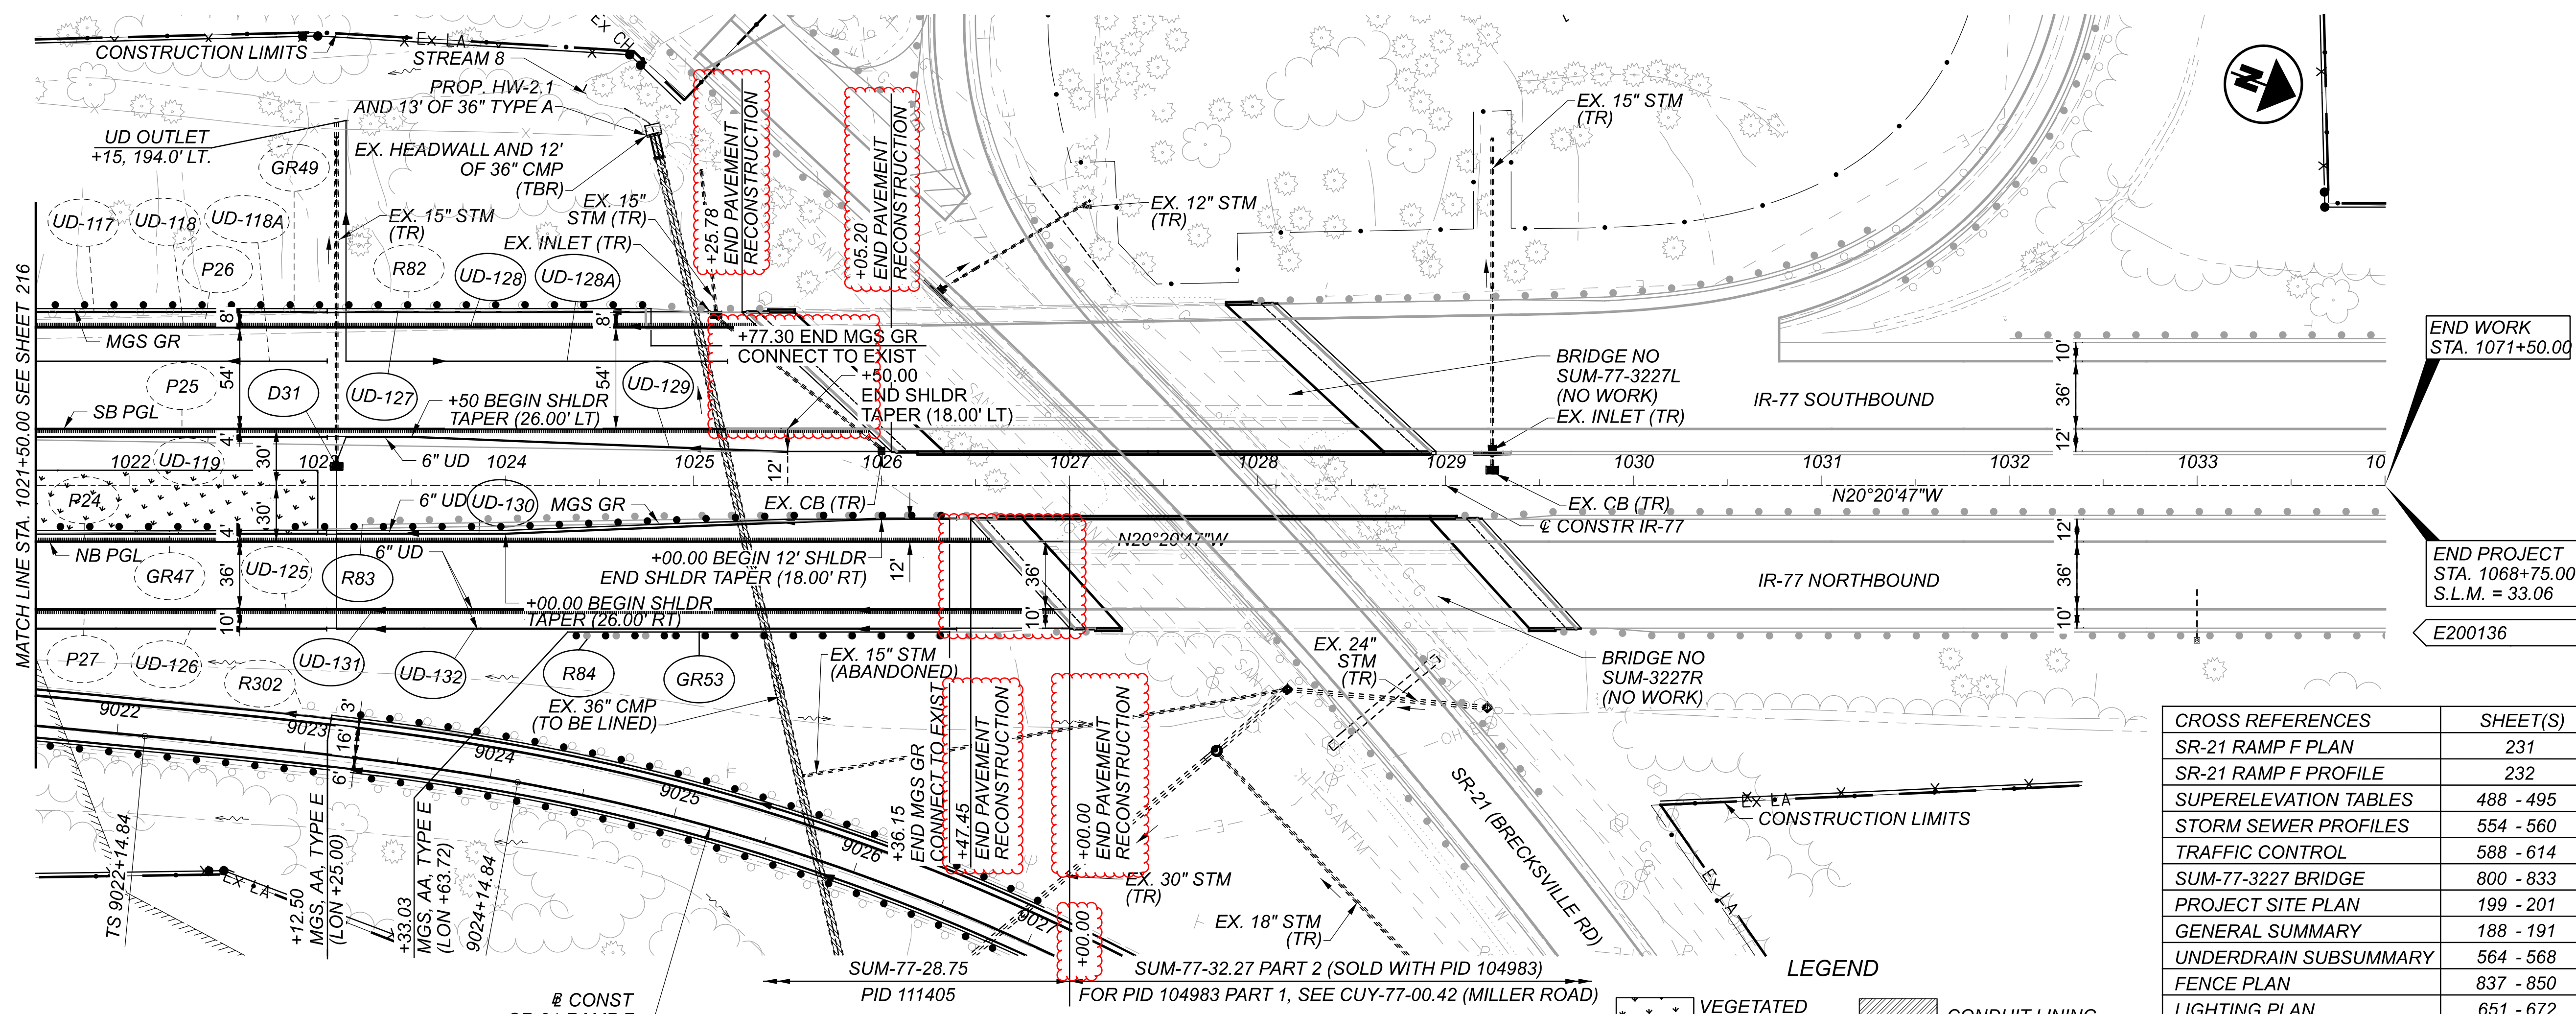

END WORK STA. 1071+50.00

END PROJECT STA. 1068+75.00
S.L.M. = 33.06



E200136

| CROSS REFERENCES | SHEET(S) |
|-----------------------|-----------|
| SR-21 RAMP F PLAN | 231 |
| SR-21 RAMP F PROFILE | 232 |
| SUPERELEVATION TABLES | 488 - 495 |
| STORM SEWER PROFILES | 554 - 560 |
| TRAFFIC CONTROL | 588 - 614 |
| SUM-77-3227 BRIDGE | 800 - 833 |
| PROJECT SITE PLAN | 199 - 201 |
| GENERAL SUMMARY | 188 - 191 |
| UNDERDRAIN SUBSUMMARY | 564 - 568 |
| FENCE PLAN | 837 - 850 |
| LIGHTING PLAN | 651 - 672 |

LEGEND

VEGETATED FILTER STRIPS

CONDUIT LINING

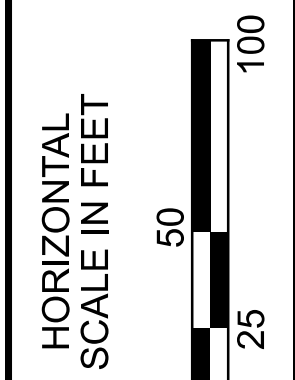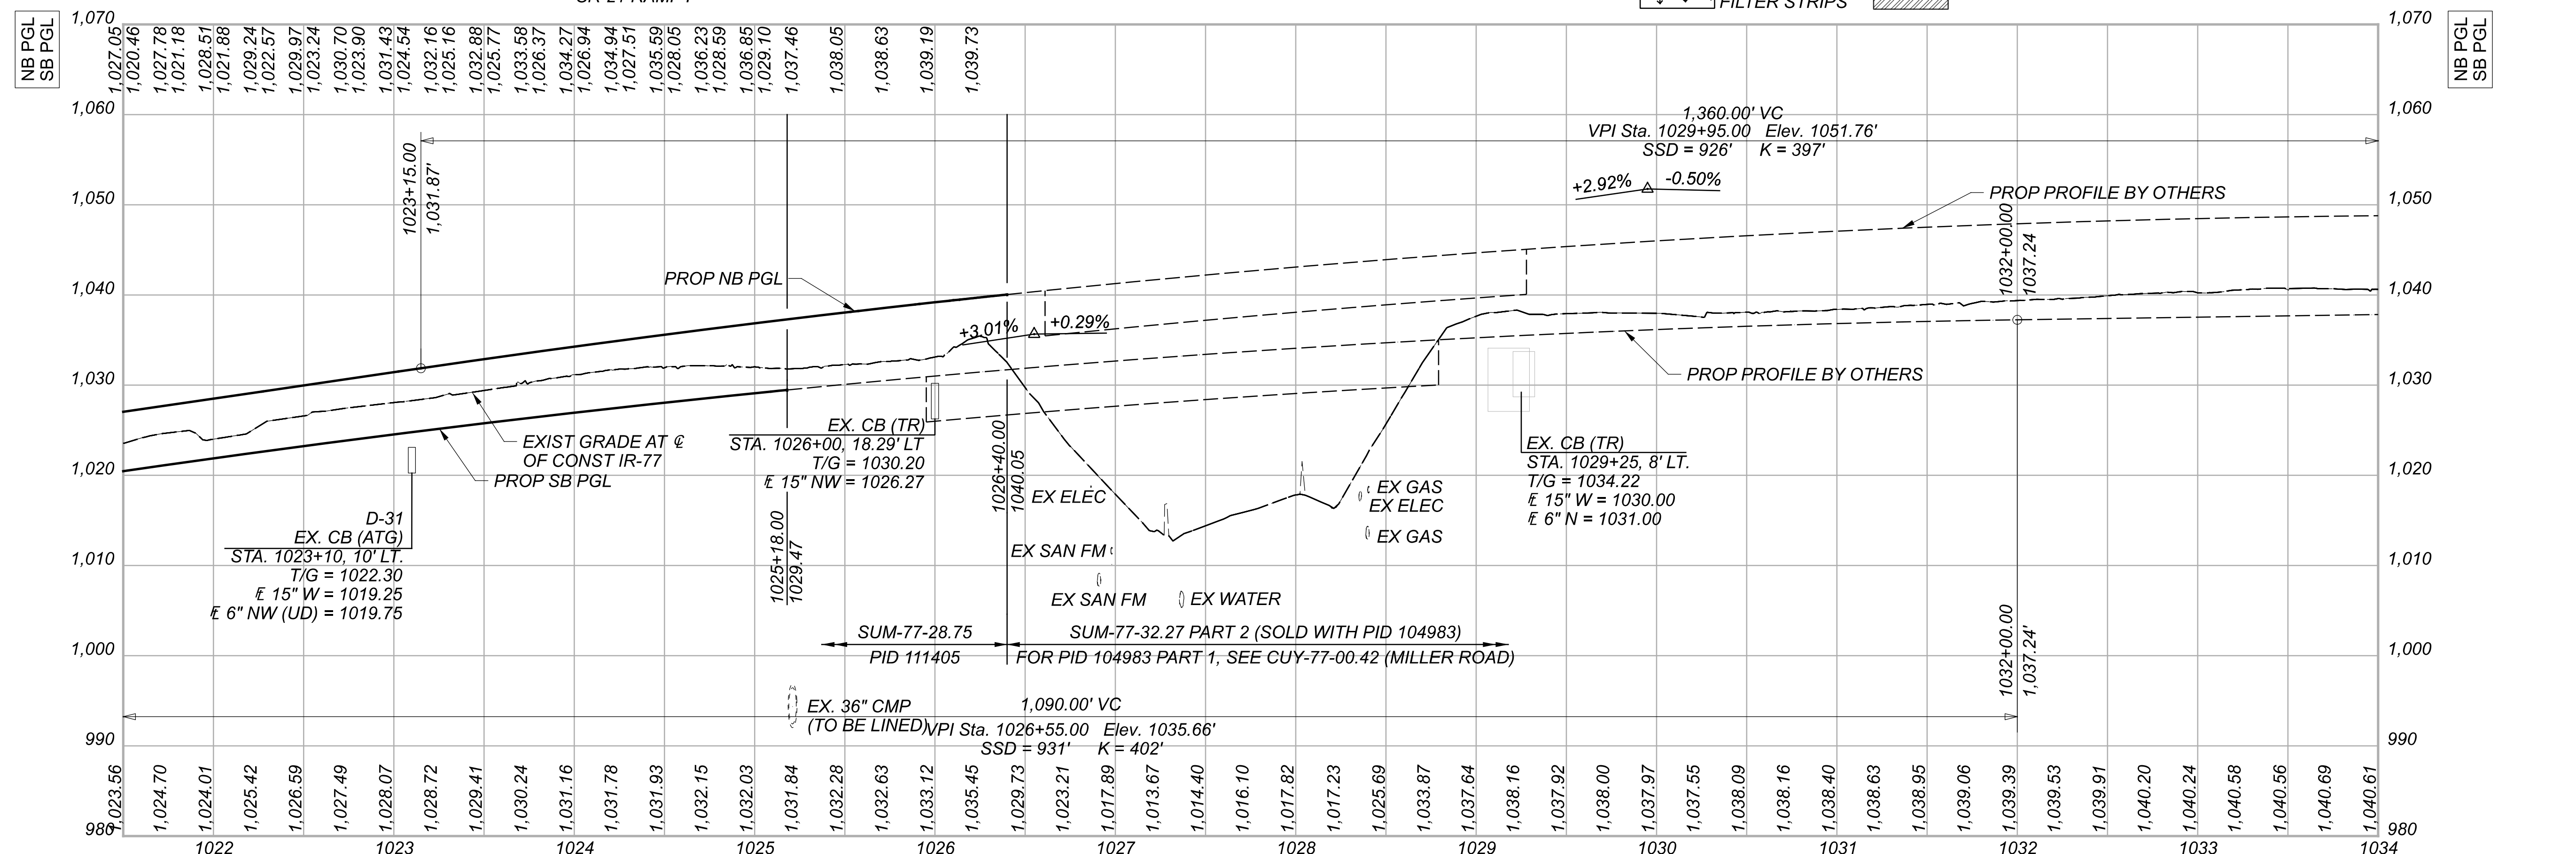

PLAN AND PROFILE

IR-77 - STA. 1021+50 TO STA. 1034+00

DESIGN AGENCY

GANNETT FLEMING

2500 Corporate Exchange Dr.
Suite 230
Columbus, OH 43231

DESIGNER

WWM

REVIEWER

PRS 04/22/22

PROJECT ID

111405

SHEET TOTAL

217 927

| SUM-77-3187 L/R BRIDGE SUMMARY | | | | | | | | | | CALCULATED: RAZ 05/18/22 | CHECKED: SAT 05/19/22 | UPDATED: SAT 10/05/22 | REVISED: SAT/BAB 01/05/23 | | | | |
|--------------------------------|-----------|-----------------|-----------|------------------|--------|-----|-------------|------|--|-----------------------------|--------------------------|--------------------------|------------------------------|-------|--------|---------|------------|
| ITEM | ITEM EXT. | TOTAL PER SPLIT | | TOTAL PER BRIDGE | | | GRAND TOTAL | UNIT | DESCRIPTION | LEFT BRIDGE | | | RIGHT BRIDGE | | | GENERAL | SHEET REF. |
| | | 03/IMS/14 | 04/IMS/13 | LEFT | RIGHT | GEN | | | | ABUT. | PIER | SUPER | ABUT. | PIER | SUPER | | |
| 202 | 11203 | | LS | | | LS | LS | | PORTIONS OF STRUCTURE REMOVED, OVER 20 FOOT SPAN, AS PER PLAN | | | | | | LS | 3 | |
| 202 | 22900 | 491 | | 246 | 245 | | 491 | SY | APPROACH SLAB REMOVED | | | 246 | | | 245 | | |
| 503 | 21100 | | 363 | 189 | 174 | | 363 | CY | UNCLASSIFIED EXCAVATION | 140 | 49 | | 123 | 51 | | | |
| 505 | 11100 | | LS | | | | LS | LS | PILE DRIVING EQUIPMENT MOBILIZATION | | | | | | LS | | |
| 507 | 00500 | | 1,140 | 570 | 570 | | 1,140 | FT | 12" CAST-IN-PLACE REINFORCED CONCRETE PILES, DRIVEN | 570 | | | 570 | | | | |
| 507 | 00550 | | 1,260 | 630 | 630 | | 1,260 | FT | 12" CAST-IN-PLACE REINFORCED CONCRETE PILES, FURNISHED | 630 | | | 630 | | | | |
| 507 | 00700 | | 840 | 420 | 420 | | 840 | FT | 16" CAST-IN-PLACE REINFORCED CONCRETE PILES, DRIVEN | | 420 | | | 420 | | | |
| 507 | 00750 | | 920 | 460 | 460 | | 920 | FT | 16" CAST-IN-PLACE REINFORCED CONCRETE PILES, FURNISHED | | 460 | | | 460 | | | |
| 509 | 10001 | | 65,825 | 32,668 | 33,156 | | 65,825 | LB | EPOXY COATED STEEL REINFORCEMENT, AS PER PLAN | 4,428 | 7,968 | 20,272 | 4,459 | 8,197 | 20,500 | 4 | |
| 509 | 20001 | | 600 | 300 | 300 | | 600 | LB | CONCRETE REINFORCEMENT, REPLACEMENT OF EXISTING CONCRETE REINFORCEMENT, AS PER PLAN | | | 300 | | | 300 | 4 | |
| 509 | 30020 | | 5,642 | 2,821 | 2,821 | | 5,642 | FT | NO. 4 DEFORMED GFRP REINFORCEMENT | | | 2,821 | | | 2,821 | | |
| 510 | 10001 | | 44 | 22 | 22 | | 44 | EACH | DOWEL HOLES WITH NONSHRINK, NONMETALLIC GROUT, AS PER PLAN | 22 | | | 22 | | | 4 | |
| 511 | 34446 | | 119 | 59 | 60 | | 119 | CY | CLASS QC2 CONCRETE WITH QC/QA, BRIDGE DECK | | | 59 | | | 60 | | |
| 511 | 34451 | | 58 | 29 | 29 | | 58 | CY | CLASS QC2 CONCRETE WITH QC/QA, BRIDGE DECK (PARAPET), AS PER PLAN | | | 29 | | | 29 | 4 | |
| 511 | 42012 | | 39 | 19 | 20 | | 39 | CY | CLASS QC1 CONCRETE WITH QC/QA, PIER ABOVE FOOTINGS | | 19 | | | 20 | | | |
| 511 | 44112 | | 42 | 21 | 21 | | 42 | CY | CLASS QC1 CONCRETE WITH QC/QA, ABUTMENT NOT INCLUDING FOOTING | 21 | | | 21 | | | | |
| 511 | 46512 | | 82 | 41 | 41 | | 82 | CY | CLASS QC1 CONCRETE WITH QC/QA, FOOTING | 26 | 15 | | 26 | 15 | | | |
| 512 | 33000 | | 30 | 15 | 15 | | 30 | SY | TYPE 2 WATERPROOFING | 15 | | | 15 | | | | |
| SPECIAL | 51275500 | | 567 | 282 | 285 | | 567 | SY | SEALING , SEALING OF CONCRETE SURFACES | 26 | 67 | 189 | 28 | 68 | 189 | | |
| 513 | 10260 | | 83,666 | 41,755 | 41,911 | | 83,666 | LB | STRUCTURAL STEEL MEMBERS, LEVEL 3 | | | 41,755 | | | 41,911 | | |
| 513 | 20000 | | 960 | 480 | 480 | | 960 | EACH | WELDED STUD SHEAR CONNECTORS | | | 480 | | | 480 | | |
| 514 | 00050 | | 1,094 | 547 | 547 | | 1,094 | SF | SURFACE PREPARATION OF EXISTING STRUCTURAL STEEL | | | 547 | | | 547 | | |
| 514 | 00056 | | 1,094 | 547 | 547 | | 1,094 | SF | FIELD PAINTING OF EXISTING STRUCTURAL STEEL, PRIME COAT | | | 547 | | | 547 | | |
| 514 | 00060 | | 5,837 | 2,911 | 2,926 | | 5,837 | SF | FIELD PAINTING STRUCTURAL STEEL, INTERMEDIATE COAT | | | 2,911 | | | 2,926 | | |
| 514 | 00066 | | 5,837 | 2,911 | 2,926 | | 5,837 | SF | FIELD PAINTING STRUCTURAL STEEL, FINISH COAT | | | 2,911 | | | 2,926 | | |
| 514 | 00504 | | 4 | 2 | 2 | | 4 | MNHR | GRINDING FINIS, TEARS, SLIVERS ON EXISTING STRUCTURAL STEEL | | | 2 | | | 2 | | |
| 514 | 10000 | | 6 | 3 | 3 | | 6 | EACH | FINAL INSPECTION REPAIR | | | 3 | | | 3 | | |
| 516 | 10010 | 152 | 68 | 110 | 110 | | 220 | FT | ARMORLESS PREFORMED JOINT SEAL | | | 110 | | | 110 | | |
| 516 | 13600 | | 34 | 17 | 17 | | 34 | SF | 1" PREFORMED EXPANSION JOINT FILLER | 17 | | | 17 | | | | |
| 516 | 13900 | | 192 | 96 | 96 | | 192 | SF | 2" PREFORMED EXPANSION JOINT FILLER | 96 | | | 96 | | | | |
| 516 | 14020 | | 60 | 30 | 30 | | 60 | FT | SEMI-INTEGRAL ABUTMENT EXPANSION JOINT SEAL | 30 | | | 30 | | | | |
| 516 | 44300 | | 8 | 4 | 4 | | 8 | EACH | ELASTOMERIC BEARING WITH INTERNAL LAMINATES AND LOAD PLATE (NEOPRENE) (13"x13"x4.08" BEARING WITH 14"x14" LOAD PLATE AND BEVELED HP10x42 PEDESTAL) | 4 | | | 4 | | | | |
| 516 | 44300 | | 8 | 4 | 4 | | 8 | EACH | ELASTOMERIC BEARING WITH INTERNAL LAMINATES AND LOAD PLATE (NEOPRENE) (15"x18"x4.08" BEARING WITH 16"x19" LOAD PLATE) | | 4 | | | 4 | | | |
| 518 | 12201 | | 4 | 2 | 2 | | 4 | EACH | SCUPPERS, INCLUDING SUPPORTS, AS PER PLAN | | | 2 | | | 2 | 4 | |
| 518 | 21200 | | 45 | 23 | 22 | | 45 | CY | POROUS BACKFILL WITH GEOTEXTILE FABRIC | 23 | | | 22 | | | | |
| 518 | 40000 | | 120 | 60 | 60 | | 120 | FT | 6" PERFORATED CORRUGATED PLASTIC PIPE | 60 | | | 60 | | | | |
| 518 | 40010 | | 100 | 50 | 50 | | 100 | FT | 6" NON-PERFORATED CORRUGATED PLASTIC PIPE, INCLUDING SPECIALS | 50 | | | 50 | | | | |
| 523 | 20001 | | 8 | 4 | 4 | | 8 | EACH | DYNAMIC LOAD TESTING, AS PER PLAN | 2 | 2 | | 2 | 2 | | 4 | |
| 523 | 20501 | | 8 | 4 | 4 | | 8 | EACH | RESTRIKE, AS PER PLAN | 2 | 2 | | 2 | 2 | | 4 | |
| 526 | 25011 | 423 | 182 | 303 | 302 | | 605 | SY | REINFORCED CONCRETE APPROACH SLABS WITH QC/QA (T=15"), AS PER PLAN | | | 303 | | | 302 | 41 | |
| 526 | 90030 | 152 | 68 | 110 | 110 | | 220 | FT | TYPE C INSTALLATION | | | 110 | | | 110 | | |
| 601 | 20000 | | 210 | 103 | 107 | | 210 | SY | CRUSHED AGGREGATE SLOPE PROTECTION | 103 | | | 107 | | | | |
| 625 | 33000 | | 2 | 1 | 1 | | 2 | EACH | STRUCTURE GROUNDING SYSTEM | 1 | | | 1 | | | | |

ESTIMATED QUANTITIES
 BRIDGE NO. SUM-77-3187 L & R
 IR-77 OVER BRUSH RD.

SFN 7704593 (L)

SFN 7704623 (R)

DESIGN AGENCY
GANNETT FLEMING
 2500 Corporate Exchange Dr.
 Suite 230
 Columbus, OH 43231

DESIGNER CHECKER
 RAZ SAT



REVIEWER
 MTO

PROJECT ID
 111405


SUBSET TOTAL
 5 47

SHEET TOTAL
 723 927

MODEL: Sheet PAPER SIZE: 34x22 (in.) DATE: 7/18/2023 TIME: 11:24:39 AM USER: stony
pw:\gnet\pw\benley.com\gnet\pw-01\Documents\Projects\67490\11405\401-Engineering-GF\Structures\3187L-SFN_7704593\Sheets\084 sr202

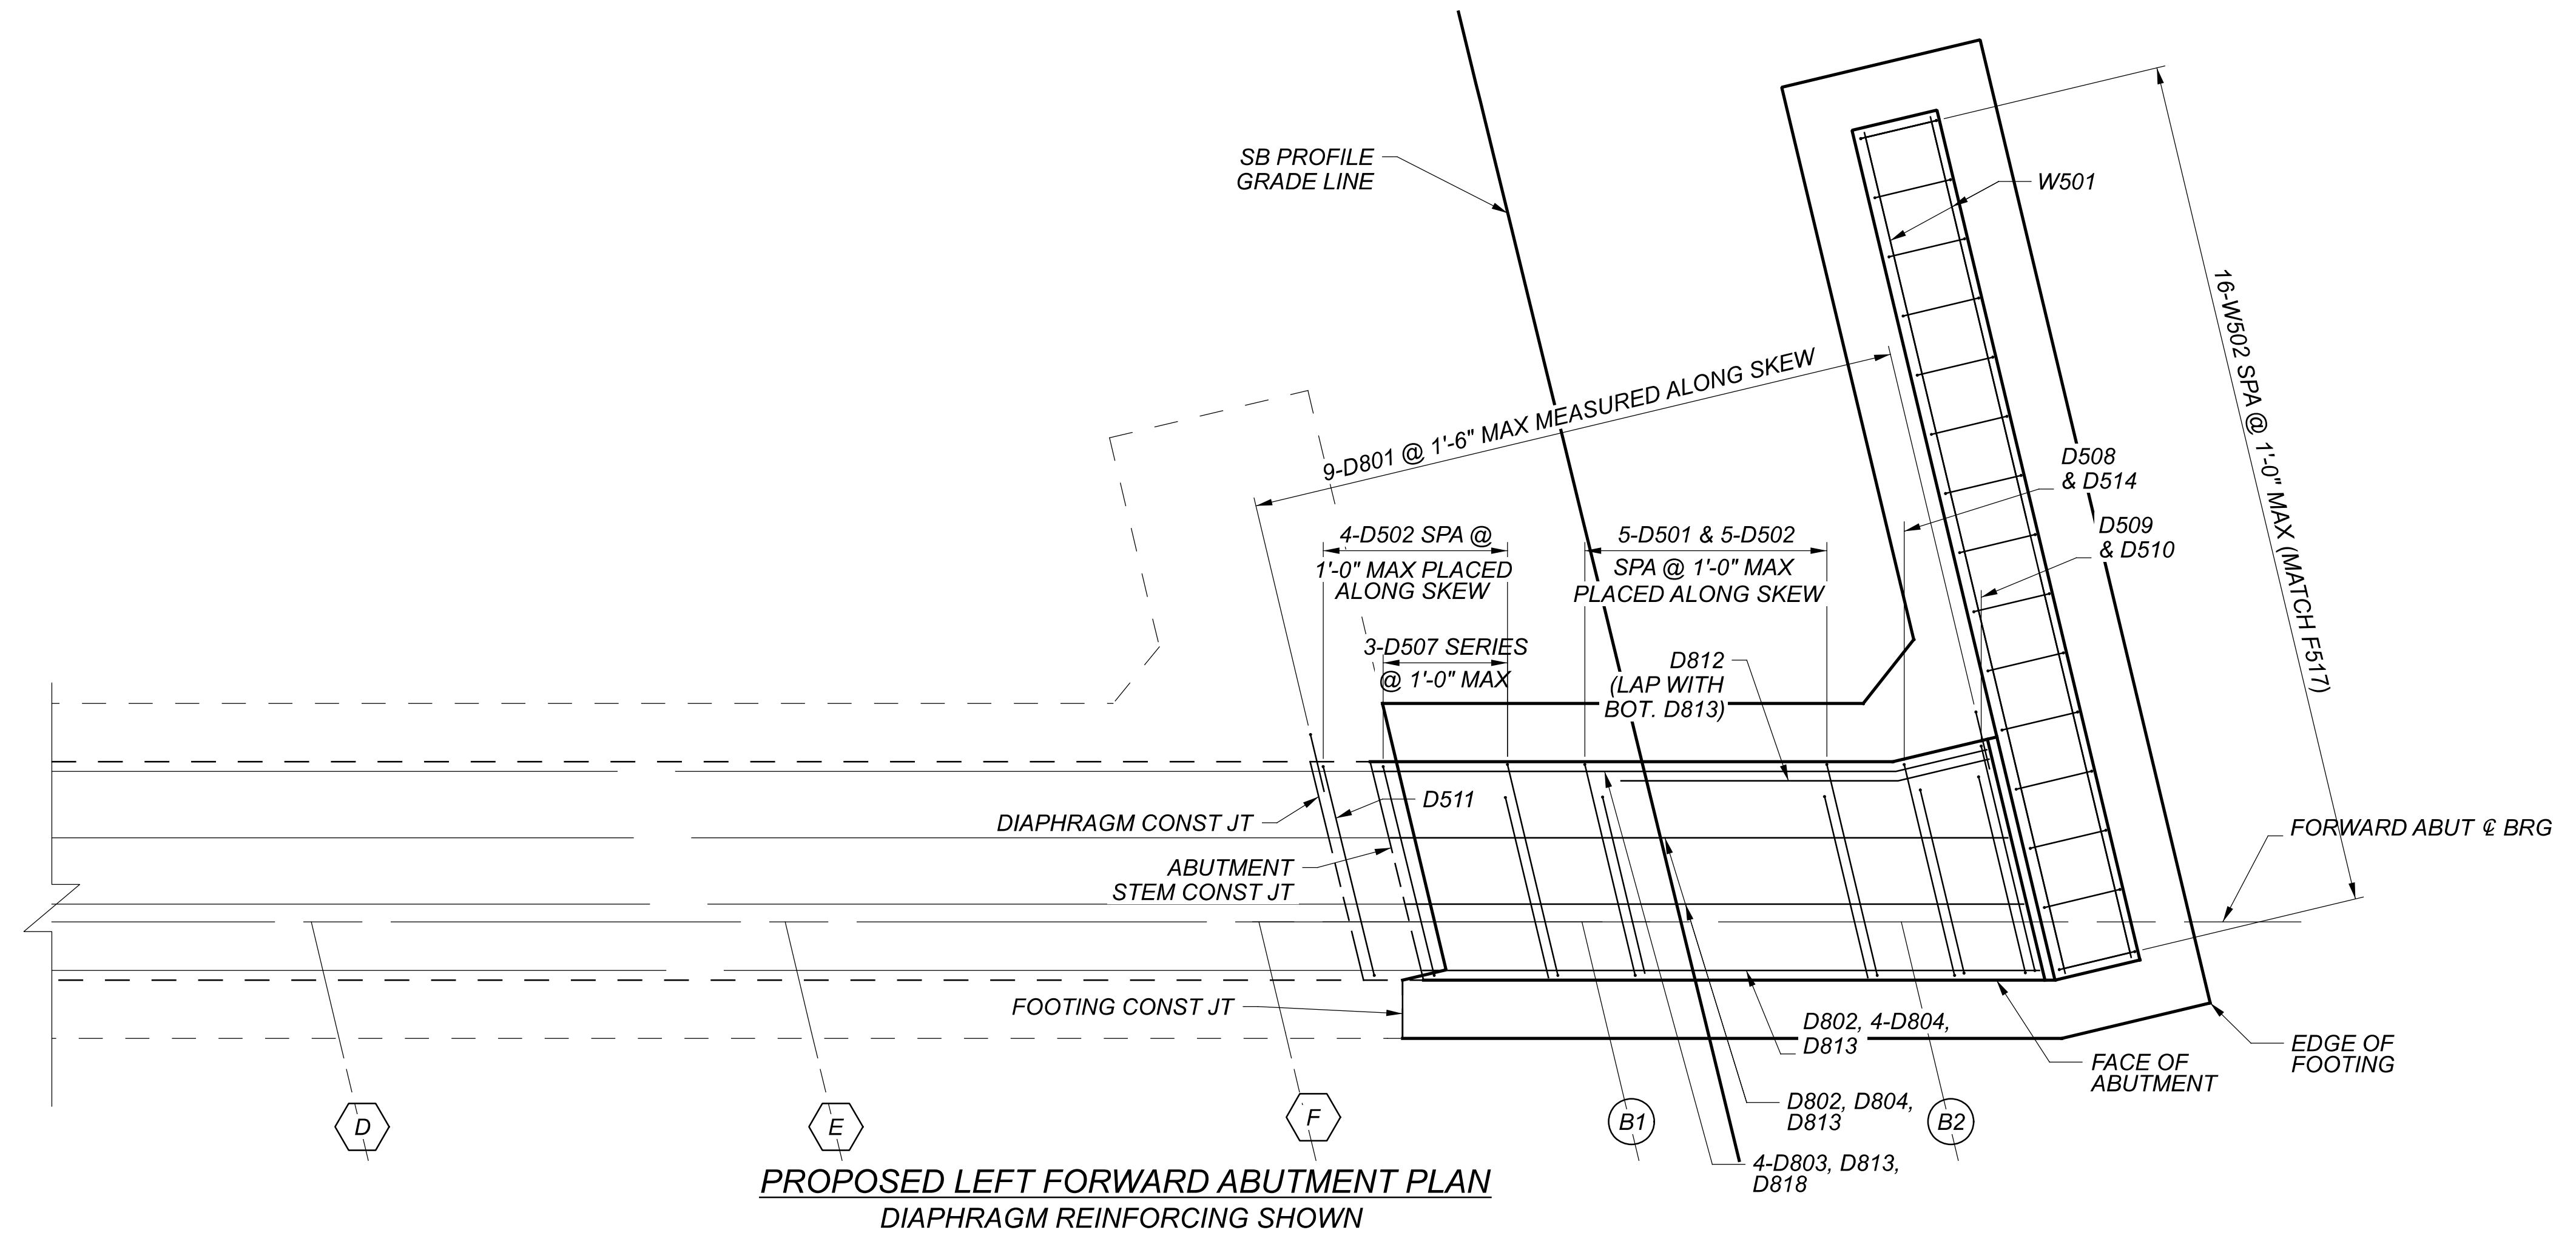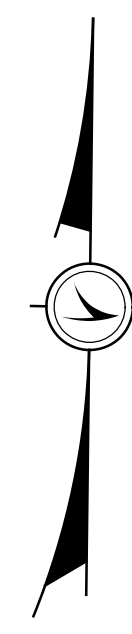

PROPOSED LEFT FORWARD ABUTMENT PLAN
DIAPHRAGM REINFORCING SHOWN

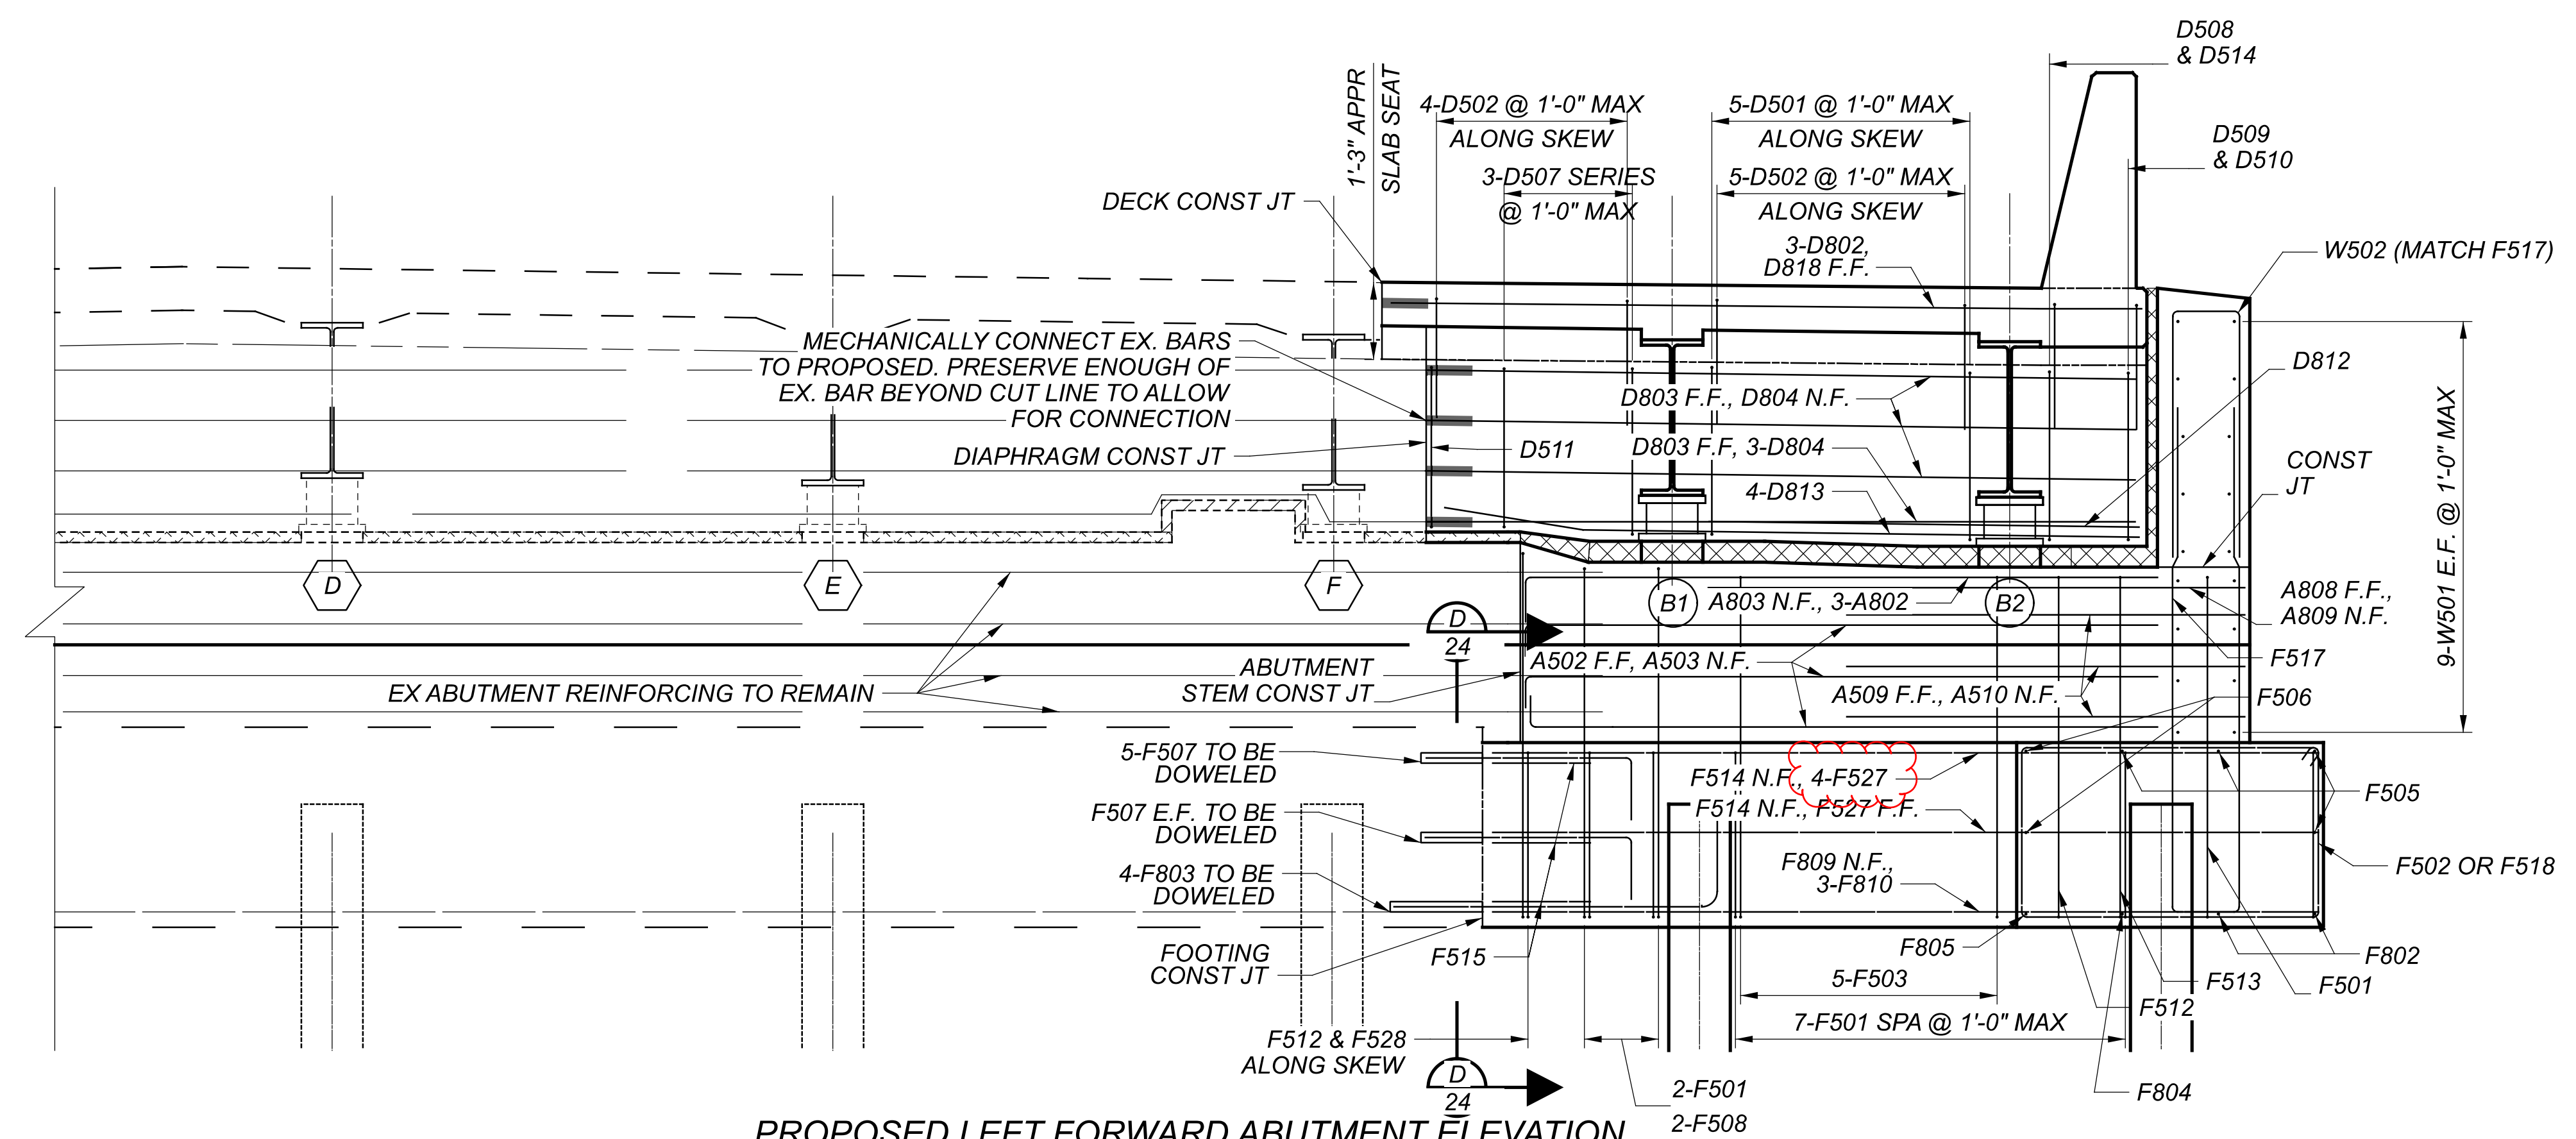


PROPOSED LEFT FORWARD ABUTMENT ELEVATION


- NOTES**
1. SEE SHEET 24/47 FOR ABUTMENT DETAILS AND SECTIONS.
 2. SEE SHEET 9/47 FOR FOUNDATION PLAN.
 3. SEE SHEET 33/47 FOR TRANSVERSE SECTION.
 4. SEE SHEET 4/47 FOR DOWEL HOLE NOTES.
 5. SEE SHEET 42/47 FOR APPROACH SLAB DETAILS.
 6. SEE SHEET 16/47 FOR FOOTING REINFORCING DETAILS.
 7. 2" CLEAR COVER UNLESS NOTED OTHERWISE.

LEFT FORWARD ABUTMENT REINFORCING
BRIDGE NO. SUM-77-3187 L & R
IR-77 OVER BRUSH RD.

| | |
|---------------|--|
| SFN | 7704593 (L) |
| SFN | 7704623 (R) |
| DESIGN AGENCY | GANNETT FLEMING 2500 Corporate Exchange Dr. Suite 230 Columbus, OH 43231 |
| DESIGNER | RSN |
| CHECKER | SAT |
| REVIEWER | MTO |
| PROJECT ID | 111405 |
| SUBSET | 15 |
| TOTAL | 47 |
| SHEET | 733 |
| TOTAL | 927 |

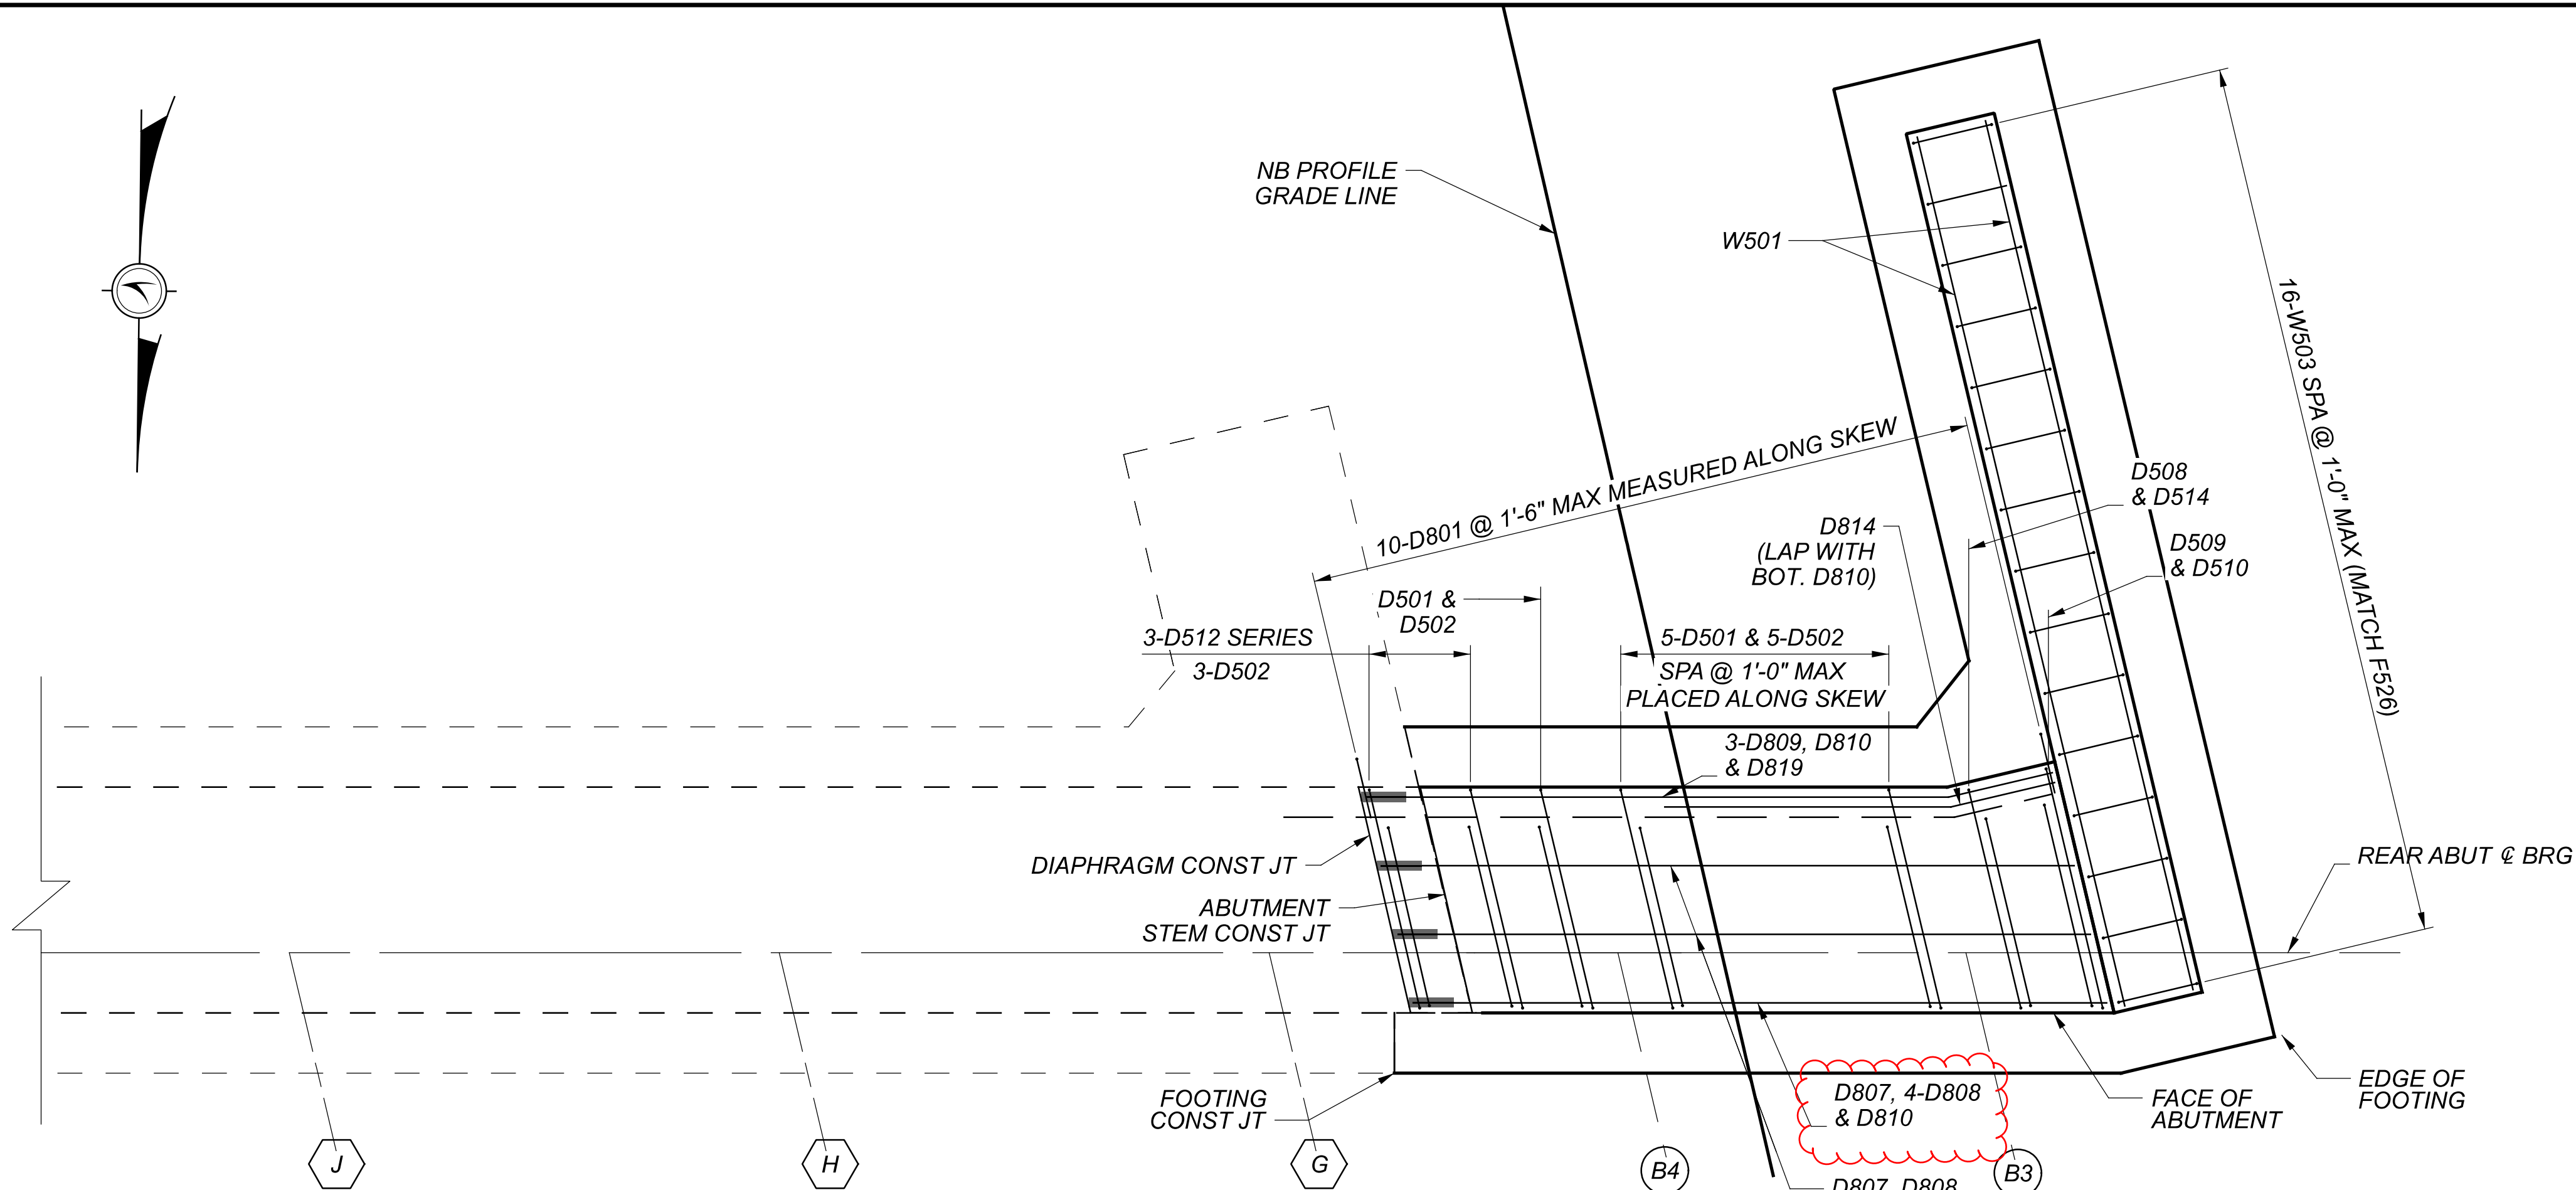

PROPOSED RIGHT REAR ABUTMENT PLAN
DIAPHRAGM REINFORCING SHOWN

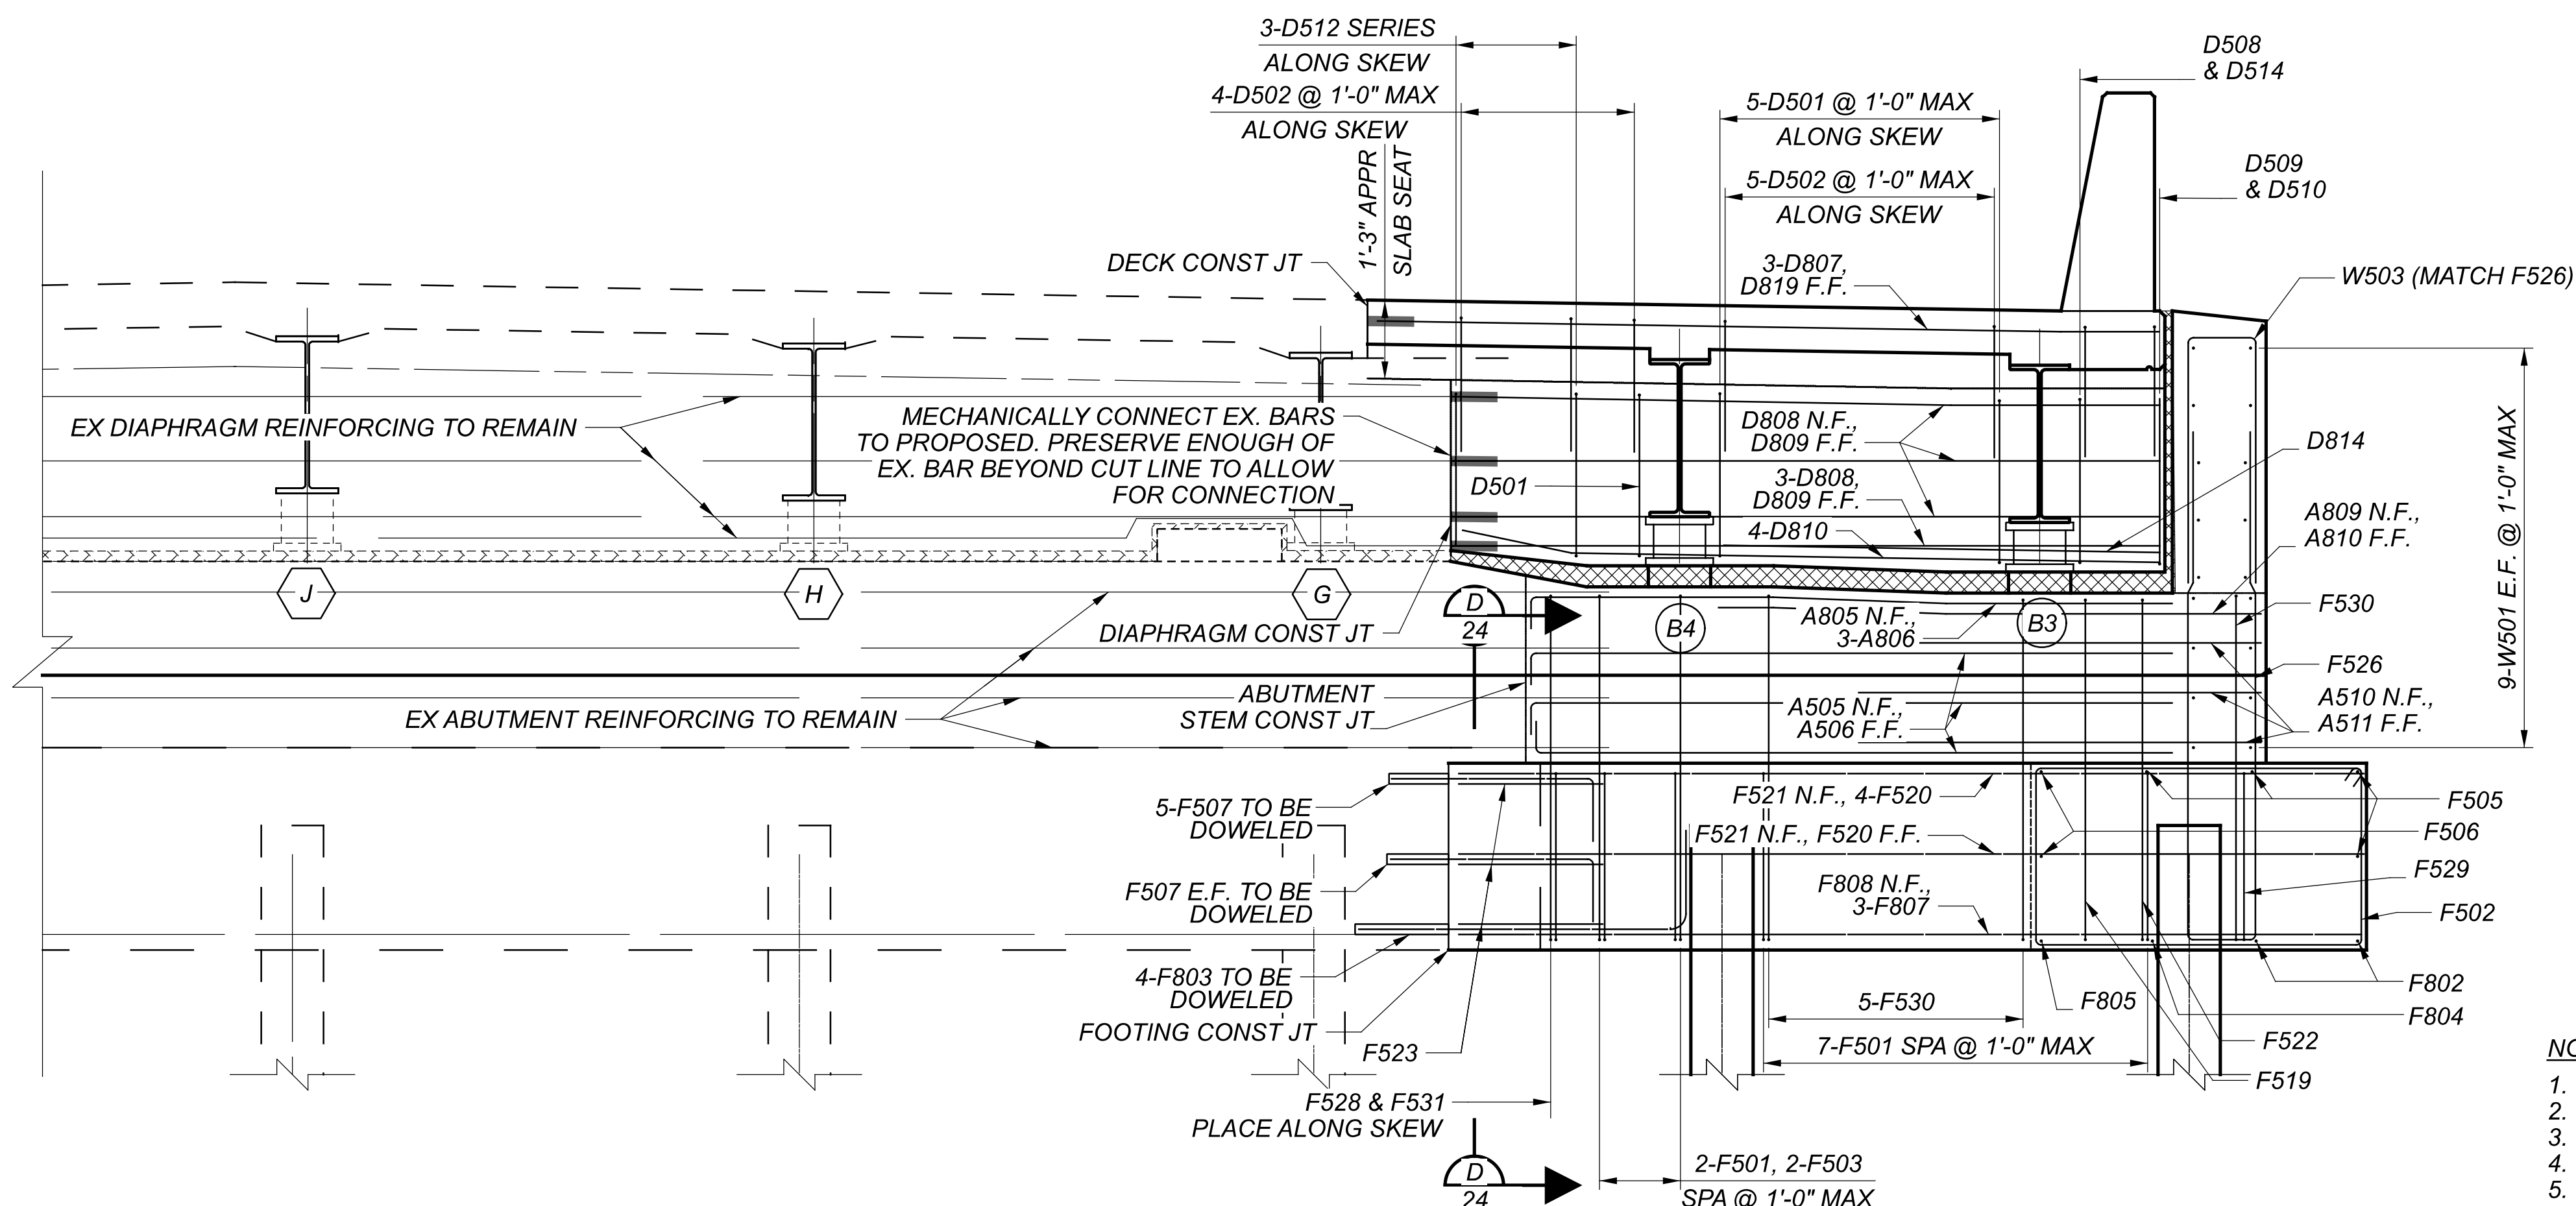

PROPOSED RIGHT REAR ABUTMENT ELEVATION

NOTES

1. SEE SHEET 24/47 FOR ABUTMENT DETAILS AND SECTIONS.
2. SEE SHEET 9/47 FOR FOUNDATION PLAN.
3. SEE SHEET 33/47 FOR TRANSVERSE SECTION.
4. SEE SHEET 4/47 FOR DOWEL HOLE NOTES.
5. SEE SHEET 43/47 FOR APPROACH SLAB DETAILS.
6. SEE SHEET 23/47 FOR FOOTING REINFORCING DETAILS.
7. 2" CLEAR COVER UNLESS NOTED OTHERWISE.

RIGHT REAR ABUTMENT REINFORCING
BRIDGE NO. SUM-77-3187 L & R
IR-77 OVER BRUSH RD.

SFN 7704593 (L)

SFN 7704623 (R)

DESIGN AGENCY
GANNETT FLEMING
2500 Corporate Exchange Dr.
Suite 230
Columbus, OH 43231

DESIGNER CHECKER
RSN SAT

REVIEWER
MTO

PROJECT ID
111405

SUBSET TOTAL
19 47

SHEET TOTAL
737 927

PENTABLE: 111405_OHDOT_Pent.tbl


PLOT DRIVER: OHDOT_PDF.plt

SUBMITTAL: Tracings


PENTABLE SUBSET: 2

SUM-77-28.75

MODEL: Sheet PAPER: 34x22 (in.) DATE: 7/18/2023 TIME: 11:59:35 AM USER: stony
pw:\gnet-pw\entley.com\gnet-pw-01\Documents\Projects\7490\11405401-Engineering-GF\Structures\3187L-SFN_7704593\Sheets\205 sa001

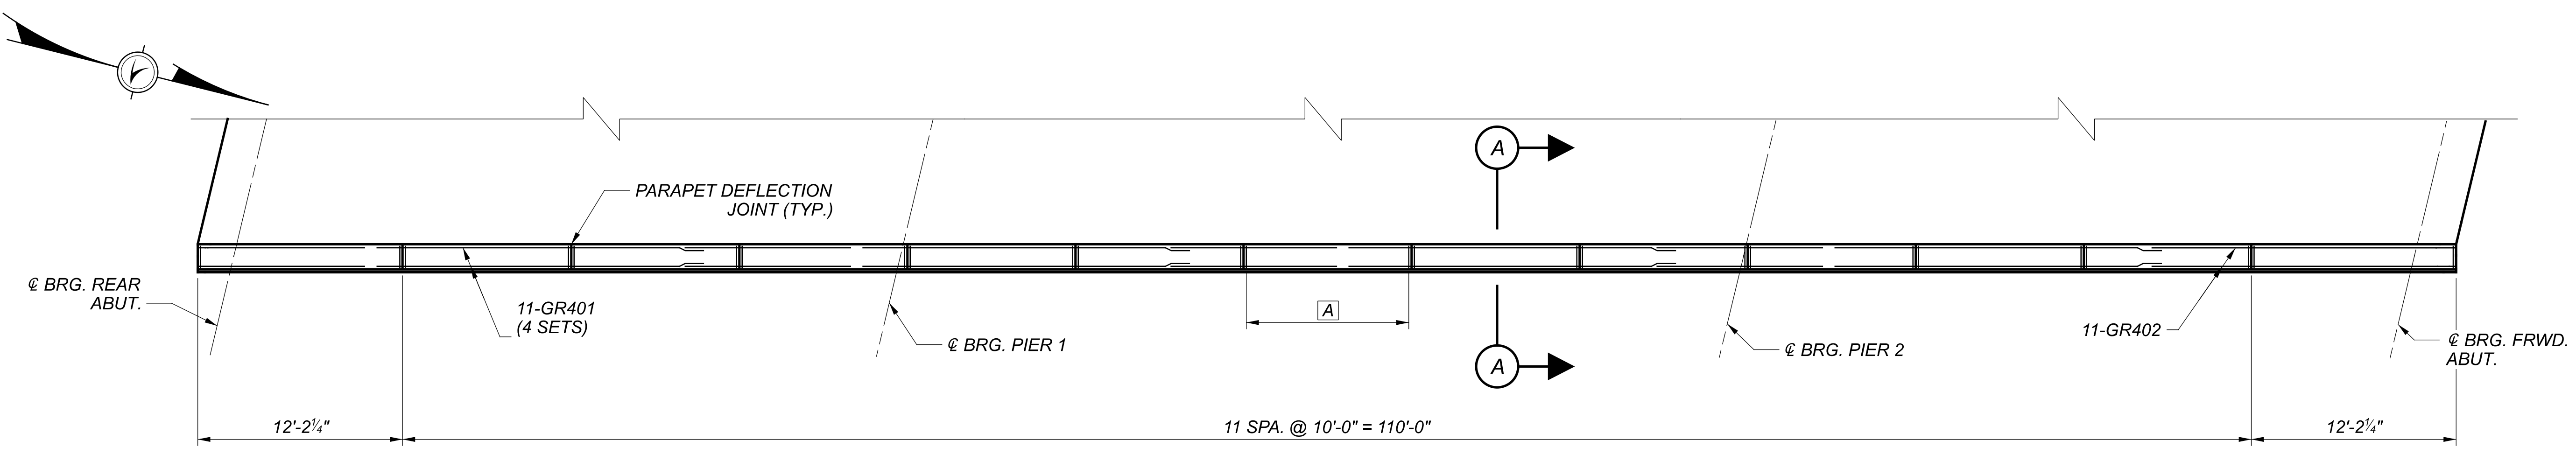


LEFT BRIDGE PARAPET PLAN

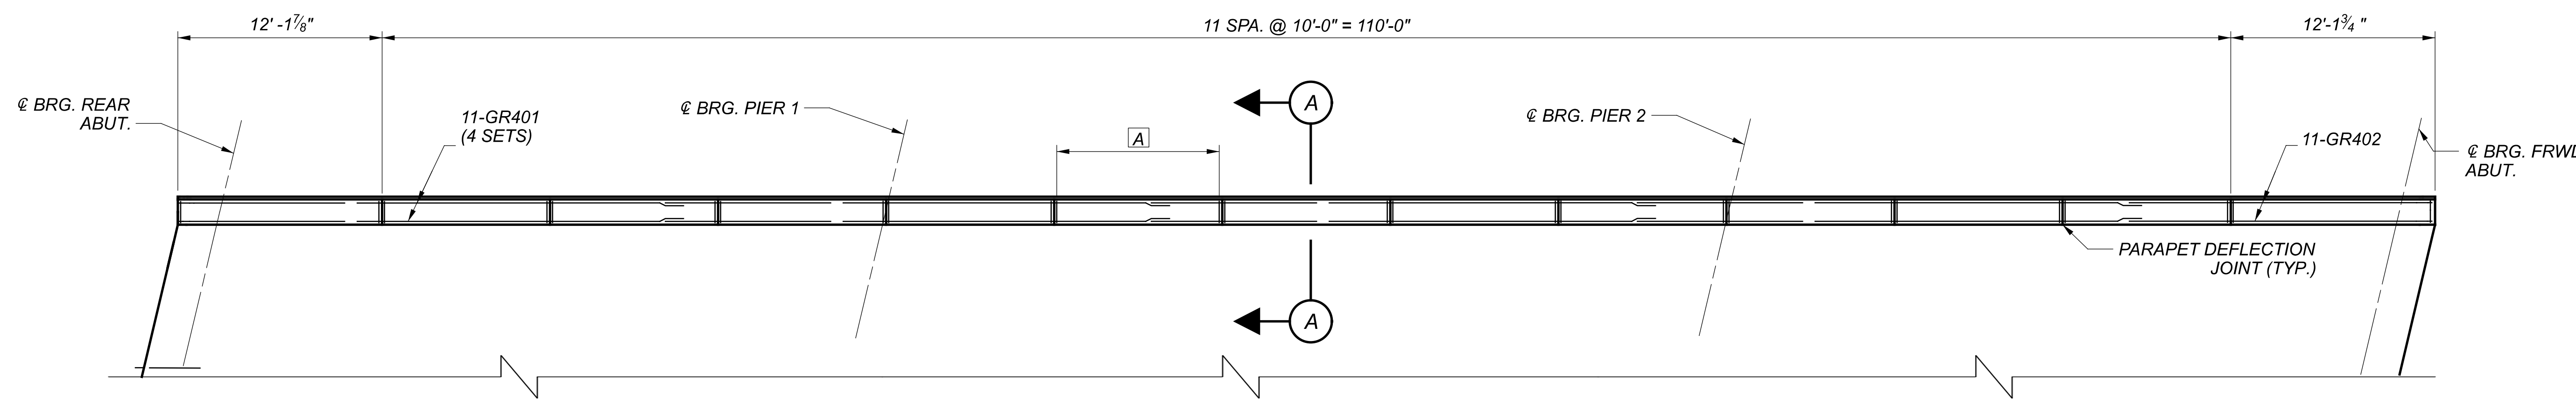


RIGHT BRIDGE PARAPET PLAN

LEGEND
 [A] - 11-R601, 11-R602 @ 10 EQ. SPA. (1'-0" MAX.)
 & 4-GR403 (TYP. FOR 10'-0" PANELS)

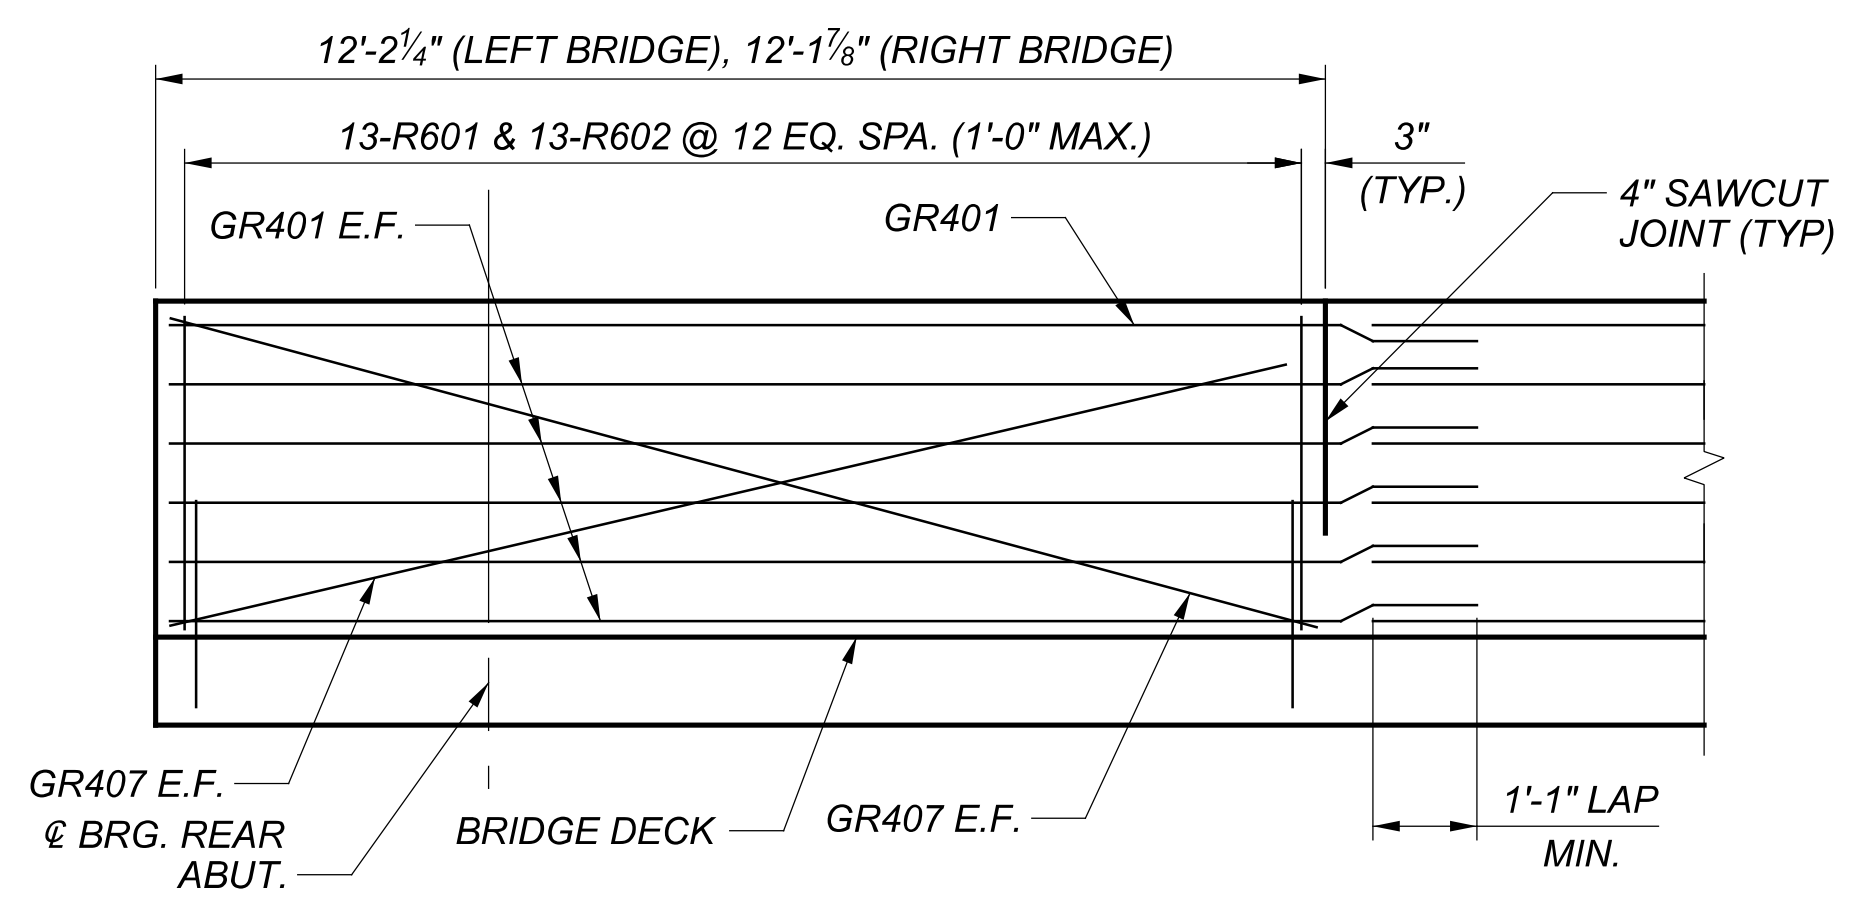

END PARAPET ELEVATION
REAR END PANEL SHOWN, FORWARD PANEL SIMILAR

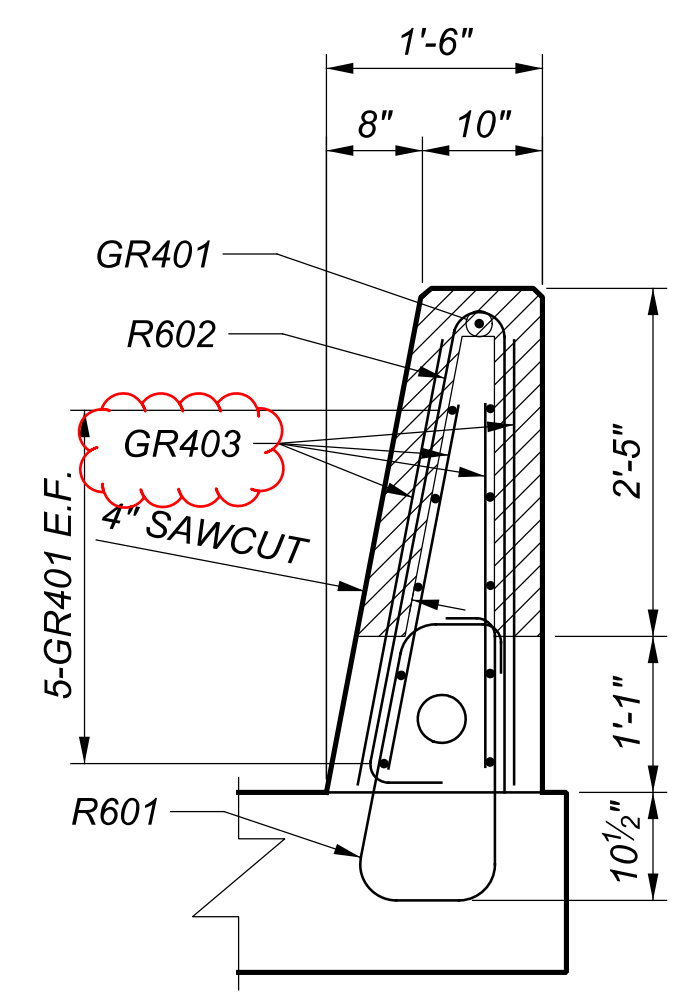

SECTION A
PARAPET REINFORCING

NOTES:
 1. FOR ADDITIONAL PARAPET DETAILS, REFER TO STANDARD BRIDGE DRAWING SBR-1-20.

PARAPET DETAILS
 BRIDGE NO. SUM-77-3187 L & R
 IR-77 OVER BRUSH RD.

| | |
|------------|-------------|
| SFN | 7704593 (L) |
| SFN | 7704623 (R) |
| DESIGNER | SAT |
| CHECKER | RSN |
| REVIEWER | MTO |
| PROJECT ID | 111405 |
| SUBSET | TOTAL |
| 39 | 47 |
| SHEET | TOTAL |
| 757 | 927 |

PENTABLE: 111405_OHDOT_Pen.tbl

PLOT DRIVER: OHDOT_PDF.plt


SUBMITTAL: Tracings

PENTABLE SUBSET: 2

SUM-77-28.75

MODEL: Sheet PAPER SIZE: 34x22 (in.) DATE: 7/18/2023 TIME: 2:21:33 PM USER: stony
pw:\gmet-pw\benley.com\gmet-pw-01\Documents\Projects\67490\11405\401-Engineering-GF\Structures\31871-SFN_7704593\Sheets\232 sl002

| Mark | NUMBER | | | LENGTH | WEIGHT | | | TYPE | DIMENSIONS | | | | |
|-------------|--------|-------|-------|---------|--------|--------|--------|------|------------|-------|-------|-------|-------|
| | LEFT | RIGHT | TOTAL | | LEFT | RIGHT | TOTAL | | A | B | C | D | E |
| DECK | | | | | | | | | | | | | |
| S401 | 52 | 52 | 104 | 30'-0" | 1,042 | 1,042 | 2,084 | STR. | | | | | |
| S402 | 13 | 13 | 26 | 22'-0" | 192 | 192 | 384 | STR. | | | | | |
| S403 | 48 | 48 | 96 | 27'-0" | 866 | 866 | 1,732 | STR. | | | | | |
| S501 | 64 | 64 | 128 | 30'-0" | 2,003 | 2,003 | 4,006 | STR. | | | | | |
| S502 | 16 | 16 | 32 | 24'-0" | 401 | 401 | 802 | STR. | | | | | |
| # S503 | 294 | | 294 | 12'-10" | 3,936 | | 3,936 | 16 | 12'-2" | | | | |
| # S504 | 294 | | 294 | 12'-2" | 3,731 | | 3,731 | STR. | | | | | |
| S505 | 294 | 294 | 588 | 7'-1" | 2,172 | 2,172 | 4,344 | 16 | 6'-6" | | | | |
| # S506 | | 294 | 294 | 13'-1" | | 4,012 | 4,012 | 16 | 12'-6" | | | | |
| # S507 | | 294 | 294 | 12'-6" | | 3,834 | 3,834 | STR. | | | | | |
| S510 | 8 | 8 | 16 | 4'-6" | 38 | 38 | 76 | 20 | 1'-0" | 1'-0" | 1'-8" | 1'-0" | 1'-0" |
| SUB-TOTAL | | | | | 14,381 | 14,560 | 28,941 | | | | | | |

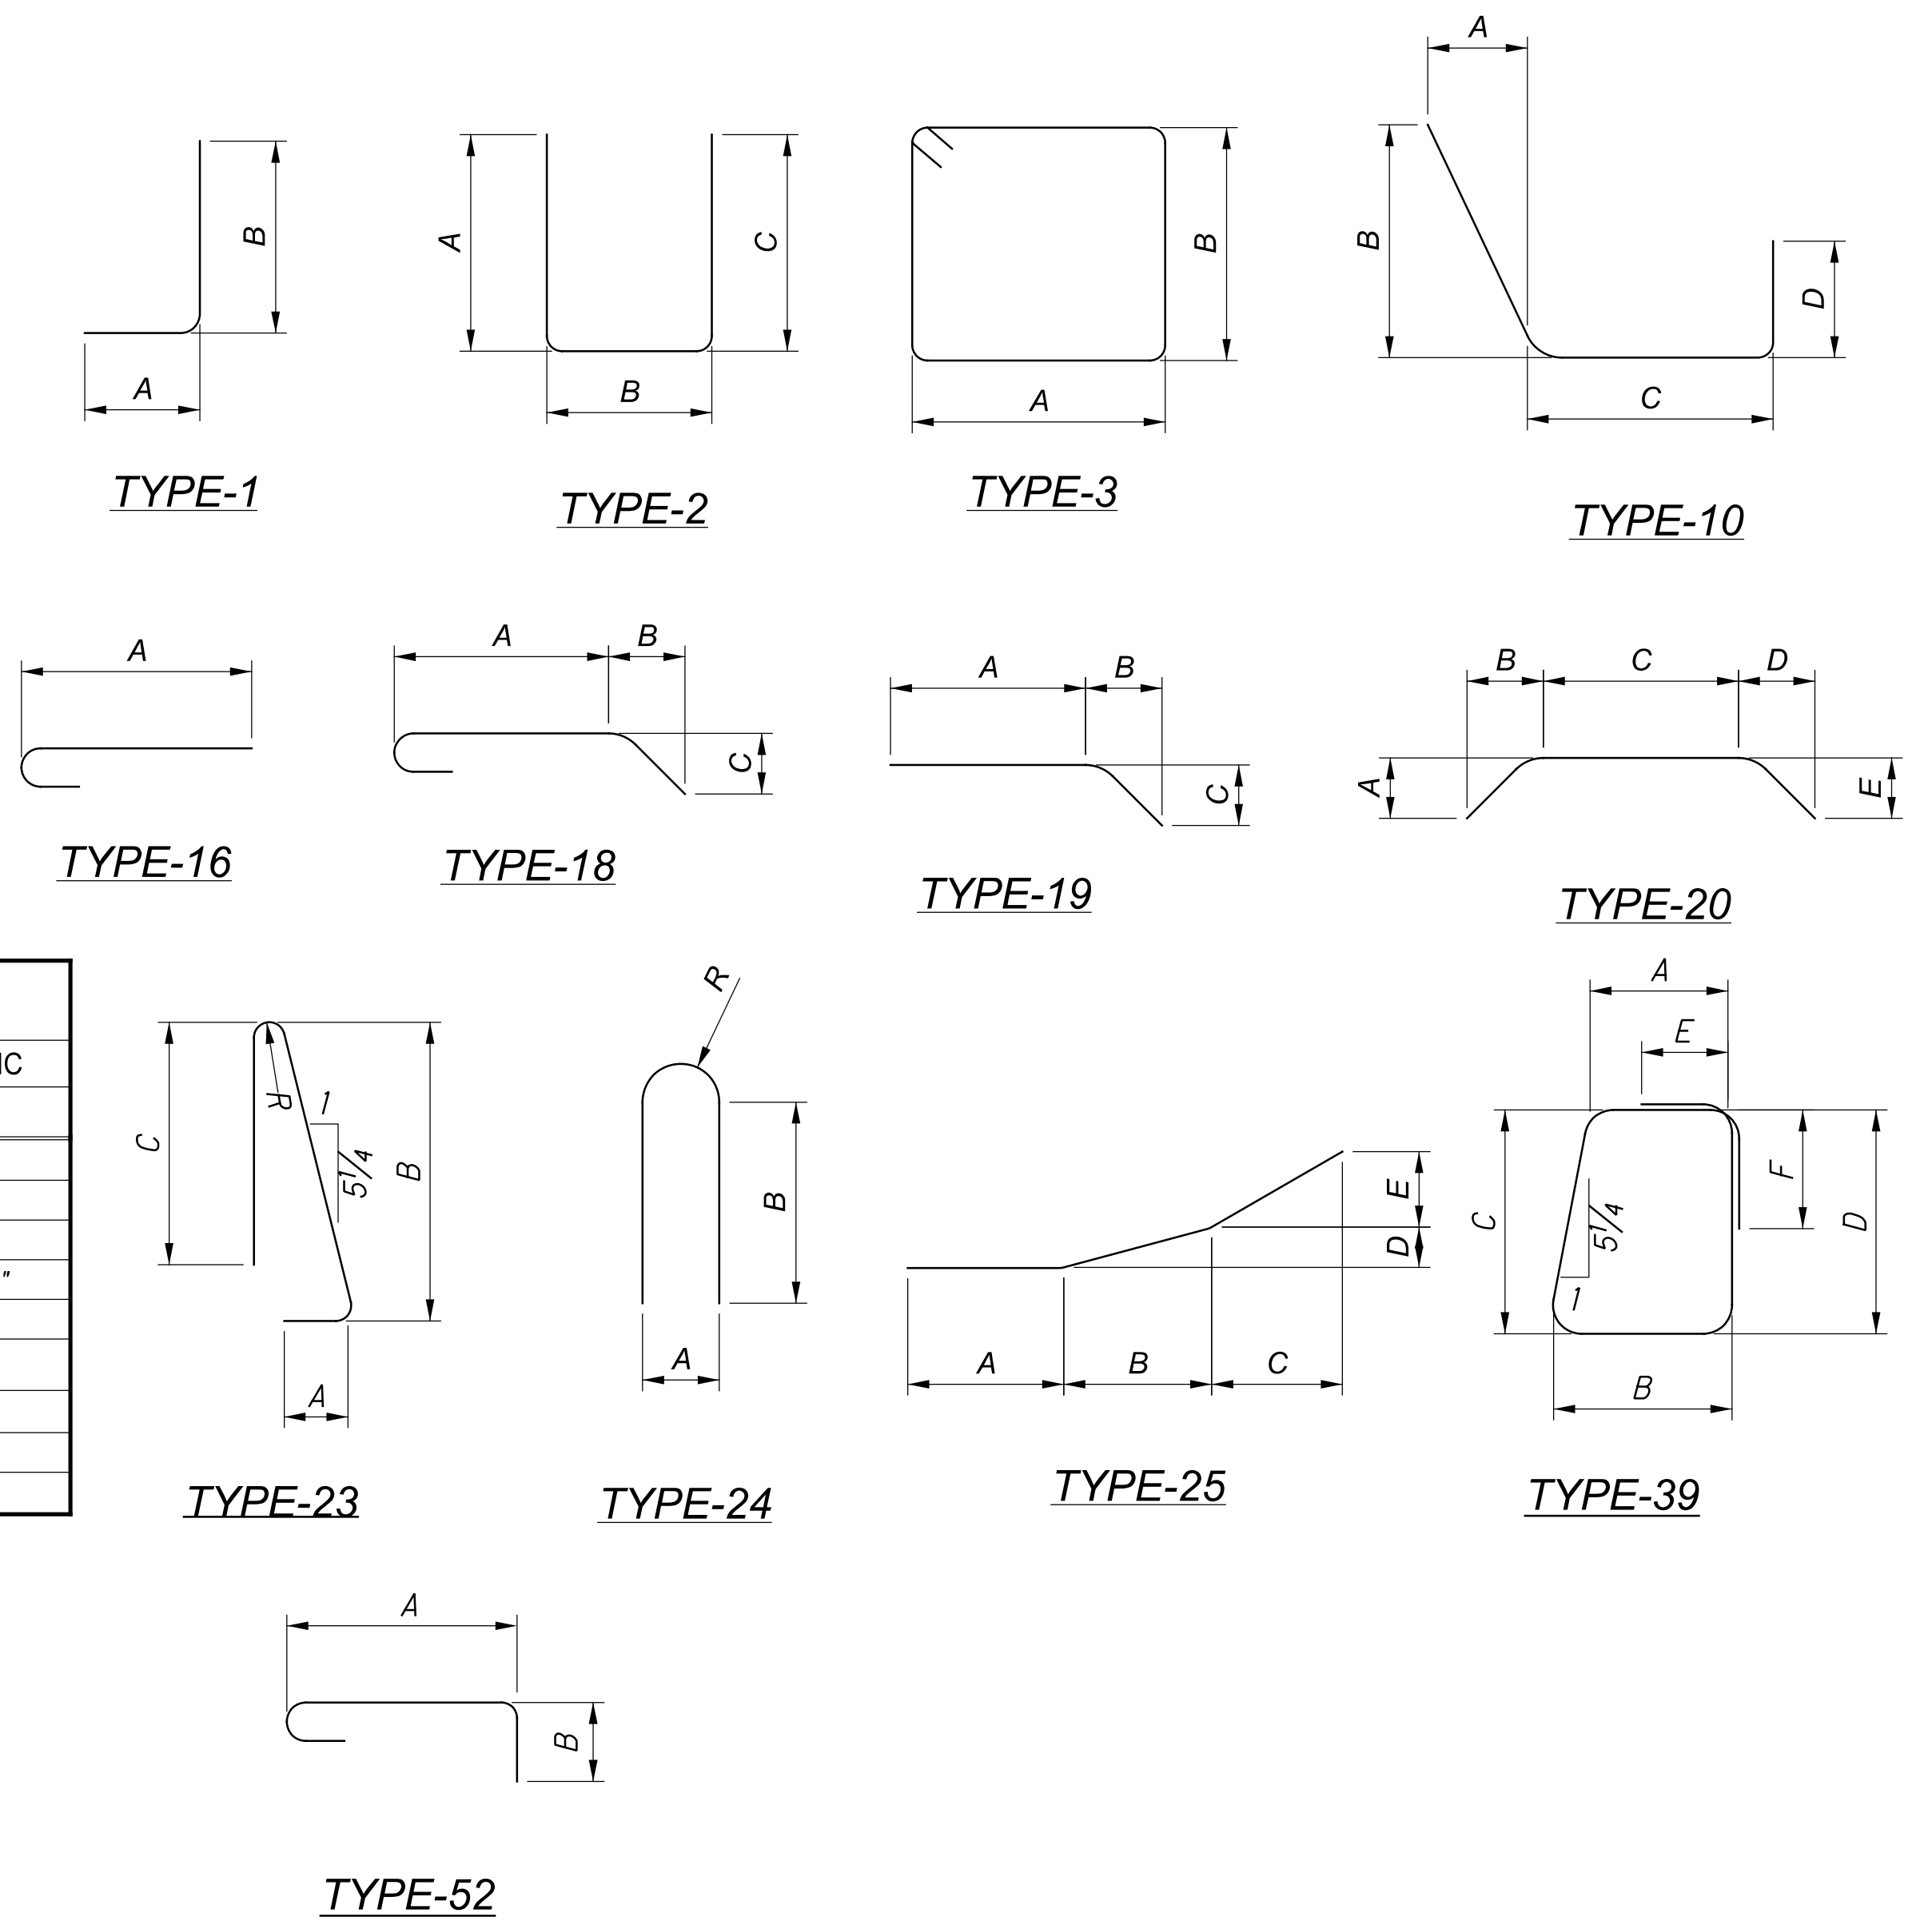

REINFORCING BEND DIAGRAMS

| Mark | NUMBER | | | | | LENGTH | WEIGHT | | | TYPE | DIMENSIONS | | | | | | | | |
|-----------------------|-----------|-----------|------------|-----------|-----------|--------|--------|--------|--------|------|------------|----------|-------|-------|----|-----|----|-----|--|
| | LEFT REAR | LEFT FWD | RIGHT REAR | RIGHT FWD | TOTAL | | LEFT | RIGHT | TOTAL | | A | B | C | D | E | F | R | INC | |
| PARAPET | | | | | | | | | | | | | | | | | | | |
| R601 | 147 | | 147 | | 294 | 7'-5" | 1,638 | 1,638 | 3,276 | 39 | 9 1/2" | 1'-3" | 2'-4" | 2'-4" | 7" | 12" | | | |
| R602 | 147 | | 147 | | 294 | 7'-1" | 1,564 | 1,564 | 3,128 | 23 | 6" | 3'-3" | 3'-3" | | | | 2" | | |
| | 4 | 4 | 4 | 4 | 16 | 4'-4" | | | | | | 3'-6" | | | | | | | |
| R603 | SER OF 11 | SER OF 11 | SER OF 11 | SER OF 11 | SER OF 11 | 5'-3" | 634 | 634 | 1,268 | 1 | 1'-0" | to 4'-4" | | | | | | 1" | |
| R604 | 16 | 16 | 16 | 16 | 64 | 4'-4" | 208 | 208 | 416 | 1 | 1'-0" | 3'-6" | | | | | | | |
| SUB-TOTAL | | | | | | | 4,044 | 4,044 | 8,088 | | | | | | | | | | |
| TOTAL ALL REINFORCING | | | | | | | 32,668 | 33,156 | 65,825 | | | | | | | | | | |

| Mark | NUMBER | | | | | LENGTH | TOTAL LENGTH (FEET) | | | TYPE | DIMENSIONS | | | | |
|---------------------|-----------|----------|------------|-----------|-------|--------|---------------------|-------|-------|------|------------|-------|-------|--------|----|
| | LEFT REAR | LEFT FWD | RIGHT REAR | RIGHT FWD | TOTAL | | LEFT | RIGHT | TOTAL | | A | B | C | D | E |
| PARAPET GFRP | | | | | | | | | | | | | | | |
| GR401 | 44 | | 44 | | 88 | 30.00' | 1,320 | 1,320 | 2,640 | STR. | | | | | |
| GR402 | 11 | | 11 | | 22 | 19.00' | 209 | 209 | 418 | STR. | | | | | |
| GR403 | 44 | | 44 | | 88 | 10.00' | 440 | 440 | 880 | STR. | | | | | |
| GR404 | 24 | 24 | 24 | 24 | 96 | 10.00' | 480 | 480 | 960 | STR. | | | | | |
| GR405 | 12 | 12 | 12 | 12 | 48 | 5.08' | 122 | 122 | 244 | STR. | | | | | |
| GR406 | 12 | 12 | 12 | 12 | 48 | 6.42' | 154 | 154 | 308 | 25 | 2'-6" | 2'-5" | 1'-5" | 1 1/2" | 5" |
| GR407 | 8 | | 8 | | 16 | 12.00' | 96 | 96 | 192 | STR. | | | | | |
| SUB-TOTAL | | | | | | | 2,821 | 2,821 | 5,642 | | | | | | |

= ALL OR A PORTION OF BARS PROVIDED WITH MECHANICAL CONNECTOR

MINIMUM LAP SPLICE LENGTHS

- #4 BAR (STEEL) = 2'-0"
- #4 BAR (GFRP) = 1'-1"
- #5 BAR (ALL) = 2'-6"
- #6 BAR (ALL) = 3'-0"
- #8 BAR (ALL) = 4'-9"
- #9 BAR (ALL) = 5'-10"

REINFORCING NOTES

1. THE BAR SIZE NUMBER IS SPECIFIED ON THE PLANS IN THE BAR MARK COLUMN. THE FIRST DIGIT WHERE THREE DIGITS ARE USED, AND THE FIRST TWO DIGITS WHEN FOUR ARE USED, INDICATES THE BAR SIZE NUMBER. FOR EXAMPLE, A501 IS A NO. 5 BAR. BAR DIMENSIONS SHOWN ARE OUT TO OUT UNLESS OTHERWISE NOTED. 'R' INDICATES INSIDE RADIUS, UNLESS OTHERWISE NOTED.
2. ALL REINFORCEMENT BARS SHALL BE EPOXY COATED. PAYMENT FOR REINFORCING, INCLUDING MECHANICAL CONNECTORS, SHALL BE MADE WITH ITEM 509 - EPOXY COATED REINFORCING STEEL.
3. "STR." IN THE TYPE COLUMN INDICATES STRAIGHT BARS.
4. "SER OF" DENOTES SERIES OF BARS, E.G "X" SER OF "Y" = "X" SERIES OF "Y" BARS/SERIES.
5. REFER TO C.M.S SECTION 509.05 FOR STANDARD BEND DIMENSIONS.
6. MECHANICAL CONNECTORS: AN APPROVED TYPE OF MECHANICAL CONNECTOR FOR REINFORCING BARS SHALL BE PROVIDED IN ACCORDANCE WITH C.M.S. SECTION 509.07. INSTALLATION OF CONNECTORS SHALL CONFORM WITH MANUFACTURER RECOMMENDED PROCEDURES.

CONNECTORS AND DOWEL BARS USED WITH EPOXY COATED BARS SHALL BE EPOXY COATED. COATING FOR BOTH CONNECTORS AND BARS SHALL CONFORM TO THE SAME SPECIFICATIONS. COATINGS THAT HAVE BEEN DAMAGED OR THAT OTHERWISE DO NOT MEET SPECIFICATIONS WITH RESPECT TO COLOR, CONTINUITY AND UNIFORMITY, MAY BE REPAIRED AS DIRECTED BY THE ENGINEER, OR THEY SHALL BE REPLACED WITH MATERIAL WITH MEETS THE SPECIFICATIONS. FOR BARS UTILIZING A MECHANICAL CONNECTOR, THE BAR LENGTH FOR PAYMENT IS MEASURED TO THE CENTER OF THE PLANNED MECHANICAL CONNECTION. EXTRA BAR LENGTH AND/OR BAR END PREPARATION MAY BE NECESSARY DEPENDING UPON THE TYPE OF MECHANICAL CONNECTOR FURNISHED AND THOSE COSTS SHALL BE INCLUDED IN THE BID PRICE FOR ITEM 509. CONNECTORS AND DOWEL BAR EXTENSIONS SHALL CONFORM TO AND BE INCLUDED IN THE BID PRICE FOR ITEM 509.

REINFORCING STEEL LIST 2 OF 2
 BRIDGE NO. SUM-77-3187 L & R
 IR-77 OVER BRUSH RD.


| | |
|---------------|------------------------|
| SFN | 7704593 (L) |
| SFN | 7704623 (R) |
| DESIGN AGENCY | GANNETT FLEMING |
| DESIGNER | SAT |
| CHECKER | SLN |
| REVIEWER | MTO |
| PROJECT ID | 111405 |
| SUBSET | 47 |
| TOTAL | 47 |
| SHEET | 765 |
| TOTAL | 927 |

| BEAM CAMBER AND DEFLECTIONS | | | | | | | | | | |
|-----------------------------|-----------------------------------|---|---------------------------------------|--|--------------|-----------------------------------|---|---------------------------------------|--|--------------|
| POINT | BEAM NO. 1 | | | | | BEAM NO. 2 | | | | |
| | DEFLECTION DUE TO WEIGHT OF STEEL | DEFLECTION DUE TO NON-COMPOSITE DEAD LOAD | DEFLECTION DUE TO COMPOSITE DEAD LOAD | ADJUSTMENT REQUIRED FOR VERTICAL CURVE | TOTAL CAMBER | DEFLECTION DUE TO WEIGHT OF STEEL | DEFLECTION DUE TO NON-COMPOSITE DEAD LOAD | DEFLECTION DUE TO COMPOSITE DEAD LOAD | ADJUSTMENT REQUIRED FOR VERTICAL CURVE | TOTAL CAMBER |
| REAR ABUTMENT | 0.00" | 0.00" | 0.00" | 0.00" | 0.00" | 0.00" | 0.00" | 0.00" | 0.00" | 0.00" |
| SPAN 1 | 0.25 L | 0.02" | 0.13" | 0.02" | -0.10" | 0.07" | 0.02" | 0.11" | 0.02" | 0.04" |
| | 0.50 L | 0.03" | 0.15" | 0.02" | -0.14" | 0.06" | 0.03" | 0.13" | 0.02" | -0.14" |
| | 0.75 L | 0.01" | 0.07" | 0.01" | -0.11" | -0.01" | 0.01" | 0.06" | 0.01" | -0.10" |
| PIER NO. 1 | 0.00" | 0.00" | 0.00" | 0.00" | 0.00" | 0.00" | 0.00" | 0.00" | 0.00" | 0.00" |
| SPAN 2 | SPLICE #1 | 0.01" | 0.03" | 0.01" | -0.09" | -0.05" | 0.01" | 0.02" | 0.01" | -0.09" |
| | 0.25 L | 0.02" | 0.12" | 0.02" | -0.16" | -0.01" | 0.02" | 0.09" | 0.02" | -0.16" |
| | 0.50 L | 0.04" | 0.20" | 0.03" | -0.22" | 0.05" | 0.04" | 0.17" | 0.03" | -0.22" |
| | 0.75 L | 0.02" | 0.12" | 0.02" | -0.17" | -0.01" | 0.02" | 0.09" | 0.02" | -0.16" |
| | SPLICE #2 | 0.01" | 0.03" | 0.01" | -0.09" | -0.05" | 0.01" | 0.02" | 0.01" | -0.09" |
| PIER NO. 2 | 0.00" | 0.00" | 0.00" | 0.00" | 0.00" | 0.00" | 0.00" | 0.00" | 0.00" | 0.00" |
| SPAN 3 | 0.25 L | 0.01" | 0.07" | 0.01" | -0.08" | 0.01" | 0.01" | 0.06" | 0.01" | -0.11" |
| | 0.50 L | 0.03" | 0.15" | 0.02" | -0.09" | 0.11" | 0.03" | 0.13" | 0.02" | -0.14" |
| | 0.75 L | 0.03" | 0.13" | 0.02" | -0.03" | 0.14" | 0.02" | 0.11" | 0.02" | -0.11" |
| FORWARD ABUTMENT | 0.00" | 0.00" | 0.00" | 0.00" | 0.00" | 0.00" | 0.00" | 0.00" | 0.00" | 0.00" |

| CAMBER BLOCKING DIAGRAM TABLE * | | | | | |
|---------------------------------|-----------|--------|--------|--------|-------------|
| BEAM NUMBER | DIMENSION | | | | CHORD SLOPE |
| | A | B | C | D | |
| BEAM NO. 1 | 0.00" | 14.04" | 24.60" | 27.24" | 1.458% |
| BEAM NO. 2 | 0.00" | 14.04" | 24.36" | 26.64" | 1.426% |

* BLOCKING DIMENSIONS ARE FROM THE LEVEL BASELINE BETWEEN ABUTMENT BEARINGS TO THE BOTTOM OF THE BOTTOM FLANGE.

NOTE:
 1. CAMBER IS MEASURED ALONG BOTTOM OF THE BEAM WEB.

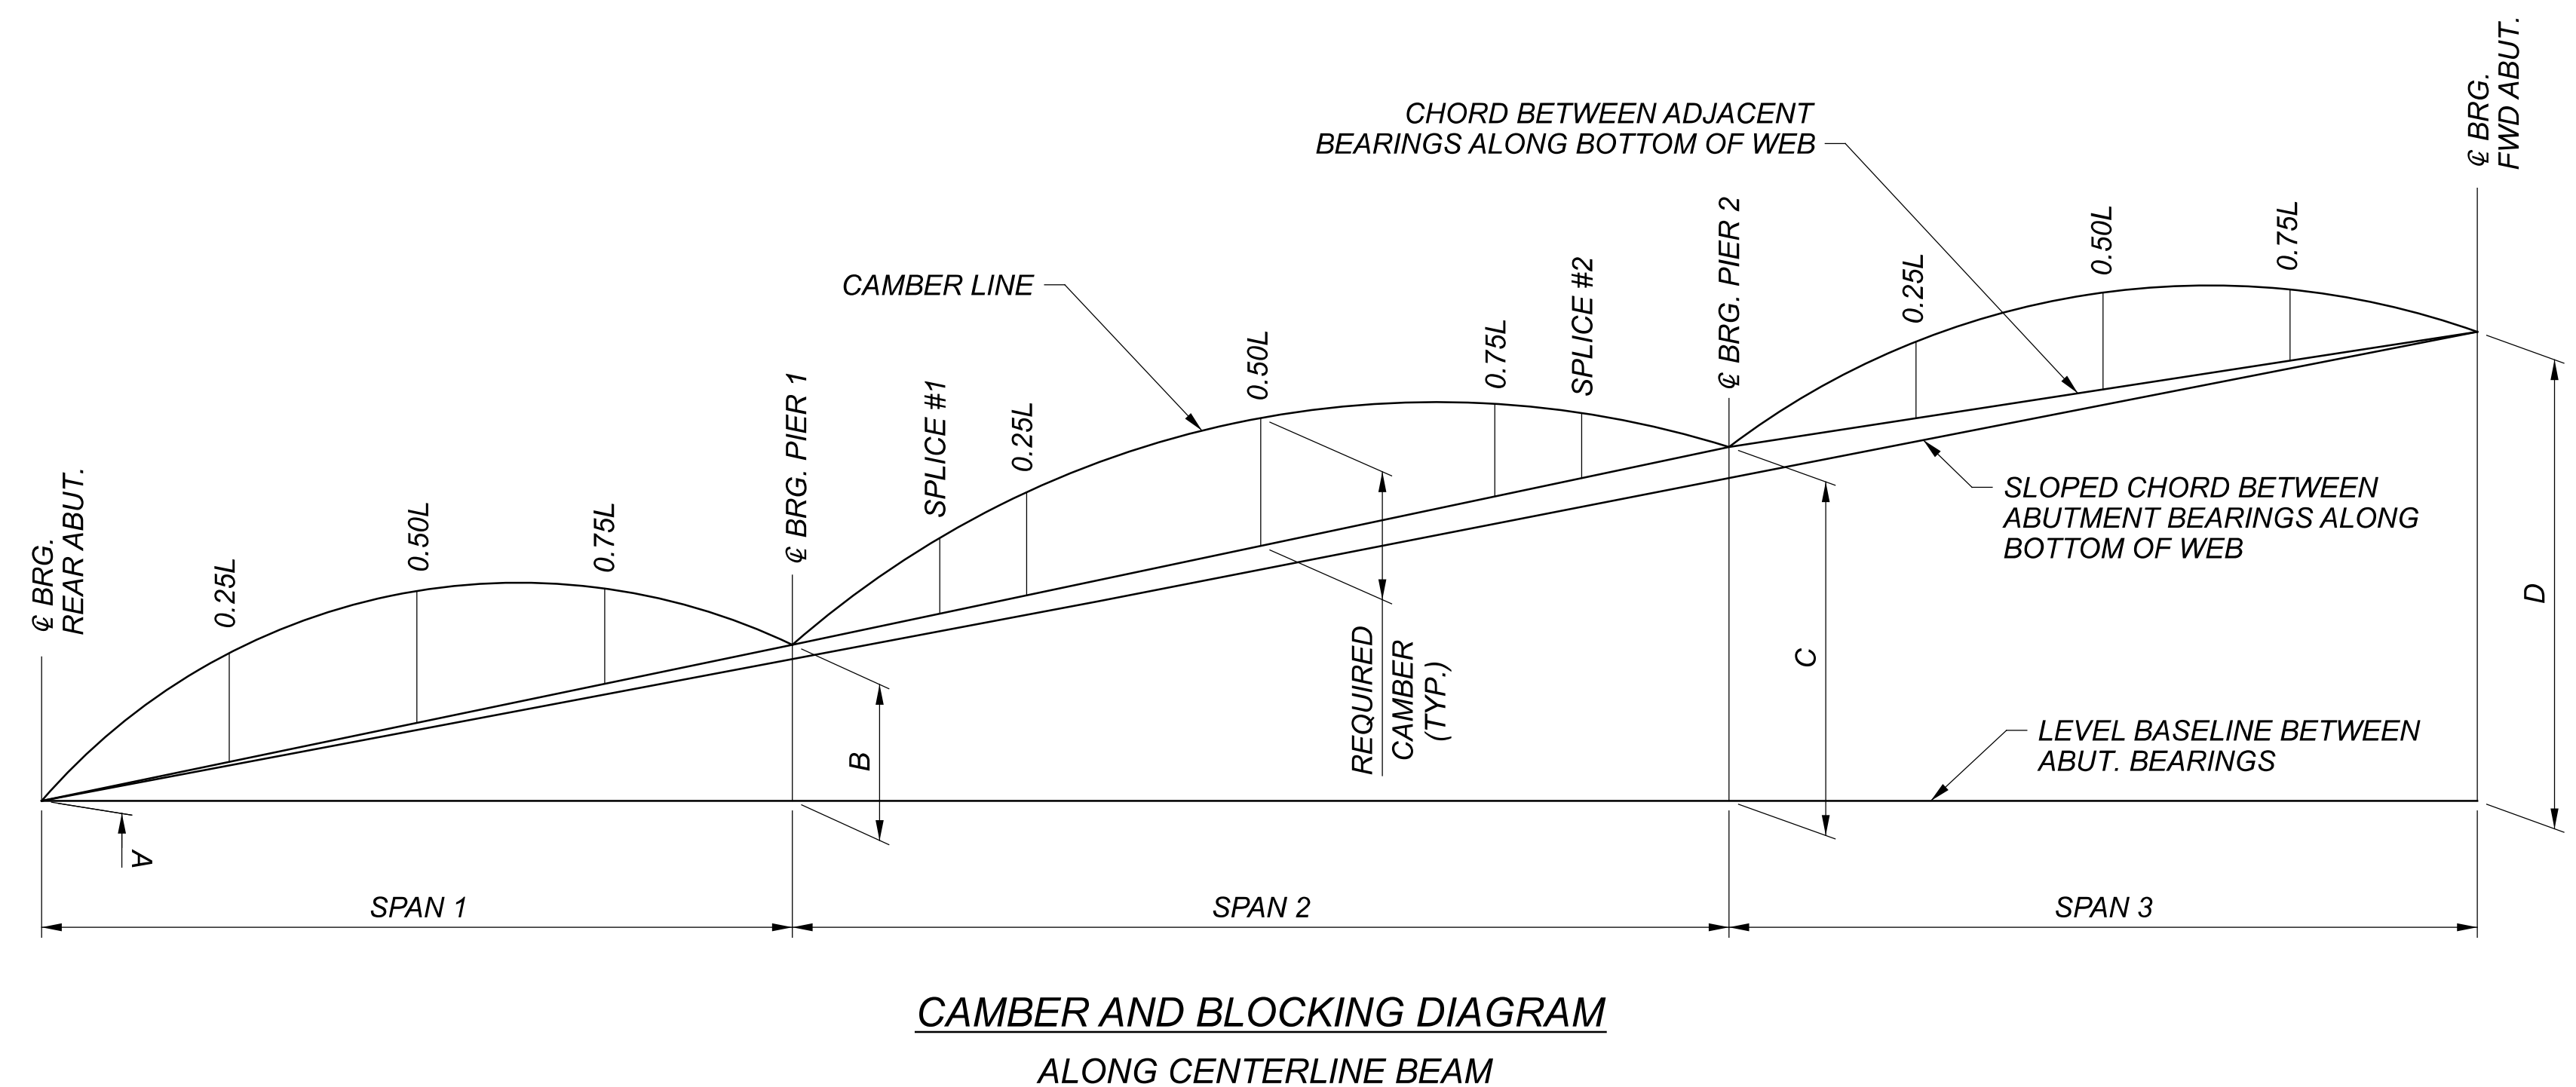

BEAM CAMBER AND BLOCKING
 BRIDGE NO. SUM-77-3197L
 I-77 OVER FURNACE RUN


| | |
|------------|-------------|
| SFN | 7704658 (L) |
| DESIGNER | RJB |
| CHECKER | CMD |
| REVIEWER | RBB |
| PROJECT ID | 111405 |
| SUBSET | 23 |
| TOTAL | 34 |
| SHEET | 788 |
| TOTAL | 927 |

| BEAM CAMBER AND DEFLECTIONS | | | | | | | | | | | |
|-----------------------------|-----------------------------------|---|---------------------------------------|--|--------------|-----------------------------------|---|---------------------------------------|--|--------------|--------|
| POINT | BEAM B3 | | | | | BEAM B4 | | | | | |
| | DEFLECTION DUE TO WEIGHT OF STEEL | DEFLECTION DUE TO NON-COMPOSITE DEAD LOAD | DEFLECTION DUE TO COMPOSITE DEAD LOAD | ADJUSTMENT REQUIRED FOR VERTICAL CURVE | TOTAL CAMBER | DEFLECTION DUE TO WEIGHT OF STEEL | DEFLECTION DUE TO NON-COMPOSITE DEAD LOAD | DEFLECTION DUE TO COMPOSITE DEAD LOAD | ADJUSTMENT REQUIRED FOR VERTICAL CURVE | TOTAL CAMBER | |
| REAR ABUTMENT | 0.00" | 0.00" | 0.00" | 0.00" | 0.00" | 0.00" | 0.00" | 0.00" | 0.00" | 0.00" | |
| SPAN 1 | 0.25 L | 0.03" | 0.17" | 0.02" | -0.20" | 0.02" | 0.03" | 0.18" | 0.02" | -0.21" | 0.03" |
| | 0.50 L | 0.04" | 0.20" | 0.02" | -0.27" | -0.01" | 0.04" | 0.21" | 0.02" | -0.28" | 0.00" |
| | 0.75 L | 0.02" | 0.09" | 0.01" | -0.21" | -0.09" | 0.02" | 0.10" | 0.01" | -0.21" | -0.08" |
| PIER NO. 1 | 0.00" | 0.00" | 0.00" | 0.00" | 0.00" | 0.00" | 0.00" | 0.00" | 0.00" | 0.00" | |
| SPAN 2 | SPLICE #1 | 0.01" | 0.07" | 0.01" | -0.21" | -0.11" | 0.01" | 0.08" | 0.01" | -0.21" | -0.11" |
| | 0.25 L | 0.03" | 0.15" | 0.02" | -0.31" | -0.11" | 0.03" | 0.16" | 0.02" | -0.32" | -0.10" |
| | 0.50 L | 0.05" | 0.26" | 0.04" | -0.41" | -0.06" | 0.05" | 0.28" | 0.04" | -0.42" | -0.05" |
| | 0.75 L | 0.03" | 0.15" | 0.02" | -0.30" | -0.09" | 0.03" | 0.16" | 0.02" | -0.31" | -0.10" |
| SPLICE #2 | 0.01" | 0.07" | 0.01" | -0.19" | -0.09" | 0.02" | 0.08" | 0.01" | -0.21" | -0.10" | |
| PIER NO. 2 | 0.00" | 0.00" | 0.00" | 0.00" | 0.00" | 0.00" | 0.00" | 0.00" | 0.00" | 0.00" | |
| SPAN 3 | 0.25 L | 0.02" | 0.09" | 0.01" | 0.00" | 0.12" | 0.02" | 0.09" | 0.01" | 0.00" | 0.12" |
| | 0.50 L | 0.04" | 0.20" | 0.02" | 0.00" | 0.26" | 0.04" | 0.21" | 0.02" | 0.00" | 0.27" |
| | 0.75 L | 0.03" | 0.17" | 0.02" | 0.00" | 0.22" | 0.03" | 0.18" | 0.02" | 0.00" | 0.23" |
| FORWARD ABUTMENT | 0.00" | 0.00" | 0.00" | 0.00" | 0.00" | 0.00" | 0.00" | 0.00" | 0.00" | 0.00" | |

NOTES:
 1. CAMBER IS MEASURED ALONG BOTTOM OF THE BEAM WEB.

| BEAM NUMBER | DIMENSION | | | | CHORD SLOPE |
|-------------|-----------|--------|--------|--------|-------------|
| | A | B | C | D | |
| BEAM B3 | 0.00" | 21.60" | 42.96" | 54.00" | 2.891% |
| BEAM B4 | 0.00" | 21.72" | 42.84" | 54.00" | 2.891% |

* BLOCKING DIMENSIONS ARE FROM THE LEVEL BASELINE BETWEEN ABUTMENT BEARINGS TO THE BOTTOM OF WEB.

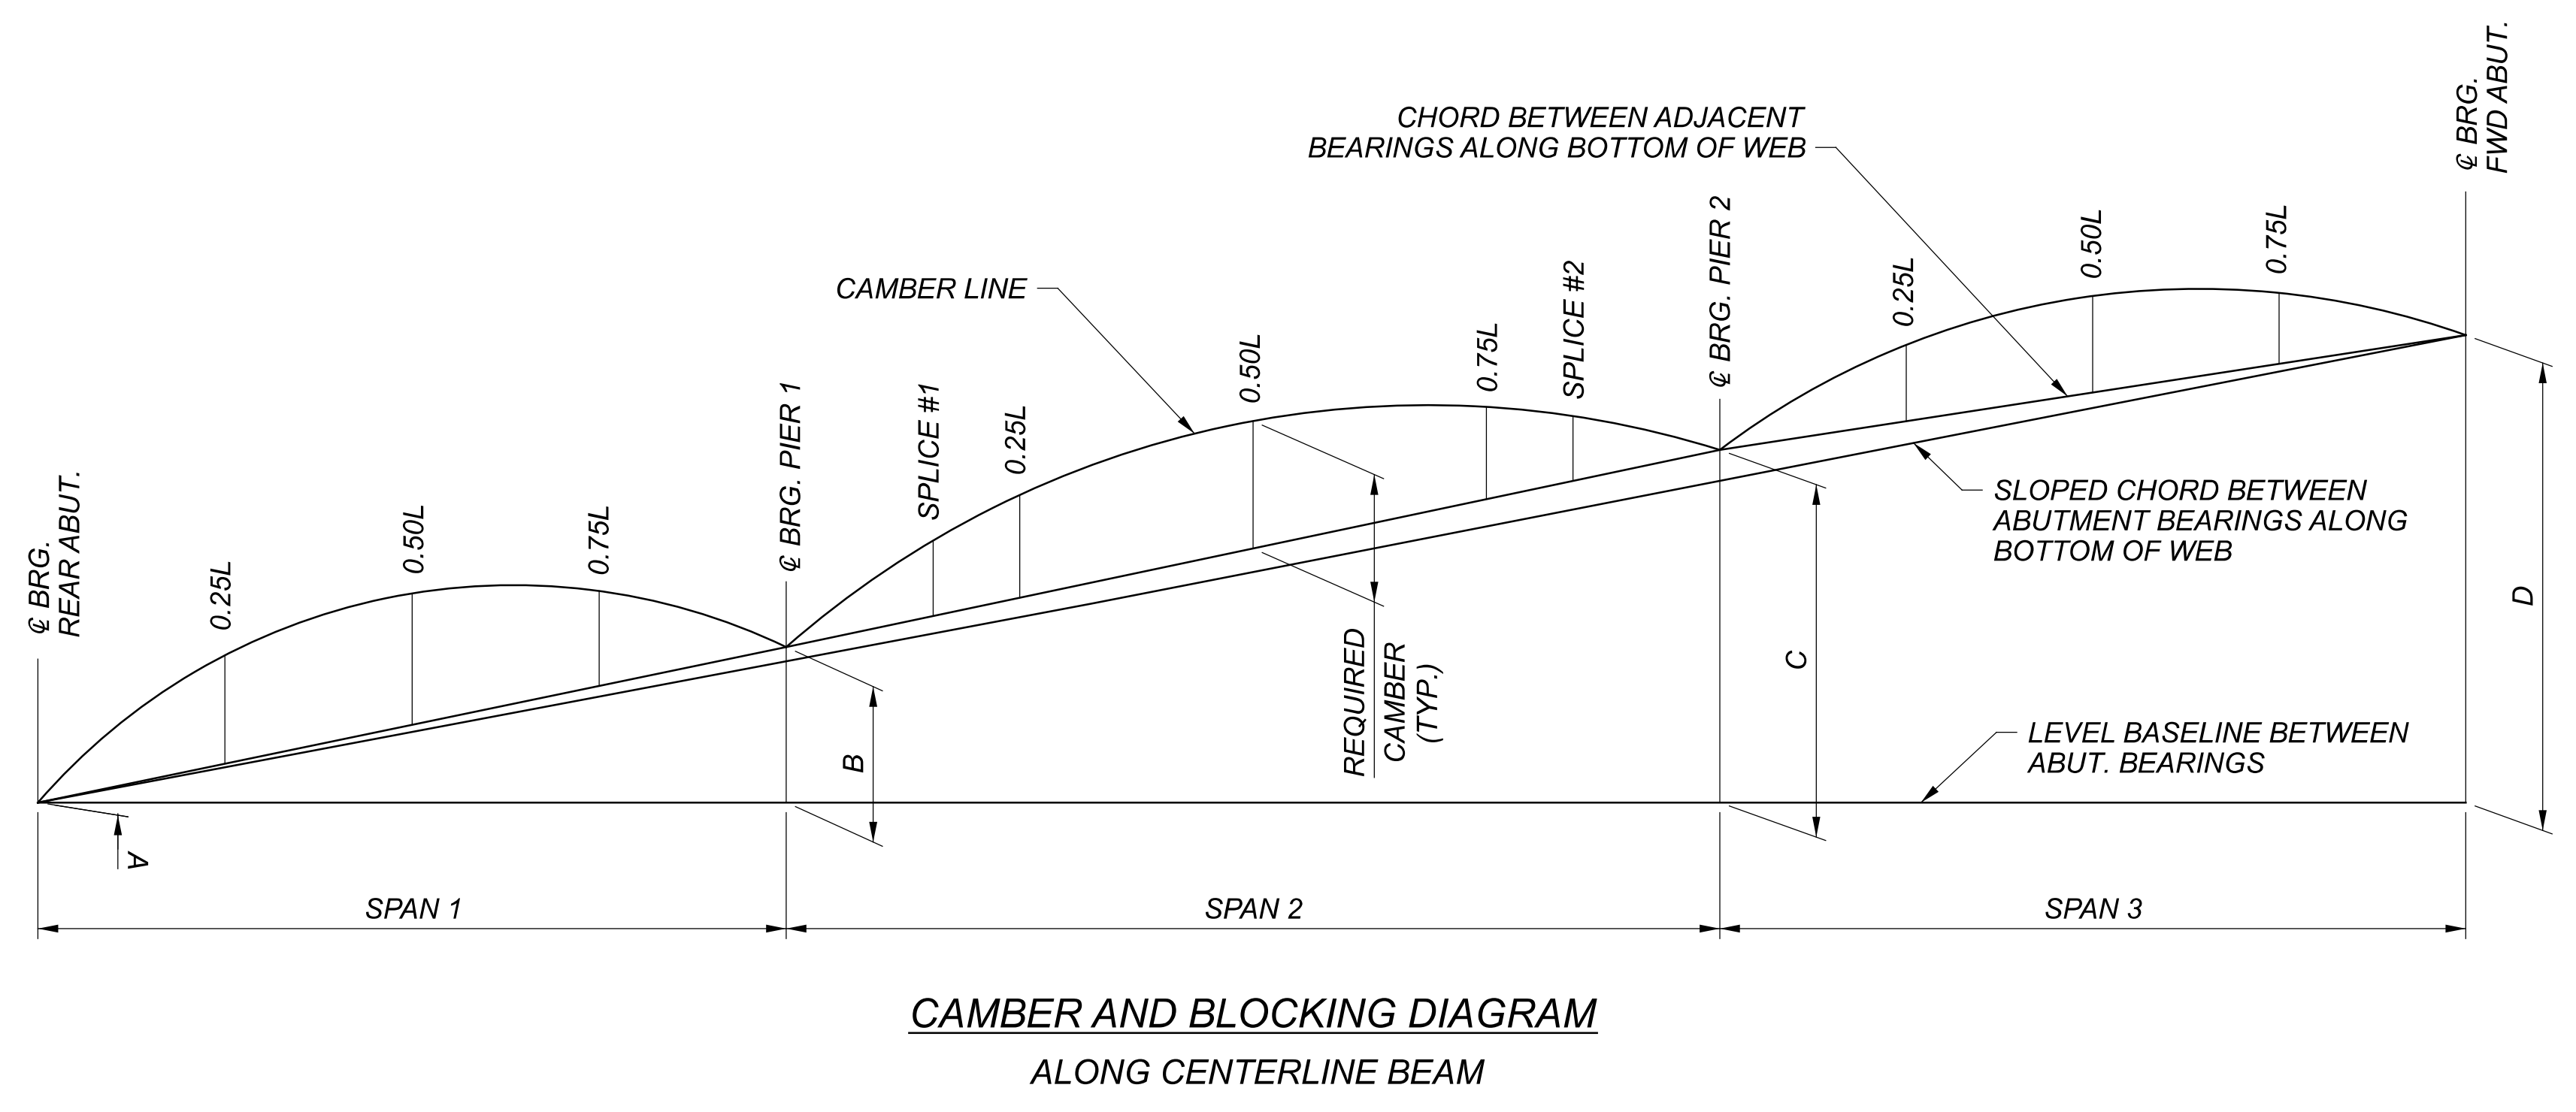

CAMBER AND BLOCKING DIAGRAM
 ALONG CENTERLINE BEAM

BEAM CAMBER AND BLOCKING
 BRIDGE NO. SUM-77-3197R
 I-77 OVER FURNACE RUN

| | |
|---------------|-------------|
| SFN | 7704682 (R) |
| DESIGN AGENCY | ARCADIS |
| DESIGNER | RJB |
| CHECKER | FJG |
| REVIEWER | RBB |
| PROJECT ID | 111405 |
| SUBSET | 23 |
| TOTAL | 34 |
| SHEET | 822 |
| TOTAL | 927 |