



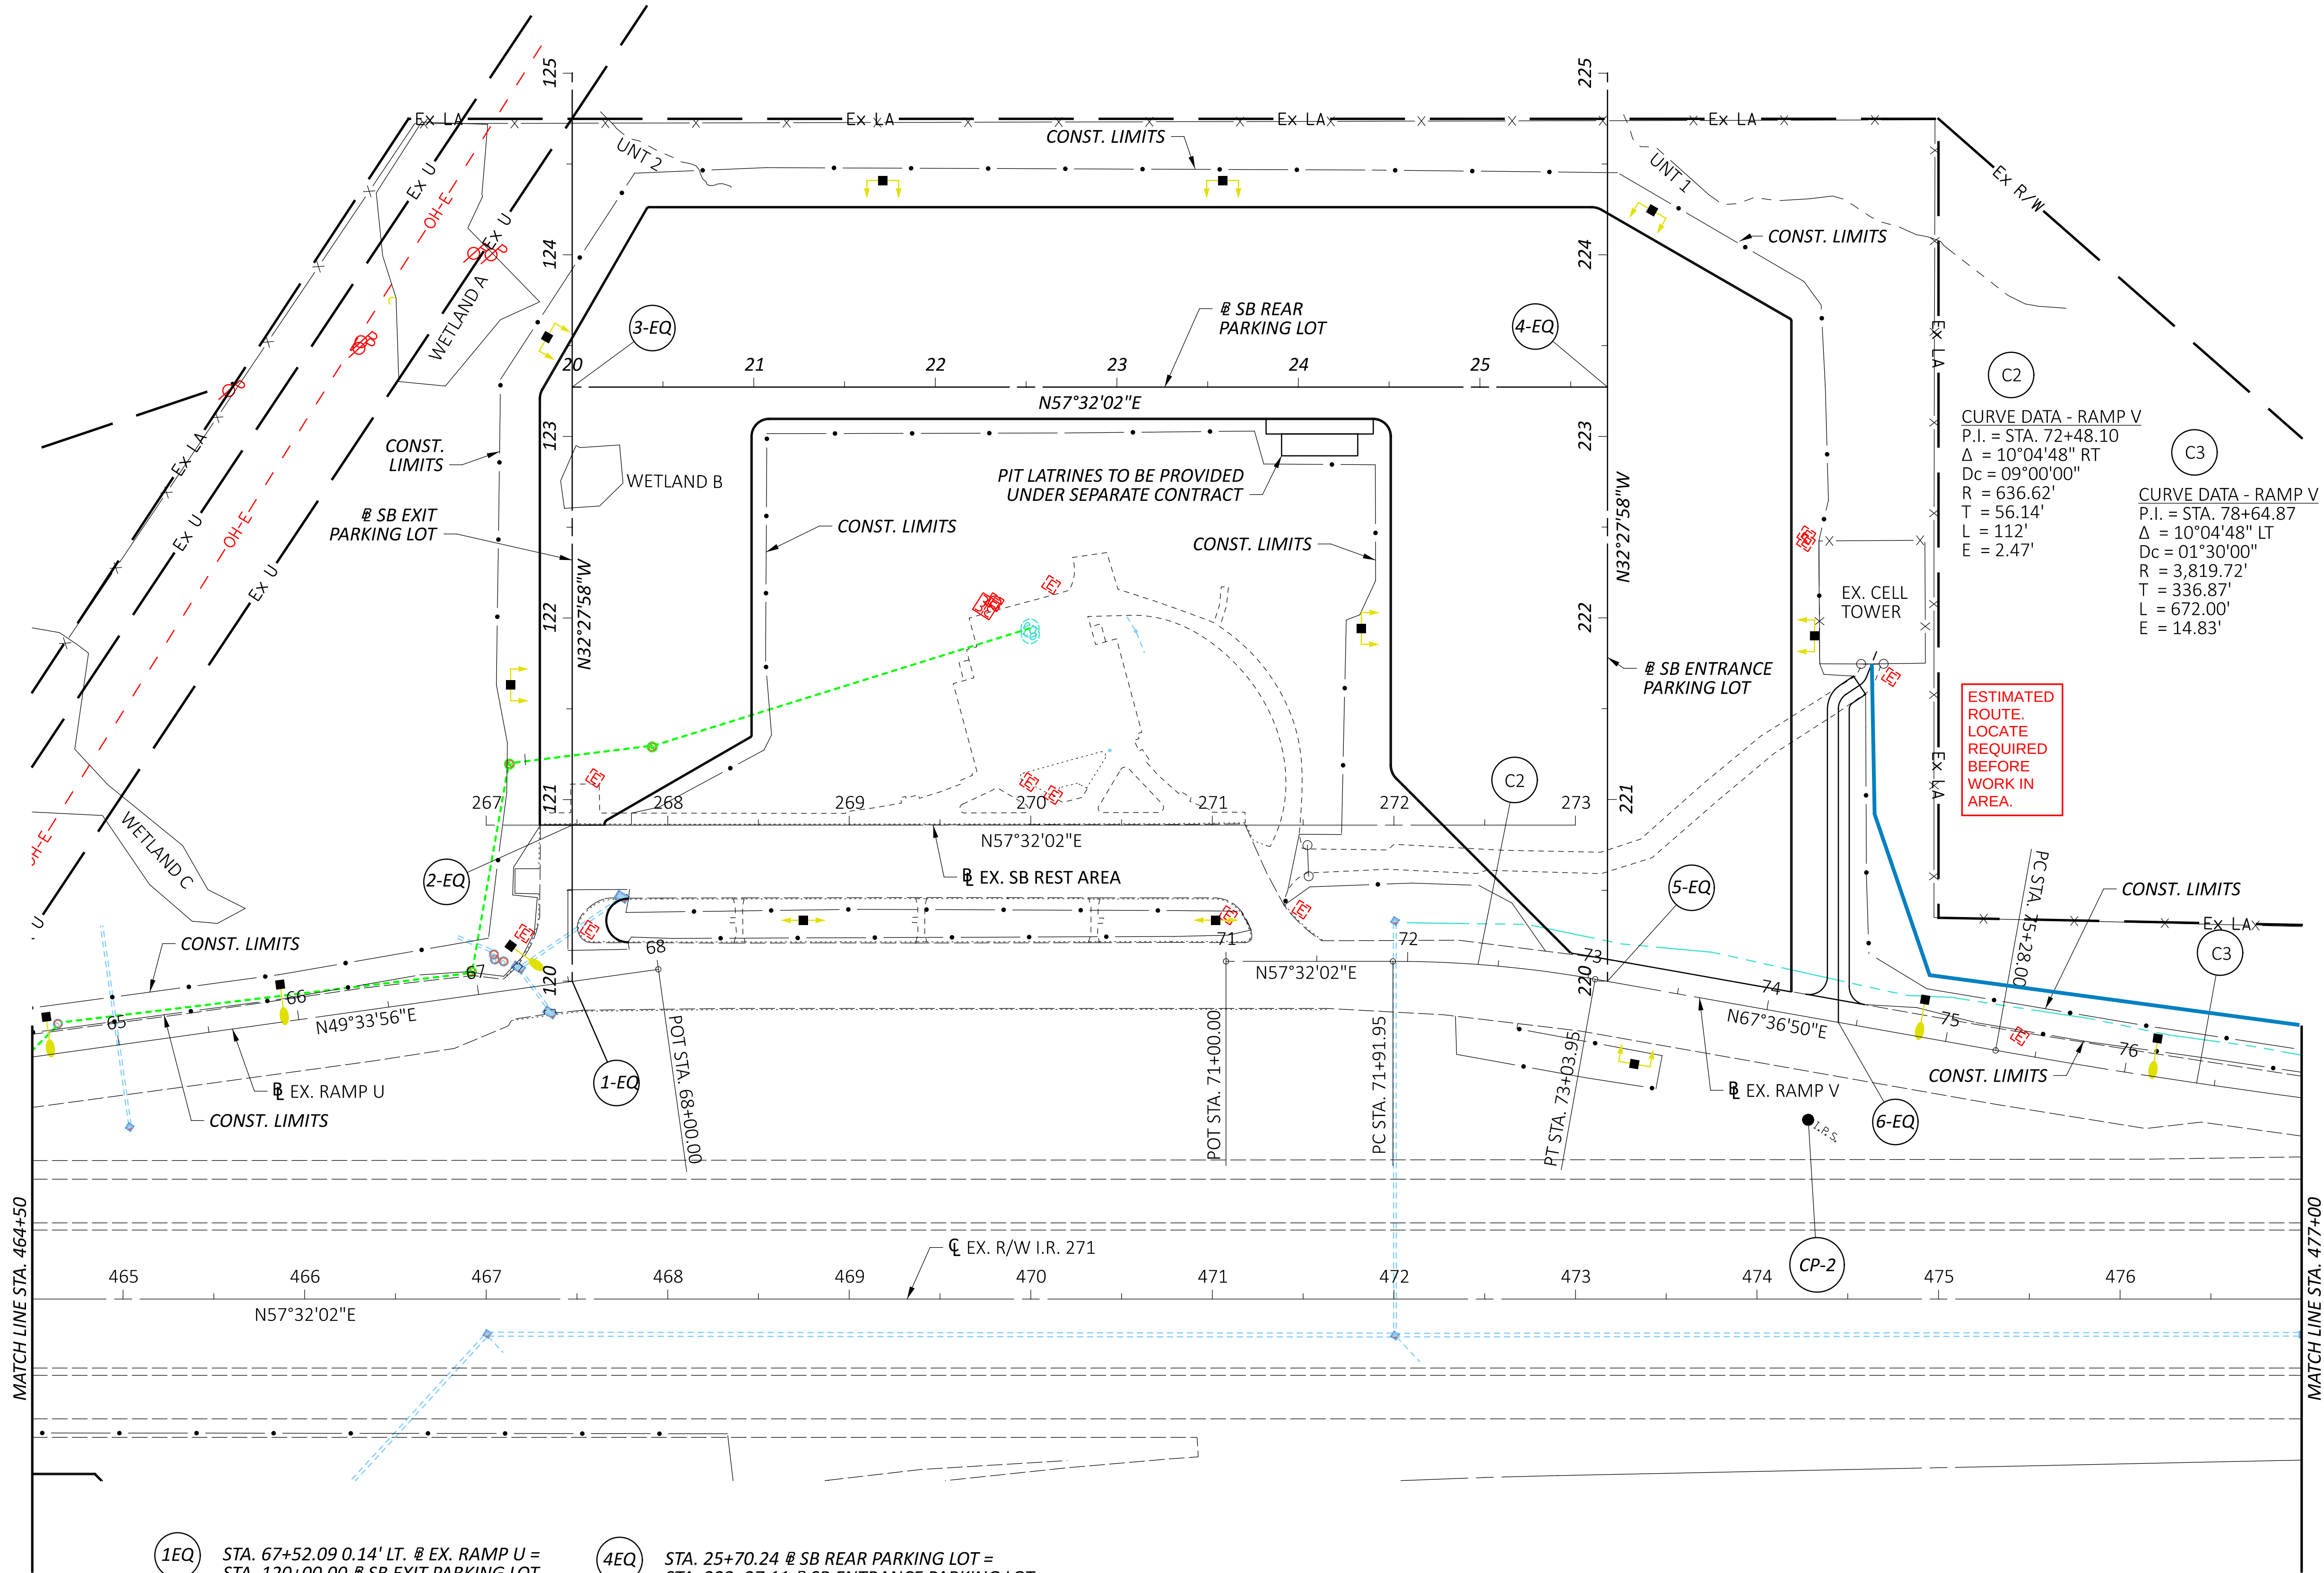

SCHMATIC PLAN - SB TRUCK PARKING
STA. 464+50.00 TO STA. 477+00.00

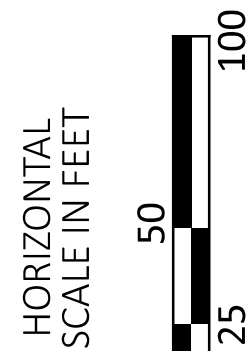

DESIGN AGENCY

2LMN

DESIGNER

MAK

REVIEWER

AMT 02/06/26

PROJECT ID

122877

SHEET

P.06

TOTAL

98