

AKRON EXPRESSWAY SYSTEM

SUM-5-12.31

SUMMIT COUNTY
CITY OF AKRON

PART 1 - MAIN VIADUCT SUBSTRUCTURE

INDEX OF SHEETS

- 1 TITLE SHEET
- 2 SITE PLAN
- 3 SITE PLAN
- 4 GENERAL PLAN AND ELEVATION, ESTIMATED QUANTITIES
- 5 NOTES
- 6-9 SOUTH ABUTMENT
- 10-11 NORTH ABUTMENT
- 12 PIER 1
- 13 PIER 2
- 14 PIER 3
- 15 PIER 4
- 16 PIER 5
- 17 PIER 6
- 18 PIER 7
- 19 REINFORCING STEEL-ABUTMENTS
- 20 REINFORCING STEEL-PIERS
- 21 DRAINAGE AND ACCESS LADDER
- 22 STONE FACING DETAILS
- 23 ANCHOR BOLT PLAN
- 24-28 SITE GRADING-SOUTH PORTION
- 29-33 SITE GRADING-NORTH PORTION
- 34 RAILROAD FORCE ACCOUNT WORK


APPROVED *William H. Davis*
DATE Dec 27 1949 DIRECTOR OF PUBLIC SERVICE, CITY OF AKRON

APPROVED F. J. Bishop
DATE J-7-50 CHIEF ENGINEER, A.C.&Y. RAILROAD

APPROVED I. H. Schram
DATE 2-1-50 CHIEF ENGINEER, ERIE RAILROAD

APPROVED D. L. Sommerville
DATE J-12-50 CHIEF ENGINEER, PENNSYLVANIA RAILROAD

APPROVED A. C. Clarke
DATE J-12-50 CHIEF ENGINEER, B. & O. RAILROAD

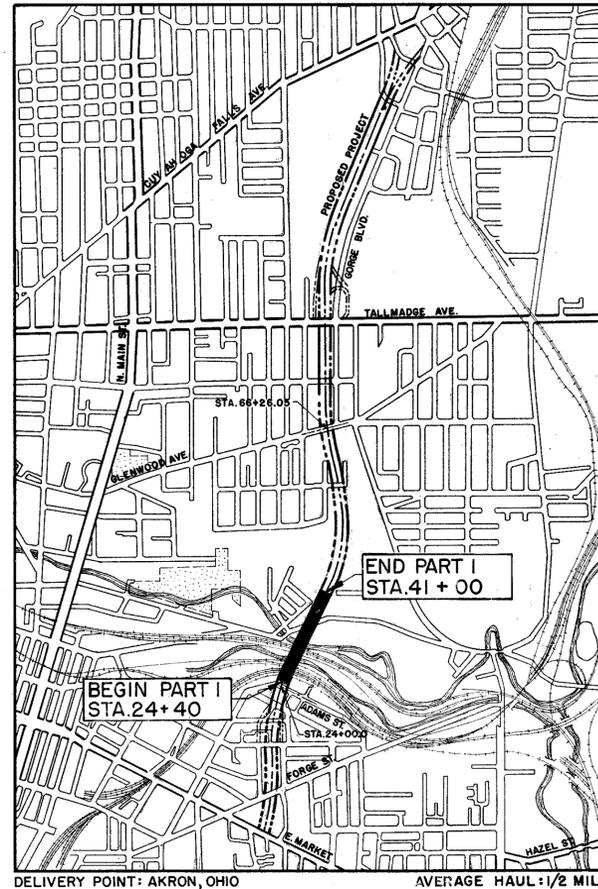

THE STANDARD SPECIFICATIONS OF THE STATE OF OHIO DEPARTMENT OF HIGHWAYS, INCLUDING CHANGES AND SUPPLEMENTAL SPECIFICATIONS LISTED IN THE PROPOSAL SHALL GOVERN THIS IMPROVEMENT.

I HEREBY APPROVE THESE PLANS AND DECLARE THAT THE MAKING OF THIS IMPROVEMENT WILL NOT REQUIRE THE CLOSING TO TRAFFIC OF THE HIGHWAY AND THAT PROVISIONS FOR THE MAINTENANCE AND SAFETY OF TRAFFIC WILL BE AS SET FORTH IN THE PLANS AND ESTIMATE.

THE RIGHT OF WAY FOR THIS IMPROVEMENT WILL BE PROVIDED BY THE STATE OF OHIO.

APPROVED *W. C. Tanner*
DATE Dec 22 1949 DIVISION DEPUTY DIRECTOR

APPROVED _____
DATE _____ CHIEF ENGINEER, BUREAU OF MAINTENANCE

APPROVED *Richard D. ...*
DATE 12-29-49 CHIEF ENGINEER, BUREAU OF BRIDGES & R.R. CROSSINGS

APPROVED *W. H. ...*
DATE 2-8-50 CHIEF ENGINEER, BUREAU OF LOCATION & DESIGN

APPROVED *J. P. ...*
DATE 2-8-50 FIRST ASSISTANT DIRECTOR & CHIEF ENGINEER

APPROVED *W. H. ...*
DATE 2-8-50 DIRECTOR OF HIGHWAYS

LINE DATA

BEGIN PART I STA. 24+40
END PART I STA. 41+00
NET LENGTH PART I 1660 FT. OR 0.314 MI.

BRIDGE LIMITS
STA. 24+85.75 TO STA. 40+68.50 = 1582.75 FT OR 0.300 MI.

PREPARED AND RECOMMENDED BY
HOWARD, NEEDLES, TAMMEN & BERGENDOFF
CONSULTING ENGINEERS

KANSAS CITY NEW YORK


H. N. Bergendoff



FILE NO. SUMMIT COUNTY
SEC. SUM-5-12.31, PART I
DATE OF LETTING _____, 195
CONTRACT NO. _____

STANDARD DRAWINGS	
L-2	10-1-45
1-1,2,3,4 & 5	2-20-45

LOCATION PLAN

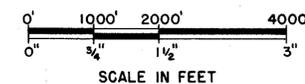

PORTION TO BE IMPROVED
STATE HIGHWAYS
OTHER HIGHWAYS



NOTE:
THIS SET OF PLANS, THE SUBSTRUCTURE OF THE MAIN VIADUCT, COVERS ONLY PART I OF THIS PROJECT. THE SUPERSTRUCTURE OF THE MAIN VIADUCT AND THE CONTIGUOUS HIGHWAY WORK WILL BE LET IN SUBSEQUENT CONTRACTS.



DEPARTMENT OF COMMERCE BUREAU OF PUBLIC ROADS	
RECOMMENDED FOR APPROVAL	
DISTRICT ENGINEER	DATE
APPROVED	
DIVISION ENGINEER	DATE

FED. ROAD DIV. NO.	STATE	FED. AID PROJ. NO.	TYPE FUNDS	3
2	OHIO	U-687(6)	POST WAR	34

SUMMIT COUNTY
CITY OF AKRON
AKRON EXPRESSWAY SYSTEM
MAIN VIADUCT
SUM - 5-12.31

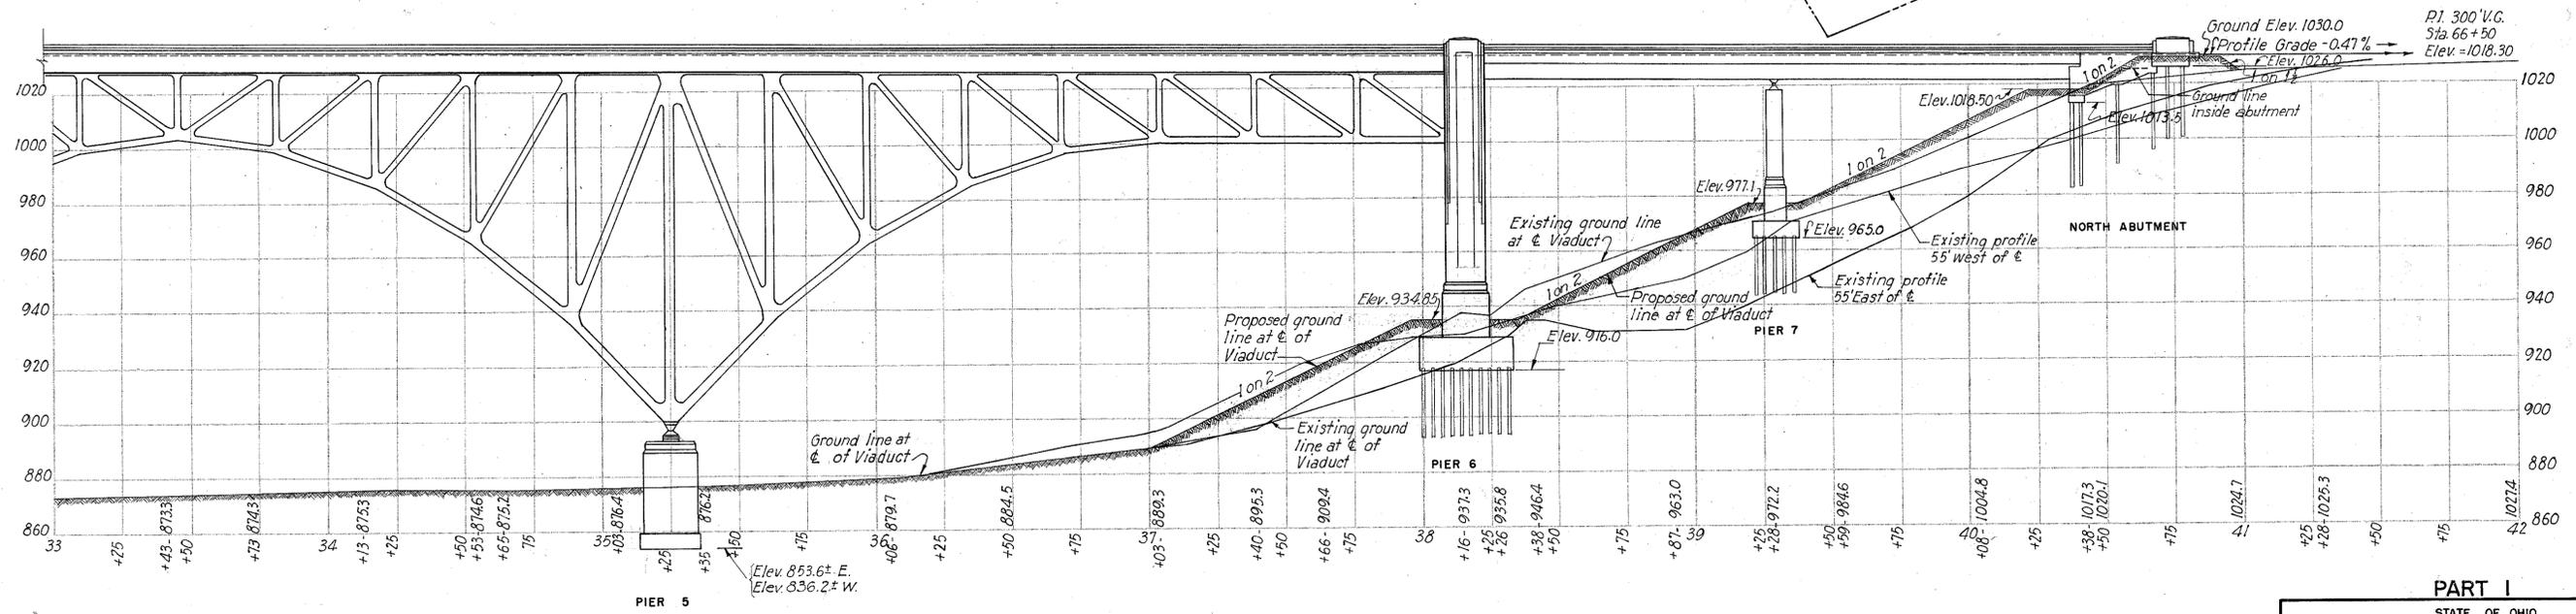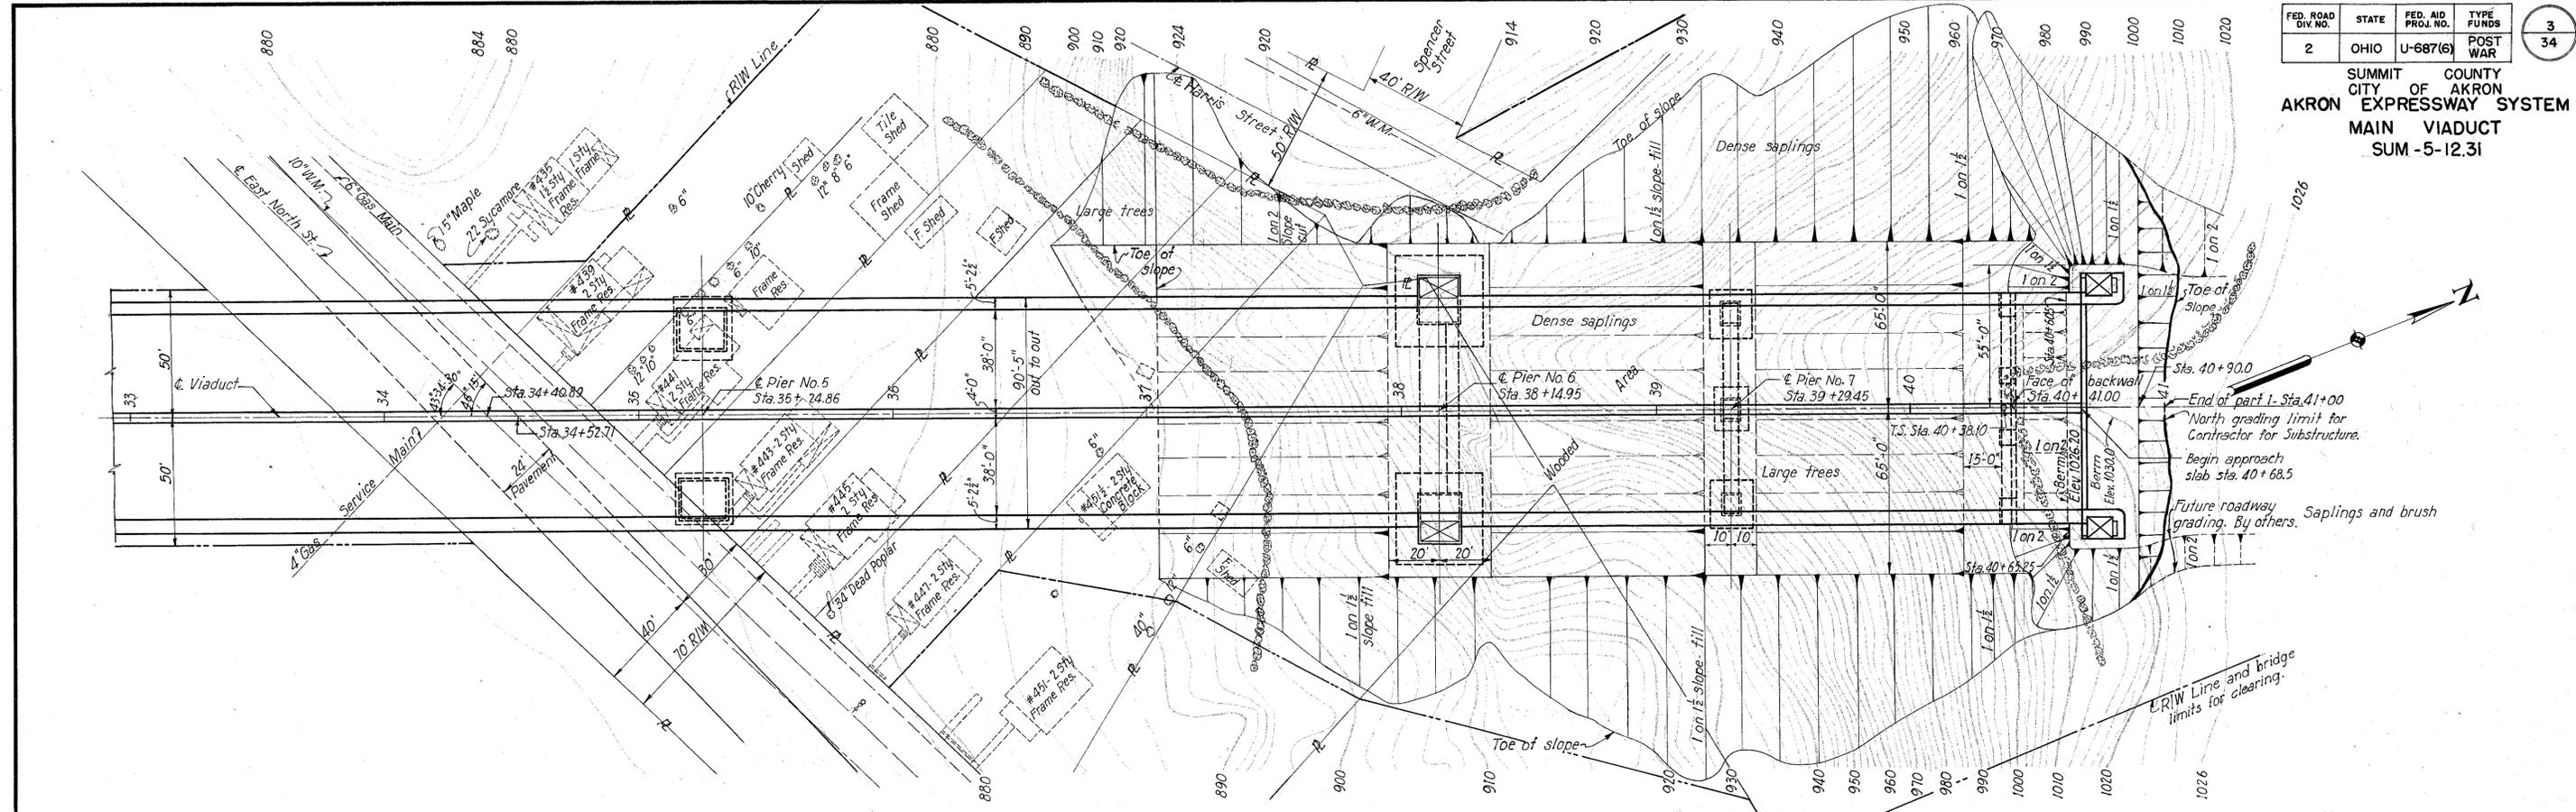

PART I

STATE OF OHIO
DEPARTMENT OF HIGHWAYS

AKRON EXPRESSWAY SYSTEM
(EAST MARKET STREET TO EAST CUYAHOGA FALLS AVENUE)
MAIN VIADUCT
BRIDGE NO. SU-5-124

SITE PLAN

AKRON, SUMMIT COUNTY, OHIO

SCALE 1" = 30'..... HOWARD, NEEDLES, TAMMEN & BERGENOFF
MADE R.F.M. DATE 7-11-49 CONSULTING ENGINEERS
TRCD. G.P.R. DATE 7-28-49 KANSAS CITY NEW YORK
CHKD. G.M. DATE 7-18-49 766 SHEET V3



Rev. 1/18/50

103

CHARLES BRUNING CO., INC.

FED. ROAD DIV. NO.	STATE	FED. AID PROJ. NO.	TYPE FUND	4
2	OHIO	U-687(6)	POST WAR	34

**SUMMIT COUNTY
CITY OF AKRON
AKRON EXPRESSWAY SYSTEM
MAIN VIADUCT
SUM-5-12.31**

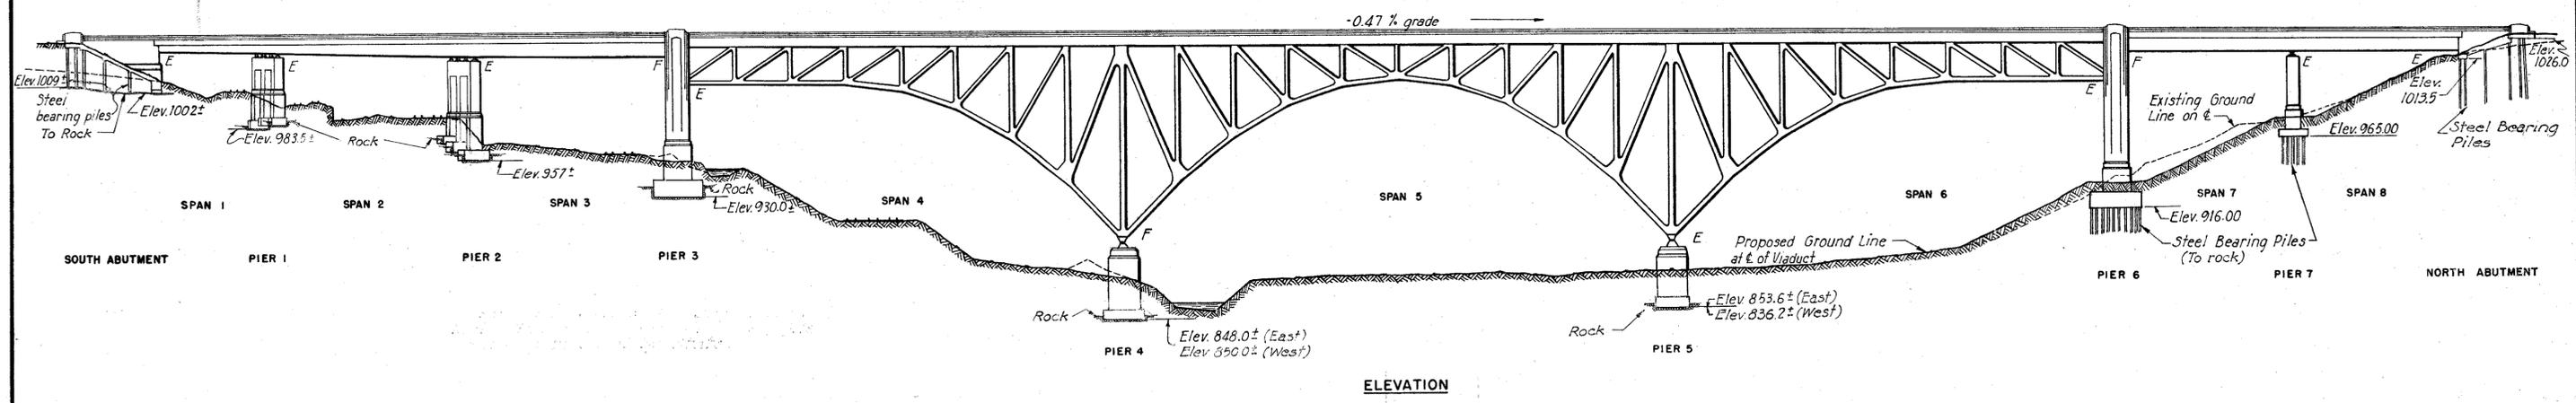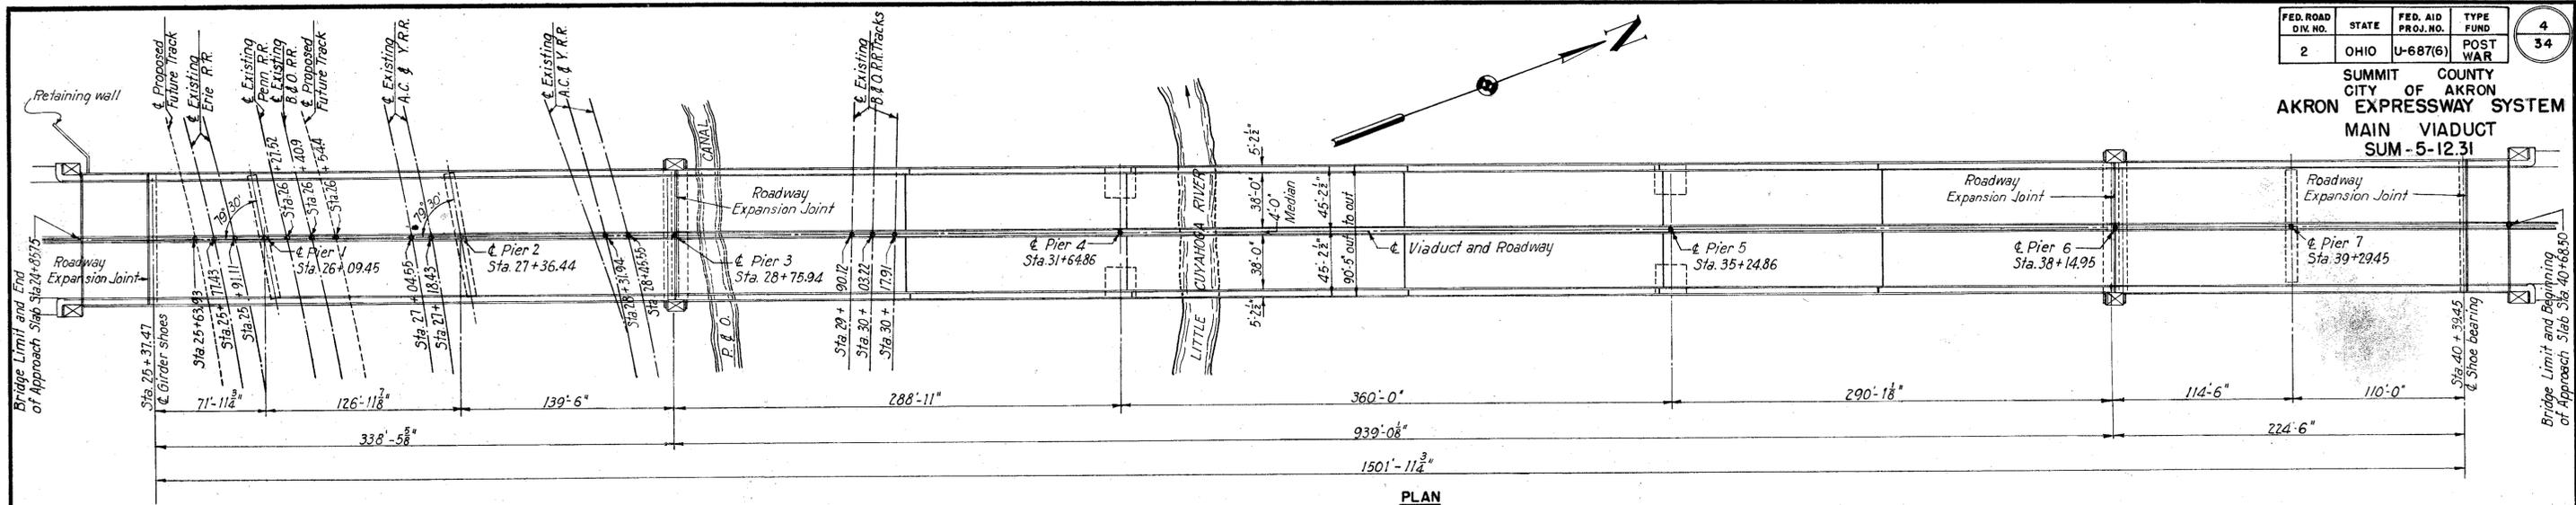

ESTIMATED QUANTITIES FOR SUBSTRUCTURE														
Item	Description	S. Abt.	Pier 1	Pier 2	Pier 3	Pier 4	Pier 5	Pier 6	Pier 7	N. Abt.	General	Units	Total	As Built
E-1	Excavation for Site Grading				55						3,400	Cu. Yd.	3,455	2,148
E-2	Cofferdams and Pumping											Lump		
E-2	Excavation for Structures - Unclassified	835	432	618	1,650	1,330	1,740	1,950	246	245		Cu. Yd.	8,946	6,385
E-2	Excavation for Structures - Rock and Shale	25	73	127	558	125	111					Cu. Yd.	1,019	3,763
E-4	Borrow for Site Grading	5,525										Cu. Yd.	37,650	4,603.7
E-9	Removal of Trees and Stumps											Lump		
E-12	16" Pipe Removed and Disposed of										110	Lin. Ft.	110	
S-1	Class "E" Concrete - Pier Roofings		145	202	1,069	300	215	1,104	195			Cu. Yd.	3,230	3,296.71
S-1	Class "C" Concrete - Pier Caps and Columns and Pier Walls		788	569	2,092	916	953	2,280	429			Cu. Yd.	7,507	8,037.23
S-1	Class "C" Concrete - Abutments	10,330								373		Cu. Yd.	1,406	1,356.47
S-4	Reinforcing Steel	99,270	47,090	51,170	172,820	18,260	17,980	110,230	35,590	42,690	1,100	Lbs.	3,962,000	5,798.94
S-7	Structural Metal - Anchor Bolts, Ladders, Manholes	1,525			415					415		Lbs.	3,800	3,560
S-16	First Test Pile											Lump		
S-17	First Test Load											Lump		
S-17	Subsequent Test Load										1	Each	1	
S-18	Steel Piles (14BP@73")	1,750							11,890	6,130	2,280	Lin. Ft.	22,050	27,525.93
S-21	Stone Facing	595			902				902	595		Cu. Ft.	2,994	2,971.3
S-25	Lighting - Junction Boxes and Conduit											Lump		
S-29	Bridge Drainage - Inlets at South Abutment and Grating at Pier 1											Lump		
S-29	Bridge Drainage - Downspouts and Attachments	150	60	100	200							Lin. Ft.	510	
S-29	Bridge Drainage - 12" Reinforced Concrete Sewer Pipe		72									Lin. Ft.	72	
I-2	16" Pipe for Storm Sewer (VSD)											Lin. Ft.	130	
J-3	Type "B" Waterproofing	20										Sq. Yds.	20	
E-11	Water										170	M. Gal.	170	0

*Includes weight of bars for drainage inlets.
 †Includes concrete for paving ditch at sewer outlet
 ‡Includes weight of bars for ditch paving.
 See sheet 34 for summary of Railroad Force Account Work.

PART I

STATE OF OHIO
DEPARTMENT OF HIGHWAYS

AKRON EXPRESSWAY SYSTEM
(EAST MARKET STREET TO EAST CUYAHOGA FALLS AVENUE)
MAIN VIADUCT
BRIDGE NO. SU-5-124

**GENERAL PLAN, ELEVATION
AND ESTIMATED QUANTITIES**

AKRON, SUMMIT COUNTY, OHIO

SCALE: 1" = 50'
 MADE & DATE: 3-5-49
 TRCD & DATE: 1-20-49
 CHKD & DATE: 6-22-49

HOWARD, NEEDLES, TAMMEN & BERGENDOFF
CONSULTING ENGINEERS
KANSAS CITY - NEW YORK

766 SHEET V 4

Rev. 1/18/50
 Rev. 1/27/50, Rev. 2/2/50

CEU 7/30/52

FED. ROAD DIV. NO.	STATE	FED. AID PROJ. NO.	TYPE FUNDS
2	OHIO	U-687(G)	POST WAR

5
34

SUMMIT COUNTY
CITY OF AKRON
AKRON EXPRESSWAY SYSTEM
MAIN VIADUCT
SUM-5-12.31

NOTES

SUBSTRUCTURE WORK TO BE PERFORMED LATER AS PART OF THE CONTRACT FOR THE SUPER-STRUCTURE CONSISTS OF: RAILING, LIGHTING SYSTEM (EXCEPT CONDUITS AND JUNCTION BOXES), TYPE C WATERPROOFING OF ABUTMENT SLABS, ASPHALTIC CONCRETE SURFACE COURSE ON ABUTMENT SLABS, CONCRETE MEDIAN STRIP ON ABUTMENT SLABS, DRAINAGE ANGLES ALONG GUTTERS OVER DRAIN TUBES, STEEL CURBS AND FINGERED EXPANSION JOINTS.

MINIMUM TEMPORARY CONSTRUCTION CLEARANCES FOR RAILROAD TRACKS:

RAILROAD	VERTICAL CLEARANCE ABOVE TOP OF RAIL	HORIZONTAL CLEARANCE FROM CENTERLINE OF TRACK
A.C. & Y.	23'-0"	8'-0"
ERIE	21'-0"	8'-0"
PENNSYLVANIA	23'-0"	8'-8"
B. & O.	23'-0"	8'-8"

CLEARING AND GRUBBING
THE AREAS ADJACENT TO PIERS 2, 6 AND 7 AND AT THE ABUTMENTS WHERE EXCAVATION AND/OR EMBANKMENT IS REQUIRED SHALL BE CLEARED AND GRUBBED AS SPECIFIED IN ITEM E-1. PAYMENT FOR SUCH CLEARING AND GRUBBING, EXCEPT PORTIONS WITHIN THE LIMITS OF ITEM E-2, EXCAVATION FOR STRUCTURES AND PAID FOR THEREWITH, AND THE REMOVAL OF TREES AND STUMPS WHICH IS PAID FOR IN ITEM E-9, IS INCLUDED IN ITEM E-1, EXCAVATION FOR SITE GRADING AND ITEM E-4, BORROW FOR SITE GRADING.

EXCAVATION AND BORROW FOR SITE GRADING ADJACENT TO PIERS 2, 6 AND 7 AND AT THE ABUTMENTS WILL BE GOVERNED BY ITEMS E-1 AND E-4. THE BORROW MATERIAL MAY BE OBTAINED FROM AREAS ADJACENT TO STATION 02 ON THE PROPOSED EXPRESSWAY AND SHALL BE AVAILABLE TO THE CONTRACTOR THERE FREE OF CHARGE.

ALL EXCESS STRUCTURAL EXCAVATION NOT REQUIRED FOR BACKFILLING SHALL BE USED IN EMBANKMENTS, AND PAYMENT FOR EMBANKMENTS SO CONSTRUCTED SHALL BE CONSIDERED FULLY COVERED BY PAYMENTS MADE FOR ITEM E-2, EXCAVATION FOR STRUCTURES.

CULVERT EXTENSION
CONSTRUCTION OF PIER 1 SHALL INCLUDE MODIFICATION OF DRAINAGE FACILITIES FOR THE ADJACENT RAILROAD TRACKS AND CONSTRUCTION OF UNDERGROUND OUTFALL LINES FROM THE DOWNSPOUTS ON THE PIER COLUMNS. THE EXISTING 36" C.I.P. CULVERT UNDER THE ERIE RR. TRACK SHALL BE SHORTENED AND THAT UNDER THE P. RR. TRACK EXTENDED. PAYMENT THEREFOR SHALL BE CONSIDERED AS INCLUDED IN THE PRICE BID FOR PIER CONCRETE AND NO DEDUCTION WILL BE MADE FROM THE PIER CONCRETE QUANTITY FOR THE VOLUME OF ENCASED PIPE. PAYMENT FOR REMOVAL OF EXISTING HEADWALLS OF RAILROAD CULVERTS TO BE MADE UNDER ITEM E-2, EXCAVATION FOR STRUCTURES, ROCK AND SHALE. DOWNSPOUT OUTFALLS TO BE STANDARD REINFORCED CONCRETE SEWER PIPE, SEC. M-6.6 (A), AND PAID FOR UNDER ITEM S-29, 12" REINFORCED CONCRETE SEWER PIPE. THE CONSTRUCTION OF PIER 2 SHALL INCLUDE THE ALTERATION AND EXTENSION OF THE EXISTING 36" CONCRETE PIPE CULVERT SHOWN ON THE PLANS. THE CONTRACTOR SHALL FURNISH AND INSTALL APPROXIMATELY 6 LIN. FT. OF 36" REINFORCED CONCRETE PIPE, SEC. M-6.6 (C), INCORPORATED IN THE CONSTRUCTION OF THE PIER. PAYMENT THEREFOR SHALL BE CONSIDERED AS INCLUDED IN THE PRICE BID FOR PIER CONCRETE AND NO DEDUCTION WILL BE MADE FROM THE PIER CONCRETE QUANTITY FOR THE VOLUME OF ENCASED PIPE.

CHANNEL CHANGE
THE PENNSYLVANIA AND OHIO CANAL ADJACENT TO PIER 3 SHALL BE TEMPORARILY RELOCATED TO THE EXTENT NECESSARY TO PERMIT CONSTRUCTION OF THE WESTERLY FOOTING OF THIS PIER. FOLLOWING COMPLETION OF THE PIER THE CHANNEL SHALL BE RESTORED TO APPROXIMATELY ITS ORIGINAL LOCATION. THE CHANNEL CHANGE SHALL BE MADE WITHOUT INTERRUPTING THE FLOW IN THE CANAL, AND ALL WORK ON THE CANAL SHALL MEET THE APPROVAL OF THE CANAL OWNERS. PAYMENT FOR ALL WORK IN CONNECTION WITH DIVERTING AND RESTORING THE CHANNEL WILL BE INCLUDED IN ITEM E-2, COFFERDAMS AND PUMPING.

JOINT FILLER
THE JOINTS BETWEEN ENDS OF RETAINING WALLS AND COLUMNS OF PIERS 1 AND 2 SHALL HAVE 1/2 INCH BITUMINOUS PREMOLDED JOINT FILLER AT THE ENDS OF WALLS AND SHALL HAVE TAR PAPER ON THE SIDES, TOPS AND BOTTOMS OF WALL SURFACES IN CONTACT WITH COLUMNS AND FOOTINGS. THE PREMOLDED JOINT FILLER SHALL CONFORM TO THE REQUIREMENTS OF SEC. M-10.01 OF THE SPECIFICATIONS. THE TAR PAPER SHALL CONFORM TO THE REQUIREMENTS OF AASHTO SPECIFICATIONS FOR SUBGRADE PAPER,

DESIGNATION M 74-38. THE JOINT FILLER AND TAR PAPER SHALL BE SECURELY FASTENED TO THE CONCRETE AND SHALL BE PROTECTED FROM DAMAGE DURING PLACING OF CONCRETE. PAYMENT FOR THE JOINT FILLER AND TAR PAPER WILL BE CONSIDERED INCLUDED IN THE PRICE BID FOR CONCRETE.

STRUCTURAL STEEL ITEM S-7 INCLUDES THE FOLLOWING STEEL PARTS:
STEEL ANCHOR BOLTS FOR ATTACHING RAILING POSTS TO EXTERIOR WALLS OF ABUTMENTS. THEY SHALL BE SET WITH METAL TEMPLATES TO INSURE TRUE FIT OF THE RAILING.
STEEL ANCHOR BOLTS FOR ATTACHING ROADWAY EXPANSION JOINTS TO BACK WALLS OF ABUTMENTS. THEY SHALL BE SET WITH METAL TEMPLATES TO INSURE TRUE FIT OF THE EXPANSION JOINTS.
CAST STEEL ACCESS MANHOLE COVERS AND FRAMES IN SIDEWALKS OF ABUTMENTS. STEEL ACCESS LADDERS AND ATTACHMENT BOLTS ON PIERS 3 AND 6.

BRIDGE DRAINAGE ITEMS (S-29) INCLUDE THE FOLLOWING PARTS:
CAST STEEL GRATING INLETS IN THE SOUTH ABUTMENT. GRATING COVER ON INLET AT PIER 1. TO BE PAID FOR AS A LUMP SUM.
WROUGHT IRON DOWNSPOUTS FOR DRAINAGE OF SUPERSTRUCTURE SLAB. TO BE PAID FOR PER LINEAR FOOT INCLUDING THE INCIDENTAL ITEMS OF STEEL ATTACHMENT BOLTS AND WROUGHT IRON SUPPORT STRAPS.

SHOP PAINT
ALL STRUCTURAL STEEL (S-7) AND THE STEEL FOR BRIDGE DRAINAGE ITEMS (S-29), EXCEPT THE EMBEDDED PORTIONS OF ANCHOR BOLTS, SHALL BE GIVEN ONE SHOP COAT OF PAINT AS PER ITEM S-7 BUT NEED NOT BE GIVEN THE FIELD COATS CALLED FOR IN ITEM S-7.

PILES SHALL BE 14" STEEL H073#. THE PILES FOR THE NORTH ABUTMENT SHALL BE DRIVEN TO A REQUIRED CAPACITY OF 65 TONS AND SHALL HAVE A MINIMUM PENETRATION OF 50 FT. THE PILES FOR PIERS 6 AND 7 SHALL BE DRIVEN TO ROCK AND TO A REQUIRED CAPACITY OF 65 TONS. THE PILES FOR THE SOUTH ABUTMENT SHALL BE DRIVEN TO ROCK AND TO A REQUIRED CAPACITY OF 45 TONS.

STONE FACING
A. STONE FACING FOR UPPER PARTS OF PIERS 3 AND 6 AND FOR HANDRAIL TERMINAL POSTS AT ABUTMENTS SHALL BE DURABLE, SOUND, INDIANA LIMESTONE OR EQUAL, OF UNIFORM QUALITY, STRUCTURE AND TEXTURE. ALL STONE SHALL BE OF A QUALITY ACCEPTABLE TO THE ENGINEER.
B. THE CONTRACTOR SHALL SUBMIT TO THE ENGINEER TWO SAMPLES ABOUT 4 IN. BY 7 IN., 1 IN. THICK, TYPICAL OF THE EXTREMES OF COLOR AND TEXTURE WHICH SHALL BE FURNISHED. THE LARGE FACES SHALL SHOW ACROSS THE GRAIN OF THE STONE AND SHALL SHOW THE FINISH SPECIFIED; TWO EDGES SHALL BE ROCK FACE. SAMPLES SHALL BE CLEARLY MARKED WITH THE CONTRACTOR'S NAME, GRADE OF STONE AND NAME OF JOB.
C. THE CONTRACTOR SHALL PREPARE ALL WORKING DRAWINGS FOR CUT STONE. THESE SHALL INCLUDE ALL WORKING DRAWINGS NECESSARY SUPPLEMENTARY TO THE DESIGN PLANS TO ENABLE THE CONTRACTOR TO CONSTRUCT THE WORK, INCLUDING ANY FULL-SIZE DRAWINGS NEEDED, WITH COMPLETE CUTTING AND SETTING DIAGRAMS FOR ALL STONEMARK, SHOWING SIZES, SECTIONS, DIMENSIONS OF STONE, ARRANGEMENTS OF JOINTS, BOLTS, ANCHORAGE AND OTHER DETAILS, AND THE NECESSARY MARKING OF STONES FOR IDENTIFICATION.
D. ALL STONE SHALL BE CUT ACCURATELY TO SHAPE AND DIMENSIONS FULL TO THE SQUARE, WITH APPROVED JOINTING. EXPOSED FACES SHALL BE CUT TRUE AND OUT OF WIND. JOINTS SHALL BE UNIFORMLY 3/8 IN. THICK. THERE SHALL BE NO PATCHING OR HIDING OF DEFECTS, AND LEWIS HOLES SHALL NOT BE IN EXPOSED SURFACES. PROVISIONS FOR ANCHORING, DOWELING AND CRAMPING SHALL BE AS INDICATED ON THE PLANS, SUPPLEMENTED BY ADDITIONAL PARTS AS NECESSARY IN KEEPING WITH STANDARD PRACTICE AND SHALL BE FULLY SHOWN ON THE WORKING DRAWINGS. HOLES AND SINKAGES SHALL BE CUT FOR ALL ANCHORS, DOWELS AND CRAMPS.
E. THE FINISH ON EXPOSED SURFACES GENERALLY SHALL BE SMOOTH, MACHINE-DRESSED, SHOWING NO TOOL MARKS. LEWIS HOLES SHALL BE PROVIDED IN ALL STONES WEIGHING MORE THAN 100 LBS. NO HOLES SHALL COME CLOSER THAN 2-1/2 IN. TO THE EXPOSED FACE OF THE STONE. EACH STONE, AS NECESSARY, SHALL HAVE ON THE BACK OR BED A NUMBER MARKED WITH NON-STAINING PAINT, CORRESPONDING TO THE MARKING ON THE WORKING DRAWING.
F. STONE SHALL BE CAREFULLY PACKED FOR TRANSPORTATION. STONE SHIPPED BY RAIL SHALL BE UNLOADED AND DELIVERED AT THE SITE WITH CARE, HANDLED THROUGHOUT BY COMPETENT WORKMEN AND BY SUCH METHODS AS WILL AVOID SOILING, MUTILATION, CHIPPING OR OTHER DAMAGE. STONE SHALL BE STORED AT THE SITE ON

PLANKS CLEAR OF THE GROUND, PROTECTED FROM DAMAGE BY DIRT, DUST, MUD, GREASE OR OTHER STAINING OR DISFIGURING ELEMENTS.

G. STONE SHALL BE SET IN CAREFULLY PREPARED CEMENT MORTAR CONFORMING TO THE REQUIREMENTS OF ARTICLE S-21.03 OF THE SPECIFICATIONS. MORTAR SHALL BE MIXED ONLY IN SUCH QUANTITIES AS ARE NEEDED FOR IMMEDIATE USE. NO RE-TEMPERING WILL BE PERMITTED; MORTAR MIXED FOR A PERIOD EXCEEDING THIRTY MINUTES SHALL NOT BE USED BUT MUST BE THROWN OUT. SAND SHALL MEET THE REQUIREMENTS OF SEC. M-2.2 OR SEC. M-2.3 OF THE SPECIFICATIONS, AND, IF CONTAINING COARSE MATERIAL THAT WOULD INTERFERE WITH PROPER JOINTING, SHALL BE SCREENED.

H. STONES SHALL BE SET IN ACCORDANCE WITH THE PLANS. BEFORE SETTING EACH STONE SHALL BE WASHED CLEAN ON ALL SIDES BY SCRUBBING WITH SOAP POWDER AND WATER APPLIED WITH FIBER BRUSH AND RINSED WITH CLEAN WATER. IMMEDIATELY PRIOR TO SETTING, EACH STONE SHALL BE AGAIN SPONGED AND DRENCHED ON ALL SIDES WITH CLEAN WATER. STONES SHALL BE SET ACCURATELY TRUE TO LINE AND LEVEL BY COMPETENT STONE SETTERS, WITH FULL FLUSHED JOINTS, FILLING ALL ANCHOR HOLES. THE FACES SHALL BE SET ON THOROUGHLY SOAKED WOODEN WEDGES WHICH SHALL REMAIN IN PLACE UNTIL THE WORK IS CLEANED AND POINTED. MORTAR SHALL BE RAKED OUT 3/4 IN. TO ALLOW FOR POINTING, AND STONE SPONGED OFF ALONG JOINTS. SPLASHING EXPOSED FACES WITH MORTAR SHALL BE AVOIDED, AND ANY SPLASHING SHALL BE IMMEDIATELY REMOVED WITH SPONGE AND CLEAN WATER. WHERE STONES ARE TO BE BACKED, THE ENTIRE BACKS WHILE WET SHALL BE PLASTERED WITH 1/2 IN. OF MORTAR. ALL DOWELS, CRAMPS AND ANCHORS SHALL BE OF BRASS, OR HOT-DIP GALVANIZED (2 OUNCES PER SQUARE FOOT) WROUGHT IRON OR OF CADMIUM PLATED WROUGHT IRON WITH PLATING .0005 IN. THICK.

I. ALL FACE JOINTS AND ALL JOINTS IN TOP STONES SHALL BE BRUSHED OUT CLEAN 3/4 IN. DEEP AND WEDGES CAREFULLY REMOVED. AFTER THOROUGH WETTING, ALL JOINTS SHALL BE POINTED WITH MORTAR CONSISTING OF ONE PART STAINLESS CEMENT, TWO PARTS CLEAN WHITE SAND AND SUFFICIENT COLD LIME PUTTY TO MAKE AS STIFF A MIXTURE AS CAN BE WORKED. THE FACE OF ALL STONE SHALL BE THOROUGHLY CLEANED UPON COMPLETION WITH SOAP POWDER BOILED IN WATER AND APPLIED VIGOROUSLY WITH STIFF FIBER BRUSHES. IF NECESSARY, CLEAN SHARP WHITE SAND MAY BE ADDED TO THE SOAP MIXTURE. AFTER CLEANING, ALL SURFACES SHALL BE DRENCHED WITH CLEAR WATER. WIRE BRUSHES AND ACIDS SHALL NOT BE USED.

J. PAYMENT FOR STONE FACING SHALL BE MADE AT THE CONTRACT UNIT PRICE PER CUBIC FOOT BID FOR ITEM S-21, STONE FACING FOR PIER PYLONS AND ABUTMENT TERMINAL POSTS.

DRAINAGE TUBES SHALL BE PLACED THROUGH THE ABUTMENT SLABS, ALONG THE CURBS, AS DESCRIBED IN SEC. S-29.07, TO PROVIDE SUB-DRAINAGE FOR THE ASPHALTIC CONCRETE SURFACE COURSE THAT WILL BE PLACED LATER. METAL TUBES SHALL ALSO BE INSTALLED IN THE CONCRETE FOR DRAINAGE OF CURB POST RECESSES IN ABUTMENTS AND BEARING RECESSES AT PIERS 4 AND 5. PAYMENT FOR METAL TUBES SHALL BE CONSIDERED INCLUDED IN THE PRICE BID FOR CONCRETE.

BEARING RECESSES ON PIERS 4 AND 5 WILL LATER BE FILLED WITH CONCRETE BY THE CONTRACTOR FOR THE SUPERSTRUCTURE.

RELOCATION OF PIPE AT SOUTH ABUTMENT
AN EXISTING 15-IN. DIA. DRAIN PIPE SERVING A CATCH BASIN IN ADAMS STREET INTERFERES WITH CONSTRUCTION OF THE SOUTH ABUTMENT. THIS PIPE SHALL BE TAKEN UP AND REPLACED FROM THE CATCH BASIN IN THE NORTH CURB OF ADAMS STREET IN A NORTHERLY DIRECTION TO DISCHARGE ON THE SLOPE AT APPROXIMATELY THE TOE OF NEW EMBANKMENT, ACCORDING TO LINE AND GRADE ESTABLISHED BY THE ENGINEER. PAYMENT WILL BE MADE UNDER ITEM E-12, 15" PIPE REMOVED AND DISPOSED OF; AND ITEM I-2, 15" PIPE FOR STORM SEWER.

WELDING SHALL BE CLASS A.

CONDUITS AND BOXES FOR LIGHTING
CONDUITS AND JUNCTION BOXES FOR LIGHTING SHALL CONFORM TO THE REQUIREMENTS OF ITEM S-25.08 OF THE SPECIFICATIONS. PAYMENT THEREFOR SHALL BE MADE UNDER THE PRICE BID FOR ITEM S-25, CONDUITS AND BOXES FOR LIGHTING.

FOOTING ELEVATIONS
ELEVATIONS OF BOTTOMS OF FOOTINGS WHICH REST ON ROCK ARE SUBJECT TO CHANGE WHEN EXCAVATIONS ARE MADE AND ACTUAL ELEVATIONS OF TOP OF SOUND ROCK DETERMINED. ALL SUCH FOOTINGS SHALL EXTEND AT LEAST 3 IN. INTO SOUND ROCK.

COPPER WATER STOPS
PAYMENT FOR COPPER WATER STOPS AND BITUMINOUS PREMOLDED JOINT FILLER IN JOINTS OF THE SOUTH ABUTMENT SHALL BE CONSIDERED INCLUDED IN THE PRICE BID FOR CONCRETE.

EXISTING BUILDINGS ON THE VIADUCT RIGHT-OF-WAY WILL BE REMOVED BY OTHERS TO THE LEVEL OF EXISTING GROUND, AND BASEMENTS SHALL, IF SO DIRECTED BY THE ENGINEER, BE FILLED BY THE CONTRACTOR WITH COMPACTED EMBANKMENT MATERIAL; PAYMENT FOR WHICH WILL BE MADE UNDER ITEMS E1 AND E4.

SURFACE FINISH OF CONCRETE
A RUBBED SURFACE FINISH SHALL BE APPLIED TO THE FACES OF THE CURBS, AND TO THEIR HORIZONTAL SURFACES FOR A DISTANCE OF 11" FROM FACE OF CURB; ALSO TO THE FACES OF THE ABUTMENT WINGWALLS EXPOSED TO VIEW. ALL OTHER ABUTMENT AND PIER SURFACES EXPOSED TO VIEW, EXCEPT SIDEWALKS AND ROADWAY HEADERS, SHALL BE GROUT CLEANED AS PER ITEM S-1.22, AND SHALL ALSO BE FORMED WITH FORM LINER.

FOUNDATION SOUNDINGS
FOUNDATION DESIGN AND FOUNDATION QUANTITIES ARE BASED ON A STUDY OF ROD SOUNDINGS AND SOIL SAMPLING SOUNDINGS MADE AT THE SITE. THIS SOUNDING INFORMATION MAY BE INSPECTED IN THE OFFICE OF THE BUREAU OF BRIDGES IN COLUMBUS OR IN AN ABRIDGED FORM IN THE DIVISION OFFICE, BUT THE STATE ASSUMES NO RESPONSIBILITY FOR THE ACCURACY THEREOF.

PART I

STATE OF OHIO
DEPARTMENT OF HIGHWAYS

AKRON EXPRESSWAY SYSTEM
(EAST MARKET STREET TO EAST CUYAHOGA FALLS AVENUE)
MAIN VIADUCT
BRIDGE NO. SU-5-124


NOTES

AKRON, SUMMIT COUNTY, OHIO


SCALE..... HOWARD, NEEDLES, TAMMEN & BERGENDOFF
MADE 10/11/50 DATE..... CONSULTING ENGINEERS
TRCD 11/6 DATE 12/21/50 KANSAS CITY NEW YORK
CHKD..... DATE..... 766 SHEET V 5

Rev. 1/18/50
Rev. 1/27/50 Rev. 2/2/50


SUMMIT COUNTY
CITY OF AKRON
AKRON EXPRESSWAY SYSTEM
MAIN VIADUCT
SUM-5-12.31

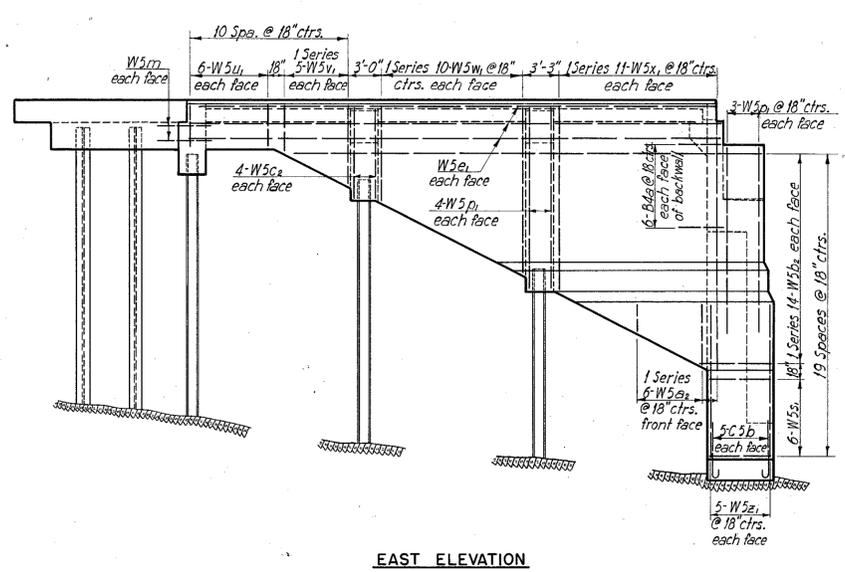


EAST ELEVATION

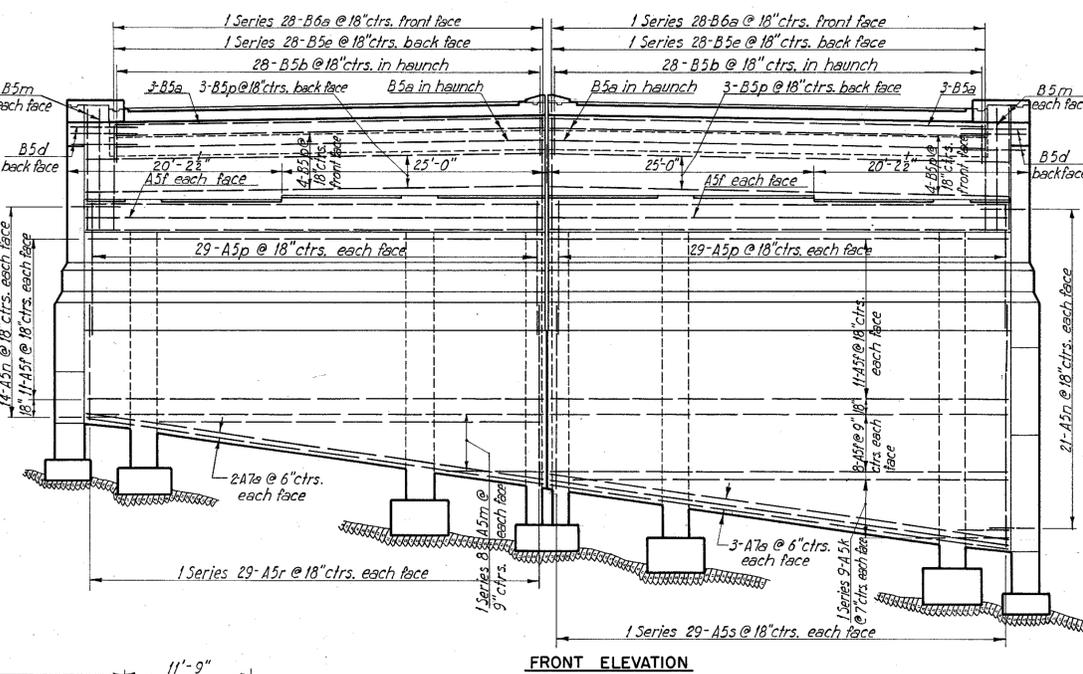


FRONT ELEVATION

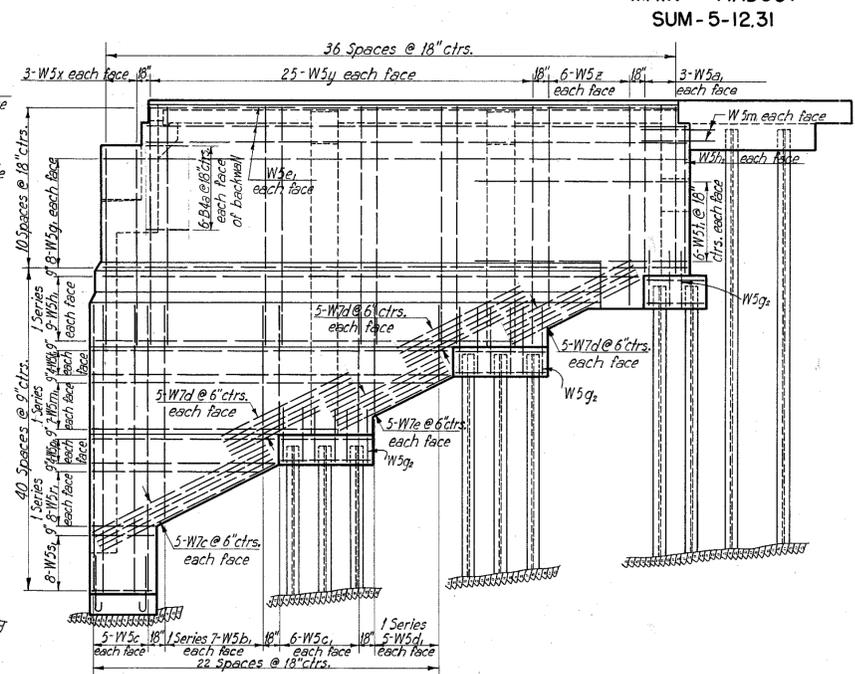

WEST ELEVATION

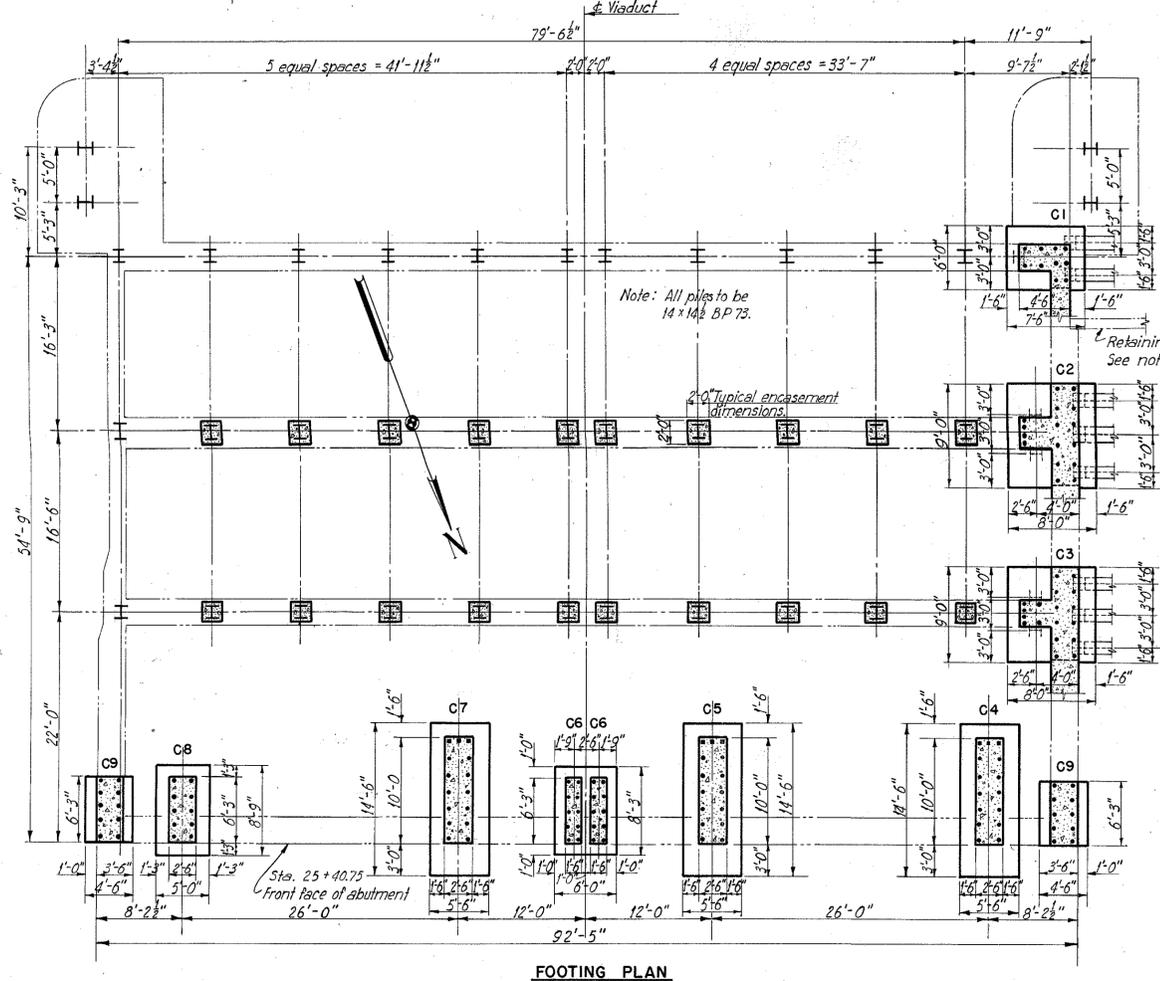

FOOTING PLAN

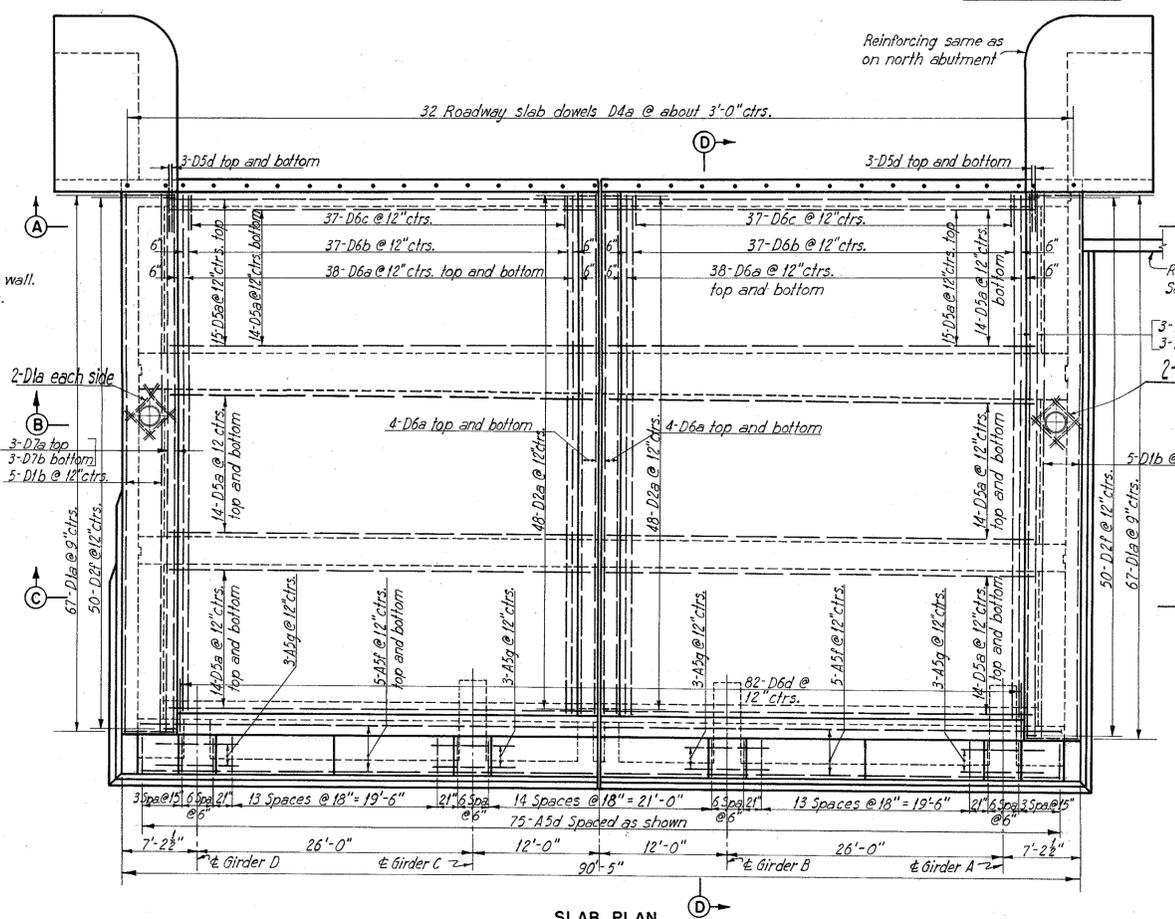

SLAB PLAN

Notes:
For details, footing and pile plan of retaining wall see Sheet 8.
For details of end post footing see Sheet 10.
For sections A-A and B-B see Sheet 8.
For sections C-C and D-D see Sheet 9.

PART I

STATE OF OHIO
DEPARTMENT OF HIGHWAYS

AKRON EXPRESSWAY SYSTEM
(EAST MARKET STREET TO EAST GUYAHOGA FALLS AVENUE)

MAIN VIADUCT
BRIDGE NO. SU-5-124


SOUTH ABUTMENT

AKRON, SUMMIT COUNTY, OHIO


SCALE: A=1"=0'... HOWARD, NEEDLES, TAMMEN & BERGENDOFF
MADE B.R.M. DATE 8-27-49 CONSULTING ENGINEERS
TRCD. B.P. DATE 10-18-49 KANSAS CITY NEW YORK
CHKD. R.Q.D. DATE 10-8-49 766 SHEET V7

FED. ROAD DIV. NO.	STATE	FED. AID PROJ. NO.	TYPE FUNDS	8
2	OHIO	U-687(6)	POST WAR	34

SUMMIT COUNTY CITY OF AKRON
AKRON EXPRESSWAY SYSTEM
 MAIN VIADUCT
 SUM-5-12.31


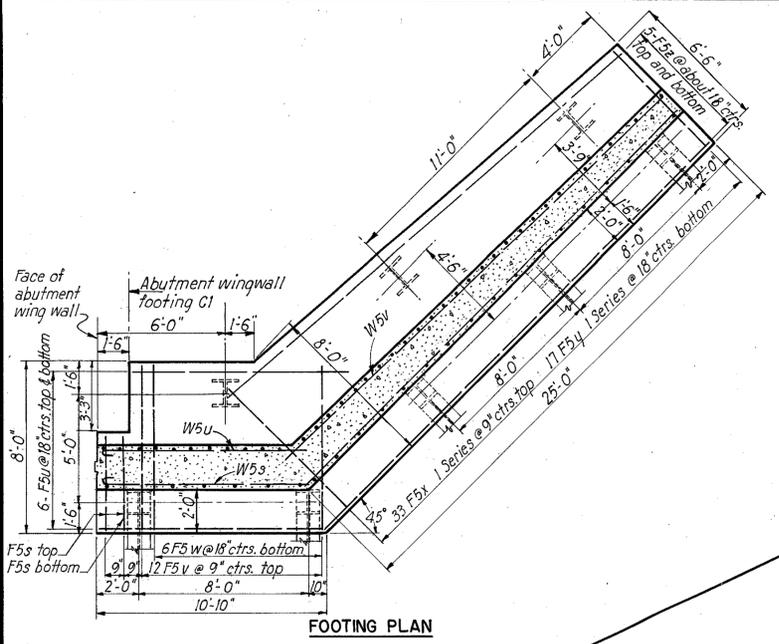


FOOTING PLAN

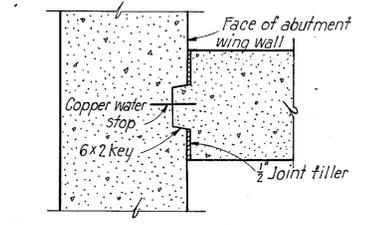


DETAIL AT ABUTMENT END OF WALL
 Scale: 1/4"=1'-0"


Note: Median strip to be placed by superstructure contractor. Stirrups to be placed by substructure contractor.

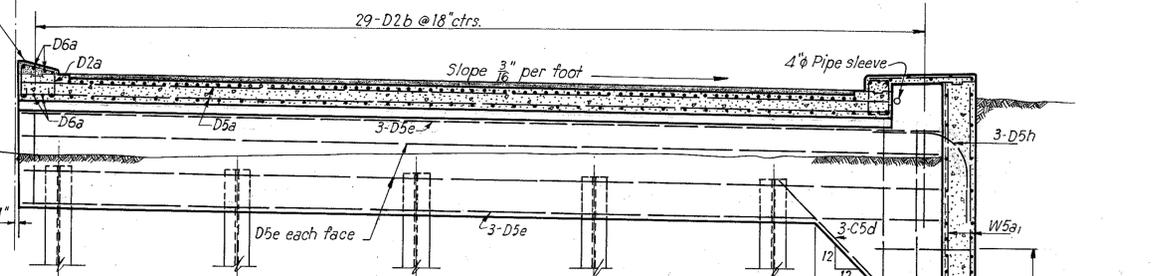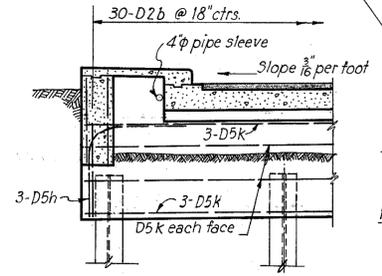

SECTION A-A

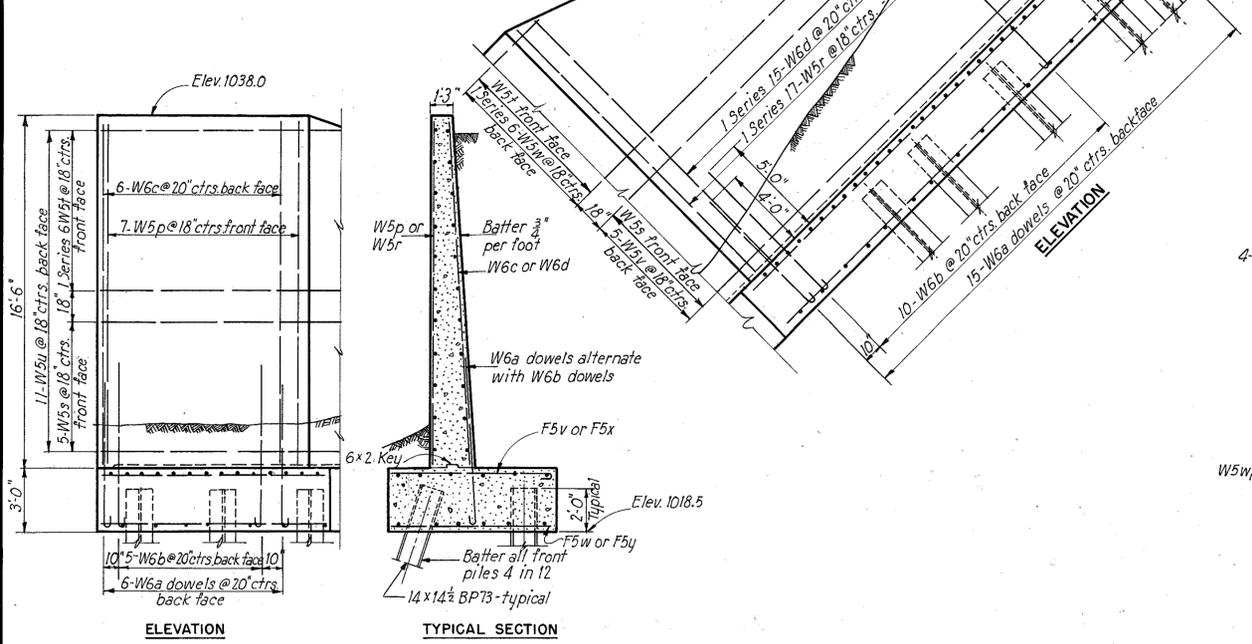


RETAINING WALL DETAILS
 Scale: 3/4"=1'-0"

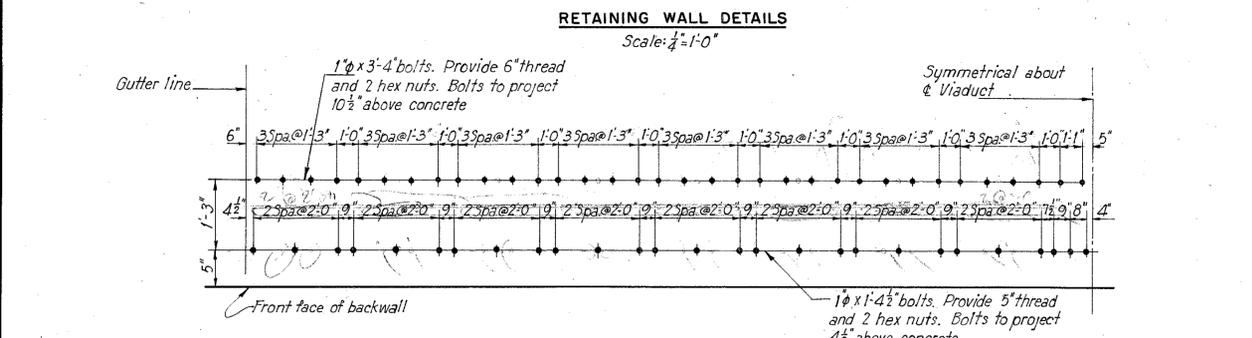


ANCHOR BOLT PLAN FOR EXPANSION CASTINGS
 No scale
 For both abutments.

Note:-- Before placing anchor bolts, verify number and spacing by referring to Expansion Casting Details on plans for Part 2 of this project.

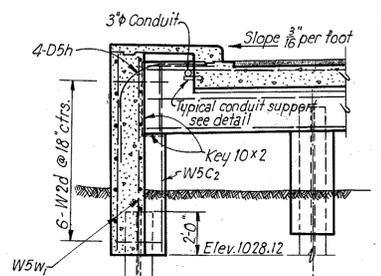


TYPICAL PILE ENGAGEMENT

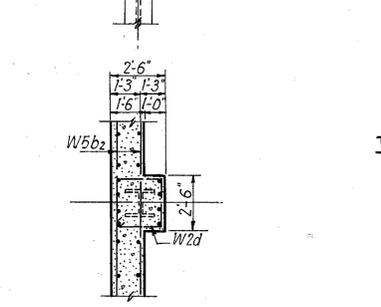


ALTERNATE PILE ENGAGEMENT


Beam is symmetrical about the viaduct except as shown at junction with wingwalls.

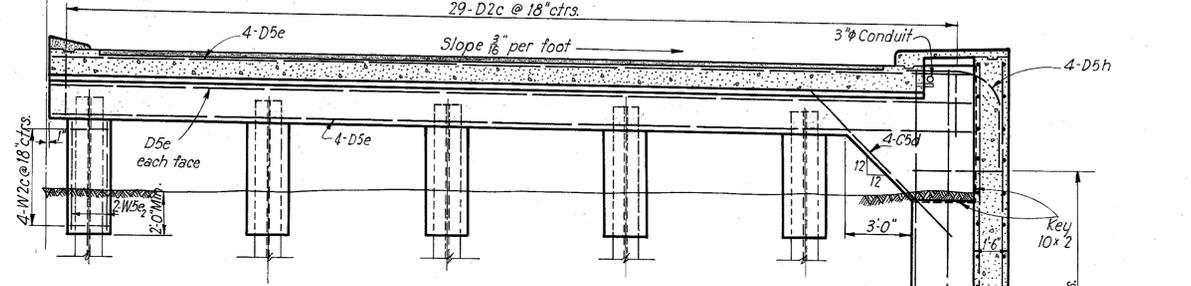


SECTION B-B

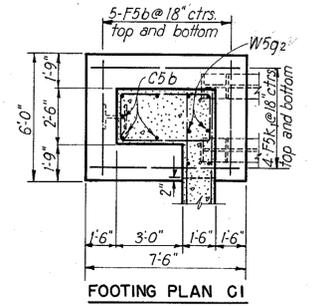


FOOTING PLAN C1

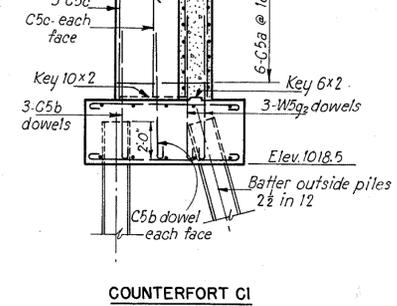

COUNTERFORT C1

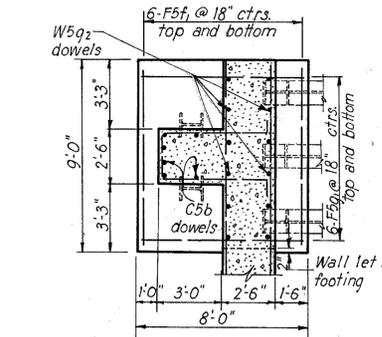

FOOTING PLAN C2
 Footing plan C3 similar

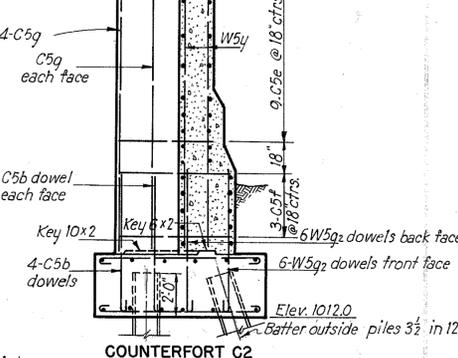

COUNTERFORT C2

PART I

STATE OF OHIO
 DEPARTMENT OF HIGHWAYS

AKRON EXPRESSWAY SYSTEM
 (EAST MARKET STREET TO EAST CUYAHOGA FALLS AVENUE)

MAIN VIADUCT
 BRIDGE NO. SU-5-124

SOUTH ABUTMENT

AKRON, OHIO
 SUMMIT COUNTY, OHIO

SCALE 3/4"=1'-0"
 MADE J.T. DATE 9-26-49
 TRCD 116 R.R. DATE 10-12-49
 CHKD. R.Q.P. DATE 10-20-49


HOWARD, NEEDLES, TAMMEN & BERGENDORF
 CONSULTING ENGINEERS
 KANSAS CITY NEW YORK

766 SHEET V8


Rev. 1/18/50
 Rev. 1/27/50

FED. ROAD DIV. NO.	STATE	FED. AID PROJ. NO.	TYPE FUNDS	9
2	OHIO	U-687 6	POST WAR	34


SUMMIT COUNTY
 CITY OF AKRON
AKRON EXPRESSWAY SYSTEM
 MAIN VIADUCT
 SUM-5-12.31

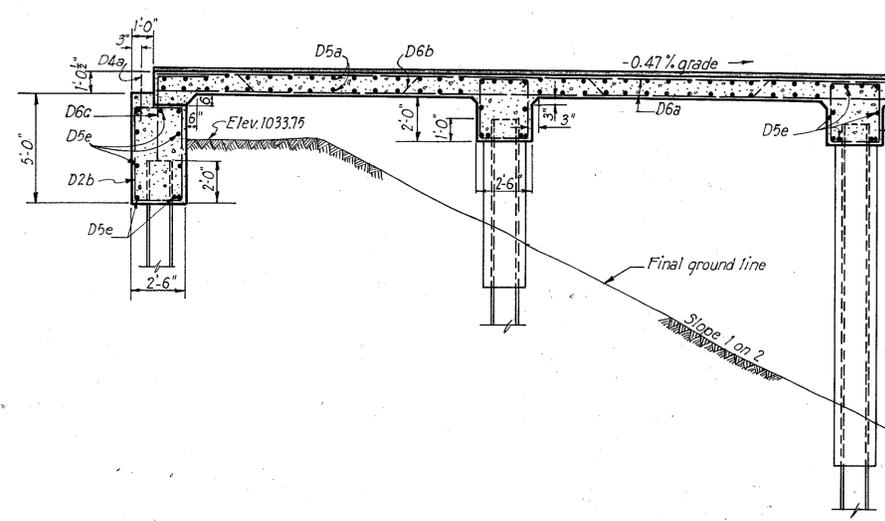


SECTION D-D

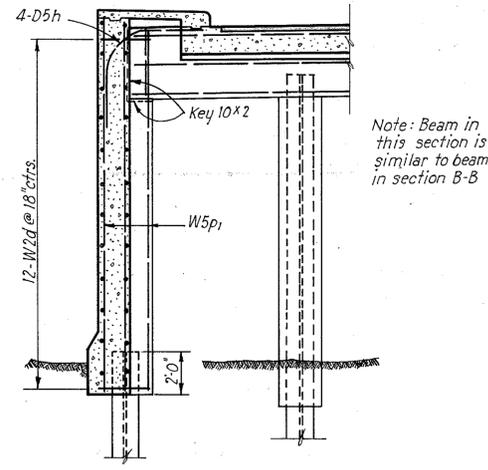

SECTION C-C

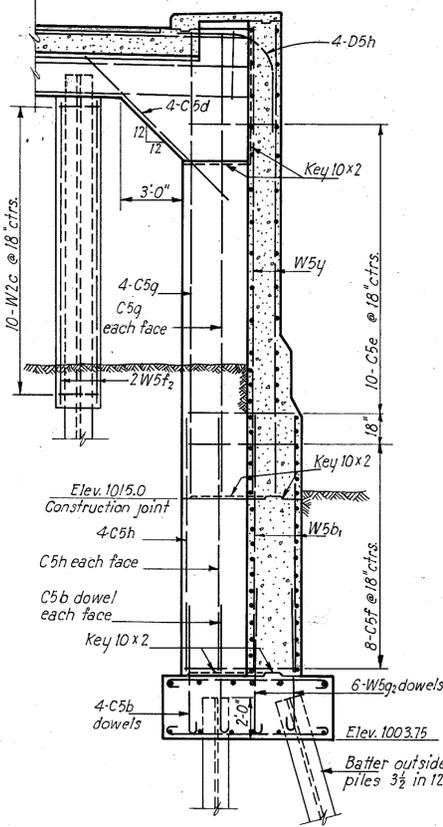


COUNTERFORT C3
Footing plan similar to C2

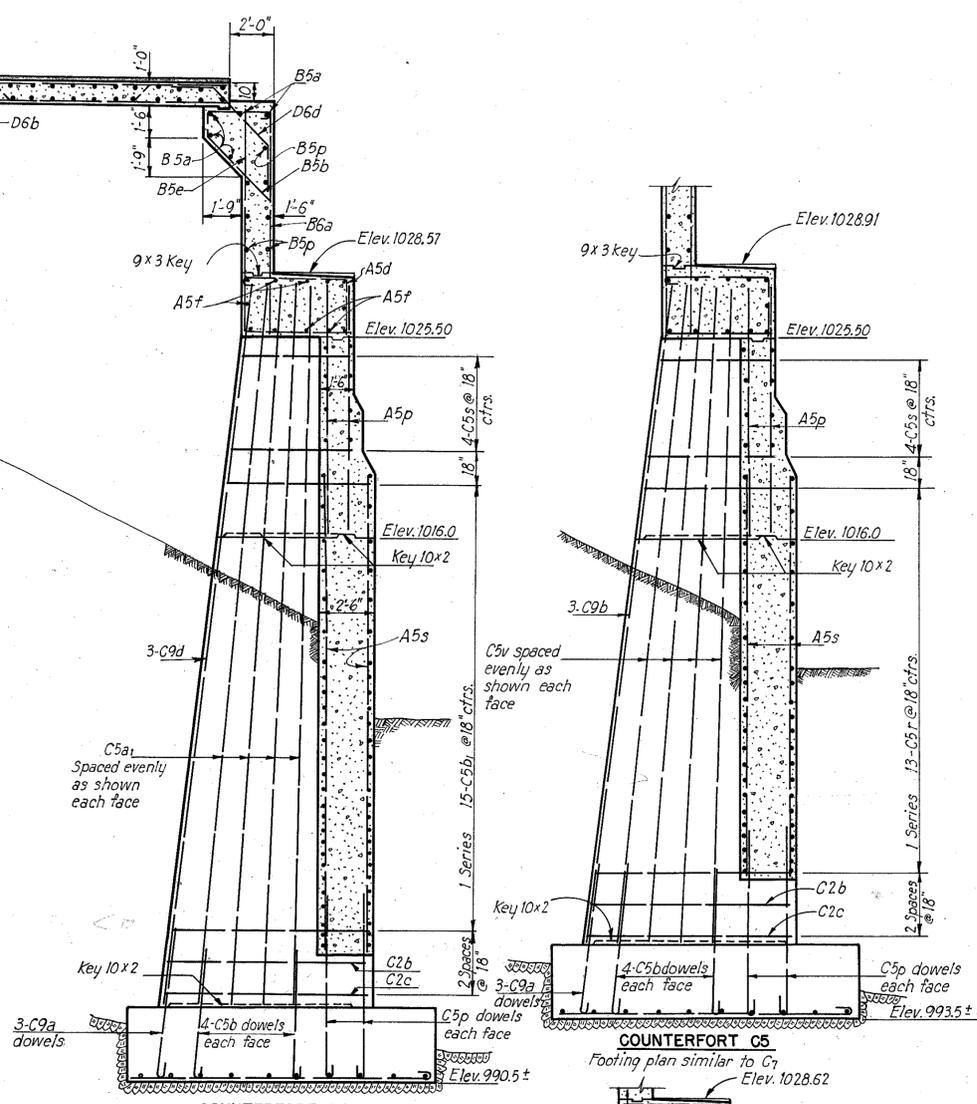


COUNTERFORT C4
Footing plan similar to C7


COUNTERFORT C5
Footing plan similar to C7

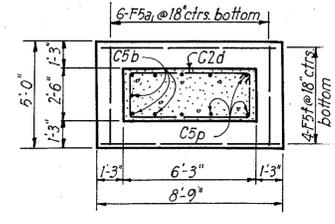


FOOTING PLAN C8

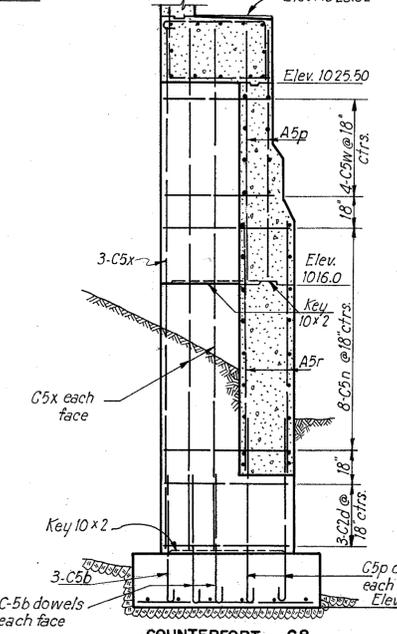


COUNTERFORT C8

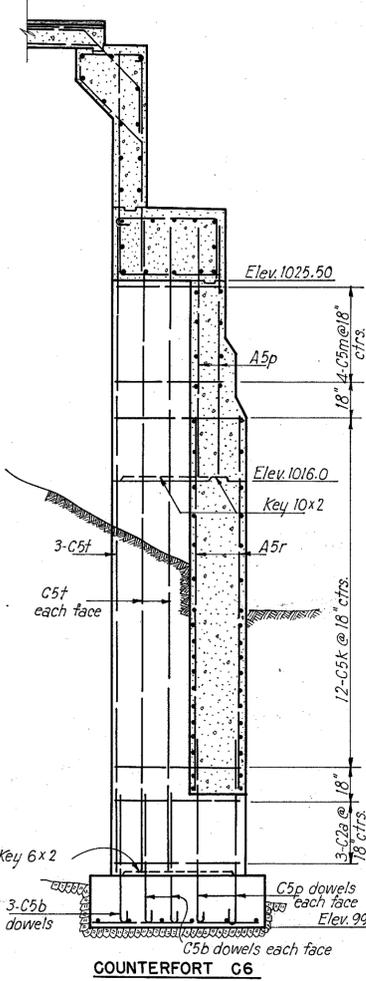


COUNTERFORT C6

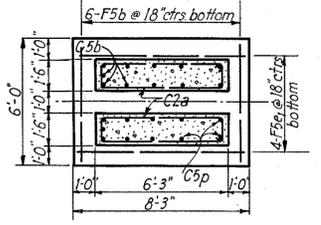

FOOTING PLAN C6

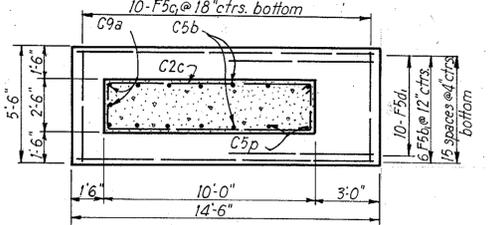

FOOTING PLAN C7
Footing plans C4 and C5 similar

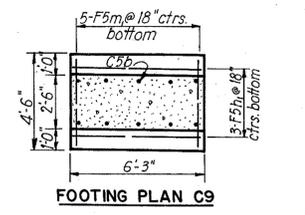


FOOTING PLAN C9

PART I
 STATE OF OHIO
 DEPARTMENT OF HIGHWAYS
AKRON EXPRESSWAY SYSTEM
 (EAST MARKET STREET TO EAST CUYAHOGA FALLS AVENUE)
MAIN VIADUCT
 BRIDGE NO. SU-5-124
SOUTH ABUTMENT
 AKRON, OHIO
 SUMMIT COUNTY, OHIO
 SCALE 1/2" = 1'-0"
 HOWARD, NEEDLES, TAMMEN & BERGENDOFF
 MADE J.T. DATE 9-28-49 CONSULTING ENGINEERS
 TRGD:H.G.R. DATE 10-10-49 KANSAS CITY NEW YORK
 CHKD:R.A.R. DATE 10-5-49 766 SHEET V9

145


FED. ROAD DIV. NO.	STATE	FED. AID PROJ. NO.	TYPE FUNDS	10
2	OHIO	U-687(6)	POST WAR	34

SUMMIT COUNTY
CITY OF AKRON
AKRON EXPRESSWAY SYSTEM
MAIN VIADUCT
SUM-5-12.31

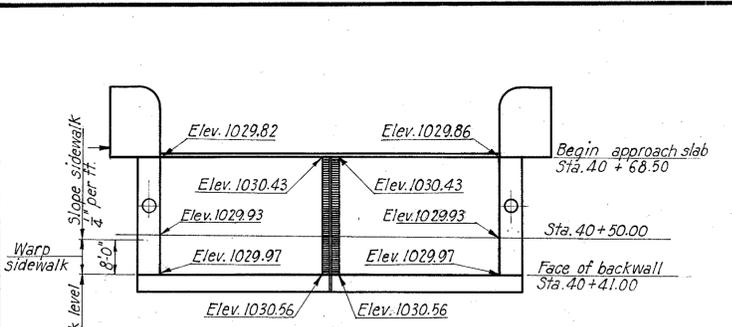


ROADWAY ELEVATIONS

Note: There is a straight line variation between elevations parallel and transverse to ϵ of roadway.

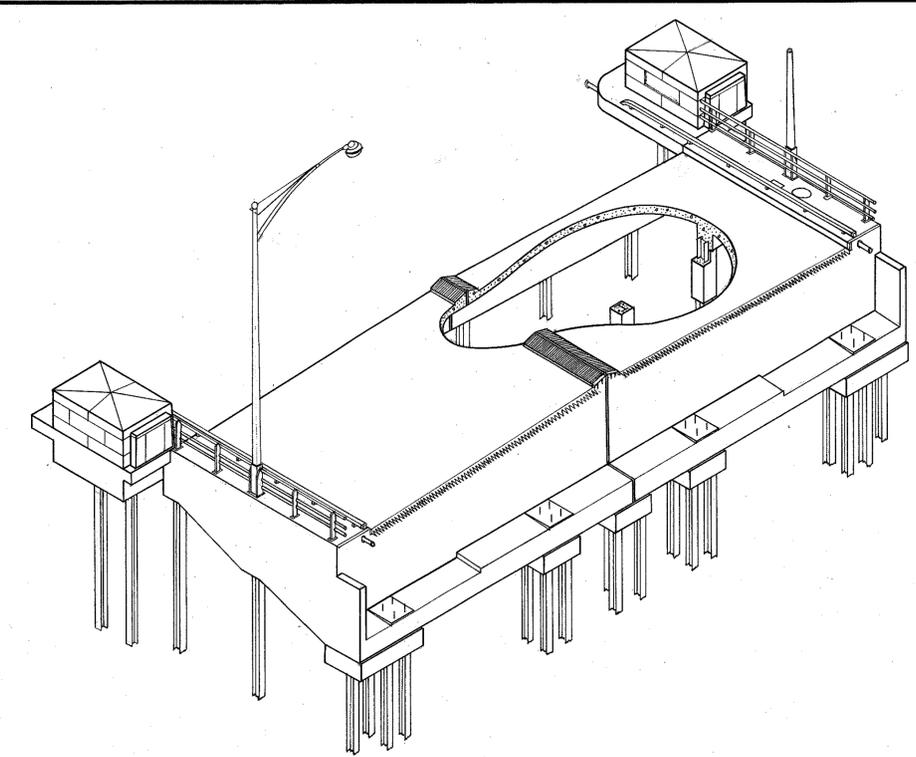


ISOMETRIC VIEW OF ABUTMENT

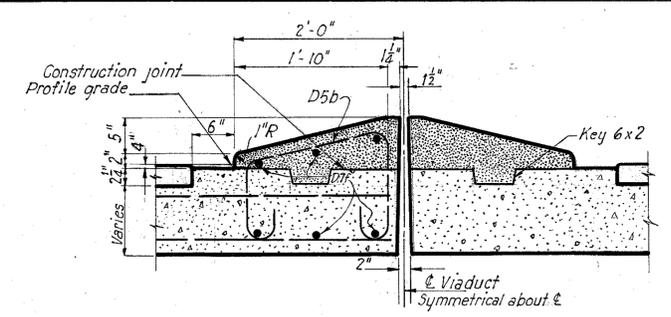


MEDIAN STRIP DETAIL
Scale: 1"=1'-0"

Note: Concrete in median strip above construction joint will be furnished and placed by superstructure contractor. Reinforcing steel shown is for North Abutment only.

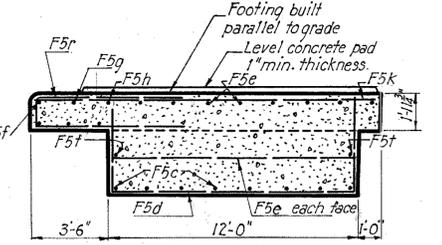


SECTION G-G

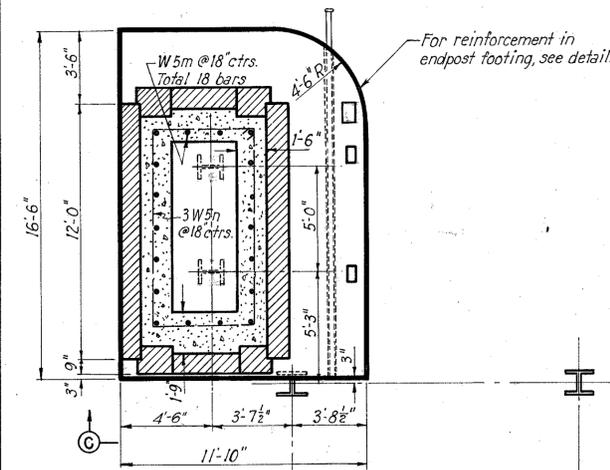

For reinforcement in endpost footing, see detail.


Notes:
All forms and falsework within the abutment shall be removed. Falsework piles, if used, may be cut off flush with finished ground surface.
For details of stone facing, see sheet 22.
For plan of anchor bolts holding expansion castings, see sheet 8.
For Sections B-B and C-C, see sheet 11.

Extend conduit through endpost footing and provide threaded cap

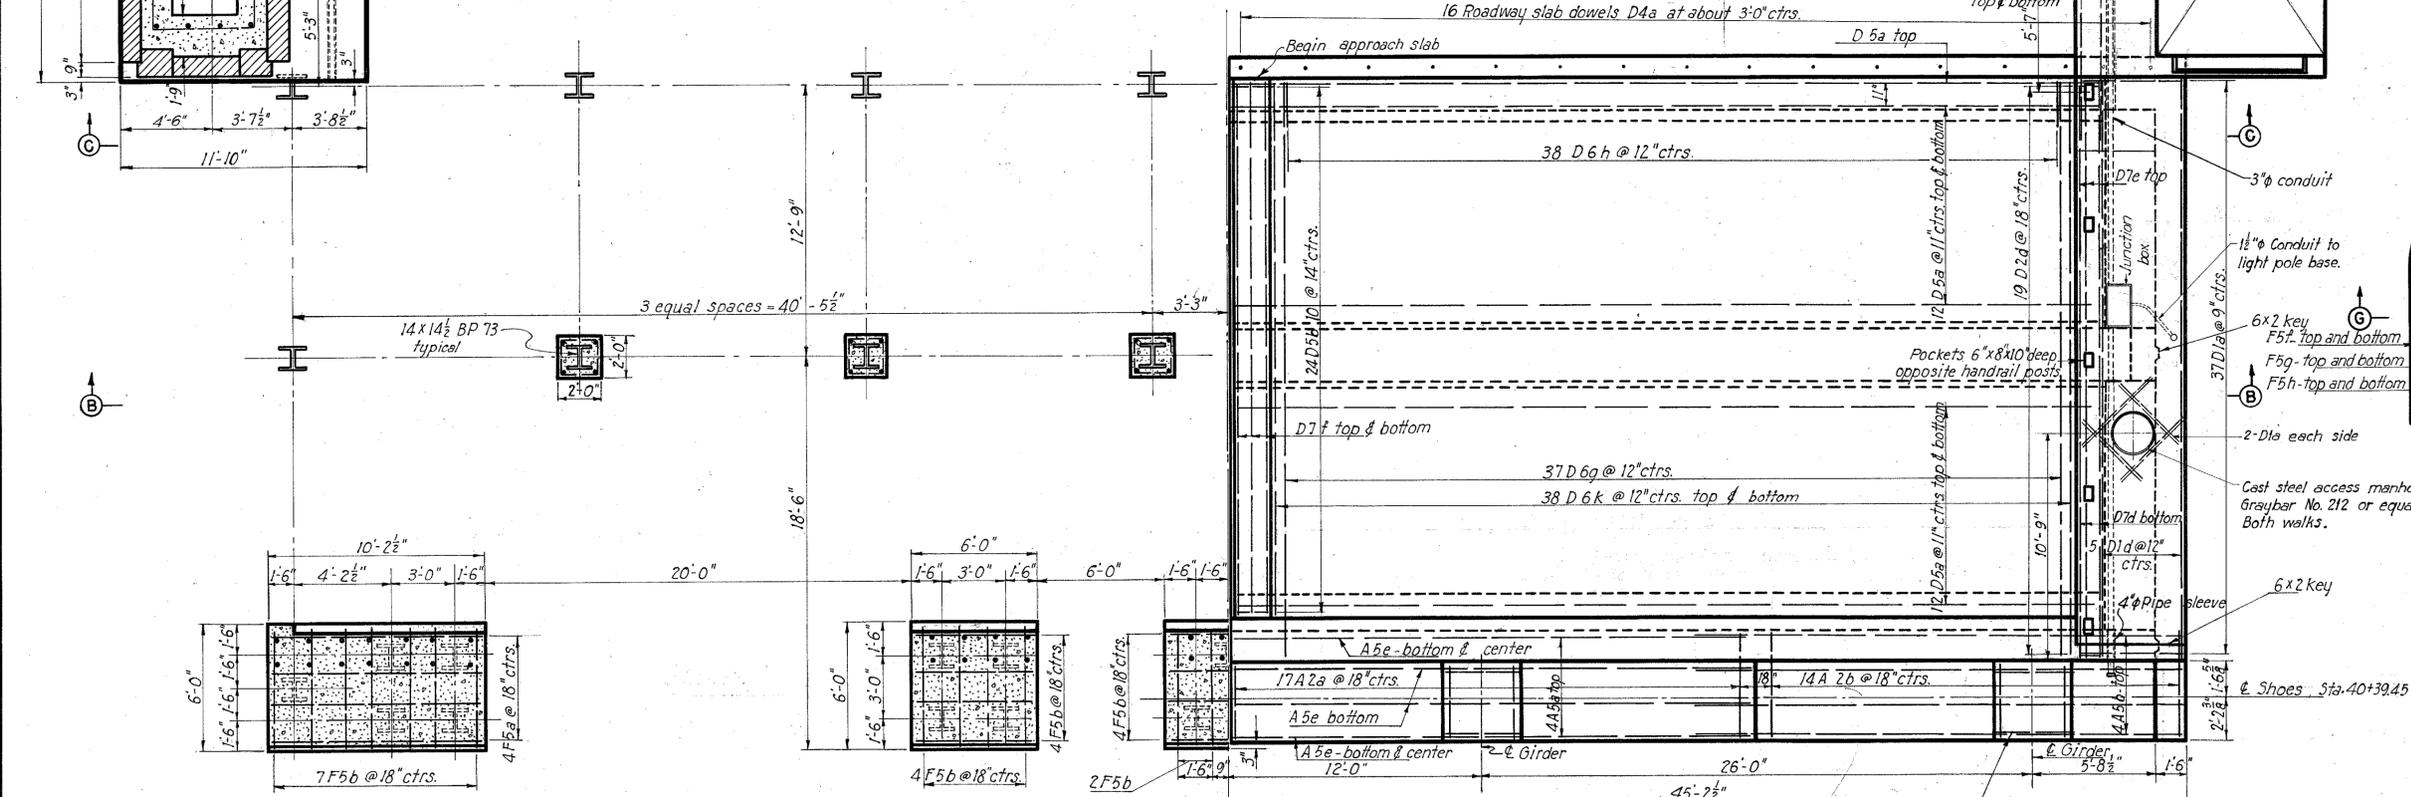


HALF FOOTING PLAN
Scale: 1/4"=1'-0"

HALF SLAB PLAN
Scale: 1/4"=1'-0"

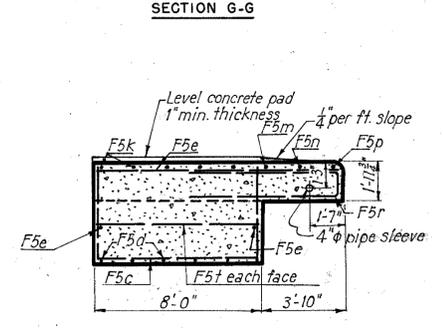

SECTION H-H

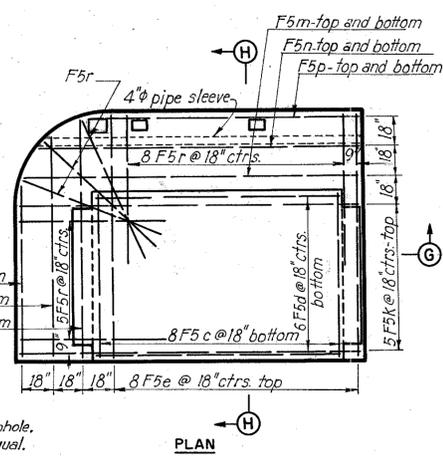

ENDPOST FOOTING DETAIL
Scale: 1/4"=1'-0"

PART I

STATE OF OHIO
DEPARTMENT OF HIGHWAYS

AKRON EXPRESSWAY SYSTEM
(EAST MARKET STREET TO EAST CUYAHOGA FALLS AVENUE)
MAIN VIADUCT
BRIDGE NO. SU-5-124
NORTH ABUTMENT

AKRON, SUMMIT COUNTY, OHIO


SCALE 1/4"=1'-0"
MADE 6-0-49, DATE 5-5-49
TRCD. B.K., DATE 6-30-49
CHKD. C.B., DATE 8-23-49

HOWARD, NEEDLES, TAMMEN & BERGENDOFF
CONSULTING ENGINEERS
KANSAS CITY NEW YORK


766 SHEET V10

FED. ROAD DIV. NO.	STATE	FED. AID PROJ. NO.	TYPE FUNDS	15
2	OHIO	U-6876	POST WAR	34


SUMMIT COUNTY
CITY OF AKRON
AKRON EXPRESSWAY SYSTEM
MAIN VIADUCT
SUM-5-12.31

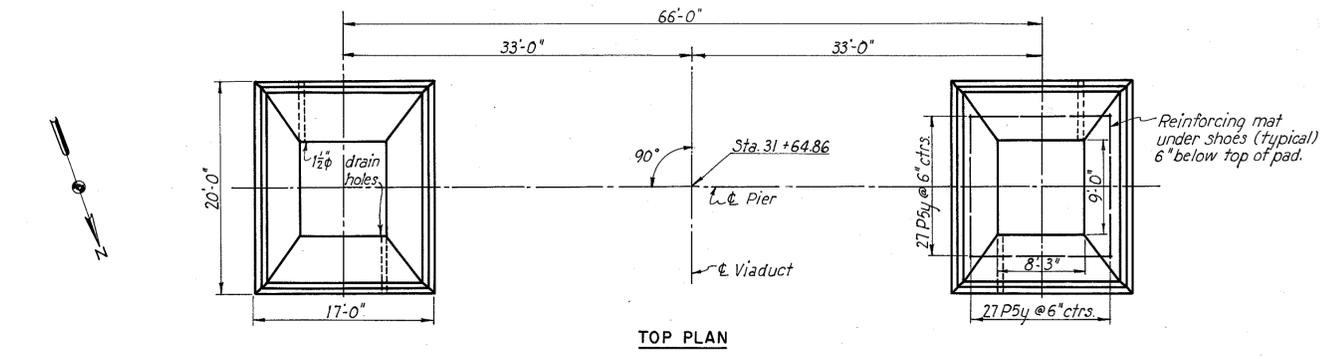


TOP PLAN

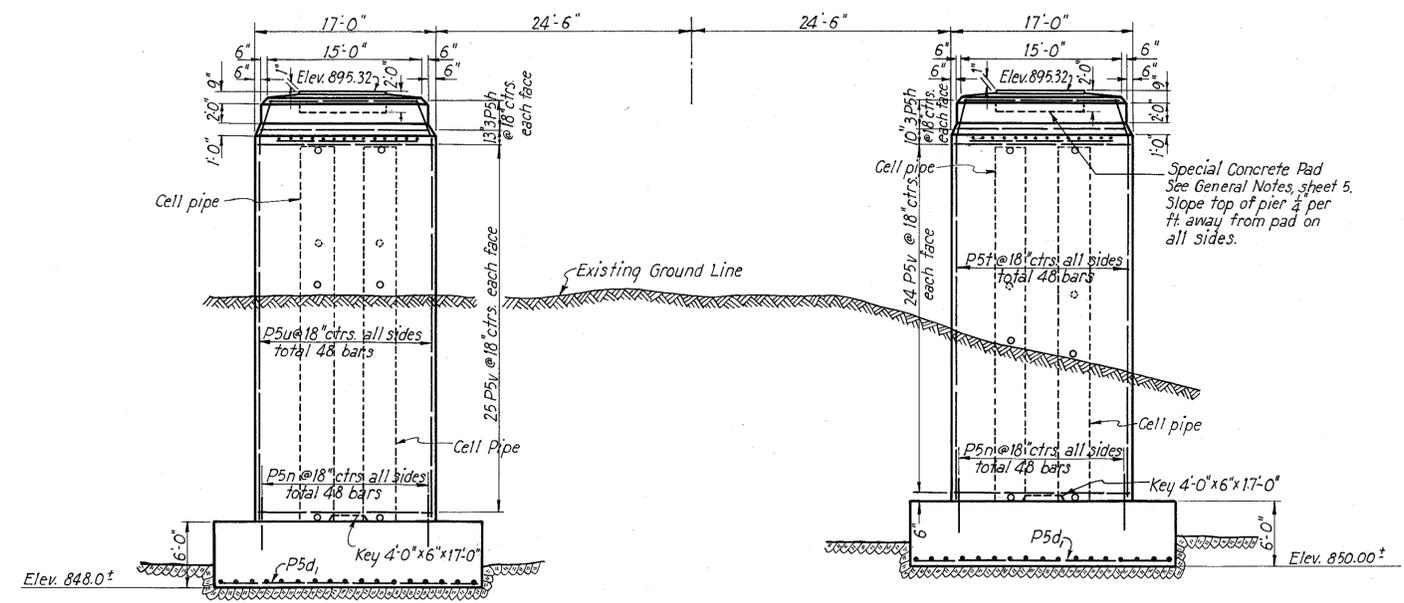


ELEVATION

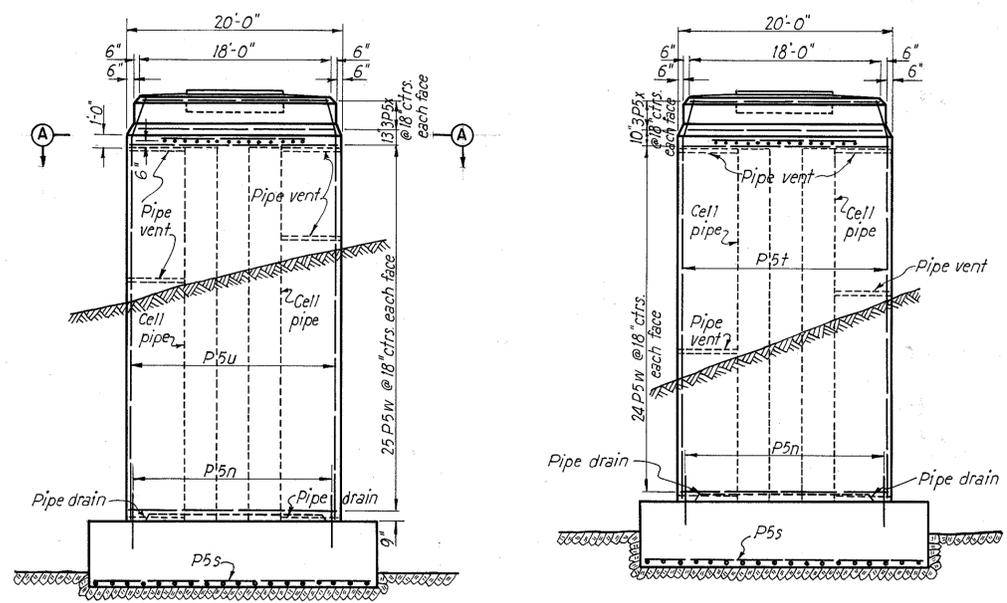

END VIEWS

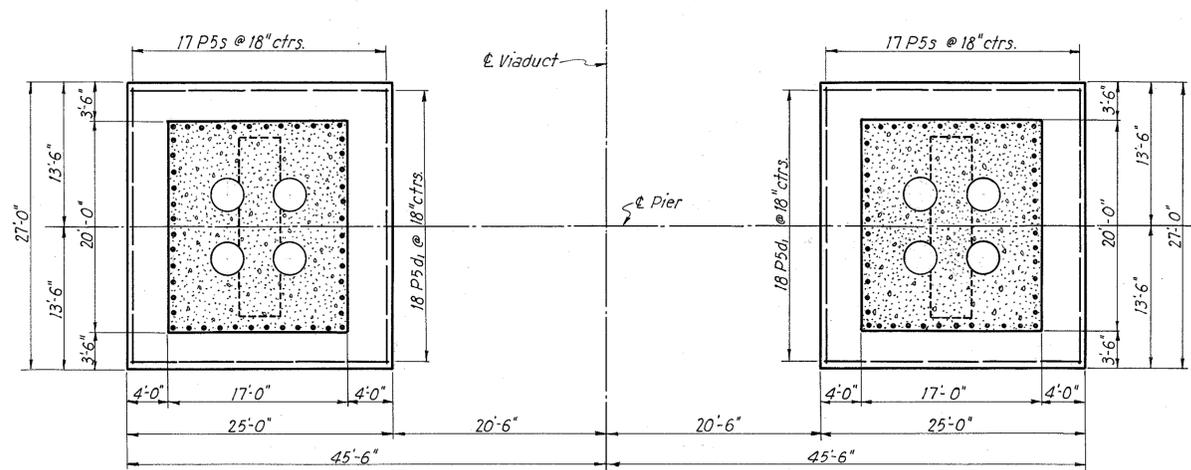

FOOTING PLAN

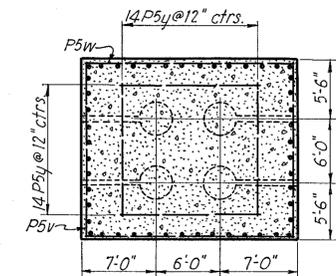

SECTION A-A

Notes:
Cell pipes shall be 36" diameter metal pipe of adequate strength.
A 6" vent shall be located just above ground level and at top of each cell.
A 6" drain shall be located at bottom of each cell.
Vent and drain pipes shall be 6" diameter cement asbestos pipe inserted in openings cut in the cell pipes.
Payment for these cell, vent and drain pipes is included in the price of concrete and deductions will be made from the pier concrete quantities for the volume of encased pipe.

PART I

STATE OF OHIO
DEPARTMENT OF HIGHWAYS

AKRON EXPRESSWAY SYSTEM
(EAST MARKET STREET TO EAST CUYAHOGA FALLS AVENUE)

MAIN VIADUCT
BRIDGE NO. SU-5-124

PIER 4

AKRON, SUMMIT COUNTY, OHIO






SCALE 1/2" = 1'-0"
MADE B.C. DATE 5-13-49
TRCD B.R. DATE 6-14-49
CHKD C.R. DATE 6-8-49

HOWARD, NEEDLES, TAMMEN & BERGENDOFF
CONSULTING ENGINEERS
KANSAS CITY NEW YORK

766 SHEET V15

FED. ROAD DIV. NO.	STATE	FED. AID PROJ. NO.	TYPE FUNDS	16 34
2	OHIO	U-687(6)	POST WAR	

SUMMIT COUNTY
CITY OF AKRON
AKRON EXPRESSWAY SYSTEM
MAIN VIADUCT
SUM-5-12.31

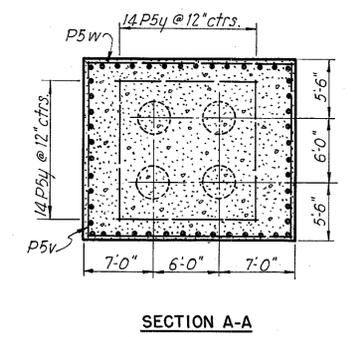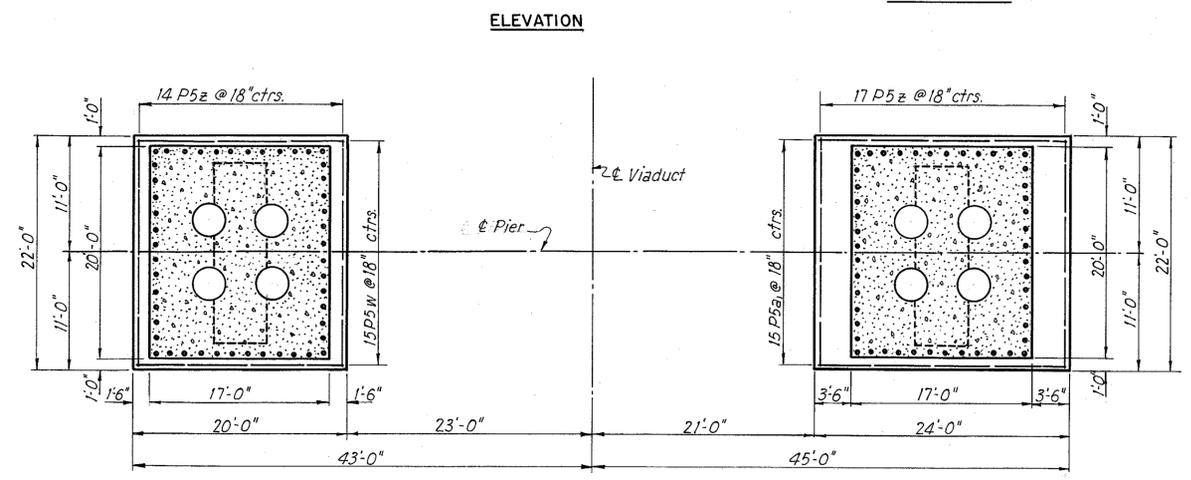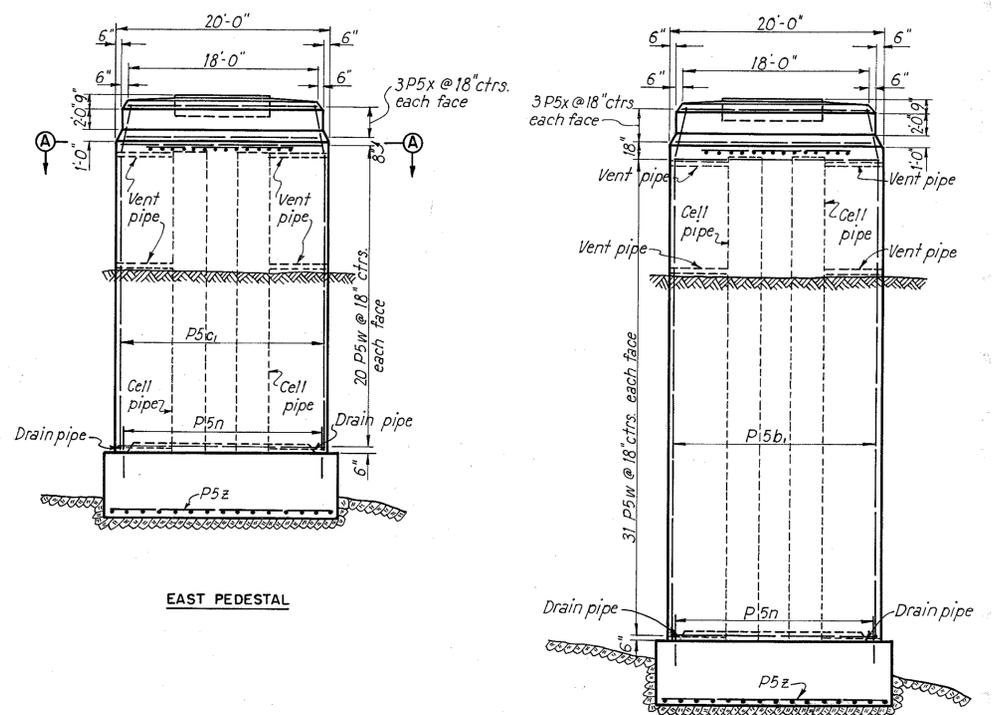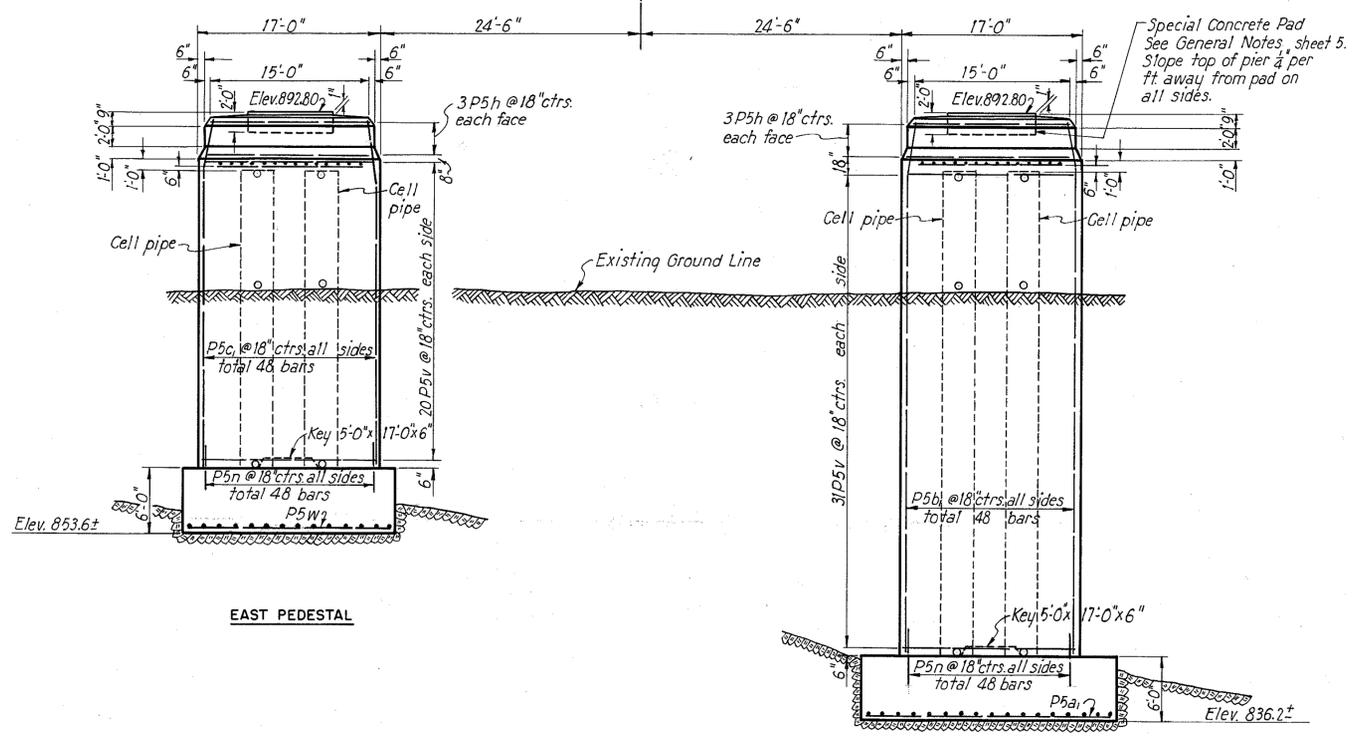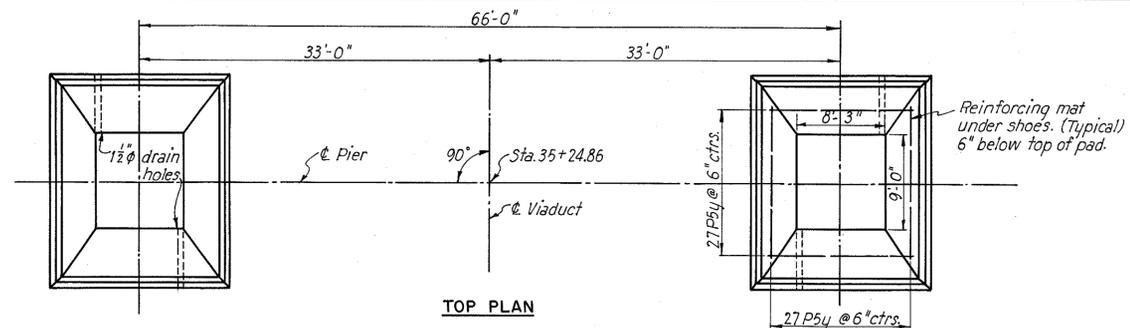

Note:
For notes regarding 36" cell pipes see sheet 15.

PART I

STATE OF OHIO
DEPARTMENT OF HIGHWAYS

AKRON EXPRESSWAY SYSTEM
(EAST MARKET STREET TO EAST CUYAHOGA FALLS AVENUE)
MAIN VIADUCT
BRIDGE NO. SU-5-124

PIER 5








AKRON, OHIO SUMMIT COUNTY, OHIO

SCALE 1/4" = 1'-0"
MADE I.P.A. DATE 5-16-49
TRCD. R.R. DATE 6-14-49
CHKD. C.R. DATE 6-2-49

HOWARD, NEEDLES, TAMMEN & BERGENDOFF
CONSULTING ENGINEERS
KANSAS CITY NEW YORK

766 SHEET V16

SUMMIT COUNTY
CITY OF AKRON
AKRON EXPRESSWAY SYSTEM
MAIN VIADUCT
SUM-5-12.31

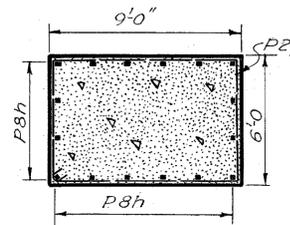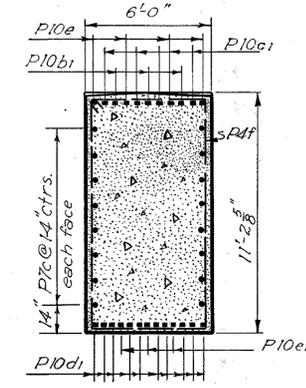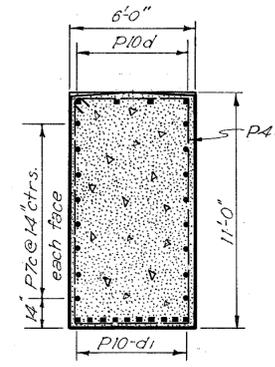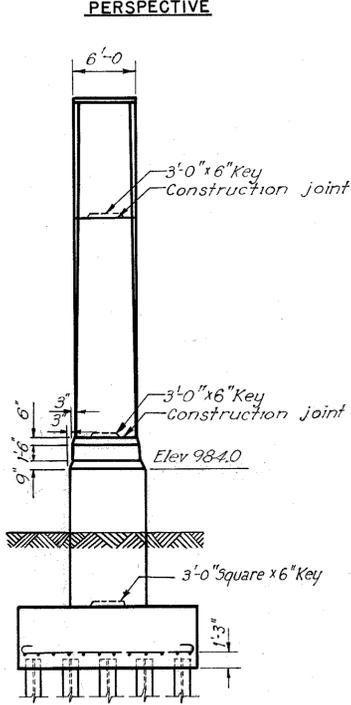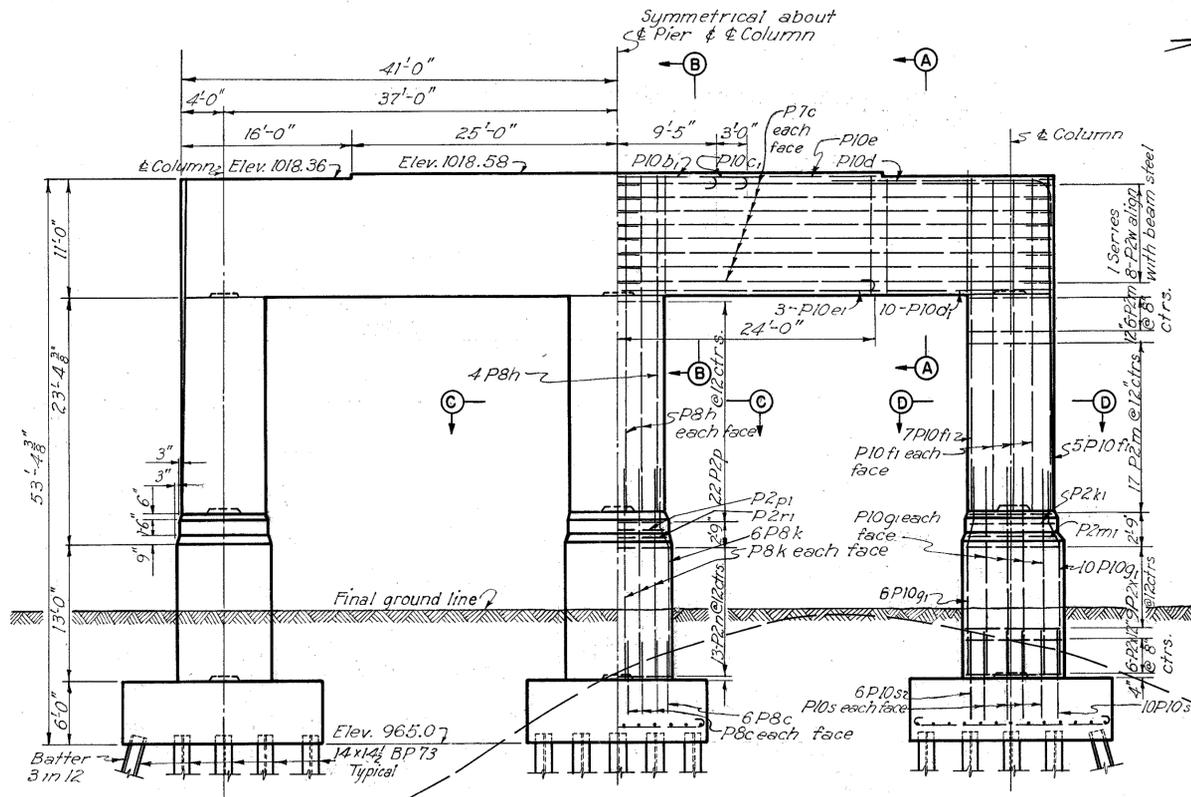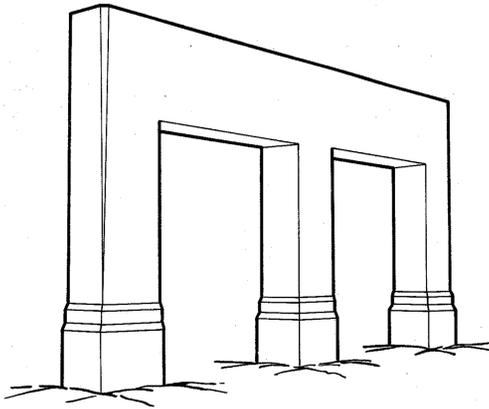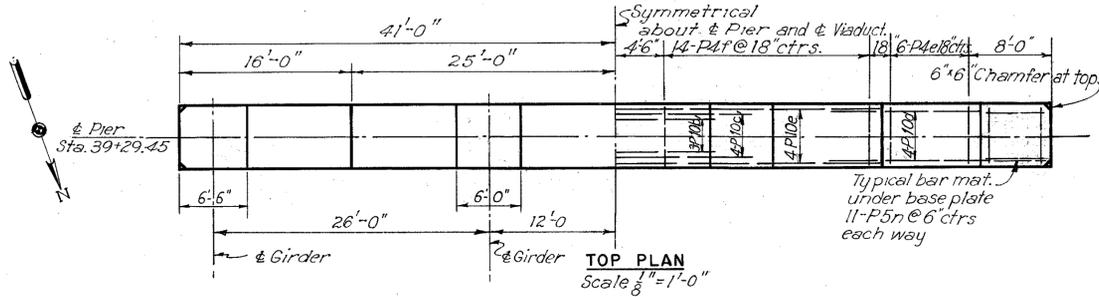

SUMMIT COUNTY
CITY OF AKRON
AKRON EXPRESSWAY SYSTEM
MAIN VIADUCT
SUM-5-12.31

Mark	Size	No.	Length	Type	Dimensions		Weight Pounds
					A	B	
SOUTH ABUTMENT							
C9a	1/2"	9	8'-3"	101	7'-0"		320
C9b	1/2"	3	31'-0"	Str.			400
C9c	1/2"	3	27'-6"	Str.			350
C9d	1/2"	3	34'-0"	Str.			440
A7a	1"	10	43'-6"	Str.			1160
D7a	1"	6	52'-0"	100	49'-10"		830
D7b	1"	6	49'-9"	Str.			800
W7c	1"	10	18'-0"	Str.			480
W7d	1"	30	13'-3"	Str.			1060
W7e	1"	10	12'-0"	Str.			320
B6a	3/8"	2	10'-0" to 10'-6"	Str.			1170
D6a	3/8"	168	48'-0"	Str.			16480
D6b	3/8"	74	49'-9"	111			7520
D6c	3/8"	14	7'-6"	104	4'-6"	3'-0"	1130
D6d	3/8"	82	8'-0"	106	4'-0"	2'-0"	1340
W6a	3/8"	21	7'-3"	101	6'-5"		310
W6b	3/8"	15	8'-3"	101	7'-5"		250
W6c	3/8"	6	16'-3"				200
W6d	3/8"	7	7'-3" to 15'-9"	Str.			350
A5d	3/8"	75	8'-3"	107	2'-9"	4'-10"	930
A5f	3/8"	84	43'-3"	Str.			5450
A5g	3/8"	12	8'-0"	Str.			140
A5k	3/8"	2	4'-0" to 43'-3"	Str.			640
A5m	3/8"	2	4'-0" to 43'-3"	Str.			570
A5n	3/8"	70	8'-0"	104	5'-0"	3'-0"	840
A5p	3/8"	116	12'-3"	Str.			2130
A5r	3/8"	2	10'-9" to 17'-0"	Str.			1210
A5s	3/8"	2	17'-0" to 22'-6"	Str.			1720
B5a	3/8"	10	40'-9"	Str.			610
B5b	3/8"	56	8'-9"	102			740
B5d	3/8"	6	6'-6"	Str.			60
B5e	3/8"	2	14'-9" to 15'-3"	104	10'-0" to 10'-6"	4'-9"	1260
B5m	3/8"	8	11'-9"	Str.			140
B5p	3/8"	14	43'-3"	Str.			910
C5a	3/8"	6	14'-6"	109	4'-2"	2'-2"	130
C5b	3/8"	82	6'-0"	101	5'-3"		740
C5c	3/8"	5	14'-0"	Str.			110
C5d	3/8"	11	9'-3"	Str.			150
C5e	3/8"	19	11'-6"	103	2'-2"	4'-2"	330
C5f	3/8"	11	13'-6"	103	2'-2"	5'-2"	220
C5g	3/8"	12	22'-0"	Str.			400
C5h	3/8"	6	12'-3"	Str.			110
C5k	3/8"	24	14'-0"	103	1'-2"	5'-11"	500
C5m	3/8"	8	12'-0"	103	1'-2"	4'-11"	140
C5n	3/8"	8	15'-0"	103	2'-2"	5'-11"	180
C5p	3/8"	24	9'-6"	101	8'-9"		340
C5r	3/8"	2	17'-0" to 21'-6"	103	2'-2"	6'-11" to 9'-2"	380
C5s	3/8"	2	13'-3" to 14'-6"	103	2'-2"	5'-0" to 5'-8"	250
C5t	3/8"	14	30'-6"	Str.			640
C5v	3/8"	8	31'-0"	Str.			370
C5w	3/8"	4	13'-0"	103	2'-2"	4'-11"	80
C5x	3/8"	7	24'-6"	Str.			260
C5y	3/8"	17	17'-0" to 21'-6"	103	2'-2"	6'-11" to 9'-2"	320
C5z	3/8"	8	27'-6"	Str.			330
D5a	3/8"	8	34'-0"	Str.			410
C5b	3/8"	17	17'-0" to 21'-6"	103	2'-2"	6'-11" to 9'-2"	430
D5a	3/8"	170	40'-9"	Str.			10390
D5d	3/8"	12	6'-0"	Str.			110
D5e	3/8"	50	43'-3"	Str.			3240
D5h	3/8"	22	8'-3"	120	4'-6"	4'-6"	270
D5k	3/8"	10	44'-9"	Str.			670
F5b	3/8"	16	5'-6"	Str.			130
F5c	3/8"	16	15'-9"	105	7'-8"	4'-0"	380
F5d	3/8"	12	19'-9"	105	11'-8"	4'-0"	360
F5e	3/8"	20	11'-6"	Str.			350
F5f	3/8"	4	8'-3"	Str.			50
F5g	3/8"	4	10'-6"	Str.			60
F5h	3/8"	4	11'-3"	Str.			70
F5k	3/8"	10	16'-0"	Str.			240
F5m	3/8"	4	15'-9"	Str.			90
F5n	3/8"	4	15'-0"	Str.			90
F5p	3/8"	4	13'-0"	Str.			80
F5r	3/8"	32	15'-9"	105	1'-7"	7'-1"	760
F5t	3/8"	4	7'-6"	Str.			40
W5a	3/8"	8	31'-9"	Str.			380
W5b	3/8"	4	28'-0"	Str.			170
W5c	3/8"	4	27'-0"	Str.			160
W5d	3/8"	2	21'-6" to 29'-0"	Str.			460
W5e	3/8"	2	6'-6" to 15'-0"	Str.			190
W5f	3/8"	12	10'-3"	Str.			180
W5g	3/8"	6	15'-3"	Str.			90
W5h	3/8"	2	11'-0" to 14'-0"	Str.			530
W5k	3/8"	2	6'-9" to 10'-0"	Str.			350
W5m	3/8"	44	6'-3"	Str.			410
W5n	3/8"	6	28'-9"	109	4'-6"	9'-0"	260
W5p	3/8"	24	8'-0"	104	5'-0"	3'-0"	200
D4a	3/8"	32	1'-6"	Str.			50
A2c	3/8"	7	19'-6"	Str.			90
A2d	3/8"	13	7'-9"	113	2'-8"	2'-0"	60
C2a	3/8"	6	15'-3"	109	5'-11"	1'-2"	60
C2b	3/8"	3	24'-0"	109	9'-3"	2'-2"	50
C2c	3/8"	3	24'-6"	109	9'-6"	2'-2"	50
C2d	3/8"	3	17'-3"	109	5'-11"	2'-2"	30
D2a	3/8"	96	5'-3"	110	1'-5"	1'-0"	340
D2b	3/8"	59	14'-6"	109	4'-6"	2'-2"	570
D2c	3/8"	116	10'-9"	109	2'-8"	2'-2"	830
D2f	3/8"	100	6'-3"	109	1'-6"	1'-0"	420
W2c	3/8"	140	7'-9"	109	1'-8"	1'-8"	720
W2d	3/8"	18	9'-9"	109	2'-2"	2'-2"	120
D1a	3/8"	150	4'-9"	Str.			270
D1b	3/8"	10	49'-9"	Str.			190

Mark	Size	No.	Length	Type	Dimensions		Weight Pounds
					A	B	
NORTH ABUTMENT							
F5p	3/8"	4	13'-0"	Str.			80
F5r	3/8"	32	15'-9"	105	1'-7"	7'-1"	760
F5s	3/8"	3	4'-3"	Str.			20
F5t	3/8"	4	7'-6"	Str.			40
F5u	3/8"	12	10'-3"	Str.			180
F5v	3/8"	12	8'-3"	101	7'-6"		150
F5w	3/8"	6	7'-6"	Str.			70
F5x	3/8"	2	6'-9" to 8'-3"	101	6'-0" to 7'-6"		370
F5y	3/8"	2	6'-0" to 7'-6"	Str.			170
F5z	3/8"	10	25'-3"	Str.			380
F5a	3/8"	6	4'-6"	Str.			40
F5b	3/8"	18	14'-9"	101	14'-0"		400
F5c	3/8"	30	5'-0"	Str.			230
F5d	3/8"	30	7'-6"	101	6'-9"		340
F5e	3/8"	4	7'-9"	Str.			50
F5f	3/8"	24	8'-6"	Str.			310
F5g	3/8"	24	8'-9"	100	7'-6"		320
F5h	3/8"	3	5'-9"	Str.			30
F5i	3/8"	8	8'-3"	100	7'-0"		100
F5j	3/8"	5	4'-0"	Str.			30
W5c	3/8"	10	27'-0"	Str.			410
W5p	3/8"	7	16'-3"	Str.			170
W5r	3/8"	2	7'-3" to 15'-9"	Str.			290
W5s	3/8"	5	35'-0"	108	24'-9"		260
W5t	3/8"	2	11'-9" to 32'-3"	108	1'-6" to 22'-0"		200
W5u	3/8"	11	10'-3"	101	9'-7"		170
W5v	3/8"	5	24'-9"	Str.			190
W5w	3/8"	2	1'-6" to 22'-0"	Str.			110
W5x	3/8"	6	18'-6"	Str.			170
W5y	3/8"	50	22'-3"	Str.			1670
W5z	3/8"	12	18'-0"	Str.			320
W5a	3/8"	6	15'-0"	Str.			140
W5b	3/8"	2	15'-0" to 19'-6"	Str.			360
W5c	3/8"	12	12'-0"	Str.			220
W5d	3/8"	2	7'-0" to 10'-0"	Str.			130
W5e	3/8"	12	49'-9"	Str.			900
W5g	3/8"	16	54'-6"	Str.			1310
W5h	3/8"	2	39'-3" to 50'-9"	Str.			1220
W5k	3/8"	8	33'-6"	Str.			400
W5m	3/8"	2	23'-0" to 32'-0"	Str.			580
W5p	3/8"	22	17'-0"	Str.			560
W5r	3/8"	2	5'-6" to 15'-6"	Str.			250
W5s	3/8"	14	17'-6"	109	5'-9"	2'-1"	370
W5t	3/8"	12	20'-0"	Str.			360
W5u	3/8"	12	3'-9"	Str.			70
W5v	3/8"	2	4'-0" to 7'-0"	Str.			80
W5w	3/8"	2	8'-6" to 15'-3"	Str.			360
W5x	3/8"	2	16'-9" to 24'-3"	Str.			680
W5z	3/8"	10	14'-9"	Str.			220
W5a	3/8"	2	2'-0" to 5'-0"	Str.			30
W5b	3/8"	2	6'-3" to 44'-0"	Str.			1060
W5c	3/8"	8	9'-0"	Str.			110
W5e	3/8"	40	5'-0"	Str.			300
W5f	3/8"	40	14'-0"	Str.			840
W5g	3/8"	30	7'-6"	101	6'-9"		340
W5h	3/8"	2	13'-3"	Str.			40
W5i	3/8"	44	6'-3"	Str.			410
W5n	3/8"	6	28'-9"	109	4'-6"	9'-0"	260
B4a	3/8"	24	8'-0"	104	5'-0"	3'-0"	200
D4a	3/8"	32	1'-6"	Str.			50
A2c	3/8"	7	19'-6"	Str.			90
A2d	3/8"	13	7'-9"	113	2'-8"	2'-0"	60
C2a	3/8"	6	15'-3"	109	5'-11"		

AKRON EXPRESSWAY SYSTEM
 COUNTY OF AKRON
 MAIN VIADUCT
 SUM-5-12-31


Mark	Size	No.	Length	Type	Dimensions		Weight Pounds
					A	B	
PIER 1							
P10a	1/4"	14	20'-9"	100	18'-0"		1540
P10b	1/4"	24	11'-6"	101	10'-0"		1470
P10c	1/4"	12	15'-3"	101	13'-9"		970
P10d	1/4"	10	26'-6"	120	21'-0"	6'-4"	1410
P10e	1/4"	5	49'-6"	Str.			1320
P10f	1/4"	4	36'-9"	100	34'-0"		780
P10g	1/4"	8	24'-9"	100	22'-0"		1050
P10k	1/4"	28	45'-3"	101	43'-9"		6720
P10m	1/4"	15	19'-9"	Str.			1580
P10n	1/4"	48	20'-0"	119	12'-9"	5'-2"	5100
P10p	1/4"	48	18'-6"	119	11'-3"	5'-2"	4720
P10r	1/4"	15	19'-3"	Str.			1540
P10s	1/4"	96	8'-6"	Str.			4370
P8a	1"	12	19'-9"	Str.			810
P8b	1"	16	17'-9"	119	11'-3"	4'-5"	970
P8c	1"	16	6'-9"	Str.			370
P7a	1"	24	43'-6"	Str.			2790
P6a	1"	12	15'-0"	Str.			370
P6b	1"	22	35'-6"	Str.			1600
P5a	1"	26	12'-9"	100	11'-6"		500
P5b	1"	10	14'-9"	100	13'-6"		220
P5c	1"	10	15'-9"	100	14'-6"		240
P5d	1"	76	4'-6"	Str.			510
P5n	1"	16	5'-0"	Str.			120
P5a2	1"	16	6'-0"	Str.			140
P5b2	1"	70	7'-6"	Str.			790
P5c2	1"	12	12'-0"	Str.			220
P5d2	1"	12	9'-0"	Str.			160
P5e2	1"	44	4'-3"	101	3'-6"		280
PIER 2							
P10d	1/4"	12	26'-6"	120	21'-0"	6'-4"	1690
P10e	1/4"	6	49'-6"	Str.			1580
P10s	1/4"	64	8'-6"	Str.			2890
P10t	1/4"	26	43'-9"	Str.			6030
P10v	1/4"	30	31'-6"	Str.			5020
P10w	1/4"	32	21'-9"	118	13'-5"	5'-9"	3690
P10x	1/4"	32	30'-3"	118	22'-0"	5'-9"	5150
P10y	1/4"	6	28'-3"	100	25'-5"		910
PIER 3							
P10h	1/4"	18	28'-0"	Str.			2,680
P10s	1/4"	226	8'-6"	Str.			10,200
P10u	1/4"	6	59'-0"	120	53'-8"	6'-2"	1,880
P10k	1/4"	134	31'-0"	118	22'-9"	5'-8"	22,100
P10n	1/4"	68	32'-0"	101	30'-7"		11,560
P10r	1/4"	10	46'-9"	100	43'-11"		2,490
P10s	1/4"	10	39'-6"	101	38'-1"		2,100
P10t	1/4"	10	27'-6"	101	26'-1"		1,460
P10u	1/4"	13	35'-6"	101	34'-1"		2,450
P10v	1/4"	13	47'-6"	101	46'-1"		3,280
P10w	1/4"	84	47'-6"	Str.			21,200
P10x	1/4"	84	60'-0"	Str.			26,780
P10y	1/4"	74	20'-0"	Str.			7,860
P10a2	1/4"	16	44'-3"	100	41'-6"		3,760
P10b2	1/4"	17	17'-9" to 39'-6"	100	14'-11" to 36'-8"		420
P10c2	1/4"	1	44'-9"	100	41'-11"		240
P10d2	1/4"	13	13'-6"	101	12'-1"		930
P10e2	1/4"	15	21'-3"	101	19'-10"		1,690
P10f2	1/4"	32	14'-6"	101	13'-1"		2,470
P10g2	1/4"	16	29'-6"	101	28'-1"		2,510
P7d	1"	66	46'-9"	Str.			8,270
P7e	1"	66	60'-0"	Str.			10,570
P7f	1"	4	58'-0"	120	53'-6"	5'-4"	620
PIER 4							
P2k	1/2"	4.3	36'-9"	125	7'-8"	9'-8"	1060
P2m	1/2"	4.4	27'-9"	109	7'-8"	5'-8"	790
P2n	1/2"	18	37'-9"	109	7'-8"	10'-8"	450
P2p	1/2"	22	29'-9"	109	5'-8"	8'-8"	440
P2r	1/2"	2	29'-9"	109	8'-2"	6'-2"	40
P2s	1/2"	2	33'-9"	109	9'-2"	7'-2"	50
P2t	1/2"	1	31'-9"	109	9'-2"	6'-2"	20
P2u	1/2"	1	35'-9"	109	10'-2"	7'-2"	20
P2w	1/2"	2	9'-3"	124	5'-5" to 5'-2"	1" to 4"	100
PIER 5							
P5h	1/2"	12	15'-0"	Str.			270
P5n	1/2"	96	5'-0"	Str.			720
P5s	1/2"	34	26'-6"	Str.			1,350
P5t	1/2"	48	39'-0"	123	34'-0"		2,810
P5u	1/2"	48	41'-0"	123	36'-0"		2,960
P5v	1/2"	98	16'-6"	Str.			2,430
P5w	1/2"	98	19'-6"	Str.			2,870
P5x	1/2"	12	18'-0"	Str.			330
P5y	1/2"	164	13'-0"	Str.			3,200
P5z	1/2"	31	21'-6"	Str.			1,000
P5a1	1/2"	15	23'-6"	Str.			530
P5b1	1/2"	48	50'-3"	123	45'-3"		3,620
P5c1	1/2"	48	32'-9"	123	27'-9"		2,360
PIER 6							
P10h	1/4"	18	28'-0"	Str.			2,680
P10s	1/4"	94	8'-6"	Str.			4,250
P10i	1/4"	76	24'-0"	118	15'-9"	5'-8"	9,690
P10m	1/4"	68	48'-9"	101	47'-4"		17,610
P10p	1/4"	4	34'-9"	100	31'-11"		740
P10r	1/4"	4	46'-9"	100	43'-11"		990
P10s	1/4"	8	39'-6"	101	38'-1"		1,680
P10t	1/4"	8	27'-6"	101	26'-1"		1,170
P10u	1/4"	10	35'-6"	101	34'-1"		1,890
P10v	1/4"	10	47'-6"	101	46'-1"		2,520
P10w	1/4"	30	47'-6"	Str.			7,570
P10x	1/4"	30	60'-0"	Str.			9,560
PIER 7							
P7c	1"	32	42'-6"	Str.			3,630
PIER 8							
P8c	1"	26	6'-9"	Str.			600
P8d	1"	25	19'-9"	100	17'-6"		1,680
P8e	1"	22	22'-9"	100	20'-6"		1,700
P8f	1"	18	31'-9"	Str.			1,940
P8g	1"	26	25'-3"	118	17'-9"		2,230
PIER 9							
P9a	1/8"	18	14'-9"	Str.			1,140
PIER 10							
P10a	1"	32	43'-6"	Str.			3,700
P10b	1"	15	31'-0"	Str.			1,240

Mark	Size	No.	Length	Type	Dimensions		Weight Pounds
					A	B	
P5b	3/8"	12	14'-9"	100	13'-6"		270
P5e	3/8"	11	18'-9"	100	17'-6"		310
P5f	3/8"	12	16'-9"	100	15'-6"		300
P5g	3/8"	10	18'-3"	100	17'-0"		270
P5h	3/8"	38	15'-0"	Str.			860
P5k	3/8"	38	10'-6"	Str.			600
P5m	3/8"	25	31'-0"	Str.			1,160
P5n	3/8"	88	5'-0"	Str.			660
P5a2	3/8"	16	6'-0"	Str.			140
PIER 3							
P10h	1/4"	18	28'-0"	Str.			2,680
P10s	1/4"	226	8'-6"	Str.			10,200
P10u	1/4"	6	59'-0"	120	53'-8"	6'-2"	1,880
P10k	1/4"	134	31'-0"	118	22'-9"	5'-8"	22,100
P10n	1/4"	68	32'-0"	101	30'-7"		11,560
P10r	1/4"	10	46'-9"	100	43'-11"		2,490
P10s	1/4"	10	39'-6"	101	38'-1"		2,100
P10t	1/4"	10	27'-6"	101	26'-1"		1,460
P10u	1/4"	13	35'-6"	101	34'-1"		2,450
P10v	1/4"	13	47'-6"	101	46'-1"		3,280
P10w	1/4"	84	47'-6"	Str.			21,200
P10x	1/4"	84	60'-0"	Str.			26,780
P10y	1/4"	74	20'-0"	Str.			7,860
P10a2	1/4"	16	44'-3"	100	41'-6"		3,760
P10b2	1/4"	17	17'-9" to 39'-6"	100	14'-11" to 36'-8"		420
P10c2	1/4"	1	44'-9"	100	41'-11"		240
P10d2	1/4"	13	13'-6"	101	12'-1"		930
P10e2	1/4"	15	21'-3"	101	19'-10"		1,690
P10f2	1/4"	32	14'-6"	101	13'-1"		2,470
P10g2	1/4"	16	29'-6"	101	28'-1"		2,510
P7d	1"	66	46'-9"	Str.			8,270
P7e	1"	66	60'-0"	Str.			10,570
P7f	1"	4	58'-0"	120	53'-6"	5'-4"	620
PIER 5							
P5h	1/2"	12	15'-0"	Str.			270
P5n	1/2"	96	5'-0"	Str.			720
P5s	1/2"	34	26'-6"	Str.			1,350
P5t	1/2"	48	39'-0"	123	34'-0"		2,810
P5u	1/2"	48	41'-0"	123	36'-0"		2,960
P5v	1/2"	98	16'-6"	Str.			2,430
P5w	1/2"	98	19'-6"	Str.			2,870
P5x	1/2"	12	18'-0"	Str.			330
P5y	1/2"	164	13'-0"	Str.			3,200
P5z	1/2"	31	21'-6"	Str.			1,000
P5a1	1/2"	15	23'-6"	Str.			530
P5b1	1/2"	48	50'-3"	123	45'-3"		3,620
P5c1	1/2"	48	32'-9"	123	27'-9"		2,360
PIER 6							
P10h	1/4"	18	28'-0"	Str.			2,680
P10s	1/4"	94	8'-6"	Str.			4,250
P10i	1/4"	76	24'-0"	118	15'-9"	5'-8"	9,690
P10m	1/4"	68	48'-9"	101	47'-4"		17,610
P10p	1/4"	4	34'-9"	100	31'-11"		740
P10r	1/4"	4	46'-9"	100	43'-11"		990
P10s	1/4"	8	39'-6"	101	38'-1"		1,680
P10t	1/4"	8	27'-6"	101	26'-1"		1,170
P10u	1/4"	10	35'-6"	101	34'-1"		1,890
P10v	1/4"	10	47'-6"	101	46'-1"		2,520
P10w	1/4"	30	47'-6"	Str.			7,570
P10x	1/4"	30	60'-0"	Str.			9,560
PIER 7							
P7c	1"	32	42'-6"	Str.			3,630
PIER 8							
P8c	1"	26	6'-9"	Str.			600
P8d	1"	25	19'-9"	100	17'-6"		1,680
P8e	1"	22	22'-9"	100	20'-6"		1,700
P8f	1"	18	31'-9"	Str.			1,940
P8g	1"	26	25'-3"	118	17'-9"		2,230
PIER 9							
P9a	1/8"	18	14'-9"	Str.			1,140
PIER 10							
P10a	1"	32	43'-6"	Str.			3,700
P10b	1"	15	31'-0"	Str.			1,240


Mark	Size	No.	Length	Type	Dimensions		Weight Pounds
					A	B	
P4h	3/8"	55	47'-0"	105	4'-8"	21'-2"	2,700
P4k	3/8"	110	4'-3"	Str.			490
P4m	3/8"	47	46'-0"	126	7'-5"	7'-8"	2,250
PIER 4							
P2a	1/2"	120	21'-0"	105	19'-8"	8"	1,680
P2b	1/2"	4	20'-6"	105	19'-2"	8"	60
P2c	1/2"	4	19'-6"</				

FED. ROAD DIV. NO.	STATE	FED. AID PROJ. NO.	TYPE FUNDS	21
2	OHIO	U-687(6)	POST WAR	34

SUMMIT COUNTY
CITY OF AKRON
AKRON EXPRESSWAY SYSTEM
MAIN VIADUCT
SUM-5-12.31

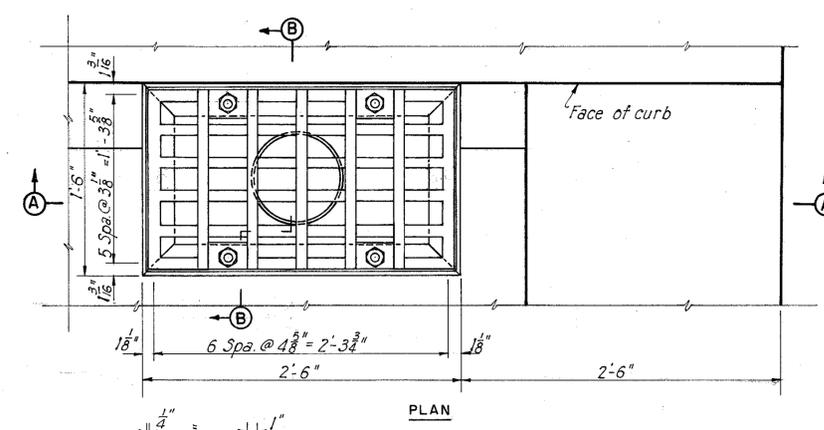


PLAN

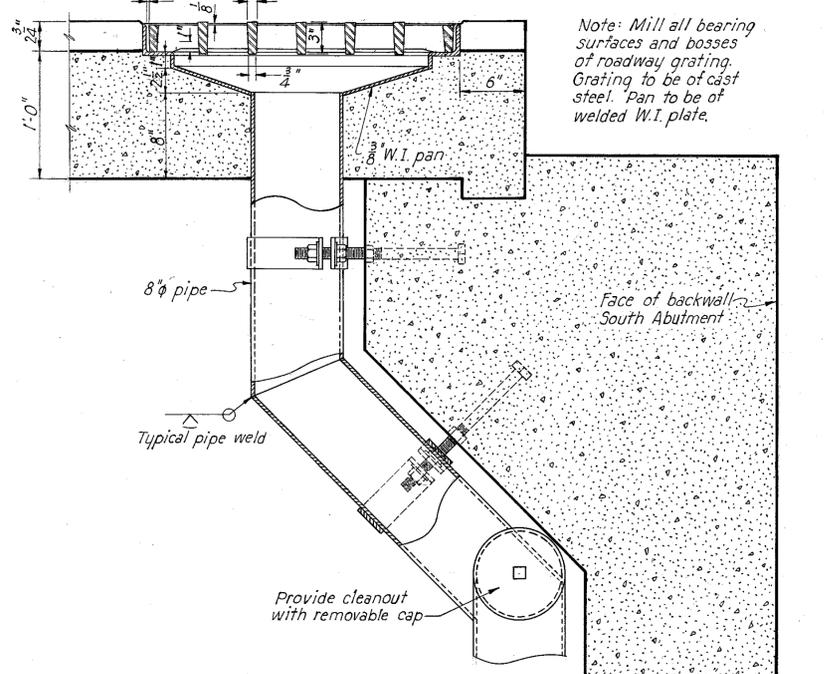


SECTION A-A


GRATING DETAILS
South Abutment only
Scale: 1/2" = 1'-0"

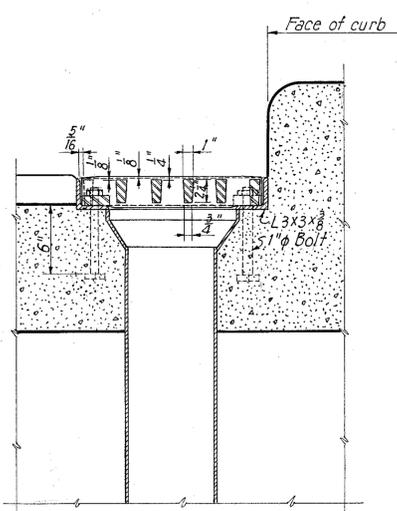


SECTION B-B

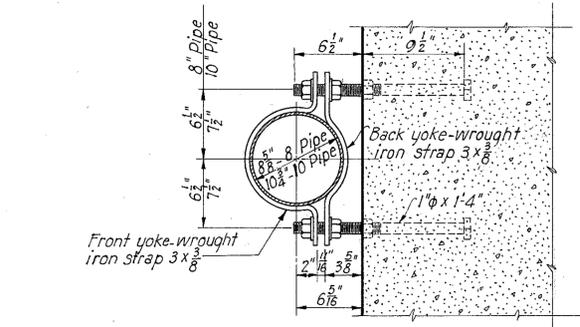


TYPICAL PIPE SUPPORT
Scale: 1/2" = 1'-0"
Note: Pipe supports shall be placed at about 5'-0" ctrs.

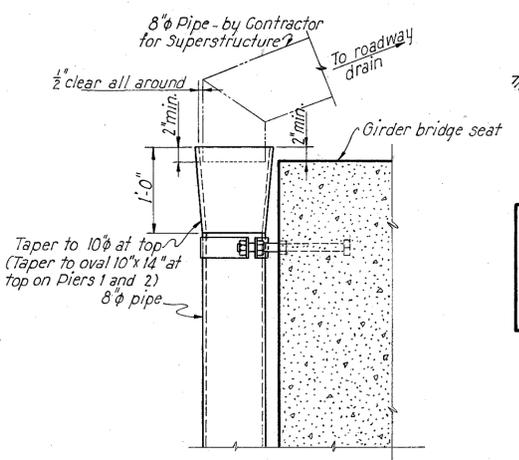

DRAIN DETAIL AT PIER 3
Scale: 1" = 1'-0"
Note: Drains at Piers 1 and 2 similar except as noted.

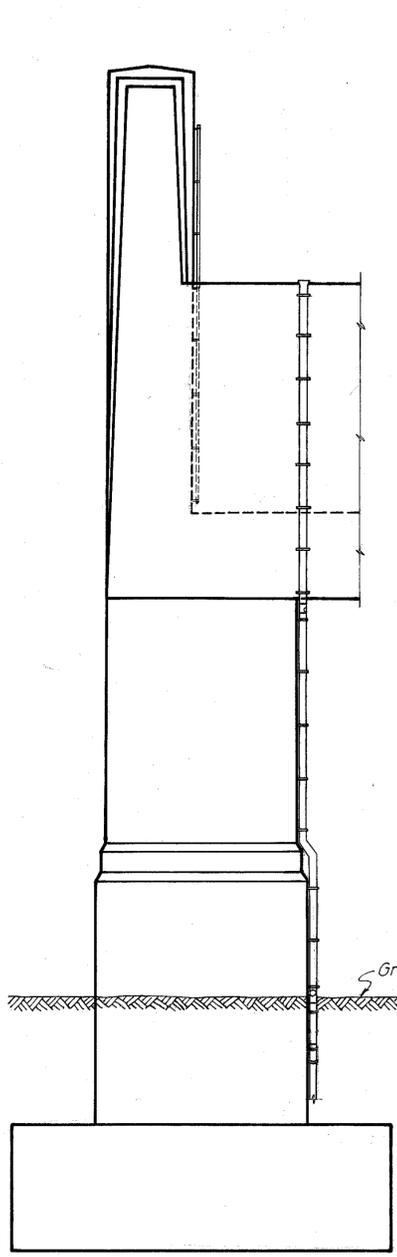


ELEVATION C-C

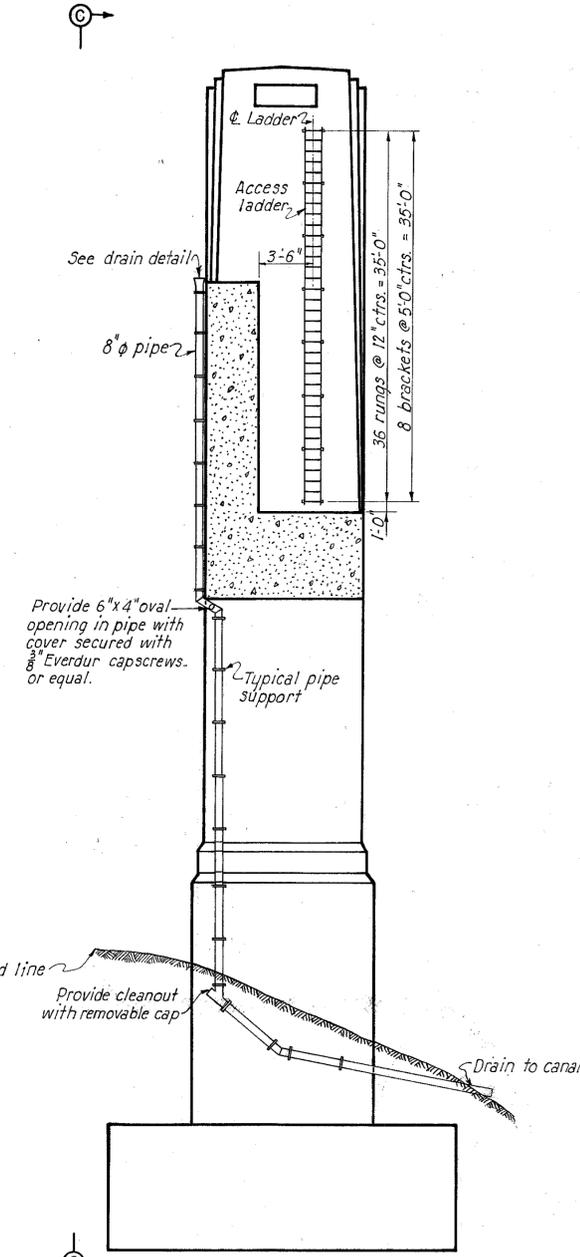


SECTION THROUGH BRIDGE SEAT

DRAINAGE DETAILS AT PIER 3
Scale: 1/2" = 1'-0"
Note: Pier 6 has a similar access ladder.

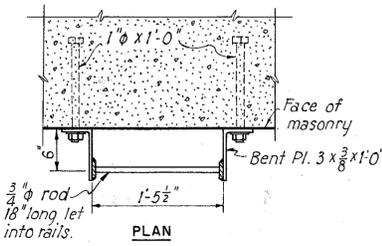

PLAN

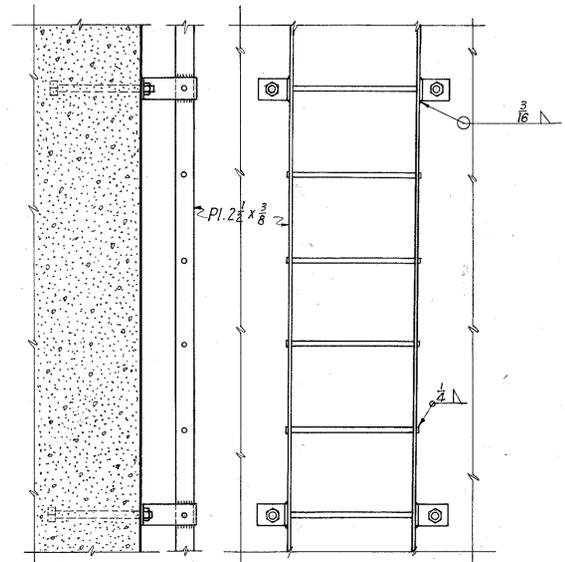

SIDE ELEVATION

FRONT ELEVATION

ACCESS LADDER DETAILS
Scale: 1" = 1'-0"

Notes:
All 8" pipe shall be wrought iron pipe at 24.7 pounds per foot.
All 10" pipe shall be wrought iron pipe at 31.2 pounds per foot.
For location of pipe at South Abutment, see sheet 6.
For location of pipe at Pier 1, see sheet 12.
For location of pipe at Pier 2, see sheet 13.

PART I






STATE OF OHIO
DEPARTMENT OF HIGHWAYS

AKRON EXPRESSWAY SYSTEM
(EAST MARKET STREET TO EAST CUYAHOGA FALLS AVENUE)
MAIN VIADUCT
BRIDGE NO. SU-5-124


DRAINAGE AND ACCESS LADDER

AKRON, OHIO SUMMIT COUNTY, OHIO

SCALE 1/2" = 1'-0" HOWARD, NEEDLES, TAMMEN & BERGENDOFF
MADE IN OHIO DATE 7-15-49 CONSULTING ENGINEERS
TRCD. P.R. DATE 7-23-49 KANSAS CITY NEW YORK
CHKD. B.O.R. DATE 7-13-49 766 SHEET V21

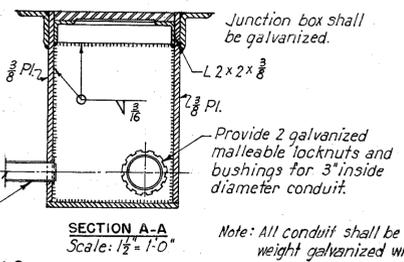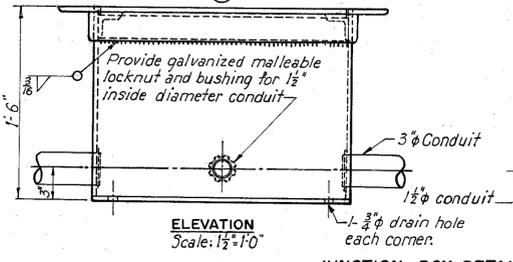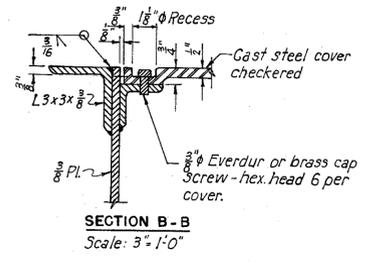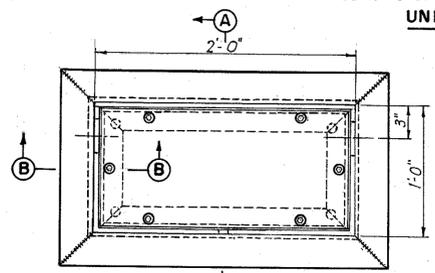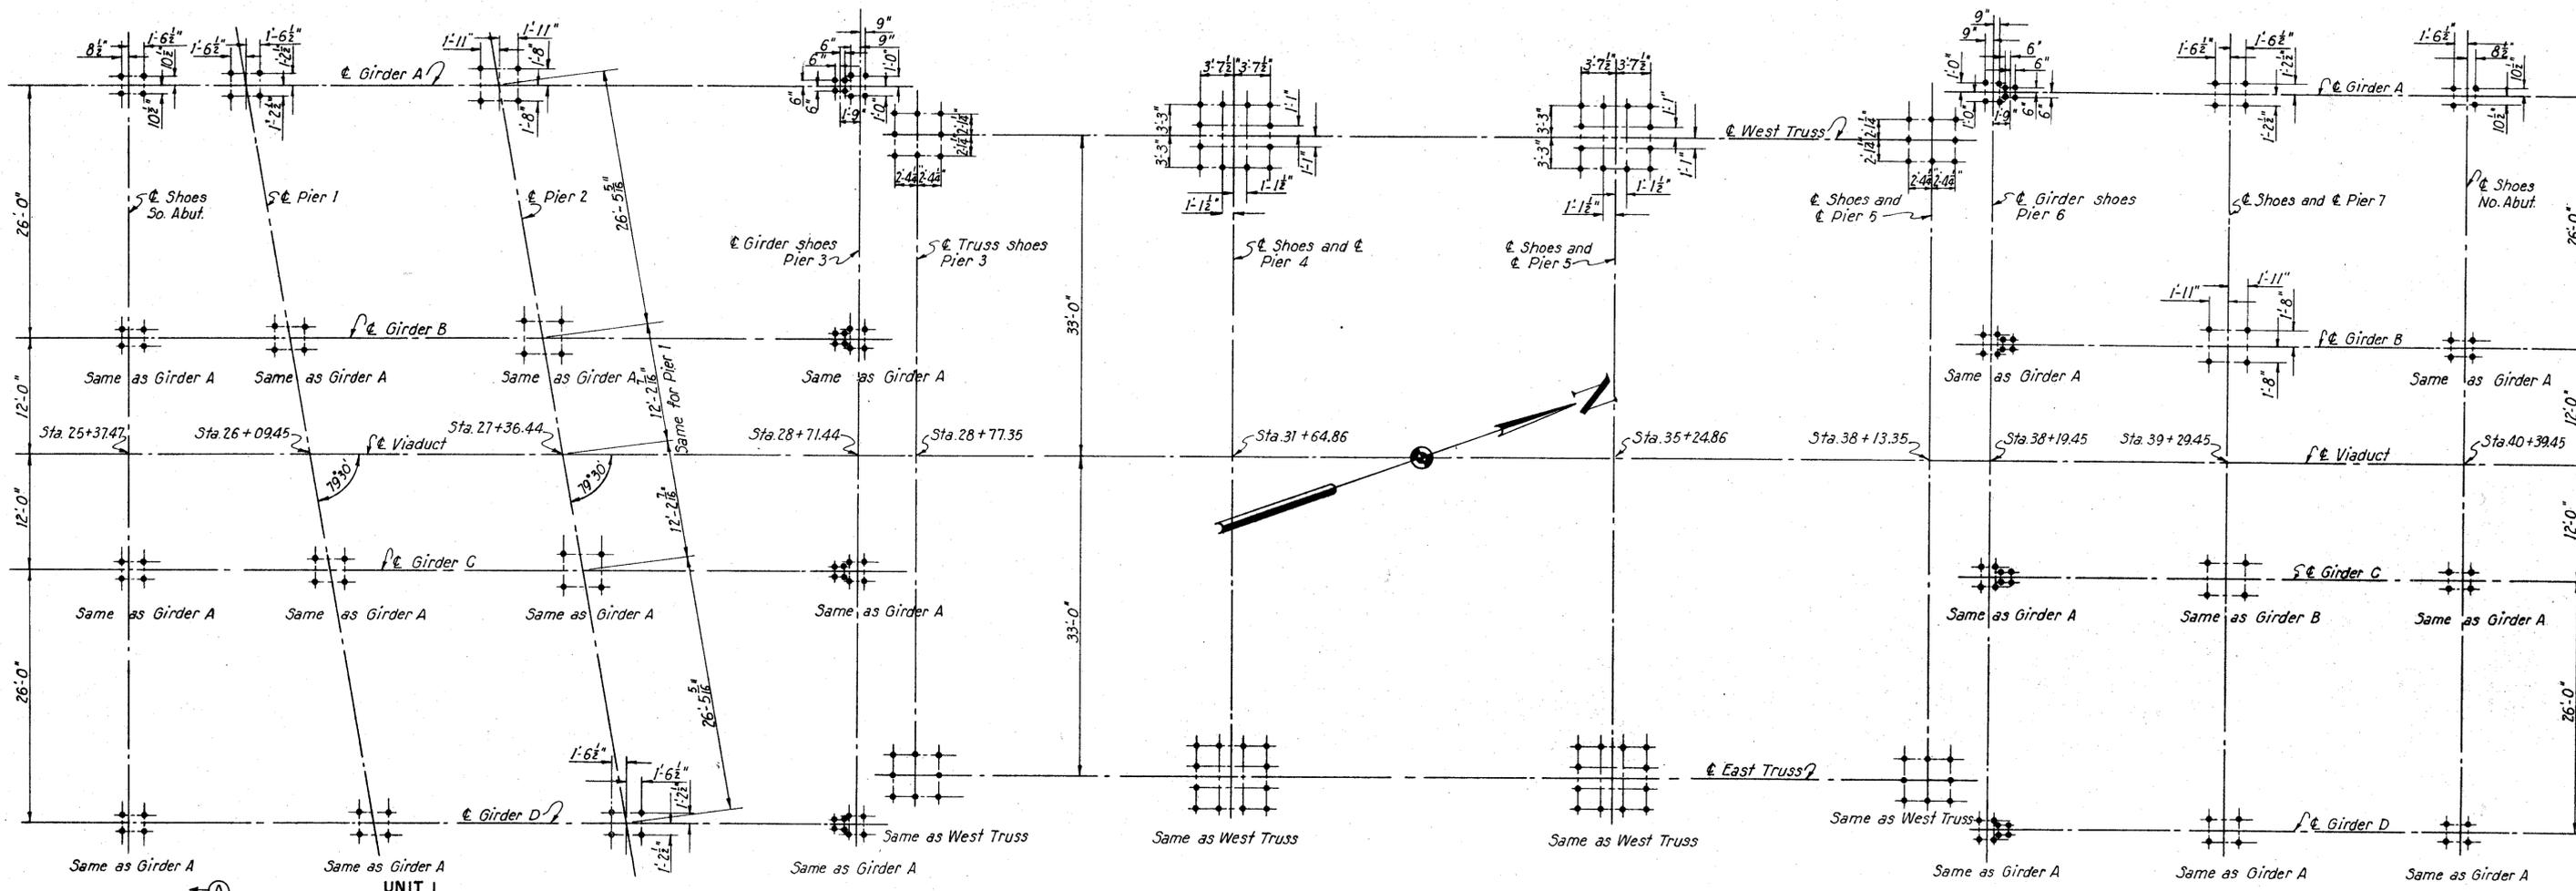

Note: All conduit shall be standard weight galvanized wrought iron pipe.

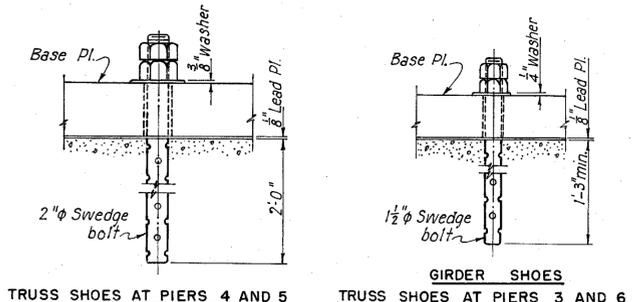

TOP MASONRY ELEVATIONS

PIER OR ABUTMENT	TOP MASONRY UNDER GIRDER				TOP MASONRY UNDER W. TRUSS E. TRUSS	
	A	B	C	D		
So. Abut.	1028.57	1028.91	1028.93	1028.62		
1	1025.31	1025.46	1025.32	1024.85		
2	1020.98	1021.24	1021.26	1021.01		
3	1021.08	1021.42	1021.44	1021.13	999.63	999.63
4					895.32	895.32
5					892.78	892.78
6	1019.63	1019.95	1019.95	1019.63	995.23	995.23
7	1018.36	1018.58	1018.58	1018.36		
No. Abut.	1019.02	1019.33	1019.33	1019.02		

Note: All anchor bolts for shoes and jacking plates are to be furnished and set (and holes drilled) by Contractor for Superstructure. Bolt Plan is furnished with substructure plans for information only so reinforcing steel will be placed to clear holes to be drilled for anchor bolts.


PART I
STATE OF OHIO
DEPARTMENT OF HIGHWAYS
AKRON EXPRESSWAY SYSTEM
(EAST MARKET STREET TO EAST CUYAHOGA FALLS AVENUE)
MAIN VIADUCT
ANCHOR BOLT PLAN & LIGHTING
AKRON, SUMMIT COUNTY, OHIO
SCALE: 1/2" = 1'-0" HOWARD, NEEDLES, TAMMEN & BERGENDOFF
MADE IN U.S.A. DATE: 5-20-49 CONSULTING ENGINEERS
TRCD. DATE: 5-26-49 KANSAS CITY NEW YORK
CHKD. DATE: 6-20-49 766 SHEET V23

SUMMIT COUNTY CITY OF AKRON EXPRESSWAY SYSTEM MAIN VIADUCT SUM-5-12.31


CONSTRUCTION SEQUENCE FOR SOUTH ABUTMENT

- Stage 1**
Excavate from existing ground elevations for footings of front wall and footings C2 and C3 of the west wall. Drive piles for footings C2 and C3. Construct footings for front wall, C2 and C3. Construct east wall to elevation 1012.62, front wall to elevation 1016.0 and west wall to elevation 1015.0. Backfill around footings and walls listed above to existing ground surface. (Method E-2.07)
- Stage 2**
Place and compact fill in and around abutment (Method E-1.05) conforming to slopes and elevations shown on this sheet.
- Stage 3**
Make required structural excavation of compacted embankment material for unconstructed footings, walls, pile encasements and beams. Excavate to elevation 1033.75 for berm inside abutment. Drive piles. Construct abutment footing C1 and retaining wall footing. Construct abutment walls, retaining wall, pile encasements and rear transverse beam.
- Stage 4**
Complete backfilling and grading and compact to final elevations and final slopes indicated (Method E-2.07). Place remaining concrete.


Structural excavation and backfill under Stages 1 and 3 to be paid for as provided in Item E-2, Excavation for Structures. Embankment filling (exclusive of backfilling and excess structural excavation) under stages 2 and 4 to be paid for as provided in Item E-4, Borrow.

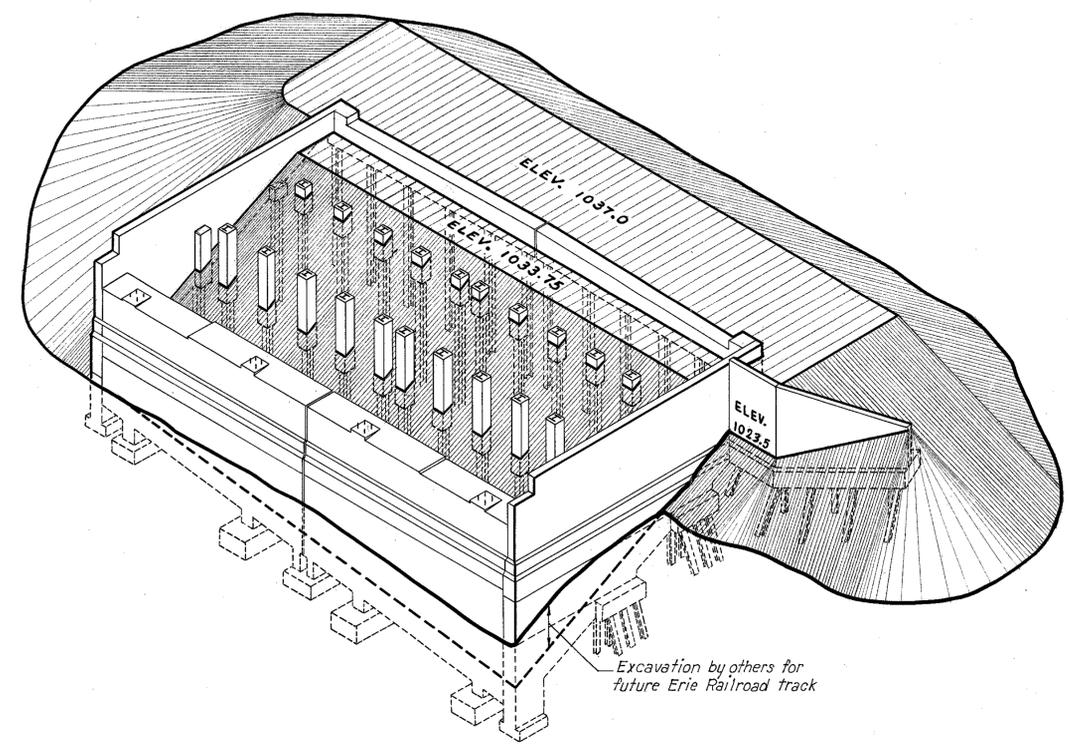

ISOMETRIC VIEW SHOWING FINAL GRADING

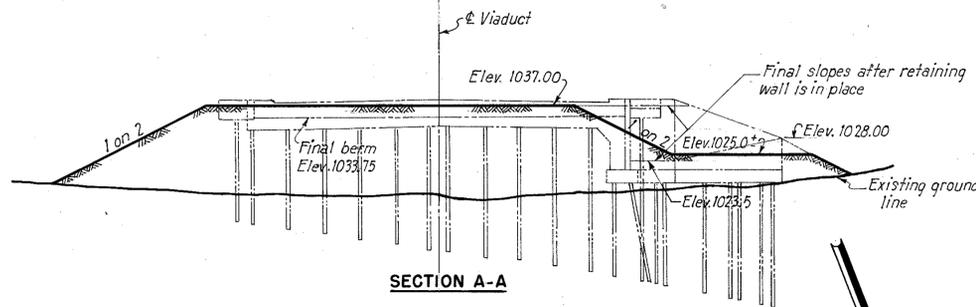


SECTION A-A

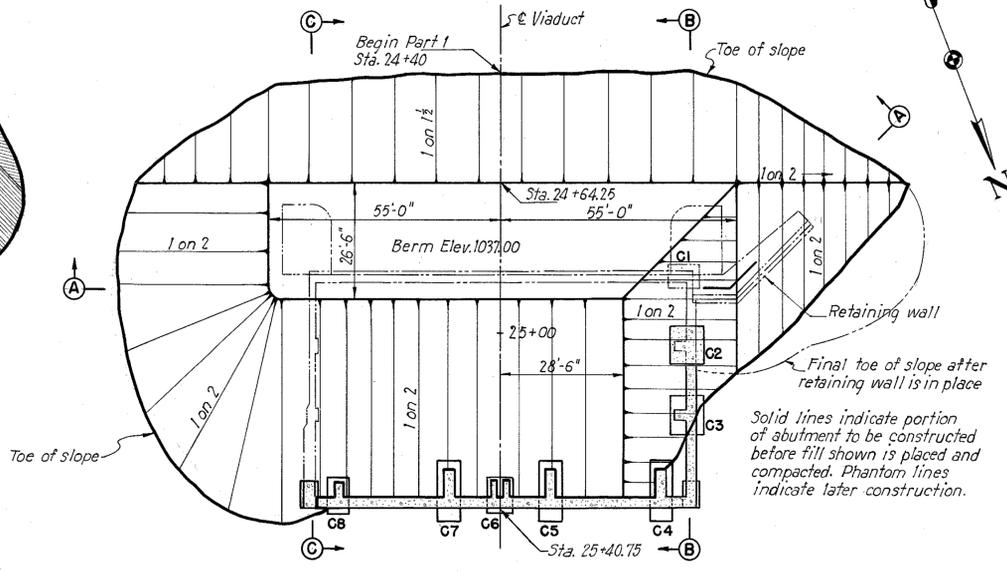


PLAN

(Stage 2 Construction)

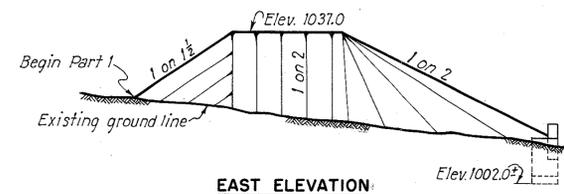


EAST ELEVATION

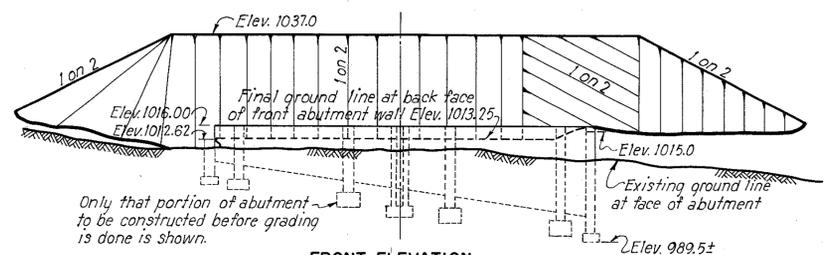


FRONT ELEVATION


SOUTH ABUTMENT-GRADING LAYOUT

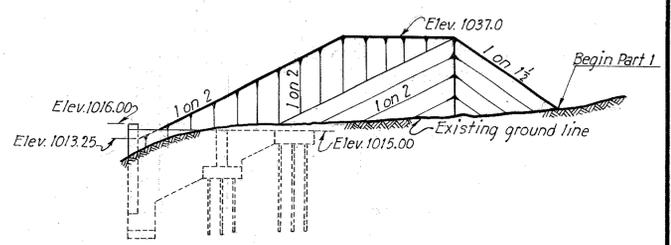


WEST ELEVATION

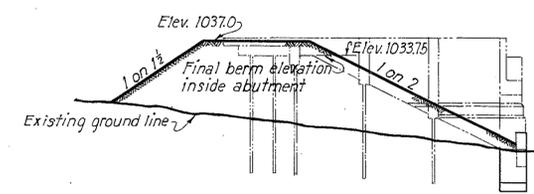

SECTION C-C

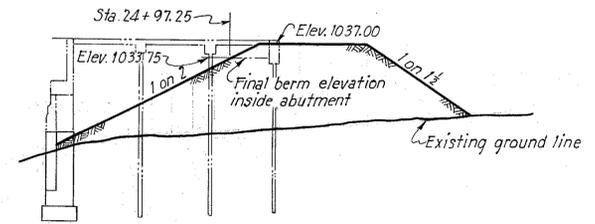

SECTION ON G

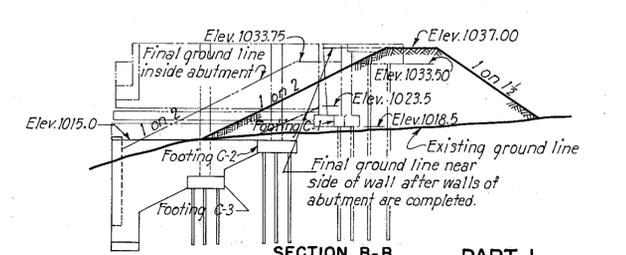

SECTION B-B PART I

STATE OF OHIO
DEPARTMENT OF HIGHWAYS

AKRON EXPRESSWAY SYSTEM
(EAST MARKET STREET TO EAST GUYAHOGA FALLS AVENUE)
MAIN VIADUCT
BRIDGE NO. SU-5-124



SITE GRADING-SOUTH PORTION

AKRON,	SUMMIT COUNTY,	OHIO
SCALE 1" = 20'	HOWARD, NEEDLES, TAMMEN & BERGENDOFF	
MADE D.J.W. DATE 2-29-49	CONSULTING ENGINEERS	
TRCD. R.R. DATE 10-8-49	KANSAS CITY NEW YORK	
CHKD. R.R.M. DATE 10-1-49		766 SHEET V24

FED. ROAD DIV. NO.	STATE	FED. AID PROJ. NO.	TYPE FUNDS	25
2	OHIO	U-687(6)	POST WAR	34

SUMMIT COUNTY
CITY OF AKRON
AKRON EXPRESSWAY SYSTEM
MAIN VIADUCT
SUM-5-12.31

Contractor to change alignment of P & O canal temporarily as necessary to clear construction operations

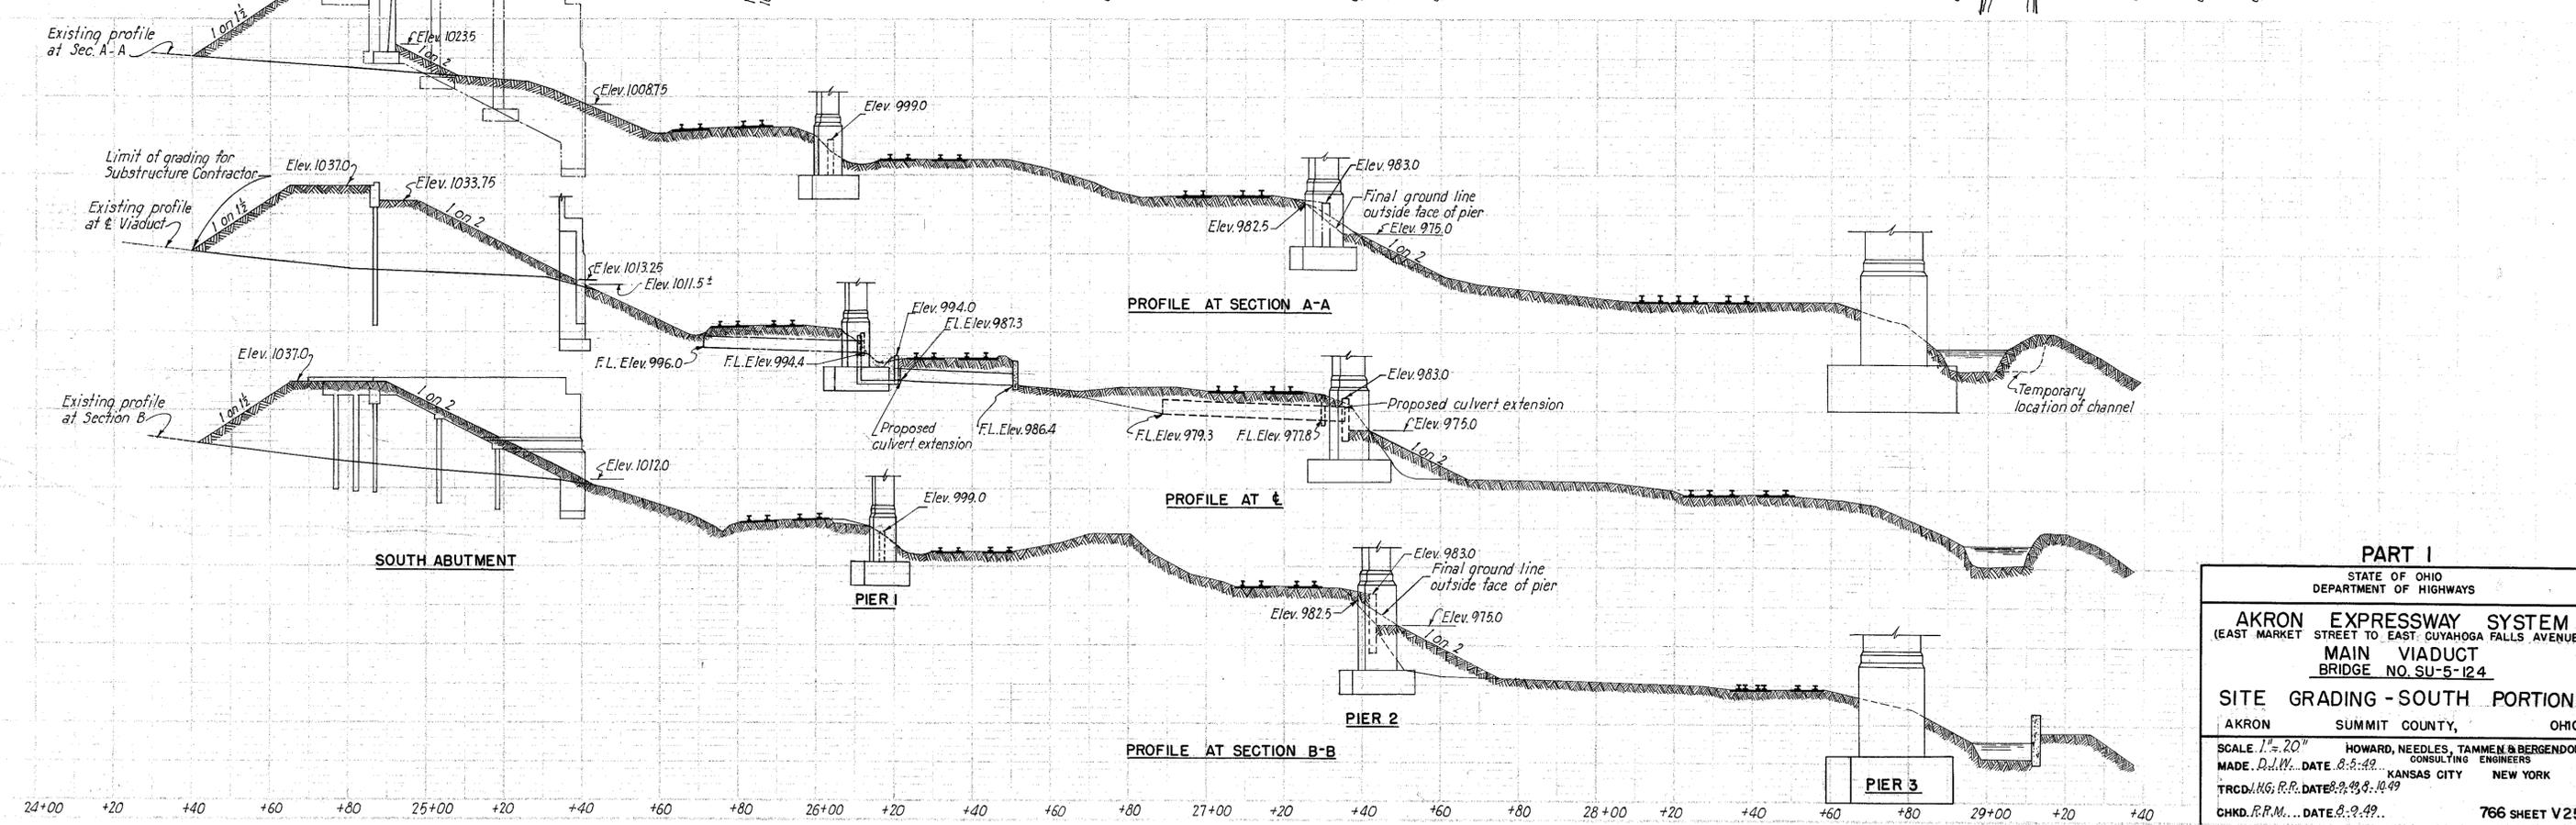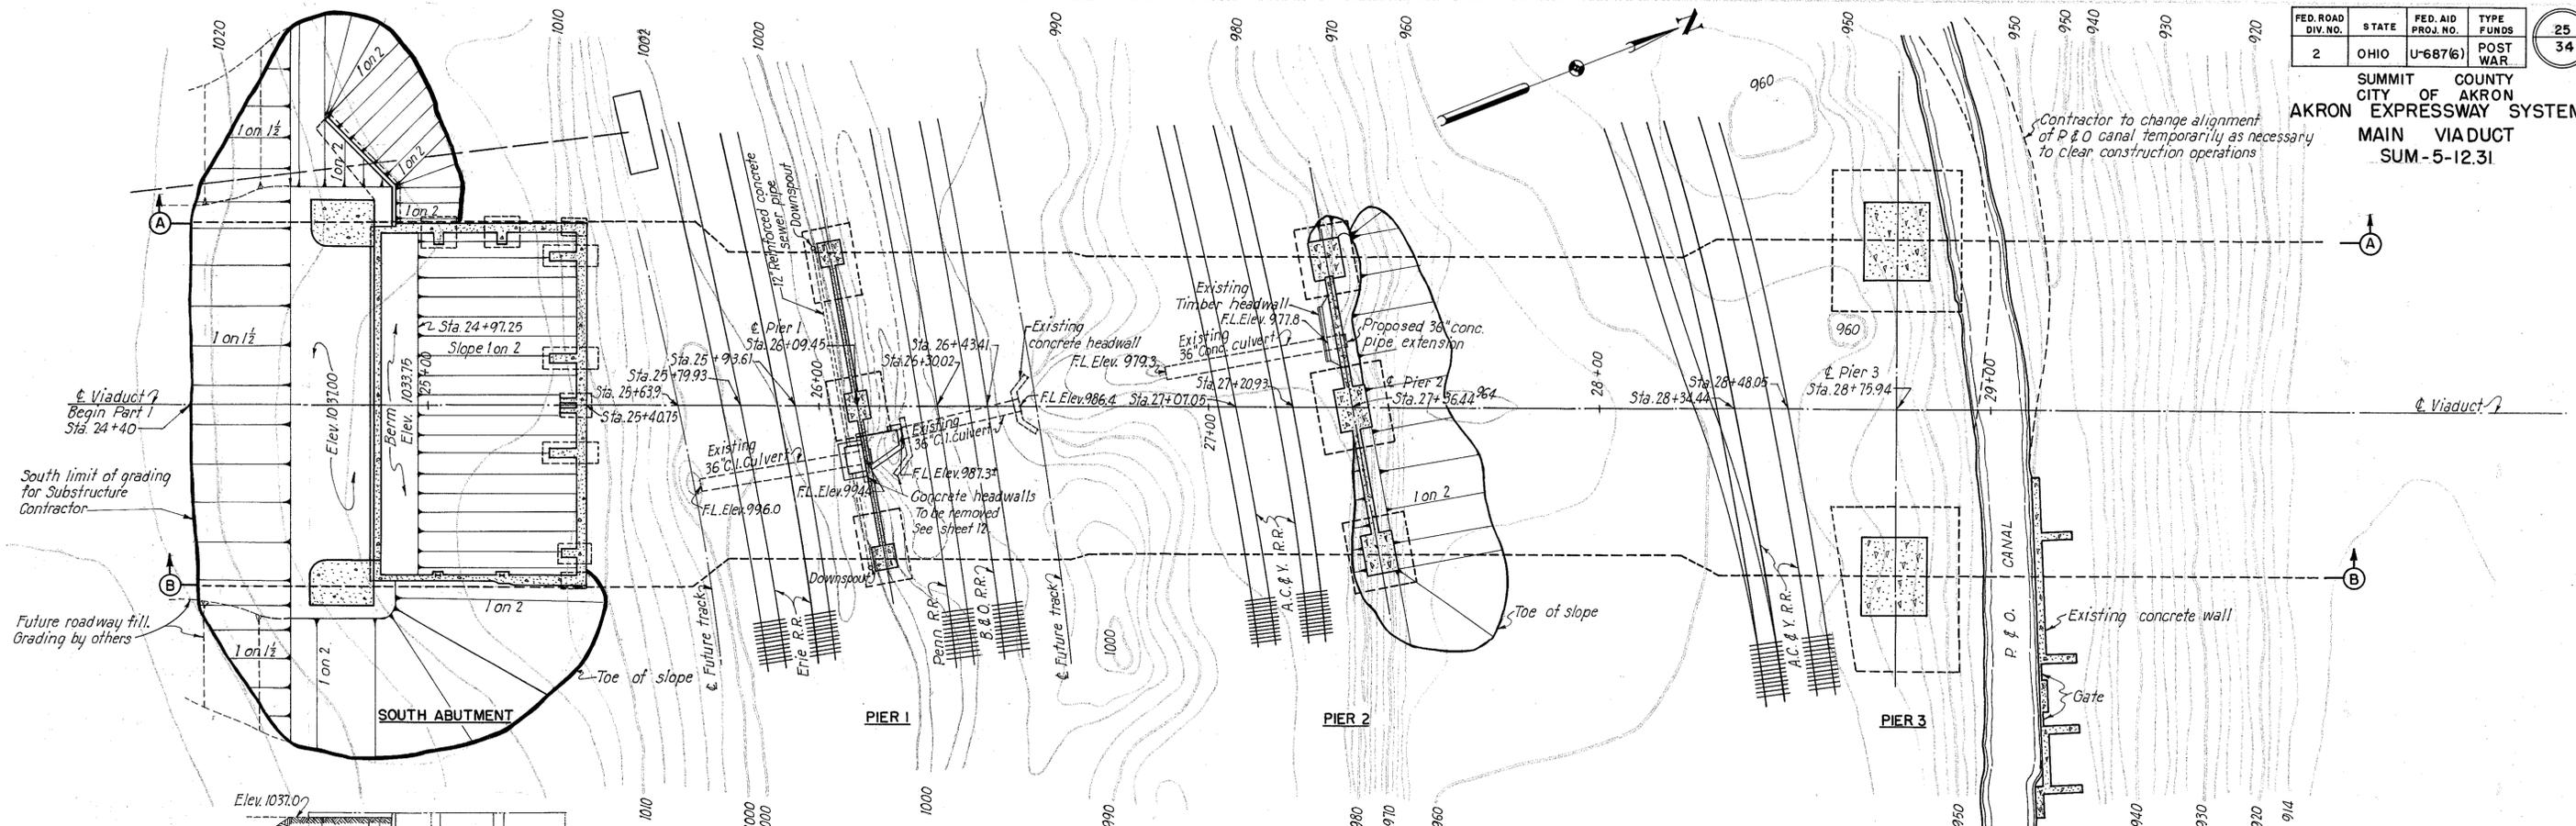

PART I
STATE OF OHIO
DEPARTMENT OF HIGHWAYS

AKRON EXPRESSWAY SYSTEM
(EAST MARKET STREET TO EAST CUYAHOGA FALLS AVENUE)
MAIN VIADUCT
BRIDGE NO. SU-5-12.4

SITE GRADING - SOUTH PORTION
AKRON SUMMIT COUNTY, OHIO


SCALE: 1" = 20'
MADE: D.W. DATE: 8-8-49
TRCD: J.H.G. R.P. DATE: 8-23-49
CHKD: R.R.M. DATE: 8-2-49

HOWARD, NEEDLES, TAMMEN & BERGENDOFF
CONSULTING ENGINEERS
KANSAS CITY NEW YORK

766 SHEET V25

FED. ROAD DIV. NO.	STATE	FED. AID PROJ. NO.	TYPE FUNDS	26
2	OHIO	U-687 6	POST WAR	34

SUMMIT COUNTY
CITY OF AKRON
AKRON EXPRESSWAY SYSTEM
MAIN VIADUCT
SUM-5-12.31

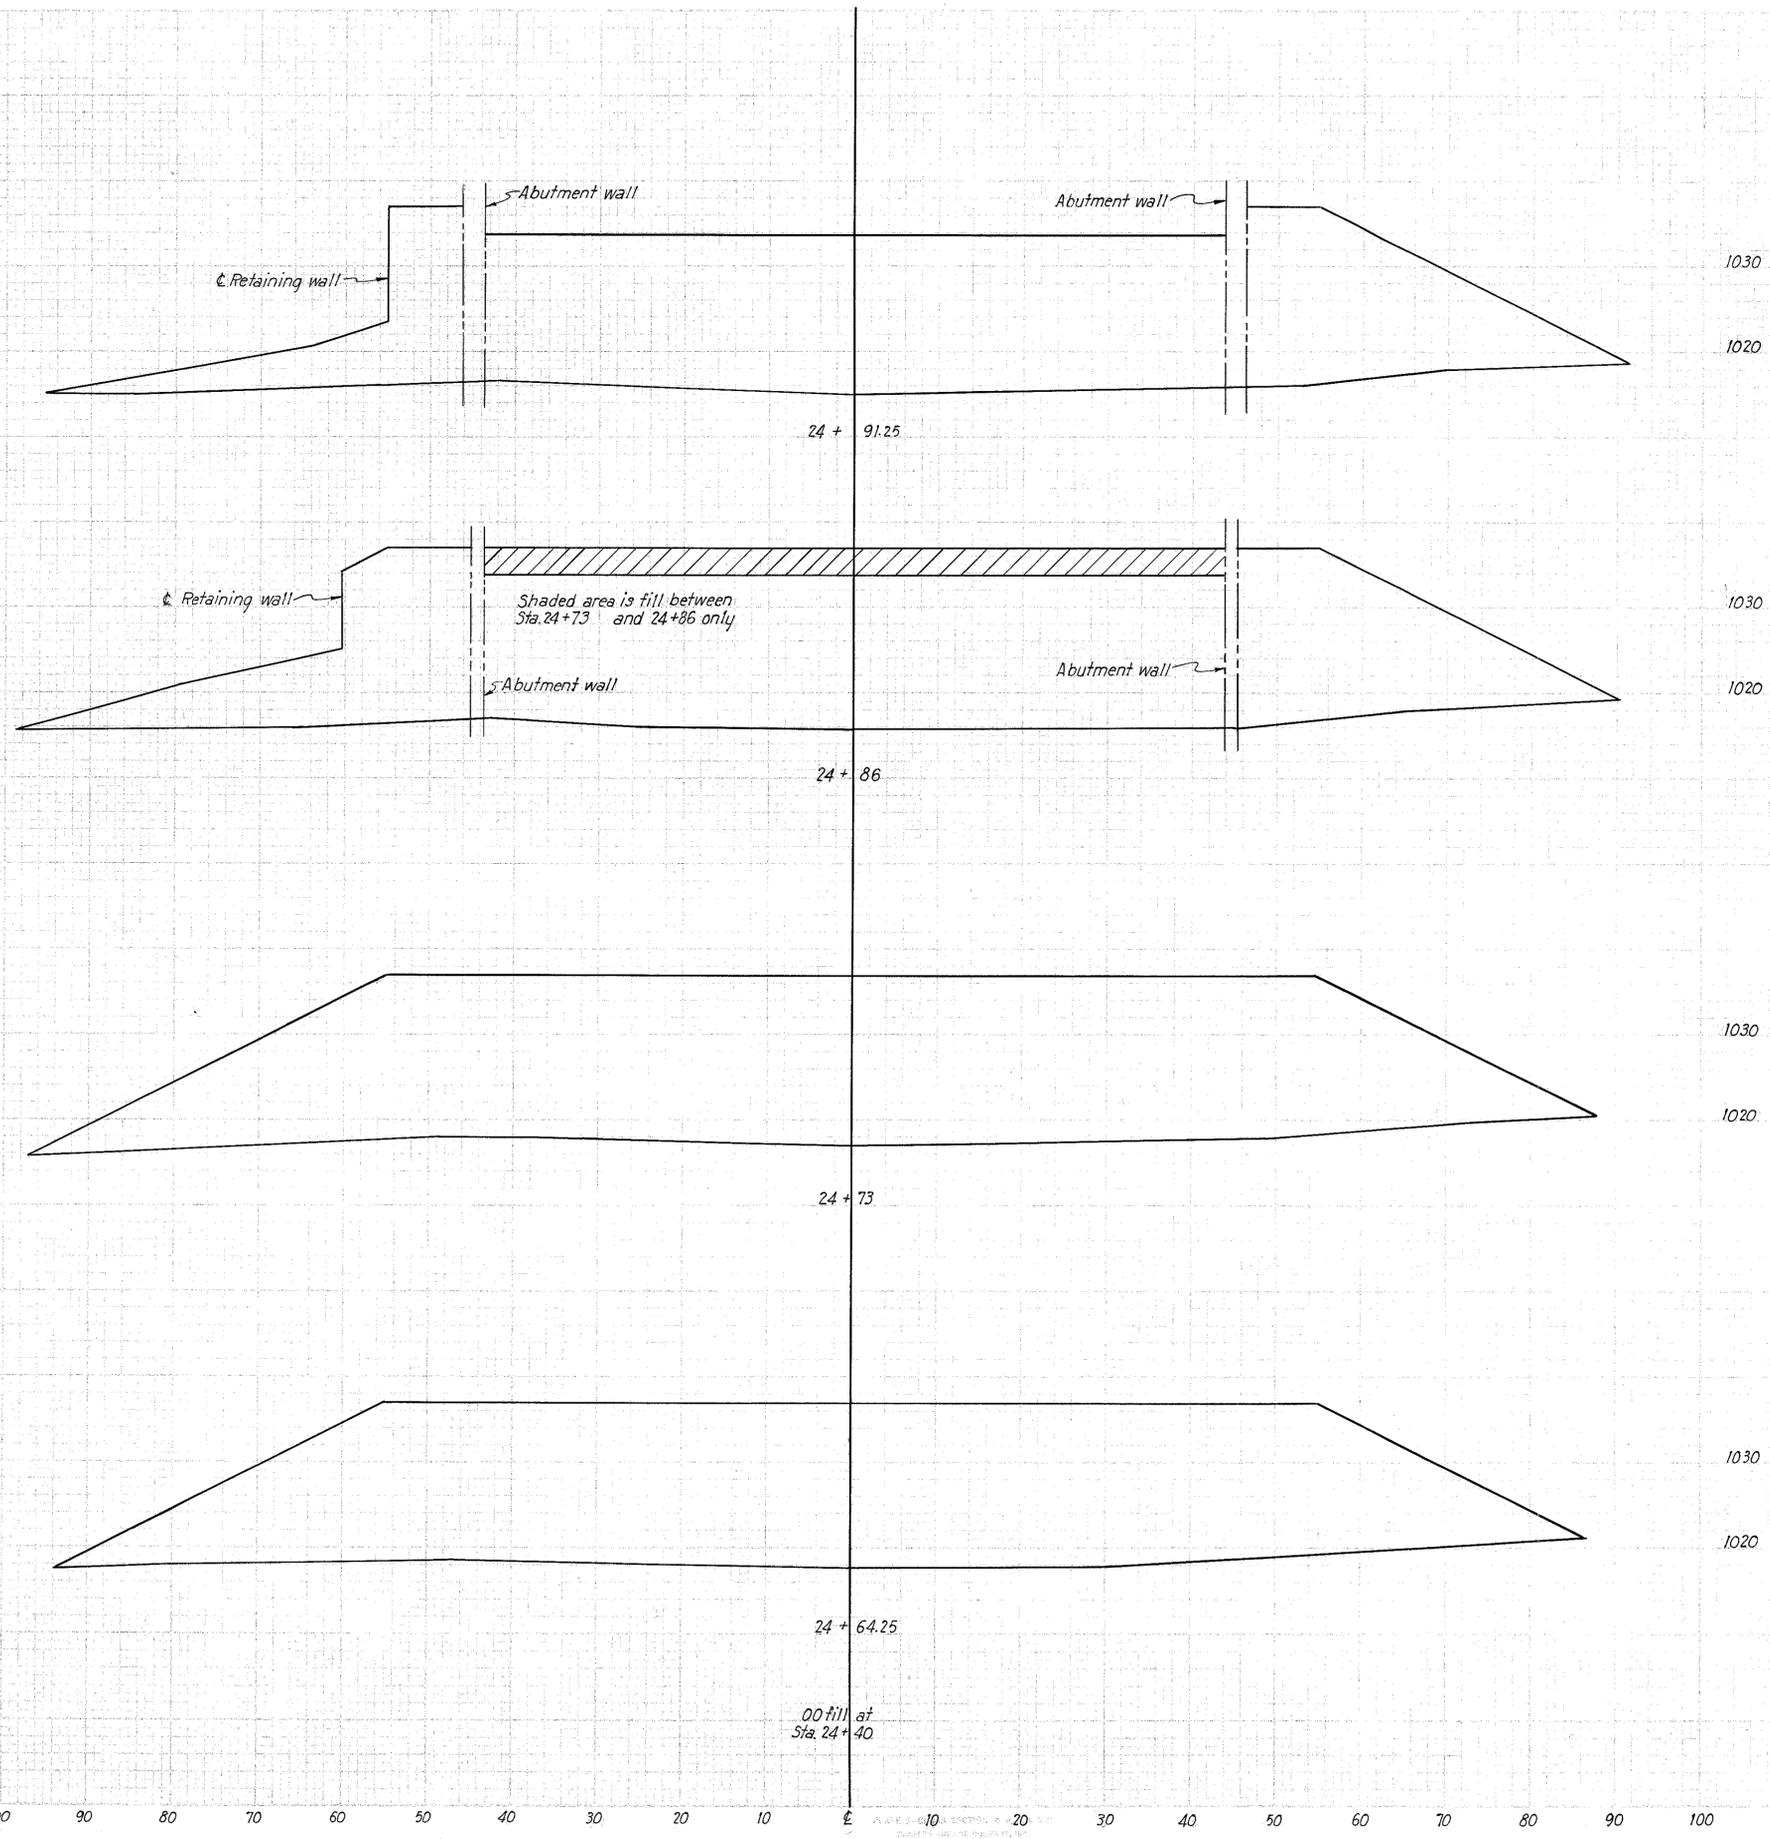


END AREA		VOLUME	
Cut	Fill	Cut	Fill
0	2410		484
		2575	
		2862	
			1365
0	2810		886
0	2660		1195

PART I
STATE OF OHIO
DEPARTMENT OF HIGHWAYS
AKRON EXPRESSWAY SYSTEM
(EAST MARKET STREET TO EAST CUYAHOGA FALLS AVENUE)
MAIN VIADUCT
BRIDGE NO. SU-5-124
SITE GRADING - SOUTH PORTION
AKRON, SUMMIT COUNTY, OHIO
SCALE 1" = 10'
MADE P.R.M. DATE 10-14-49
TRCD P.R.M. DATE 10-14-49
CHKD P.A.W. DATE 10-14-49
HOWARD, NEEDLES, TAMMEN & BERGENDOFF
CONSULTING ENGINEERS
KANSAS CITY NEW YORK
766 SHEET V26

FED. ROAD DIV. NO.	STATE	FED. AID PROJ. NO.	TYPE FUNDS	27
2	OHIO	U-687(6)	POST WAR	34

SUMMIT COUNTY
CITY OF AKRON
AKRON EXPRESSWAY SYSTEM
MAIN VIADUCT
SUM-5-12.31

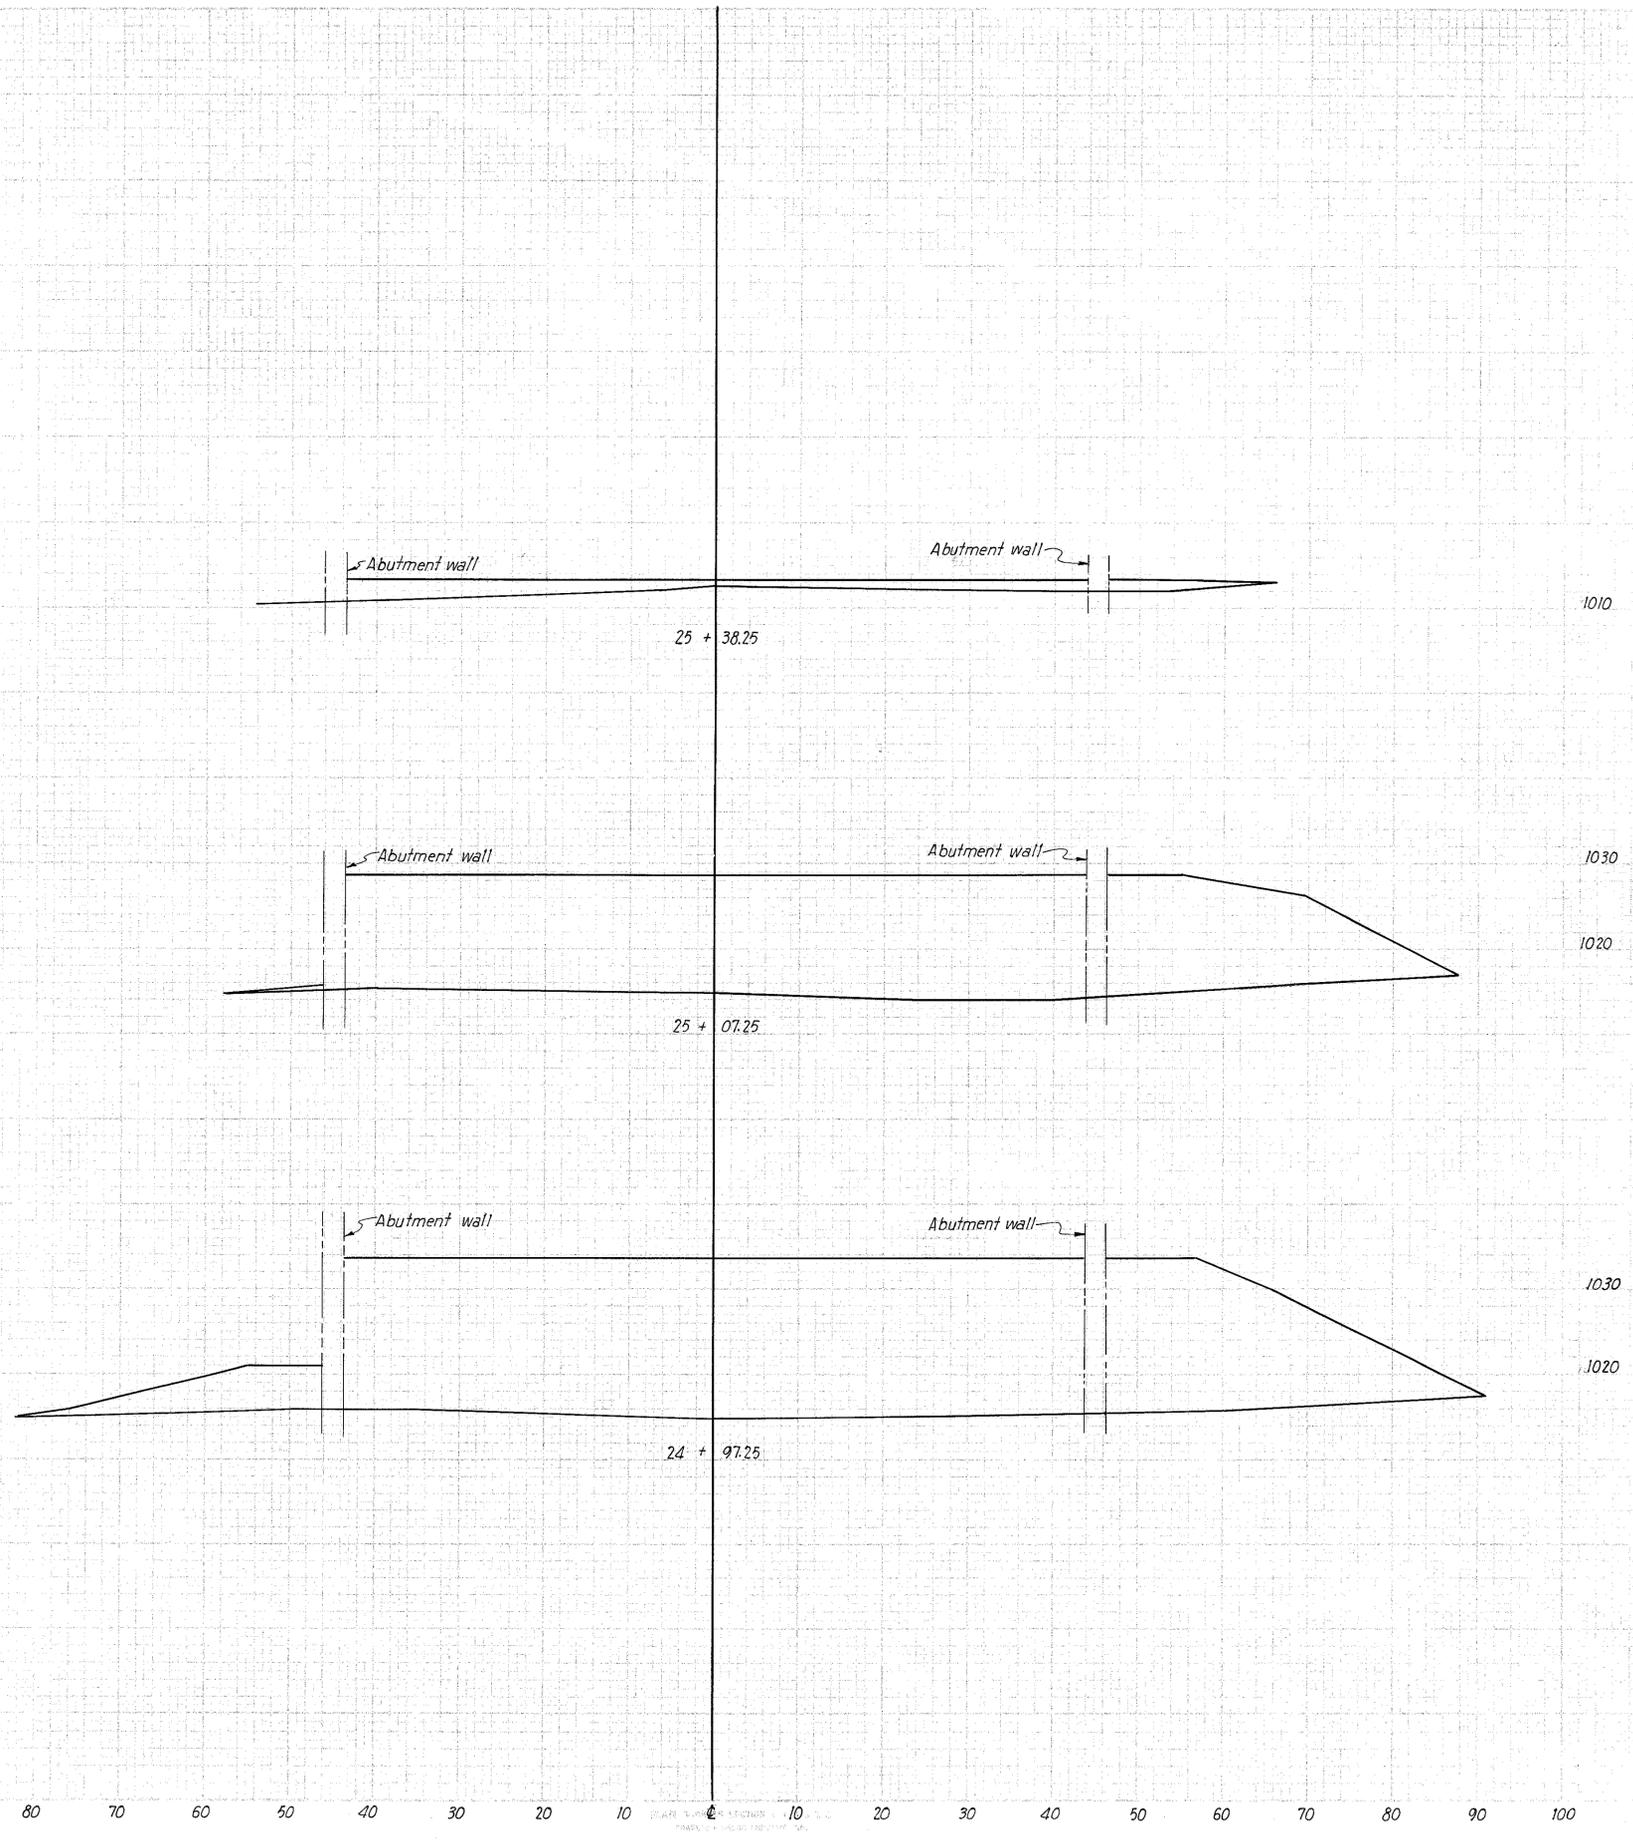

END AREA		VOLUME	
Cut	Fill	Cut	Fill
0	170		
0	1570		
0	2190		
		999	
			696
			511

PART I
STATE OF OHIO
DEPARTMENT OF HIGHWAYS
AKRON EXPRESSWAY SYSTEM
(EAST MARKET STREET TO EAST CUYAHOGA FALLS AVENUE)
MAIN VIADUCT
BRIDGE NO. SU-5-124
SITE GRADING - SOUTH PORTION
AKRON, SUMMIT COUNTY, OHIO
SCALE: 1"=10'
MADE P.R.M. DATE 10-14-49
TRCD P.R.M. DATE 10-14-49
CHKD O.J.W. DATE 10-14-49
HOWARD, NEEDLES, TAMMEN & BERGENDOFF
CONSULTING ENGINEERS
KANSAS CITY NEW YORK
766 SHEET V 27


SUMMARY FOR SOUTH PORTION BORROW

Embankment (gross)	6,460
Less concrete included in embankment	- 70
Net embankment	6,390
Shrinkage 20%	1,280
Total excavation required	7,670
Less excess structural excavation	2,090
Less site grading (cut)	- 55
Item E-4, borrow (gross) - South Portion	5,525 Cu.Yds.

FED. ROAD DIV. NO.	STATE	FED. AID PROJ. NO.	TYPE FUNDS
2	OHIO	U-687(6)	POST WAR

SUMMIT COUNTY
CITY OF AKRON
AKRON EXPRESSWAY SYSTEM
MAIN VIADUCT
SUM-5-12.31

END CUT	AREA FILL	VOLUME	
		CUT	FILL
10	130	1.0	12.0
		5.7	156
15	550		
		15.0	126
83	272		
		32.8	23.5
360	45		

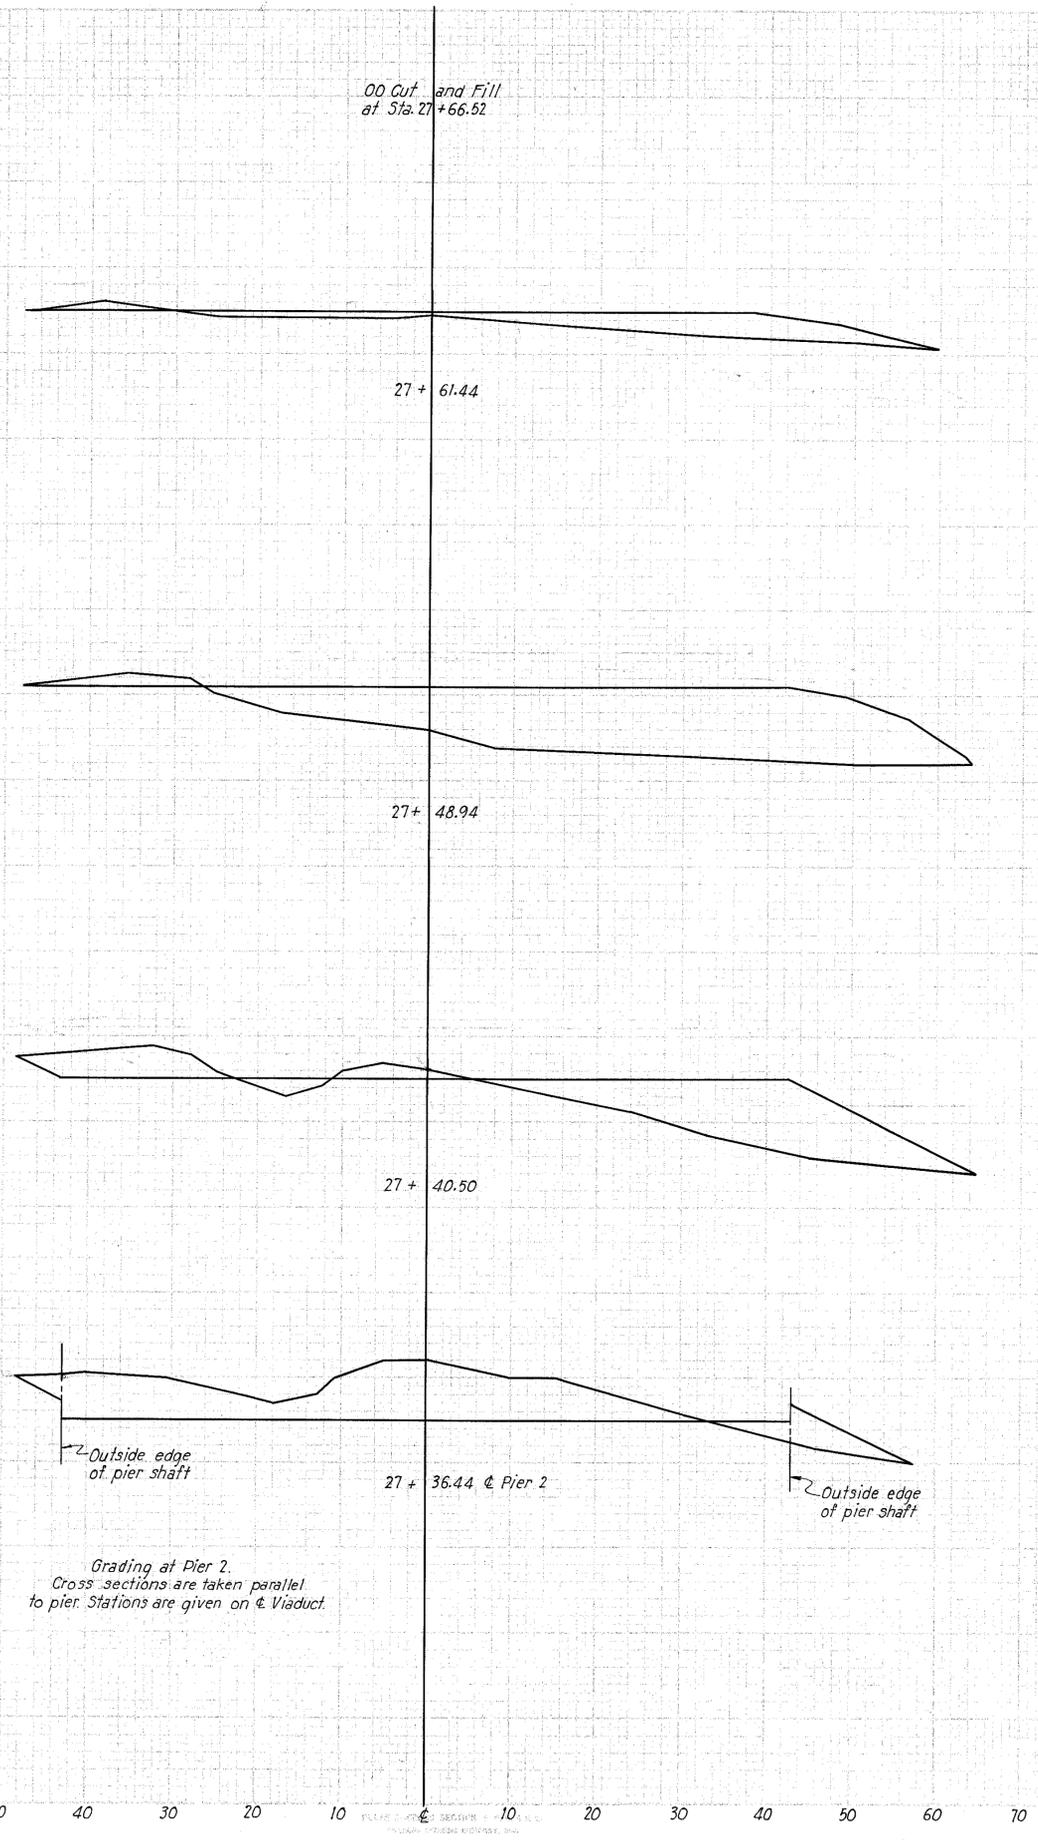

PART I

STATE OF OHIO
DEPARTMENT OF HIGHWAYS

AKRON EXPRESSWAY SYSTEM
(EAST MARKET STREET TO EAST CUYAHOGA FALLS AVENUE)
MAIN VIADUCT
BRIDGE NO. SU-5-124

SITE GRADING - SOUTH PORTION

AKRON, SUMMIT COUNTY, OHIO


SCALE 1" = 10'..... HOWARD, NEEDLES, TAMMEN & BERGENDOFF
MADE R.R.M. DATE 9-29-49 CONSULTING ENGINEERS
TRCD R.R.M. DATE 10-3-49 KANSAS CITY NEW YORK
CHKD. R.L.W. DATE 10-4-49 766 SHEET V28

110 100 90 80 70 60 50 40 30 20 10 0 10 20 30 40 50 60 70 80 90 100 110 120 130

FED. ROAD DIV. NO.	STATE	FED. AID PROJ. NO.	TYPE FUNDS
2	OHIO	U-687(6)	POST WAR

29
34

SUMMIT COUNTY
CITY OF AKRON
AKRON EXPRESSWAY SYSTEM
MAIN VIADUCT
SUM-5-12.31

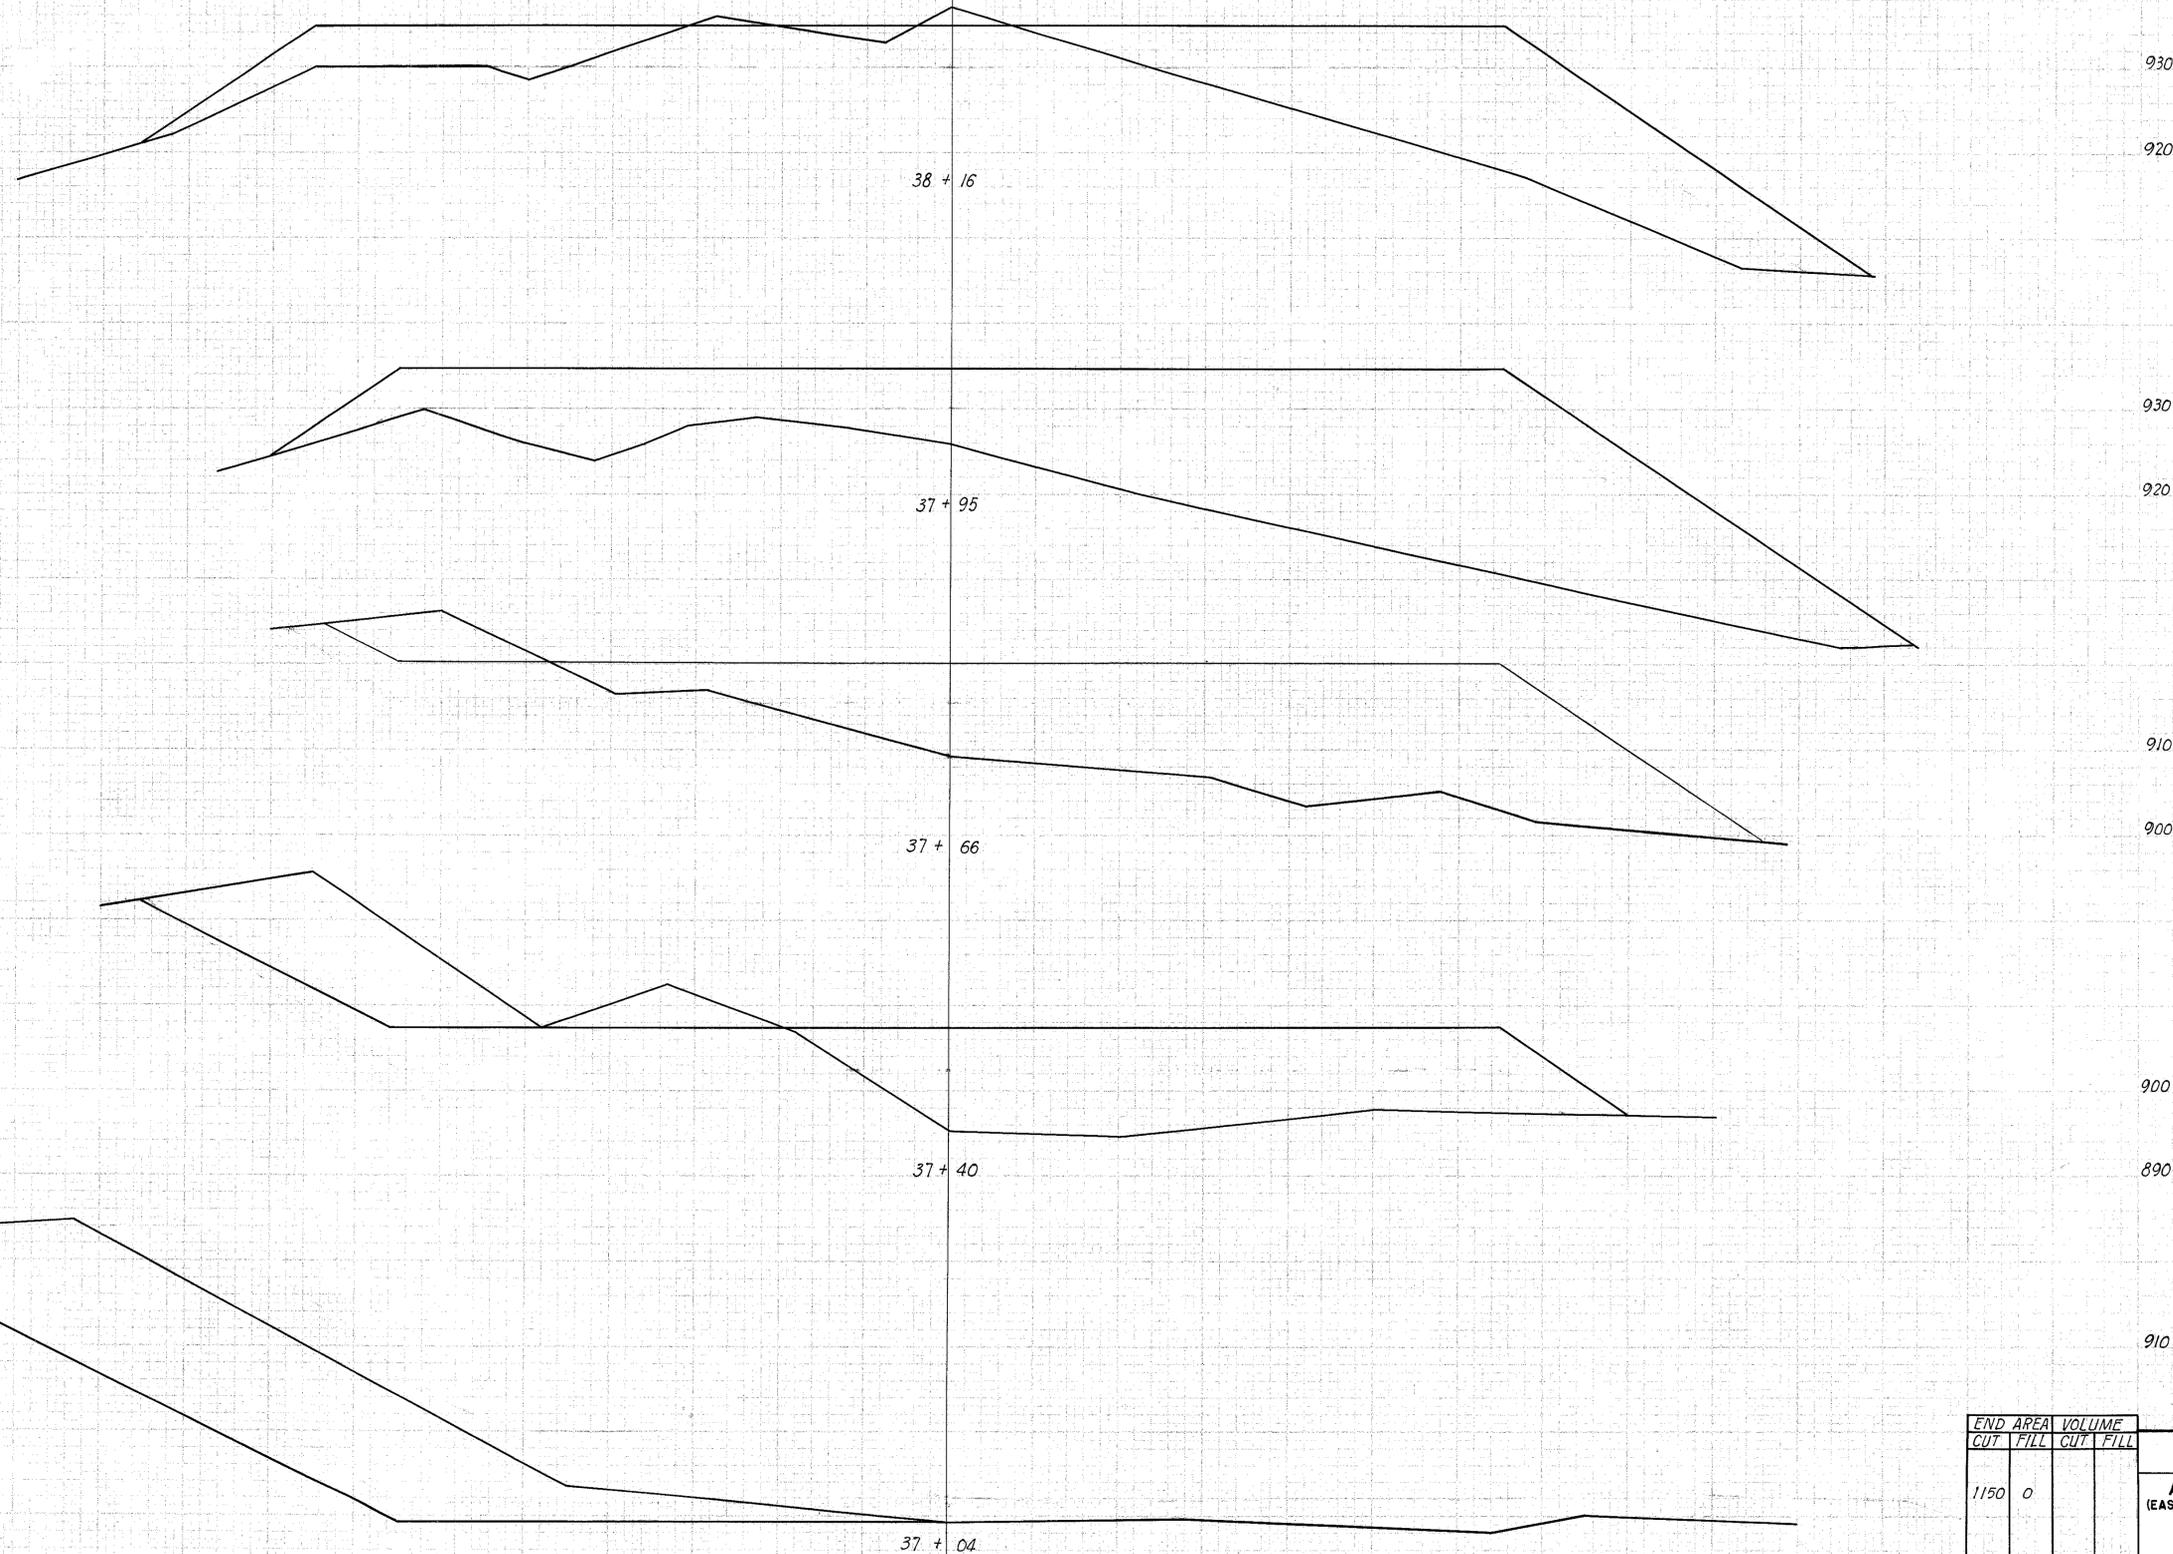

END AREA		VOLUME	
CUT	FILL	CUT	FILL
0	1180		
		0	1344
0	2275		
		54	1995
100	1440		
		265	1141
450	930		
		1067	620

Vertical Curve Data
Station
Grade
Length
Elevation

Vertical Curve Data
Station
Grade
Length
Elevation

00 Cut Section at Sta. 36+87

120 110 100 90 80 70 60 50 40 30 20 10 0 10 20 30 40 50 60 70 80 90 100 110

END AREA		VOLUME	
CUT	FILL	CUT	FILL
1150	0		
		362	0


PART I
STATE OF OHIO
DEPARTMENT OF HIGHWAYS
AKRON EXPRESSWAY SYSTEM
(EAST MARKET STREET TO EAST CUYAHOGA FALLS AVENUE)
MAIN VIADUCT
BRIDGE NO. SU-5-124
SITE GRADING - NORTH PORTION
AKRON, SUMMIT COUNTY, OHIO
SCALE: 1" = 10'
MADE R.S. DATE: 1-11-49
TRCD. P.S. DATE: 8-4-49
CHKD. A.H. DATE: 8-3-49
HOWARD, NEEDLES, TAMMEN & BERGENDOFF
CONSULTING ENGINEERS
KANSAS CITY NEW YORK
766 SHEET V29

110 100 90 80 70 60 50 40 30 20 10 0 10 20 30 40 50 60 70 80 90 100

FED. ROAD DIV. NO.	STATE	FED. AID PROJ. NO.	TYPE FUNDS
2	OHIO	U-687(6)	POST WAR

30
34

SUMMIT COUNTY
CITY OF AKRON
AKRON EXPRESSWAY SYSTEM
MAIN VIADUCT
SUM-5-12.31

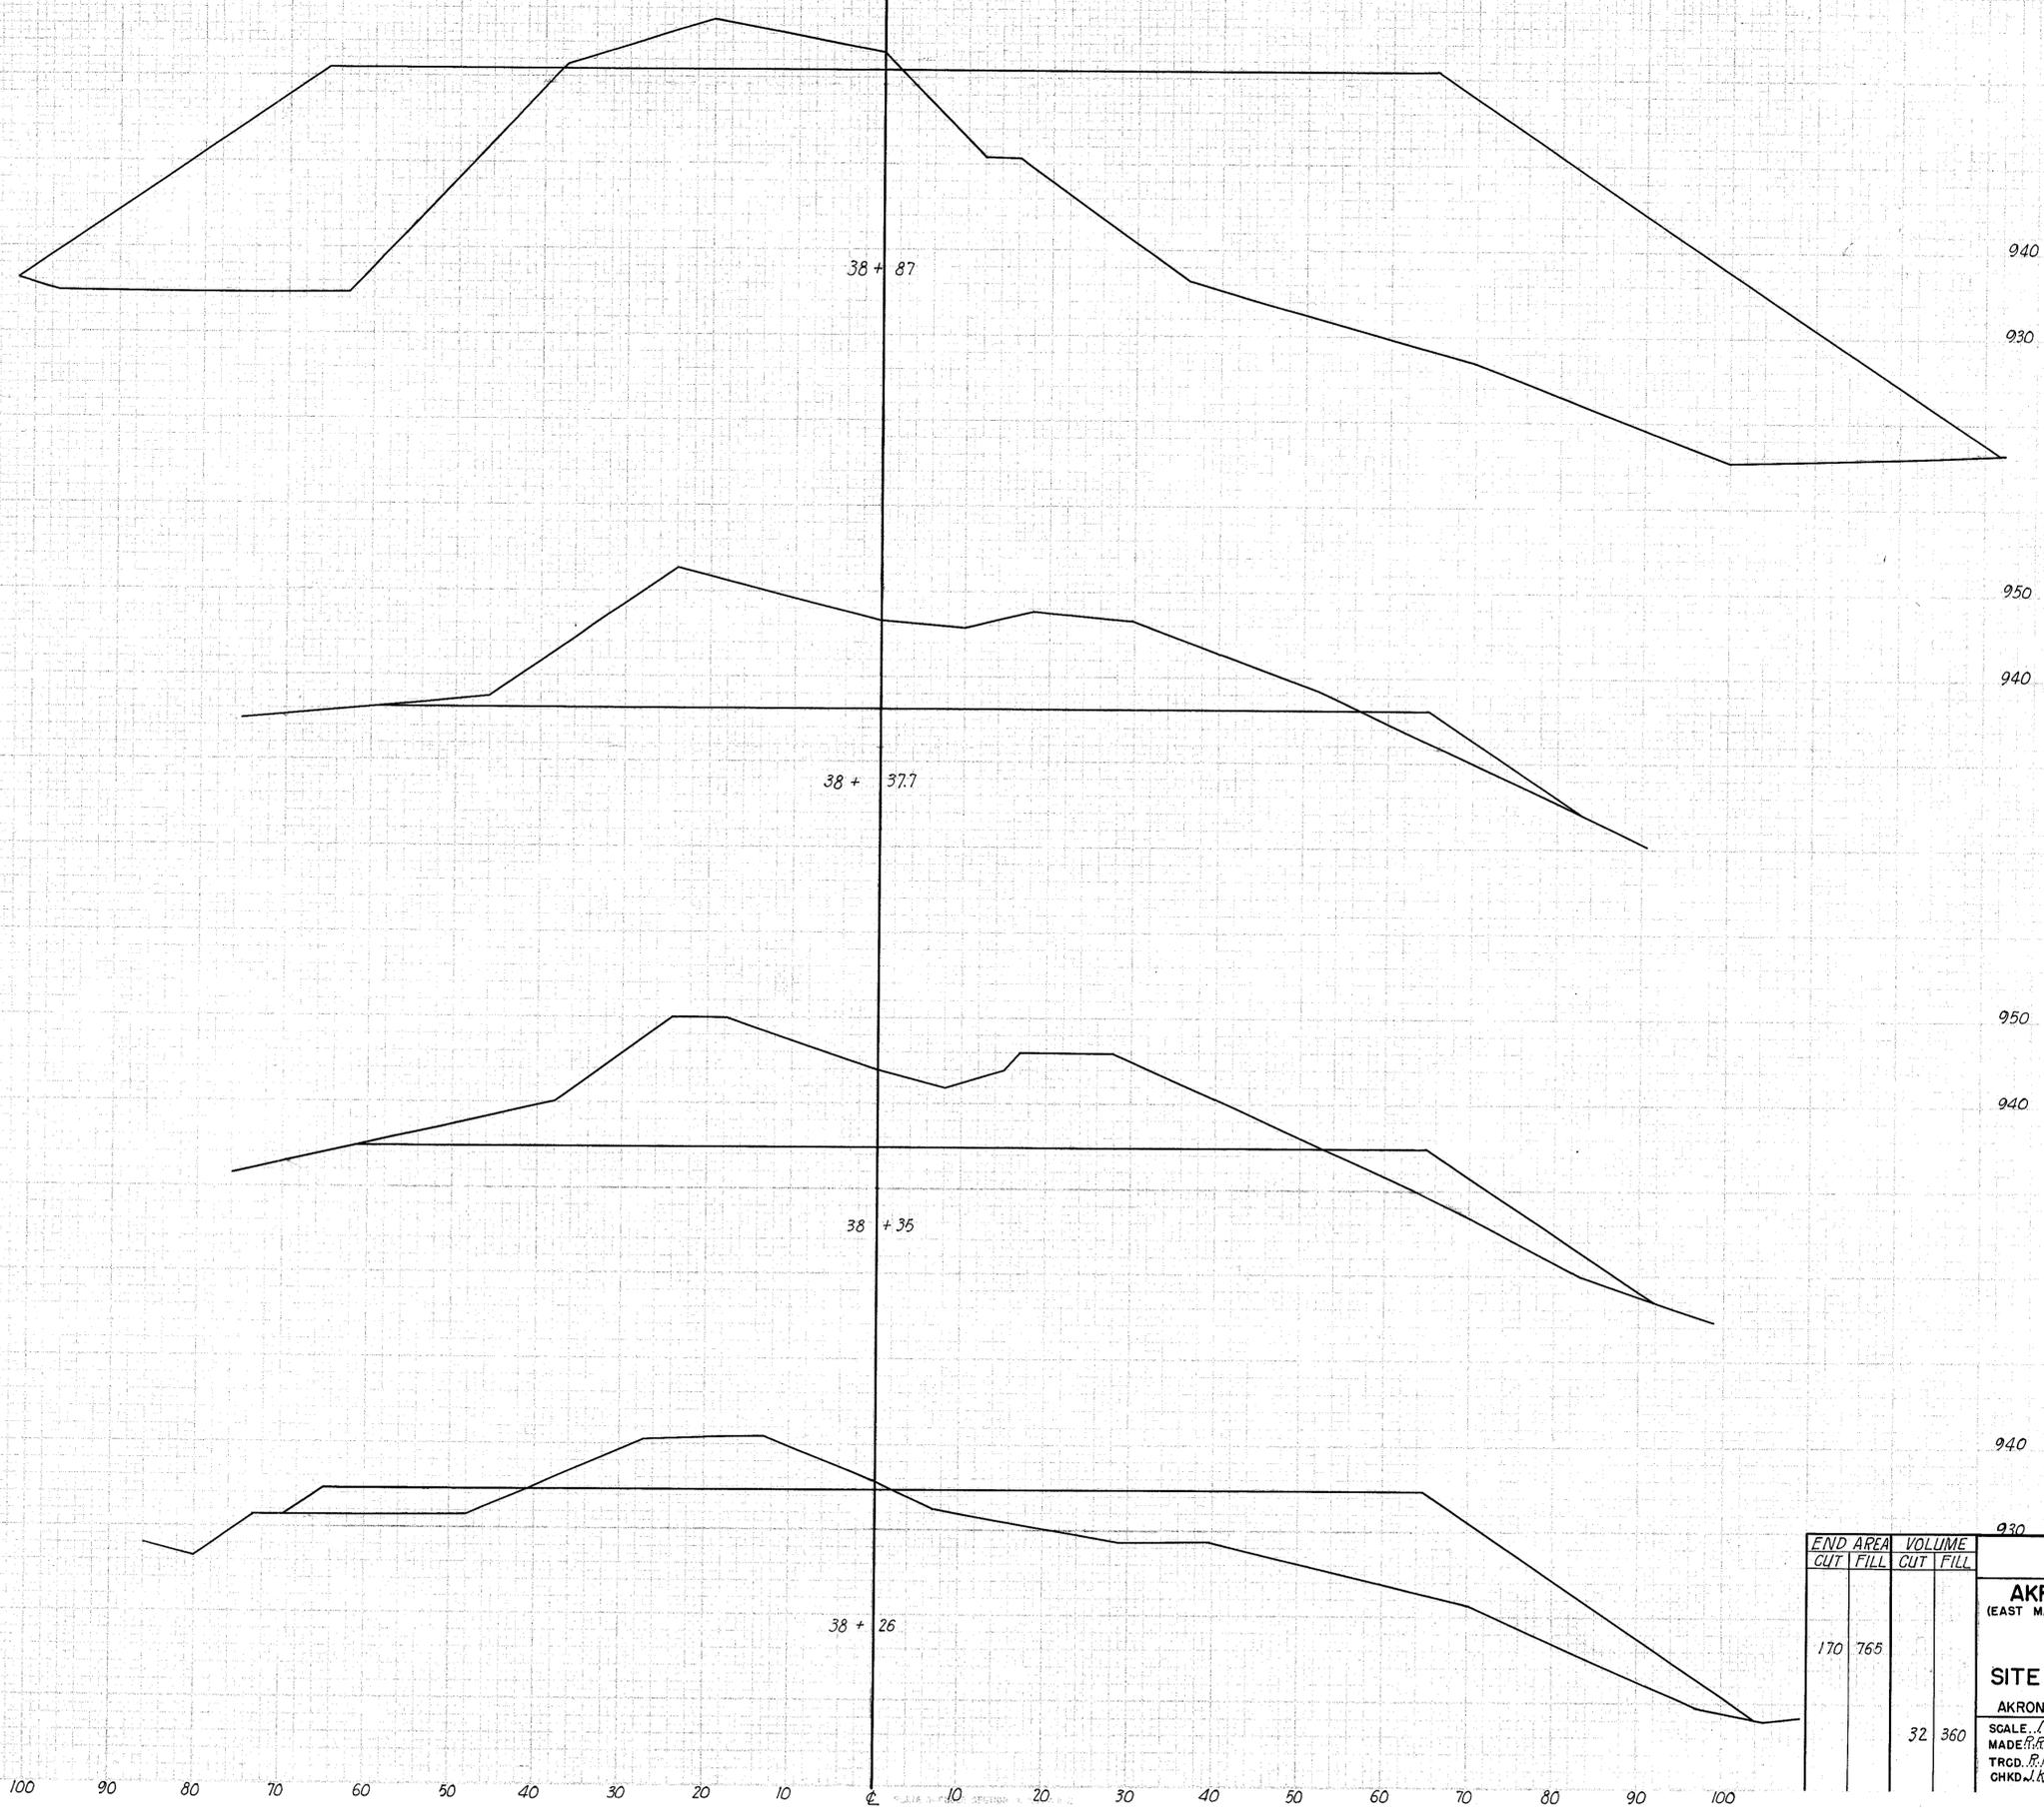

END AREA		VOLUME	
CUT	FILL	CUT	FILL
140	3435		
		1058	3182
1020	50		
		96	9
1910	125		
		180	148

END AREA		VOLUME	
CUT	FILL	CUT	FILL
170	765		
		32	360

PART I
STATE OF OHIO
DEPARTMENT OF HIGHWAYS
AKRON EXPRESSWAY SYSTEM
(EAST MARKET STREET TO EAST GUYAHOGA FALLS AVENUE)
MAIN VIADUCT
BRIDGE NO. SU-5-124
SITE GRADING NORTH PORTION
AKRON, SUMMIT COUNTY, OHIO
SCALE 1/4"=10'
MADE P.R.M. DATE 7-11-49 HOWARD, NEEDLES, TAMMEN & BERGENDOFF
TRCD. P.R.M. DATE 8-4-49 CONSULTING ENGINEERS
CHKD. I.C.M. DATE 8-5-49 KANSAS CITY NEW YORK
766 SHEET V 30


100 90 80 70 60 50 40 30 20 10 0 10 20 30 40 50 60 70 80 90 100

100 90 80 70 60 50 40 30 20 10 0 10 20 30 40 50 60 70 80 90 100 110 120 130 140

FED. ROAD DIV. NO.	STATE	FED. AID PROJ. NO.	TYPE FUNDS
2	OHIO	U-687(6)	POST WAR

31
34

SUMMIT COUNTY
CITY OF AKRON
AKRON EXPRESSWAY SYSTEM
MAIN VIADUCT
SUM-5-12.31

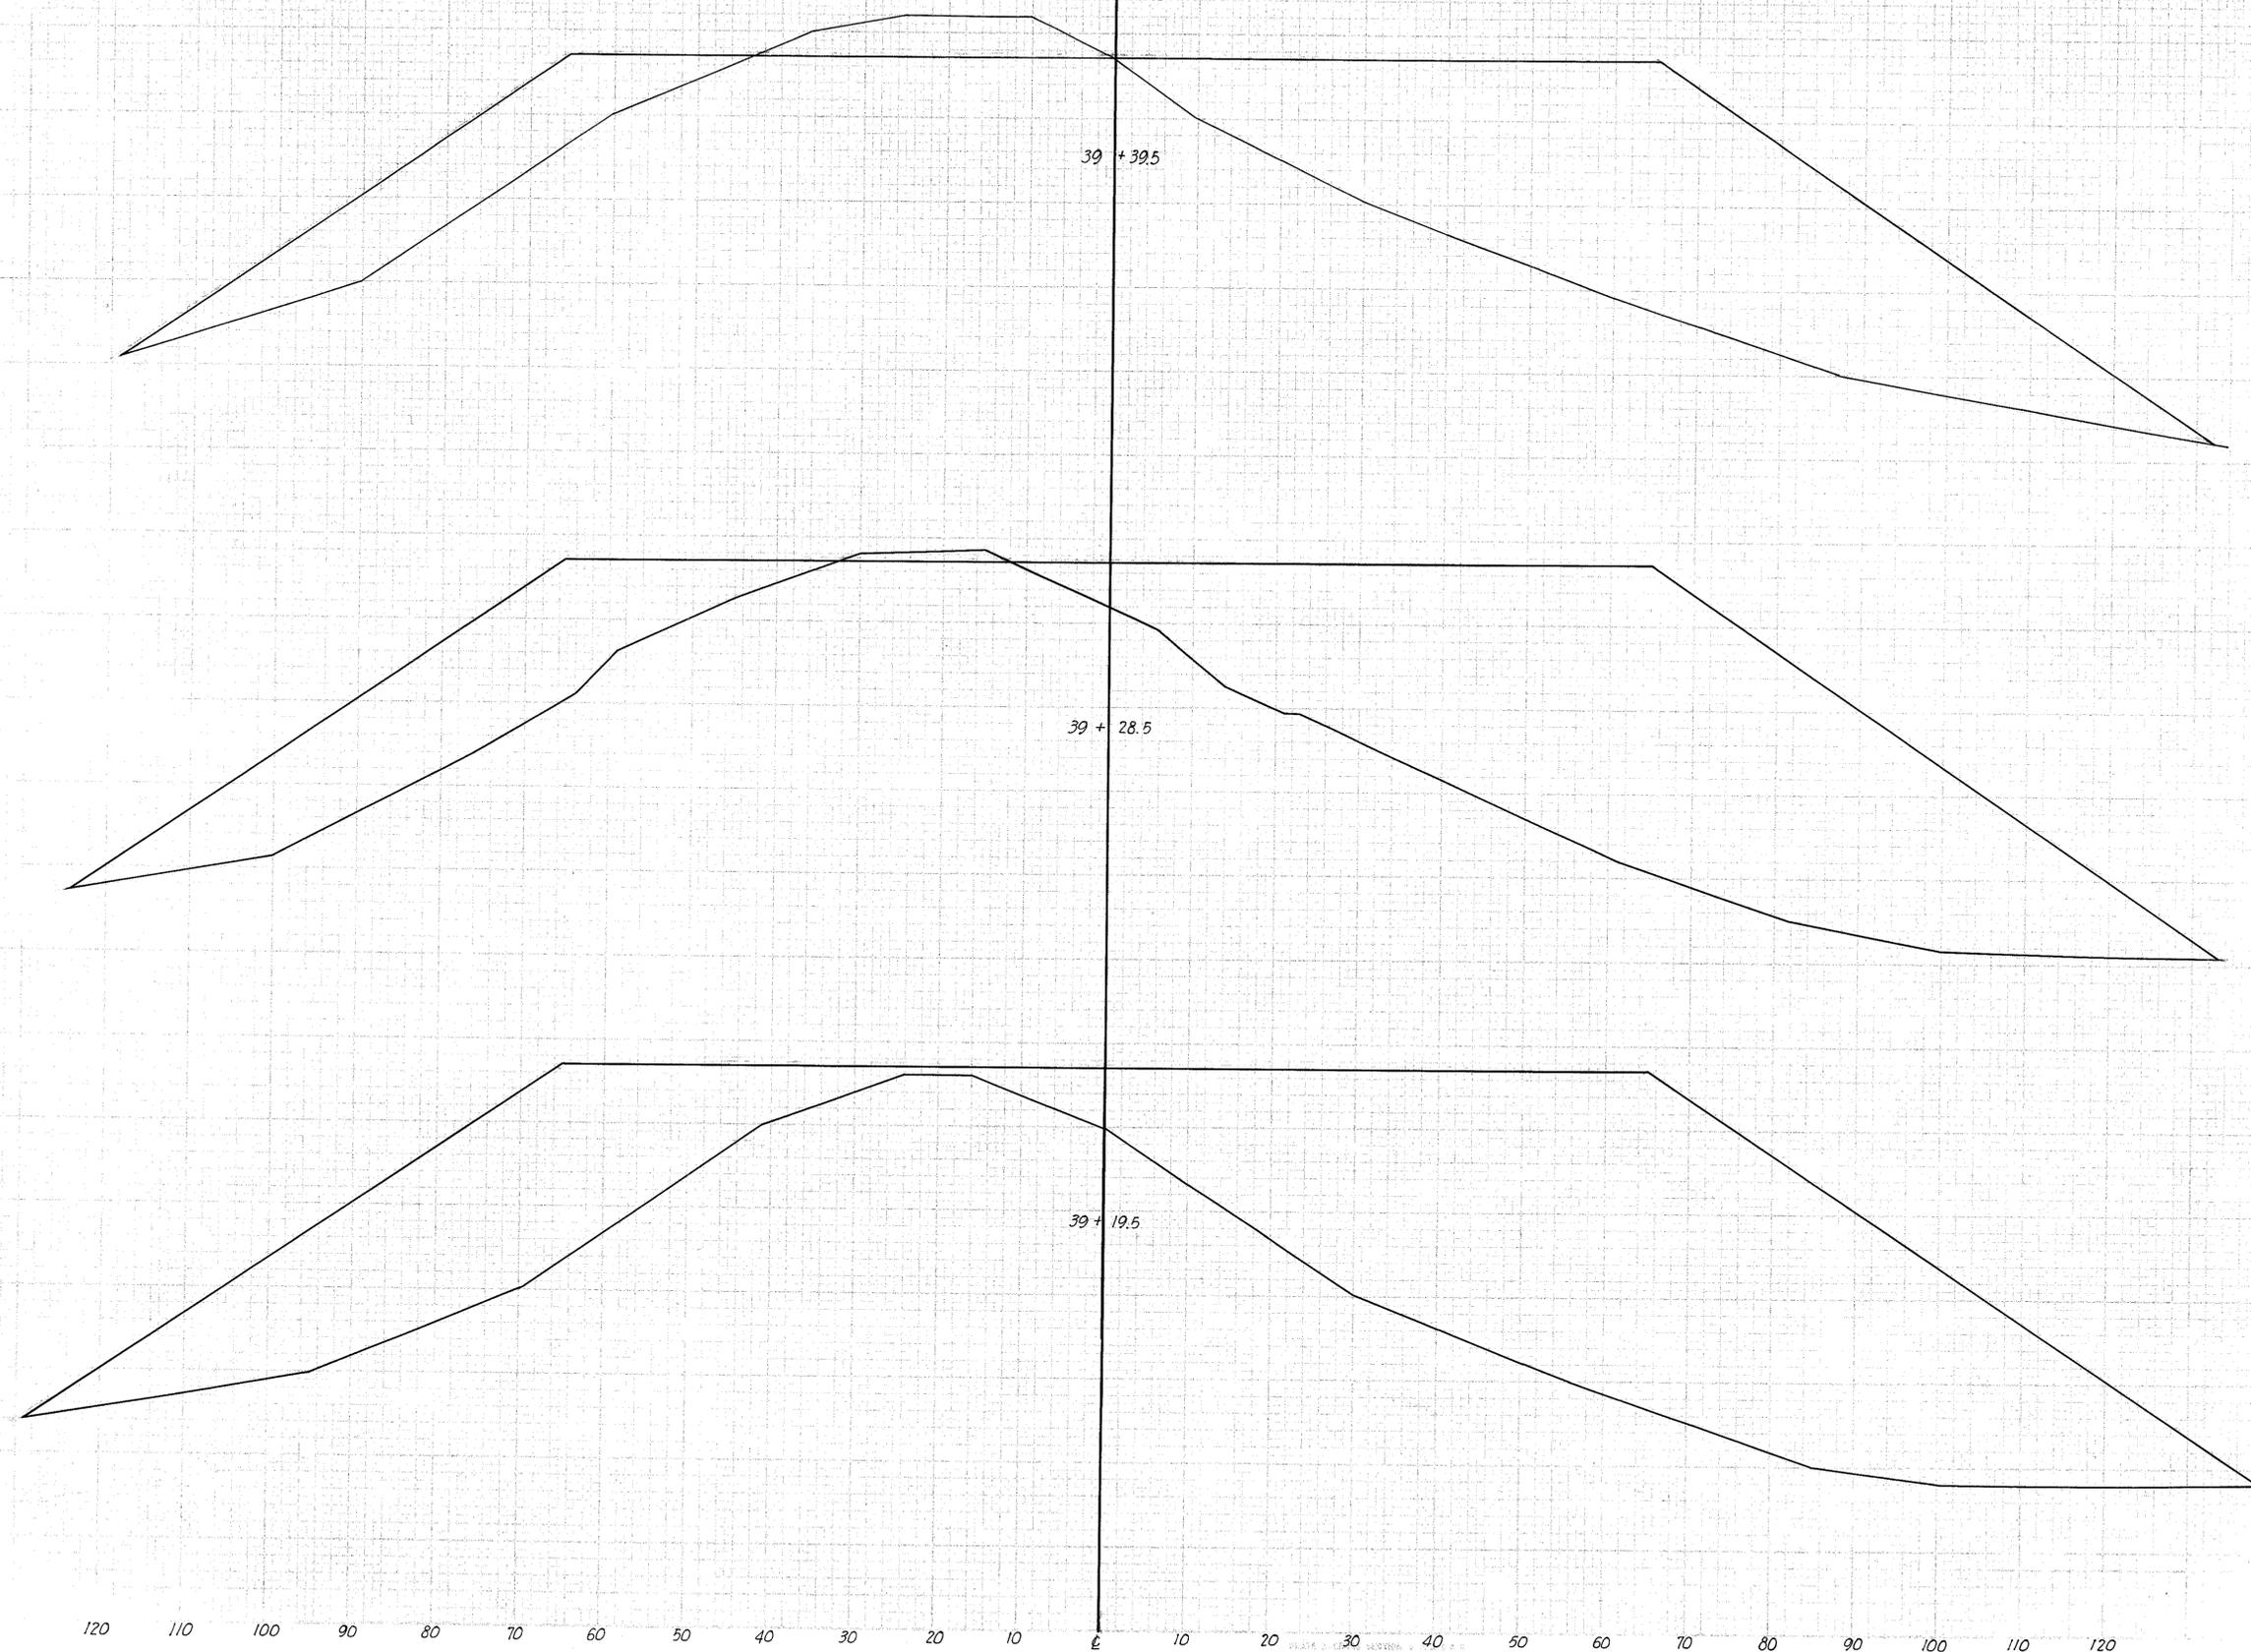

END CUT	AREA		VOLUME	
	CUT	FILL	CUT	FILL
970	140	2675		
960			33	1298
970				
960	20	3695		
			3	1417
970				
960	0	4810		
			84	4962


PART I

STATE OF OHIO
DEPARTMENT OF HIGHWAYS
AKRON EXPRESSWAY SYSTEM
(EAST MARKET STREET TO EAST CUYAHOGA FALLS AVENUE)
MAIN VIADUCT
BRIDGE NO. SU-5-124
SITE GRADING - NORTH PORTION
AKRON, SUMMIT COUNTY, OHIO
SCALE 1"=10'..... HOWARD, NEEDLES, TAMMEN & BERGENDOFF
MADE R.R.M. DATE 7-11-49 CONSULTING ENGINEERS
TRCD. P.R. DATE 8-4-49 KANSAS CITY NEW YORK
CHKD. J.K.M. DATE 8-5-49 766 SHEET V31

150 140 130 120 110 100 90 80 70 60 50 40 30 20 10 0 10 20 30 40 50 60 70 80 90 100 110 120 130

FED. ROAD DIV. NO.	STATE	FED. AID PROJ. NO.	TYPE FUNDS	32 34
2	OHIO	U-687(6)	POST WAR	

SUMMIT COUNTY
CITY OF AKRON
AKRON EXPRESSWAY SYSTEM
MAIN VIADUCT
SUM-5-12.31

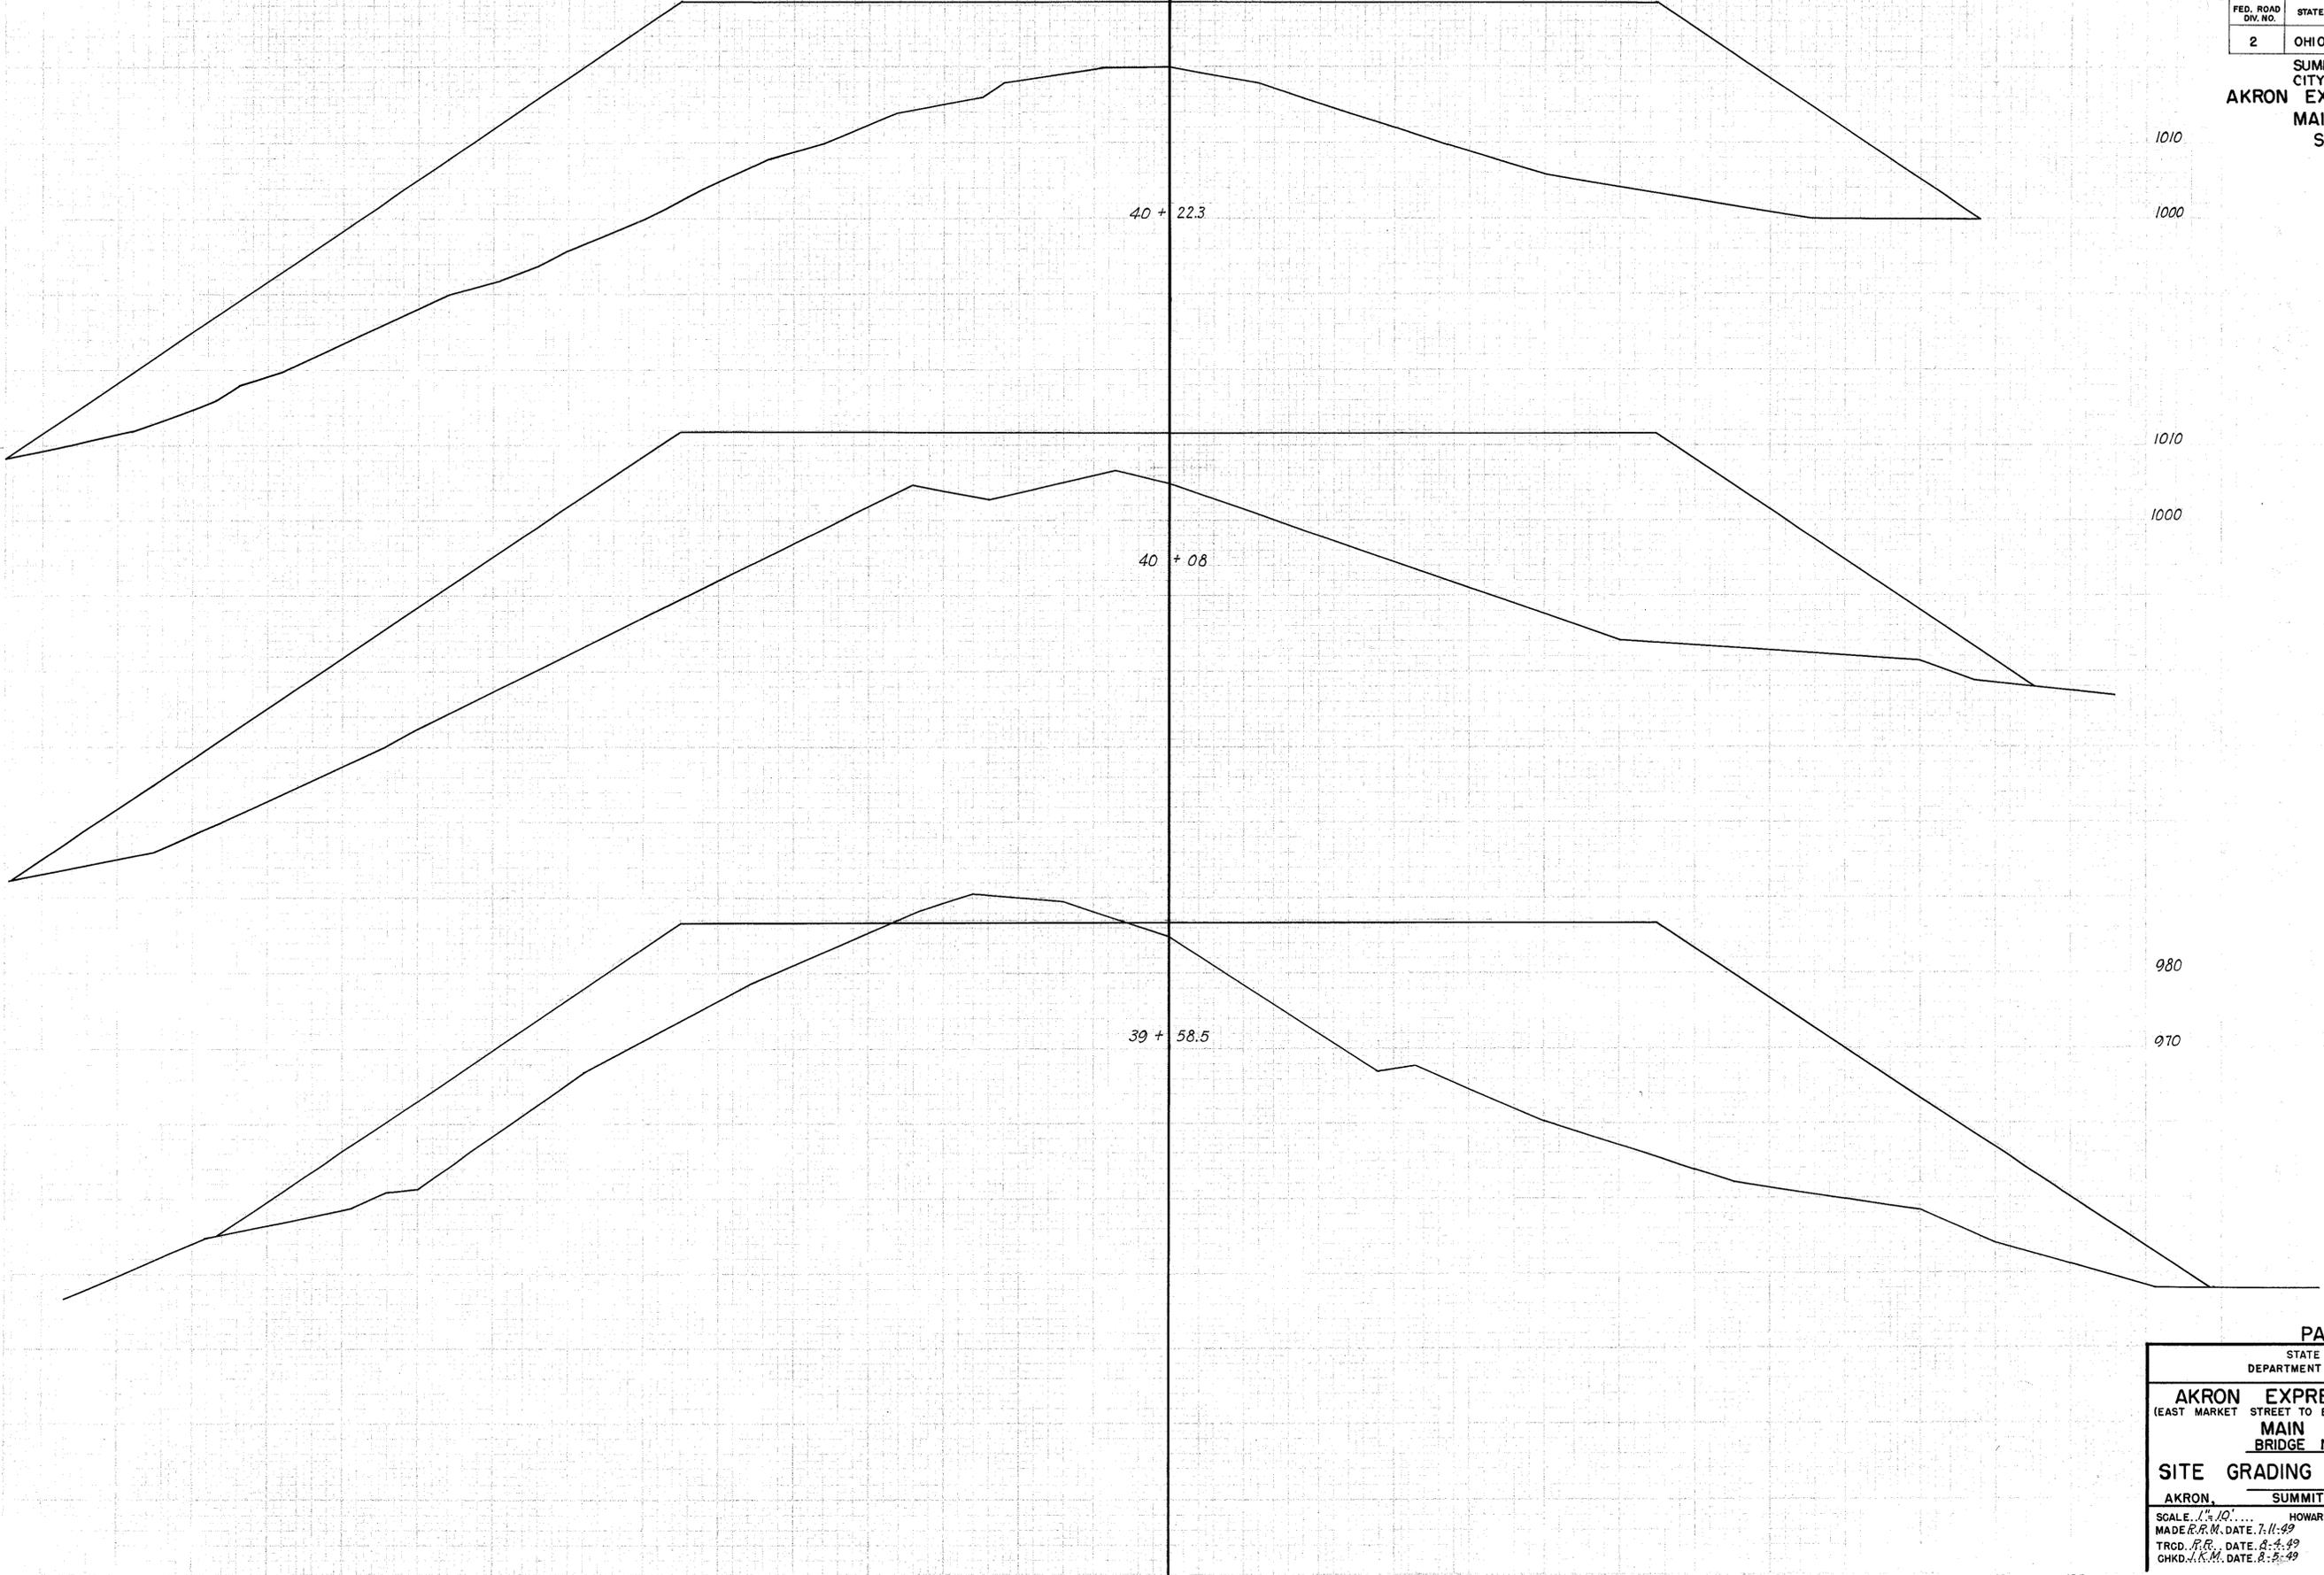

END STA.	AREA		VOLUME	
	CUT	FILL	CUT	FILL
0	4000			
0	3670			
64			6233	
74				2042

PART I

STATE OF OHIO
DEPARTMENT OF HIGHWAYS

AKRON EXPRESSWAY SYSTEM
(EAST MARKET STREET TO EAST CUYAHOGA FALLS AVENUE)
MAIN VIADUCT
BRIDGE NO. SU-5-124

SITE GRADING NORTH PORTION

AKRON, SUMMIT COUNTY, OHIO


SCALE: 1" = 10'
MADE R.R.M. DATE: 7-11-49
TRCD. R.R.M. DATE: 8-4-49
CHKD. R.R.M. DATE: 8-5-49

HOWARD, NEEDLES, TAMMEN & BERGENDOFF
CONSULTING ENGINEERS
KANSAS CITY NEW YORK

766 SHEET V32

150 140 130 120 110 100 90 80 70 60 50 40 30 20 10 0 10 20 30 40 50 60 70 80 90 100 110 120

140 130 120 110 100 90 80 70 60 50 40 30 20 10 0 10 20 30 40 50 60 70 80 90 100 110 120 130

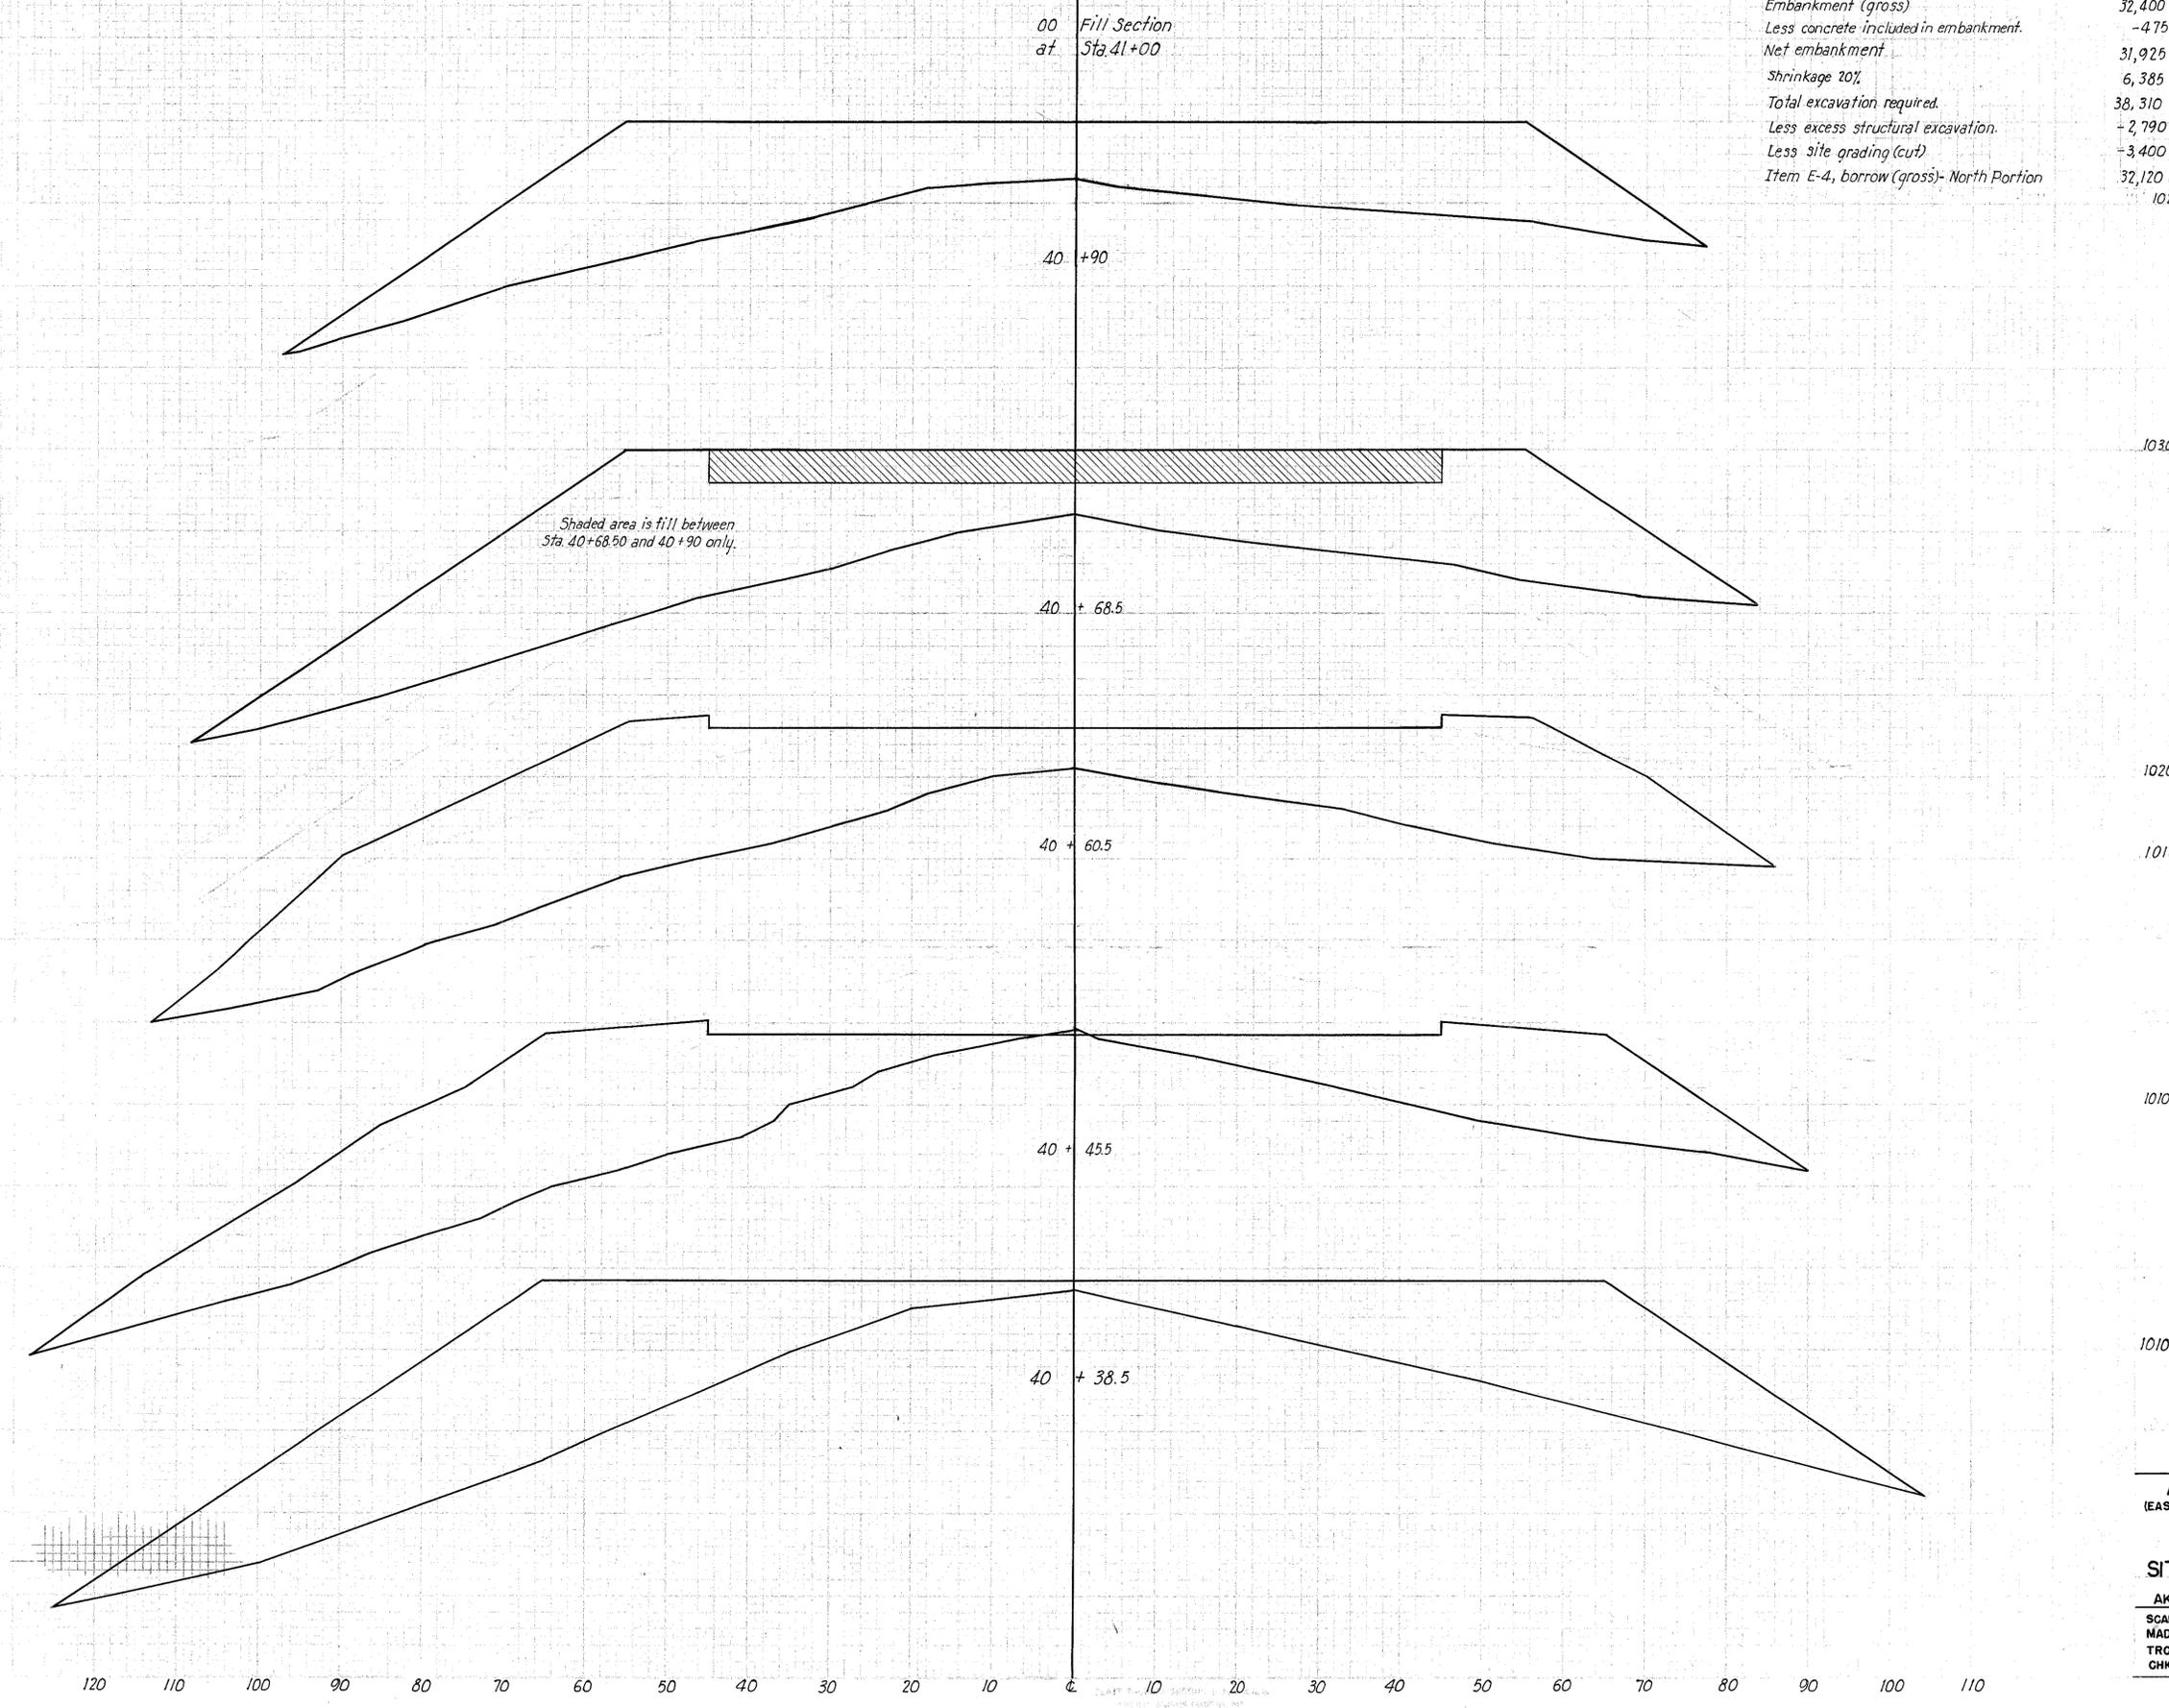

SUMMARY FOR NORTH PORTION BORROW

Embankment (gross)	32,400
Less concrete included in embankment.	-475
Net embankment	31,925
Shrinkage 20%	6,385
Total excavation required.	38,310
Less excess structural excavation.	-2,790
Less site grading (cut)	-3,400
Item E-4, borrow (gross)- North Portion	32,120 Cu. Yds.
	1020

FED. ROAD DIV. NO.	STATE	FED. AID PROJ. NO.	TYPE FUNDS	33 34
2	OHIO	U-687(6)	POST WAR	

SUMMIT COUNTY
CITY OF AKRON
AKRON EXPRESSWAY SYSTEM
MAIN VIADUCT
SUM-5-12.31

END STA.	AREA		VOLUME	
	CUT	FILL	CUT	FILL
0	0	0	0	189
0	1020	0	0	1296
0	2235	0	0	612
0	1875	0	0	1145
0	2260	0	0	520
0	1860	0	0	1846
0	2155	0	0	

PART I
STATE OF OHIO
DEPARTMENT OF HIGHWAYS

AKRON EXPRESSWAY SYSTEM
(EAST MARKET STREET TO EAST CUYAHOGA FALLS AVENUE)
MAIN VIADUCT
BRIDGE NO. SU-5-124

SITE GRADING NORTH PORTION

AKRON, SUMMIT COUNTY, OHIO


SCALE: 1" = 10'... HOWARD, NEEDLES, TAMMEN & BERGENDOFF
MADE R.B.M. DATE 7-11-49 CONSULTING ENGINEERS
TRGD. B.B. DATE 8-4-49 KANSAS CITY NEW YORK
CHKD. K.M. DATE 8-8-49 766 SHEET V33

120 110 100 90 80 70 60 50 40 30 20 10 0 10 20 30 40 50 60 70 80 90 100 110

FED. ROAD DIV. NO.	STATE	FED. AID PROJ. NO.	TYPE FUNDS	POST WAR
2	OHIO	U-687(6)		

34
34

SUMMIT COUNTY
CITY OF AKRON
AKRON EXPRESSWAY SYSTEM
MAIN VIADUCT
SUM-5-12.31

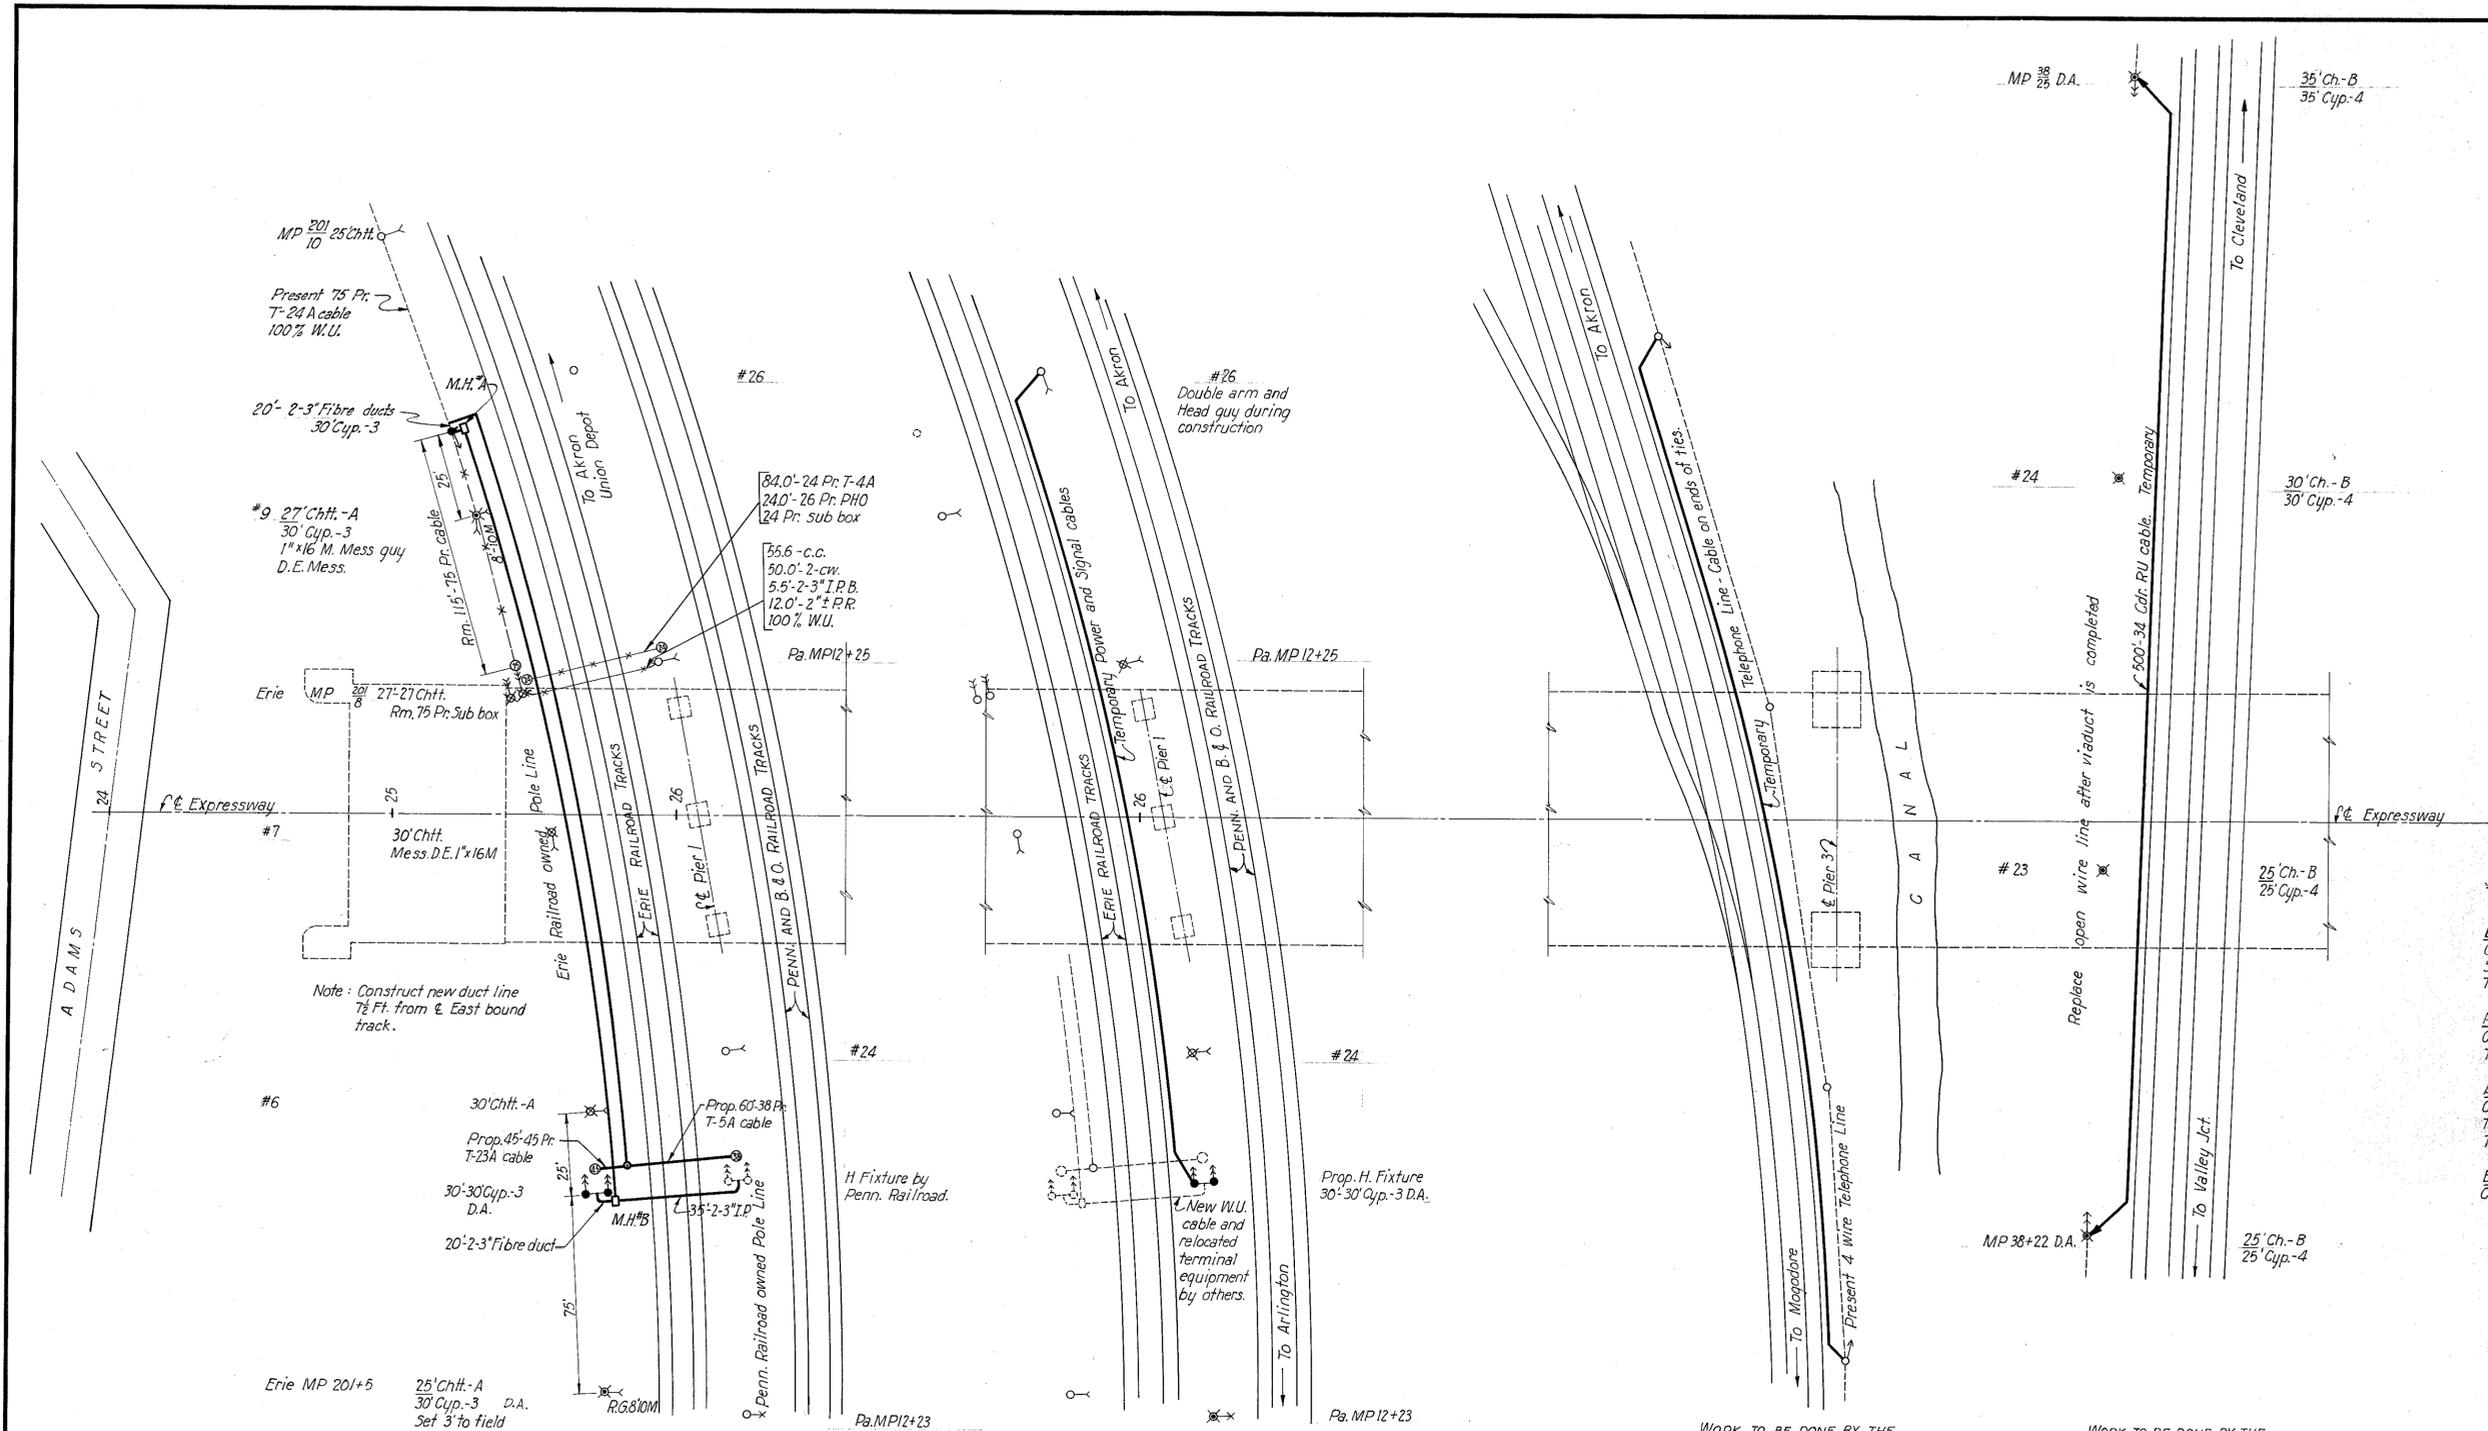

SUMMARY OF RAILROAD FORCE ACCOUNT WORK
(Federal participation)

Erie Railroad Company
Construction Engineering and Inspection,
Signals and Interlocking,
Telegraph and Telephone Lines

Pennsylvania Railroad Company
Construction Engineering and Inspection,
Telephone, Telegraph and Signal Line changes

Akron, Canton, and Youngstown Railroad Company
Construction Engineering and Inspection
Telephone Lines - Temporary Work,
Telephone Lines - Permanent Work

Baltimore and Ohio Railroad Company
Construction Engineering and Inspection

WORK TO BE DONE BY THE
ERIE RAILROAD COMPANY ON
ITS RIGHT-OF-WAY:

Replace aerial cable and open
wire line with U.G. conduit and
cable.

WORK TO BE DONE BY THE
PENNSYLVANIA RAILROAD COMPANY
ON ITS RIGHT-OF-WAY:

WORK TO BE DONE BY THE
AKRON, CANTON AND YOUNGSTOWN
RAILROAD COMPANY ON ITS RIGHT-OF-WAY:

WORK TO BE DONE BY THE
ERIE RAILROAD COMPANY (WESTERN UNION)
ON THE B. & O. RAILROAD-RIGHT-OF-WAY:

PART I

STATE OF OHIO
DEPARTMENT OF HIGHWAYS

AKRON EXPRESSWAY SYSTEM
(EAST MARKET STREET TO EAST CUYAHOGA FALLS AVENUE)
MAIN VIADUCT
BRIDGE NO. SU-5-124

RAILROAD FORCE ACCOUNT WORK

AKRON, SUMMIT COUNTY, OHIO

SCALE 1" = 20'..... HOWARD, NEEDLES, TAMMEN & BERGENDOFF
MADE N.Y. DATE 12-16-42..... CONSULTING ENGINEERS
TRCD N.Y. DATE 12-22-42..... KANSAS CITY NEW YORK
CHKD. DATE 12-21-42..... 766 SHEET V34

STATE OF OHIO
DEPARTMENT OF HIGHWAYS

FED. ROAD DIV. NO.	STATE	FED. AID PROJ. NO.	FISCAL YEAR
2	OHIO		1951

SUMMIT COUNTY
CITY OF AKRON
AKRON EXPRESSWAY SYSTEM
MAIN VIADUCT DRAINAGE
SUM-5-12.31

AKRON EXPRESSWAY SYSTEM

SUM-5-12.31

SUMMIT COUNTY

CITY OF AKRON

MAIN VIADUCT DRAINAGE

INDEX OF SHEETS

- 1 TITLE SHEET
- 2 PLAN AND PROFILE
- 3 MISC. DETAILS, GENERAL NOTES, QUANTITIES

APPROVED [Signature]
DATE 12/27/51 DIRECTOR OF PUBLIC SERVICE, CITY OF AKRON

PRINT APPROVED F.J. Bishop
DATE 1-15-52 CHIEF ENGINEER, A.C.&Y. RAILROAD

PRINT APPROVED I.H. Schram
DATE 1-7-52 CHIEF ENGINEER, ERIE RAILROAD


PRINT APPROVED A.C. Clarke
DATE 1-11-52 CHIEF ENGINEER, B. & O. RAILROAD

PRINT APPROVED A.C. Clarke
DATE 1-21-52 REAL ESTATE & IMPROVEMENT CO. OF BALTIMORE CITY


LINE DATA

BEGIN PROJECT STA. 25+28.75
 END PROJECT STA. 32+05
 DEDUCTIONS STA. 25+70 TO STA. 27+40
 NET LENGTH OF PROJECT AND WORK 506.25 L.F. OR 0.095 MI.*

* SEE PLAN

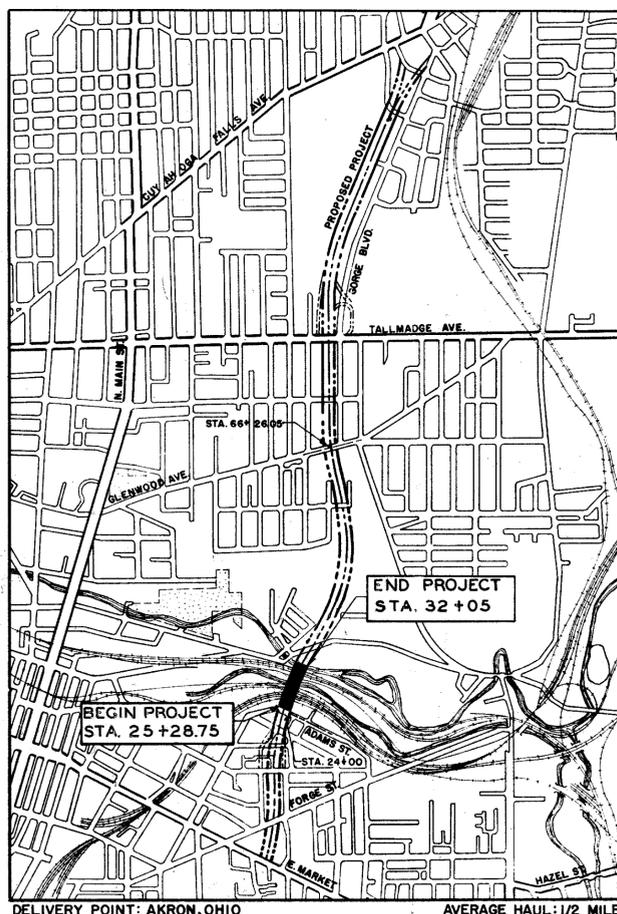

LOCATION PLAN

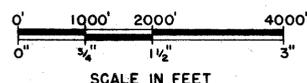

PORTION TO BE IMPROVED **THICK BLACK LINE**
 STATE HIGHWAYS **DOUBLE LINE**
 OTHER HIGHWAYS **SINGLE LINE**

SUPPLEMENTAL SPECIFICATIONS	
NUMBER	DATE
T-171.19	Rev. 7-31-50

STANDARD DRAWINGS	
NUMBER	DATE
I-1,2,3,4&5	2-20-45
I-8 M.H. No 1	5-1-51
I-8 M.H. No 2	1-2-51
I-8 C.B. 2-3&2-4	1-2-51

THE STANDARD SPECIFICATIONS OF THE STATE OF OHIO DEPARTMENT OF HIGHWAYS, INCLUDING CHANGES AND SUPPLEMENTAL SPECIFICATIONS LISTED IN THE PROPOSAL SHALL GOVERN THIS IMPROVEMENT.

I HEREBY APPROVE THESE PLANS AND DECLARE THAT THE MAKING OF THIS IMPROVEMENT WILL NOT REQUIRE THE CLOSING TO TRAFFIC OF THE HIGHWAY AND THAT PROVISIONS FOR THE MAINTENANCE AND SAFETY OF TRAFFIC WILL BE AS SET FORTH IN THE PLANS AND ESTIMATE.

THE RIGHT OF WAY FOR THIS IMPROVEMENT WILL BE PROVIDED BY THE STATE OF OHIO.

APPROVED W.L. Tupper
DATE 12/19/52 DIVISION DEPUTY DIRECTOR

APPROVED Norman M. Dille
DATE 2-18-52 CHIEF ENGINEER, BUREAU OF PLANNING & PROGRAMMING

APPROVED [Signature]
DATE 2-23-52 CHIEF ENGINEER, BUREAU OF BRIDGES & R.R. CROSSINGS

APPROVED [Signature]
DATE 2-15-52 CHIEF ENGINEER, BUREAU OF LOCATION & DESIGN

APPROVED [Signature]
DATE 2-18-52 FIRST ASSISTANT DIRECTOR & CHIEF ENGINEER

APPROVED [Signature]
DATE 2-18-52 DIRECTOR OF HIGHWAYS

CONSTRUCTION BUREAU
OCT 27 1955
GROUND PHOTOLAB


DEPARTMENT OF COMMERCE BUREAU OF PUBLIC ROADS	
RECOMMENDED FOR APPROVAL	
DISTRICT ENGINEER	DATE
APPROVED	
DIVISION ENGINEER	DATE

* Revised 12/13/51

FILE NO.	SUMMIT COUNTY
	SEC. SUM-5-12.31
	DATE OF LETTING _____, 195
	CONTRACT NO. _____

397

397

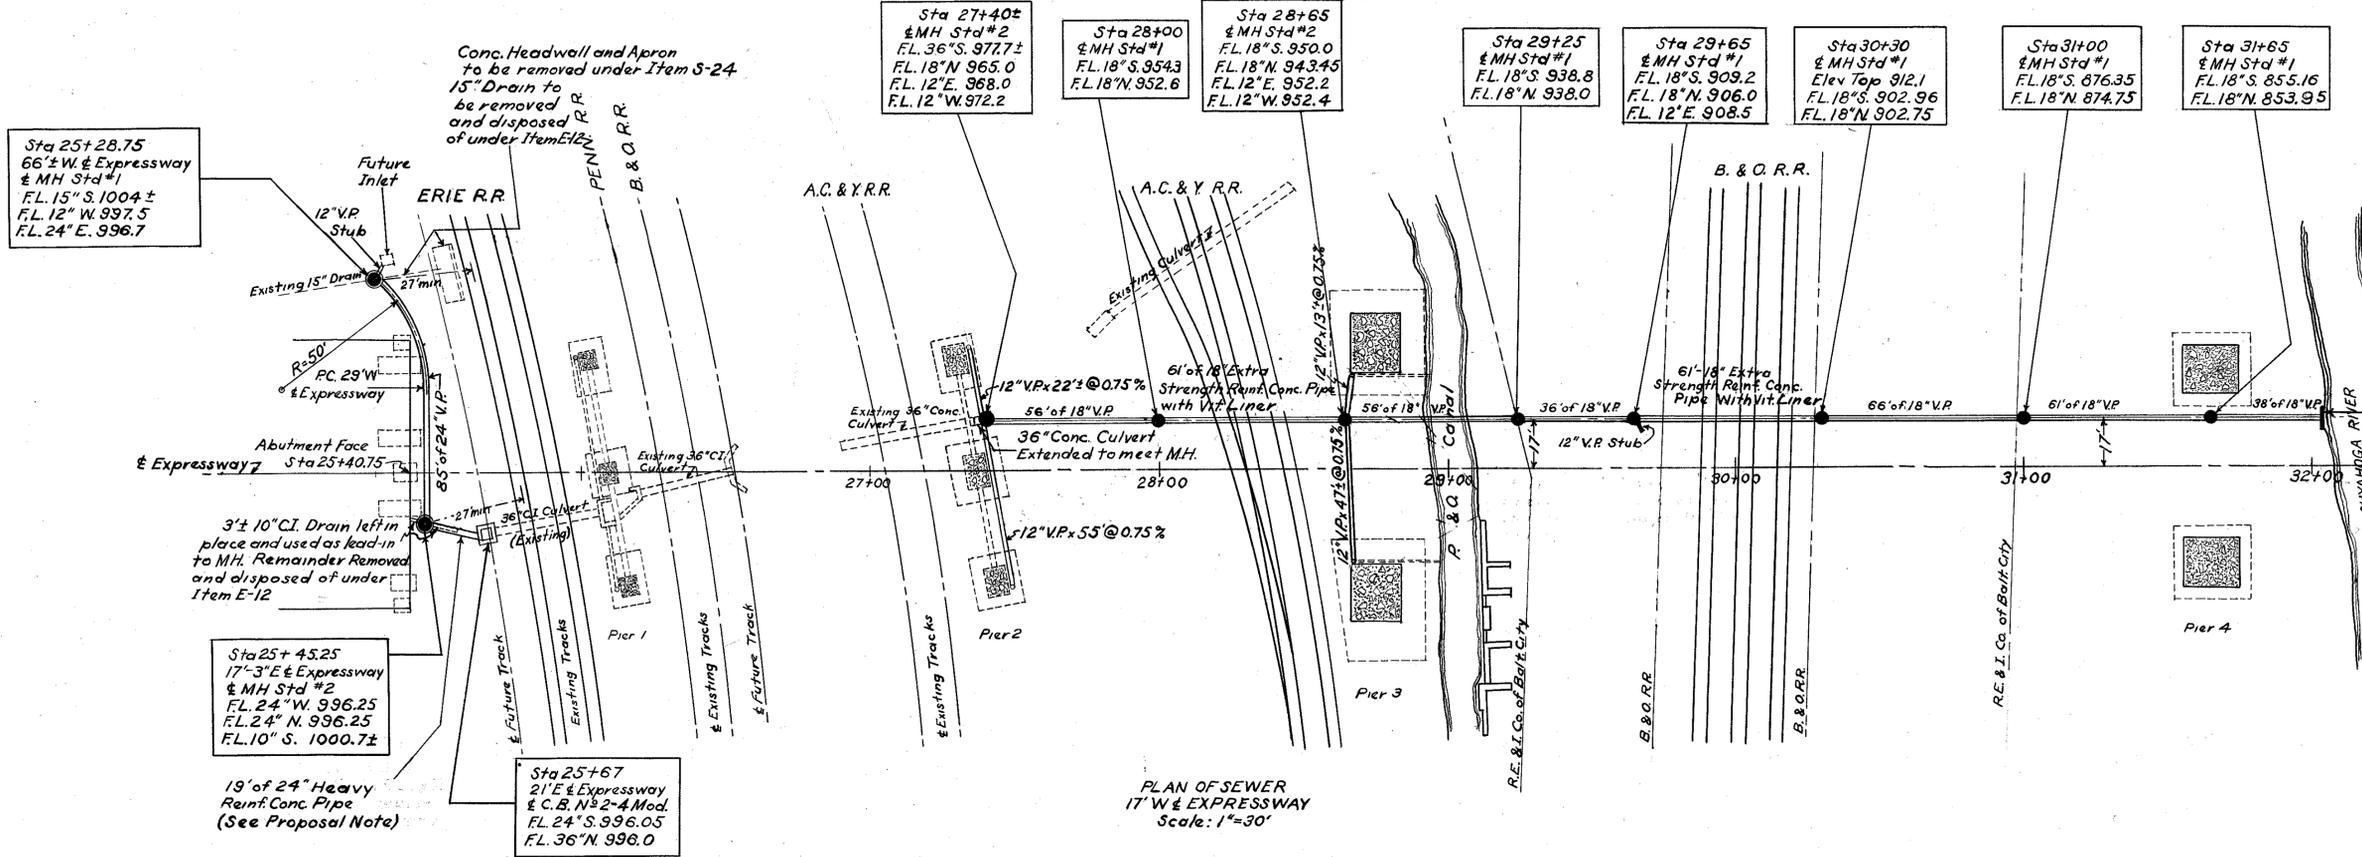

Conc. Headwall and Apron to be removed under Item S-24
15" Drain to be removed and disposed of under Item E-12

Sta 25+28.75
66"± W of Expressway
± MH Std #1
FL. 15" S. 1004±
FL. 12" W. 997.5
FL. 24" E. 996.7

Sta 25+43.25
17'± E of Expressway
± MH Std #2
FL. 24" W. 996.25
FL. 24" N. 996.25
FL. 10" S. 1000.7±

Sta 25+67
21' E of Expressway
± C.B. No 2-4 Mod.
FL. 24" S. 996.05
FL. 36" N. 996.0

Sta 27+40±
± MH Std #2
FL. 36" S. 977.7±
FL. 18" N. 965.0
FL. 12" E. 968.0
FL. 12" W. 972.2

Sta 28+00
± MH Std #1
FL. 18" S. 954.3
FL. 18" N. 952.6

Sta 28+65
± MH Std #2
FL. 18" S. 950.0
FL. 18" N. 943.45
FL. 12" E. 952.2
FL. 12" W. 952.4

Sta 29+25
± MH Std #1
FL. 18" S. 938.8
FL. 18" N. 938.0

Sta 29+65
± MH Std #1
FL. 18" S. 909.2
FL. 18" N. 906.0
FL. 12" E. 908.5


Sta 30+30
± MH Std #1
Elev Top 912.1
FL. 18" S. 902.96
FL. 18" N. 902.75

Sta 31+00
± MH Std #1
FL. 18" S. 876.35
FL. 18" N. 874.75

Sta 31+65
± MH Std #1
FL. 18" S. 855.16
FL. 18" N. 853.95

Sta 32+05
Face of Headwall
See detail on Sheet 3


PLAN OF SEWER
17' W of EXPRESSWAY
Scale: 1"=30'

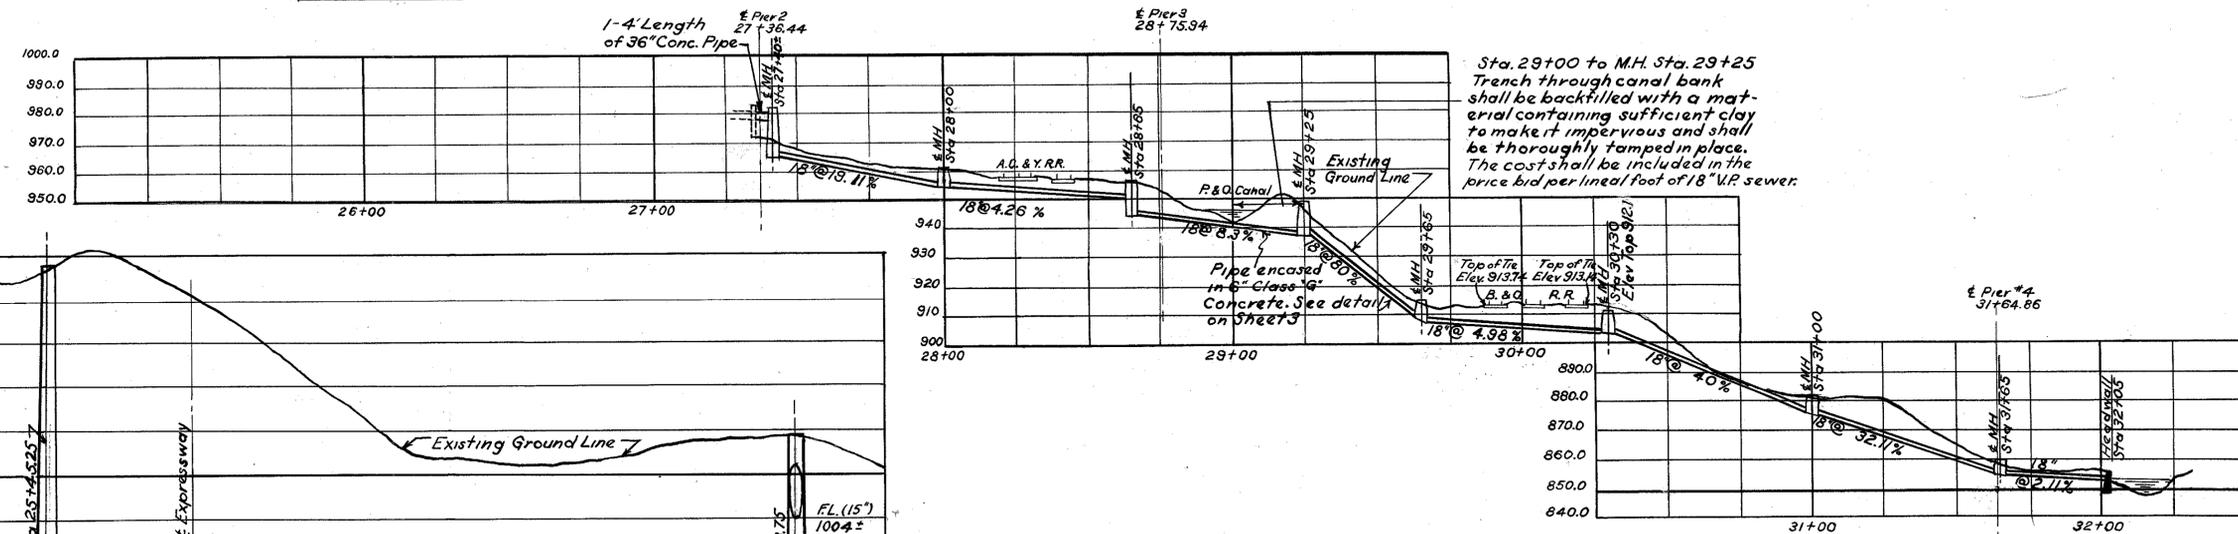

Sta. 29+00 to M.H. Sta. 29+25
Trench through canal bank
shall be backfilled with a mat-
erial containing sufficient clay
to make it impervious and shall
be thoroughly tamped in place.
The cost shall be included in the
price bid per lined foot of 18" V.P. sewer.

PROFILE OF GROUND AND SEWER
17' WEST OF E OF EXPRESSWAY
Scale: 1"=30'

Note: Stations of E of Piers are
along E of Expressway.

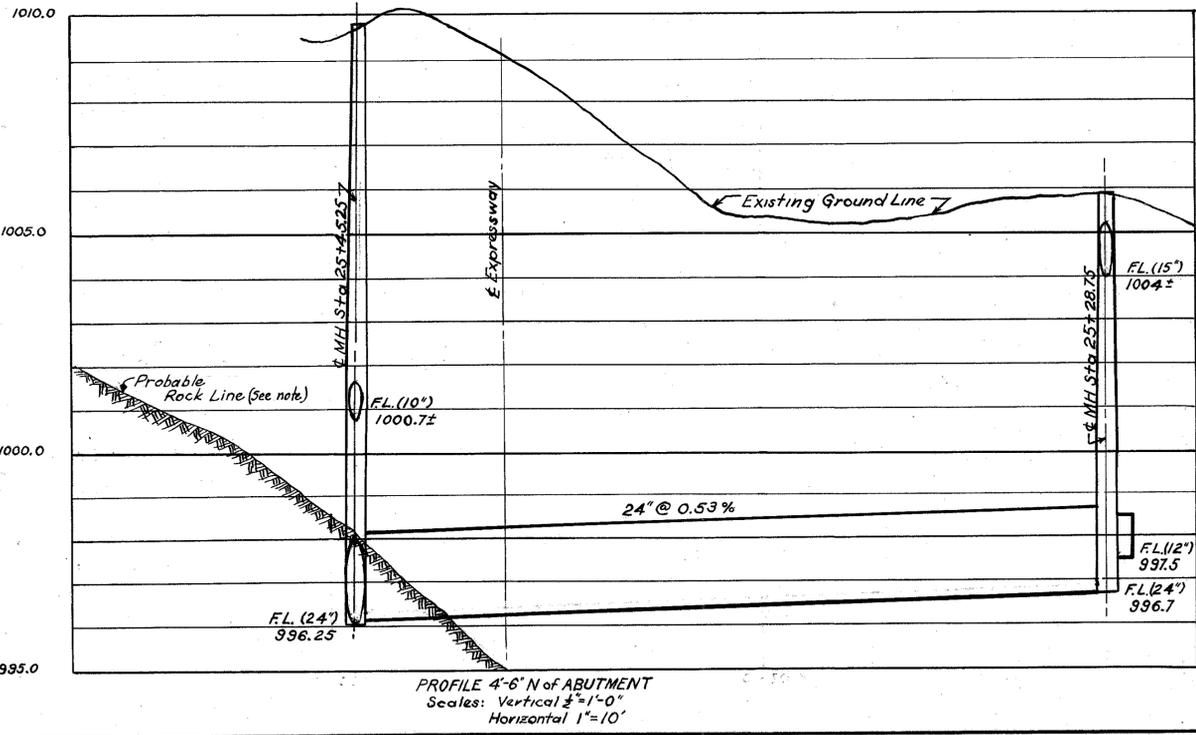

PROFILE 4'-6" N of ABUTMENT
Scales: Vertical 1"=1'-0"
Horizontal 1"=10'

NOTE:~
Information regarding location of rock shown on these plans has
been taken from the best information available but the State
of Ohio does not guarantee the correctness thereof.

STATE OF OHIO
DEPARTMENT OF HIGHWAYS

AKRON EXPRESSWAY SYSTEM
(EAST MARKET STREET TO EAST CUYAHOGA FALLS AVENUE)

MAIN VIADUCT DRAINAGE
PLAN AND PROFILE

AKRON, SUMMIT COUNTY, OHIO

SCALE: AS SHOWN
MADE DATE CITY OF AKRON
TRGD DATE DEPARTMENT OF PUBLIC SERVICE
CHKD DATE DIVISION OF HIGHWAYS

GENERAL NOTES

INLETS, MANHOLES, AND PIPES

The proposed elevation and location of catch basins, manholes, and pipes and the estimated lengths of pipes may be adjusted by the engineer during construction.

PLASTERING MANHOLES

The plastering of the inside of manholes under Item I-8 shall be omitted. Inside mortar joints shall be neatly struck.

LENGTH OF PIPE SPECIALS

The number of lineal feet of pipe to be paid for shall be the length of the pipe line less the assumed lengths (3 feet) of specials, regardless of the actual length of the pipe special used. If actual length of pipe special is less than three (3) feet, the contractor shall furnish enough extra pipe to make up the difference between the assumed and actual lengths. If the actual length of the pipe special used is greater than three (3) feet, the extra length of each pipe special, over and above the assumed length, shall be paid for as lineal feet of pipe.

PIPES UNDER RAILROAD TRACKS

Pipes shall be jacked under railroad tracks unless the presence of rock or shale makes jacking impossible. It is assumed that pipe can be jacked under B. & O. tracks, but that rock will interfere with jacking operations at the A., C., & Y. tracks. Before jacking of pipes, the contractor shall prepare, and receive State and Railroad approval of plans, method of procedure and timing for installing jacking pits, and jacking the pipe. If pipes cannot be jacked, the contractor shall prepare, and receive State and Railroad approval of plans and methods for installation of the pipe beneath railroad tracks.

Any track supporting of B. & O. R.R. tracks made necessary by the contractor's method of placing pipe will be installed, maintained and removed by railroad forces. The contractor shall pay the B. & O. Railroad for these services in accordance with requirements of Special Provisions for this work.

Any track supporting of A., C., & Y. tracks made necessary by the contractor's method of placing the pipe shall be installed, maintained, and removed by the contractor.

Jacking pits shall not be closer than 8'-0" from ends of ties and shall be amply sheeted and braced, subject to the approval of the State and Railroad.

CLOSING RAILROADS TO TRAFFIC

The north track of the B & O Railroad will be closed to railroad traffic for three successive calendar days.

PROTECTION COSTS

Protection costs will be charged to the contractor by the railroads. Such costs will include Railroad Retirement and Unemployment Taxes, Vacation Allowances, and other standard and legal costs. Minimum "protection" while working under or adjacent to tracks will consist of a conductor and two flagmen.

FLOW OF WATER IN P&O CANAL

The contractor shall be responsible for maintaining a continuous flow of water through the P&O Canal equal to the flow at the time of construction. This shall be done by means of a flume or other device, approved by the engineer, and shall be included in the price bid for the 18" V.P. sewer.


BEDDING OF PIPE IN CONCRETE

Whenever rock is encountered in excavation for sewer, outside the limits between Sta. 28+75 and Sta. 29+65, pipe shall be cradled in Class "G" Concrete as shown in detail for "Bedding".


GENERAL SUMMARY ESTIMATED QUANTITIES

ITEM	DESCRIPTION	UNIT	QUANTITY
DRAINAGE			
I-2	12" PIPE FOR STORM SEWERS, SEC. M-6.8(a)	LIN. FT.	145
I-2	18" PIPE FOR STORM SEWERS, SEC. M-6.8(a), AS PER PLAN	LIN. FT.	313
I-2	24" PIPE FOR STORM SEWERS, SEC. M-6.8(a)	LIN. FT.	85
I-2	24" HEAVY REINFORCED CONCRETE CULVERT PIPE FOR STORM SEWERS, AS PER PLAN	LIN. FT.	19
I-2	36" PIPE FOR STORM SEWERS, SEC. M-6.6(a)	LIN. FT.	4
I-5	12" PIPE SPECIALS FOR STORM SEWERS	EACH	8
I-8	STANDARD No. 1 MANHOLE	EACH	7
I-8	STANDARD No. 2 MANHOLE	EACH	3
I-8	CATCH BASIN STANDARD No. 2-4 MODIFIED	EACH	1
I-2	18" EXTRA-STRENGTH REINFORCED CONCRETE CULVERT PIPE, SEC. M-6.6(c) WITH VITRIFIED LINER FOR STORM SEWERS UNDER RAILROAD AS PER PLAN	LIN. FT.	122
S-1	CLASS "G" CONCRETE FOR STRUCTURES	CU. YDS.	30
S-1	CLASS "E" CONCRETE FOR STRUCTURES	CU. YDS.	11
S-24	REMOVAL OF EXISTING STRUCTURES	LUMP	LUMP SUM
E-2	EXCAVATION FOR STRUCTURES, UNCLASSIFIED	CU. YDS.	22
E-2	EXCAVATION FOR STRUCTURES, ROCK OR SHALE	CU. YDS.	5
E-12	PIPE REMOVED AND DISPOSED OF (15" AND UNDER)	LIN. FT.	40


RAILROAD FORCE ACCOUNT BY:
B & O RR - Engineering
ERIE RR - Engineering
AC & Y RR - Engineering

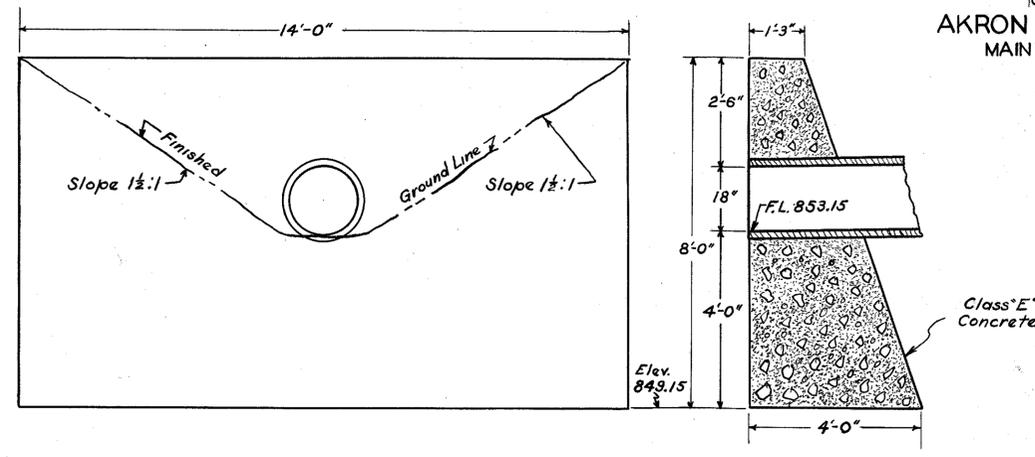



HEADWALL AT STATION 32+05
Scale: 1"=2'-0"

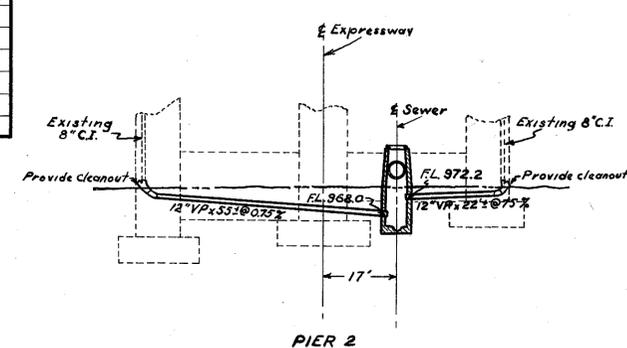

PROFILE OF DOWNSPOUT DRAINS AT PIERS
Scale: 1"=20"

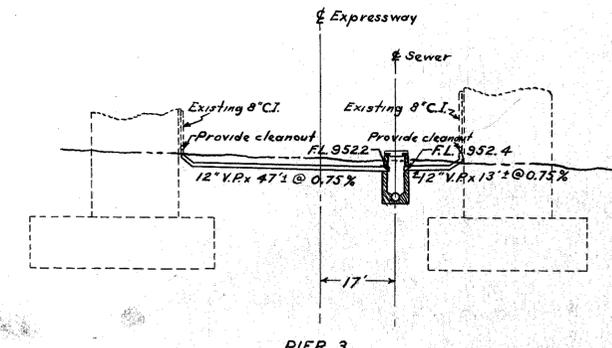


PROFILE OF DOWNSPOUT DRAINS AT PIERS
Scale: 1"=20"

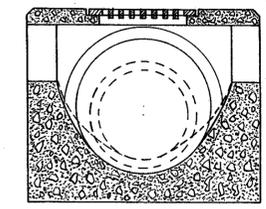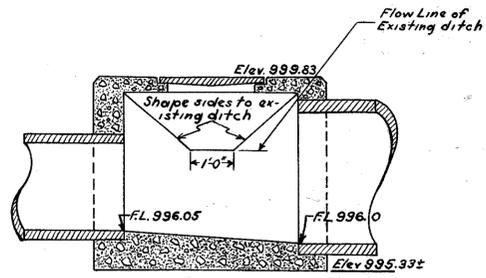


STANDARD No. 2-4 CATCH BASIN MODIFIED
Scale: 1"=2'-0"

Note: For details see State Standard Construction Drawing I-8 C.B.2-4

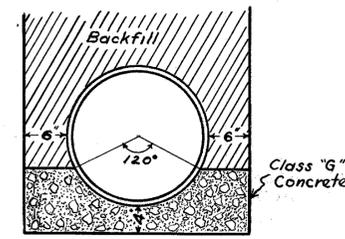

Section Through Rock
24" and 18" Pipe

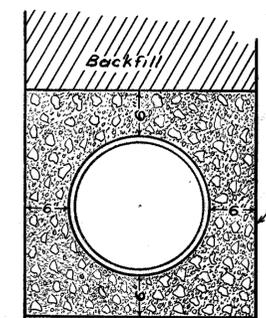

Section Between Sta. 28+75
and Sta. 29+63

BEDDING AND ENCASING DETAILS
Scale: 1"=1'-0"

NOTE: Quantities for Class "G" Concrete shall be paid for on the basis shown in the detail. If the contractor elects to use concrete the full width of the trench he may do so at his own expense beyond the limits shown on the detail.

STATE OF OHIO
DEPARTMENT OF HIGHWAYS

AKRON EXPRESSWAY SYSTEM
(EAST MARKET STREET TO EAST CUYAHOGA FALLS AVENUE)

MAIN VIADUCT DRAINAGE
MISCELLANEOUS DETAILS,
GENERAL NOTES, & QUANTITIES

AKRON, SUMMIT COUNTY, OHIO

SCALE: AS SHOWN
MADE DATE
TRCD DATE
CHKD DATE

CITY OF AKRON
DEPARTMENT OF PUBLIC SERVICE
DIVISION OF HIGHWAYS