

STATE OF OHIO
DEPARTMENT OF TRANSPORTATION

SUM-224-11.25 / 14.30

CITY OF AKRON
SPRINGFIELD TOWNSHIP
SUMMIT COUNTY

PROJECT DESCRIPTION

RESURFACING OF US 224 IN SUMMIT COUNTY FROM SLM 11.25 - 12.70 AND FROM SLM 14.30 - 14.84. MINOR WORK TO 4 STRUCTURES.

EARTH DISTURBED AREAS

PROJECT EDA: N/A (MAINTENANCE PROJECT)
ESTIMATED CONTRACTOR EDA: 0.25 ACRES
NOTICE OF INTENT EDA: N/A (MAINTENANCE PROJECT)

Corrected Federal Project Number


2019 SPECIFICATIONS

THE STANDARD SPECIFICATIONS OF THE STATE OF OHIO, DEPARTMENT OF TRANSPORTATION, INCLUDING SUPPLEMENTAL SPECIFICATIONS LISTED IN THE PLANS AND CHANGES LISTED IN THE PROPOSAL SHALL GOVERN THIS IMPROVEMENT.

I HEREBY APPROVE THESE PLANS AND DECLARE THAT THE MAKING OF THIS IMPROVEMENT WILL NOT REQUIRE THE CLOSING TO TRAFFIC OF THE HIGHWAY EXCEPT AS NOTED ON SHEET 8, AND THAT PROVISIONS FOR THE MAINTENANCE AND SAFETY OF TRAFFIC WILL BE AS SET FORTH ON THE PLANS AND ESTIMATES.

APPROVED: *[Signature]*
DATE: 9/4/19 DISTRICT DEPUTY DIRECTOR

APPROVED: _____
DATE: _____ DIRECTOR, DEPARTMENT OF TRANSPORTATION

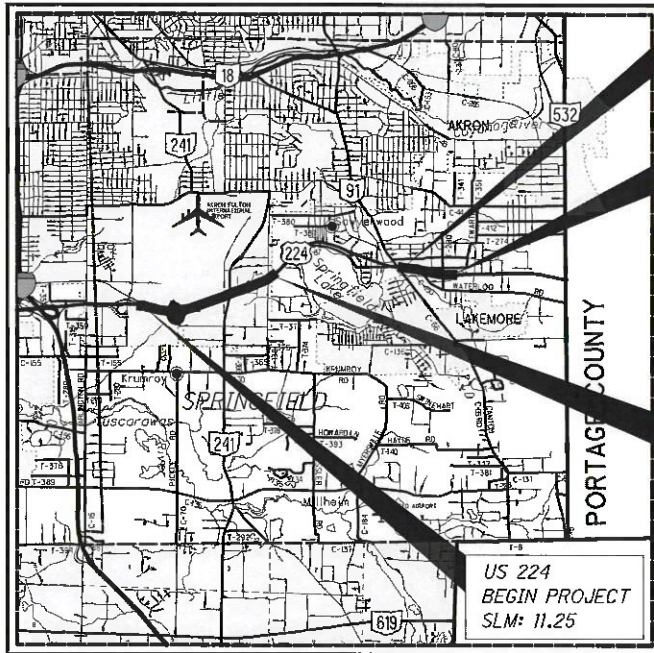

US 224
BEGIN PROJECT
SLM: 14.30

US 224
END PROJECT
SLM: 14.84


US 224
END PROJECT
SLM: 12.70

US 224
BEGIN PROJECT
SLM: 11.25

LOCATION MAP

LATITUDE: 41°01'59" LONGITUDE: 81°26'47"

SCALE IN MILES

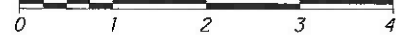

PORTION TO BE IMPROVED	_____
INTERSTATE HIGHWAY	_____
FEDERAL ROUTES	_____
STATE ROUTES	_____
COUNTY & TOWNSHIP ROADS	_____
OTHER ROADS	_____

DESIGN DESIGNATION

DESIGN FUNCTIONAL CLASSIFICATION:
URBAN PRINCIPAL ARTERIAL
NHS PROJECT YES

DESIGN EXCEPTIONS

NONE

INDEX OF SHEETS:

TITLE SHEET	1
TYPICAL SECTIONS	2-4
GENERAL NOTES	5-6
MAINTENANCE OF TRAFFIC	7-9
GENERAL SUMMARY	10-11
PAVEMENT CALCULATIONS	12-13
RAISED PAVEMENT MARKER SUBSUMMARY	14
PAVEMENT MARKINGS SUBSUMMARY	15
STRUCTURES	16-19

UNDERGROUND UTILITIES
Contact Two Working Days Before You Dig

OHIO811, 8-1-1, or 1-800-362-2764
(Non-members must be called directly)

PLAN PREPARED BY:
ODOT DISTRICT 4 - PLANNING AND ENGINEERING
2088 S. ARLINGTON RD.
AKRON, OH 44306

ENGINEERS SEAL:



SIGNED: *[Signature]*
DATE: 9/4/19

STANDARD CONSTRUCTION DRAWINGS				SUPPLEMENTAL SPECIFICATIONS	SPECIAL PROVISIONS
BP-3.1	7/18/14	TC-41.20	10/18/13	800-2019 10/18/19	
BP-3.2	1/18/19	TC-52.10	10/18/13	821 4/20/12	
		TC-52.20	7/20/18	832 10/19/18	
DM-4.3	1/15/16	TC-65.10	1/17/14	875 1/18/19	
DM-4.4	1/15/16	TC-65.11	7/21/17	921 4/20/12	
		TC-71.10	1/19/18		
MT-95.30	7/19/19	TC-72.20	7/20/18		
MT-95.31	7/19/19	TC-73.20	7/21/17		
MT-95.32	4/19/19	TC-82.10	7/19/19		
MT-95.50	7/21/17				
MT-97.12	1/20/17				
MT-98.29	7/19/19				
MT-98.30	7/19/19				
MT-99.20	4/19/19				
MT-101.90	7/21/17				
MT-105.10	7/19/13				

FEDERAL PROJECT NO. E161(255)

PID NO. 98486

CONSTRUCTION PROJECT NO.

RAILROAD INVOLVEMENT METRO RTA

SUM-224-11.25 / 14.30

I:\ProjectData\SUM\98486_224_11.25\Design\Roadway\Sheet\S\98486_GT001.dgn Sheet 9/3/2019 4:28:10 PM mpalagan