


STATE OF OHIO DEPARTMENT OF TRANSPORTATION

TRU-46/82 DDI

HOWLAND TOWNSHIP
TRUMBULL COUNTY

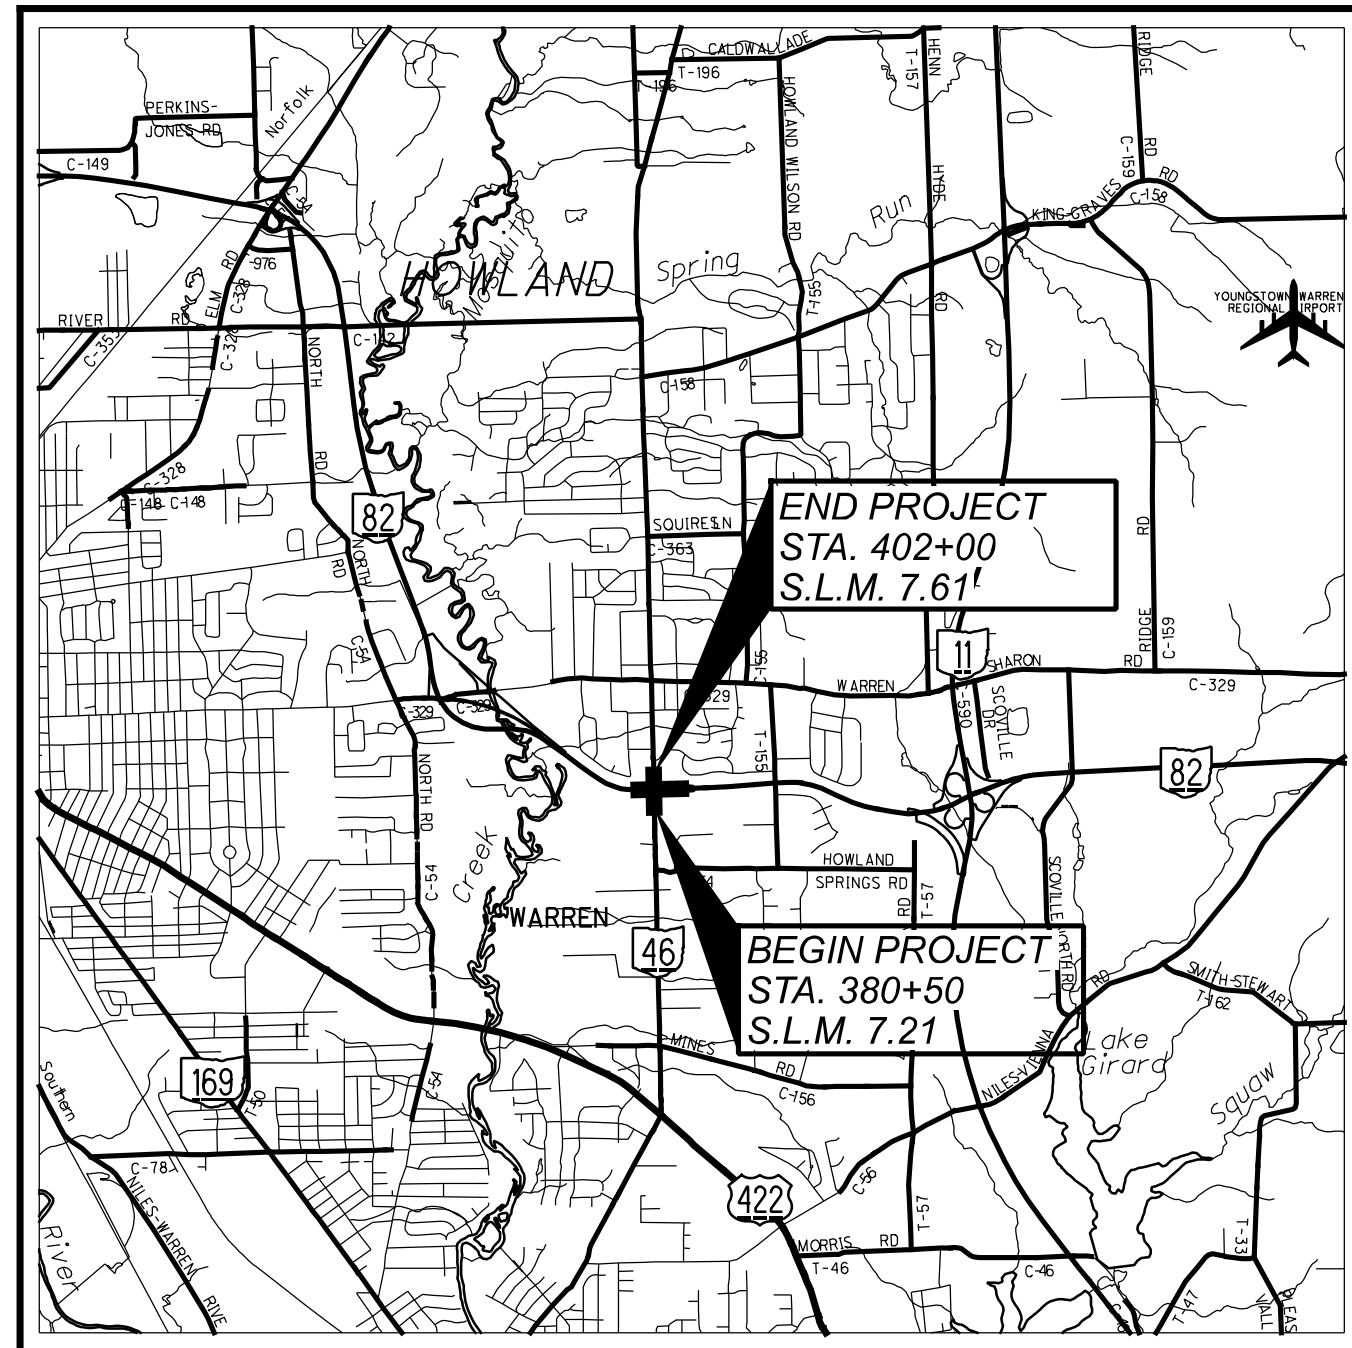

LOCATION MAP

LATITUDE: 41°13'47" LONGITUDE: -80°44'26"



PORTION TO BE IMPROVED	
INTERSTATE HIGHWAY	
FEDERAL ROUTES	
STATE ROUTES	
COUNTY & TOWNSHIP ROADS	
OTHER ROADS	

DESIGN EXCEPTIONS

DESIGN FEATURE	APPROVAL DATES	SHEET NO.
HORIZONTAL: SHOULDER WIDTH	1-26-2021	346 AND 349

ADA DESIGN WAIVERS

NONE REQUIRED

INDEX OF SHEETS:

TITLE SHEET	1	SUPERELEVATION TABLES	455 - 461
DESIGN DESIGNATIONS & SEALS	2	PAVEMENT ELEVATION DETAILS	462 - 467
SCHEMATIC SHEETS	3 - 8	INTERCHANGE GORE DETAILS	468 - 469
TYPICAL SECTIONS	9 - 30	INTERSECTION DETAILS	470 - 471
GENERAL NOTES	31 - 35	MEDIAN BARRIER DETAILS	472
MAINTENANCE OF TRAFFIC	36 - 285	INTERSECTION CURB DETAILS	473 - 474
GENERAL SUMMARY	286 - 291	CURB RAMP AND PED PATH DETAILS	475 - 484
SUBSUMMARIES	292 - 315	PAVEMENT JOINT DETAILS	485 - 488
PROJECT SITE PLAN	316 - 317	DRIVEWAY DETAILS	489 - 506
PLAN AND PROFILE SR 46	318 - 337	DRAINAGE PLANS	507 - 515
PLAN AND PROFILE SR 82	338 - 340	STORM SEWER PROFILES	516 - 526
PLAN AND PROFILE RAMP A & AA	341 - 345	ARTIFICIAL TURF ISLAND DETAILS	527 - 528
PLAN AND PROFILE RAMP B & BB	346 - 352	UNDERDRAIN DETAILS	529 - 533
PLAN AND PROFILE RAMP C & CC	353 - 357	SANITARY SEWER	534
PLAN AND PROFILE RAMP D & DD	358 - 364	WATER WORK	535 - 542
PROFILES HUNTERS TRAIL & KETTERING ST. SE	365	TRAFFIC CONTROL	543 - 588
CROSS SECTIONS SR 46	366 - 392	TRAFFIC SIGNAL / ITS	589 - 611
CROSS SECTIONS SR 82	393 - 403	LIGHTING	612 - 626
CROSS SECTIONS RAMP A & AA	404 - 410	LANDSCAPING	627 - 628
CROSS SECTIONS RAMP B & BB	411 - 428	STRUCTURE OVER 20' SPAN: BRIDGE NO. TRU-0082-18.050	629 - 672
CROSS SECTIONS RAMP C & CC	429 - 439	FENCE PLANS	673 - 674
CROSS SECTIONS RAMP D & DD	440 - 454	RIGHT OF WAY	675 - 688
		SOIL PROFILES	689 - 704B

FEDERAL PROJECT NUMBER

E190(304)

RAILROAD INVOLVEMENT

NONE

PROJECT DESCRIPTION

CONSTRUCTION OF DIVERGING DIAMOND INTERCHANGE (DDI) AT THE STATE ROUTE 46 AND STATE ROUTE 82 INTERCHANGE IN TRUMBULL COUNTY, OHIO. PROJECT ALSO INCLUDES THE REPLACEMENT OF THE SR82 STRUCTURE (SFN# 7804652) OVER STATE ROUTE 46

EARTH DISTURBED AREAS

PROJECT EARTH DISTURBED AREA:	18.4 ACRES
ESTIMATED CONTRACTOR EARTH DISTURBED AREA:	2.2 ACRES
NOTICE OF INTENT EARTH DISTURBED AREA:	20.6 ACRES

LIMITED ACCESS

THIS IMPROVEMENT IS ESPECIALLY DESIGNED FOR THROUGH TRAFFIC AND HAS BEEN DECLARED A LIMITED ACCESS HIGHWAY OR FREEWAY BY ACTION OF THE DIRECTOR IN ACCORDANCE WITH THE PROVISIONS OF SECTION 5511.02 OF THE OHIO REVISED CODE.

2019 SPECIFICATIONS

THE STANDARD SPECIFICATIONS OF THE STATE OF OHIO, DEPARTMENT OF TRANSPORTATION, INCLUDING SUPPLEMENTAL SPECIFICATIONS LISTED IN THE PLANS AND CHANGES LISTED IN THE PROPOSAL SHALL GOVERN THIS IMPROVEMENT.

UNDERGROUND UTILITIES
Contact Two Working Days Before You Dig

OHIO811.org
Before You Dig

OHIO811. 8-1-1. or 1-800-362-2764
(Non members must be called directly)

PLAN PREPARED BY:

HDR ENGINEERING, INC.
1100 SUPERIOR AVE., SUITE 650
CLEVELAND OHIO 44114
216-912-4240

STANDARD CONSTRUCTION DRAWINGS										SUPPLEMENTAL SPECIFICATIONS	SPECIAL PROVISIONS					
BP-1.1	7/28/00	CB-3A	7/16/21	I-3D	7/15/22	MT-101.80	1/17/20	SBR-2-20	1/15/21	ITS-10.10	7/15/22	TC-41.10	7/19/13	800	SEE PROPOSAL	WATERWAY PERMIT
BP-2.1	1/21/22	CB-5	7/16/21			MT-104.10	10/16/15			ITS-10.11	7/15/22	TC-41.20	10/18/13	804	10/21/22	11/15/22
BP-2.2	1/15/21			MGS-1.1	7/16/21	MT-105.10	1/17/20	HL-10.11	7/15/22	ITS-12.10	7/15/22	TC-41.30	10/18/13	808	1/18/19	REGIONAL
BP-2.3	7/18/14	DM-1.1	7/17/20	MGS-2.1	1/19/18			HL-10.12	1/20/17	ITS-14.10	7/15/22	TC-41.40	10/18/13	809	7/15/22	GENERAL PERMIT
BP-2.4	7/19/13	DM-1.2	7/16/21	MGS-3.1	1/19/18	RM-1.1	1/15/21	HL-10.13	4/17/20	ITS-14.11	1/21/22	TC-52.10	10/18/13	813	10/19/18	11/7/22
BP-3.1	1/21/22	DM-2.1	1/18/13	MGS-3.2	1/18/13	RM-4.2	4/17/20	HL-20.11	10/21/22	ITS-15.10	7/15/22	TC-52.20	1/15/21	821	4/20/12	
BP-4.1	7/19/13	DM-4.1	7/17/20	MGS-4.3	1/18/13	RM-4.3	1/21/22	HL-30.11	1/15/21	ITS-18.00	7/16/21	TC-65.10	1/17/14	825	1/17/20	
BP-5.1	7/15/22	DM-4.2	7/20/12	MGS-5.3	7/15/16	RM-4.5	7/21/17	HL-30.21	4/17/20	ITS-50.10	7/15/22	TC-65.11	7/15/22	832	7/15/22	
BP-6.1	7/19/13	DM-4.3	1/15/16	MGS-6.1	1/19/18	RM-4.6	7/19/13	HL-30.22	1/15/21	ITS-50.12	7/15/22	TC-71.10	7/15/22	834	7/15/22	
BP-7.1	1/21/22	DM-4.4	1/15/16					HL-30.32	4/17/20			TC-72.20	7/20/18	894	4/16/21	
BP-8.2	1/18/19			MH-3	7/16/21	AS-1-15	7/17/15	HL-40.20	7/15/22	TC-12.31	4/15/22	TC-73.20	1/17/20	904	7/15/22	
BP-9.1	1/18/19	F-1.1	7/19/13			AS-2-15	1/18/19	HL-50.11	1/16/15	TC-15.116	7/16/21	TC-74.10	1/21/22	908	10/20/17	
		F-2.1	7/20/18	MT-95.30	7/19/19	GSD-1-19	1/15/21	HL-50.21	7/15/22	TC-16.22	7/16/21	TC-81.22	7/15/22	909	10/21/22	
CB-2-2A, 2B, 2C	7/16/21	F-3.3	7/19/13	MT-99.60	7/15/16	ICD-1-20	1/21/22	HL-60.11	7/21/17	TC-21.11	7/16/21	TC-83.20	7/15/22	913	4/16/21	
CB-2-3, 2-4	7/16/21	F-3.4	7/19/13	MT-100.00	7/16/21	PCB-91	7/17/20	HL-60.12	7/16/21	TC-21.21	7/15/22	TC-85.10	10/21/22	921	4/20/12	
CB-3	7/16/21			MT-101.70	1/17/20	SBR-1-20	7/17/20	HL-60.31	1/17/20	TC-22.20	1/17/14	TC-85.20	7/20/18			

I HEREBY APPROVE THESE PLANS AND DECLARE THAT THE MAKING OF THIS IMPROVEMENT WILL NOT REQUIRE THE CLOSING TO TRAFFIC OF THE HIGHWAY EXCEPT AS NOTED ON SHEETS 54 - 58, AND THAT PROVISIONS FOR THE MAINTENANCE AND SAFETY OF TRAFFIC WILL BE AS SET FORTH ON THE PLANS AND ESTIMATES.

DISTRICT DEPUTY DIRECTOR

DIRECTOR, DEPARTMENT OF TRANSPORTATION

TITLE SHEET

DESIGN AGENCY



DESIGNER
CLW

REVIEWER
JMB 08/19/21

PROJECT ID
108547

SHEET TOTAL
1 704

TRU-46/82 DDI

PAPER SIZE: 17X11 (in.) DATE: 12/8/2022 TIME: 8:46:56 PM USER: TSCHOEN DGN: c:\pwworking\east01\10438571\108547.dgn MODEL: Sheet

PAVING UNDER GUARDRAIL

THIS OPERATION SHALL INCLUDE PREPARATION OF THE GRADED SHOULDER USING ITEM 209, LINEAR GRADING, AS PER PLAN AND PAVING UNDER THE GUARDRAIL USING 441 ASPHALT CONCRETE INTERMEDIATE COURSE, TYPE 1, (449), (UNDER GUARDRAIL), AS PER PLAN.

ITEM 209, LINEAR GRADING, AS PER PLAN SHALL CONSIST OF EXCAVATING TOPSOIL, AND PLACING GRANULAR MATERIAL.

ALL COLLECTED DEBRIS AND TOPSOIL, INCLUDING RHIZOMES, ROOTS AND OTHER VEGETATIVE PLANT MATERIAL SHALL BE REMOVED AND DISPOSED OF AS SPECIFIED IN 105.17.

THE REMOVED MATERIAL SHALL BE REPLACED WITH COMPACTABLE GRANULAR MATERIAL CONFORMING TO 703.16 PLACED TO GRADE AS DETAILED ON THE TYPICAL SECTION OR AS APPROVED BY THE ENGINEER.

ALL EQUIPMENT, MATERIALS AND LABOR REQUIRED TO PERFORM THE WORK OUTLINED ABOVE SHALL BE INCLUDED FOR PAYMENT UNDER ITEM 209, LINEAR GRADING, AS PER PLAN.

PAVING UNDER GUARDRAIL SHALL CONSIST OF PLACING ITEM 441 TO THE DEPTH SPECIFIED USING ONE OF THE FOLLOWING METHODS:

- METHOD A:
1. SET GUARDRAIL POSTS
 2. PLACE ITEM 441

- METHOD B:
1. PLACE ITEM 441
 2. BORE ASPHALT AT POST LOCATIONS (MAY BE OMITTED IF STEEL POSTS ARE USED)
 3. SET GUARDRAIL POSTS
 4. PATCH AROUND POSTS. THE MATERIALS USED FOR PATCHING SHALL BE AN ASPHALT CONCRETE APPROVED BY THE ENGINEER. PATCHED AREAS SHALL BE COMPACTED USING EITHER HAND OR MECHANICAL METHODS. FINISHED SURFACES SHALL BE SMOOTH AND SLOPED TO DRAIN AWAY FROM THE POSTS.

ALL EQUIPMENT, MATERIALS AND LABOR REQUIRED TO PERFORM THE WORK OUTLINED ABOVE, WITH THE EXCEPTION OF SETTING GUARDRAIL POSTS, SHALL BE INCLUDED FOR PAYMENT UNDER ITEM 441, ASPHALT CONCRETE, INTERMEDIATE COURSE, TYPE 1 (449), (UNDER GUARDRAIL), AS PER PLAN.

INTERSECTIONS

INTERSECTIONS WILL BE RESURFACED 25 FT. BEYOND THE EDGE LINE, UNLESS OTHERWISE DIRECTED BY THE ENGINEER OR INDICATED IN THE PLAN. INTERSECTIONS SHALL BE PAVED AFTER COMPLETION OF THE SURFACE COURSE. A BUTT JOINT, AS PER STANDARD CONSTRUCTION DRAWING BP-3.1, SHALL BE USED TO PROVIDE A SMOOTH TRANSITION TO THE EXISTING PAVEMENT. USE THE SAME ASPHALT CONCRETE AS THE MAINLINE PAVEMENT UNLESS SHOWN OTHERWISE ON THE ASPHALT CONCRETE CALCULATIONS SHEET. ANY GRADING OR PRIME NECESSARY TO ACCOMPLISH THIS WORK SHALL BE INCLUDED IN THE COST OF THE PERTINENT BID ITEM.

ITEM 408 - PRIME COAT, AS PER PLAN

APPLY "MC-70" AT A RATE OF 0.4 GALLONS PER SQUARE YARD, OR AS DETERMINED BY THE ENGINEER, TO THE COMPLETED COMPACTED AGGREGATE SHOULDER.

ITEM SPECIAL – SURVEY CONTROL VERIFICATION

THE CONTRACTOR SHALL PERFORM THIS WORK TO VERIFY THE PROVIDED SURVEY CONTROL. THE CONTRACTOR WILL PERFORM THE VERIFICATION USING ONE OF THE TWO METHODS BELOW DEPENDENT UPON THE CONTRACTOR'S CHOSEN MEANS OF SURVEY CONTROL TO BE USED ON THE PROJECT. THE WORK SHALL BE PERFORMED UNDER THE DIRECT SUPERVISION OF AN OHIO LICENSED SURVEYOR.

- 1) IF USING GPS DEVICES TO ESTABLISH AND OR PROVIDE SUPPLEMENTAL HORIZONTAL AND VERTICAL SURVEY CONTROL
 - a. LOCATE VERTICAL CONTROL POINTS PROVIDED IN THE PLANS AND PERFORM A DIFFERENTIAL LEVEL CIRCUIT.
 - b. PERFORM A SITE CALIBRATION UTILIZING THE AVAILABLE HORIZONTAL AND VERTICAL CONTROL POINTS PROVIDED IN THE PLAN.
 - c. PROVIDE A REPORT, SIGNED BY AN OHIO LICENSED SURVEYOR, TO THE PROJECT ENGINEER COMPARING THE OBSERVED DATA TO THE PLAN DATA ALONG WITH A NARRATIVE DETAILING ANY DISCREPANCIES FOUND.
- 2) IF USING CONVENTIONAL SURVEY INSTRUMENTATION TO ESTABLISH AND OR PROVIDE SUPPLEMENTAL HORIZONTAL AND VERTICAL SURVEY CONTROL
 - a. LOCATE VERTICAL CONTROL POINTS PROVIDED IN THE PLANS AND PERFORM A DIFFERENTIAL LEVEL CIRCUIT.
 - b. LOCATE AND OBSERVE ANGLE AND DISTANCE TO ALL AVAILABLE HORIZONTAL CONTROL POINTS PROVIDED IN THE PLAN
 - c. PROVIDE A REPORT, SIGNED BY AN OHIO LICENSED SURVEYOR, TO THE PROJECT ENGINEER COMPARING THE OBSERVED DATA TO THE PLAN DATA ALONG WITH A NARRATIVE DETAILING ANY DISCREPANCIES FOUND.

ALL MATERIALS, LABOR, EQUIPMENT, TOOLS, AND INCIDENTALS NECESSARY TO COMPLETE THIS WORK SHALL BE INCLUDED IN THE LUMP SUM BID ITEM.

ITEM 617 - COMPACTED AGGREGATE, AS PER PLAN

IN LOW SHOULDER AREAS EXCEEDING 1", AND ADJACENT TO THE SAFETY EDGE, OR AS DIRECTED BY THE ENGINEER, RECYCLED ASPHALT PAVEMENT (RAP) SHALL BE USED IN AREAS ADJACENT TO THE PAVED BERM. THE RAP SHALL HAVE A MINIMUM PG CONTENT OF 4.5% AND MEET THE FOLLOWING GRADATION. ONCE THE STOCKPILE MEETS THE GRADATION, THE PG CONTENT OF THE RAP SHALL BE DETERMINED PER 440.05. THE RAP ANALYSIS MUST BE SUBMITTED TO THE ENGINEER FOR APPROVAL 2 WEEKS PRIOR TO USE. METHOD OF MEASUREMENT SHALL BE AS PER 617.06. PLACEMENT AND COMPACTION SHALL MEET THE REQUIREMENTS OF ITEM 617. ALL MATERIALS, LABOR, EQUIPMENT, TOOLS AND INCIDENTALS NECESSARY TO COMPLETE THE WORK SHALL BE INCLUDED IN THE UNIT PRICE BID FOR ITEM 617 COMPACTED AGGREGATE, AS PER PLAN.

MODIFIED GRADATION SHALL APPLY:

SIEVE	TOTAL PERCENT PASSING
1- 1/2 "	100
3/4 "	50-100
NO. 4	35-70
NO. 30	9-33
NO. 200	0-13

ITEM 442 - ASPHALT CONCRETE SURFACE COURSE, 12.5 MM, TYPE A (448), AS PER PLAN, PG70-22M

THE REQUIREMENTS OF 442 AND 448 WILL APPLY; DEVIATIONS FROM THESE ARE AS FOLLOWS:

THE PERCENTAGE OF RECLAIMED MATERIAL PROPOSED FOR USE WILL BE INCLUDED IN THE MIX DESIGN PROCESS TO ESTABLISH THE JOB MIX FORMULA (JMF) IN ACCORDANCE WITH 440.05.

MATERIALS: THE MATERIALS WILL BE:
 AGGREGATES 703.05*

*THE VIRGIN COARSE AGGREGATE PORTION OF THE MIXTURE WILL CONTAIN 50% AIR COOLED BLAST FURNACE SLAG (ACBFS) AND MEET THE REQUIREMENTS OF 703.05.

USE AN NDES OF 50, AN NMAX OF 75 AND THE COMBINATION OF NEW AGGREGATES, NEW ASPHALT BINDER, AND RECLAIMED MATERIAL SHALL BE AS REQUIRED TO PRODUCE A COMPOSITION CONTAINING A MINIMUM OF 6.0% NEW ASPHALT BINDER RESULTING IN A MINIMUM TOTAL BINDER OF 6.5%.

703.05 DO NOT USE ANY FINE OR COARSE AGGREGATE WITH A 'SR' OR 'SRH' DESIGNATION ACCORDING TO THE OFFICE OF MATERIALS MANAGEMENT (OMM) IN ANY JOB MIX FORMULA (JMF) FOR THIS ITEM.

**ITEM 611 – MANHOLE ADJUSTED TO GRADE, AS PER PLAN
 ITEM 623 – MONUMENT ASSEMBLY ADJUSTED TO GRADE, AS PER PLAN**

IN ADDITION TO THE REQUIREMENTS OF CMS 611.10.D FOR MANHOLES OR 623.05 FOR MONUMENT ASSEMBLY BOXES, THE CONTRACTOR WILL MAKE A CLEAN CIRCULAR CUT AROUND THE CASTING (48" DIAMETER FOR STORM AND SANITARY MANHOLE CASTINGS, 24"-28" FOR MONUMENT ASSEMBLY BOXES, AND 2' IN DIAMETER LARGER THAN THE CASTING DIAMETER FOR ANY CASTINGS THAT ARE LARGER THAN STANDARD MANHOLES SUCH AS TELECOMMUNICATION MANHOLE CASTINGS) AND REMOVE AND DISCARD THE EXISTING CASTING. INSTALL A NEW CASTING TO GRADE (ACCORDING TO TOLERANCES AS SHOWN ON STANDARD CONSTRUCTION DRAWING BP-3.1) AFTER THE PAVEMENT SURFACE COURSE HAS BEEN REPLACED.

CMS 499 CLASS QCMS CONCRETE (DYE THE CONCRETE SUCH THAT ITS COLOR CLOSELY MATCHES THE COLOR OF THE SURROUNDING PAVEMENT) WILL BE USED FOR BACKFILLING THE FULL PAVEMENT SECTION AND THE JOINT BETWEEN THE ASPHALT AND CONCRETE WILL BE SEALED WITH CMS 702.01 PG BINDER. EPOXY COATED REBAR SHALL BE PLACED IN THE CONCRETE AT 6" MAXIMUM ON CENTER AND A MINIMUM OF 3.5" CLEARANCE FROM THE TOP, BOTTOM AND SIDES. THE CONCRETE WILL BE VIBRATED SUFFICIENTLY TO ELIMINATE AIR POCKETS UNDER THE FRAME.

PAYMENT WILL INCLUDE REMOVAL OF THE EXISTING MATERIAL, INSTALLATION AND FURNISHING OF A NEW CASTING, AND ALL LABOR AND MATERIALS REQUIRED TO COMPLETE THIS ITEM OF WORK AS DESCRIBED.

VEGETATED BIOFILTER

THIS PLAN UTILIZES VEGETATED BIOFILTER(S) FOR POST CONSTRUCTION STORM WATER TREATMENT. PLACE EITHER ITEM 660 SODDING OR ITEM 659 SEEDING AND MULCHING WITH A 4-INCH LIFT OF TOPSOIL AS SHOWN IN THE PLANS TO ANY DISTURBED AREA ON THE SHOULDER AND FORESLOPE DRAINING TO A VEGETATED BIOFILTER. THE DITCH FOR EACH VEGETATED BIOFILTER SHALL BE TRAPEZOIDAL, AS SHOWN IN THE PLAN CROSS SECTIONS. PROVIDE ITEM 670 AS SPECIFIED IN THE PLANS.

ENDANGERED SPECIES HABITAT - INDIANA BAT/NORTHERN LONG-EARED BAT

THE PROJECT SITE IS LOCATED WITHIN THE KNOWN HABITAT RANGES OF THE FEDERALLY LISTED AND PROTECTED INDIANA BAT AND NORTHERN LONG-EARED BAT. NO TREES SHALL BE REMOVED AT THIS LOCATION FROM APRIL 1 THROUGH SEPTEMBER 30. ALL NECESSARY TREE REMOVAL SHALL OCCUR FROM OCTOBER 1 THROUGH MARCH 31. THIS REQUIREMENT IS NECESSARY TO AVOID AND MINIMIZE IMPACTS TO THESE SPECIES AS REQUIRED BY THE ENDANGERED SPECIES ACT. FOR THE PURPOSES OF THIS NOTE, A TREE IS DEFINED AS A LIVE, DYING, OR DEAD WOODY PLANT, WITH A TRUNK THREE INCHES OR GREATER IN DIAMETER AT A HEIGHT OF 4.5 FEET ABOVE THE GROUND SURFACE, AND WITH A MINIMUM HEIGHT OF 13 FEET.

STREAM AVOIDANCE

UNDER NO CIRCUMSTANCES SHALL ANY EQUIPMENT (LIFT, SCAFFOLDING, BACKHOE, EARTH MOVING EQUIPMENT, ETC.) AND/OR MATERIALS ENTER AN UNNAMED TRIBUTARY TO MOSQUITO CREEK. NO FILL MATERIAL (INCLUDING TEMPORARY FILLS SUCH AS WORK PADS, COFFERDAMS, ETC.) SHALL BE PLACED BELOW THE IDENTIFIED ORDINARY HIGH WATER MARK (OHWM) OF AN UNNAMED TRIBUTARY TO MOSQUITO CREEK DEPICTED IN THE PROJECT PLANS. THE CONTRACTOR SHALL TAKE ALL PRECAUTIONS NECESSARY TO PREVENT ALL DEMOLITION DEBRIS, CONSTRUCTION MATERIALS, WASTE MATERIALS, WATER CHEMICALS OR OTHER SUBSTANCES USED TO CONSTRUCT THE PROJECT FROM ENTERING AN UNNAMED TRIBUTARY TO MOSQUITO CREEK.

WETLANDS AVOIDANCE

NO EXCAVATION, GRADING, OR FILLING OPERATIONS SHALL BE PERFORMED IN THE WETLANDS DELINEATED BEYOND THE PROJECT CONSTRUCTION LIMITS AND DEPICTED IN THE PROJECT PLANS. THE CONTRACTOR SHALL ALSO TAKE ALL PRECAUTIONS NECESSARY TO PREVENT ANY INCIDENTAL DISCHARGES INTO THESE WETLANDS. TO PREVENT ANY INCIDENTAL DISCHARGES, A FILTER FABRIC FENCE AND TEMPORARY CONSTRUCTION FENCE PER SUPPLEMENTAL SPECIFICATION 832, SHALL BE INSTALLED, MAINTAINING A ONE-FOOT BUFFER BETWEEN THE FENCE AND THE WETLAND BOUNDARIES, WHEN PRACTICABLE, PRIOR TO THE START OF ANY CONSTRUCTION ACTIVITIES, INCLUDING ANY NECESSARY CLEARING AND GRUBBING ACTIVITIES, AND BE MAINTAINED BY THE CONTRACTOR THROUGHOUT PROJECT CONSTRUCTION. IF DEBRIS ENTER WETLANDS UNAUTHORIZED FOR IMPACT DURING CONSTRUCTION, THE CONTRACTOR SHALL REMOVE THE DEBRIS IMMEDIATELY UTILIZING EQUIPMENT STAGED OUTSIDE THE BOUNDARY OF THE WETLANDS. UNDER NO CIRCUMSTANCES SHALL THE CONTRACTOR STORE EQUIPMENT (LIFT, SCAFFOLDING, BACKHOE, EARTH MOVING EQUIPMENT, ETC.) AND/OR MATERIALS IN ANY WETLANDS, ETC. ODOT CONSTRUCTION AND MATERIALS SPECIFICATIONS SECTION 107.10 (PROTECTION AND RESTORATION OF PROPERTY) PROHIBIT THE CONTRACTOR FROM CREATING STAGING AREAS NEAR STREAMS AND/OR WETLANDS. TO PREVENT ALL DEMOLITION DEBRIS, CONSTRUCTION MATERIALS, WASTE MATERIALS, WATER CHEMICALS OR OTHER SUBSTANCES USED TO CONSTRUCT THE PROJECT FROM ENTERING AN UNNAMED TRIBUTARY TO MOSQUITO CREEK.

DESIGN AGENCY



DESIGNER
TJS

REVIEWER
MJL 08/19/21

PROJECT ID
108547

SHEET TOTAL
34 | 704

ITEM 622 - PORTABLE BARRIER, UNANCHORED

DURING THE PLACEMENT OF THE PORTABLE BARRIER ON SR 82 ONLY, TRAFFIC WILL BE PROHIBITED FROM OCCUPYING THE TRAVEL LANE ADJACENT TO THE BARRIER. THE BARRIER WILL BE PLACED AT NIGHT PER THE WORK HOUR RESTRICTION NOTE AND IN ACCORDANCE WITH THE PERMITTED LANE CLOSURE MAP. THE CLOSURE OF THE ADJACENT LANE WILL BE PER THE STANDARD DRAWING MT-95.30.

THE CONTRACTOR WILL SUBMIT A PLAN TO THE ENGINEER FOR APPROVAL SEVEN (7) DAYS IN ADVANCE OF THE PLANNED LANE CLOSURE. WORK WILL NOT BEGIN UNTIL APPROVAL OF THE PLANS HAS BEEN GRANTED.

ALL COSTS INVOLVED IN PLACING THE PORTABLE CONCRETE BARRIER WILL BE INCLUDED IN THE CONTRACT PRICE BID FOR ITEM 622 PORTABLE BARRIER, UNANCHORED.

TIME LIMITATION, TRAFFIC ON A MILLED SURFACE

THE MAXIMUM ALLOWABLE TIME FOR TRAFFIC TO BE PLACED ON A MILLED SURFACE SHALL BE 7 DAYS CONSECUTIVE CALENDAR DAYS. SHOULD THE CONTRACTOR FAIL TO MEET THIS REQUIREMENT, THE CONTRACTOR SHALL BE ASSESSED A DISINCENTIVE IN THE AMOUNT OF \$3,000 PER DAY THAT THE TRAFFIC IS PLACED ON A MILLED SURFACE BEYOND THE SPECIFIED LIMIT.

DROPOFFS

THE CONTRACTOR WILL NOT BE PERMITTED TO LEAVE A DIFFERENCE IN ELEVATION BETWEEN THE MAINLINE ASPHALT SURFACE COURSE AND SIDE STREET APPROACHES/DRIVEWAYS GREATER THAN 1.25 INCH. THE CONTRACTOR SHALL PLACE A 12:1 ASPHALT WEDGE FOR ALL RESULTING ELEVATION DIFFERENCES GREATER THAN 1.25 INCH PRIOR TO OPENING TO TRAFFIC. THE PAVING OF INTERSECTION APPROACHES AND DRIVEWAYS SHALL BE PERFORMED WITHIN 7 DAYS OF MAINLINE SURFACE COURSE BEING APPLIED AND A DROPOFF BEING CREATED BETWEEN THE NEW SURFACE COURSE AND THE MILLED/EXISTING SIDE ROAD OR DRIVEWAY SURFACE. THE CONTRACTOR MAY ELECT TO PLACE A 12:1 ASPHALT WEDGE IN LIEU OF COMPLETING THE PAVING, HOWEVER THE ASPHALT CONCRETE USED FOR THE WEDGE SHALL BE CONSIDERED INCIDENTAL TO ITEM 614 - MAINTAINING TRAFFIC AND SHALL INCLUDE THE REMOVAL OF THE WEDGE BEFORE THE INTERSECTION/DRIVEWAY IS PAVED.

DUST CONTROL

THE CONTRACTOR SHALL FURNISH AND APPLY WATER FOR DUST CONTROL AS DIRECTED BY THE ENGINEER. THE FOLLOWING ESTIMATED QUANTITIES HAVE BEEN INCLUDED FOR DUST CONTROL PURPOSES:

ITEM 616, WATER 200 M. GAL.

FLOODLIGHTING

FLOODLIGHTING OF THE WORK SITE FOR OPERATIONS CONDUCTED DURING NIGHTTIME PERIODS SHALL BE ACCOMPLISHED SO THAT THE LIGHTS DO NOT CAUSE GLARE TO THE DRIVERS ON THE ROADWAY. TO ENSURE THE ADEQUACY OF THE FLOODLIGHT PLACEMENT, THE CONTRACTOR AND THE ENGINEER SHALL DRIVE THROUGH THE WORK SITE EACH NIGHT WHEN THE LIGHTING IS IN PLACE AND OPERATIVE PRIOR TO COMMENCING ANY WORK. IF GLARE IS DETECTED, THE LIGHT PLACEMENT AND SHIELDING SHALL BE ADJUSTED TO THE SATISFACTION OF THE ENGINEER BEFORE WORK PROCEEDS.

PAYMENT FOR ALL LABOR, EQUIPMENT AND MATERIALS SHALL BE INCLUDED IN THE LUMP SUM CONTRACT PRICE FOR ITEM 614, MAINTAINING TRAFFIC.

ITEM 614, MAINTAINING TRAFFIC (NOTICE OF CLOSURE SIGN)

NOTICE OF CLOSURE SIGNS (W20-H13) SHALL BE ERECTED BY THE CONTRACTOR PRIOR TO THE SCHEDULED ROAD OR RAMP CLOSURE IN ACCORDANCE WITH THE NOTICE OF CLOSURE TIME TABLE BELOW. AT THE APPROVAL OF THE ENGINEER, PORTABLE CHANGEABLE MESSAGE SIGNS MAY BE USED IN LIEU OF THE STANDARD FLATSHEET SIGN FOR CLOSURE DURATIONS OF LESS THAN 1 WEEK.

THE SIGNS SHALL BE ERECTED ON THE RIGHT-HAND SIDE OF THE ROAD/RAMP FACING TRAFFIC. THEY SHALL BE PLACED SO AS NOT TO INTERFERE WITH THE VISIBILITY OF ANY OTHER TRAFFIC CONTROL SIGNS. ON ROADWAYS, THEY SHOULD BE ERECTED AT OR NEAR THE POINT OF CLOSURE. THE SIGNS MAY BE ERECTED ANYWHERE ON RAMPS AS LONG AS THEY ARE VISIBLE TO THE MOTORISTS USING THE RAMP. ON ENTRANCE RAMPS, THE SIGN SHALL BE ERECTED WELL IN ADVANCE OF THE MERGE AREA TO AVOID DISTRACTING MOTORISTS.

NOTICE OF CLOSURE SIGN TIME TABLE		
ITEM	DURATION OF CLOSURE	SIGN DISPLAYED TO PUBLIC
RAMP & ROAD CLOSURES	>=2 WEEKS PRIOR TO CLOSURE	14 CALENDAR DAYS
	> 12 HOURS & < 2 WEEKS PRIOR TO CLOSURE	7 CALENDAR DAYS
	<= 12 HOURS PRIOR TO CLOSURE	2 BUSINESS DAYS

THE SIGN SHALL DISPLAY THE DATE OF THE CLOSURE IN MMM-DD FORMAT AND THE NUMBER OF DAYS OF THE CLOSURE. THE LAST LINE OF THE W20-H13 SIGN LISTS A PHONE NUMBER WHICH A MOTORIST MAY CALL FOR ADDITIONAL INFORMATION. THIS IS TO BE A SPECIFIC OFFICE WITHIN THE DISTRICT RATHER THAN THE GENERAL SWITCHBOARD NUMBER.

ITEM 614, MAINTAINING TRAFFIC (TIME LIMITATION ON A DETOUR)

RAMPS MAY BE CLOSED FOR SHORT DURATIONS IN ACCORDANCE WITH THE RAMP CLOSURES TABLE AND DETOUR SHEETS \$MD001D005. THE CONTRACTOR SHALL BE ASSESSED A DISINCENTIVE AS DESIGNATED IN THE RAMP CLOSURES TABLE FOR EACH CALENDAR DAY THE RAMP REMAINS CLOSED TO TRAFFIC BEYOND THE SPECIFIED AMOUNT.

RAMP CLOSURES TABLE			
RAMP	PERMITTED WEEKEND CLOSURE	PERMITTED WEEKDAY NIGHTTIME CLOSURE	DISINCENTIVE AMOUNTS PER DAY
A	FRIDAY 8PM - MONDAY 6AM	N/A	\$36,700
B		10PM-6AM	\$21,500
C		N/A	\$45,100
D		N/A	\$39,500
MARKET STREET		N/A	\$4,600

ITEM 614, MAINTAINING TRAFFIC (SR 46 CLOSURE)

DURING DEMOLITION OF EXISTING SR 82 BRIDGE, SR 46 MAY BE CLOSED FOR SHORT DURATIONS IN ACCORDANCE WITH THE SR 46 CLOSURE TABLE BELOW. THE CONTRACTOR SHALL BE ASSESSED A DISINCENTIVE AS DESIGNATED IN THE SR 46 CLOSURE TABLE FOR EACH HOUR THAT SR 46 REMAINS CLOSED TO TRAFFIC BEYOND THE SPECIFIED PERIOD.

SR 46 CLOSURE TABLE		
PERMITTED NIGHTTIME CLOSURE		DISINCENTIVE AMOUNT PER MINUTE PER LANE
MONDAY - FRIDAY	10 PM - 5 AM	\$355

ITEM 614, WORK ZONE CROSSOVER LIGHTING SYSTEM

THIS WORK SHALL CONSIST OF FURNISHING, ERECTING, OPERATING, MAINTAINING AND REMOVING A WORK ZONE LIGHTING SYSTEM FOR A SINGLE CROSSOVER, OR OVERLAPPING A PAIR OF CROSSOVERS. THE SYSTEM SHALL BE AS SHOWN ON TRAFFIC SCD MT-100.00. THE CONTRACTOR SHALL ARRANGE FOR AND PAY FOR POWER. ALL MATERIALS AND CONSTRUCTION SHALL COMPLY WITH APPLICABLE PORTIONS OF 625 AND 725 EXCEPT: THE PERFORMANCE TEST OF 625.19F, AND CERTIFIED DRAWING REQUIREMENT OF 625.06, ARE WAIVED AND USED MATERIALS IN GOOD CONDITION ARE ACCEPTABLE.

POLES WHICH ARE NOT PROTECTED BY GUARDRAIL OR PORTABLE BARRIER SHALL BE LOCATED OUTSIDE THE CLEAR ZONE, AND SHOULD BE LOCATED AT LEAST 30 FEET (PREFERABLY 40 FEET) FROM THE EDGE OF PAVEMENT WHEN POSSIBLE. ADDITIONAL POLE LINES, CABLES AND APPURTENANCES NECESSARY TO FURNISH POWER TO THE LIGHTING SYSTEM SHALL BE INCLUDED IN THIS ITEM. SERVICE POLES SHALL BE POSITIONED WITH THE SAME CONSTRAINTS AS THE LIGHTING POLES AS A MINIMUM.

PAYMENT WILL BE MADE AT THE UNIT PRICE PER EACH FOR ITEM 614, WORK ZONE CROSSOVER LIGHTING SYSTEM THROUGHOUT ALL PHASES OF WORK WHEN THE CROSSOVER ROADWAYS ARE USED.

THE FOLLOWING ESTIMATED QUANTITIES HAVE BEEN CARRIED TO THE GENERAL SUMMARY:

ITEM 614, WORK ZONE CROSSOVER LIGHTING SYSTEM 2 EA

ASPHALT PAVING LIMITATION

THE CONTRACTOR SHALL NOT ANTICIPATE OR SCHEDULE PLACING ASPHALT (ASPHALT SURFACE COURSE, ASPHALT INTERMEDIATE COURSE, ASPHALT CONCRETE BASE, ETC.) BETWEEN NOVEMBER 1 AND APRIL 1 WHEN SUBMITTING THEIR INITIAL BAR CHART PROGRESS SCHEDULE TO THE DISTRICT CONSTRUCTION ENGINEER (DCE) AS SPECIFIED IN CMS SECTION 108.02A. THIS LIMITATION SHALL ALSO INCLUDE INITIAL BASE LINE SCHEDULES AND ALL UPDATES IF A CPM SCHEDULE IS REQUIRED.

LANE VALUE CONTRACTING TABLE

ALL EXISTING LANES OF TRAFFIC SHALL BE MAINTAINED AT ALL TIMES BY USE OF THE EXSITING PAVEMENT, ITEM 615 TEMPORARY PAVEMENT, AND THE PROPOSED PAVEMENT. THE CONTRACTOR SHALL BE ASSESSED A DISINCENTIVE AS DESIGNATED IN THE LANE VALUE CONTRACT TABLE FOR EACH UNIT OF TIME A LANE/SHOULDER IS CLOSED BY THE CONTRACTOR'S ACTION WHILE NOT OTHERWISE PERMITTED BY THE LANE VALUE CONTRACT TABLE.

LANE VALUE CONTRACT TABLE							
SECTION (SLM)	SEASON	EXISTING NUMBER OF LANES PER DIRECTION	LANE CLOSURES ARE NOT PERMITTED:				DISINCENTIVE AMOUNTS PER MINUTE PER LANE
			LANE REDUCTION	MON TO FRI	SAT	SUN	
ELM RD/SR5 (14.08) TO SR46 (16.80) [EAST]	SUMMER	2	2 TO 1	7AM-8AM 2PM-6PM	NO RESTRICTION	NO RESTRICTION	\$235
	SPRING/FALL			3PM-6PM			
	WINTER						
ELM RD/SR5 (14.08) TO SR46 (16.80) [WEST]	SUMMER	2	2 TO 1	7AM-8AM 2PM-7PM	NO RESTRICTIONS	NO RESTRICTIONS	\$235
	SPRING/FALL			7AM-9AM 2PM-6PM			
	WINTER			7AM-8AM 3PM-6PM			
ALL SHOULDER CLOSURES WILL FOLLOW THE TIME OF DAY AND DURATIONS GIVEN FOR A SINGLE LANE CLOSURE							

ITEM 622, PORTABLE BARRIER, 50", AS PER PLAN

THIS WORK SHALL CONSIST OF FURNISHING, MAINTAINING, AND SUBSEQUENTLY REMOVING A 50-INCH PORTABLE BARRIER AT THE LOCATIONS SHOWN ON THE PLANS. FOR DETAILS, SEE SCD RM-4.1.

PORTABLE STEEL BARRIER IS AN APPROVED ALTERNATIVE TO PORTABLE CONCRETE BARRIER. FOR INFORMATION ON APPROVED VENDORS, SEE THE APPROVED PRODUCTS LIST MAINTAINED BY THE OFFICE OF ROADWAY ENGINEERING.

PORTABLE BARRIER, 32 INCHES HIGH WITH AN 18-INCH MINIMUM HEIGHT GLARE SCREEN MAY BE USED AT THE OPTION OF THE CONTRACTOR. THE GLARE SCREEN SHALL BE CONSTRUCTED USING ONE OF THE SCREENS PROVIDED ON THE APPROVED LIST, AVAILABLE ON THE OFFICE OF ROADWAY ENGINEERING WEBSITE.

PADDLE OR INTERMITTENT TYPE GLARE SCREENS SHALL BE DESIGNED USING A 20 DEGREE CUT-OFF ANGLE BASED ON TANGENT ALIGNMENT. THAT SPACING SHALL BE USED THROUGHOUT THE BARRIER LENGTH WITHOUT REGARD TO BARRIER CURVATURE.

THE GLARE SCREEN SYSTEM SHALL BE SECURELY FASTENED TO THE 32-INCH PORTABLE BARRIER USING THE HARDWARE AND PROCEDURES SPECIFIED BY THE MANUFACTURER.

FOR DIRECTIONS ON HOW TO INSTALL THE GLARE SCREEN AND THE BARRIER, SEE THE MANUFACTURER'S INSTRUCTIONS.

PAYMENT SHALL INCLUDE ALL LABOR, MATERIAL, AND EQUIPMENT NECESSARY TO PERFORM THE WORK AND SHALL BE PAID FOR AT THE CONTRACT PRICE PER FOOT FOR ITEM 622, PORTABLE BARRIER, 50", AS PER PLAN.

PHASING RESTRICTIONS

FROM NOVEMBER 1 THROUGH JANUARY 3, TRAFFIC SHALL BE MAINTAINED PER THE PHASING SHEETS 107 THROUGH 118. NO ADDITIONAL LANE CLOSURES SHALL BE PERMITTED DURING THIS TIME FRAME FOR WORK ON SR 46. FAILURE TO COMPLY WITH THIS RESTRICTION SHALL RESULT IN A DISINCENTIVE PENALTY OF \$4000/DAY THAT LANE CLOSURES EXIST BEYOND WHAT IS SHOWN ON THE STRUCTURE PHASING SHEETS. TRAFFIC SHALL BE PLACED IN THE SR 46 STAGE 2 PREPHASE PATTERN BY NOVEMBER 1, 2024. TRAFFIC SHALL NOT BE SHIFTED INTO SR 46 STAGE 2 PHASE 1 PATTERN UNTIL APRIL 1, 2025 WITHOUT APPROVAL OF THE ENGINEER. FAILURE TO MEET THESE REQUIREMENTS SHALL RESULT IN A DISINCENTIVE PENALTY OF \$4000/DAY.

TRU-46/82 DDI

MODEL: General Summary 4 PAPER SIZE: 34x22 (in.) DATE: 5/4/2023 TIME: 5:05:12 PM USER: TSCHOEN
pvc:\pvh\rd\users\01\HDR_US_East_01\Documents\Ohio_DOT\DOTDIT_TRU-46-82_DDI\6.0_CAD_BIM\6.2_WIP\01_Design\108547\400-Engineering\Roadway\Sheets\General Summary 1

SHEET NUM.												PART.		ITEM	ITEM EXT	GRAND TOTAL	UNIT	DESCRIPTION	SEE SHEET NO.	
32	40	41	293	294	295	543	546	550	613	614	615	01/SAF/21	02/NHS/11							
																			LIGHTING (CONT.)	
									542	775	65	1,382		352	625	25500	1,382	FT	CONDUIT, 3", 725.04	
															625	25600	352	FT	CONDUIT, 4", 725.04	
									114			114			625	25802	114	FT	CONDUIT, CONCRETE ENCASED, 3", 725.05	
										2		2			625	26253	2	EACH	LUMINAIRE, CONVENTIONAL, SOLID STATE (LED), AS PER PLAN, TYPE II, 15300-16700 LM, 120V	612
									14	9	9	32			625	26253	32	EACH	LUMINAIRE, CONVENTIONAL, SOLID STATE (LED), AS PER PLAN, TYPE II, 15300-16700 LM, 240V	612
									2	3	1	6			625	26253	6	EACH	LUMINAIRE, CONVENTIONAL, SOLID STATE (LED), AS PER PLAN, TYPE III, 15300-16700 LM, 240V	612
											4	4			625	27503	4	EACH	LUMINAIRE, UNDERPASS, SOLID STATE (LED), AS PER PLAN, TYPE III, 2900-4200 LM, 240V	612
									3,501	2,020	3,729	9,250			625	29000	9,250	FT	TRENCH	
											2			2	625	29920	2	EACH	STRUCTURE JUNCTION BOX	
									5	5	5	15			625	30700	15	EACH	PULL BOX, 725.08, 18"	
									2	5	2	7		2	625	30706	9	EACH	PULL BOX, 725.08, 24"	
									17	10	10	37			625	32000	37	EACH	GROUND ROD	
										2		2			625	32001	2	EACH	GROUND ROD, AS PER PLAN	
											2			2	625	33000	2	EACH	STRUCTURE GROUNDING SYSTEM	612
									1			1			625	34001	1	EACH	POWER SERVICE, AS PER PLAN	612
									3,501	2,020	3,729	9,250			625	36011	9,250	FT	UNDERGROUND WARNING/MARKING TAPE, AS PER PLAN	612
											1	1			625	37100	1	EACH	SERVICE TO UNDERPASS LIGHTING	
									1			1			625	76000	1	EACH	ARC FLASH CALCULATIONS AND LABEL, PWR SVR - NLS	612
																			TRAFFIC CONTROL	
	150							106				256			621	00100	256	EACH	RPM	
	150					105						255			621	54000	255	EACH	RAISED PAVEMENT MARKER REMOVED	
							8					8			625	32000	8	EACH	GROUND ROD, TC-21.21	
38				12	10							60			626	00102	60	EACH	BARRIER REFLECTOR, TYPE 1 (ONE-WAY)	
28			39		20							87			626	00110	87	EACH	BARRIER REFLECTOR, TYPE 2 (ONE-WAY)	
							642.5					642.5			630	03100	642.5	FT	GROUND MOUNTED SUPPORT, NO. 3 POST	
							49.5					49.5			630	04100	49.5	FT	GROUND MOUNTED SUPPORT, NO. 4 POST	
							181					181			630	06500	181	FT	GROUND MOUNTED STRUCTURAL BEAM SUPPORT, W6X9	
							76					76			630	07600	76	FT	GROUND MOUNTED STRUCTURAL BEAM SUPPORT, W10X12	
							12					12			630	08600	12	EACH	SIGN POST REFLECTOR	
							6					6			630	09000	6	EACH	BREAKAWAY STRUCTURAL BEAM CONNECTION	
							3					3			630	72320	3	EACH	OVERHEAD SIGN SUPPORT, TYPE TC-12.31, DESIGN 6	
							4					4			630	72410	4	EACH	OVERHEAD SIGN SUPPORT, TYPE TC-15.116, DESIGN 1	
							1					1			630	72430	1	EACH	OVERHEAD SIGN SUPPORT, TYPE TC-15.116, DESIGN 3	
							1					1			630	72540	1	EACH	OVERHEAD SIGN SUPPORT, TYPE TC-16.22, DESIGN 12	
							667.2					667.2			630	80100	667.2	SF	SIGN, FLAT SHEET	
							1,286.1					1,286.1			630	80200	1,286.1	SF	SIGN, GROUND MOUNTED EXTRUSHEET	
							10					10			630	84510	10	EACH	RIGID OVERHEAD SIGN SUPPORT FOUNDATION, TC-21.11	
							102					102			630	84900	102	EACH	REMOVAL OF GROUND MOUNTED SIGN AND DISPOSAL	
							10					10			630	85100	10	EACH	REMOVAL OF GROUND MOUNTED SIGN AND REERECTION	
							91					91			630	86002	91	EACH	REMOVAL OF GROUND MOUNTED POST SUPPORT AND DISPOSAL	
							15					15			630	87400	15	EACH	REMOVAL OF OVERHEAD MOUNTED SIGN AND DISPOSAL	
							3					3			630	89702	3	EACH	REMOVAL OF OVERHEAD SIGN SUPPORT AND DISPOSAL	
	4							3.17				7.17			646	10010	7.17	MILE	EDGE LINE, 6"	
		1.5						0.9				2.4			646	10110	2.4	MILE	LANE LINE, 6"	
		0.25						0.96				1.21			646	10200	1.21	MILE	CENTER LINE	
		500						2,644				3,144			646	10310	3,144	FT	CHANNELIZING LINE, 12"	
								207				207			646	10400	207	FT	STOP LINE	
								230				230			646	10510	230	FT	CROSSWALK LINE, 12"	
								138				138			646	10600	138	FT	TRANSVERSE/DIAGONAL LINE	
								58				58			646	20300	58	EACH	LANE ARROW	
								3				3			646	20320	3	EACH	WRONG WAY ARROW	
								4				4			646	20350	4	EACH	LANE REDUCTION ARROW	
								1,755				1,755			646	20504	1,755	FT	DOTTED LINE, 6"	

GENERAL SUMMARY

DESIGN AGENCY



DESIGNER

TJS

REVIEWER

KF 07/15/22

PROJECT ID

108547

SHEET

289

TOTAL

704

STATION RANGE		TYPICAL SECTION	SIDE	DISTANCE (D)	AVERAGE WIDTH (W)	SURFACE AREA (A) A=DxW/9	CADD GENERATED AREA	204	204	204	204	204	302	304	304	407	442	442	609	690									
								SUBGRADE COMPACTION	PROOF ROLLING	EXCAVATION OF SUBGRADE, 12"	GRANULAR MATERIAL, TYPE C, 12"	GEOTEXTILE FABRIC	ASPHALT CONCRETE BASE, PG64-22, (449), 7"	AGGREGATE BASE, 6"	AGGREGATE BASE, 16"	NON-TRACKING TACK COAT (0.06/SY)	ASPHALT CONCRETE SURFACE COURSE, 12.5 MM, TYPE A (448), AS PER PLAN, PG70-22M, 1.5"	ASPHALT CONCRETE INTERMEDIATE COURSE, 19 MM, TYPE A (446), 1.75"	6" CONCRETE TRAFFIC ISLAND, AS PER PLAN, CLASS QC1P	SPECIAL - ARTIFICIAL TURF									
				FT	FT	SY	SY	SY	HOUR	CY	CY	SY	CY	CY	CY	GAL	CY	CY	SY	SY									
SR 46 NORTHBOUND (CONT.)																													
182+90.16	183+79.59		LT/RT	89.43	57.78		574.11						111.63			68.89	23.92	27.91											
			LT/RT	89.43	59.01		586.33							97.72															
			LT/RT	89.43	59.44		590.67	590.67	0.30																				
SR 46 SOUTHBOUND																													
281+50.00	282+00.00		LT/RT	50.00	39.00	216.67							42.13			26.00	9.03	10.53											
			LT/RT	50.00	40.00	222.22								37.04															
			LT/RT	50.00	41.00	227.78		227.78	0.11																				
282+00.00	283+05.47		LT/RT	105.47	36.00	421.88							82.03			50.63	17.58	20.51											
			LT/RT	105.47	37.00	433.60								72.27															
			LT/RT	105.47	38.00	445.32																							
283+05.47	283+73.51		LT/RT	68.04	50.59		382.44						74.36			45.89	15.94	18.59											
			LT/RT	68.04	52.18		394.44							65.74															
			LT/RT	68.04	52.70		398.44	398.44	0.20																				
SOUTH CROSS OVER																													
183+79.59	185+82.88		LT/RT	203.29			1784.11									107.05	74.34												
283+73.51	285+81.12		LT/RT	207.61			1797.22									107.83		87.36											
			LT/RT				1799.44						349.89																
			LT/RT				1830.89							305.15															
			LT/RT				1838.00	1838.00	0.92																				
184+50.00	185+82.88		LT/RT	132.88			1417.11			472.37	472.37	2892.89																	
284+50.00	285+81.12		LT/RT	131.12																									
SOUTH MEDIAN ISLAND																													
380+50.50	383+67.84		LT/RT	317.34	8.93		314.89	314.89	0.16							139.95													
RAMP A SPLITTER ISLAND																													
			LT				94.56																						
			LT				219.00																						
			LT				360.11	360.11	0.18							160.05													
RAMP B SPLITTER ISLAND																													
			RT				182.22																						
			RT				745.33																						
			RT				927.44	927.44	0.46							412.20													
CENTRAL MEDIAN ISLAND																													
			LT/RT				376.78																						
			LT/RT				615.22	615.22	0.31							273.43													
SR 46 NORTHBOUND																													
185+82.88	187+29.95		LT/RT	147.07	58.01		948.00																						
			LT/RT	147.07	59.22		967.78																						
			LT/RT	147.07	60.53		989.11						192.33																
			LT/RT	147.07	61.58		1006.22																						
			LT/RT	147.07	62.22		1016.67	1016.67	0.51	338.89	338.89	2066.02				167.70													
SR 46 SOUTHBOUND																													
285+81.12	287+29.85		LT/RT	148.73	39.97		660.56																						
			LT/RT	148.73	42.08		695.44																						
			LT/RT	148.73	42.41		700.78						136.26																
			LT/RT	148.73	43.32		715.89																						
			LT/RT	148.73	43.77		723.33	723.33	0.36	241.11	241.11	1479.72																	
SUBTOTALS								7457.87	3.73	1052.37	1052.37	6438.62	988.64	864.93	985.63	602.60	207.82	245.76	968.44	964.33									
TOTALS CARRIED TO SHEET 310								7458	4	1053	1053	6439	989	865	986	603	208	246	969	965									

PAVEMENT SUBSUMMARY


DESIGN AGENCY



DESIGNER
VLE
 REVIEWER
MJL 06/29/22
 PROJECT ID
108547
 SHEET TOTAL
297 704

STATION RANGE	TYPICAL SECTION	SIDE	DISTANCE (D)	AVERAGE WIDTH (W)	SURFACE AREA (A) A=DxW/9	CADD GENERATED AREA	204	204	204	204	204	302	304	304	407	442	442	609	690								
							SUBGRADE COMPACTION	PROOF ROLLING	EXCAVATION OF SUBGRADE, 12"	GRANULAR MATERIAL, TYPE C, 12"	GEOTEXTILE FABRIC	ASPHALT CONCRETE BASE, PG64-22, (449), 7"	AGGREGATE BASE, 6"	AGGREGATE BASE, 16"	NON-TRACKING TACK COAT (0.06/SY)	ASPHALT CONCRETE SURFACE COURSE, 12.5 MM, TYPE A (448), AS PER PLAN, PG70-22M, 1.5"	ASPHALT CONCRETE INTERMEDIATE COURSE, 19 MM, TYPE A (446), 1.75"	6" CONCRETE TRAFFIC ISLAND, AS PER PLAN, CLASS QCIP	SPECIAL - ARTIFICIAL TURF								
			FT	FT	SY	SY	SY	HOUR	CY	CY	SY	CY	CY	CY	GAL	CY	CY	SY	SY								
NORTH CROSS OVER																											
187+29.95		189+15.55																									
287+29.85		289+17.02				1307.44										78.45	54.48										
						1320.89										79.25		64.21									
						1322.89						257.23															
						1348.00							224.67														
						1349.89	1349.89	0.67																			
187+29.95		188+00.00																									
287+29.85		288+00.00				691.78			230.59	230.59	1414.71																
RAMP C SPLITTER ISLAND																											
						118.11																					
						222.56																					
						393.89	393.89	0.20																			
RAMP D SPLITTER ISLAND																											
						639.00																					
						839.67																					
						1110.44	1110.44	0.56																			
SR 46 SOUTHBOUND																											
289+17.02		290+00.81				432.00						84.00			51.84	18.00	21.00										
						445.44							74.24														
						449.00	449.00	0.22																			
290+00.81		290+28.08										26.25			16.20	5.62	6.56										
													23.26														
290+28.08		291+10.00										86.07			53.12	18.44	21.52										
													75.29														
291+10.00		291+60.00										41.73			25.75	8.94	10.43										
													36.69														
291+60.00		293+32.42										110.79			68.37	23.74	27.70										
													98.15														
SR 46 NORTHBOUND																											
189+15.55		189+61.18				256.22						49.82			30.75	10.68	12.46										
						266.56							44.43														
						270.11	270.11	0.14																			
189+61.18		189+80.63										14.48			8.94	3.10	3.62										
													12.95														
189+80.63		190+27.13										33.65			20.76	7.21	8.41										
													30.13														
190+27.13		190+93.97										64.35			39.71	13.79	16.09										
													56.39														
190+93.97		192+47.76										131.94			81.43	28.27	32.99										
													115.94														
192+47.76		193+30.91										69.36			42.81	14.86	17.34										
													60.99														
NORTH MEDIAN ISLAND																											
389+00.95		390+03.44				221.56	221.56	0.11							98.47												
SUBTOTALS							6892.65	3.45	230.59	230.59	1414.71	969.66	853.13	767.06	597.37	207.14	242.32	978.67	1062.22								
TOTALS CARRIED TO SHEET 310							6893	4	231	231	1415	970	854	768	598	208	243	979	1063								

PAVEMENT SUBSUMMARY

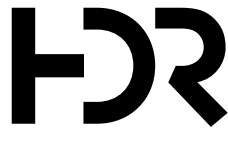DESIGN AGENCY

 DESIGNER
 VLE
 REVIEWER
 MJL 06/29/22
 PROJECT ID
 108547
 SHEET TOTAL
 298 704

SHEET	202	202	204	204	204	204	204	204	204	209	252	254	302	304	304	304	304	407	407	408	441	441	441	441	442	442	452	452	452	452	609	617	690	690
	PAVEMENT REMOVED	WEARING COURSE REMOVED	SUBGRADE COMPACTION	PROOF ROLLING	EXCAVATION OF SUBGRADE, 12"	EXCAVATION OF SUBGRADE, 24"	GRANULAR MATERIAL, TYPE C, 12"	GRANULAR MATERIAL, TYPE C, 24"	GEOTEXTILE FABRIC	LINEAR GRADING, AS PER PLAN	FULL DEPTH PAVEMENT SAWING	PAVEMENT PLANING, ASPHALT CONCRETE, 1.5"	ASPHALT CONCRETE BASE, PG64-22, (449), 7"	AGGREGATE BASE, 6"	AGGREGATE BASE, 8"	AGGREGATE BASE, 9.25"	AGGREGATE BASE, 16"	NON-TRACKING TACK COAT (0.06/SY)	NON-TRACKING TACK COAT (0.09/SY)	PRIME COAT, AS PER PLAN (0.04/SY)	ASPHALT CONCRETE SURFACE COURSE, TYPE 1, (449), (DRIVEWAYS), 1.25"	ASPHALT CONCRETE SURFACE COURSE, TYPE 1, (449), (DRIVEWAYS), 2"	ASPHALT CONCRETE INTERMEDIATE COURSE, TYPE 2, (449), (DRIVEWAYS), 1.75"	ASPHALT CONCRETE INTERMEDIATE COURSE, TYPE 1, (449), (UNDER GUARDRAIL), 1.5"	ASPHALT CONCRETE SURFACE COURSE, 12.5 MM, TYPE A (448), AS PER PLAN, PG70-22M, 1.5"	ASPHALT CONCRETE INTERMEDIATE COURSE, 19 MM, TYPE A (446), 1.75"	6" NON-REINFORCED CONCRETE PAVEMENT, CLASS QC 1P	8" NON-REINFORCED CONCRETE PAVEMENT, CLASS QC 1P	10" NON-REINFORCED CONCRETE PAVEMENT, CLASS QC 1P	4" CONCRETE WALK	6" CONCRETE TRAFFIC ISLAND, AS PER PLAN, CLASS QC1P	COMPACTED AGGREGATE, AS PER PLAN, 2"	SPECIAL - REINFORCED MESH FOR TRANSVERSE AND/OR LONGITUDINAL JOINTS AND CRACKS	SPECIAL - ARTIFICIAL TURF
	SY	SY	SY	HOUR	CY	CY	CY	CY	SY	STA	FT	SY		CY	CY	CY	CY	GAL	GAL	GAL	CY	CY	CY	CY	CY	CY	SY	SY	SY	SF	SY	CY	SY	SY
296			2,864	2							897	3,081	517	464				504	278						239	130							445	
297			7,458	4	1,053		1,053		6,439				989	865			986	603							208	246					969			965
298			6,893	4	231		231		1,415				970	854			768	598							208	243					979			1,063
299			4,959	3	727		727		4,542				921	809				563							196	229								
300			1,188	1							1,303	1,738	202	184				120	157						114	49								703
301			1,685	1							1,191	28,287	289	259		10		158	2,546						1,239	70								686
302			2,468	2						20			59	124	347			130			55	25	76	45	13	15	32	227		18,878				
303																				46												64		
304	31,529	156																							7									
305			2,661	2	684		684		4,211		31	90		426					9						4			570	1,906					
306			3,587	2							26	382	581					224							76	94		1,362						
307			2,523	2		1,147		1,147	3,665				25	399														2,293						
308			4,018	3									552	691				205							71	83			2,049					
309	4,771		4,088	2						12	229	725	871	849				509	326	2			26	223	225								3	
SUBTOTAL	36,300	156	44,392	28	2,695	1,147	2,695	1,147	20,272	32	4,254	33,921	5,535	6,505	347	10	1,754	3,614	3,316	48	55	25	76	71	2,598	1,384	32	4,452	3,955	18,878	1,948	67	1,834	2,028
TOTALS CARRIED TO GENERAL SUMMARY	36,300	156	44,392	28	3,842		3,842		20,272	32	4,254	33,921	5,535	8,616			6,930		48	80		76	71	2,598	1,384	32	4,452	3,955	18,878	1,948	67	1,834	2,028	

PAVEMENT SUBSUMMARY

DESIGN AGENCY



DESIGNER

VLE

REVIEWER



MJL 06/29/22

PROJECT ID

108547

SHEET TOTAL

310 | 704

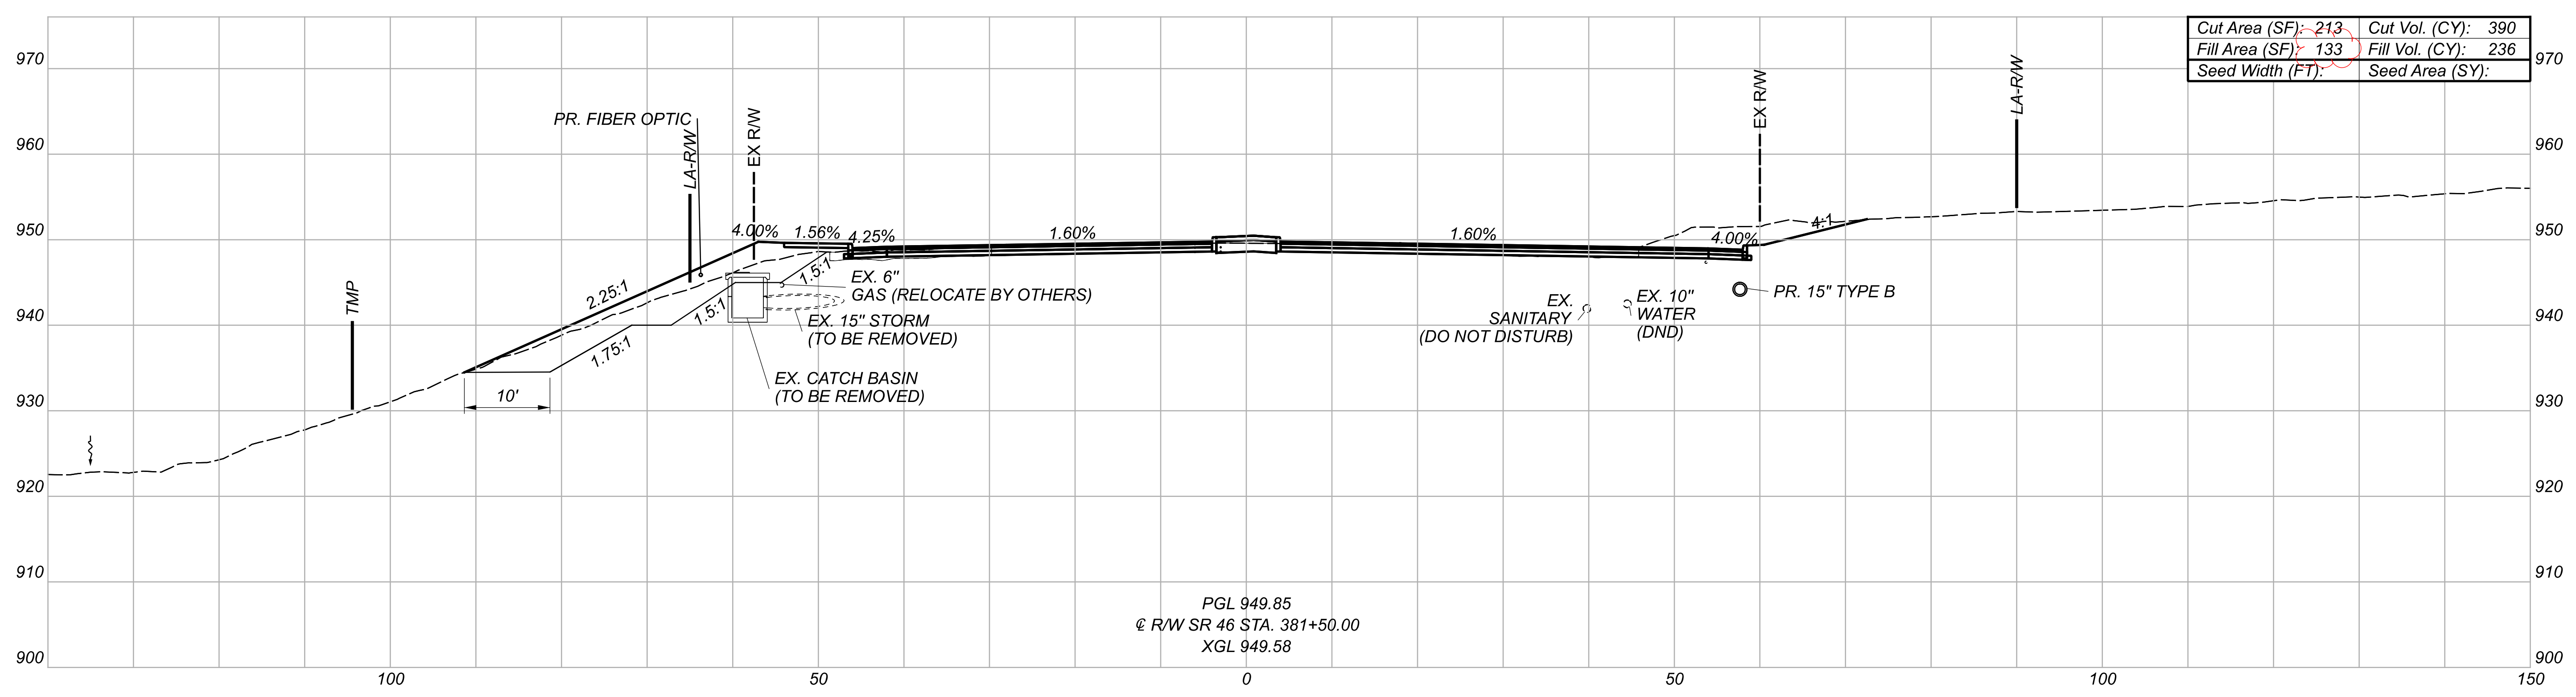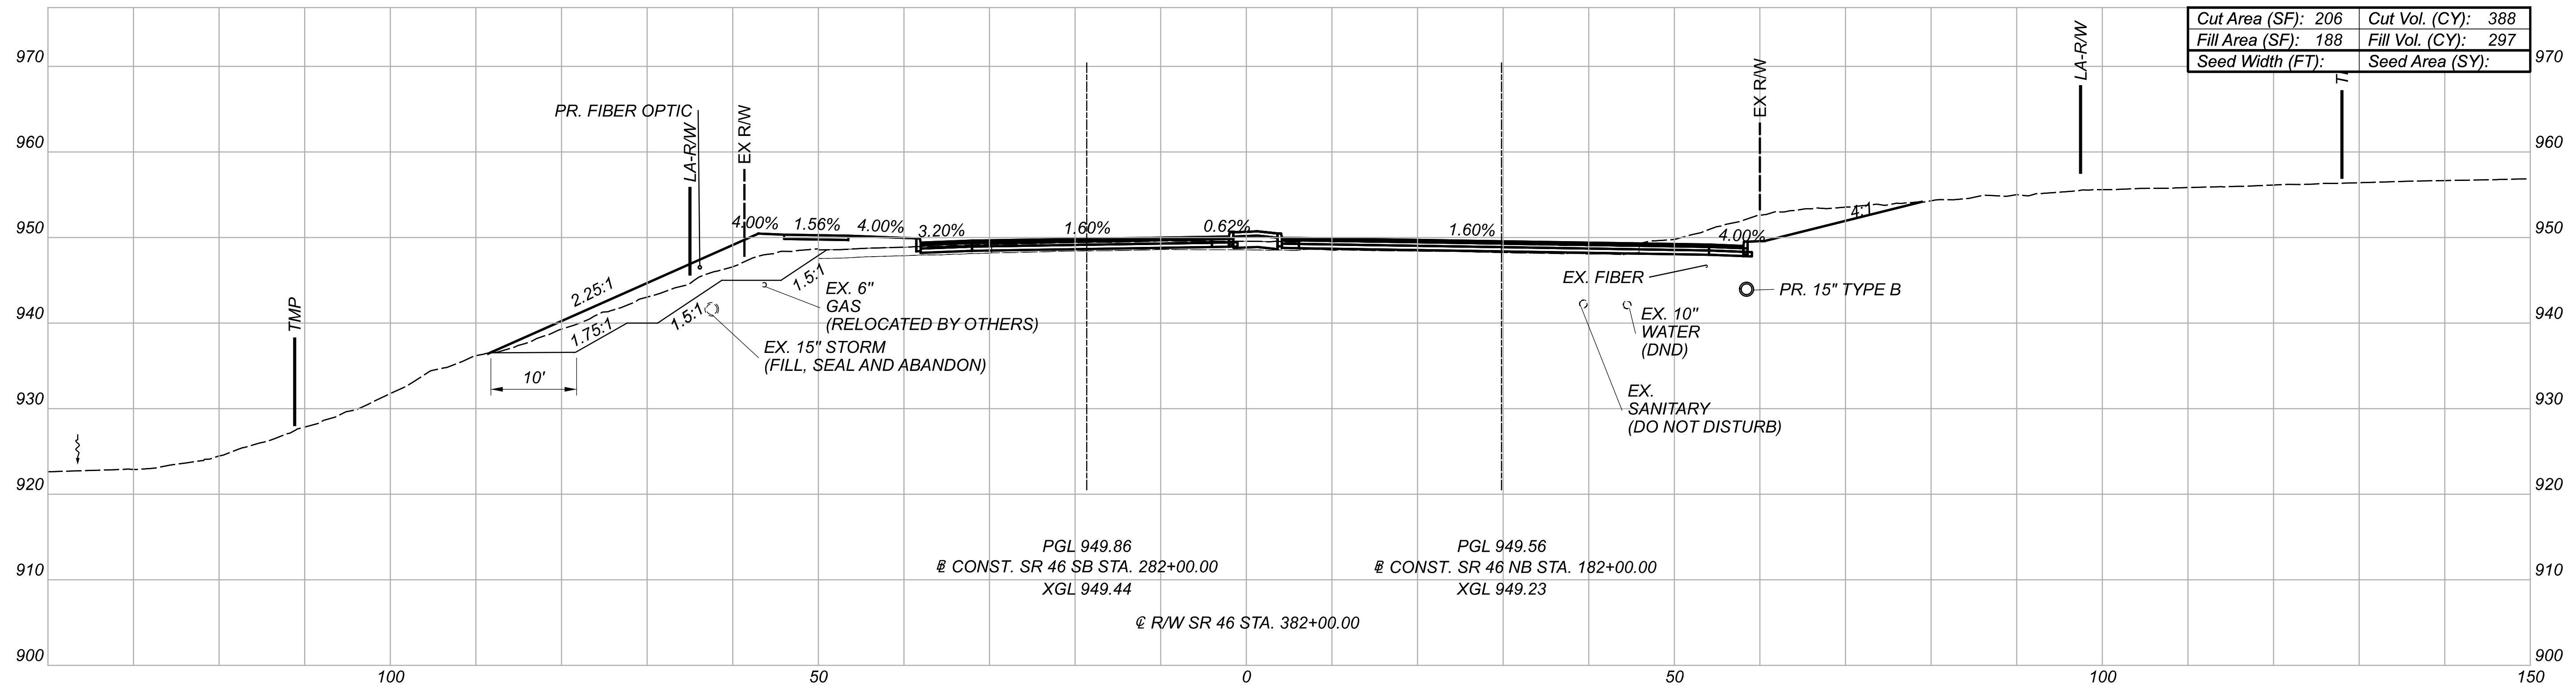

CROSS SECTIONS - CENTERLINE R/W & CONST. SR 46
 STA. 381+50.00 TO STA. 382+00.00

DESIGN AGENCY





DESIGNER
 MJL




REVIEWER
 JMB 08/19/21

PROJECT ID
 108547

Sheet Totals			SHEET TOTAL	
Seeding	Cut	Fill	373	704
.	777	533		

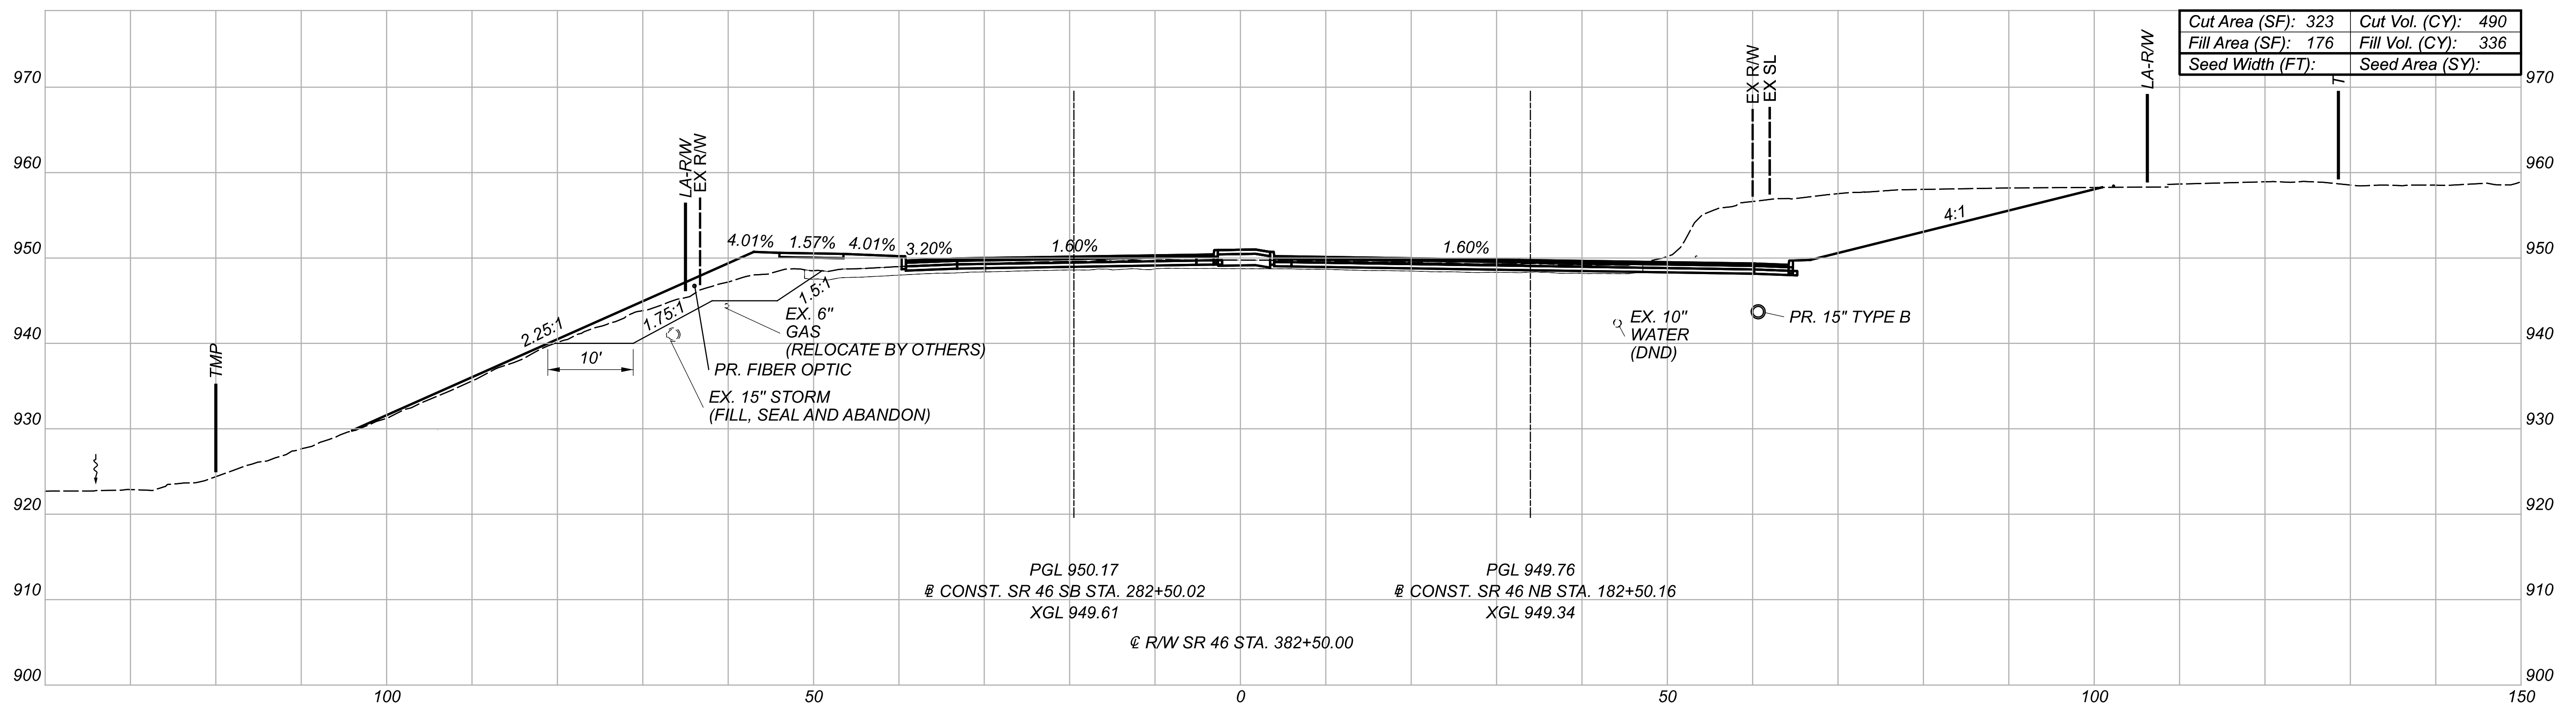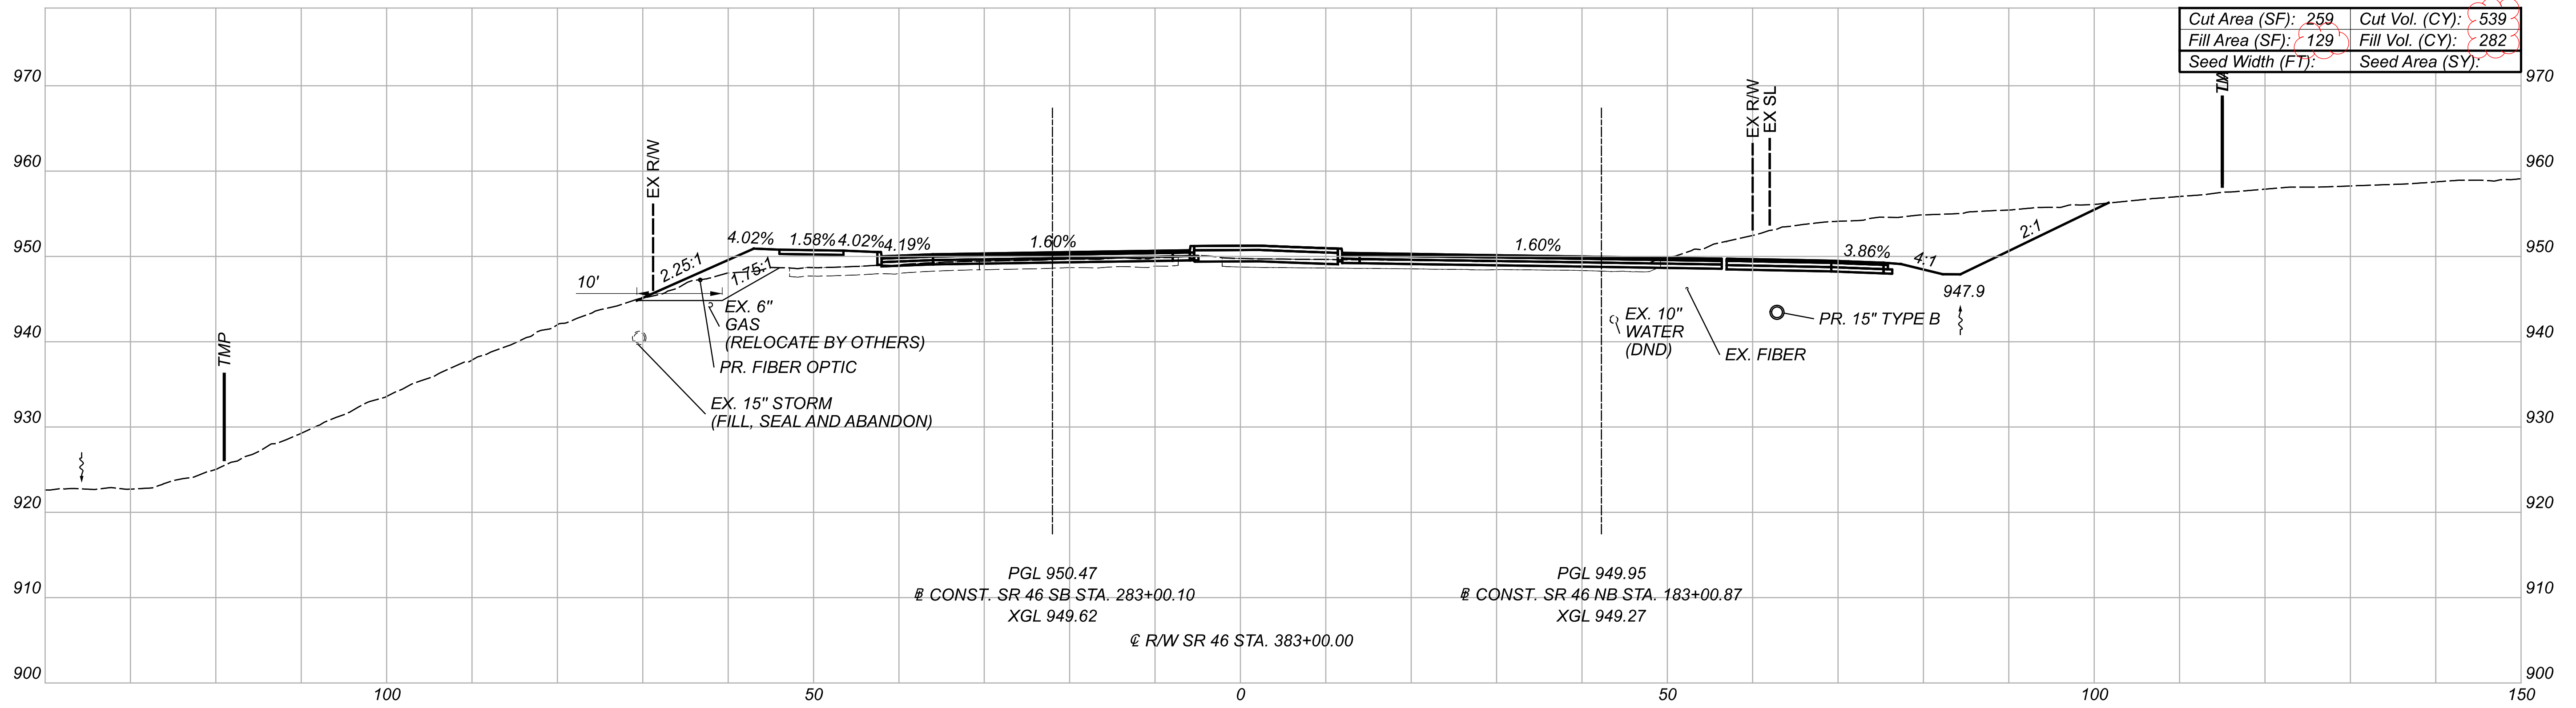

Sheet Totals			SHEET TOTAL	
Seeding	Cut	Fill	374	704
·	1029	618		

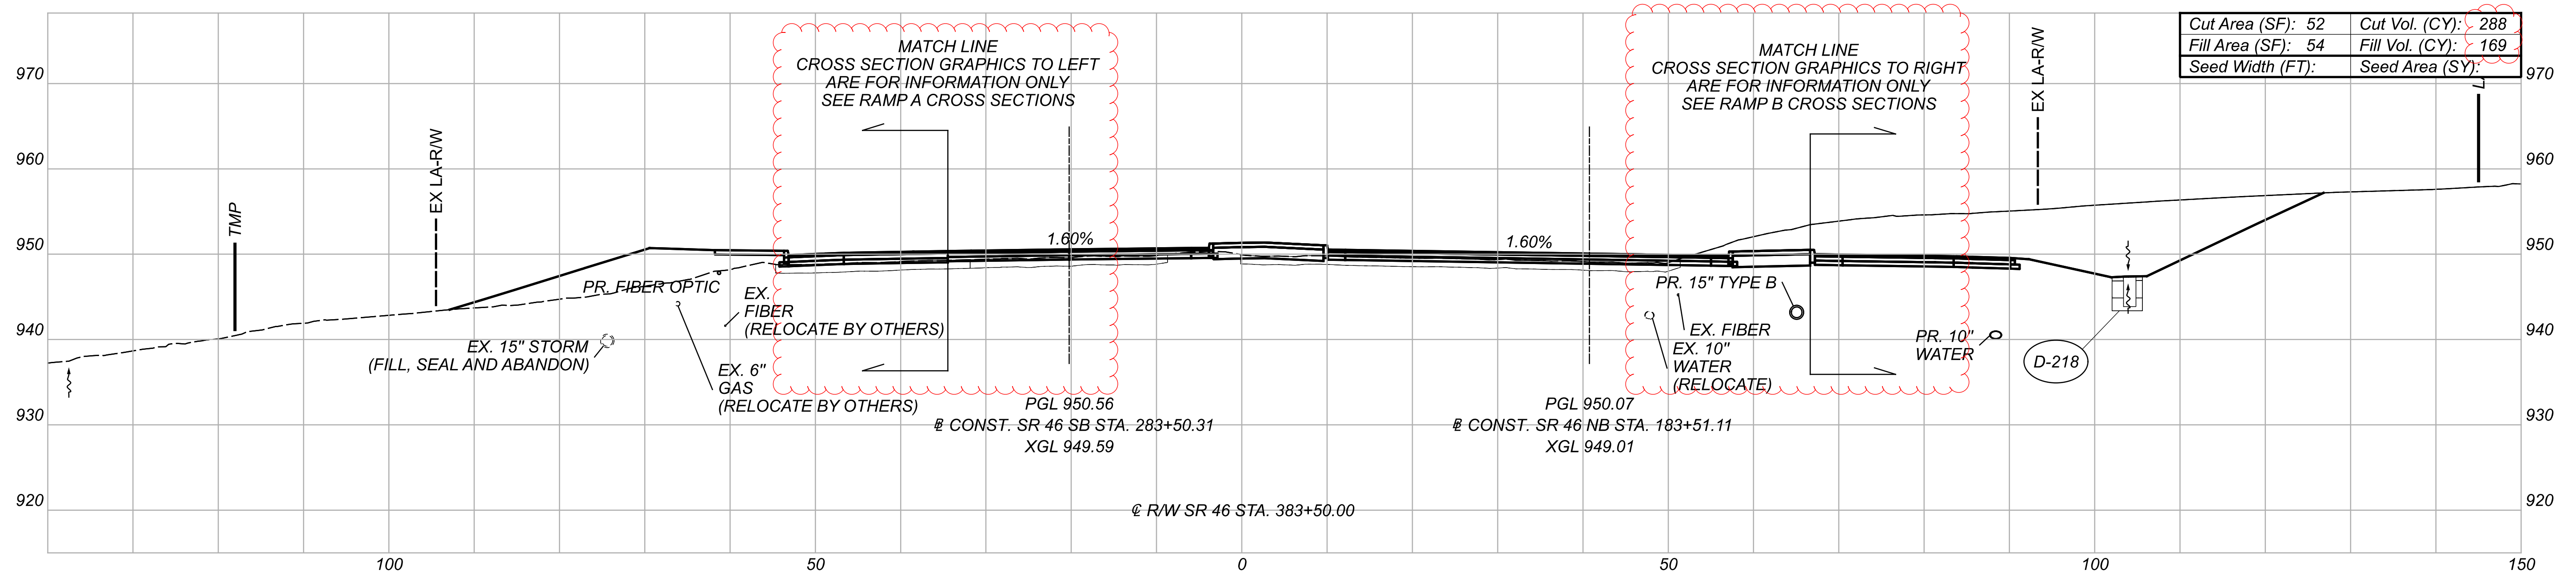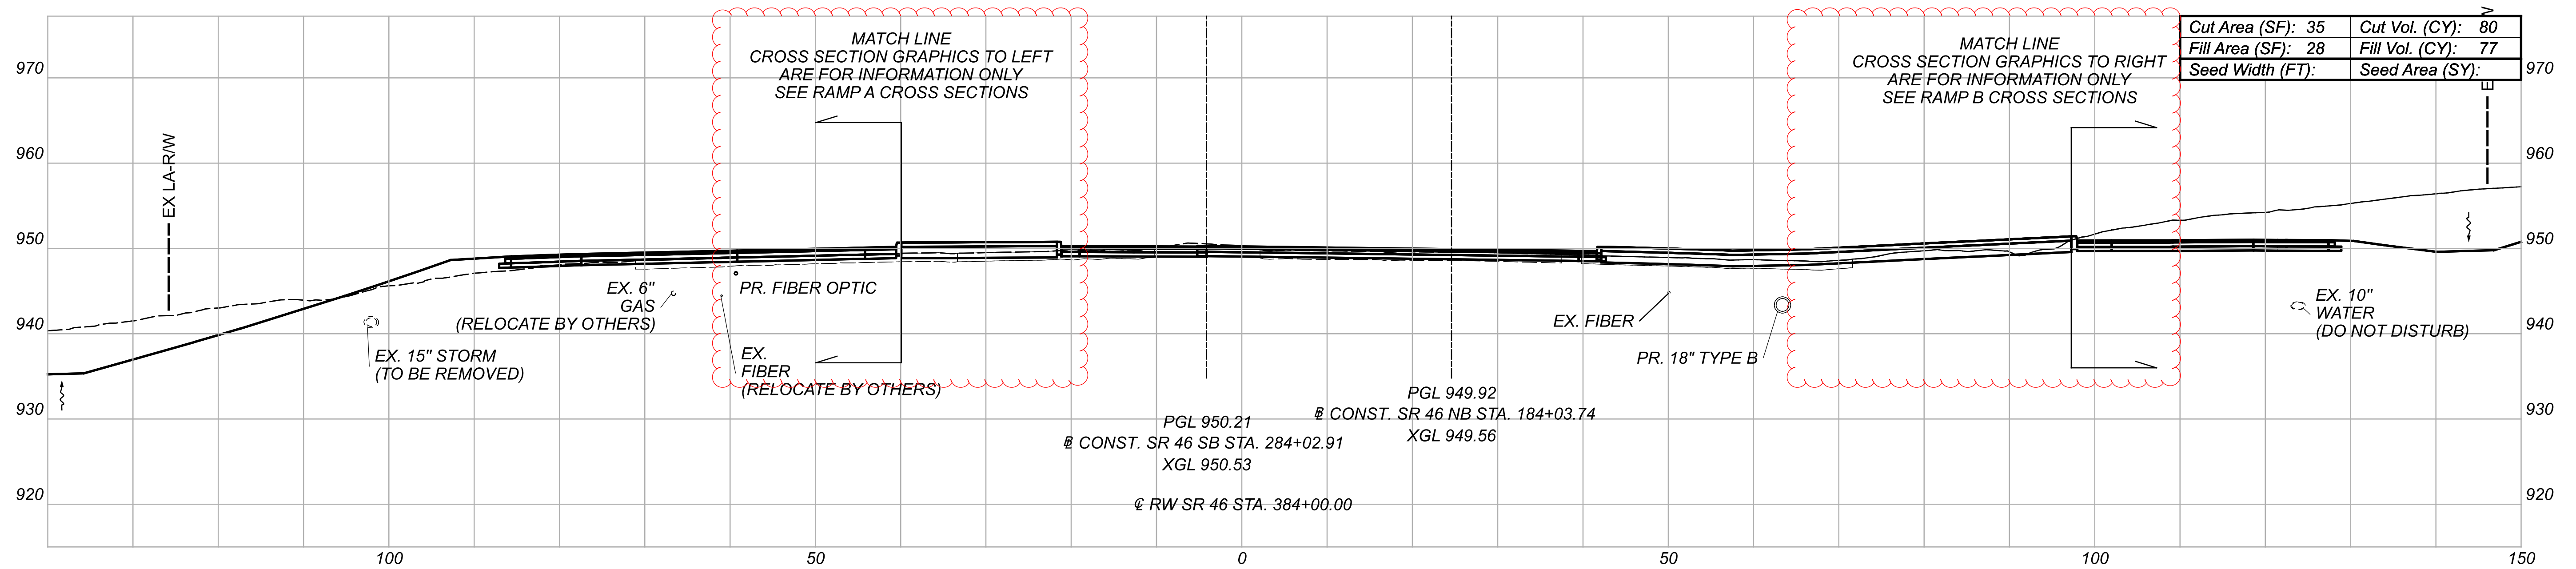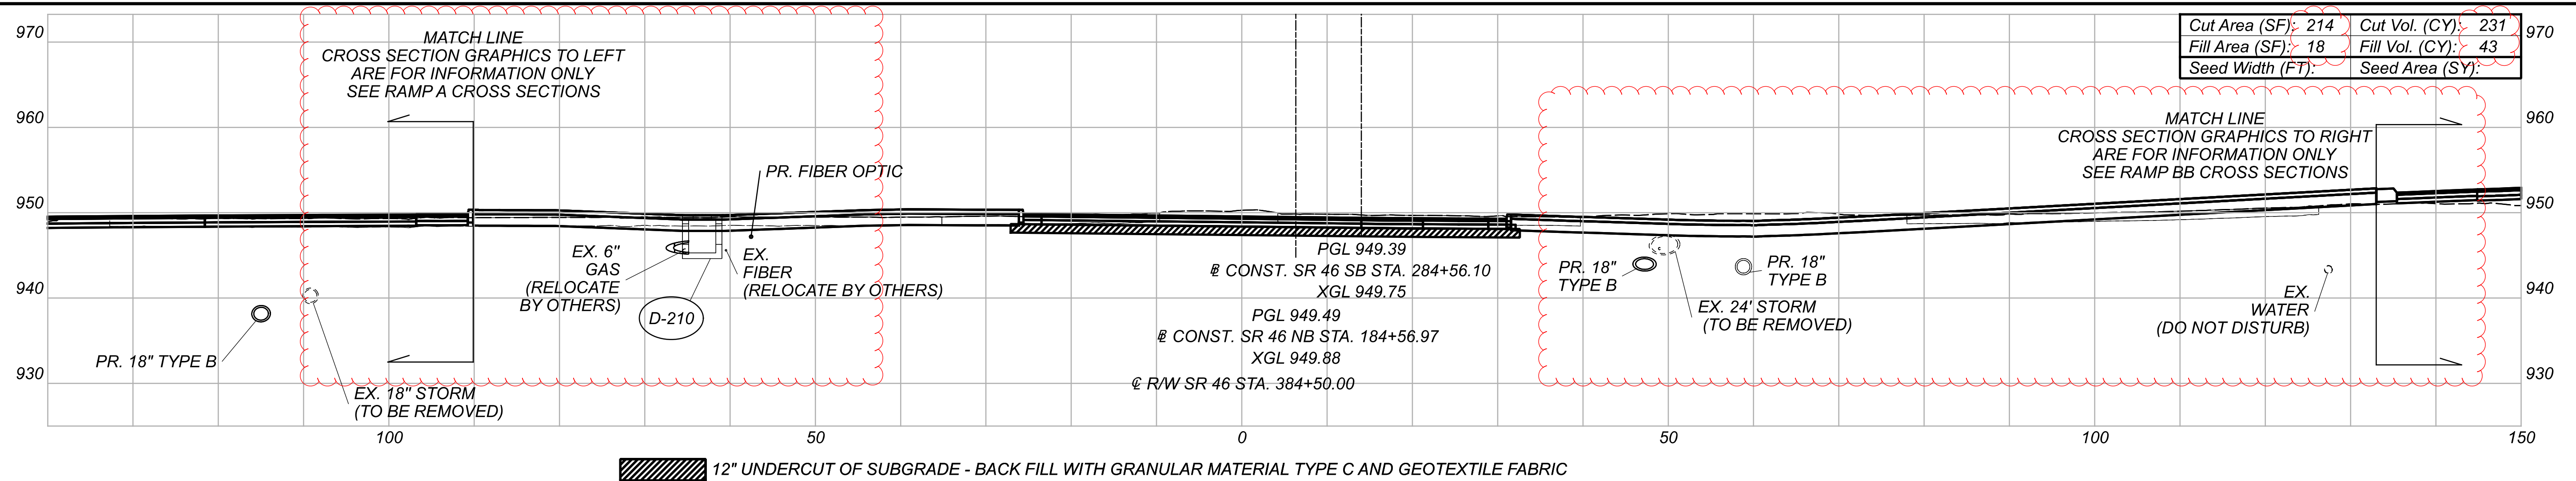

CROSS SECTIONS - CENTERLINE R/W & CONST. SR 46
 STA. 383+50.00 TO STA. 384+50.00

DESIGN AGENCY




DESIGNER
MJL


REVIEWER
JMB 08/19/21

PROJECT ID
108547

Sheet Totals			SHEET TOTAL
Seeding	Cut	Fill	
	599	289	375
			704

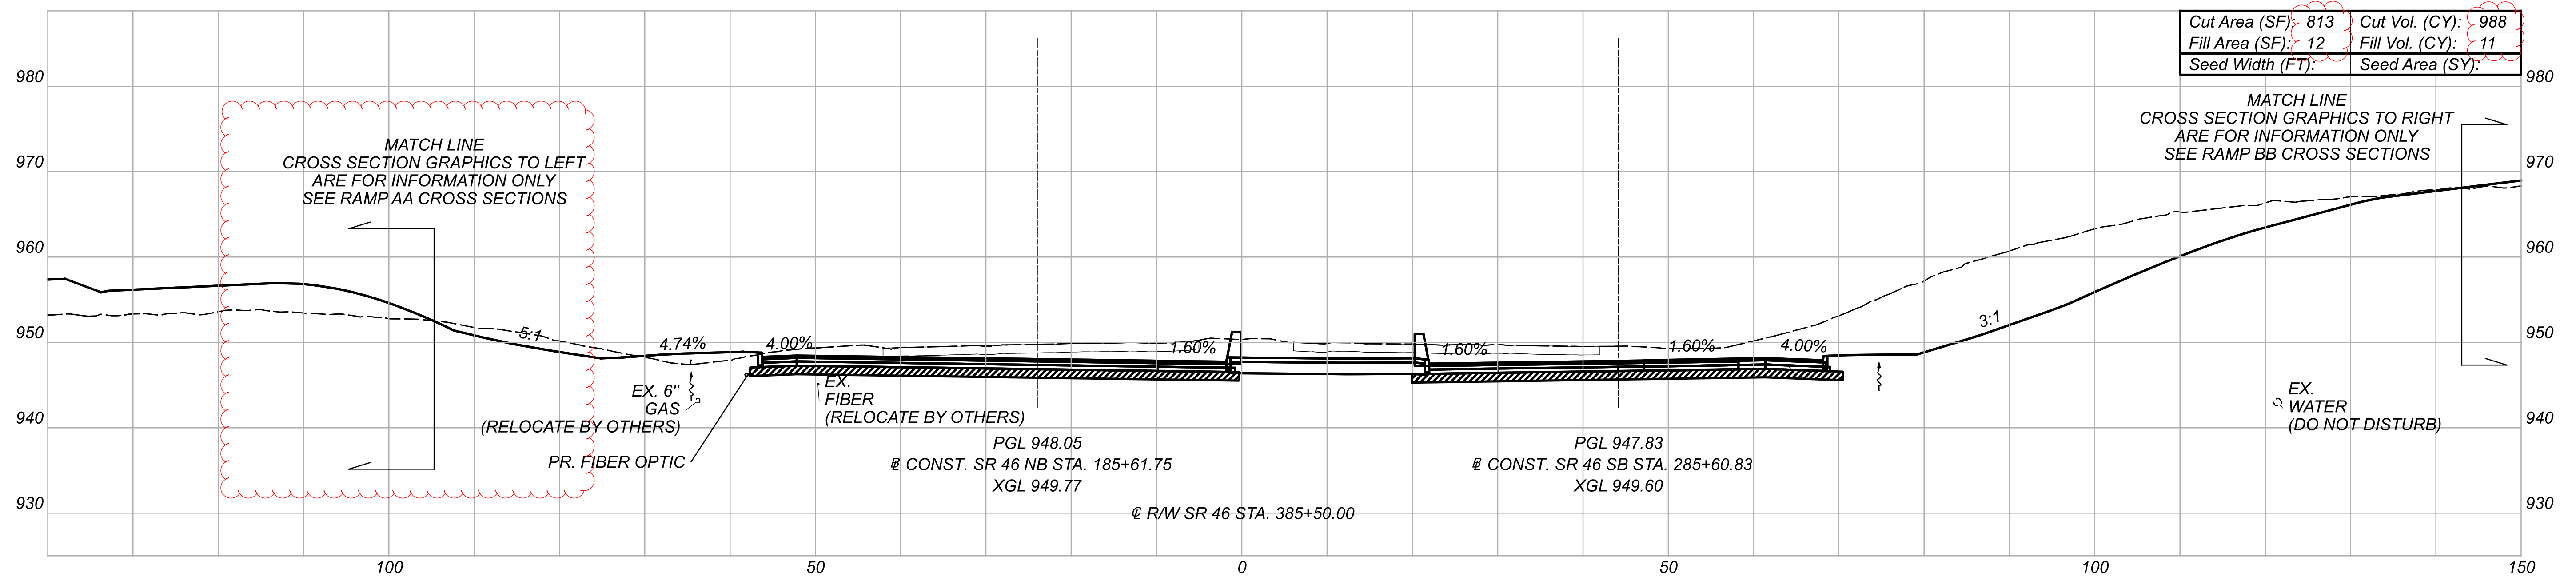

12" UNDERCUT OF SUBGRADE - BACK FILL WITH GRANULAR MATERIAL TYPE C AND GEOTEXTILE FABRIC

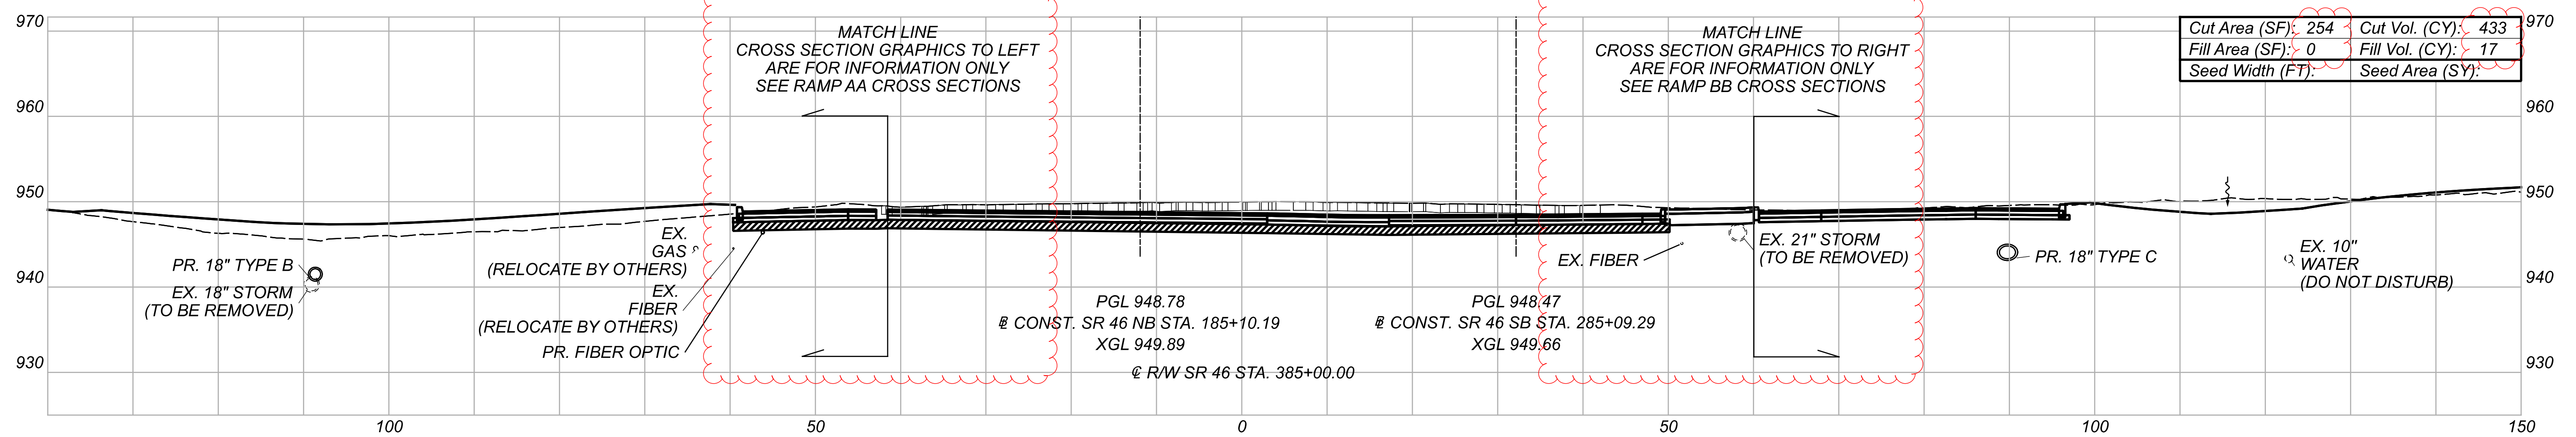

12" UNDERCUT OF SUBGRADE - BACK FILL WITH GRANULAR MATERIAL TYPE C AND GEOTEXTILE FABRIC

CROSS SECTIONS - CENTERLINE R/W & CONST. SR 46
STA. 385+00.00 TO STA. 385+50.00

DESIGN AGENCY





DESIGNER
MJL

REVIEWER
JMB 08/19/21


PROJECT ID
108547




Sheet Totals			SHEET	TOTAL
Seeding	Cut	Fill		
•	1421	28	376	704

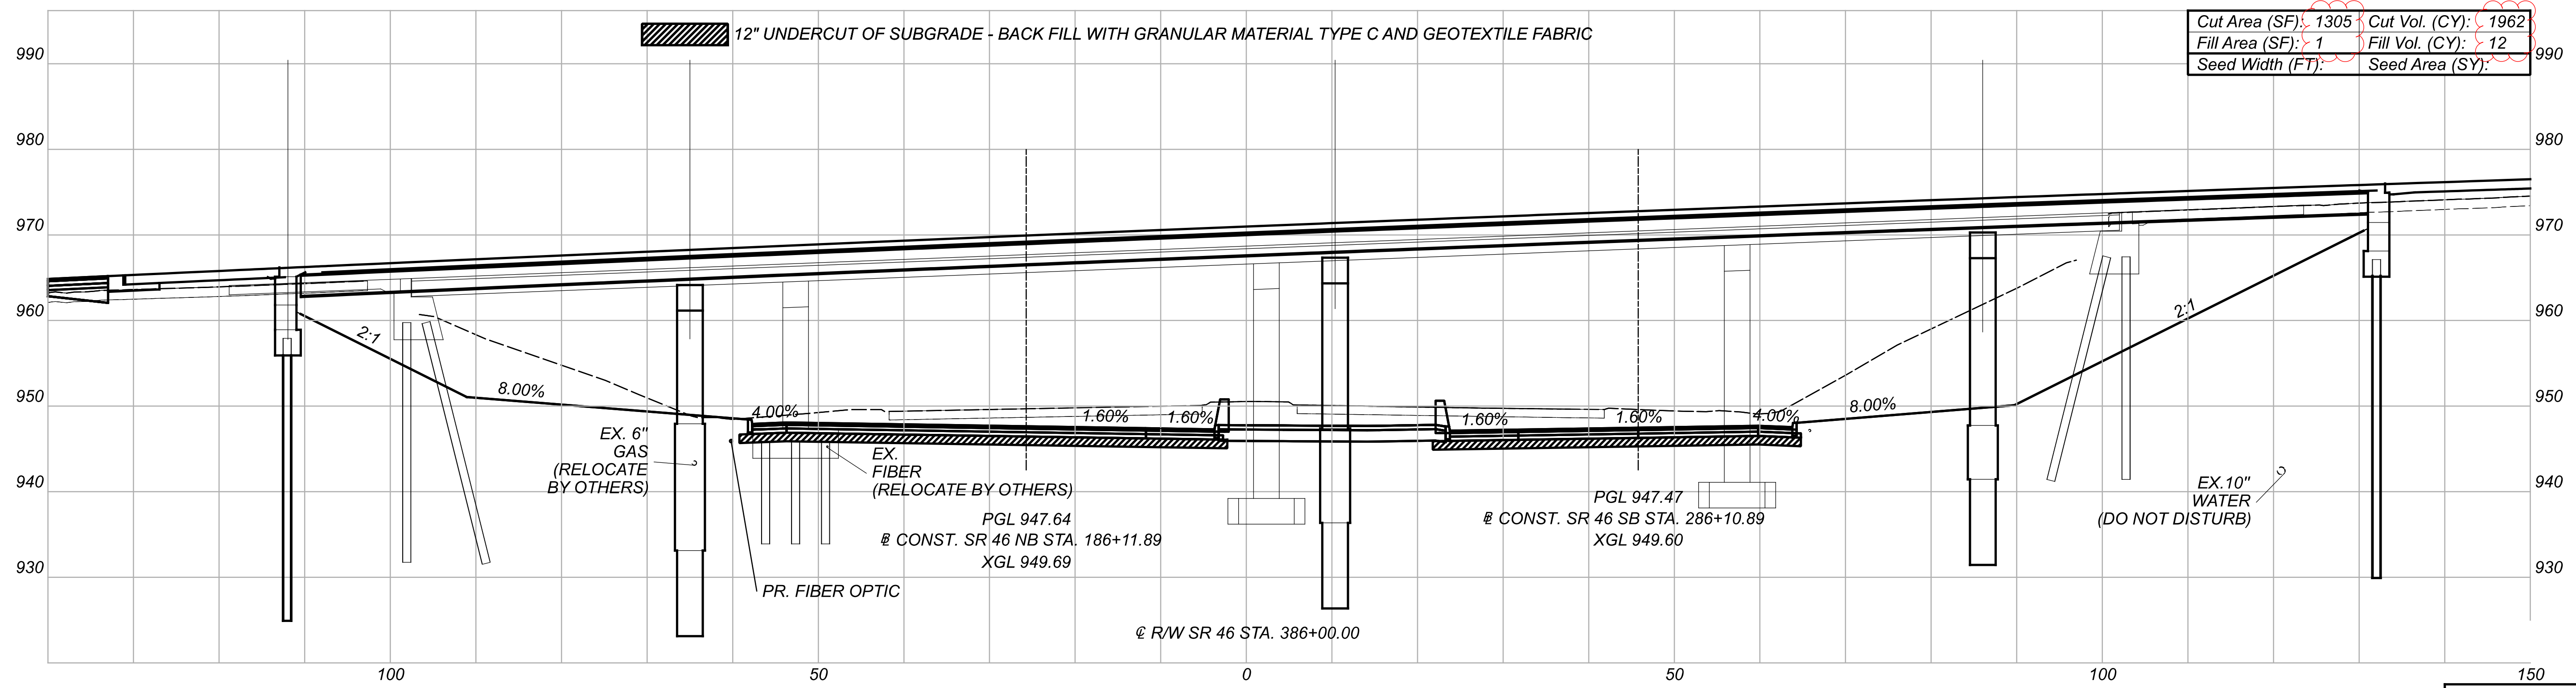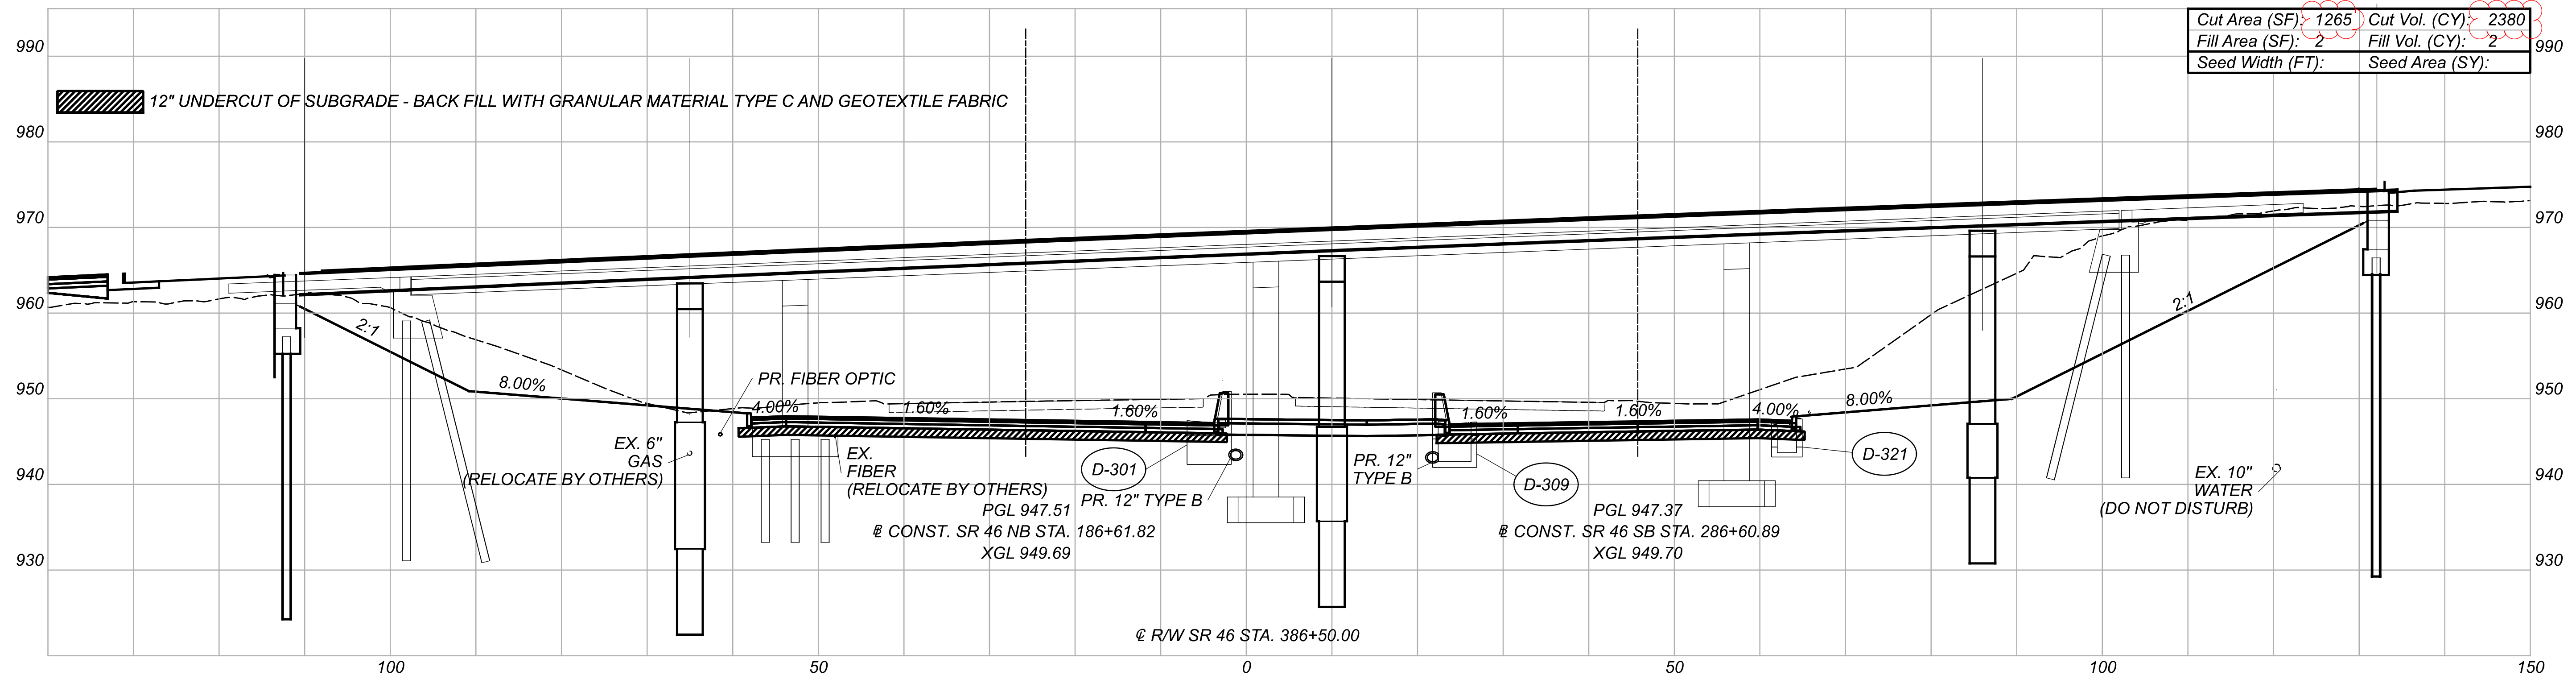

Sheet Totals			SHEET	TOTAL
Seeding	Cut	Fill		
·	4342	14	377	704

CROSS SECTIONS - CENTERLINE R/W & CONST. SR 46
 STA. 386+00.00 TO STA. 386+50.00



DESIGN AGENCY

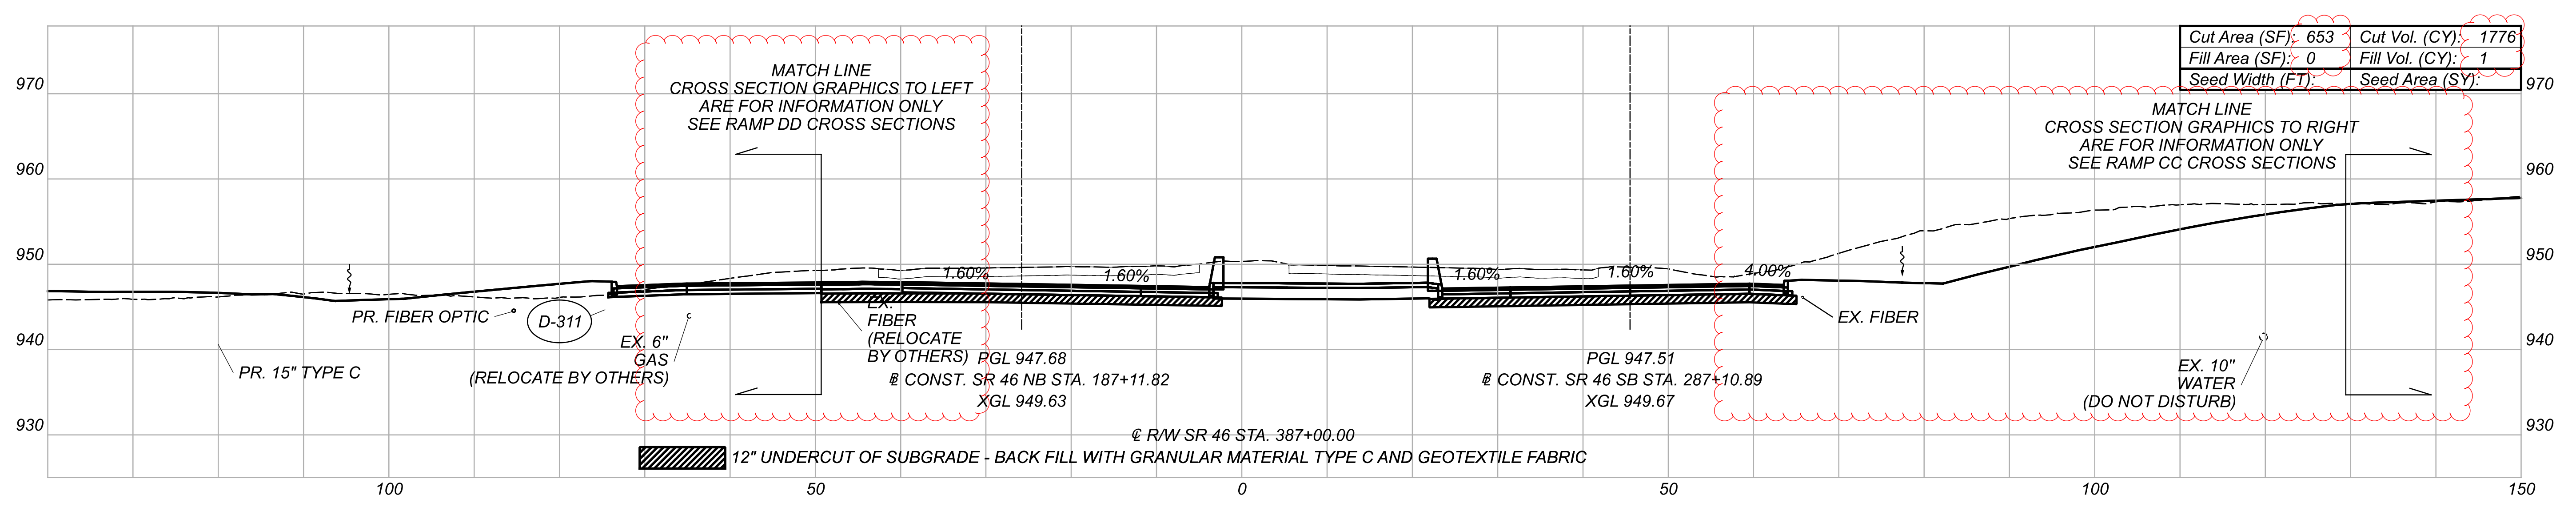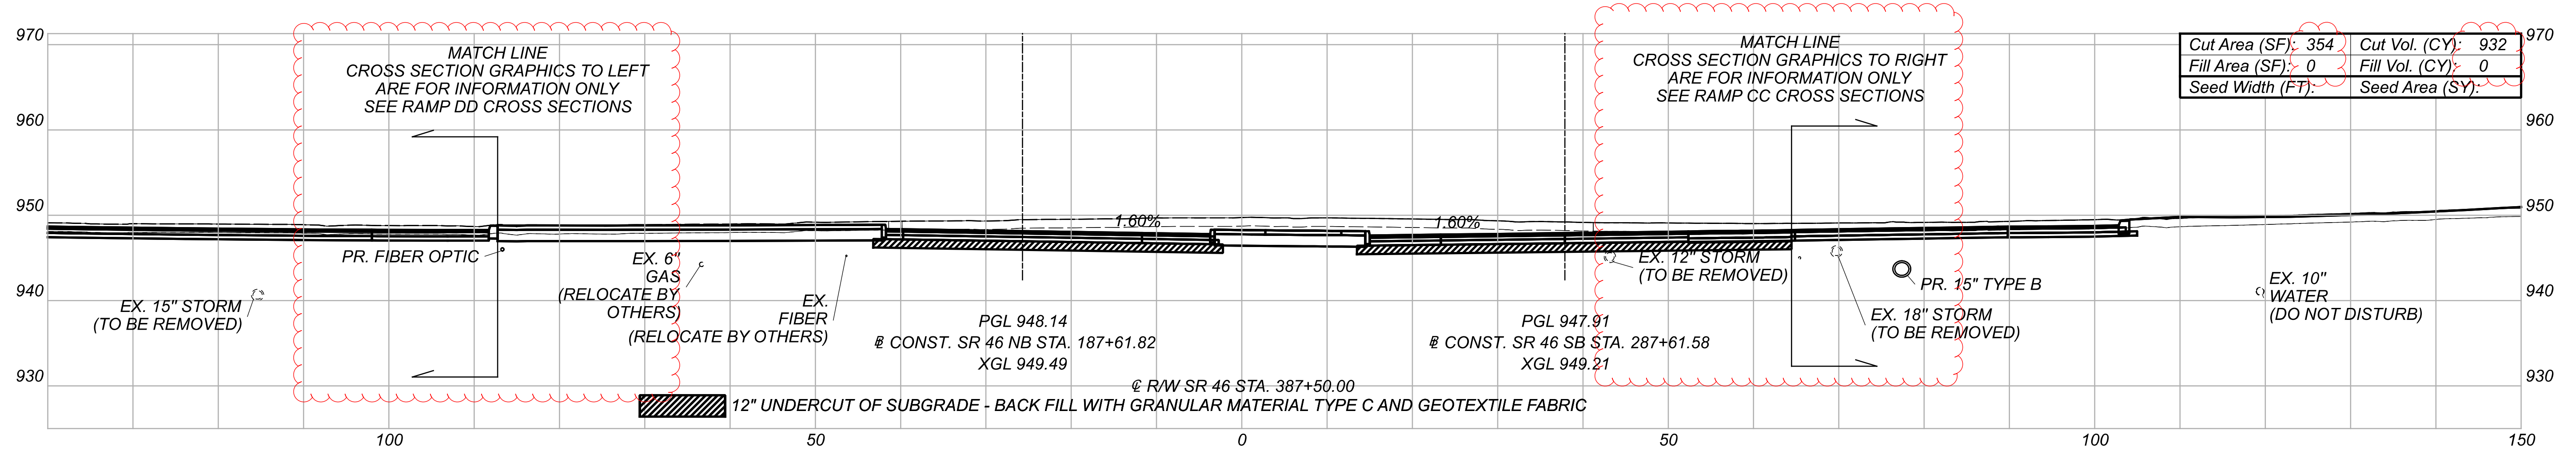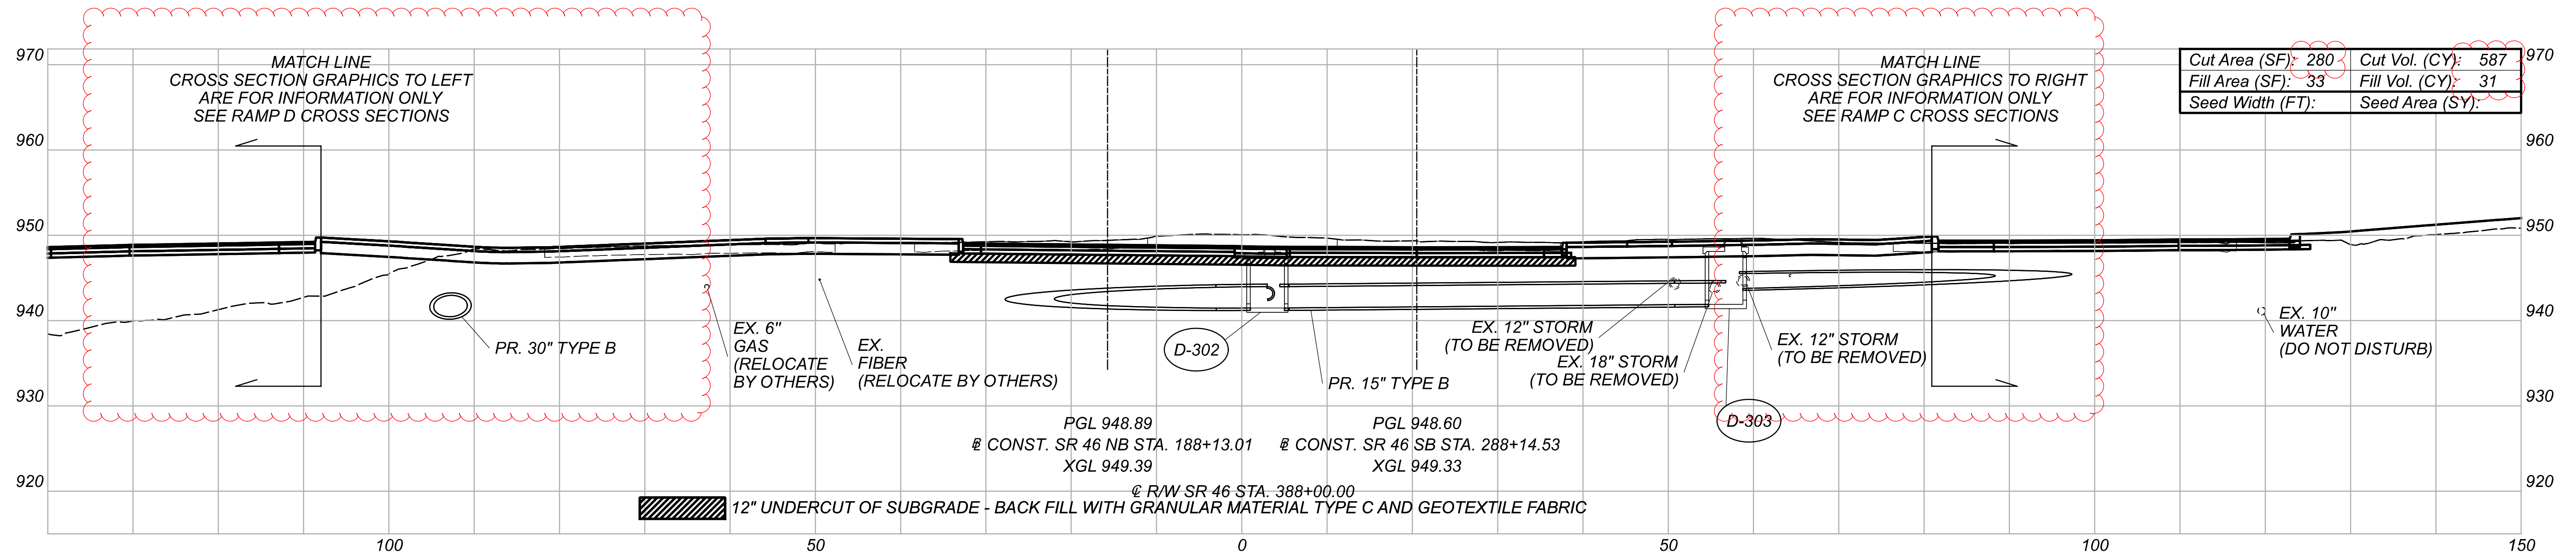 DESIGNER
 MJL
 REVIEWER
 JMB 08/19/21
 PROJECT ID
 108547



Sheet Totals			108547
Seeding	Cut	Fill	SHEET TOTAL
•	3295	32	378 704

CROSS SECTIONS - CENTERLINE R/W & CONST. SR 46
STA. 387+00.00 TO STA. 388+00.00

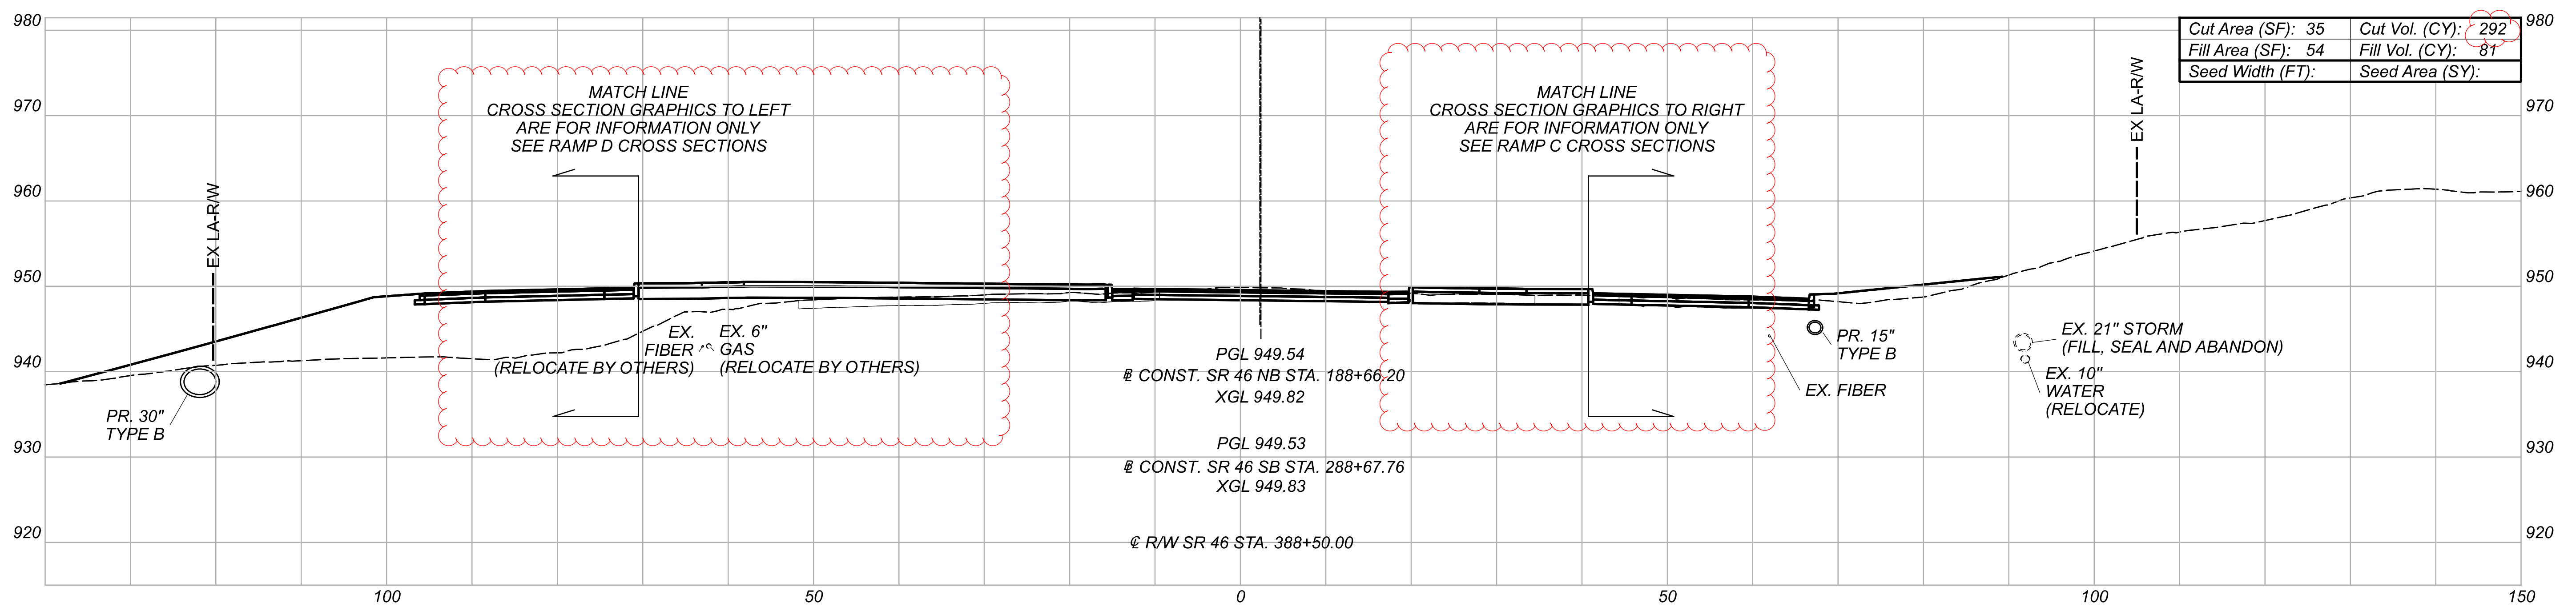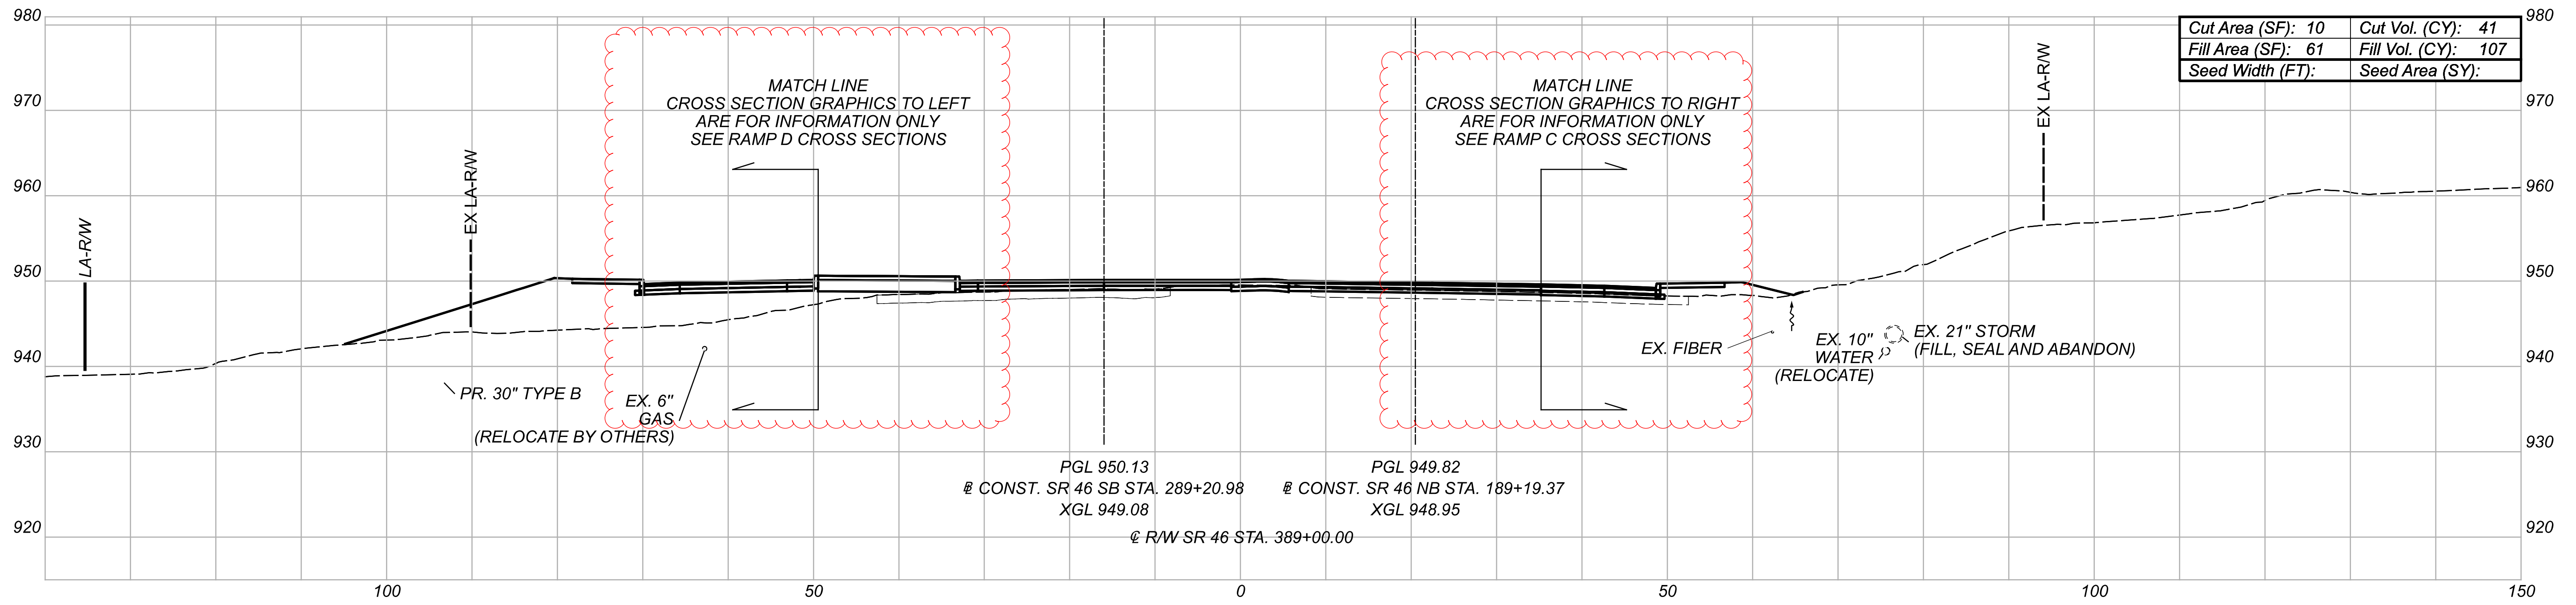DESIGN AGENCY
HR
DESIGNER
MJL
REVIEWER
JMB 08/19/21
PROJECT ID
108547



CROSS SECTIONS - CENTERLINE R/W & CONST. SR 46
 STA. 388+50.00 TO STA. 389+00.00

DESIGN AGENCY




DESIGNER
MJJ


REVIEWER
JMB 08/19/21

PROJECT ID
108547

Sheet Totals			SHEET TOTAL	
Seeding	Cut	Fill	SHEET	TOTAL
.	333	187	379	704

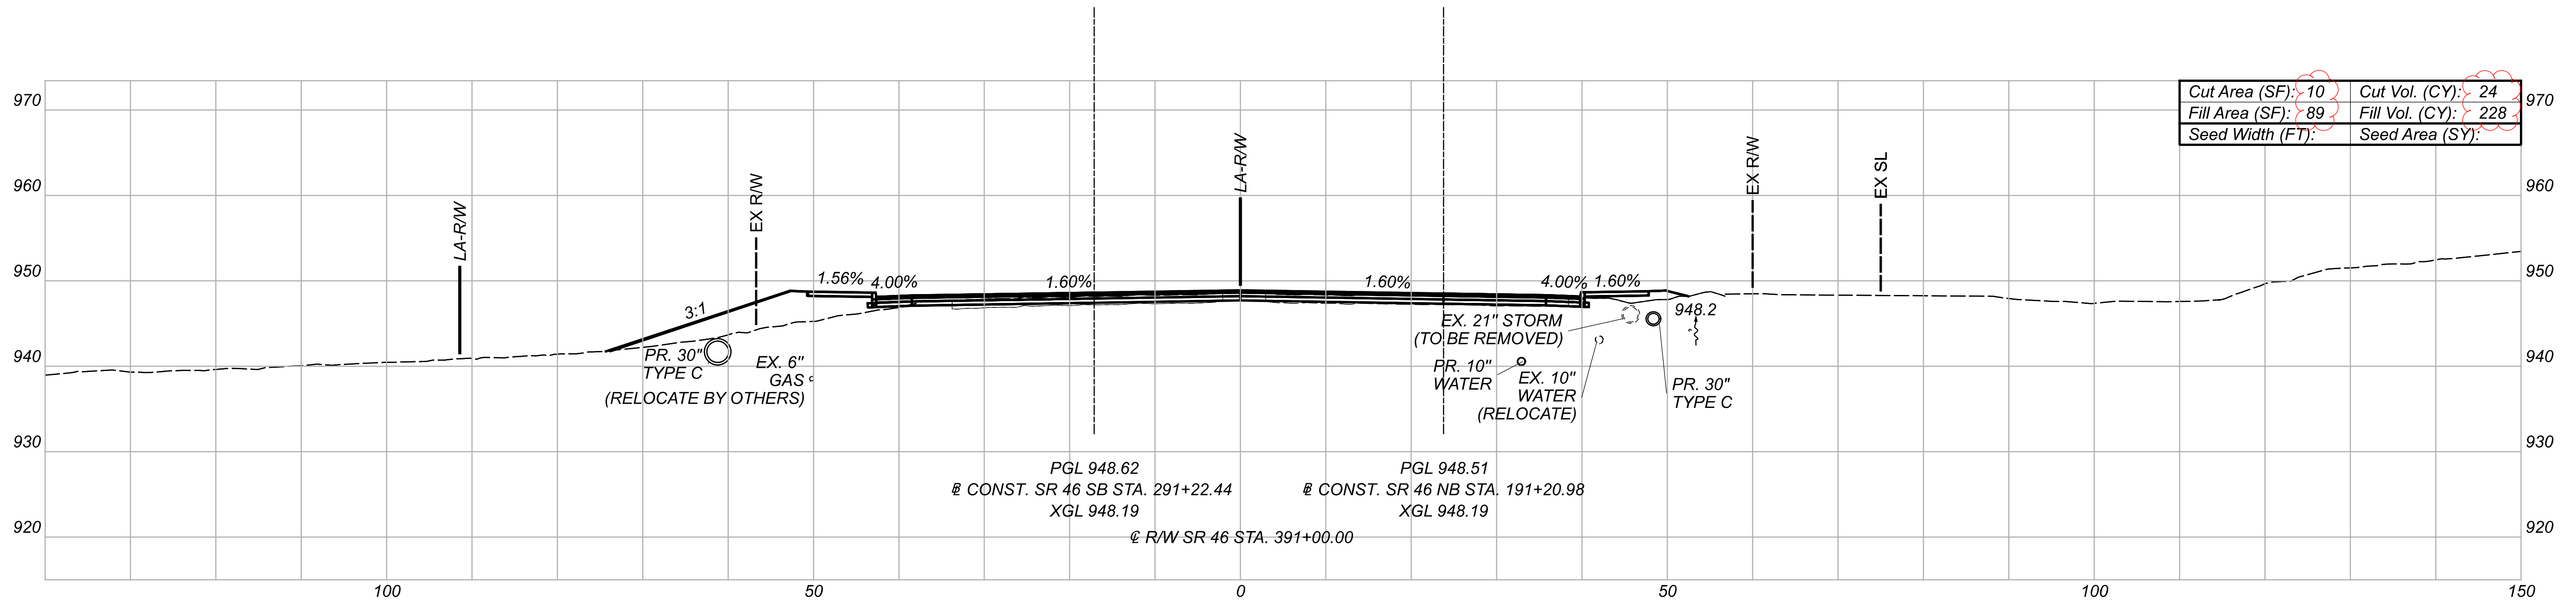

Cut Area (SF): 10	Cut Vol. (CY): 24
Fill Area (SF): 89	Fill Vol. (CY): 228
Seed Width (FT):	Seed Area (SY):

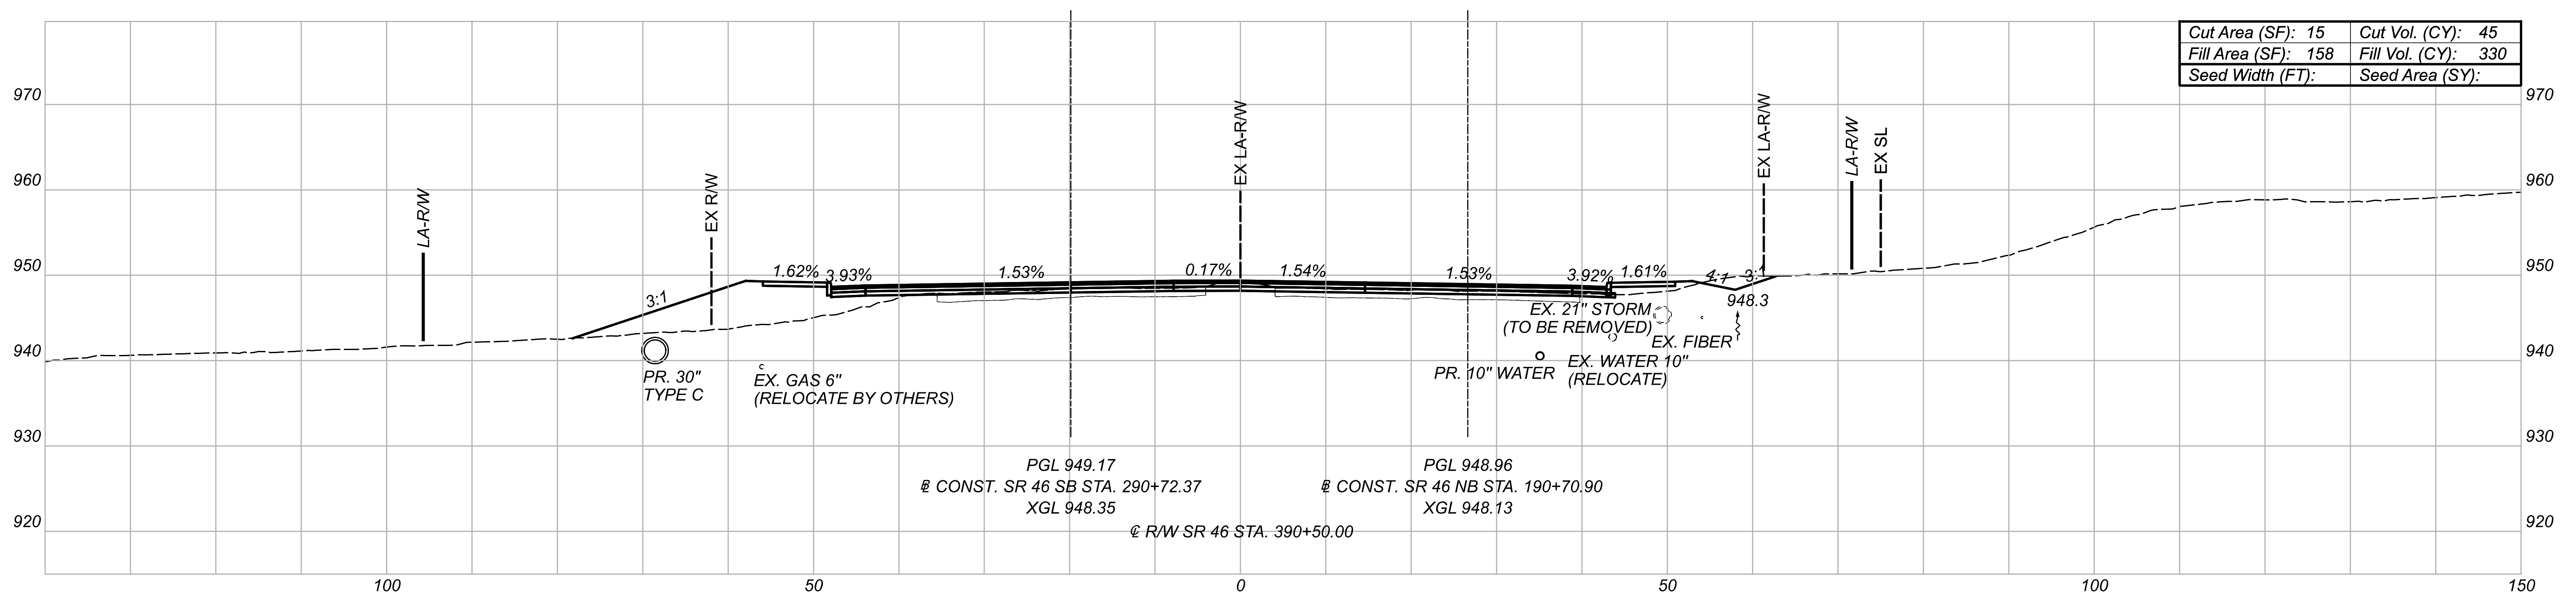

Cut Area (SF): 15	Cut Vol. (CY): 45
Fill Area (SF): 158	Fill Vol. (CY): 330
Seed Width (FT):	Seed Area (SY):

Sheet Totals			SHEET TOTAL	
Seeding	Cut	Fill	SHEET	TOTAL
·	69	558	381	704

CROSS SECTIONS - CENTERLINE R/W & CONST. SR 46
 STA. 390+50.00 TO STA. 391+00.00



DESIGN AGENCY



DESIGNER
MJL

REVIEWER
JMB 08/19/21

PROJECT ID
108547

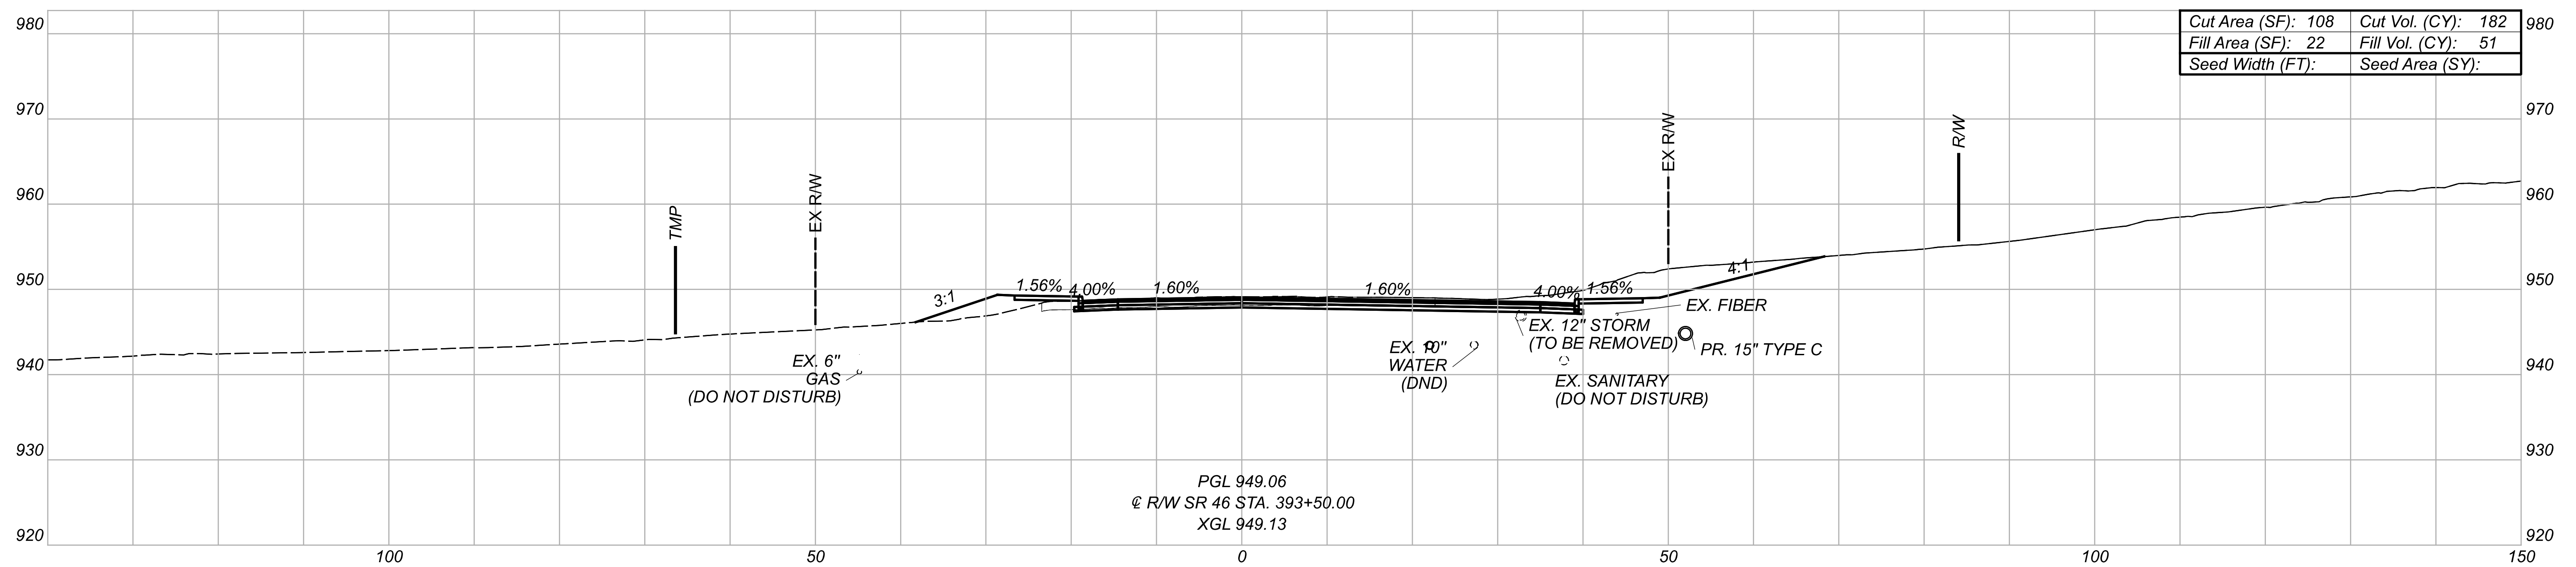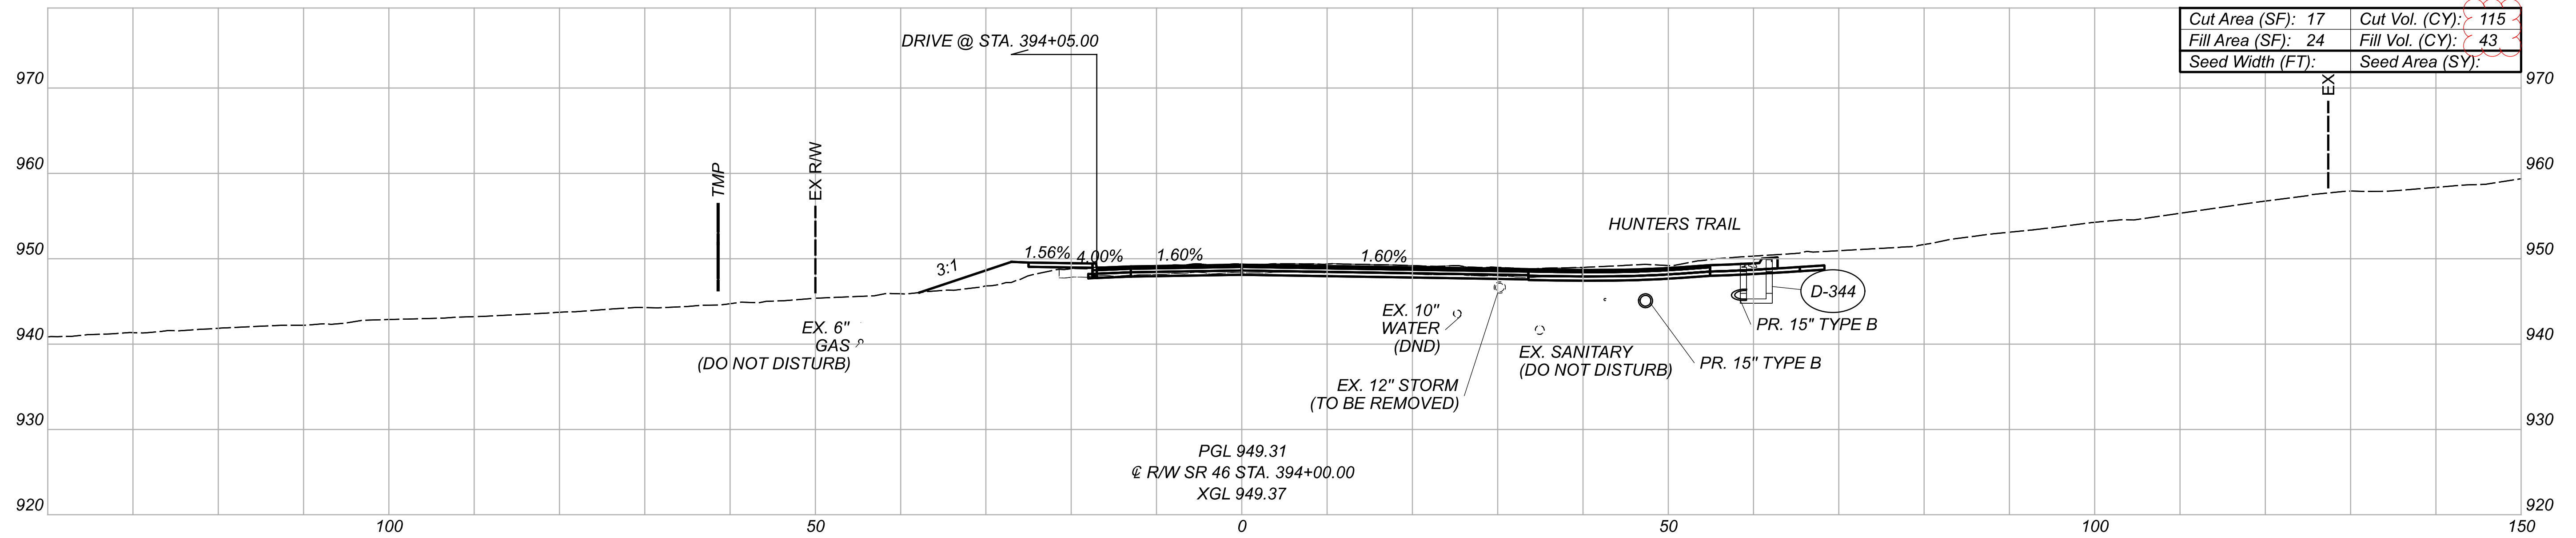

CROSS SECTIONS - CENTERLINE R/W & CONST. SR 46
STA. 393+50.00 TO STA. 394+00.00

DESIGN AGENCY





DESIGNER
MJL


REVIEWER
JMB 08/19/21

PROJECT ID
108547



Sheet Totals			TOTAL	
Seeding	Cut	Fill	SHEET	TOTAL
.	297	94	384	704

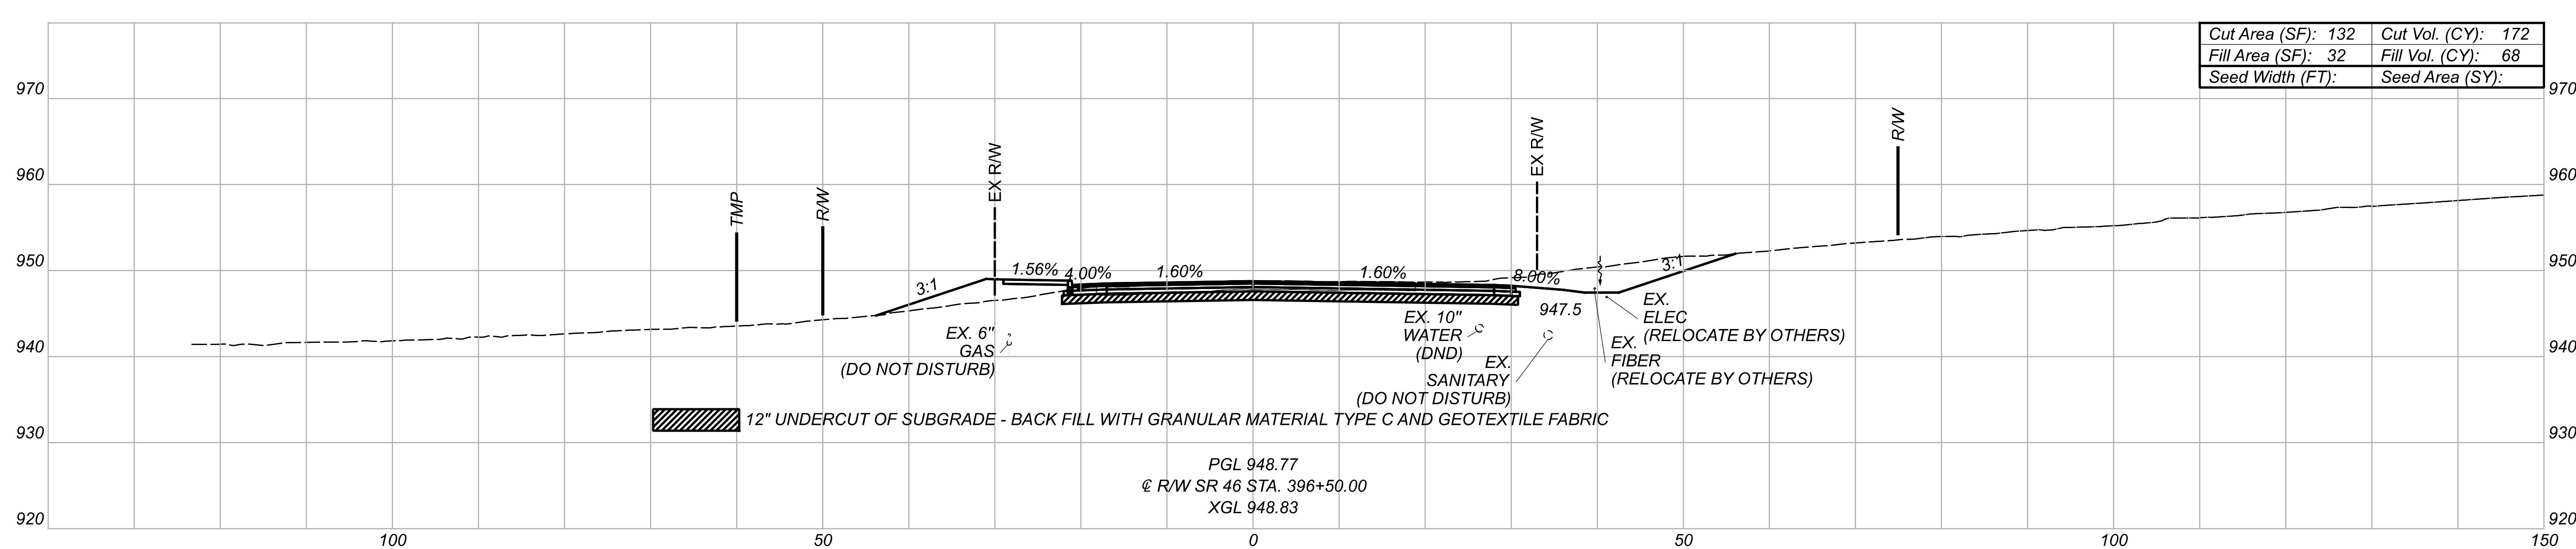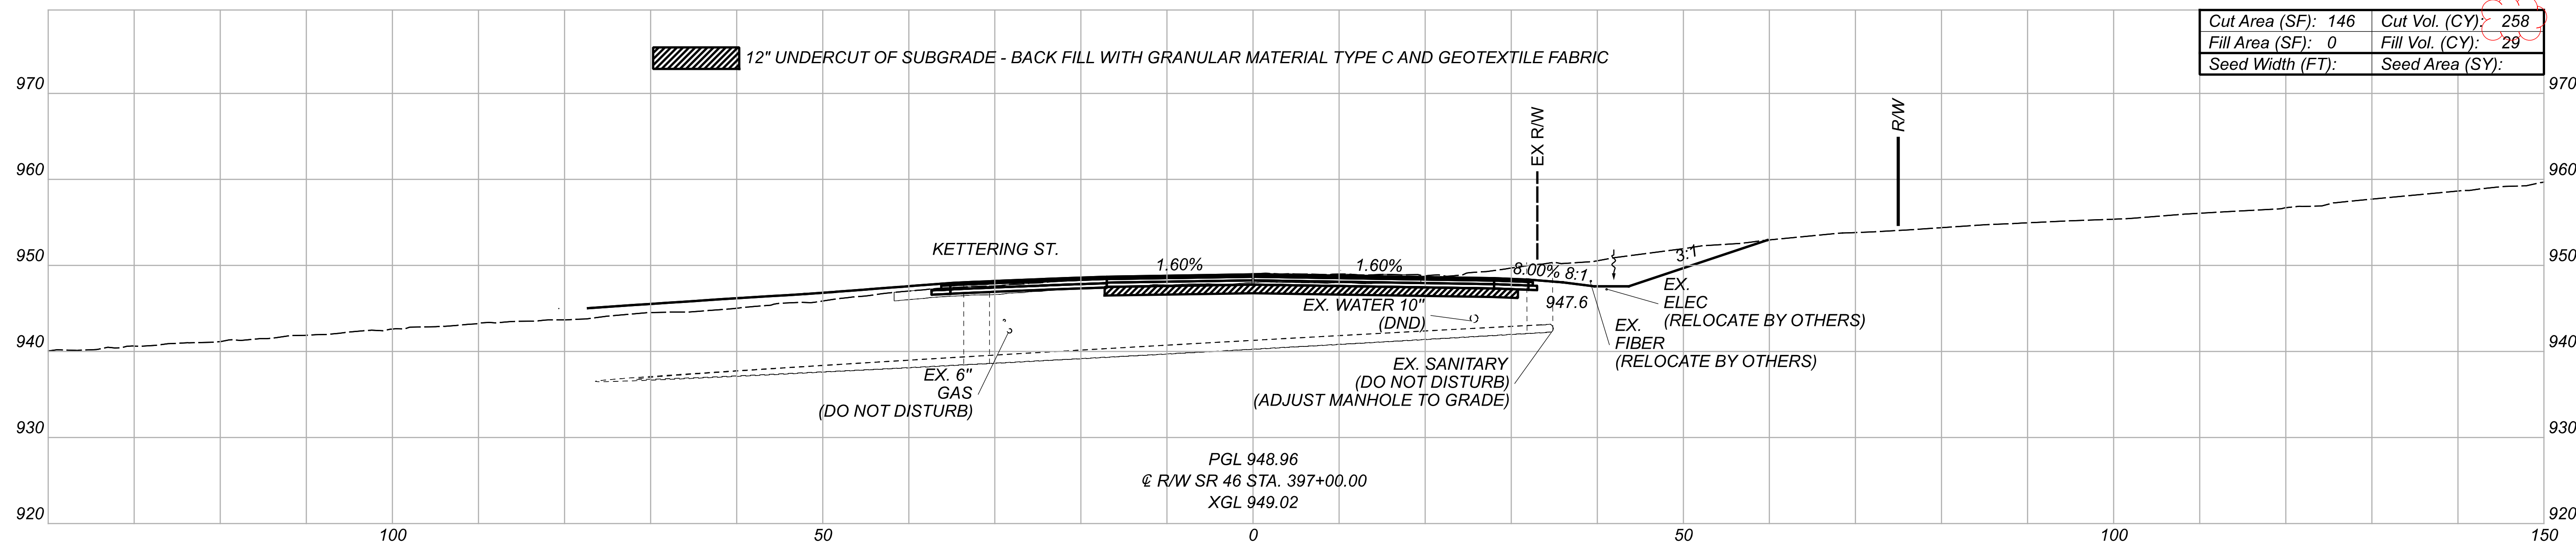

CROSS SECTIONS - CENTERLINE R/W & CONST. SR 46
 STA. 396+50.00 TO STA. 397+00.00

DESIGN AGENCY

 DESIGNER
 MJL
 REVIEWER
 JMB 08/19/21
 PROJECT ID
 108547

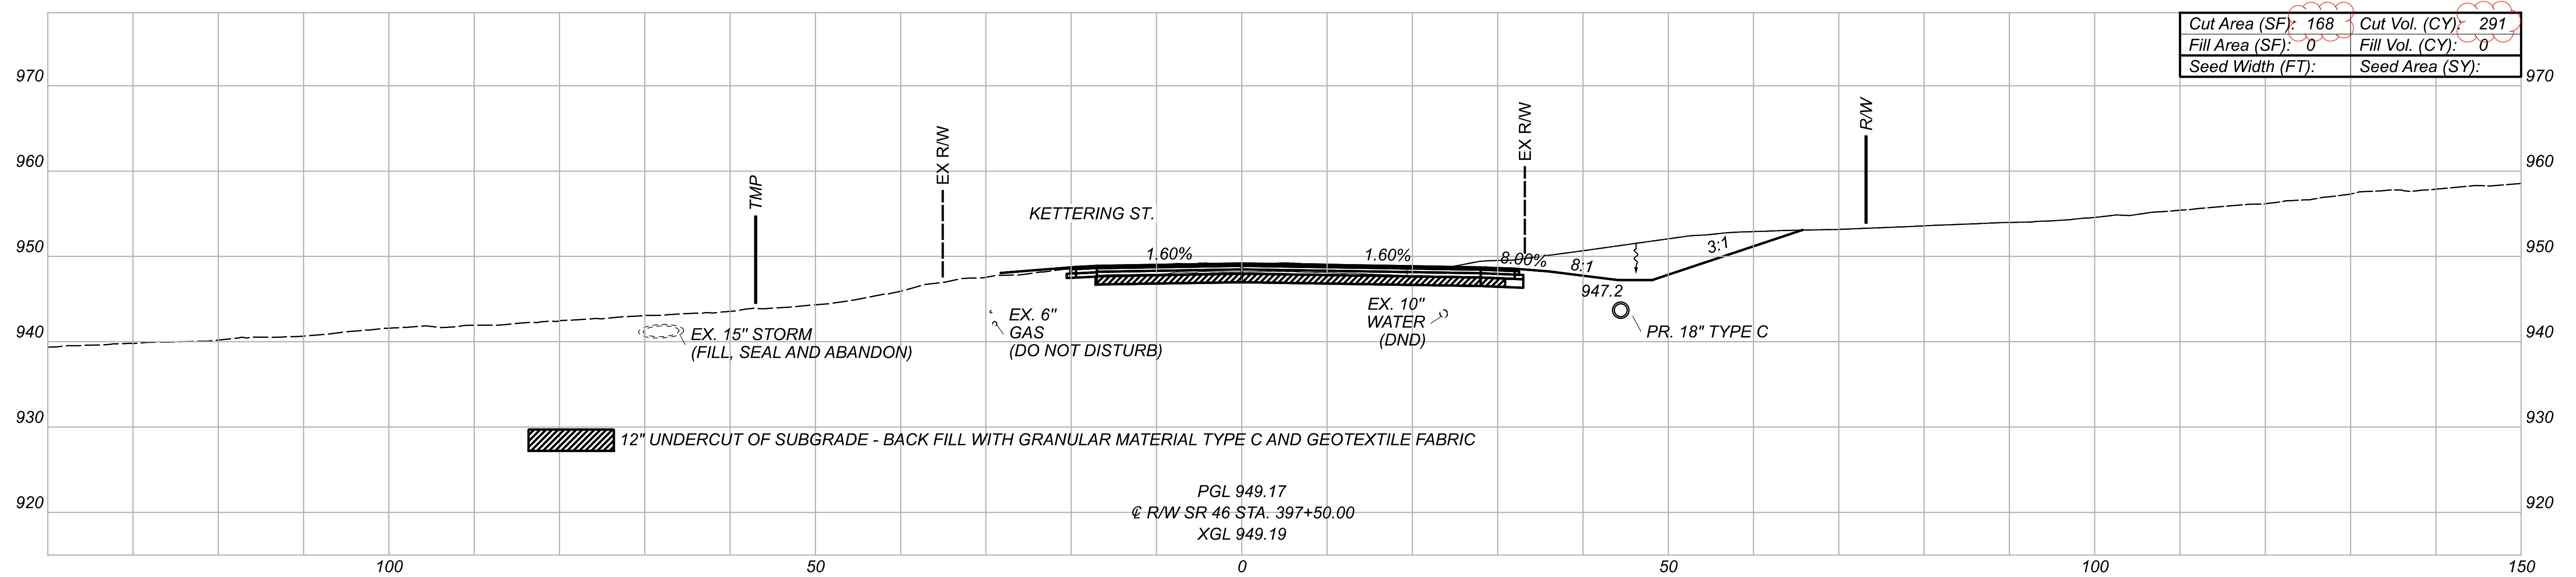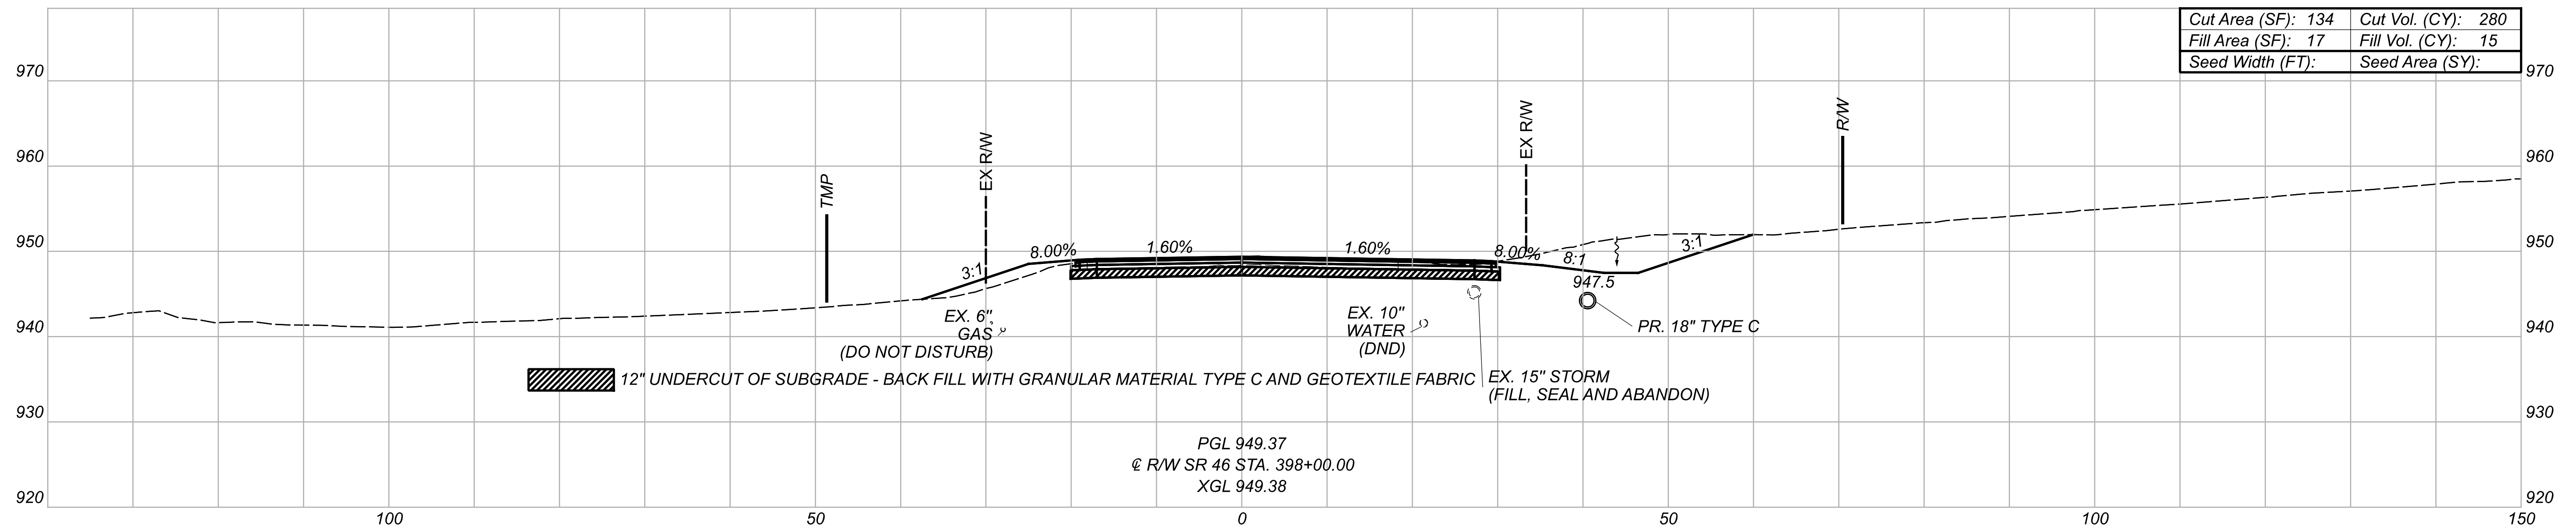Sheet Totals			SHEET TOTAL	
Seeding	Cut	Fill	SHEET	TOTAL
.	430	98	387	704



CROSS SECTIONS - CENTERLINE R/W & CONST. SR 46
 STA. 397+50.00 TO STA. 398+00.00

DESIGN AGENCY



DESIGNER

MJL



REVIEWER

JMB 08/19/21

PROJECT ID


108547



Sheet Totals			SHEET	TOTAL
Seeding	Cut	Fill		
•	571	15	388	704

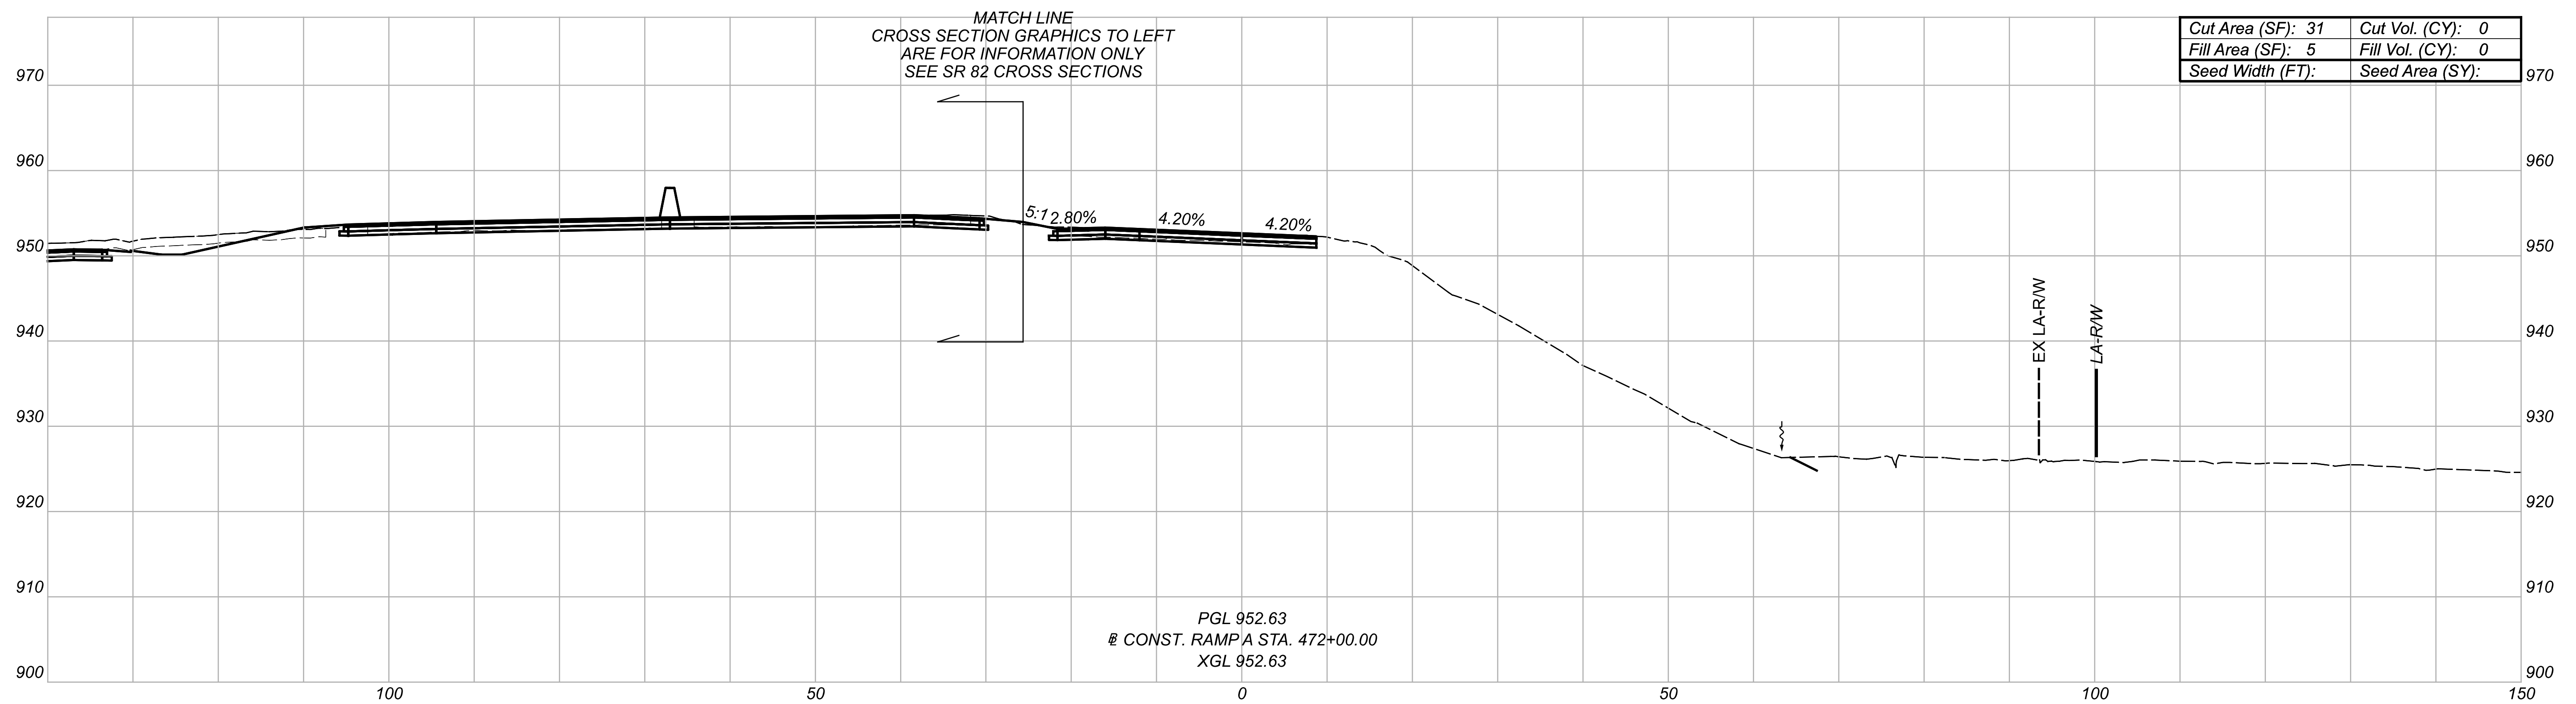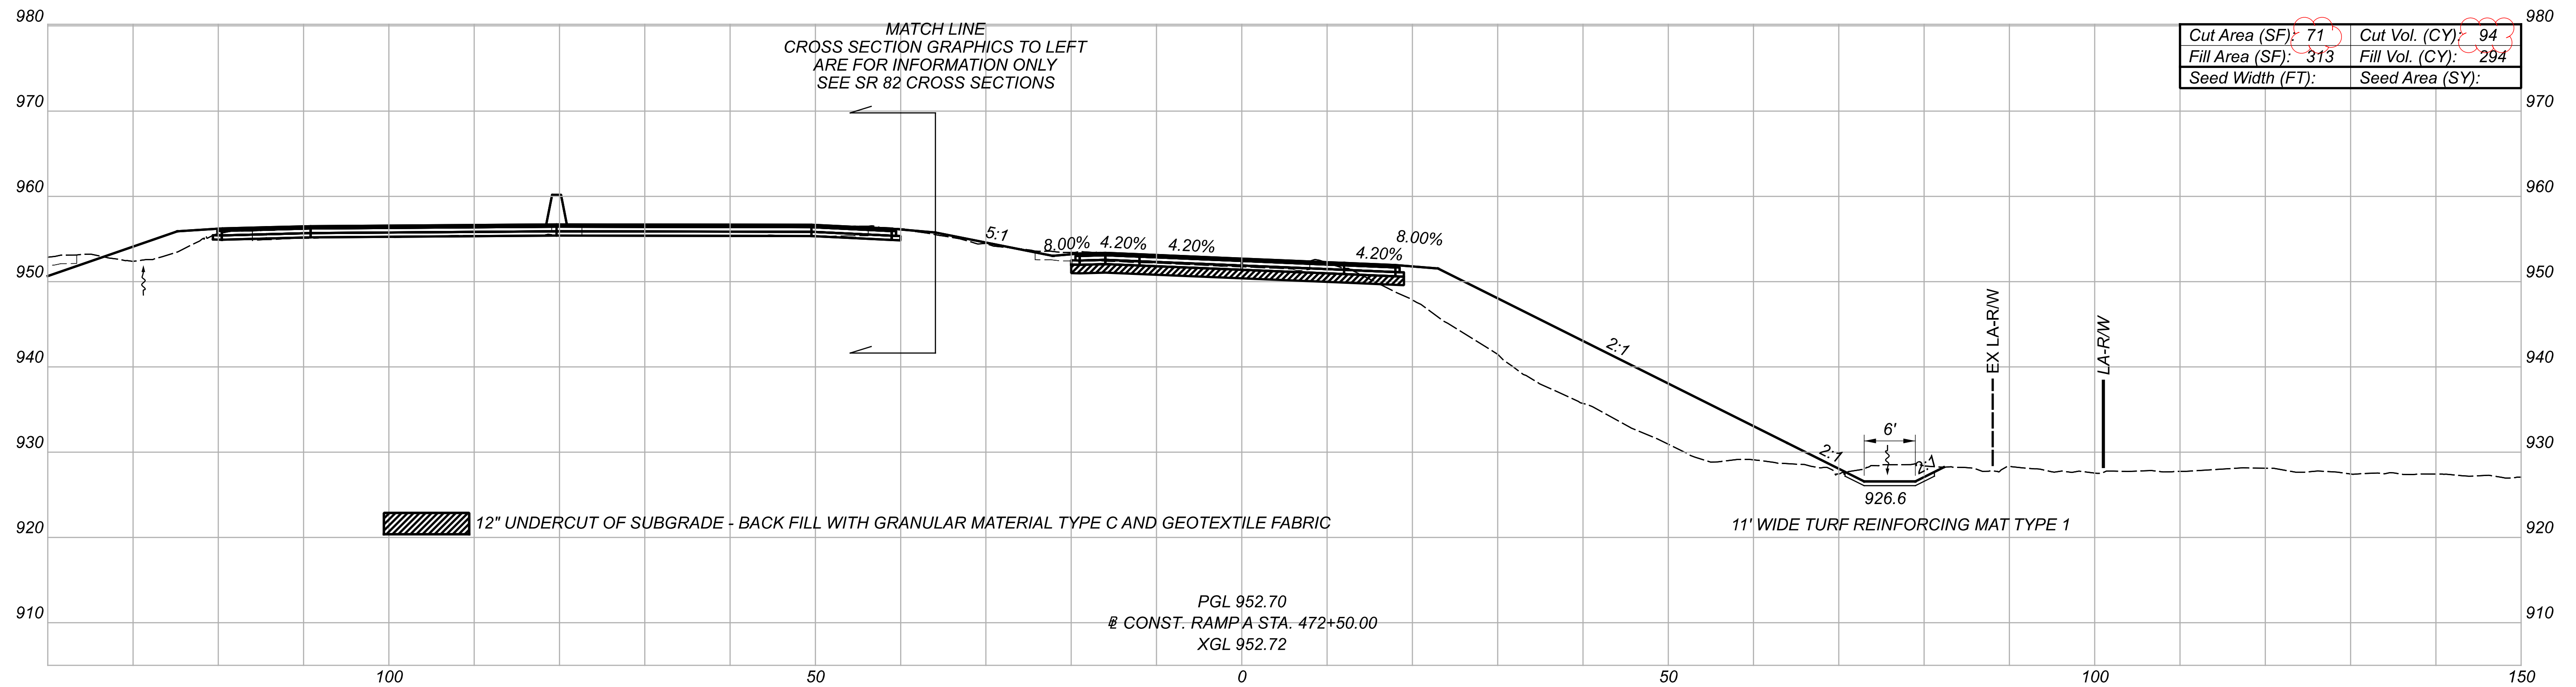

Sheet Totals		
Seeding	Cut	Fill
.	94	294

CROSS SECTIONS - BASELINE CONST. RAMP A
 STA. 472+00.00 TO STA. 472+50.00

DESIGN AGENCY

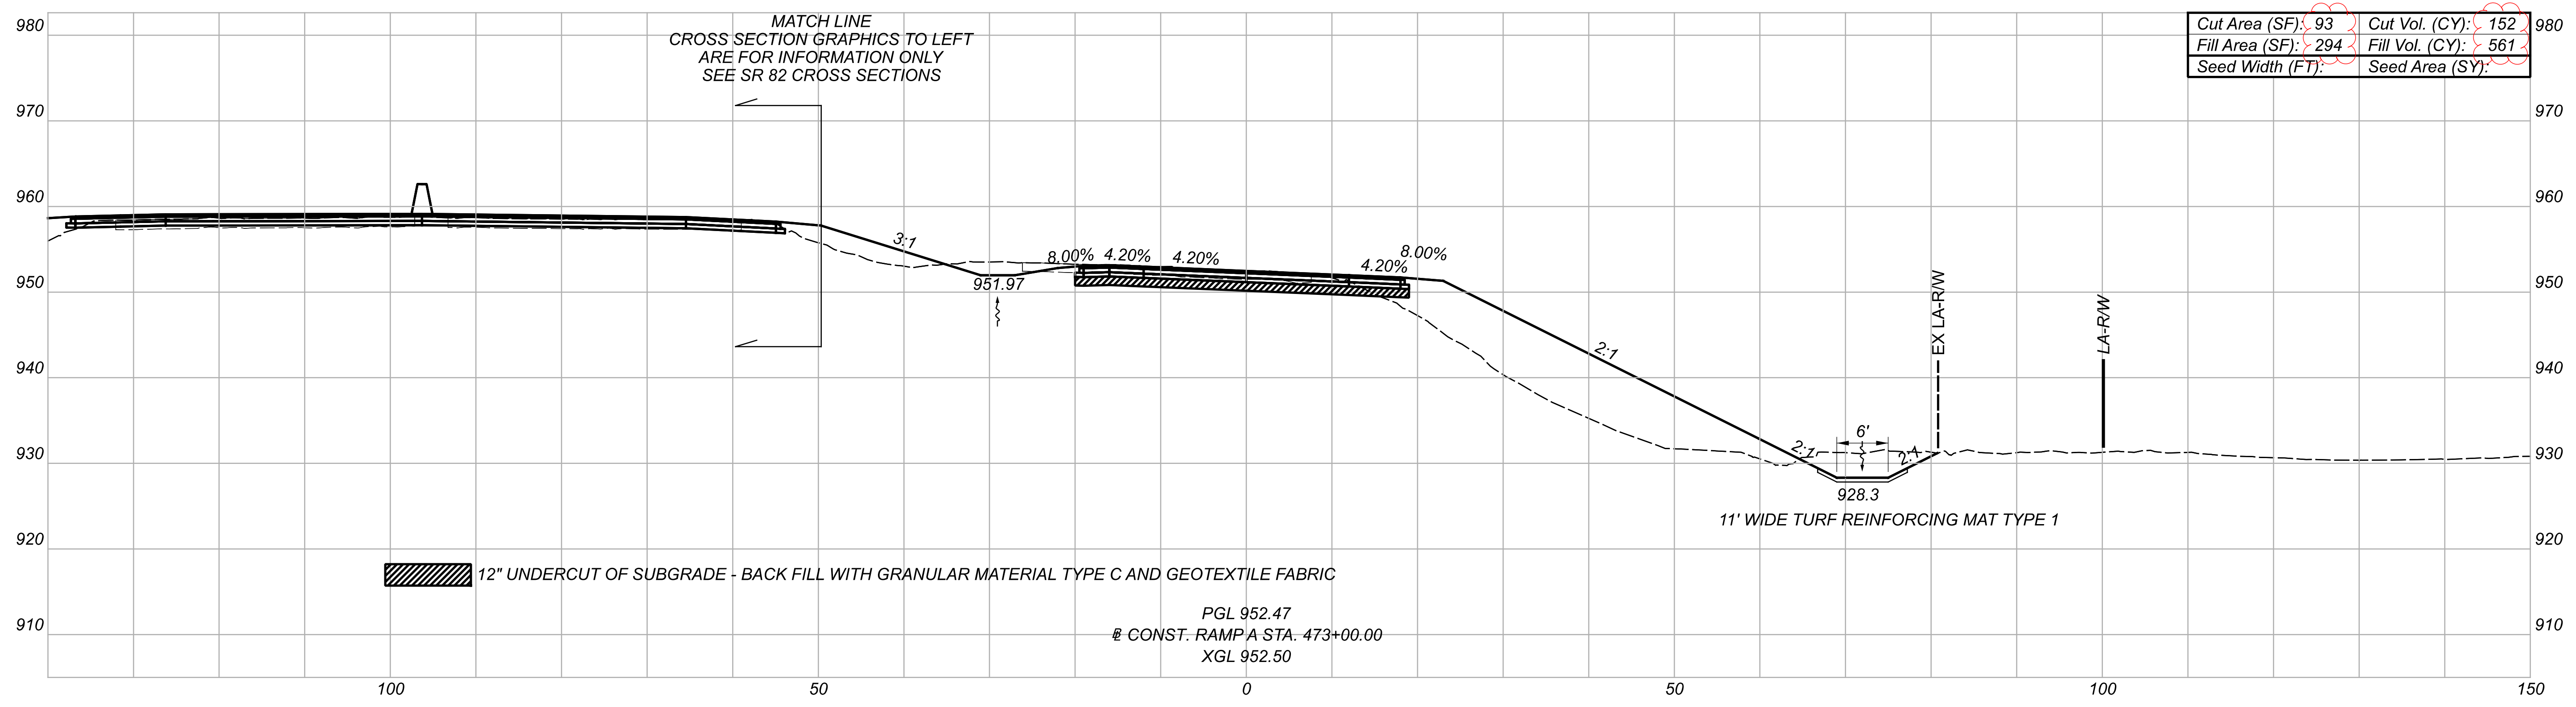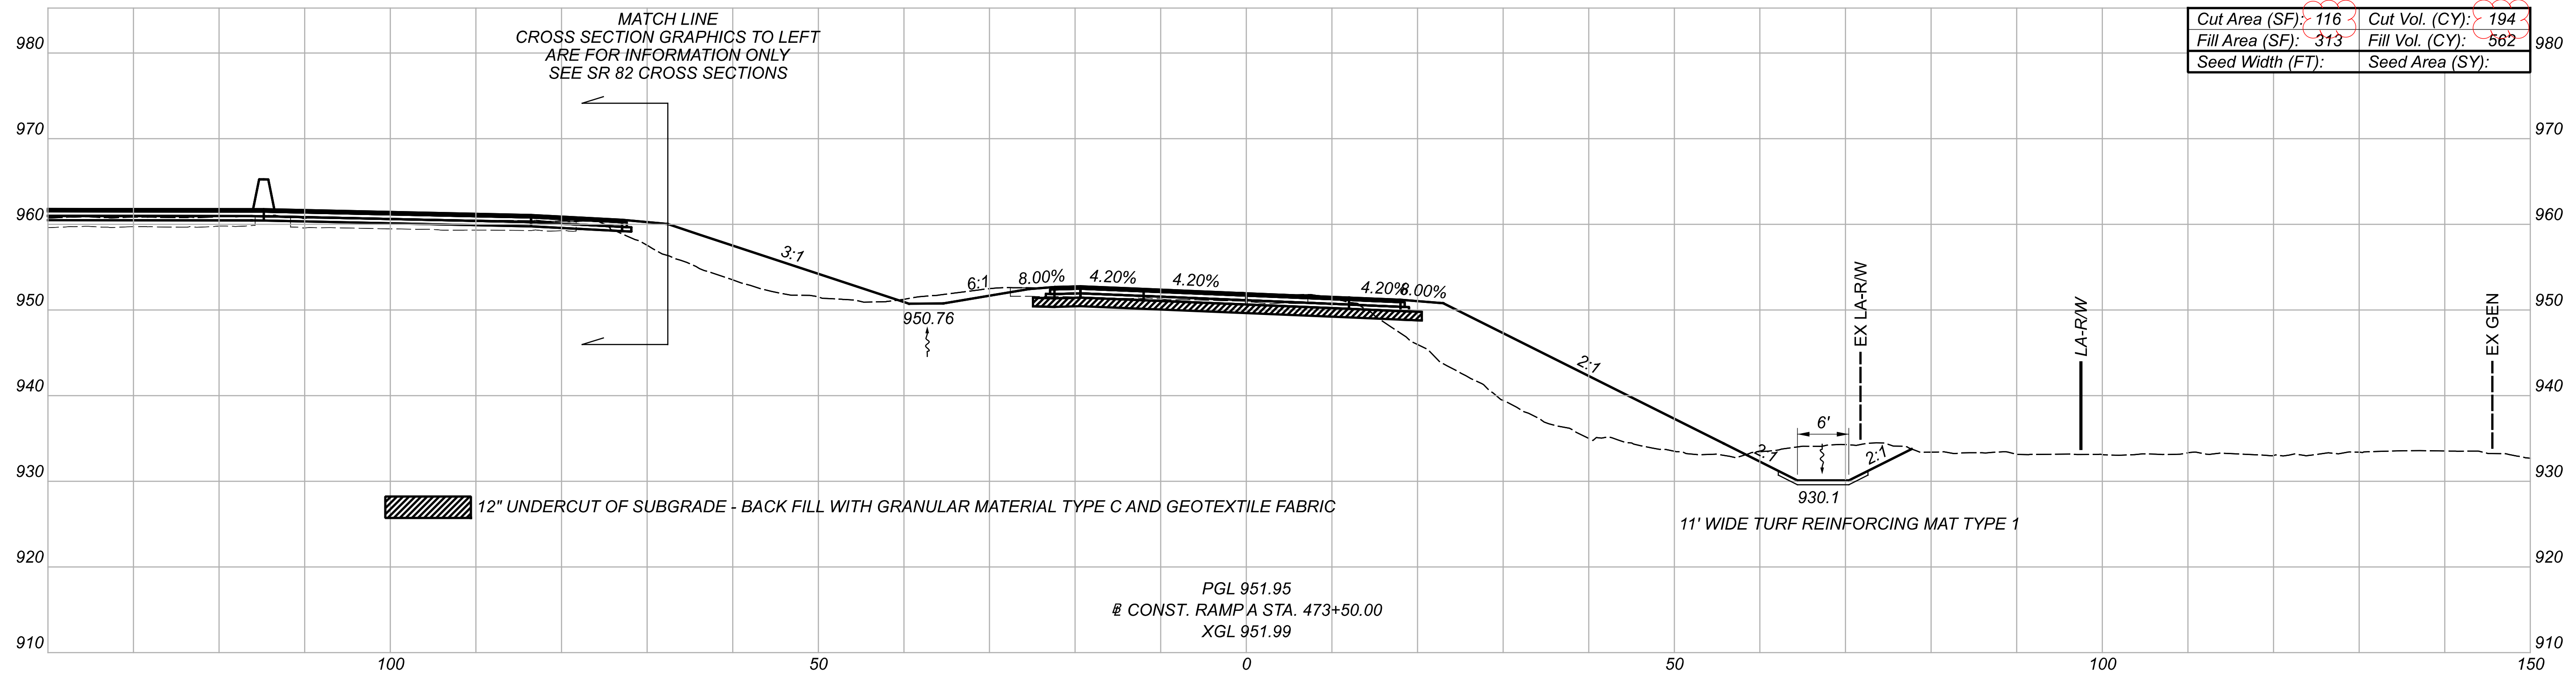 DESIGNER
 MJL
 REVIEWER
 JMB 08/19/21
 PROJECT ID
 108547
 SHEET TOTAL
 404 704



CROSS SECTIONS - BASELINE CONST. RAMP A
STA. 473+00.00 TO STA. 473+50.00

DESIGN AGENCY





DESIGNER
MJL

REVIEWER
JMB 08/19/21

PROJECT ID
108547

Sheet Totals			SHEET	TOTAL
Seeding	Cut	Fill		
·	345	1123	405	704

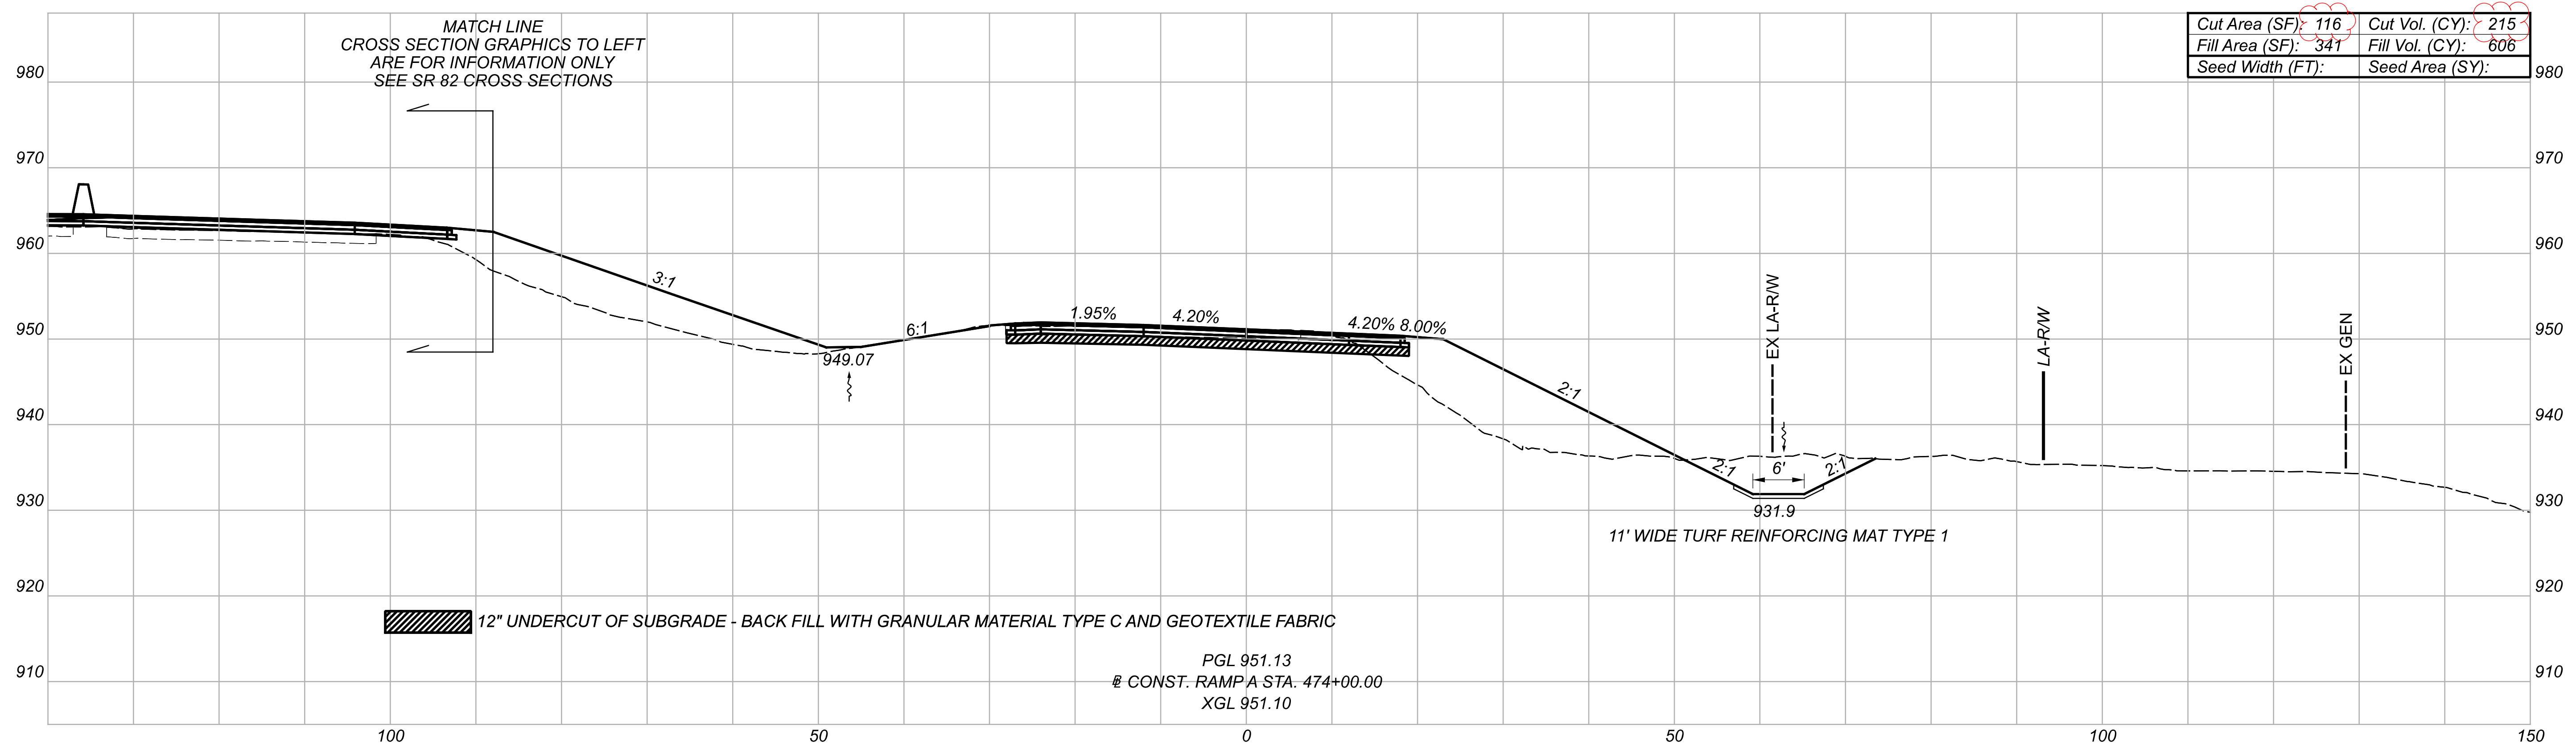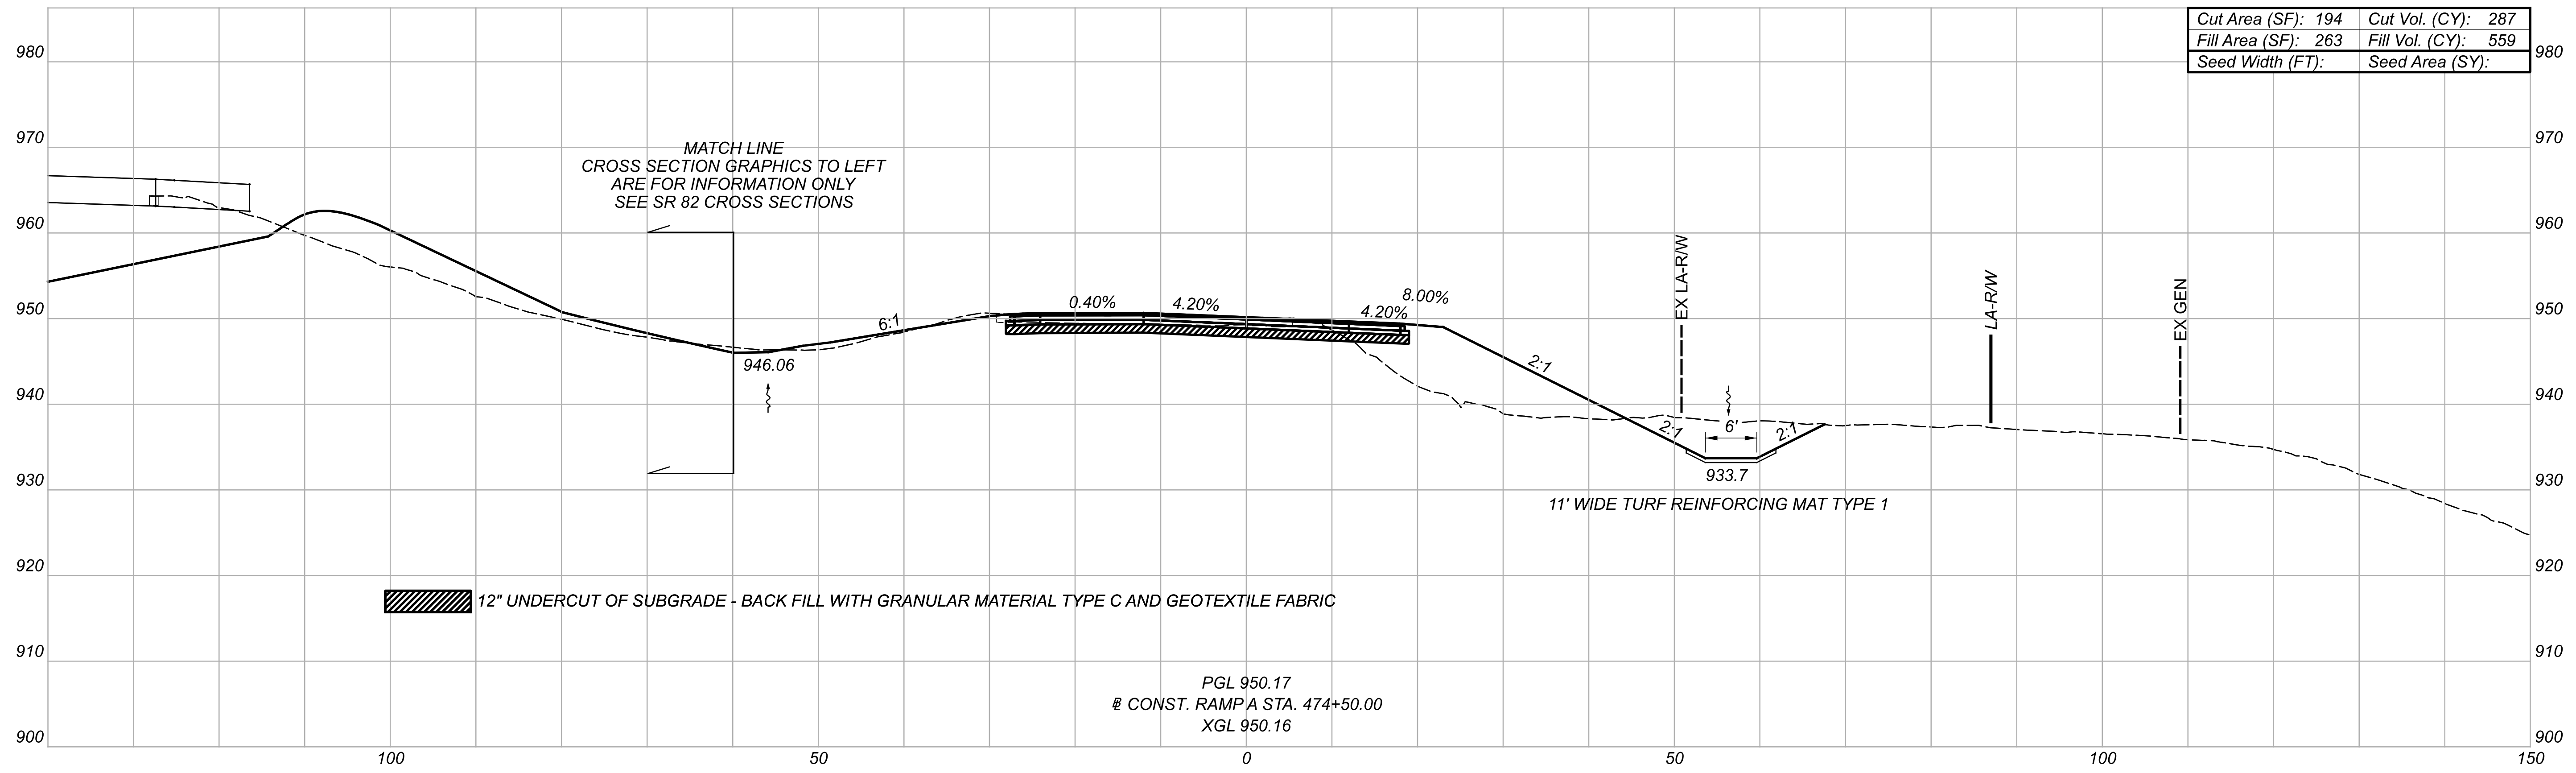

CROSS SECTIONS - BASELINE CONST. RAMP A
STA. 474+00.00 TO STA. 474+50.00

DESIGN AGENCY




DESIGNER
MJL


REVIEWER
JMB 08/19/21

PROJECT ID
108547

Sheet Totals			SHEET	TOTAL
Seeding	Cut	Fill		
.	501	1165	406	704

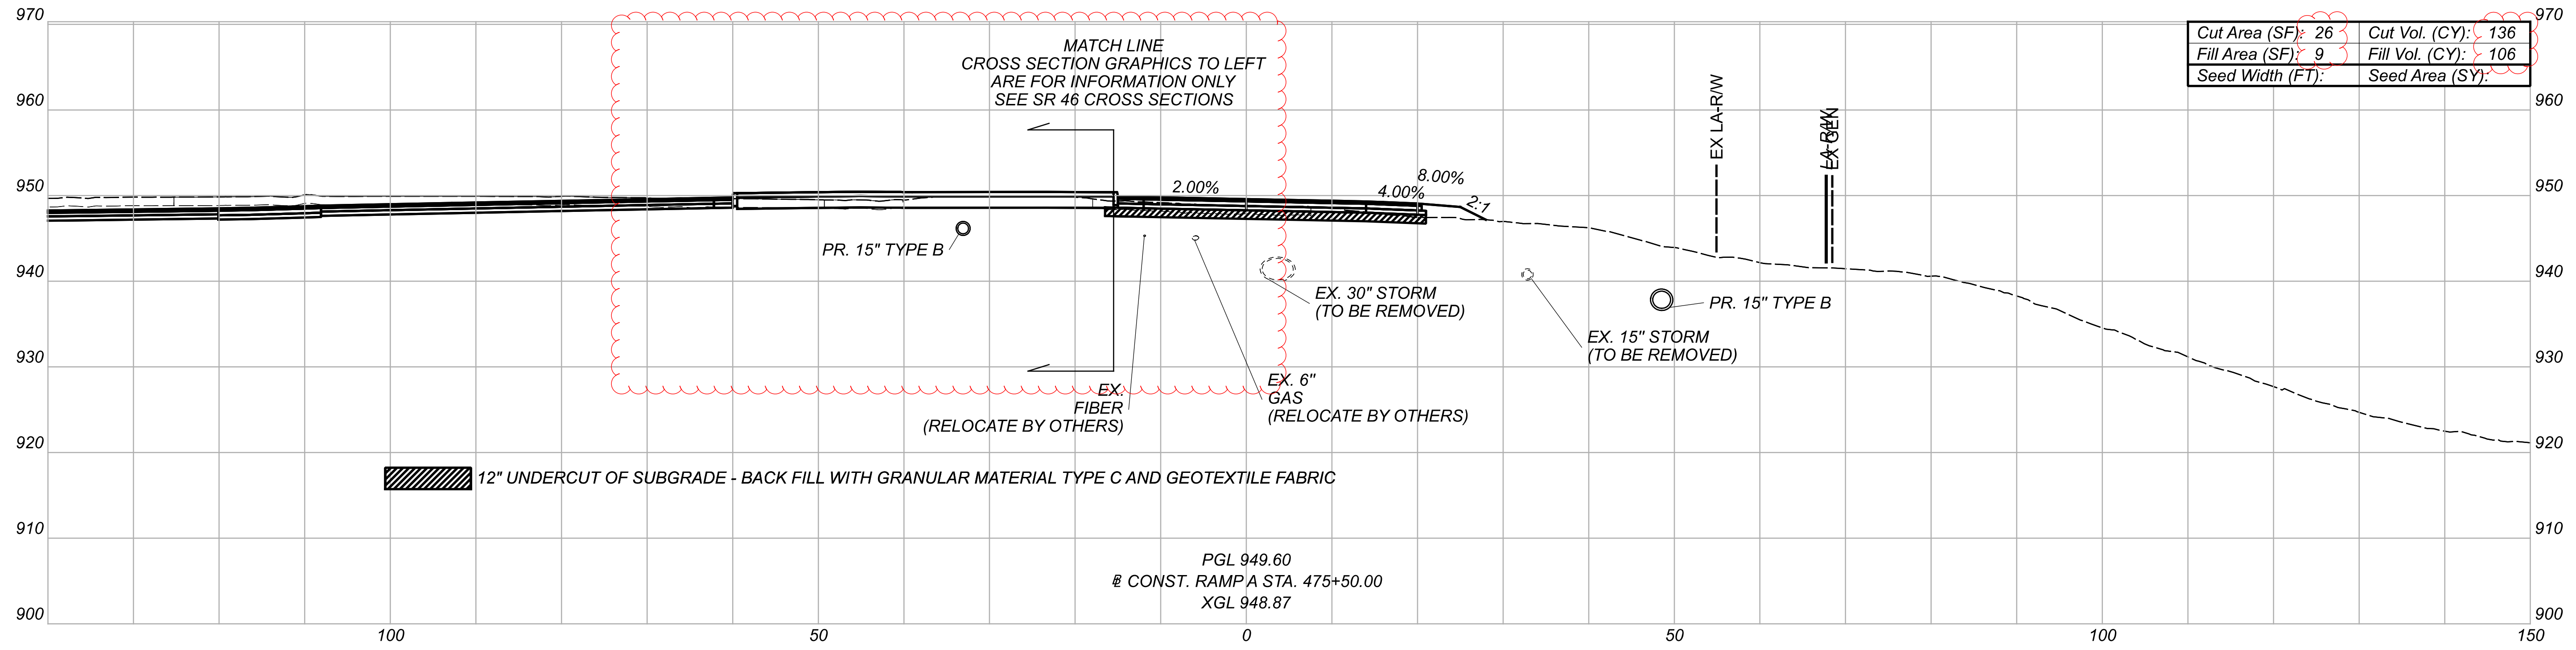

Cut Area (SF): 26	Cut Vol. (CY): 136
Fill Area (SF): 9	Fill Vol. (CY): 106
Seed Width (FT):	Seed Area (SY):

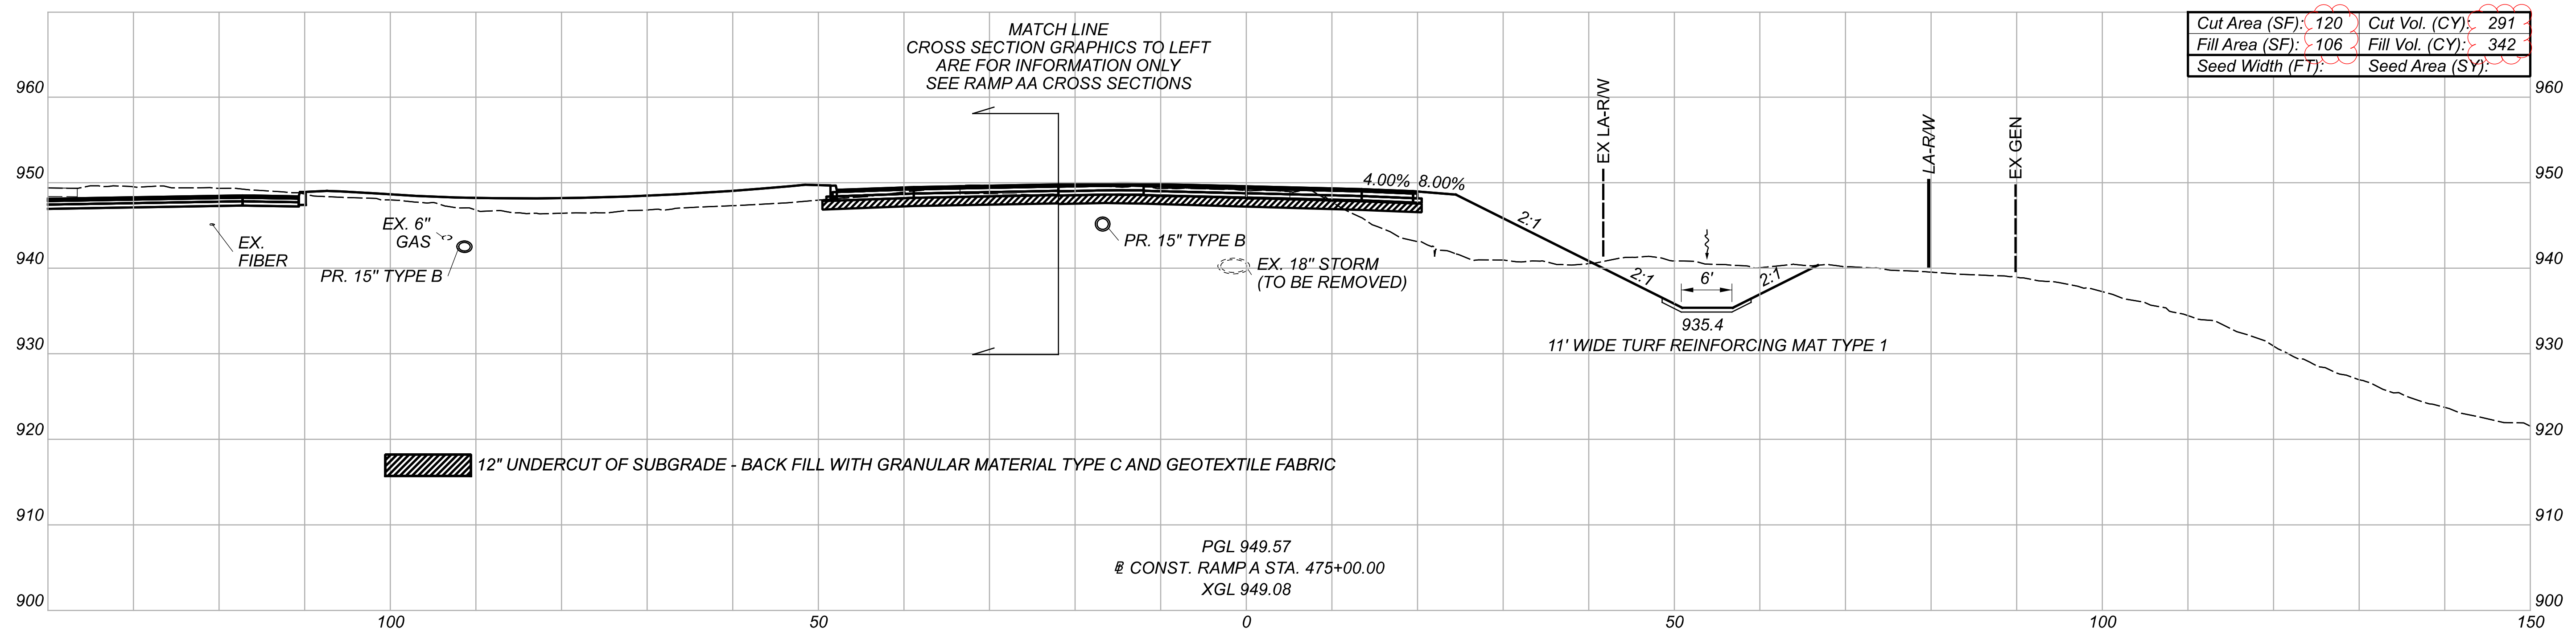

Cut Area (SF): 120	Cut Vol. (CY): 291
Fill Area (SF): 106	Fill Vol. (CY): 342
Seed Width (FT):	Seed Area (SY):

CROSS SECTIONS - BASELINE CONST. RAMP A
 STA. 475+00.00 TO STA. 475+50.00

DESIGN AGENCY





DESIGNER
 MJL

REVIEWER
 JMB 08/19/21

PROJECT ID
 108547

Sheet Totals			SHEET TOTAL	
Seeding	Cut	Fill	SHEET	TOTAL
•	426	449	407	704

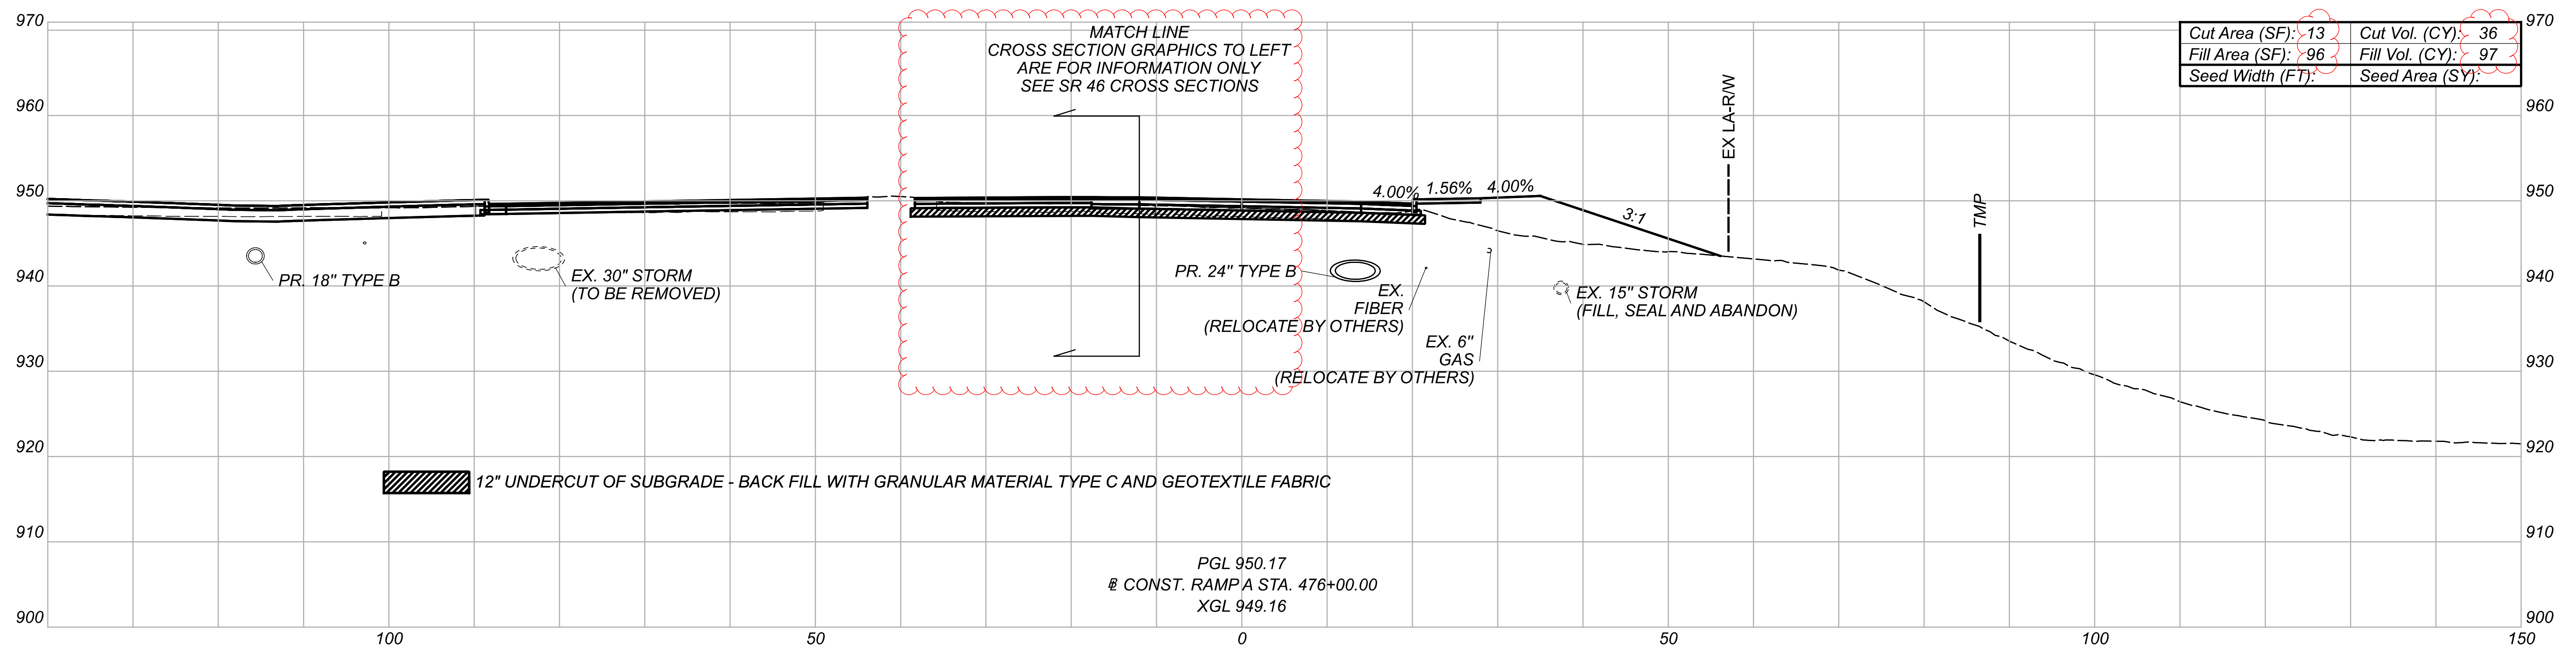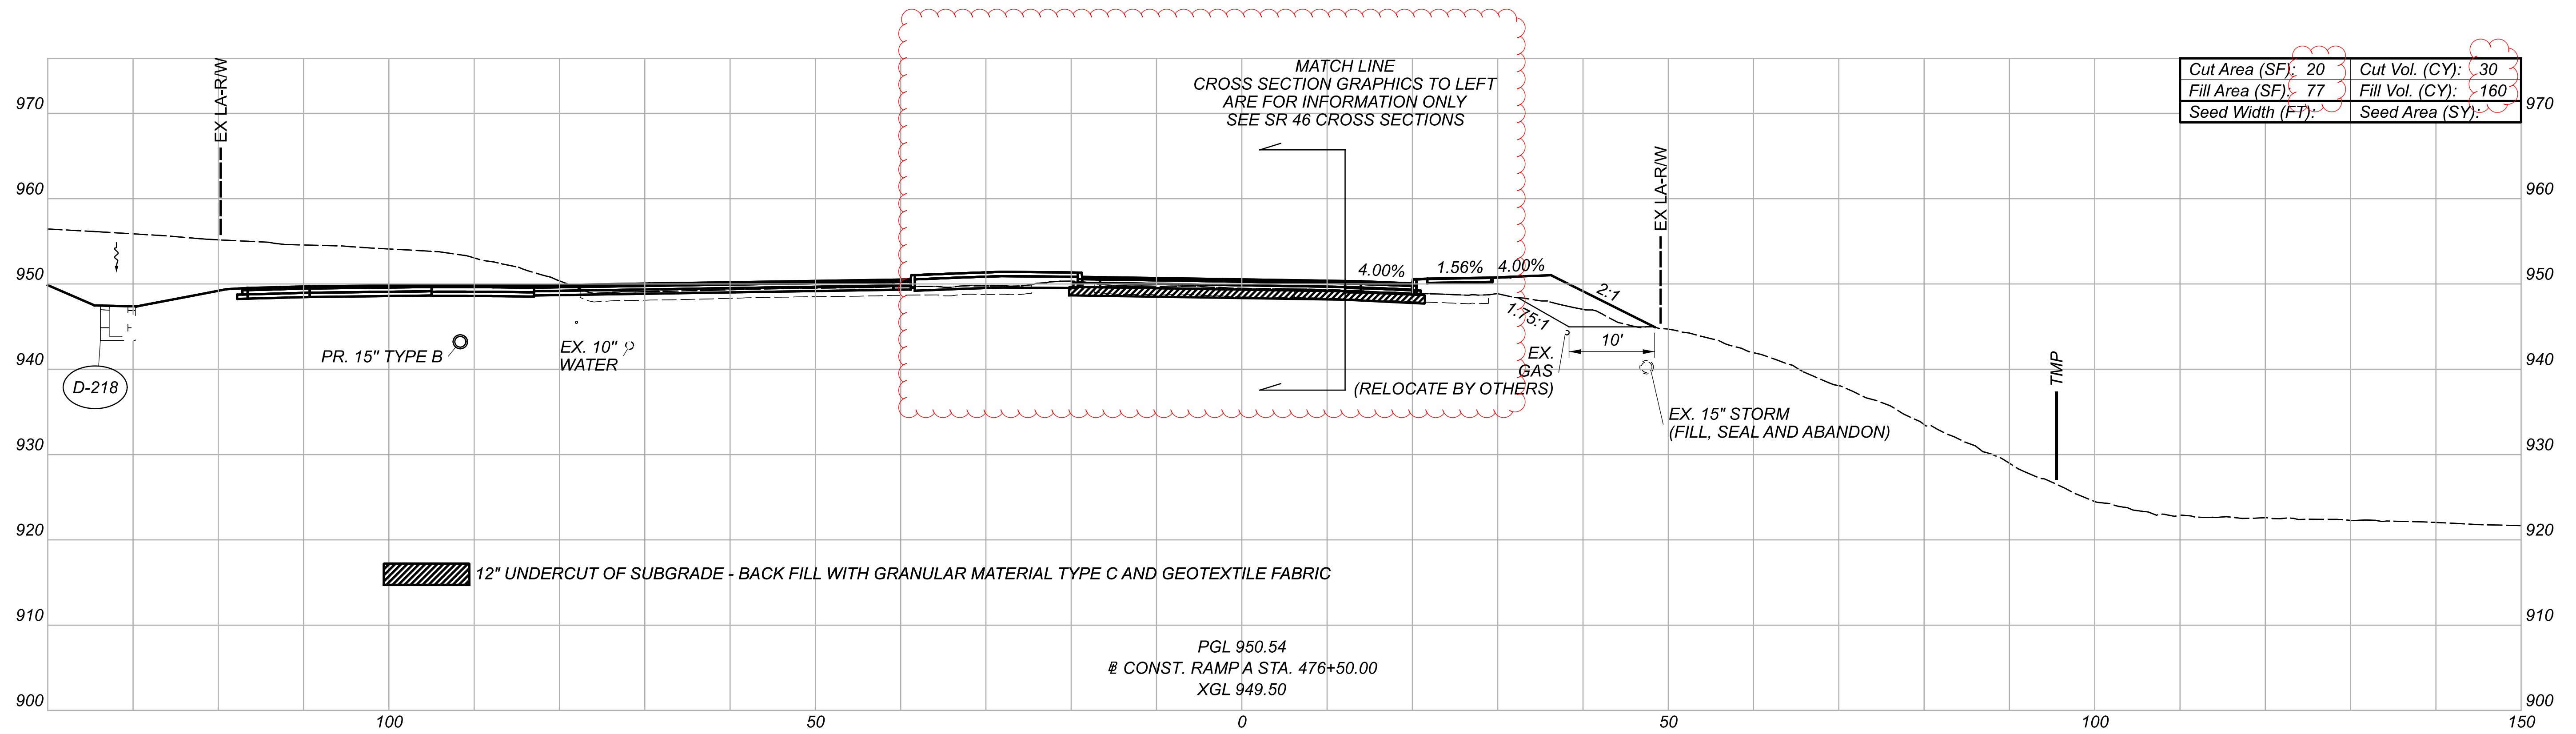

CROSS SECTIONS - BASELINE CONST. RAMP A
 STA. 476+00.00 TO STA. 476+50.00

DESIGN AGENCY




DESIGNER
 MJL

REVIEWER
 JMB 08/19/21


PROJECT ID
 108547

Sheet Totals			SHEET TOTAL	
Seeding	Cut	Fill	408	704
.	66	257		

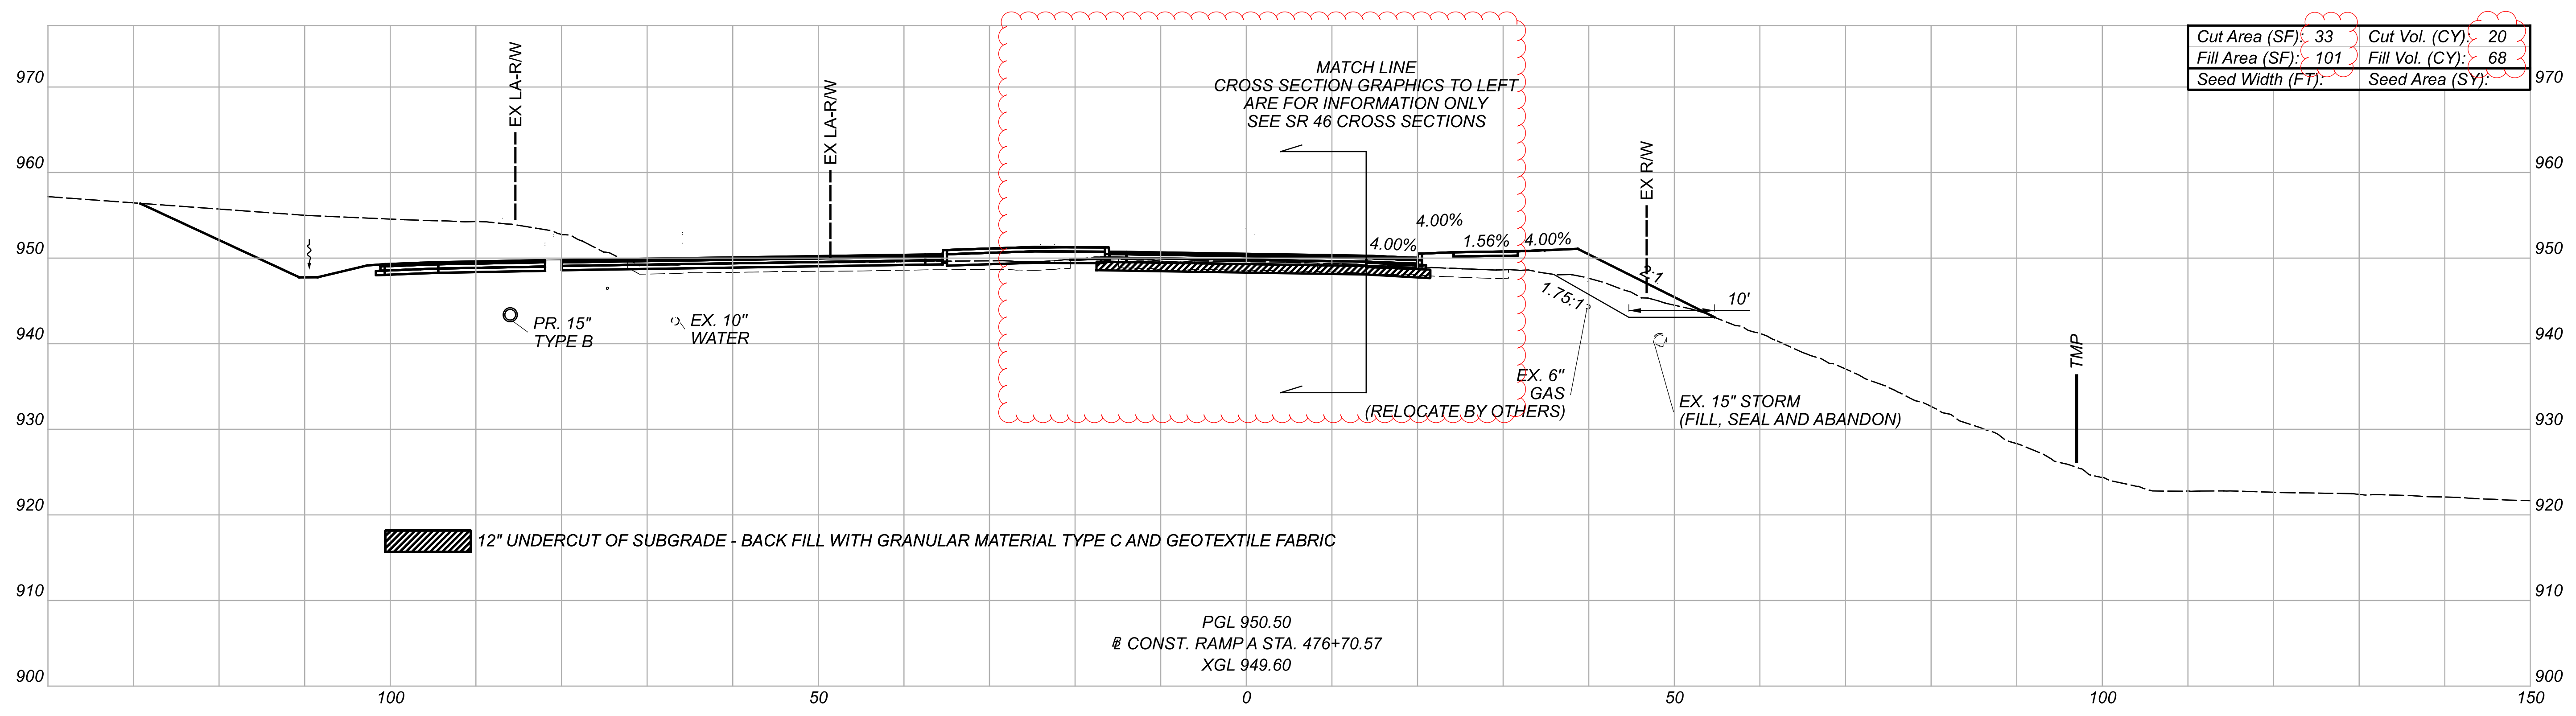


Cut Area (SF):	33	Cut Vol. (CY):	20
Fill Area (SF):	101	Fill Vol. (CY):	68
Seed Width (FT):		Seed Area (SY):	


Sheet Totals			PROJECT ID	
Seeding	Cut	Fill	108547	
•	20	68	SHEET	TOTAL
			409	704

DESIGN AGENCY

 DESIGNER
 MJL
 REVIEWER
 JMB 08/19/21
 PROJECT ID
 108547

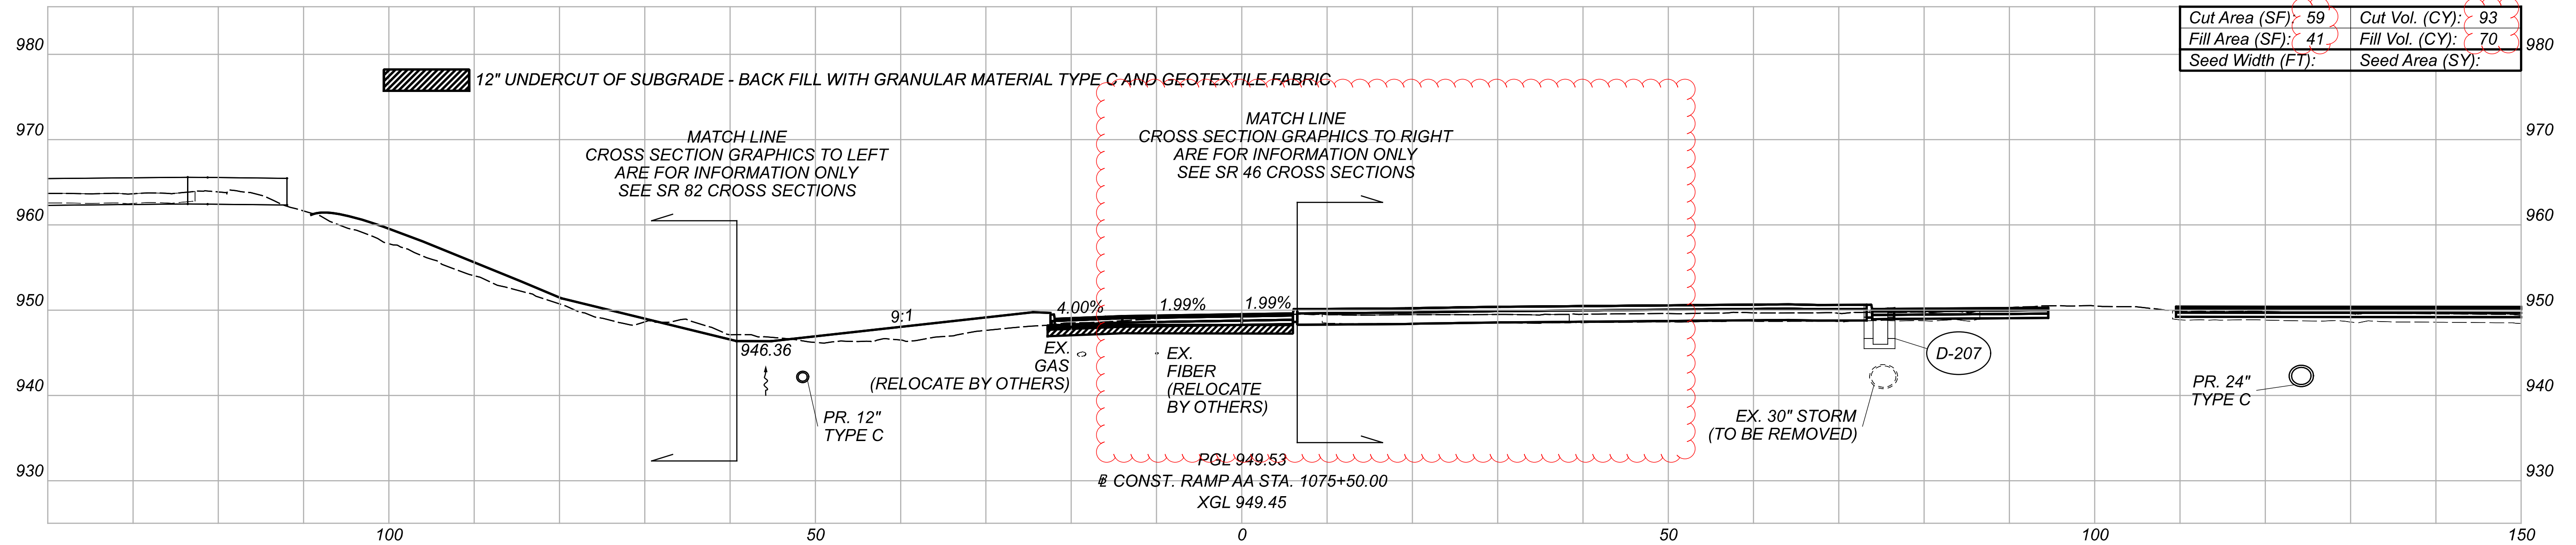CROSS SECTIONS - BASELINE CONST. RAMP A
 STA. 476+71.05

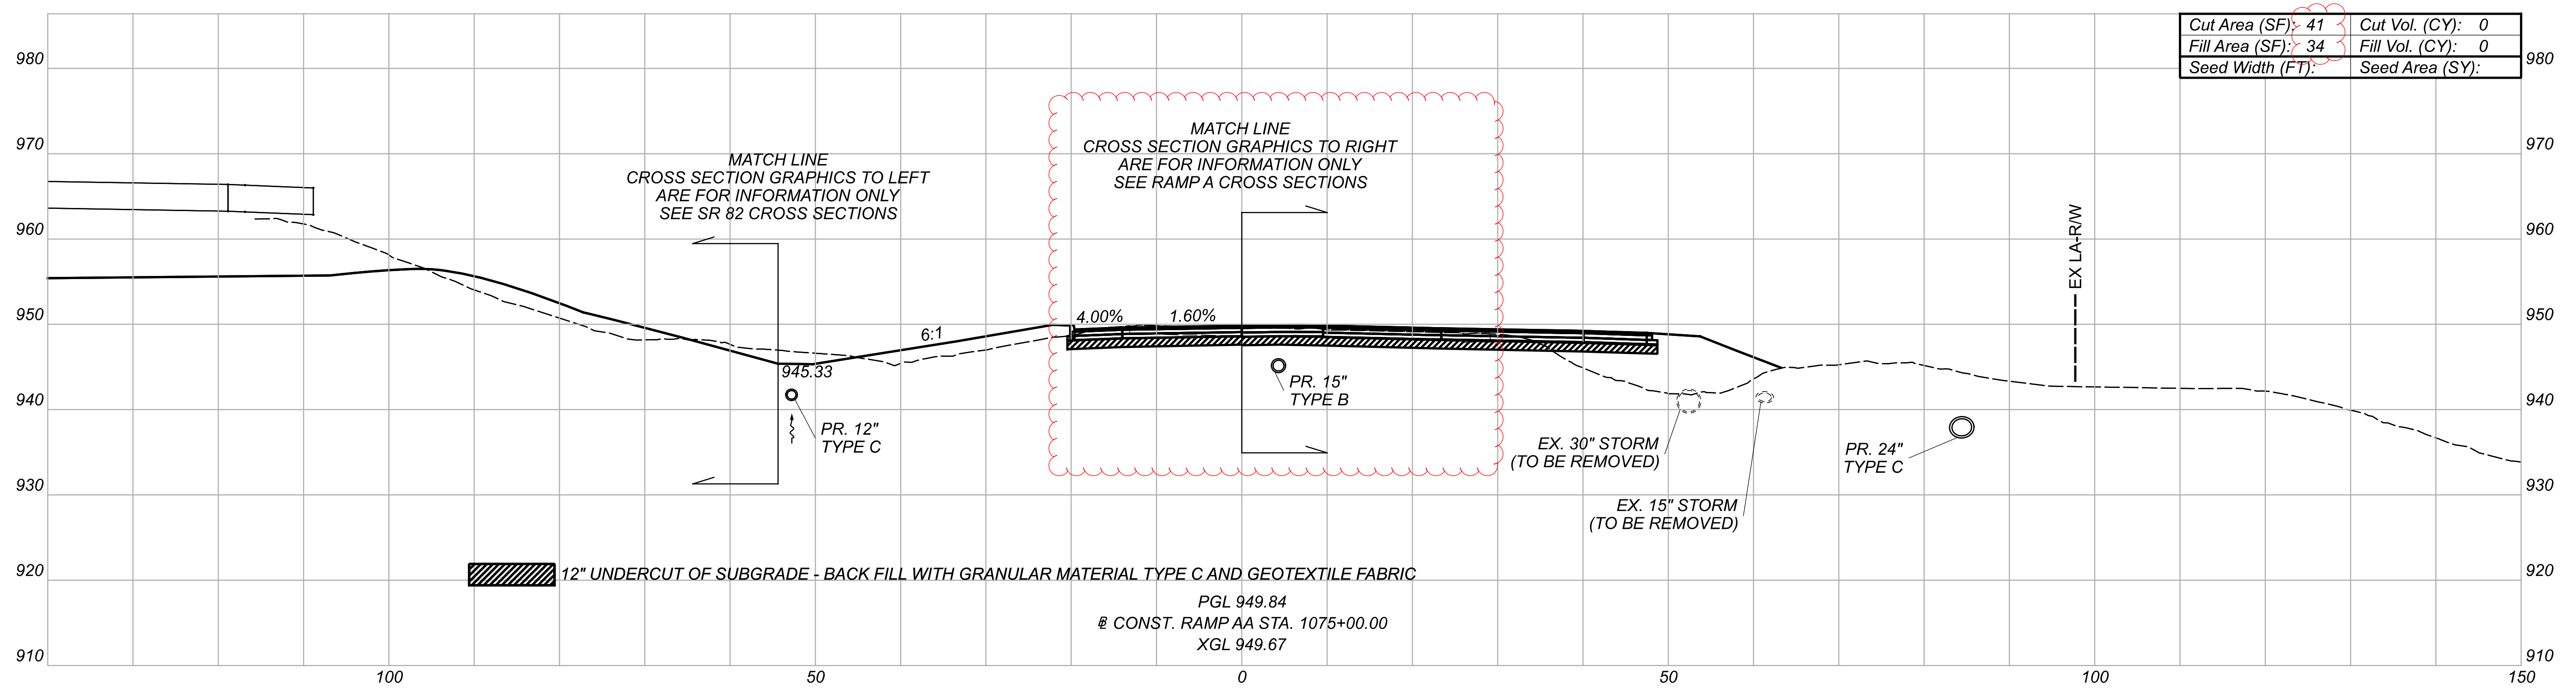

Cut Area (SF):	59	Cut Vol. (CY):	93
Fill Area (SF):	41	Fill Vol. (CY):	70
Seed Width (FT):		Seed Area (SY):	



Cut Area (SF):	41	Cut Vol. (CY):	0
Fill Area (SF):	34	Fill Vol. (CY):	0
Seed Width (FT):		Seed Area (SY):	

Sheet Totals			SHEET TOTAL
Seeding	Cut	Fill	
.	93	70	410 704



CROSS SECTIONS - BASELINE CONST. RAMP AA
STA. 1075+00.00 TO STA. 1075+50.00

DESIGN AGENCY
HR

DESIGNER
MJL

REVIEWER
JMB 08/19/21

PROJECT ID
108547

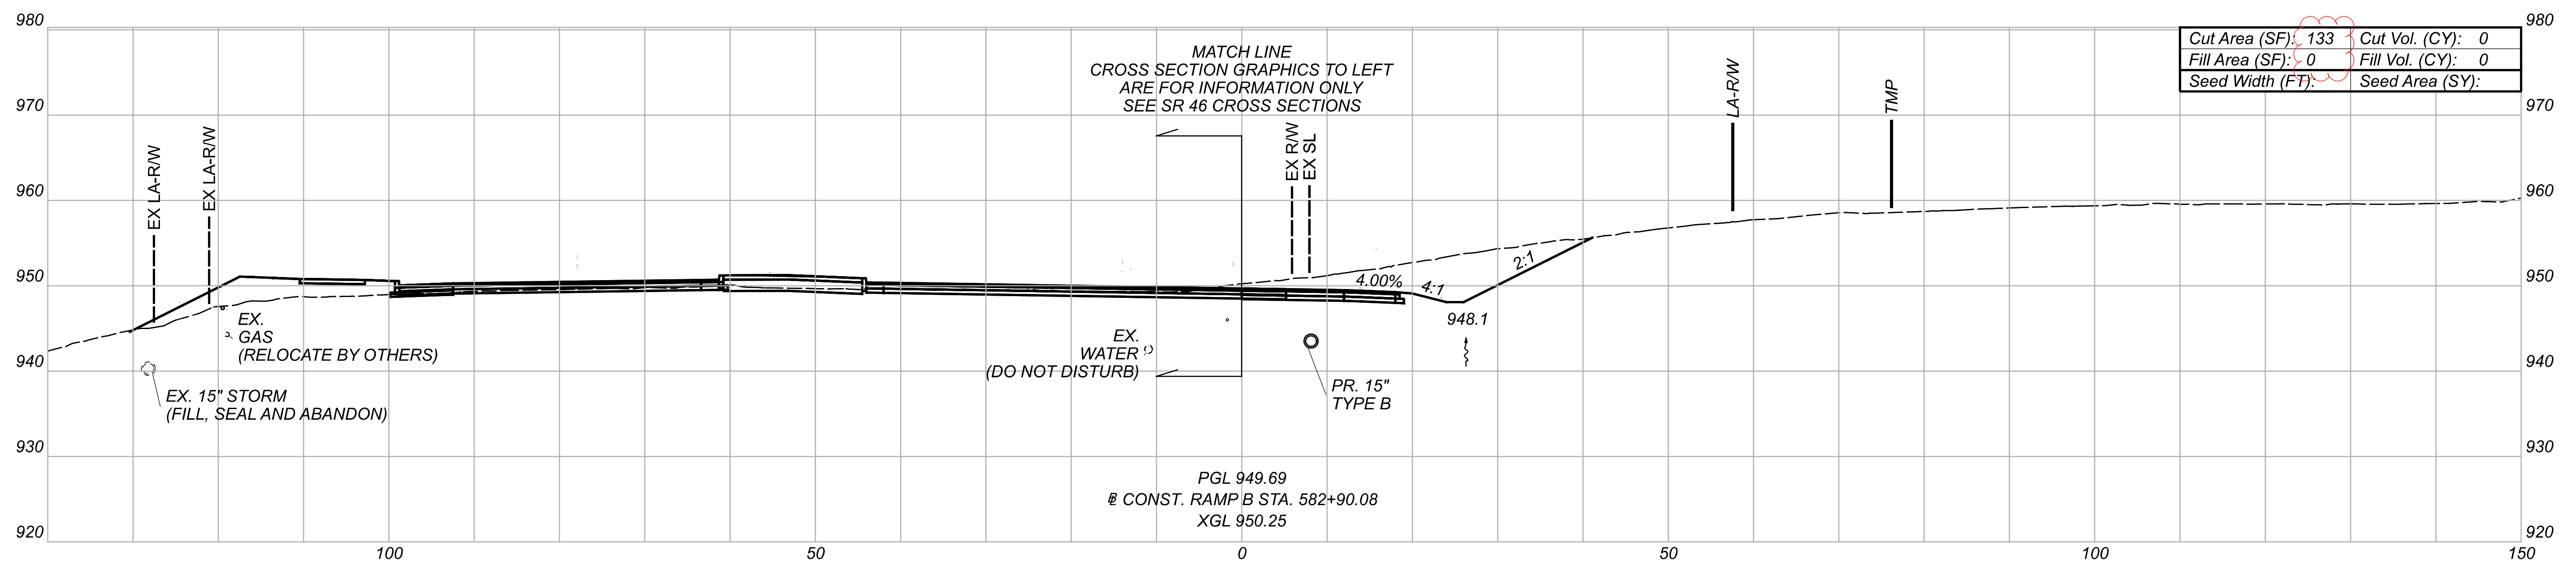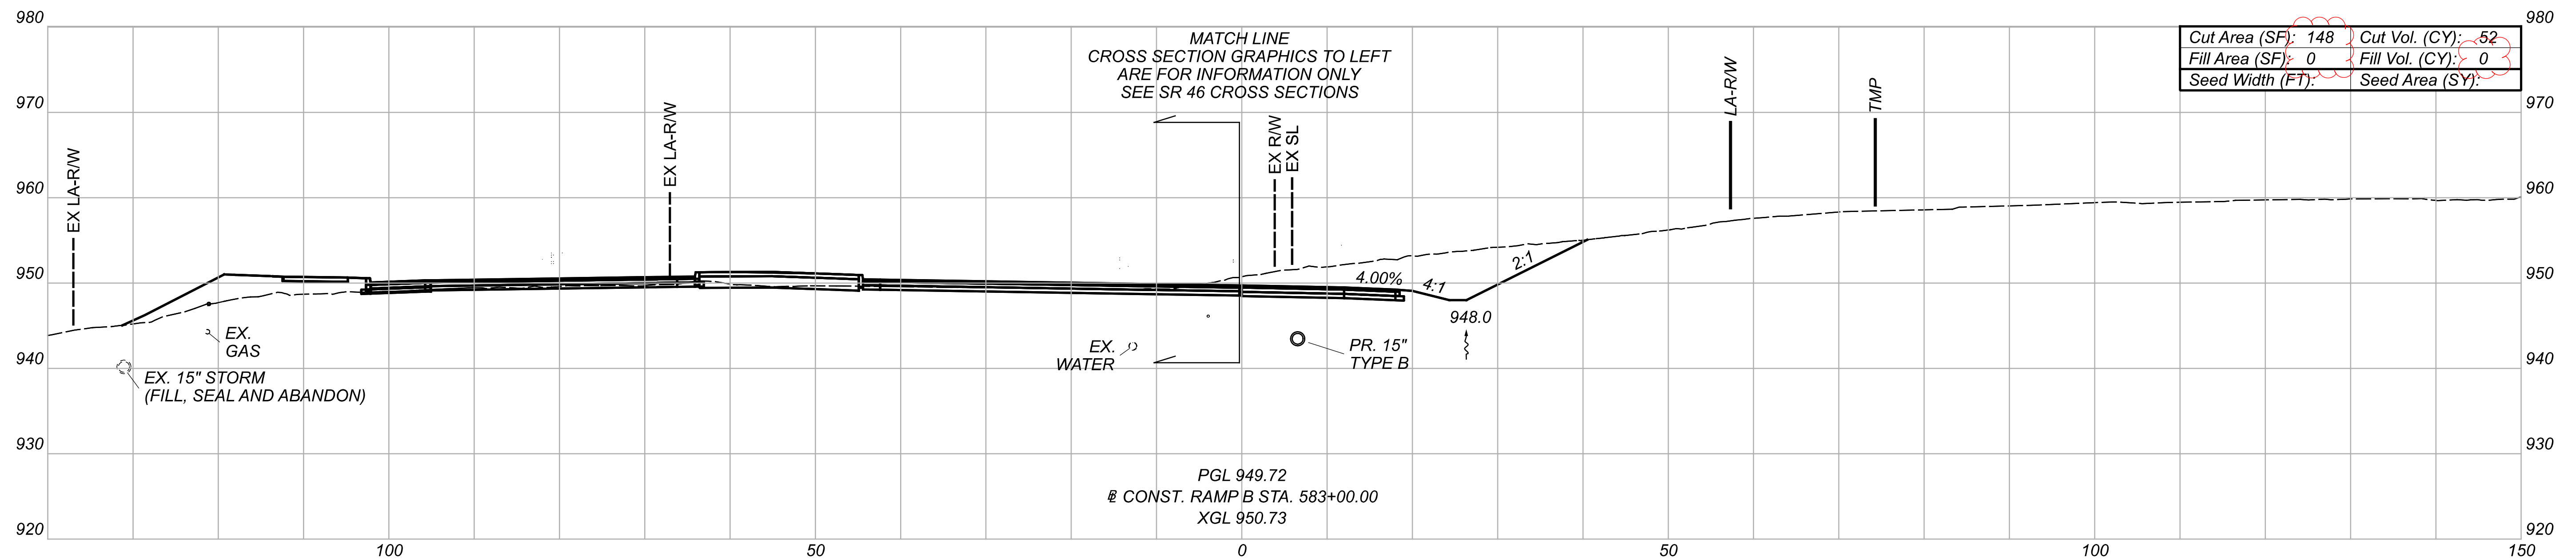

CROSS SECTIONS - BASELINE CONST. RAMP B
 STA. 582+90.08 TO STA. 583+00.00

DESIGN AGENCY






DESIGNER
 MJL

REVIEWER
 JMB 08/19/21

PROJECT ID
 108547

Sheet Totals			SHEET TOTAL	
Seeding	Cut	Fill	SHEET	TOTAL
0	52	0	411	704

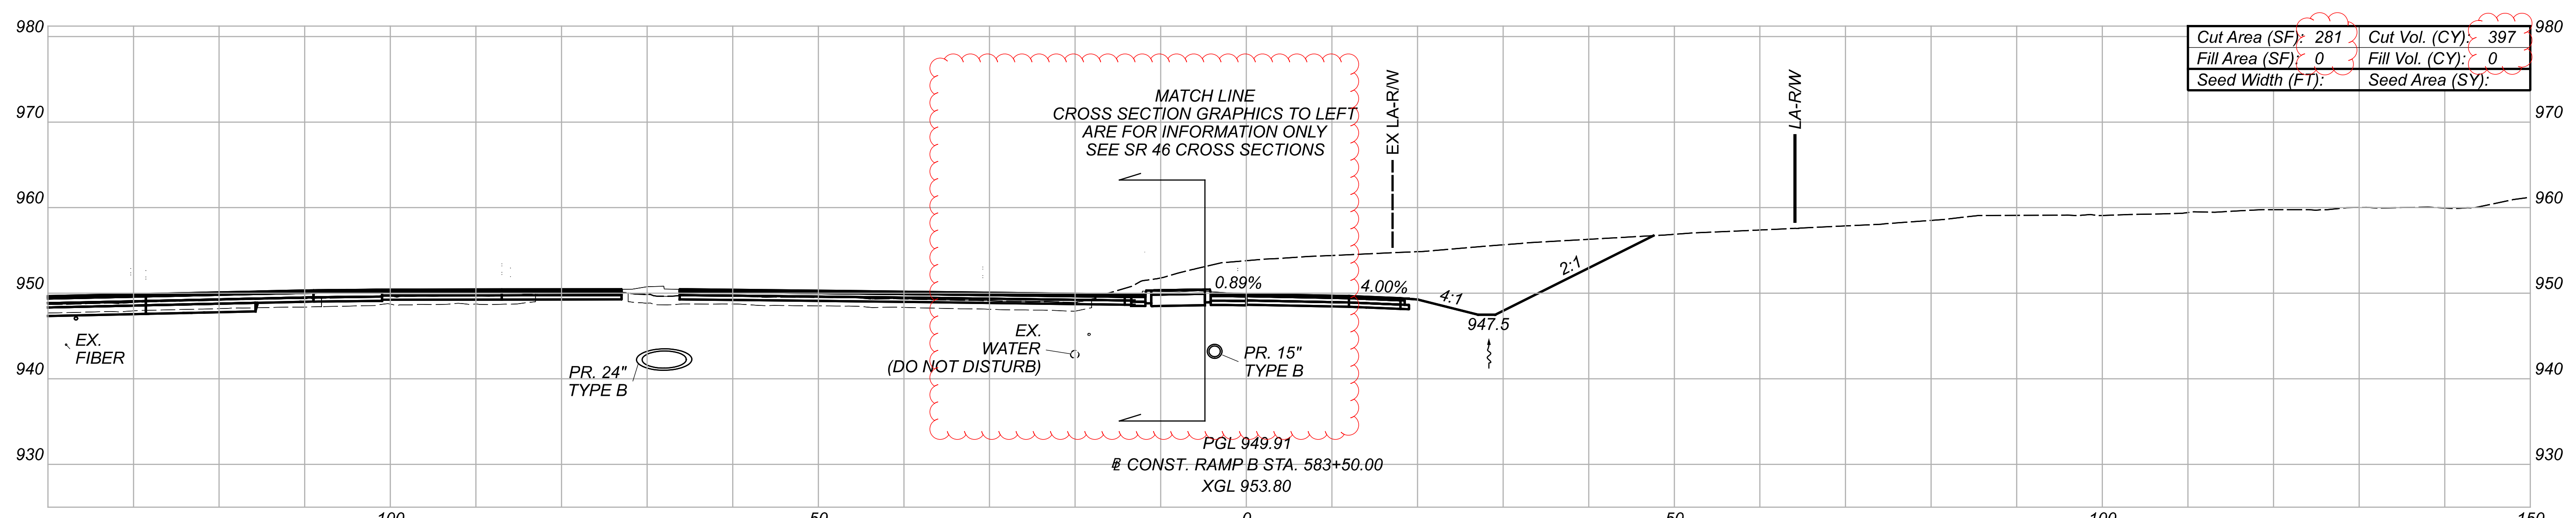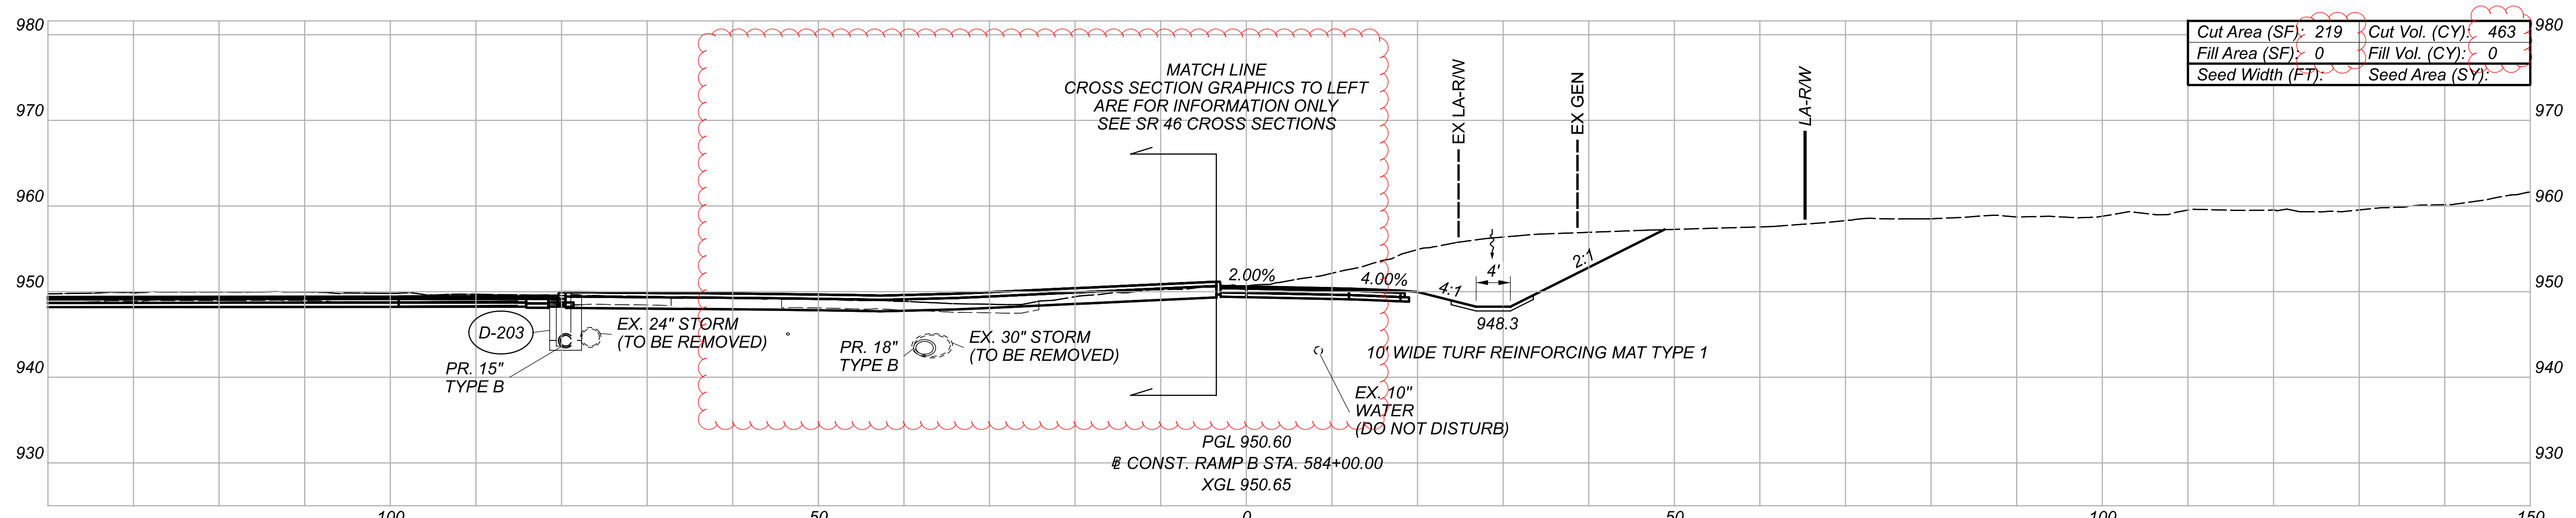
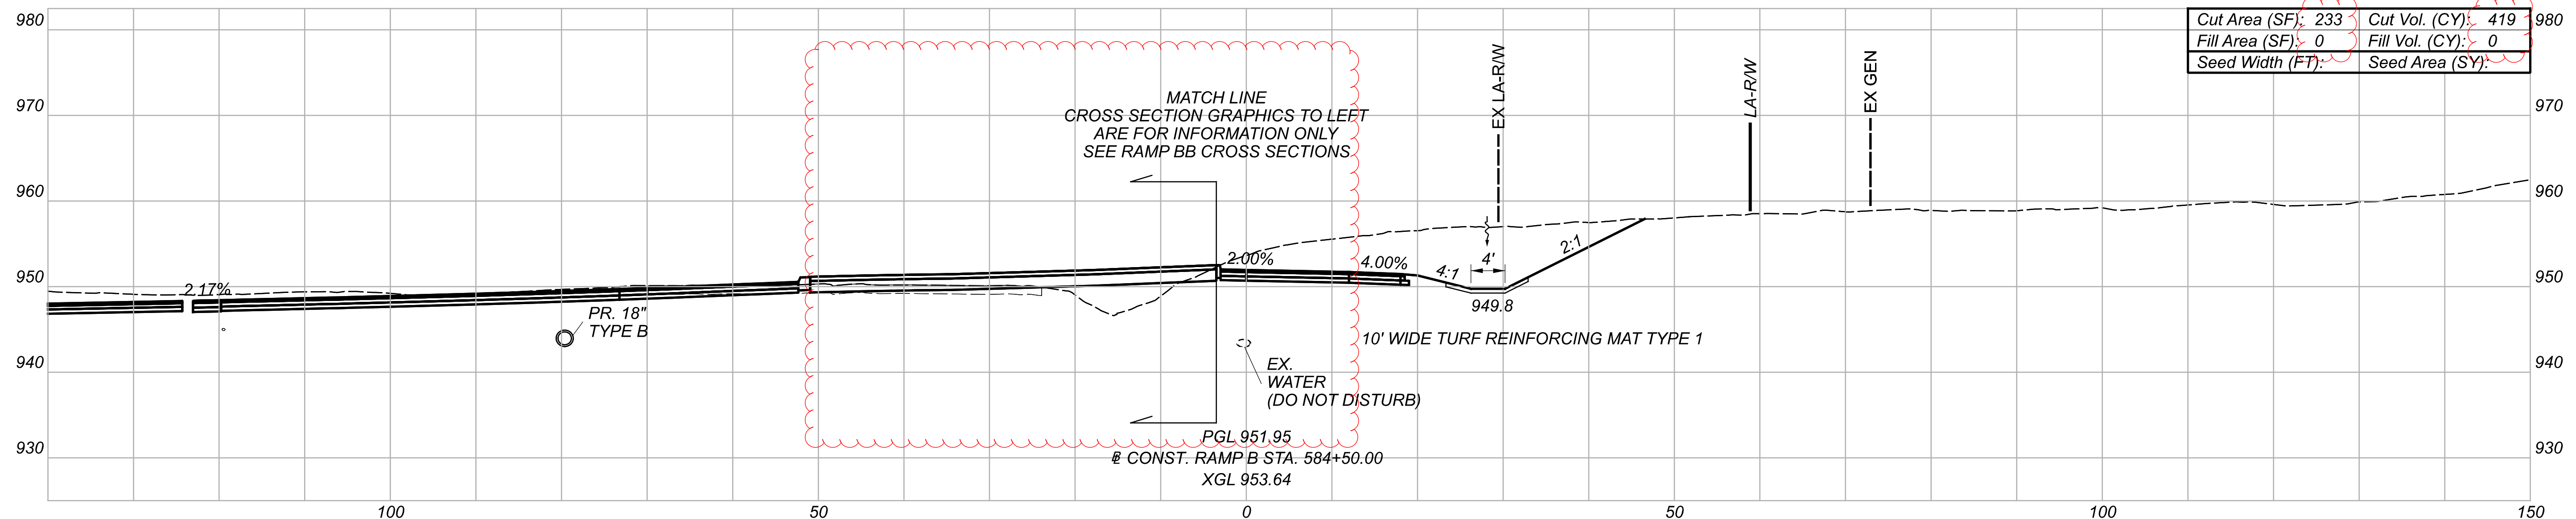


CROSS SECTIONS - BASELINE CONST. RAMP B
STA. 583+50.00 TO STA. 584+50.00

DESIGN AGENCY
HR
DESIGNER
MJL
REVIEWER
JMB 08/19/21
PROJECT ID
108547

Sheet Totals			SHEET	TOTAL
Seeding	Cut	Fill	412	704
•	1278	0		

TRU-46/82 DDI
MODEL: BLP_R82B - 585+00.00 [Sheet] PAPER SIZE: 34x22 (in.) DATE: 5/4/2023 TIME: 12:08:28 PM USER: TSCHOEN
p:\pwhdr\users\01\DR_US_East_01\Documents\010\DOT\DOT_TRU-46-82\DDI\6.0_CAD_BIM\6.2_WIP\01_Design\108547\400-Engineering\Roadway\Roadway_Sheets\Ramp_B - Roadway Cross Sections Sheet

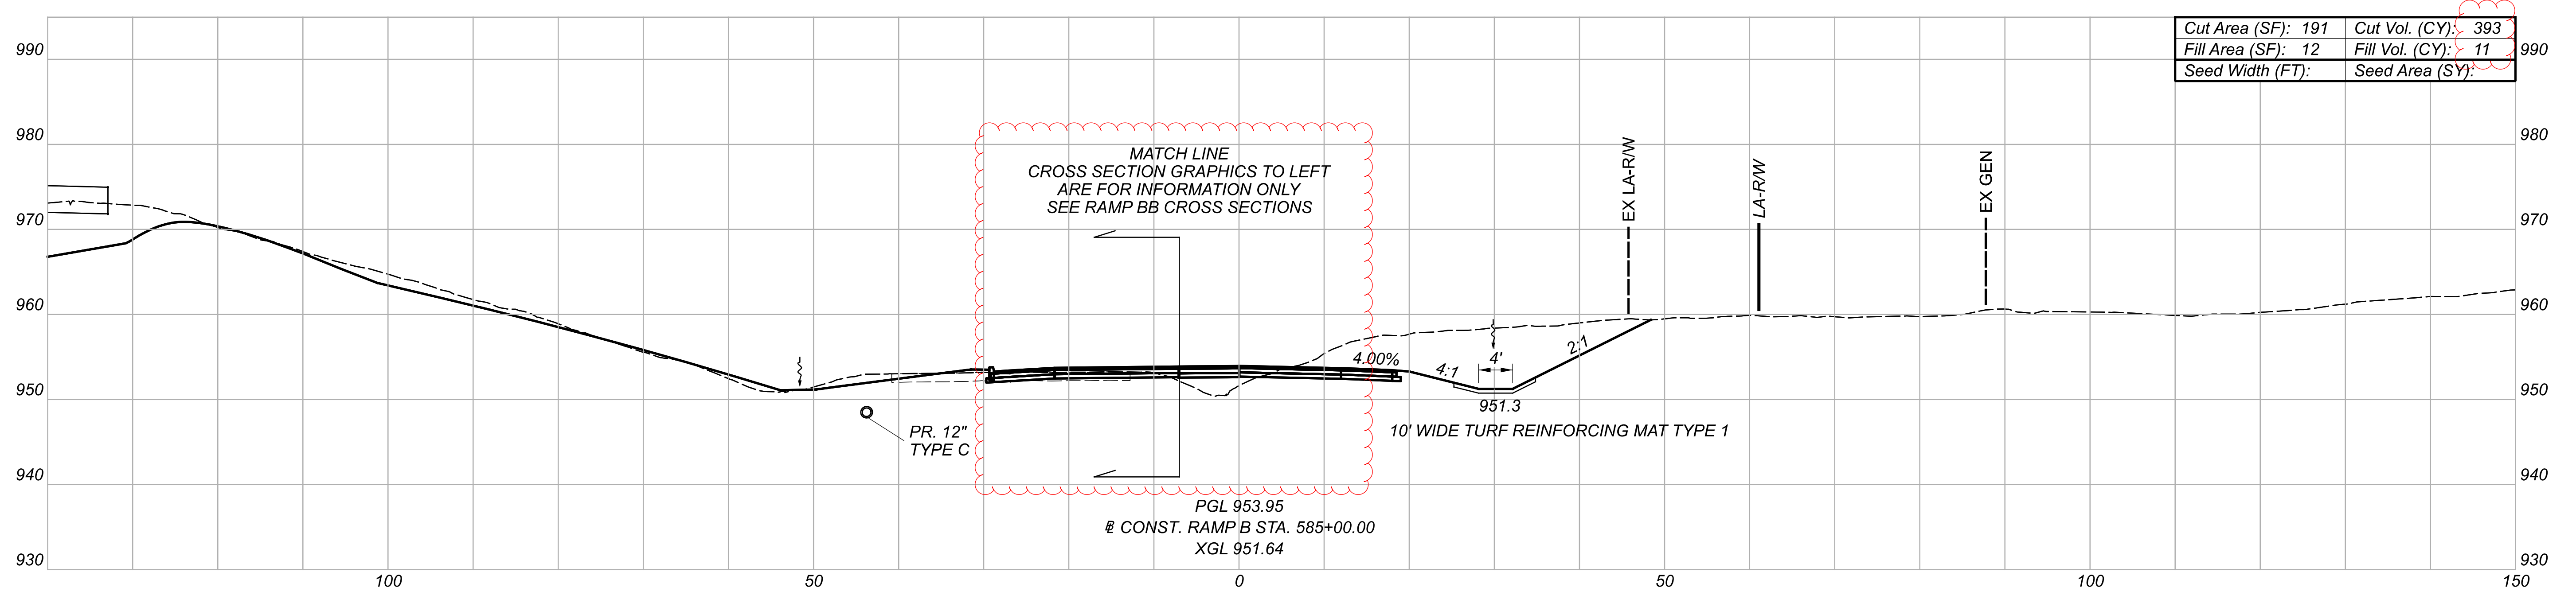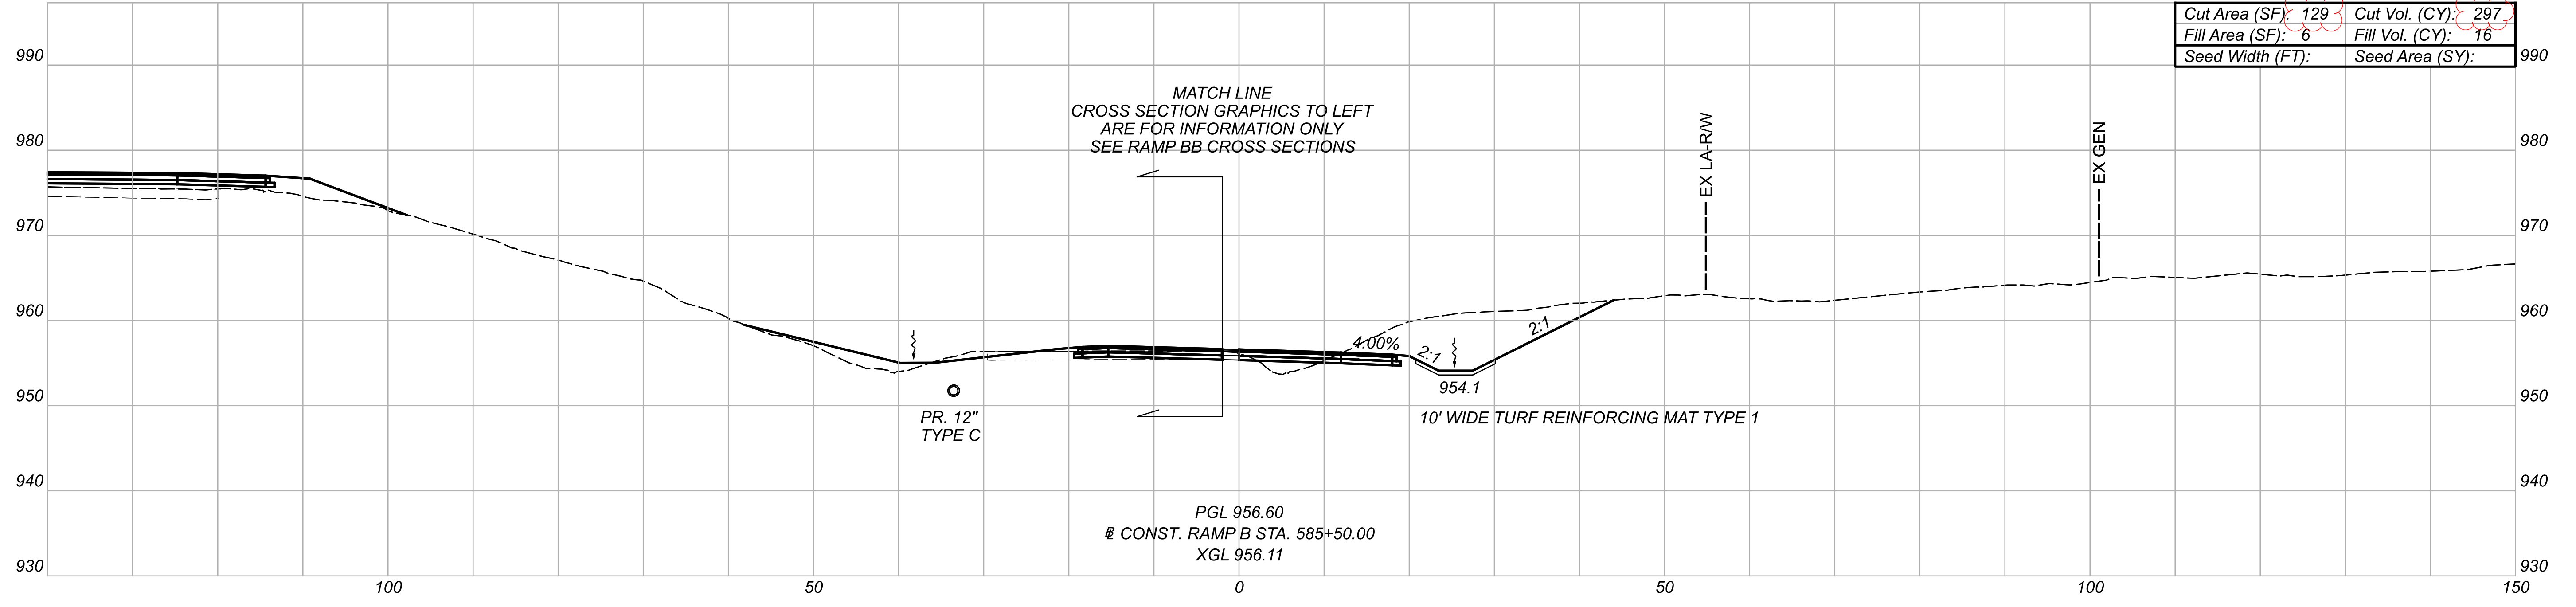

CROSS SECTIONS - BASELINE CONST. RAMP B
STA. 585+00.00 TO STA. 585+50.00

DESIGN AGENCY





DESIGNER
MJL

REVIEWER
JMB 08/19/21

PROJECT ID
108547

Sheet Totals			
Seeding	Cut	Fill	TOTAL
690	27	413	704

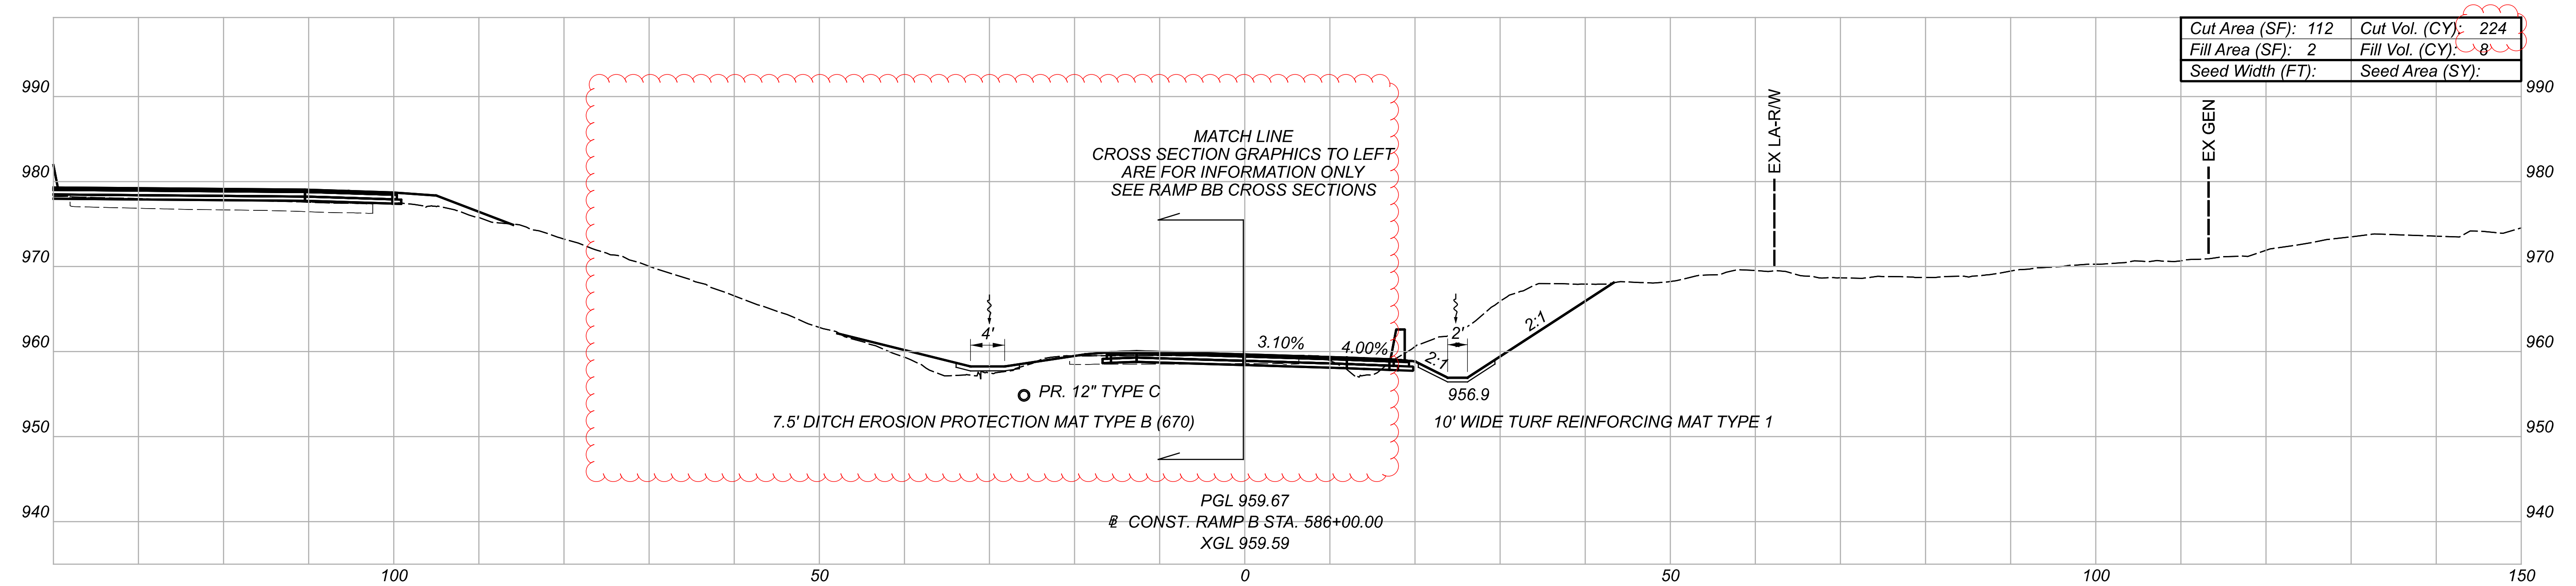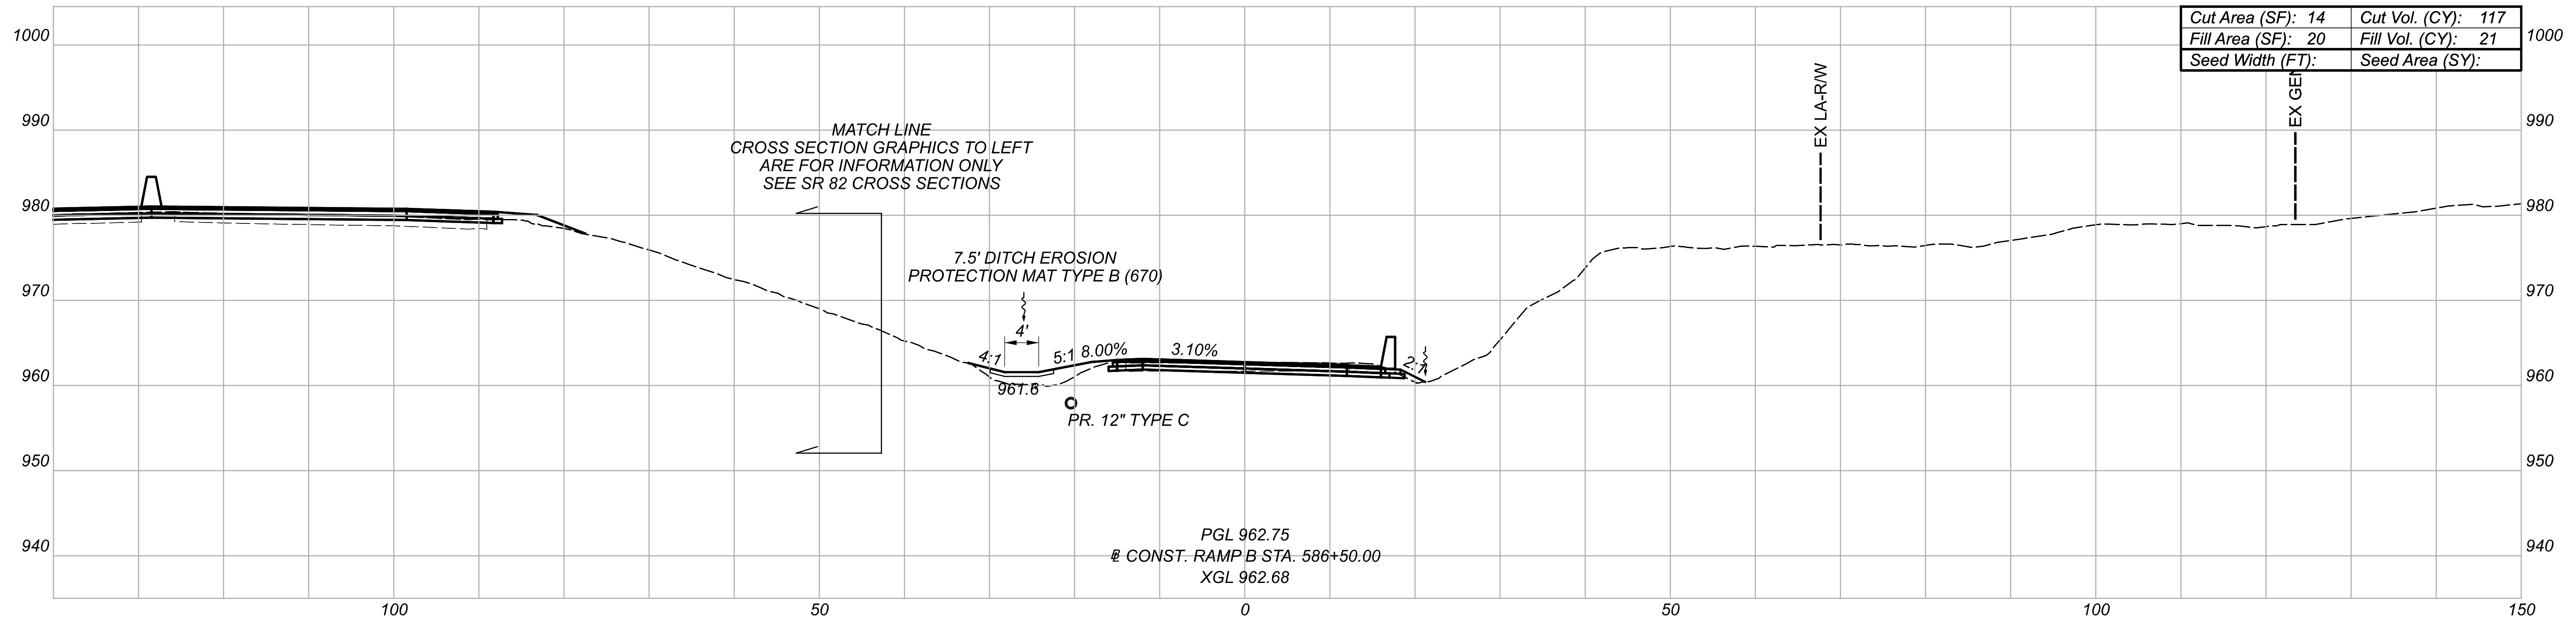

CROSS SECTIONS - BASELINE CONST. RAMP B
 STA. 586+00.00 TO STA. 586+50.00

DESIGN AGENCY





DESIGNER
 MJL

REVIEWER
 JMB 08/19/21

PROJECT ID
 108547

Sheet Totals			108547	
Seeding	Cut	Fill	SHEET	TOTAL
•	340	29	414	704

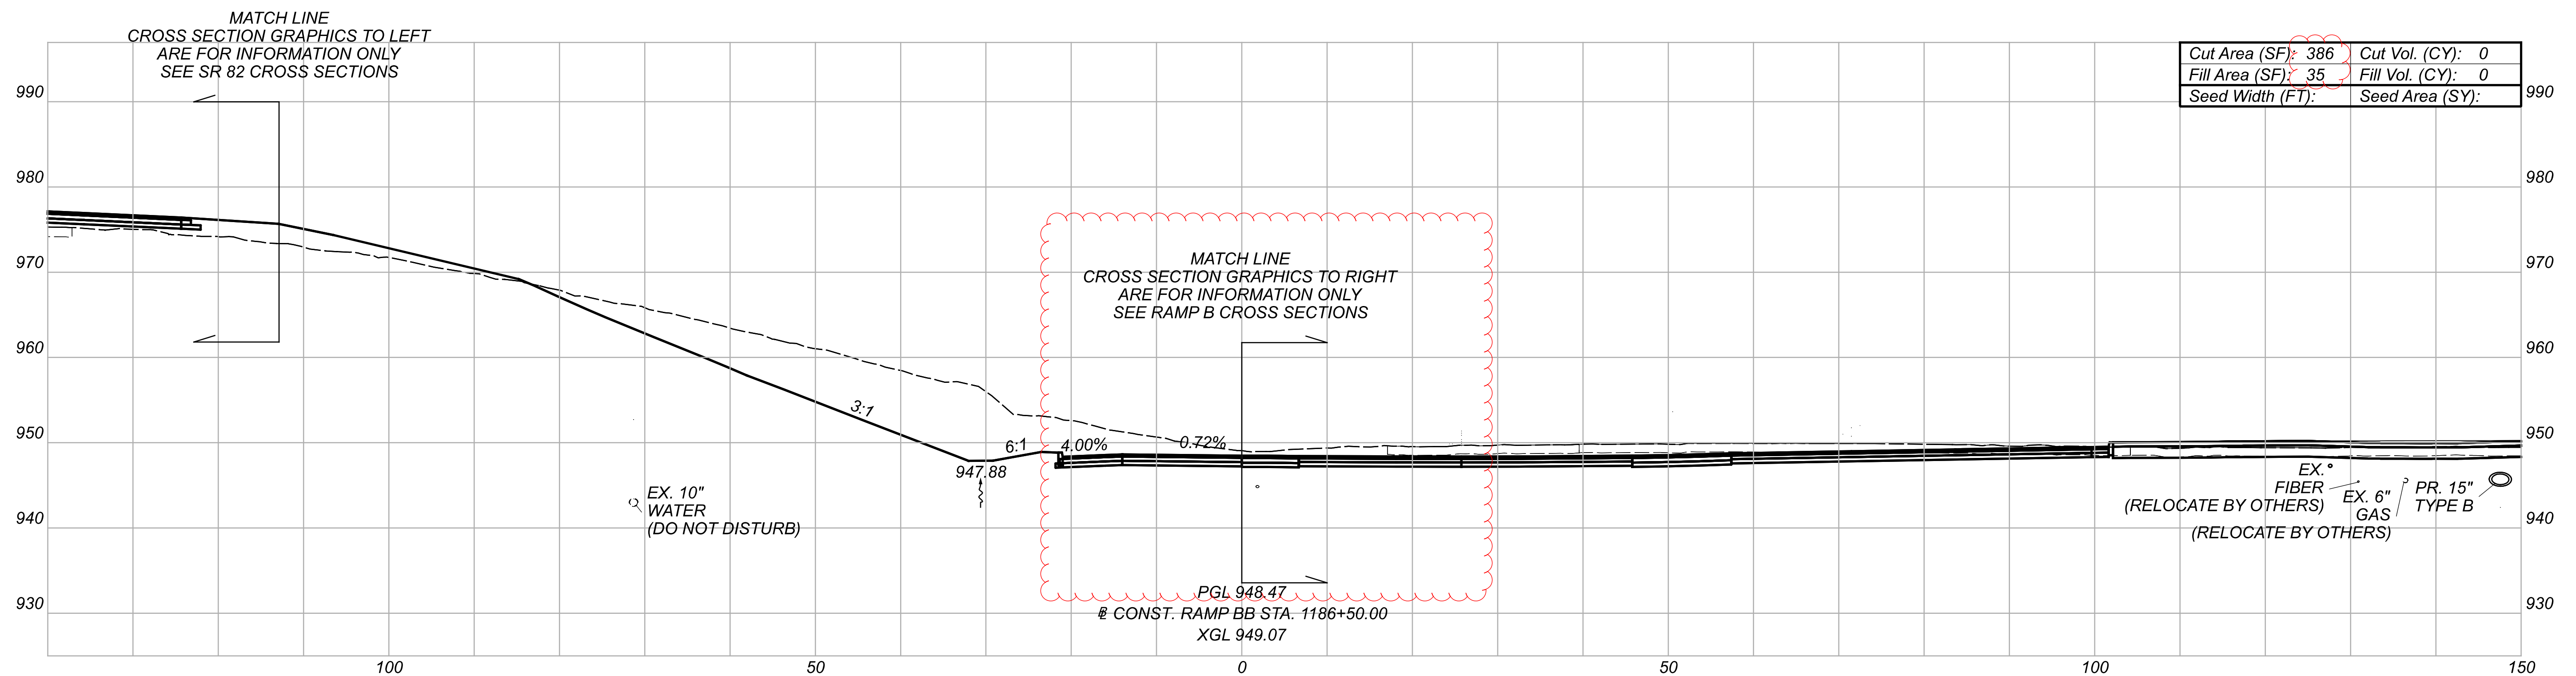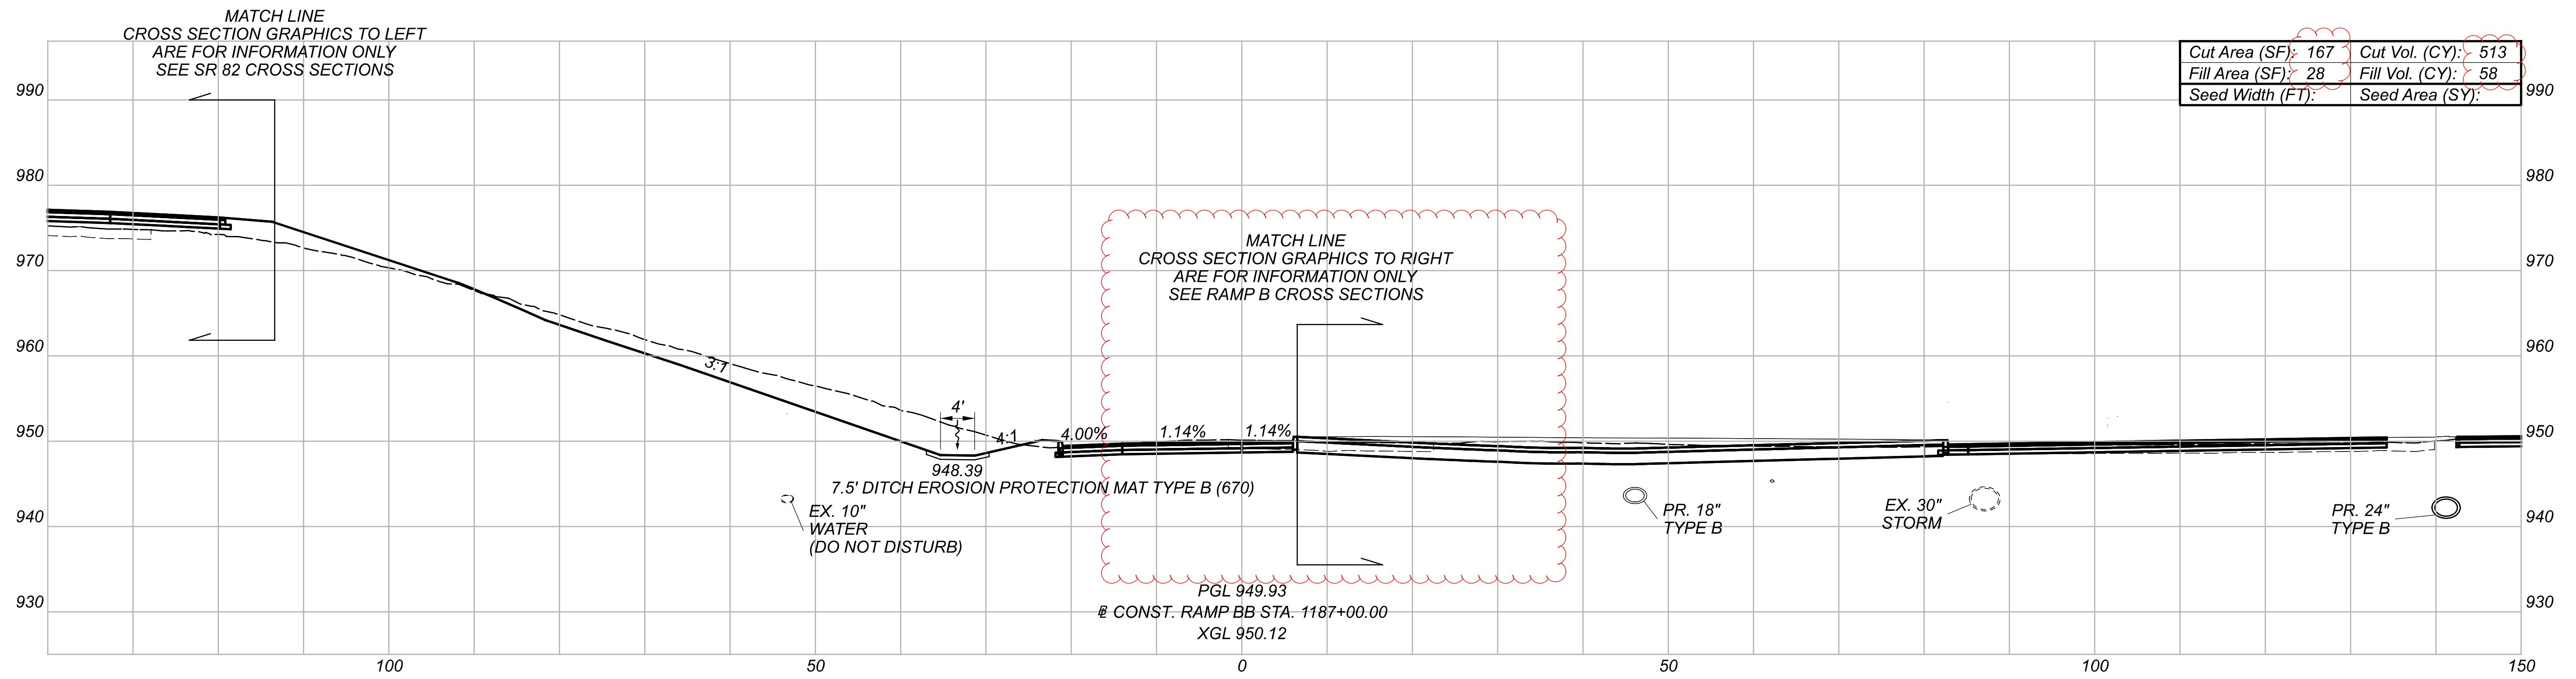

CROSS SECTIONS - BASELINE CONST. RAMP BB
STA. 1186+50.00 TO STA. 1187+00.00

DESIGN AGENCY





DESIGNER
MJL

REVIEWER
JMB 08/19/21


PROJECT ID
108547

Sheet Totals			108547
Seeding	Cut	Fill	SHEET TOTAL
513	58	425	704

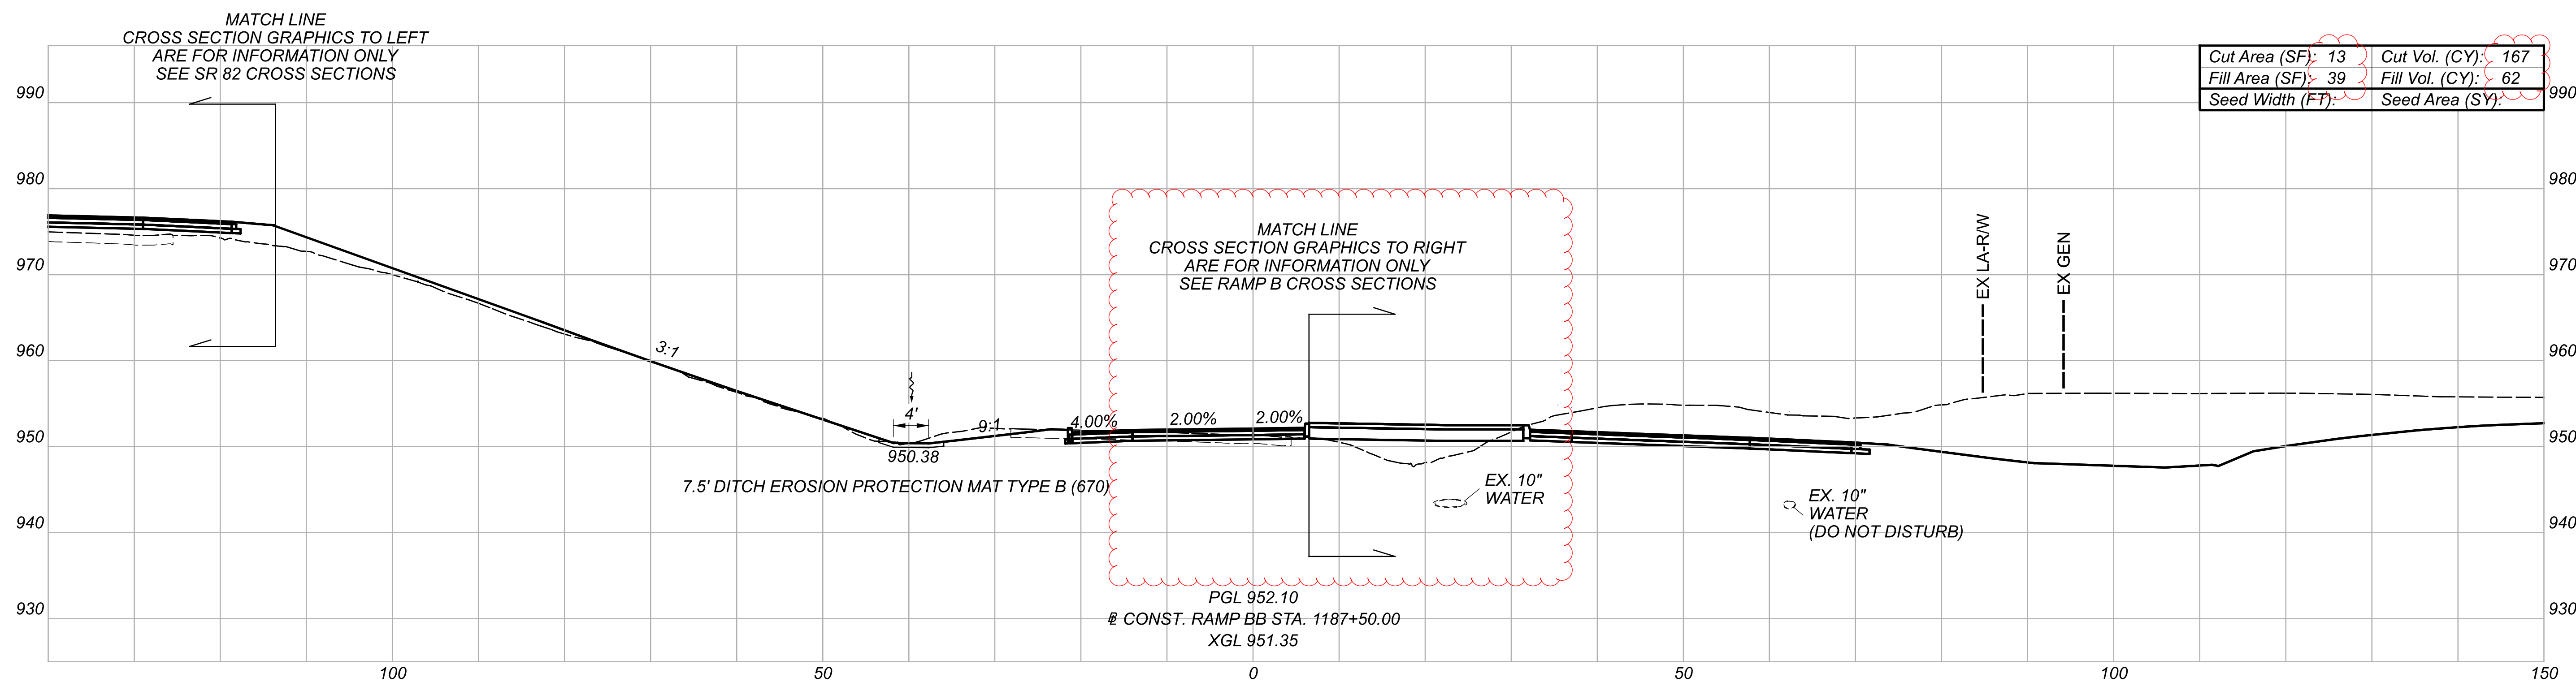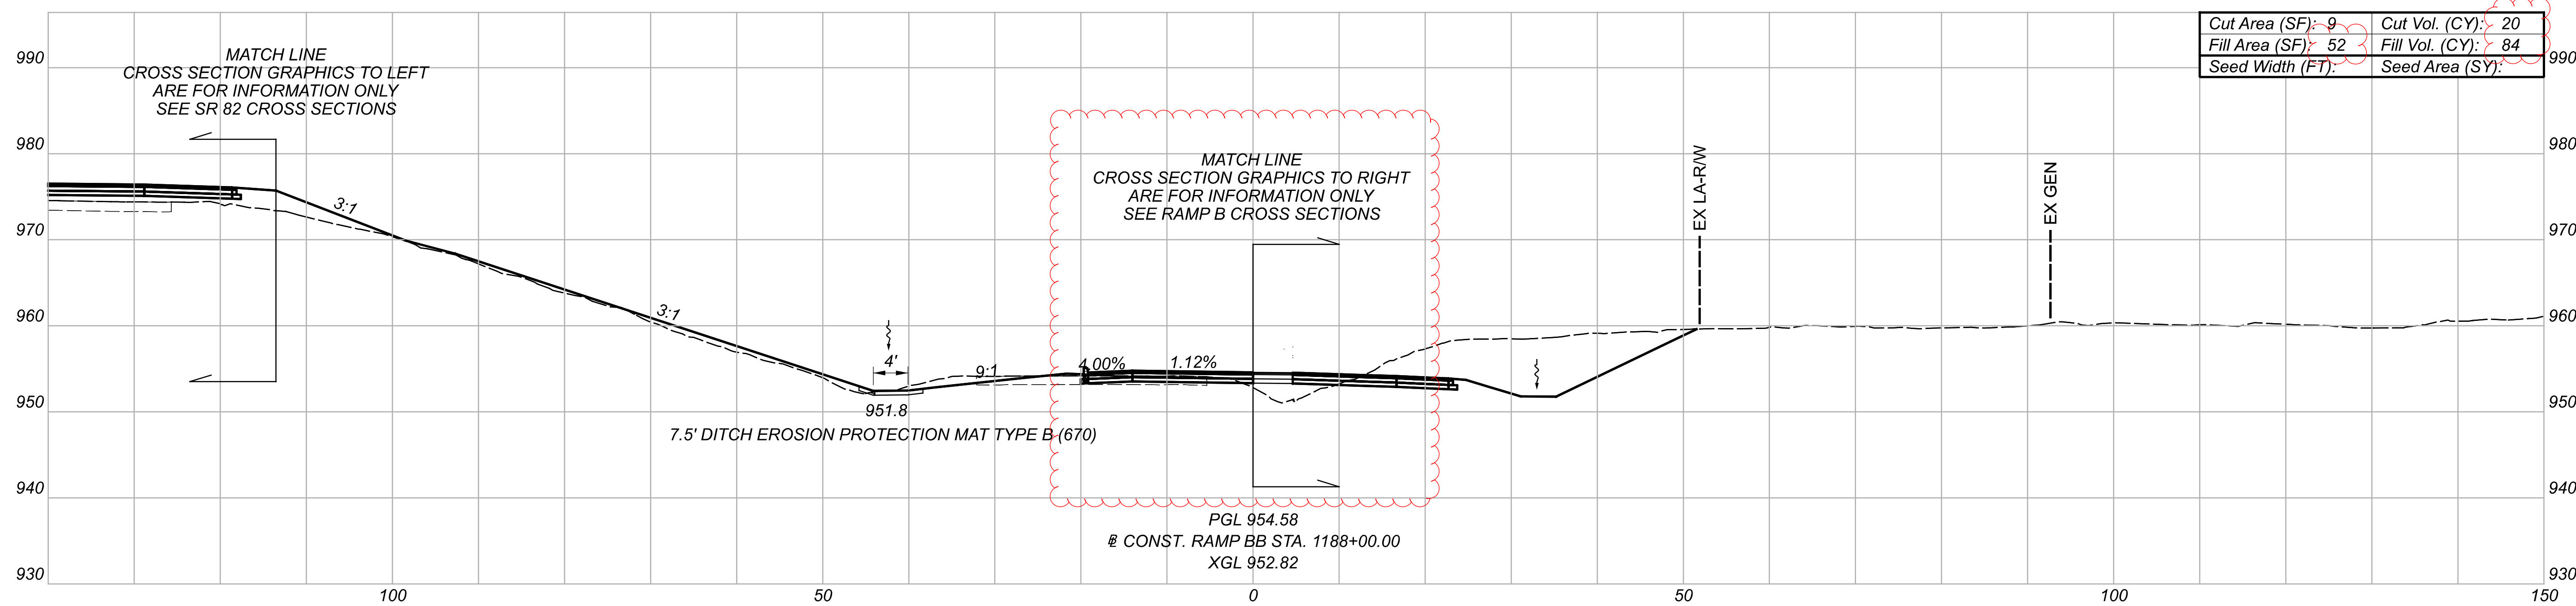

CROSS SECTIONS - BASELINE CONST. RAMP BB
 STA. 1187+50.00 TO STA. 1188+00.00

DESIGN AGENCY

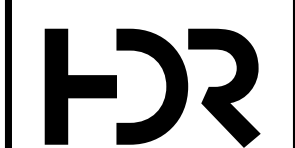


DESIGNER
MJL

REVIEWER
JMB 08/19/21

PROJECT ID
108547

Sheet Totals			SHEET	TOTAL
Seeding	Cut	Fill		
•	187	146	426	704

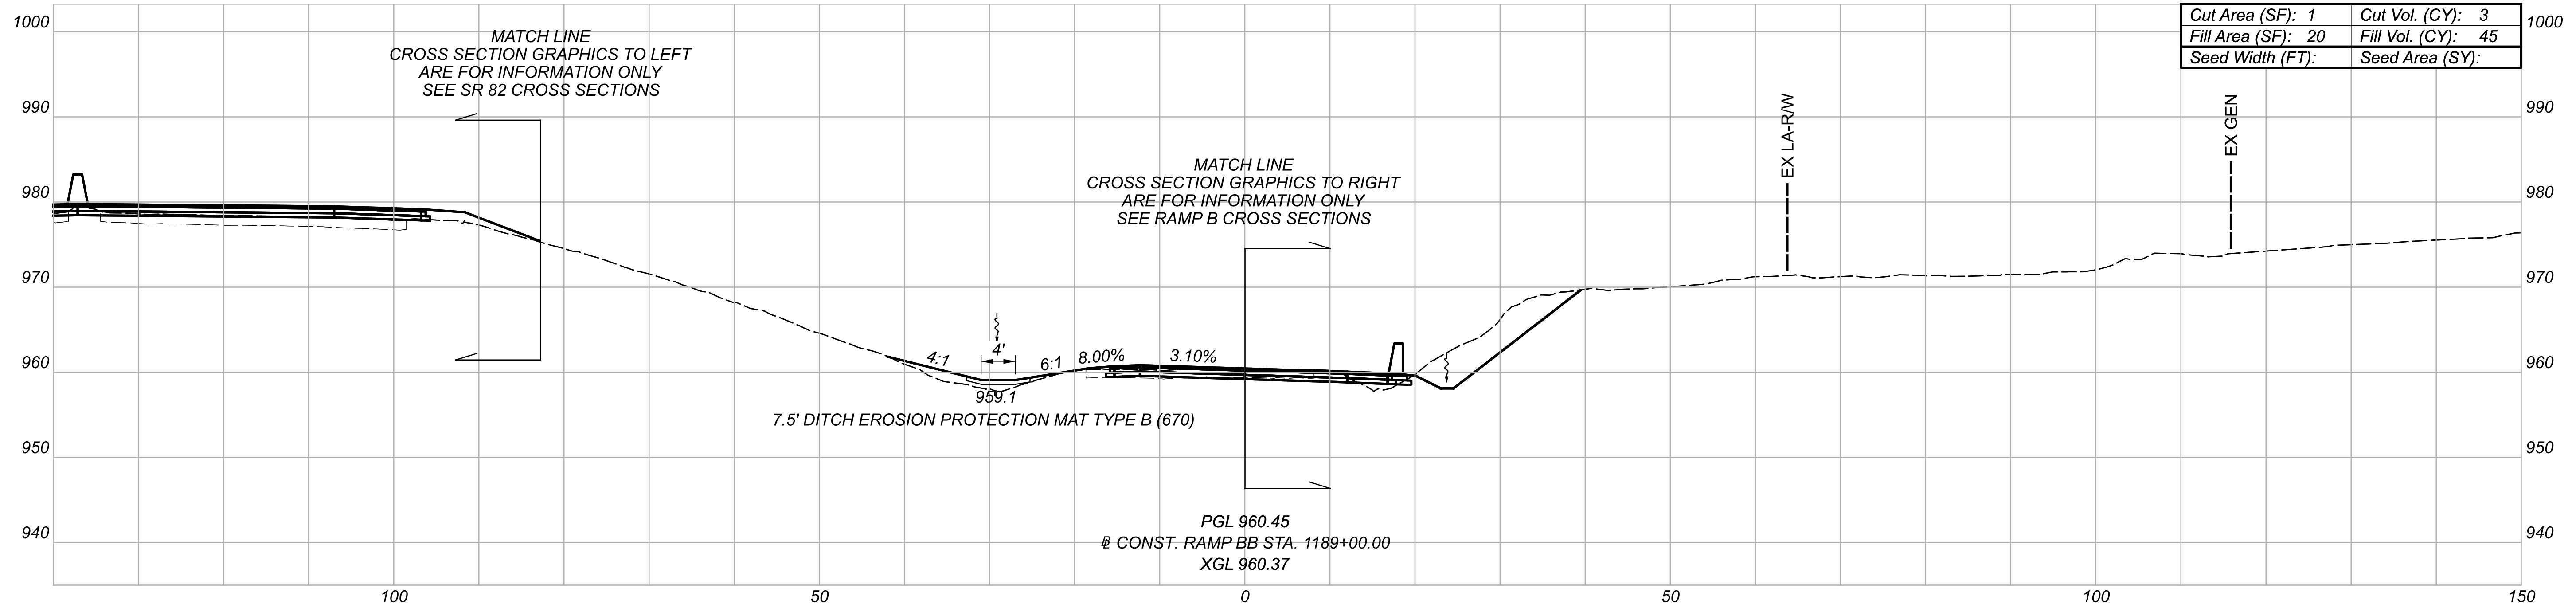

MATCH LINE
 CROSS SECTION GRAPHICS TO RIGHT
 ARE FOR INFORMATION ONLY
 SEE RAMP B CROSS SECTIONS

MATCH LINE
 CROSS SECTION GRAPHICS TO LEFT
 ARE FOR INFORMATION ONLY
 SEE SR 82 CROSS SECTIONS

7.5' DITCH EROSION PROTECTION MAT TYPE B (670)

PGL 960.45
 @ CONST. RAMP BB STA. 1189+00.00
 XGL 960.37

Cut Area (SF): 3	Cut Vol. (CY): 11
Fill Area (SF): 29	Fill Vol. (CY): 75
Seed Width (FT):	Seed Area (SY):

MATCH LINE
 CROSS SECTION GRAPHICS TO RIGHT
 ARE FOR INFORMATION ONLY
 SEE RAMP B CROSS SECTIONS

MATCH LINE
 CROSS SECTION GRAPHICS TO LEFT
 ARE FOR INFORMATION ONLY
 SEE SR 82 CROSS SECTIONS

7.5' DITCH EROSION PROTECTION MAT TYPE B (670)

PGL 957.40
 @ CONST. RAMP BB STA. 1188+50.00
 XGL 957.24

CROSS SECTIONS - BASELINE CONST. RAMP BB
 STA. 1188+50.00 TO STA. 1189+00.00

DESIGN AGENCY





DESIGNER
 MJL

REVIEWER
 JMB 08/19/21


PROJECT ID
 108547



Sheet Totals			SHEET	TOTAL
Seeding	Cut	Fill		
·	14	120	427	704

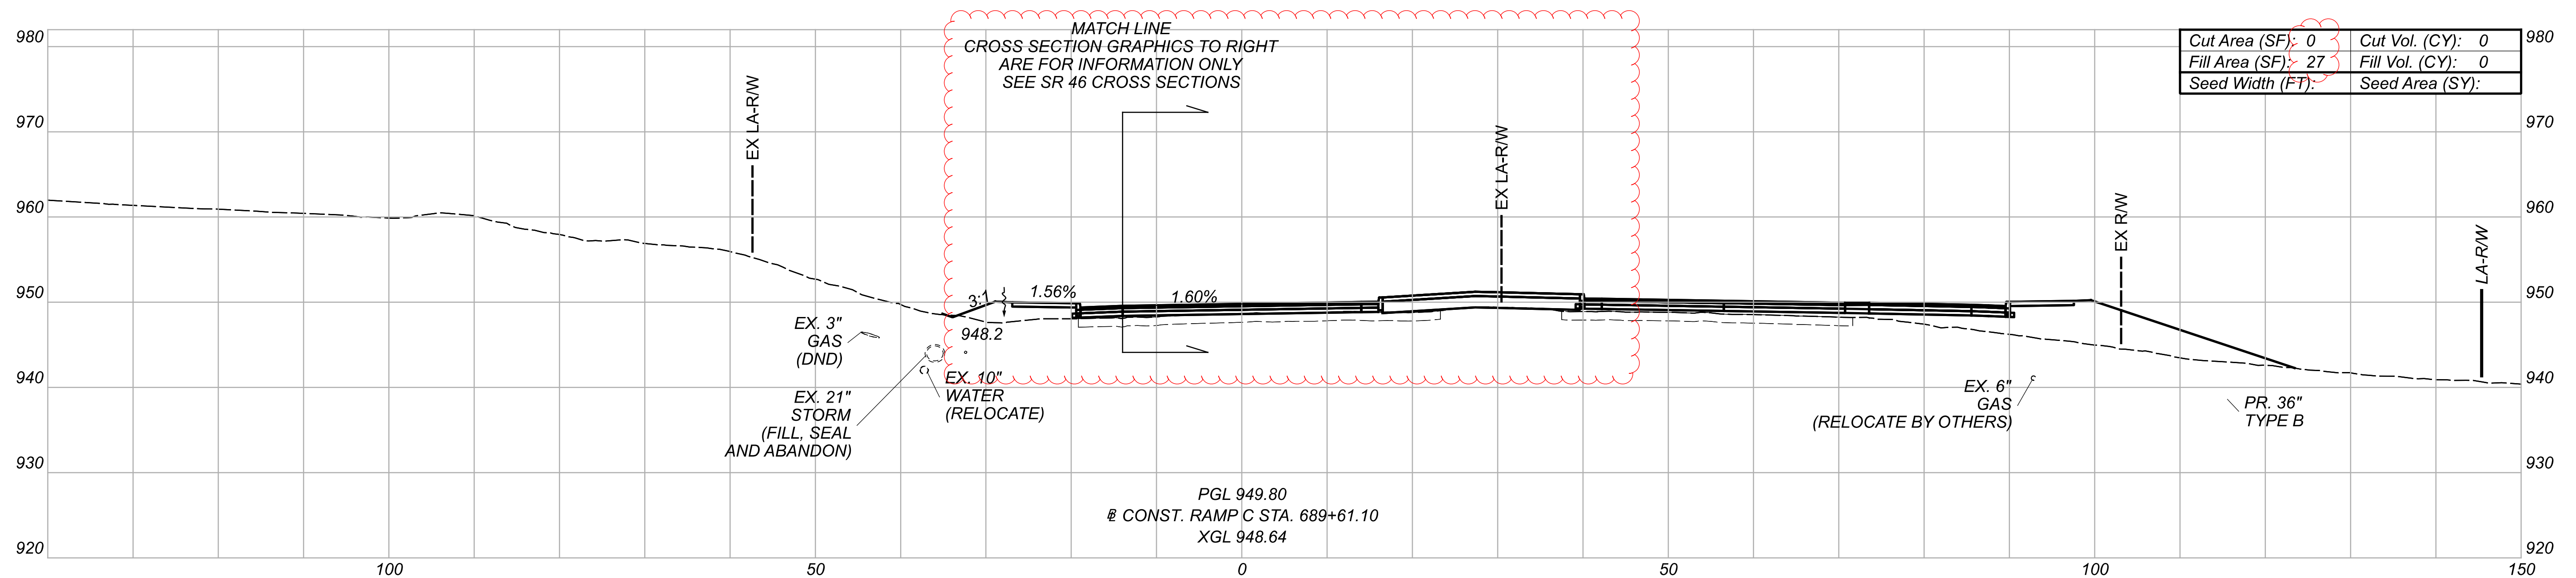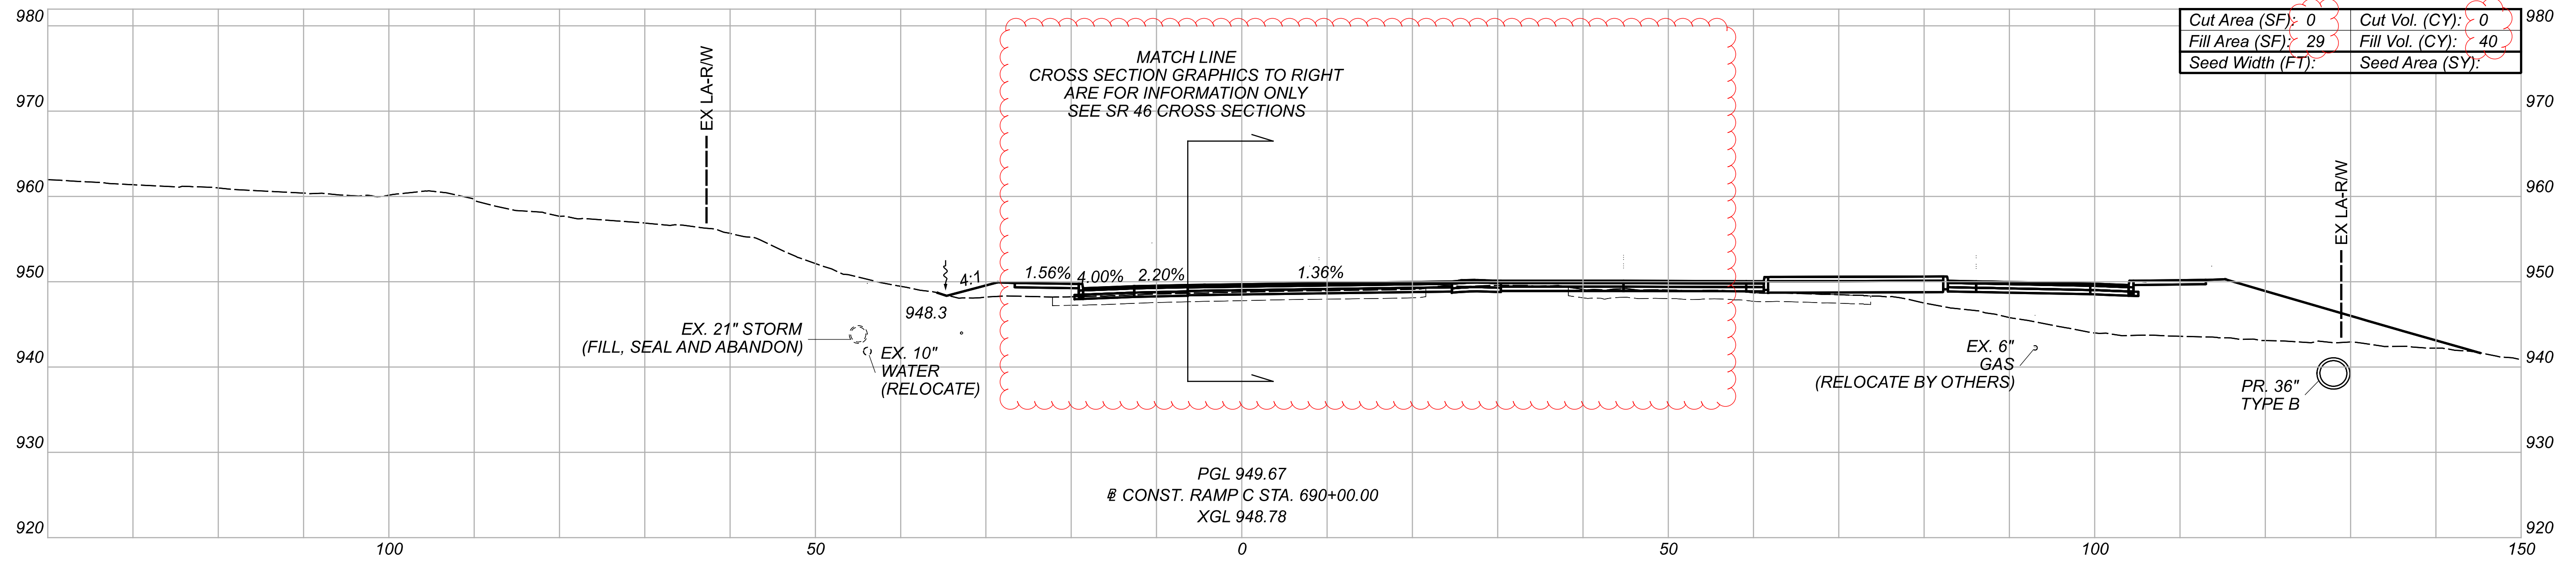

Sheet Totals			SHEET	TOTAL
Seeding	Cut	Fill		
0	0	40	429	704


CROSS SECTIONS - BASELINE CONST. RAMP C
 STA. 689+61.10 TO STA. 690+00.00

DESIGN AGENCY

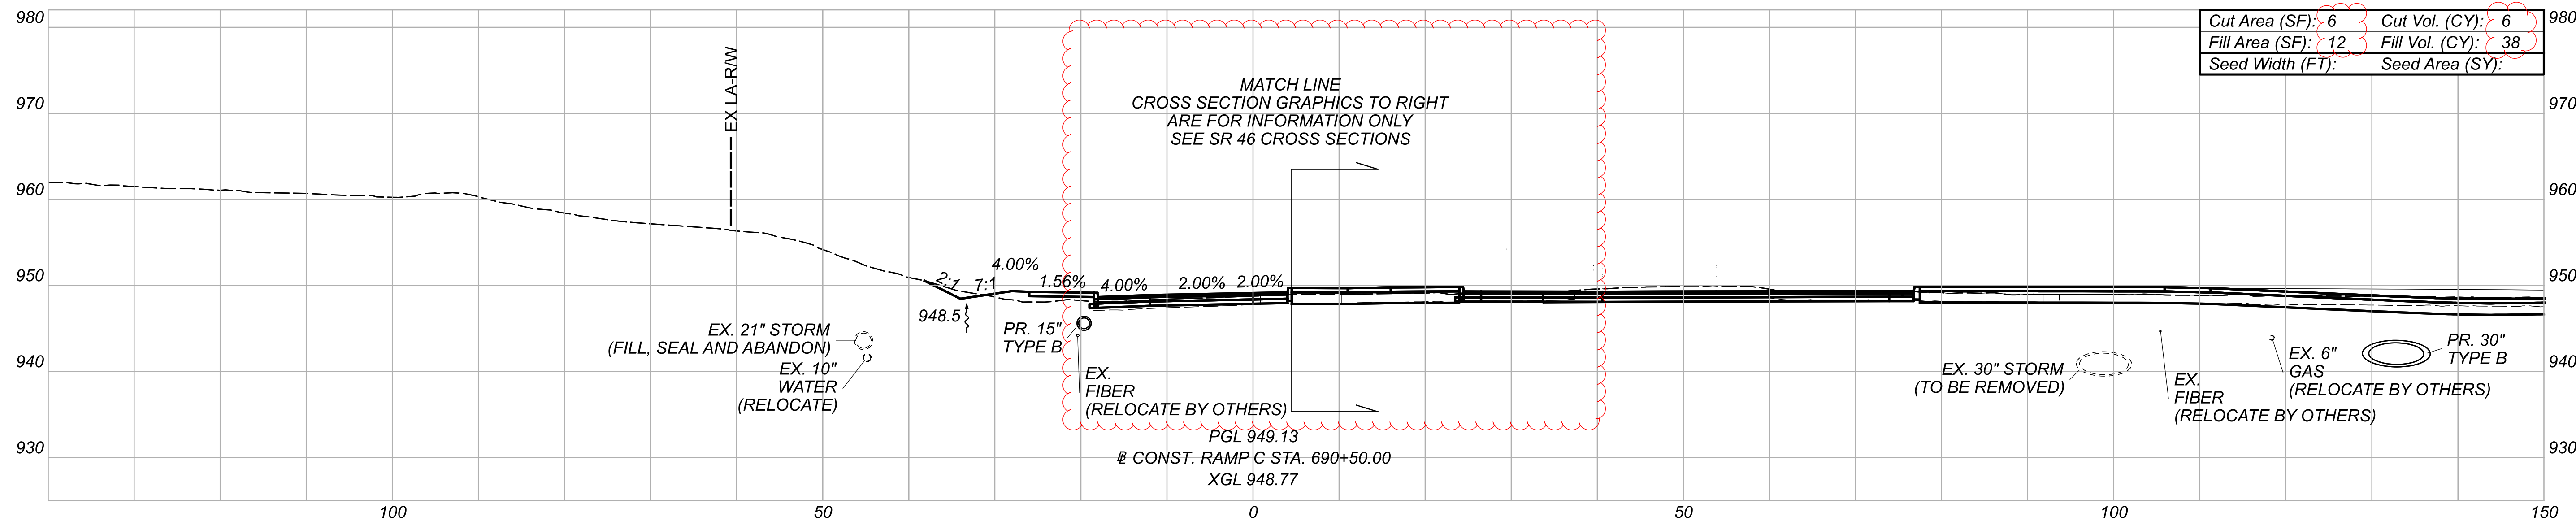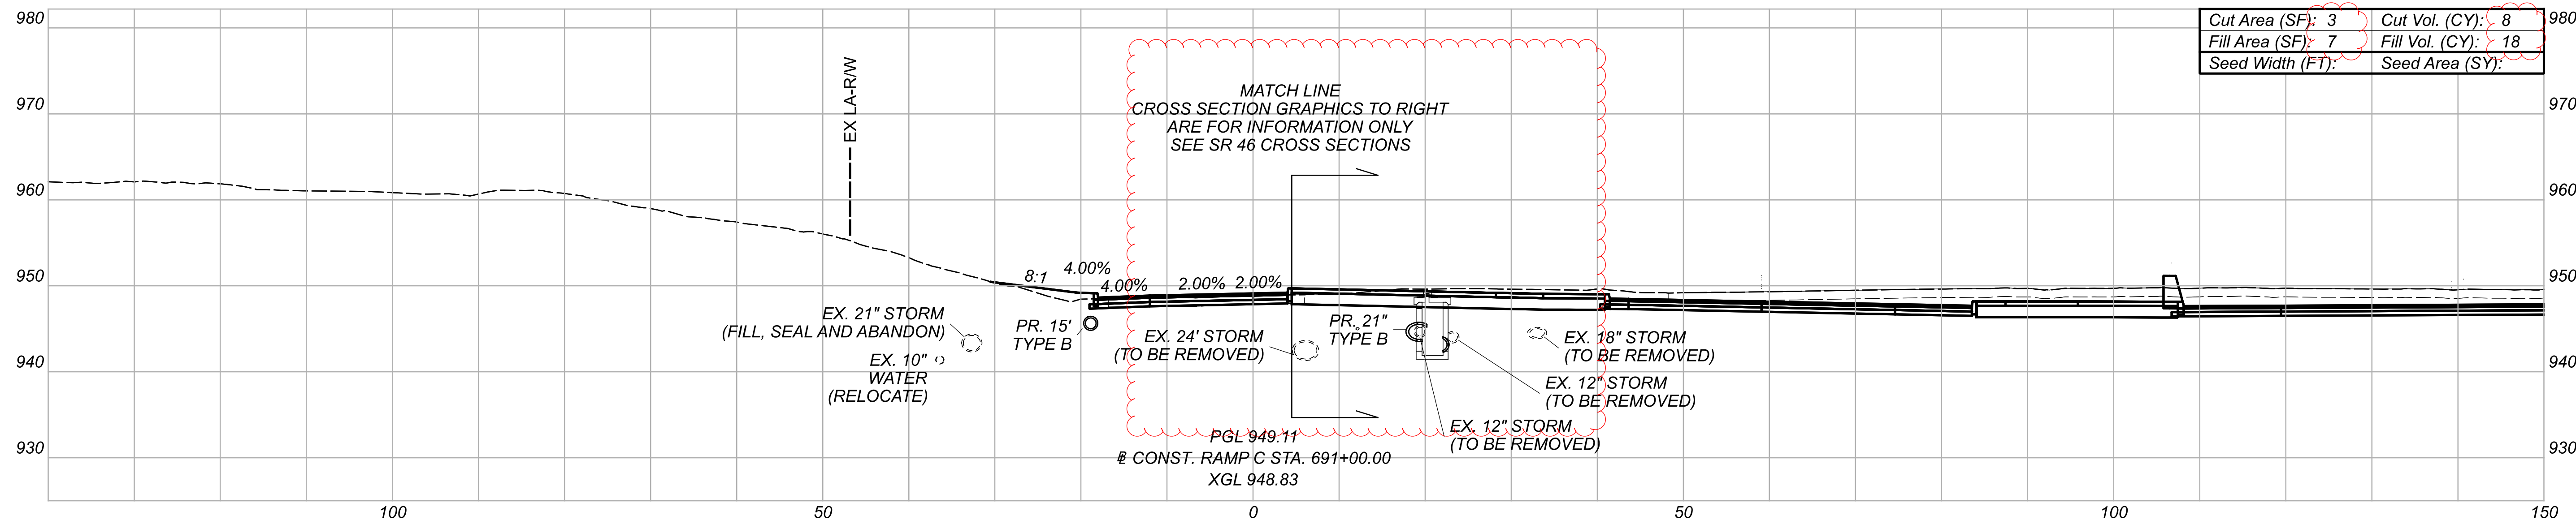 DESIGNER
 MJL
 REVIEWER
 JMB 08/19/21
 PROJECT ID
 108547



CROSS SECTIONS - BASELINE CONST. RAMP C
 STA. 690+50.00 TO STA. 691+00.00

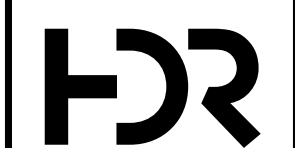DESIGN AGENCY





DESIGNER
 MJL


REVIEWER
 JMB 08/19/21

PROJECT ID
 108547

Sheet Totals			SHEET	TOTAL
Seeding	Cut	Fill		
·	14	56	430	704

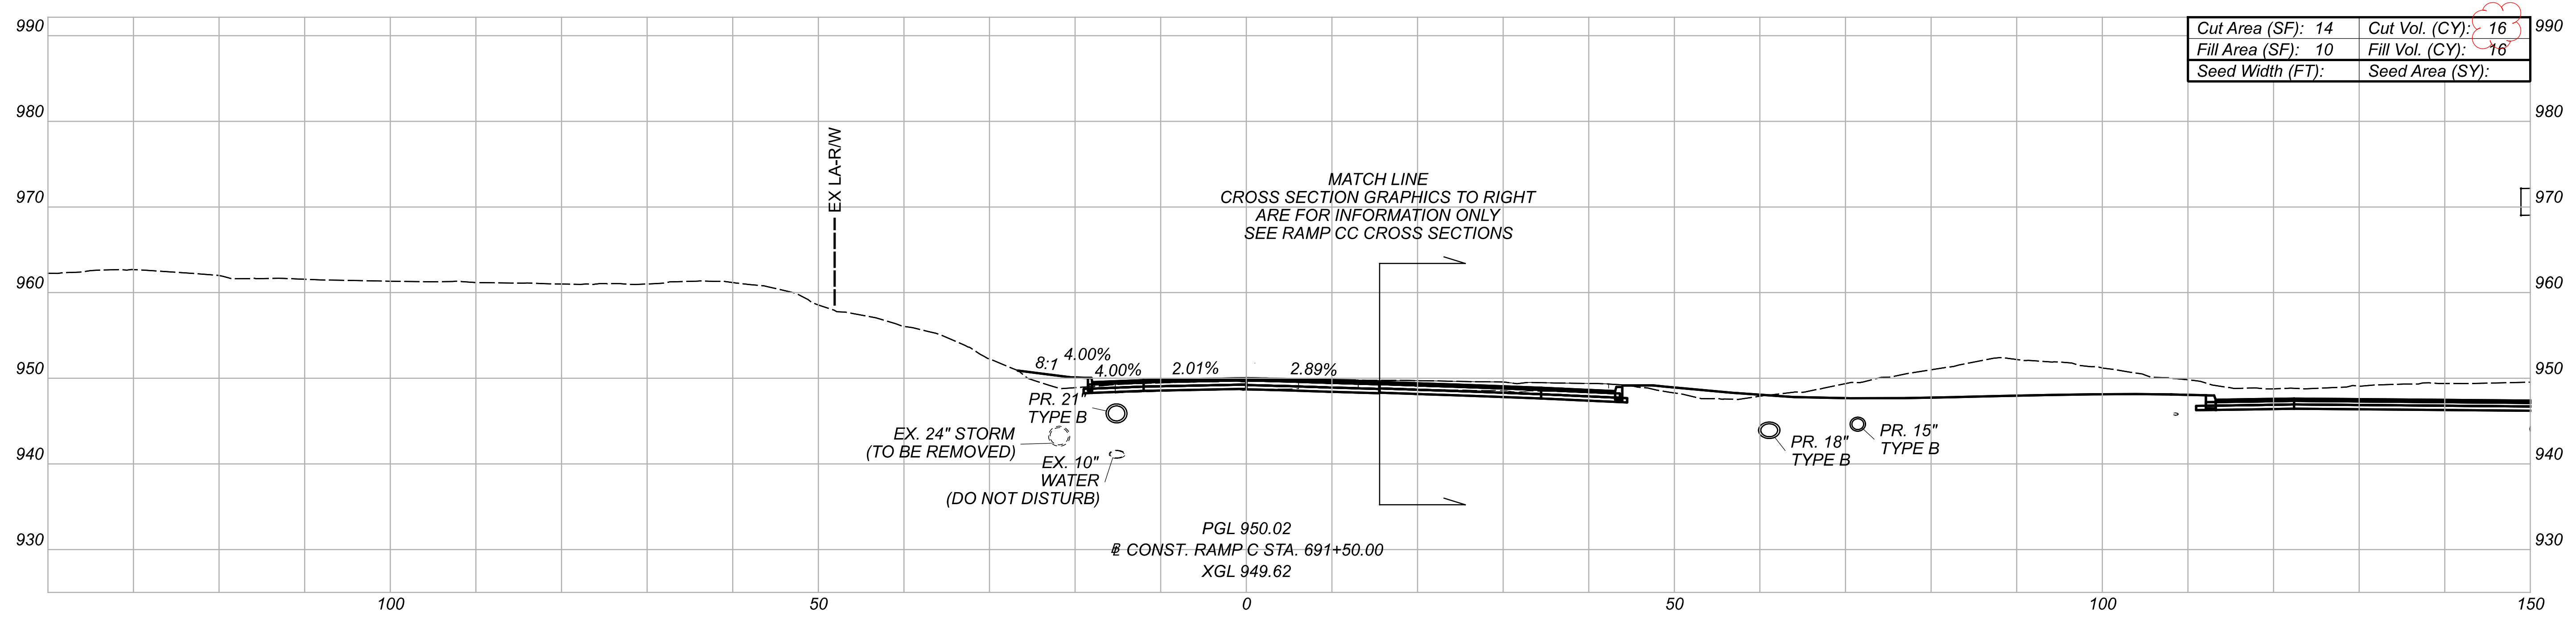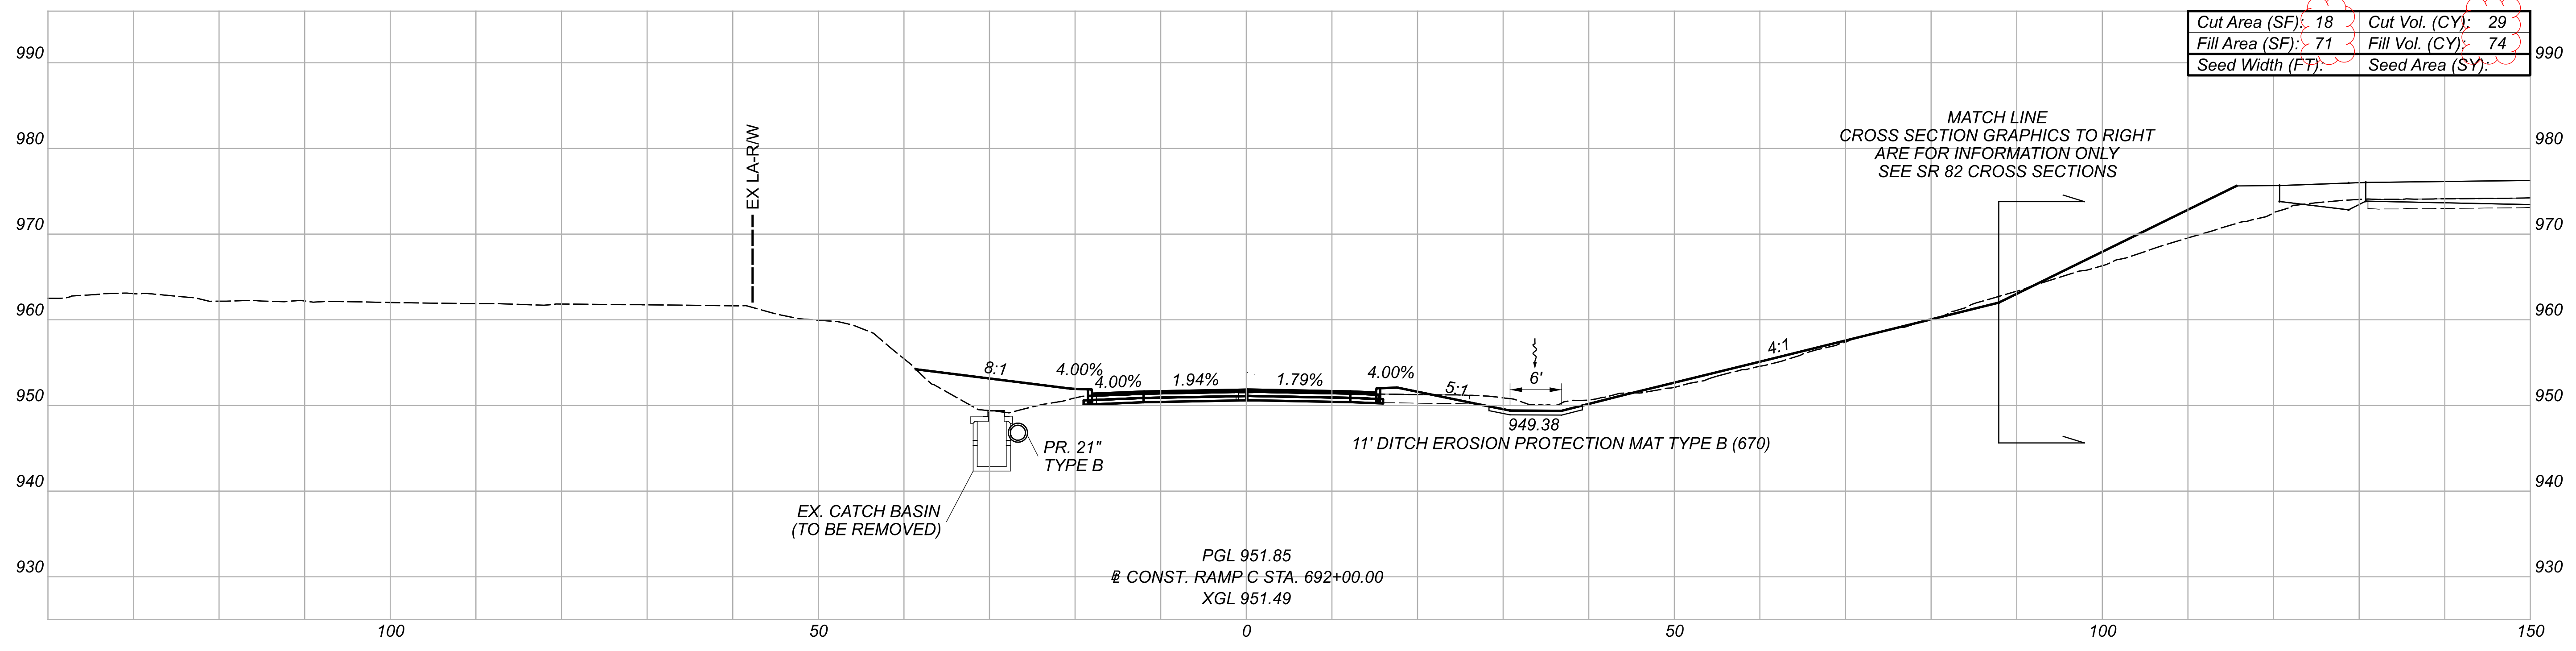


CROSS SECTIONS - BASELINE CONST. RAMP C
 STA. 691+50.00 TO STA. 692+00.00


DESIGN AGENCY

 DESIGNER
 MJL
 REVIEWER
 JMB 08/19/21
 PROJECT ID
 108547

Sheet Totals			SHEET TOTAL	
Seeding	Cut	Fill	SHEET	TOTAL
·	45	90	431	704

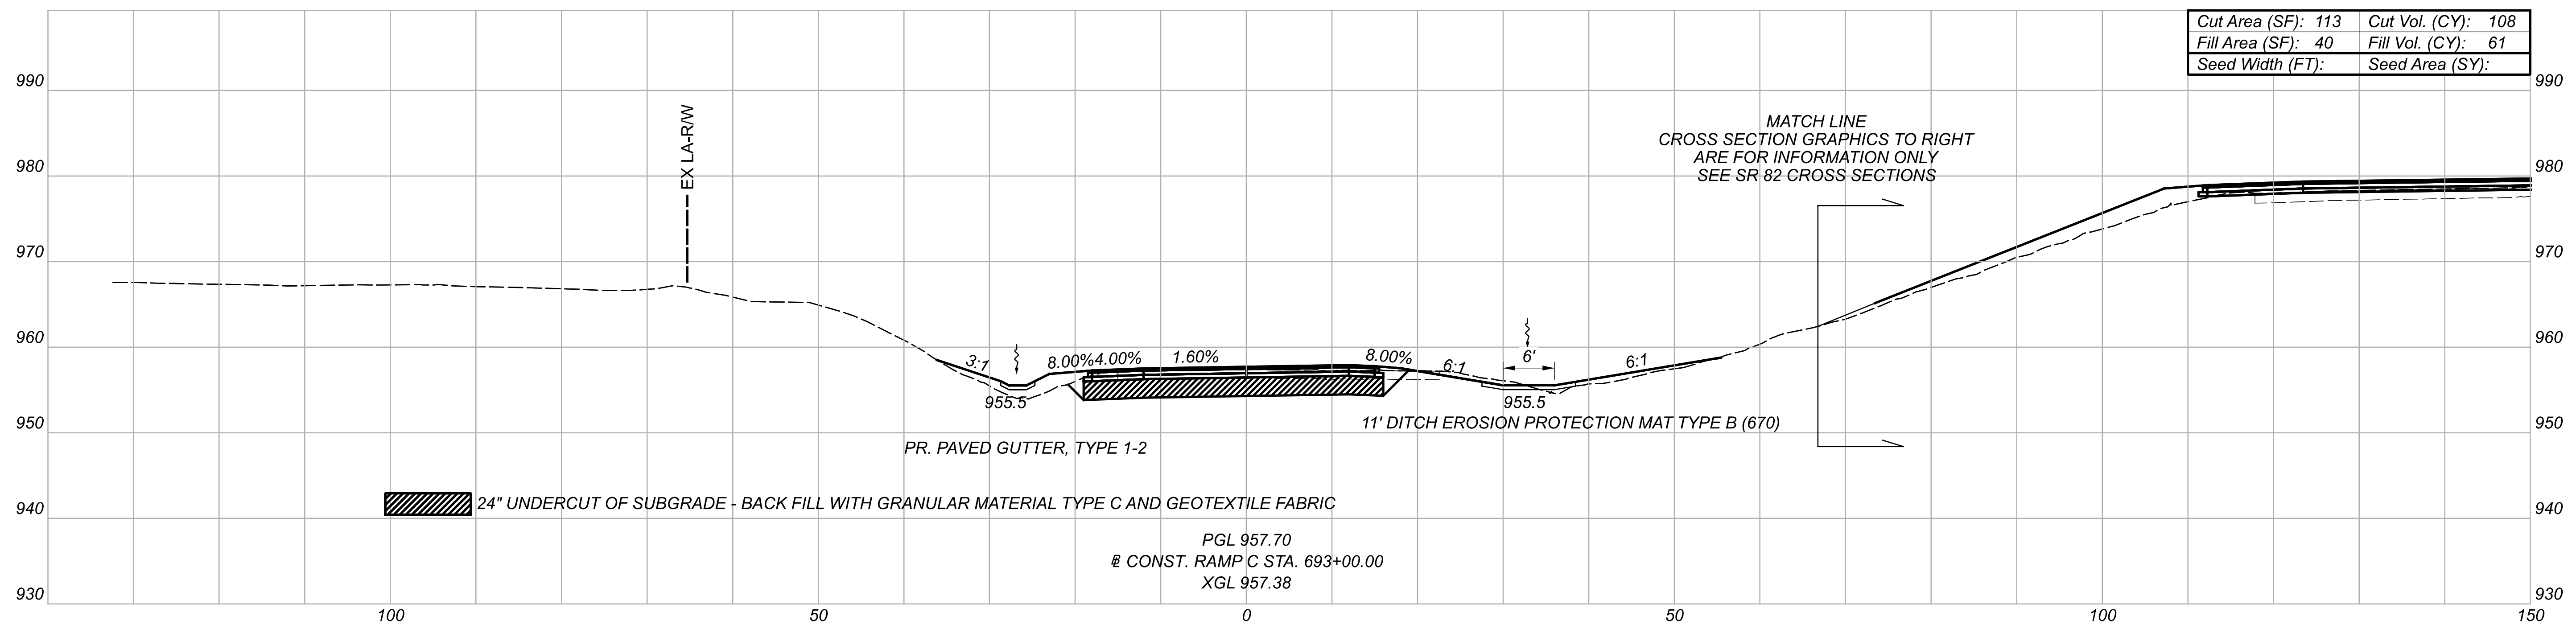TRU-46/82 DDI
 MODEL: BLP_R82C - 692+50.00 [Sheet] PAPER SIZE: 34x22 (in.) DATE: 5/4/2023 TIME: 11:35:53 PM USER: TSCHOEN
 p:\pwhdr\users\tschoen\01\Documents\01\DOT\DOT_TRU-46-82\DDI\6.0_CAD_BIM\6.2_WIP\01_Design\108547_400-Engineering\Roadway\Sheets\Ramp C - Roadway Cross Sections Sheet

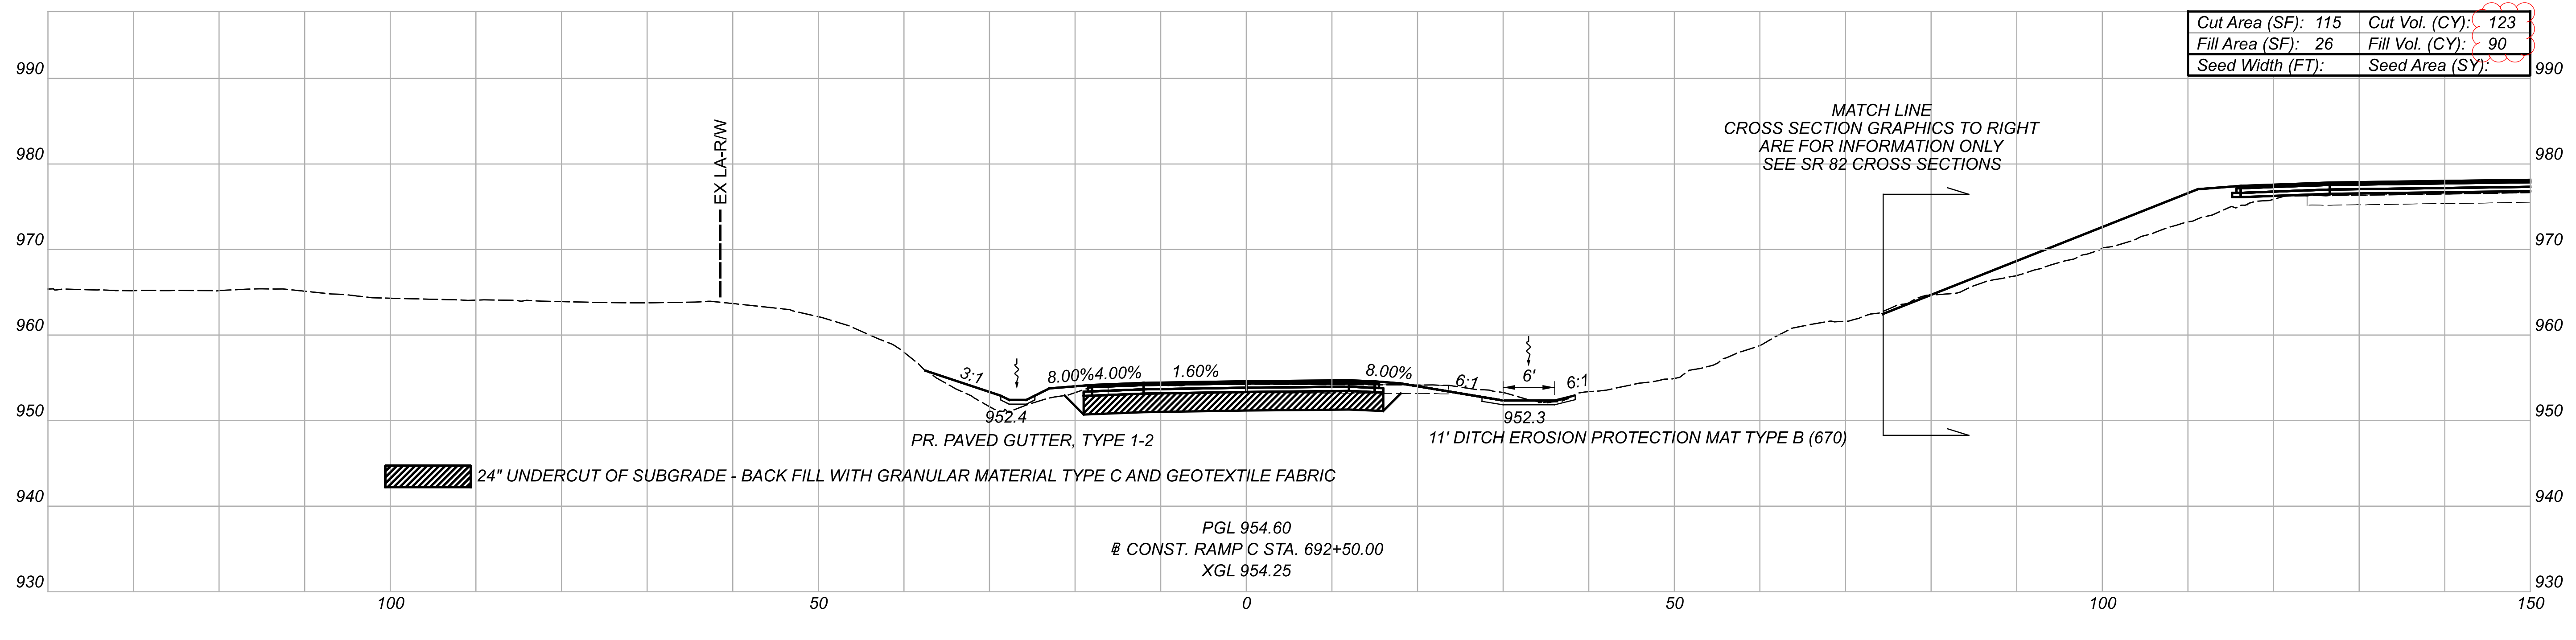

Cut Area (SF): 113	Cut Vol. (CY): 108
Fill Area (SF): 40	Fill Vol. (CY): 61
Seed Width (FT):	Seed Area (SY):



Cut Area (SF): 115	Cut Vol. (CY): 123
Fill Area (SF): 26	Fill Vol. (CY): 90
Seed Width (FT):	Seed Area (SY):

CROSS SECTIONS - BASELINE CONST. RAMP C
 STA. 692+50.00 TO STA. 693+00.00

DESIGN AGENCY





DESIGNER
MJL

REVIEWER
JMB 08/19/21

PROJECT ID
108547

Sheet Totals			108547	
Seeding	Cut	Fill	SHEET	TOTAL
•	334	151	432	704

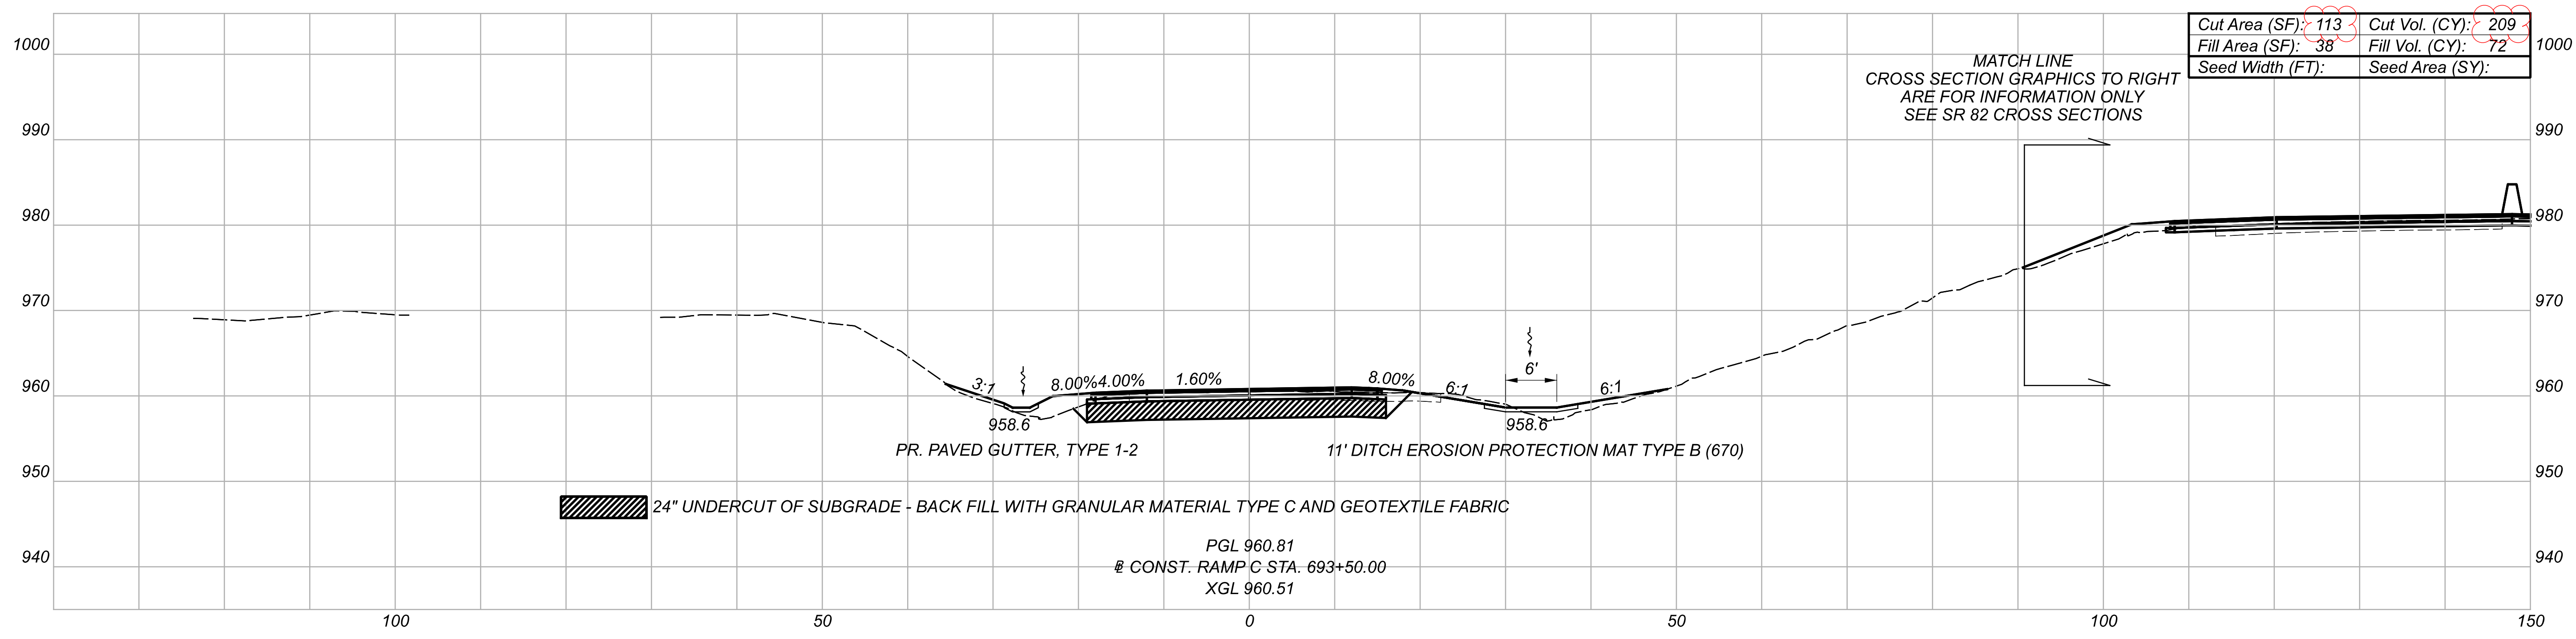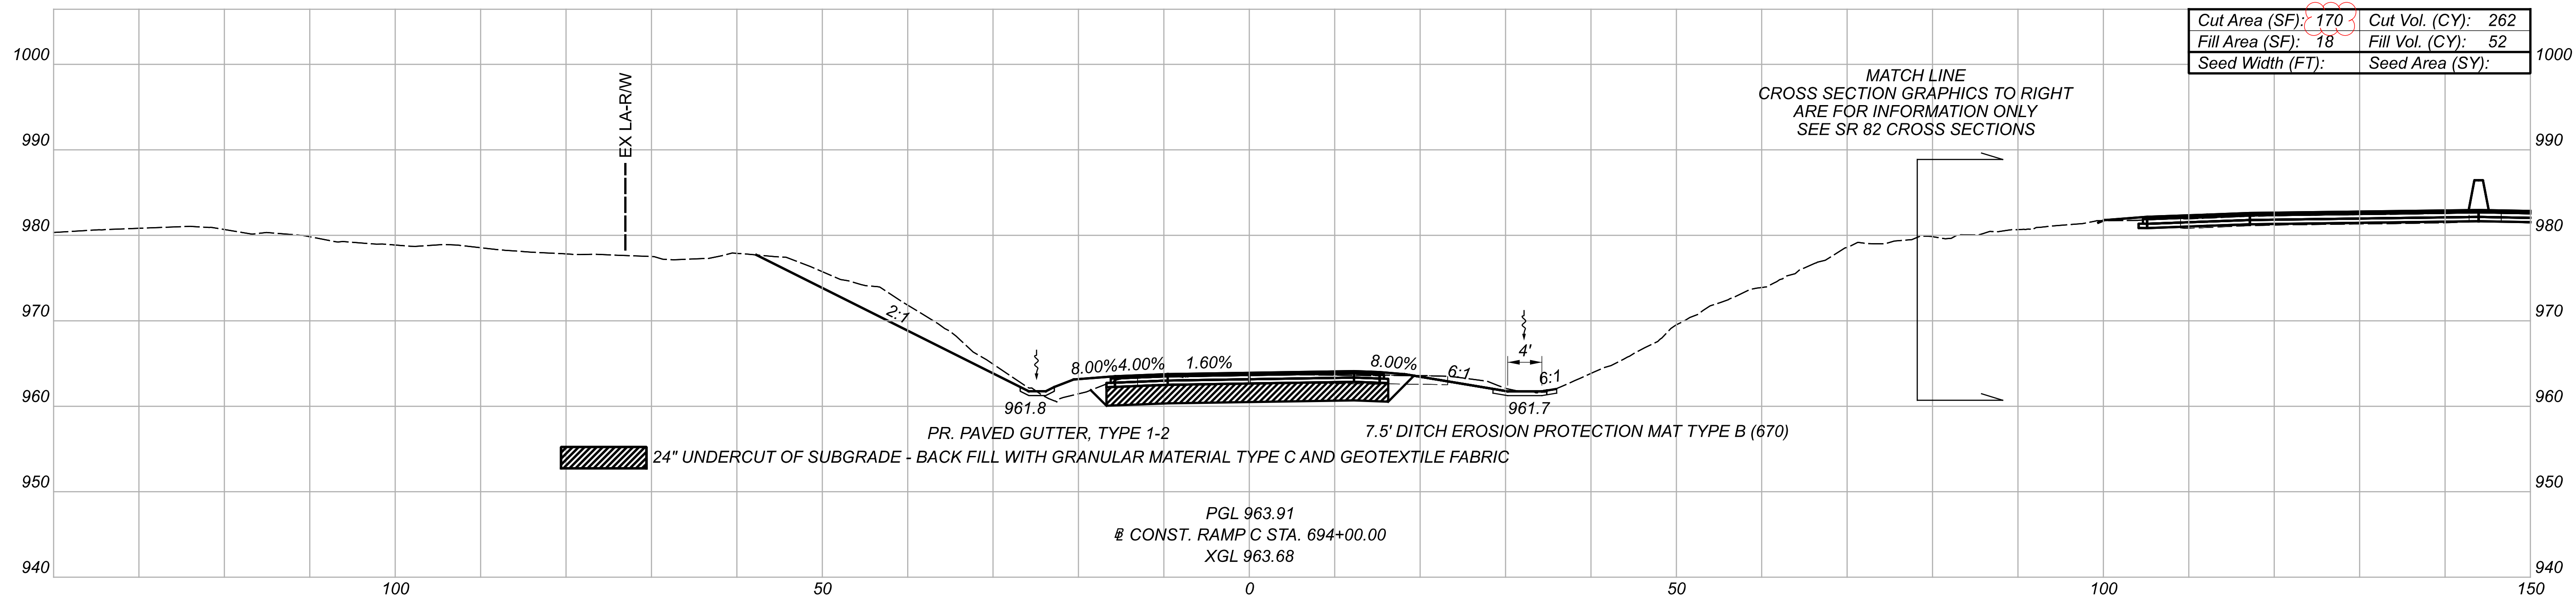

CROSS SECTIONS - BASELINE CONST. RAMP C
 STA. 693+50.00 TO STA. 694+00.00

DESIGN AGENCY





DESIGNER
 MJL

REVIEWER
 JMB 08/19/21



PROJECT ID
 108547

Sheet Totals			SHEET	TOTAL
Seeding	Cut	Fill		
.	471	124	433	704

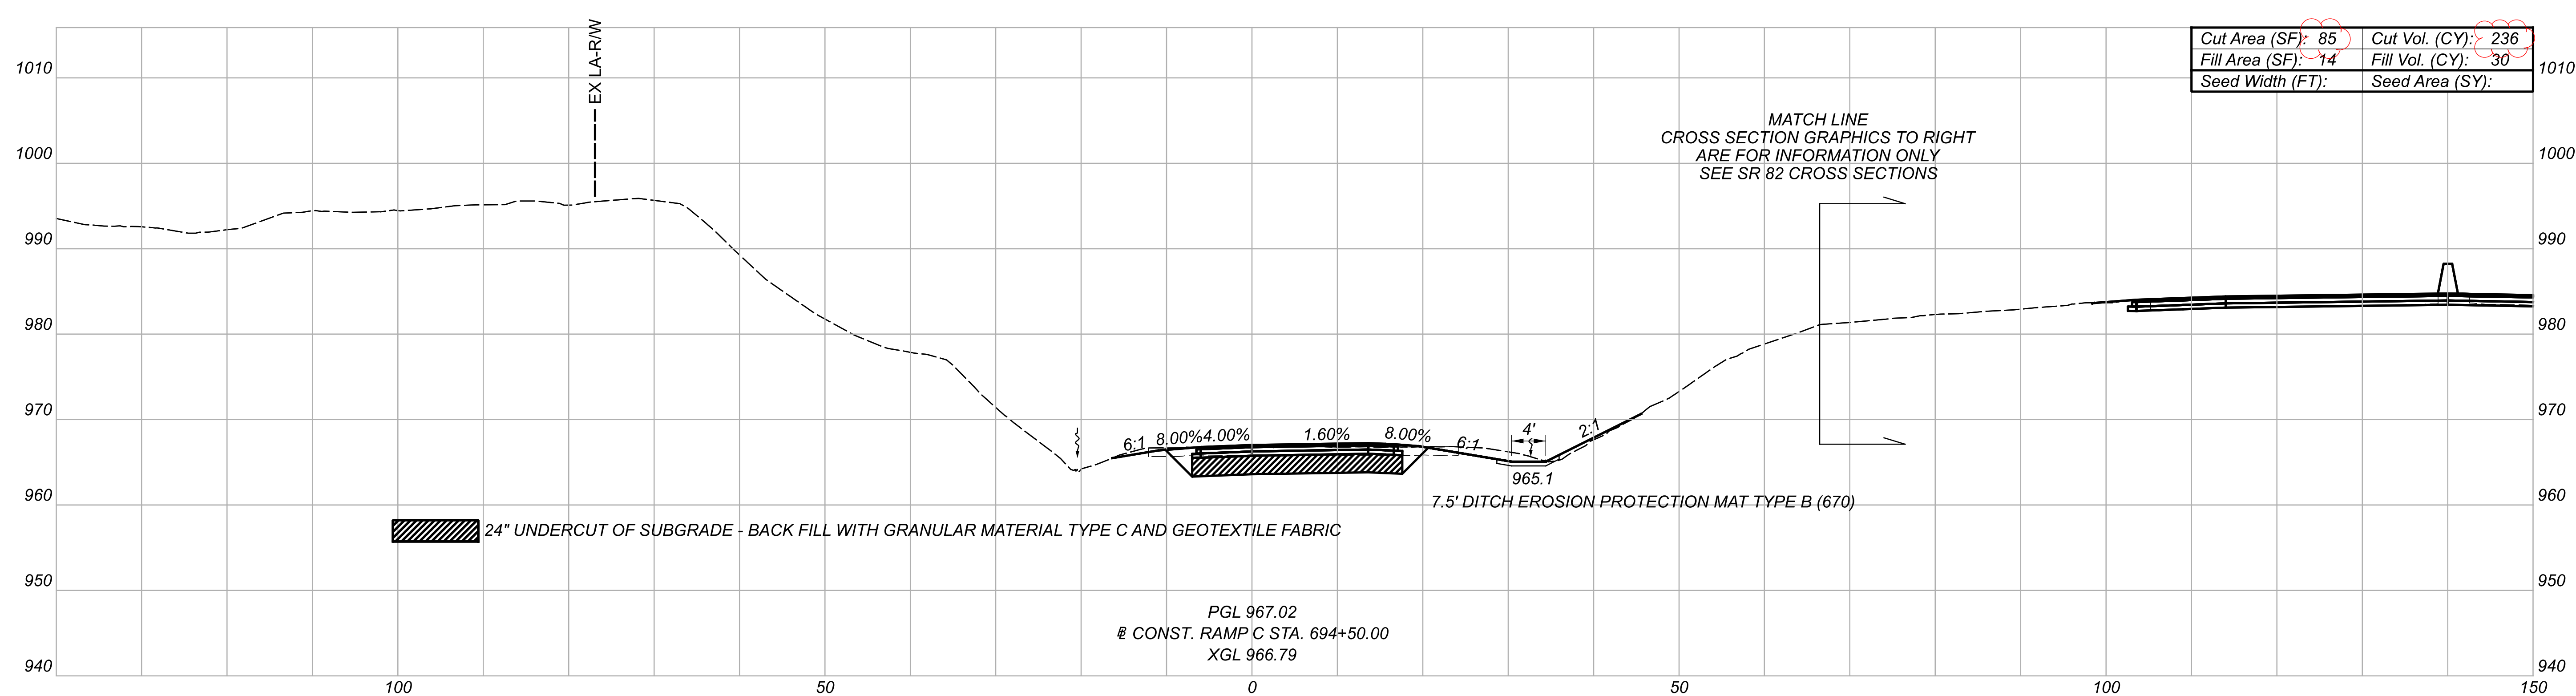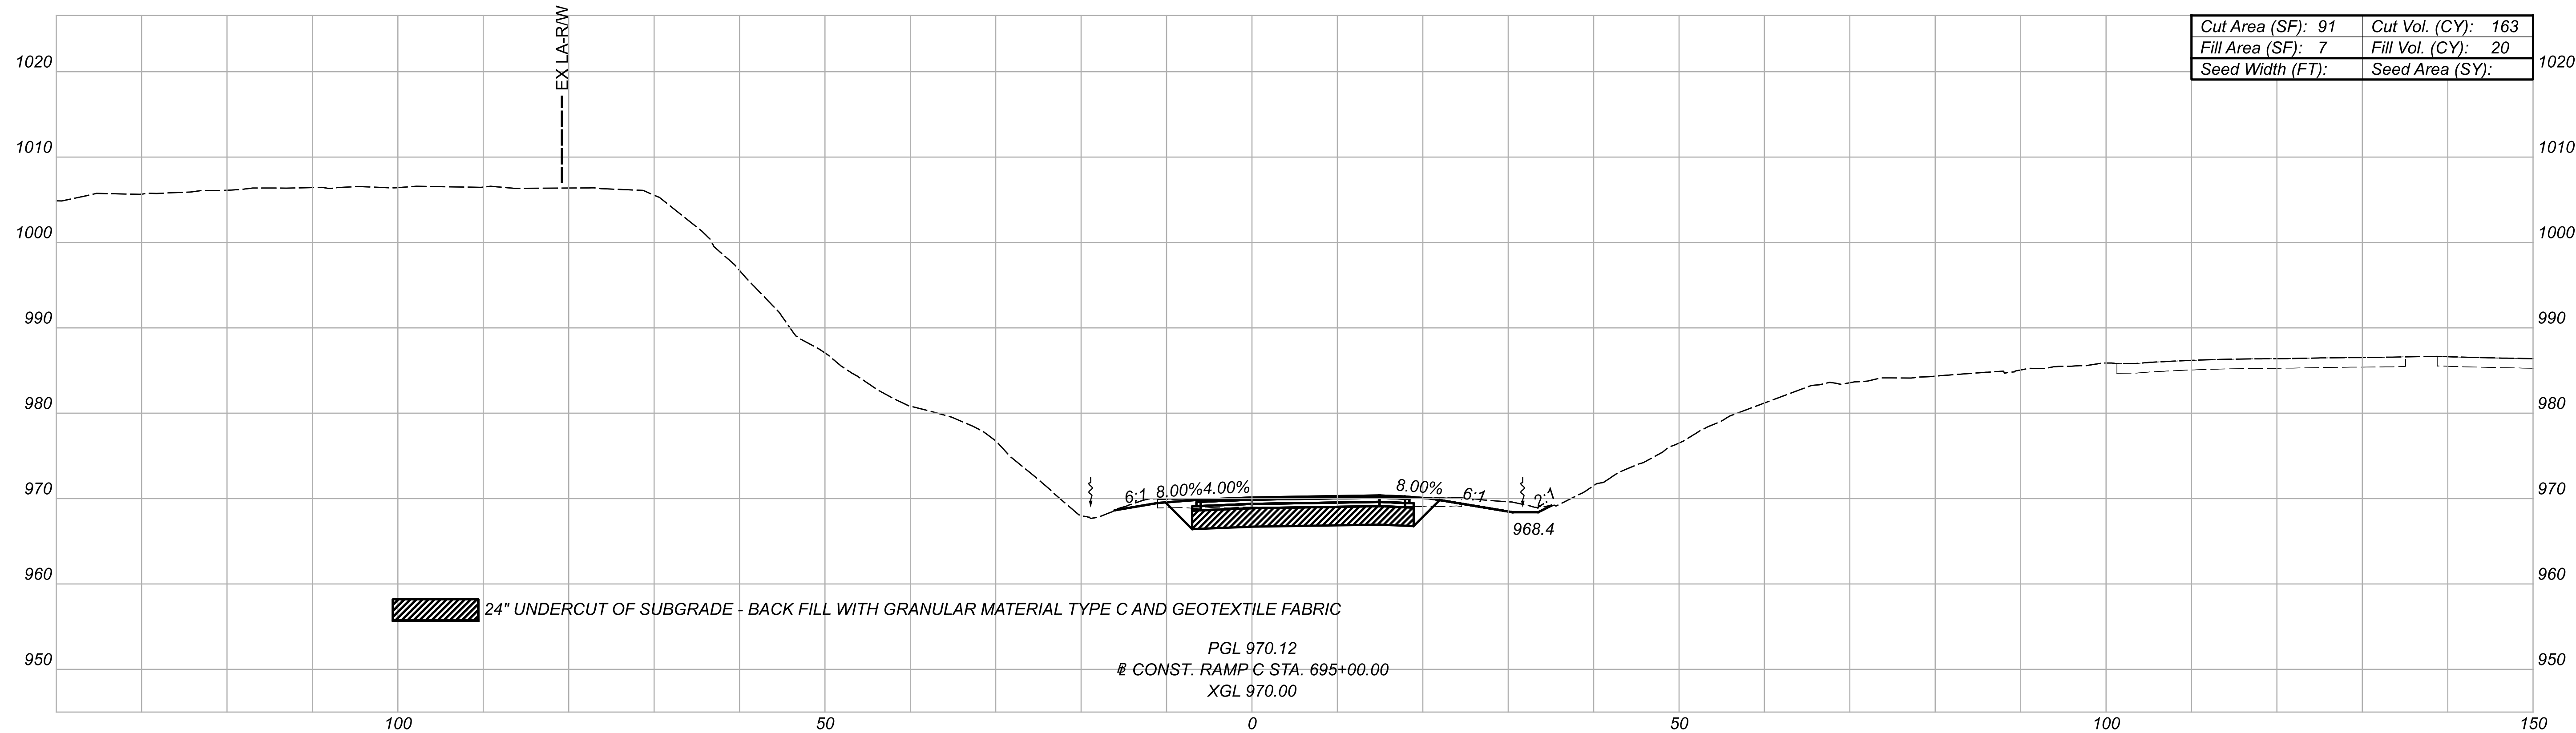

Sheet Totals			108547	
Seeding	Cut	Fill	SHEET	TOTAL
.	399	50	434	704

DESIGN AGENCY	HR
DESIGNER	MJL
REVIEWER	JMB 08/19/21
PROJECT ID	108547

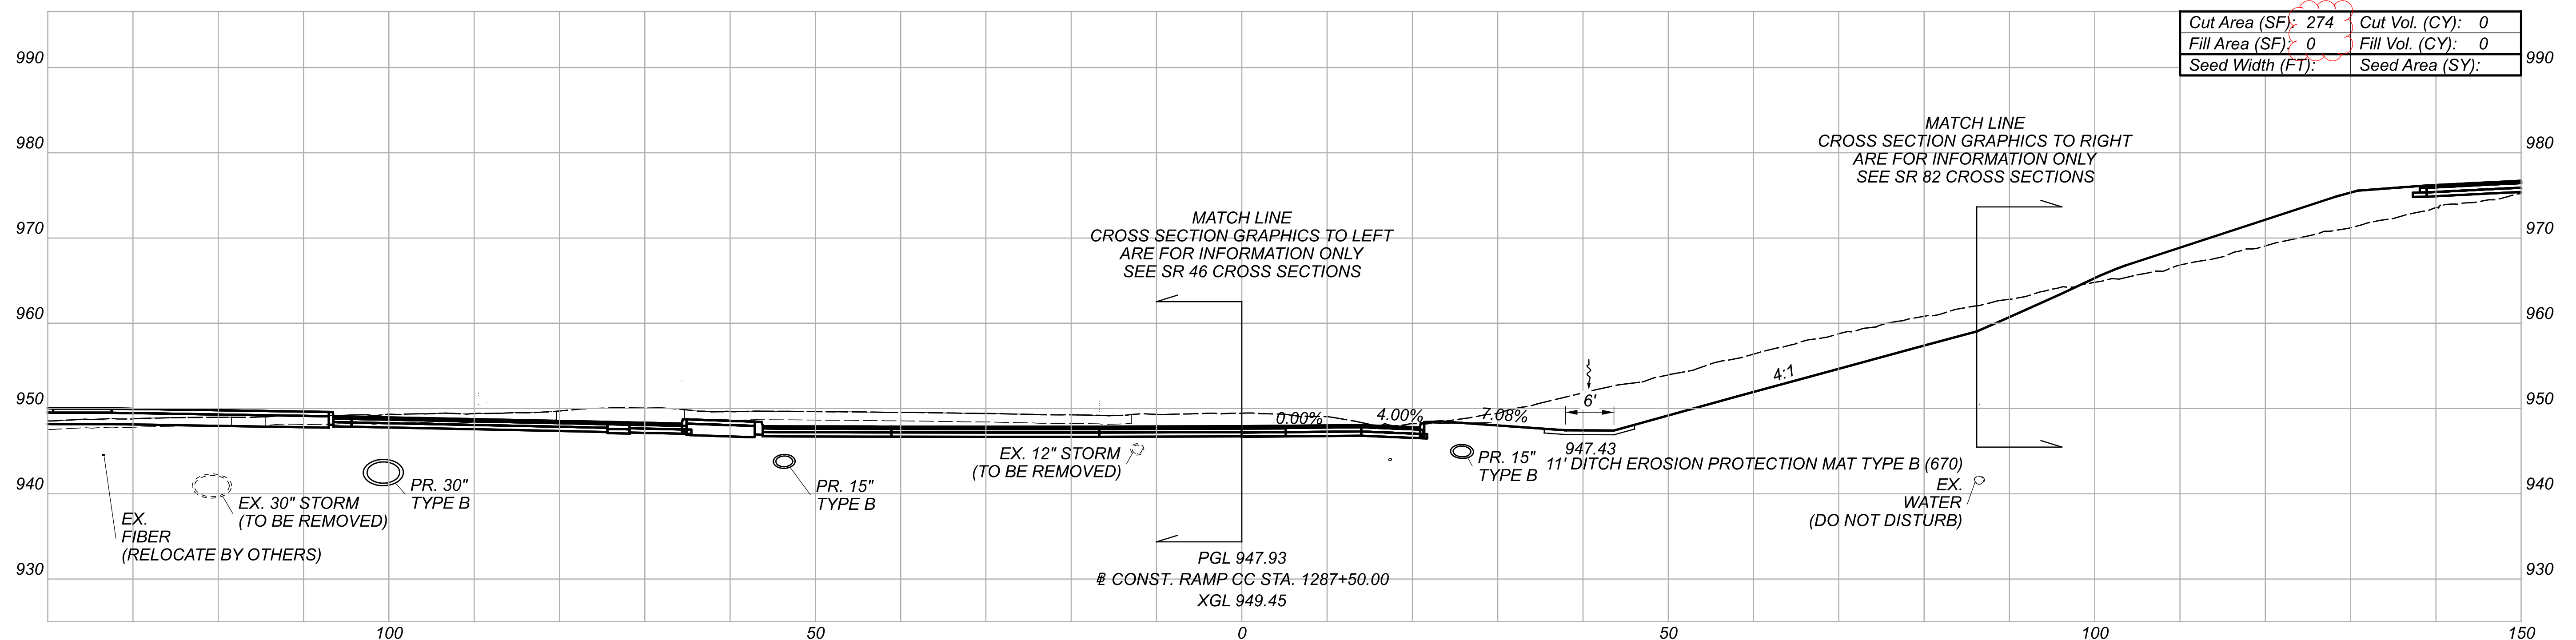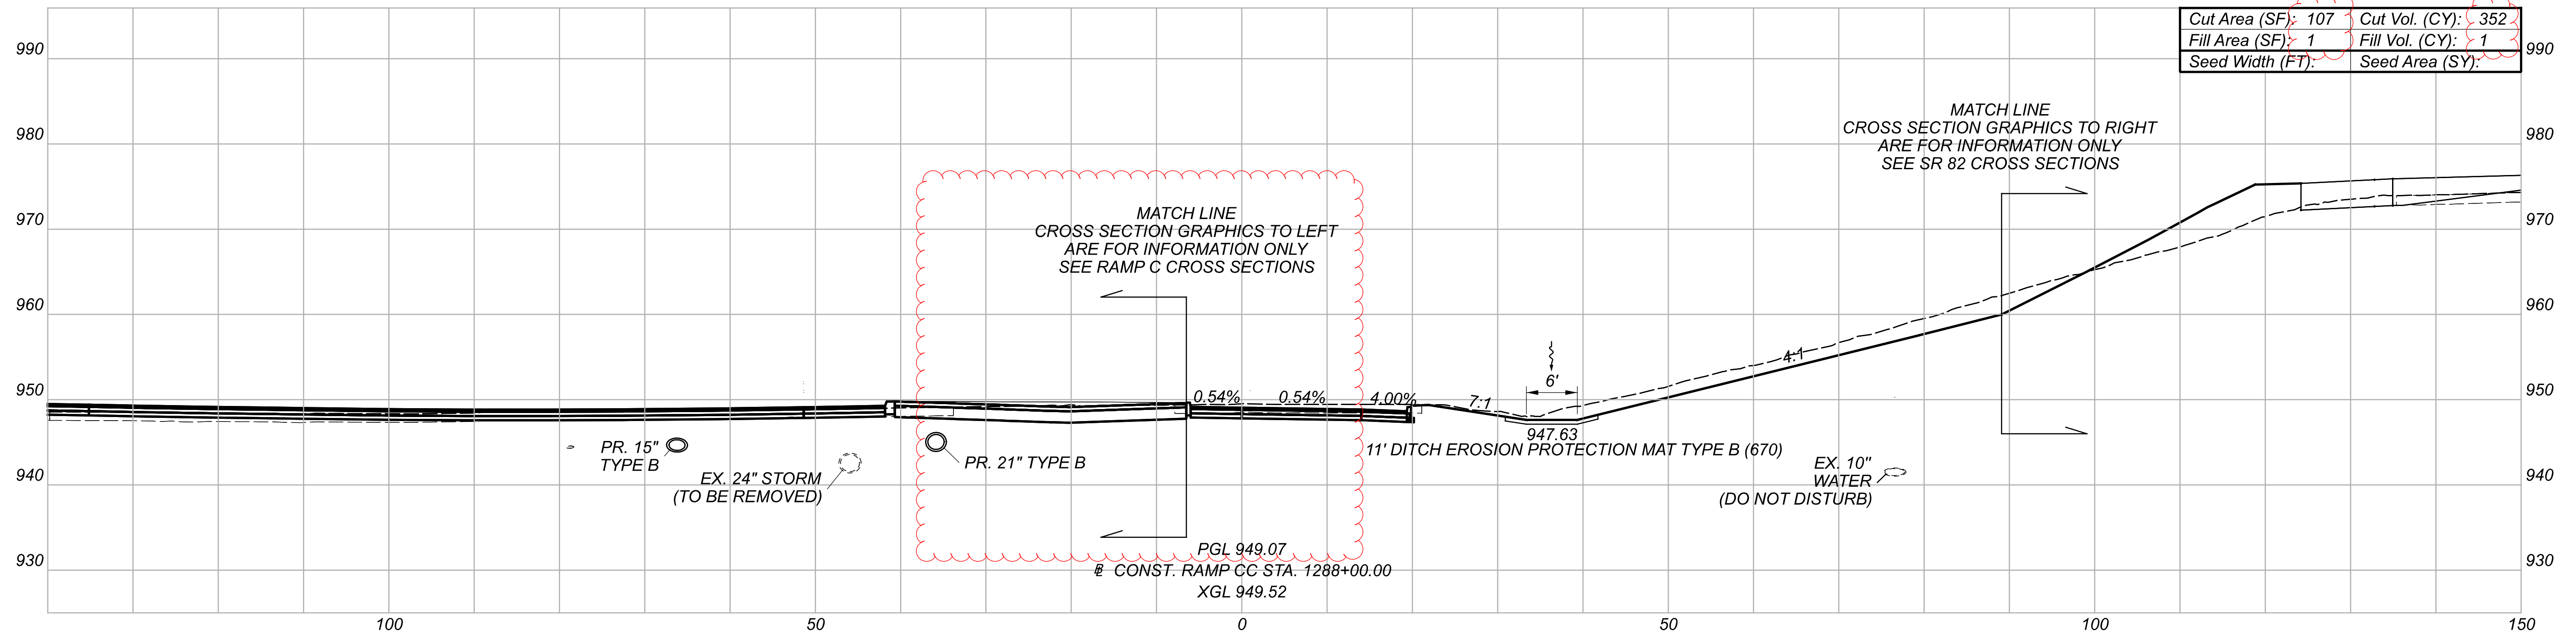

Sheet Totals			108547	
Seeding	Cut	Fill	SHEET	TOTAL
·	352	1	438	704

CROSS SECTIONS - BASELINE CONST. RAMP CC
 STA. 1287+50.00 TO STA. 1288+00.00


DESIGN AGENCY



DESIGNER
MJL

REVIEWER
JMB 08/19/21

PROJECT ID
108547

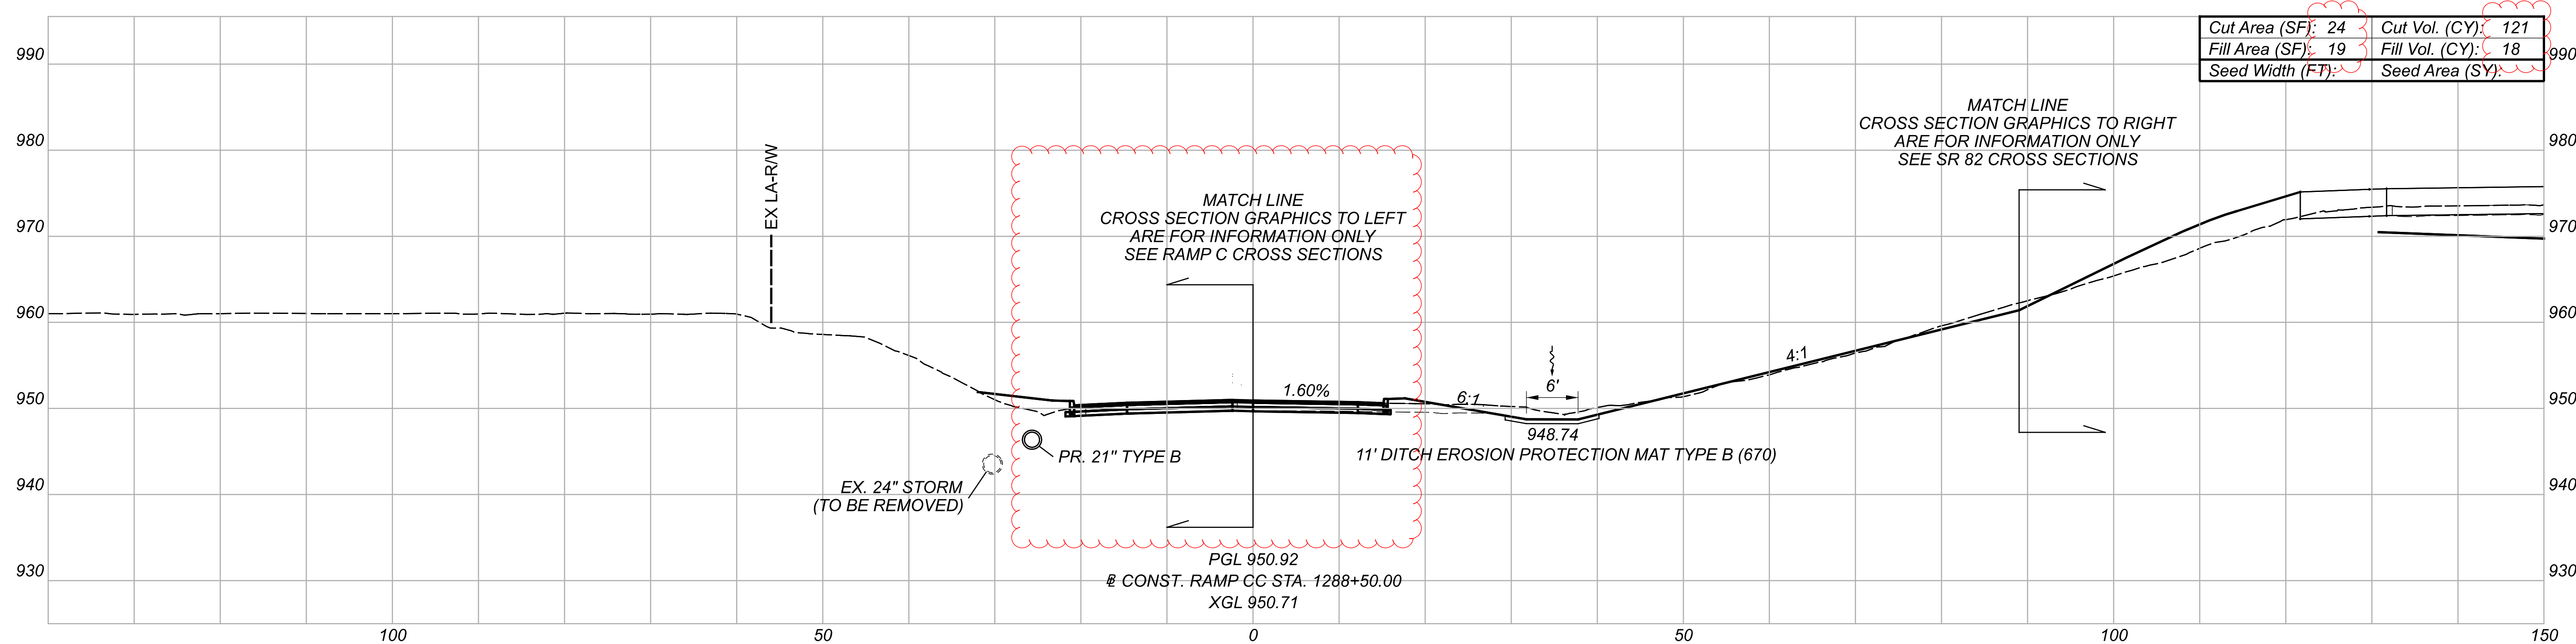

Cut Area (SF):	24	Cut Vol. (CY):	121
Fill Area (SF):	19	Fill Vol. (CY):	18
Seed Width (FT):		Seed Area (SY):	

Sheet Totals			PROJECT ID	
Seeding	Cut	Fill	SHEET	TOTAL
•	121	18	439	704

CROSS SECTIONS - BASELINE CONST. RAMP CC
 STA. 1288+50.00 TO STA. 1288+00.00



DESIGN AGENCY



DESIGNER
MJL

REVIEWER
JMB 08/19/21

PROJECT ID
108547

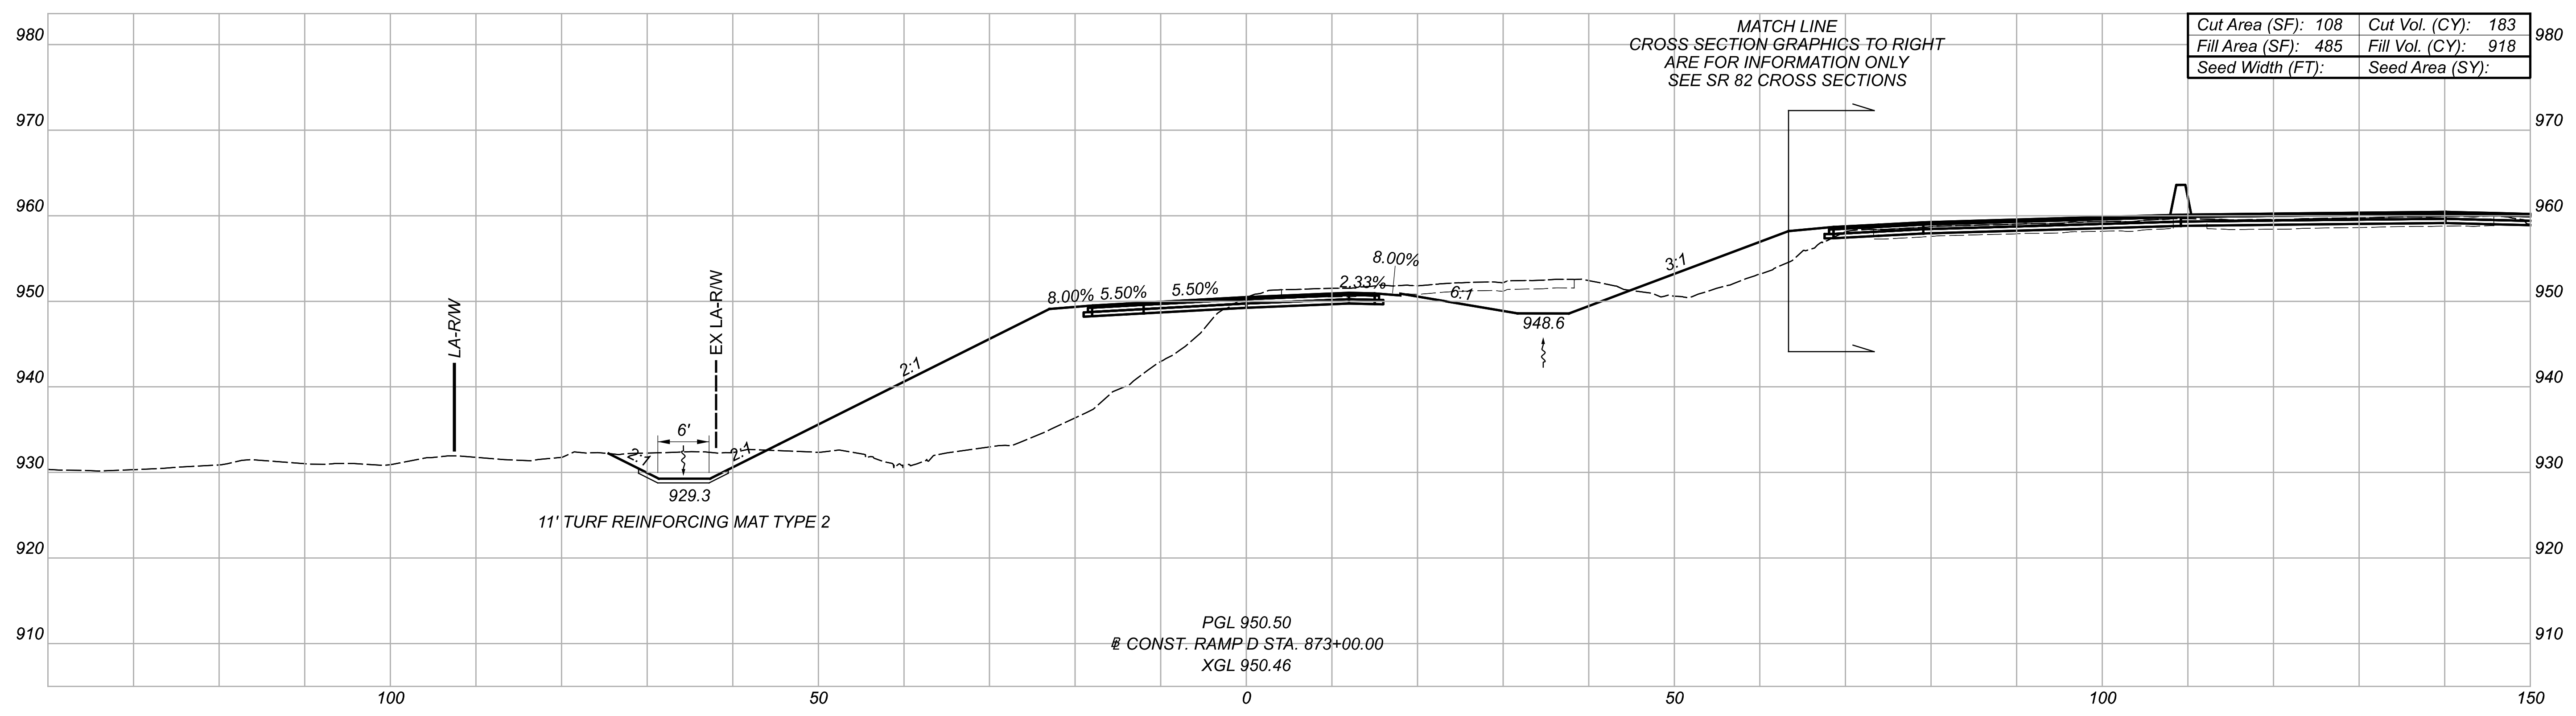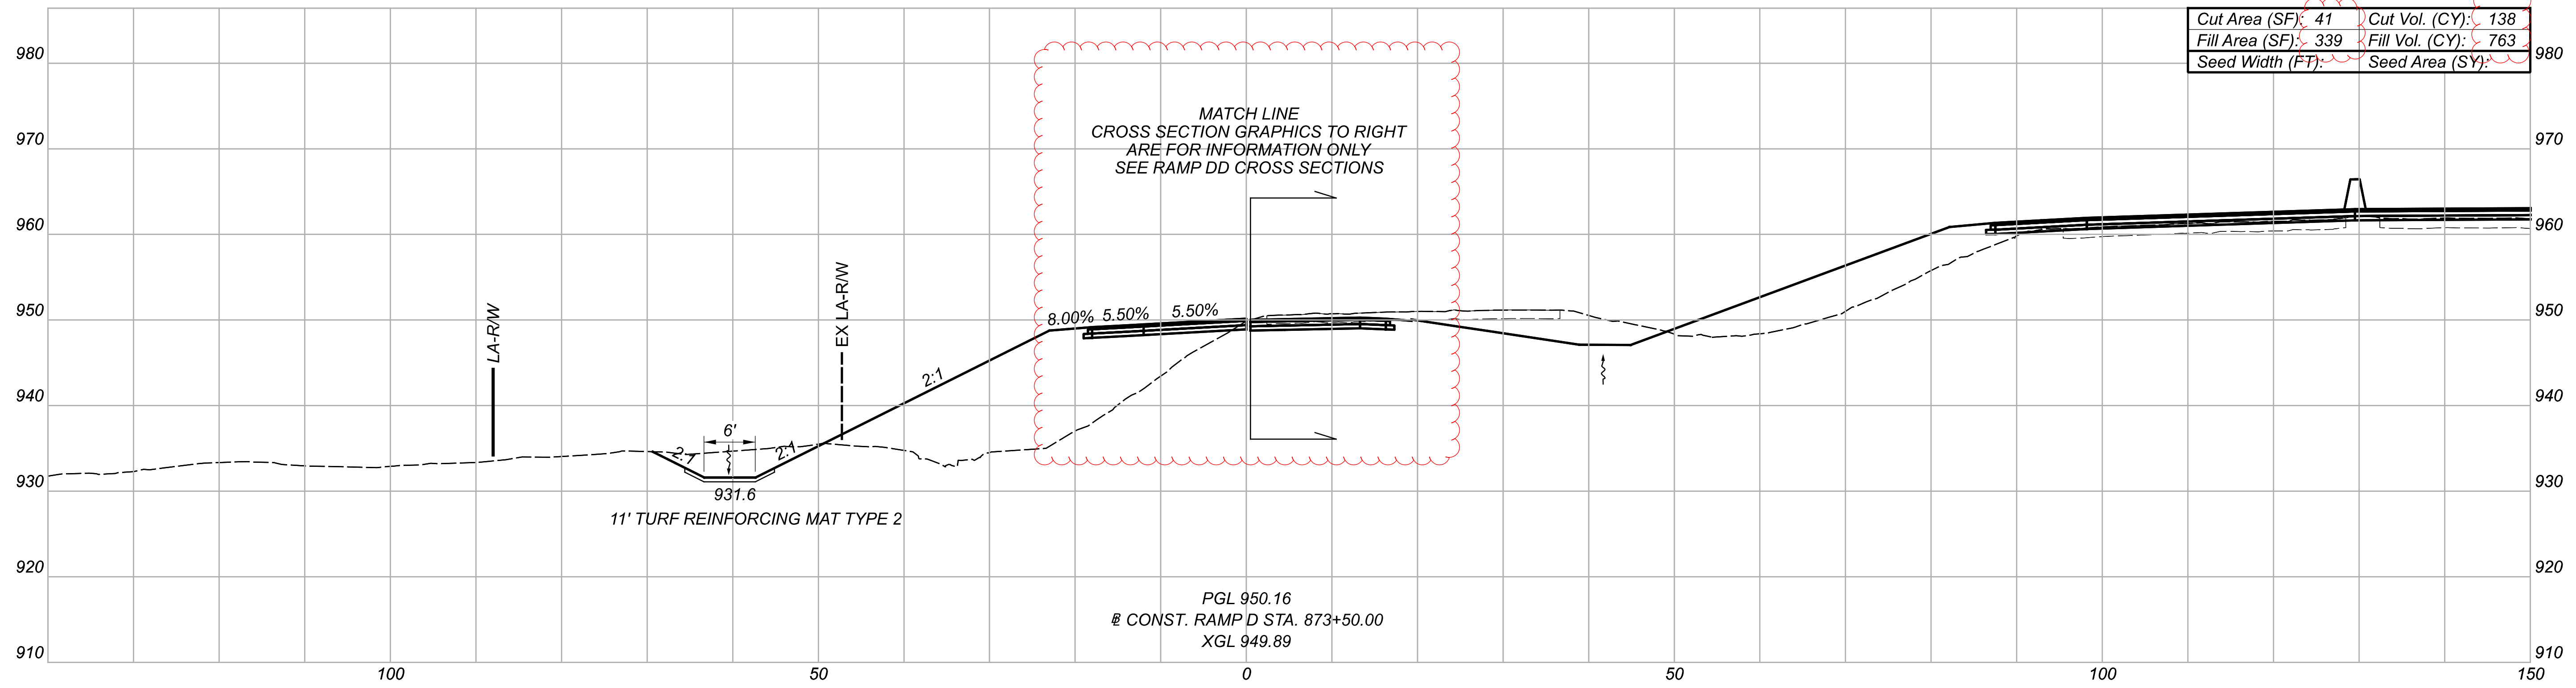

CROSS SECTIONS - BASELINE CONST. RAMP D
 STA. 873+00.00 TO STA. 873+50.00

DESIGN AGENCY





DESIGNER
 MJL

REVIEWER
 JMB 08/19/21

PROJECT ID
 108547

Sheet Totals		SHEET	TOTAL
Seeding	Cut	448	704
•	321	1687	

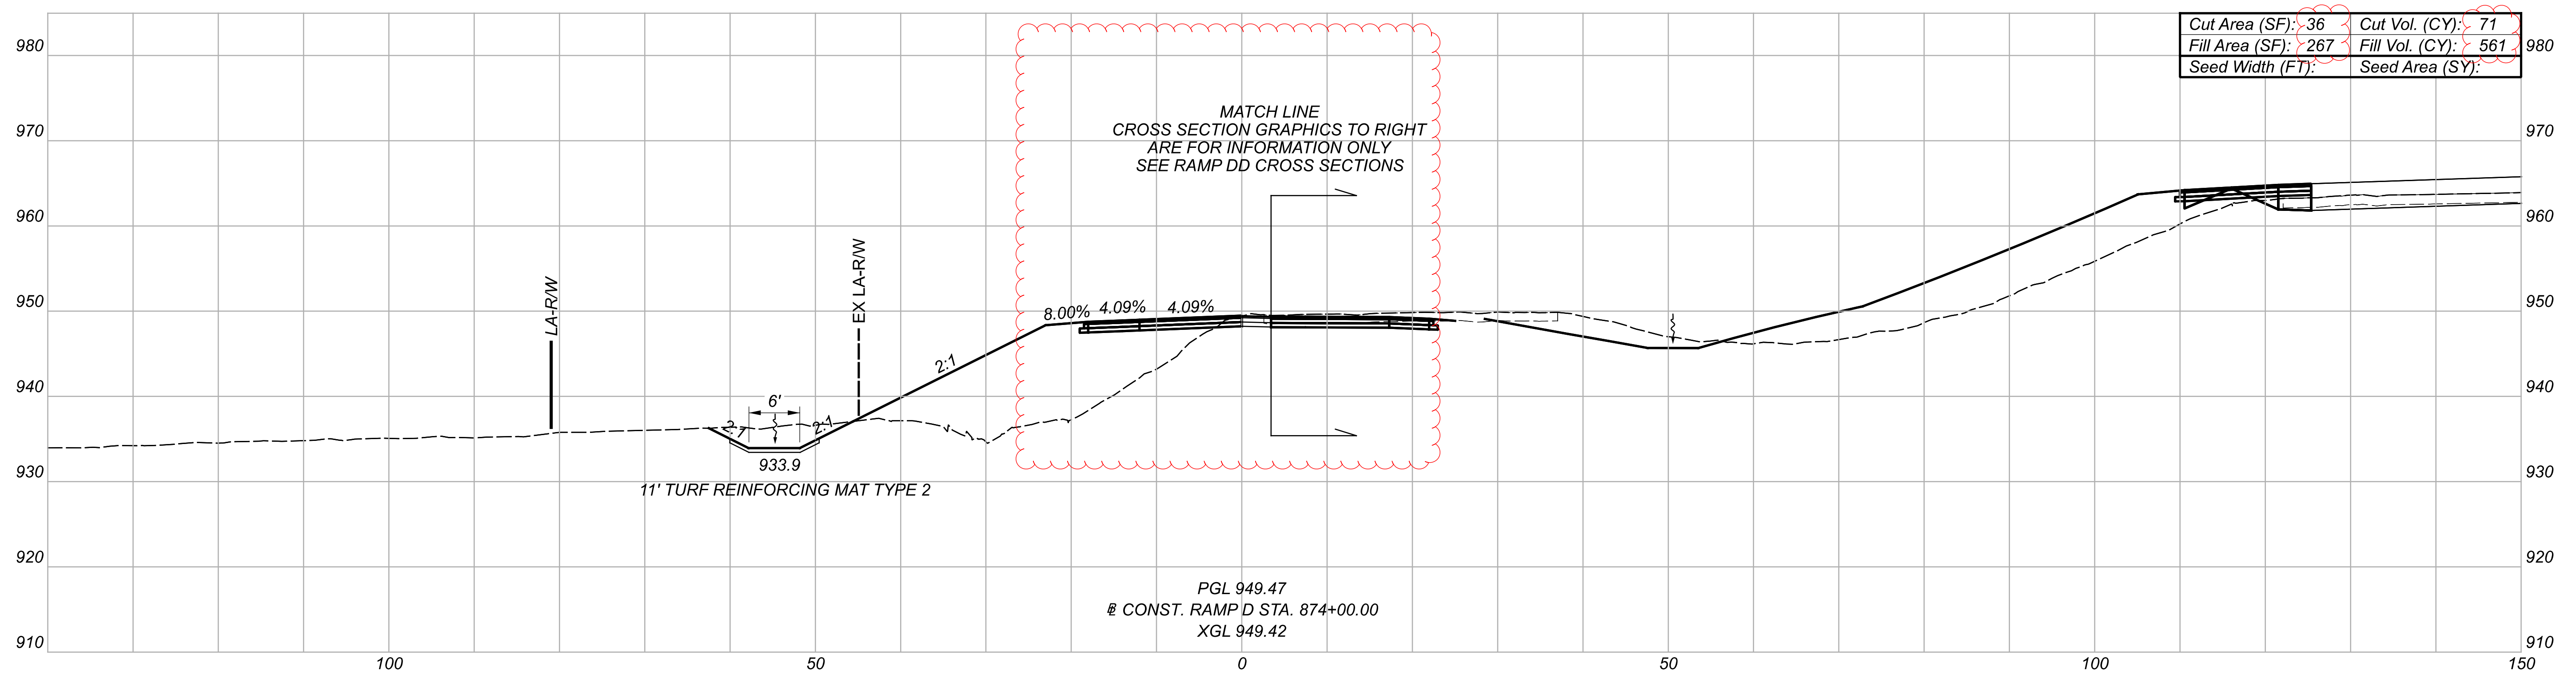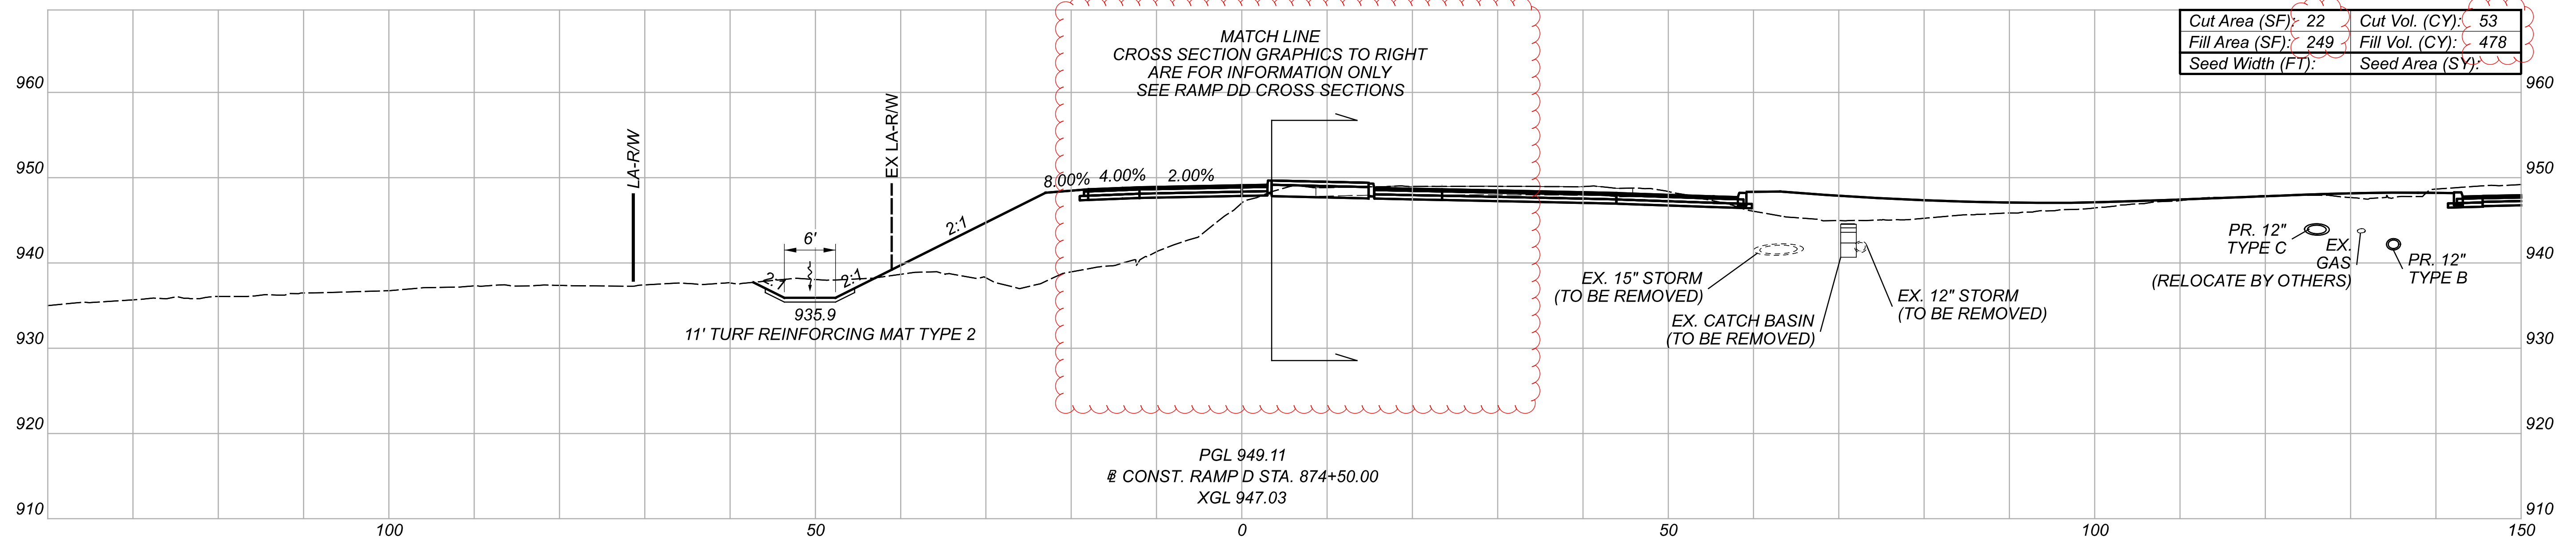

CROSS SECTIONS - BASELINE CONST. RAMP D
 STA. 874+00.00 TO STA. 874+50.00

DESIGN AGENCY






DESIGNER
 MJL

REVIEWER
 JMB 08/19/21

PROJECT ID
 108547

Sheet Totals			SHEET TOTAL	
Seeding	Cut	Fill	SHEET	TOTAL
124	1039	449	449	704

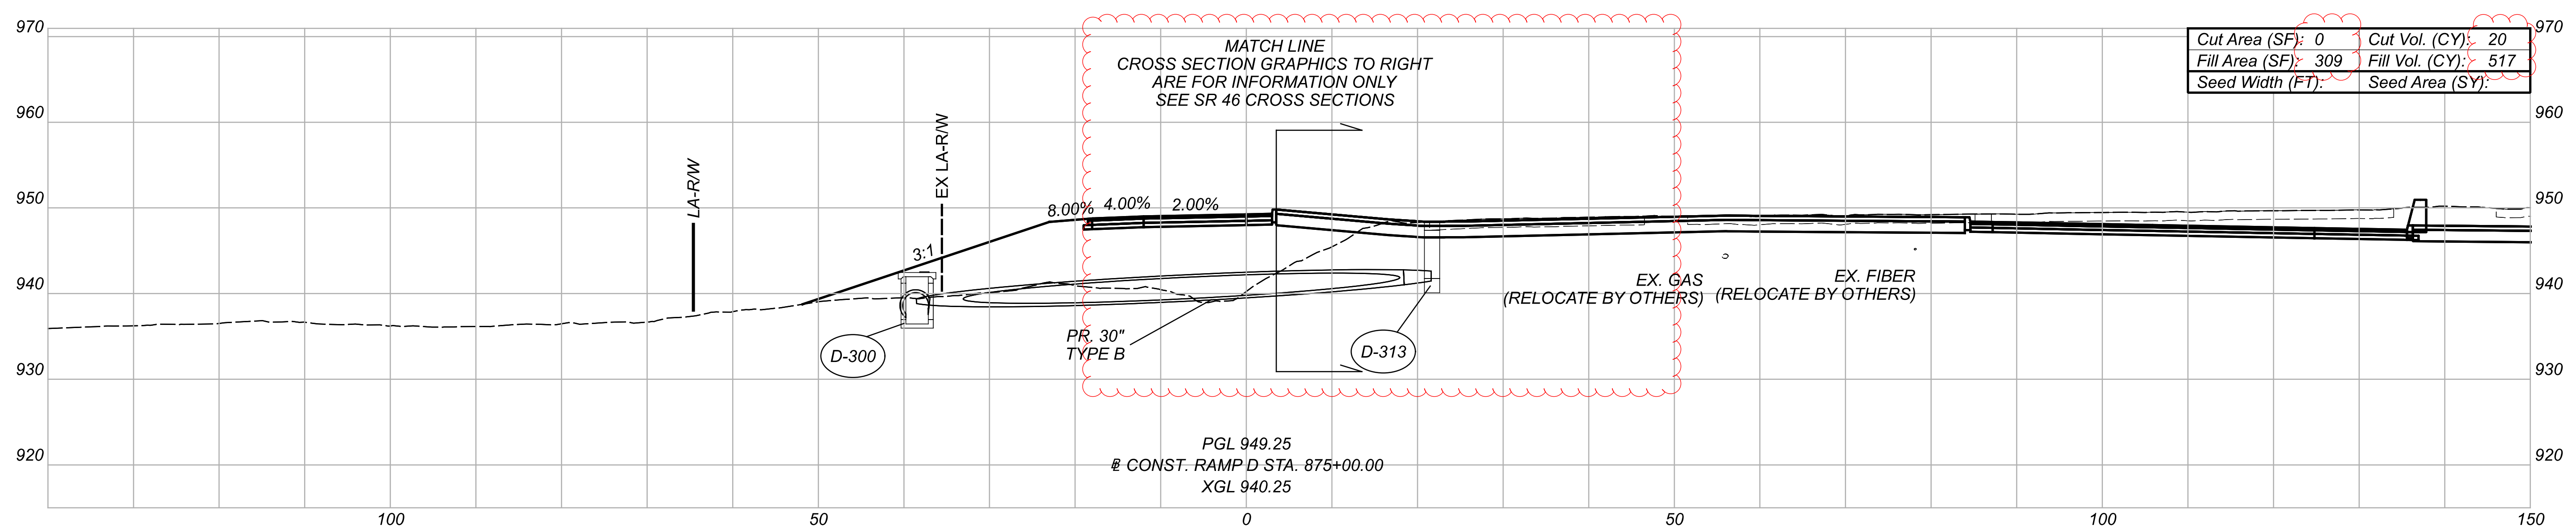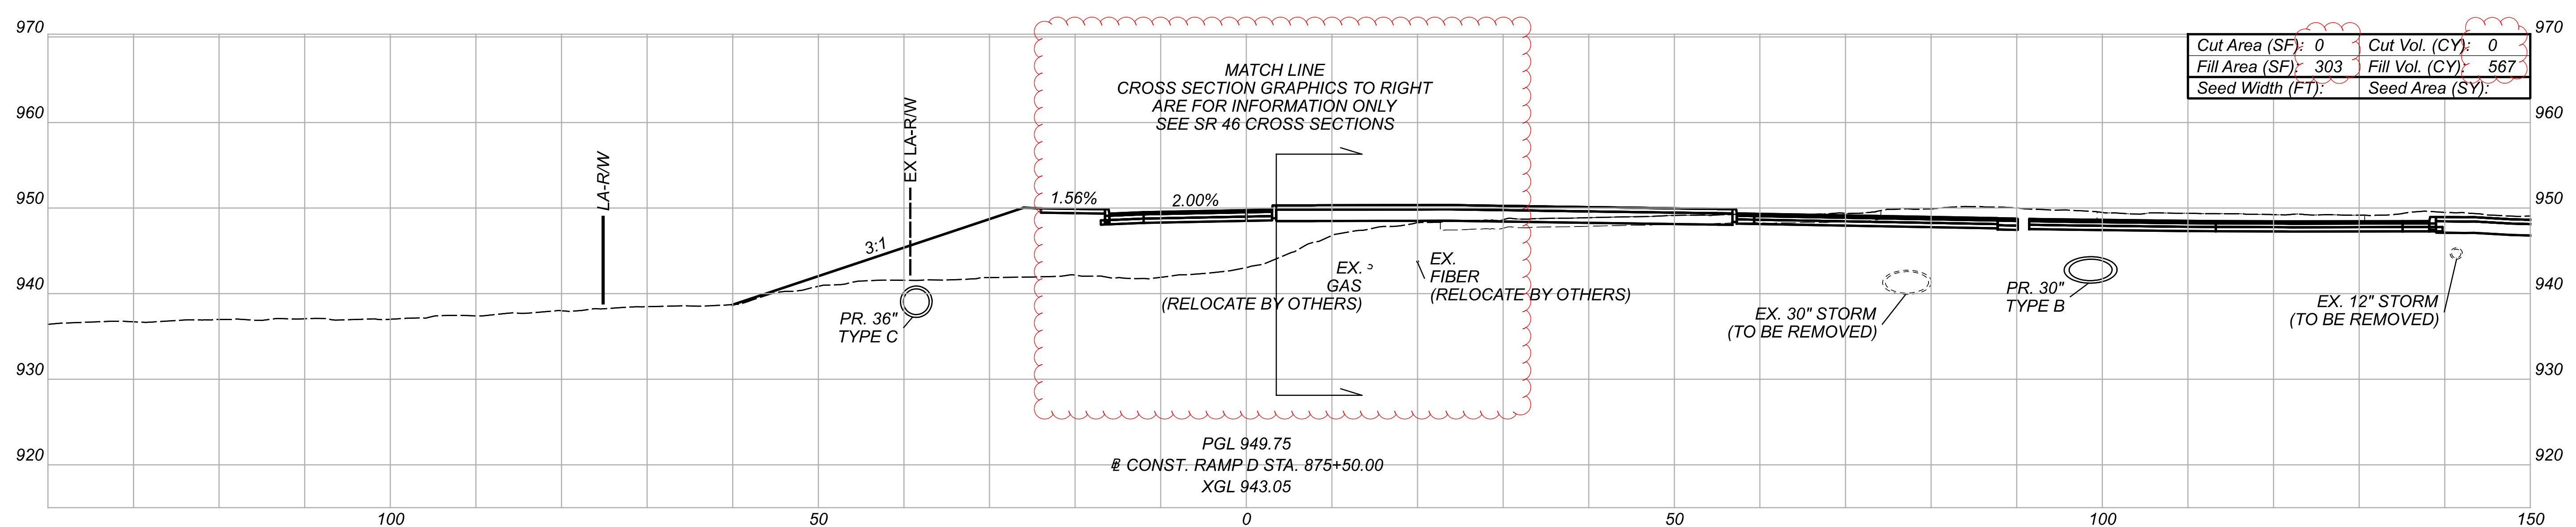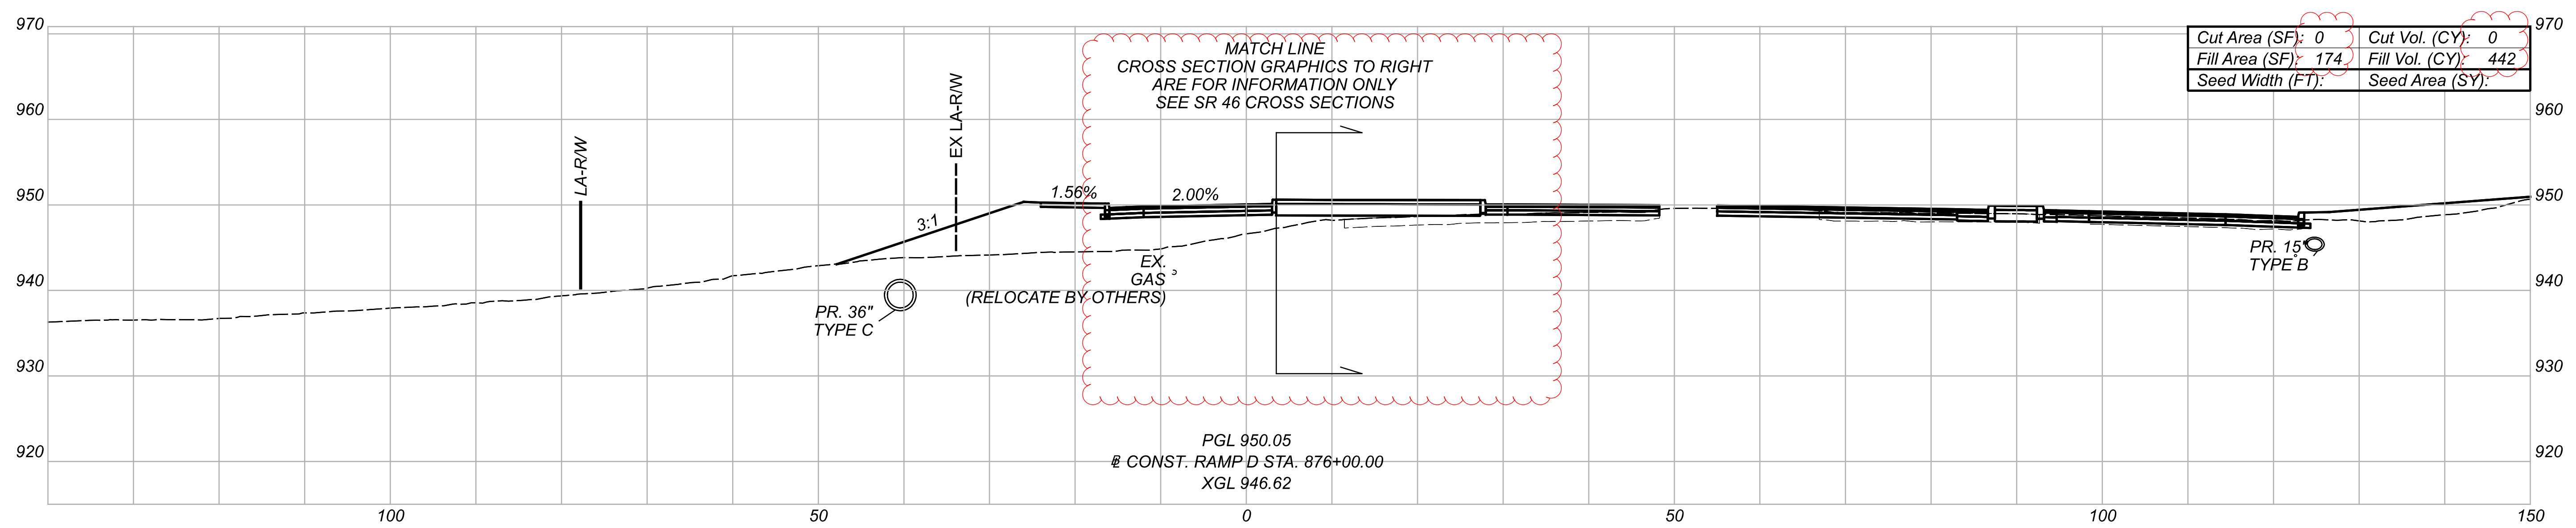

CROSS SECTIONS - BASELINE CONST. RAMP D
 STA. 875+00.00 TO STA. 876+00.00

DESIGN AGENCY





DESIGNER
 MJL

REVIEWER
 JMB 08/19/21

PROJECT ID
 108547

Sheet Totals			SHEET TOTAL	
Seeding	Cut	Fill	SHEET	TOTAL
·	20	1525	450	704

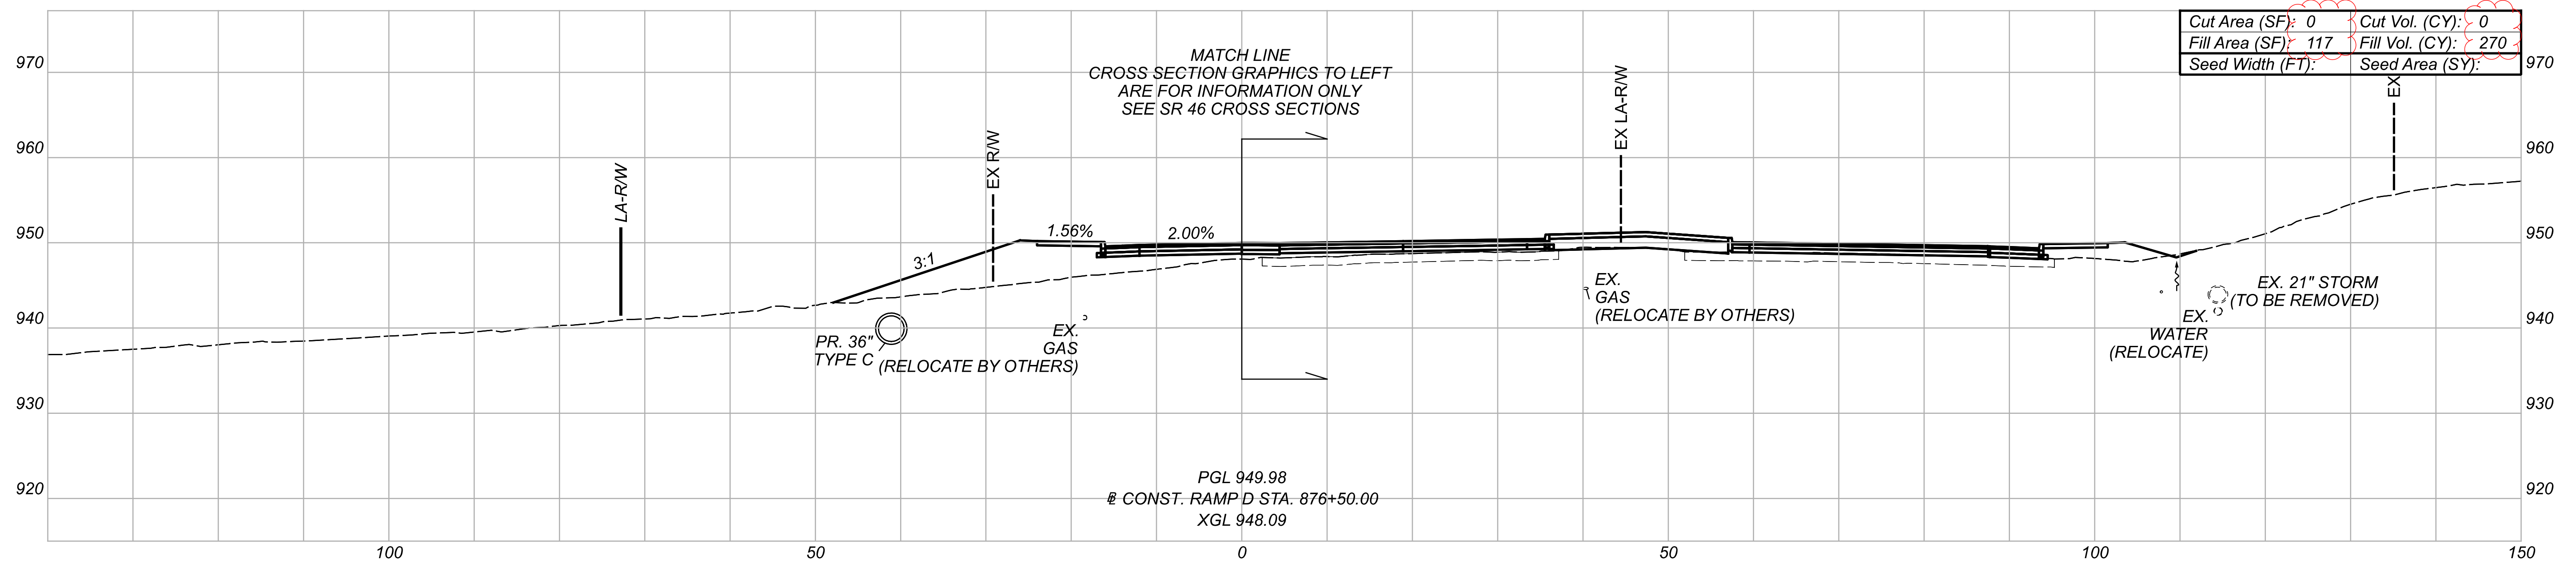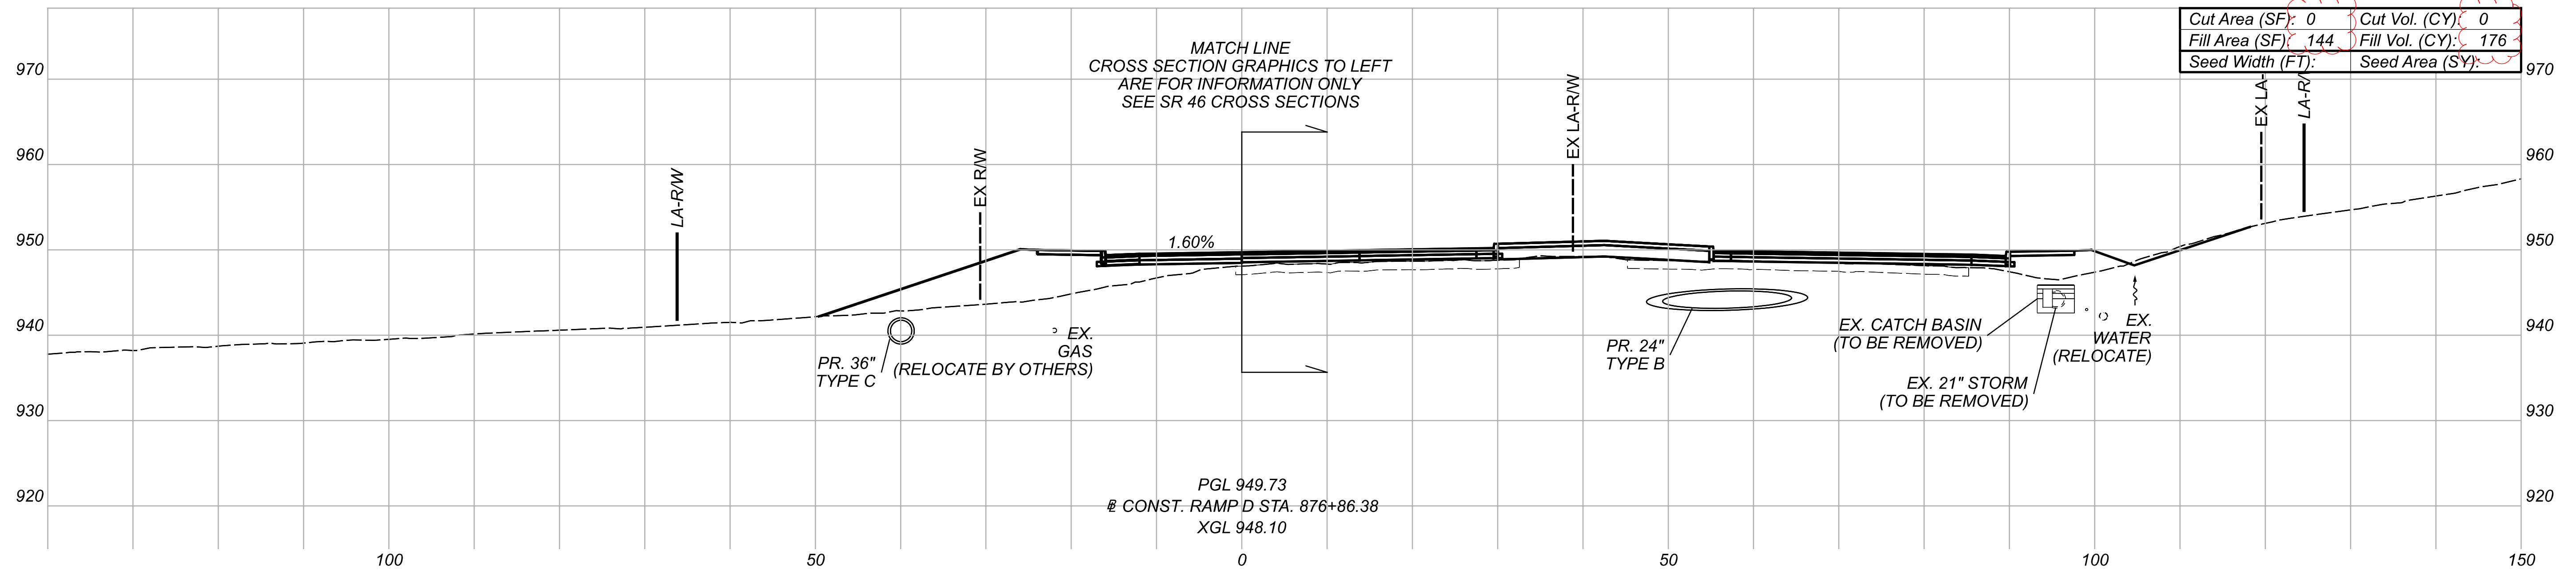

CROSS SECTIONS - BASELINE CONST. RAMP D
 STA. 876+50.00 TO STA. 876+86.38

DESIGN AGENCY



DESIGNER

MJL



REVIEWER

JMB 08/19/21

PROJECT ID

108547

Sheet Totals				SHEET	TOTAL
Seeding	Cut	Fill			
0	0	446	451	704	

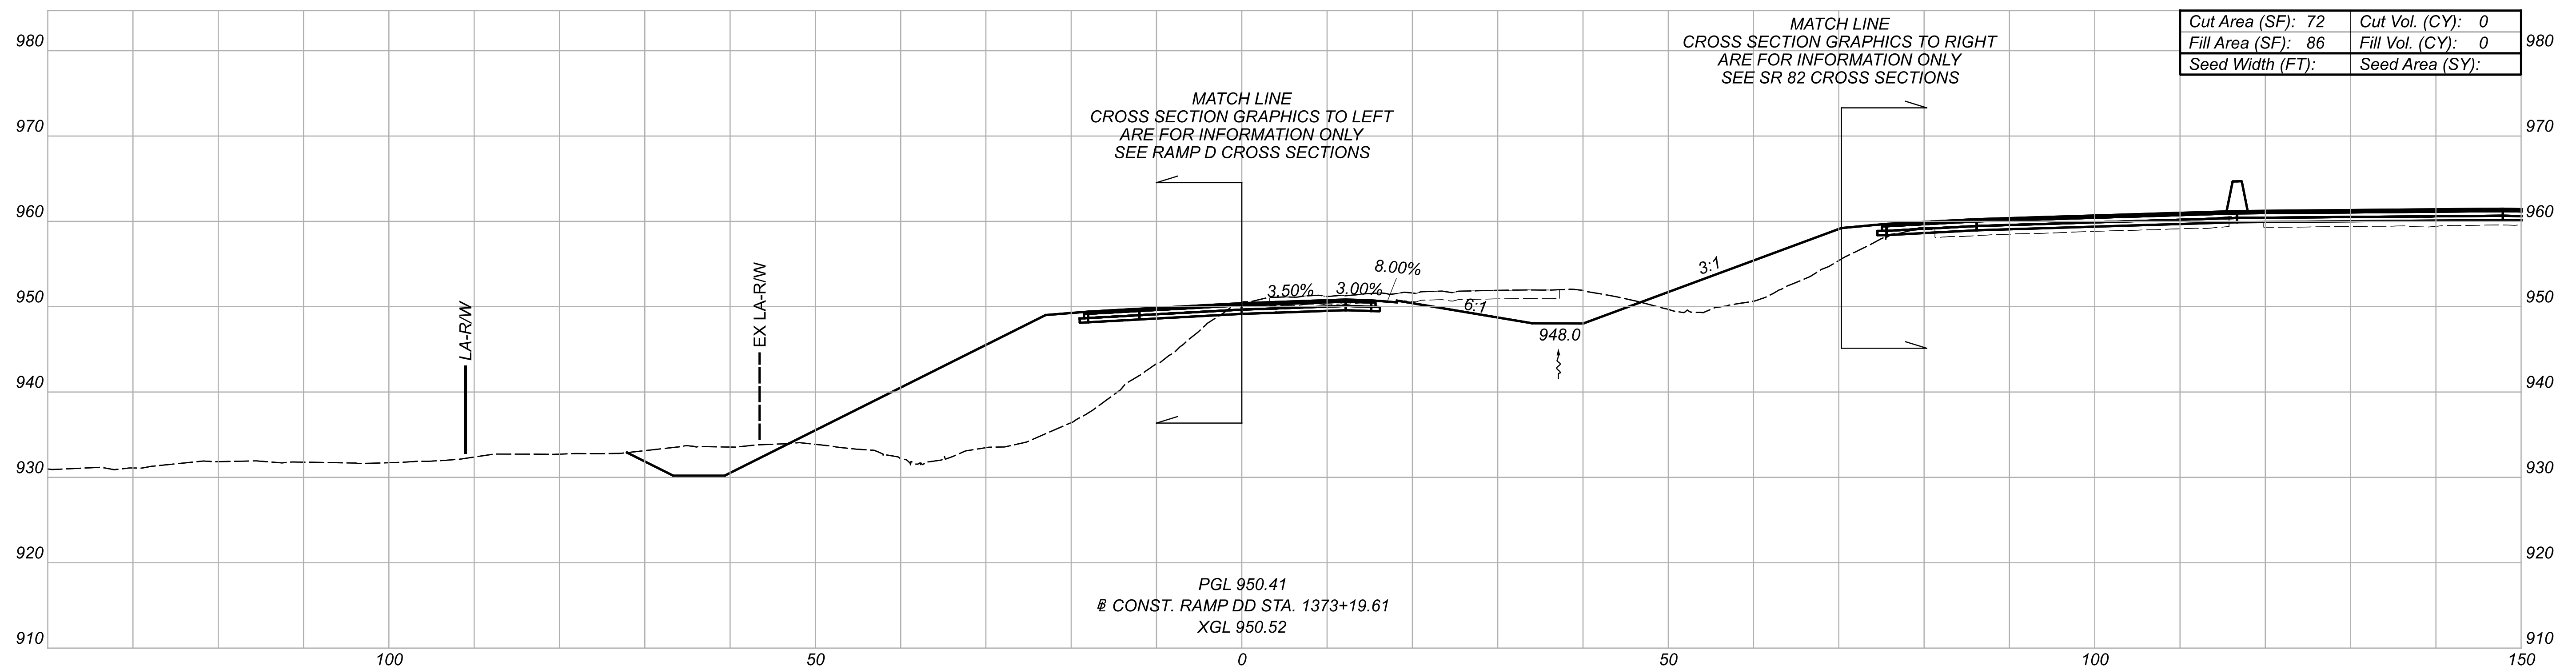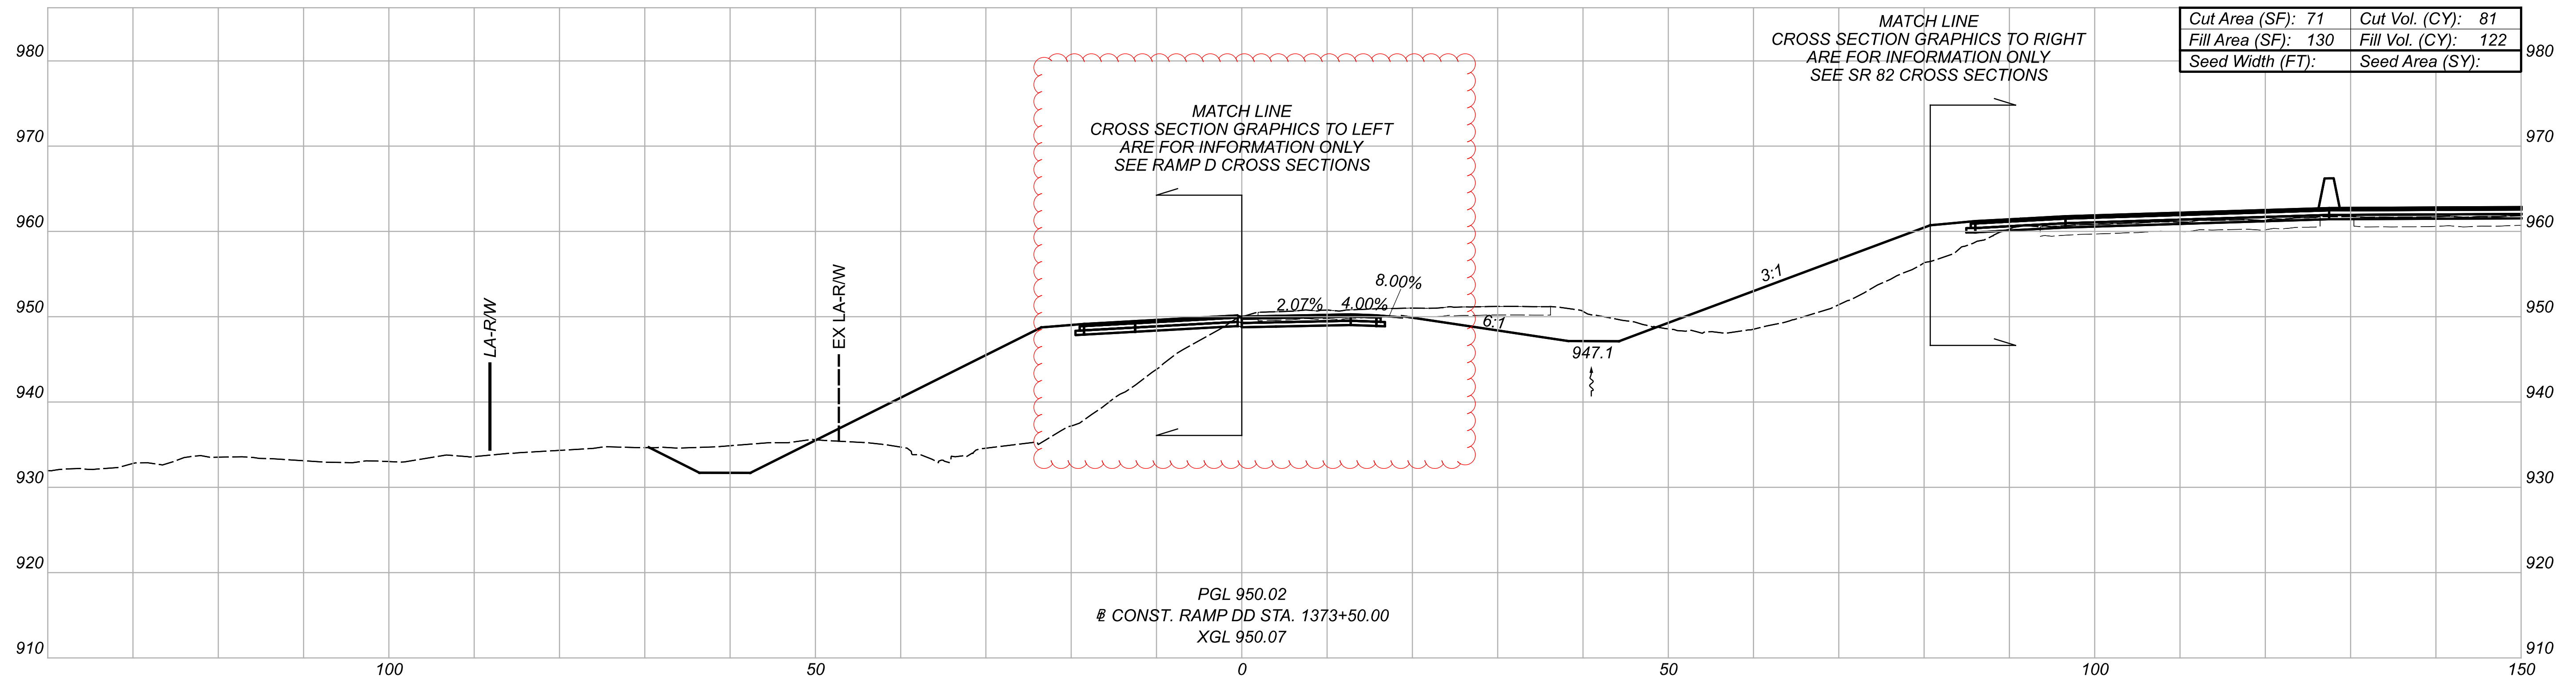

CROSS SECTIONS - BASELINE CONST. RAMP DD
STA. 1373+19.61 TO STA. 1373+50.00

DESIGN AGENCY




DESIGNER
MJL


REVIEWER
JMB 08/19/21

PROJECT ID
108547

Sheet Totals			SHEET	TOTAL
Seeding	Cut	Fill		
.	81	122	452	704

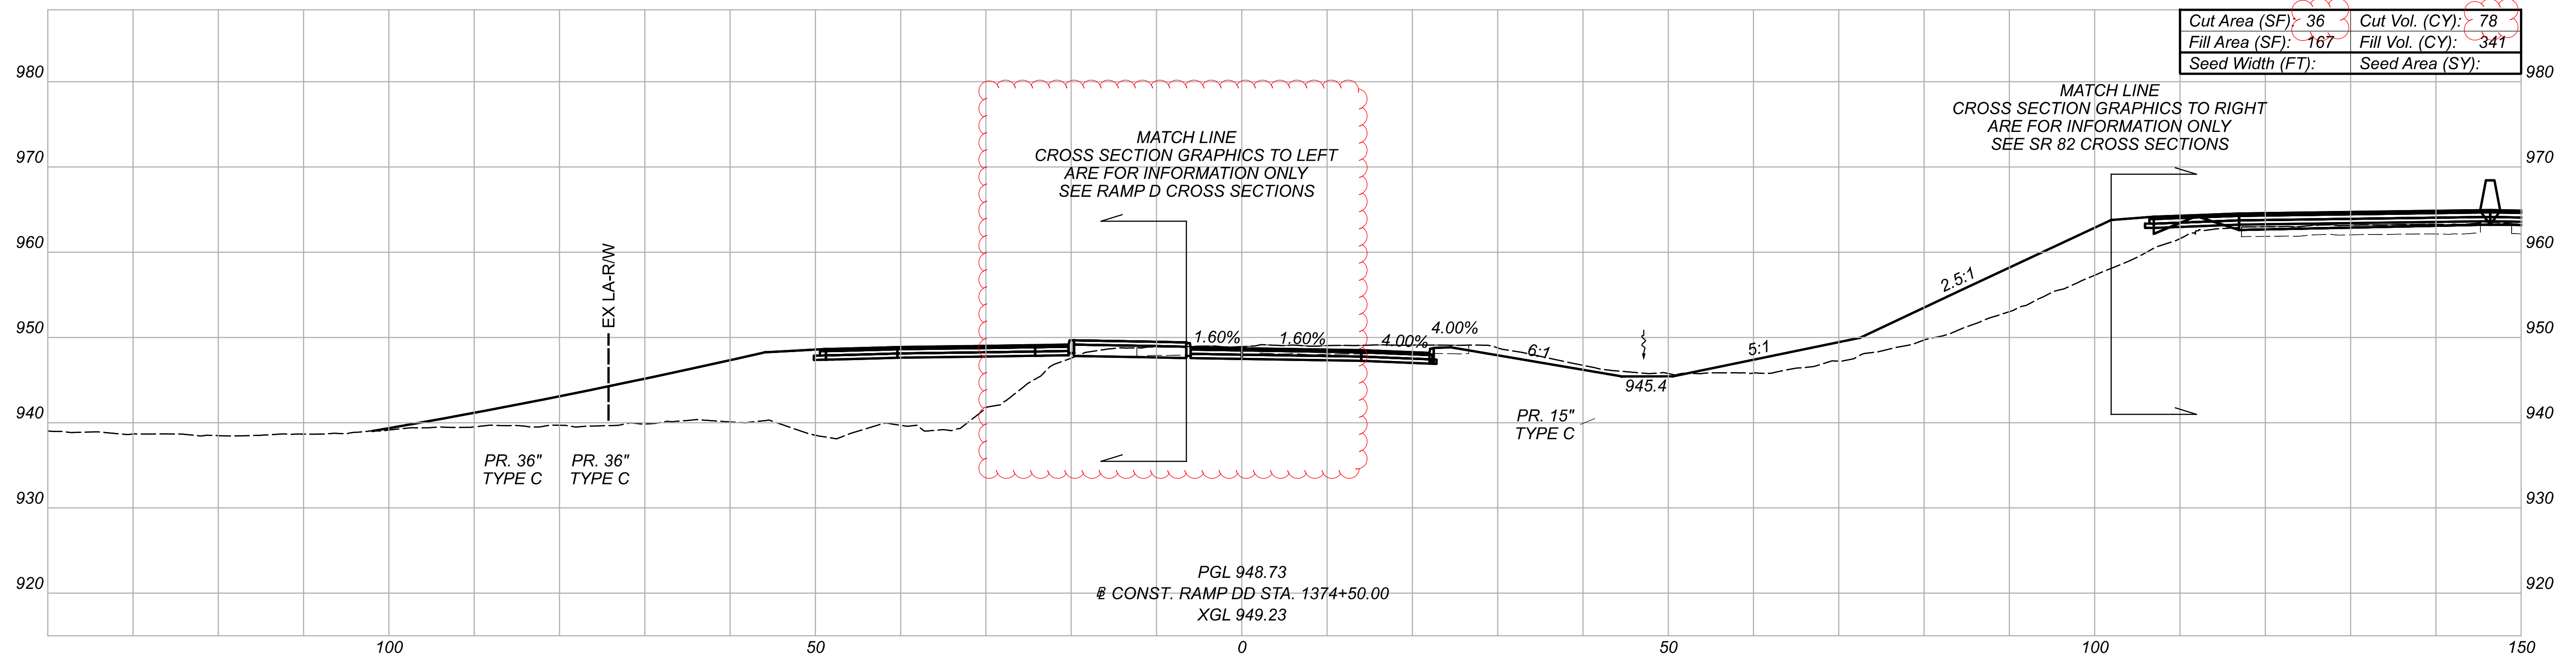


Cut Area (SF):	36	Cut Vol. (CY):	78
Fill Area (SF):	167	Fill Vol. (CY):	341
Seed Width (FT):		Seed Area (SY):	

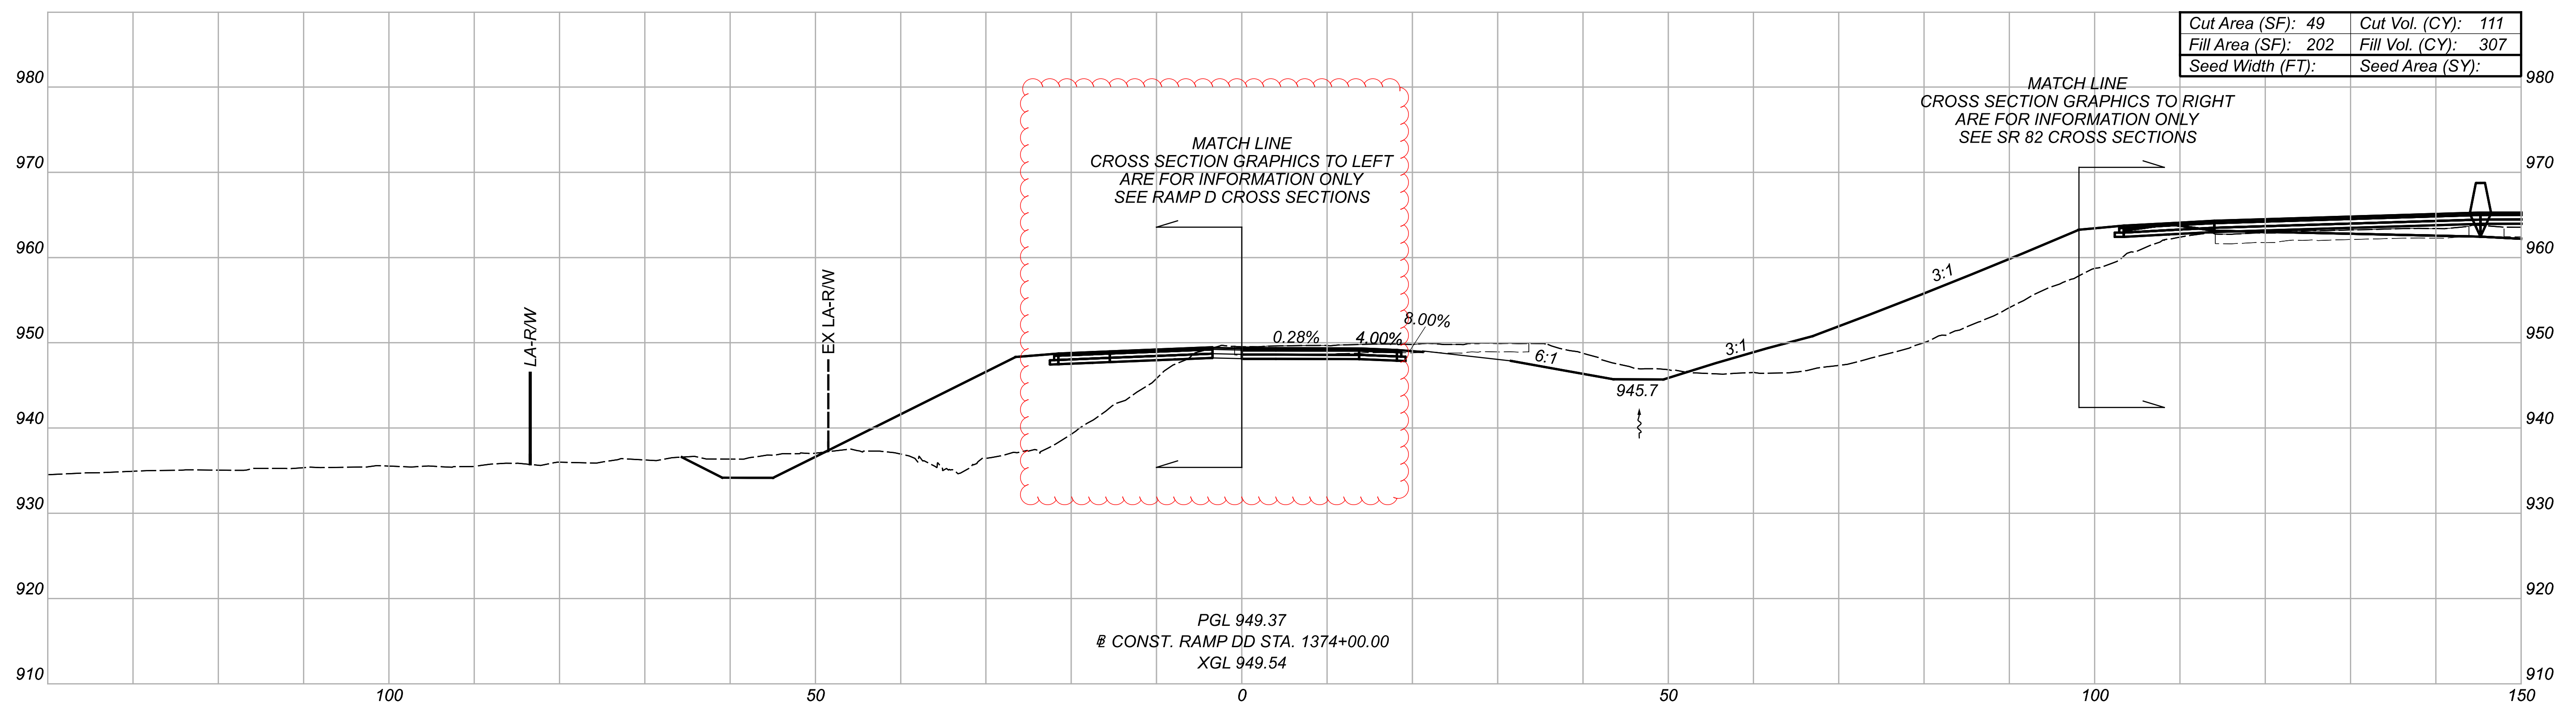


Cut Area (SF):	49	Cut Vol. (CY):	111
Fill Area (SF):	202	Fill Vol. (CY):	307
Seed Width (FT):		Seed Area (SY):	


Sheet Totals			108547	
Seeding	Cut	Fill	SHEET	TOTAL
	189	649	453	704

CROSS SECTIONS - BASELINE CONST. RAMP DD
 SHEET SUB-TITLE STA. 1374+00.00 TO STA. 1374+50.00

DESIGN AGENCY

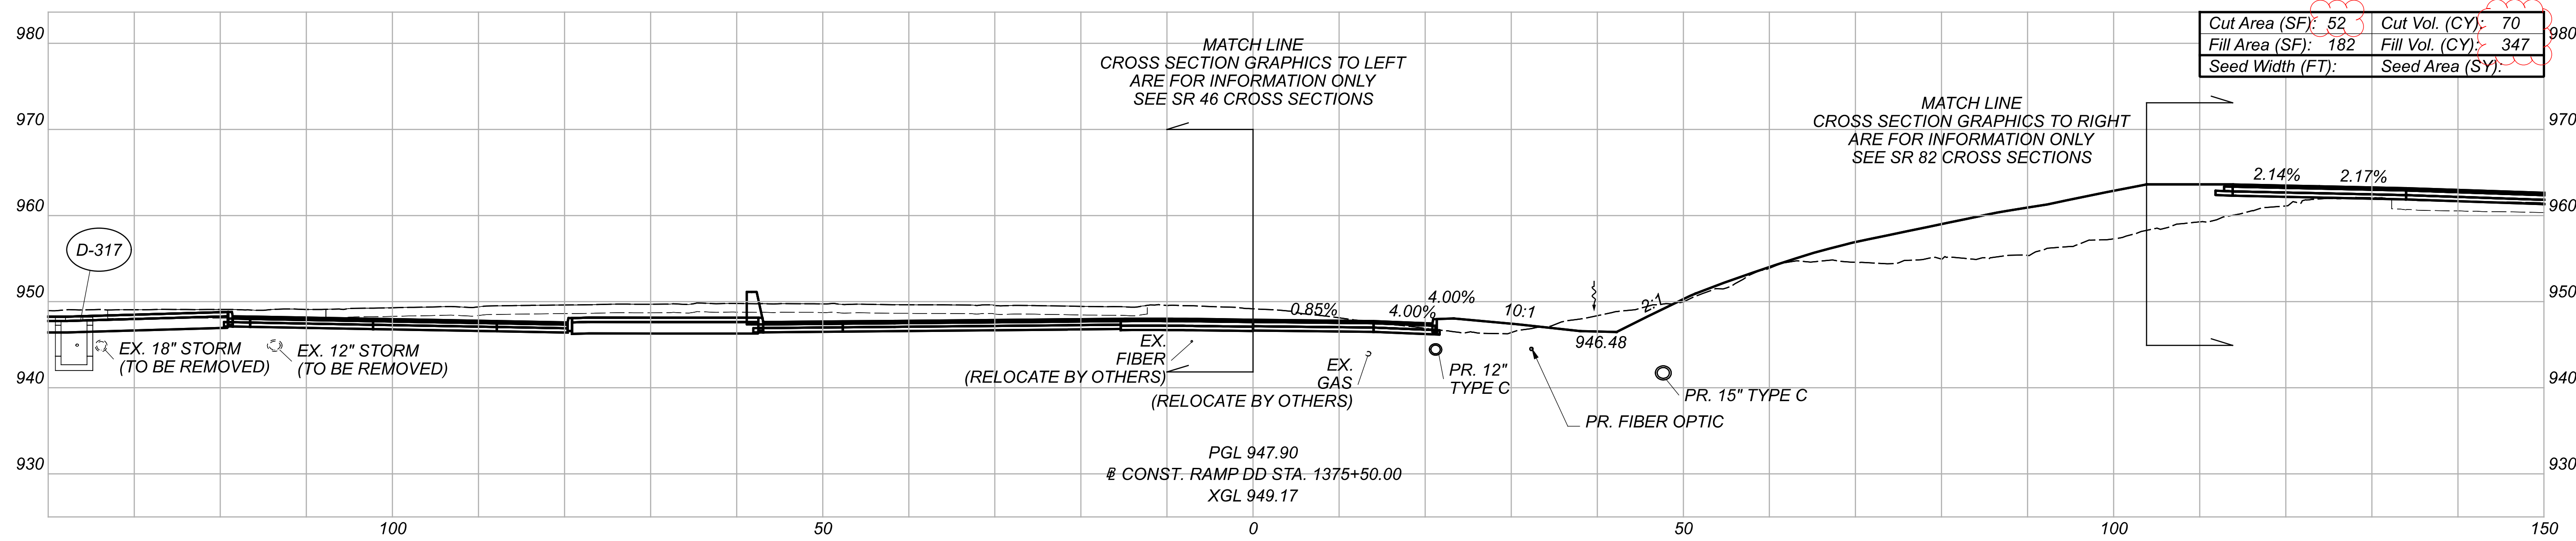 DESIGNER
 MJL
 REVIEWER
 JMB 08/19/21
 PROJECT ID
 108547

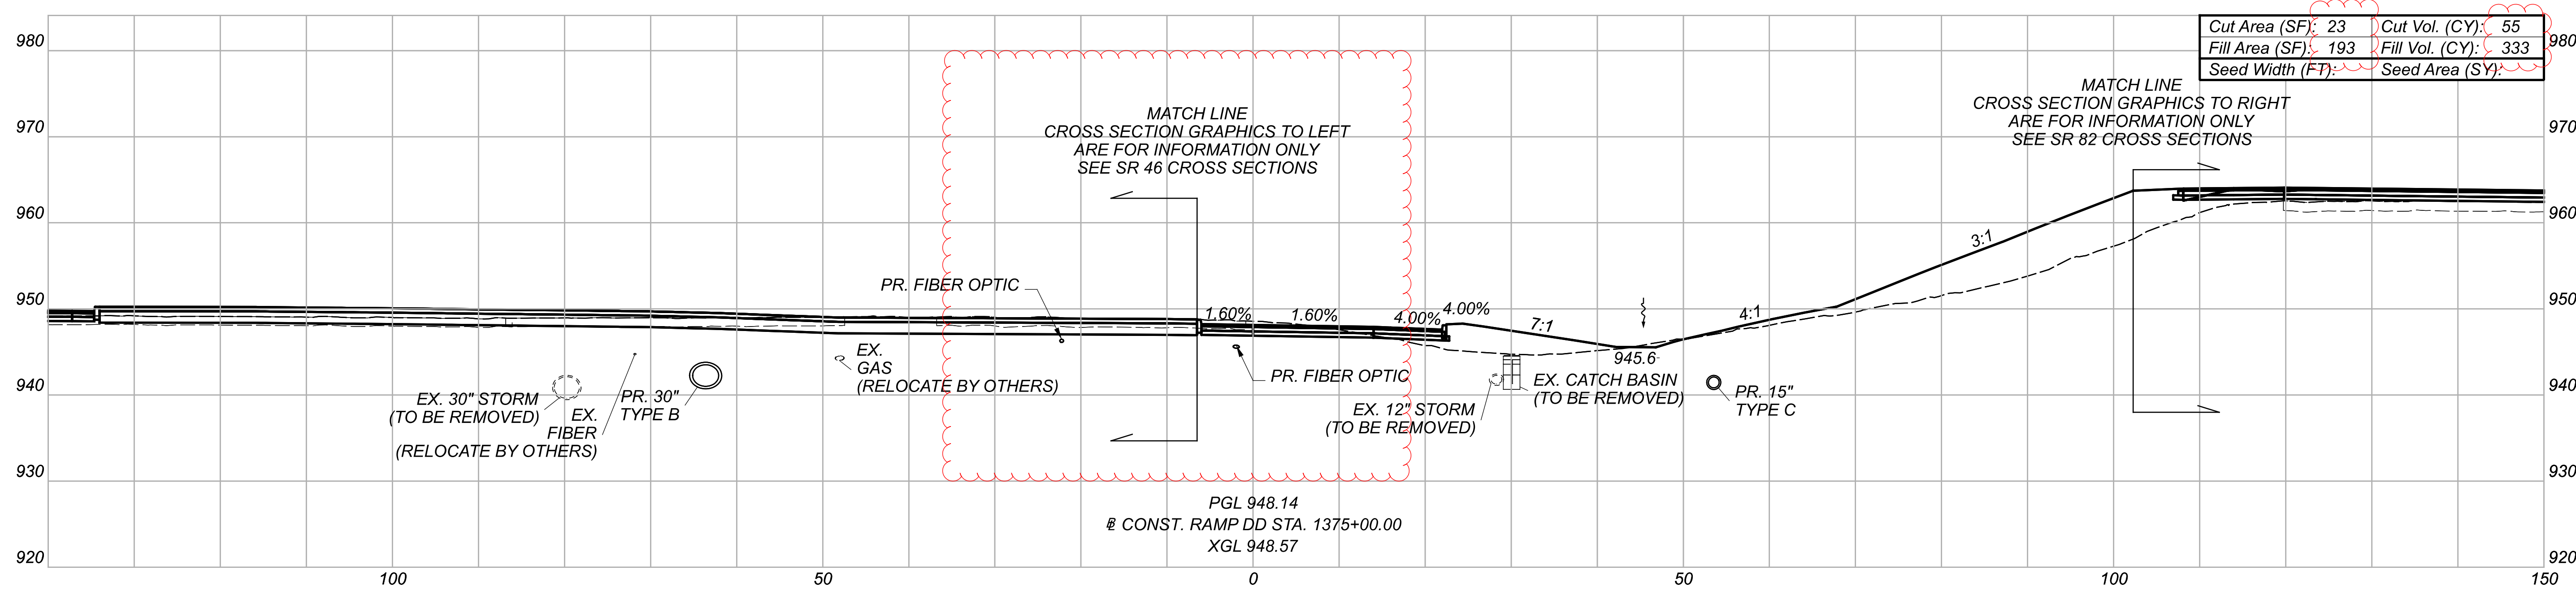

Cut Area (SF): 52	Cut Vol. (CY): 70
Fill Area (SF): 182	Fill Vol. (CY): 347
Seed Width (FT):	Seed Area (SY):




Cut Area (SF): 23	Cut Vol. (CY): 55
Fill Area (SF): 193	Fill Vol. (CY): 333
Seed Width (FT):	Seed Area (SY):

Project Totals			Sheet Totals		
Cut	Fill	Seeding	Cut	Fill	
29517	26942	·	125	680	

EARTHWORK TOTALS CARRIED TO GENERAL SUMMARY

CROSS SECTIONS - BASELINE CONST. RAMP DD
 STA. 1375+00.00 TO STA. 1375+50.00


DESIGN AGENCY

 DESIGNER
 MJL
 REVIEWER
 JMB 08/19/21
 PROJECT ID
 108547
 SHEET TOTAL
 454 704

TRU-46/82 DDI

MODEL: TS002 PAPER SIZE: 34x22 (in.) DATE: 5/3/2023 TIME: 1:53:38 PM USER: TSCHOEN
 p:\pwhruse01\HJR_US_East_01\Documents\Ohio_DOT\ODI_TRU-46-82_DDI\6.0_CAD_BIM\6.2_WIP\01_Design\108547400-Engineering\Traffic\Sheets\Signing & Pavement\Marking_Subsummary

SHEET NO.	REFERENCE NO.	LOCATION	STATION	SIDE	CODE	SIZE (INCHES)		GROUND MOUNTED SUPPORT, NO. 3 POST	GROUND MOUNTED SUPPORT, NO. 4 POST	SIGN POST REFLECTOR	630		SIGN, FLAT SHEET	SIGN, GROUND MOUNTED EXTRUSHEET	GROUND ROD TC-21.21	OVERHEAD SIGN SUPPORT, TYPE TC-12.31, DESIGN 6	OVERHEAD SIGN SUPPORT, TC-15.116, DESIGN 1	OVERHEAD SIGN SUPPORT TC-15.116 DESIGN 3	BREAKAWAY STRUCTURAL BEAM CONNECTION	OVERHEAD SIGN SUPPORT TC-16.22 DESIGN 12	RIGID OVERHEAD SIGN SUPPORT FOUNDATION TC-21.11	630		REMOVAL OF OVERHEAD MOUNTED SIGN AND DISPOSAL	REMOVAL OF OVERHEAD SIGN SUPPORT AND DISPOSAL					
						W	H				FT	FT										EACH	FT			FT	SF	SF	EACH	EACH
562		RAMP CC	1288+42	LT	REMOVAL																	2		1						
		RAMP C	693+37	RT	REMOVAL																		1		2					
			693+37	LT	REMOVAL																			1		2				
			695+26	LT	REMOVAL																			1		2				
			696+75	RT	REMOVAL																			1		2				
697+75	LT		REMOVAL																			1		1						
563		RAMP D	873+16	RT	REMOVAL																		1		1					
			873+59	RT	REMOVAL																			1		1				
			874+20	RT	REMOVAL																				1		1			
			874+54	RT	REMOVAL																				1		1			
564	S-1	SR 46	375+37	LT	R3-9b-24	24	X	36	15.5/15.5																					
				LT	I-H2b	24	X	18																						
565	S-2	SR 46	378+74	RT	LEVEL 3	150	X	90				19.0/19.0		93.8																
	S-3		379+43	LT	R2-1-30	30	X	36	14.0																					
	OSS-4		380+75	RT/LT	R3-9a-30 (X2)	30	X	36																						
					R3-9cP-30	30	X	12																						
					R3-9dP-30	30	X	12																						
					LEVEL 3	120	X	84									70.0													
					LEVEL 3	192	X	84									112.0													
	S-5		381+50	LT	R3-H8cb-48	48	X	30	13.5/13.5						10.0															
	S-6		382+52	LT	M1-5-24	24	X	24	14.0							4.0														
					M3-3-24	24	X	12						2.0																
	S-7		383+52	RT	LEVEL 3	60	X	84					18.0/18.0		35.0															
	S-8		383+65	RT	R3-4-36	36	X	36	14.0							9.0														
R4-7-24		24			X	30						5.0																		
S-9	384+94	RT	LEVEL 3	96	X	84					18.0/18.0		56.0																	
S-10	385+26	RT	R4-8-24	24	X	30	13.5						5.0																	
566	OSS-11	SR 46	385+32	LT	LEVEL 3	120	X	84						70.0	1	1					1									
	S-12		385+75	RT/LT	I-H25b-12	12	X	12	12.0					1.0																
	S-13		386+55	RT	I-H25b-12	12	X	12	12.0					1.0																
	S-14		387+15	LT	LEVEL 3	60	X	84					18.0/18.0		35.0															
	OSS-15		386+91	RT	LEVEL 3	120	X	102							85.0	1	1					1								
	S-16		387+76	RT	R4-8-24	24	X	30	13.5						5.0															
567	S-17	SR 46	389+08	RT	R3-4-36	36	X	36	14.0					9.0																
				RT	R4-7-24	24	X	30						5.0																
	S-18		386+54	LT	LEVEL 3	60	X	84					18.0/18.0		35.0															
	S-19		389+24	LT	W11-2-36	36	X	36	16.5						9.0															
					W16-9P-24	24	X	12						2.0																
	OSS-20		389+82	LT	LEVEL 3	120	X	96							80.0	1														
					LEVEL 3	96	X	84					56.0																	
	OSS-21		391+42	LT	R3-9a-30 (X2)	30	X	36							15.0															
					R3-9cP-30	30	X	12					2.5																	
	S-22		390+90	LT	R3-H8cb-48	48	X	30	13.5/13.5						10.0															
	S-23		390+00	RT	M3-1-24	24	X	12							2.0															
M1-5-24		24			X	24					4.0																			
S-24	391+00	RT	W4-2R-48	48	X	48	15.0/15.0						16.0																	
OSS-25	392+13	RT	W9-H4R-144	144	X	60							60.0	1																
			LEVEL 3	150	X	90					7.5																			
568	S-27	SR 46	393+00	RT	R2-1-30	30	X	36	14.0					6.3																
	S-28		393+61	LT	LEVEL 3	150	X	90					19.0/19.0	93.8																
	S-29		394+43	LT	R1-1-30	30	X	30	13.5					6.3																
	S-30		395+90	RT	R3-H8ca-48	48	X	30						10.0	1	1														
569	S-68	SR 46	397+40	RT	R3-9b-24	24	X	36	14.0					6.0																
	S-31		395+40	LT	R3-H8ba-30	30	X	30	13.5					6.3																
	S-32		402+50	RT	R2-1-24	24	X	30	13.5					5.0																
571	S-33	SR 46	402+51	LT	R3-9b-24	24	X	36	14.0					6.0																
	S-34		408+50	RT	R3-9b-24	24	X	36	14.0					6.0																
TOTALS CARRIED TO SHEET					546			332.5	16.5	4	144	76	274.6	906.6	7	3	4	0	1	1	8	11	0	14	0	0				

SIGNING SUBSUMMARY

DESIGN AGENCY

 DESIGNER: CTS
 REVIEWER: JMB 08/20/21
 PROJECT ID: 108547
 SHEET: 545 TOTAL: 704

