


STATE OF OHIO DEPARTMENT OF TRANSPORTATION

TRU-534-0.75

VILLAGE OF NEWTON FALLS

NEWTON TOWNSHIP

TRUMBULL COUNTY

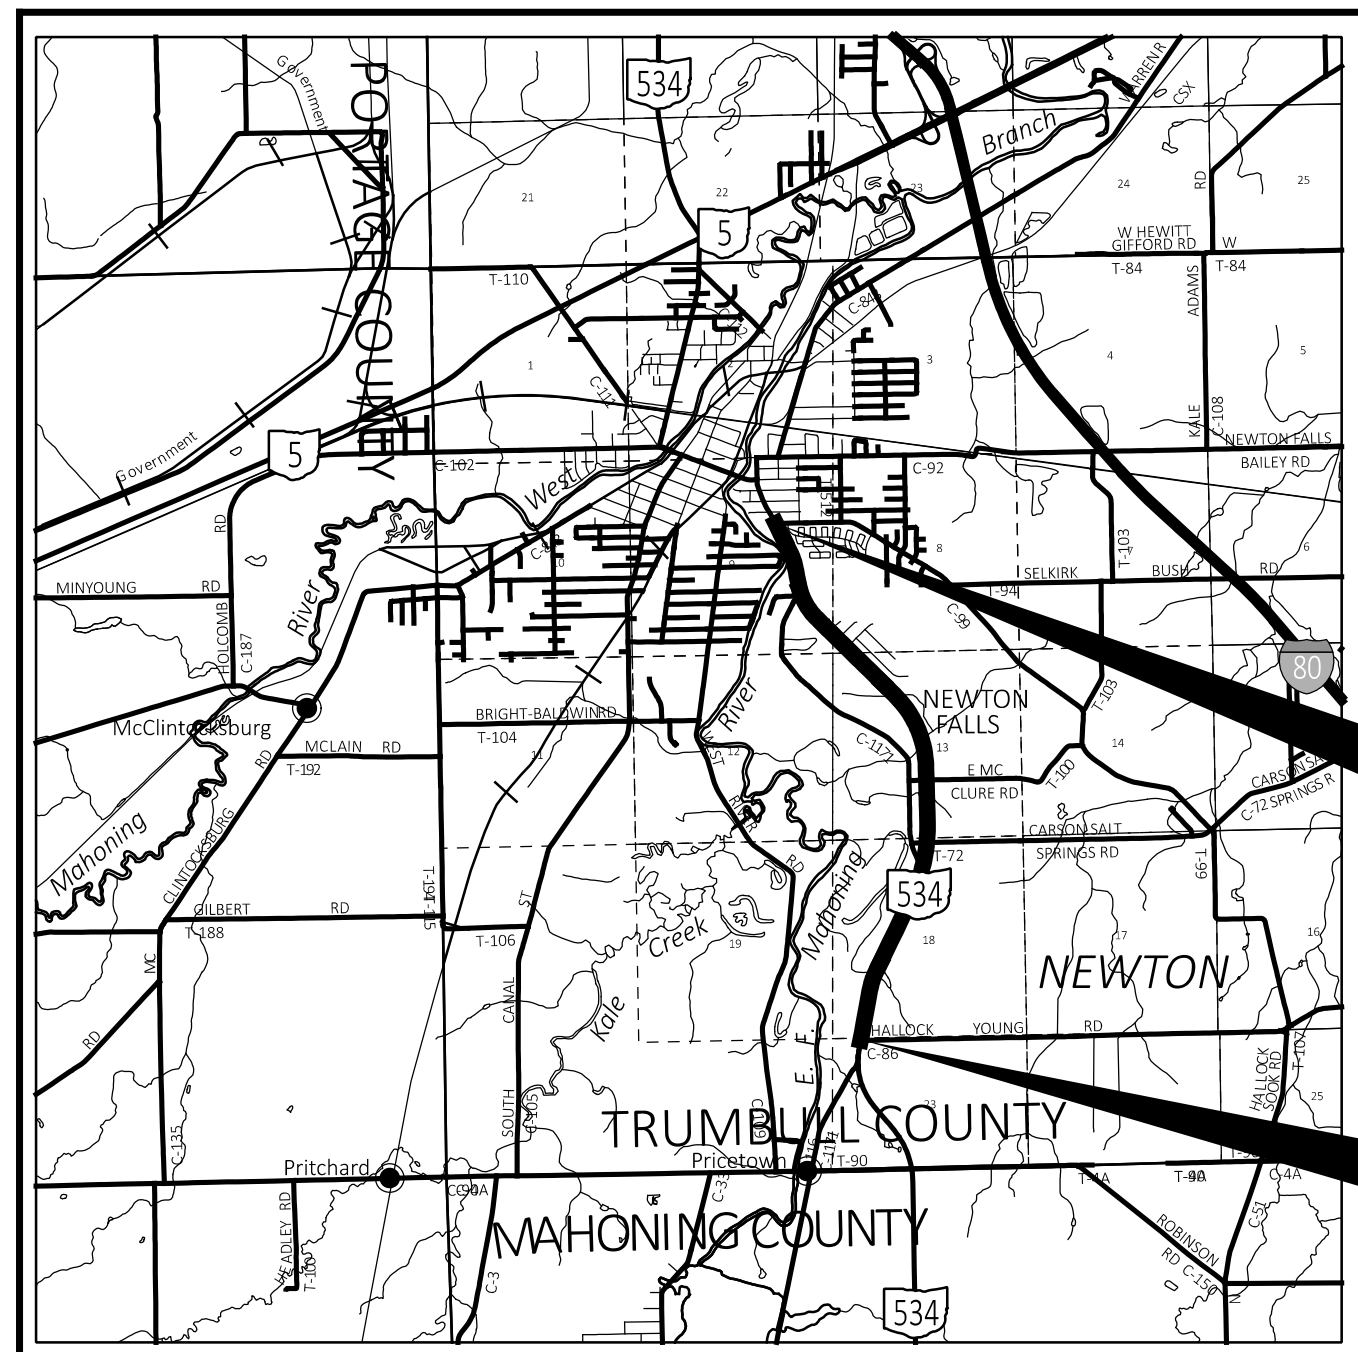

LOCATION MAP

LATITUDE: N41°09'45" LONGITUDE: W80°57'15"



PORTION TO BE IMPROVED	=====
INTERSTATE HIGHWAY	=====
FEDERAL ROUTES	=====
STATE ROUTES	=====
COUNTY & TOWNSHIP ROADS	=====
OTHER ROADS	=====

DESIGN DESIGNATION	SLM 0.75 TO	SLM 2.73 TO
	SLM 2.73	SLM 3.76
CURRENT ADT (2023)	4,016	4,919
DESIGN HOURLY VOLUME (2044)	391	531
DIRECTIONAL DISTRIBUTION	57%	51%
TRUCKS (24 HOUR B&C)	5%	3%
DESIGN SPEED	60 MPH	35 MPH
LEGAL SPEED	55 MPH	35 MPH
DESIGN FUNCTIONAL CLASSIFICATION:	05 - RURAL MAJOR COLLECTOR	05 - URBAN MAJOR COLLECTOR
NHS PROJECT	NO	

DESIGN EXCEPTIONS

NONE

ADA DESIGN WAIVERS

NONE

UNDERGROUND UTILITIES
Contact Two Working Days
Before You Dig

OHIO811.org
Before You Dig

OHIO811, 8-1-1, or 1-800-362-2764
(Non members must be called directly)

PLAN PREPARED BY:
ODOT DISTRICT 4, CAPITAL PLANNING
2088 S. ARLINGTON ROAD
AKRON, OHIO 44306

INDEX OF SHEETS:

TITLE SHEET	P.1
TYPICAL SECTIONS	P.2
GENERAL NOTES	P.3-P.4
MAINTENANCE OF TRAFFIC	P.5-P.6
GENERAL SUMMARY	P.7
PAVEMENT CALCULATIONS	P.8
PAVEMENT MARKING SUBSUMMARY	P.9

FEDERAL PROJECT NUMBER

E240233

RAILROAD INVOLVEMENT

NONE

PROJECT DESCRIPTION

RESURFACING OF TRU SR 534 FROM 0.75 TO 3.76

EARTH DISTURBED AREAS

PROJECT EARTH DISTURBED AREA:	N/A ACRES
ESTIMATED CONTRACTOR EARTH DISTURBED AREA:	0.25 ACRES
NOTICE OF INTENT EARTH DISTURBED AREA:	N/A ACRES

2023 SPECIFICATIONS

THE STANDARD SPECIFICATIONS OF THE STATE OF OHIO, DEPARTMENT OF TRANSPORTATION, INCLUDING SUPPLEMENTAL SPECIFICATIONS LISTED IN THE PLANS, CHANGES LISTED IN THE PROPOSAL, AND THE SUPPLEMENTAL SPECIFICATION 800 VERSION INDICATED ON THE PROPOSAL SHALL GOVERN THIS IMPROVEMENT.

I HEREBY APPROVE THESE PLANS AND DECLARE THAT THE MAKING OF THIS IMPROVEMENT WILL NOT REQUIRE THE CLOSING TO TRAFFIC OF THE HIGHWAY AND THAT PROVISIONS FOR THE MAINTENANCE AND SAFETY OF TRAFFIC WILL BE AS SET FORTH ON THE PLANS AND ESTIMATES.

Arthur G. Noiro Jr., P.E.
District 04 Deputy Director

Jack Marchbanks, PhD
Director, Department of Transportation

STANDARD CONSTRUCTION DRAWINGS				SUPPLEMENTAL SPECIFICATIONS	SPECIAL PROVISIONS
BP-3.1	1/21/22	TC-65.10	1/17/14	800-2023	1/19/24
BP-3.2	1/18/19	TC-65.11	7/15/22	832	7/21/23
BP-4.1	7/19/13	TC-71.10	4/21/23	872	1/21/22
				874	4/17/20
				875	1/18/19
MT-97.10	4/19/19				
MT-97.12	1/20/17				
MT-99.20	4/19/19				
MT-101.90	7/17/20				
MT-105.10	1/17/20				
TC-41.20	10/18/13				
TC-42.10	10/18/13				
TC-42.20	10/18/13				
TC-52.10	10/18/13				
TC-52.20	1/15/21				
TC-64.10	7/21/23				

ENGINEER'S SEAL

TITLE SHEET

DESIGN AGENCY	
DESIGNER	NKF
REVIEWER	CLF
PROJECT ID	12-26-23
SHEET	119190
TOTAL	9

TRU-534-0.75

MODEL: Sheet PAPER: 34x22 (in.) DATE: 8/16/2024 TIME: 2:56:11 PM USER: cgalitan pwc:\ohiodot-pw-bentley.com\ohiodot-pw-02\Documents\01 Active Projects\District 04\Trumbull\119190\400-Engineering\Roadway\Sheets\119190_GT001.dgn