


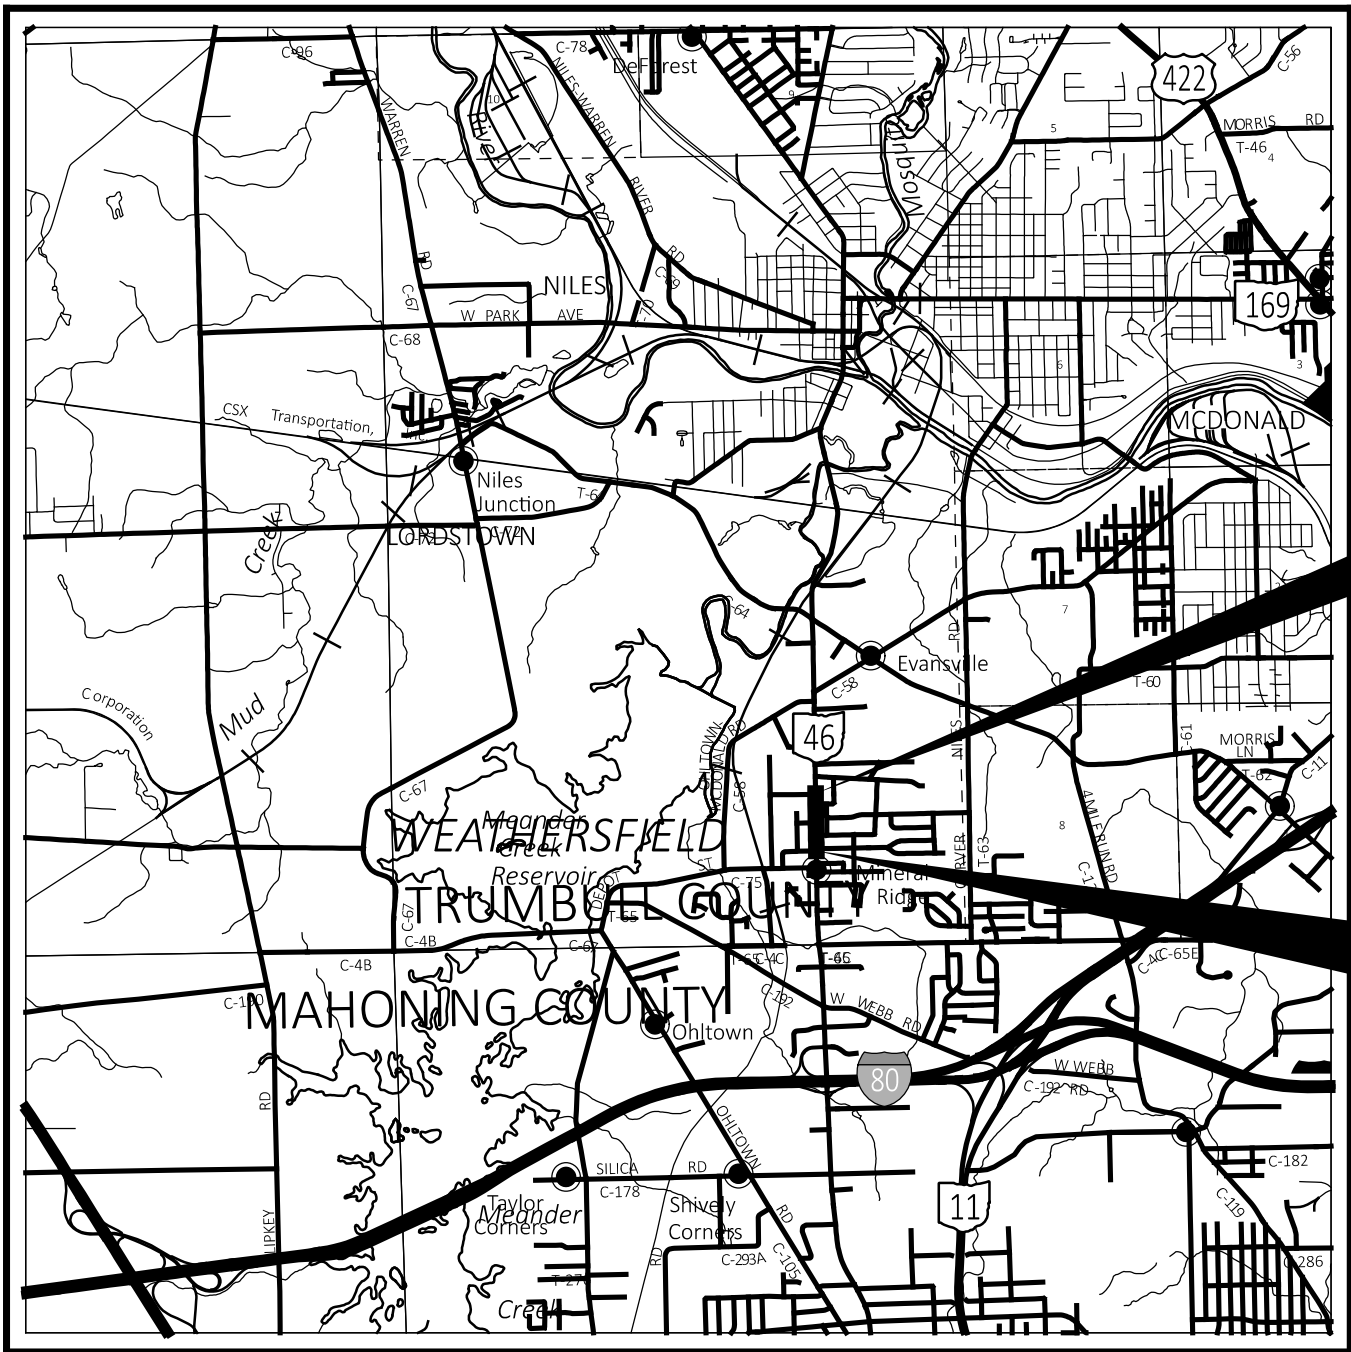

LOCATION MAP

LATITUDE: 41°08'35" LONGITUDE: -80°46'10"



PORTION TO BE IMPROVED	
INTERSTATE HIGHWAY	
FEDERAL ROUTES	
STATE ROUTES	
COUNTY & TOWNSHIP ROADS	
OTHER ROADS	

DESIGN DESIGNATION

CURRENT ADT (2025)	11,969
DESIGN YEAR ADT (2045)	N/A
DESIGN HOURLY VOLUME (2045)	1,093
DIRECTIONAL DISTRIBUTION	0.54
TRUCKS (24 HOUR B&C)	774 (6%)
DESIGN SPEED	40
LEGAL SPEED	35
DESIGN FUNCTIONAL CLASSIFICATION:	
03 OTHER PRINCIPAL ARTERIAL (URBAN)	
NHS PROJECT	NO

DESIGN EXCEPTIONS

NONE REQUIRED

ADA DESIGN WAIVERS

NONE REQUIRED

UNDERGROUND UTILITIES

Contact Two Working Days
Before You Dig


Before You Dig

OHIO811, 8-1-1, or 1-800-362-2764
(Non members must be called directly)

PLAN PREPARED BY:
ODOT DISTRICT 4, CAPITAL PROGRAMS
2088 S. ARLINGTON ROAD
AKRON, OH 44306

STATE OF OHIO

DEPARTMENT OF TRANSPORTATION

TRU-46-0.50

SIDEWALKS

WEATHERSFIELD TOWNSHIP

TRUMBULL COUNTY, OHIO

END PROJECT
STA. 141+81.18
SR 46 SLM 0.79

BEGIN PROJECT
STA. 125+54.35
SR 46 SLM 0.48

INDEX OF SHEETS:

TITLE SHEET	P.1
SCHEMATIC PLAN	P.2
TYPICAL SECTIONS	P.3
GENERAL NOTES	P.4 - P.5
MAINTENANCE OF TRAFFIC NOTES	P.6
GENERAL SUMMARY	P.7
SUBSUMMARIES	P.8 - P.10
PLAN AND PROFILE SHEETS	P.11 - P.14
CROSS SECTIONS	P.15 - P.35
TRAFFIC CONTROL	P.36 - P.37

FEDERAL PROJECT NUMBER

E251188

RAILROAD INVOLVEMENT

NONE

PROJECT DESCRIPTION

REPLACE SIDEWALKS ALONG TRU SR 46 BETWEEN MORRIS ST AND SEABORN ST
IN WEATHERSFIELD TOWNSHIP, TRUMBULL COUNTY, OHIO AND INSTALL
RECTANGULAR RAPID FLASHING BEACONS AT THE UNCONTROLLED PEDESTRIAN
CROSSING BY STEWART ST.


EARTH DISTURBED AREAS

PROJECT EARTH DISTURBED AREA:	0.83 ACRES
ESTIMATED CONTRACTOR EARTH DISTURBED AREA:	0.20 ACRES
NOTICE OF INTENT EARTH DISTURBED AREA:	N/A (NOI NOT REQUIRED)*
*ROUTINE MAINTENANCE PROJECT	

2023 SPECIFICATIONS

THE STANDARD SPECIFICATIONS OF THE STATE OF OHIO, DEPARTMENT OF
TRANSPORTATION, INCLUDING SUPPLEMENTAL SPECIFICATIONS LISTED IN
THE PLANS, CHANGES LISTED IN THE PROPOSAL, AND THE SUPPLEMENTAL
SPECIFICATION 800 VERSION INDICATED ON THE PROPOSAL SHALL GOVERN
THIS IMPROVEMENT.

I HEREBY APPROVE THESE PLANS AND DECLARE THAT THE MAKING OF THIS
IMPROVEMENT WILL NOT REQUIRE THE CLOSING TO TRAFFIC OF THE HIGHWAY
AND THAT PROVISIONS FOR THE MAINTENANCE AND SAFETY OF TRAFFIC
WILL BE AS SET FORTH ON THE PLANS AND ESTIMATES.

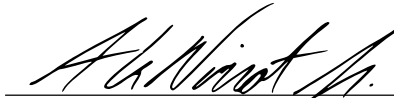
Arthur G. Noirot Jr., P.E.
District 04 Deputy Director


Pamela Boratyn
Director, Department of Transportation

STANDARD CONSTRUCTION DRAWINGS						SUPPLEMENTAL SPECIFICATIONS	SPECIAL PROVISIONS
BP-4.1	7/19/13	MT-97.10	7/18/25			800-2023 1/16/26	
BP-5.1	1/16/26	MT-97.12	1/16/26			832 7/18/25	
BP-7.1	1/16/26	MT-101.90	7/17/20				
BP-8.1	7/19/24	MT-105.10	1/17/20				
		MT-110.10	7/19/13				
DM-1.1	1/17/25						
DM-2.1	1/18/13	TC-42.20	10/18/13				
DM-4.3	1/15/16	TC-52.10	10/18/13				
DM-4.4	1/15/16	TC-52.20	1/15/21				
		TC-74.10	1/16/26				
LA-1.1	10/15/10	TC-83.30	1/16/26	added			
		TC-87.10	1/16/26				
MH-1	7/15/22						
RM-2.1	7/19/13						

ENGINEER'S SEAL



ITEM SPECIAL - AS-BUILT CONSTRUCTION PLANS

PRIOR TO FINAL ACCEPTANCE OF THE WORK, THE CONTRACTOR SHALL FURNISH THE DEPARTMENT FORMAL AS-BUILT CONSTRUCTION PLANS. THE FORMAL AS-BUILT CONSTRUCTION PLANS SHALL INCLUDE ALL RED-LINED CHANGES. RED-LINE CHANGE SHALL BE DENOTED UTILIZING CLOUDING IN MICROSTATION (OR OTHER CAD SOFTWARE) OR CLOUDING IN PDF EDITING SOFTWARE. THE AS-BUILT CONSTRUCTION PLANS SHALL HAVE A SIGNED VERIFICATION ON THE TITLE SHEET FROM THE CONTRACTOR INDICATING THAT ALL RED-LINED AND FIELD CHANGES HAVE BEEN INCORPORATED INTO AS-BUILT CONSTRUCTION PLANS.

THE CONTRACTORS VERIFICATION STATEMENT INDICATES ALL KNOWN FIELD MODIFICATIONS MADE HAVE BEEN INCLUDED IN THE FORMAL AS-BUILT CONSTRUCTION PLANS. THE CONTRACTORS VERIFICATION STATEMENT SHALL BE SIGNED BY THE CONTRACTORS PROJECT MANAGER (OR ACCEPTABLE REPRESENTATIVE).

IN ADDITION TO THE INFORMATION SHOWN ON THE CONSTRUCTION PLANS, THE AS-BUILT CONSTRUCTION PLANS SHALL SHOW THE FOLLOWING:

1. ALL DEVIATIONS FROM THE ORIGINAL APPROVED CONSTRUCTION PLANS WHICH RESULT IN A CHANGE OF LOCATION, MATERIAL, TYPE OR SIZE OF WORK.
2. ANY UTILITIES, PIPES, WELLHEADS, ABANDONED PAVEMENTS, FOUNDATIONS OR OTHER MAJOR OBSTRUCTIONS DISCOVERED AND REMAINING IN PLACE WHICH ARE NOT SHOWN, OR DO NOT CONFORM TO LOCATIONS OR DEPTHS SHOWN IN THE PLANS. UNDERGROUND FEATURES SHALL BE SHOWN AND LABELED ON THE AS-BUILT CONSTRUCTION PLANS IN TERMS OF STATION, OFFSET AND ELEVATION.
3. THE FINAL OPTION AND SPECIFICATION NUMBER SELECTED FOR THOSE ITEMS WHICH ALLOW SEVERAL MATERIAL OPTIONS UNDER THE SPECIFICATION (E.G., CONDUIT).
4. CHANGES TO THE PAY ITEMS AND FINAL QUANTITIES AS PAID SHALL BE SHOWN ON THE GENERAL SUMMARY AND SUBSUMMARIES.
5. ADDITIONAL PLAN SHEETS MAY BE NEEDED IF NECESSARY TO SHOW WORK NOT INCLUDED IN THE CONSTRUCTION PLANS. IF ADDITIONAL PLAN SHEETS ARE NEEDED, THEY ARE REQUIRED TO BE PREPARED IN CONFORMANCE WITH THE LOCATION AND DESIGN MANUAL, VOLUME 3, SECTION 1200 - PLAN PREPARATION.

NOTATION SHALL ALSO BE MADE OF LOCATIONS AND THE EXTENT OF USE OF MATERIALS, OTHER THAN SOIL, FOR EMBANKMENT CONSTRUCTION (ROCK, BROKEN CONCRETE WITHOUT REINFORCING STEEL, ETC.).

THE PLAN INDEX SHALL SHOW THE PLAN SHEETS WHICH HAVE CHANGES APPEARING ON THEM.

TWO COPIES OF THE AS-BUILT CONSTRUCTION PLANS SHALL BE DELIVERED TO THE PROJECT ENGINEER FOR APPROVAL UPON COMPLETION OF THE PHYSICAL WORK BUT PRIOR TO THE REQUEST FOR FINAL PAYMENT. AFTER THE DEPARTMENT HAS APPROVED THE AS-BUILT CONSTRUCTION PLANS, THE ASSOCIATED ELECTRONIC FILES SHALL BE DELIVERED TO THE DISTRICT CAPITAL PROGRAMS ADMINISTRATOR. ACCEPTANCE OF THESE PLANS AND DELIVERY OF THE ASSOCIATED ELECTRONIC FILES IS REQUIRED PRIOR TO THE WORK BEING ACCEPTED AND THE FINAL ESTIMATE APPROVED.

PAYMENT FOR ALL THE ABOVE SHALL BE LUMP SUM UPON PROPER EXECUTION OF ALL WORK OF THIS ITEM AS DETERMINED BY THE PROJECT ENGINEER.

630 SIGNING MISC.: SOLAR-POWERED RECTANGULAR RAPID FLASHING BEACON (RRFB) SIGN ASSEMBLY

THIS WORK SHALL CONSIST OF FURNISHING AND INSTALLING A SOLAR POWERED RECTANGULAR RAPID FLASHING BEACON (RRFB) SIGN ASSEMBLY. THE FLASHING UNIT SHALL BE SOLAR POWERED, PEDESTRIAN ACTIVATED, AND 2-SIDED WITH TWO LED ARRAY BASED YELLOW INDICATIONS ON EACH SIDE. MULTIPLE UNITS SHALL BE WIRELESSLY CONTROLLED AND SYNCHRONIZED. THE UNIT SHALL BE COMPLIANT WITH THE MOST CURRENT OHIO MANUAL OF UNIFORM TRAFFIC CONTROL DEVICES (OMUTCD) AND FHWA INTERIM APPROVAL FOR RRFBs (IA-21).

GENERAL REQUIREMENTS -

EACH RRFB SHALL CONSIST OF TWO RAPIDLY FLASHED RECTANGULAR-SHAPED YELLOW INDICATIONS HAVING LED ARRAY BASED LIGHT SOURCE.

EACH RRFB SHALL BE A COMPLETE ASSEMBLY, CONSISTING OF BUT NOT LIMITED TO, SIGNAGE, SIGN MOUNTING HARDWARE, INDICATIONS AND ELECTRICAL COMPONENTS (WIRING, SOLID-STATE CIRCUIT BOARDS, ETC.).

EACH RRFB SHALL CONTAIN A PEDESTRIAN INDICATION LIGHT VISIBLE BY THE PEDESTRIAN IN THE DIRECTION OF TRAVEL.

FUNCTIONAL REQUIREMENTS -

EACH RRFB SHALL UTILIZE SOLAR POWER.

EACH RRFB SHALL BE ACTIVATED BY ADA COMPLIANT ACCESSIBLE PEDESTRIAN PUSHBUTTONS.

THE RRFB SHALL BE NORMALLY DARK, SHALL INITIATE OPERATION ONLY UPON PEDESTRIAN ACTUATION, AND SHALL CEASE OPERATION AFTER A PREDETERMINED TIME LIMIT (BASED ON OMUTCD PROCEDURES).

EACH REMOTE RRFB SHALL BE WIRELESSLY ACTIVATED.

ALL RRFB LIGHT INDICATIONS SHALL BE WIRELESSLY SYNCHRONIZED (ALL LIGHTS WILL TURN ON WITHIN 120 MSEC & REMAIN SYNCHRONIZED THROUGHOUT THE DURATION OF THE FLASHING CYCLE).

THE UNIT SHALL BE CAPABLE OF RUNNING 14 DAYS WITHOUT SUNLIGHT.

MATERIALS -

FURNISH A COMPLETE ASSEMBLY, CONSISTING OF BUT NOT LIMITED TO SIGNAGE, SIGN MOUNTING HARDWARE, INDICATIONS & ELECTRICAL

COMPONENTS (WIRING, SOLID-STATE CIRCUIT BOARDS, ETC.). THE RRFB ASSEMBLY INCLUDES THE FOLLOWING ITEMS:

1. RRFB INDICATIONS

A. EACH RRFB INDICATION LENS SHALL BE A MINIMUM SIZE OF APPROXIMATELY 5" WIDE X 2" HIGH.

B. THE RRFB INDICATIONS SHALL BE ALIGNED HORIZONTALLY, WITH THE LONGER DIMENSION OF THE INDICATION HORIZONTAL. THERE SHALL BE TWO INDICATIONS ON THE FRONT AND TWO INDICATIONS ON THE BACK.

C. EACH RRFB SHALL BE SUPPLIED WITH ALL REQUIRED HARDWARE TO INSTALL ASSEMBLY. ALL EXPOSED HARDWARE SHALL BE ANTI-VANDAL.

D. EACH RRFB SHALL BE LOCATED BETWEEN THE BOTTOM OF THE CROSSING WARNING SIGN AND THE TOP OF THE SUPPLEMENTAL DOWNWARD DIAGONAL ARROW PLAQUE.

E. THE LIGHT INTENSITY OF THE YELLOW INDICATIONS SHALL MEET THE MINIMUM CLASS 1 SPECIFICATIONS OF SOCIETY OF AUTOMOTIVE ENGINEERS (SAE) STANDARD J595 (DIRECTIONAL FLASHING OPTICAL WARNING DEVICES FOR AUTHORIZED EMERGENCY, MAINTENANCE & SERVICE VEHICLES) DATED JANUARY, 2005.

F. TO MINIMIZE EXCESSIVE GLARE DURING NIGHTTIME CONDITIONS, AN AUTOMATIC SIGNAL DIMMING DEVICE SHALL BE USED TO REDUCE THE BRILLIANCE OF THE RRFB INDICATIONS.

G. An LED PEDESTRIAN CONFIRMATION LIGHT DIRECTED AT AND VISIBLE TO PEDESTRIANS IN THE CROSSWALK SHALL BE INSTALLED INTEGRAL TO THE RRFB OR PUSHBUTTON TO GIVE CONFIRMATION THAT THE RRFB IS IN OPERATION.

H. THE PEDESTRIAN CONFIRMATION LIGHT SHALL HAVE A MINIMUM AREA OF 0.5 SQUARE INCHES & BE CONSPICUOUS EDESTRIANS AT ALL DISTANCES FROM THE BEGINNING OF THE CONTROLLED CROSSWALK TO A POINT 10 FEET FROM THE END OF THE CONTROLLED CROSSWALK DURING BOTH DAY & NIGHT.

2. SIGNS

- A. ALL SIGN ASSEMBLIES SHALL USE ANTI-VANDAL FASTENERS TO MOUNT COMPONENTS TO SIGN AND SIGN TO FIXTURE.
- B. ACCESSIBLE PEDESTRIAN PUSHBUTTONS SIGNS SHALL BE PROVIDED AND INCLUDE THE LEGEND "PUSH BUTTON FOR WARNING LIGHTS/WAIT FOR GAP IN TRAFFIC". SIGNS SHOULD BE MOUNTED ADJACENT TO OR INTEGRAL WITH EACH PEDESTRIAN PUSHBUTTON.

C. TWO SETS OF SIGNS SHALL BE REQUIRED PER UNIT FOR VIEW FROM EACH APPROACH.

D. ENSURE THE ASSURE SIGN MEETS THE REQUIREMENTS OF C&MS 630.

3. CONTROL CIRCUIT

A. THE CONTROL CIRCUIT SHALL HAVE THE CAPABILITY OF INDEPENDENTLY FLASHING UP T TWO INDEPENDENT OUTPUTS. THE LED LIGHT OUTPUTS AND FLASH PATTERN SHALL BE COMPLETELY PROGRAMMABLE.

B. THE CONTROL CIRCUIT SHALL BE SEALED WATERTIGHT TO ELIMINATE DIRT CONTAMINATION AND ALLOW FOR SAFE HANDLING IN ALL WEATHER CONDITIONS.

C. THE LEDS SHALL BE SEALED AGAINST DUST AND MOISTURE INTRUSION AS PER THE REQUIREMENTS OF NEMA STANDARD 250-1991 FOR TYPE 4 ENCLOSURE AND TO PROTECT ALL INTERNAL LED AND ELECTRICAL COMPONENTS.

4. BATTERY AND SOLAR PANELS

A. BATTERY UNIT SHALL BE A 12VDC, 35 AHR MINIMUM, SEALED GEL OR AGM LEAD ACID BATTERY. BATTERIES SHALL HAVE A WRITTEN TWO YEAR FULL REPLACEMENT WARRANTY.

B. THE SOLAR PANEL SHALL PROVIDE A MINIMUM OF 40 WATTS PEAK TOTAL OUTPUT.

C. THE SOLAR PANEL SHALL BE MOUNTED TO AN ALUMINUM PLATE AND BRACKET AT AN ANGLE OF 45 DEGREES - 60 DEGREES TO PROVIDE MAXIMUM OUTPUT.

D. ALL FASTENERS USED SHALL BE ANTI-VANDAL.

5. WIRELESS RADIO

A. RADIO CONTROL SHALL OPERATE ON A 900 MHZ FREQUENCY HOPPING SPREAD SPECTRUM NETWORK, WI-FI OR APPROVED EQUAL.

B. RADIO SHALL INTEGRATE COMMUNICATION OF RRFB CONTROL CIRCUIT TO ACTIVATE SIGN FROM PUSHBUTTON INPUT.

C. THE RADIO SHALL BE SYNCHRONIZED SO ALL OF THE REMOTE RRFB LIGHT INDICATIONS WILL TURN ON WITHIN 120 MSEC OF EACH OTHER AND REMAIN SYNCHRONIZED THROUGH-OUT THE DURATION OF THE FLASHING CYCLE.

6. ACCESSIBLE PEDESTRIAN PUSHBUTTON

A. THE PUSHBUTTON SHALL BE CAPABLE OF CONTINUOUS OPERATION OVER A TEMPERATURE RANGE OF -30 DEGREES F TO +165 DEGREES F.

B. PUSHBUTTON SHALL BE ADA COMPLIANT.

7. PEDESTAL SHAFT AND BASE - MOUNT ON AN ALUMINUM PEDESTAL POLE PER SCD TC-83.30 WITH BREAKAWAY BASE. A 17.5 FOOT POLE SHALL BE PROVIDED AND FIELD ADJUSTED AND CAPPED TO MAINTAIN THE PROPER SIGN MOUNTING HEIGHTS, UNLESS SPECIFIED OTHERWISE IN THE PLANS. POLE AND BASE MANUFACTURER SHALL BE LISTED ON ODOT'S QUALIFIED PRODUCTS LIST.

CONSTRUCTION -

THE RRFB SHALL BE ASSEMBLED AND CONSTRUCTED BY THE CONTRACTOR AS SHOWN AND SPECIFIED ON THE PLANS.

WARRANTY -

WARRANTY SHALL BE TWO YEARS FROM THE DATE OF FINAL ACCEPTANCE.

MEASUREMENT -

THE DEPARTMENT WILL MEASURE THE ITEM COMPLETE IN PLACE, INCLUDING ALL MATERIALS, TESTING, LABOR AND SOFTWARE FOR A FULLY FUNCTIONAL UNIT.

PAYMENT -

PAYMENT WILL BE AT THE CONTRACT UNIT PRICE PER EACH FOR ITEM 630 "SIGNING MISC.: SOLAR POWERED RECTANGULAR RAPID FLASHING BEACON (RRFB) SIGN ASSEMBLY".

revised

DESIGN AGENCY



DESIGNER

FA

REVIEWER

RMM 01/30/26

PROJECT ID

120979

SHEET

P.5

TOTAL

37

SHEET NUMBER													PART.	ITEM	ITEM	GRAND	UNIT	DESCRIPTION	SEE SHEET NO.
P.4	P.5	P.6	P.8	P.9	P.10	P.35	P.36	P.37					01/S>2		EXT	TOTAL			
LS													LS	201	11000	LS		ROADWAY	
				27									27	202	23000	27	SY	CLEARING AND GRUBBING	
					5								5	202	23500	5	SY	PAVEMENT REMOVED	
					39								39	202	32000	39	FT	WEARING COURSE REMOVED (T=1.25")	
					10								10	202	32500	10	FT	CURB REMOVED	
																		CURB AND GUTTER REMOVED	
					25								25	202	32601	25	FT	GUTTER REMOVED, AS PER PLAN	P.4
			12,782		655								13,437	202	30000	13,437	SF	WALK REMOVED	
			32	72	1	87							192	203	10000	192	CY	EXCAVATION	Revised
						47							47	203	20000	47	CY	EMBANKMENT	
			9,820										9,820	608	10000	9,820	SF	4" CONCRETE WALK	
					483								483	608	52000	483	SF	CURB RAMP	
					261								261	608	52001	261	SF	CURB RAMP, AS PER PLAN	P.4
	LS												LS	SPECIAL	69091000	LS		AS-BUILT CONSTRUCTION PLANS	P.5
																		EROSION CONTROL	
193													193	659	00300	193	CY	TOPSOIL	
1,738													1,738	659	10000	1,738	SY	SEEDING AND MULCHING	
0.23													0.23	659	20000	0.23	TON	COMMERCIAL FERTILIZER	
0.36													0.36	659	31000	0.36	ACRE	LIME	
10													10	659	35000	10	MGAL	WATER	
													3,000	832	30000	3,000	EACH	EROSION CONTROL	
																		DRAINAGE	
			1										1	611	99654	1	EACH	MANHOLE ADJUSTED TO GRADE	
																		PAVEMENT	
					1								1	301	56000	1	CY	ASPHALT CONCRETE BASE, PG64-22, (449) (T=5")	
					1								1	407	20000	1	GAL	NON-TRACKING TACK COAT	
					10								11	441	70000	11	CY	ASPHALT CONCRETE SURFACE COURSE, TYPE 1, (449), PG64-22 (T=1.25")	
			124	18									139	452	10010	139	SY	6" NON-REINFORCED CONCRETE PAVEMENT, CLASS QC 1P	
			391	336									727	452	12010	727	SY	8" NON-REINFORCED CONCRETE PAVEMENT, CLASS QC 1P	Revised
					34								34	609	26000	34	FT	CURB, TYPE 6	
					1								1	617	10100	1	CY	COMPACTED AGGREGATE (T=2")	
																		WATER WORK	
			1										1	638	10800	1	EACH	VALVE BOX ADJUSTED TO GRADE	
																		OTHER UTILITIES	Added
			3										3	SPECIAL	61199700	3	EACH	GAS VALVE BOX ADJUSTED TO GRADE	
																		TRAFFIC CONTROL	
								13					13	630	03100	13	FT	GROUND MOUNTED SUPPORT, NO. 3 POST	
							5						5	630	03101	5	FT	GROUND MOUNTED SUPPORT, NO. 3 POST, AS PER PLAN	P.36
								1					1	630	08600	1	EACH	SIGN POST REFLECTOR	
							6.3						6.3	630	80100	6.3	SF	SIGN, FLAT SHEET	
							4						4	630	84900	4	EACH	REMOVAL OF GROUND MOUNTED SIGN AND DISPOSAL	
								1					1	630	85100	1	EACH	REMOVAL OF GROUND MOUNTED SIGN AND REERECTION	
								2					2	630	86002	2	EACH	REMOVAL OF GROUND MOUNTED POST SUPPORT AND DISPOSAL	
								4					4	630	87500	4	EACH	REMOVAL OF POLE MOUNTED SIGN AND DISPOSAL	
								2					2	630	87521	2	EACH	REMOVAL OF POLE MOUNTED SIGN AND REERECTION, AS PER PLAN	P.37
								2					2	630	97700	2	EACH	SIGNING, MISC.:REMOVAL OF REFLECTOR	P.36
							2						2	630	97700	2	EACH	SIGNING, MISC.:SOLAR POWERED RECTANGULAR RAPID FLASHING BEACON (RRFB) SIGN ASSEMBLY	P.5
							10	14					24	646	10400	24	FT	STOP LINE	
							50	100					150	646	10520	150	FT	CROSSWALK LINE, 24"	
							70						70	646	50100	70	FT	REMOVAL OF PAVEMENT MARKING	
																		TRAFFIC SIGNALS	Added
			1										1	625	31510	1	EACH	PULL BOX REMOVED	
																		MAINTENANCE OF TRAFFIC	
													50	614	11110	50	HOURL	LAW ENFORCEMENT OFFICER WITH PATROL CAR FOR ASSISTANCE	
			50										0.3	616	10000	0.3	MGAL	WATER	
			0.3															INCIDENTALS	
													LS	614	11000	LS		MAINTAINING TRAFFIC	
													6	619	16010	6	MNTH	FIELD OFFICE, TYPE B	
													LS	623	10000	LS		CONSTRUCTION LAYOUT STAKES AND SURVEYING	
													LS	624	10000	LS		MOBILIZATION	

GENERAL SUMMARY

DESIGN AGENCY



DESIGNER

FA

REVIEWER

RMM 01/30/26

PROJECT ID

120979

SHEET

P.7



TOTAL


37

REF NO.	SHEET NO.	STATION RANGE			TYPICAL SECTION	SIDE	DISTANCE (D)	AVERAGE WIDTH (W)	SURFACE AREA (A) A=DxW/9	CADD GENERATED AREA	202	203	452	452	608	608	611	SPECIAL	625	638										
							FT	FT	SY		SY	SF	CY	SY	SY	SF	SF	EACH	EACH	EACH	EACH									
SW-1	P.11	125+54.35	TO	125+59.35	1	RT.	5.00	5.00	2.78			0.31			25.00															
SW-2	P.11	125+59.35	TO	125+81.35	1	RT.	22.00	5.00	12.22			2.72		12.22																
SW-3	P.11	125+81.35	TO	126+25.24	1	RT.	43.89	5.00	24.38			2.71			219.45			2.00	1.00											
SW-4	P.11	126+70.61	TO	127+72.69	1	RT.	102.08	5.00	56.71	510.40					510.40															
SW-5	P.11	127+72.69	TO	127+89.12	1	RT.	16.43	5.00	9.13				9.13																	
SW-6	P.11	127+89.12	TO	129+83.16	1	RT.	194.04	5.00	107.80	970.20					970.20															
SW-7	P.12	130+26.85	TO	131+52.09	1	RT.	125.24	5.00	69.58	626.20					626.20															
SW-8	P.12	131+52.09	TO	131+73.05	1	RT.	20.96	5.00	11.64	104.80				11.64																
SW-9	P.12	131+73.05	TO	135+36.87	1	RT.	363.82	5.00	202.12	1819.10					1819.10			1.00												
SW-10	P.13	135+88.90	TO	136+96.24	1	RT.	107.34	5.00	59.63	536.70					536.70															
SW-11	P.13	136+96.24	TO	137+18.45	1	RT.	22.21	5.00	12.34	111.05			12.34																	
SW-12	P.13	137+18.45	TO	137+70.14	1	RT.	51.69	5.00	28.72	258.45					258.45															
SW-13	P.13	137+70.14	TO	137+95.27	1	RT.	25.13	5.00	13.96	125.65			13.96																	
SW-14	P.13	137+95.27	TO	138+43.85	1	RT.	48.58	5.00	26.99	242.90					242.90															
SW-15	P.13	138+88.72	TO	140+24.42	1	RT.	135.70	5.00	75.39	678.50					678.50															
SW-16	P.14	140+24.42	TO	140+37.01	1	RT.	12.59	5.00	6.99	62.95			6.99																	
SW-17	P.14	140+37.01	TO	140+99.52	1	RT.	62.51	5.00	34.73	312.55					312.55															
SW-18	P.14	140+99.52	TO	141+10.49	1	RT.	10.97	5.00	6.09	54.85			6.09																	
SW-19	P.14	141+10.49	TO	141+81.18	1	RT.	70.69	5.00	39.27	353.45					353.45	1.00														
SW-20	P.11	126+10.13	TO	127+30.88	1	LT.	120.75	5.00	67.08	603.75				67.08																
SW-21	P.11	127+30.88	TO	127+38.78	1	LT.	7.90	5.00	4.39	39.50					39.50															
SW-22	P.11	127+38.78	TO	127+51.18	1	LT.	12.40	5.00	6.89	62.00					6.89															
SW-23	P.11	127+51.18	TO	128+05.60	1	LT.	54.42	5.00	30.23	272.10					272.10															
SW-24	P.11	128+05.60	TO	128+20.57	1	LT.	14.97	5.00	8.32	74.85				8.32																
SW-25	P.11	128+20.57	TO	128+43.54	1	LT.	22.97	5.00	12.76	114.85					114.85															
SW-26	P.11	128+43.54	TO	128+69.00	1	LT.	25.46	5.00	14.14	127.30				14.14																
SW-27	P.11	128+69.00	TO	131+12.47	1	LT.	243.47	5.00	135.26	1217.35					1217.35				1.00											
SW-28	P.12	131+12.47	TO	131+37.80	1	LT.	25.33	5.00	14.07	126.65				14.07																
SW-29	P.12	131+37.80	TO	132+24.60	1	LT.	86.80	5.00	48.22	434.00					434.00															
SW-30	P.12	132+24.60	TO	133+25.09	1	LT.	100.49	5.00	55.83	502.45					55.83															
SW-31	P.12	133+73.49	TO	134+19.54	1	LT.	46.05	5.00	25.58	230.25					230.25															
SW-32	P.12	134+19.54	TO	134+32.61	1	LT.	13.07	5.00	7.26	65.35				7.26																
SW-33	P.12	134+32.61	TO	135+03.48	1	LT.	70.87	5.00	39.37	354.35					354.35															
SW-34	P.13	135+03.48	TO	136+34.92	1	LT.	131.44	5.00	73.02	657.20				73.02																
SW-35	P.13	136+34.92	TO	137+08.15	1	LT.	73.23	5.00	40.68	366.15					366.15															
SW-36	P.13	137+08.15	TO	137+44.55	1	LT.	36.40	5.00	20.22	182.00					20.22															
SW-37	P.13	137+44.55	TO	137+92.25	1	LT.	47.70	5.00	26.50	238.50					238.50															
SW-38	P.13	137+92.25	TO	139+27.25	1	LT.	135.00	5.00	75.00	345.00		4.07	75.00																	
SW-39	P.14	139+27.25	TO	141+06.03	1	LT.	178.78	5.00	99.32			22.07		99.32																
</																														


MODEL: Sheet PAPERSIZE: 34x22 (in.) DATE: 7/2/2026 TIME: 10:49:51 AM PLTDRY: OHDOT_PDF.pltgrc PENITBL: 120979_OHDOT_UTPen.tbl USER: Fahad.Ahmadzal@dot.ohio.gov WORKSPACE: OHDOTCEv02 WORKSET: 120979 PRODUCT: OpenRoadsDesigner 24.00.00.2005
pw:\ohiodot-pw-bentley.com:\ohiodot-pw-02\Documents\01 Active Projects\District 04\Trumbull\120979\400-Engineering\Roadway\Sheets\120979_GS002.dgn

[illegible]

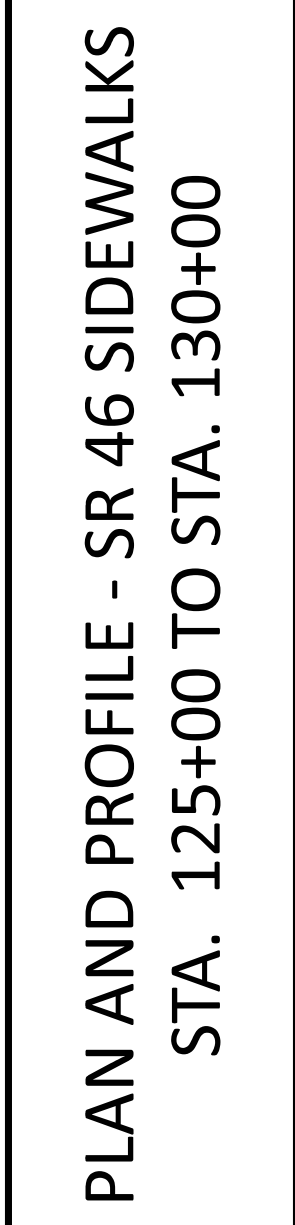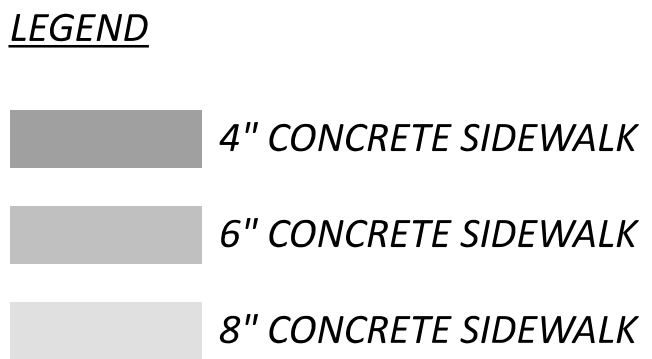

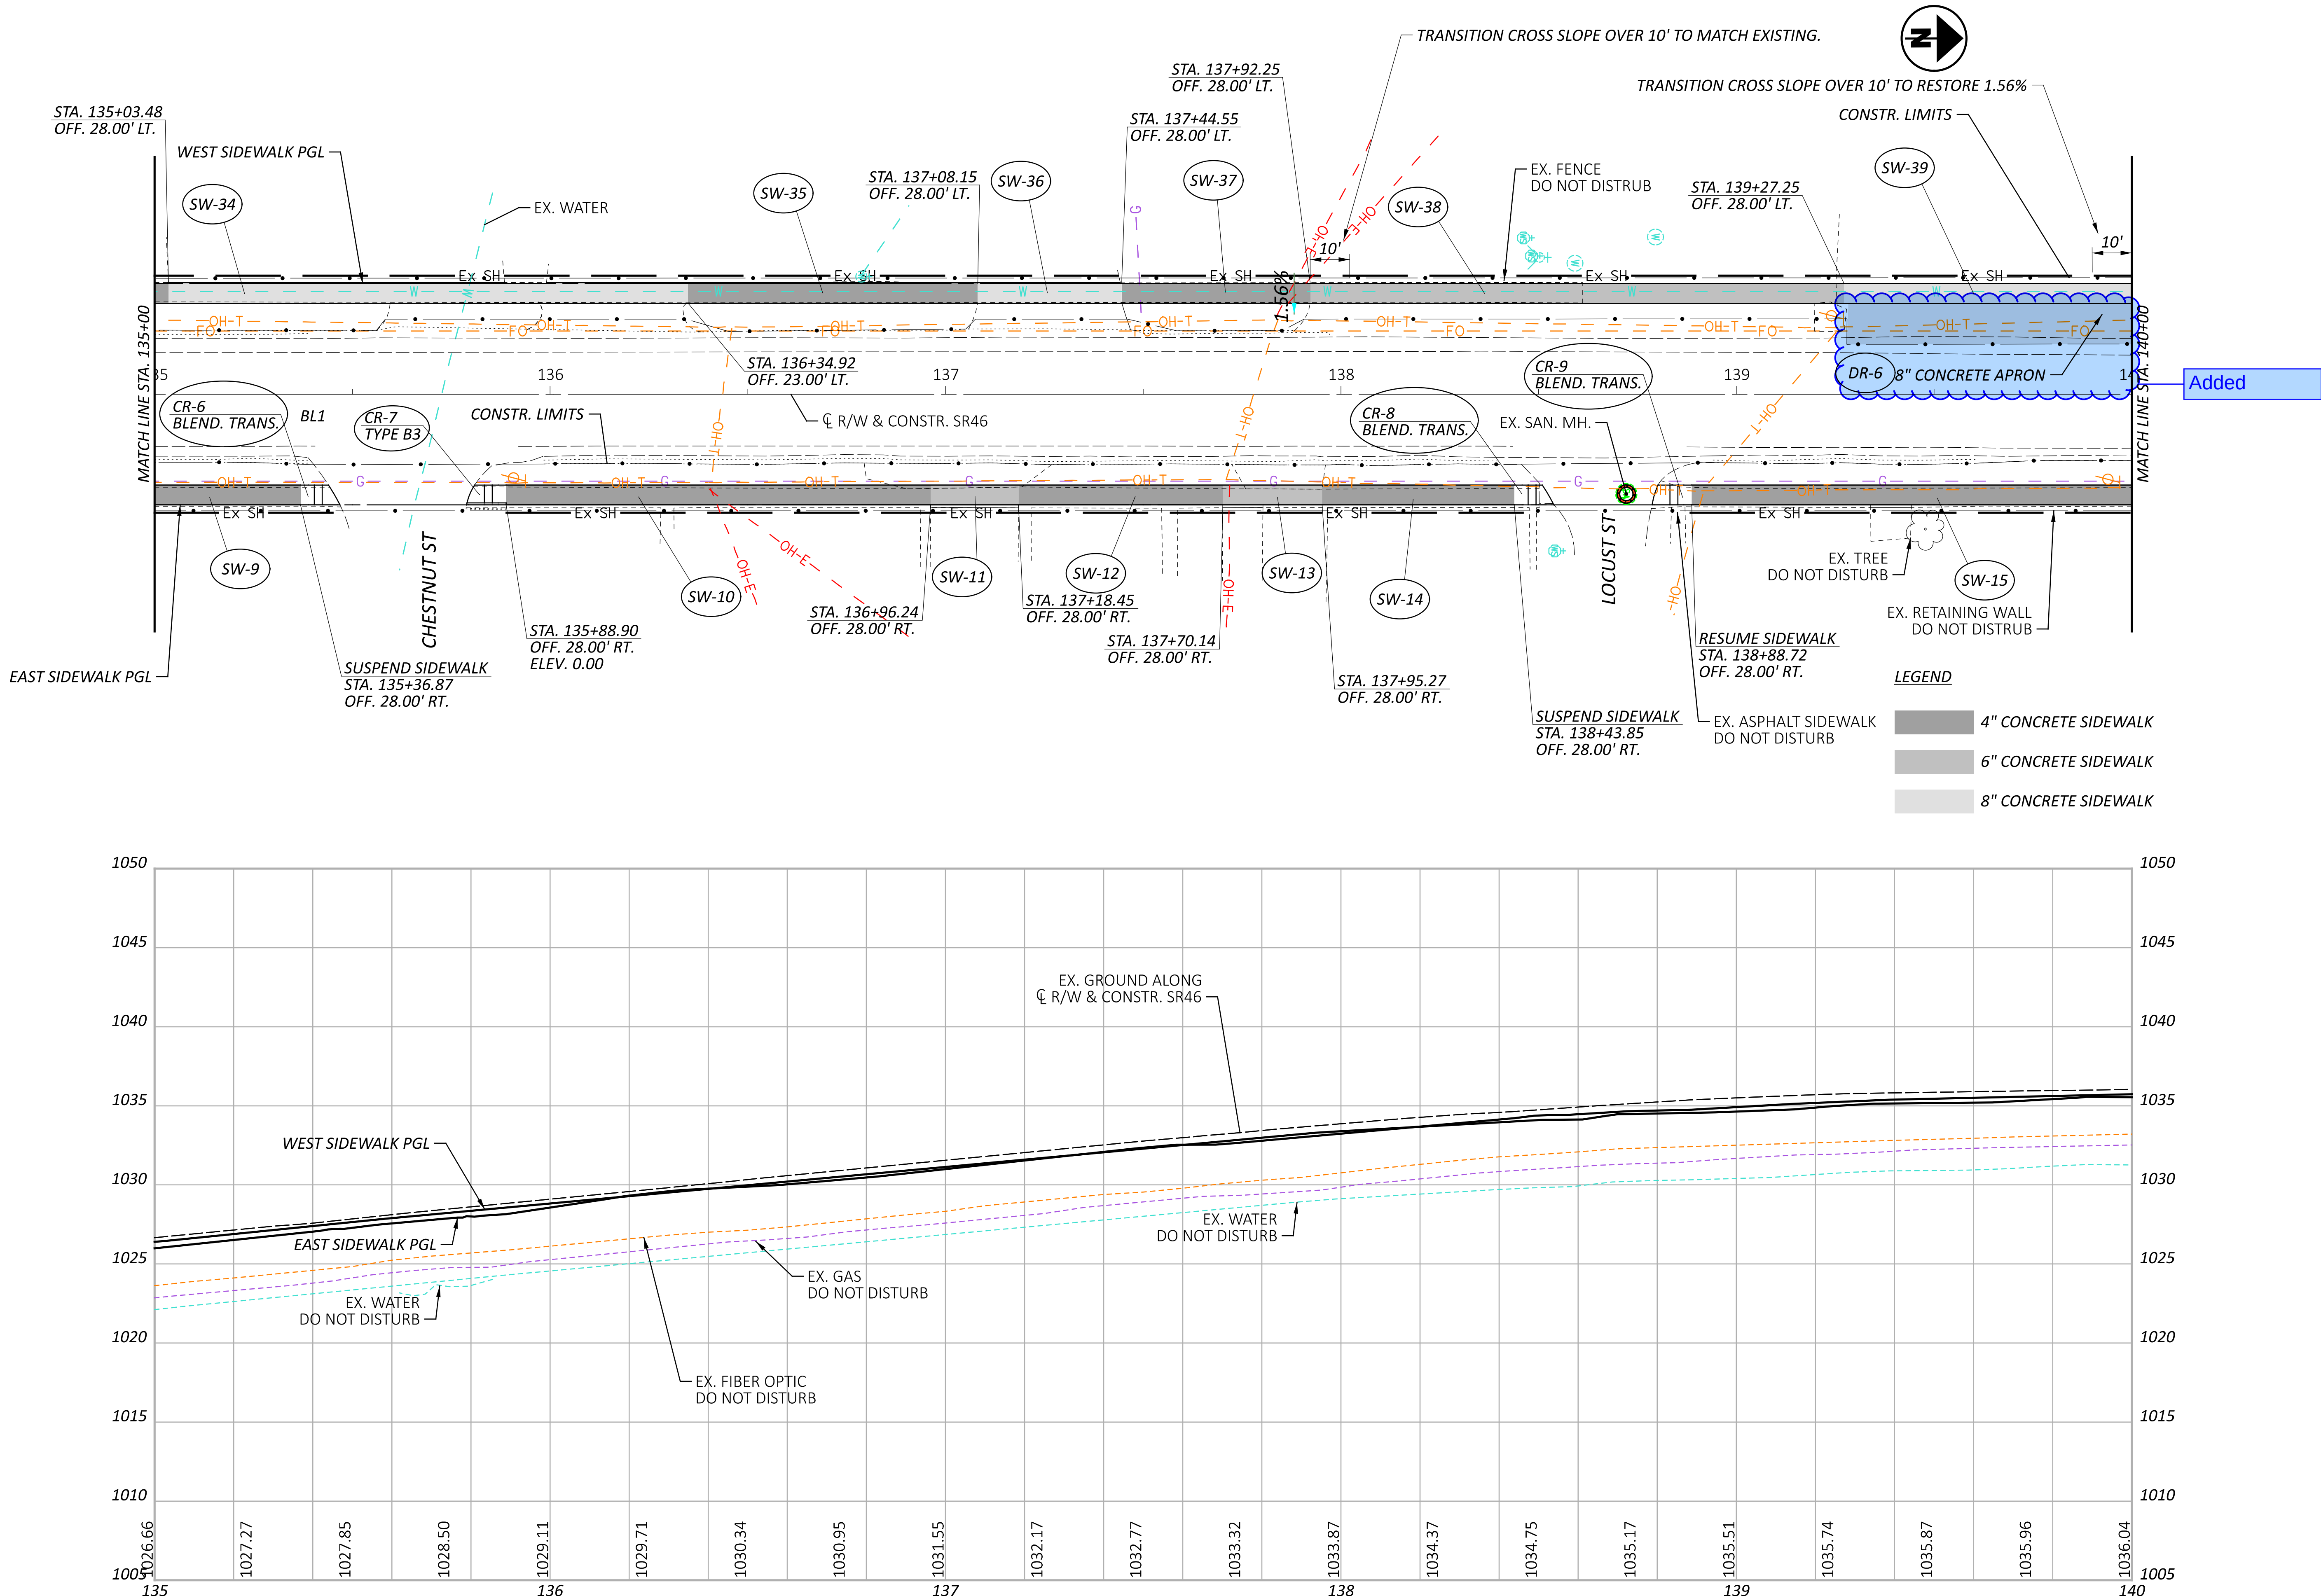

PLAN AND PROFILE - SR 46 SIDEWALKS
STA. 135+00 TO STA. 140+00

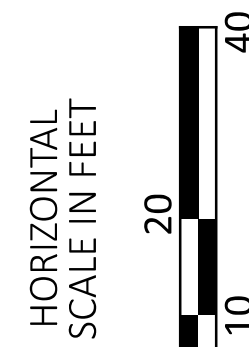

DESIGN AGENCY



DESIGNER

FA

REVIEWER

RMM 01/30/26

PROJECT ID




120979

SHEET

P.13

TOTAL

37

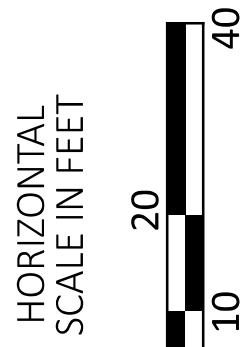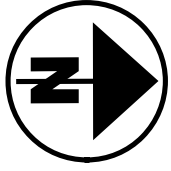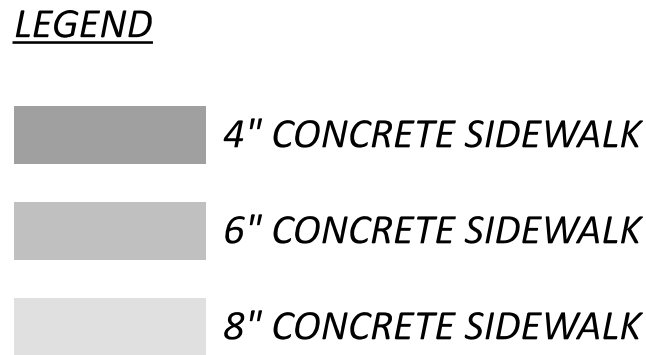


PLAN AND PROFILE - SR 46 SIDEWALKS
STA. 140+00 TO STA. 141+81

DESIGN AGENCY	
	
DESIGNER	
FA	
REVIEWER	
RMM 01/30/26	
PROJECT ID	
120979	
SHEET	TOTAL
P.14	37


TRU-46-0.50 (Sidewalks)

MODEL: CLRW0465 - Plan 1 [Sheet] PAPER: 34x22 (in.) DATE: 7/8/2026 TIME: 2:36:59 PM PLOTTER: OHDOT_PDF.plt PLOT: OHDOT_UTPEN.tbl USER: Kuldeep.Yadav@dot.ohio.gov WORKSPACE: OHDOTCv02 WORKSET: 120979 PRODUCT: OpenRoadsDesigner 24.00.00.205
 pw:\johidott-pw.bentley.com:ohidott-pw-02\Documents\01 Active Projects\District 04\Trumbull\120979\400-Engineering\Traffic\Sheets\120979_TP001.dgn

REF NO.		SHEET NO.	STATION	SIDE	CODE *PLYWOOD # YELLOW/GREEN ## WHITE ON BROWN	SIZE (INCHES)	630	630	630	630	630	630	630	630	646	646	646
							SIGNING, MISC.:SOLAR POWERED RECTANGULAR RAPID FLASHING BEACON (RRFB) SIGN ASSEMBLY	REMOVAL OF GROUND MOUNTED SIGN AND DISPOSAL	REMOVAL OF GROUND MOUNTED POST SUPPORT AND DISPOSAL	REMOVAL OF POLE MOUNTED SIGN AND DISPOSAL	SIGNING, MISC.:REMOVAL OF REFLECTOR	SIGN, FLAT SHEET	REMOVAL OF GROUND MOUNTED SIGN AND REERECTION	GROUND MOUNTED SUPPORT, NO. 3 POST, AS PER PLAN	CROSSWALK LINE, 24", HIGH VISIBILITY	REMOVAL OF PAVEMENT MARKING	STOP LINE
							EACH	EACH	EACH	EACH	EACH	SF	EACH	FT	FT	FT	FT
S1	P.36	125+63	RT.		RRFB		1	2	1	2	1						
S2	P.36	125+51	LT.		RRFB		1	2	1	2	1						
S3	P.36	125+72	LT.	R10-15	30x30							6.3	1	5			
SL-1	P.36	125+75	LT.														10
CW-1	P.36	125+63													50	70	
TOTALS CARRIED TO GENERAL SUMMARY							2	4	2	4	2	6.3	1	5	50	70	10

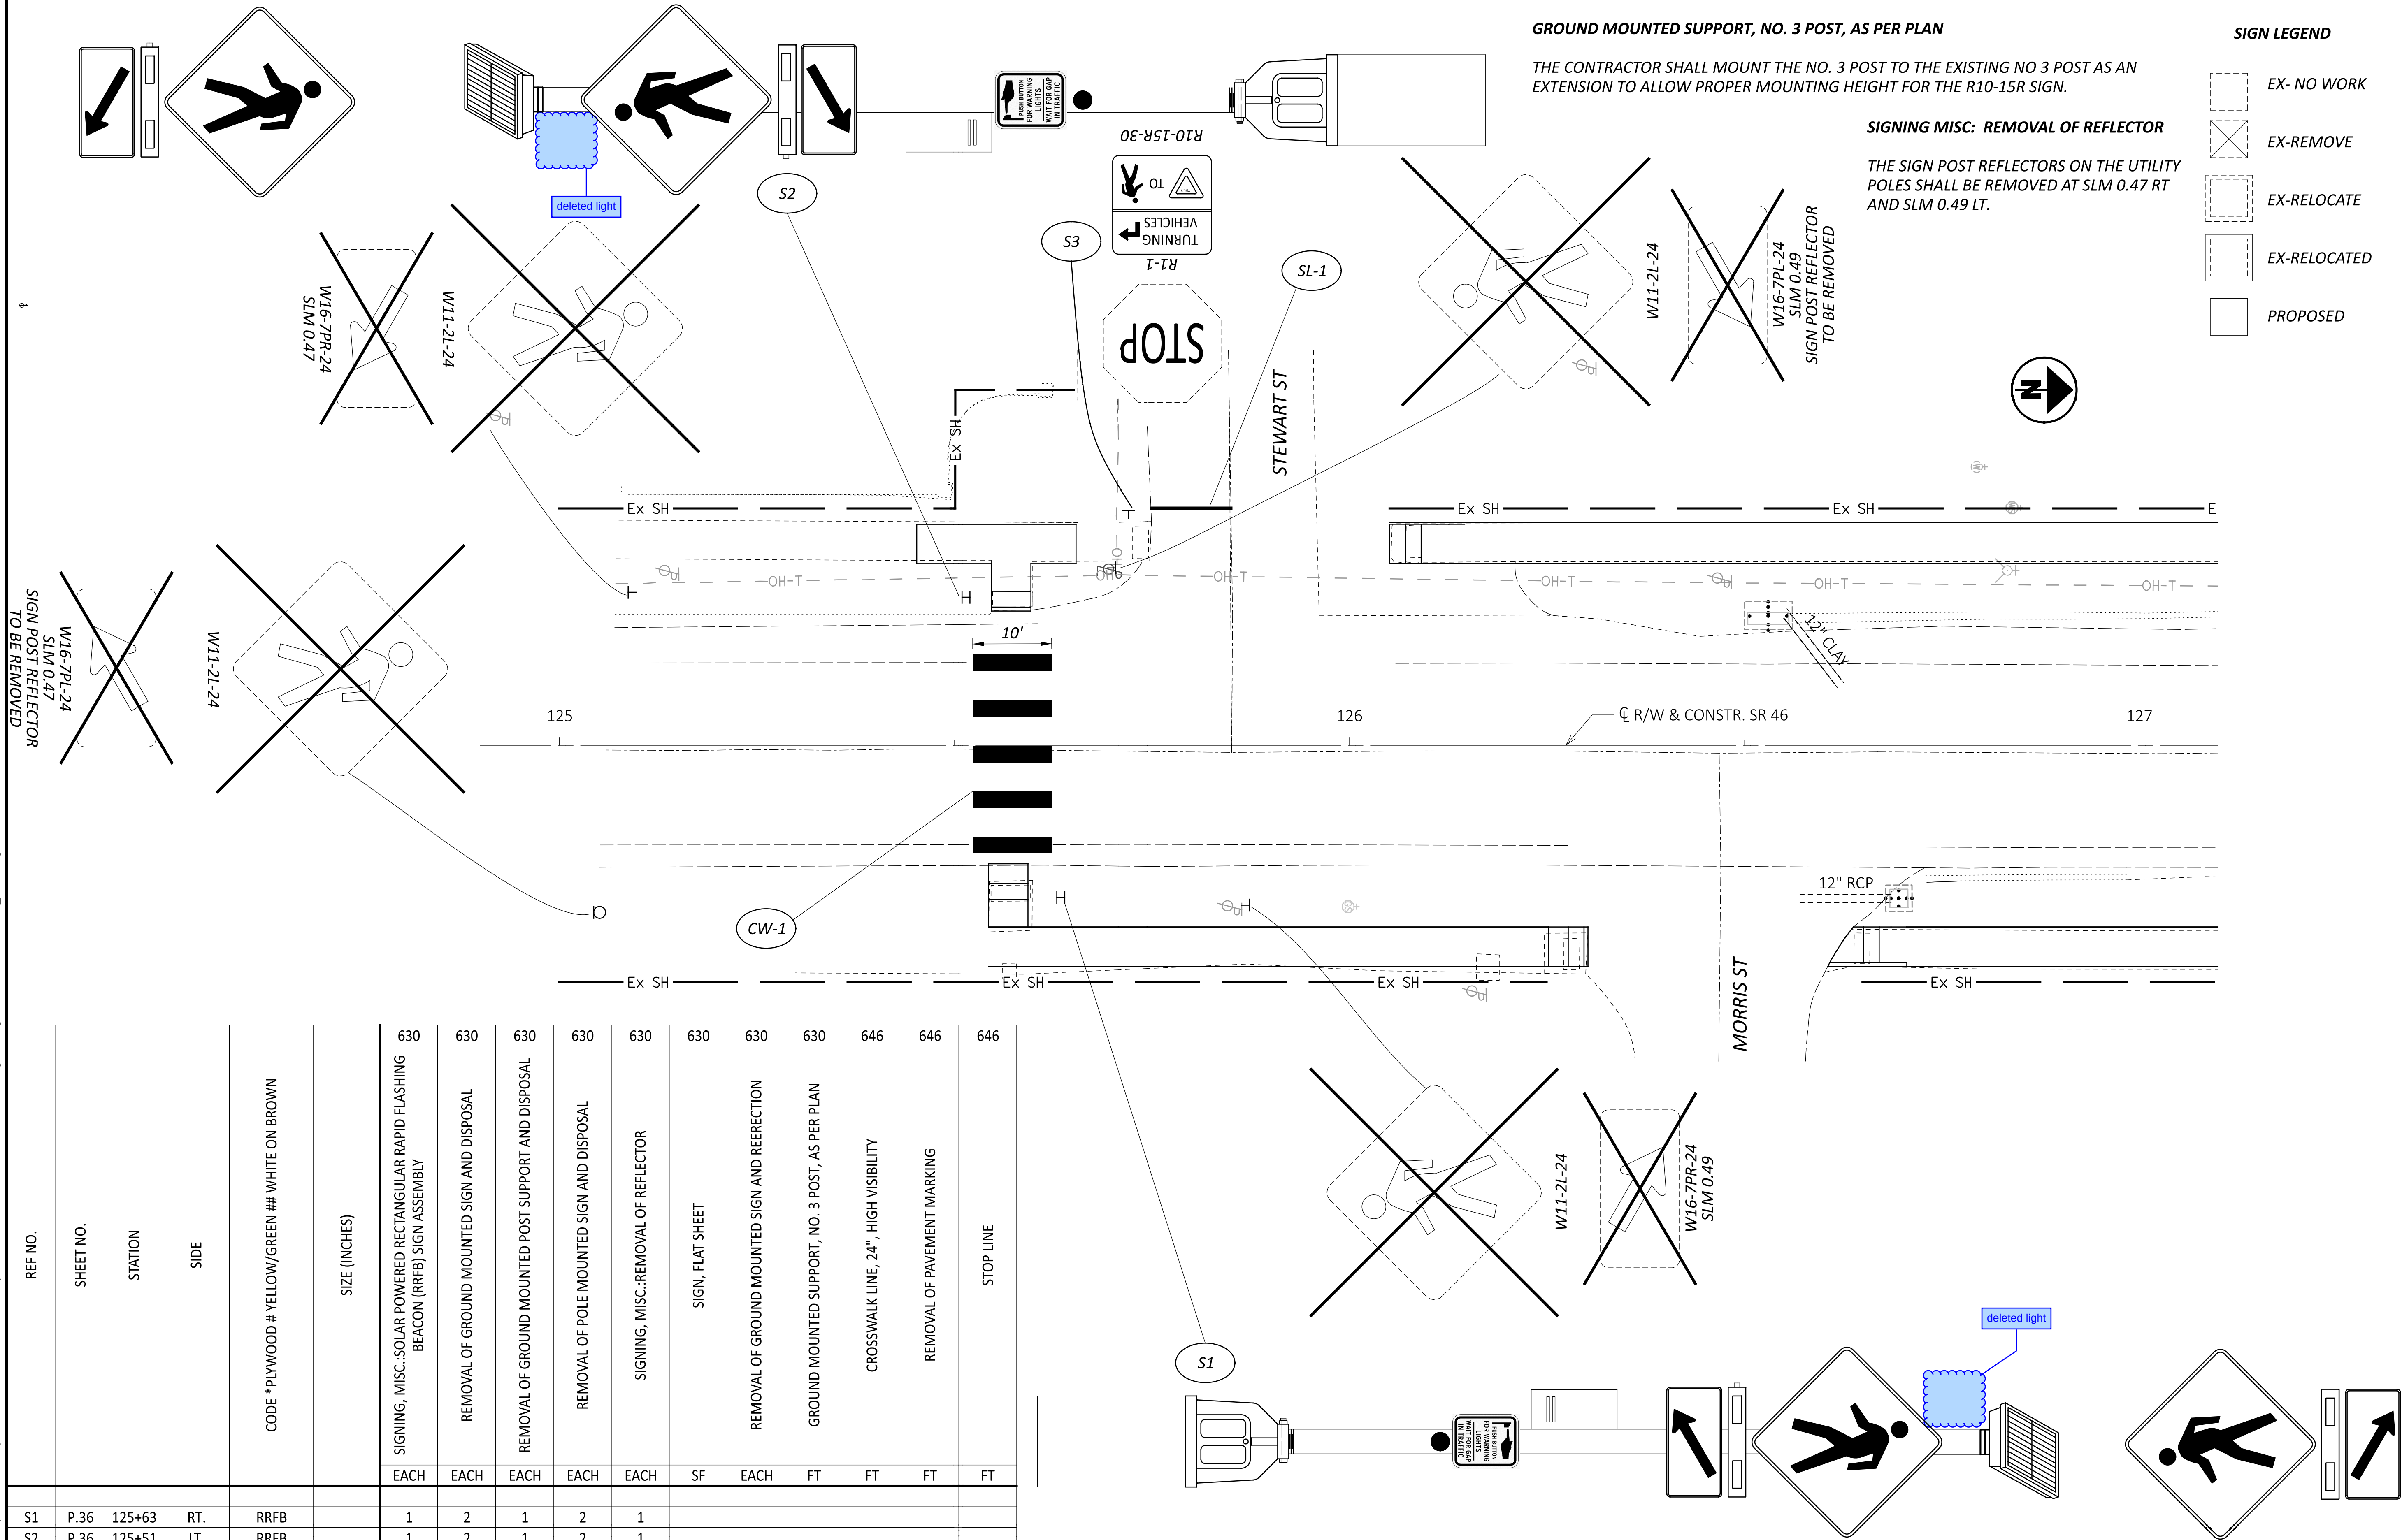

TRAFFIC CONTROL

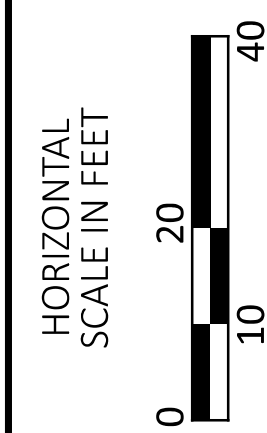

DESIGN AGENCY



DESIGNER
FA

REVIEWER
RMM 01/30/2

PROJECT ID
120979

SHEET	TOTAL
P.36	3