


ITEM 251 - PARTIAL DEPTH PAVEMENT REPAIR, (441), AS PER PLAN, 4.25"

SEE GENERAL NOTES FOR MORE INFORMATION REGARDING ITEM 251 - PARTIAL DEPTH PAVEMENT REPAIR, (441), AS PER PLAN, 4.25"

SEAL THE PERIMETER SURFACE OF THE REPAIRED AREAS BY APPLYING A 2 TO 4 INCH WIDE STRIP OF APPROVED 705.04 MATERIAL OR 702.01 APPROVED PG BINDER, PER CMS 255.07.

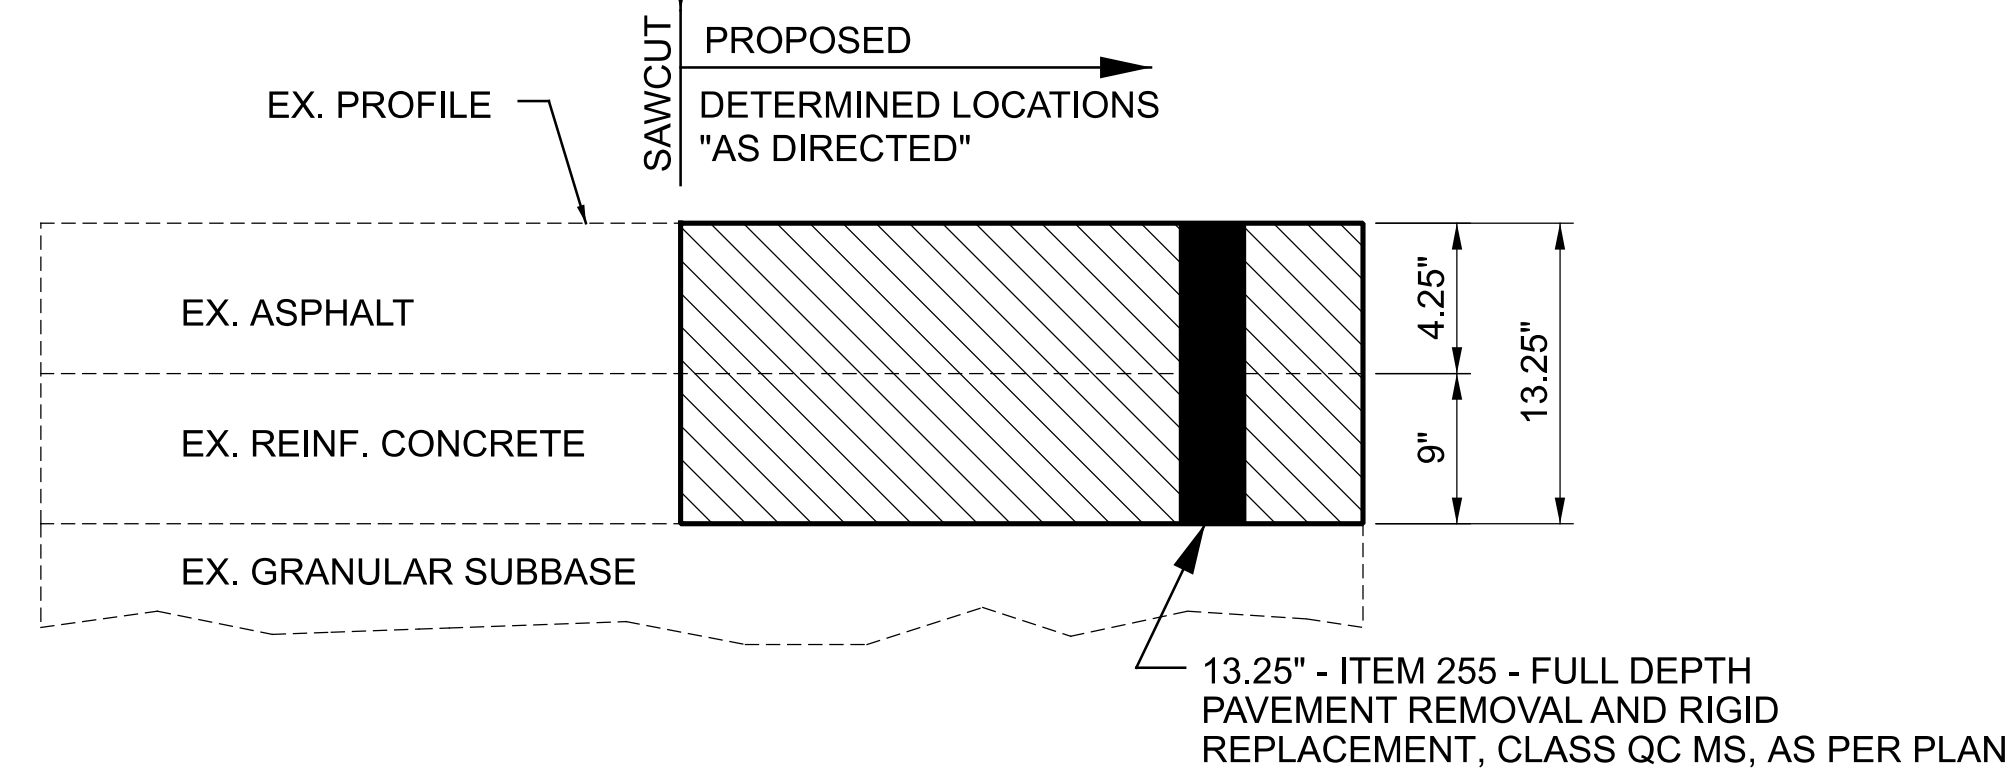

ITEM 255 - FULL DEPTH PAVEMENT REMOVAL AND RIGID REPLACEMENT, CLASS QC MS, AS PER PLAN

SEE GENERAL NOTES FOR MORE INFORMATION REGARDING ITEM 255 - FULL DEPTH PAVEMENT REMOVAL AND RIGID REPLACEMENT, CLASS QC MS, AS PER PLAN. SEE PAVEMENT REPAIR SUBSUMMARY FOR LOCATIONS OF REPAIRS.

