


STATE OF OHIO
 DEPARTMENT OF TRANSPORTATION
VAN-CR 418- 2.840-8.139
 TULLY, UNION AND PLEASANT TOWNSHIPS
 VAN WERT COUNTY



LATITUDE: 40°53'20.99" North
 LONGITUDE: 84°39'20.87" West

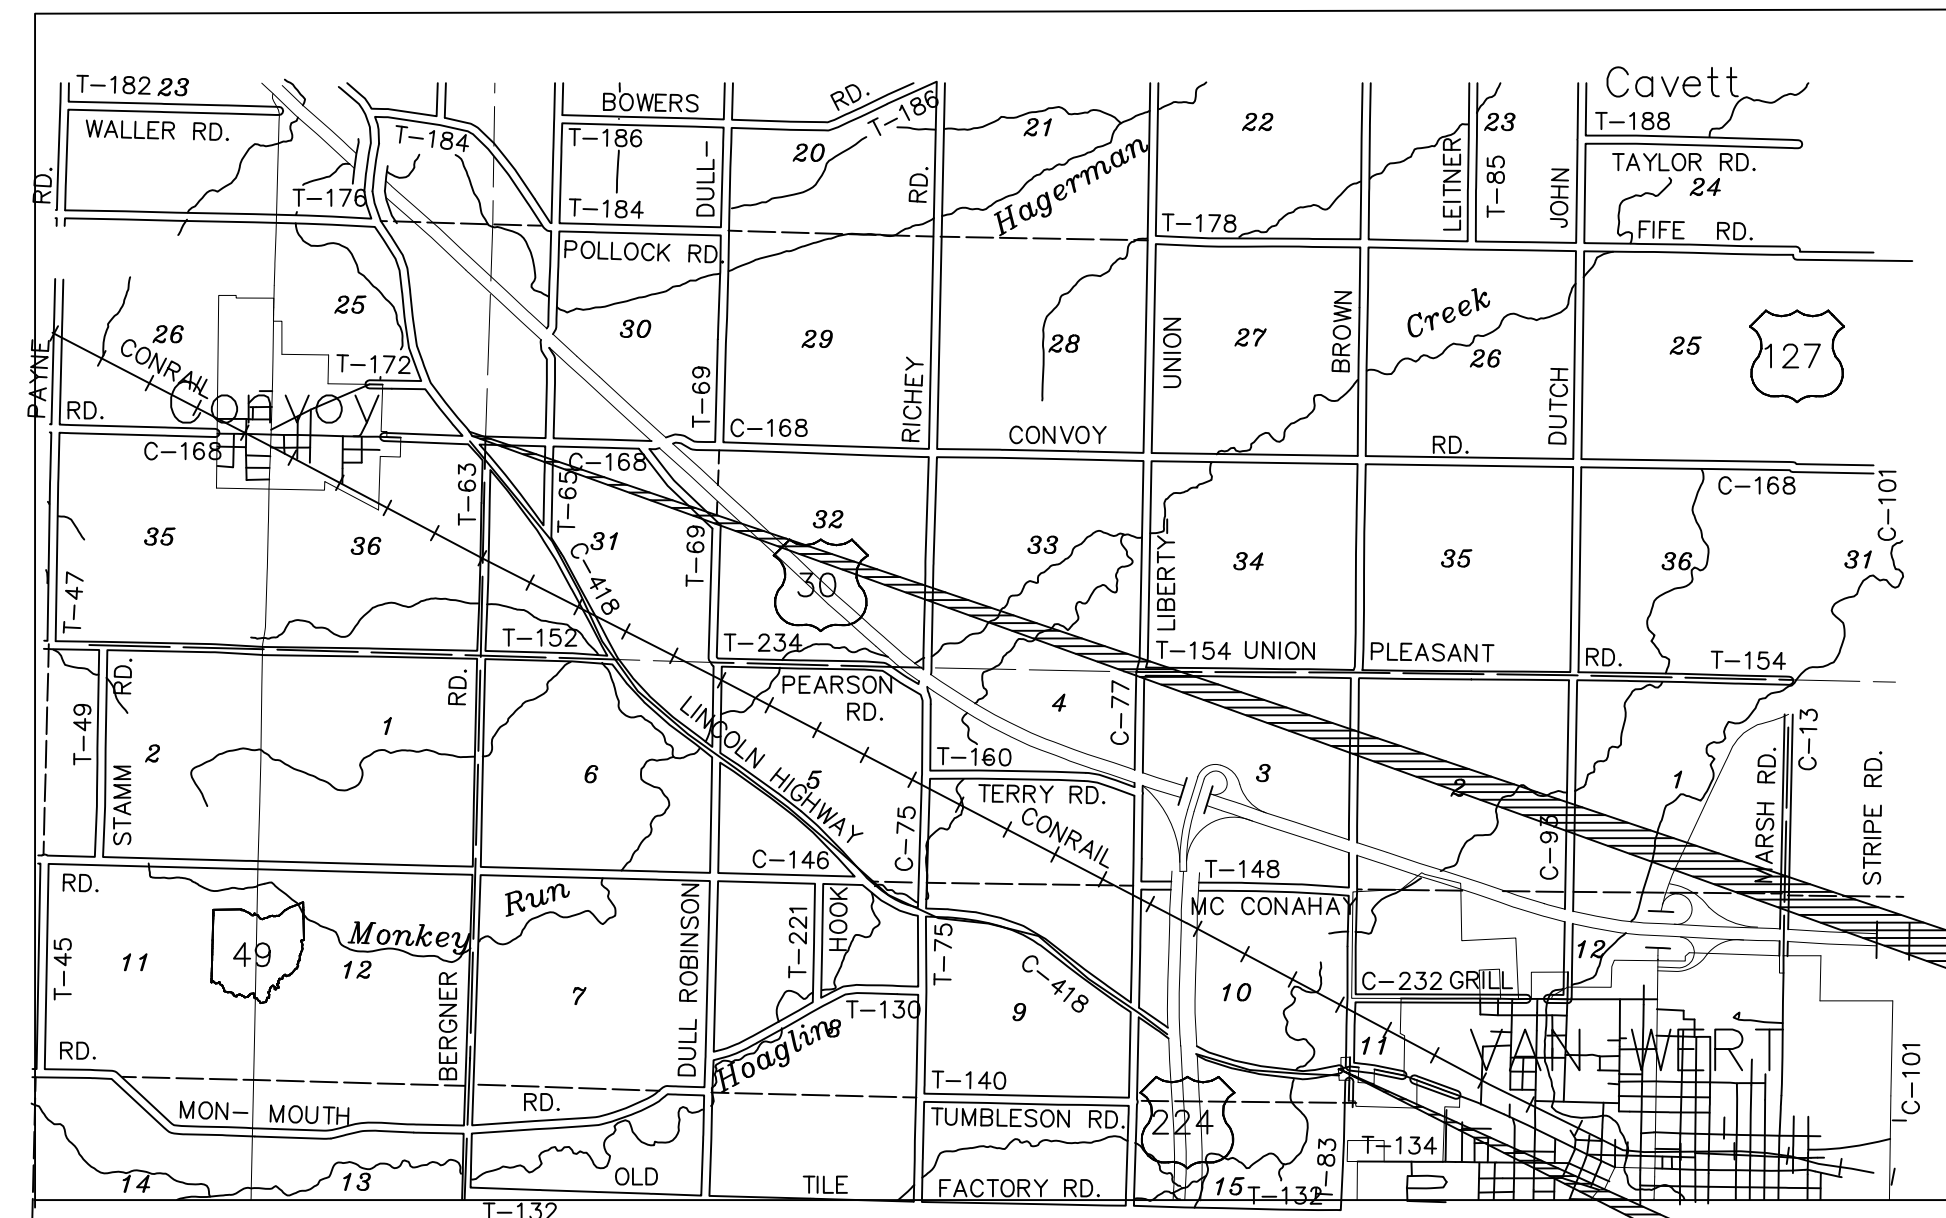

DETOUR & LOCATION MAP

DESIGN DESIGNATION


CURRENT AADT TMS (2021)	3396
DESIGN ADT (2043)	4576
DHV (2043)	458
D (DIRECTIONAL DISTRIBUTION)	55%
T (PERCENT B AND C TRUCKS)	3%
V (DESIGN SPEED)	3R Project
V (LEGAL SPEED)	55 mph & 45 mph

FUNCTIONAL CLASSIFICATION = RURAL MAJOR COLLECTOR

DESIGN EXCEPTIONS: NONE



PLANS PREPARED BY:
VAN WERT COUNTY ENGINEER
 1192 GRILL RD
 VAN WERT, OHIO 45891
 PH (419) 238-0210

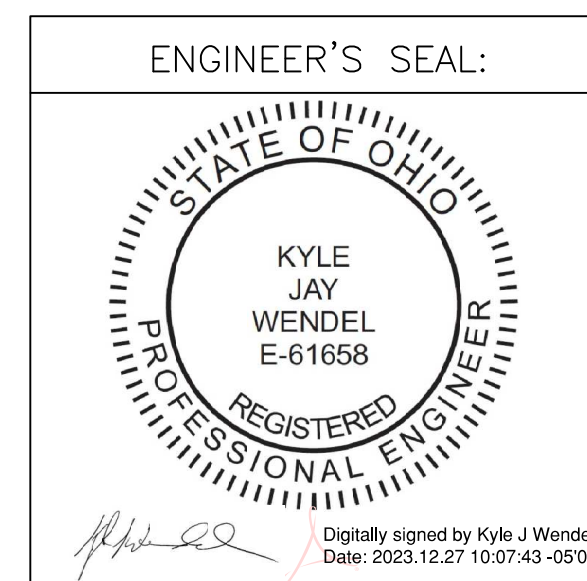

STANDARD CONSTRUCTION DRAWINGS			SUPPLEMENTAL SPECIFICATIONS	
BP-3.1	01/21/22	TC-65.10	1/17/14	800 10/20/2023
		TC-65.11	7/15/22	832 7/15/2022
		TC-64.10	1/20/23	875 1/18/2019
MT-97.11	1/20/17	TC-41.20	10/18/13	
MT-97.12	1/20/17	TC-42.10	10/18/13	
MT-99.20	4/19/19	TC-42.20	10/18/13	
MT-101.90	7/17/20	TC-52.10	10/18/13	
MT-105.10	1/17/20	TC-52.20	1/15/21	
DM-4.3	1/15/16			
DM-4.1	7/17/20			

BEGIN PROJECT
 STA 383+65.46

END PROJECT
 STA 665+81.09

INDEX OF SHEETS

TITLE SHEET	1
GENERAL NOTES	2
TYPICAL SECTIONS	3
DRIVEWAYS & MAILBOX APPROACHES	4
SCHEMATIC PLAN	5
SCHEMATIC PLAN	6
SCHEMATIC PLAN	7
TRANSITION DETAIL	8
TRANSITION DETAIL	9
TRANSITION DETAIL	10
INTERSECTION DETAILS	11
INTERSECTION DETAILS	12
INTERSECTION DETAILS	13
PAVEMENT MARKINGS & INTERSECTION SUMMARY	14
GENERAL SUMMARY	15

PROJECT DESCRIPTION

IMPROVEMENT OF 5.30 MI. OF LINCOLN HIGHWAY IN VAN WERT COUNTY BY RESURFACING.

2023 SPECIFICATIONS

THE STANDARD SPECIFICATIONS OF THE STATE OF OHIO, DEPARTMENT OF TRANSPORTATION, INCLUDING CHANGES AND SUPPLEMENTAL SPECIFICATIONS LISTED IN THE PROPOSAL, SHALL GOVERN THIS IMPROVEMENT.

EARTH DISTURBED AREAS

PROJECT EARTH DISTURBED AREA:	0.0 ACRES
ESTIMATED CONTRACTOR EARTH DISTURBED AREA:	0.0 ACRES
NOTICE OF INTENT EARTH DISTURBED AREA:	N/A (NOI NOT REQUIRED)

I HEREBY APPROVE THESE PLANS AND DECLARE THAT THE MAKING OF THIS IMPROVEMENT WILL NOT REQUIRE THE CLOSING TO TRAFFIC OF THE HIGHWAY AND THAT PROVISIONS FOR THE MAINTENANCE AND SAFETY OF TRAFFIC WILL BE AS SET FORTH ON THE PLANS AND ESTIMATES.

Christopher A. Hughes
 Christopher A. Hughes, P.E.
 District 01 Deputy Director

Jack Marchbanks
 Jack Marchbanks, PhD
 Director, Department of Transportation

FEDERAL PROJECT NUMBER
 E1161621

PID NO.
 101976

RAILROAD INVOLVEMENT
 NONE

VAN-CR418-2.840-8.139