

BENCHING OF FOUNDATION SLOPES

Although cross-sections indicate specific dimensions for proposed benching of the embankment foundations in certain areas, no waiver of the specifications is intended. Bench all other sloped embankment areas as set forth in 203.05. No additional payment will be made for benching required under the provisions of 203.05.

CONNECTION BETWEEN EXISTING AND PROPOSED GUARDRAIL

When it is necessary to splice proposed guardrail to existing guardrail, only the existing guardrail shall be cut, drilled, or punched. The connection shall be made using a W-Beam, beam splice as shown in AASHTO M 80-12, except the beam washers are not to be used. Payment shall be included in the contract price for the respective guardrail items.

ENVIRONMENTAL COMMITMENTS

1. The project is located within the known habitat ranges of the federally-listed northern long-eared and Indiana bats, and the state-listed little brown and tricolored bats. The Contractor shall not remove trees under this project from April 1 through September 30. All necessary tree removal shall occur from October 1 through March 31. The Contractor shall demarcate clearing limits in the field to avoid any unauthorized tree clearing. This requirement is necessary to avoid and minimize impacts to these species as required by the Endangered Species Act. For the purposes of this note, a tree is defined as a live, dying, or dead woody plant, with a trunk three inches or greater in diameter at a height of 4.5 feet above the ground surface, and with a minimum height of 13 feet.

2. The following Section 4(f) measures to minimize harm will be added as project plan notes to address impacts to the Countryside YMCA Trail and Premier Health Atrium Medical Center Bike Park:

- Partial closure of the Countryside YMCA Trail will be required, but access shall be maintained at all times.
- Appropriate signage will be installed to alert users of construction activities on the Countryside YMCA Trail.
- The staging and/or storage of construction equipment or materials shall not take place outside proposed construction limits that are within the defined boundaries of the 4(f) properties.
- The contractor shall be required to closely coordinate the construction schedule with the City of Lebanon prior to the start of construction activities.
- The entrance to the Premier Health Atrium Medical Center Bike Park shall be maintained at all times.
- The shed located within the bike park boundary will not be disturbed.
- Access to the trails and the parking lot within the bike park will be maintained at all times, except for the time needed to temporarily occupy the property. The duration of the temporary occupancy shall be less than 14 days.
- Appropriate signage will be installed by the contractor at the park entrance to alert users of construction activities within the Premier Health Atrium Medical Center Bike Park.

3. The Contractor shall not perform any work within the jurisdictional boundaries of any waterway, including wetlands, until the necessary waterway permit(s) are obtained. This includes the placement of any temporary or permanent fills.

4. The Contractor shall provide the Project Engineer a Post-Construction Completion Certification Report, per OAC 3745-513-370, within 30 days of completion of the construction activities within 300 feet of the former City of Lebanon Municipal Landfill.

LANDFILL (3745-513) AUTHORIZATION

The City of Lebanon Municipal Landfill is located within the project limits from STA 1+50.00 to STA 3+06.50. The OEPA issued an Authorization under OAC 3745-513-01 (H) or (M) to work in the landfill. This Authorization is included in the special provisions. Adhere to all terms and conditions of the Authorization during construction. Determine appropriate personal protective equipment for those who conduct work within the limits of the landfill. Manage all excavated materials as a solid waste and dispose of at a licensed landfill. Provide completed log forms and manifests for transport and disposal to the Engineer for signature. The Contractor is responsible for any additional testing that the landfill may require for disposal.

If excavations within the landfill limits require dewatering for construction purposes, dewater, containerize, and dispose of waters by the method proscribed in the Authorization.

Backfill all excavated areas with suitable material in accordance with the OEPA Authorization, project plans, applicable ODOT specifications, or as directed by the Engineer. Complete the certification report following guidance contained under OAC 3745-513-370 within 60 days for authorizations under OAC 3745-513-01 (H) and (M). Furnish all the labor, equipment, and materials necessary to properly manage, store (if necessary), test for disposal, transport, and dispose of regulated materials, including any required permits or fees within the identified limits. Payment for this work shall be made at the contract price bid. The following estimated quantity has been included in the General Summary:

| | | |
|--------------------------------------|----|-----|
| 690E65000 Work Involving | | |
| Non-regulated Material | 45 | Ton |
| 690E65010 Work Involving Solid Waste | 45 | Ton |

k:\Roadway_Projects\99993_LEBANON2\Design\Roadway\Sheet\99993.dgn Sheet 2/10/2022 9:40:50 AM mike

CALCULATED
VG
CHECKED
MJH

GENERAL NOTES

**WAR-COUNTRYSIDE
YMCA TRAIL EXT.**

For General Note Abbreviation information, see Sheet 6.

K:\Roadway\Projects\9993_LEBANON2\Design\Roadway\Sheet\2/10/2022 9:40:59 AM mike

| SHEET NUM. | | | | | | | | | | | PART. | ALT | ITEM | ITEM | GRAND | UNIT | DESCRIPTION | SEE SHEET NO. | CALCULATED | CHECKED |
|------------|---|----|-------|-------|-----|----|----|----|-------------|--|-----------|-----|---------|----------|--------|------|---|---------------|------------|---------|
| 7 | 8 | 10 | 13 | 14 | 15 | 50 | 63 | 65 | Office Calc | | 04/CMQ/OT | (X) | EXT | TOTAL | | | | | VG | MJH |
| | | | | | | | | | | | LS | | 201 | 11000 | LS | | ROADWAY | | | |
| | | | 1 | | | | | | | | 1 | | 202 | 98100 | 1 | EACH | REMOVAL MISC.:FOOTBRIDGE | 7 | | |
| | | | 351 | | | | | | | | 351 | | 202 | 23001 | 351 | SY | PAVEMENT REMOVED, AS PER PLAN | 7 | | |
| | | | 6,064 | | | | | | | | 6,064 | | 202 | 30000 | 6,064 | SF | WALK REMOVED | | | |
| | | | 42 | | | | | | | | 42 | | 202 | 32000 | 42 | FT | CURB REMOVED | | | |
| | | | 344 | | | | | | | | 344 | | 202 | 32500 | 344 | FT | CURB AND GUTTER REMOVED | | | |
| | | | 170 | | | | | | | | 170 | | 202 | 38000 | 170 | FT | GUARDRAIL REMOVED | | | |
| | | | 85 | | | | | | | | 85 | | 202 | 75000 | 85 | FT | FENCE REMOVED | | | |
| | | | 1 | | | | | | | | 1 | | 202 | 98100 | 1 | EACH | REMOVAL MISC.: EXISTING POST | 7 | | |
| | | | | 2,041 | | | | | | | 2,041 | | 203 | 10000 | 2,041 | CY | EXCAVATION | | | |
| | | | | 2,954 | | | | | | | 2,954 | | 203 | 20000 | 2,954 | CY | EMBANKMENT | | | |
| | | | | 3,462 | | | | | | | 3,462 | | 204 | 10000 | 3,462 | SY | SUBGRADE COMPACTION | | | |
| | | | | 4 | | | | | | | 4 | | 204 | 45000 | 4 | HOUR | PROOF ROLLING | | | |
| | | | 820 | | | | | | | | 820 | | 607 | 15100 | 820 | FT | FENCE, TYPE 47RA | | | |
| | | | 200 | | | | | | | | 200 | | 607 | 98000 | 200 | FT | FENCE, MISC.: WOODEN FENCE | 7 | | |
| | | | | 173 | | | | | | | 173 | | 608 | 10000 | 173 | SF | 4" CONCRETE WALK | | | |
| | | | | 3,158 | | | | | | | 3,158 | | 608 | 52001 | 3,158 | SF | CURB RAMP, AS PER PLAN | 7 | | |
| | | | | 32 | | | | | | | 32 | | 608 | 53020 | 32 | SF | DETECTABLE WARNING | | | |
| | | | | 518 | | | | | | | 518 | | 609 | 12001 | 518 | FT | COMBINATION CURB AND GUTTER, TYPE 2, AS PER PLAN | 7 | | |
| | | | | 26 | | | | | | | 26 | | 609 | 26001 | 26 | FT | CURB, TYPE 6, AS PER PLAN | 7 | | |
| 45 | | | | | | | | | | | 45 | | SPECIAL | 69065000 | 45 | TON | WORK INVOLVING NON-REGULATED MATERIALS | 8 | | |
| 45 | | | | | | | | | | | 45 | | SPECIAL | 69065010 | 45 | TON | WORK INVOLVING SOLID WASTE | 8 | | |
| | | | | | | | | | | | LS | | 878 | 25000 | LS | | INSPECTION AND COMPACTION TESTING OF UNBOUND MATERIALS | | | |
| | | | | | | | | | | | | | | | | | EROSION CONTROL | | | |
| | | | | | 48 | | | | | | 48 | | 601 | 32200 | 48 | CY | ROCK CHANNEL PROTECTION, TYPE C WITH FILTER | | | |
| 506 | | | | | 760 | | | | | | 1,266 | | 659 | 00300 | 1,266 | CY | TOPSOIL | | | |
| 12,000 | | | | | | | | | | | 12,000 | | 659 | 10001 | 12,000 | SY | SEEDING AND MULCHING, AS PER PLAN | 7 | | |
| 1,200 | | | | | | | | | | | 1,200 | | 659 | 14001 | 1,200 | SY | REPAIR SEEDING AND MULCHING, AS PER PLAN | 7 | | |
| 1.6 | | | | | | | | | | | 1.6 | | 659 | 20000 | 1.6 | TON | COMMERCIAL FERTILIZER | | | |
| 65 | | | | | | | | | | | 65 | | 659 | 35000 | 65 | MGAL | WATER | | | |
| 4,550 | | | | | | | | | | | 4,550 | | 670 | 00500 | 4,550 | SY | SLOPE EROSION PROTECTION | | | |
| LS | | | 7 | | | | | | | | 7 | | 670 | 00710 | 7 | SY | DITCH EROSION PROTECTION MAT, TYPE A | | | |
| | | | | | | | | | | | LS | | 832 | 15000 | LS | | STORM WATER POLLUTION PREVENTION PLAN | | | |
| | | | | | | | | | | | LS | | 832 | 15002 | LS | | STORM WATER POLLUTION PREVENTION INSPECTIONS | | | |
| | | | | | | | | | | | LS | | 832 | 15010 | LS | | STORM WATER POLLUTION PREVENTION INSPECTION SOFTWARE | | | |
| | | | | | | | | | 21,000 | | 21,000 | | 832 | 30000 | 21,000 | EACH | EROSION CONTROL | | | |
| | | | | | | | | | | | | | | | | | DRAINAGE | | | |
| | | | | | 4.5 | | | | | | 4.5 | | 602 | 20000 | 4.5 | CY | CONCRETE MASONRY | | | |
| | | | | | 210 | | | | | | 210 | | 605 | 06000 | 210 | FT | 4" BASE PIPE UNDERDRAINS | 4 | | |
| | | | | | 56 | | | | | | 56 | | 611 | 53006 | 56 | FT | 38" X 60" CONDUIT, TYPE D, 706.04 | | | |
| | | | 2 | | | | | | | | 2 | | 611 | 99654 | 2 | EACH | MANHOLE ADJUSTED TO GRADE | | | |
| | | | | | | | | | | | | | | | | | DRAINAGE ALTERNATES | | | |
| | | | | | 80 | | | | | | 80 | x | 611 | 07900 | 80 | FT | 18" CONDUIT, TYPE D (GENERIC)(ALTERNATE 1) | | | |
| | | | | | 44 | | | | | | 44 | x | 611 | 10900 | 44 | FT | 24" CONDUIT, TYPE D (GENERIC)(ALTERNATE 1) | | | |
| | | | | | 56 | | | | | | 56 | x | 611 | 16900 | 56 | FT | 36" CONDUIT, TYPE D (GENERIC)(ALTERNATE 1) | | | |
| | | | | | 80 | | | | | | 80 | x | 611 | 07900 | 80 | FT | 18" CONDUIT, TYPE D (706.02)(ALTERNATE 2) | | | |
| | | | | | 44 | | | | | | 44 | x | 611 | 10900 | 44 | FT | 24" CONDUIT, TYPE D (706.02)(ALTERNATE 2) | | | |
| | | | | | 56 | | | | | | 56 | x | 611 | 16900 | 56 | FT | 36" CONDUIT, TYPE D (706.02)(ALTERNATE 2) | | | |
| | | | | | | | | | | | | | | | | | PAVEMENT | | | |
| | | | | | 609 | | | | | | 609 | | 301 | 46000 | 609 | CY | ASPHALT CONCRETE BASE, PG64-22, 4" | | | |
| | | | | | 30 | | | | | | 30 | | 301 | 46000 | 30 | CY | ASPHALT CONCRETE BASE, PG64-22, 6" | | | |
| | | | | | 577 | | | | | | 577 | | 304 | 20000 | 577 | CY | AGGREGATE BASE | | | |
| | | | | | 228 | | | | | | 228 | | 407 | 20000 | 228 | GAL | NON-TRACKING TACK COAT | | | |
| | | | | | 316 | | | | | | 316 | | 441 | 10000 | 316 | CY | ASPHALT CONCRETE SURFACE COURSE, TYPE 1, (446), PG64-22 | | | |
| | | | | | 116 | | | | | | 116 | | 452 | 11010 | 116 | SY | 7" NON-REINFORCED CONCRETE PAVEMENT, CLASS QC 1P | | | |

GENERAL SUMMARY




**WAR-COUNTRYSIDE
YMCA TRAIL EXT.**

Existing Signal Heads
(To Remain)

Proposed Signal Heads

Existing Signs
(To Remove)

Proposed Signs

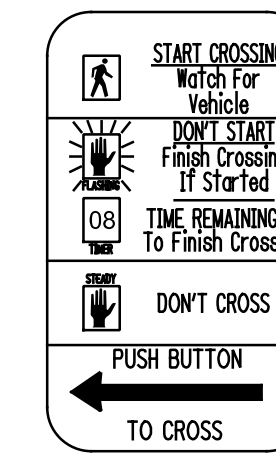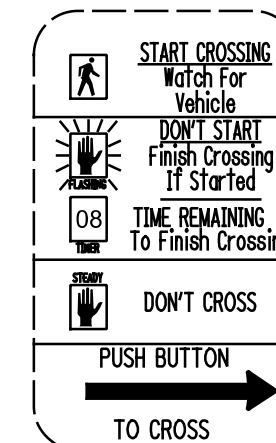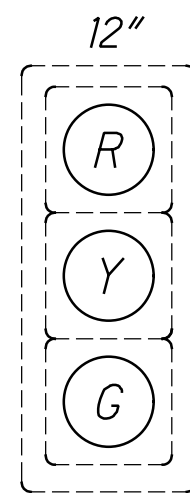

Pedestrian Heads (LED, Countdown, Type D2)

Pedestrian Heads (LED), Countdown, Type D2


R10-3e-9R
2 - Right Arrow
ES1,ES4

R9-3
ES6

R9-3
ES3,ES7,ES8

R10-3e-9L
2 - Left Arrow
S1,S2

Signal & Sign Layout Detail

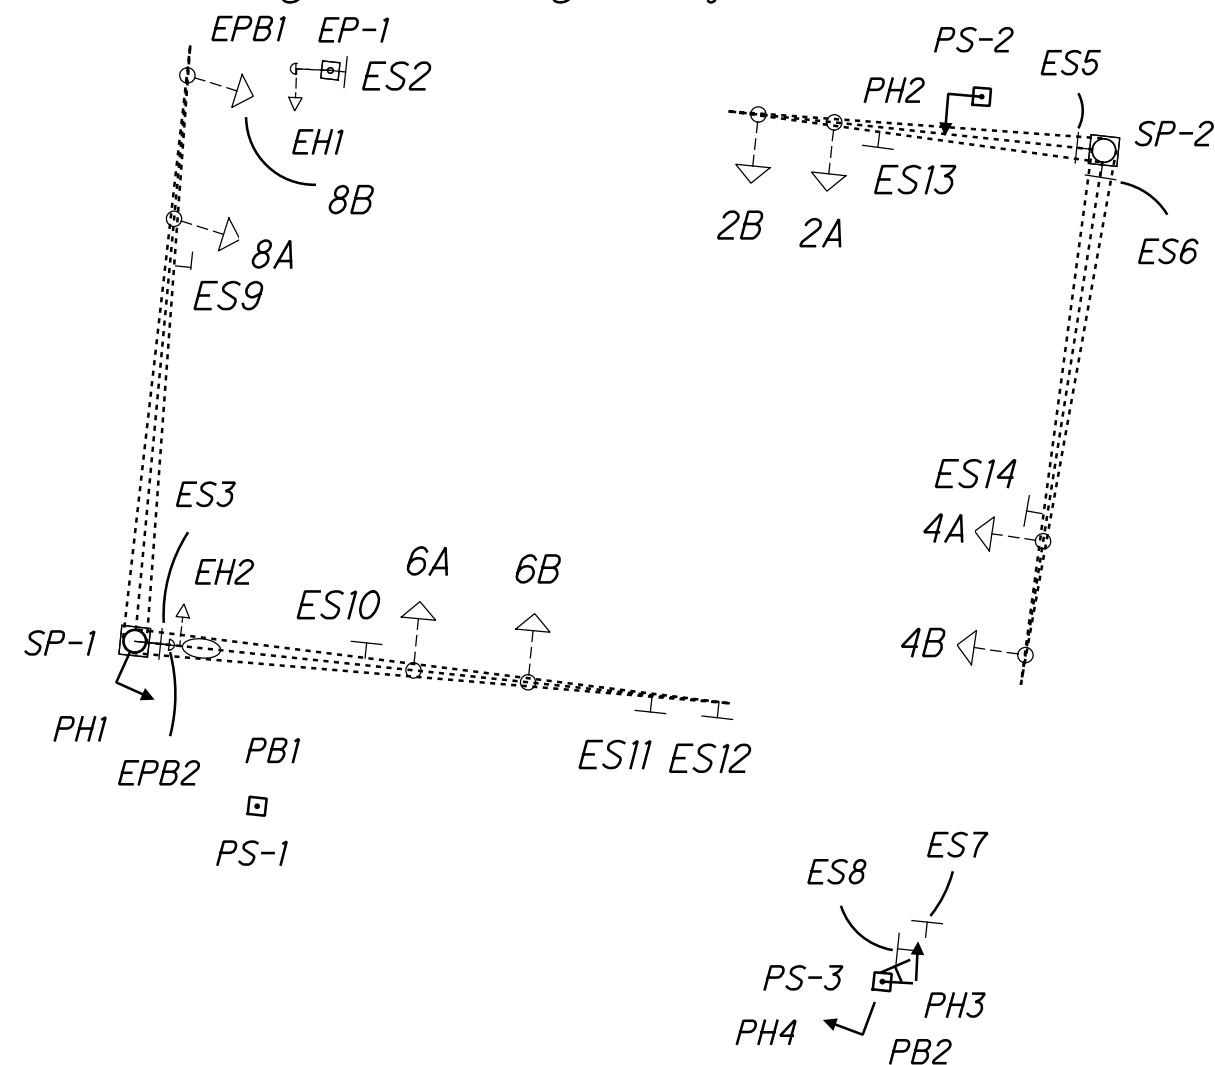

Existing Pull Box, EB3
To Remain

Existing Conduit
To Remain

Existing Pedestal, PS-2
With Existing Pedestrian Signal Head, EHI
Remove Existing Pushbutton, EPB1


Existing conduit
to remain

Proposed 8' Pedestal, PS-2
Add Pedestrian Signal Head, PH2
Sta. 78+79.5, 15.9' RT.


Proposed 2" PVC - 19'

Existing Signal Pole, SP-2
Remove Existing Sign, ES6


Existing Pull Box, EB5
To Be Modified

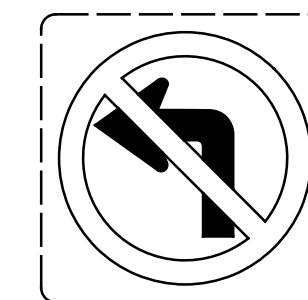

R3-2
ES11

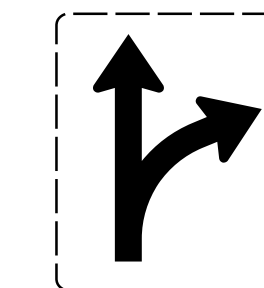

R3-6R
ES12

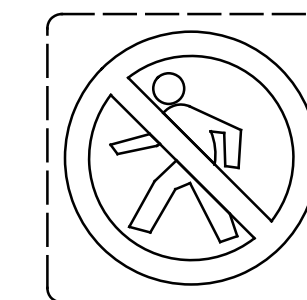

R9-3
ES2,ES5

Existing Signs
(To Remain)

Existing Signal Pole, SP-1
Add Pedestrian Signal Head, PHI
Remove Existing sign, ES3
Remove existing pushbutton, EPB2

Existing Pull Box, EB2
To Be Relocated

Relocated Pull Box, EB2
Sta. 78+01.1, 48.1' LT.

Existing Conduit
To Remain

Proposed 8' Pedestal, PS-1
Add Pushbutton, PB1
Sta. 77+98.1, 51.5' LT.

Proposed 2" PVC - 8'

Existing Conduit
To Be Removed

Proposed 2" PVC - 10'

Existing Pull Box, EB1
To Be Modified

Existing Controller
To Be Modified

Existing Conduit
To Remain

Plan View

Existing Conduit
To Remain

Existing Pull Box, EB4
To Be Modified

Existing Conduit
To Remain

Existing Utility Pole
Remove Existing Signs, ES7 & ES8


Proposed 8' Pedestal, PS-3
Add Pushbutton, PB2
Add Pedestrian Signal Heads, PH3 & PH4
Sta. 77+86.7, 15.2' RT.

Traffic Signal Legend

| | Proposed | Existing |
|-----------------------------|----------|----------|
| 3-Section Signal Head, 12" | | o--> |
| Pedestrian Signal Head | ↓ | ↓ |
| Pushbutton | — | — |
| Signal pole | | □ |
| Pedestal | □ | □ |
| Sign | | + |
| Traffic Pull Box | ⊞ | ⊞ |
| Controller Cabinet With UPS | | ⊞ |
| Detector Loops | ◇ | ◇ |

Notes

1. Pole locations have been indicated as accurately as possible. In no case shall the clearance from face of curb to face of pole, sign or other proposed items be less than 3 ft. Top of pole foundations shall be flush with adjacent walk ways, if applicable.
2. Location of conduit runs shown on the drawing are approximate. Maintain 36" horizontal clearance from water and gas lines. Field adjust as needed.
3. All conduit shall be installed in open-cut trench.

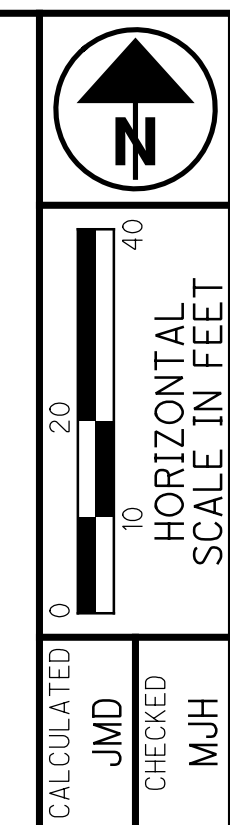

TRAFFIC SIGNAL PLAN
DEERFIELD RD. & TURTLECREK UNION RD.

WAR-COUNTRYSIDE
YMCA TRAIL EXT.