

H:\2018\80554\0D0T\ProjectData\06224\_SRI23\Design\Roadway\Sheets\06224\_G001.dgn Sheet 2/3/2023 12:59:50 PM Troyer

SHEET NUM.										PART.		ITEM	ITEM EXT	GRAND TOTAL	UNIT	DESCRIPTION	SEE SHEET NO.	CALCULATED EJT	CHECKED SDC
4	5	13	14	15	24	29	50	OFFICE CALCS	01/CMQ/04	02/BRF/11									
<b>ROADWAY</b>																			
LS									LS		201	11000	LS		CLEARING AND GRUBBING				
		4							4		202	20010	4	EACH	HEADWALL REMOVED				
					277			967	1,244		202	23000	1,244	SY	PAVEMENT REMOVED				
		60							60		202	32500	60	FT	CURB AND GUTTER REMOVED				
		56							56		202	32800	56	SY	CONCRETE SLOPE PROTECTION REMOVED				
		42							42		202	35100	42	FT	PIPE REMOVED, 24" AND UNDER				
									21		202	35200	21	FT	PIPE REMOVED, OVER 24"				
		180							180		202	38000	180	FT	GUARDRAIL REMOVED				
		1							1		202	42001	1	EACH	ANCHOR ASSEMBLY REMOVED, TYPE A, AS PER PLAN	4			
		LS							LS		202	98000	LS		REMOVAL MISC.: FIREPLACE	4			
		LS							LS		202	98000	LS		REMOVAL MISC.: DRIVEWAY BOX CULVERT STRUCTURE	4			
							127		127		203	10000	127	CY	EXCAVATION				
							109		109		203	10001	109	CY	EXCAVATION, AS PER PLAN	5			
							1,205		1,205		203	20000	1,205	CY	EMBANKMENT				
							109		109		203	20001	109	CY	EMBANKMENT, AS PER PLAN	5			
25									25		203	98000	25	CY	ROADWAY, MISC.: STRUCTURAL BACKFILL, TYPE 1	4			
							300		1,966		204	10000	2,266	SY	SUBGRADE COMPACTION				
40									40		204	13000	40	CY	EXCAVATION OF SUBGRADE				
40									40		204	20000	40	CY	EMBANKMENT				
1									1		204	45000	1	HOUR	PROOF ROLLING				
60									60		204	50000	60	SY	GEOTEXTILE FABRIC				
		400							400		606	15050	400	FT	GUARDRAIL, TYPE MGS				
		1							1		606	26050	1	EACH	ANCHOR ASSEMBLY, MGS TYPE B				
		3							3		606	26550	3	EACH	ANCHOR ASSEMBLY, MGS TYPE T				
								1	1		623	38500	1	EACH	MONUMENT ASSEMBLY, TYPE C				
									4		4	SPECIAL	69050100	4	EACH	MAILBOX SUPPORT SYSTEM, SINGLE	5		
									LS		878	25000	LS		INSPECTION AND COMPACTION TESTING OF UNBOUND MATERIALS				
<b>EROSION CONTROL</b>																			
									6		601	11000	6	SY	RIPRAP, TYPE D				
									2		659	00100	2	EACH	SOIL ANALYSIS TEST				
									300		659	00300	300	CY	TOPSOIL				
									2,695		659	10000	2,695	SY	SEEDING AND MULCHING				
									0.4		659	20000	0.4	TON	COMMERCIAL FERTILIZER				
									0.6		659	31000	0.6	ACRE	LIME				
									15		659	35000	15	MGAL	WATER				
									49		670	00700	49	SY	DITCH EROSION PROTECTION				
									21,000		832	30000	21,000	EACH	EROSION CONTROL				
<b>DRAINAGE</b>																			
									1.01		602	20000	1.01	CY	CONCRETE MASONRY				
109									109		605	31100	109	FT	AGGREGATE DRAINS				
									100		611	00400	100	FT	4" CONDUIT, TYPE E				
									250		611	00900	250	FT	6" CONDUIT, TYPE B				
									250		611	01100	250	FT	6" CONDUIT, TYPE C				
									100		611	01500	100	FT	6" CONDUIT, TYPE F				
									5		611	04600	5	FT	12" CONDUIT, TYPE C				
									72		611	06400	72	FT	15" CONDUIT, TYPE D				
									169		611	53100	169	FT	43" X 68" CONDUIT, TYPE A, 706.04				
									101		611	53200	101	FT	48" X 76" CONDUIT, TYPE A, 706.04				
									15		611	97400	15	FT	CONDUIT, MISC.: 3" ROOF DRAIN				
									1		611	98470	1	EACH	CATCH BASIN, NO. 2-2B	4			
									2		611	99574	2	EACH	MANHOLE, NO. 3 (96" DIAM)				

**GENERAL SUMMARY**

**WAR-123-28.55**



H:\2018\80554\0D01\ProjectData\06224\_SRI23\Design\Roadway\Sheets\06224\_G004.dgn Sheet 2/2/2023 1:9:50 PM troyer

SHEET NUM.				PART.		ITEM	ITEM EXT	GRAND TOTAL	UNIT	DESCRIPTION	SEE SHEET NO.					
6	7		41	01/CMQ/04	02/BRF/11											
<b>STRUCTURE OVER 20 FOOT SPAN (SFN: 8360546)</b>																
			LS		LS	202	11002	LS		STRUCTURE REMOVED, OVER 20 FOOT SPAN						
			86		86	202	23500	86	SY	WEARING COURSE REMOVED						
			LS		LS	503	11100	LS		COFFERDAMS AND EXCAVATION BRACING <sup>(R)</sup>						
			LS		LS	503	21300	LS		UNCLASSIFIED EXCAVATION						
			11,044		11,044	509	10000	11,044	LB	EPOXY COATED STEEL REINFORCEMENT						
			81		81	511	46510	81	CY	CLASS QC1 CONCRETE, FOOTING						
			77		77	511	46610	77	CY	CLASS QC1 CONCRETE, HEADWALL						
			8		8	511	50210	8	CY	CLASS QC1 CONCRETE, SUBSTRUCTURE						
			100		100	512	10100	100	SY	SEALING OF CONCRETE SURFACES (EPOXY-URETHANE)						
			185		185	512	33000	185	SY	TYPE 2 WATERPROOFING						
			285		285	512	33010	285	SY	TYPE 3 WATERPROOFING						
			102		102	516	13600	102	SF	1" PREFORMED EXPANSION JOINT FILLER						
			18		18	518	21201	18	CY	POROUS BACKFILL WITH GEOTEXTILE FABRIC, AS PER PLAN	41					
			51		51	601	32100	51	CY	ROCK CHANNEL PROTECTION, TYPE B WITH FILTER						
			55		55	601	34100	55	CY	ROCK CHANNEL PROTECTION, TYPE B WITHOUT FILTER						
			80		80	611	70001	80	FT	CONDUIT, TYPE A, PRECAST REINFORCED CONCRETE THREE SIDED FLAT TOPPED CULVERT, AS PER PLAN (28'-0" SPAN x 8'-0" RISE)	41					
<b>MAINTENANCE OF TRAFFIC</b>																
	20				20	410	12000	20	CY	TRAFFIC COMPACTED SURFACE, TYPE A OR B						
	60				60	614	11110	60	HOUR	LAW ENFORCEMENT OFFICER WITH PATROL CAR FOR ASSISTANCE						
	LS				LS	614	12420	LS		DETOUR SIGNING						
	10				10	614	13000	10	CY	ASPHALT CONCRETE FOR MAINTAINING TRAFFIC						
	16				16	614	18600	16	SNMT	PORTABLE CHANGEABLE MESSAGE SIGN						
	30				30	616	10000	30	MGAL	WATER						
	180				180	622	41100	180	FT	PORTABLE BARRIER, UNANCHORED						
<b>INCIDENTALS</b>																
	LS	LS			LS	614	11000	LS		MAINTAINING TRAFFIC						
					LS	623	10000	LS		CONSTRUCTION LAYOUT STAKES AND SURVEYING						
					LS	624	10000	LS		MOBILIZATION						
										<table border="1"> <thead> <tr> <th>REV.</th> <th>DATE</th> <th>DESCRIPTION</th> </tr> </thead> <tbody> <tr> <td>R1</td> <td>2-2-23</td> <td>ADDED QUANTITY FOR COFFERDAMS AND EXCAVATION BRACING. CHANGED UNIT AND ITEM EXTENSION OF POROUS BACKFILL.</td> </tr> </tbody> </table>	REV.	DATE	DESCRIPTION	R1	2-2-23	ADDED QUANTITY FOR COFFERDAMS AND EXCAVATION BRACING. CHANGED UNIT AND ITEM EXTENSION OF POROUS BACKFILL.
REV.	DATE	DESCRIPTION														
R1	2-2-23	ADDED QUANTITY FOR COFFERDAMS AND EXCAVATION BRACING. CHANGED UNIT AND ITEM EXTENSION OF POROUS BACKFILL.														

**GENERAL SUMMARY**

**WAR - 123 - 28.55**

**GENERAL NOTES:**

**STANDARD BRIDGE DRAWINGS AND SUPPLEMENTAL SPECIFICATIONS:**

REFER TO THE FOLLOWING SUPPLEMENTAL SPECIFICATIONS:  
800 DATED 01-20-23

**DESIGN SPECIFICATIONS:**

THIS STRUCTURE CONFORMS TO THE 8TH EDITION OF THE "LRFD BRIDGE DESIGN SPECIFICATIONS" ADOPTED BY THE AMERICAN ASSOCIATION OF STATE HIGHWAY AND TRANSPORTATION OFFICIALS, 2017 AND THE ODOT BRIDGE DESIGN MANUAL, 2019.

**OPERATIONAL IMPORTANCE:**

A LOAD MODIFIER OF 1.0 HAS BEEN ASSUMED FOR THE DESIGN OF THIS STRUCTURE IN ACCORDANCE WITH THE AASHTO LRFD BRIDGE DESIGN SPECIFICATIONS, ARTICLE 1.3.5 AND THE ODOT BRIDGE DESIGN MANUAL, 2019.

**DESIGN LOADING:**

BRIDGE UNITS: HL-93 AND FUTURE WEARING SURFACE (FWS) OF 60 PSF  
HEADWALLS: EARTH PRESSURE + LIVE LOAD SURCHARGE

**DESIGN DATA:**

CONCRETE CLASS QC1 - COMPRESSIVE STRENGTH 4.0 KSI  
(HEADWALL, CULVERT FOOTING, AND PEDESTAL SUBSTRUCTURE)

REINFORCING STEEL - MINIMUM YIELD STRENGTH 60 KSI  
(EPOXY COATED)

PRECAST STRUCTURES - FOR PRECAST REINFORCED THREE SIDED STRUCTURES, SEE CMS SECTION 611

**FOUNDATION BEARING RESISTANCE:**

CULVERT FOOTINGS, AS DESIGNED, PRODUCE A MAXIMUM SERVICE LIMIT STATE BEARING PRESSURE OF 1.06 KIPS PER SQUARE FOOT AND A MAXIMUM STRENGTH LIMIT STATE BEARING PRESSURE OF 1.49 KIPS PER SQUARE FOOT. THE FACTORED BEARING RESISTANCE IS 4.0 KIPS PER SQUARE FOOT.

HEADWALL FOOTINGS, AS DESIGNED, PRODUCE A MAXIMUM SERVICE LIMIT STATE BEARING PRESSURE OF 1.68 KIPS PER SQUARE FOOT AND A MAXIMUM STRENGTH LIMIT STATE BEARING PRESSURE OF 2.57 KIPS PER SQUARE FOOT. THE FACTORED BEARING RESISTANCE IS 4.0 KIPS PER SQUARE FOOT.

**THREE SIDED STRUCTURE WALL AND TOP SLAB THICKNESS:**

THE WALL AND TOP SLAB THICKNESSES SHOWN IN THE PLANS WERE OBTAINED FROM THE MANUFACTURERS AT THE TIME THE PLANS WERE PREPARED. IF THE WALL AND/OR TOP SLAB THICKNESSES OF THE PROPOSED CULVERT ARE DIFFERENT FROM WHAT IS SHOWN IN THE PLANS, A MARKED COPY OF THE PROJECT PLANS, INCLUDING ALL PLAN NOTES AND DETAILS SHOWING ALL ITEMS AFFECTED BY THE DIFFERENT CULVERT DIMENSIONS, SHALL BE SUBMITTED FOR APPROVAL WITH THE SHOP DRAWINGS. ALL WORK REQUIRED TO ACCOMMODATE ANY REVISED DIMENSIONS SHALL BE AT NO EXTRA COST TO THE CITY.

**ITEM 518 - POROUS BACKFILL WITH GEOTEXTILE FABRIC, AS PER PLAN**

1'-6" THICK POROUS BACKFILL SHALL BE PLACED BEHIND THE HEADWALLS ONLY AND SHALL EXTEND TO 12" BELOW THE EMBANKMENT SURFACE OF THE FINISHED GROUND. GEOTEXTILE FABRIC TYPE D SHALL BE PLACED BETWEEN THE POROUS BACKFILL AND REPLACED EXCAVATION ADJACENT TO THE STRUCTURE. IT SHALL TURN UNDER THE BOTTOM OF THE POROUS BACKFILL AND RETURN 6" ABOVE THE TOP ELEVATION OF THE WEEPHOLE.

**FORESLOPE WALL ANCHOR DOWELS:**

ANCHOR PER CMS 510 WITH NONSHRINK, NONMETALLIC GROUT CONFORMING TO CMS 705.20 AND TO A DEPTH SPECIFIED IN THE PLANS. PAYMENT FOR DOWEL HOLES, GROUT, AND INSTALLATION SHALL BE INCLUDED WITH ITEM 511.


THREADED INSERTS OR NON-PROTRUDING MECHANICAL CONNECTORS CAPABLE OF DEVELOPING AT LEAST 125 PERCENT OF THE SPECIFIED YIELD STRENGTH OF THE REINFORCEMENT SHOWN ARE AN ACCEPTABLE ALTERNATIVE TO RESIN BONDING. MAINTAIN A MINIMUM COVER OF 3 INCHES AT THE BOTTOM OF THE CULVERT SLAB. MECHANICAL CONNECTORS SHALL HAVE AN L-SHAPED BAR INSIDE THE CULVERT WITH A MINIMUM HORIZONTAL LENGTH OF 12 INCHES. THE DEPARTMENT WILL CONSIDER PAYMENT FOR INSERTS OR MECHANICAL CONNECTORS AS INCIDENTAL TO ITEM 611.

**WATERPROOFING:**

TYPE 2 WATERPROOFING, PER CMS 512 AND 711.25, SHALL EXTEND VERTICALLY DOWN THE ENTIRE SIDES OF THE PRECAST CULVERT SECTIONS FOR ALL PORTIONS OF THE CULVERT WHICH SHALL BE IN CONTACT WITH THE BACKFILL. APPLY TYPE 2 WATERPROOFING TO THE ENTIRE SIDE OF THE PEDESTAL WALL IN CONTACT WITH FILL FROM TOP OF FOOTING TO CULVERT. PAYMENT FOR THE MEMBRANE WATERPROOFING SHALL BE AT THE CONTRACT PRICE BID PER SQUARE YARD FOR ITEM 512 - TYPE 2 WATERPROOFING.

IN ADDITION, TYPE 2 WATERPROOFING SHALL BE APPLIED ALONG THE JOINT BETWEEN THE PRECAST CULVERT UNIT AND THE CAST-IN-PLACE PEDESTAL INCLUDING BETWEEN THE JOINT PERIPHERY OF THE ELLIPTICAL PIPE AND THE PEDESTAL, AS SHOWN ON SHEETS 3 AND 8 OF 9.



TYPE 3 WATERPROOFING, PER CMS 512 AND 711.29 SHALL BE APPLIED TO THE ENTIRE TOP SURFACE OF THE PRECAST CULVERT SECTIONS AND SHALL EXTEND ONE FOOT VERTICALLY DOWN THE SIDES FOR ALL PORTIONS OF THE CULVERT WHICH SHALL BE IN CONTACT WITH THE BACKFILL. PAYMENT FOR THE MEMBRANE WATERPROOFING SHALL BE AT THE CONTRACT PRICE BID PER SQUARE YARD FOR ITEM 512 - TYPE 3 WATERPROOFING.

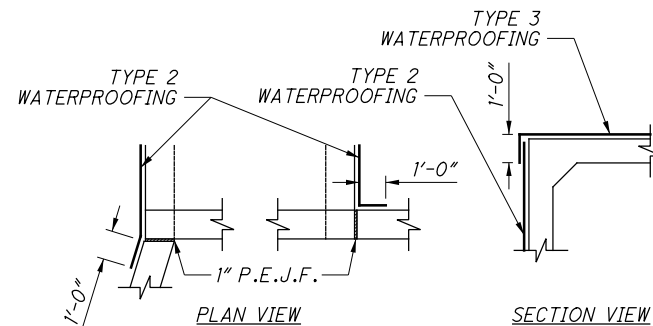

**WATERPROOFING DETAILS**

**ITEM 611 - CONDUIT, TYPE A, PRECAST REINFORCED CONCRETE THREE SIDED FLAT TOPPED CULVERT (28' SPAN X 8' RISE), AS PER PLAN**  
FOLLOW ALL REQUIREMENTS OF CMS 611 AND 706.051.

STRUCTURAL BACKFILL TYPE 1 THAT MEETS THE GRADATIONS OF ITEM 304 SHALL BE PLACED AS SHOWN IN THE DETAIL BELOW. QUANTITY SHALL BE BASED ON A TRENCH LENGTH CONSISTING OF THE LENGTH OF PAVEMENT PLUS 4 FEET OF ADDITIONAL LENGTH PER SIDE, MEASURED ALONG THE CENTERLINE OF THE CULVERT. PAYMENT FOR STRUCTURAL BACKFILL TYPE 1 AND THE EXCAVATION REQUIRED FOR THE PLACEMENT OF THE STRUCTURAL BACKFILL SHALL BE INCLUDED WITH ITEM 611 FOR PAYMENT.

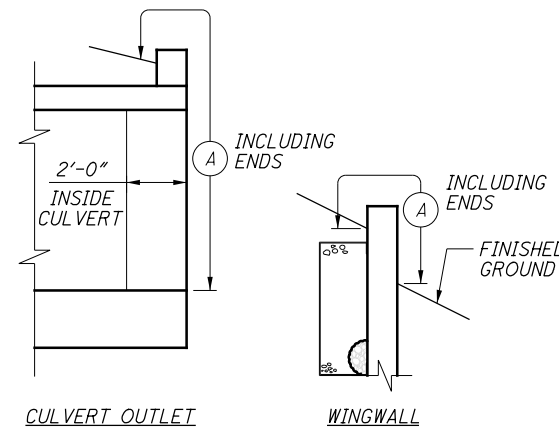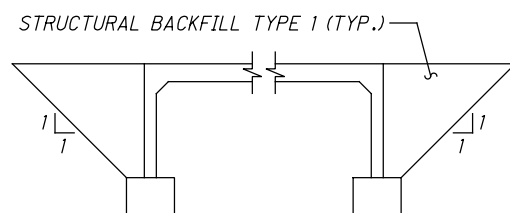

**LIMITS OF 512 - SEALING CONCRETE SURFACES**

(A) - SEAL ENTIRE CONCRETE SURFACE AREA

**ABBREVIATIONS:**

- @ - AT
- CL - CENTERLINE
- Ø - DIAMETER
- FL - FLOWLINE
- BOT. - BOTTOM
- CLR. - CLEAR, CLEARANCE
- CONST. - CONSTRUCTION
- CU. FT. - CUBIC FEET
- CFS - CUBIC FEET PER SECOND
- CY - CUBIC YARDS
- E.F. - EACH FACE
- EMBED. - EMBEDMENT
- EL. - ELEVATION
- EOP - EDGE OF PAVEMENT
- EQ. SPA. - EQUAL SPACES
- F.F. - FAR FACE
- FT. - FEET
- HW - HIGH WATER
- IN. - INCH
- KSF - KIPS PER SQUARE FOOT
- KSI - KIPS PER SQUARE INCH
- LB. - POUND
- LS - LUMP SUM
- LT. - LEFT
- MAX. - MAXIMUM
- MIN. - MINIMUM
- N.F. - NEAR FACE
- OHWM - ORDINARY HIGH WATER MARK
- P.E.J.F. - PREFORMED EXPANSION JOINT FILLER
- PRWS - PREFABRICATED RETAINING WALL SYSTEM
- RT. - RIGHT
- SER. - SERIES
- SY - SQUARE YARDS
- STA. - STATION
- T&B - TOP AND BOTTOM
- T/FTG - TOP OF FOOTING
- TYP. - TYPICAL
- VAR. - VARIES
- W/ - WITH

ESTIMATED QUANTITIES					
ITEM	ITEM EXT.	TOTAL	UNIT	DESCRIPTION	SHEET REF.
202	11002	LS		STRUCTURE REMOVED, OVER 20 FOOT SPAN	
202	23500	86	SY	WEARING COURSE REMOVED	
503	11100	LS		COFFERDAM AND EXCAVATION BRACING	
503	21300	LS		UNCLASSIFIED EXCAVATION	
509	10000	11044	LB	EPOXY COATED STEEL REINFORCEMENT	
511	46510	81	CY	CLASS QC1 CONCRETE, FOOTING	
511	46610	77	CY	CLASS QC1 CONCRETE, HEADWALL	
511	50210	8	CY	CLASS QC1 CONCRETE, SUBSTRUCTURE	
512	10100	100	SY	SEALING OF CONCRETE SURFACES (EPOXY-URETHANE)	
512	33000	185	SY	TYPE 2 WATERPROOFING	
512	33010	285	SY	TYPE 3 WATERPROOFING	
516	13600	102	SF	1" PREFORMED EXPANSION JOINT FILLER	
518	21201	18	CY	POROUS BACKFILL WITH GEOTEXTILE FABRIC, AS PER PLAN	2/9
601	32100	51	CY	ROCK CHANNEL PROTECTION, TYPE B WITH FILTER	
601	34100	55	CY	ROCK CHANNEL PROTECTION, TYPE B WITHOUT FILTER	
611	70001	80	FT	CONDUIT, TYPE A, PRECAST REINFORCED CONCRETE THREE SIDED FLAT TOPPED CULVERT (28' SPAN X 8' RISE), AS PER PLAN	2/9

ALL QUANTITIES ARE CARRIED TO THE ROADWAY GENERAL SUBSUMMARY.

REV.	DATE	DESCRIPTION
R1	2-2-23	COFFERDAM AND EXCAVATION BRACING ADDED

GENERAL NOTES & ESTIMATED QUANTITIES

BRIDGE NO. WAR-BEAL-00.10  
BEAL ROAD OVER STREAM 1

WAR-123-28.55  
PID No. 106224

2 / 9

41  
57

H:\2018\80554\001\ProjectData\06224\_SRI23\Design\Structures\WAR123\_2855C\_Sheets\23\_2855C\_SNO01.dgn Sheet 2/2/2023 1:02:19 PM Troyer

your trusted advisor  
engineers  
planners  
consultants